Guidelines to Using Section Plats

Public Works has a three sets of section plats in the records vault. They were originally produced by the county engineer. Each set was divided into four townships and then the townships were divided by range and section. It is difficult to date the sets as the dates on individual section plats vary significantly. In general they breakdown as follows:

- Set 1 – oldest - red binding in the vault - microfilmed (old book)
- Set 2 - - black binding in the vault - microfilmed
- Set 3 – newest – unbound linens – not microfilmed - scanned

There is much of the same information in each set. However, because these were working documents each set has information that is unique to it. It is common to find hand written notes concerning projects of that time.

This set of section plats may be navigated by using the PDF bookmarks.

The bookmarks will help you locate a range within a township. You will need to advance through the pages to find the appropriate section. Keep in mind that many times there is more than one plat for a given section.

You can do a text search of this file by clicking on the binocular icon near the top of the window. This will open a search window. Type in the word or phrase you wish to find and hit search. It usually works best to limit your search to a single word. A summary of what is found will be in the results box. By clicking on the various results you can move directly to that location. The search results for this document are of limited value as much of it is handwritten.


If you have any questions about using this file or suggestions or corrections please contact Keith Luna (3106) in the records vault.

SECTION 1
TOWNSHIP 33 NORTH, RANGE 2 EAST, W.M.
SKAGIT COUNTY, WASH.

SCALE 1 INCH ... 400 FEET

DATE 27, 1972

LLOYD H. JOHNSON, COUNTY ENGINEER

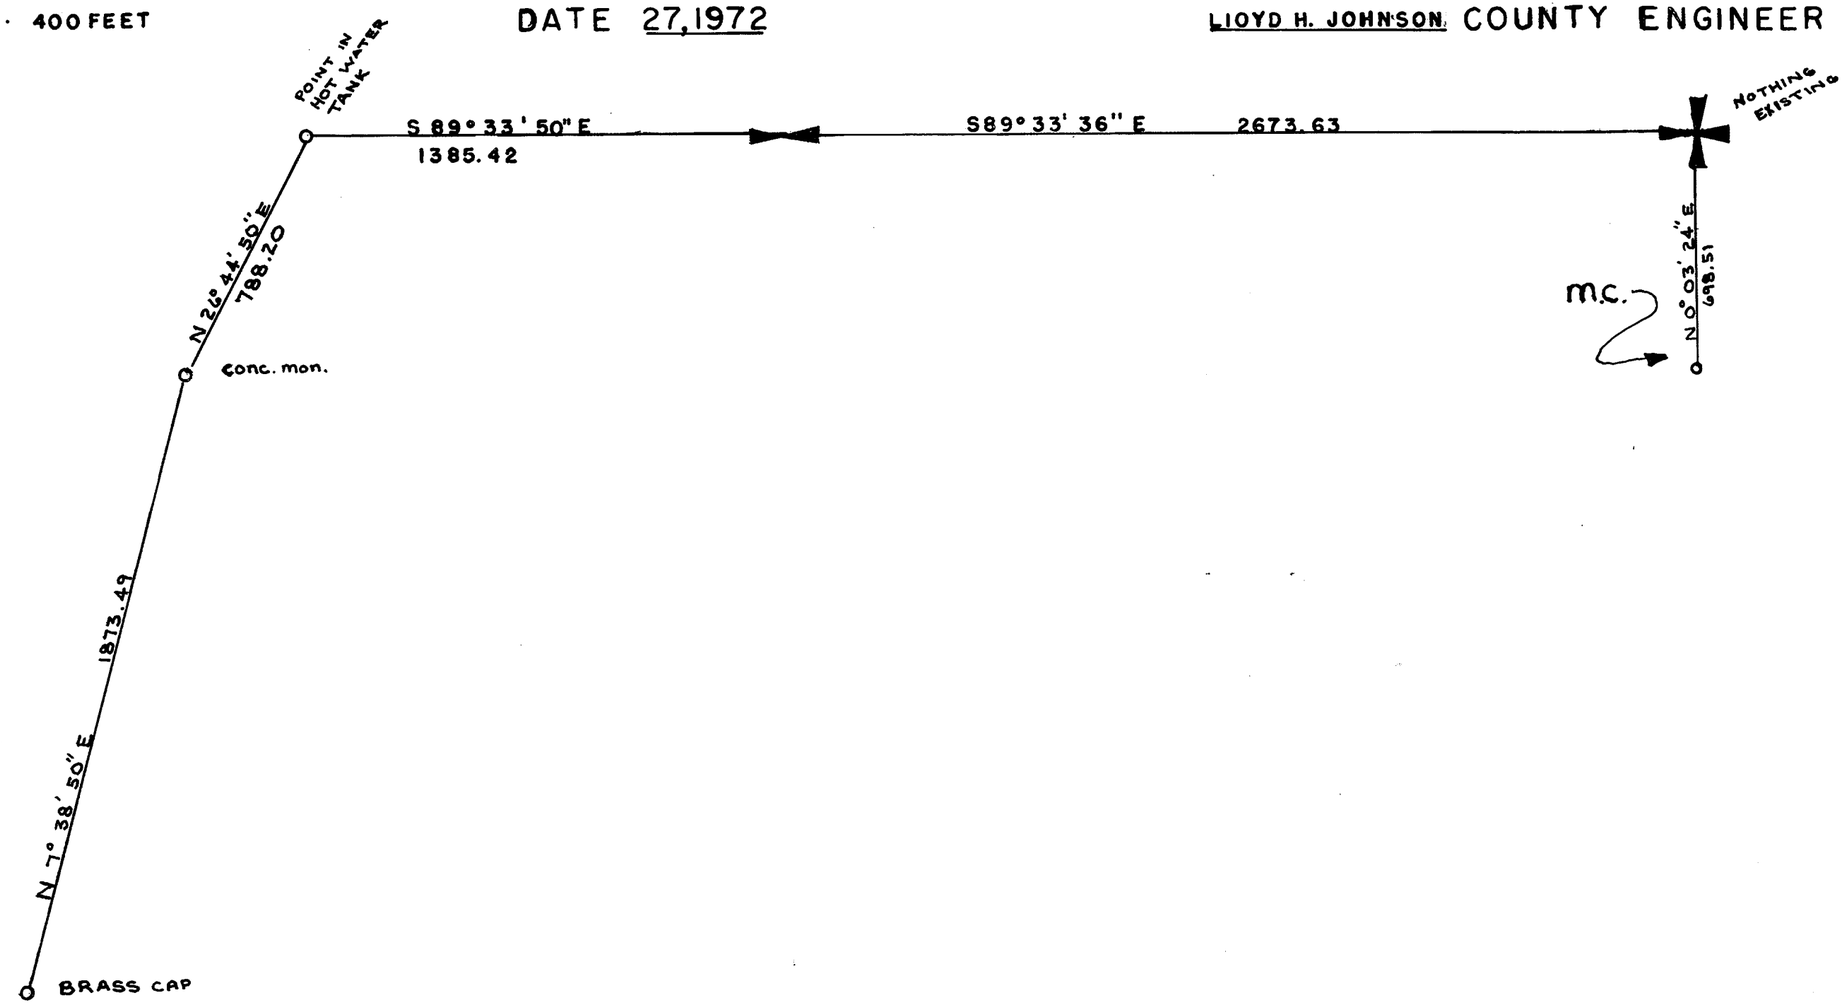

⚠ Andrew Joe Waterfront Tracks
Vol. 8 P-3


SECTION 2

TOWNSHIP 33 NORTH, RANGE 2 EAST, W. M.

SKAGIT COUNTY, WASH.

SCALE, 1 INCH--400 FEET

DATE APRIL 5, 1972 Lloyd H. Johnson COUNTY ENGINEER

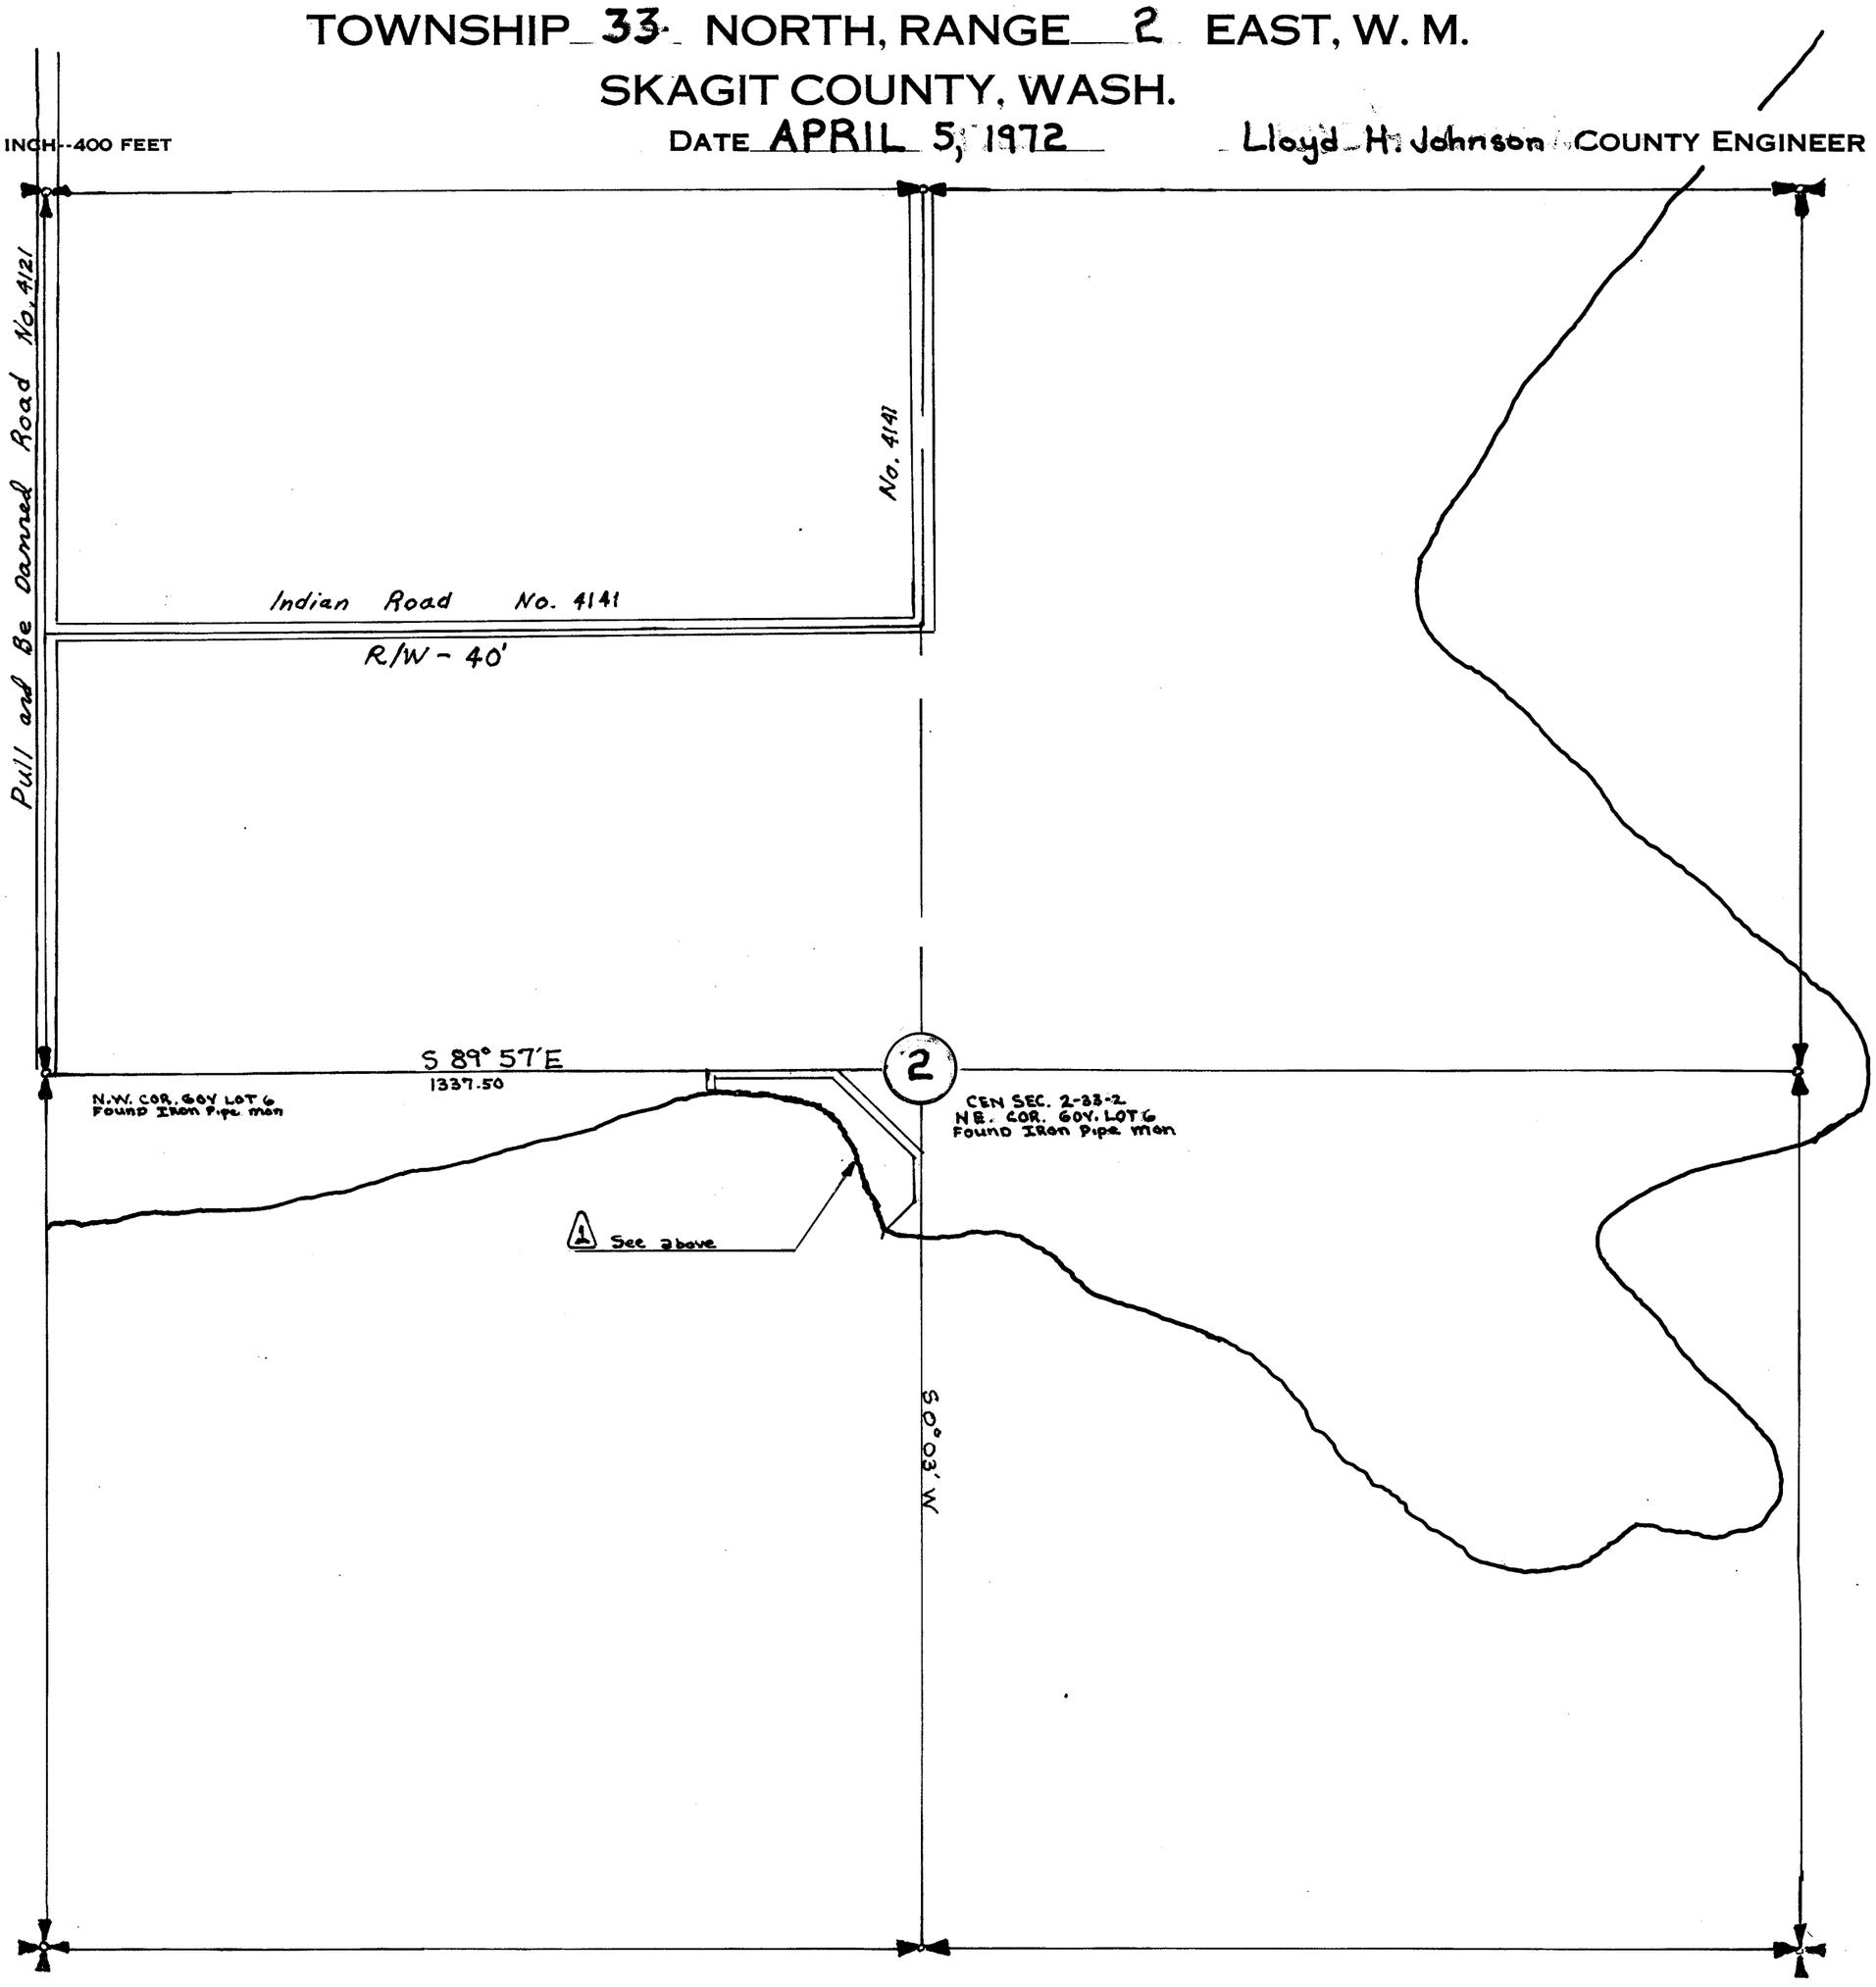

SECTION 2


TOWNSHIP 33 NORTH, RANGE 2 EAST, W. M.

SKAGIT COUNTY, WASH.

SCALE, 1 INCH -- 400 FEET

DATE AUGUST 7, 1967

LLOYD H. JOHNSON COUNTY ENGINEER

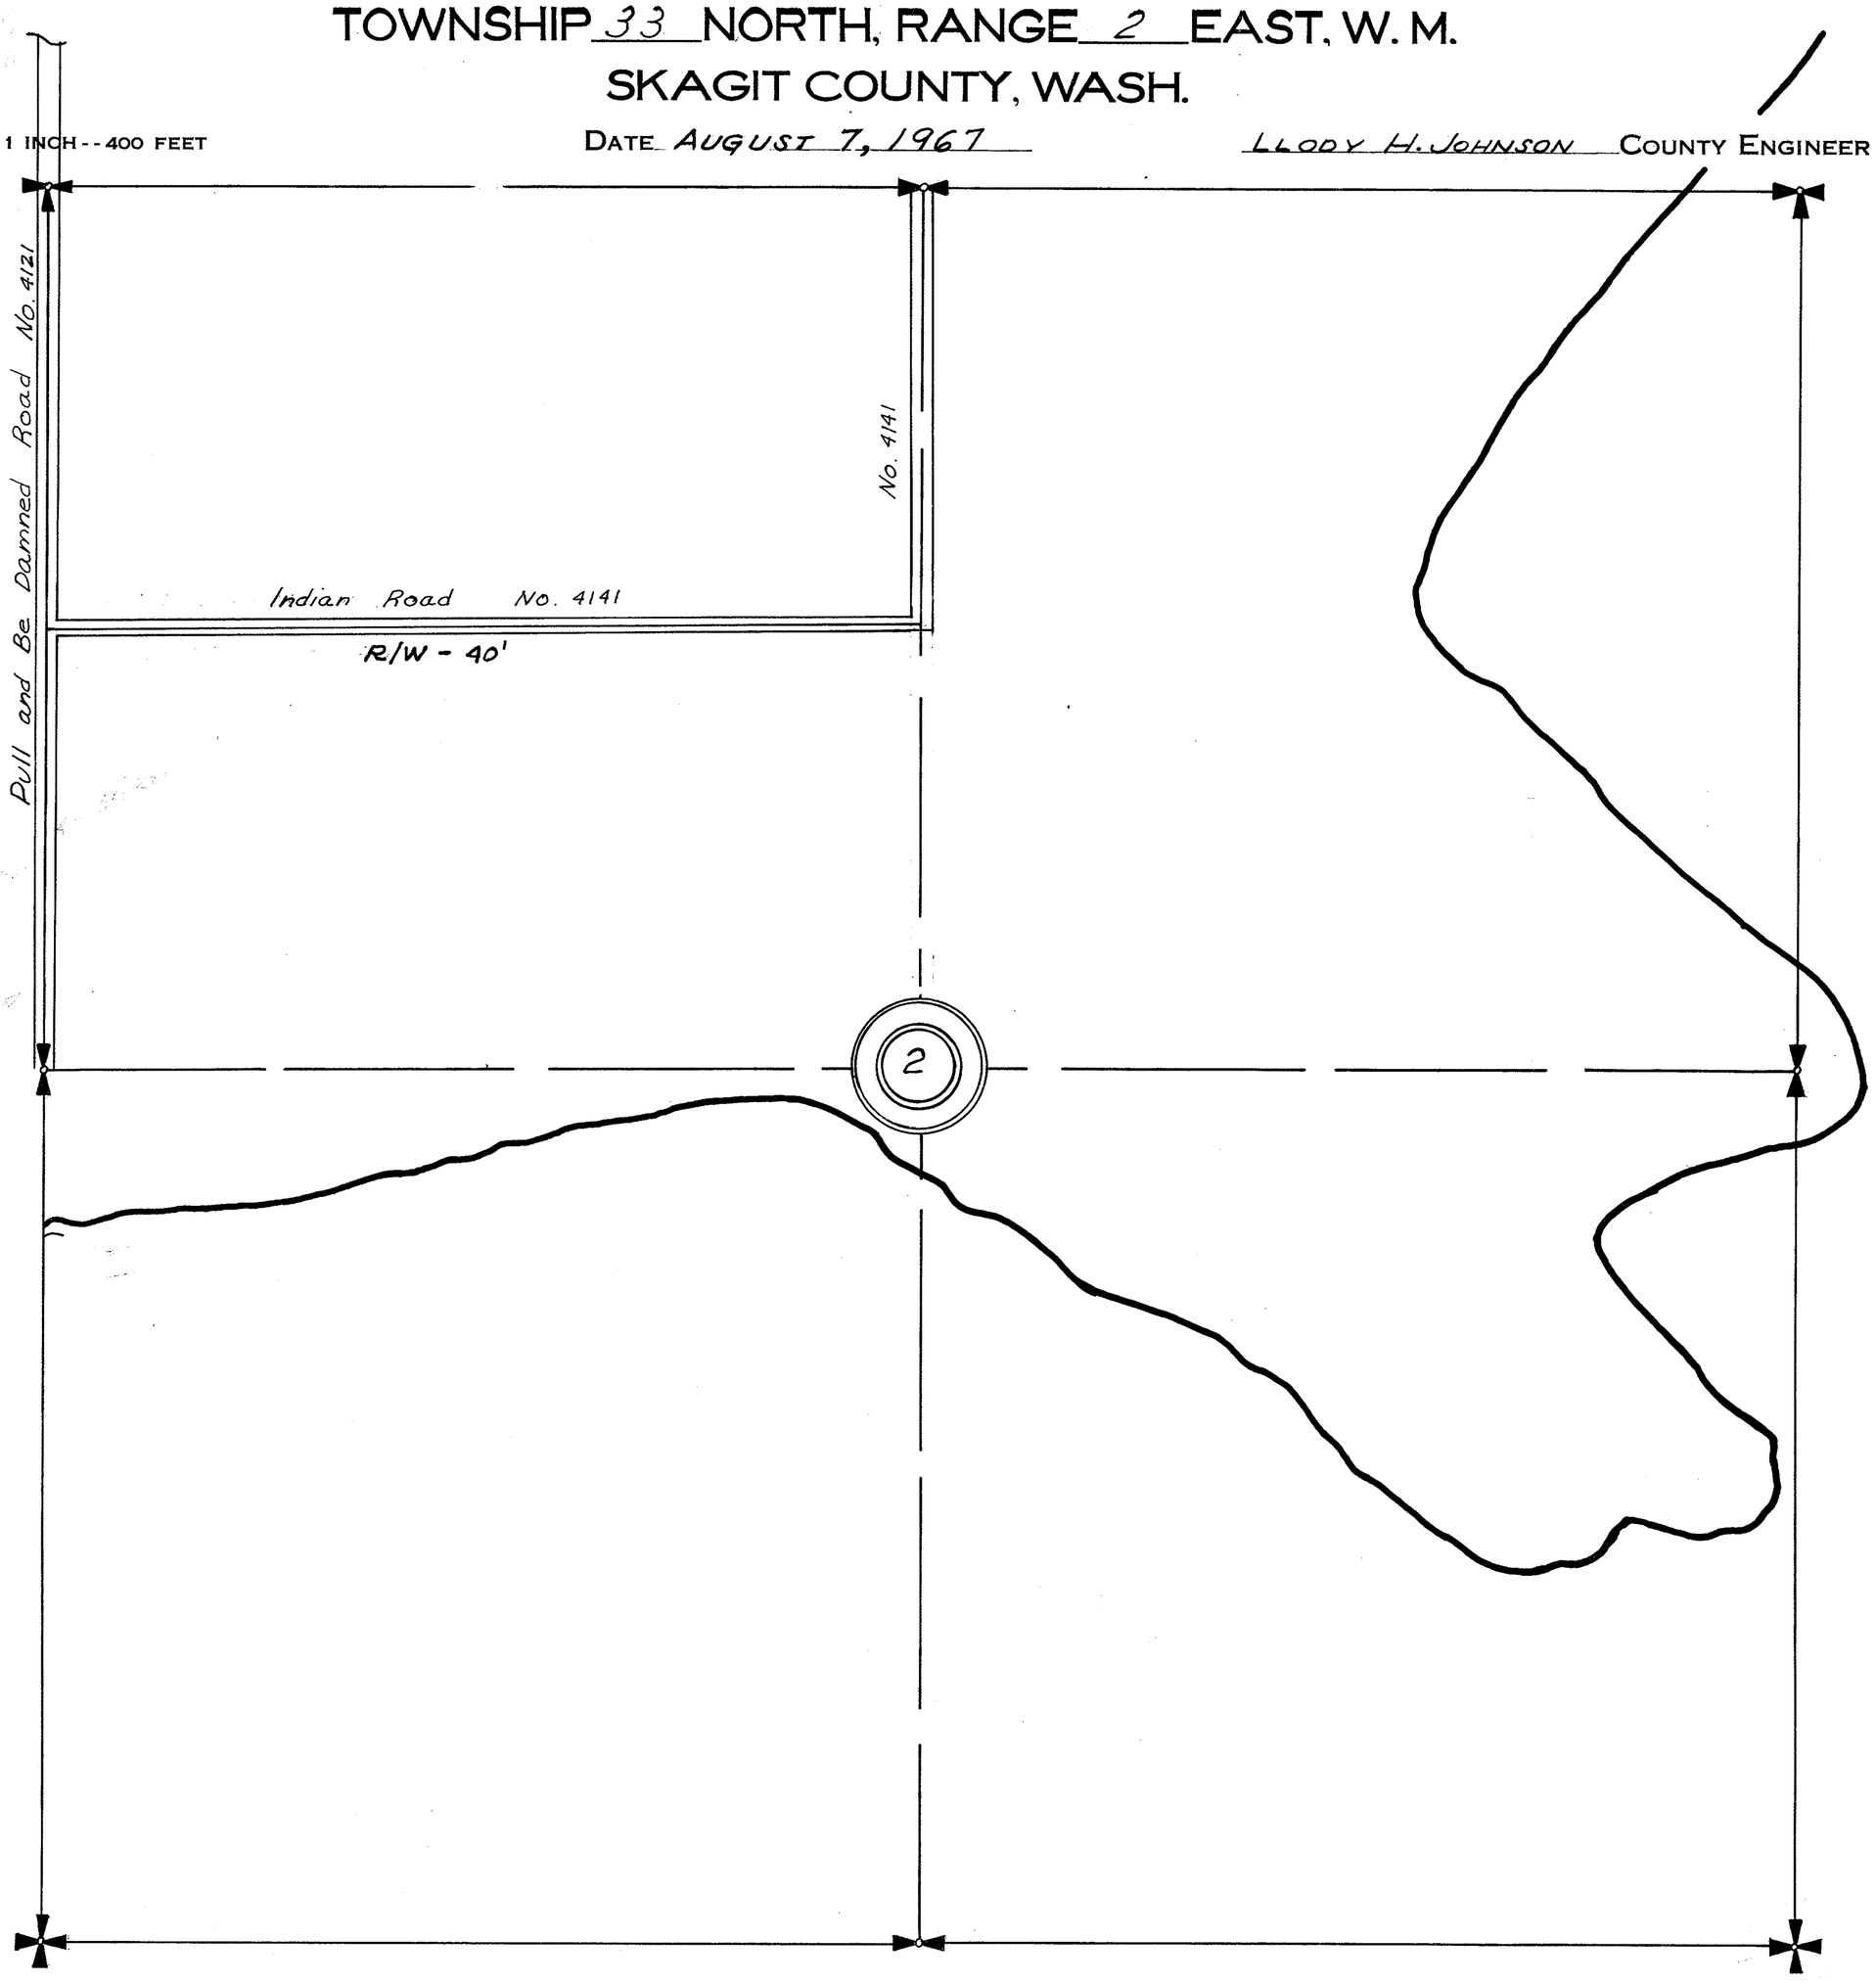

SECTION 1


TOWNSHIP 33 NORTH, RANGE 3 EAST, W. M.

SKAGIT COUNTY, WASH.

SCALE, 1 INCH--400 FEET

DATE Aug 21, 1963

COUNTY ENGINEER

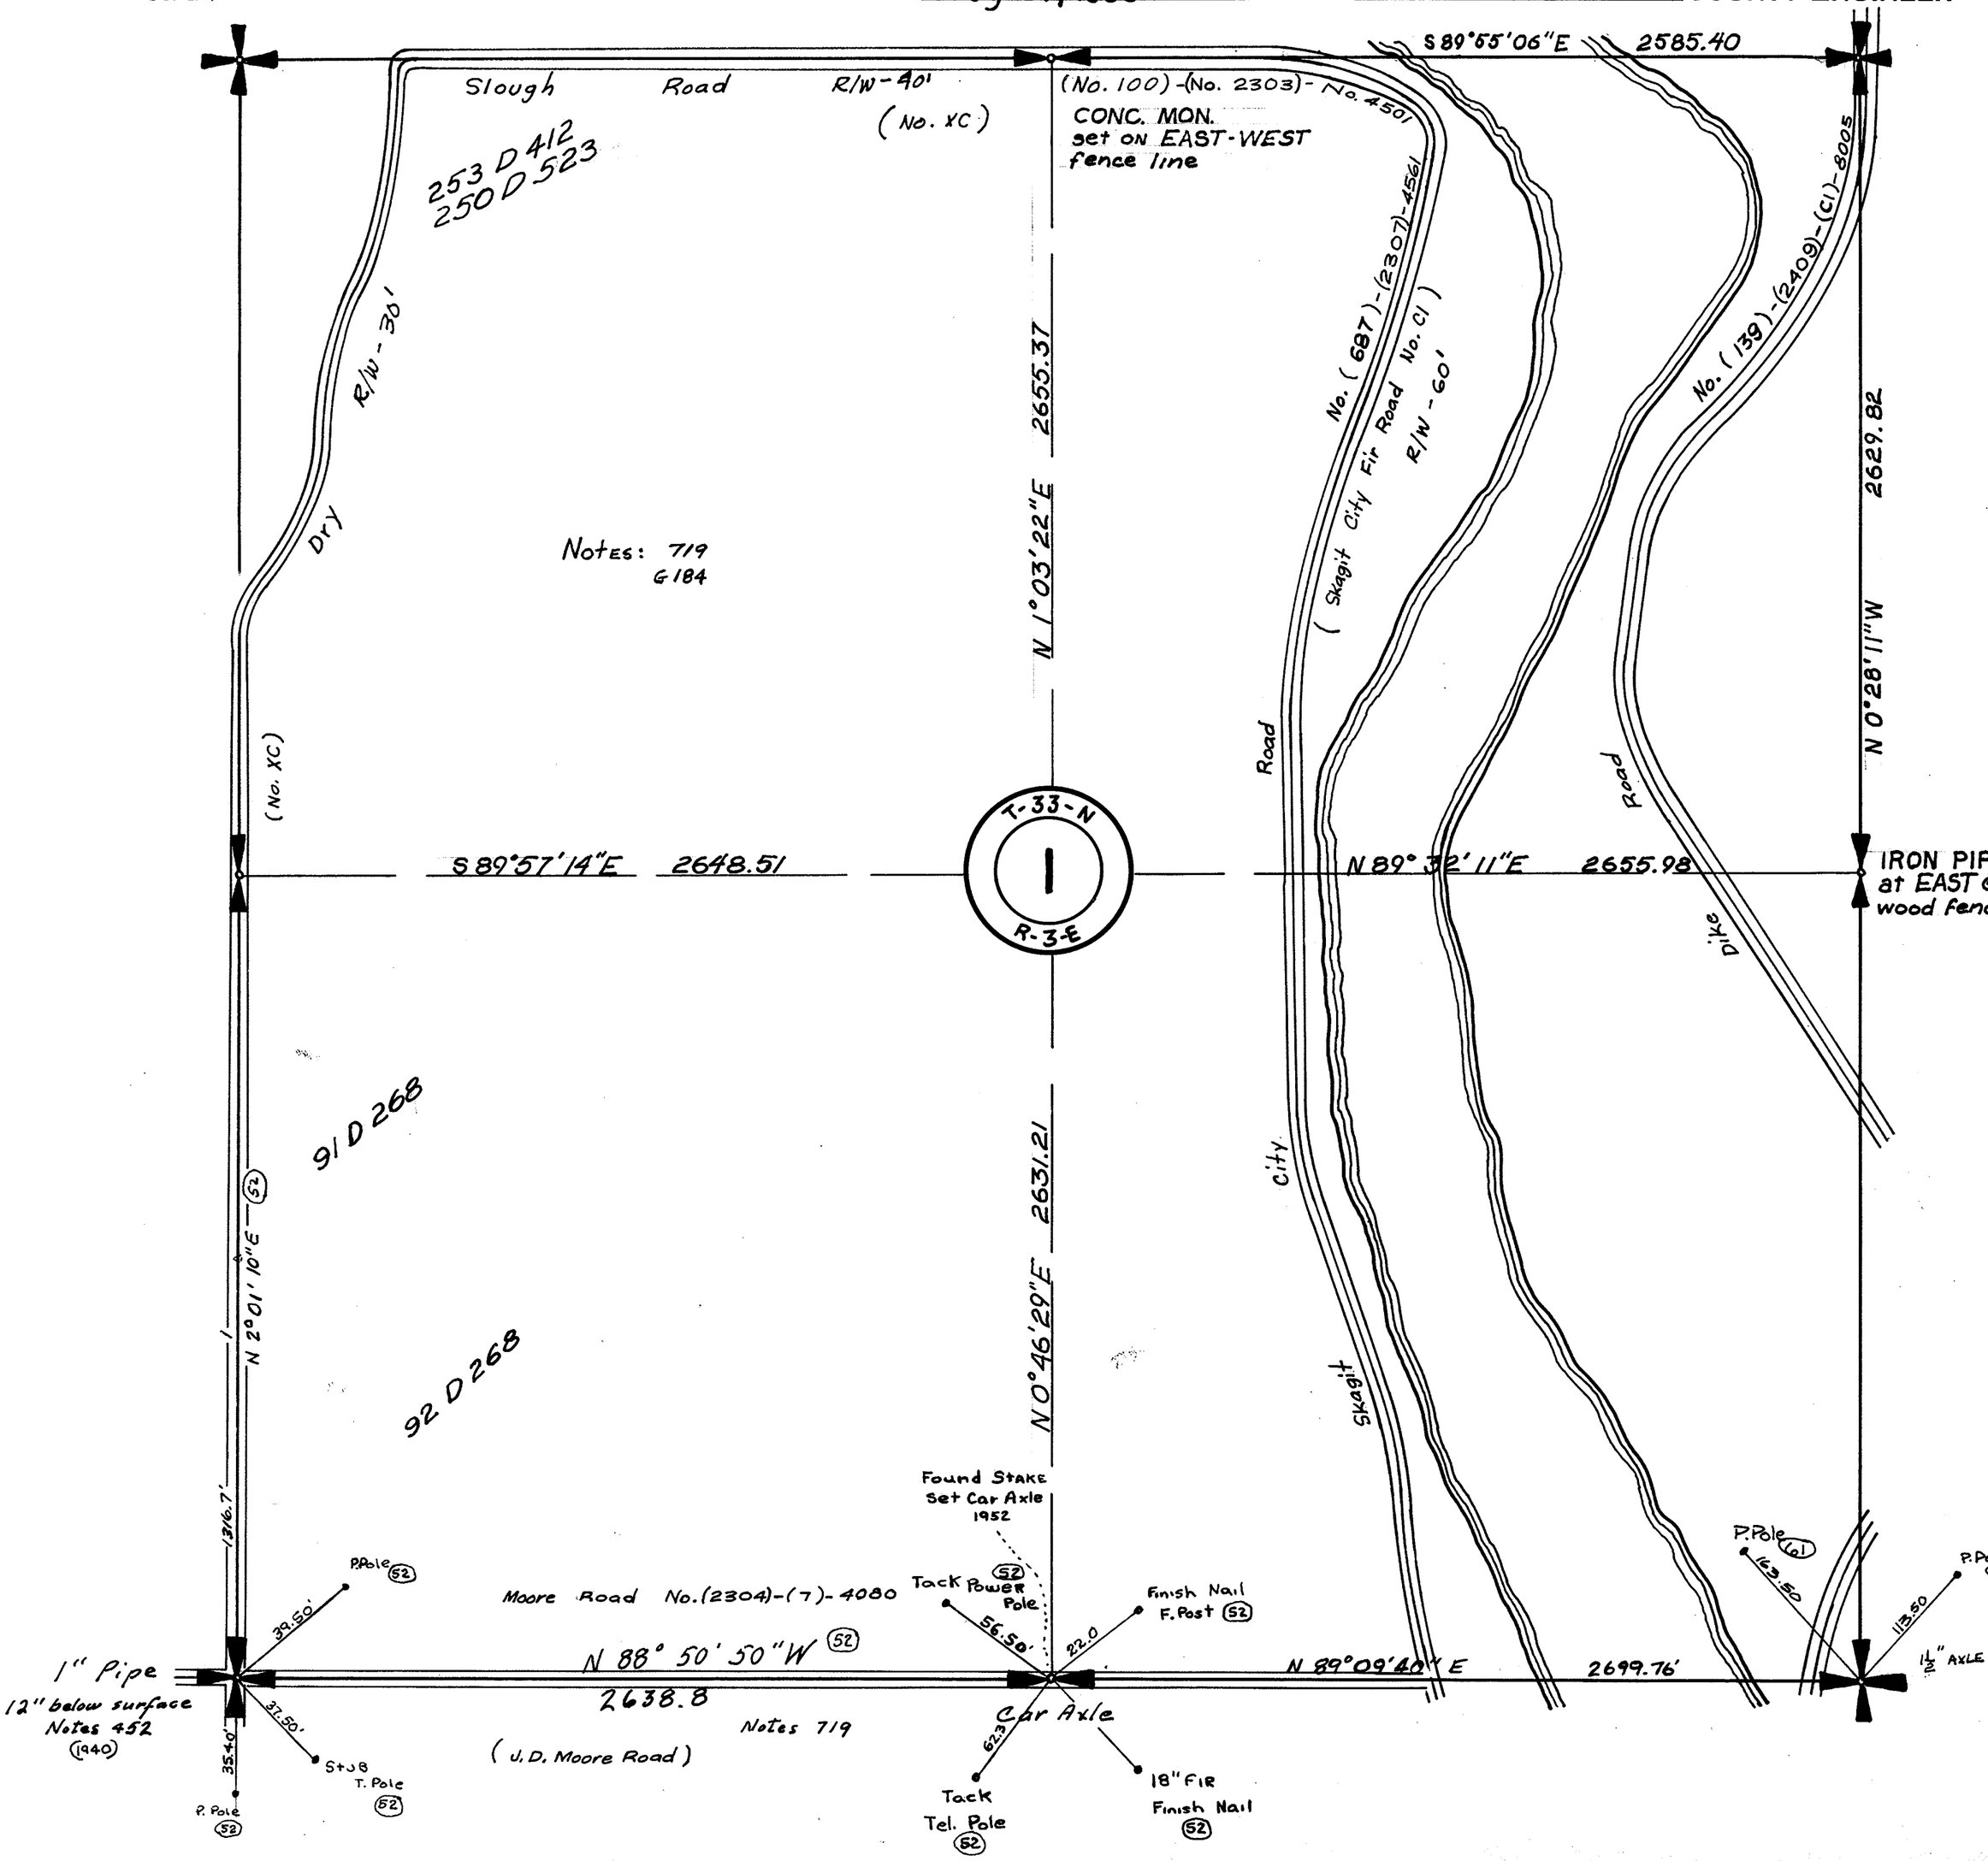


SUBDIVISION
RADER & LEONARD

SECTION 1
TOWNSHIP 33 NORTH, RANGE 3 EAST, W.M.
SKAGIT COUNTY, WASH.

SCALE 1 INCH ··· 400'

DATE 26, 1972

LLOYD H JOHNSON COUNTY ENGINEER

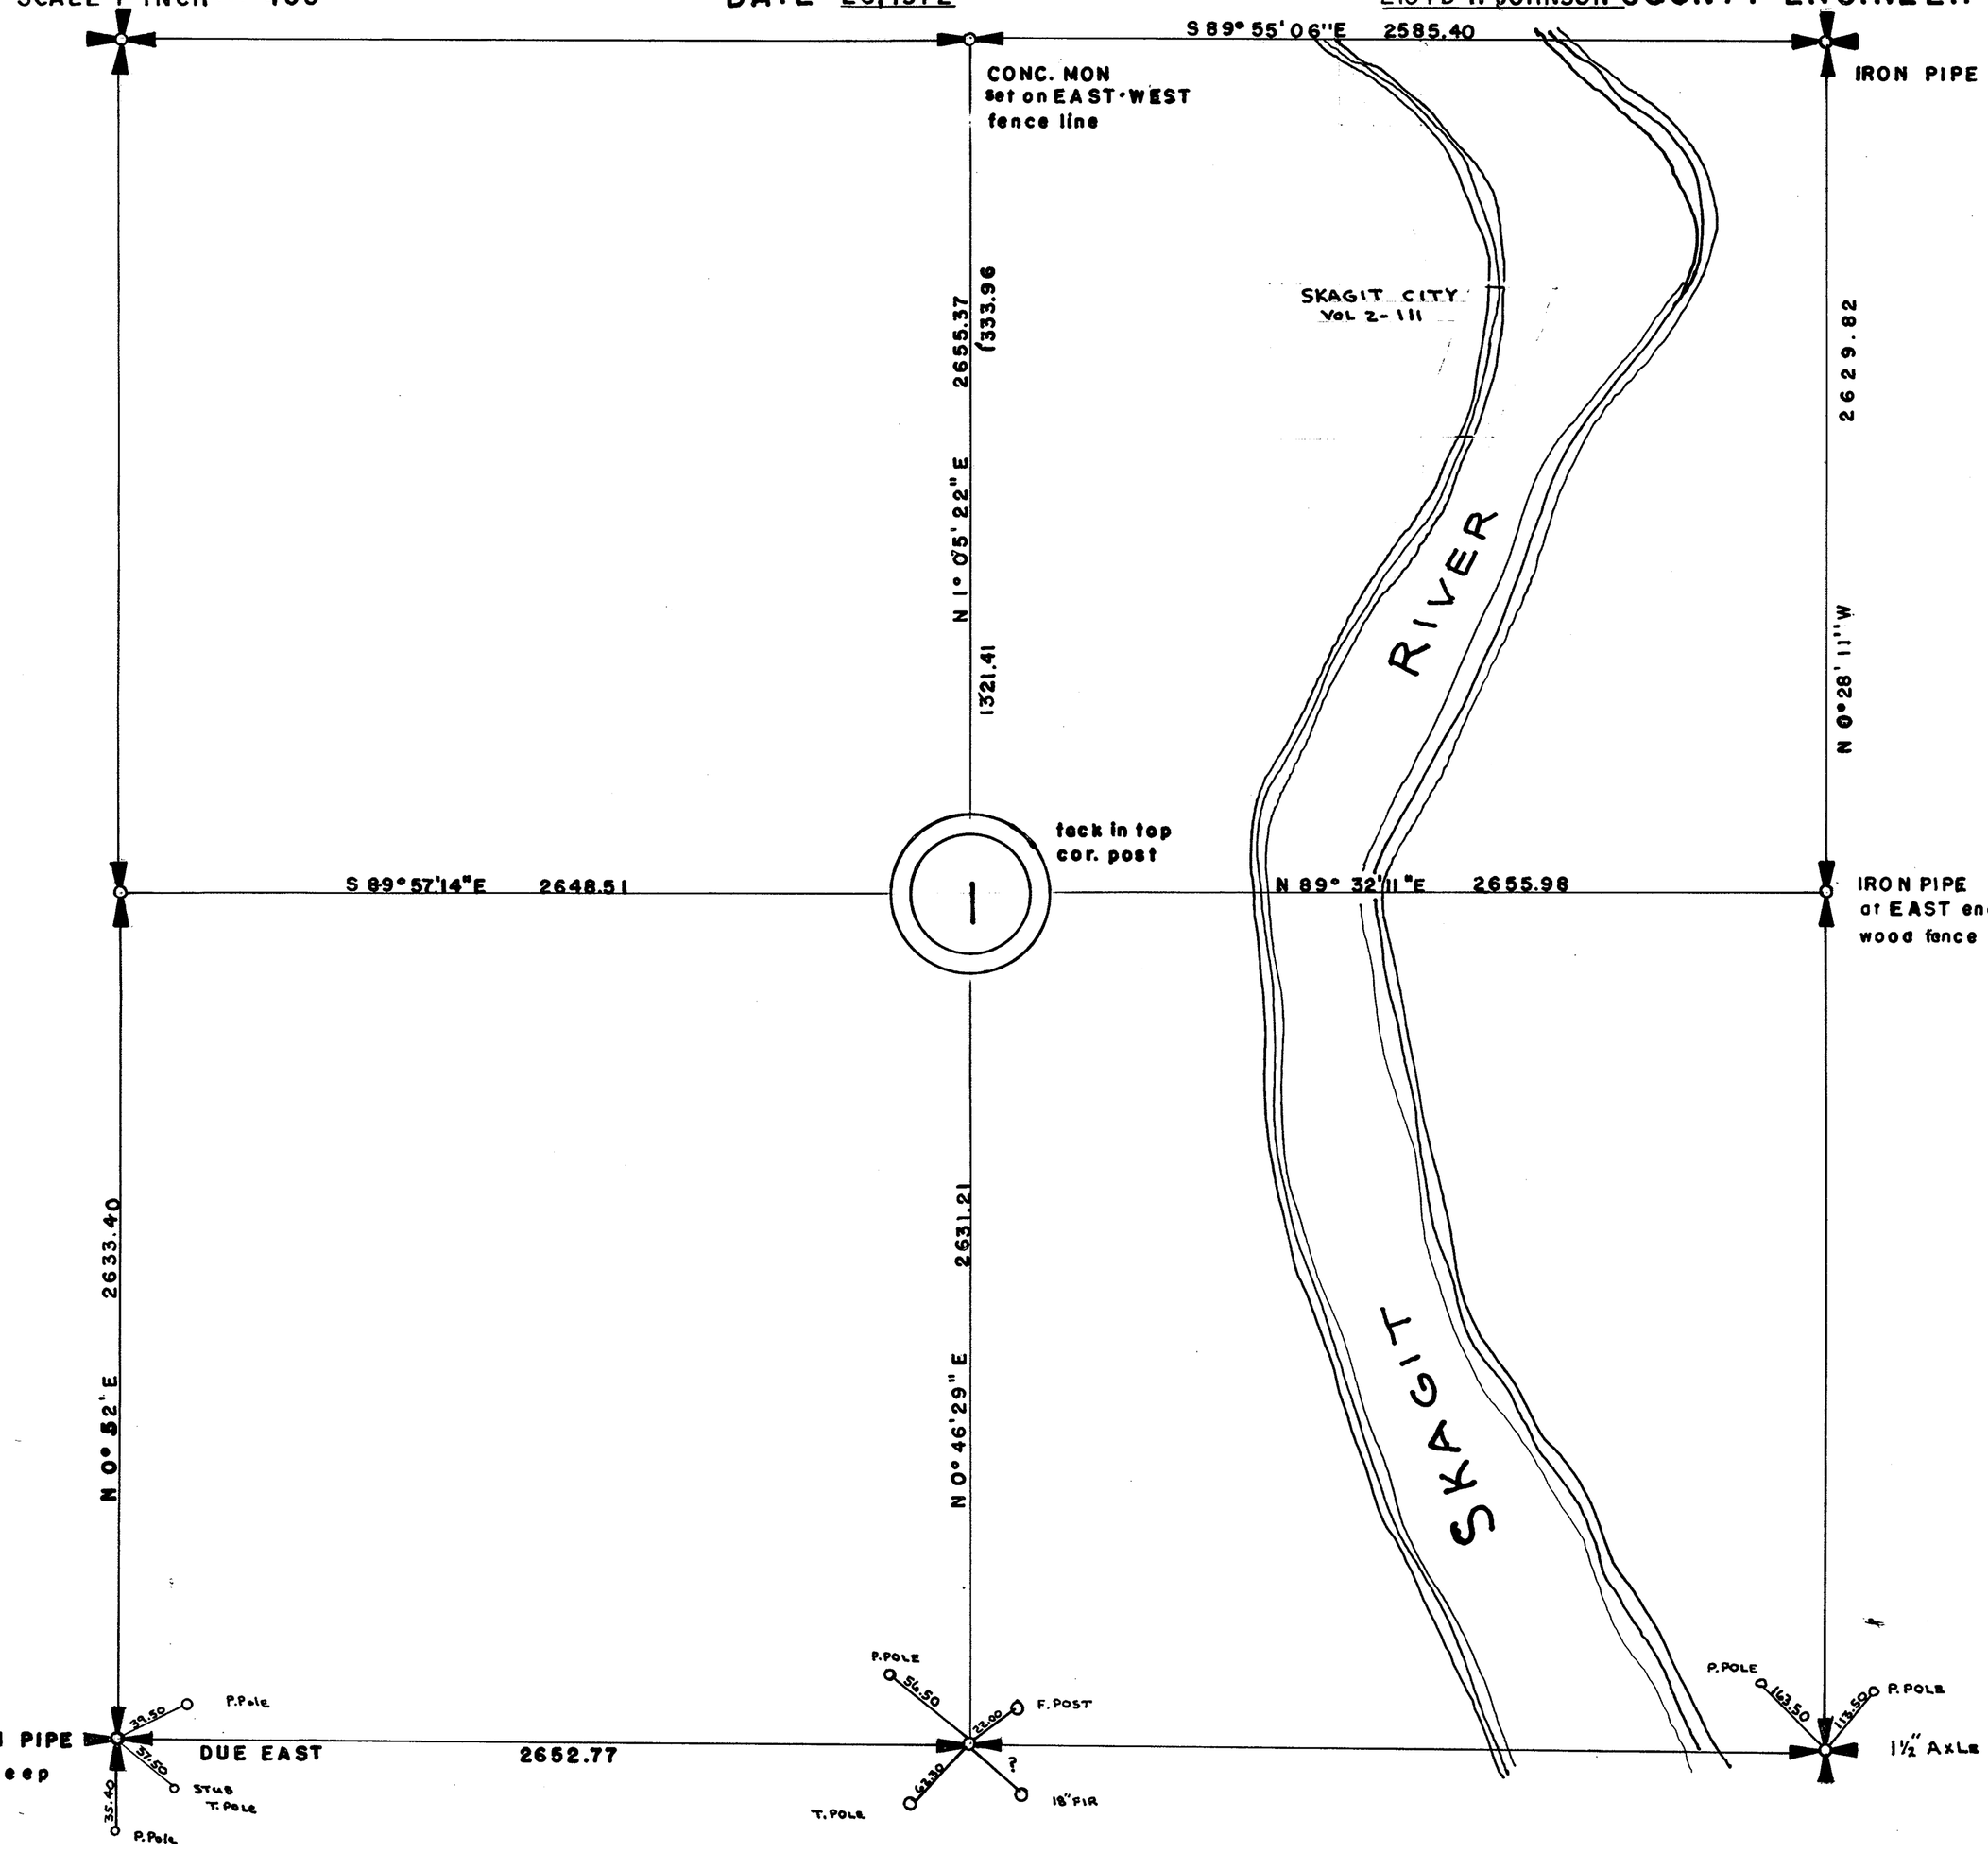

SECTION 2


TOWNSHIP 33 NORTH, RANGE 3 EAST, W. M.

SKAGIT COUNTY, WASH.

SCALE, 1 INCH--400 FEET

DATE June 25, 1963


COUNTY ENGINEER

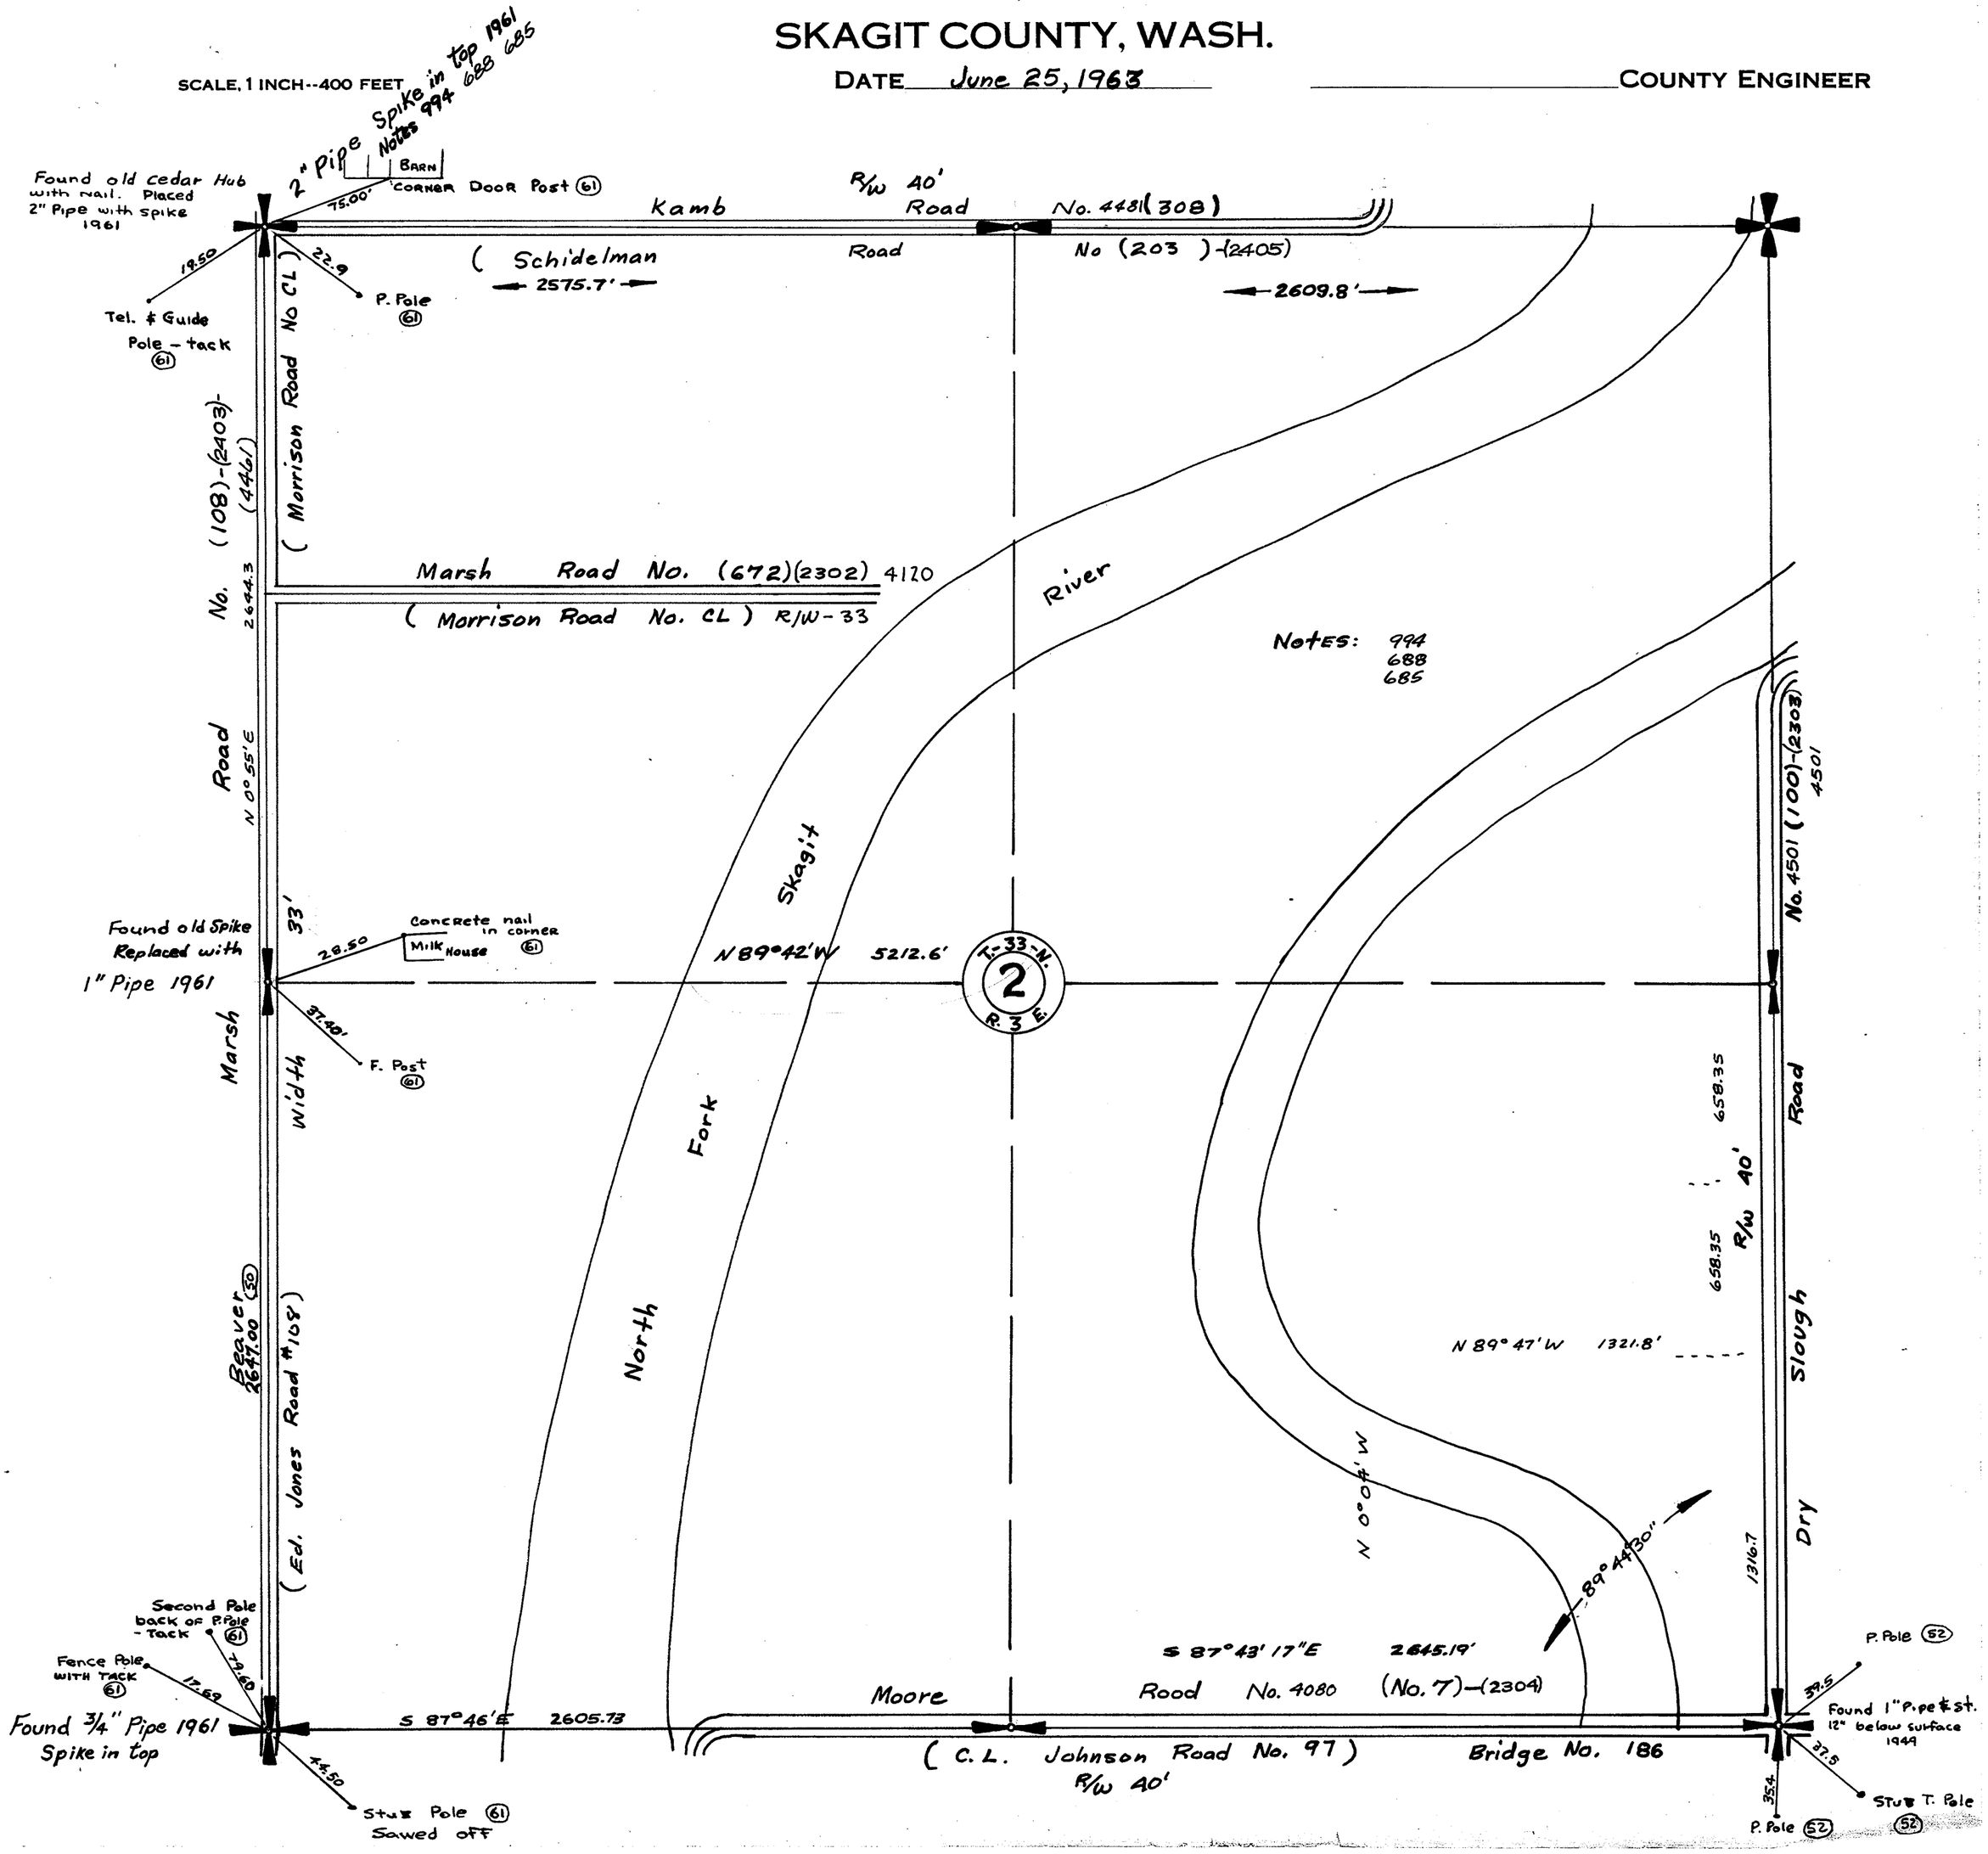

SECTION 3
TOWNSHIP 33 NORTH, RANGE 3 EAST, W. M.
SKAGIT COUNTY, WASH.

SCALE, 1 INCH--400 FEET

G. D. LeGro
August 1958
COUNTY ENGINEER

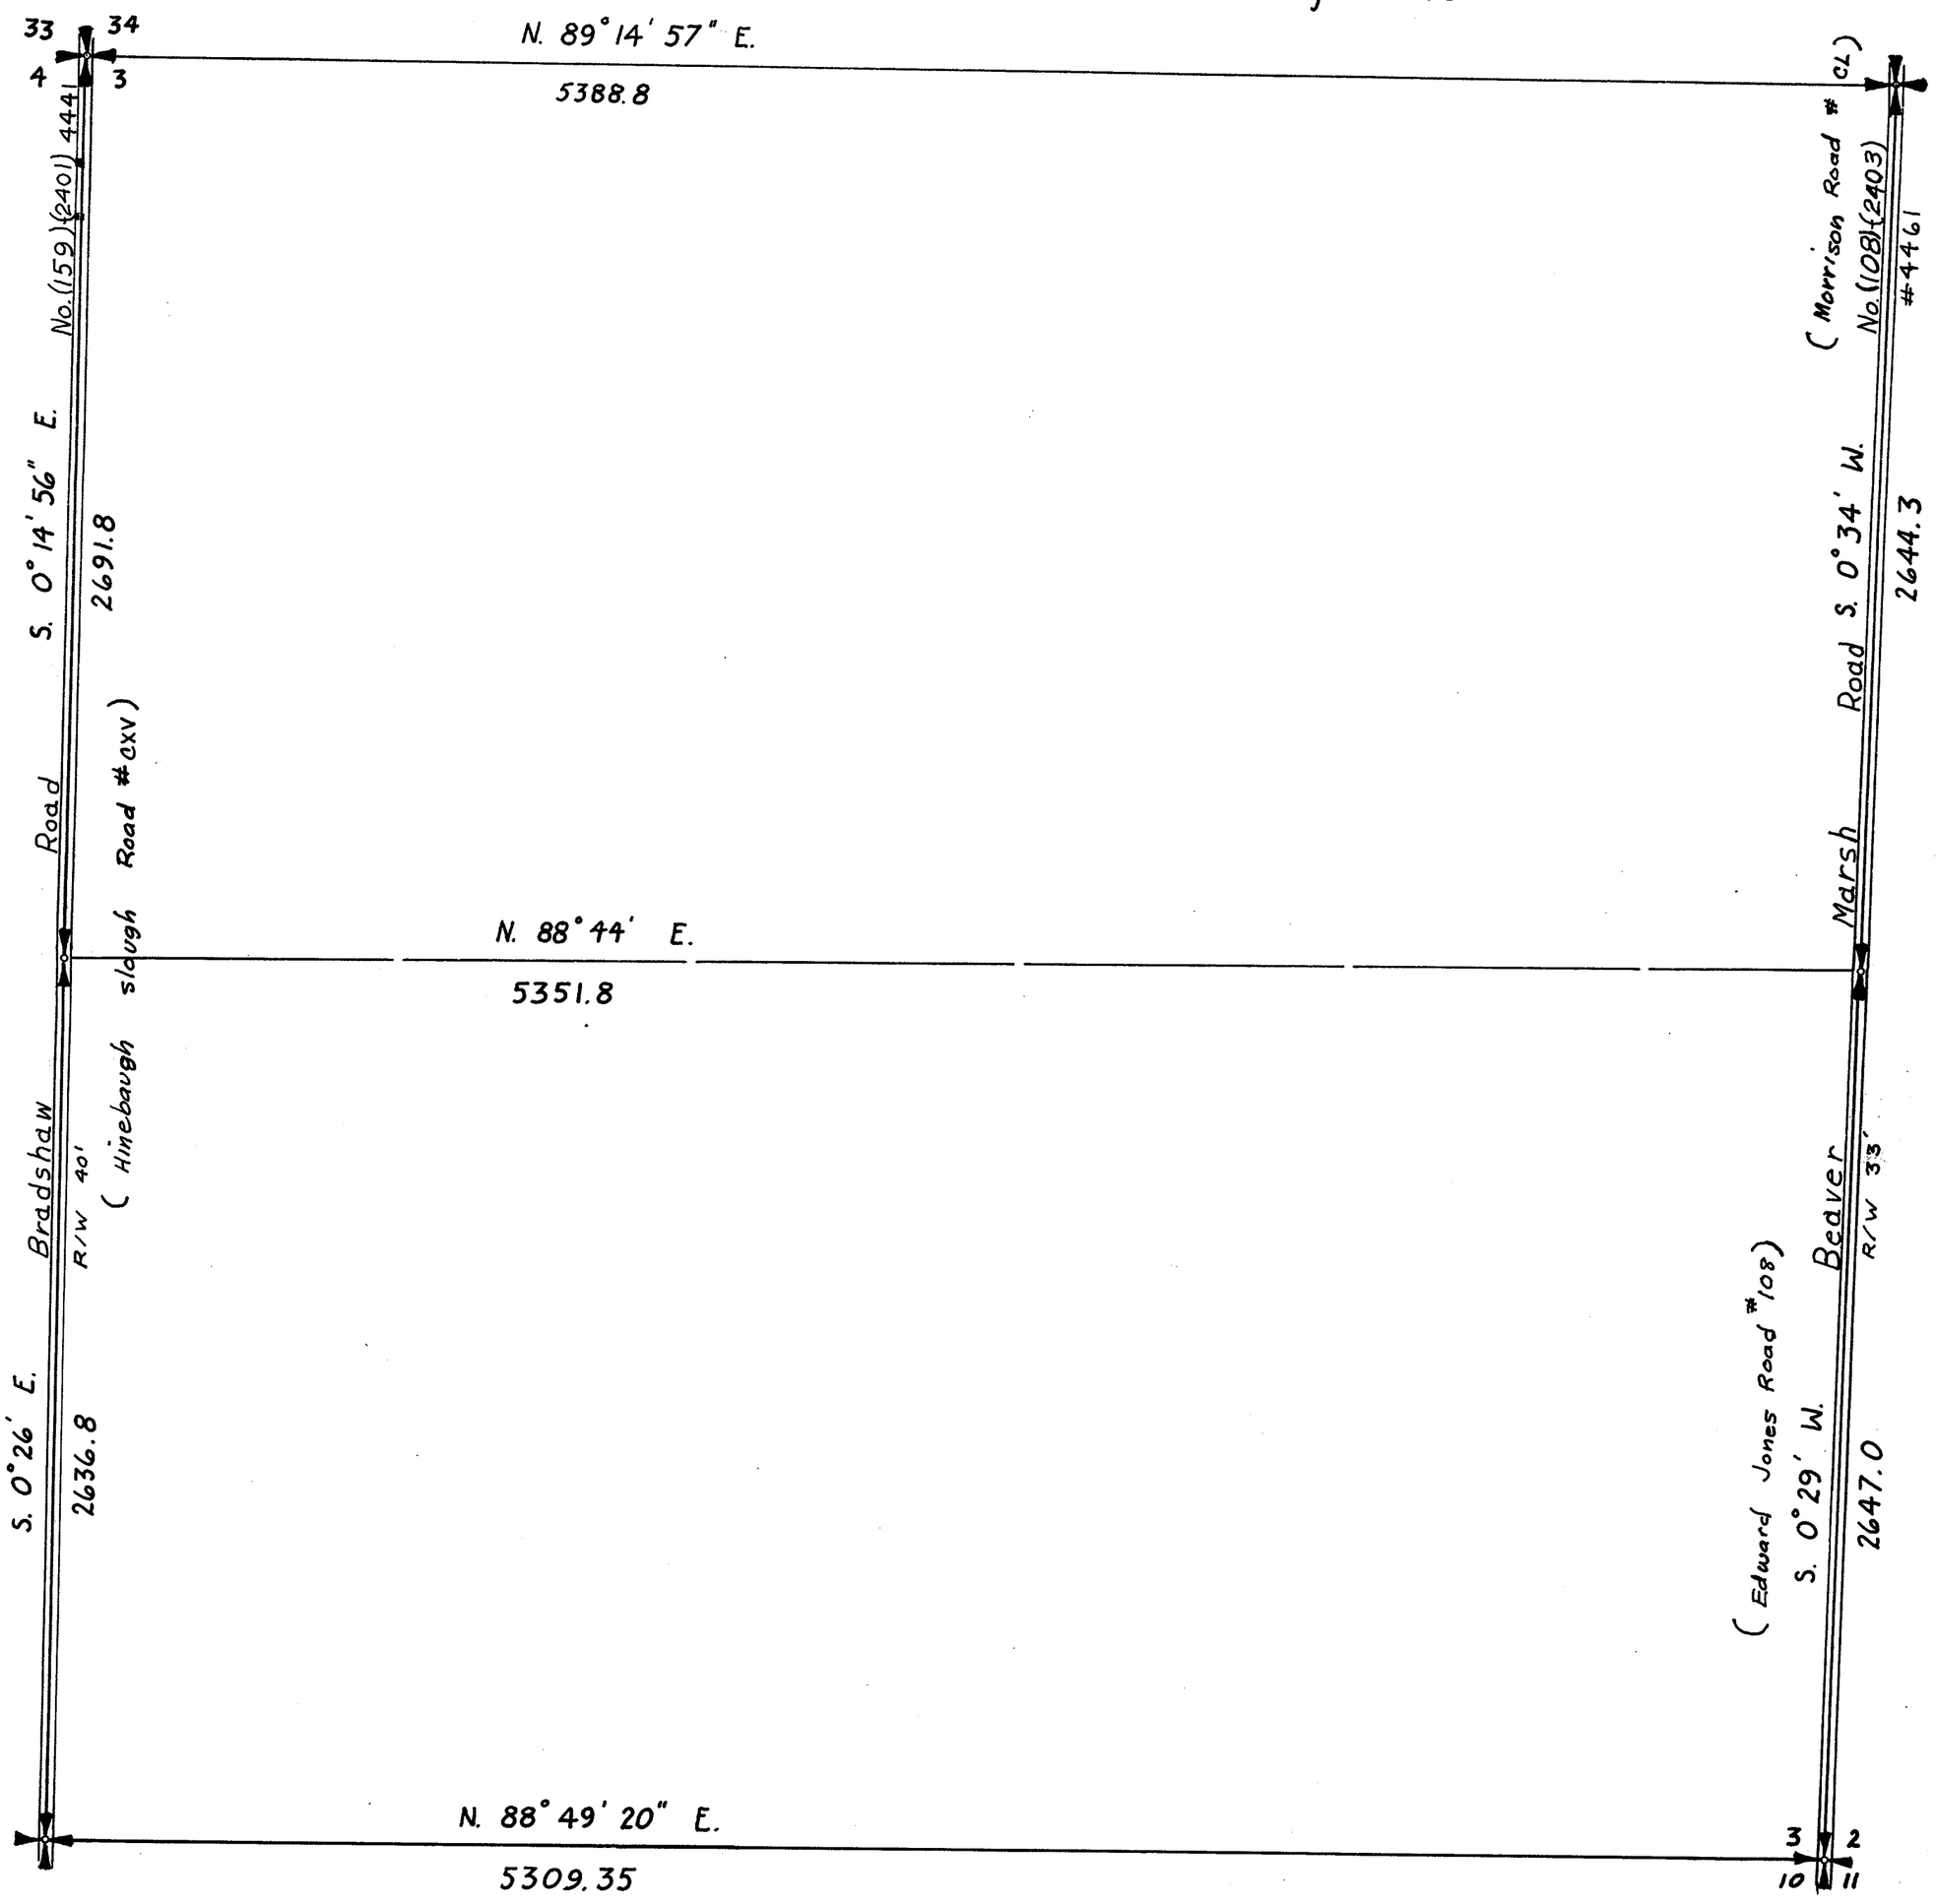

SECTION 4

TOWNSHIP 33 NORTH, RANGE 3 EAST, W. M.

SKAGIT COUNTY, WASH.

SCALE, 1 INCH--400 FEET

H.O. WALBERG, COUNTY ENGINEER

NOTES: 836, F-165

AUGUST, 1956

19,943.41 / 6,734.68 — 32 — 33 — 5 — 4 — 1" PIPE

N 89° 45' 30" W 2642.10

19,932.27 / 9,376.76

N 89° 45' 30" W 2642.10

T. 34N., R. 3E., W.M. 33 34

T. 33N., R. 3E., W.M. 4 3

19,921.12 / 12,018.83

Added 1963 July 1,

(North Fork Chilberg Road No. (1016) 4220 Road No. 593)

(CHILBERG ROAD (#XXXII) No. 66)

S 0° 20' 51" W 2690.25

R/W - 40'

No. (159) - (2401) - 4441

S 0° 29' 30" E 2688.88

(HINEBAUGH ROAD #CXV) N 0° 38' 30" E 2691.90 Road

4" CEDAR STAKE

17,254.63 / 6,757.75

S 89° 43' 25" E 2602.66

17,242.07 / 9,360.38

S 89° 43' 25" E 2628.33

17,229.39 / 11,988.68

FREDERIC BALDWIN

JOE NIDEROST — Vol 286 Page 644

77+00

C. S. PHILLIPS

VERNIA A. PHILLIPS

Vol 286 Page 563 — KALLSTROM'S VIEW — MOORE PLAT — VOL 8-8

C. S. PHILLIPS

S 0° 45' 08" W 2606.71

S 0° 20' 67" W 2616.80

Bradshaw Road

86+72 L2 — 159.56'

S 89° 36' 43" E 2611.84

86+97 L2 P.C.

Vol 207 Page 10

Vol 288 page 139

Vol 288 Page 140

HENRY TJERSLAND

LENA TJERSLAND

Rexville Grange Road No. (534) — R/W - 33 — Chilberg Road — No. 66 — No. 4431 (No. 2301)

91+34.22 P.I.

D = 2°
Δ = 17° 22' 30" LT.
T = 437.74'
L = 868.75'
R = 2865'
E = 33.25

FRANK OLBRICHT

95+65.93 P.T.

36.3'

100+02.85

N 0° 36' 30" E 2635.80

Dodge Valley Road No. (1302) - 4100

40' R/W

1" ROD — 14,648.14 / 6,723.53 — 5 — 4 — 8 — 9 — (J. SCHARFENBERG RD. #41) — S 89° 30' 00" E 2621.00

14,625.32 / 9,344.43 — FORD AXLE

S 89° 18' 30" E 2616.46

4 — 3 — 9 — 10 — 1/4" PIPE — 14,593.74 / 11,960.70

33.5

18" FIR Found (66)

44.2

10" ALDER Found (66)

SECTION 4


TOWNSHIP 33 NORTH, RANGE 3 EAST, W. M.

SKAGIT COUNTY, WASH.

SCALE, 1 INCH -- 400 FEET

DATE 1930 || Copy 1968 ||

R. E. L. Knapp 1930 COUNTY ENGINEER

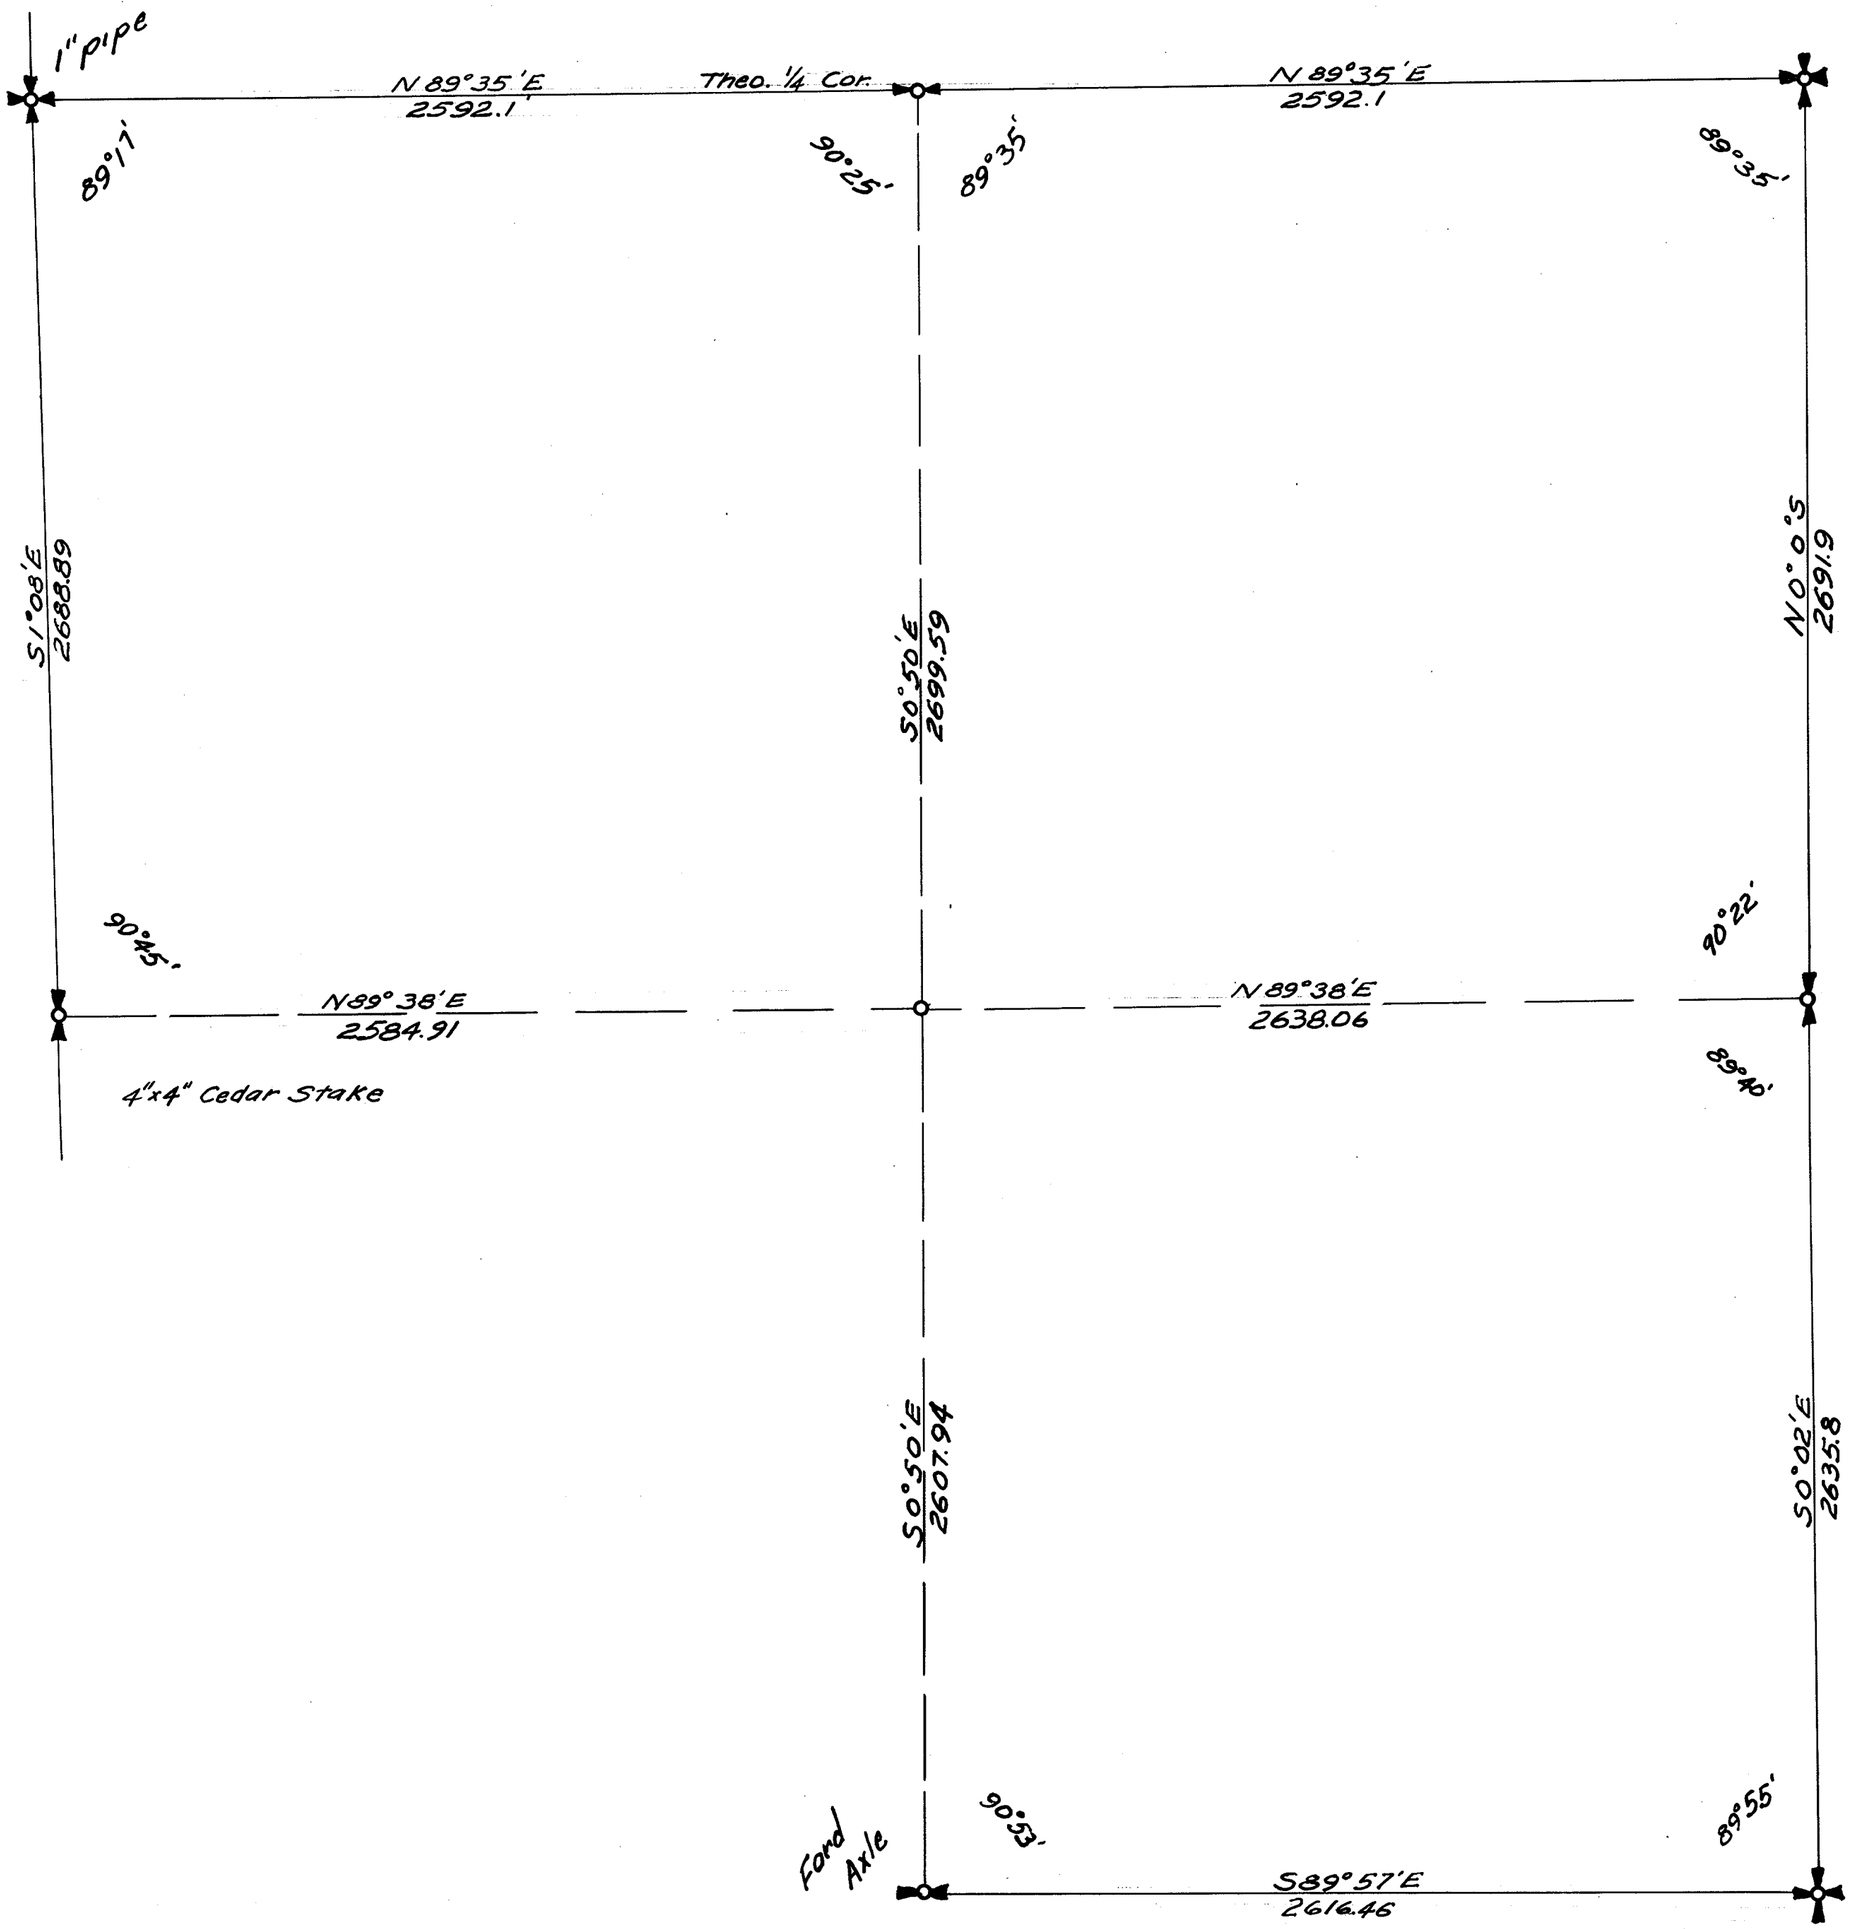



SECTION 5

TOWNSHIP 33 NORTH. RANGE 3 EAST. W. M.
SKAGIT COUNTY. WASH.

SCALE, 1 INCH--400 FEET

Robt. E. L. Knapp 1930 COUNTY ENGINEER

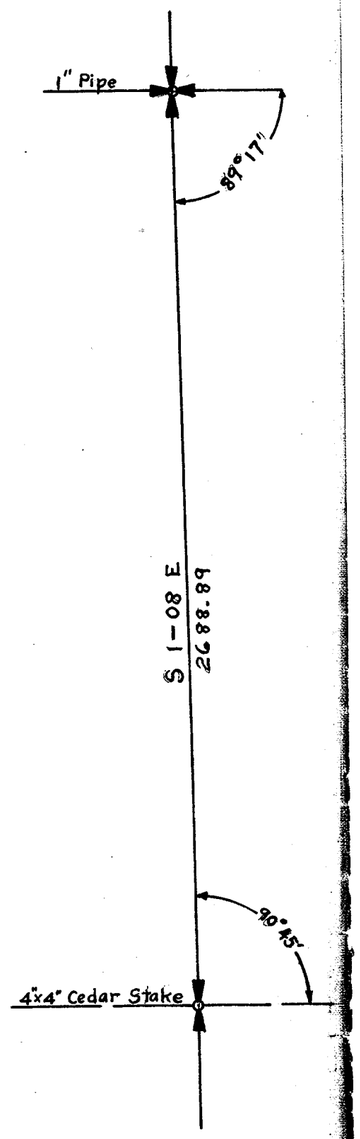

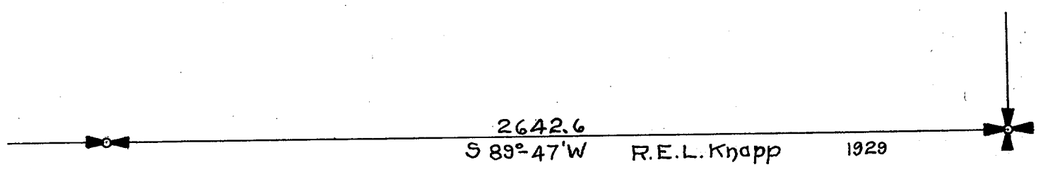

SECTION 5


TOWNSHIP 33 NORTH, RANGE 3 EAST, W. M.

SKAGIT COUNTY, WASH.

SCALE, 1 INCH--400 FEET

DATE Aug. 16, 1963

COUNTY ENGINEER

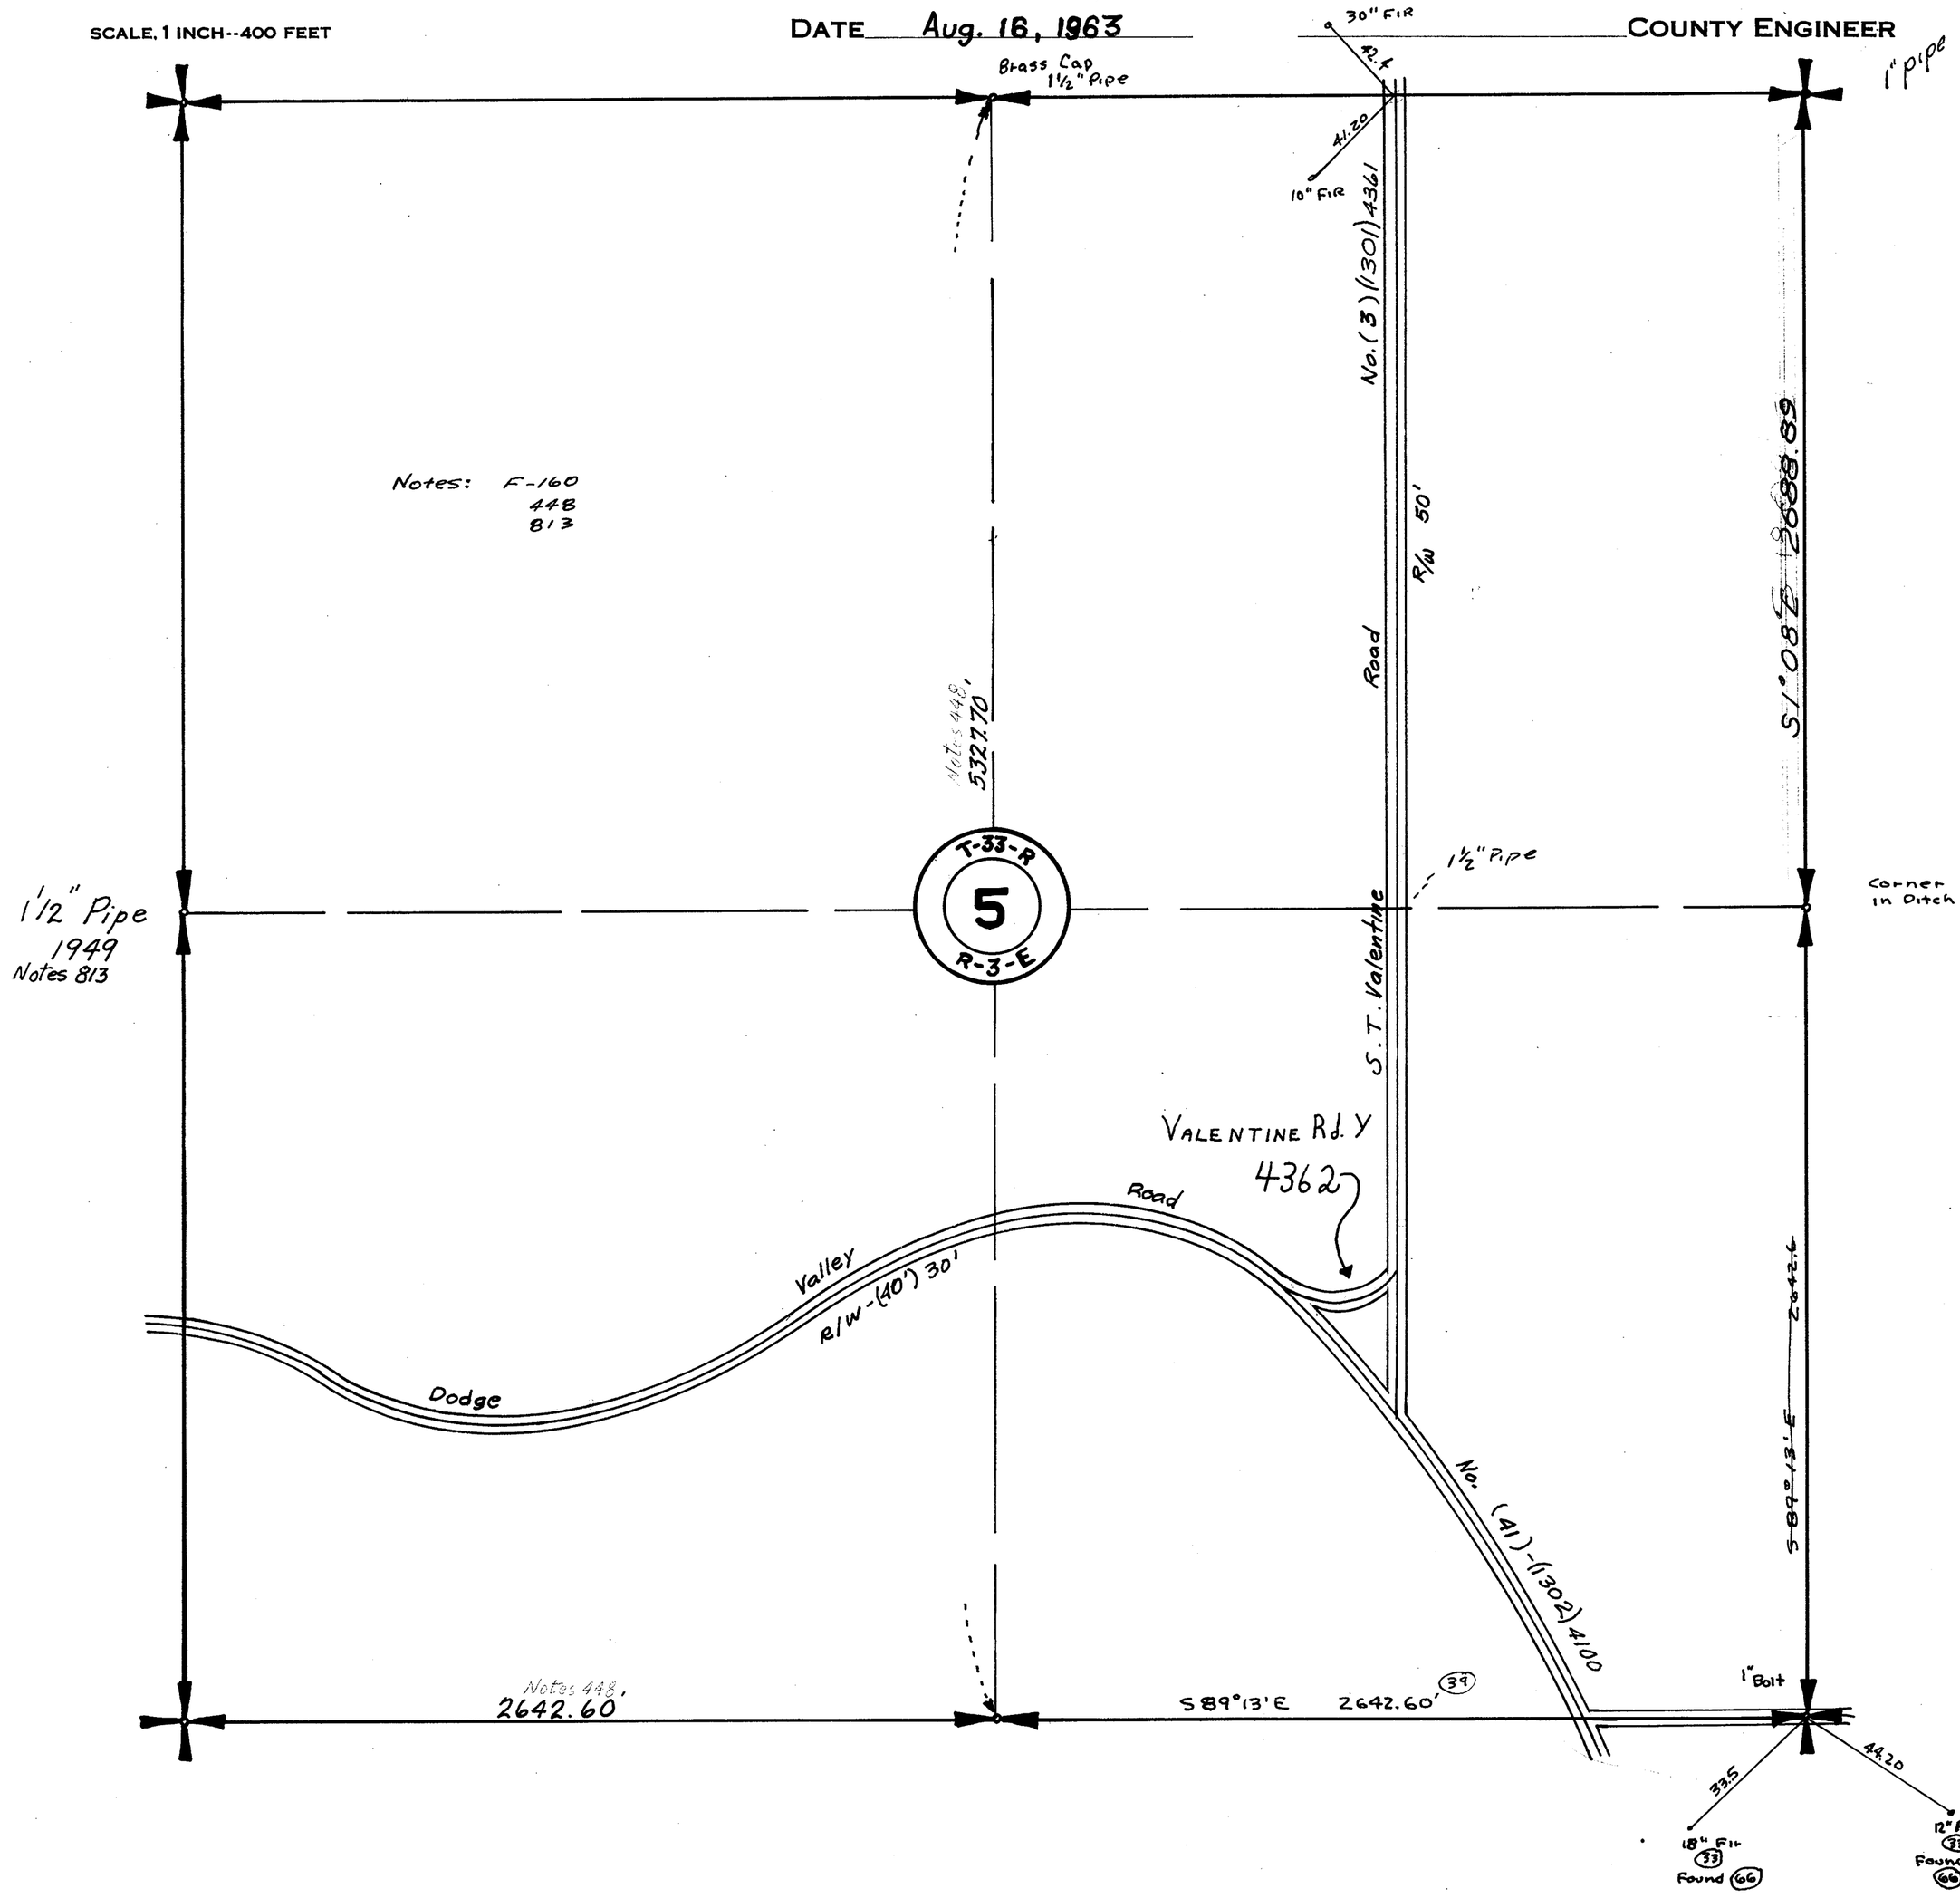

SECTION 6


TOWNSHIP 33 NORTH, RANGE 3 EAST, W. M.

SKAGIT COUNTY, WASH.

SCALE, 1 INCH--400 FEET

DATE Aug. 16, 1963

COUNTY ENGINEER

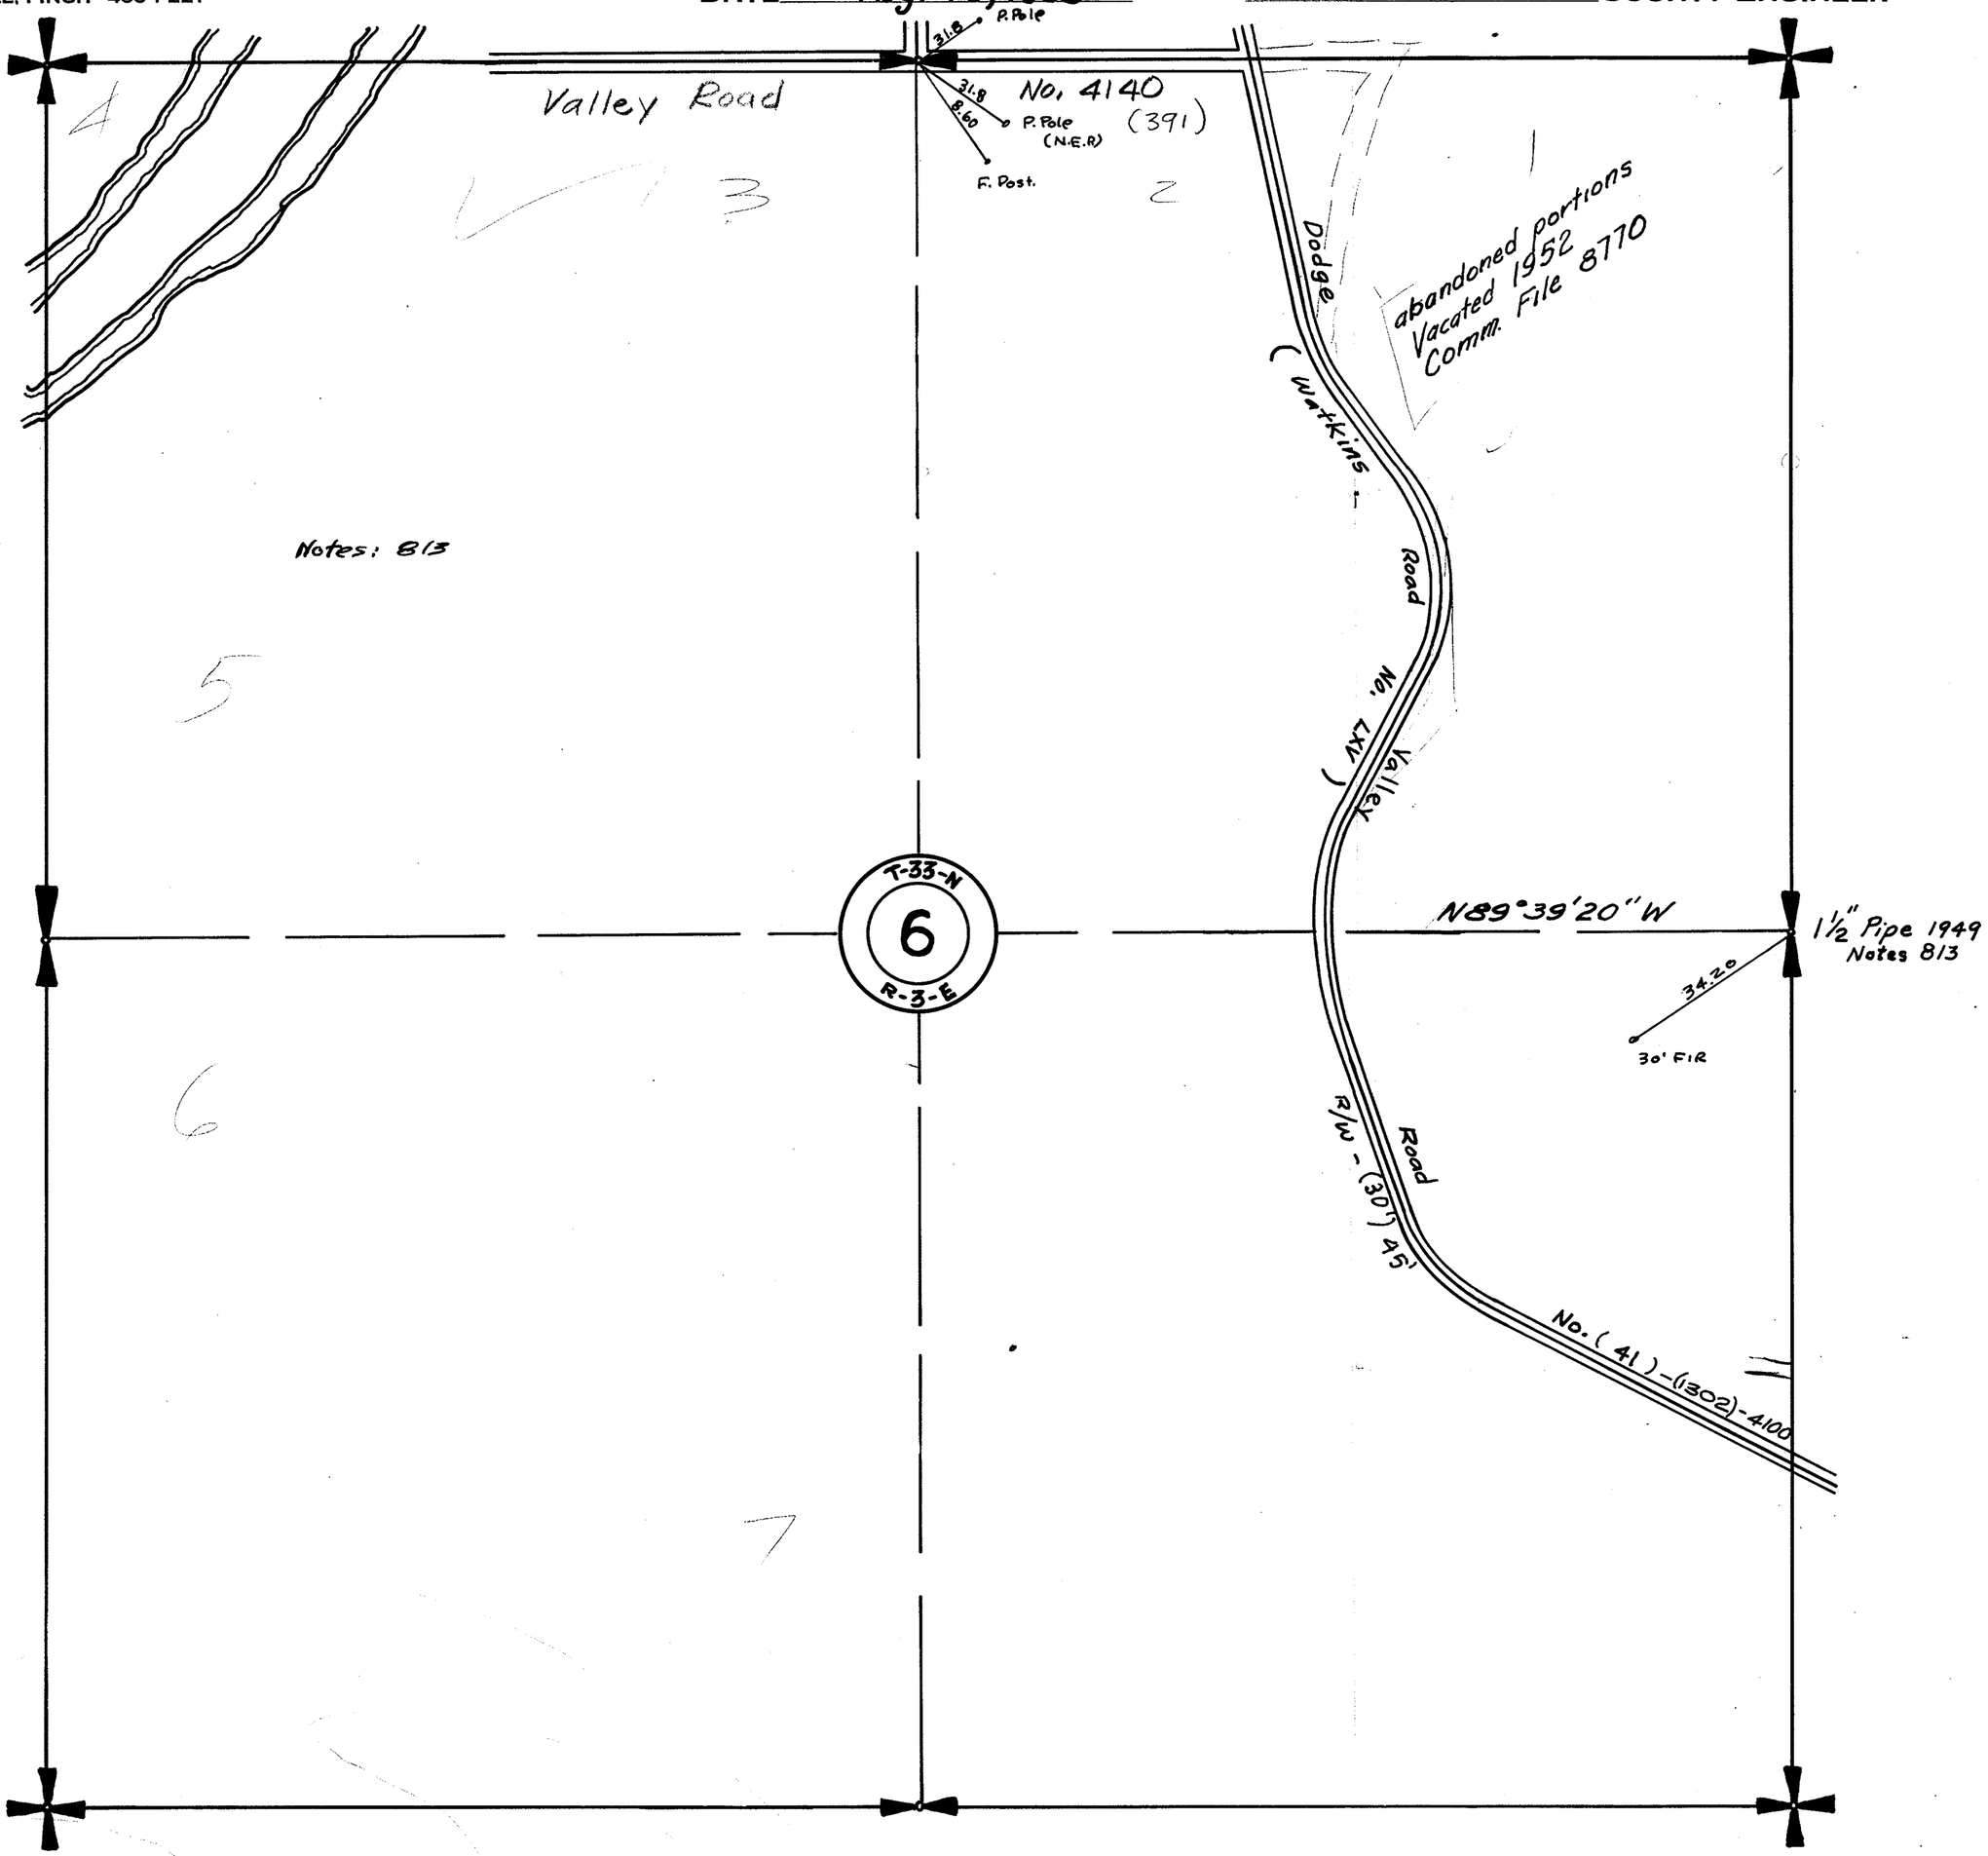

SECTION 8

TOWNSHIP 33 NORTH. RANGE 3 EAST. W. M.


SKAGIT COUNTY. WASH.

SCALE. 1 INCH—400 FEET

DATE AUGUST 1974

LLOYD JOHNSON COUNTY ENGINEER

SUBDIVISION RAIDER and LEONARD & ASSOC.

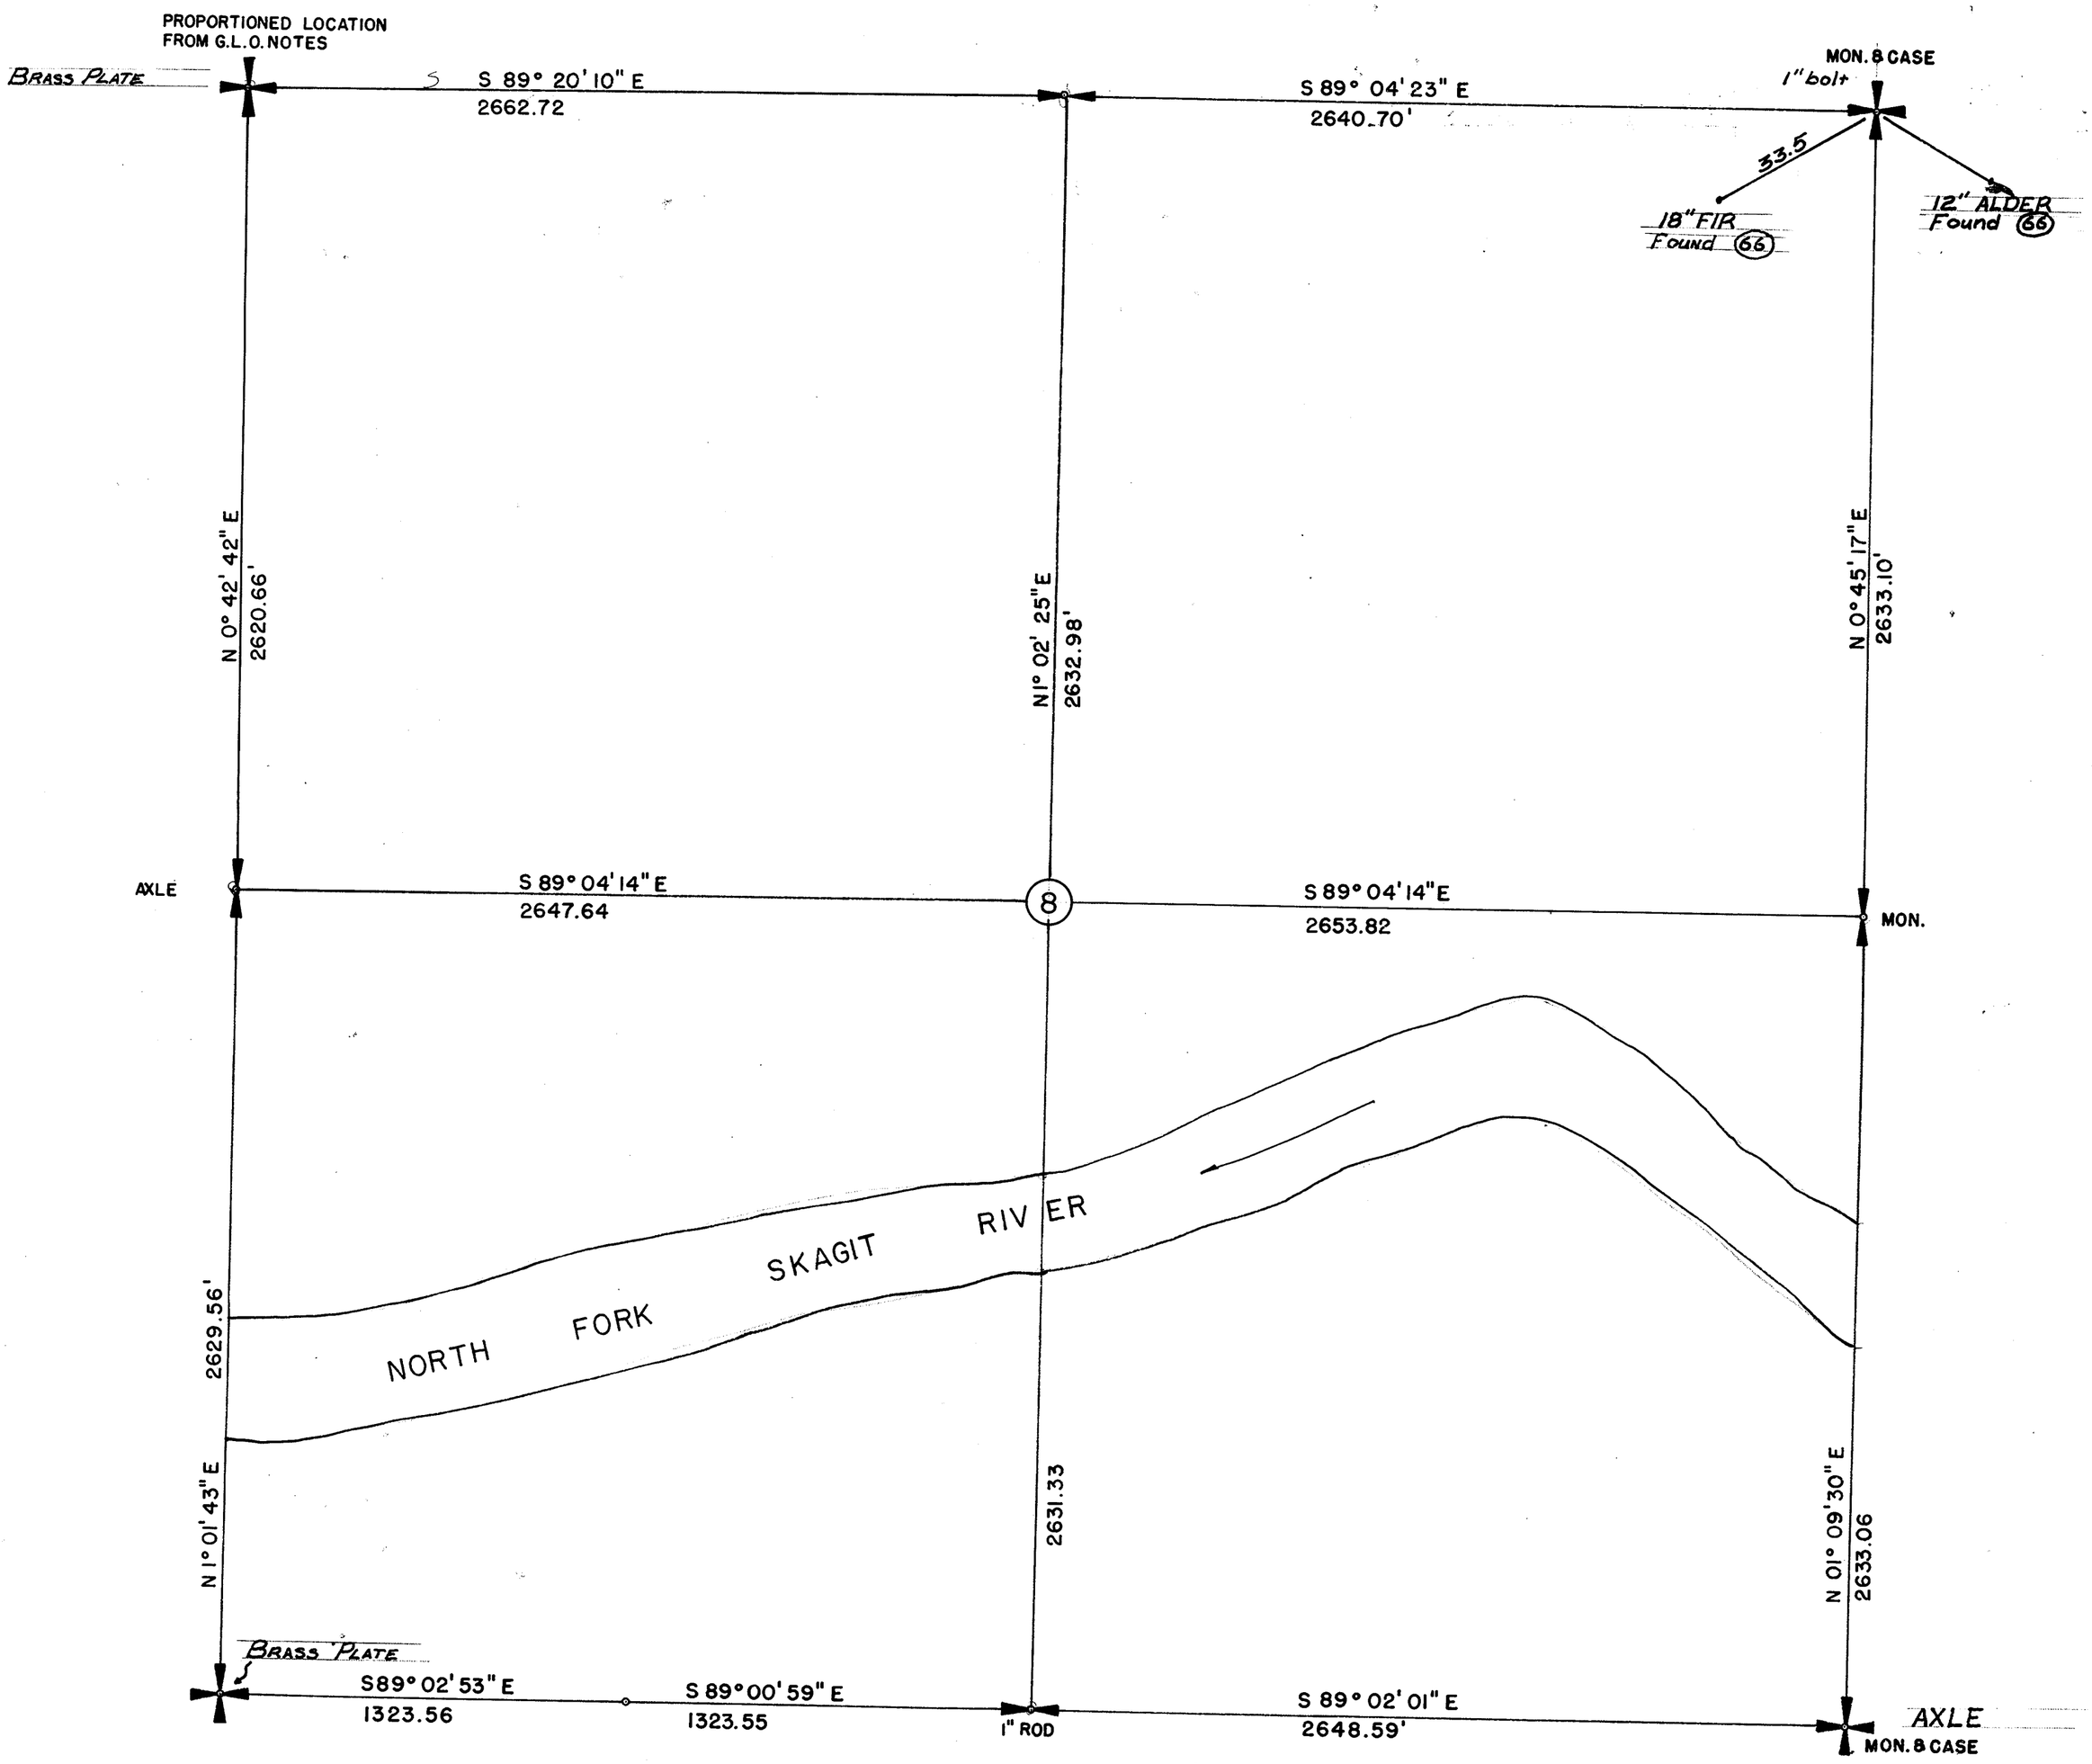

SECTION 9

Aug. 1956


TOWNSHIP 33 NORTH, RANGE 3 EAST, W. M.

SKAGIT COUNTY, WASH.

SCALE, 1 INCH--400 FEET

H. O. Walberg COUNTY ENGINEER

SUBDIVISION INFORMATION REVISED NOV. 1975
INFORMATION FROM [redacted] RADER AND LEONARD & ASSOC.

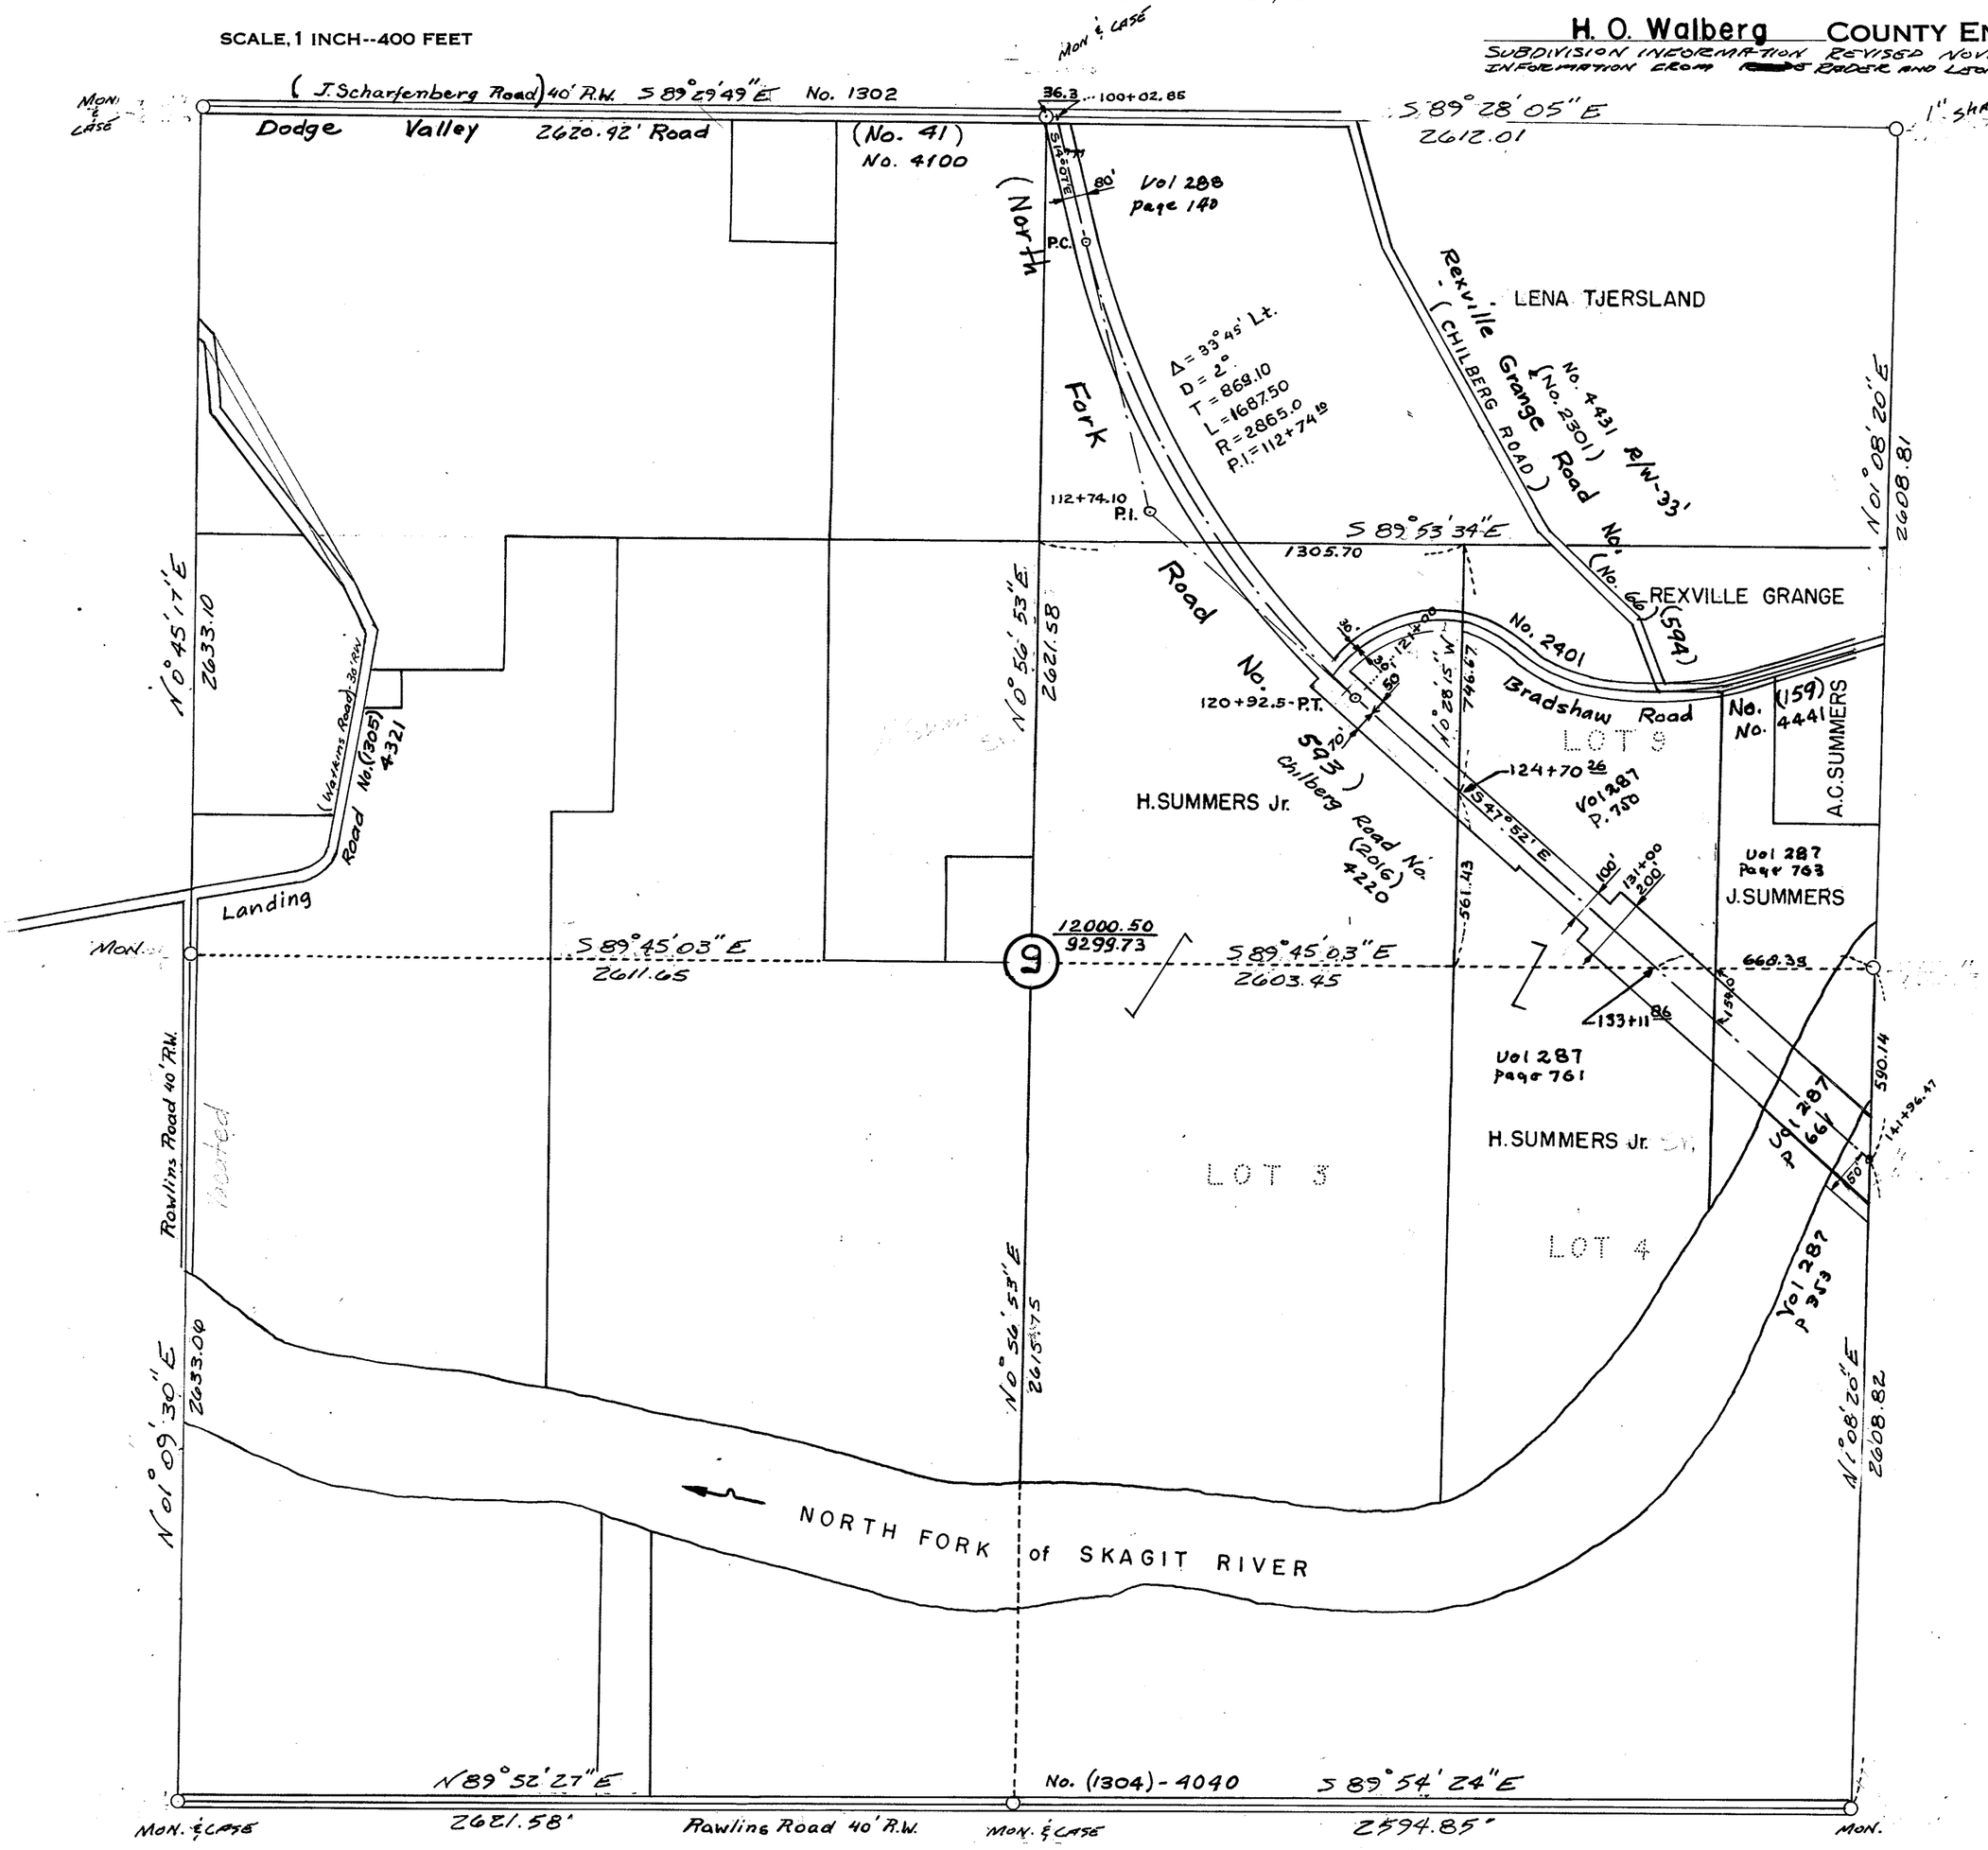


SECTION 10
TOWNSHIP 33 NORTH, RANGE 3 EAST, W. M.
SKAGIT COUNTY, WASH.

SCALE, 1 INCH -- 400 FEET
ROAD No 7 FROM NOTES 46/636

DATE 3 SEPT. 1968

Lloyd H Johnson COUNTY ENGINEER

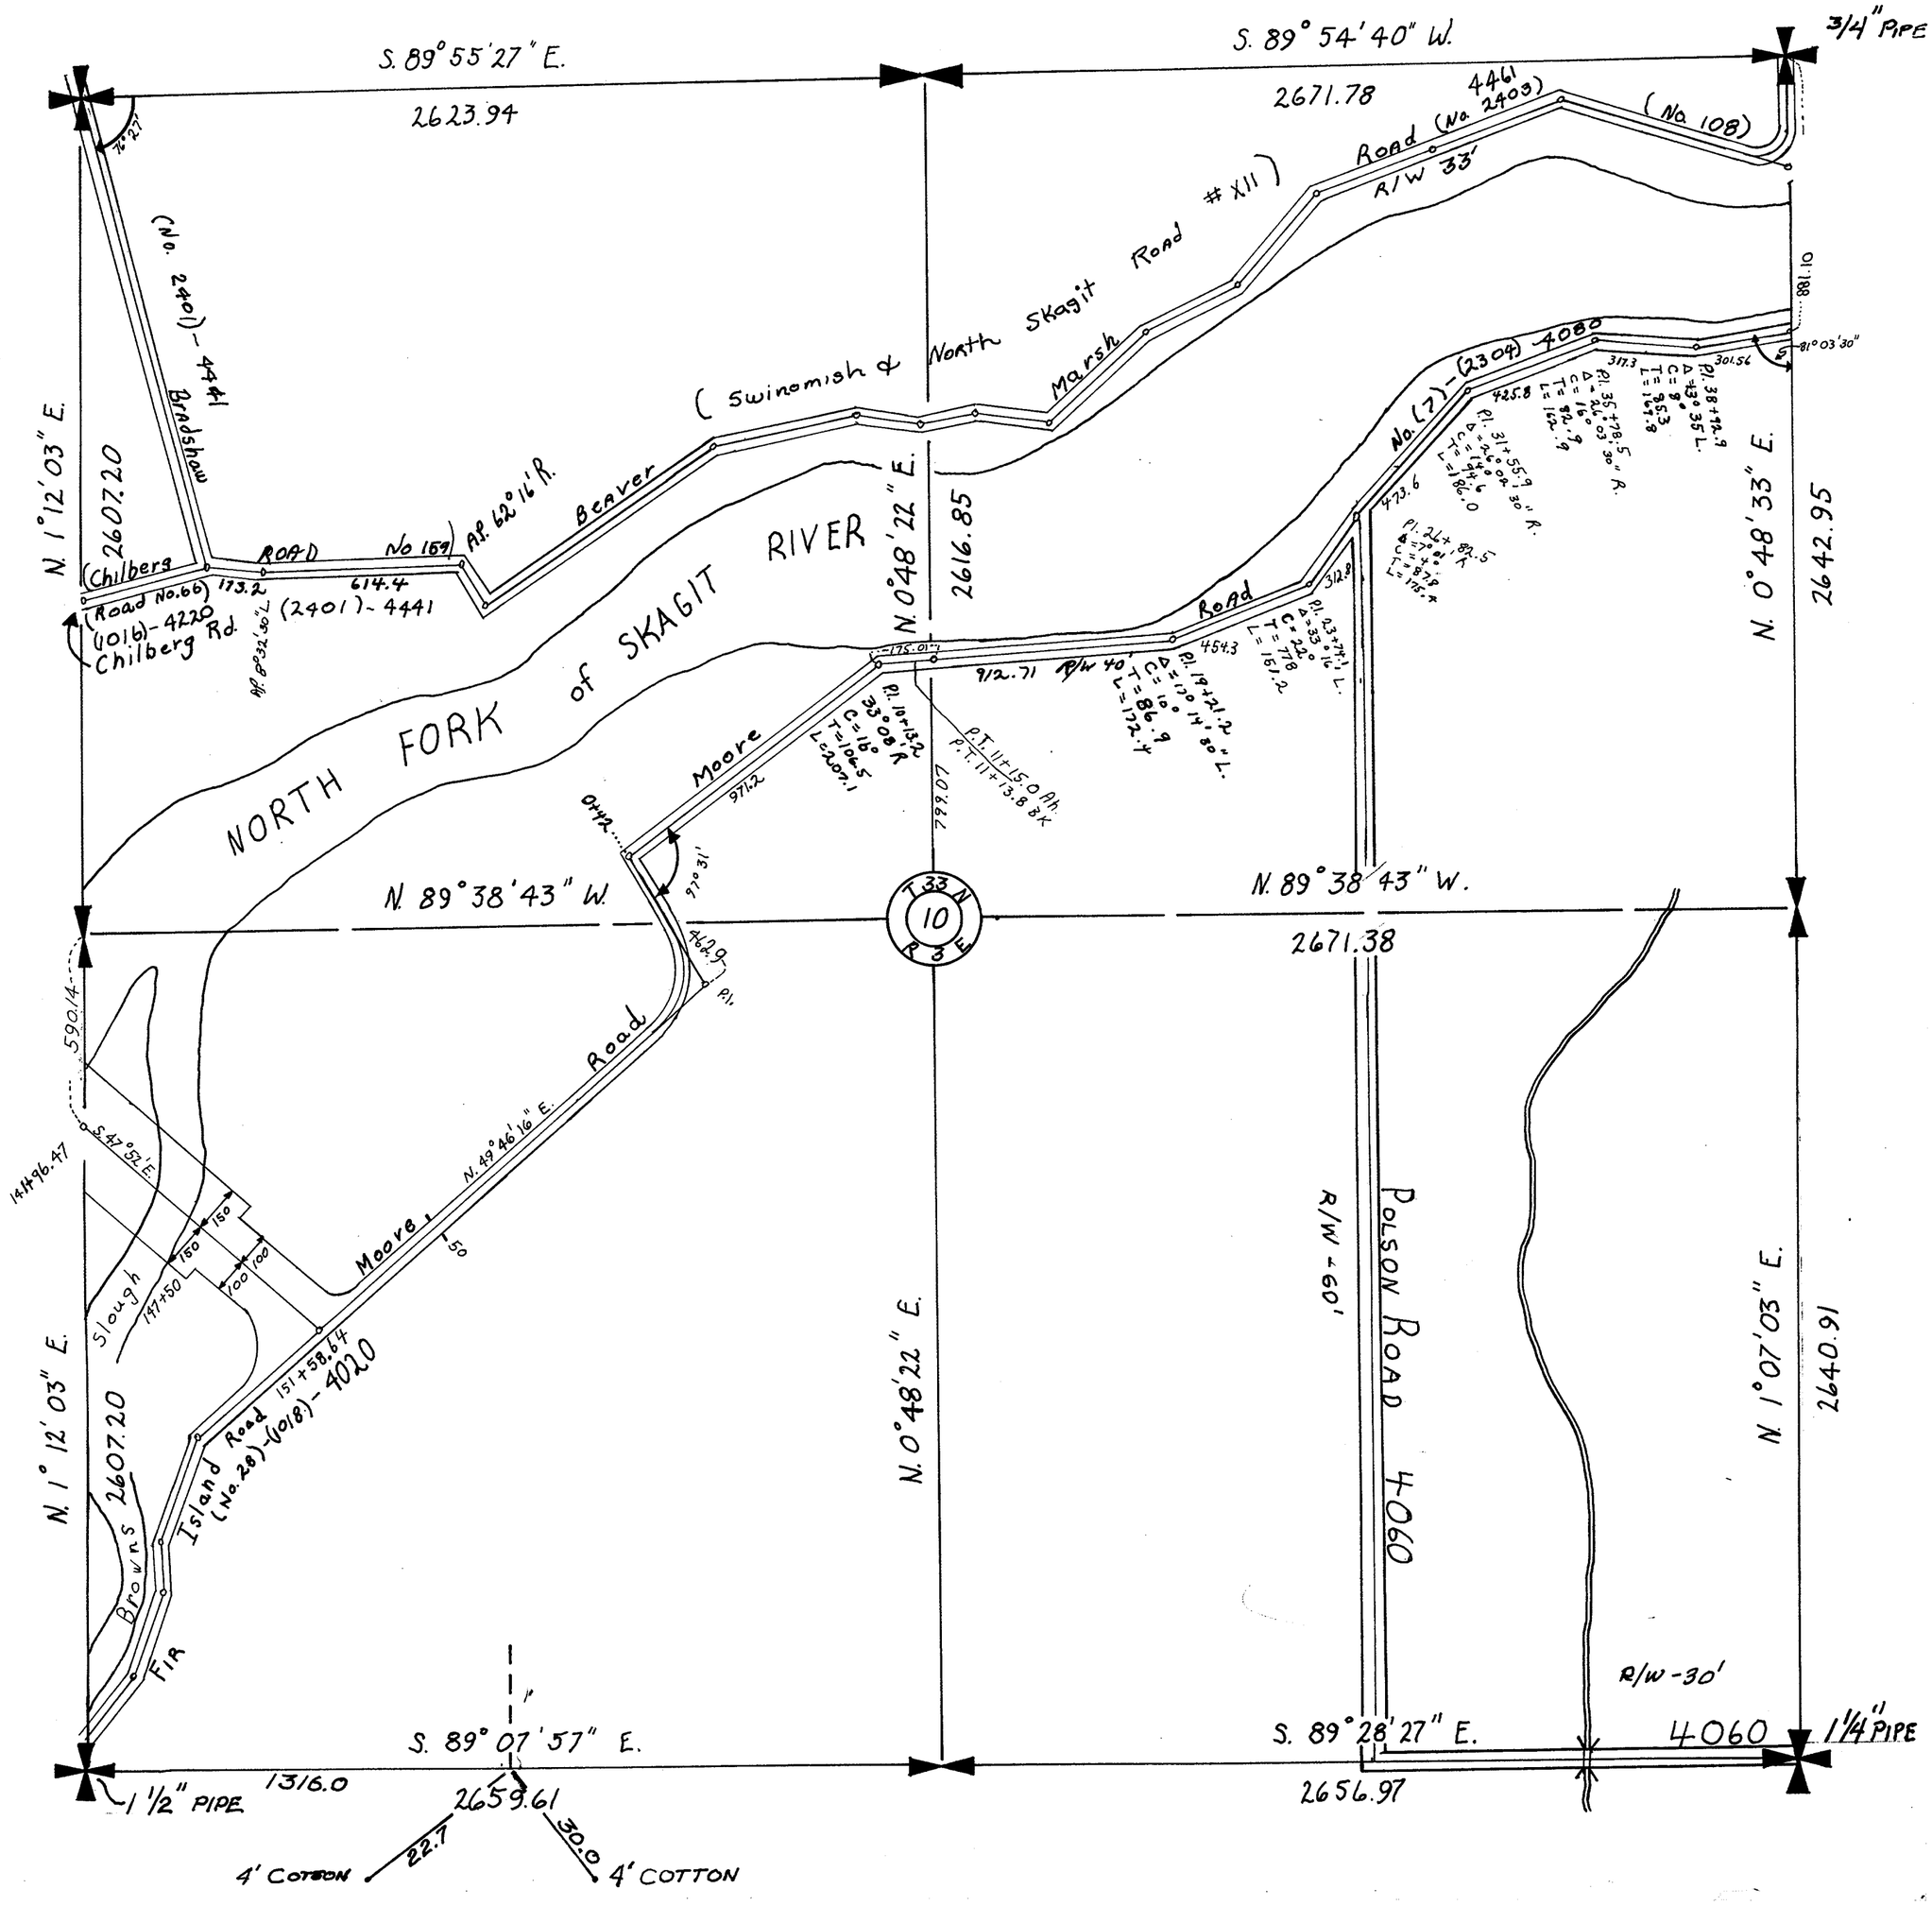


SECTION 10
TOWNSHIP 33 NORTH, RANGE 3 EAST, W. M.
SKAGIT COUNTY, WASH.

Field notes
685 - 636
F178

SCALE, 1 INCH--400 FEET
Road No. 7 From Notes 48/636

G. D. LeGro
August 1958
COUNTY ENGINEER

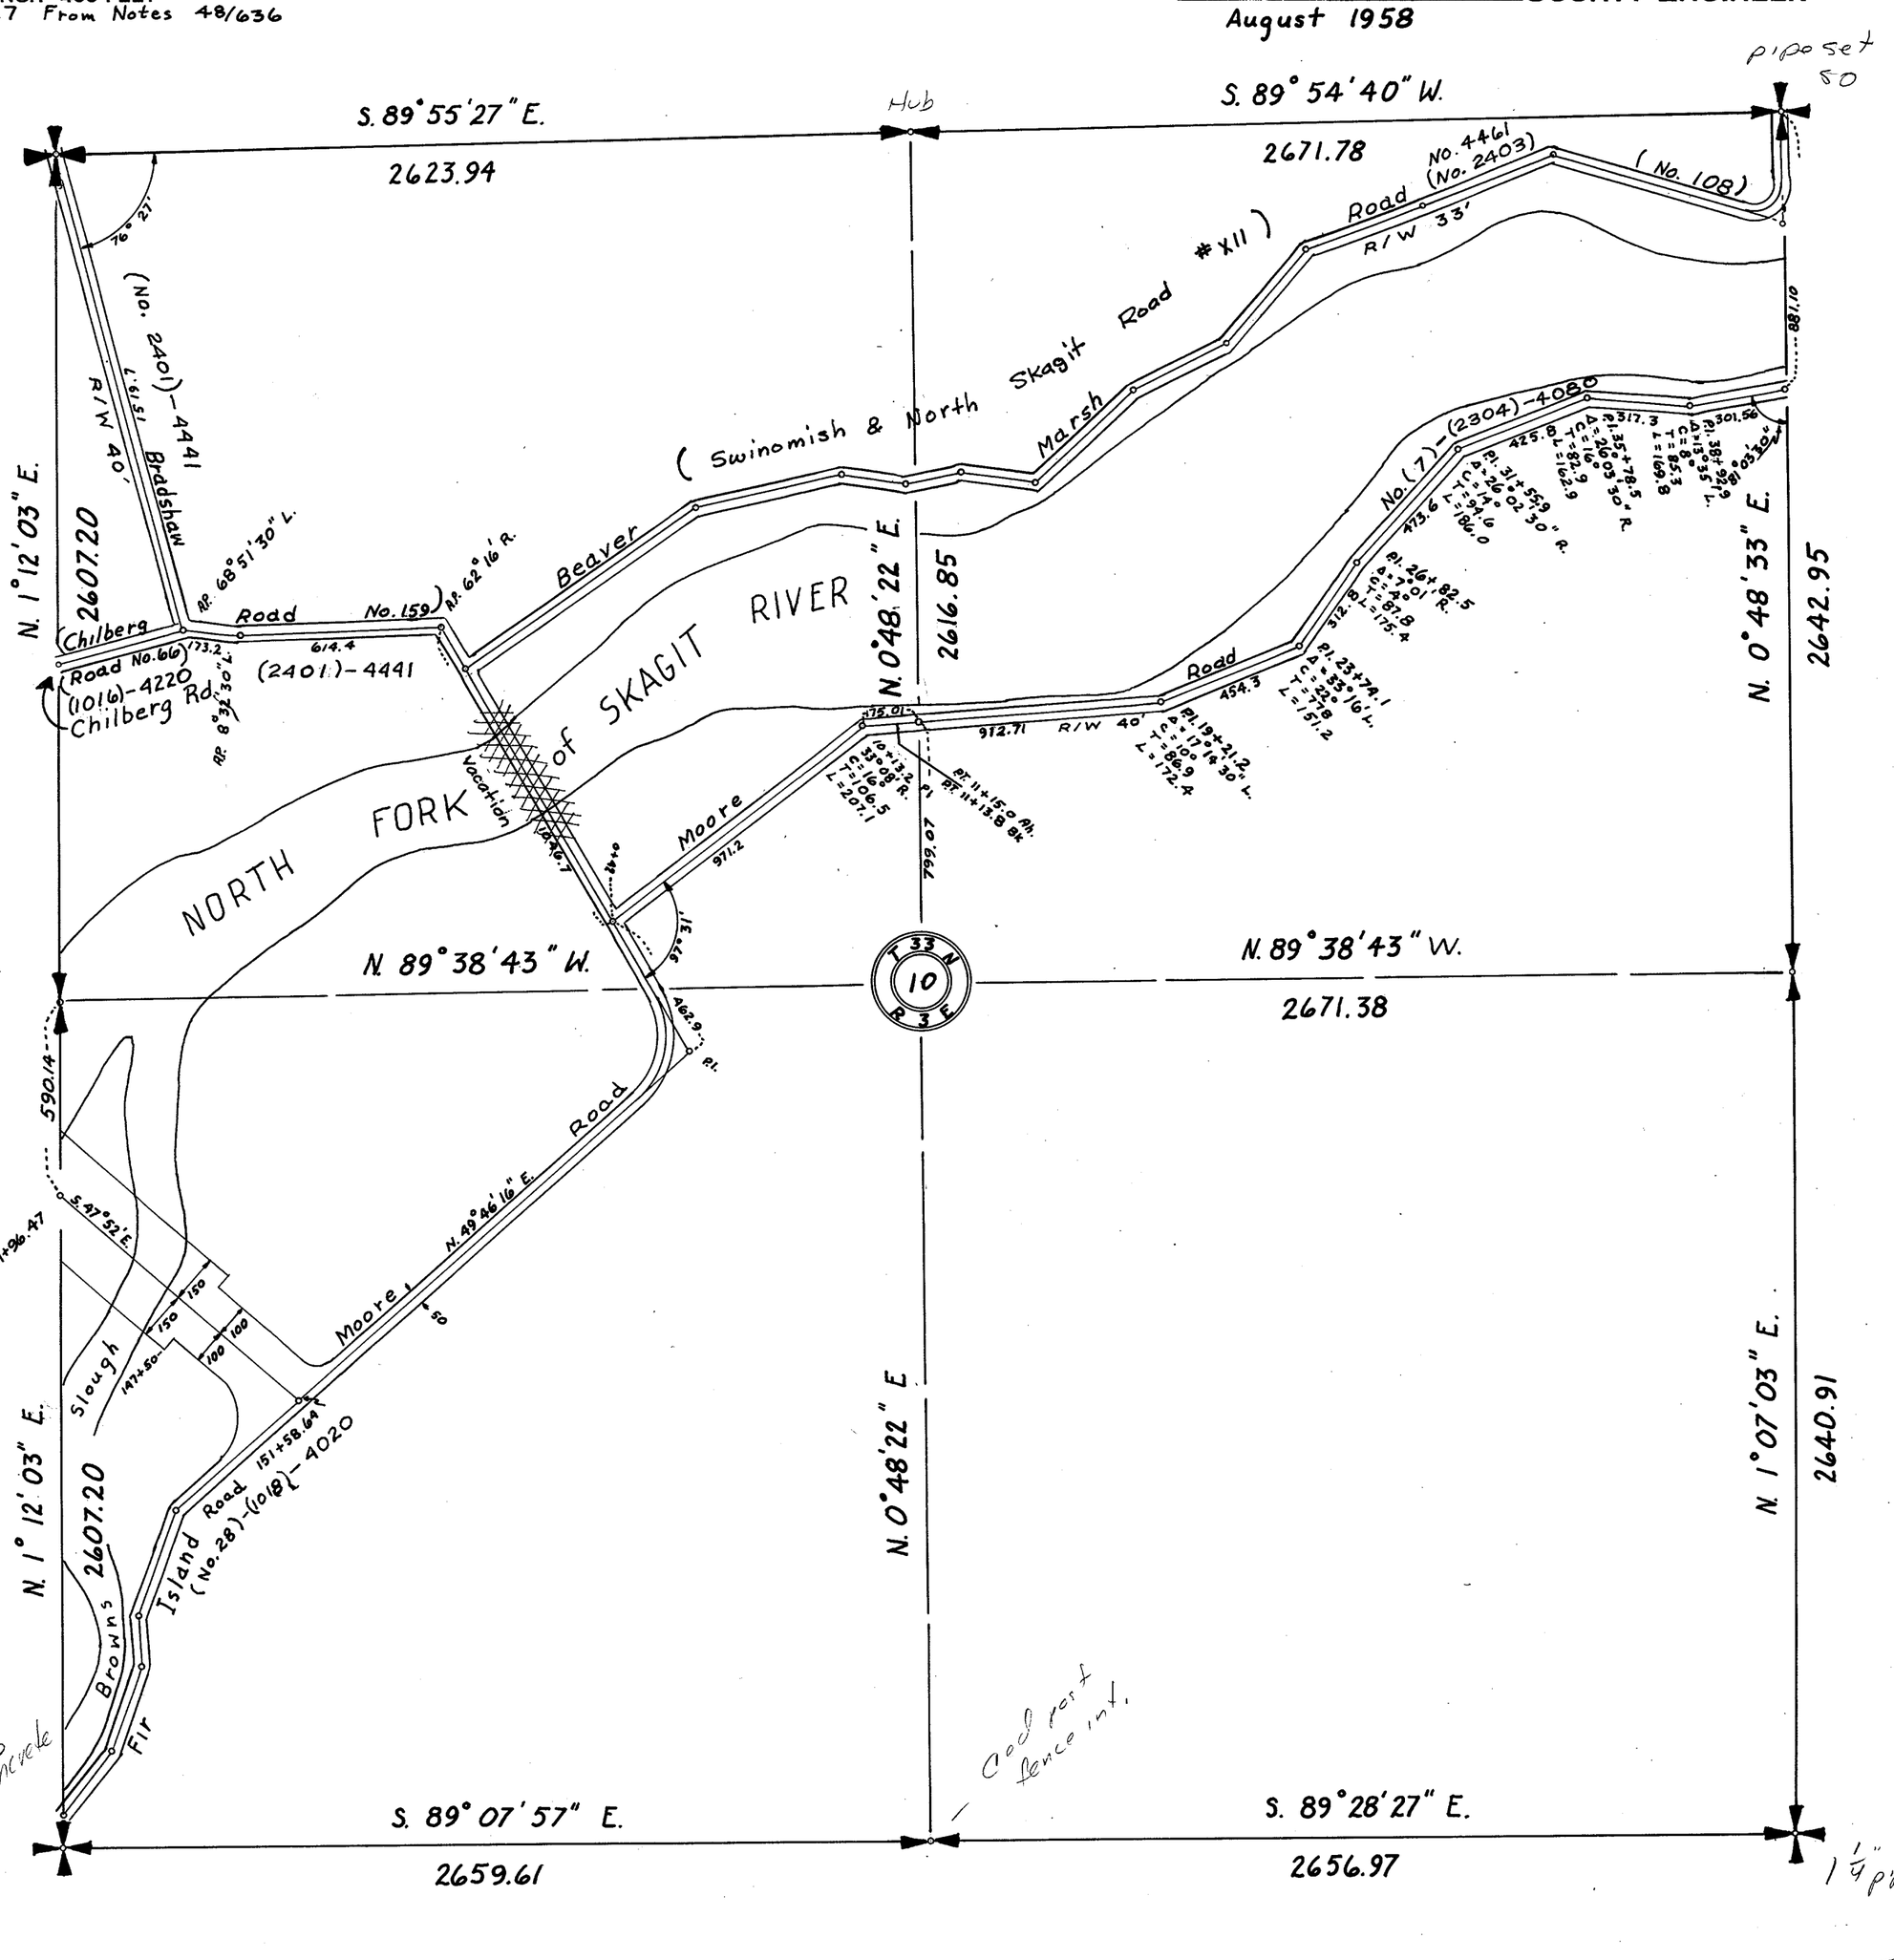


SECTION 10

TOWNSHIP 33 NORTH, RANGE 3 EAST, W. M.
SKAGIT COUNTY, WASH.

SCALE, 1 INCH–400 FEET

A. L. STRONG COUNTY ENGINEER

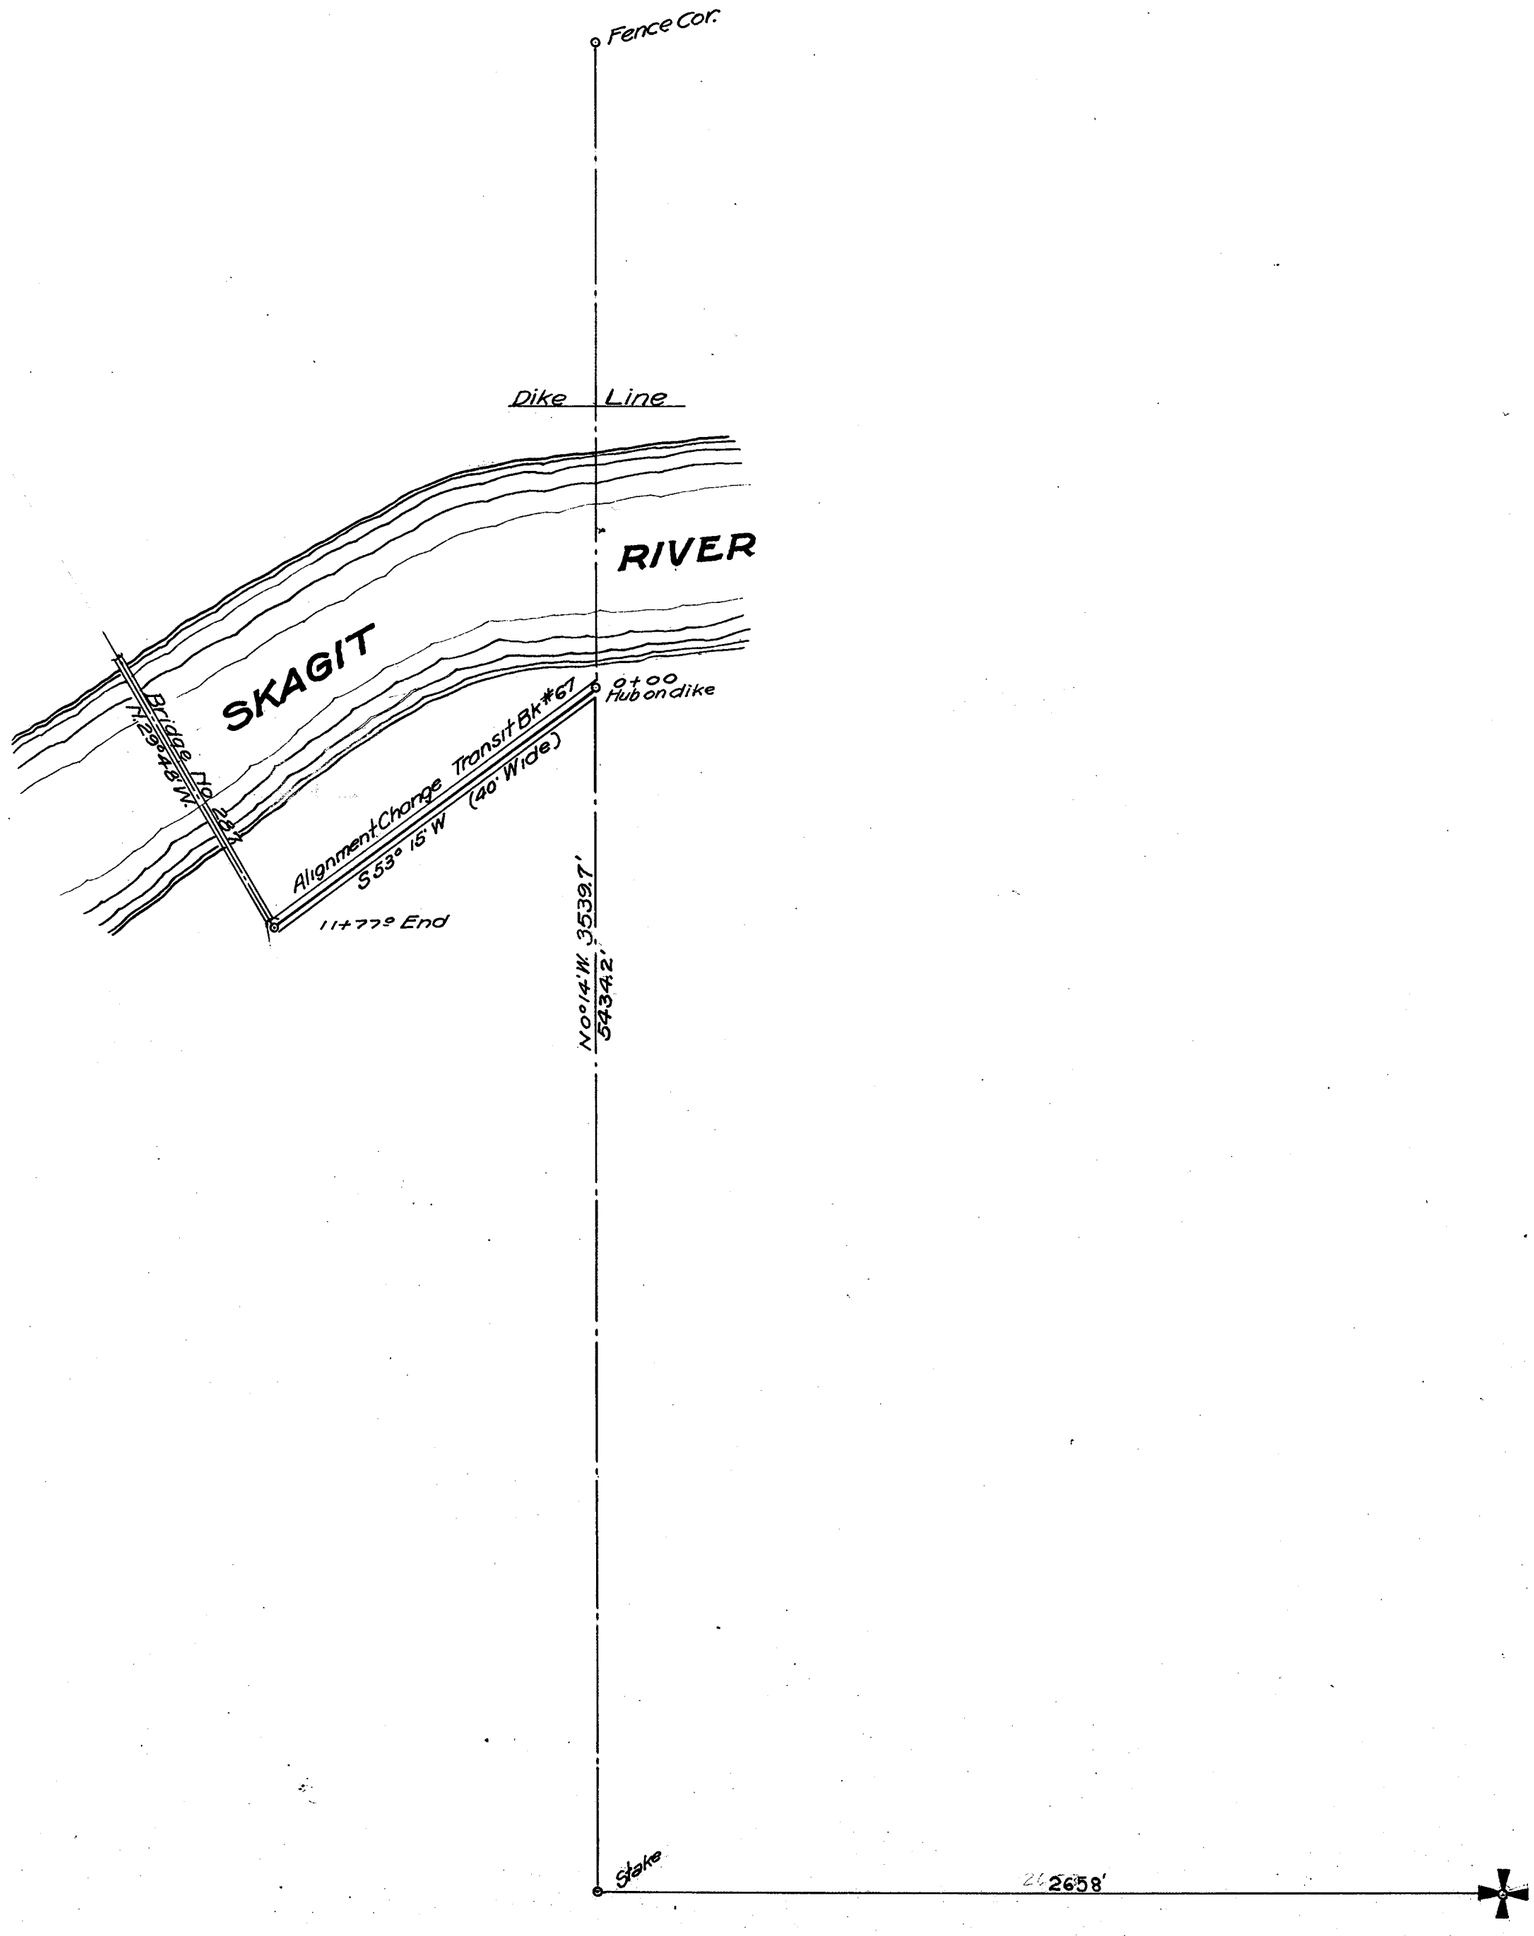

SECTION 10


TOWNSHIP 33 NORTH, RANGE 3 EAST, W. M.

SKAGIT COUNTY, WASH.

SCALE, 1 INCH--400 FEET

Notes 685 - 636
" F178

H. O. Walberg COUNTY ENGINEER

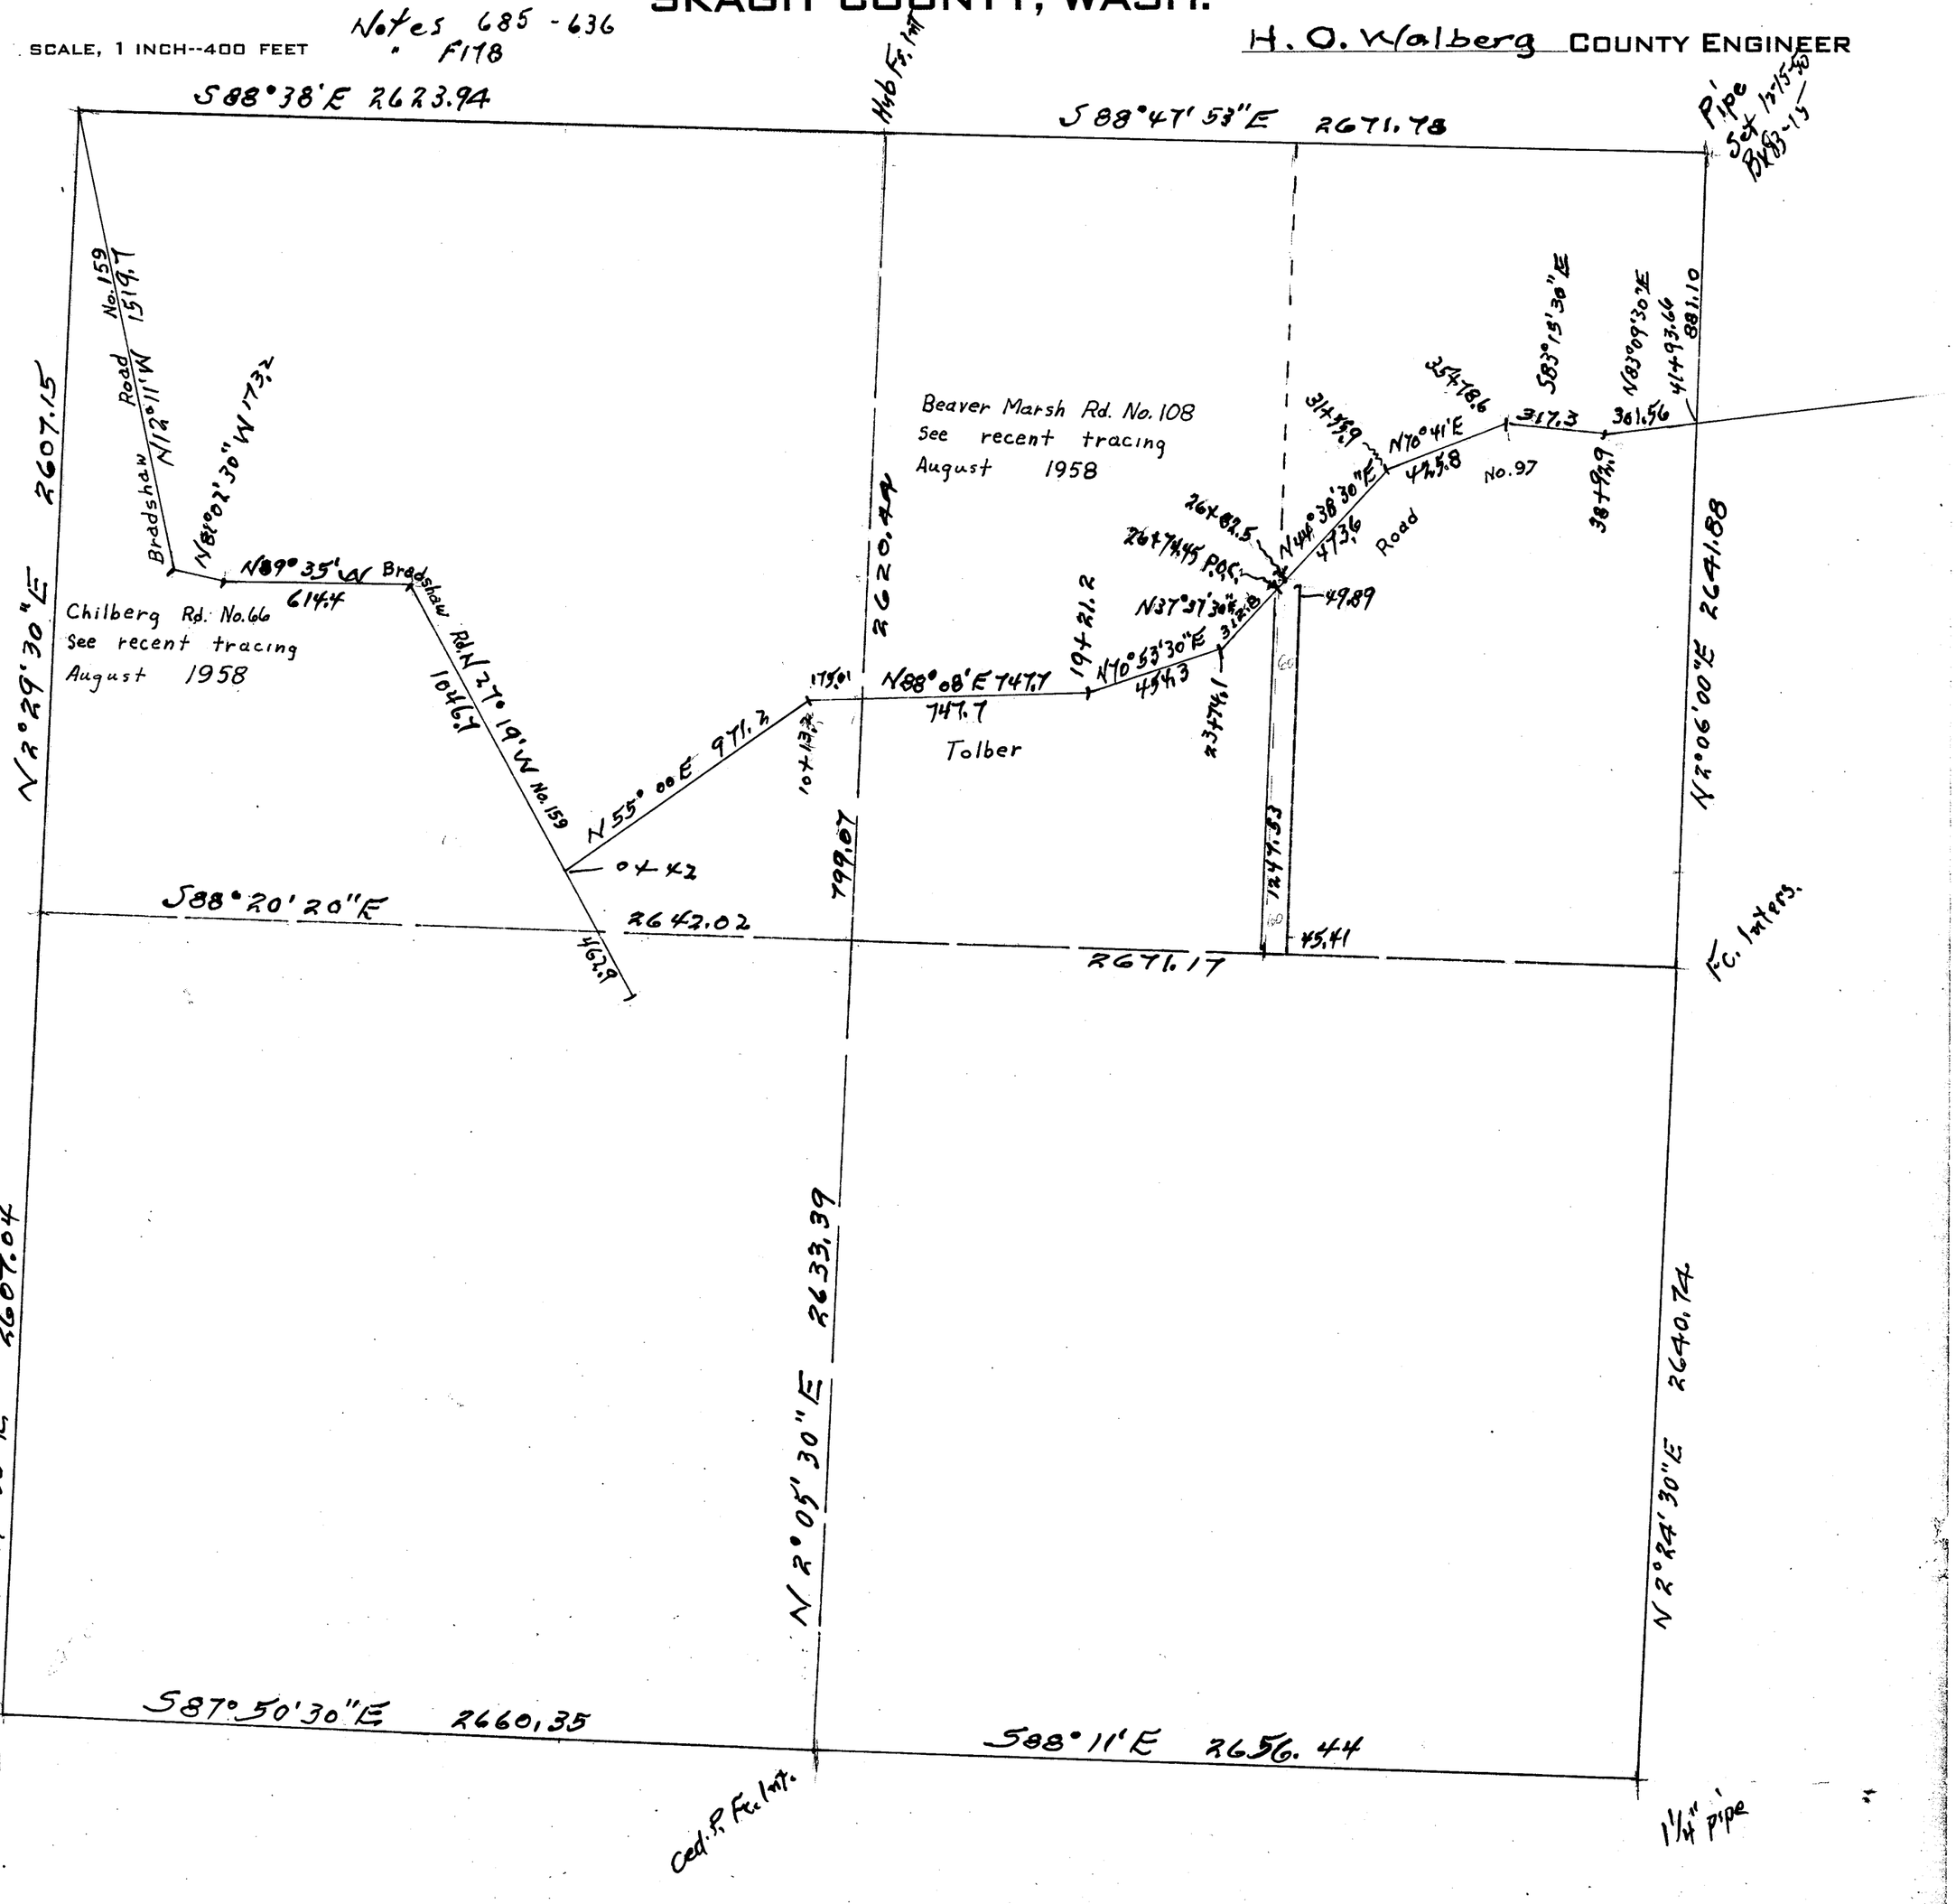


SECTION 10

TOWNSHIP 33 NORTH, RANGE 3 EAST, W. M.
SKAGIT COUNTY, WASH.

SCALE, 1 INCH--400 FEET

F 167
T.B. 90

Robt. E. L. Knapp 1930 COUNTY ENGINEER
F 178

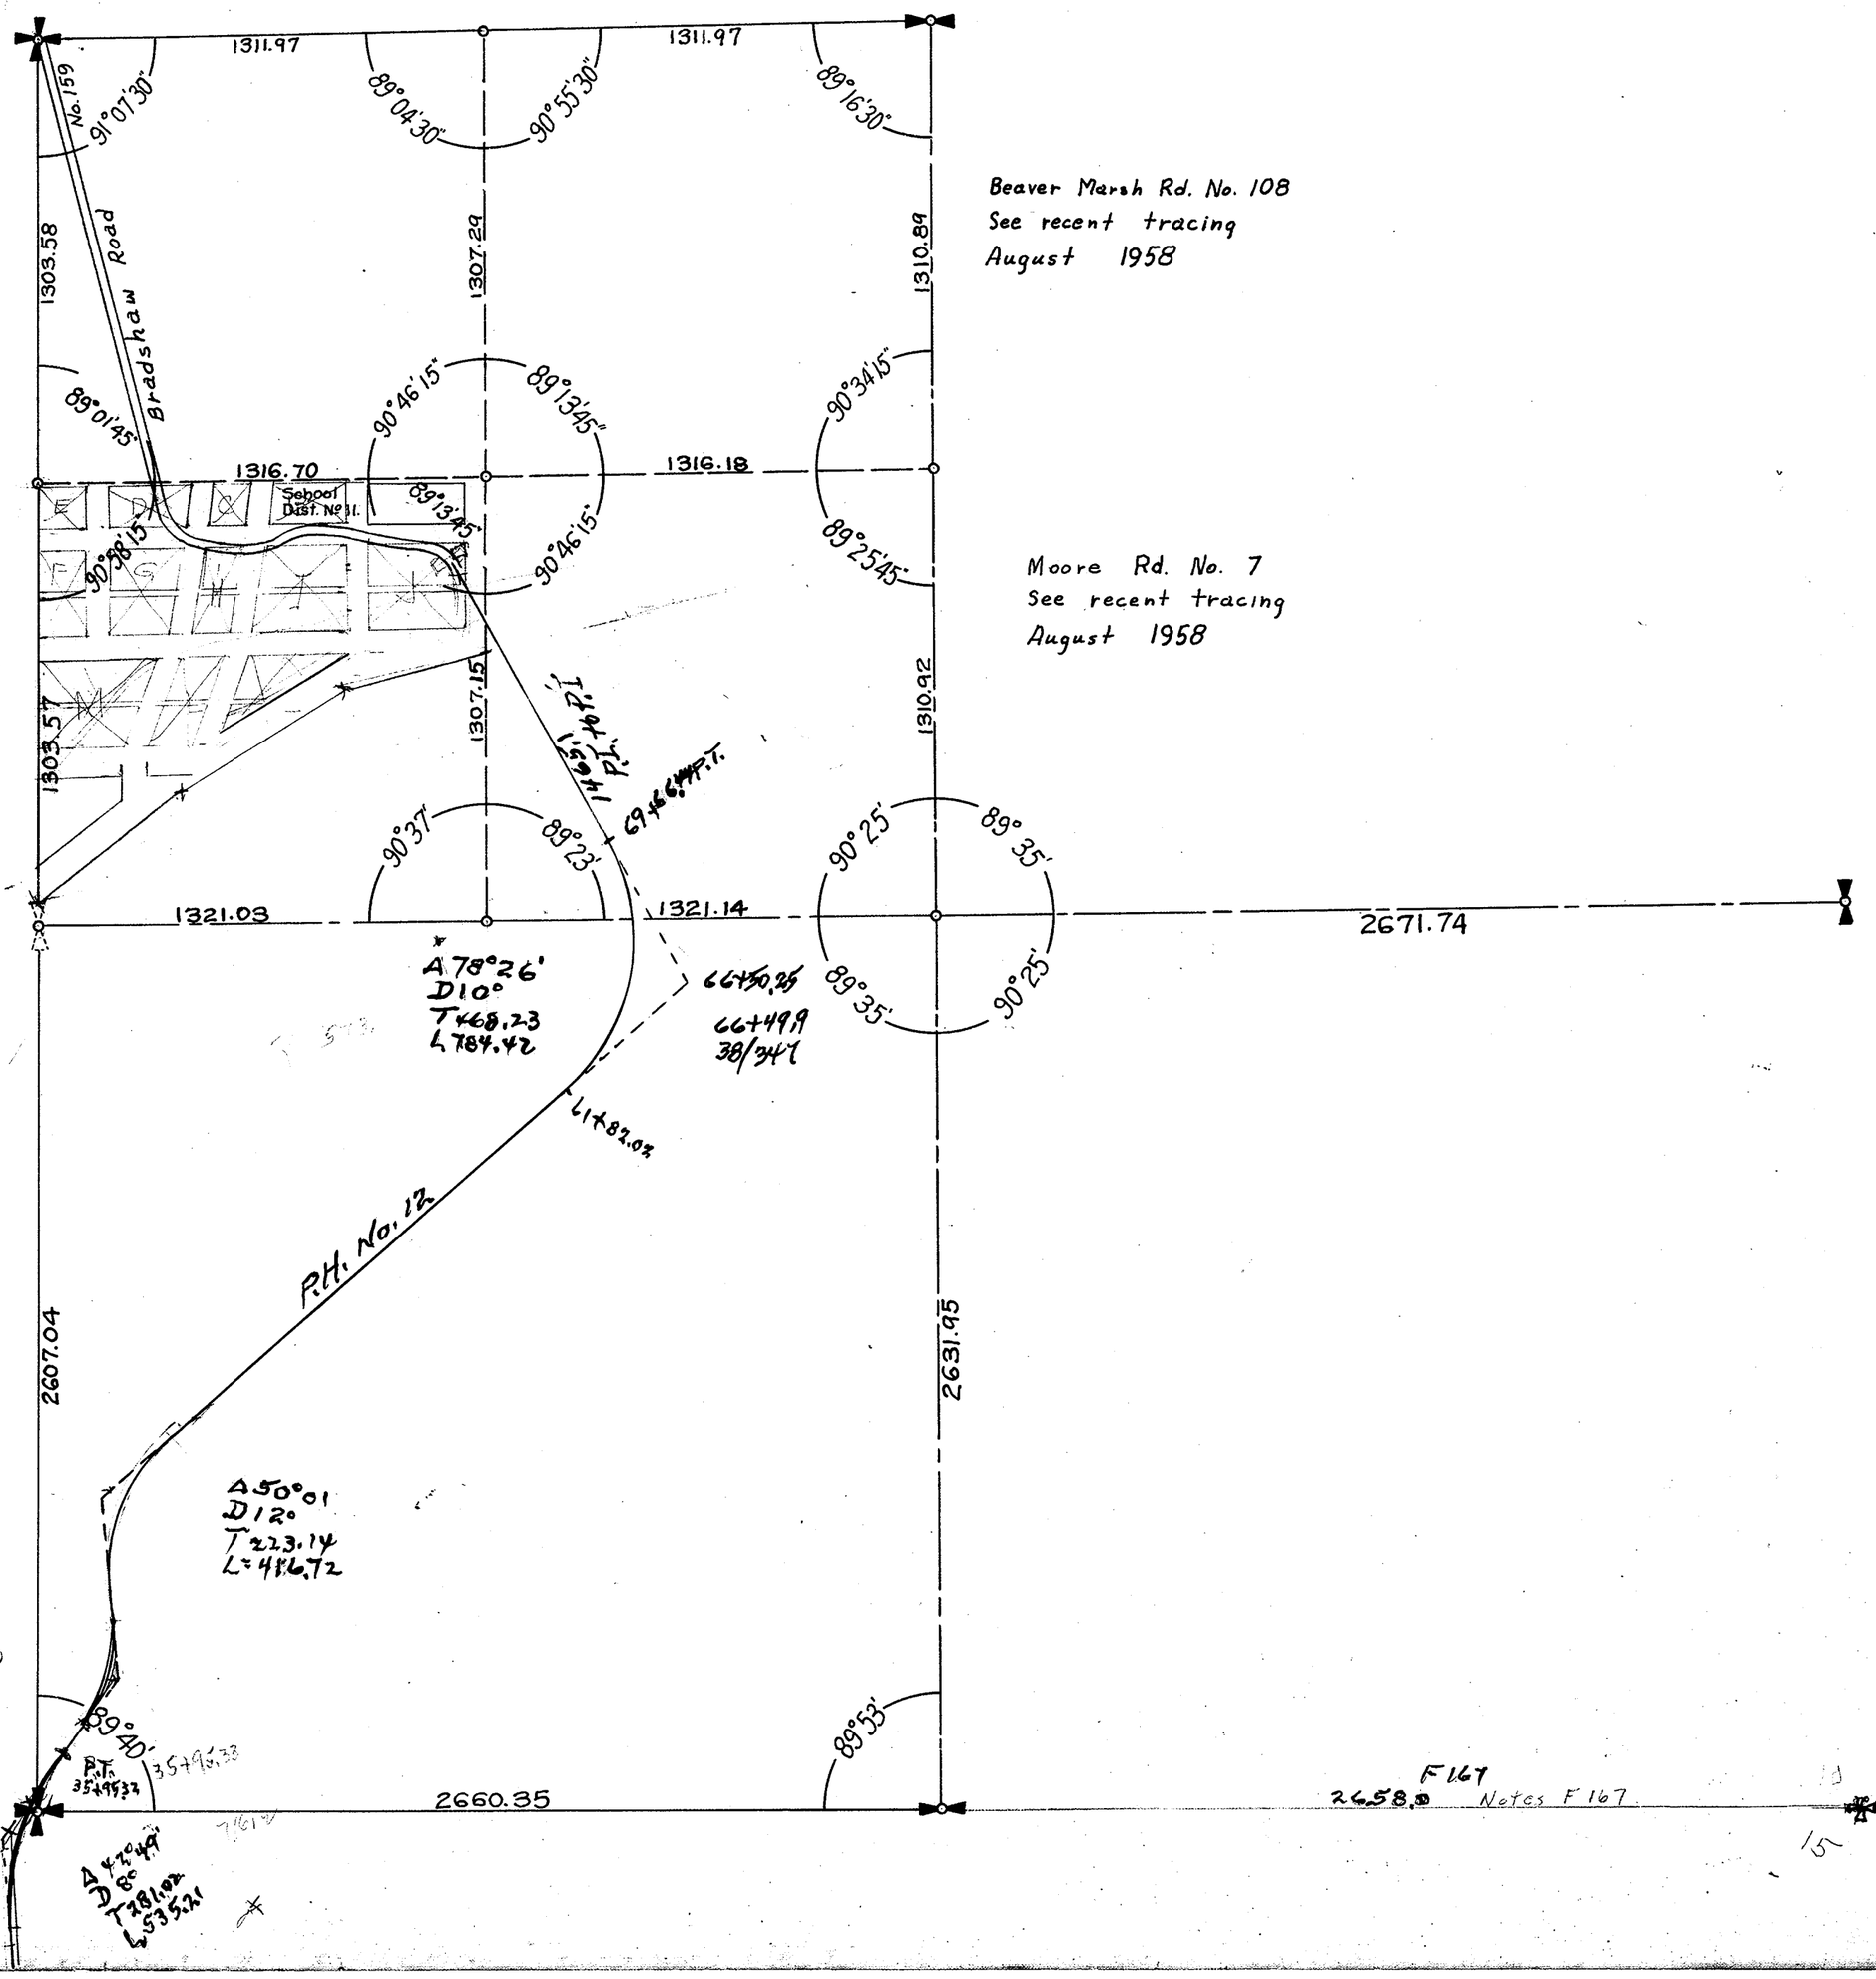

Beaver Marsh Rd. No. 108
See recent tracing
August 1958

Moore Rd. No. 7
See recent tracing
August 1958

Aug. 1956


SECTION 10

TOWNSHIP 33 NORTH, RANGE 3 EAST, W. M.

SKAGIT COUNTY, WASH.

SCALE, 1 INCH--400 FEET

H. O. Walberg COUNTY ENGINEER

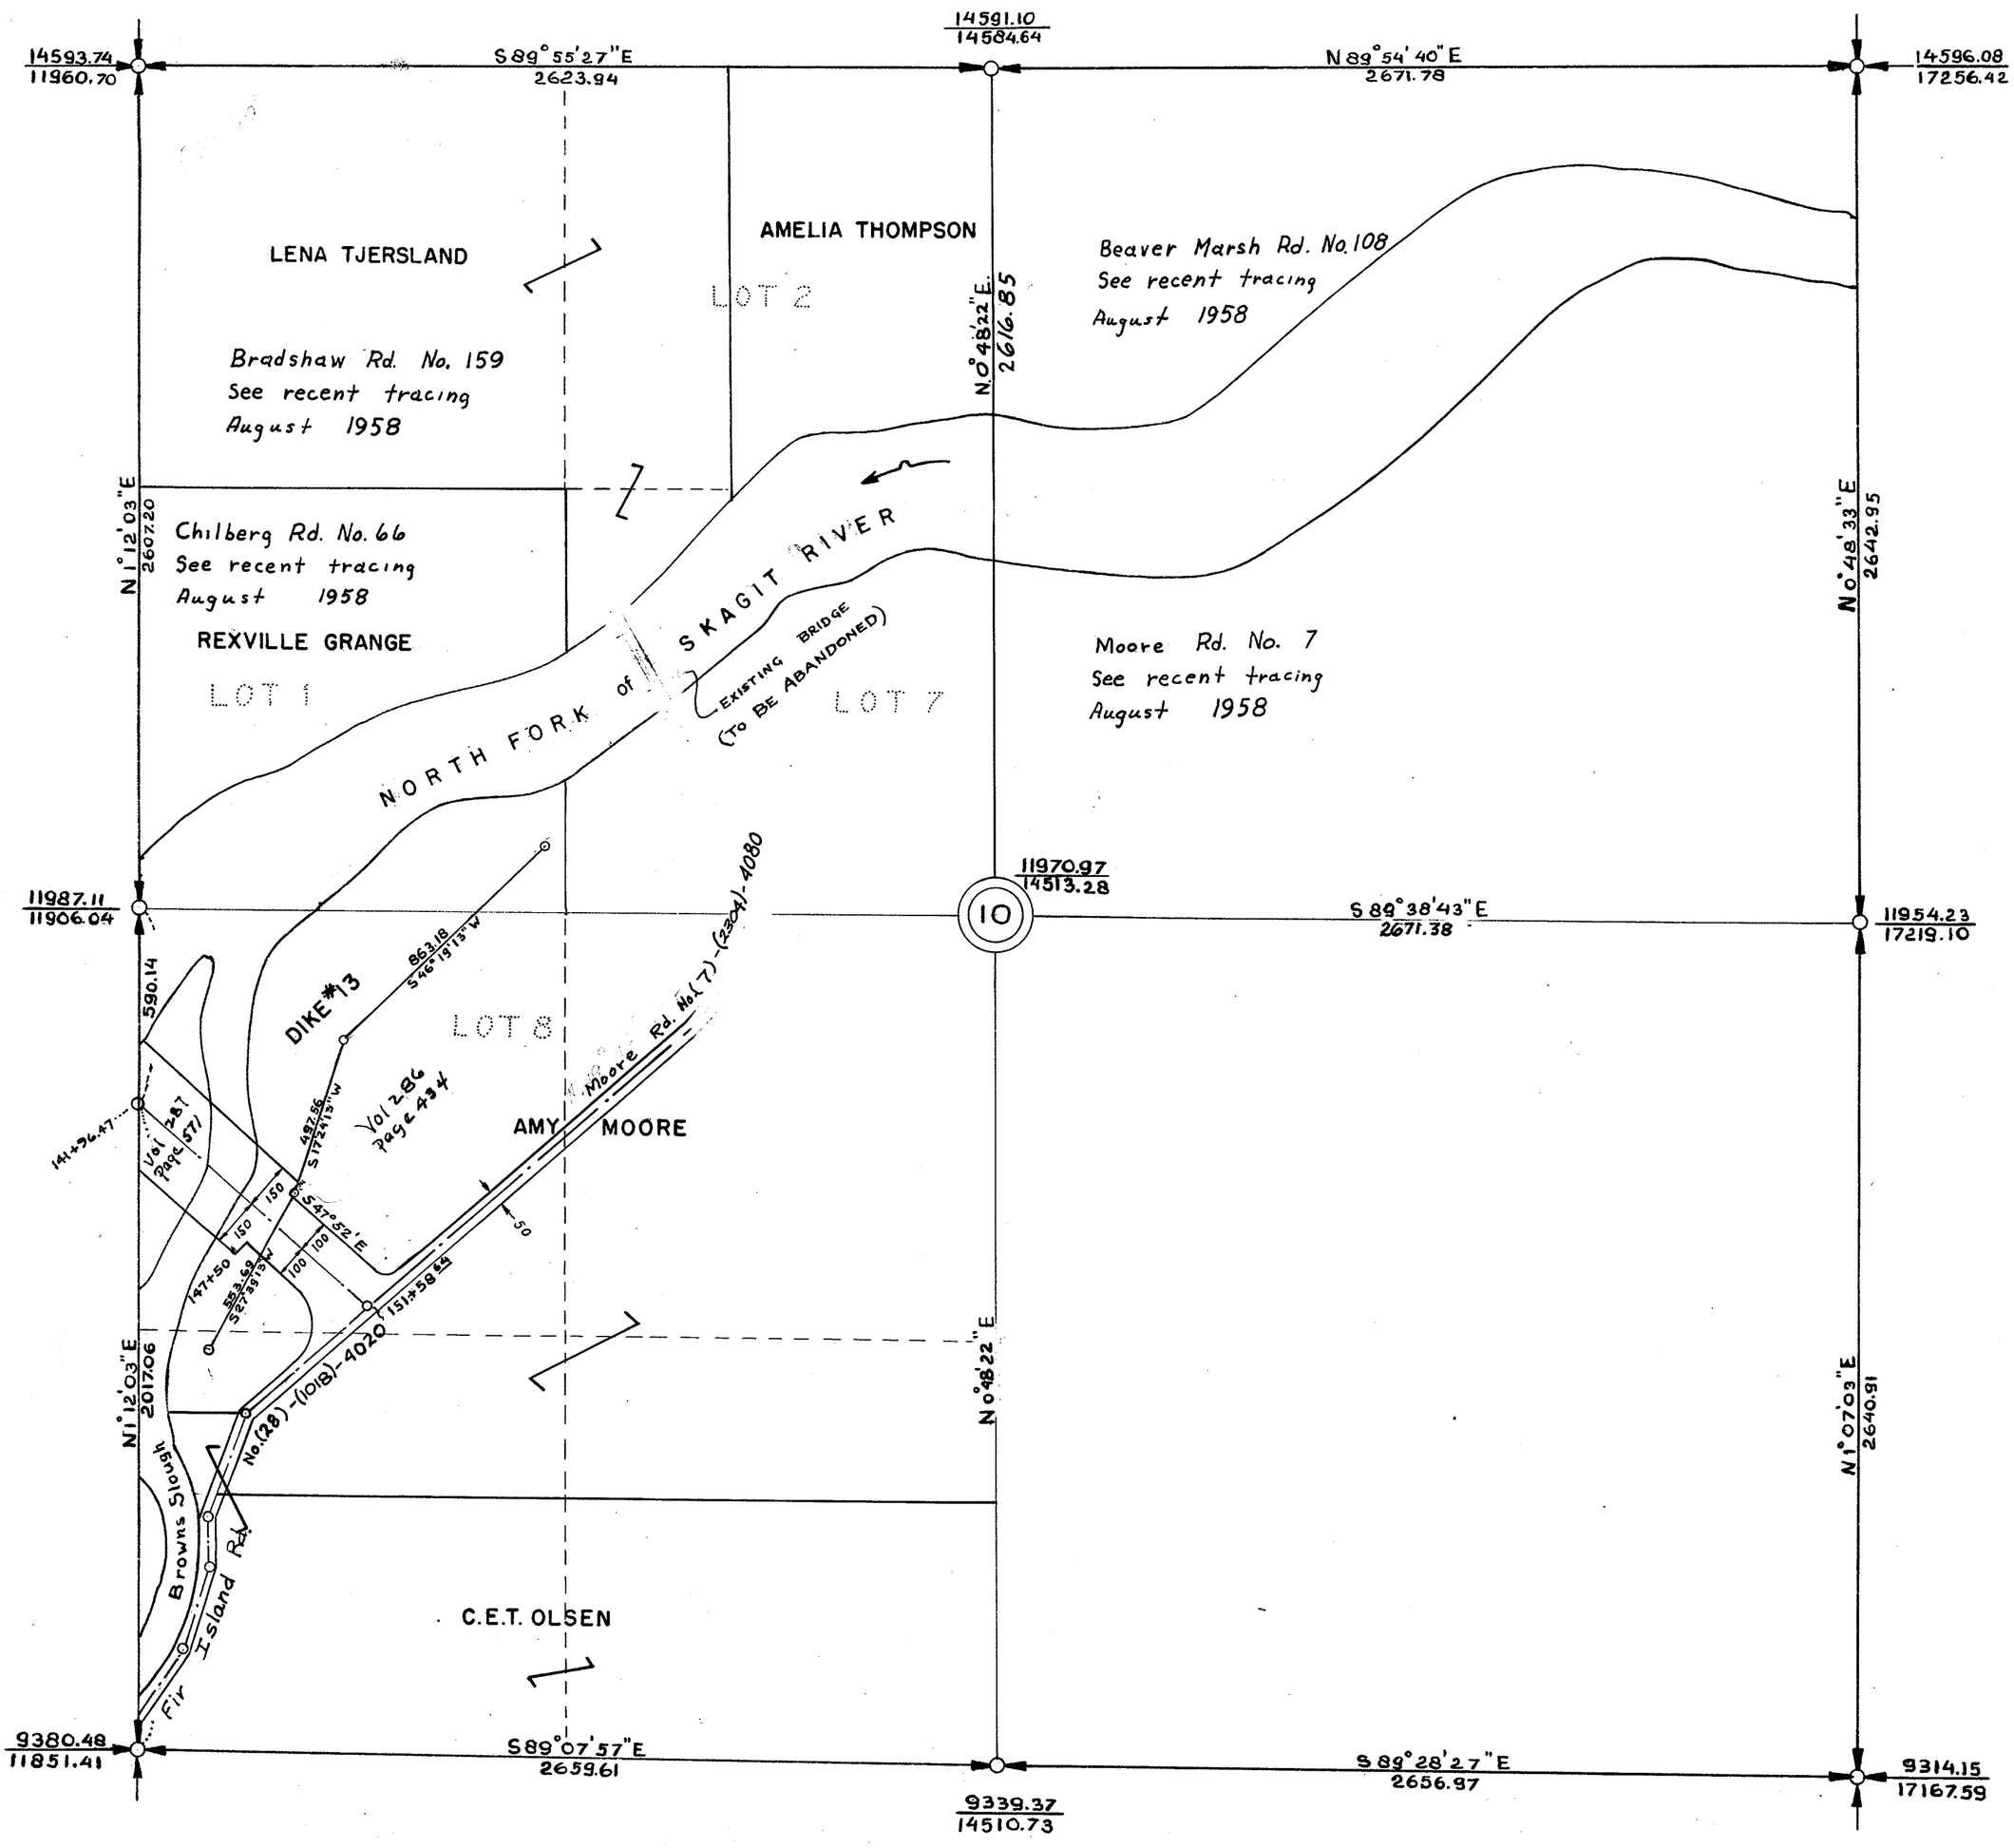

SECTION 11

TOWNSHIP 33 NORTH, RANGE 3 EAST, W. M.

SKAGIT COUNTY, WASH.

Notes 685-G 184-F 167

SCALE, 1 INCH--400 FEET

Road No. 7 from Notes 49/636 (Bk 45-38) - AB-636

G.D. LeGro COUNTY ENGINEER

August 1958

636

No.(2304)-4080

No.(7) S87°43'30"E 2645.19

R/W 40'

Road

S87°46'E 2605.73

Beaver Marsh Road (No.108) - 4461

881.10

P.I. 62+03.3

P.T. 58+76.6

P.C. 61+40.0

Δ = 55°51'
C = 48°
T = 63.3
L = 116.4

Δ = 28°09'
T = 89.8
L = 175.9

Δ = 12°58'
T = 108.5
L = 216.1

P.C. 56+96.3
P.T. 55+21.6
P.C. 54+75.7
P.T. 51+45.6
P.C. 49+29.5

P.I. 57+86.5
Δ = 5°24'30"
T = 90.2
L = 180.2

P.I. 55+05.5

Moore

844.34

R/W - 45'

P.I. 50+38.0

Δ 40°02'40"

P.O.T. 71+09.8

P.O.T. 79+93.8

AP. 87+23.5
0°58'R

AP. 90+73.3
2°16' L

P.O.T. 92+75.3

92+53.2

N20°06'E 2641.88

26 38.16

No.(100)-(2303)-4501

(No. XC)

Road

N1°58'30"E 2632.34

T 33 N
11
R 3 E

S 87°50'35"E 2617.28

2638.36

MON & CASE (74)

G 184

685

N2°24'30"E 2640.74

S87°44'30"E 2643.60

N1°50'20"E 2645.64

Slough

Dry

R/W - 30'

N 1°43'30"E 2637.38

MON & CASE (74)

S88°01'26"E 2643.40

1" PIPE Found (61)

2" PIPE Found (60)

B45-38

22.7

F167

30.0

4' Cottonwood

4' Cottonwood

SECTION II

TOWNSHIP 33 NORTH, RANGE 3 EAST, W. M.
SKAGIT COUNTY, WASH.

Notes 685 - G 184-F167
(45-38) — A6- 636

SCALE, 1 INCH--400 FEET

636

_____ COUNTY ENGINEER

S87°46'E 2605.73

2645.19

S87°43'20"E 2649.19

90°18'10"

2631.85

N1°58'30"E 2631.34

180°15'

(184)

N2°16'E 2641.88

S84°50' 35"E 2617.28

2638.36

2638.16

(6x7)

N2°21'30"E 2640.74

2655.96

N1°50'30"E

2636.86

N1°43'30"E 2637.84

S87° 44' 30"E 2643.60

S88°01'26"E 2643.40

1316

OLAF POLSON NO 37 WIDTH 40' 2639.1 by J.Meehan

II

II2

II4

II3

F167

(B 45-38)

SECTION 11

TOWNSHIP 33 NORTH, RANGE 3 EAST, W. M.

SKAGIT COUNTY, WASH.

SCALE, 1 INCH -- 400 FEET Notes 685-G 184-F167 (Bk 45-38) - AB - 636
Road No. 7 from Notes 45/636

DATE August 1968

Lloyd Johnson COUNTY ENGINEER

636

No.(2304) - 4080

S87°46'E 2605.73 Road No(7) S87°43'20"E 2645.19

R/W 40'

Beaver Marsh Road (No.108)-4461

881.10

Pl. 62+10.3

Δ=12°58'
D=6°
T=108.5
L=216.1
P.C. 49+29.5
P.T. 51+45.6

Δ=28°09'
D=16°
T=89.8
L=175.9
P.T. 58+76.6
P.C. 57+86.8
R/C 57+96.3
P.T. 55+91.6

Pl. 55+05.5

Δ=55°05'
D=48°
T=63.3
L=116.4
P.C. 61+40.0
P.T. 62+56.4

Δ=55°24'30"
D=39°
T=90.2
L=180.2
P.C. 57+86.5
P.T. 59+76.7

Δ=40°02'40"

P.O.T. 71+09.8
P.O.T. 79+93.8
A.P. 87+23.5 0°58'R
A.P. 90+73.3 2°16' L
P.O.T. 92+76.3
27+55.2

90°18'10"

Moore

844.34

R/W 45

Pl. 50+38.0

2641.88

N2°06'E

2638.16

N1°58'30"E 2632.34

Road No.(Xc)-(100)-(2303)-4501

S 87°50'35"E 2617.28

T 33 N
R 3 E

2638.36

MON & CASE 74

G 184

685

N2°24'30"E 2640.74

Slough

R/W - 30'

Dry

2645.66

N1°50'20"E

N 1°43'30"E 2637.38

89°44'56"

MON & CASE 74

S87°44'30"E 2643.60

S88°01'26"E 2643.40

1" PIPE Found (61)

Polson Road No. 4060

2" PIPE Found (60)

No. 4060

B 45-38

4' Cottonwood

22.1 F 167 30.0

4' Cottonwood

SECTION 12

TOWNSHIP 33 NORTH, RANGE 3 EAST, W. M.

SKAGIT COUNTY, WASH.

DATE Aug. 5, 1966 — Lloyd Johnson COUNTY ENGINEER

SCALE, 1 INCH = 400 FEET

Notes: 719

S89°34'30"E 2655.5
S89°50'30"E 2638.8 (62)
S89°41'20"E 2632.0

Tack P. Pole (62) — Fin. Nail F. Post (62)

Found 1" Pipe & stake 1' below surface (40)

P. Pole (62) — 39.50

Stub T. Pole (62) — 37.5

Dry Slough

Road #4501 (No. 2303)-(100) (XC)

(J.D.) Moore Road

R/W - 40'

62.3

Tack Tel. Pole (62)

18" Fir Fin. Nail (62)

No. 4080 (No. 2304)-(7)

N89°09'40"E 2699.76
N89°34'E

88°34'

(No. 2307)-(687)

No. 4561 (Skagit City & Fir Road No. C1)

2626.6

Notes: 971 452 G 184

Herdshell: A - 18/12

2631.83

N0°45'50"W

← 5319.79 →

MON. CASE 74 180°15'

N89°15'50"E

T-33-N R-3-E 12

2670.06

Road

Note: This Tracing Drawn From Aerial Photo - Not to Scale----

Notes: G 184

2631.83

N0°45'50"W

City

R/W - 40'-60'

2626.6

P. Pole (60) — 97.30 — 110.0 — 94.00 — P. Pole (60)

MON. CASE (74)

Skagit

92°13'30"

P. Pole (60) — 75.45

Set 1" Pipe 9/12/45 Found 1" pipe 1960

11 12 14 13 — Polson Road — 12 7 13 18

S89°16'E 2631.6
S89°28'30"E

(Olof Polson Road No. 37)

1¼" Pipe 3/4" Bolt (61)

(No. 2306)- No. 4060

N89°23'20"
2642.75
N87°46'30"E

MON.

21.30 — 94.30 — Gate Post (45) — F. Post (45)

182°45'

21.60 — T. Pole (60)

SECTION 12


TOWNSHIP 33 NORTH, RANGE 3 EAST, W. M.

SKAGIT COUNTY, WASH.

G 184 - B 22 - B 28 - B 31
8-20 568

SCALE, 1 INCH--400 FEET

H.O. Walberg COUNTY ENGINEER

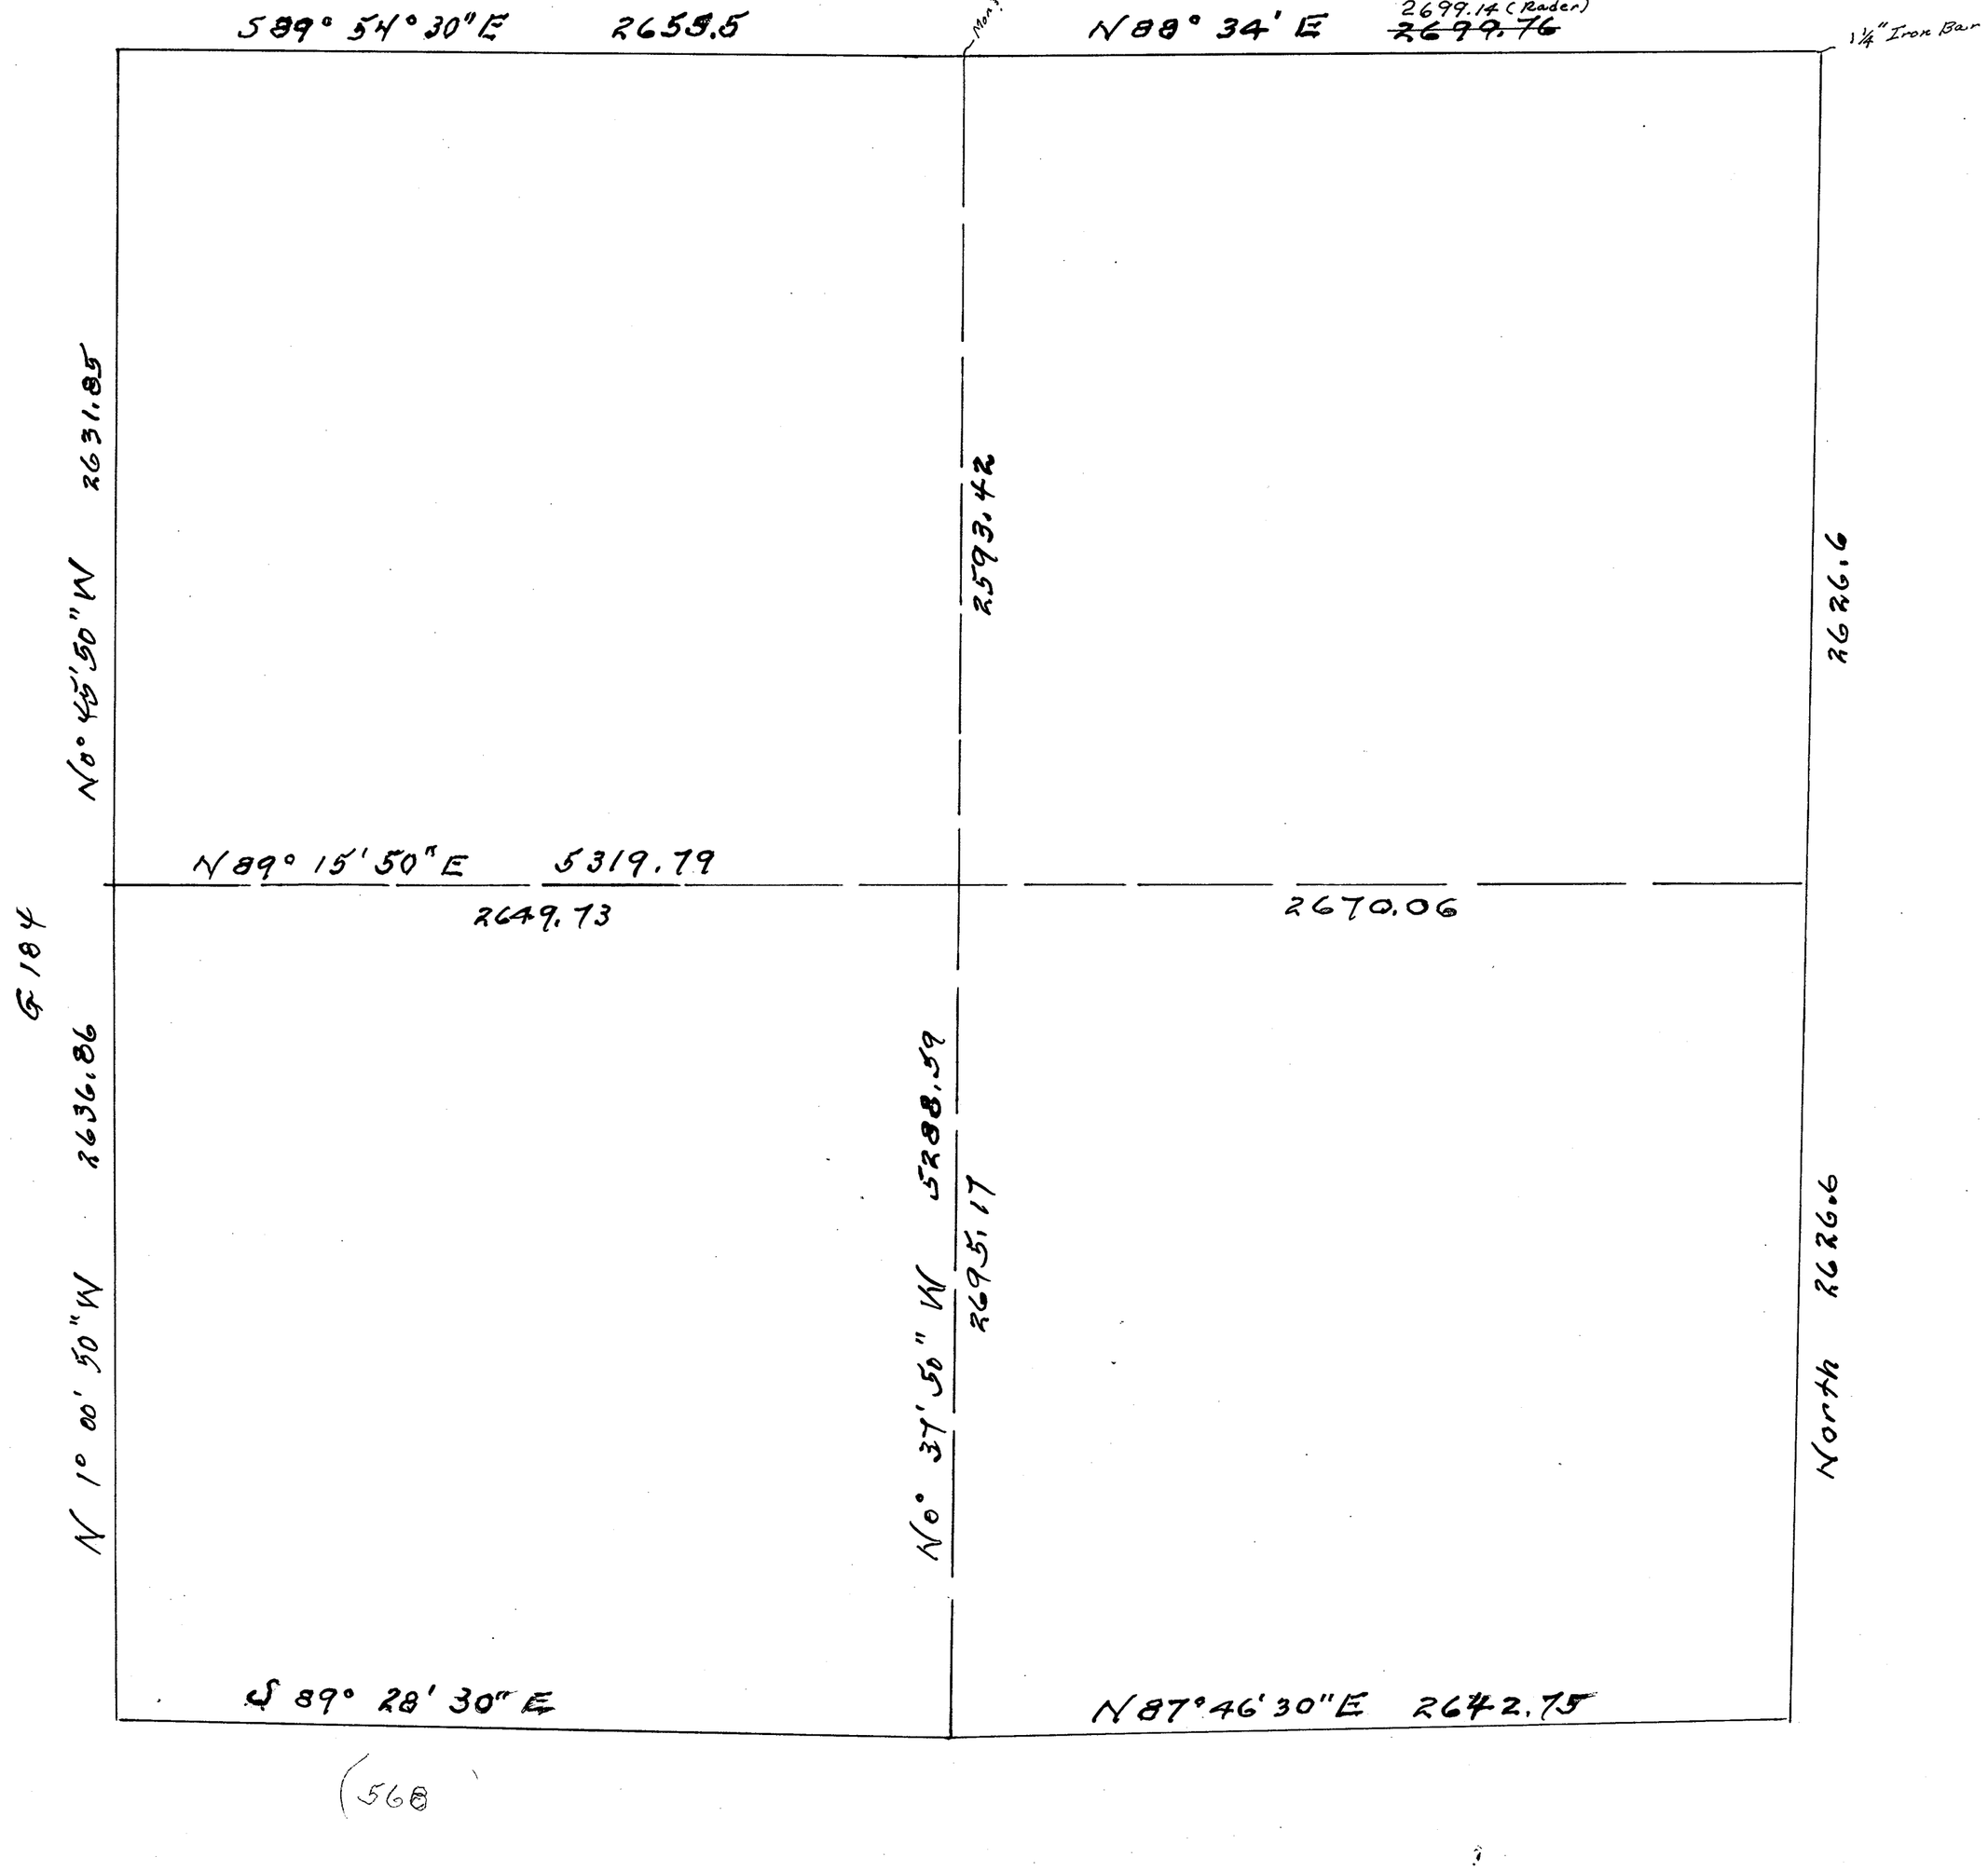

568

SECTION 12

TOWNSHIP 33 NORTH, RANGE 5 EAST, W. M.

SKAGIT COUNTY, WASH.

G184 B22 B24 B31
8-20 568

SCALE, 1 INCH–400 FEET

Robt. E. L. Knapp 1930 COUNTY ENGINEER

N6764.40
E9183.73

S-20

2655.5

S89°54'30" E

6764.15
3513.73

N 88° 34' E

2699.76

88°34'

2631.85

N 0°00'50" W

N 3670.89
E 3602.81

N89° 15'50"E 5319.79

2649.73

2670.06

180°00'

3705.08
6272.65

179.45'

G184

N 3000

S 0°37'50" E

2636.86

2625.65

2695.17

2626.6

N 975.88
E 3631.89

S89°28'30"E 2632.0

N 81°46'30" E 2647.75

2642.75

92°13'30"

1074.48
6971.65

1" pipe

N 1000
E 1000

II 12

Olaf Polson Road No. 37 40 Wide

2632.0 by J.W. Meehan

1622.4 by J.W. Meehan

MC.

1622.9

14 13


185°35'

SECTION 13

TOWNSHIP 33 NORTH, RANGE 3 EAST, W. M.
SKAGIT COUNTY, WASH.

SCALE, 1 INCH = 400 FEET
Road No. 28 from Notes No. 876

Robt. E. L. Knapp 1930 COUNTY ENGINEER
Sub-Division & No. 28 added Sept. 1958

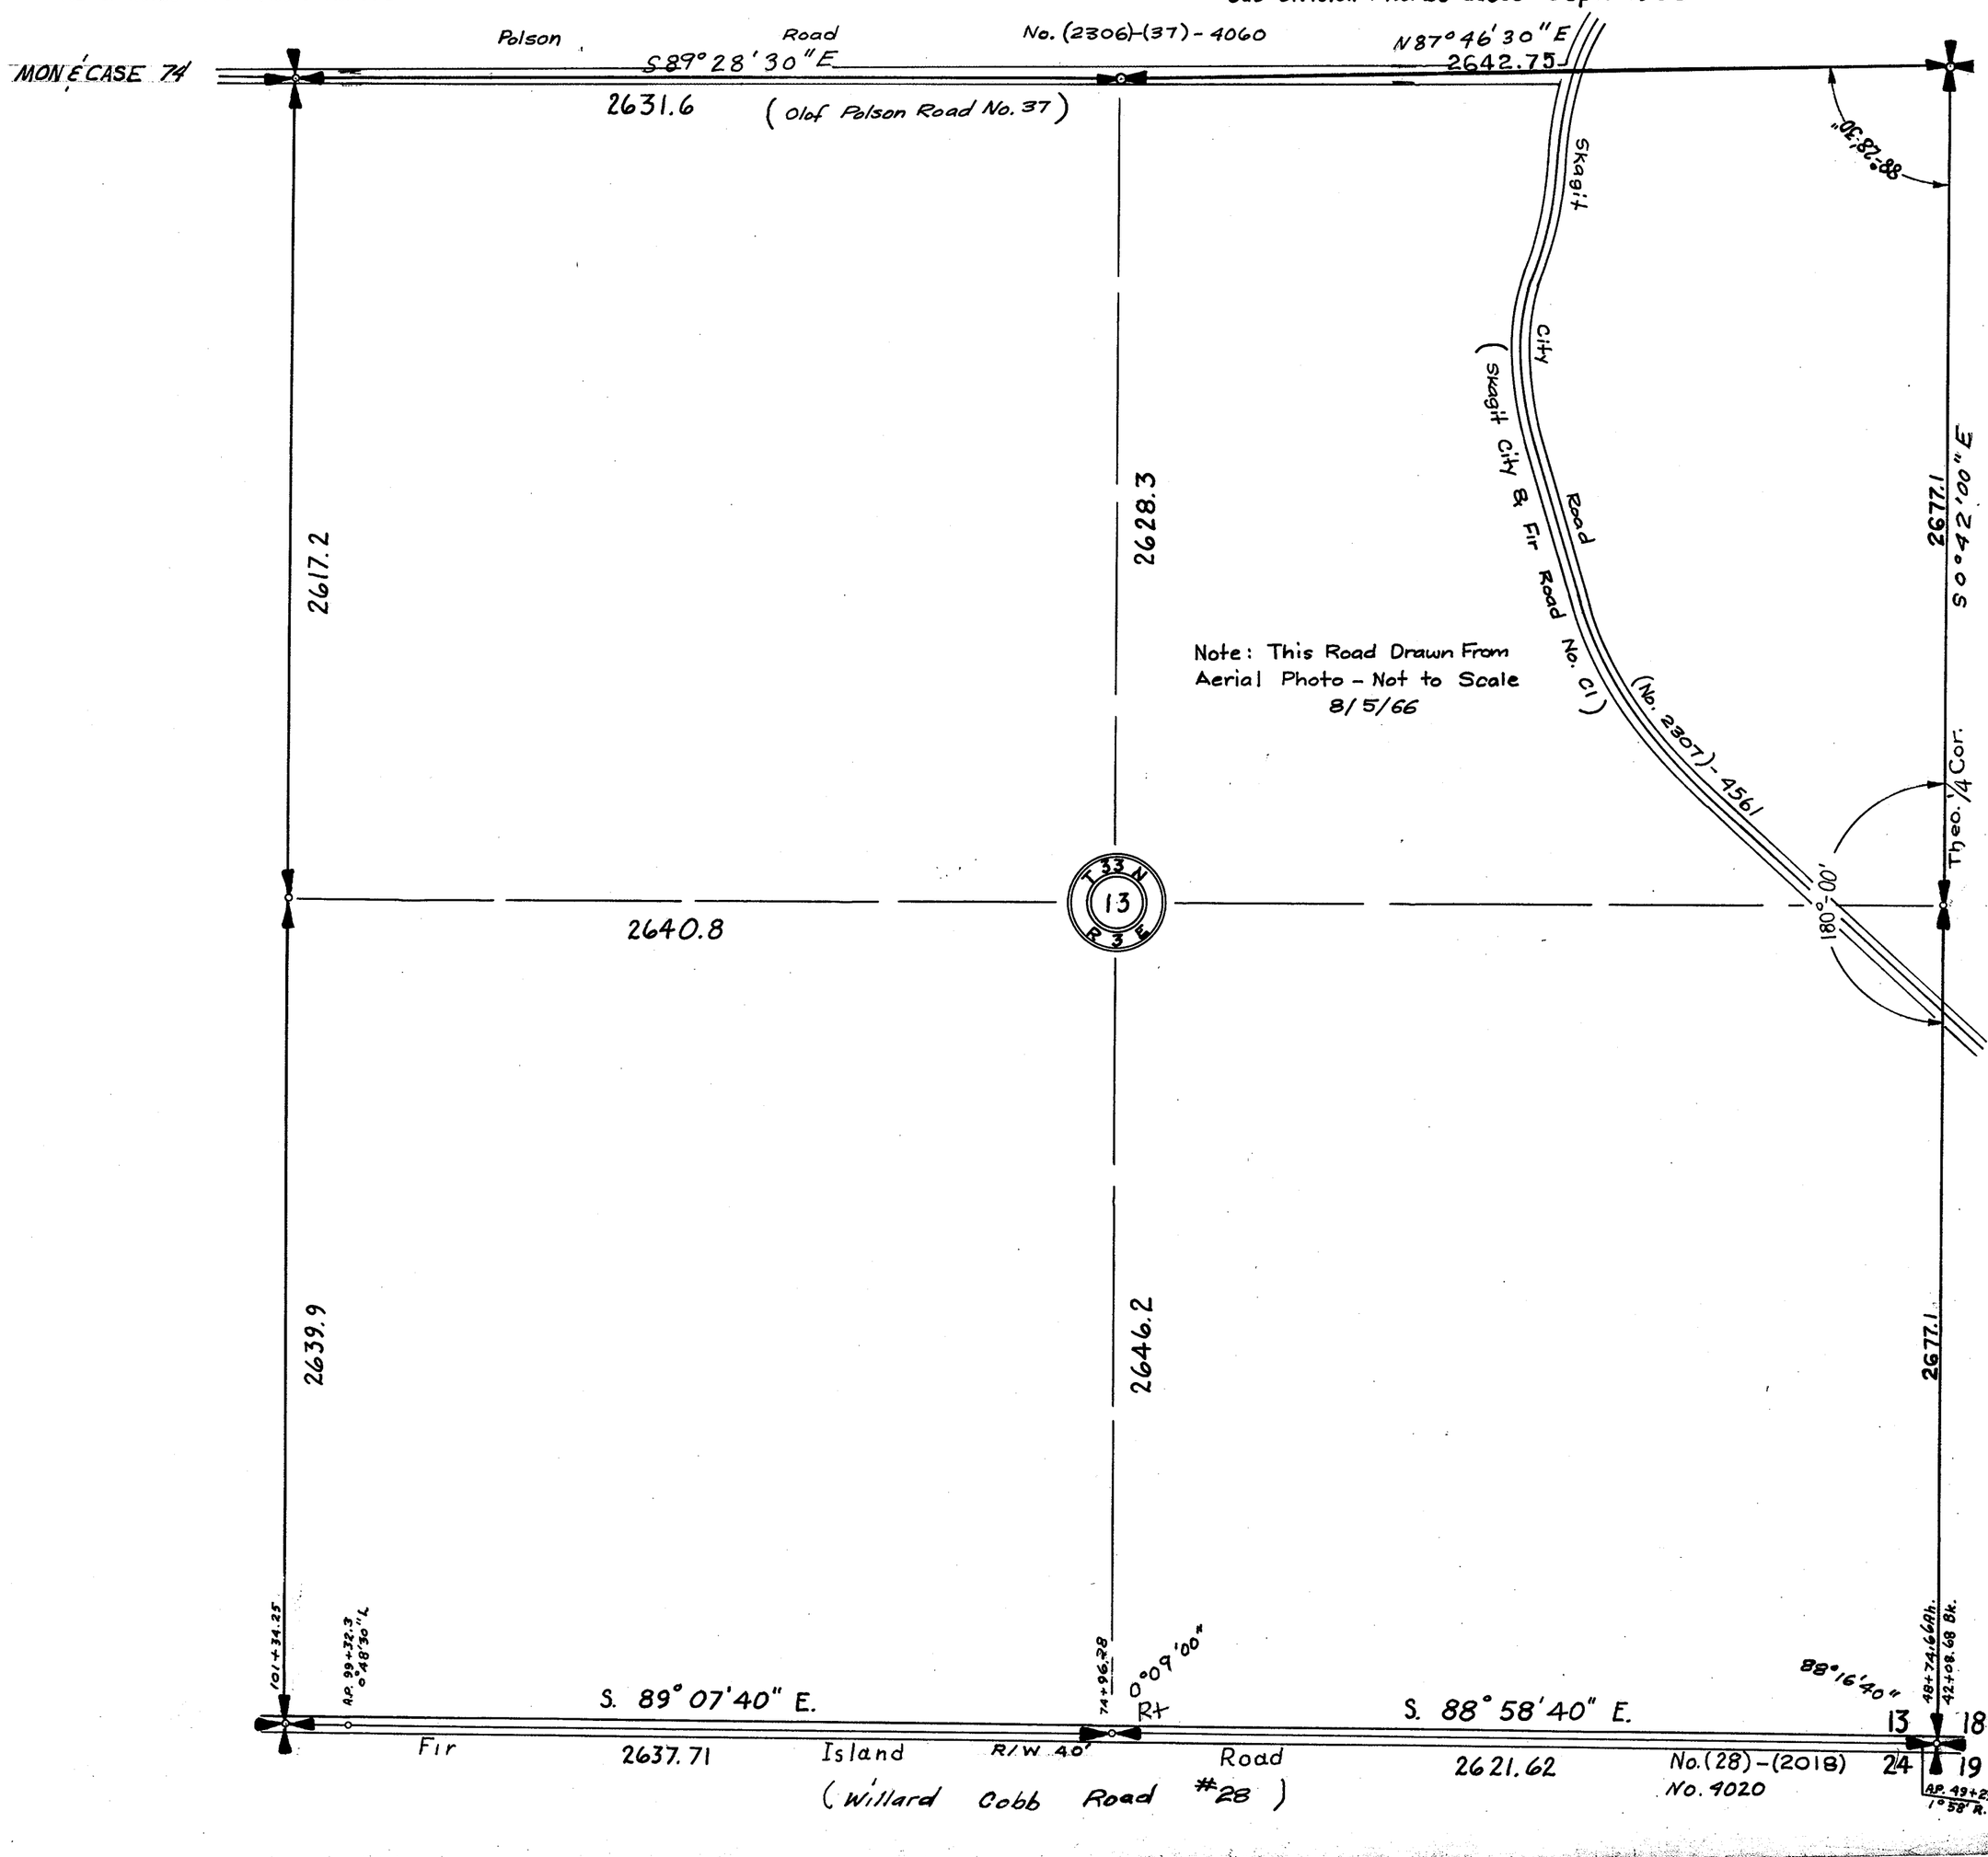

SECTION 14

TOWNSHIP 33 NORTH, RANGE 3 EAST, W. M.

SKAGIT COUNTY, WASH.

SCALE, 1 INCH--400 FEET

DATE Aug. 7, 1966

Lloyd Johnson COUNTY ENGINEER

MON. CASE 74

1¼" Pipe Found 1950 1960

(Bert Hanson Road No. 292)

P. Pole

749.4

Polson Road

S87°44'30"E

S88°38'50"E 2642.9

S88°01'30"E 2643.3

30.0

22.1

4' Cottonwood

4' Cottonwood

20.30

94.30

Gate Post (50)

F. Post (50)

P. Pole (50)

449.60

2" Pipe Found 1960

No. 4060

(No. 2306)-(37)

S89°15'10"E (W) 2643.30

S88°01'26"E 2639.1

20.80

247.30

Tel. Pole (50)

Tel. Pole (50)

Car Axle Spike (60)

1" Pipe Found (61)

20.30

94.30

Gate Post

Fence Post

NOTES:

765

685

Hardshell A - 19/12

Dry Slough

T-33-N

14

R-3-E

Note: This Tracing Drawn From Aerial Photo – Not to Scale ------

N 1°32' E

R/W - 30'

N 1°23' E

Road No. (2303)-(100)(ZC) 4501

MON. Plug in Pavement + (1951) 2.6' N & of Pavement +

9.16'

N 89°04'10"W 2641.9

Fir Island Road

No. (2018)-(28)-(1018)-4020

R/W - 40'

(Willard Cobb Road No. 28)

N 89°43'13"W 2631.8

S89°51'55"E 2639.89 (1964)

SECTION 14
TOWNSHIP 33 NORTH, RANGE 3 EAST, W. M.
SKAGIT COUNTY, WASH.

MONECASE 74

SCALE, 1 INCH--400 FEET

DATE Aug. 21, 1963

COUNTY ENGINEER

1 1/4" Pipe Found 1950 1960

S 87°44'30" E
S 88°58'50" E (M) 2642.9
S 88°01'30" E 2643.3

Gate Post (50)

20.30

94.30

F. Post (50)

79.40

22.7

30

4' cottonwood

4' COTTON

P.Pole

P.Pole (50) 63.20

2" Pipe Found 1960

1318.0

S 89°15'10" E (M) 2643.30
S 88°01'26" E 2639.1

20.80

247.30

Tel. Pole (50)

Tel. Pole (50)

Car Axle
.1" Pipe Found 1960

20.30

94.30

F. Post

Gate Post

Notes: 765
685

Haedshell A-18/12

(No. XC) No. (100)-(2303)-4051

Road

T-33-N
14
R-3-E

Slough

R/w - 30'

N 1°32'E

Dry

Mon. plug in pavement (1951)

90° 16'

N 1°23'E

Fir Island Road (1964) S 88°51'55"E 2633.89 (No. 28) No. 4020

N 89°04'10"W 2641.90'

N 89°43'13"W 2631.8

R/w - 40

(Willard Cobb Road No. 28)

1/4 COR. IS 2.6' N & OF Pavement

SECTION 15

TOWNSHIP 33 NORTH, RANGE 3 EAST, W. M.

SKAGIT COUNTY, WASH.

DATE Aug. 8, 1966 — Lloyd Johnson COUNTY ENGINEER

SCALE 1 INCH--400 FEET

Found 1½" Pipe
Set 1½" Pipe (55)
1.5' below surface (50)

(62) P. Pole — 164.10
T. Pole (50) — 28.2°
P. Pole (62) — 74.4
P. Pole (50) — 75.5

Rawlins Road
(No. 1304)
NO. 4040

S87°44'30"E 2660.35 (52)
S89°07'37"E 2529.61 (62)

P. Pole (50) — 71.4
4' COTTON — 22.7
4' COTTON — 30.0

1/16 Corner - Found 4"x4" Post
set 1½" Pipe - ½' below surface

1/4 COR. 4"x4" Cedar
Post Scribed (30)

S89°28'27"E 2656.97 (62)

No. 4060

Polson Road (No. 2306)
(Olof Polson Road No. 37)
R/W - 60'-30'

T. Pole (55) — 28.20
P. Pole (55)
MON. & CASE
1½" Pipe
1.5 down

No. (2018)-4020

Brown's Island Road (& Skagit River Road No. 111)
R/W - 40'

Notes:
710
685
717

Handshell: A-18 1/12

T-33-N
15
R-3-E

Note: This Tracing Drawn From
Aerial Photo - Not to Scale.....

P. Pole — 56.6
N.0°55'E Fir
(Loveland Road No. 82)
R/W - 38'
1½" Pipe

Maupin Road
No. (1307)-4381
(298)
T. Pole — 30.70
21.6
36.70
Granary

Fir Island Road
No. (2018)-(28)-4020

(Loveland Road No. 82)
N87°45'W 2672.6
S89°28'50"W 2656.39
R/W - 33'

(Willard Cobb Road No. 28)
PLUG IN PAVEMENT
N89°31'W 2694.9
N89°26'38"W 2699.29
R/W - 40'

MON. EDGE PAVT.

SECTION 16
TOWNSHIP 33 NORTH, RANGE 3 EAST, W. M.
SKAGIT COUNTY, WASH.

SCALE, 1 INCH--400 FEET
Road No. 298 from Notes No. 826
Road No. 28 from Aerial Photo

G. D. LeGro COUNTY ENGINEER
September 1958

Ford Axle
Drove in old Post
(42)

N. 89°26'30" E. 1329.9 MON & CASE (74) N. 89°41' E.

1292.3 2622.2 Rawlins Road 2752.59 R/W-40'

No.(1304)-4040

1½" PIPE

No.(28)-(1018)-4020

(No. 298)-(No. 1307)-No. 4381

N. 0°49' E. 4411.4

N. 0°52'55" E. 2653.23

(Brown's Slough & Skagit River Road No. 111)
Island Road R/W-40'

N. 2°05'41" E. 2641.22

T 33 N
16
R 3 E

S. 89° 22' 30" W. 2697.05

L. R. Maupin Road R/W 33'

N. 0°52'55" E. 2626.47

Fir

(Loveland Road No. 82)

N. 2°00'22" E. 2659.93

R/W (44') R/W 33'

49+61.3

47+81.7

Pl. 41+43.2

No. 1307

N. 89° 55'30" W.

R/W 33' 2644.2

(No. 28)

1/2" PIPE
Found 1' below surface (54)

21.6 54

GRAINARY

SECTION 17

TOWNSHIP 33 NORTH, RANGE 3 EAST, W. M.

SKAGIT COUNTY, WASH.

SCALE, 1 INCH -- 400 FEET

DATE August 1968

Lloyd Johnson COUNTY ENGINEER

Brass Mon.

Rawlins Road No. 4040 R/W - 33'

T 33 N
17
R 3 E

1¼" pipe Drainage ditch intersection

SKAGIT BAY


SECTION 21

TOWNSHIP 33 NORTH, RANGE 3 EAST, W. M.

SKAGIT COUNTY, WASH.

SCALE, 1 INCH--400 FEET

DATE 3 SEPT. 1968 Lloyd Johnson COUNTY ENGINEER

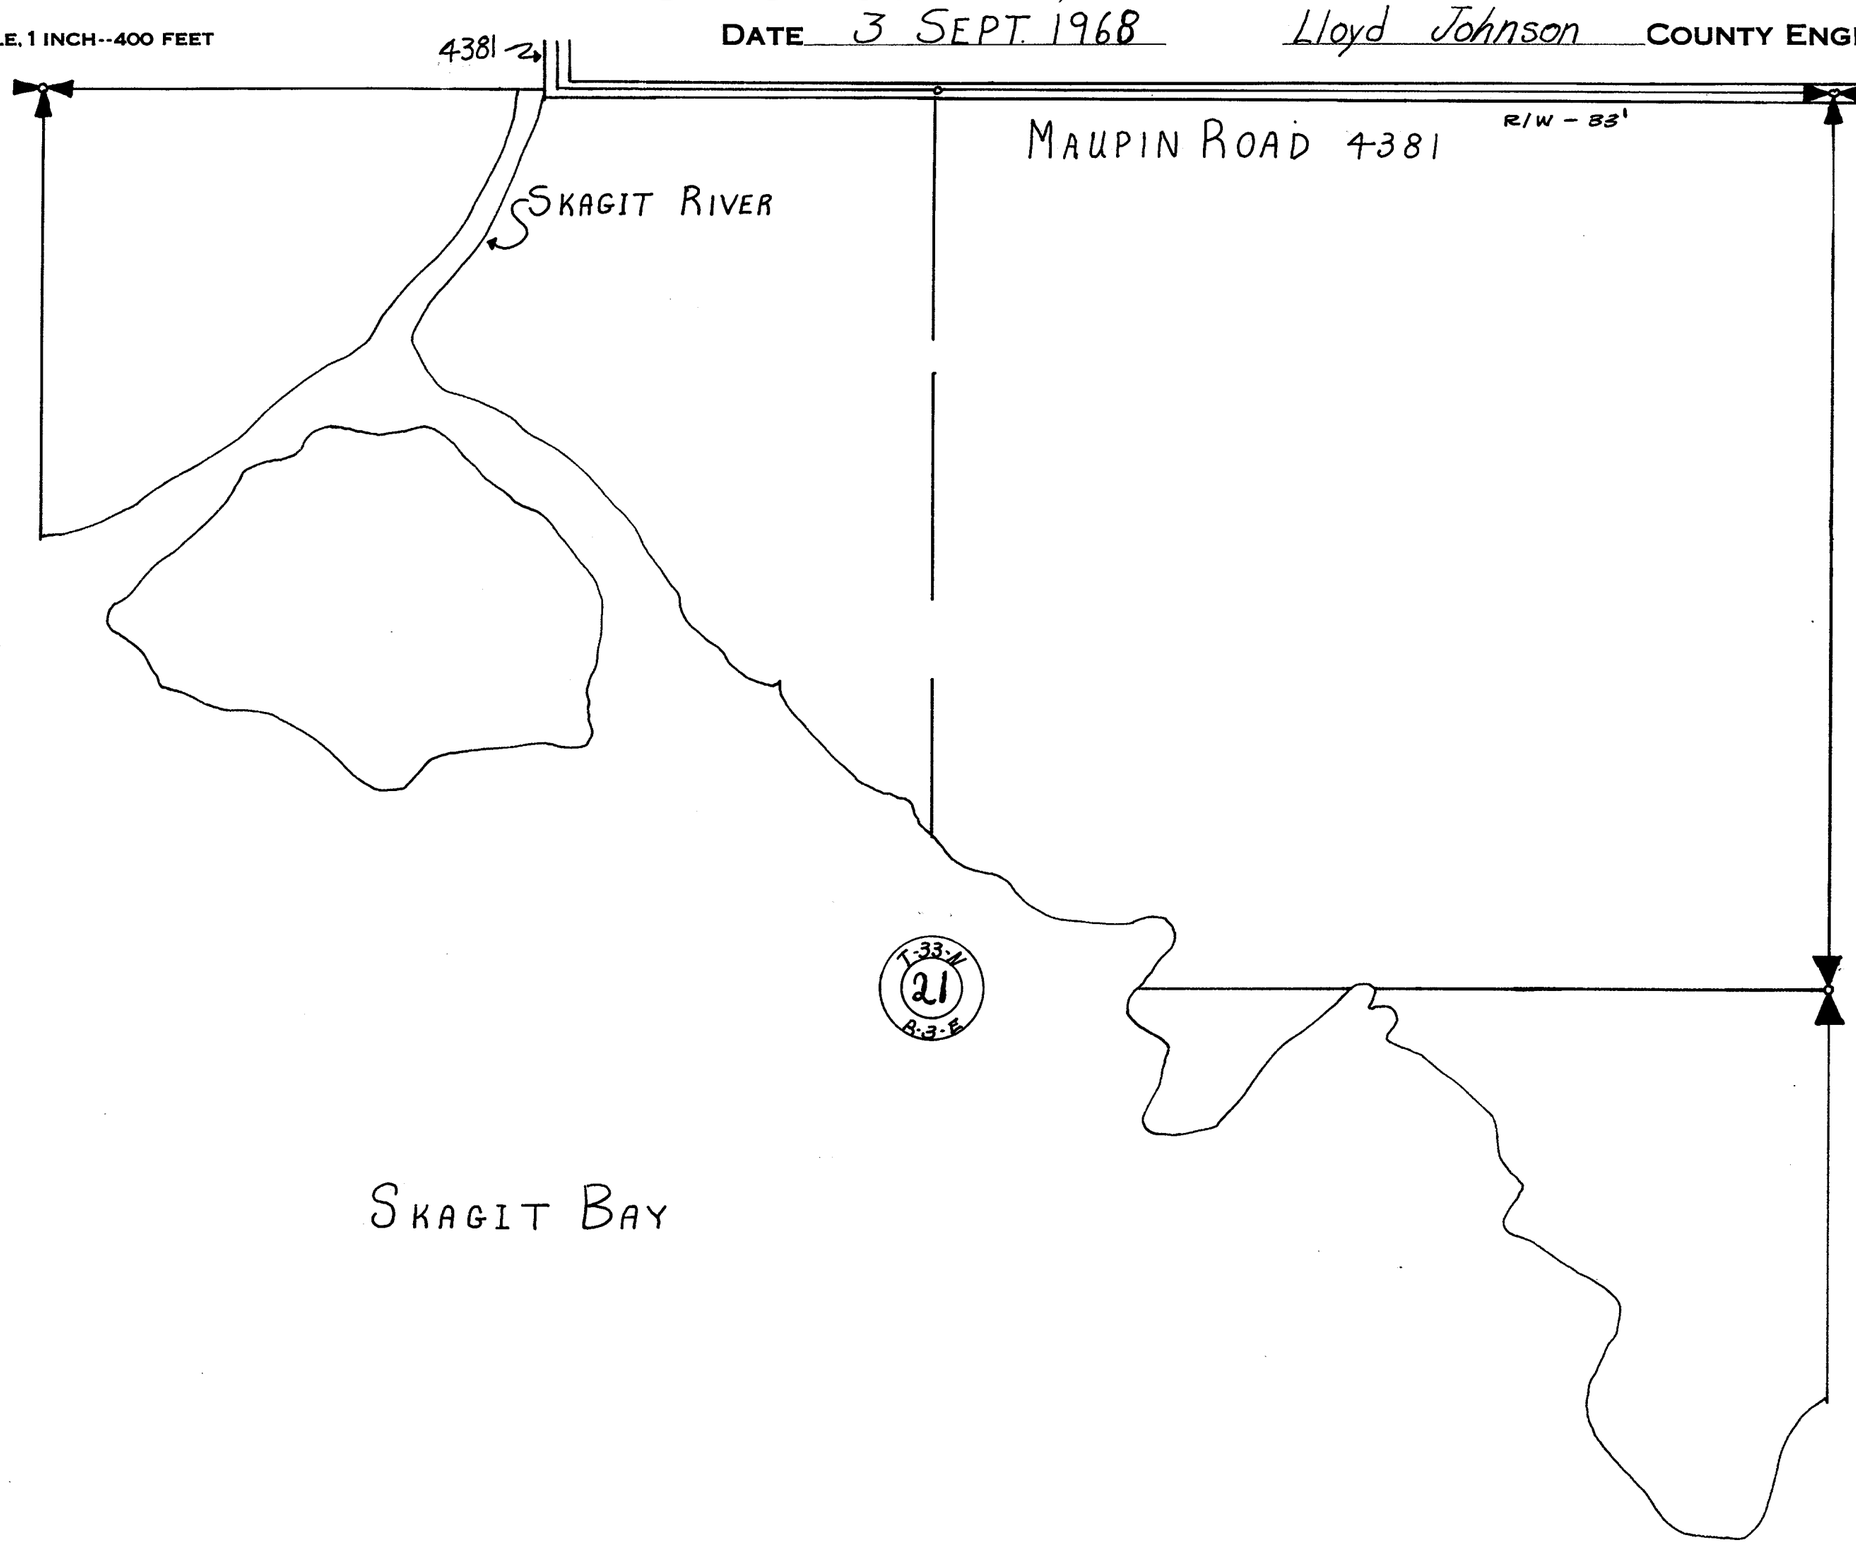


SECTION 22

TOWNSHIP 33 NORTH, RANGE 3 EAST, W. M.

SKAGIT COUNTY, WASH.

SCALE, 1 INCH--400 FEET
Road No. 28 from Bk. 95, see Revisions Notes No. 876

G. D. LeGro
Sept. 1958
COUNTY ENGINEER

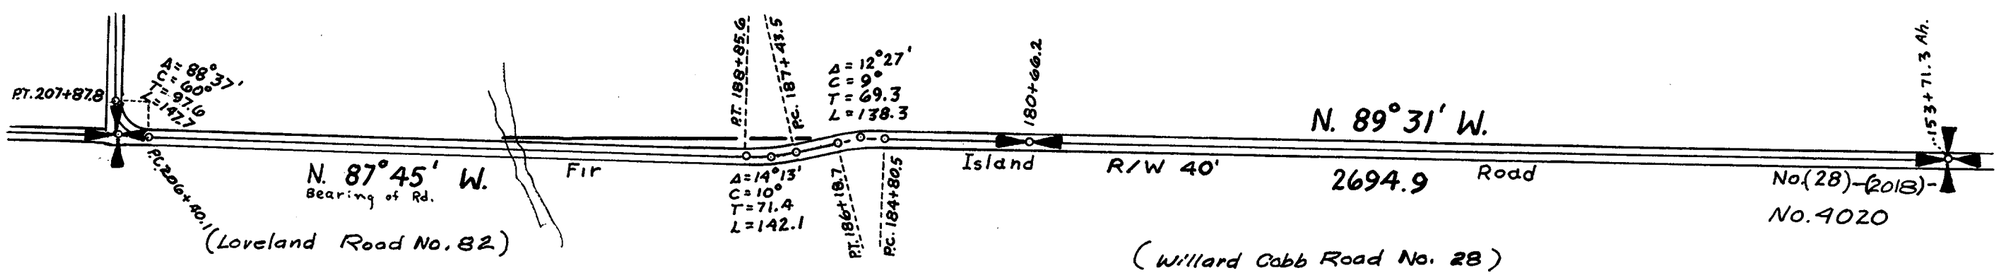

SECTION 23


TOWNSHIP 33 NORTH, RANGE 3 EAST, W. M.

SKAGIT COUNTY, WASH.

SCALE, 1 INCH--400 FEET

H.O. Walberg COUNTY ENGINEER

Sub-Division #No.28 added Sept 1958

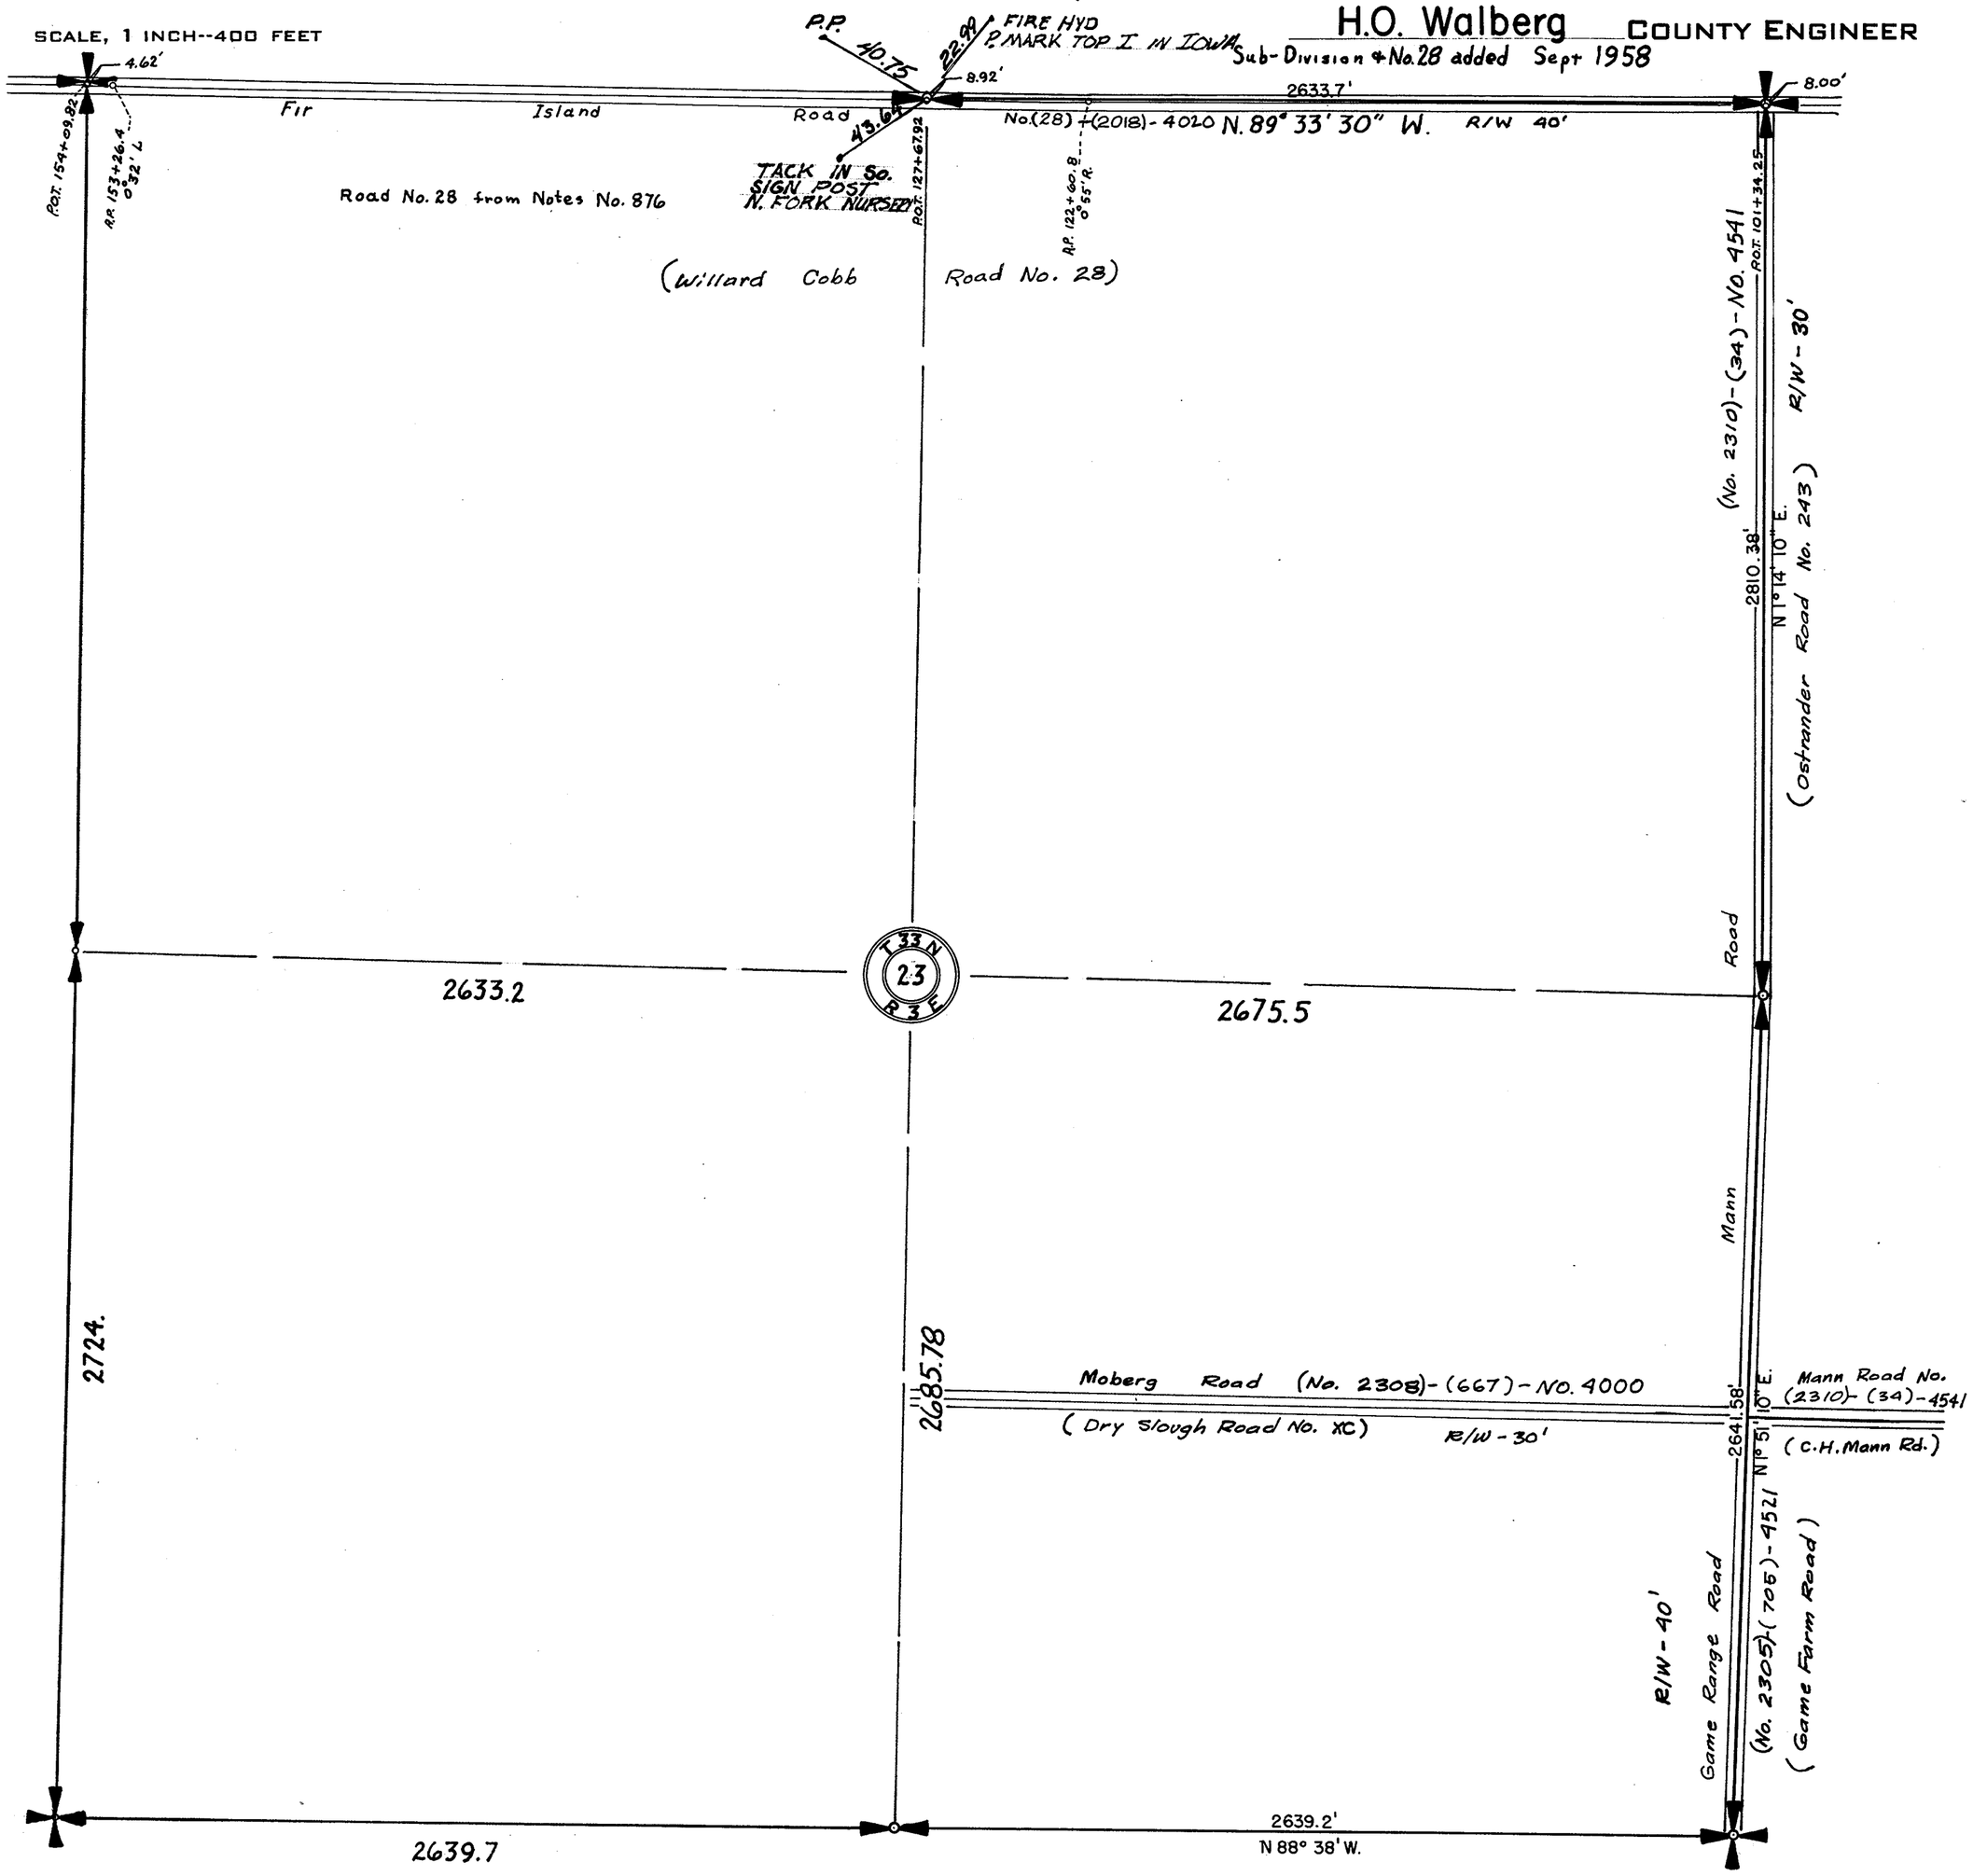


SECTION 23

TOWNSHIP 33 NORTH, RANGE 3 EAST, W. M.

SKAGIT COUNTY, WASH.

SCALE, 1 INCH–400 FEET

A. L. STRONG, COUNTY ENGINEER

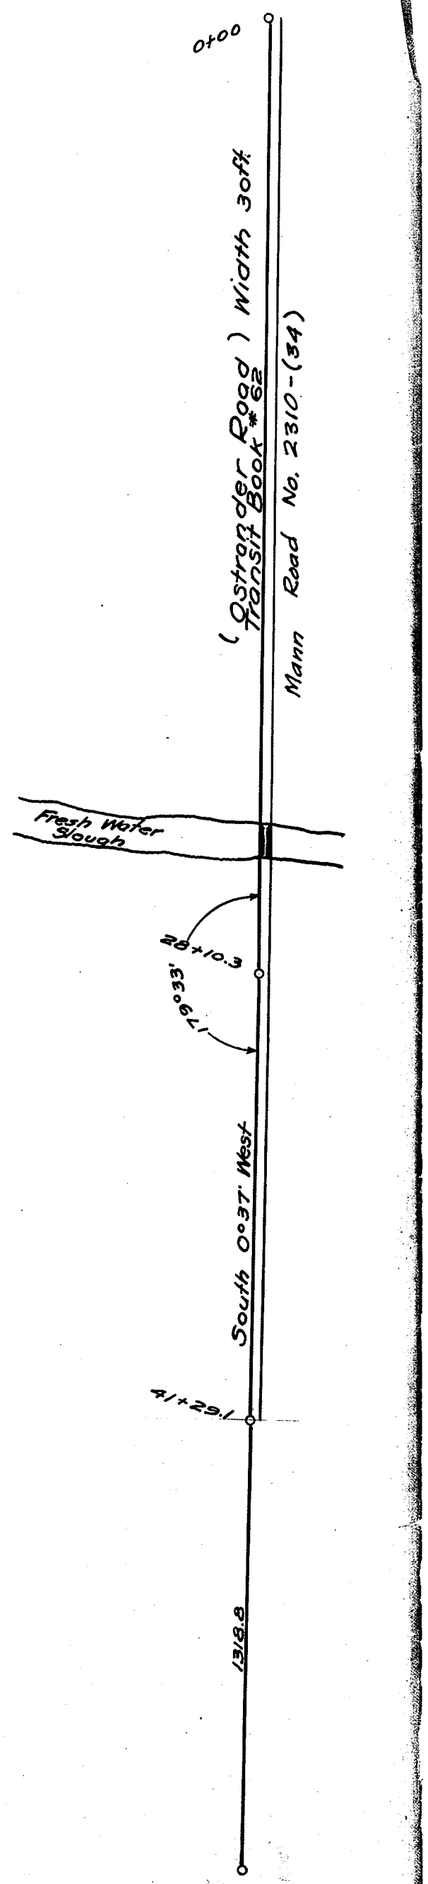


SECTION 24

TOWNSHIP 33 NORTH, RANGE 3 EAST, W. M.

SKAGIT COUNTY, WASH.

H.O. Walberg COUNTY ENGINEER

SCALE, 1 INCH--400 FEET
Road No. 28 from Book 95, p32 : Consolidation sept. 1958
Subdivision from 46/602

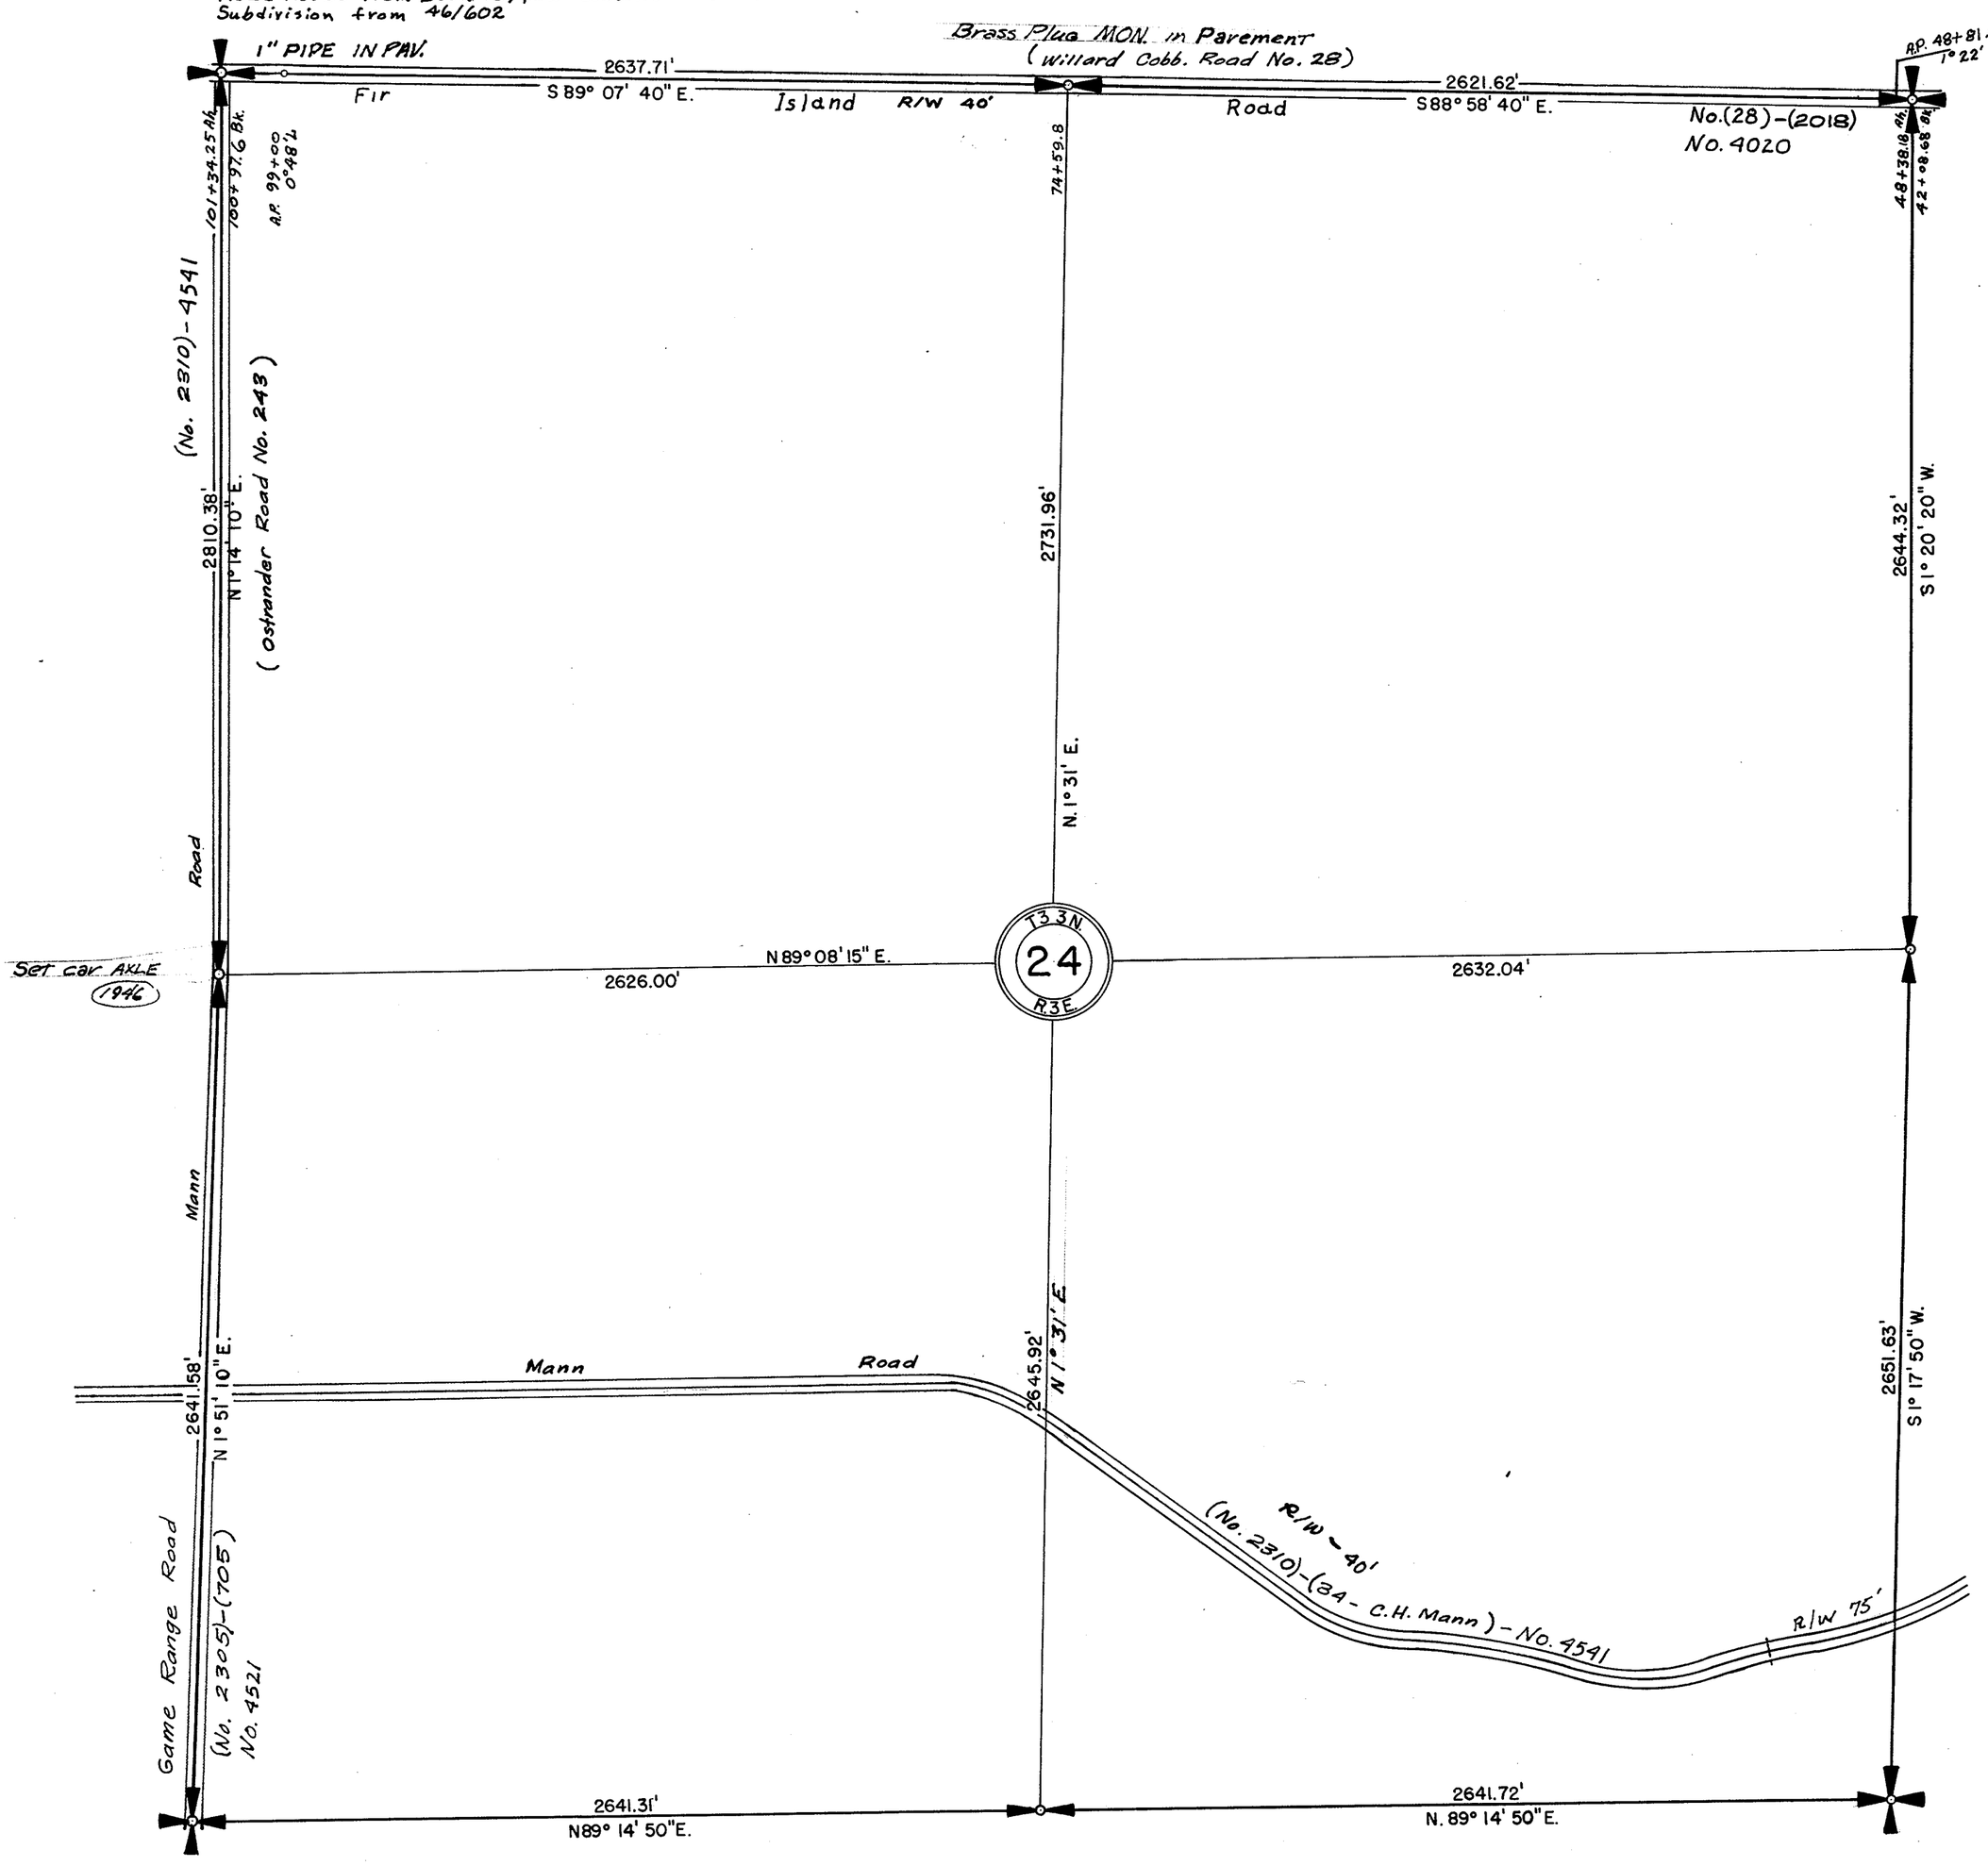


SECTION 24

TOWNSHIP 33 NORTH, RANGE 3 EAST, W. M.

SKAGIT COUNTY, WASH.

SCALE, 1 INCH–400 FEET

A. L. STRONG. COUNTY ENGINEER

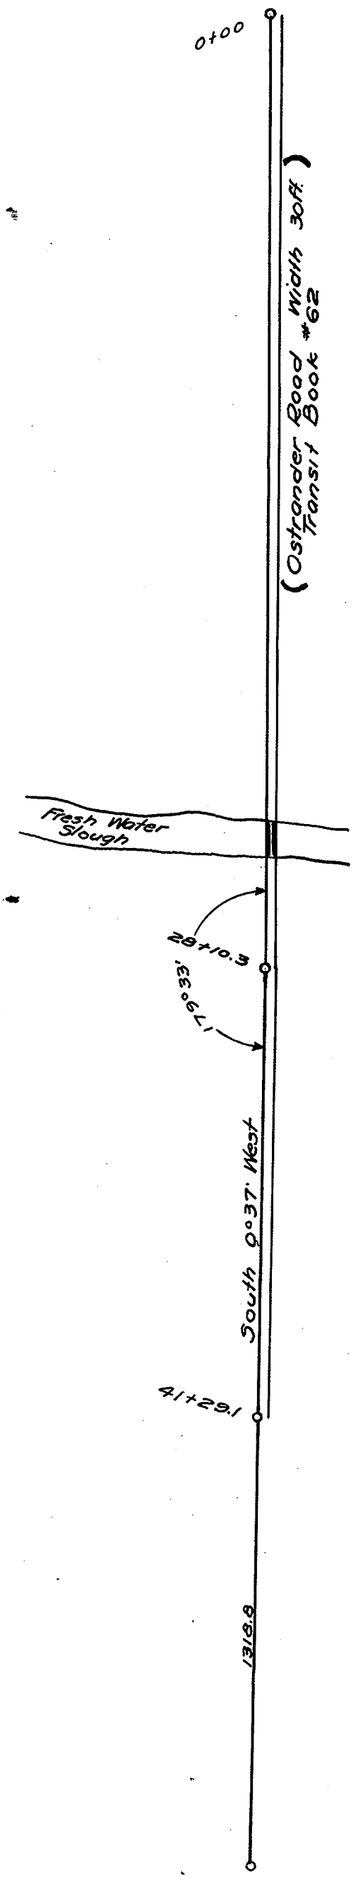

SECTION 1


TOWNSHIP 33 NORTH, RANGE 4 EAST, W. M.

SKAGIT COUNTY, WASH.

SCALE, 1 INCH -- 400 FEET

DATE Aug. 23, 1966

Lloyd Johnson COUNTY ENGINEER

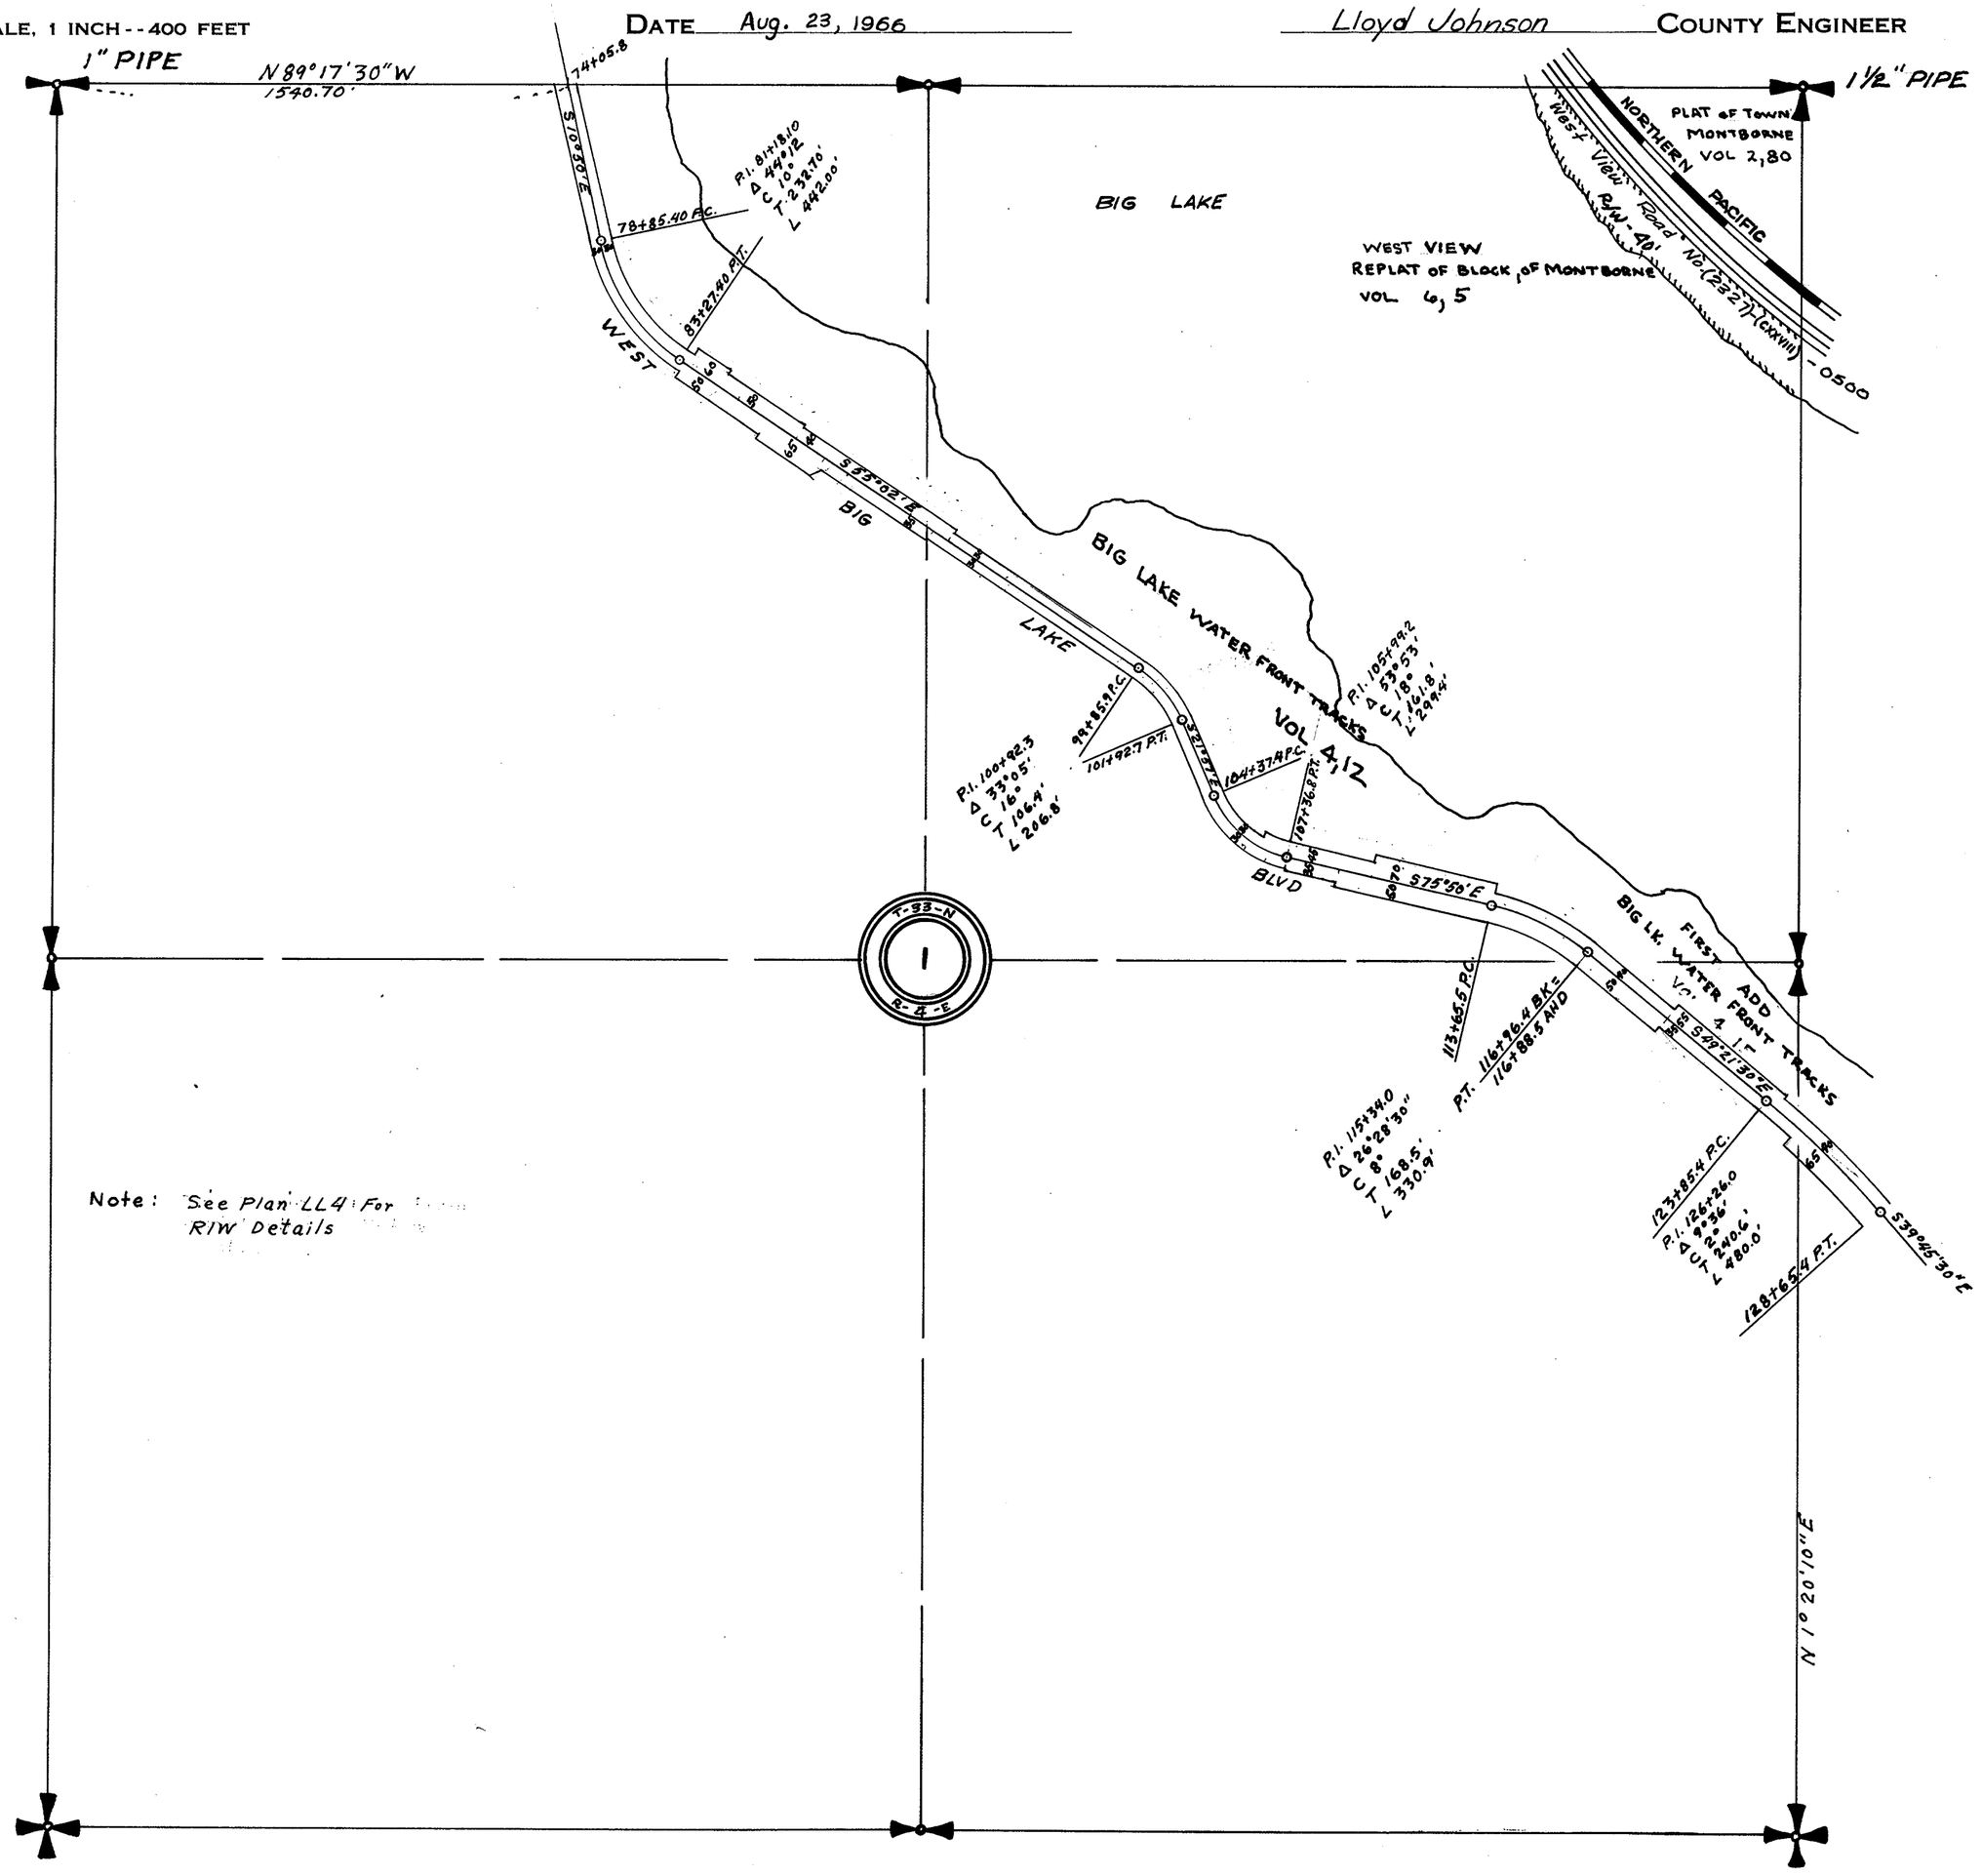

Note: See Plan LL4 For R/W Details

SECTION 2


TOWNSHIP 33 NORTH, RANGE 4 EAST, W. M.

SKAGIT COUNTY, WASH.

SCALE, 1 INCH--400 FEET

DATE June 21, 1963

_____ COUNTY ENGINEER

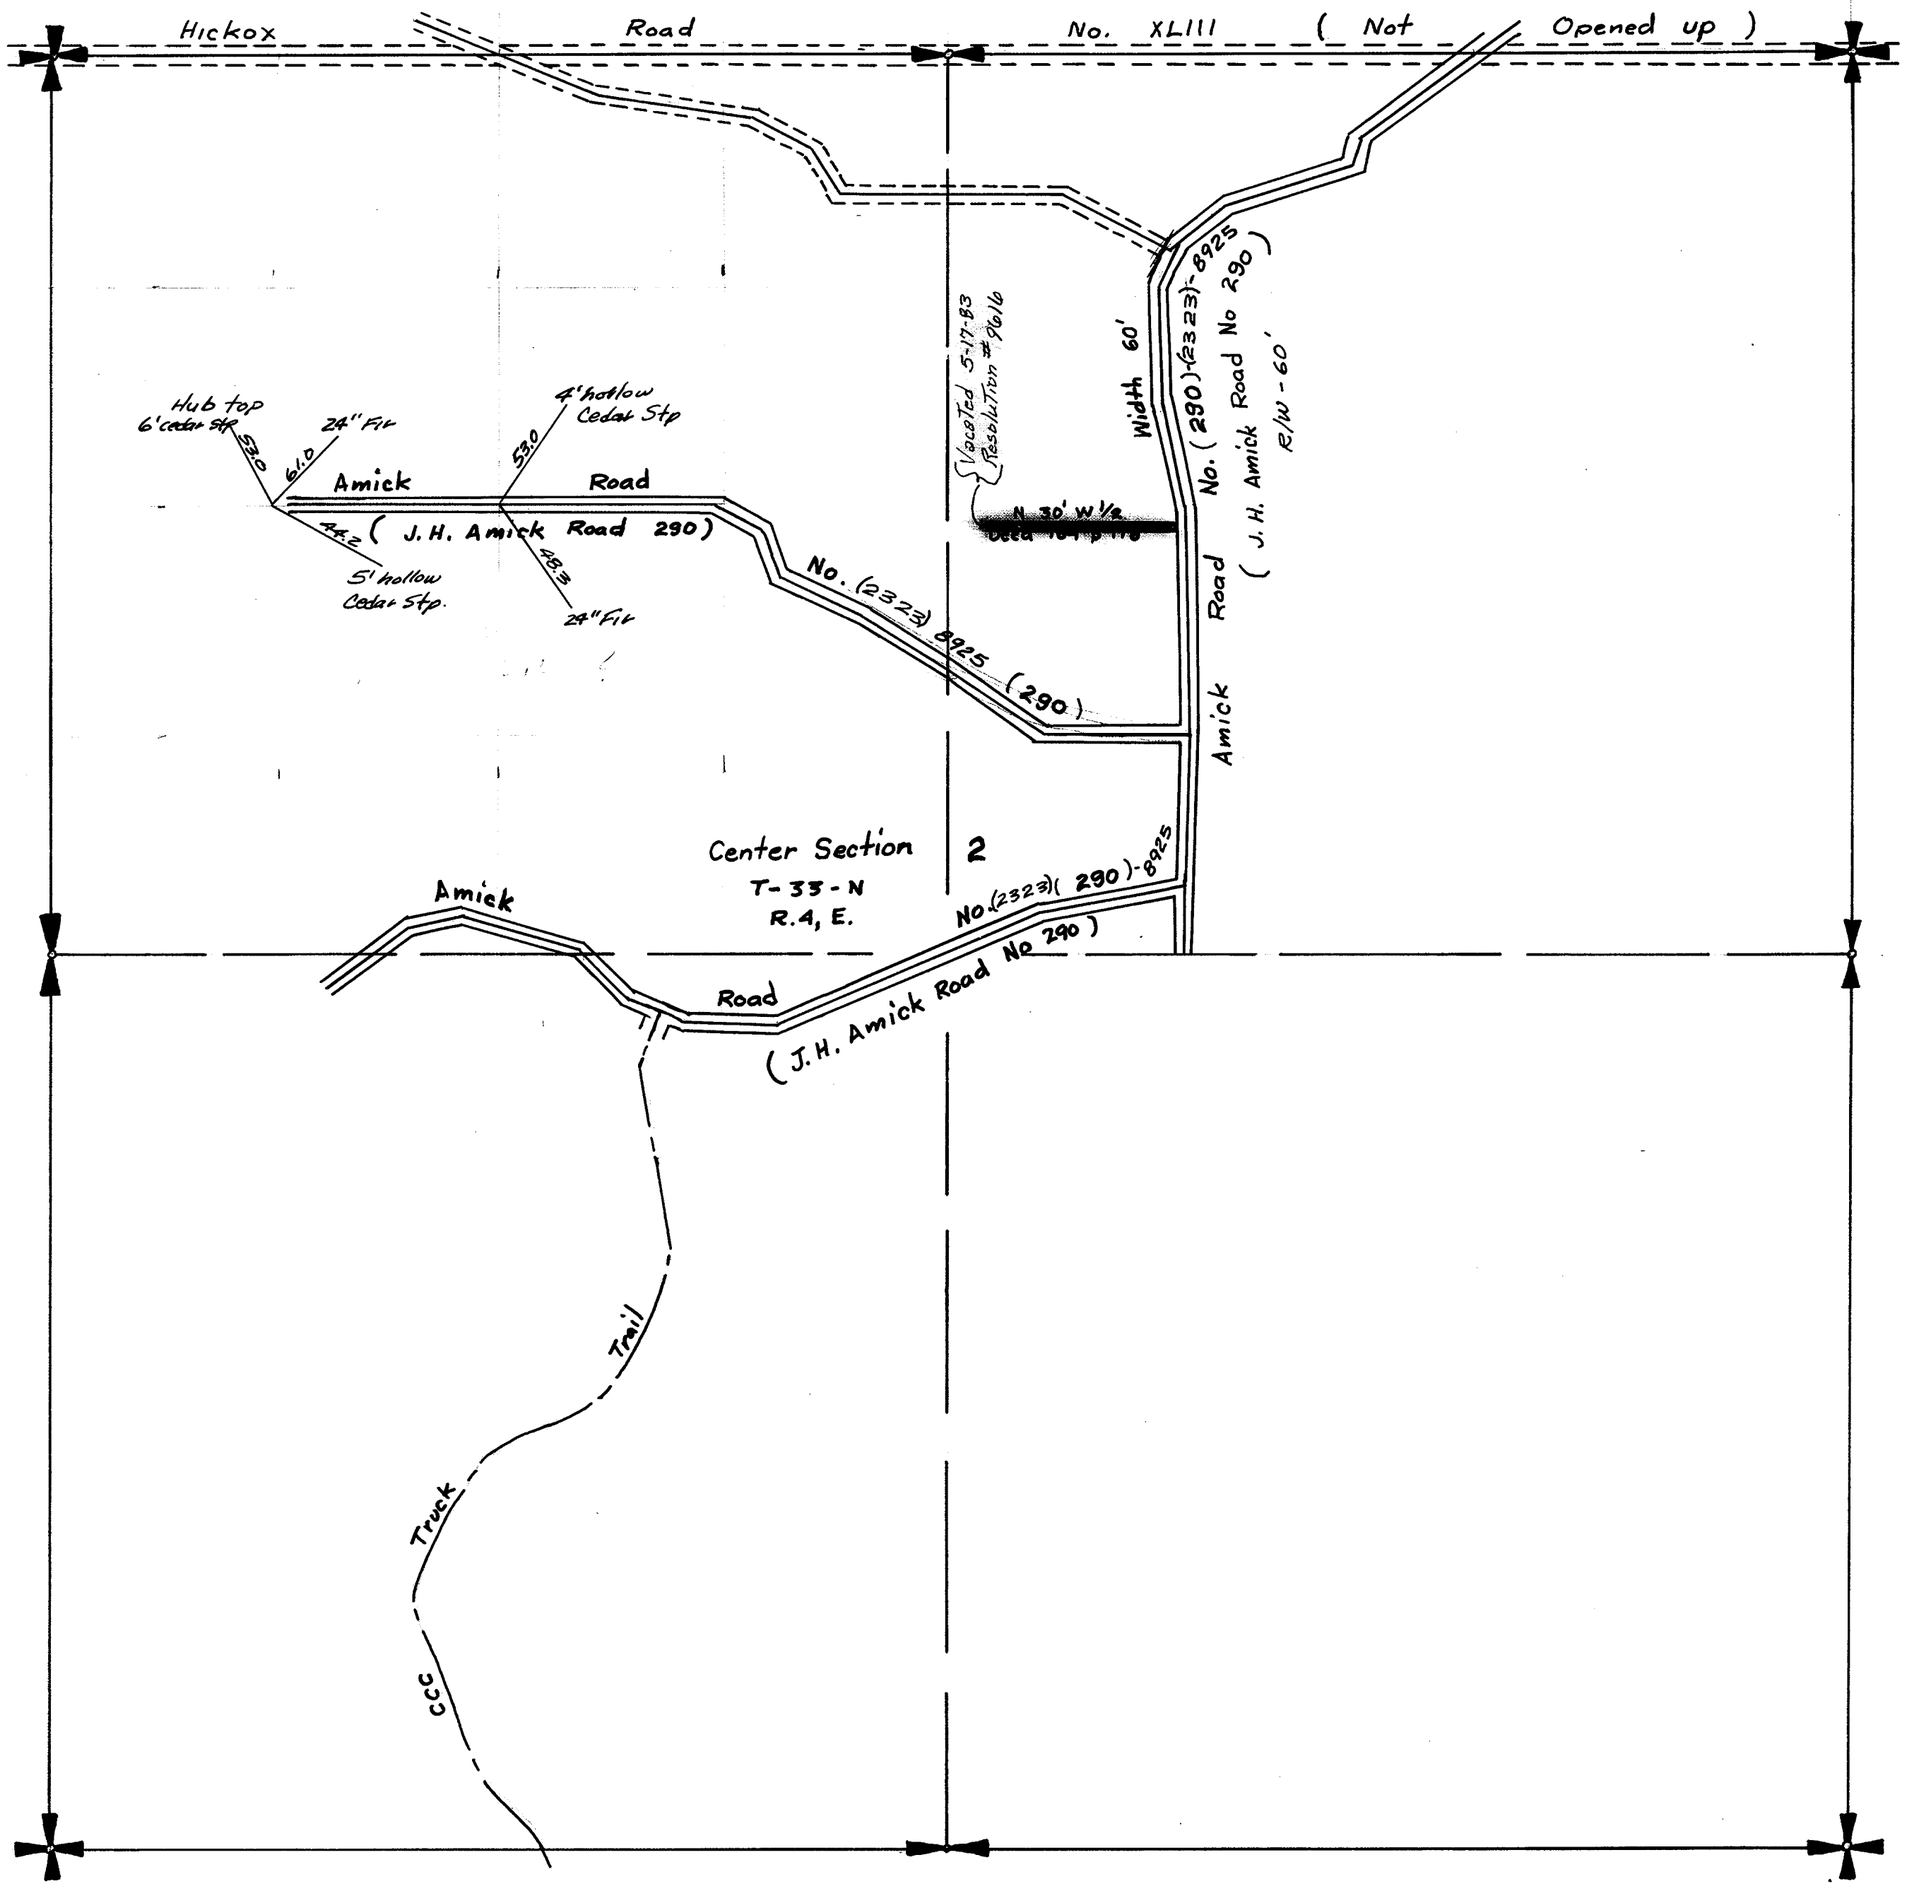

SECTION 4


TOWNSHIP 33 NORTH, RANGE 4 EAST, W. M.

SKAGIT COUNTY, WASH.

SCALE, 1 INCH--400 FEET

DATE Aug. 15, 1966

Lloyd Johnson COUNTY ENGINEER

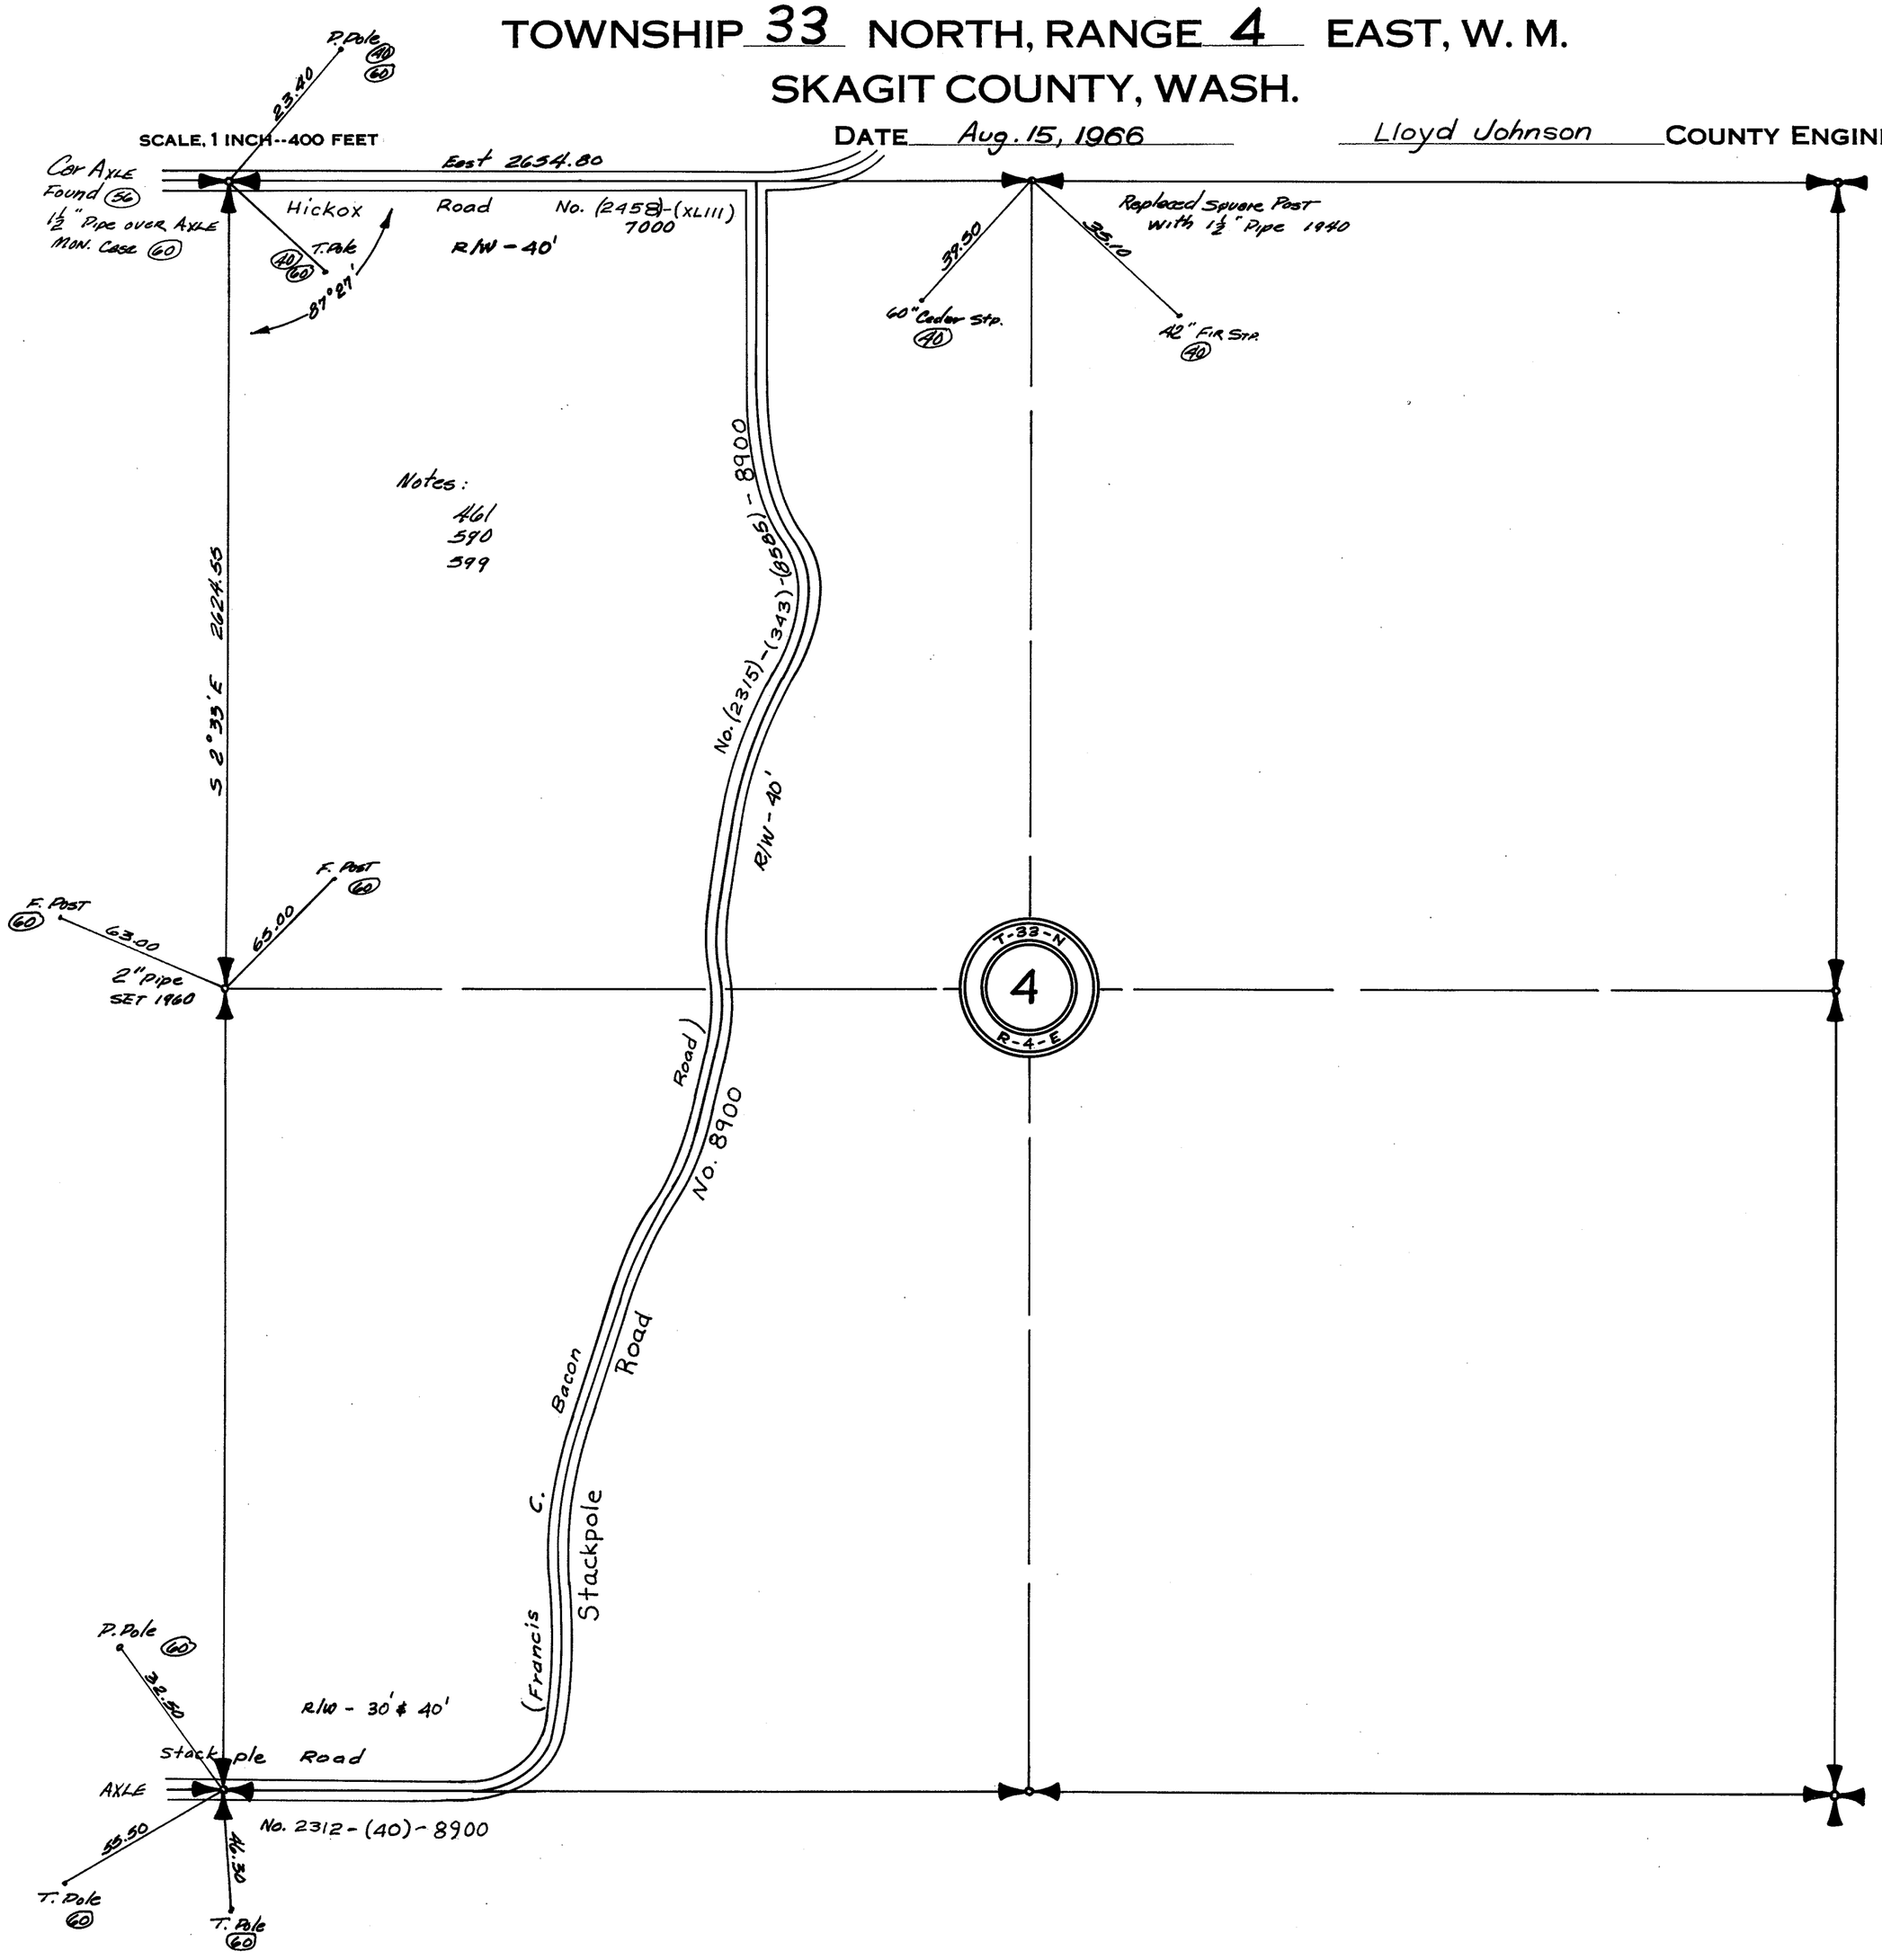

SECTION 4


TOWNSHIP 33 NORTH. RANGE 4 EAST. W. M.

SKAGIT COUNTY. WASH.

SCALE. 1 INCH—400 FEET

Lloyd Johnson COUNTY ENGINEER

DATE 11/20/75

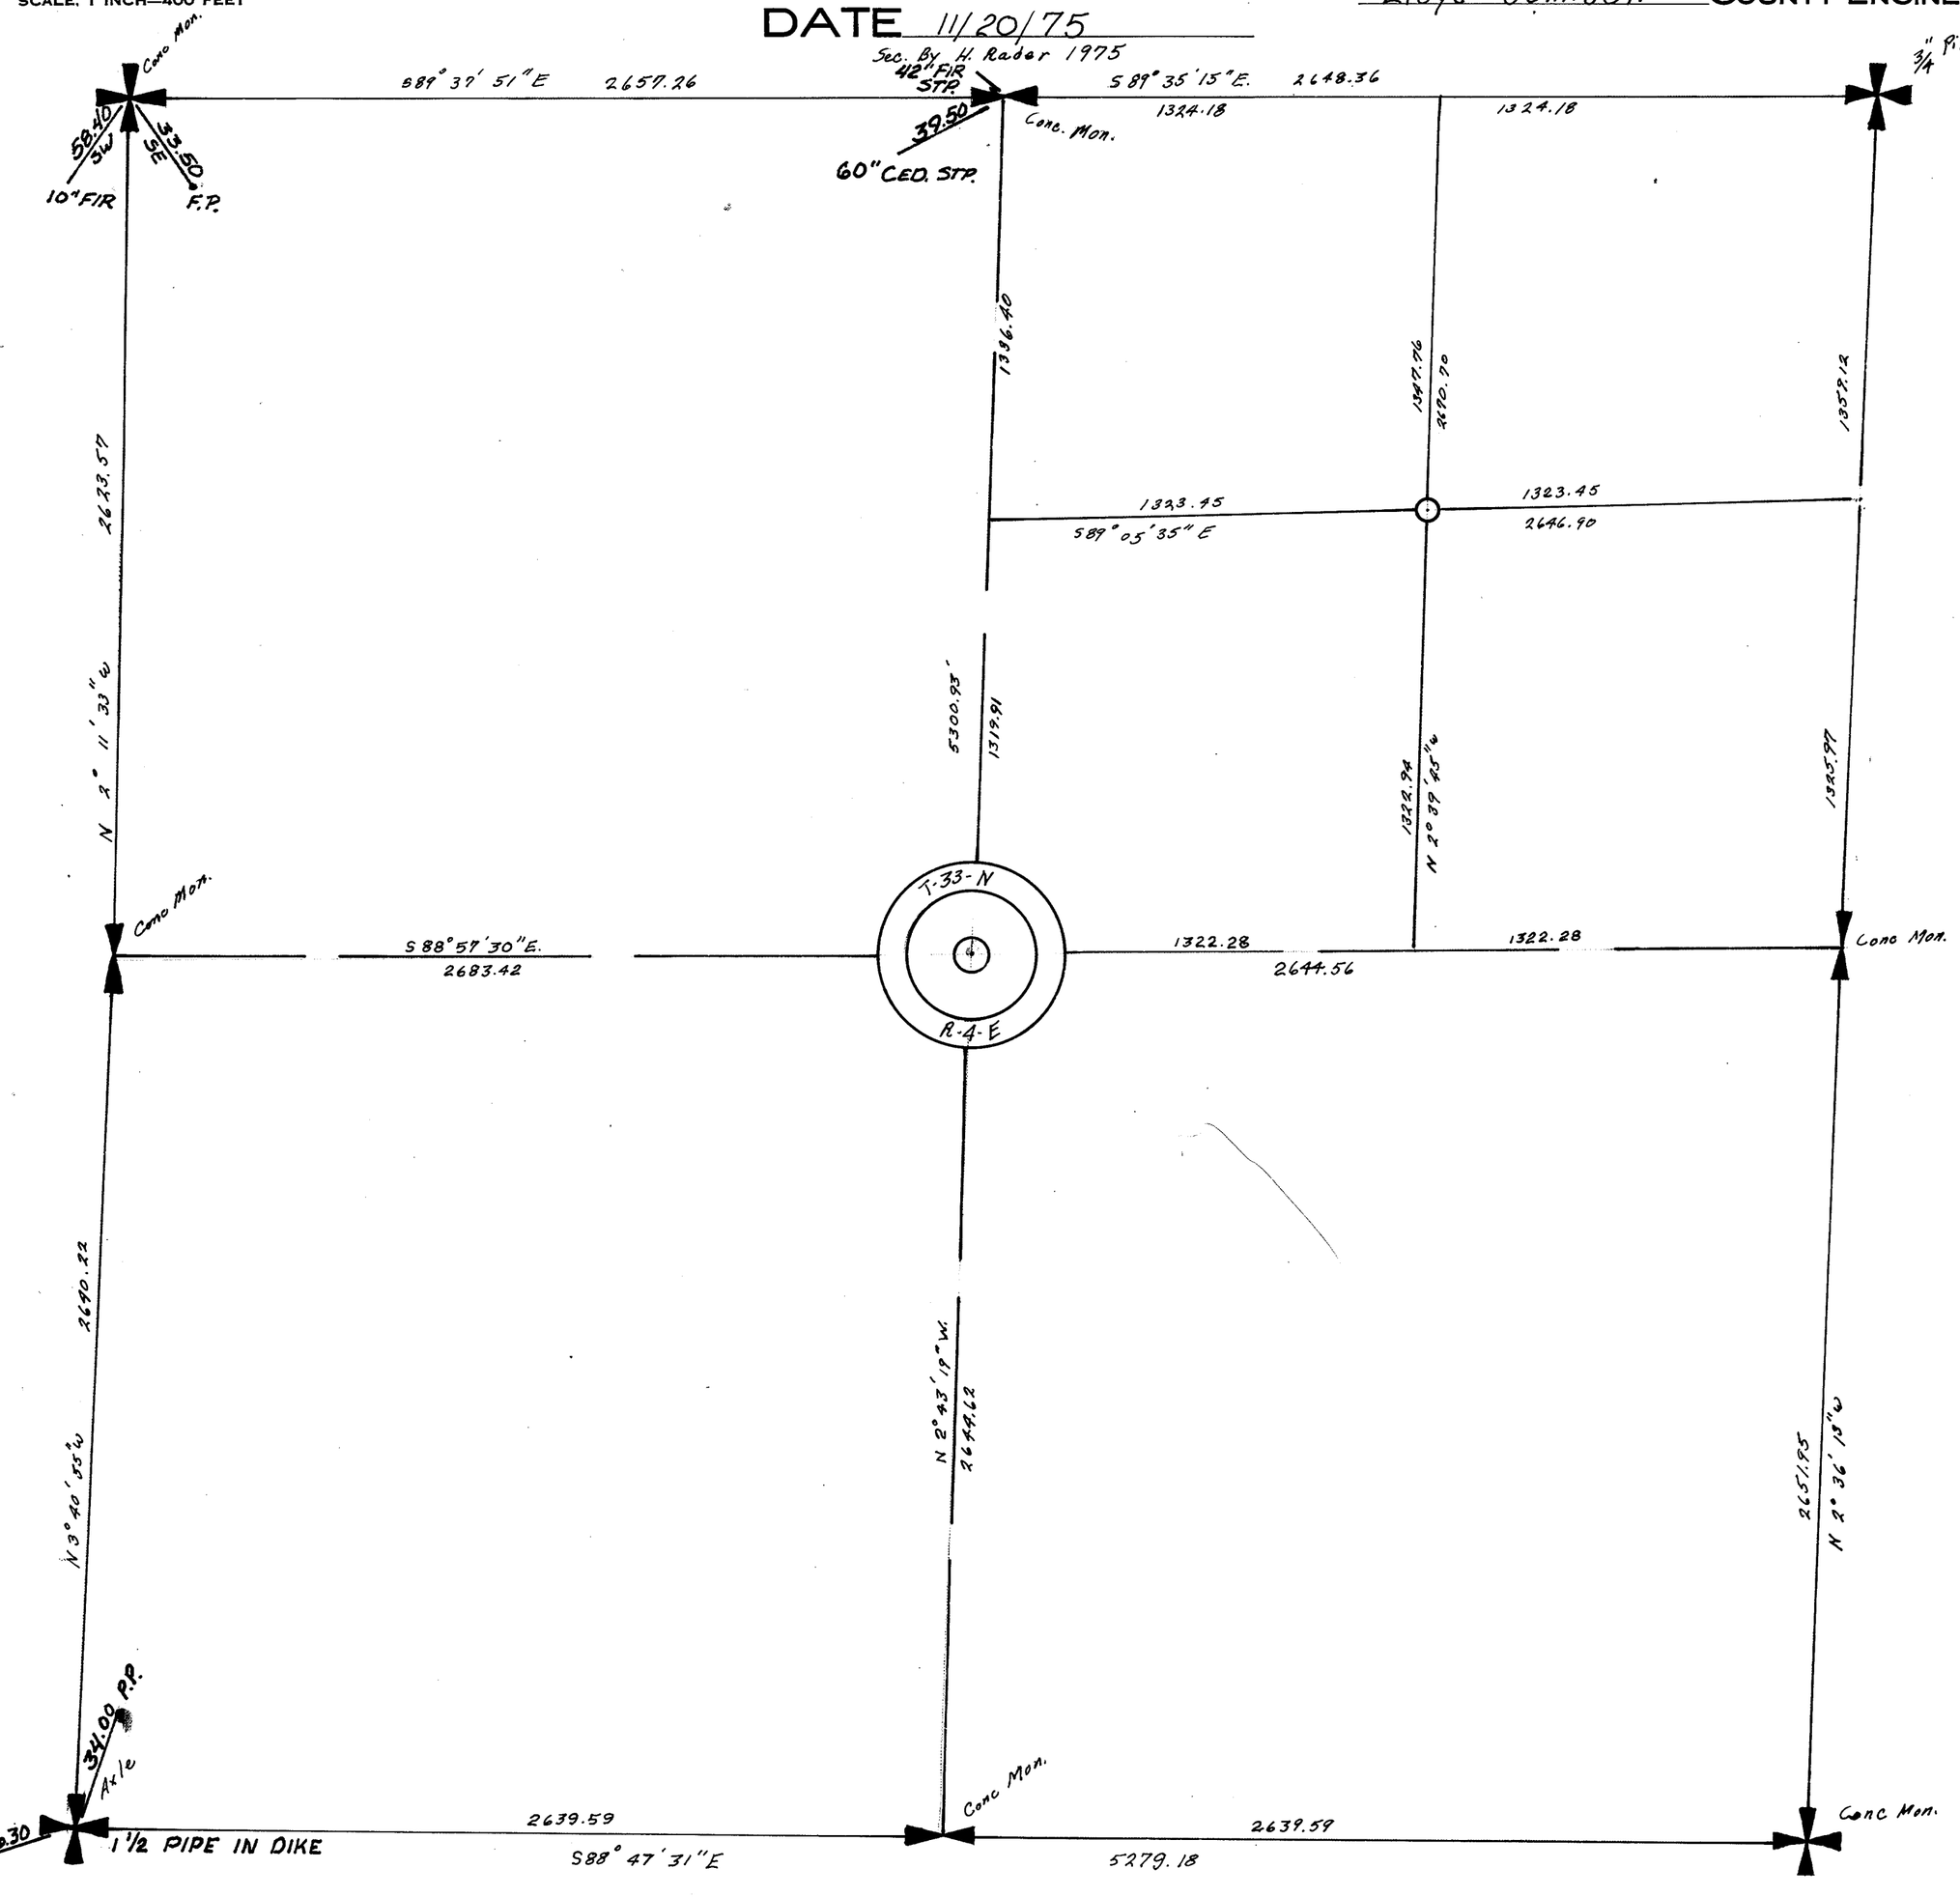


SECTION 5

TOWNSHIP 33 NORTH, RANGE 4 EAST, W. M.


SKAGIT COUNTY, WASH.

SCALE, 1 INCH--400 FEET

W.E. Castello COUNTY ENGINEER

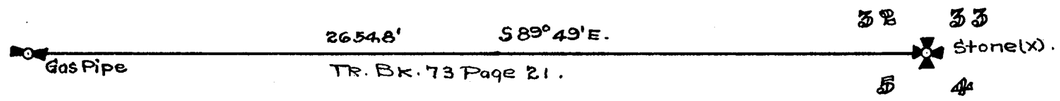

F155

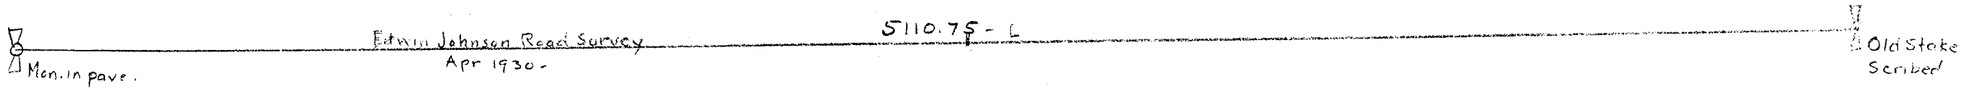


SECTION 5

TOWNSHIP 33 NORTH, RANGE 4 EAST, W. M.
SKAGIT COUNTY, WASH.

SCALE, 1 INCH–400 FEET

_____ COUNTY ENGINEER

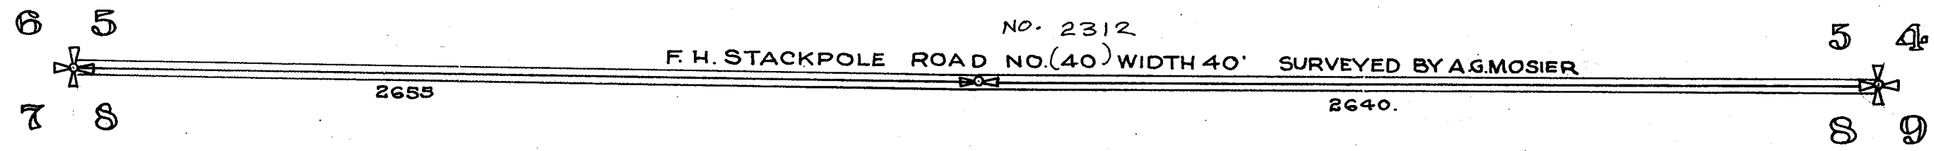

SECTION 5


TOWNSHIP 33 NORTH, RANGE 4 EAST, W. M.

SKAGIT COUNTY, WASH.

SCALE 1 INCH--400 FEET

Assembled Subd.
Notes as shown

H.O. Walberg COUNTY ENGINEER

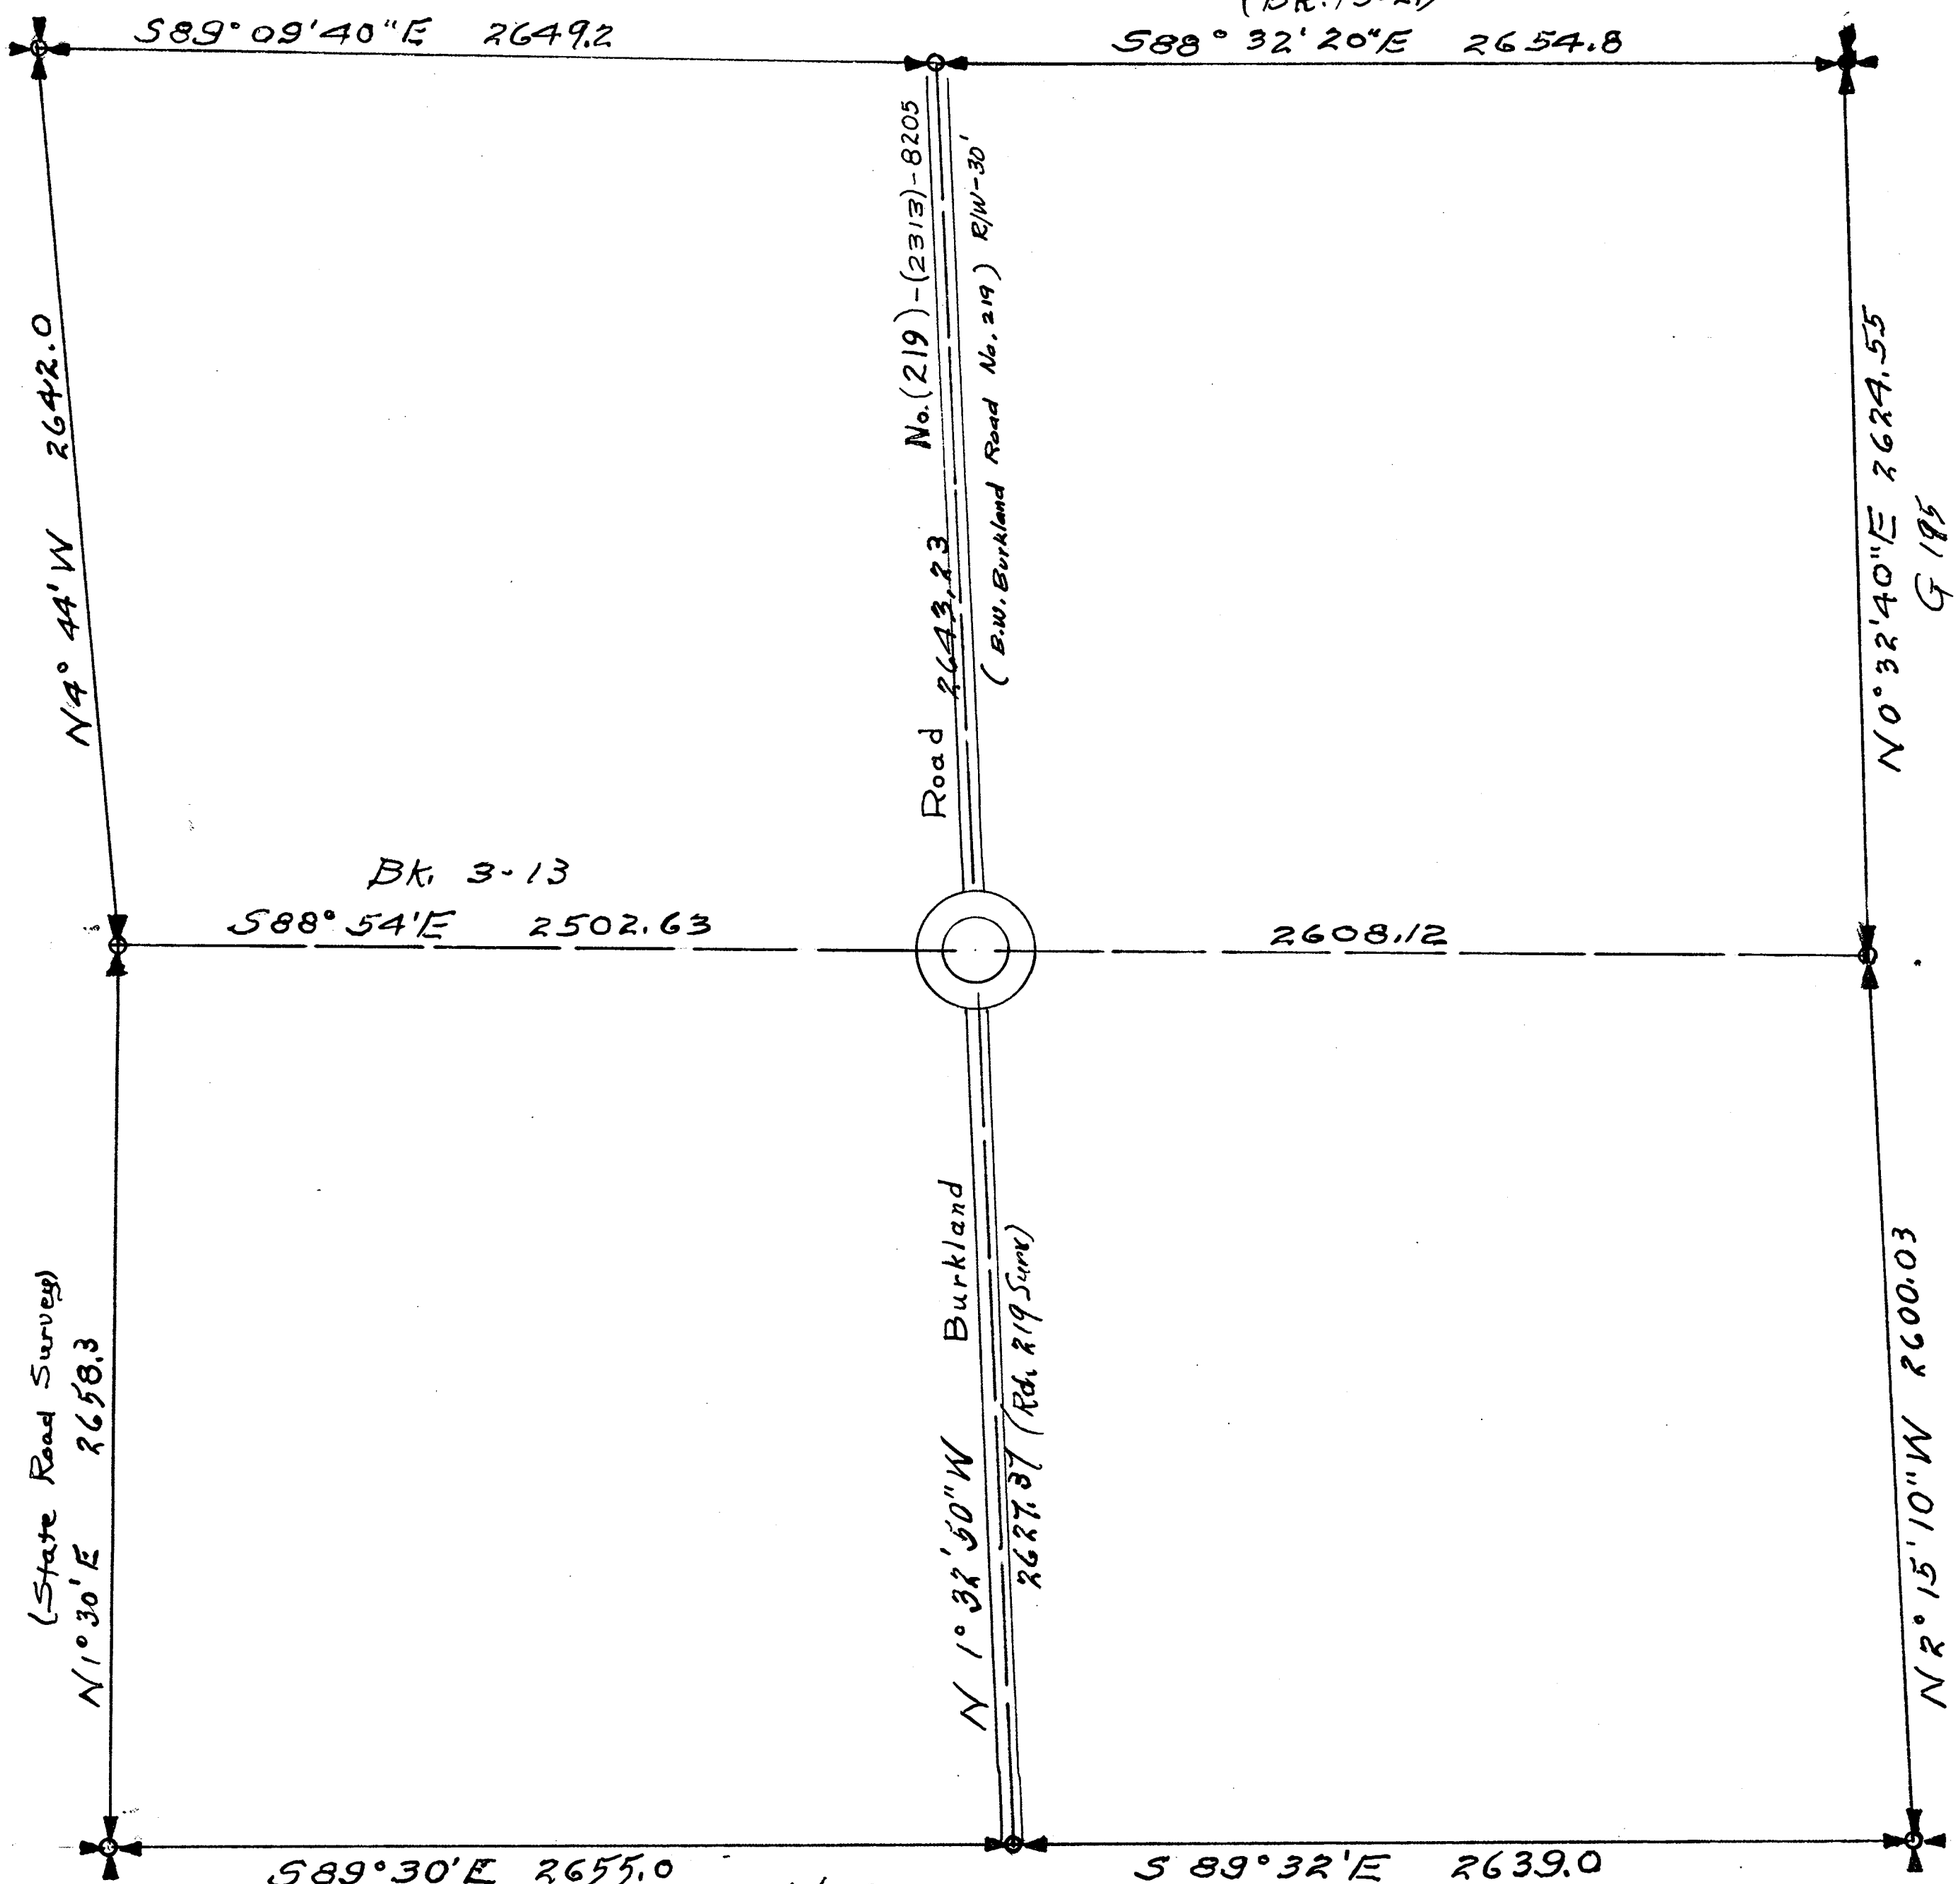

SECTION 5

TOWNSHIP 33 NORTH, RANGE 4 EAST, W. M.

SKAGIT COUNTY, WASH.

SCALE, 1 INCH--400 FEET

DATE Aug. 12, 1966

Lloyd Johnson COUNTY ENGINEER

MON'M

Mount Vernon - (Conway) South

No. (2415) - (STATE HWY-99)
7021
R/W - 60'

N4°44'W 2642.0

2649.2

Hickox

S89°09'40"E

MON Case With 1½" Pipe

R Pole (62)

T. Pole (62) (35)

42.9

21.7

Road

43.20

T. Pole (35) (60)

No. 7000 (No. 2458) - (XLIII)

S88°32'20"E 2654.8

R/W - 40'

59.40

10" FIR

32.50

F. Post

Ford AXLE

Notes:
458
577
425
599
Q-195

No. (2313) - (219) - 8205

(R/W - 30')
R/W - 40'
V 213 - P92

2643.23

N0°32'40"E

T-33-N
5
R-4-E

S88°54'E 2502.63

2608.12'

STATE HWY.

N1°30'E 2658.3

Road

Burkland

N1°32'50"W 2627.37

N2°15'10"W 2600.03

Note: This Tracing Drawn From
Aerial Photo - Not to Scale -----

Guy Pole (52)

40.90

R Pole (62)

31.00

R/W - 30' & 40'

F. H. Stackpole Road

1314.5

No. (2312) - (40) - 8900

1319.5

32.00

T. Pole (52)

S89°30'E 2655.0

S89°32'E 2639.0

MON. IN PAVEMENT

34.30

T. Pole (62)

Pipe in ditch under bridge
Set 1" Rod - hex. nut on top
MAY 1950 South edge of Gravel

SECTION 6

TOWNSHIP 33 NORTH, RANGE 4 EAST, W. M.
SKAGIT COUNTY, WASH.

SCALE, 1 INCH–400 FEET

G. D. LeGro COUNTY ENGINEER
Sept. 1958
Road No. 139 drawn from aerial

Hickox Road No. 2458–(XLIII)

2599.6

2622.5

Dike Road No.(139)

Skagit River Road No. 1X)

No. 2409

No.(139) Dike Road R/W deed Width 25'

R/W - 60'

Mount-Vernon Conway No. 2415–(99)

T 33 N
6
R 4 E

STATE HWY. – 5–(99)

No. 2312
F. H. STACKPOLE ROAD NO(40) WIDTH 40FT 5374.8 BY A. L. STRONG BK 67

2672.7

2663.3

6 5
7 8


SECTION 6

TOWNSHIP 33 NORTH, RANGE 4 EAST, W. M.

SKAGIT COUNTY, WASH.

SCALE, 1 INCH--400 FEET

DATE 26 MARCH 1959 F. GILKEY COUNTY ENGINEER

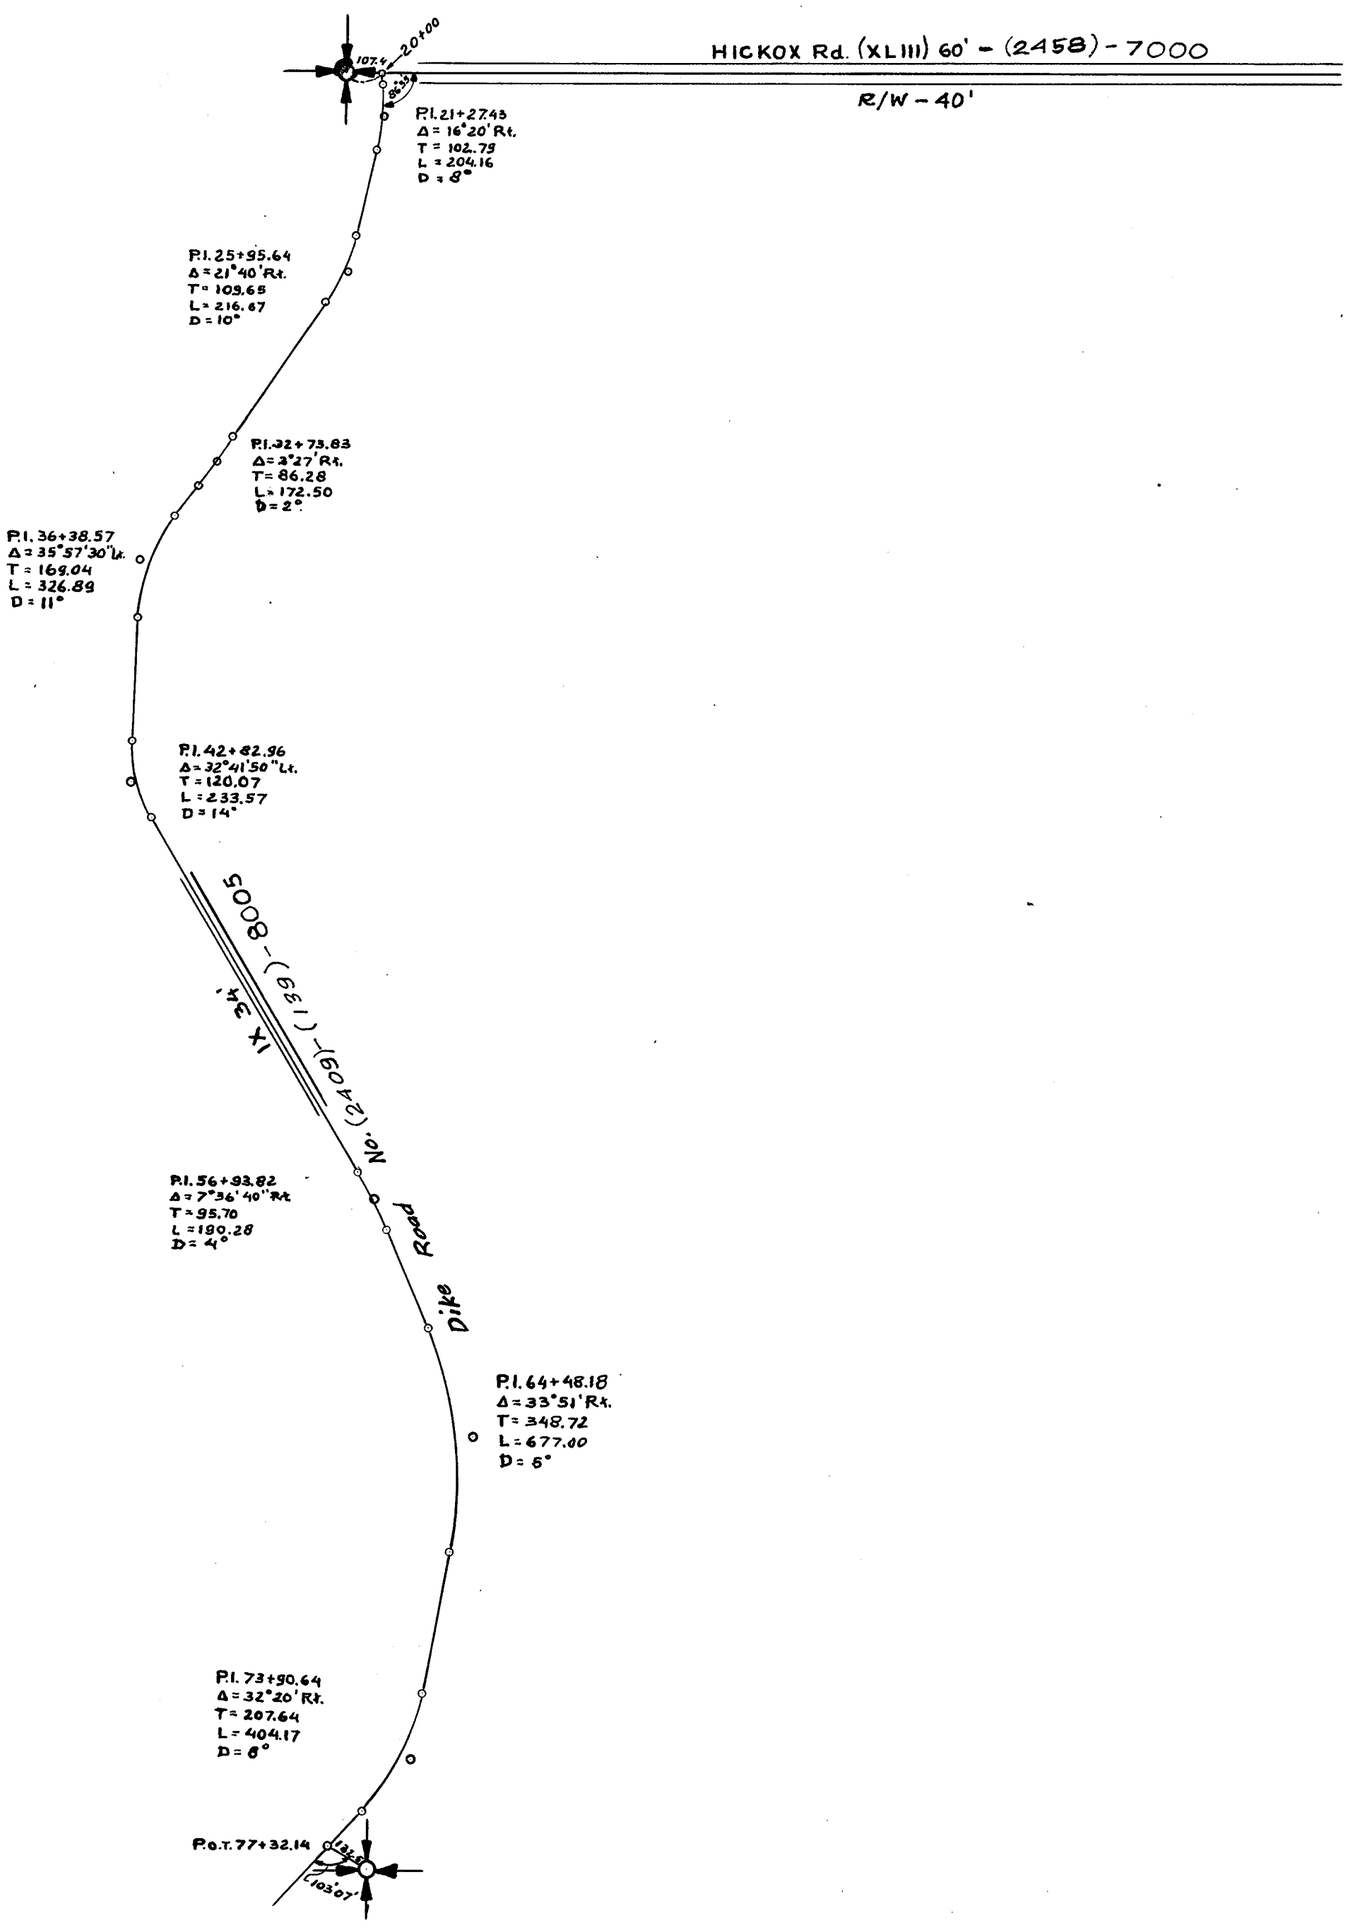


SECTION 7

TOWNSHIP 33 NORTH, RANGE 4 EAST, W. M.

SKAGIT COUNTY, WASH.

SCALE, 1 INCH--400 FEET

G. D. LeGro COUNTY ENGINEER
From aerial photograph
Sept. 1958

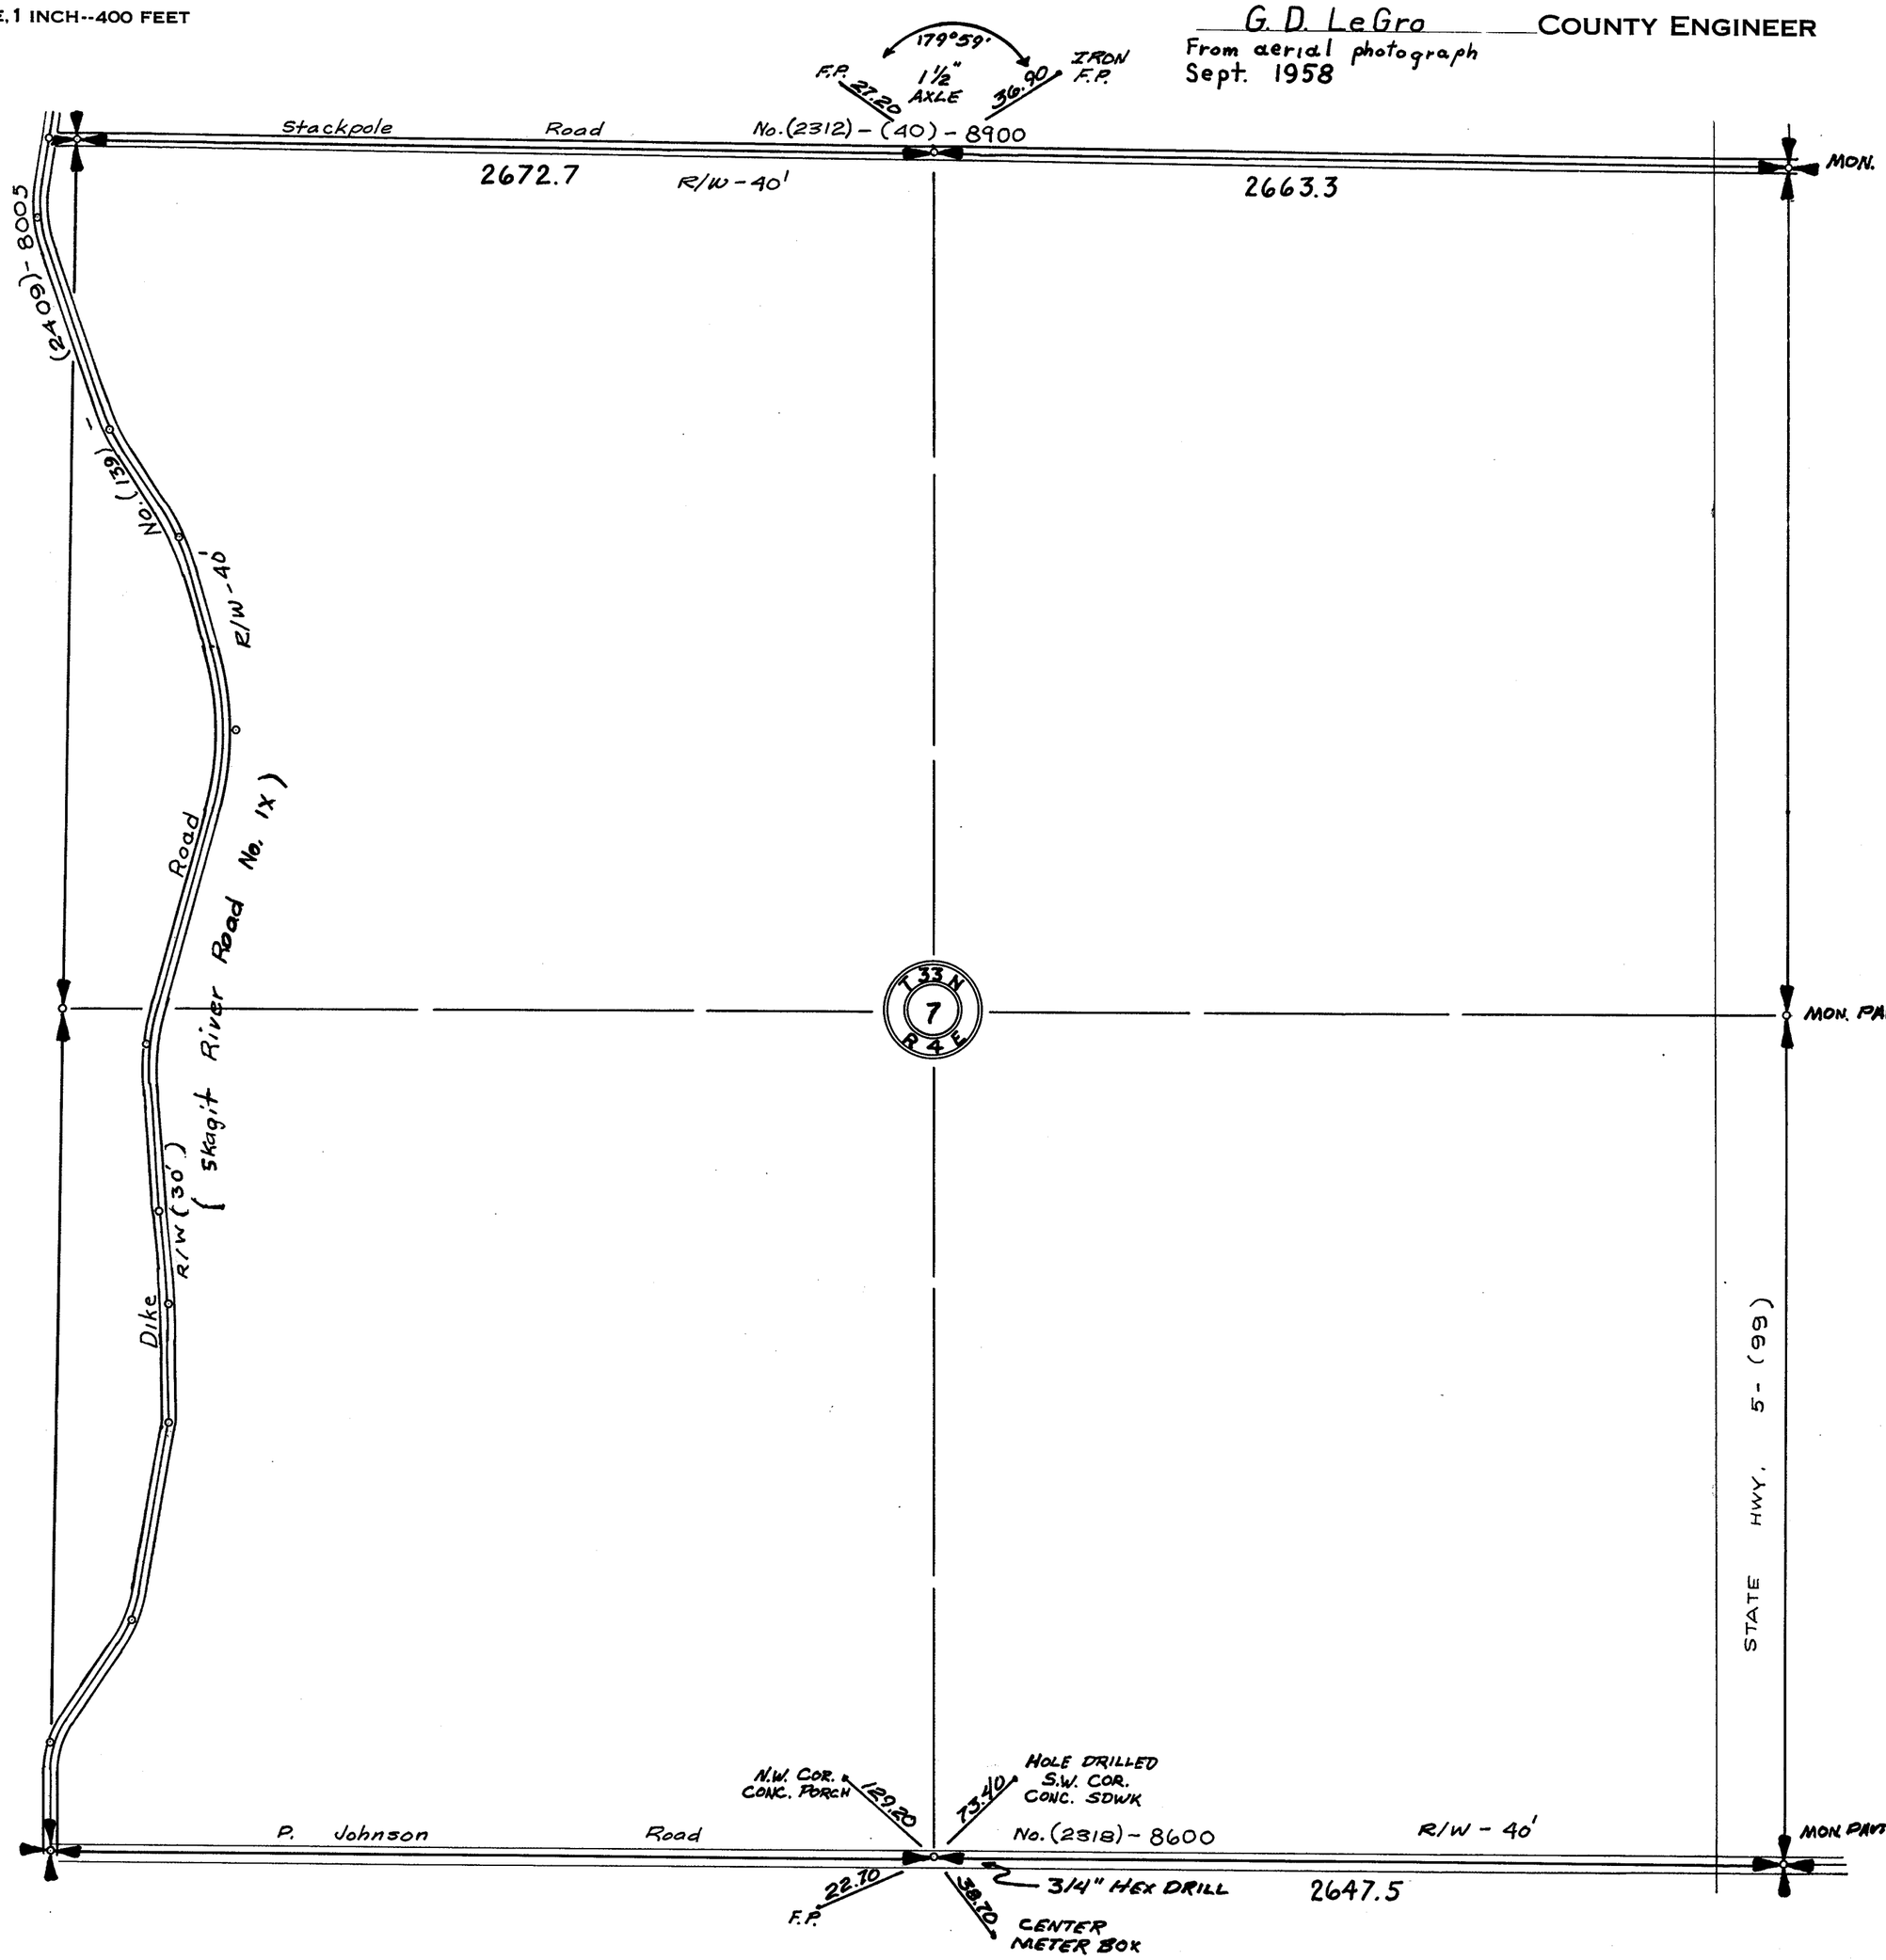


SECTION 8

TOWNSHIP 33N. NORTH, RANGE 4E. EAST, W. M.

SKAGIT COUNTY, WASH.

SCALE, 1 INCH--400 FEET

FRANK GILKEY COUNTY ENGINEER

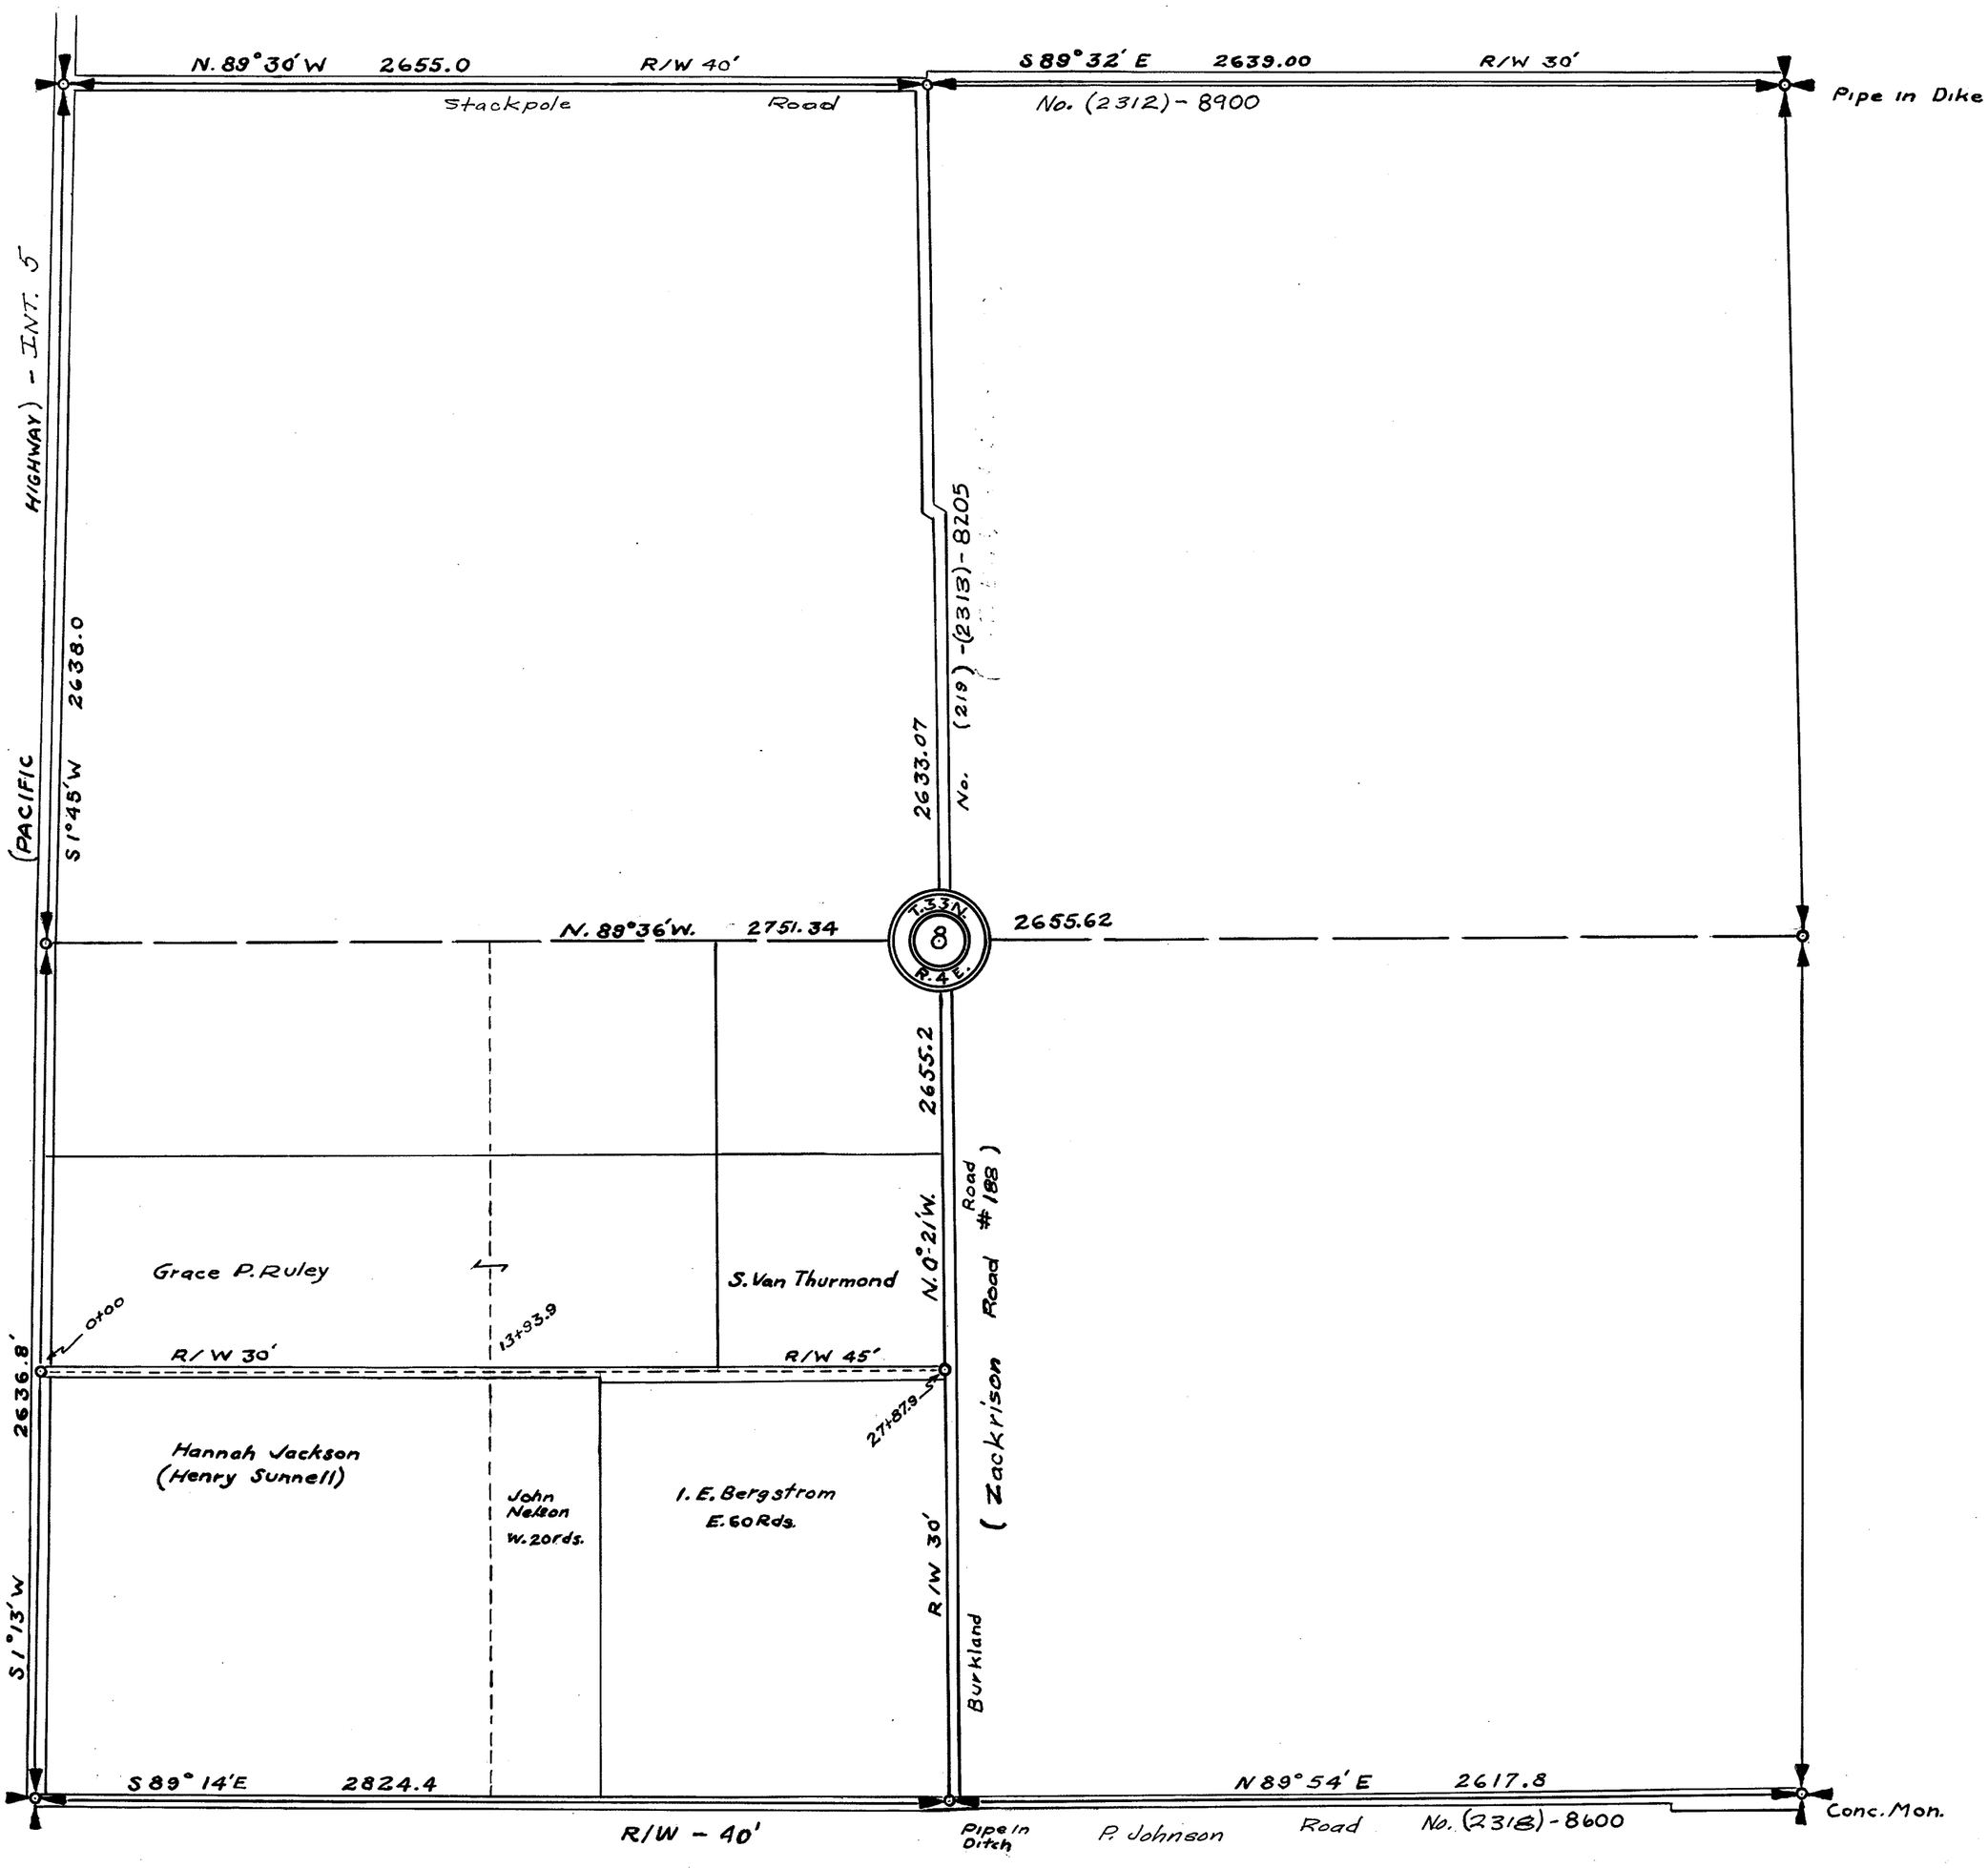


SECTION 8

TOWNSHIP 33 NORTH, RANGE 4 EAST, W. M.

SKAGIT COUNTY, WASH.

SCALE, 1 INCH--400 FEET
NOTES- 36/306

H.O. WALBERG COUNTY ENGINEER
Platted Feb. 1941

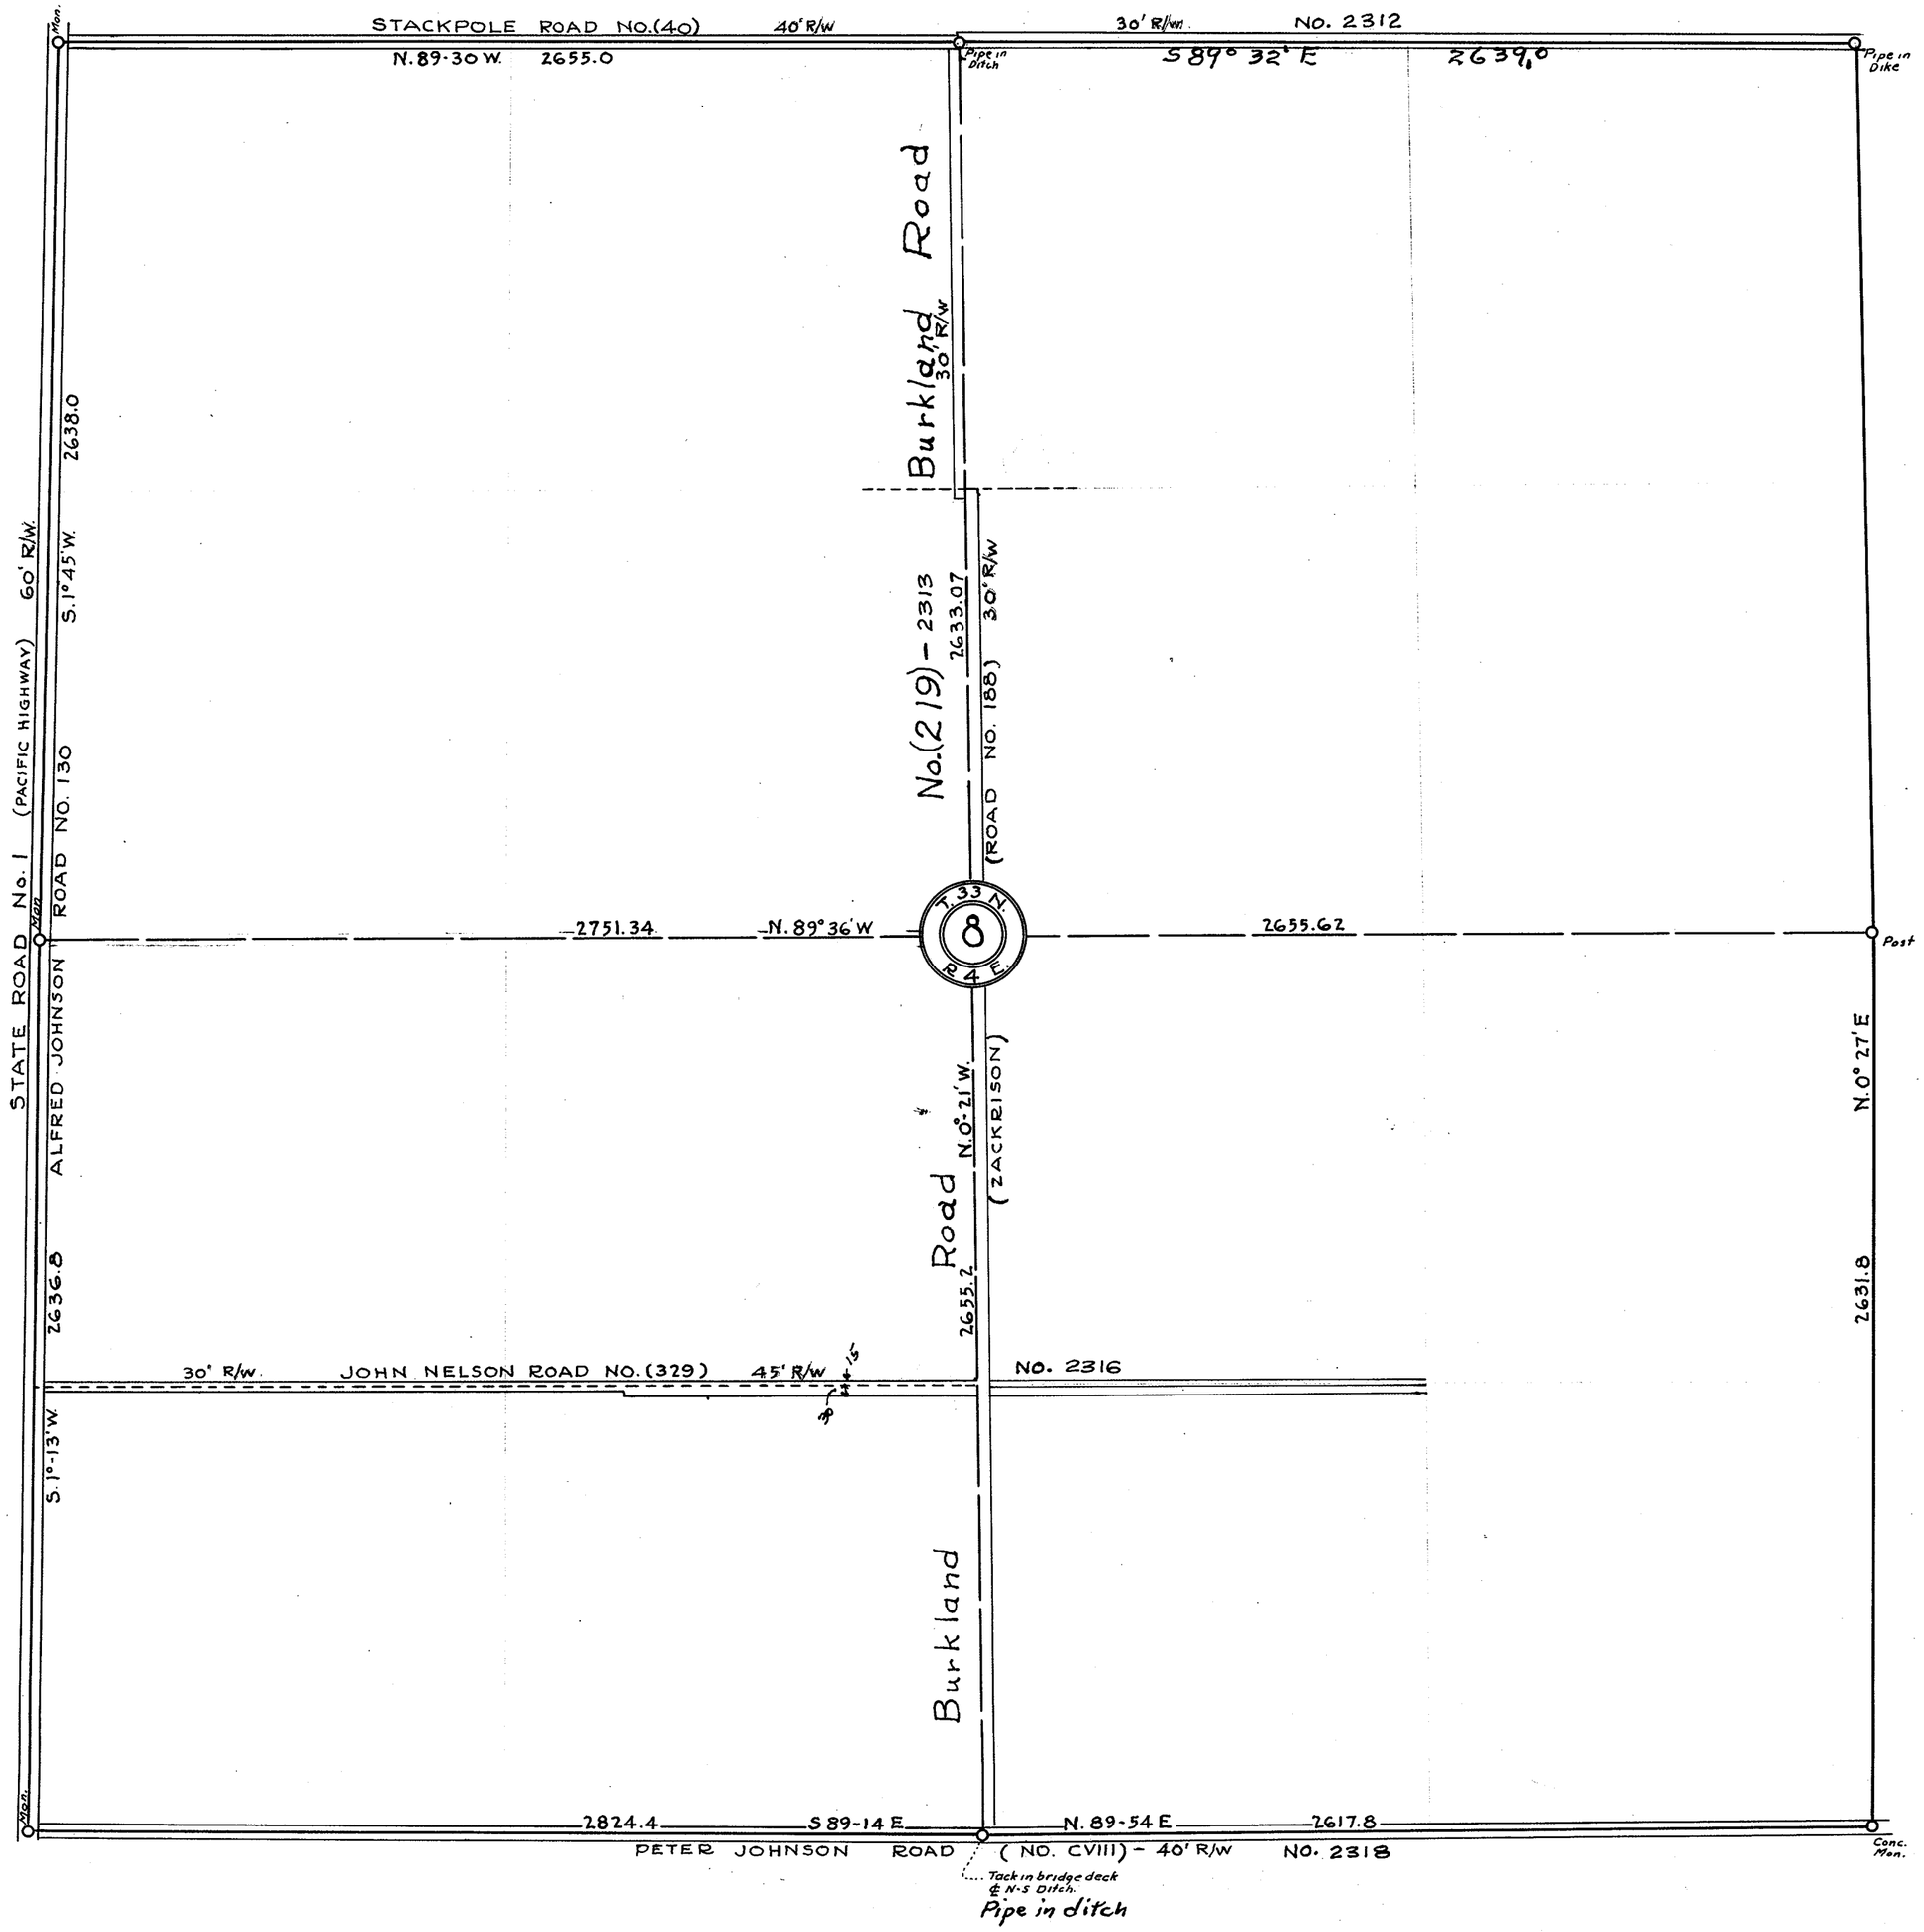

SECTION 8


TOWNSHIP 33 NORTH, RANGE 4 EAST, W. M.

SKAGIT COUNTY, WASH.

SCALE, 1 INCH--400 FEET

DATE August 1968

Lloyd Johnson COUNTY ENGINEER

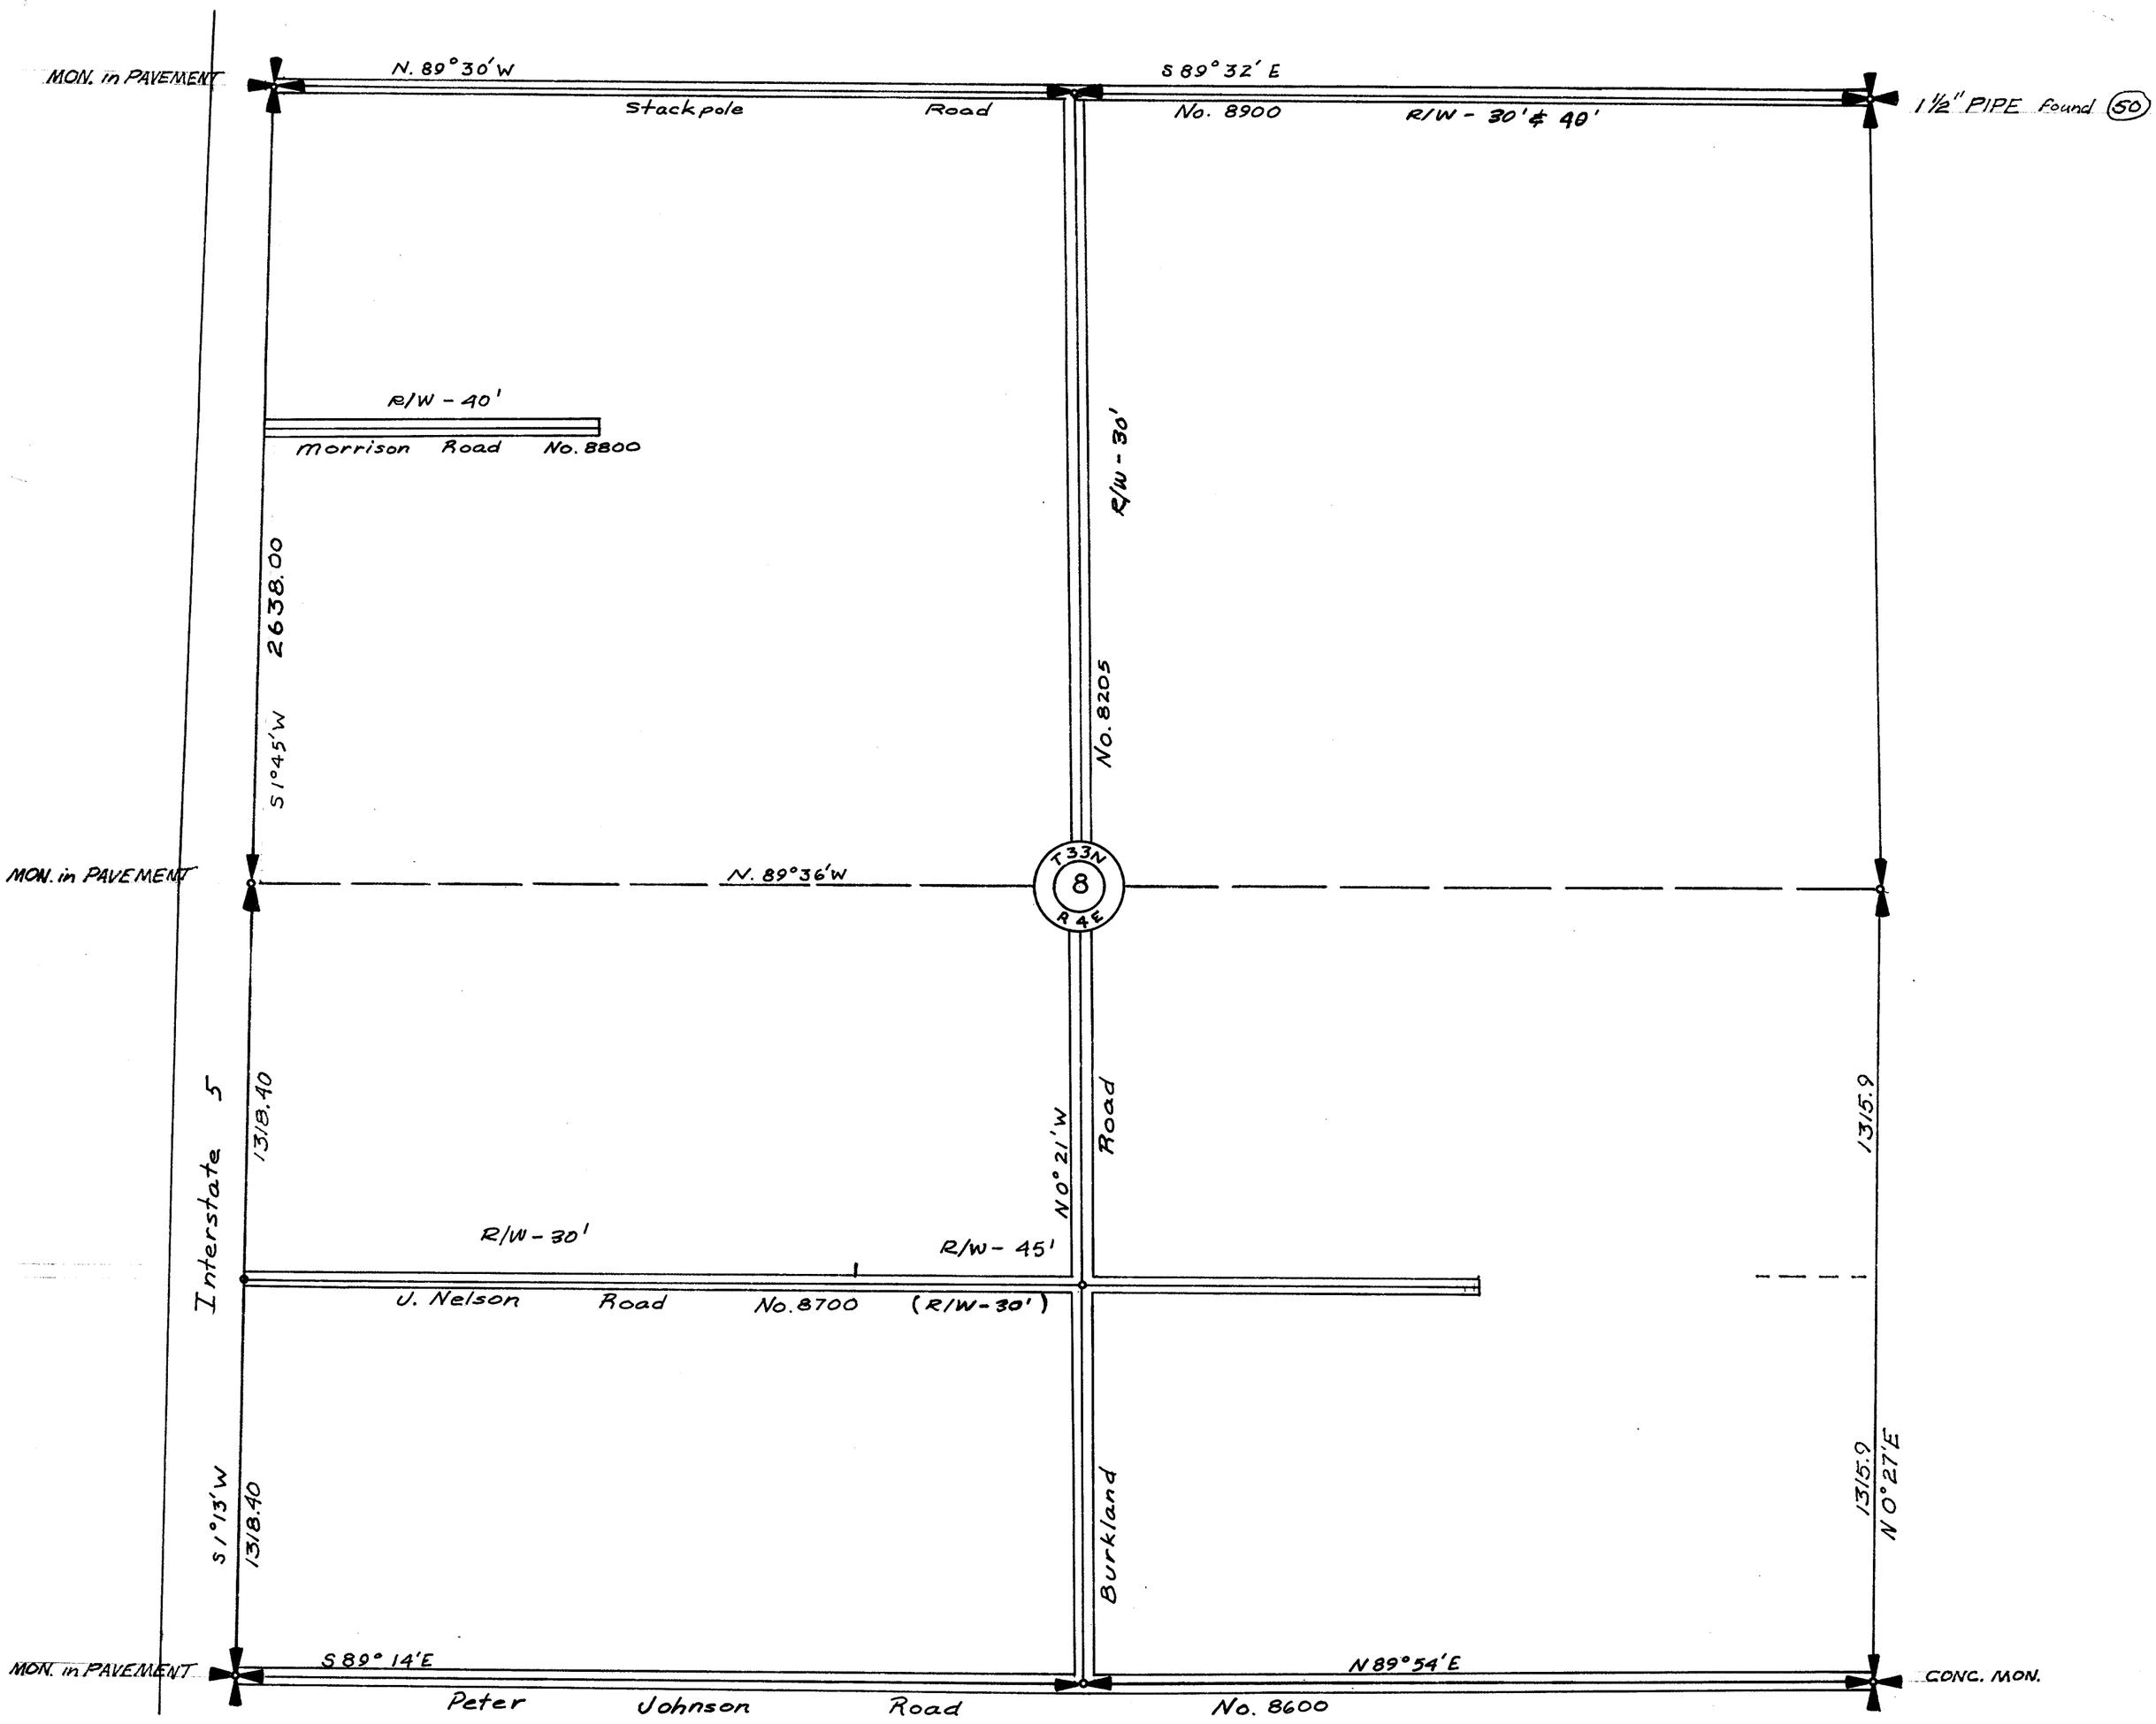

SECTION 8


TOWNSHIP 33 N. NORTH, RANGE 4 E EAST, W. M.

SKAGIT COUNTY, WASH.

SCALE, 1 INCH--400 FEET

NOTES: 36/306

W. A. Costello COUNTY ENGINEER

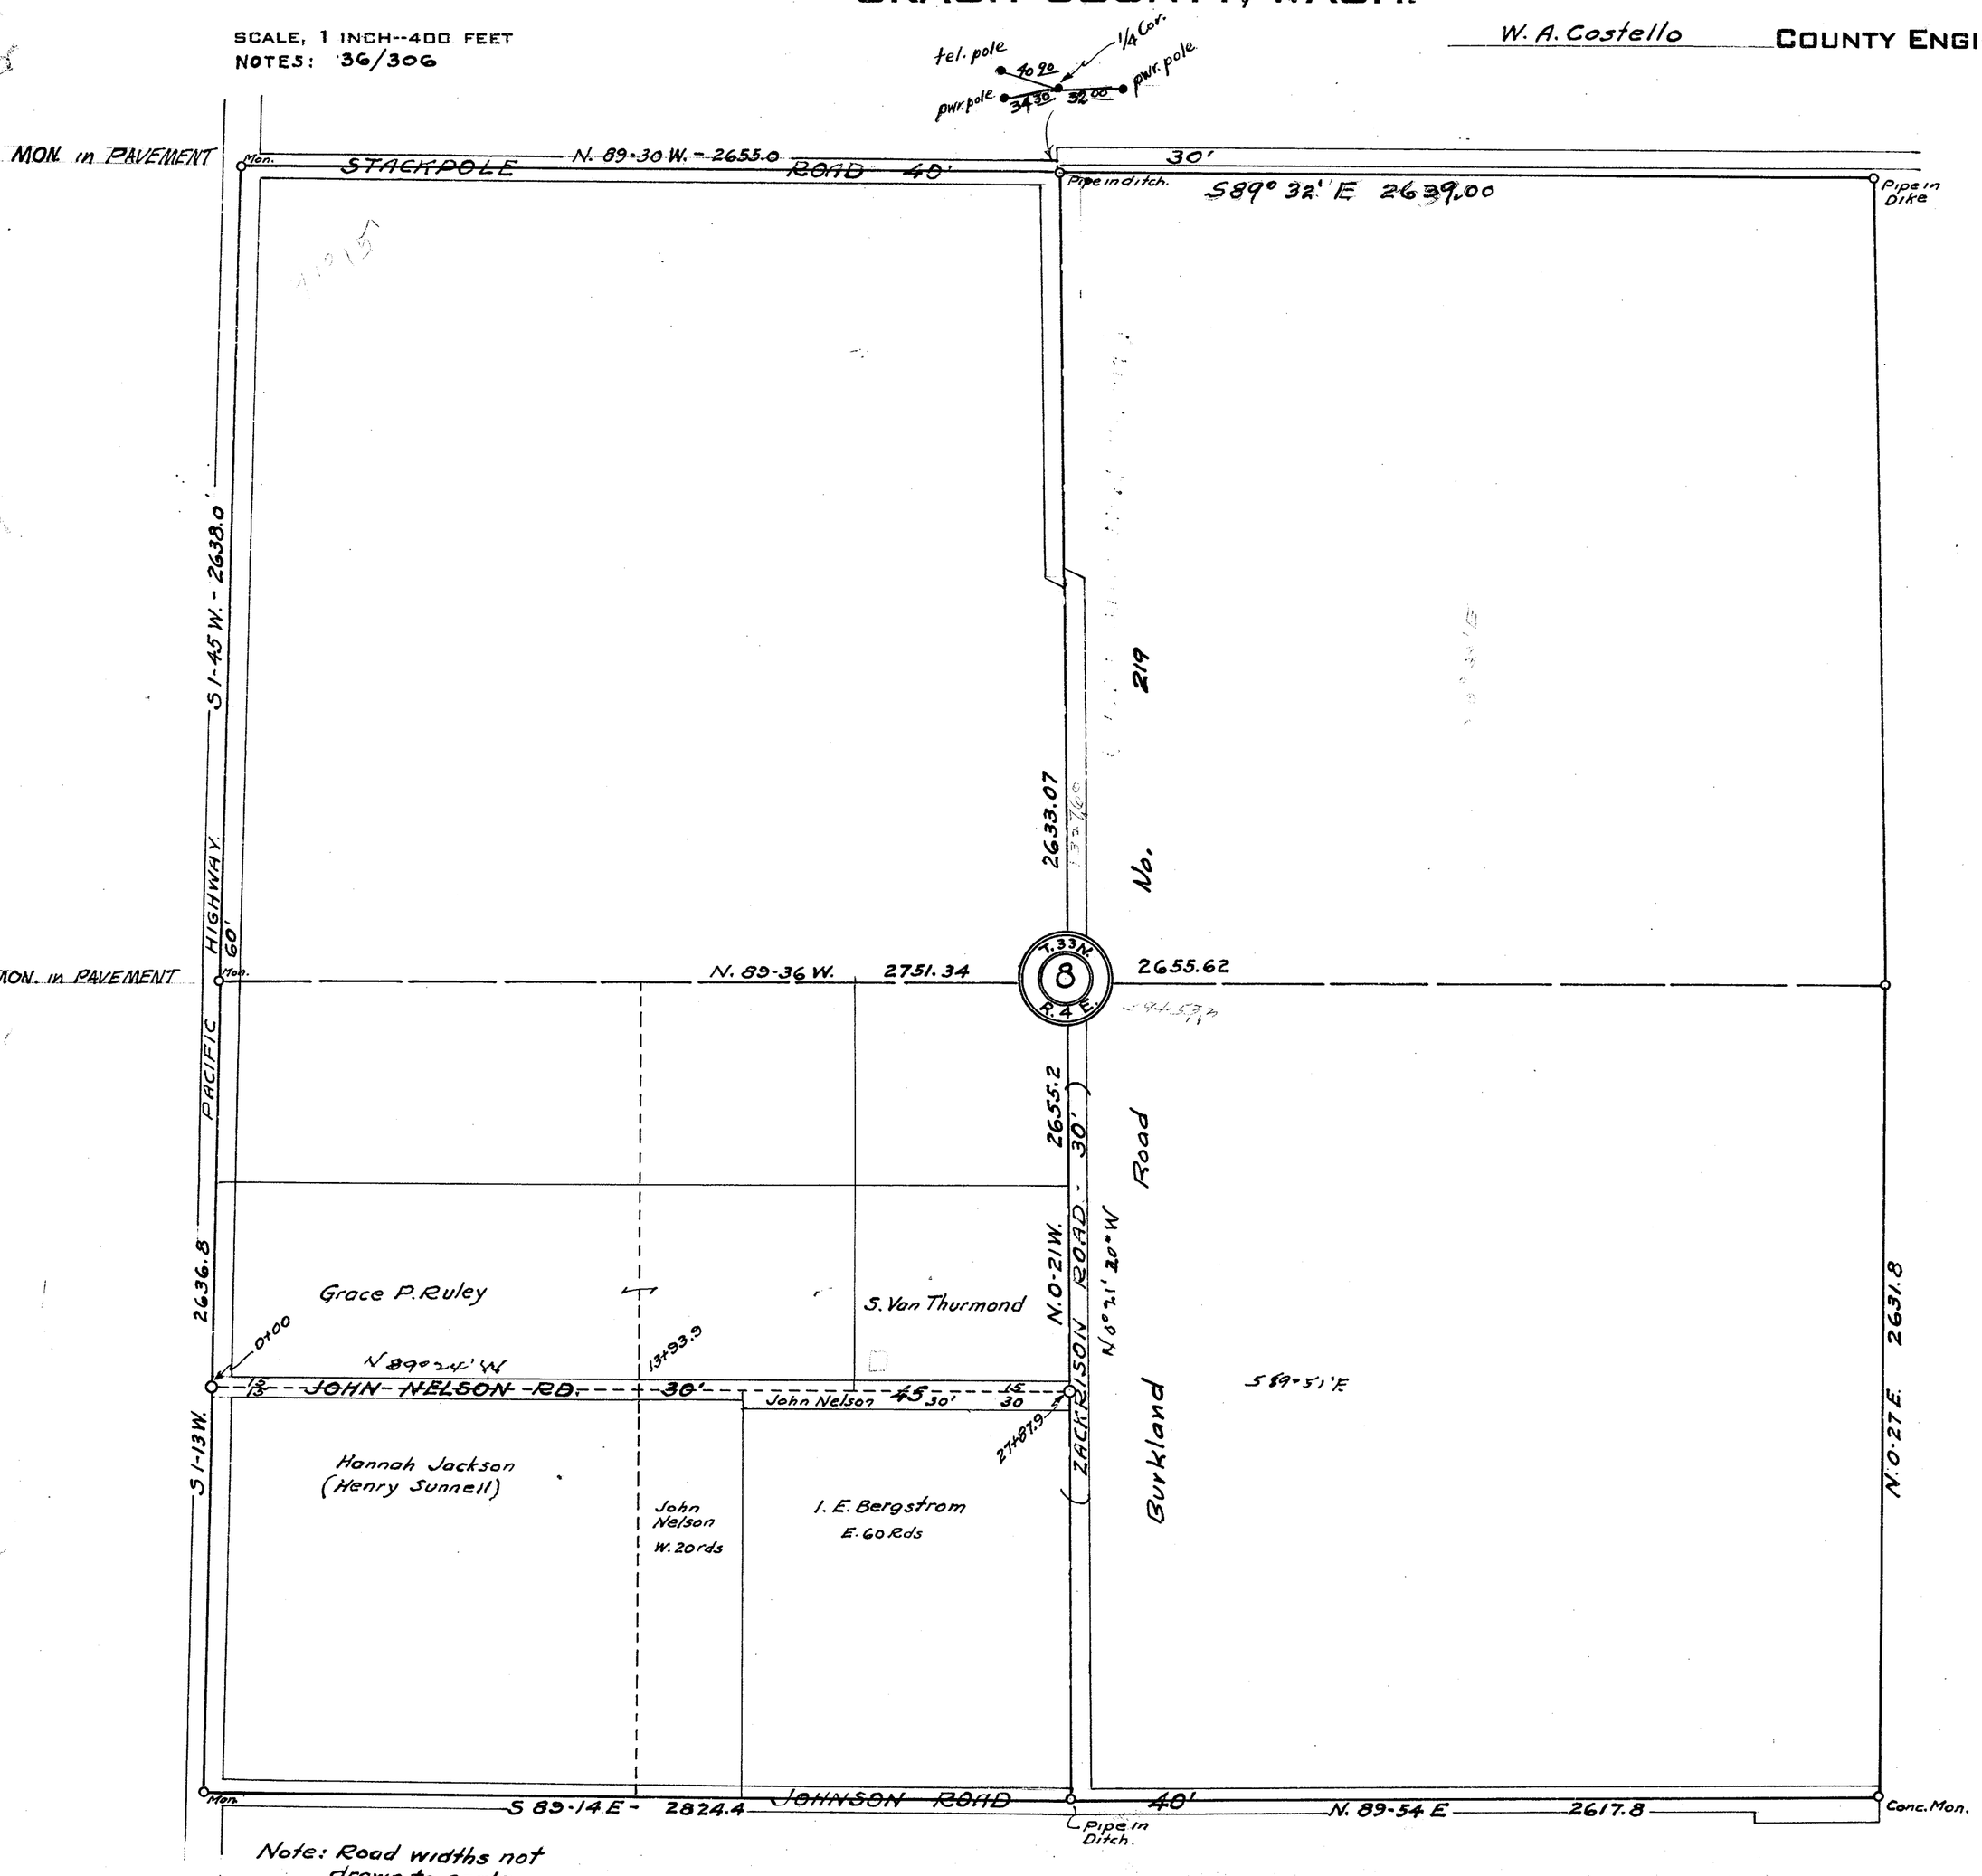

Note: Road widths not drawn to scale

⚠ IDLEWOOD
VOL. 8 P-25


SECTION 15

TOWNSHIP 33 NORTH, RANGE 4 EAST, W. M.

SKAGIT COUNTY, WASH.

SCALE, 1 INCH--400 FEET

DATE APRIL 6, 1972 Lloyd H. Johnson COUNTY ENGINEER

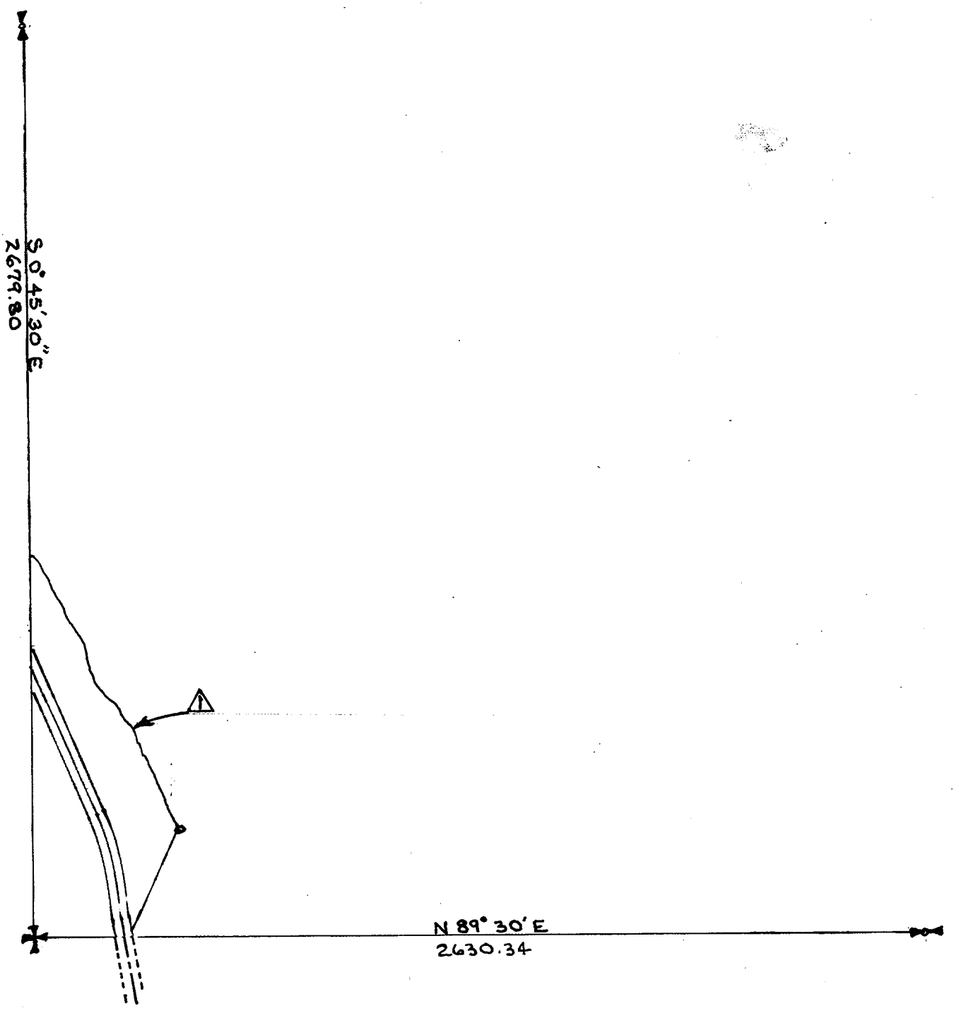

SECTION 16

TOWNSHIP 33 NORTH, RANGE 4 EAST, W. M.

SKAGIT COUNTY, WASH.

DATE 3 SEPT 1968 — Lloyd H Johnson COUNTY ENGINEER

SCALE, 1 INCH--400 FEET

Tel. Pole #53
35.25
CON. MON.
8.43
Gate Post #53

Notes: 329
392

N 0°01' 02"W
2700.37

P. Pole
75.00
F. Post #39
36.50
20.30' T. Pole #39
VOL 334 - P 174 D
VOL 83 - P 141 OR
60' R/W
N 88° 11' 40" W
1" Pipe Found 1950
4.17
1880
F Post #39
P. Pole

T-33-N
16
R-4-E

5104.52

R/W - 40'

Bulson Road No. 8075
N 2° 44' 50" E

T. Pole 39
75.00
1880
P. Pole 39
2847.74

2" Pipe Found 1950 1' Below Surface

HERMWAY HEIGHTS #2
VOL 9, 63

R/W - 50'
TABBERT RD.
HERMWAY Heights
8475

ASSESSORS PLAT OF HERMWAY HEIGHTS
VOL 9, 47

Guy Pole #34
5202.85 feet
West 30'
#784376
4/23/73
Tel. Pole #39
28.30
54.20
S.S.H. 1-H

F. Post
2.080

1" Pipe Found 1950 3' Below Surface Drove 4' long 3/4" Pipe alongside 0.4 Below top of oil

N 88° 38' E
2589.45

40.70
P. Pole #4405 39

N 88° 30' 39" E
2687.25
2594.02

35.00
T. Pole
2.8.30
Stub. P. Pole
1¼" Pipe

SECTION 16

TOWNSHIP 33 NORTH, RANGE 4 EAST, W. M.

SKAGIT COUNTY, WASH.

SCALE, 1 INCH--400 FEET

DATE Aug. 8, 1963

COUNTY ENGINEER

Notes: 329
392

Tel. Pole (53)
35.25
Con. mon.
B.F.
Gate Post (53)

P.Pole
15.00
F.Post (39) 36.50
20.30 T.Pole (39)
60' R/W
Vol 354 P 174 DEEDS
Vol 83 P 141 OR
1" Pipe Found 1950
41.7
18.80
F.Post (39)
P.Pole
R/W - 40'
Road No. (170)-(2317)-4075
(E.E. Gulson No. 186)
Bulson

T-33-N
16
R-4-E

15.00 T. Pole (39)
2" Pipe Found 1950 1' Below Surface
18.80
P.Pole (39)

Guy Pole (39)
Tel. Pole (39)
28.30
54.20
S.S.H. 1-H
1" Pipe Found 1950 3' Below Surface Drove 4' long 3/4" Pipe alongside 0.4 Below top of oil
40.70
P.Pole #4405 (39)
N 88° 38' E 2589.45

F. Post
20.80
35.00
28.30
T. Pole
Stub. P. Pole
1 1/4" Pipe
N 88° 30' 39" E 2687.25
2594.02


SECTION 17

TOWNSHIP 33 NORTH, RANGE 4 EAST, W. M.

SKAGIT COUNTY, WASH.

SCALE, 1 INCH--400 FEET

DATE June, 1959 Frank Gilkey COUNTY ENGINEER

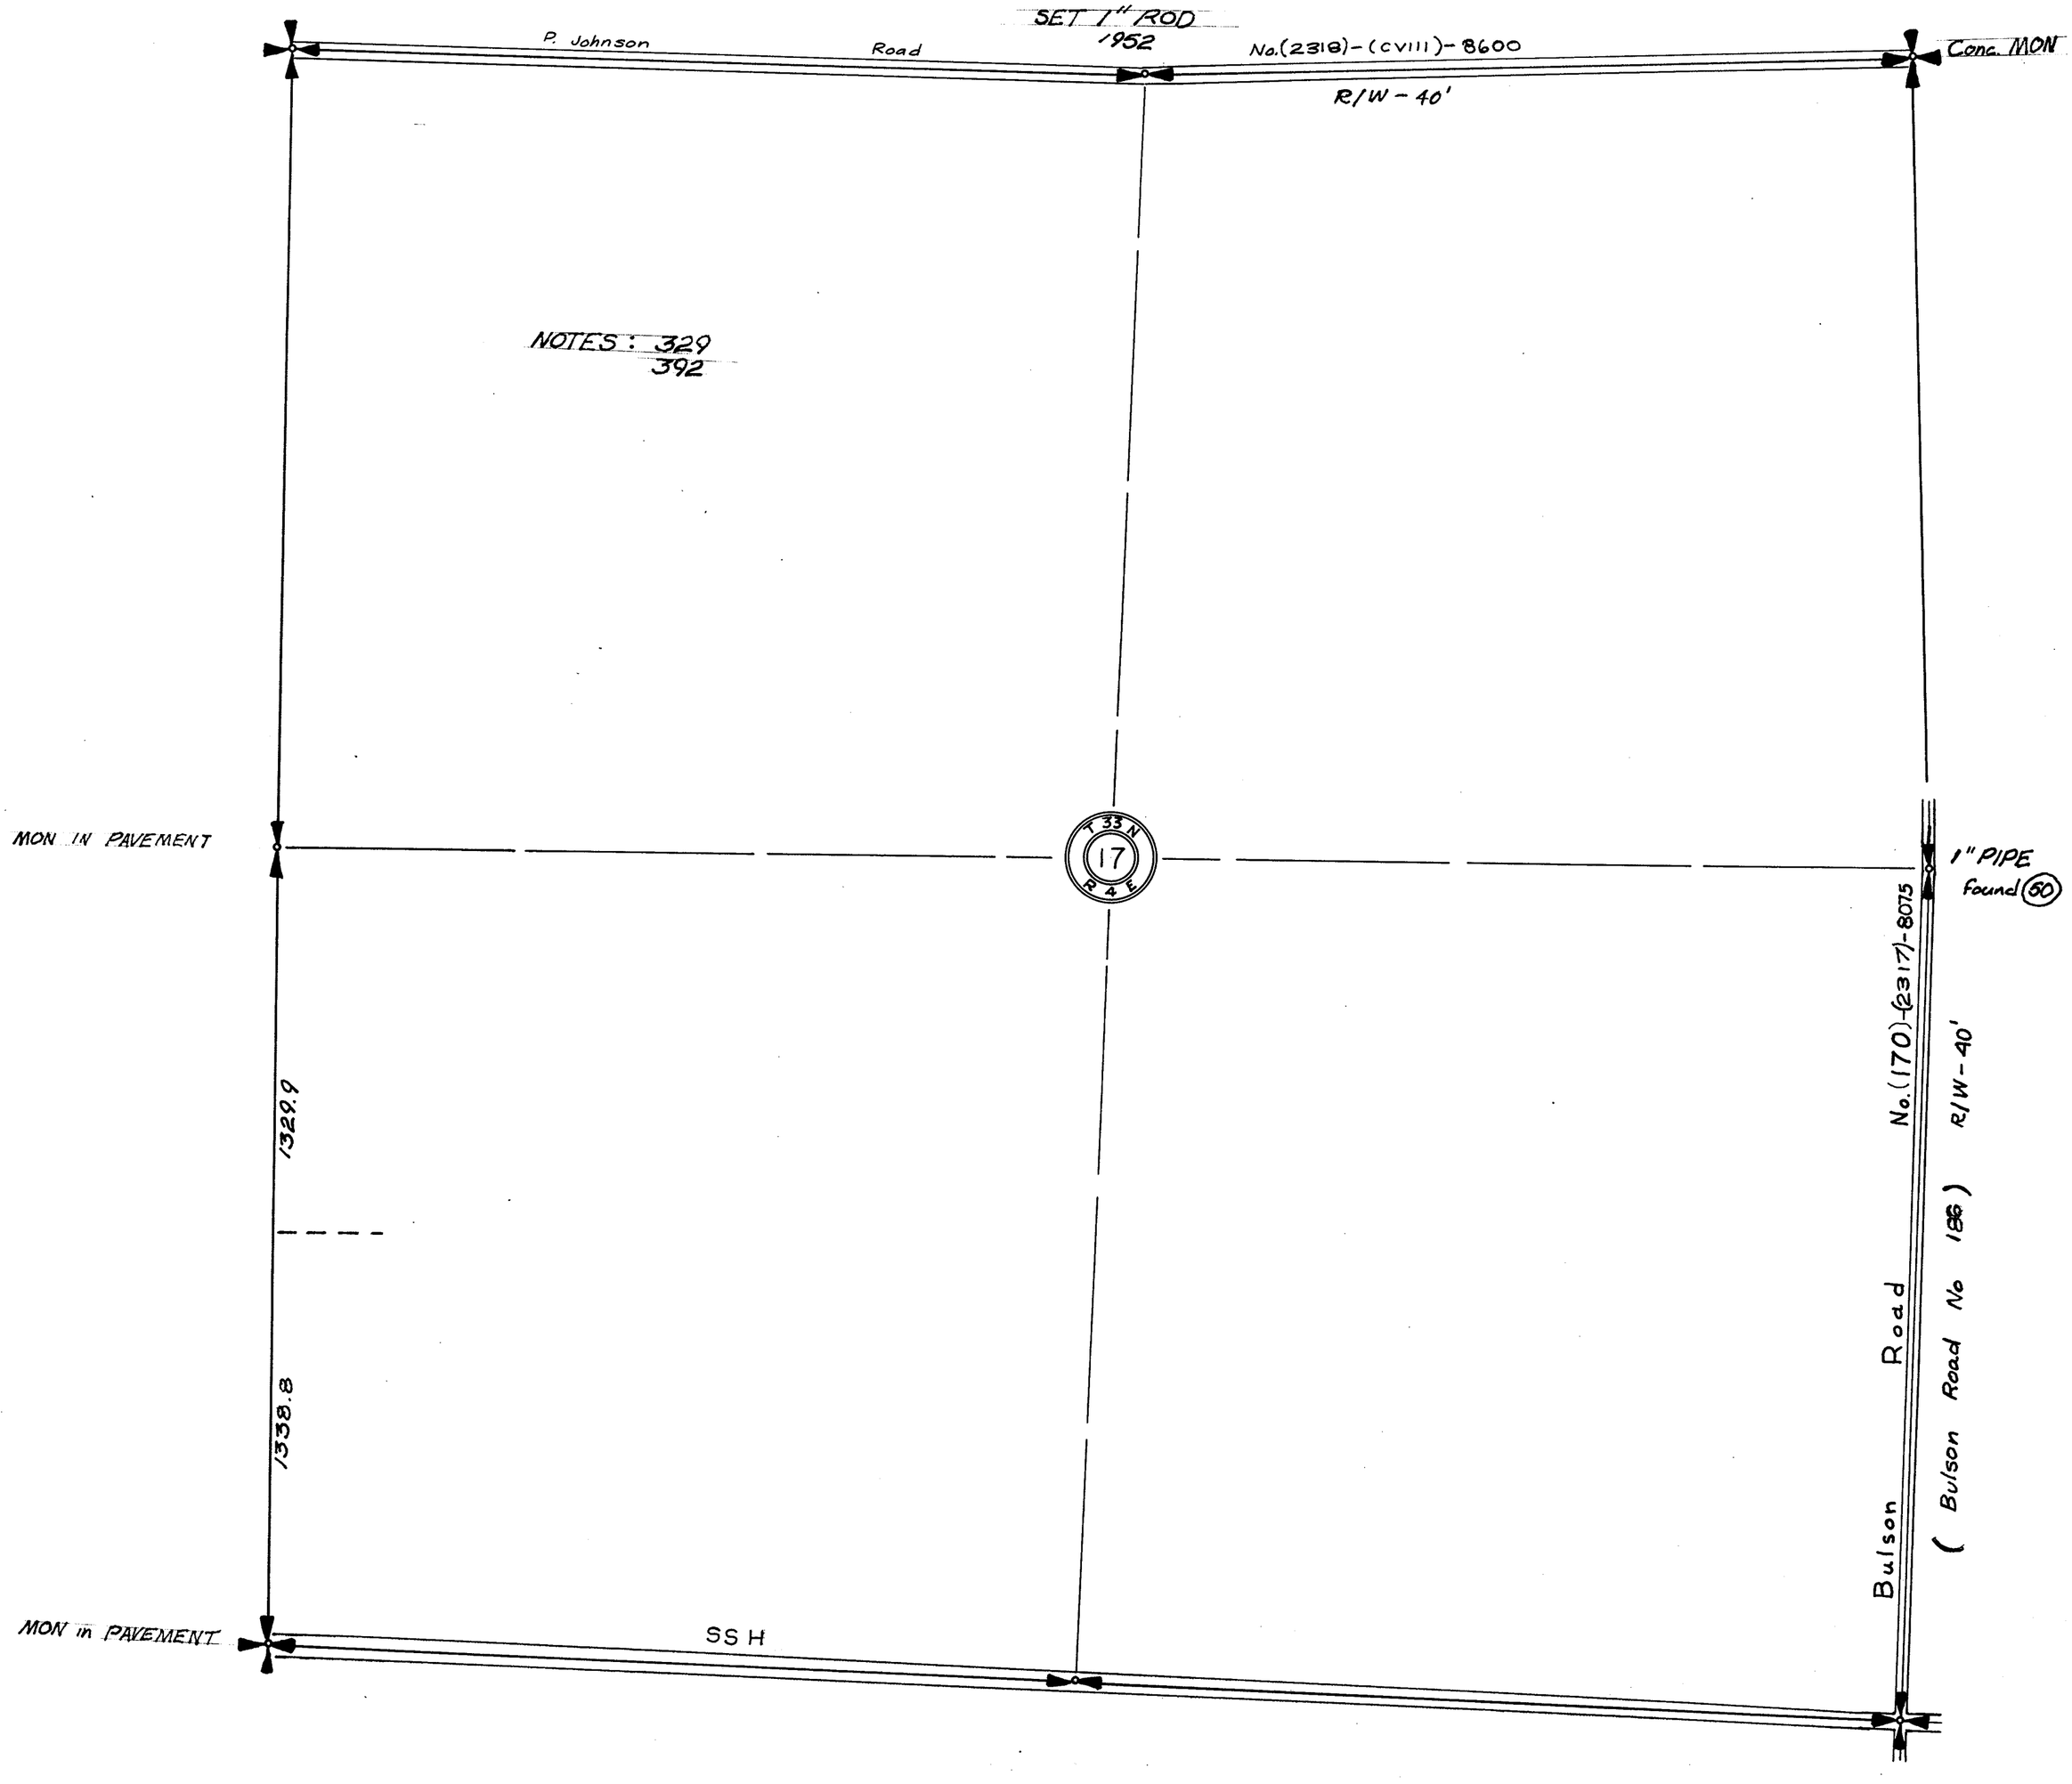


SECTION 18

TOWNSHIP 33 NORTH, RANGE 4 EAST, W. M.
SKAGIT COUNTY, WASH.

SCALE 1 INCH = 400 FEET
Road No. 28 from Bk. 95, p. 7

A. L. Strong COUNTY ENGINEER
Road No. 139 & No. 28 added Sept. 1958

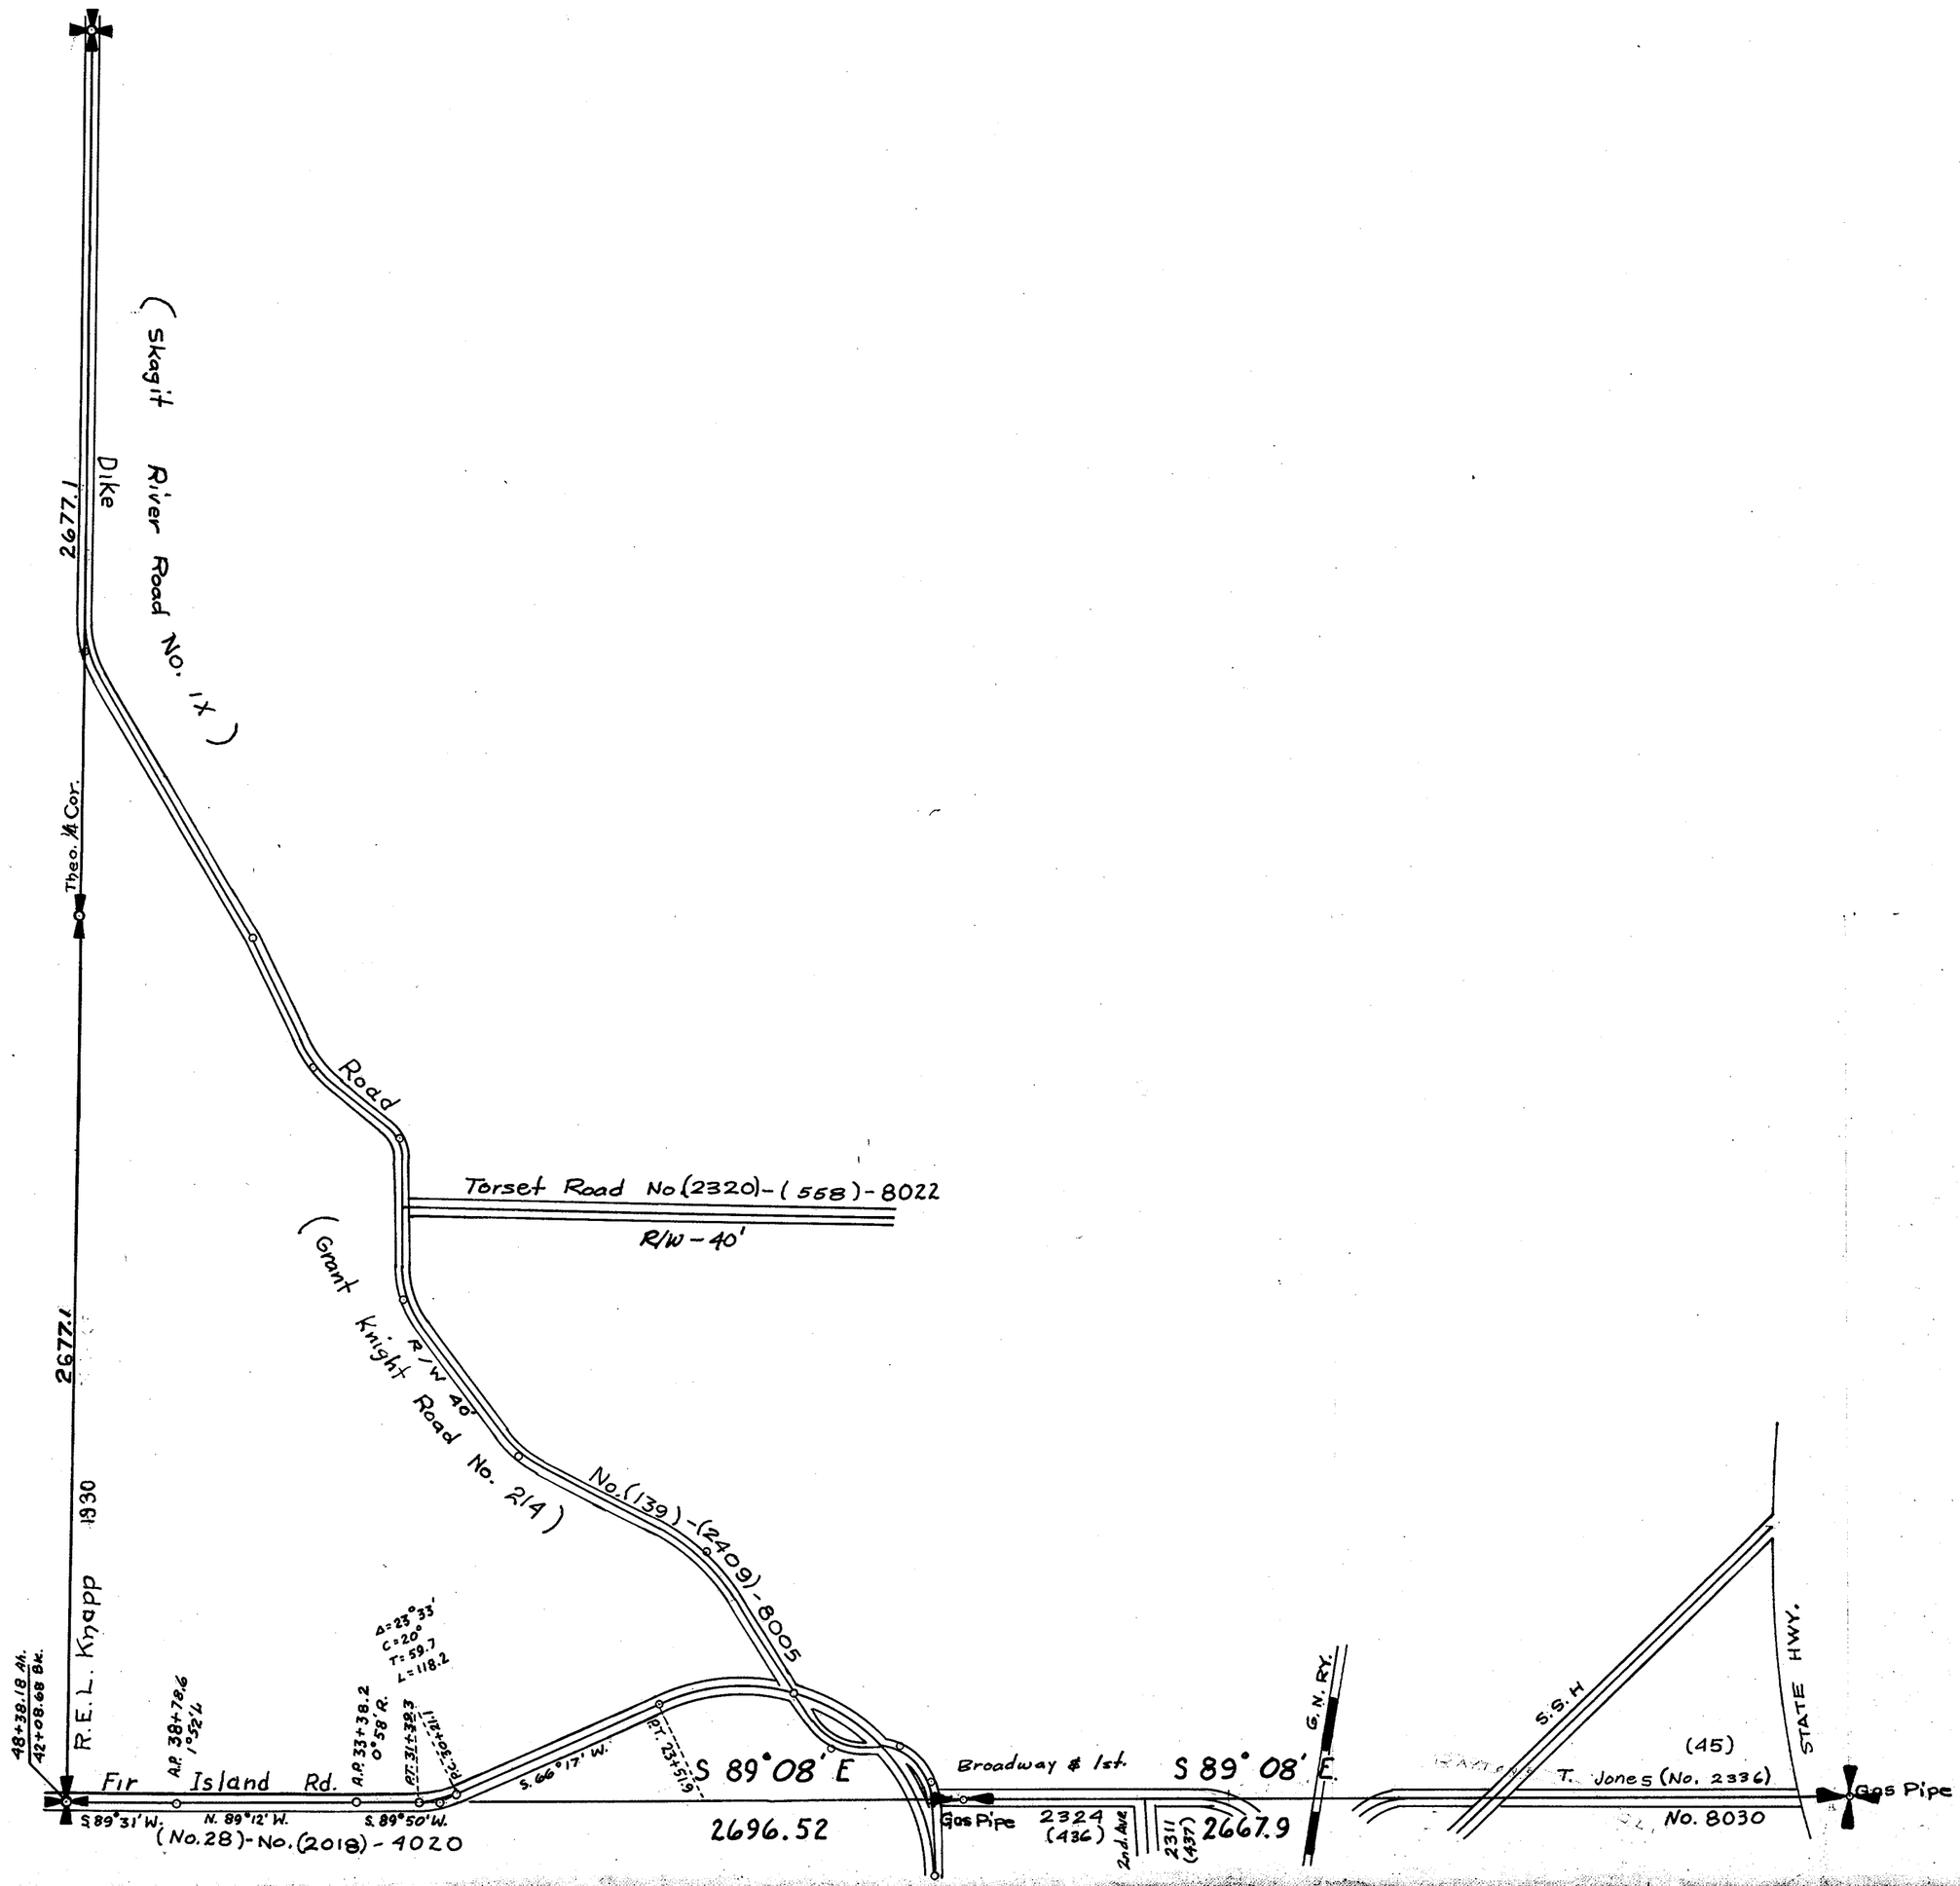

SECTION 19

TOWNSHIP 33 NORTH, RANGE 4. EAST, W. M.
SKAGIT COUNTY, WASH.

SCALE, 1 INCH--400 FEET

A. L. Strong COUNTY ENGINEER

Road No. 28 from BK. No. 95, p. 7

Fir Island Rd.

A.P. 38+78.6 1°52' L.

A.P. 33+38.2 0°58' R.

P.C. 32+39.3

P.T. 33+21.1

S 66° 17' W.

S 89° 08' E

2696.52

S 89° 08' E

Changed (Broadway & 1st.) No. 2324

Gas Pipe (436)

T. Jones

Road (No. 2336)

69-5

Gas Pipe

S.89° 31' W.

N. 89° 12' W.

S.89° 50' W.

No. 28

Δ = 23° 33'

C = 20°

T = 59.7

L = 118.2

48+38.18 Ahead

42+08.68 Back

(No. 2018)-(28)

No. 4020

(C. Mann Road)

8545 (437) (No. 2311)

2667.9

TR. BK. NO. Page 50

(No. 45) No. 8030

STATE HWY

Main Street

2nd.

(No. 2322)-(50)

No. 8029

R/W - 40'

No. (2310)-(34)-4541

Mann Road

S. S. HWY.

SECTION 19


TOWNSHIP 33 NORTH, RANGE 4 EAST, W. M.

SKAGIT COUNTY, WASH.

SCALE, 1 INCH -- 400 FEET

DATE August 1968

Lloyd Johnson COUNTY ENGINEER

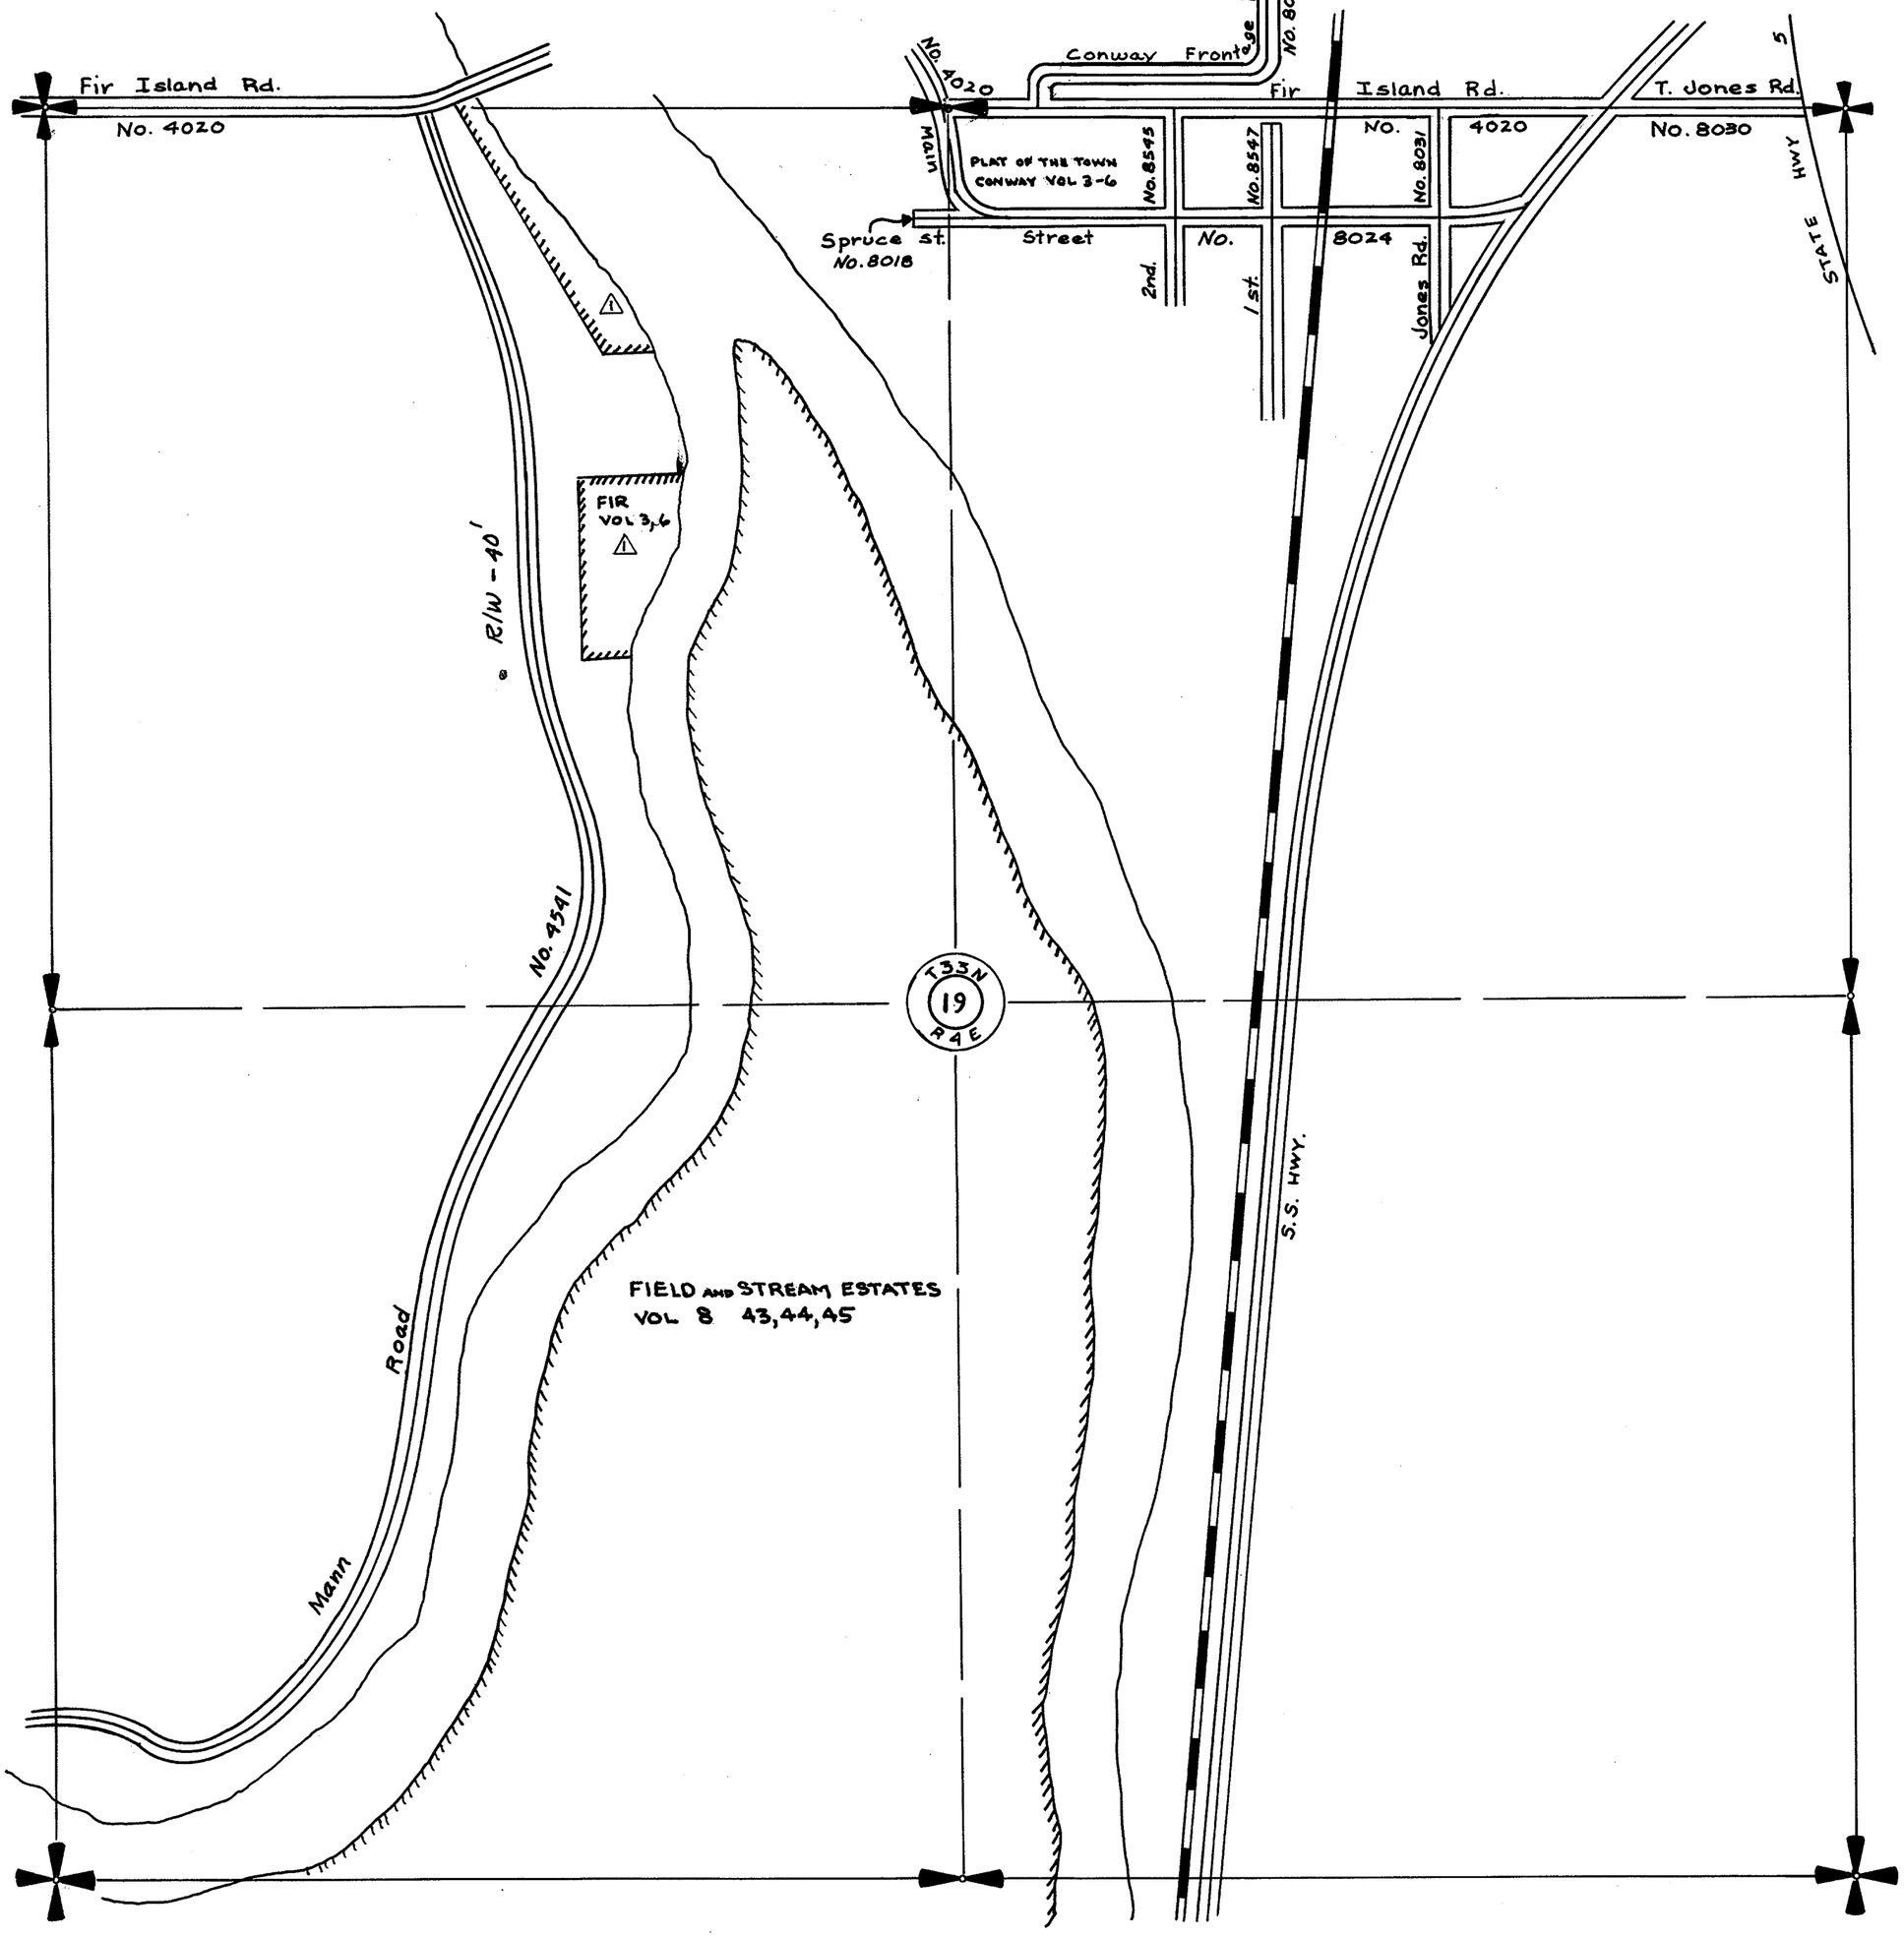

SECTION 20

TOWNSHIP 33 NORTH, RANGE 4 EAST, W. M.

SKAGIT COUNTY, WASH.

DATE Aug. 13, 1963 — Lloyd Johnson — COUNTY ENGINEER

SCALE, 1 INCH--400 FEET

Tel. Pole (32) — 55.20 — 35.30 — Tel. Pole (32)

1" Pipe — N 89°58'W — 2683.5 — S.S.H. — Tel. Pole (32) — 20.70' E — 1" Pipe — 2754.5 — N 89°57'W — T. Pole (32) — 28.30 — 54.20 — Guy Pole (32) — 3/4" Pipe .4 below oil

52.30 — Power Pole (32)

62.50 — S.E. Truss Post (32)

No. 534 — 1377.6 — 1377.6 — 40.70 — P. Pole #4405 (32)

5436.8

Notes: 202
281

1343.8 — 2687.6 — S 1°43'E — 2666.4 — 2667.68 — (668) - (2328) — No. 8500 — 90° 2'

1337.2 — 1337.2 — 1367.3 — R/W-30' — 1367.3

N 89°49'30"E — Road — N 89°50'E 2732.3 — No. (170) - (2317) — 0075 — 1323.30 — 2646.51 — 2646.50

Conway Hill — (Holmes Road No. CV)

29.00 — T. Pole — 69.10 — Tack

S 1°17'E — S 0° 20'E — N 1°36'E — 2637.21 — 2645.34

1343.8

N 89°37'E — 2662.76 — 2662.75 — T-33-N — 20 — R-4-E — 2710.07 — 2710.11 — 2710.24 — 1¼" Pipe — 10" deep

10.50 — F. Post — 7.10 — F. Post — U.S. Highway 99 — 20.80 — F. Post — 25.00 — T. Pole — 28.30 — Stub P. Pole

5372.86

5372.83

Road — R/W - 40' — Bulson

F. Post — 17.20 — 1½" Pipe 12" deep — 11.40 — F. Post

SECTION 20


TOWNSHIP 33 NORTH, RANGE 4 EAST, W. M.

SKAGIT COUNTY, WASH.

SCALE, 1 INCH--400 FEET

DATE June, 1959

Frank Gilkey COUNTY ENGINEER

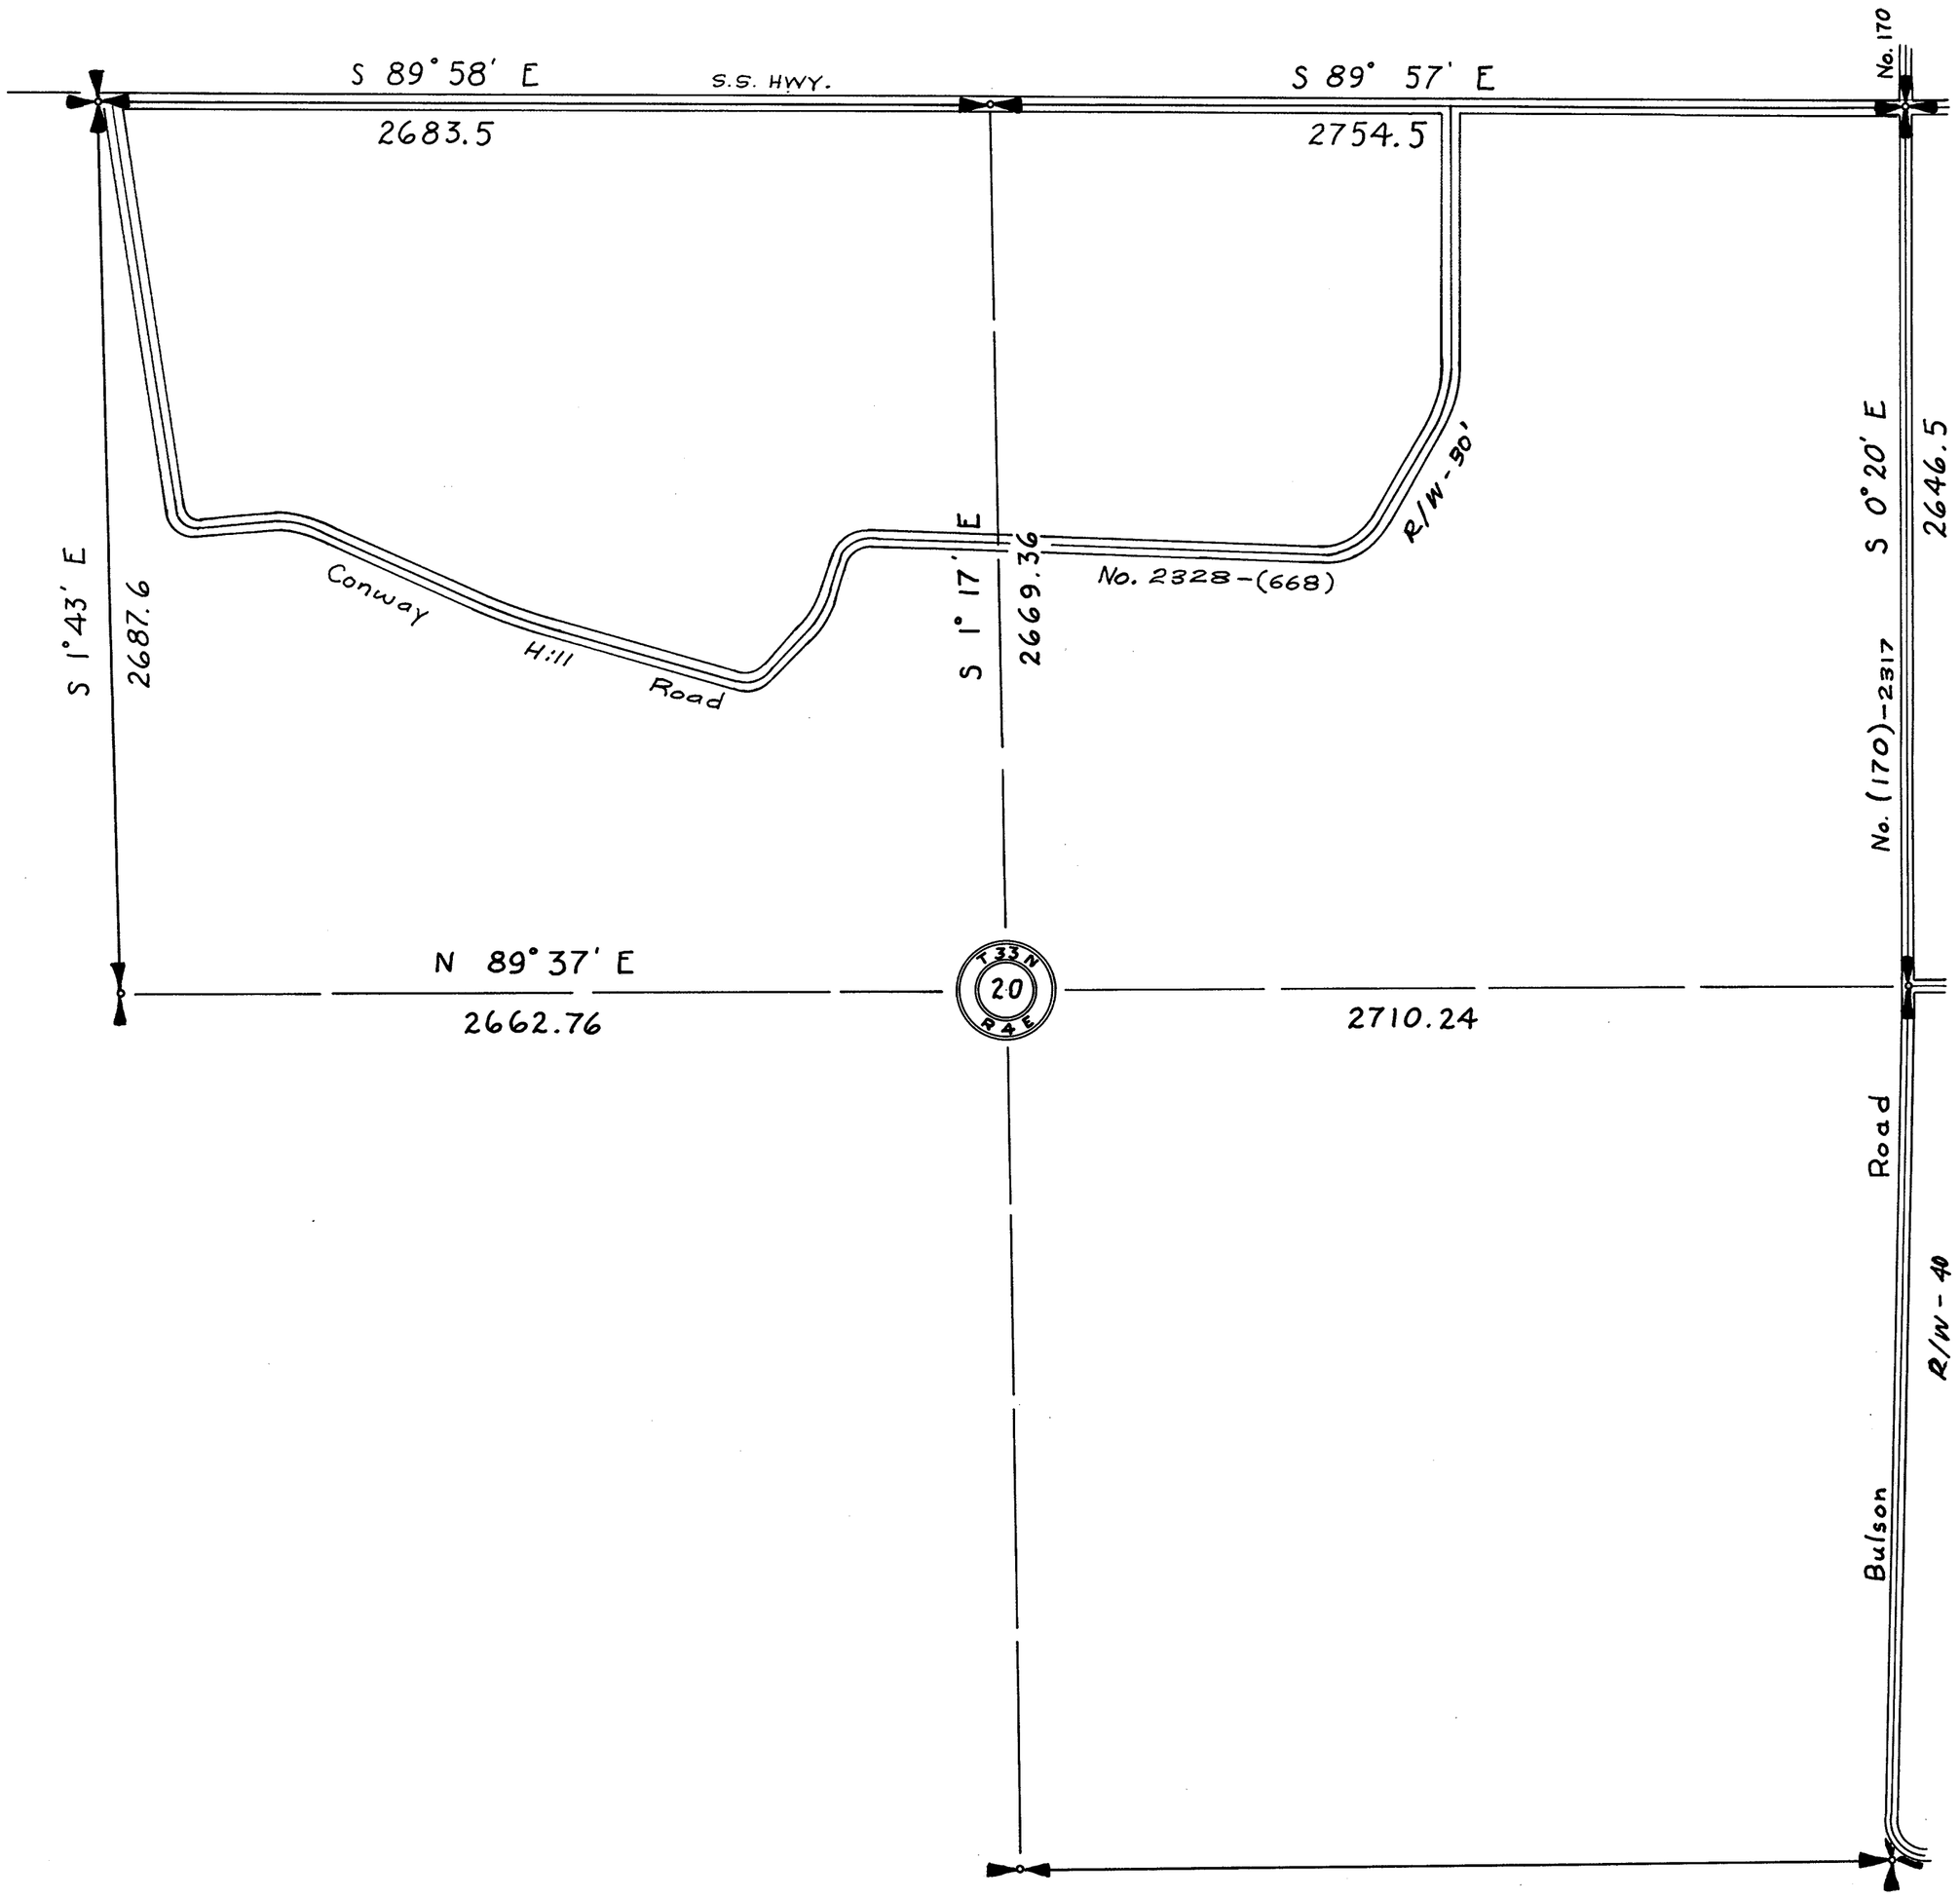


SECTION 20

TOWNSHIP 33 NORTH, RANGE 4 EAST, W. M.

SKAGIT COUNTY, WASH.

SCALE, 1 INCH—400 FEET

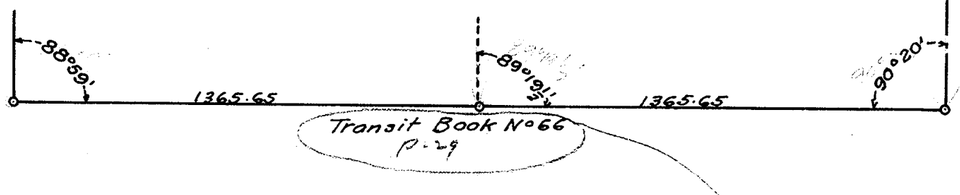

Transit Book No 66
p. 29

A. L. STRONG COUNTY ENGINEER


SECTION 20

TOWNSHIP 33 NORTH, RANGE 4 EAST, W. M.

SKAGIT COUNTY, WASH.

SCALE, 1 INCH--400 FEET

FRANK GILKEY COUNTY ENGINEER

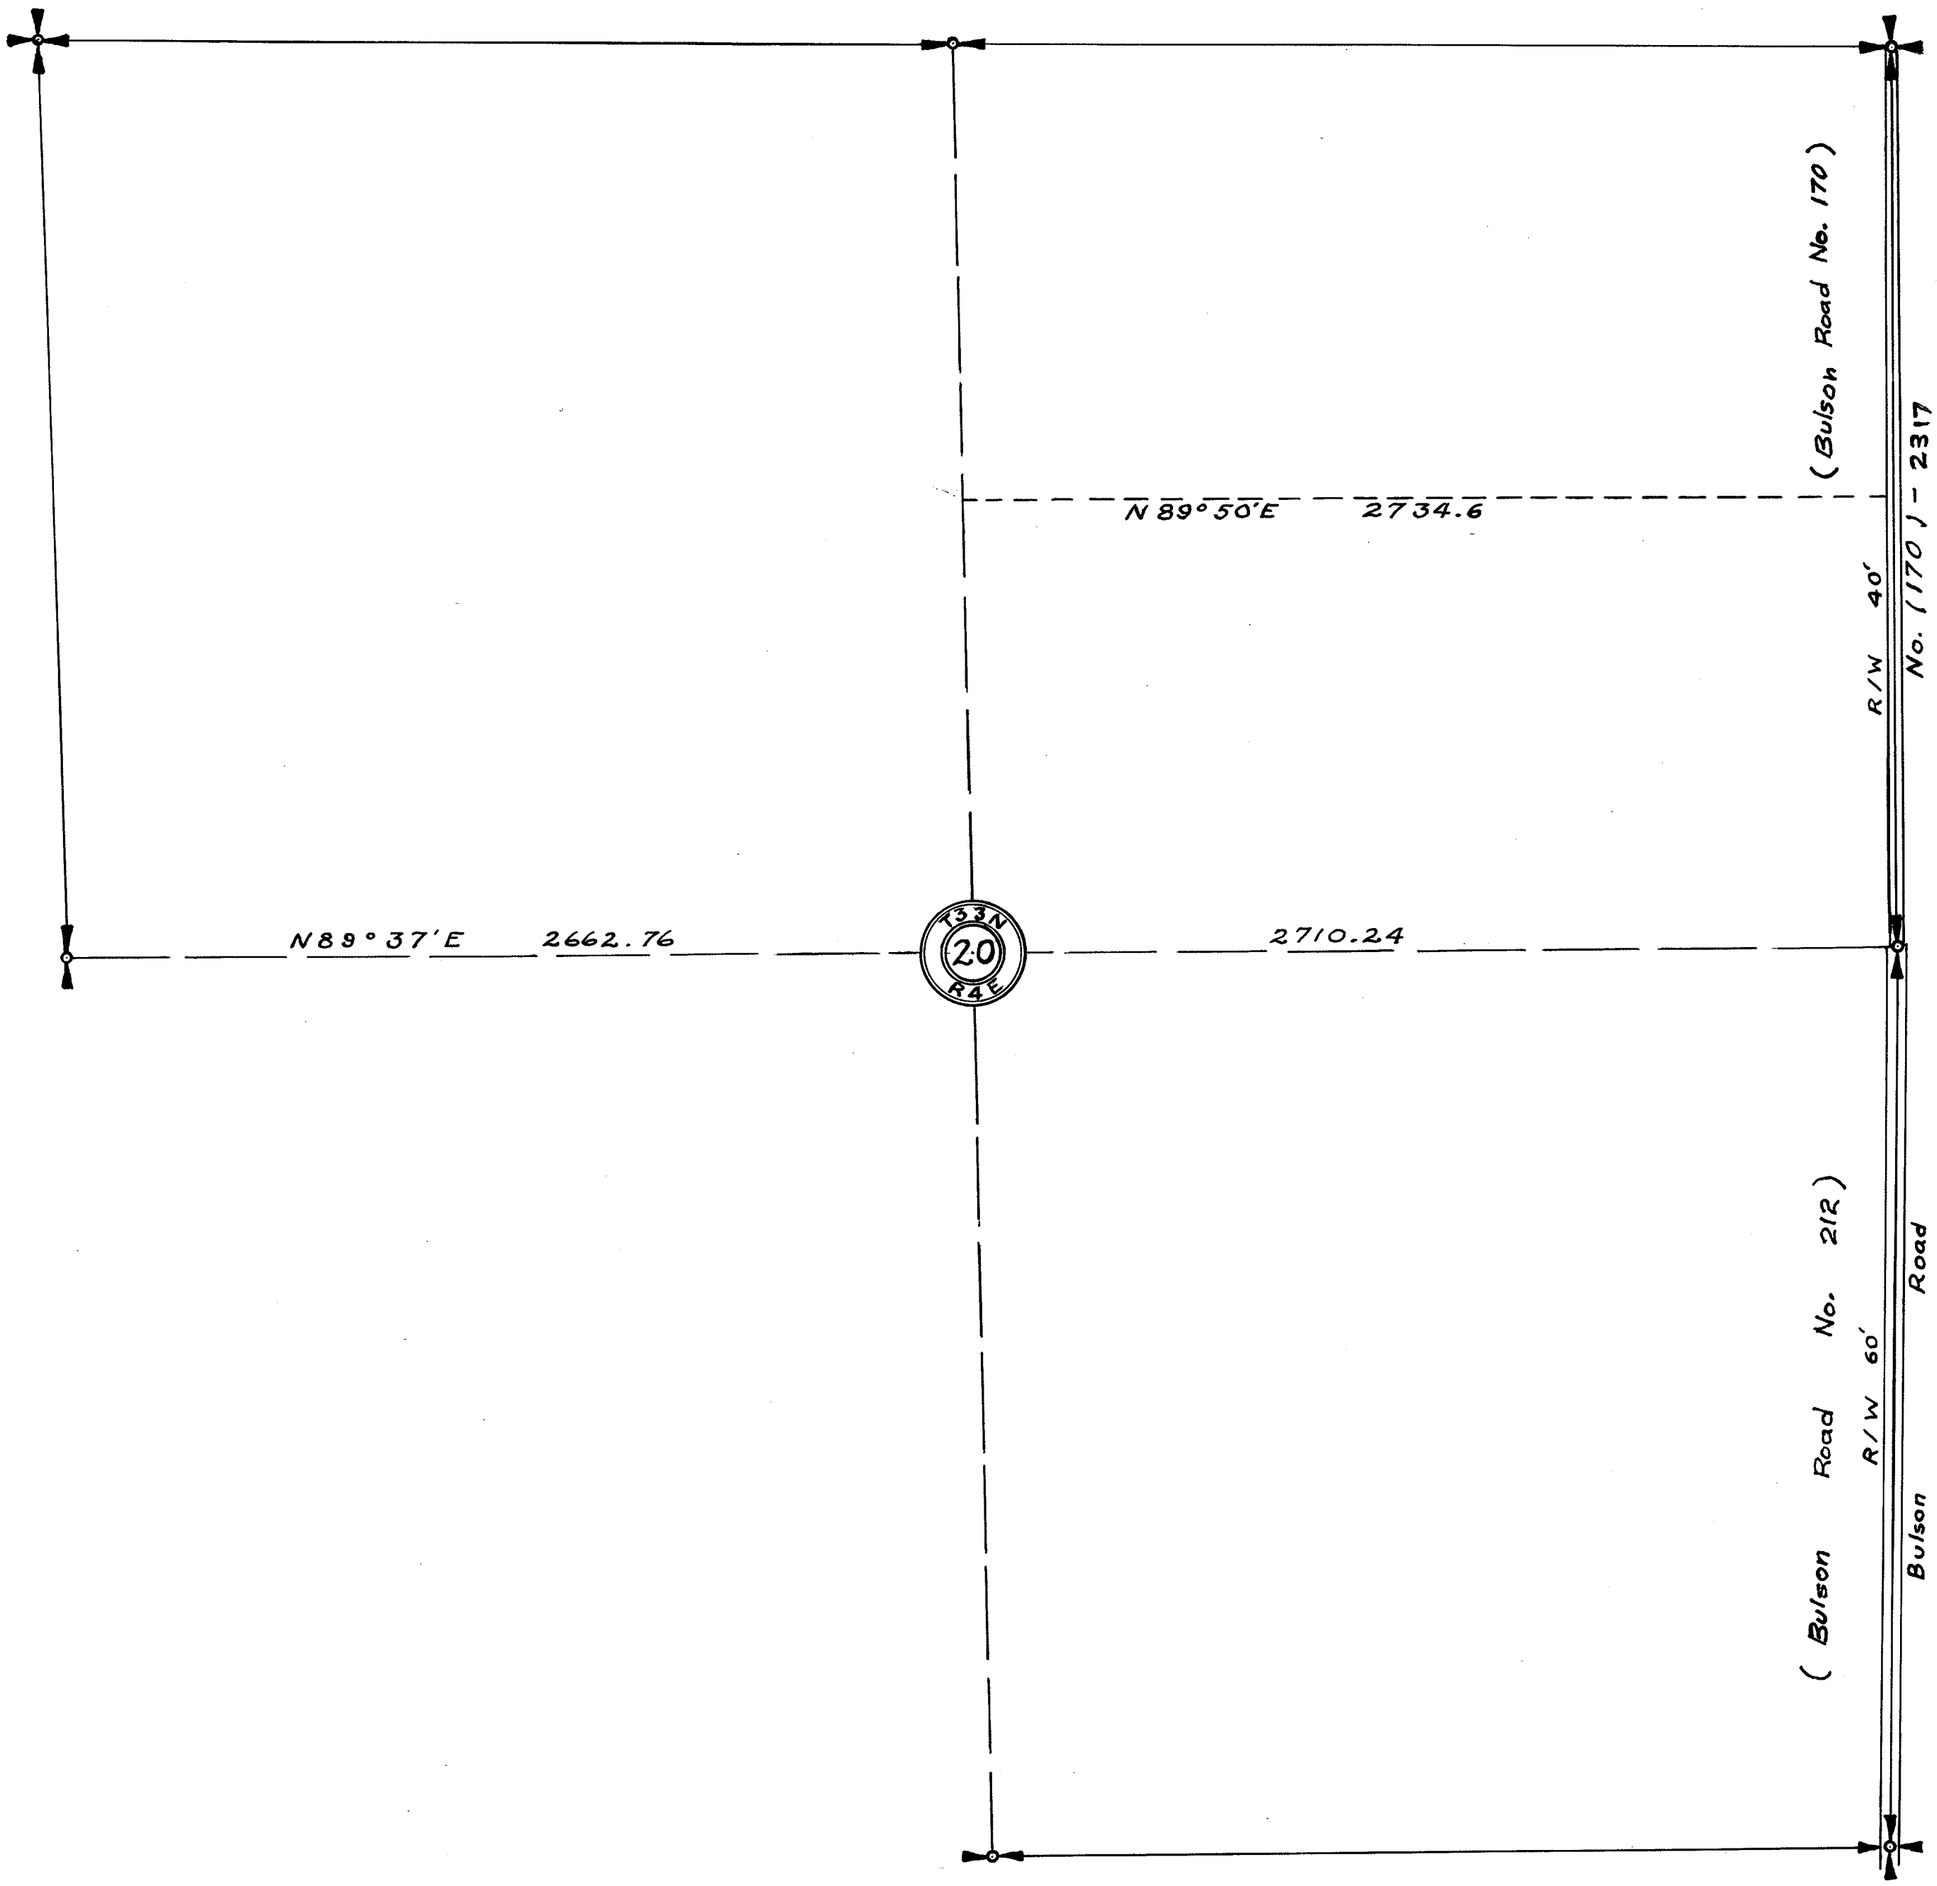

SECTION 20


TOWNSHIP 33 NORTH, RANGE ~~4~~ EAST, W. M.

SKAGIT COUNTY, WASH.

1-1-32 H202

SCALE, 1 INCH--400 FEET

H.O. Walberg COUNTY ENGINEER

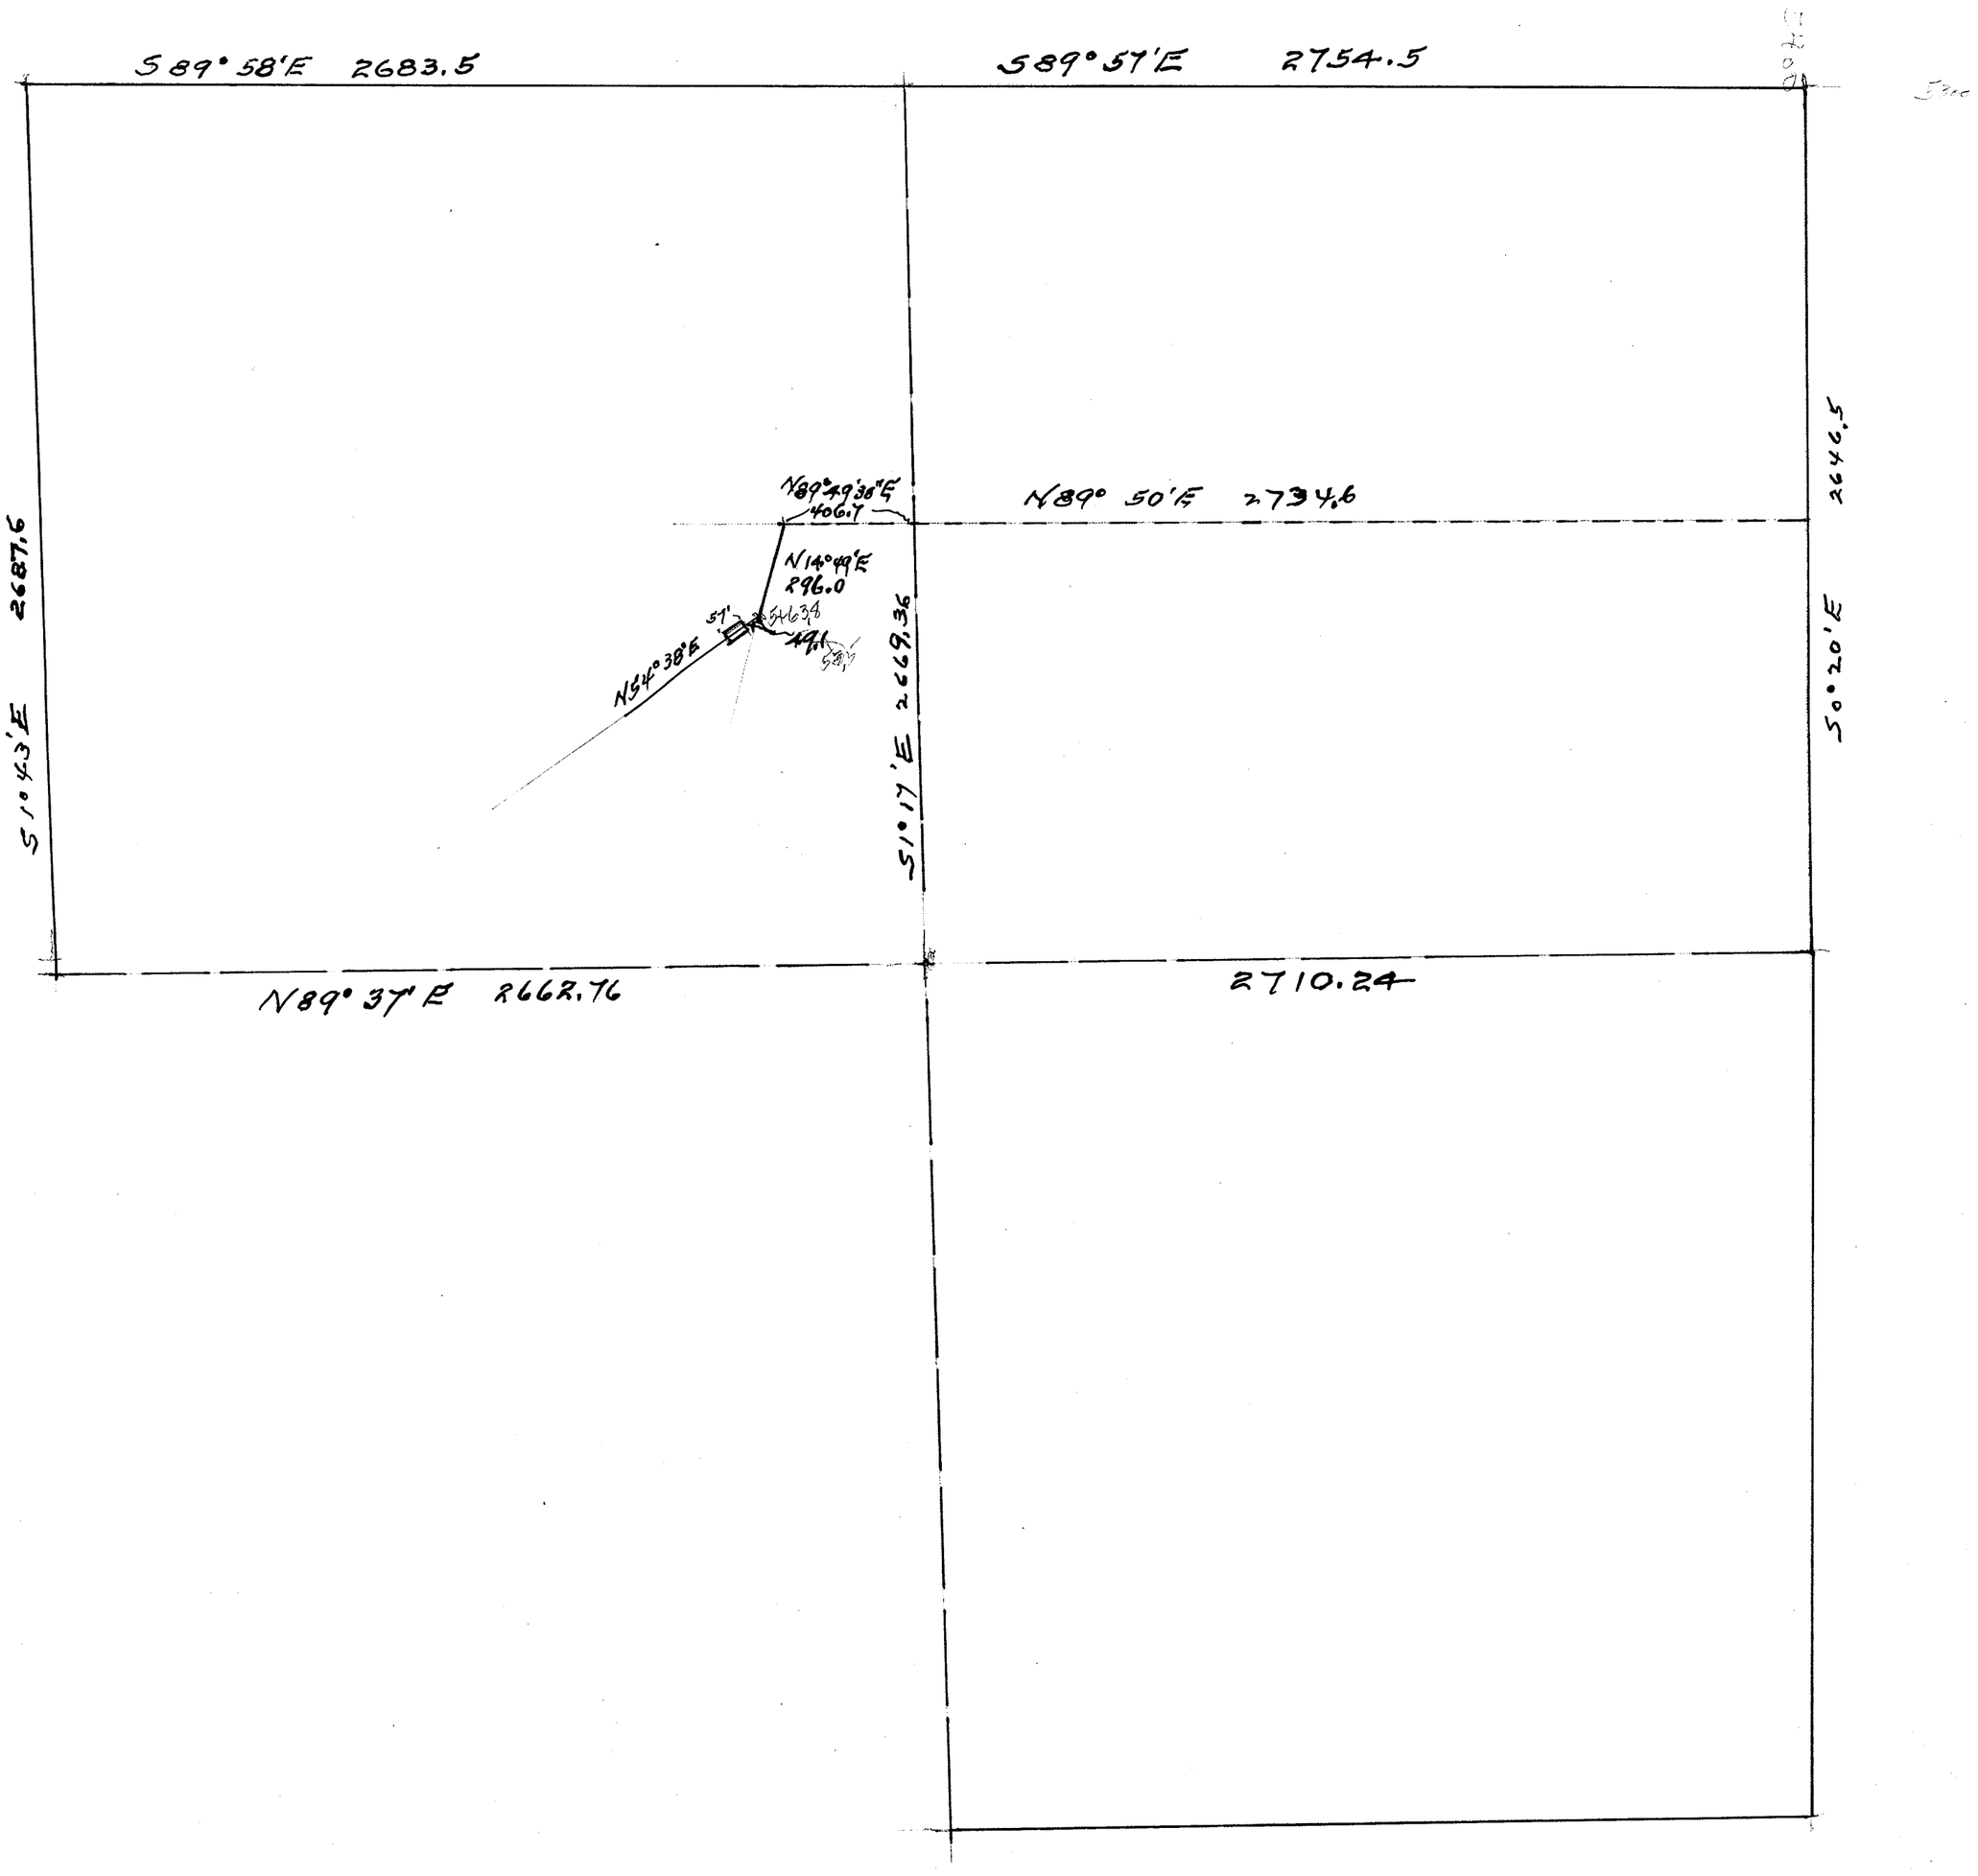


SECTION 21

TOWNSHIP 33 NORTH. RANGE 4 EAST. W. M.
SKAGIT COUNTY. WASH.

SCALE. 1 INCH = 100 FEET

L. H. Johnson COUNTY ENGINEER

DATE 3-15-74

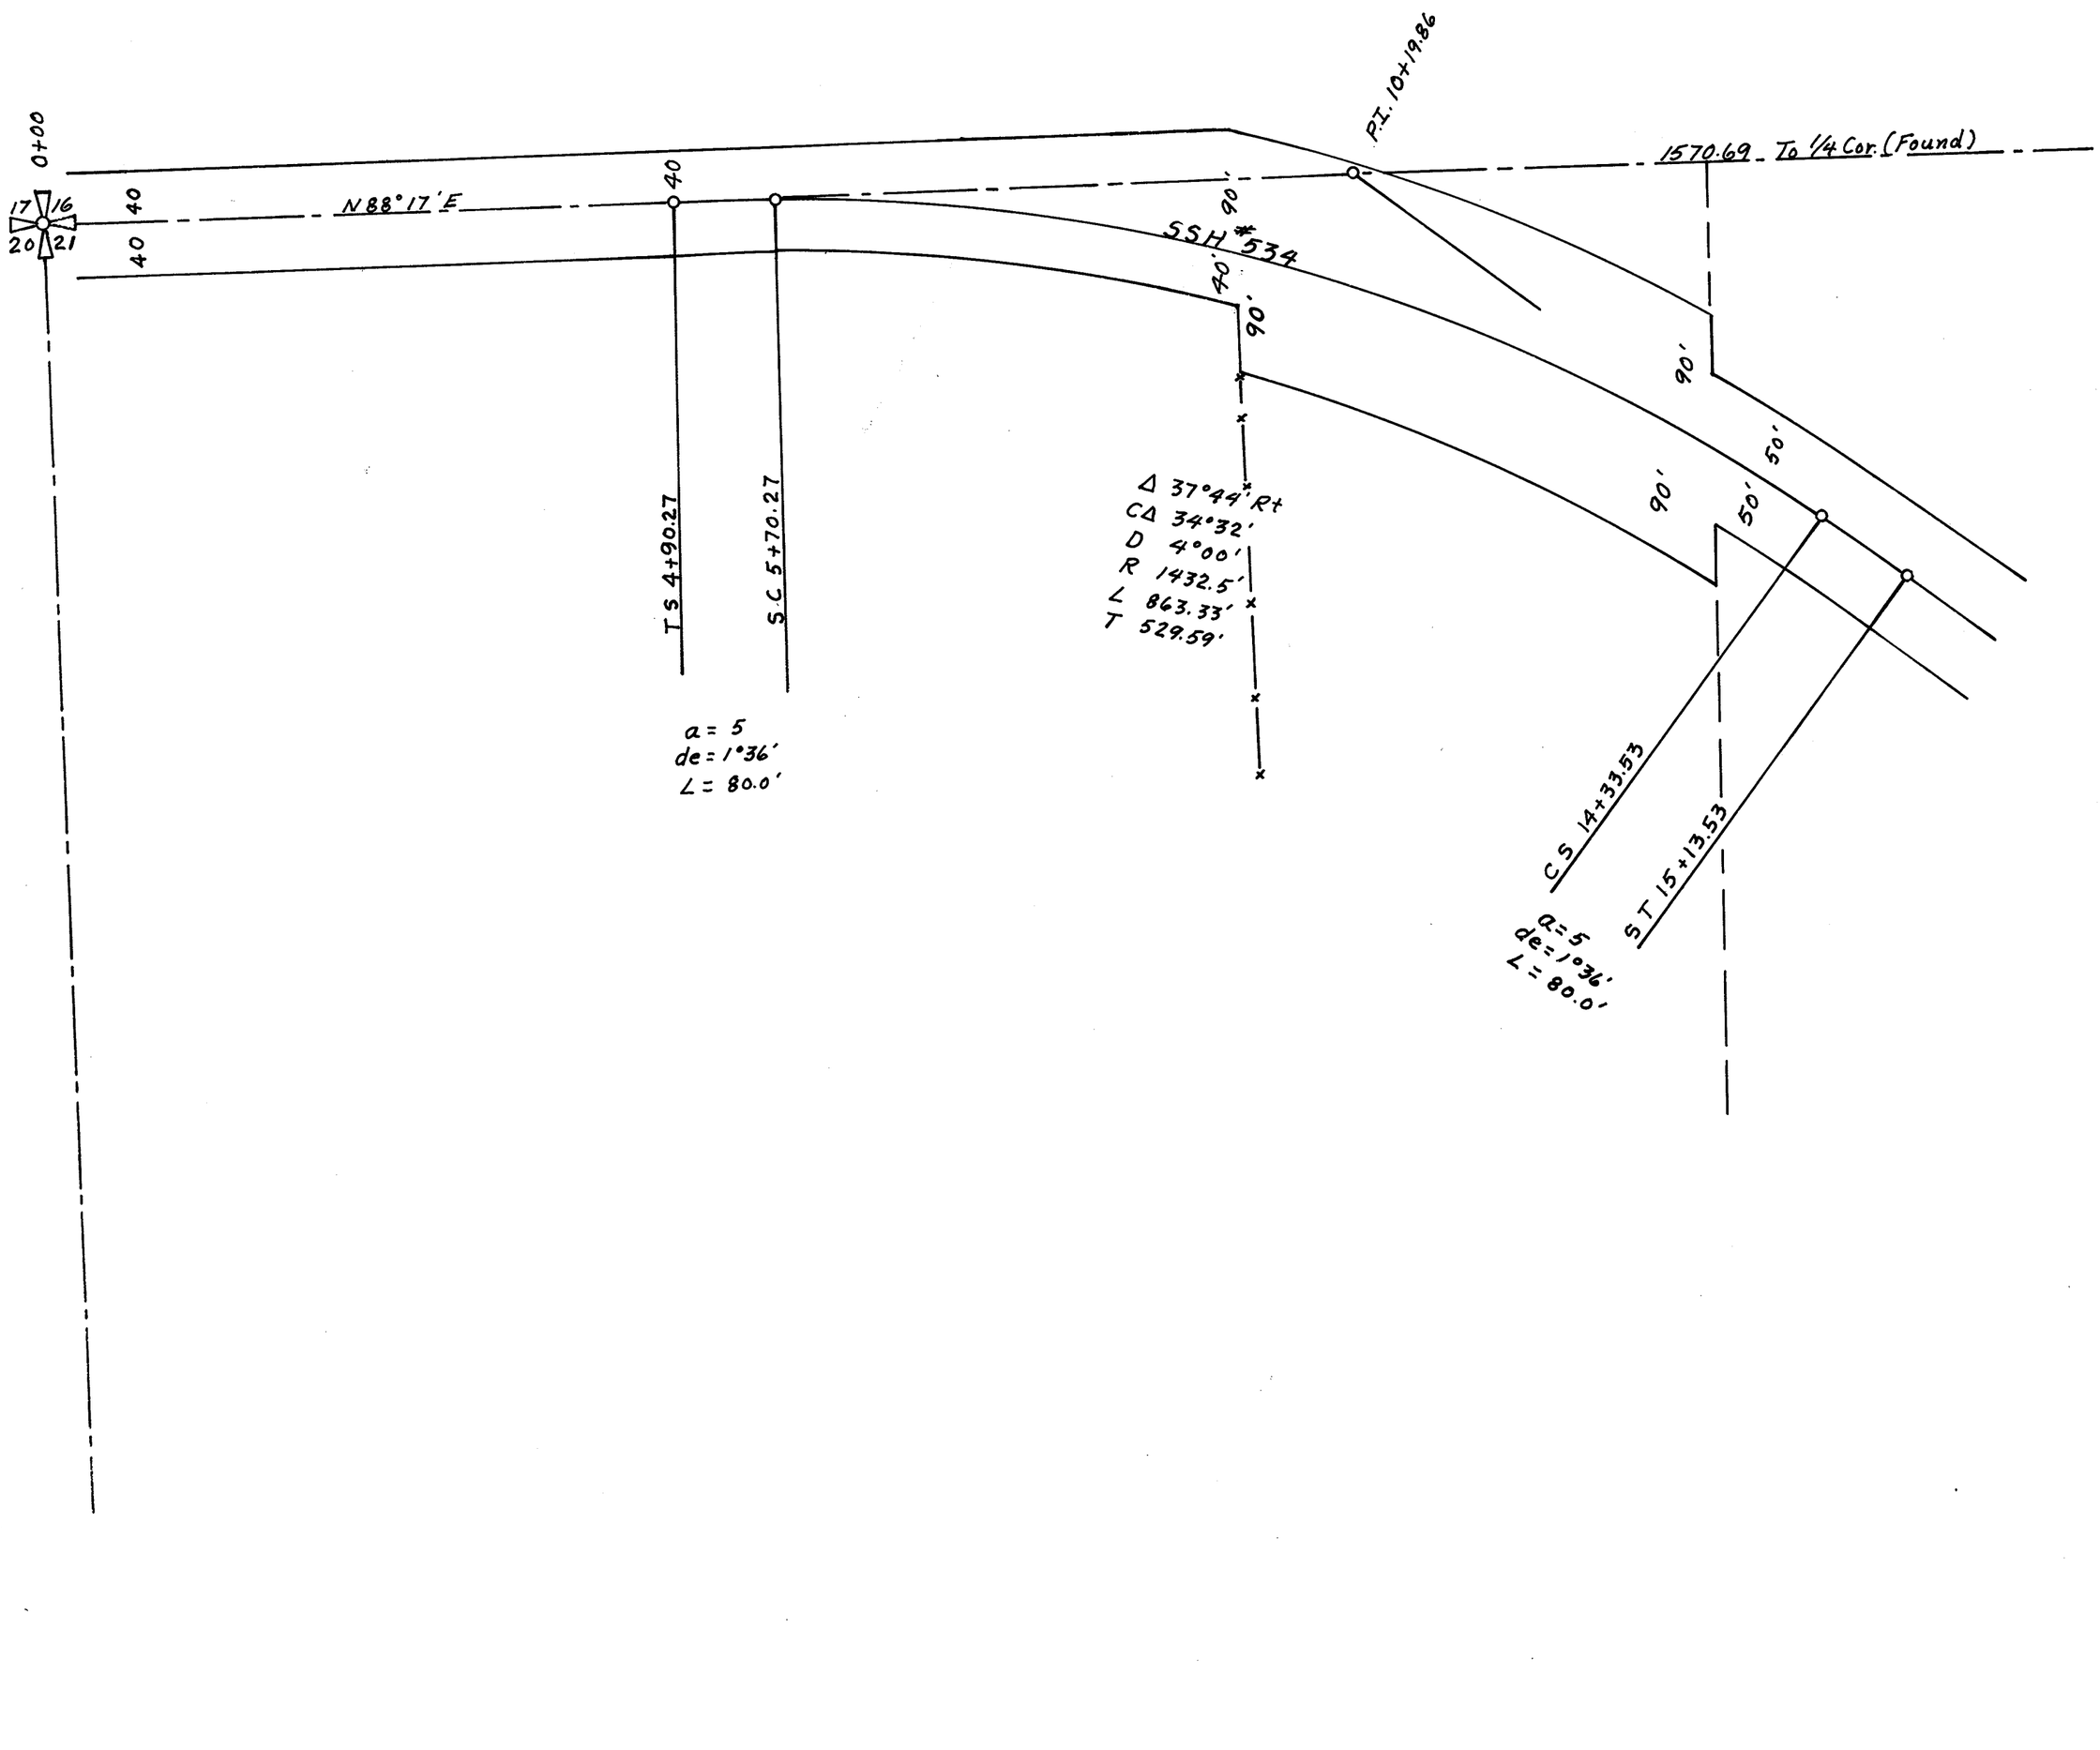


SECTION 21

TOWNSHIP 33 NORTH, RANGE 4 EAST, W. M.

SKAGIT COUNTY, WASH.

SCALE, 1 INCH--400 FEET

DATE June, 1959 Frank Gilkey COUNTY ENGINEER

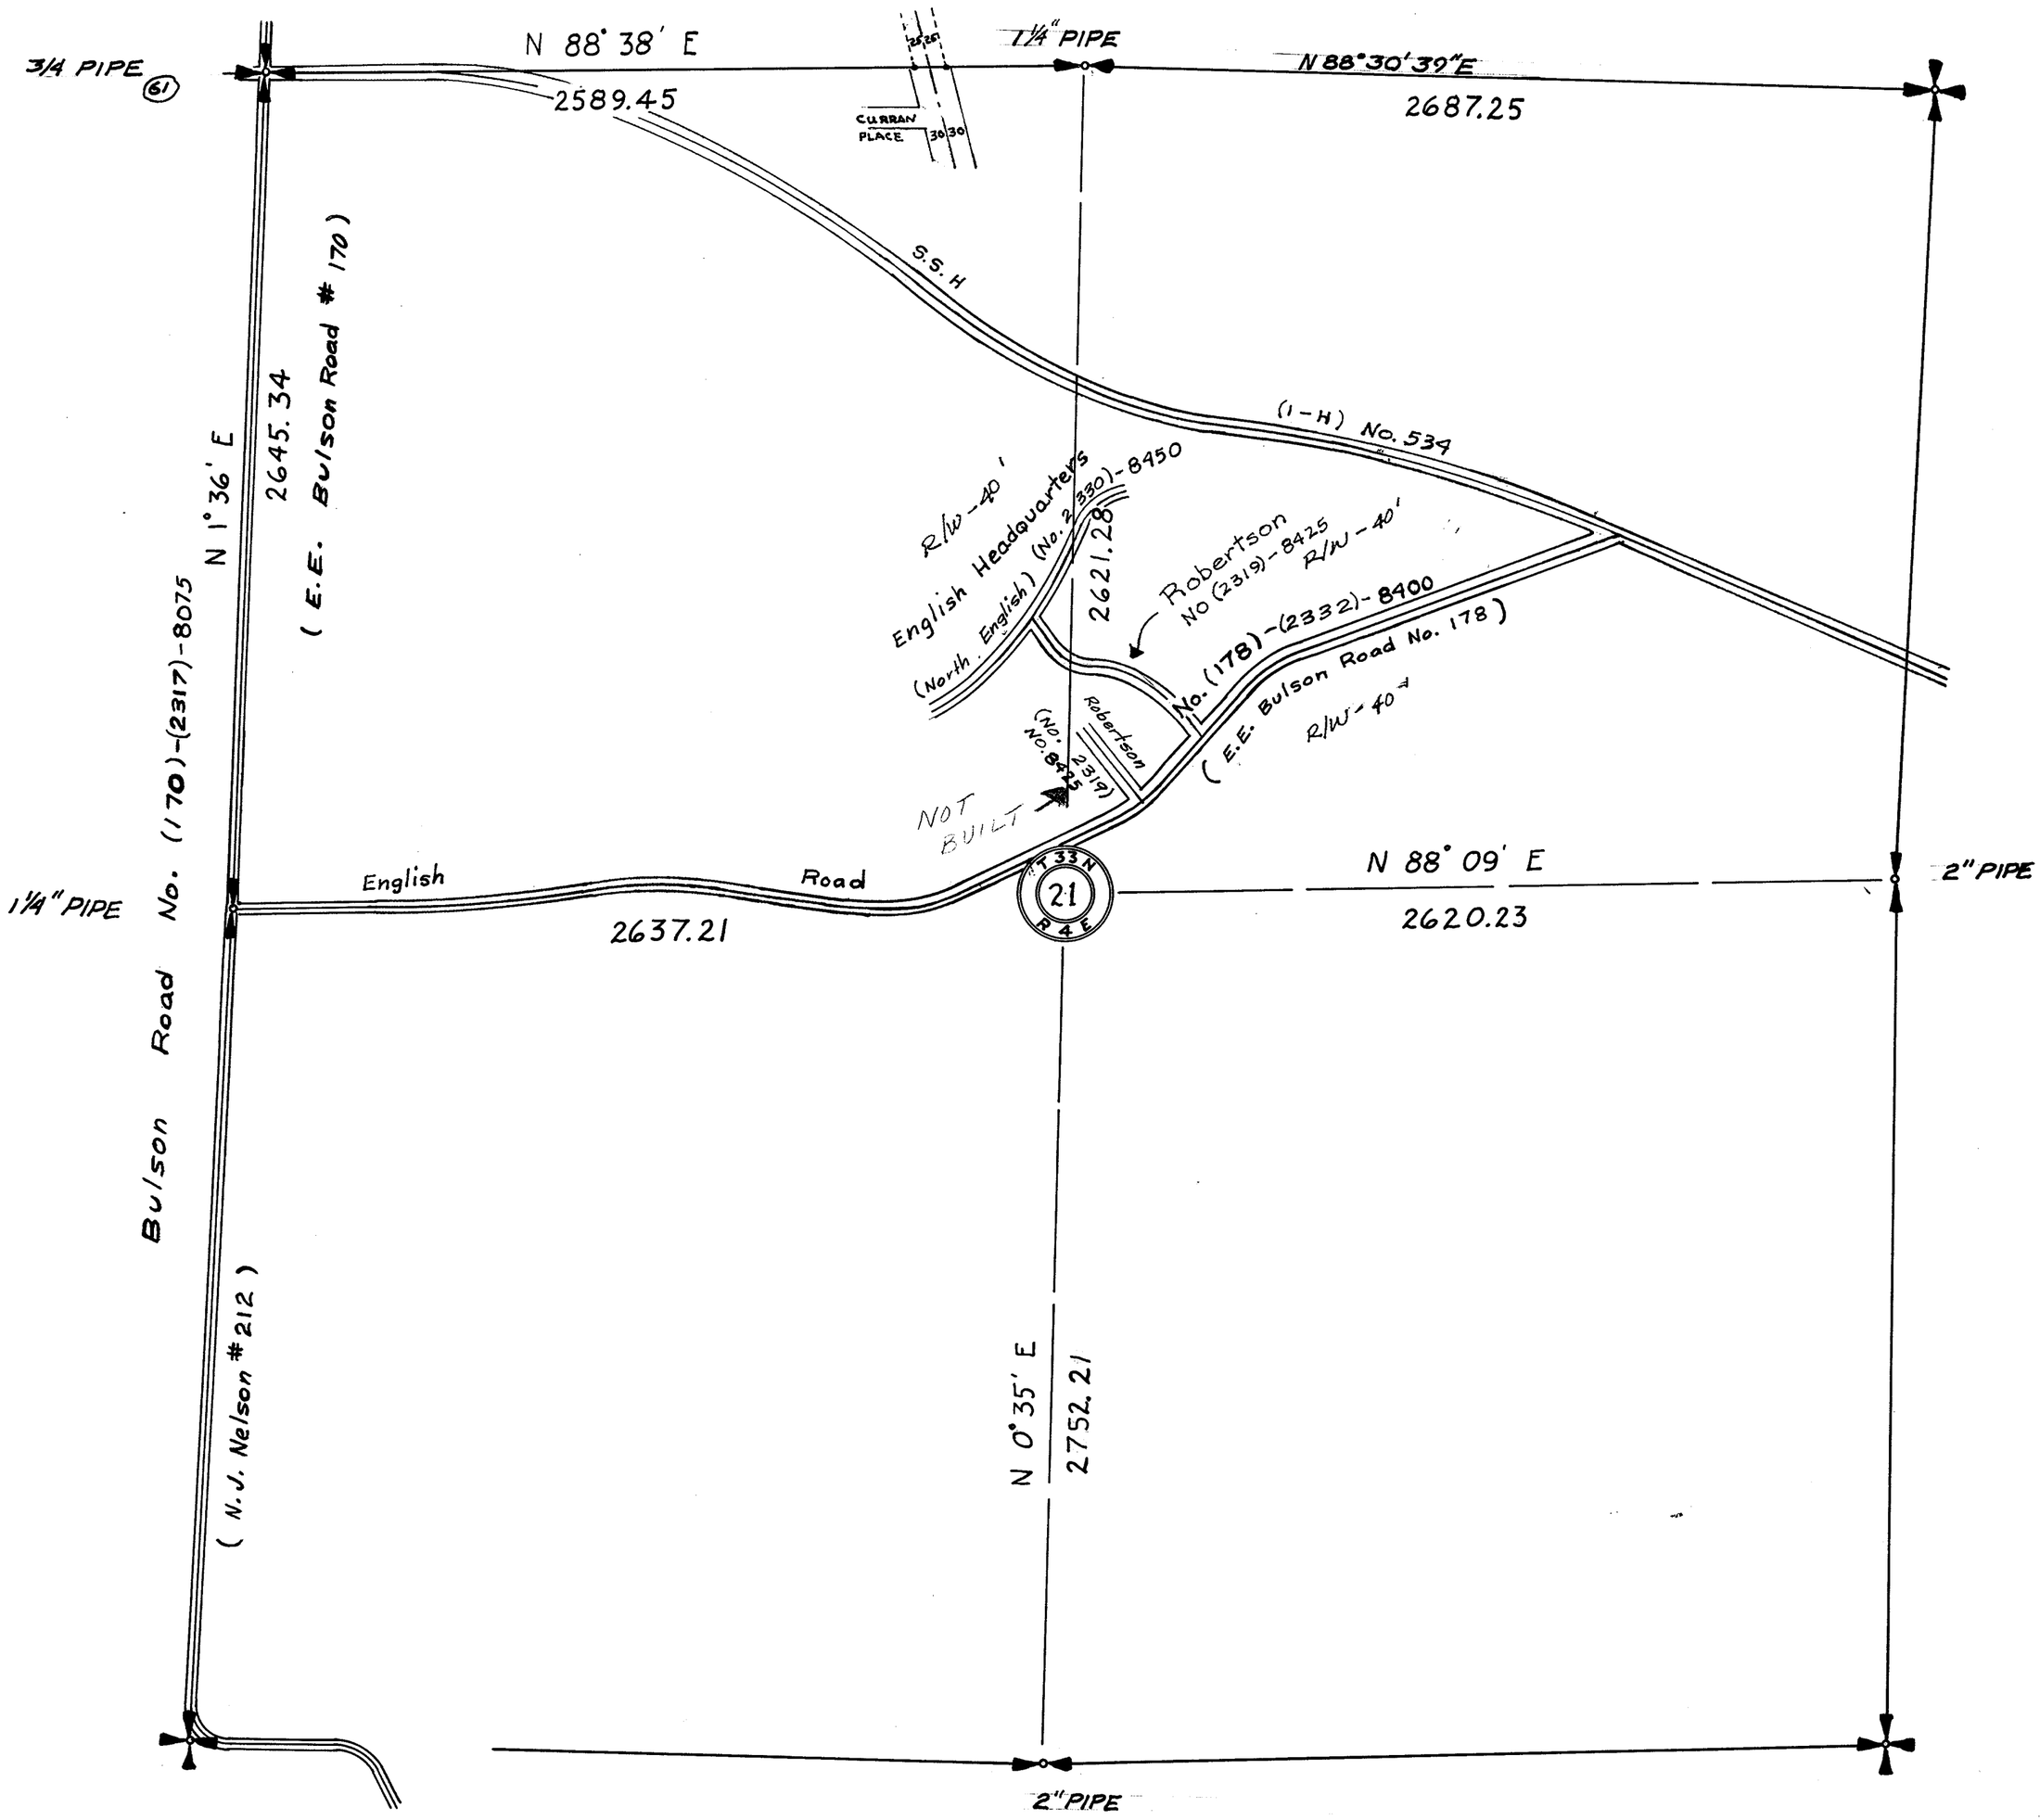

SECTION 21


TOWNSHIP 33 NORTH, RANGE 4 EAST, W. M.

SKAGIT COUNTY, WASH.

SCALE, 1 INCH -- 400 FEET

DATE August 1968

Lloyd Johnson COUNTY ENGINEER

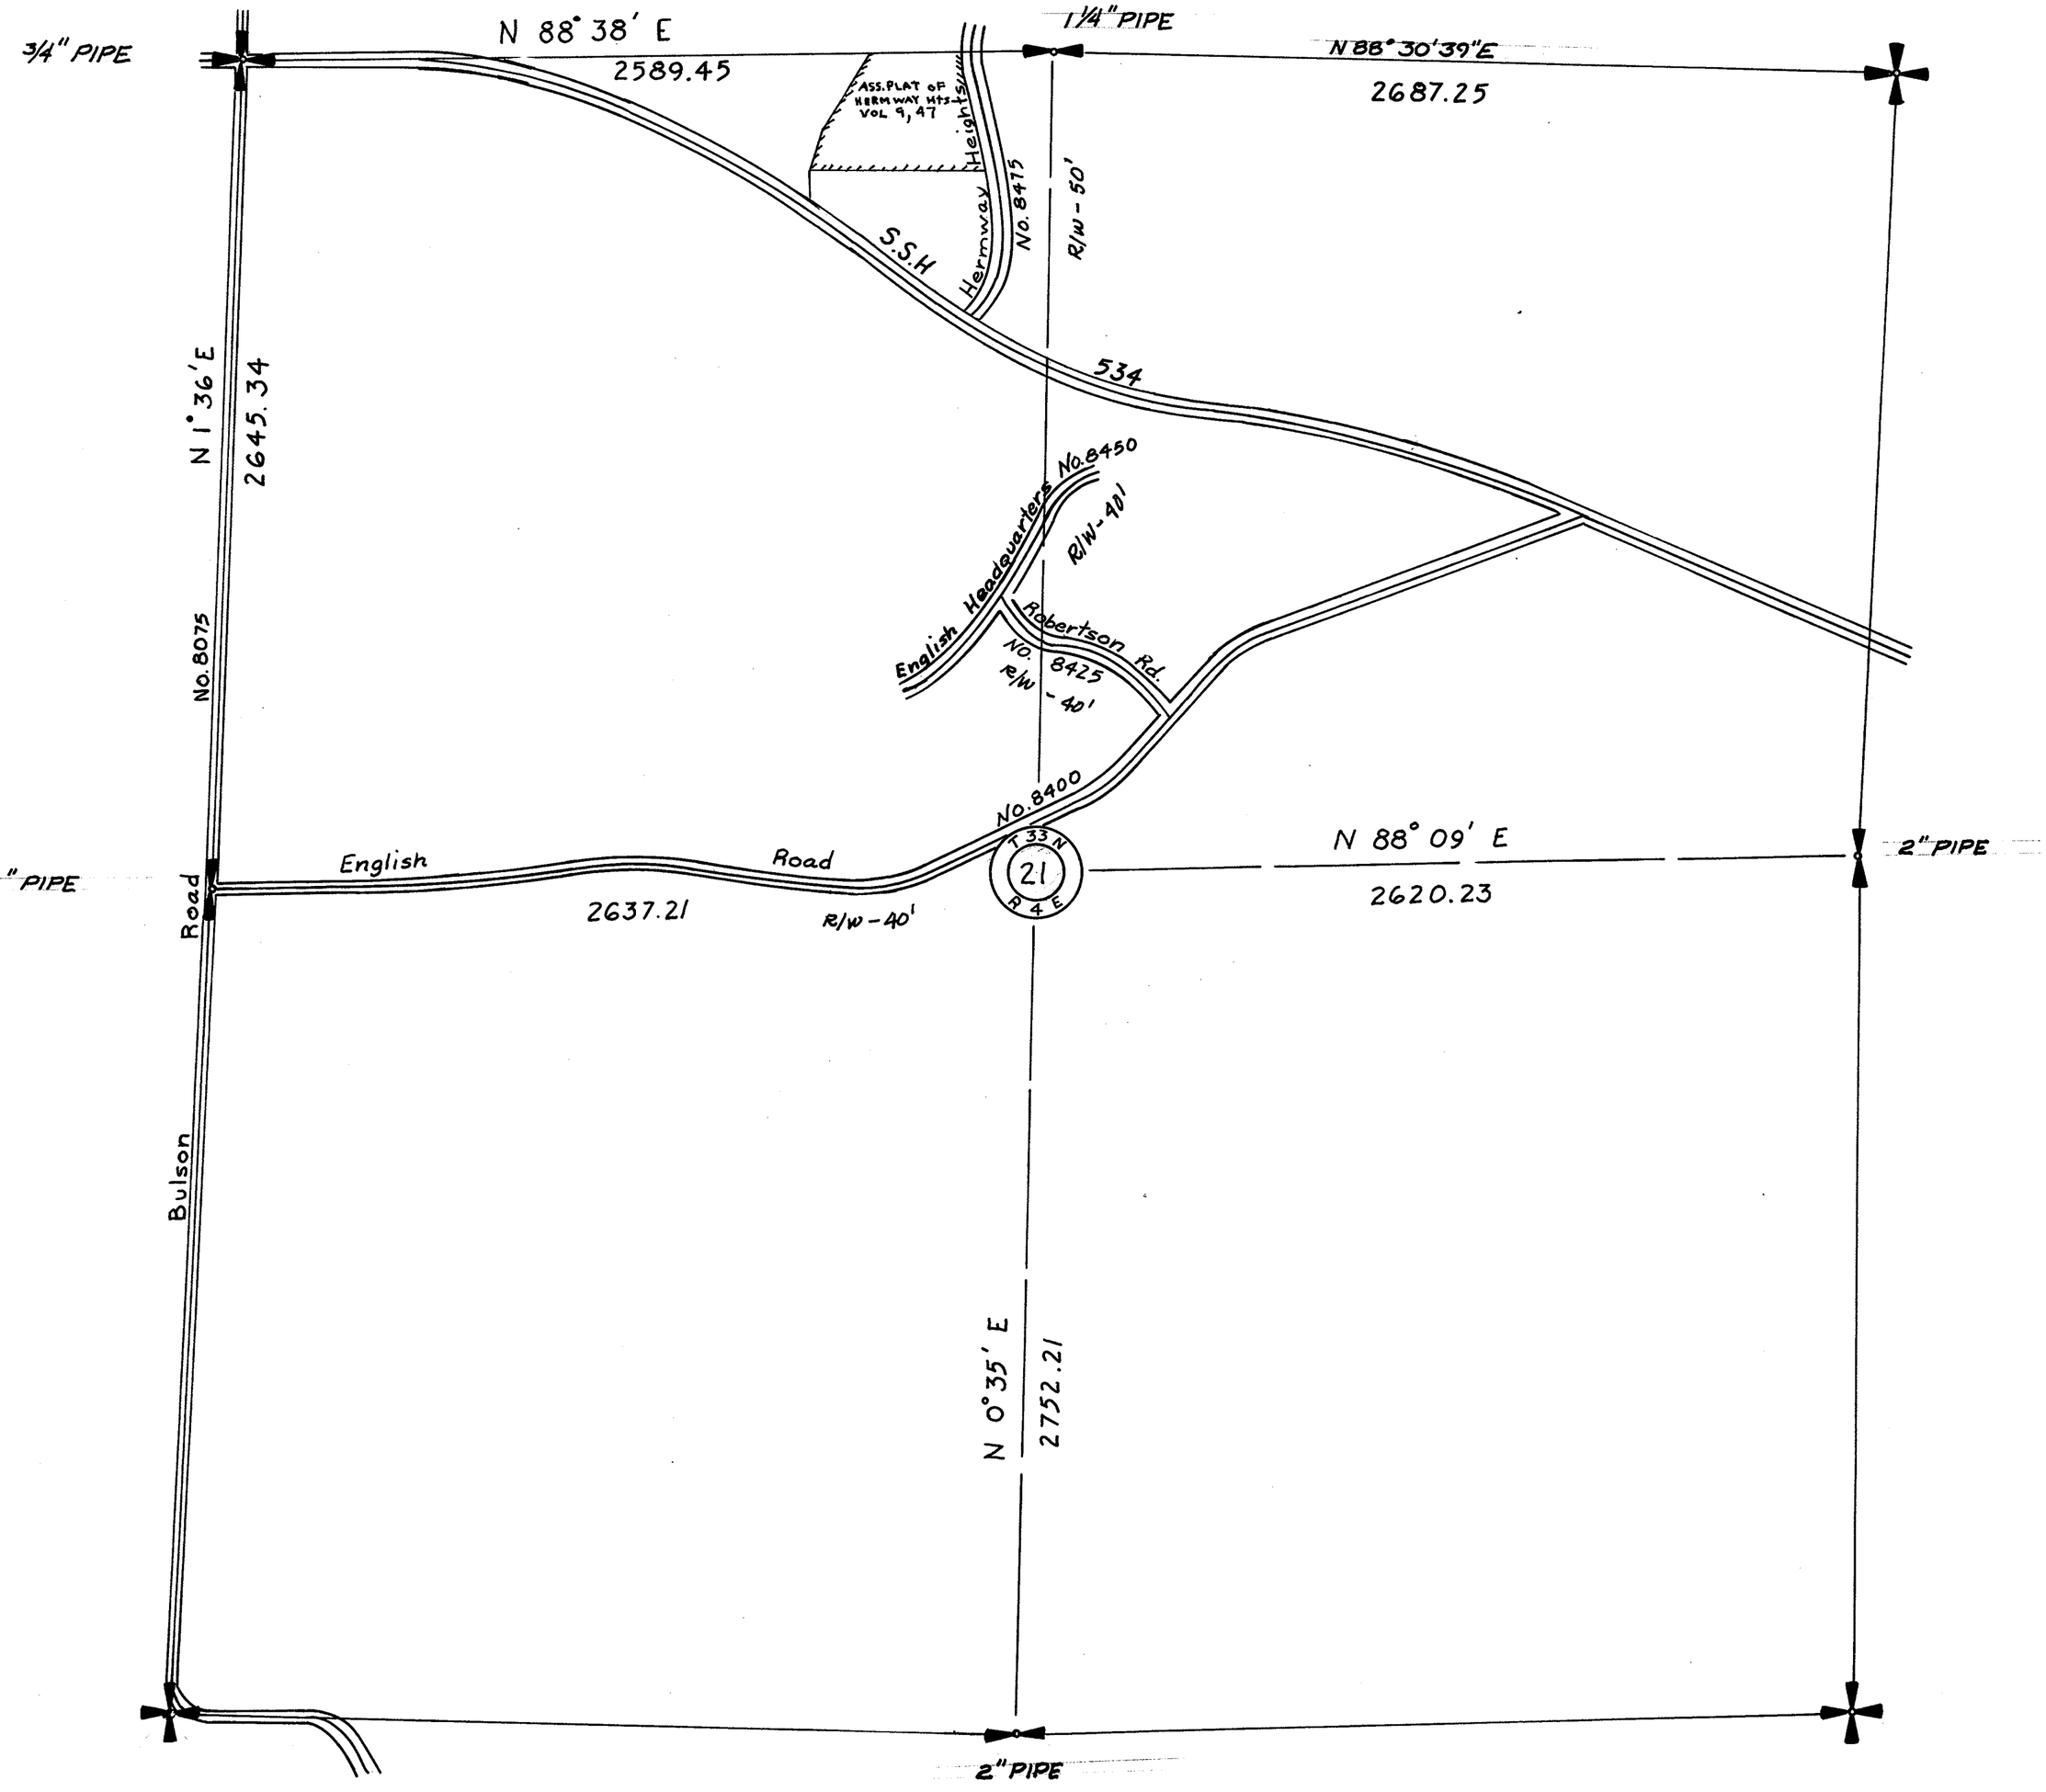


1 PLAT OF THE TOWN OF Mc
VOL-2-56
2 TOWN OF McMURRAY VOL 2-107
3 HULLS WATERFRONT TRACKS

SECTION 25

TOWNSHIP 33 NORTH, RANGE 4 EAST, W. M.
SKAGIT COUNTY, WASH.

SCALE, 1 INCH–400 FEET

A. L. STRONG COUNTY ENGINEER

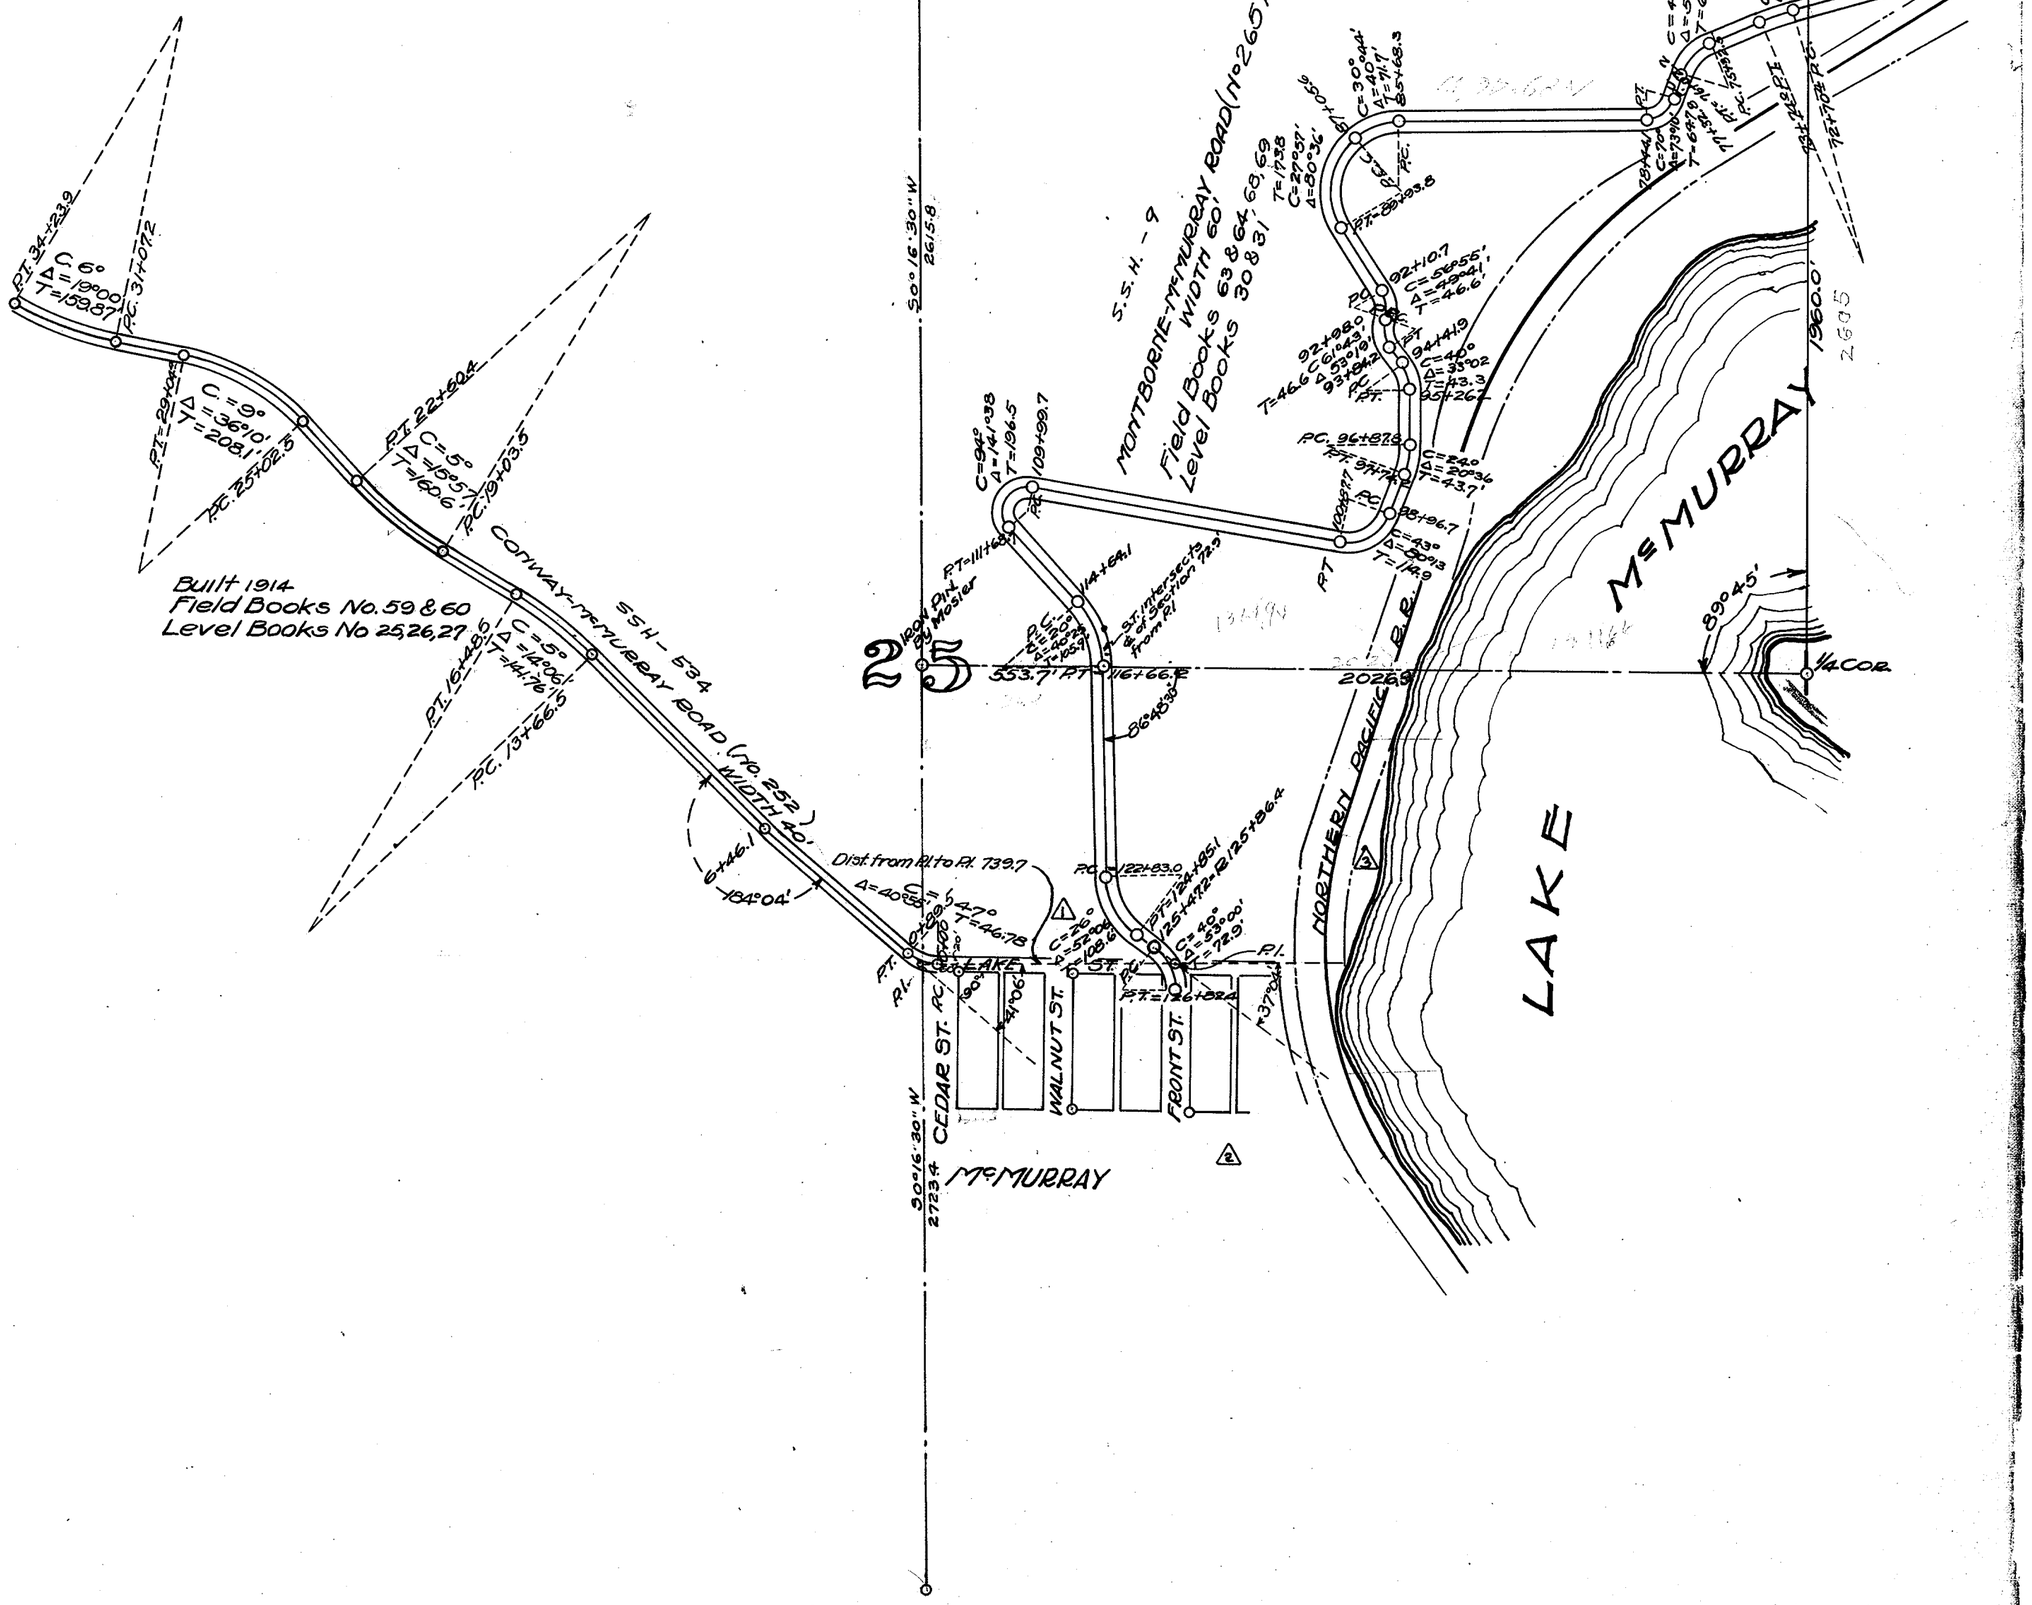


SECTION 27

TOWNSHIP 33 NORTH. RANGE 4 EAST. W. M.
SKAGIT COUNTY. WASH.

SCALE. 1 INCH–400 FEET

R.E.L. Knapp COUNTY ENGINEER

NOTES: H:211, 36-301

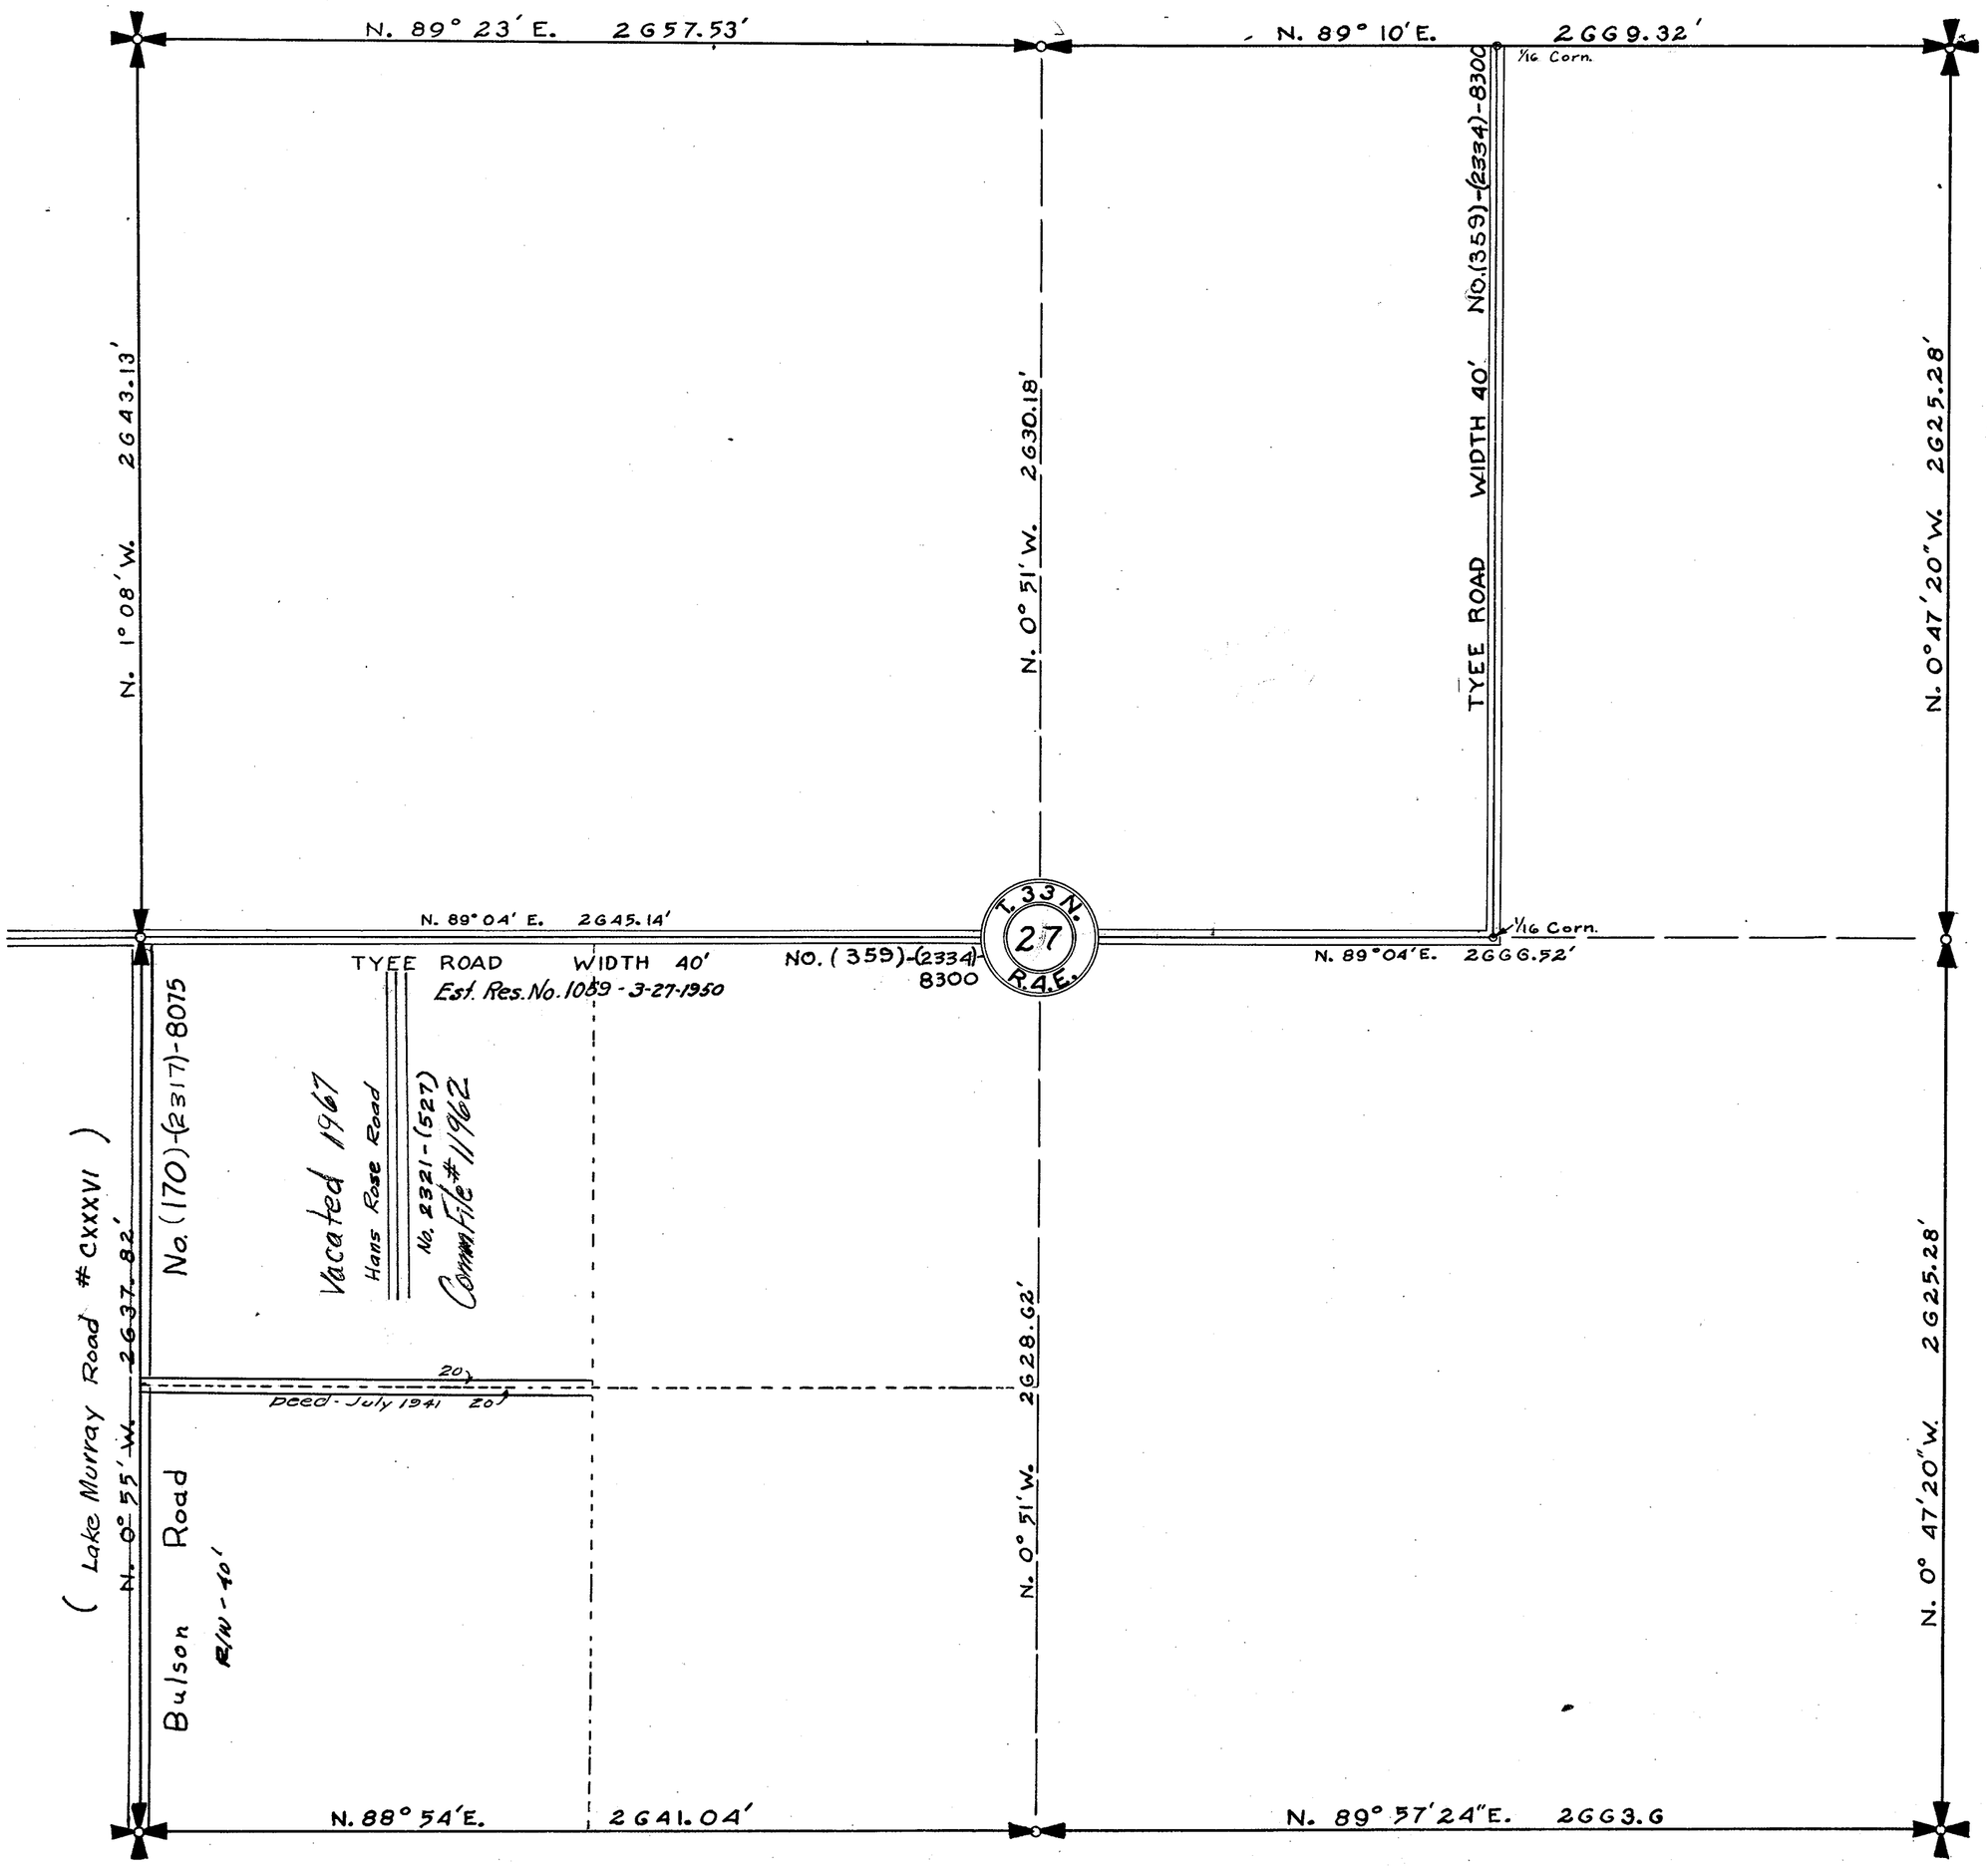



TOWNSHIP 33 NORTH, RANGE 4 EAST, W. M.

SKAGIT COUNTY, WASH.

SCALE, 1 INCH--400 FEET

DATE June, 1959 Frank Gilkey COUNTY ENGINEER

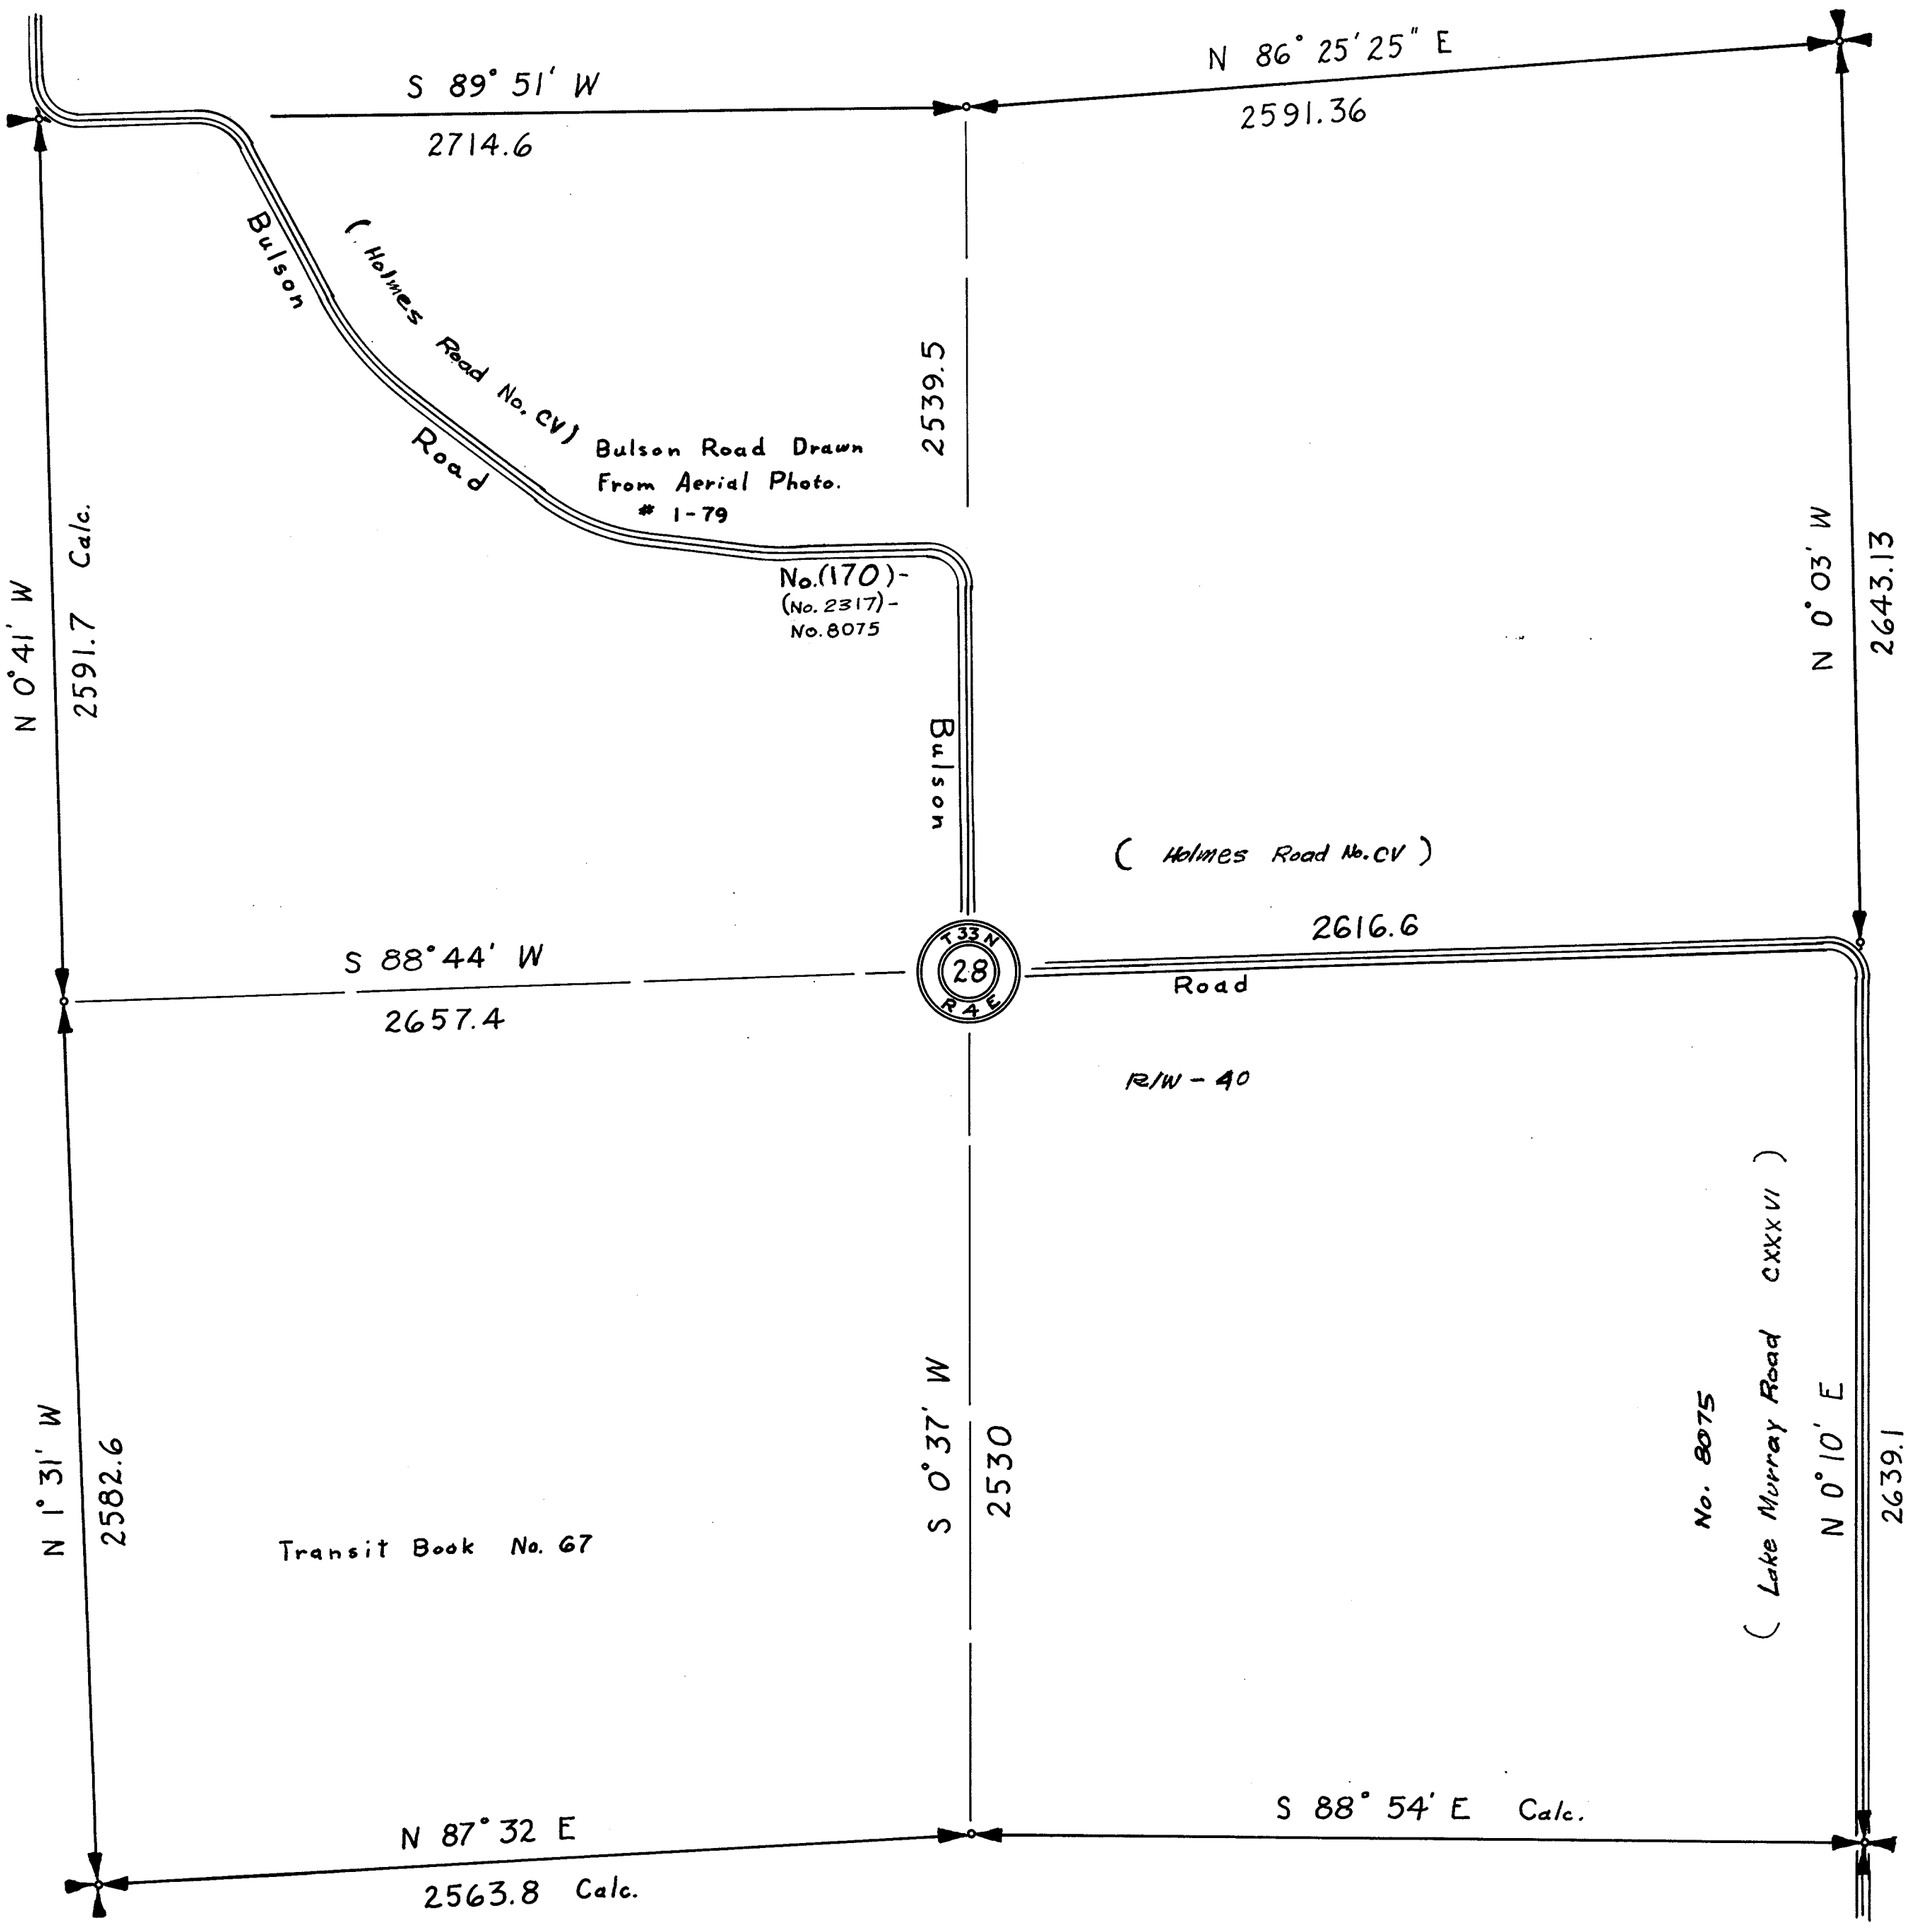


SECTION 28

TOWNSHIP 33 NORTH, RANGE 4 EAST, W. M.
SKAGIT COUNTY, WASH.

SCALE 1 INCH–400 FEET

A. L. STRONG COUNTY ENGINEER
1916

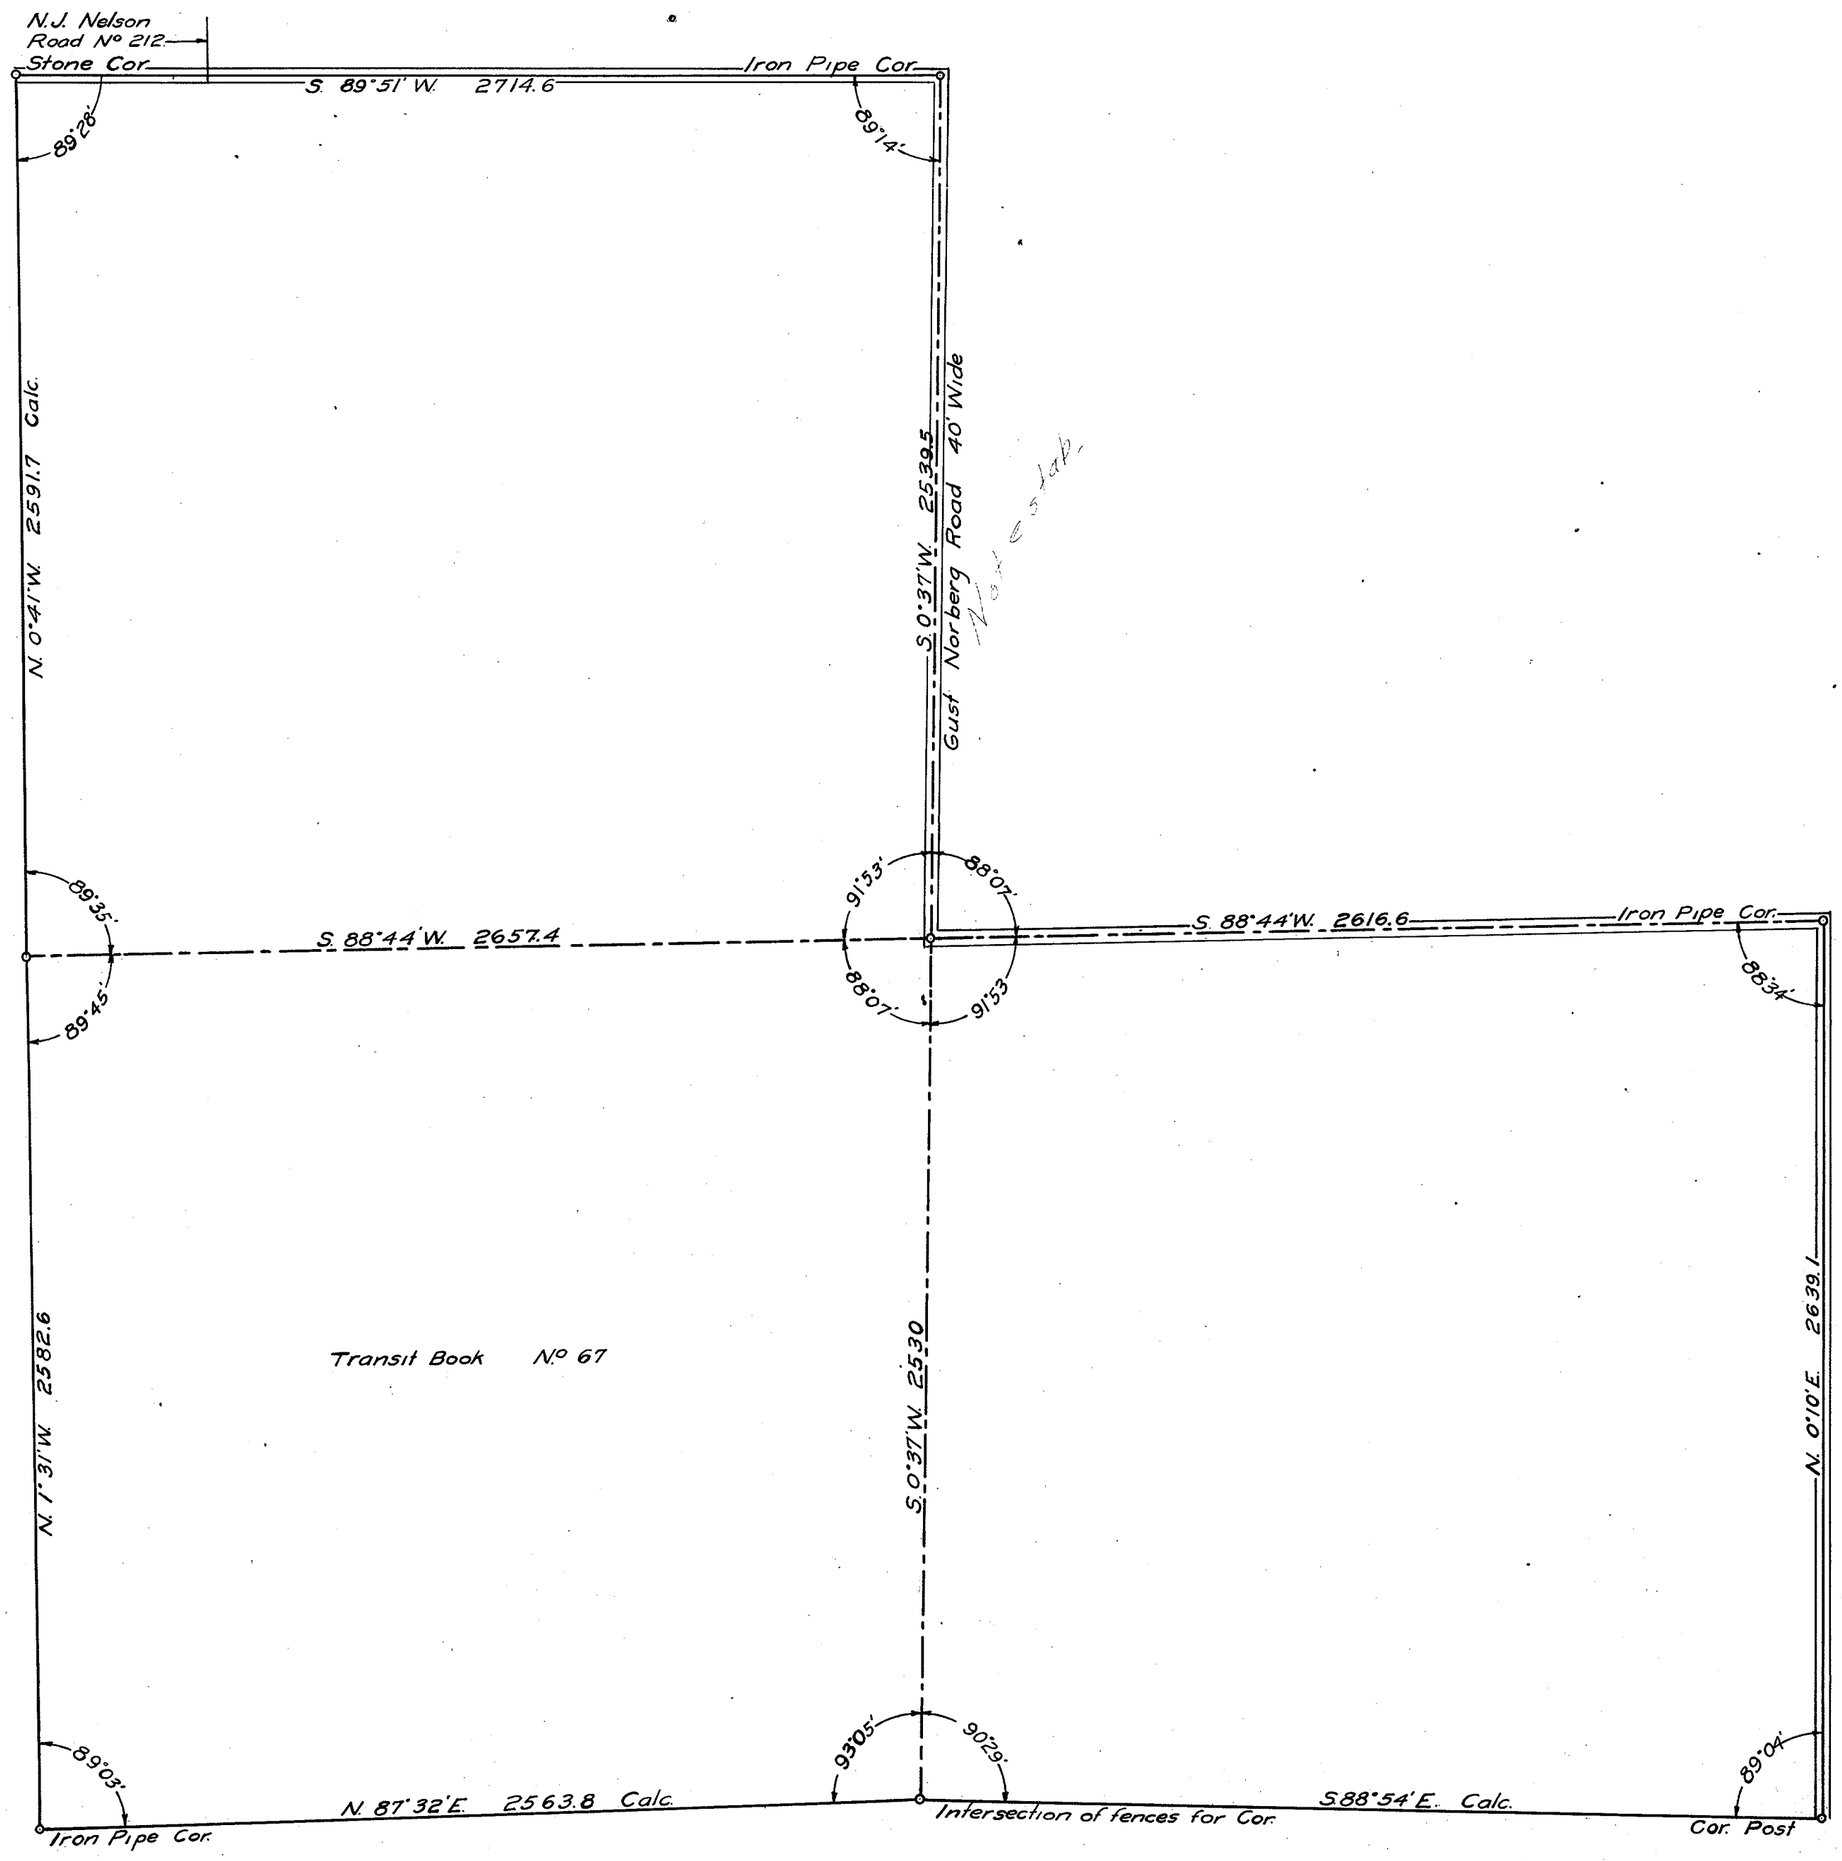


SECTION 28

TOWNSHIP 33 NORTH, RANGE 4 EAST, W. M.

SKAGIT COUNTY, WASH.

SCALE, 1 INCH--400 FEET

FRANK GILKEY COUNTY ENGINEER

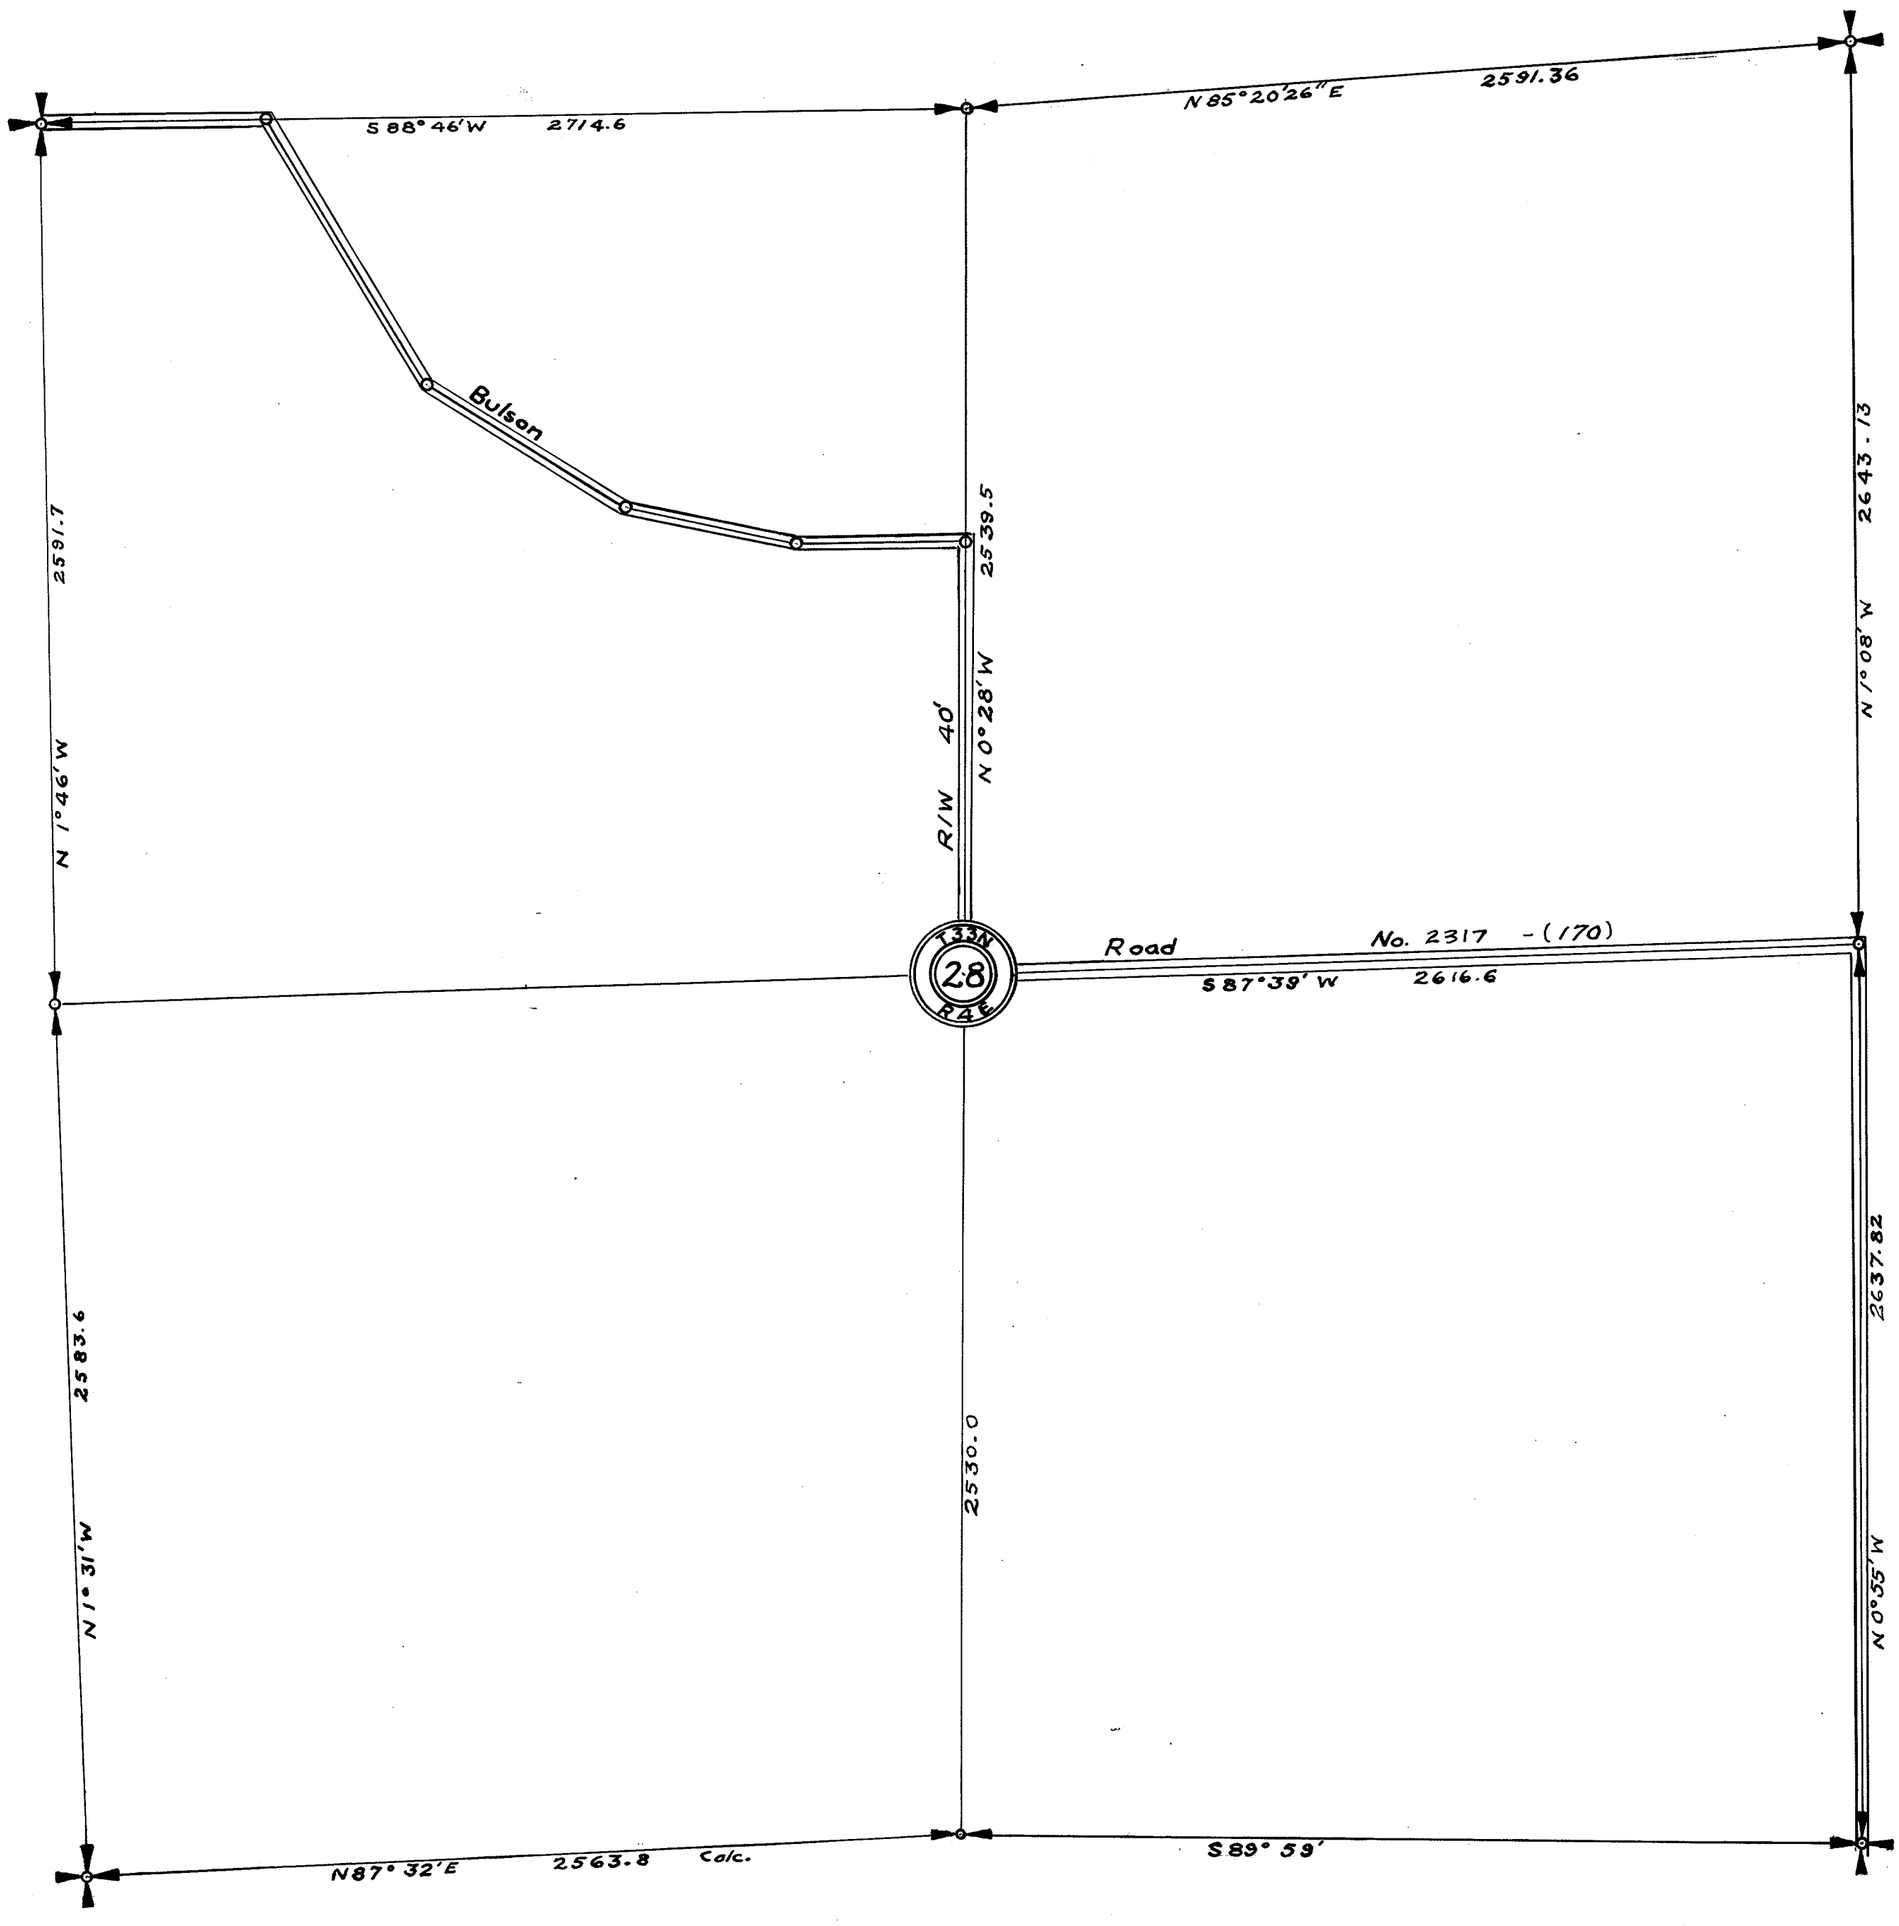



TOWNSHIP 33 NORTH, RANGE 4 EAST, W. M.
SKAGIT COUNTY, WASH.

SCALE, 1 INCH–400 FEET

A.L. STRONG COUNTY ENGINEER

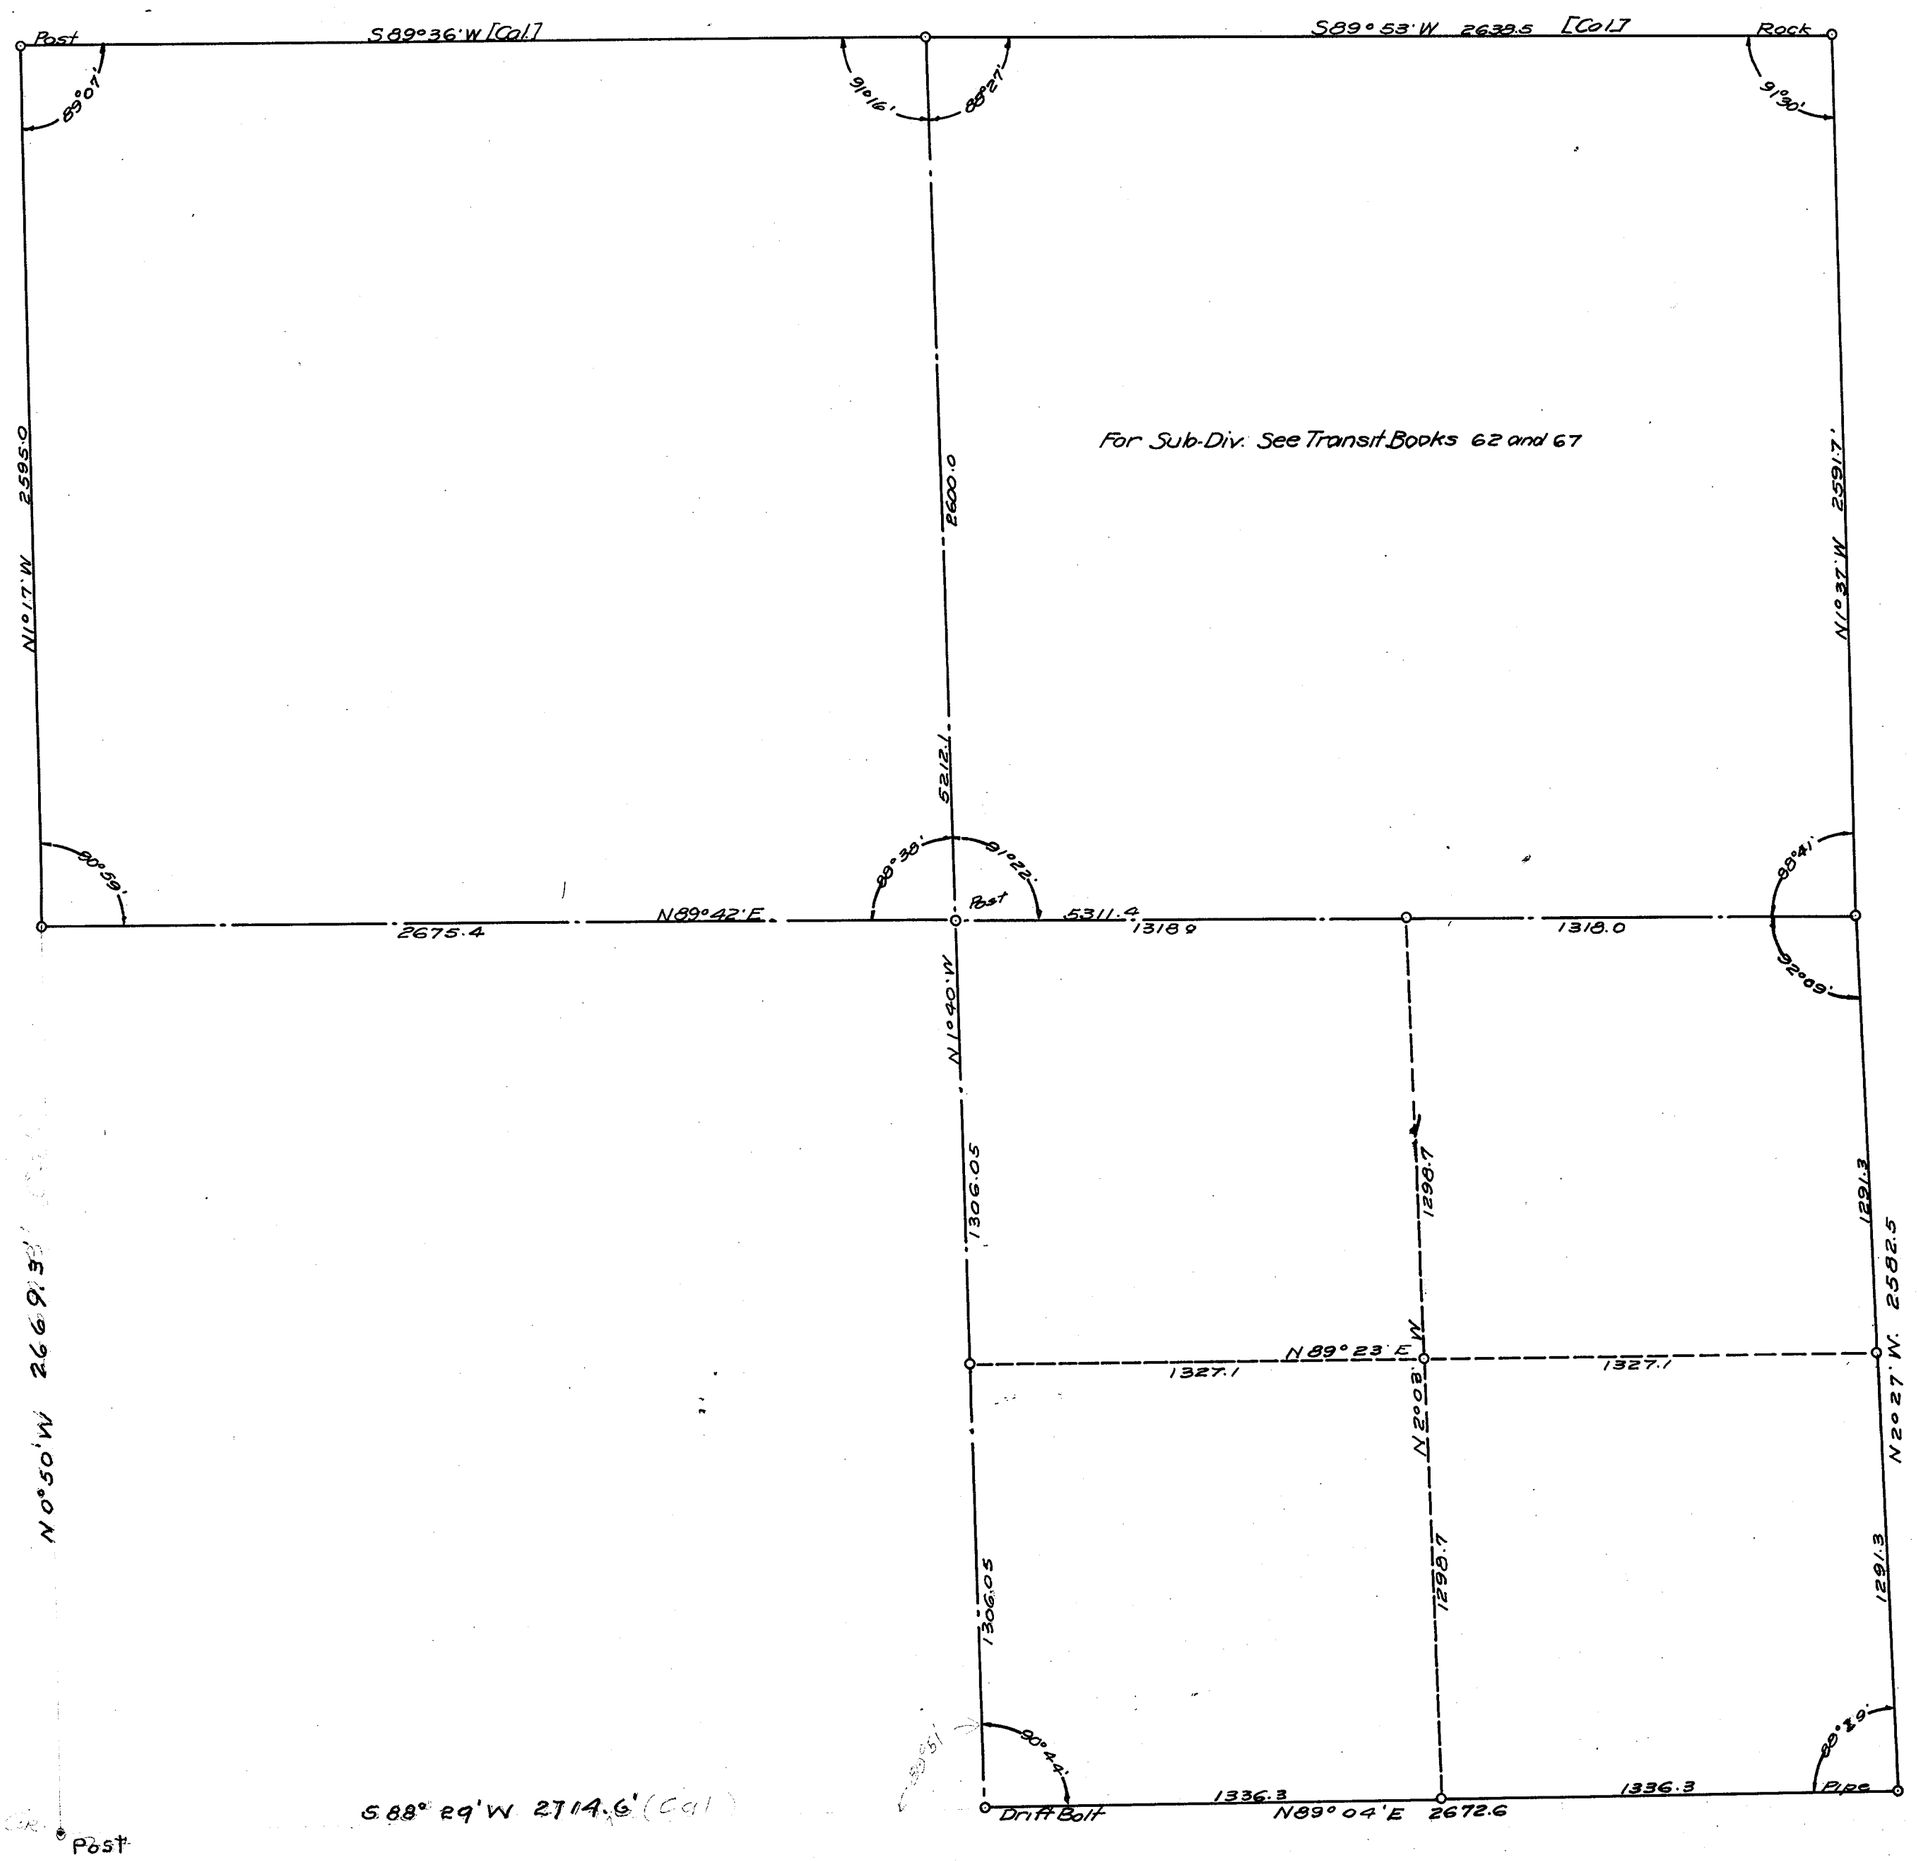

SECTION 29

TOWNSHIP 33 NORTH, RANGE 4 EAST, W. M.

SKAGIT COUNTY, WASH.

SCALE, 1 INCH -- 400 FEET

DATE Aug. 19, 1966

Lloyd Johnson COUNTY ENGINEER

Notes: 329

Post — 89°07' — S89°36'W — S89°53'W 2638.5 — 91°30' — Rock

N 1°17'W 2595.0

STATE HWY. 99-5

2600.0

N 1°17'W 2591.7

90°59' — N89°42'E — 2675.4 — 91°22' — S88°45'30"E 2636.0

½" Pipe

No.(2343)-(239)- 8220

R/W-50'

T-33-N 29 R-4-E

Post

2669.3 2668.34

N0°50'W N0°40'30"

W.H. Franklin Road

N0°16'55"E 2640.12

2612.1

N1°40'W N10°40'30"W

90°44'

Post — S88°56'30"E 2712.6 — S89°23'30"E 2670.05 — Pipe


DRIFT BOLT

SECTION 31

TOWNSHIP 33 NORTH. RANGE 4 EAST. W. M.
SKAGIT COUNTY. WASH.

SCALE, 1 INCH–400 FEET

A.L. Strong COUNTY ENGINEER

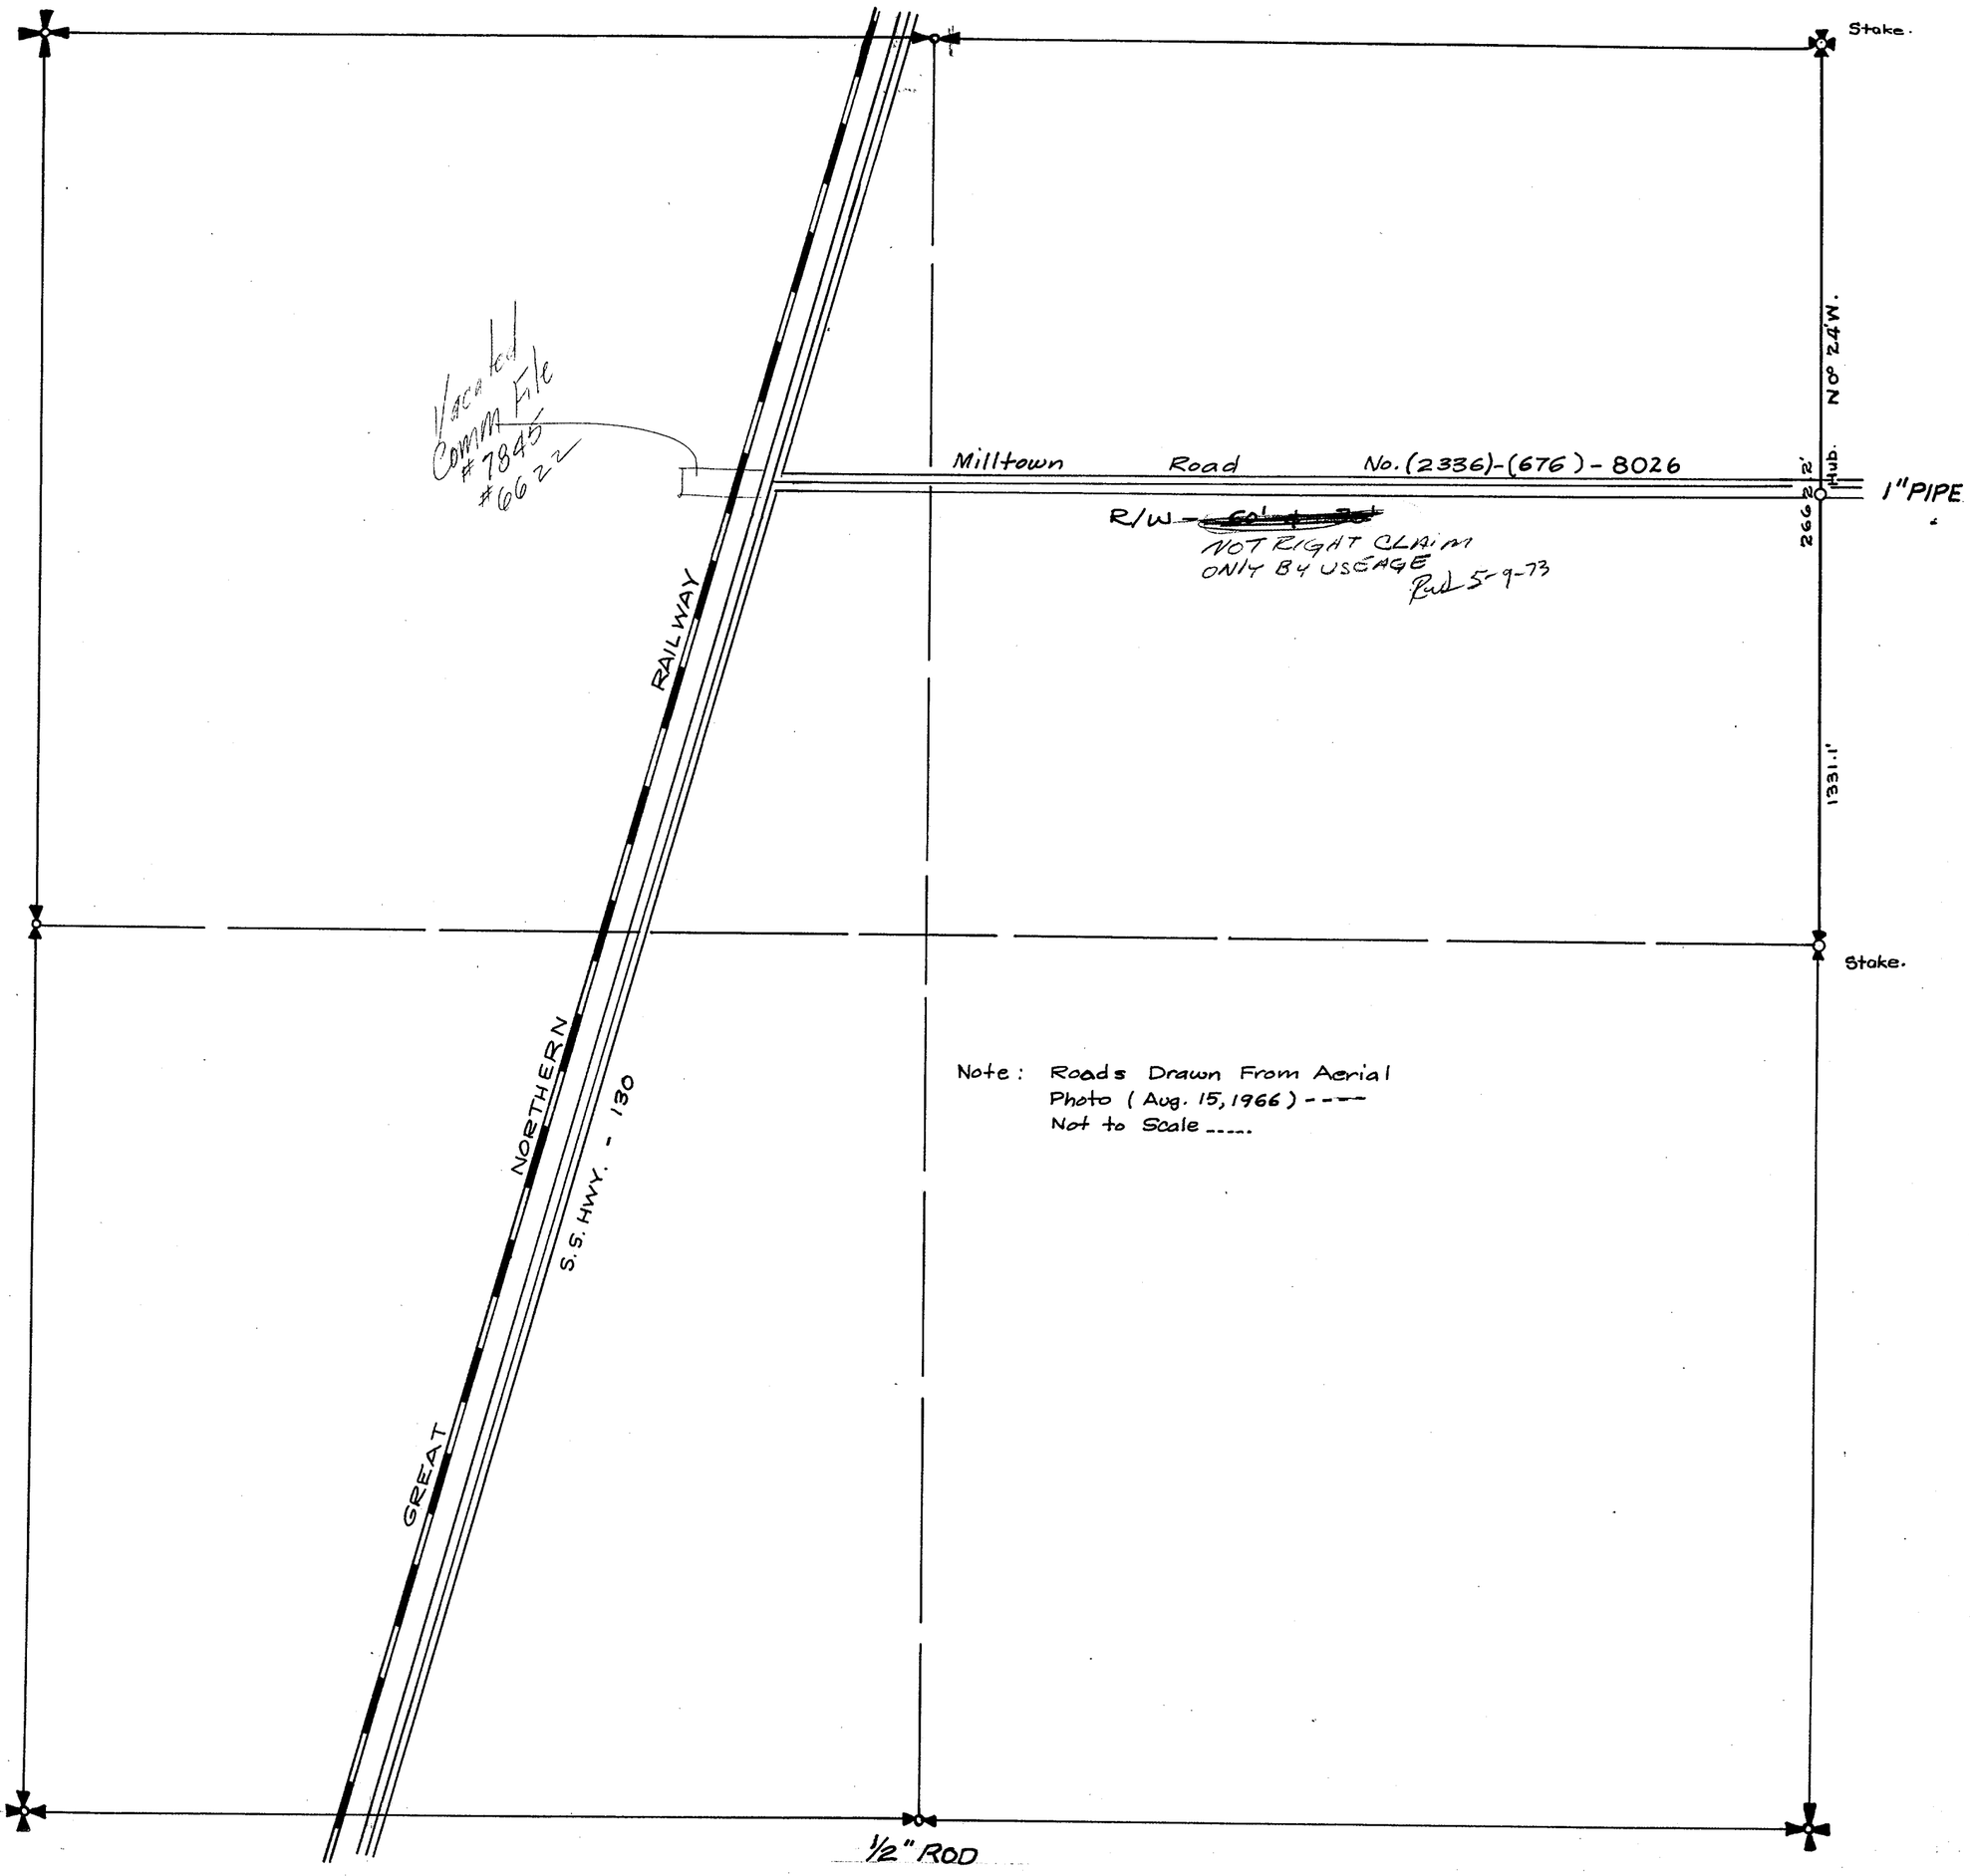

Note: Roads Drawn From Aerial Photo (Aug. 15, 1966) ----
Not to Scale -----.

SECTION 32


TOWNSHIP 33 NORTH, RANGE 4 EAST, W. M.

SKAGIT COUNTY, WASH.

SCALE, 1 INCH -- 400 FEET

DATE 3 SEPT 1968

Lloyd H Johnson COUNTY ENGINEER

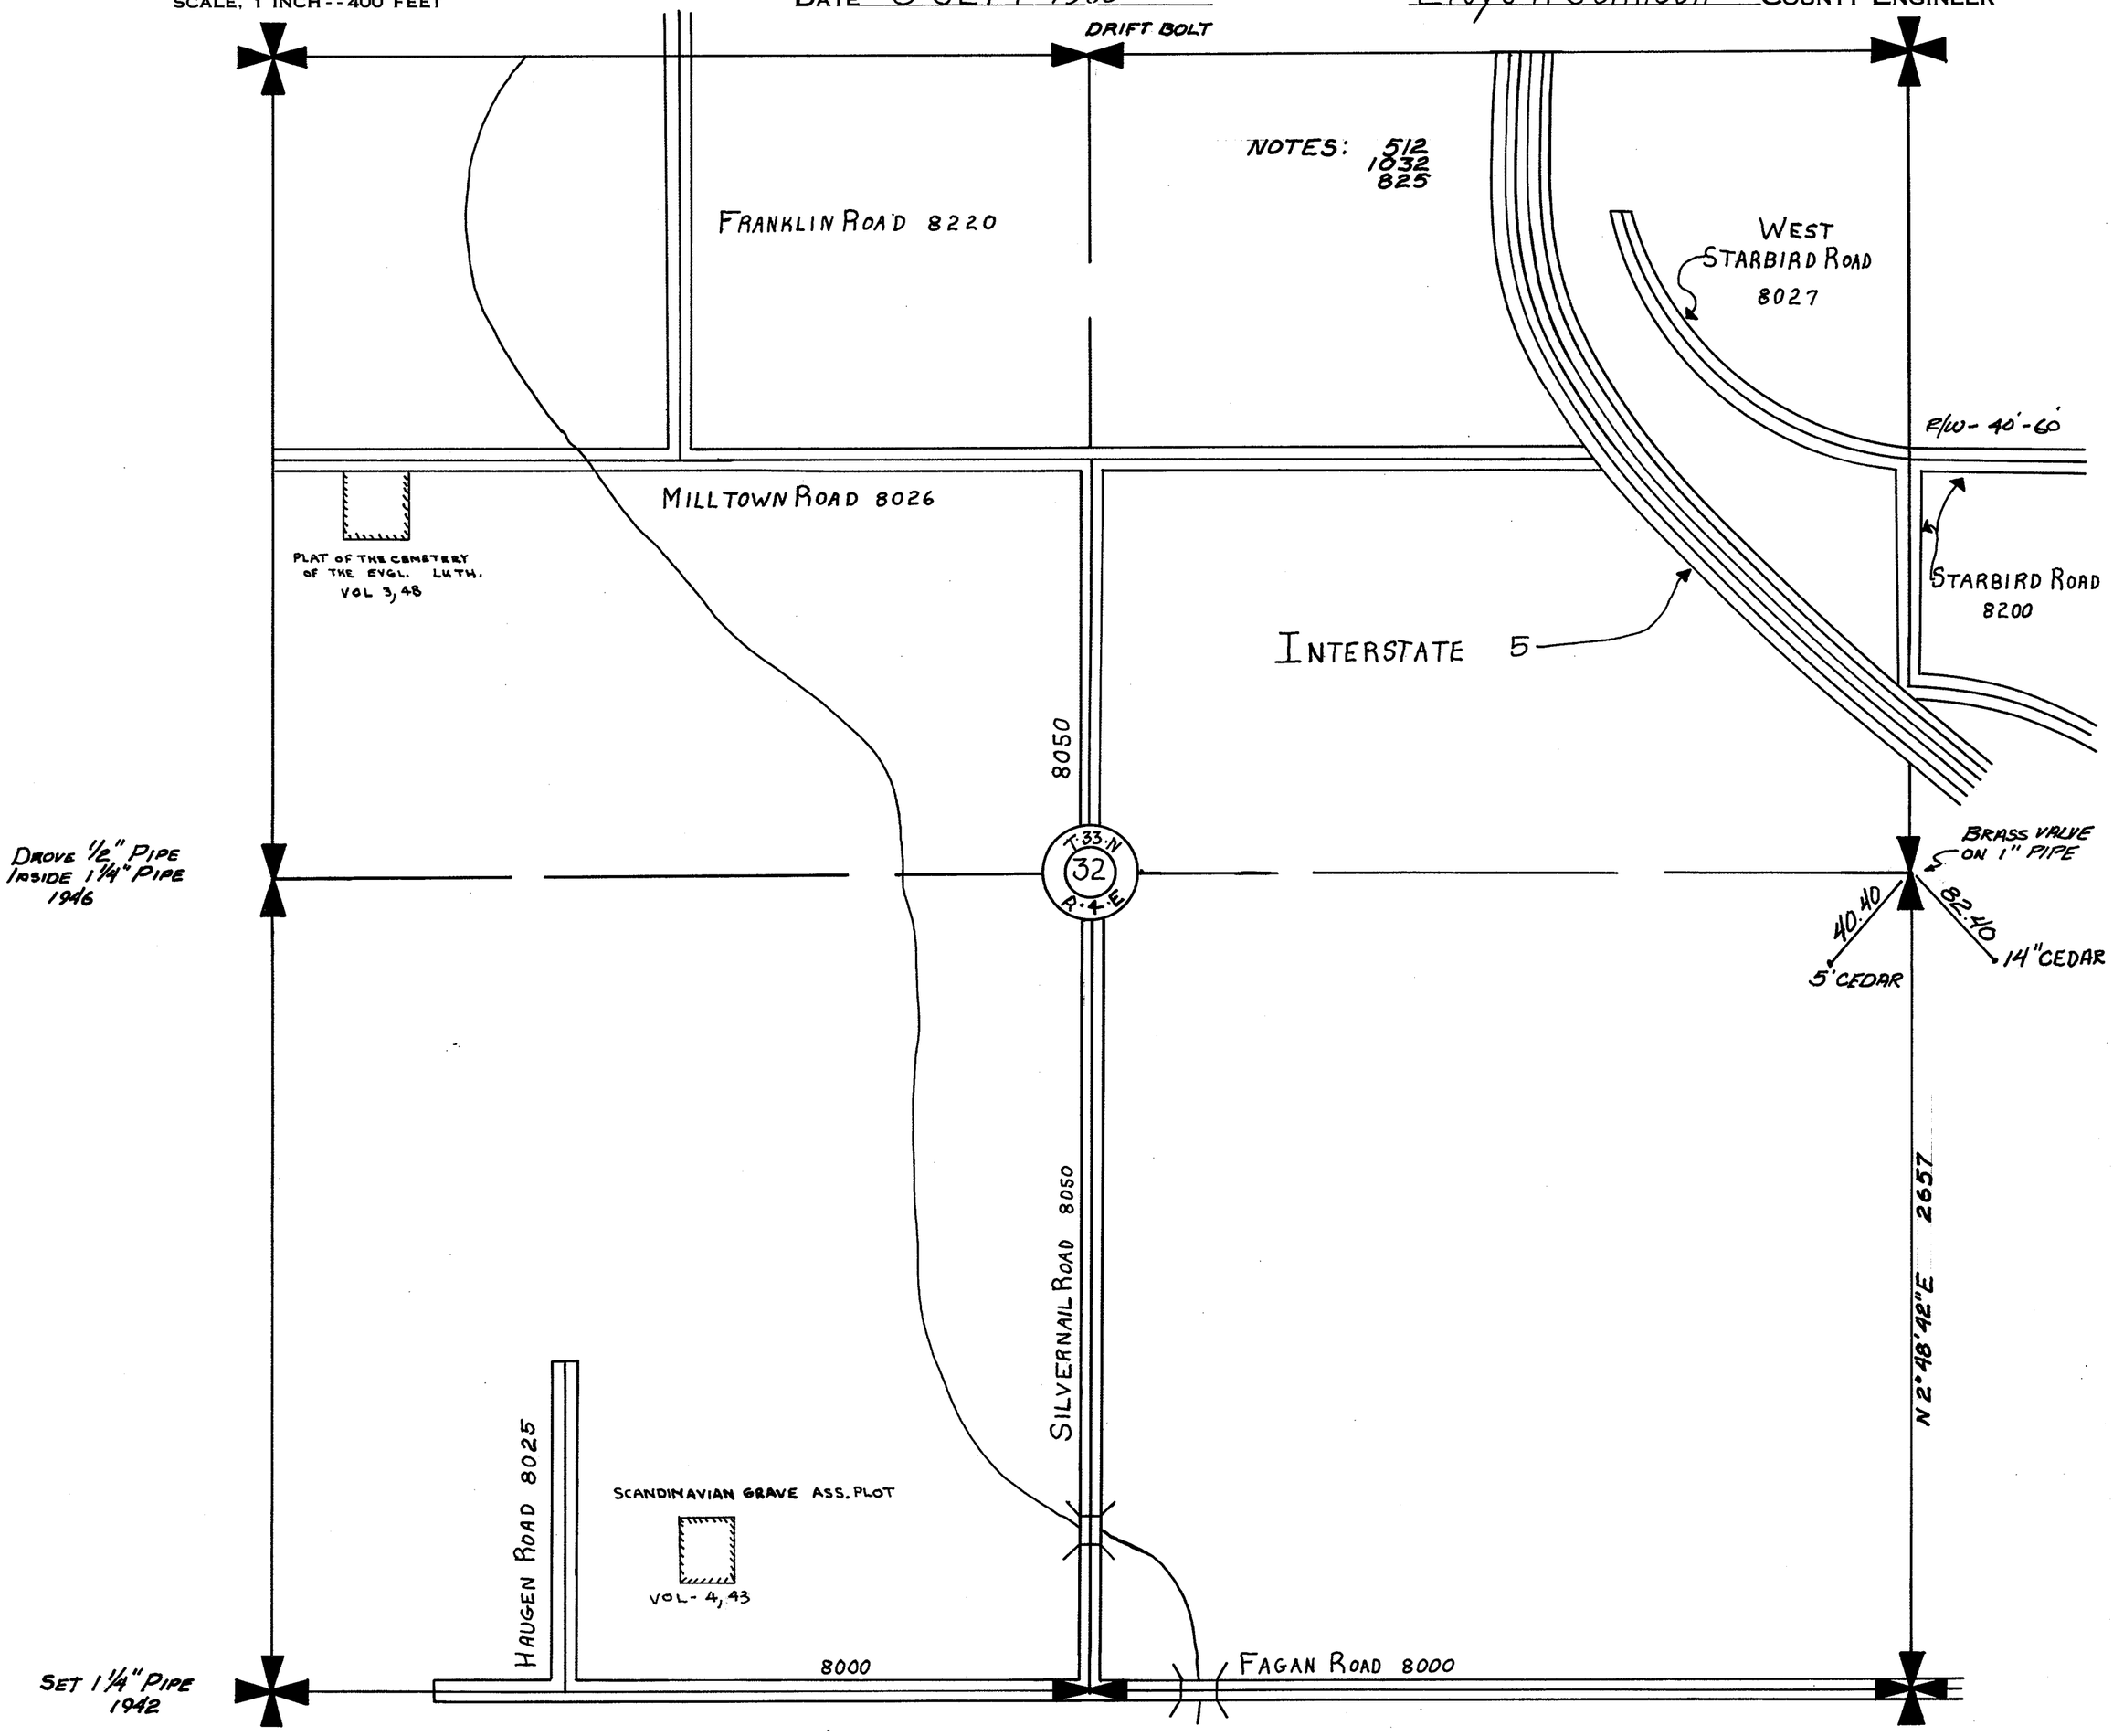


SECTION 32

TOWNSHIP 33 NORTH, RANGE 4 EAST, W. M.
SKAGIT COUNTY, WASH.

SCALE, 1 INCH–400 FEET

A.L. Strong COUNTY ENGINEER

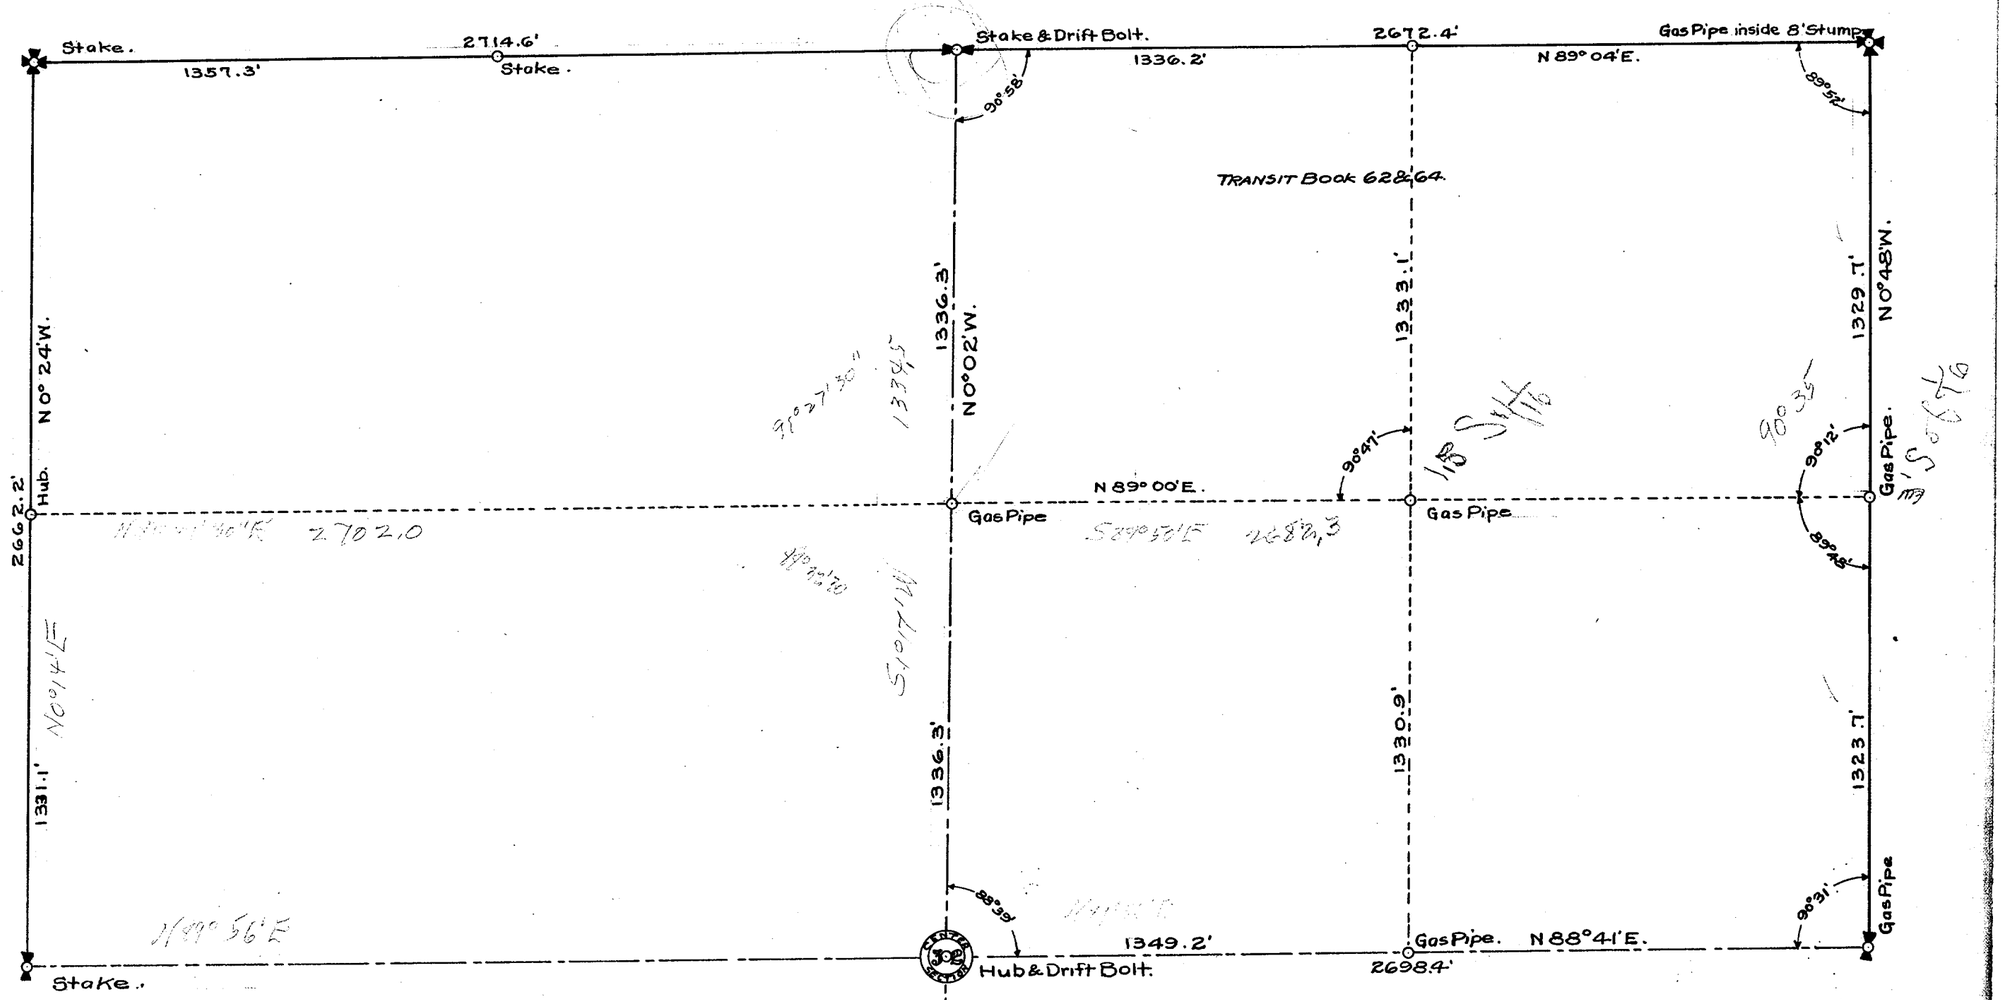


SECTION 32

TOWNSHIP 33 NORTH, RANGE 4 EAST, W. M.

SKAGIT COUNTY, WASH.

SCALE, 1 INCH–400 FEET

R.E.L. Knapp COUNTY ENGINEER

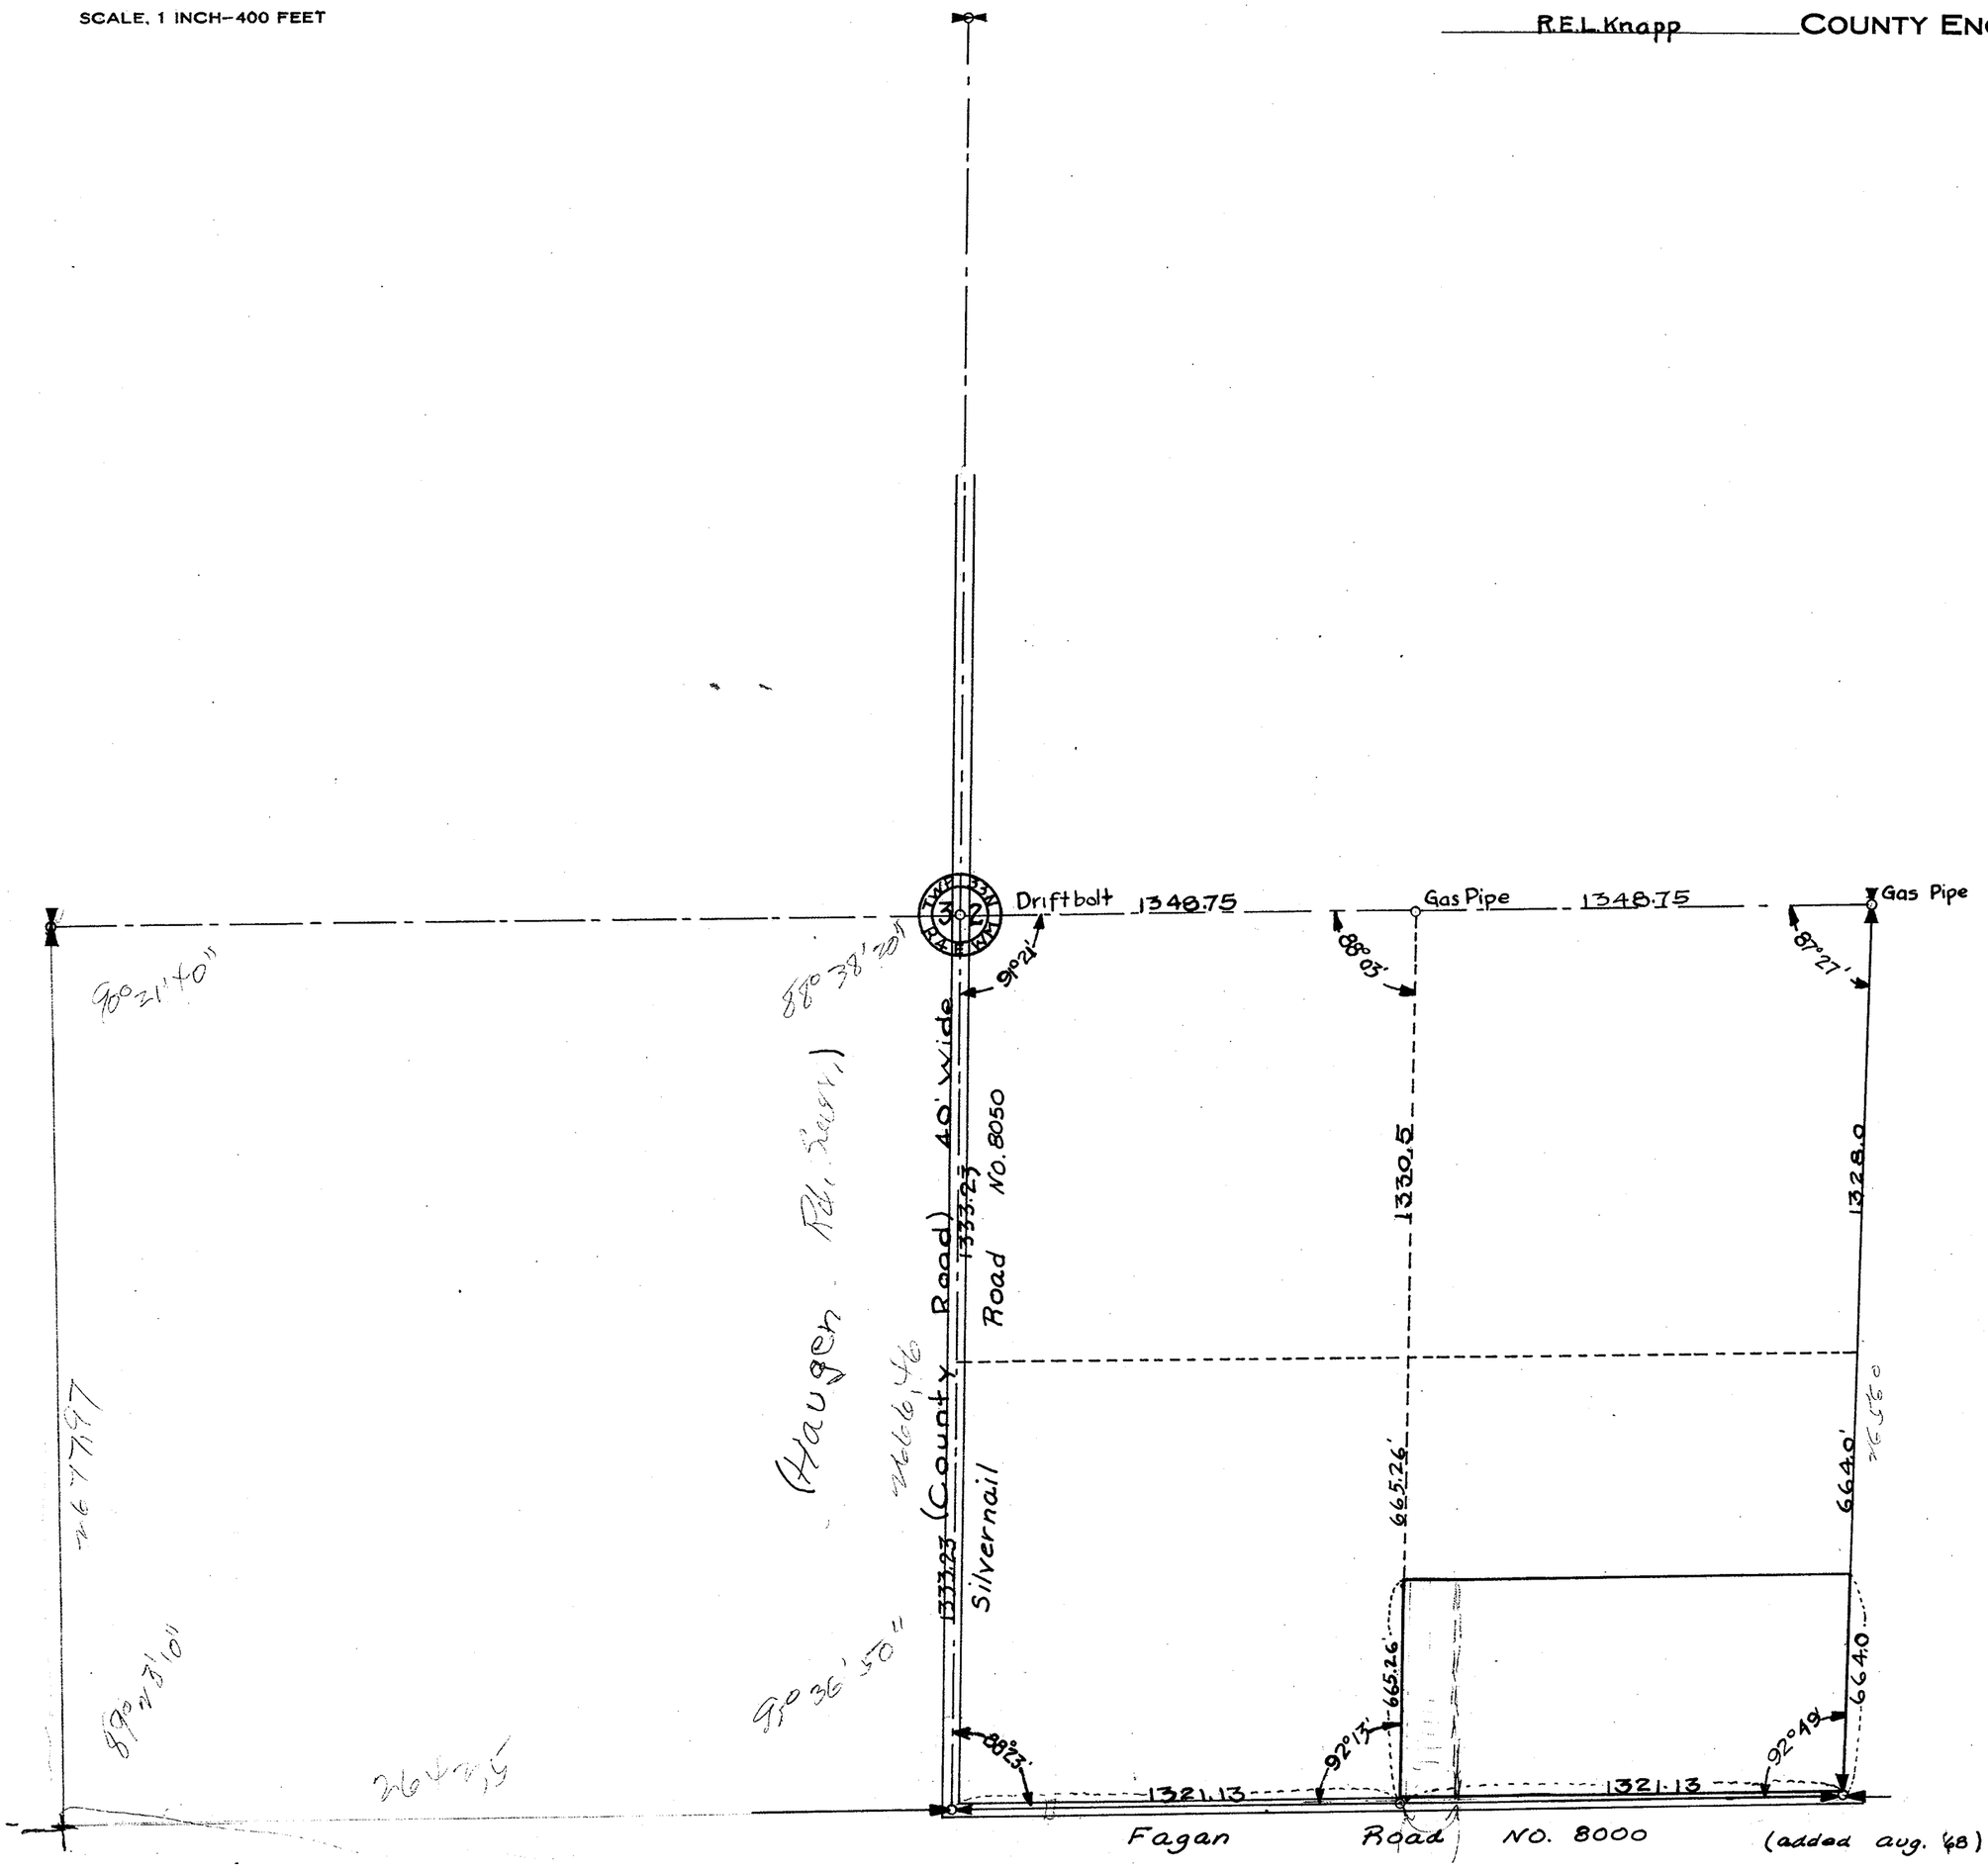

SECTION 33


TOWNSHIP 33 NORTH, RANGE 4 EAST, W. M.

SKAGIT COUNTY, WASH.

SCALE, 1 INCH--400 FEET

DATE June, 1959

Frank Gilkey COUNTY ENGINEER

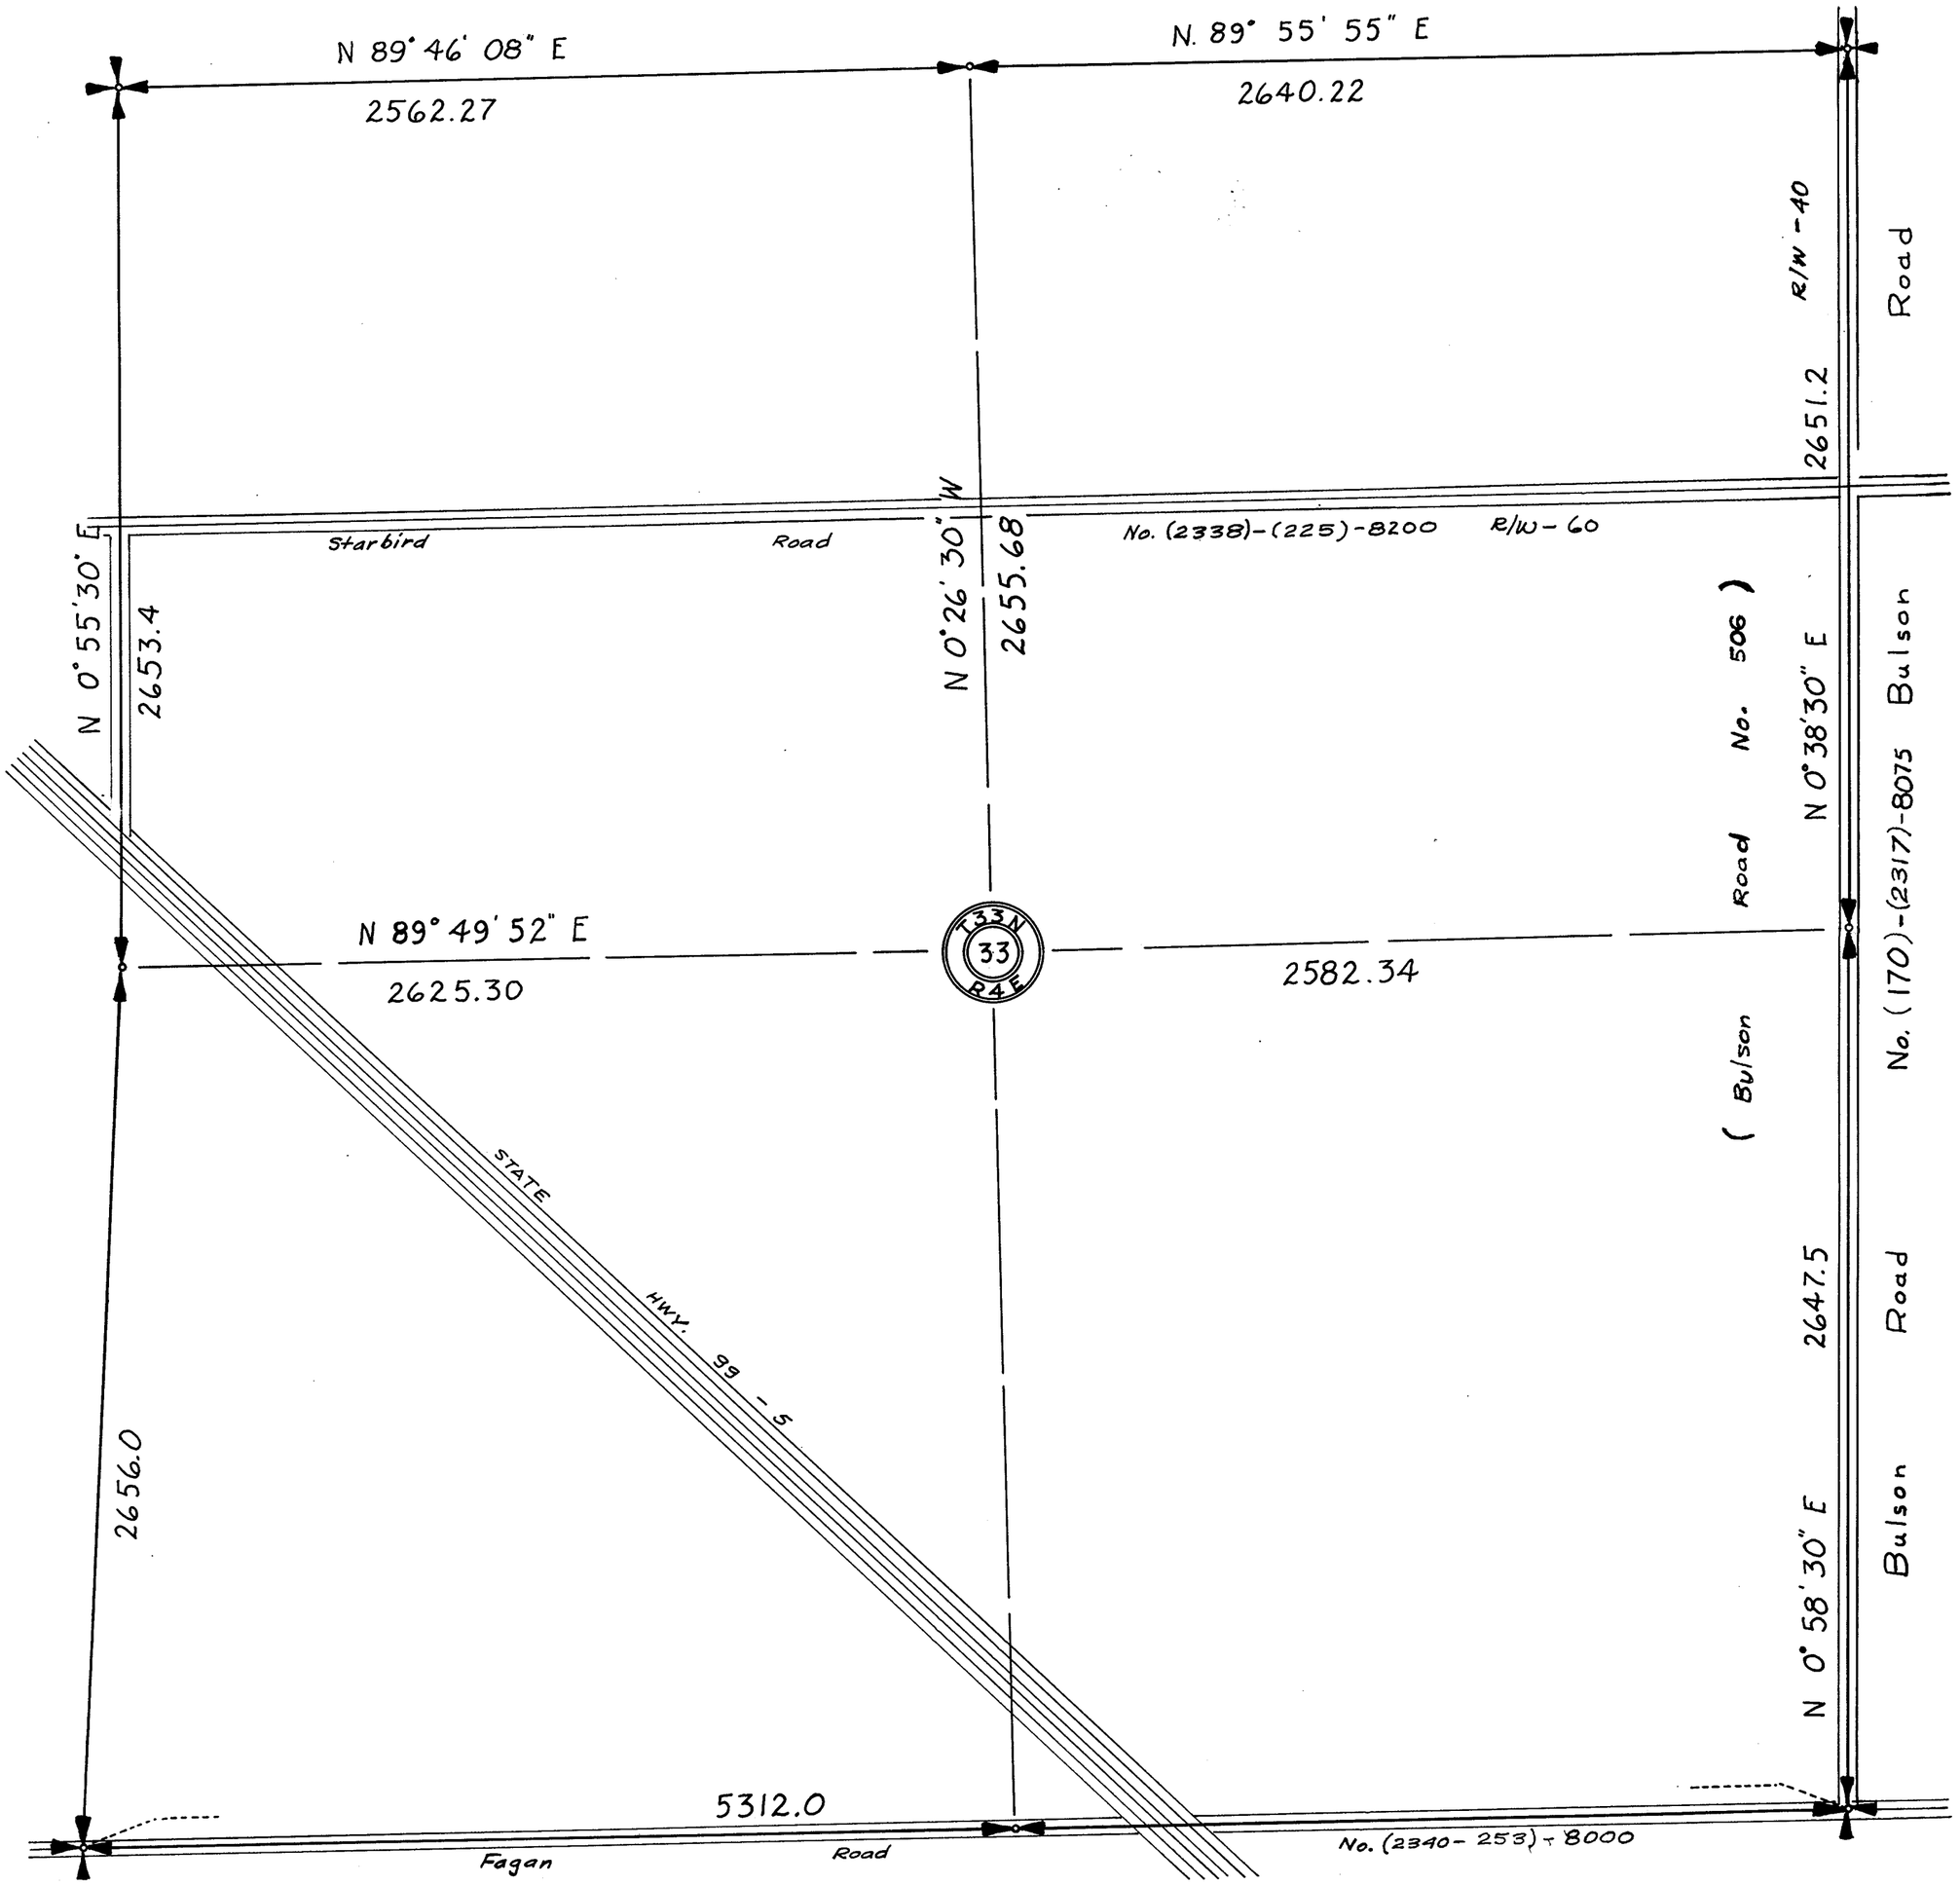


SECTION 33

TOWNSHIP 33 NORTH, RANGE 4 EAST, W. M.
SKAGIT COUNTY, WASH.

SCALE, 1 INCH—400 FEET

A.L. Strong COUNTY ENGINEER

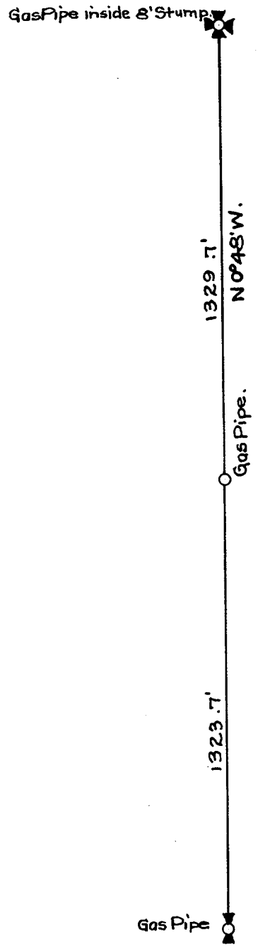


SECTION 33

TOWNSHIP 33 NORTH, RANGE 4 EAST, W. M.
SKAGIT COUNTY, WASH.

SCALE, 1 INCH–400 FEET

A.L. Strong COUNTY ENGINEER

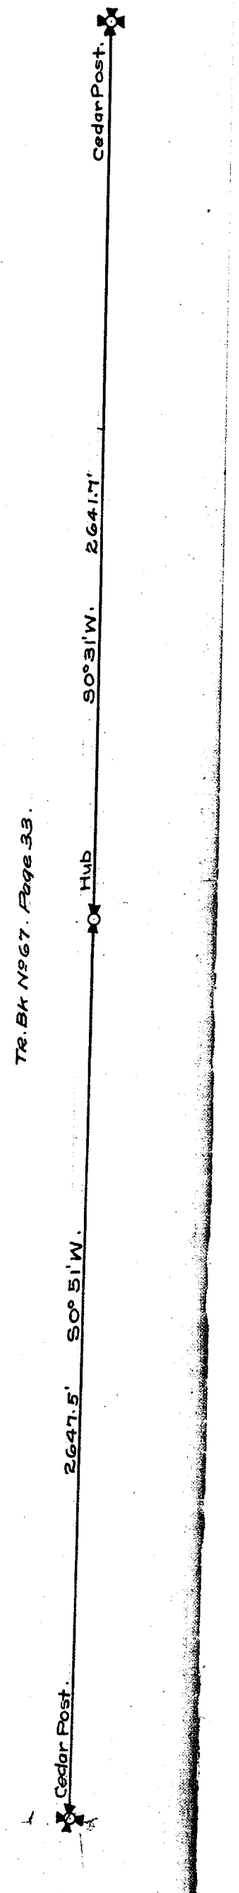


SECTION 33

TOWNSHIP 33 NORTH, RANGE 4 EAST, W. M.
SKAGIT COUNTY, WASH.

SCALE, 1 INCH–400 FEET

Arthur L Strong COUNTY ENGINEER

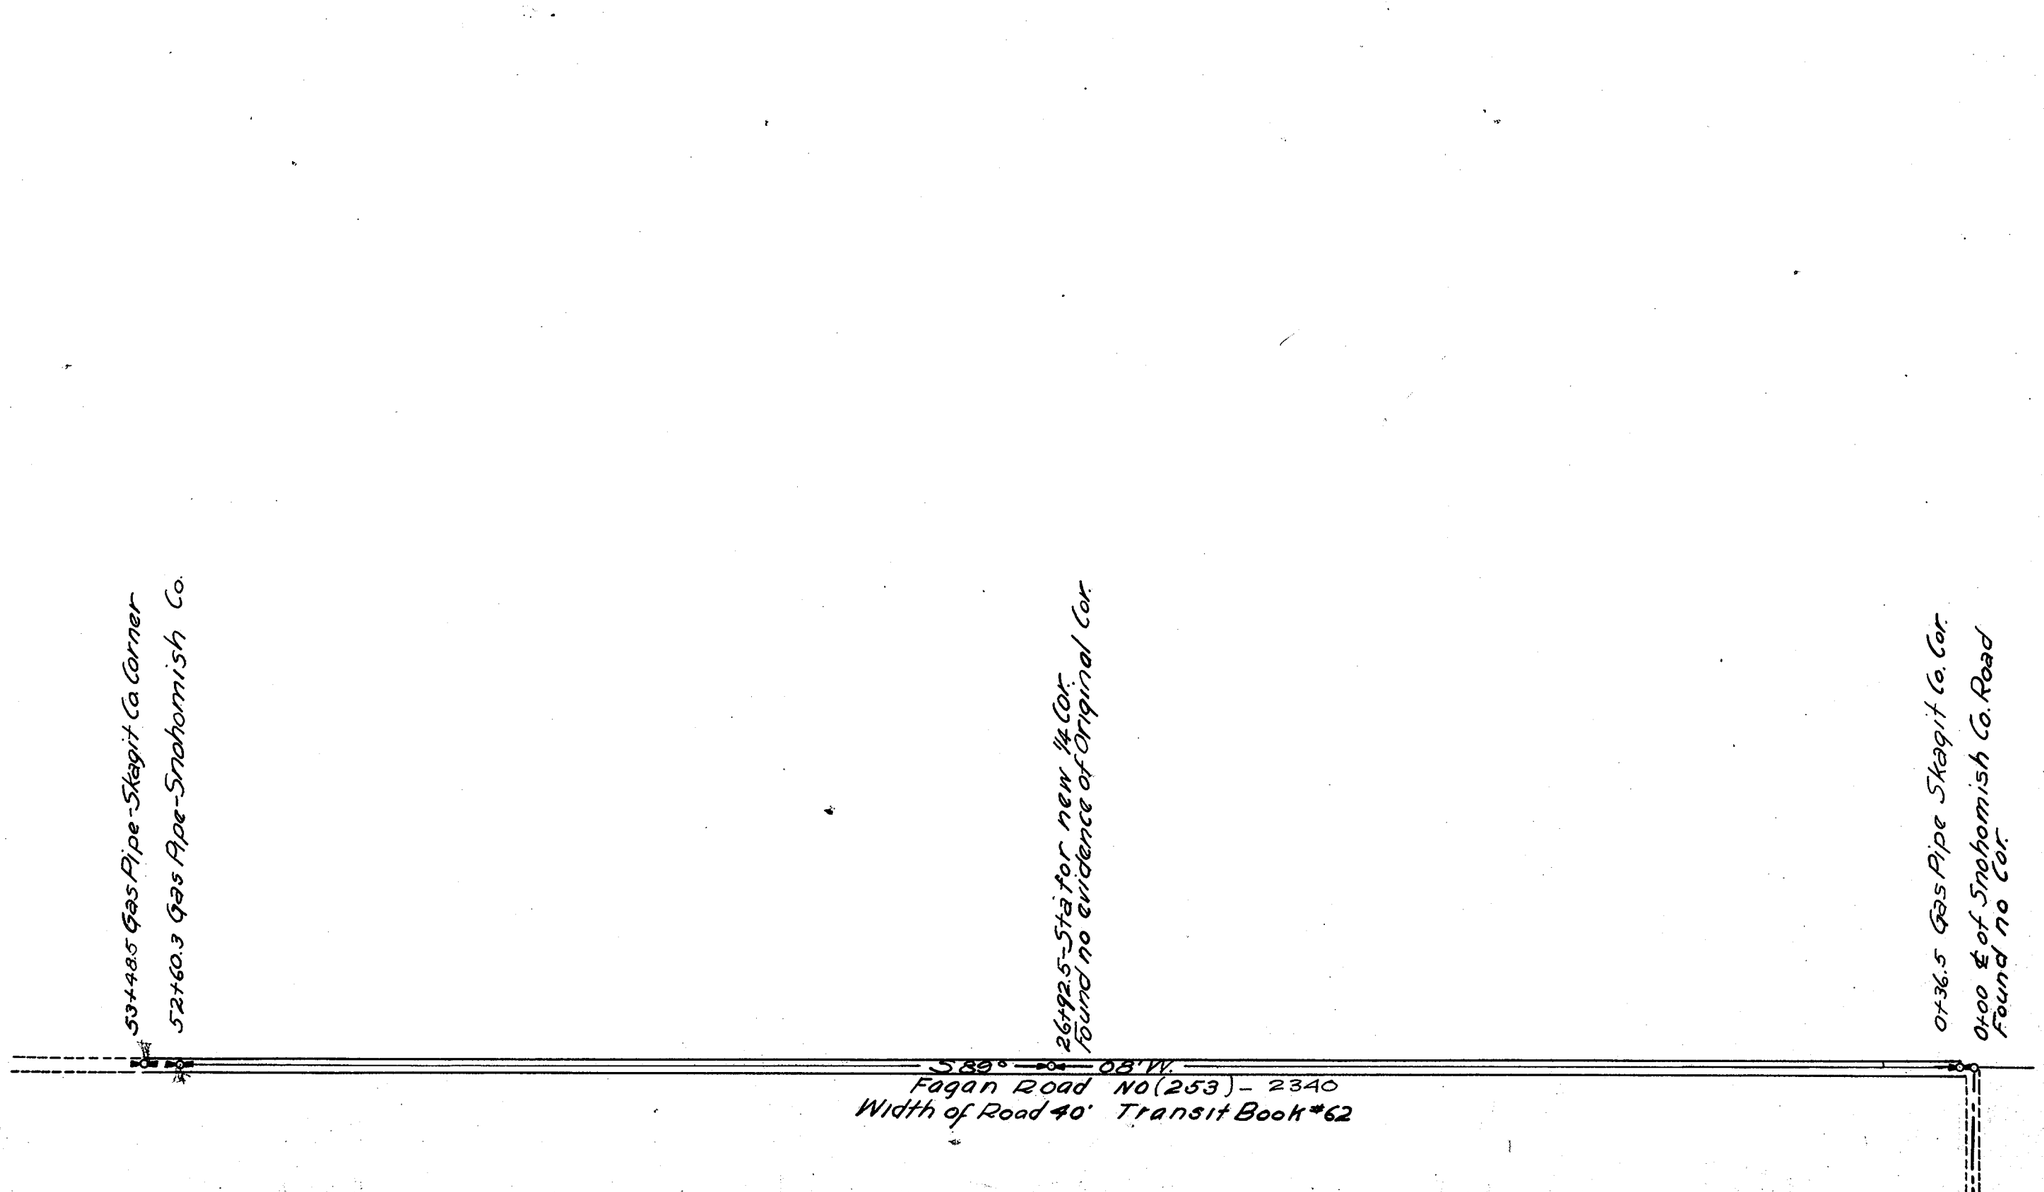


SECTION 34

TOWNSHIP 33 NORTH, RANGE 4 EAST, W. M.
SKAGIT COUNTY, WASH.

SCALE, 1 INCH–400 FEET

1932

R.E.L. Knapp COUNTY ENGINEER

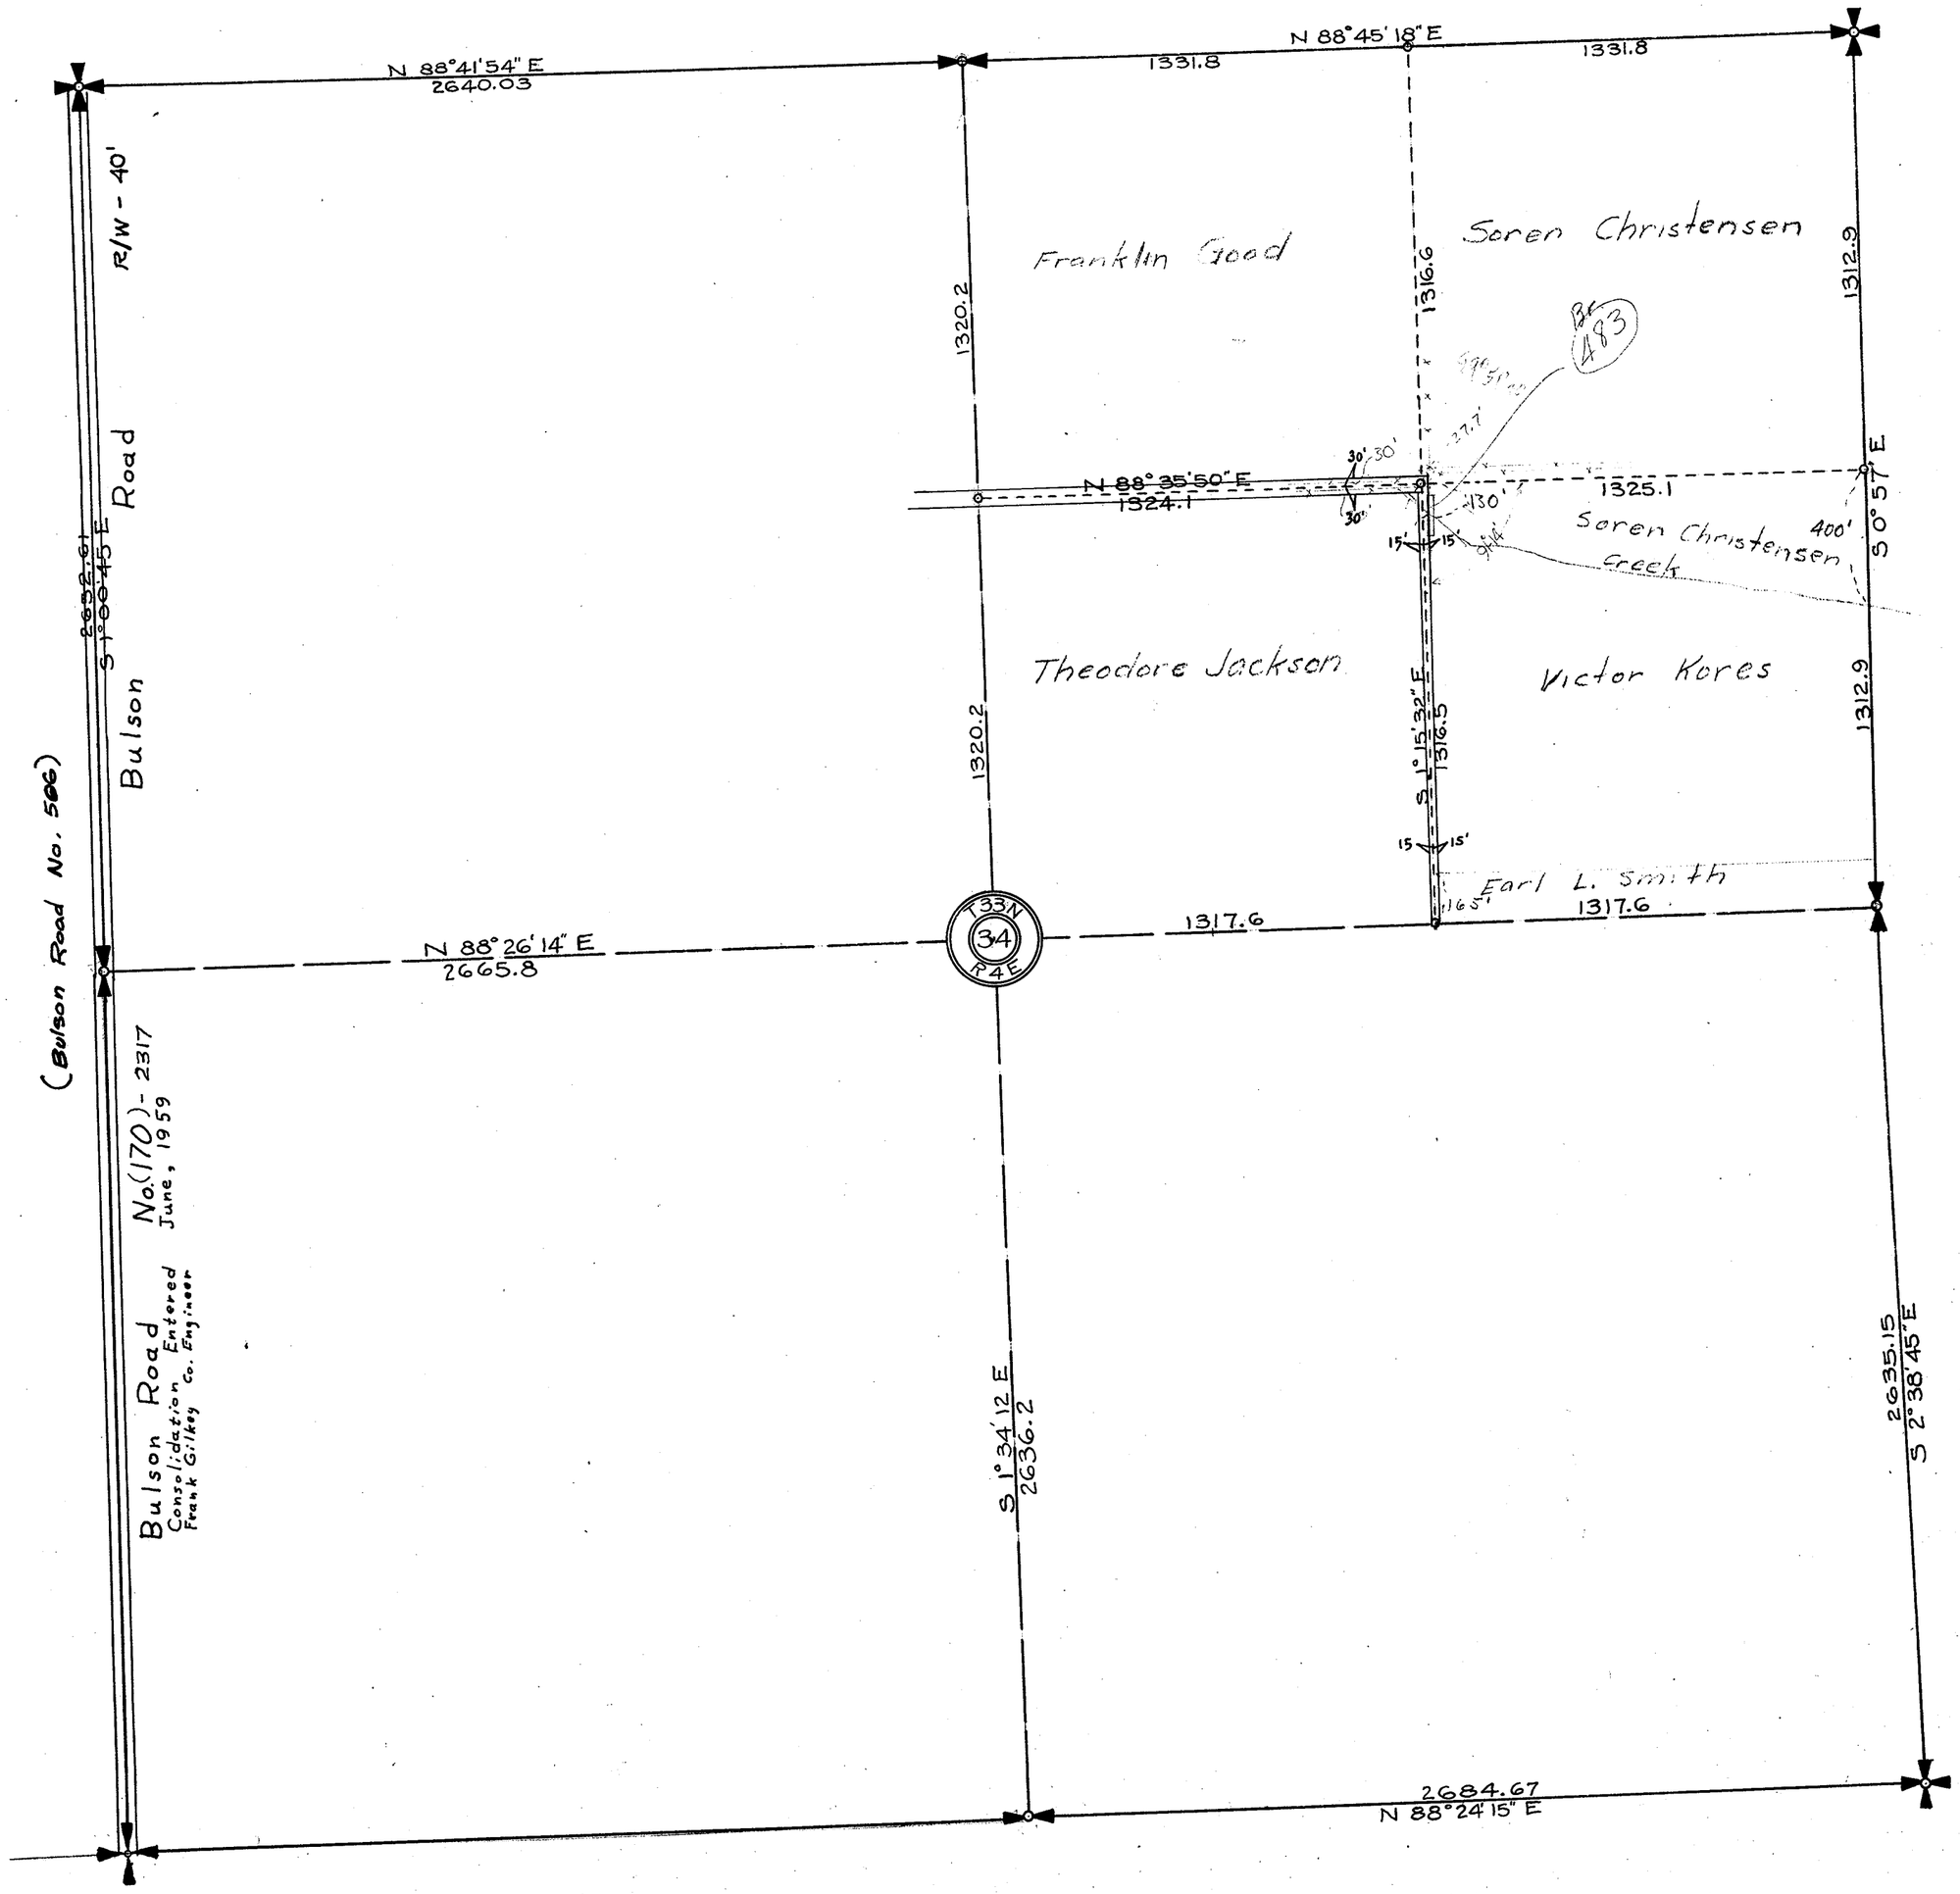

SECTION 34

TOWNSHIP 35 NORTH, RANGE 4 EAST, W. M.
SKAGIT COUNTY, WASH.

SCALE, 1 INCH—400 FEET

A.L. Strong COUNTY ENGINEER




SECTION 34

TOWNSHIP 33 NORTH, RANGE 4 EAST, W. M.

SKAGIT COUNTY, WASH.

DATE September, 1958 Frank Gilkey COUNTY ENGINEER

SCALE, 1 INCH--400 FEET
Subdivision from Notes #211

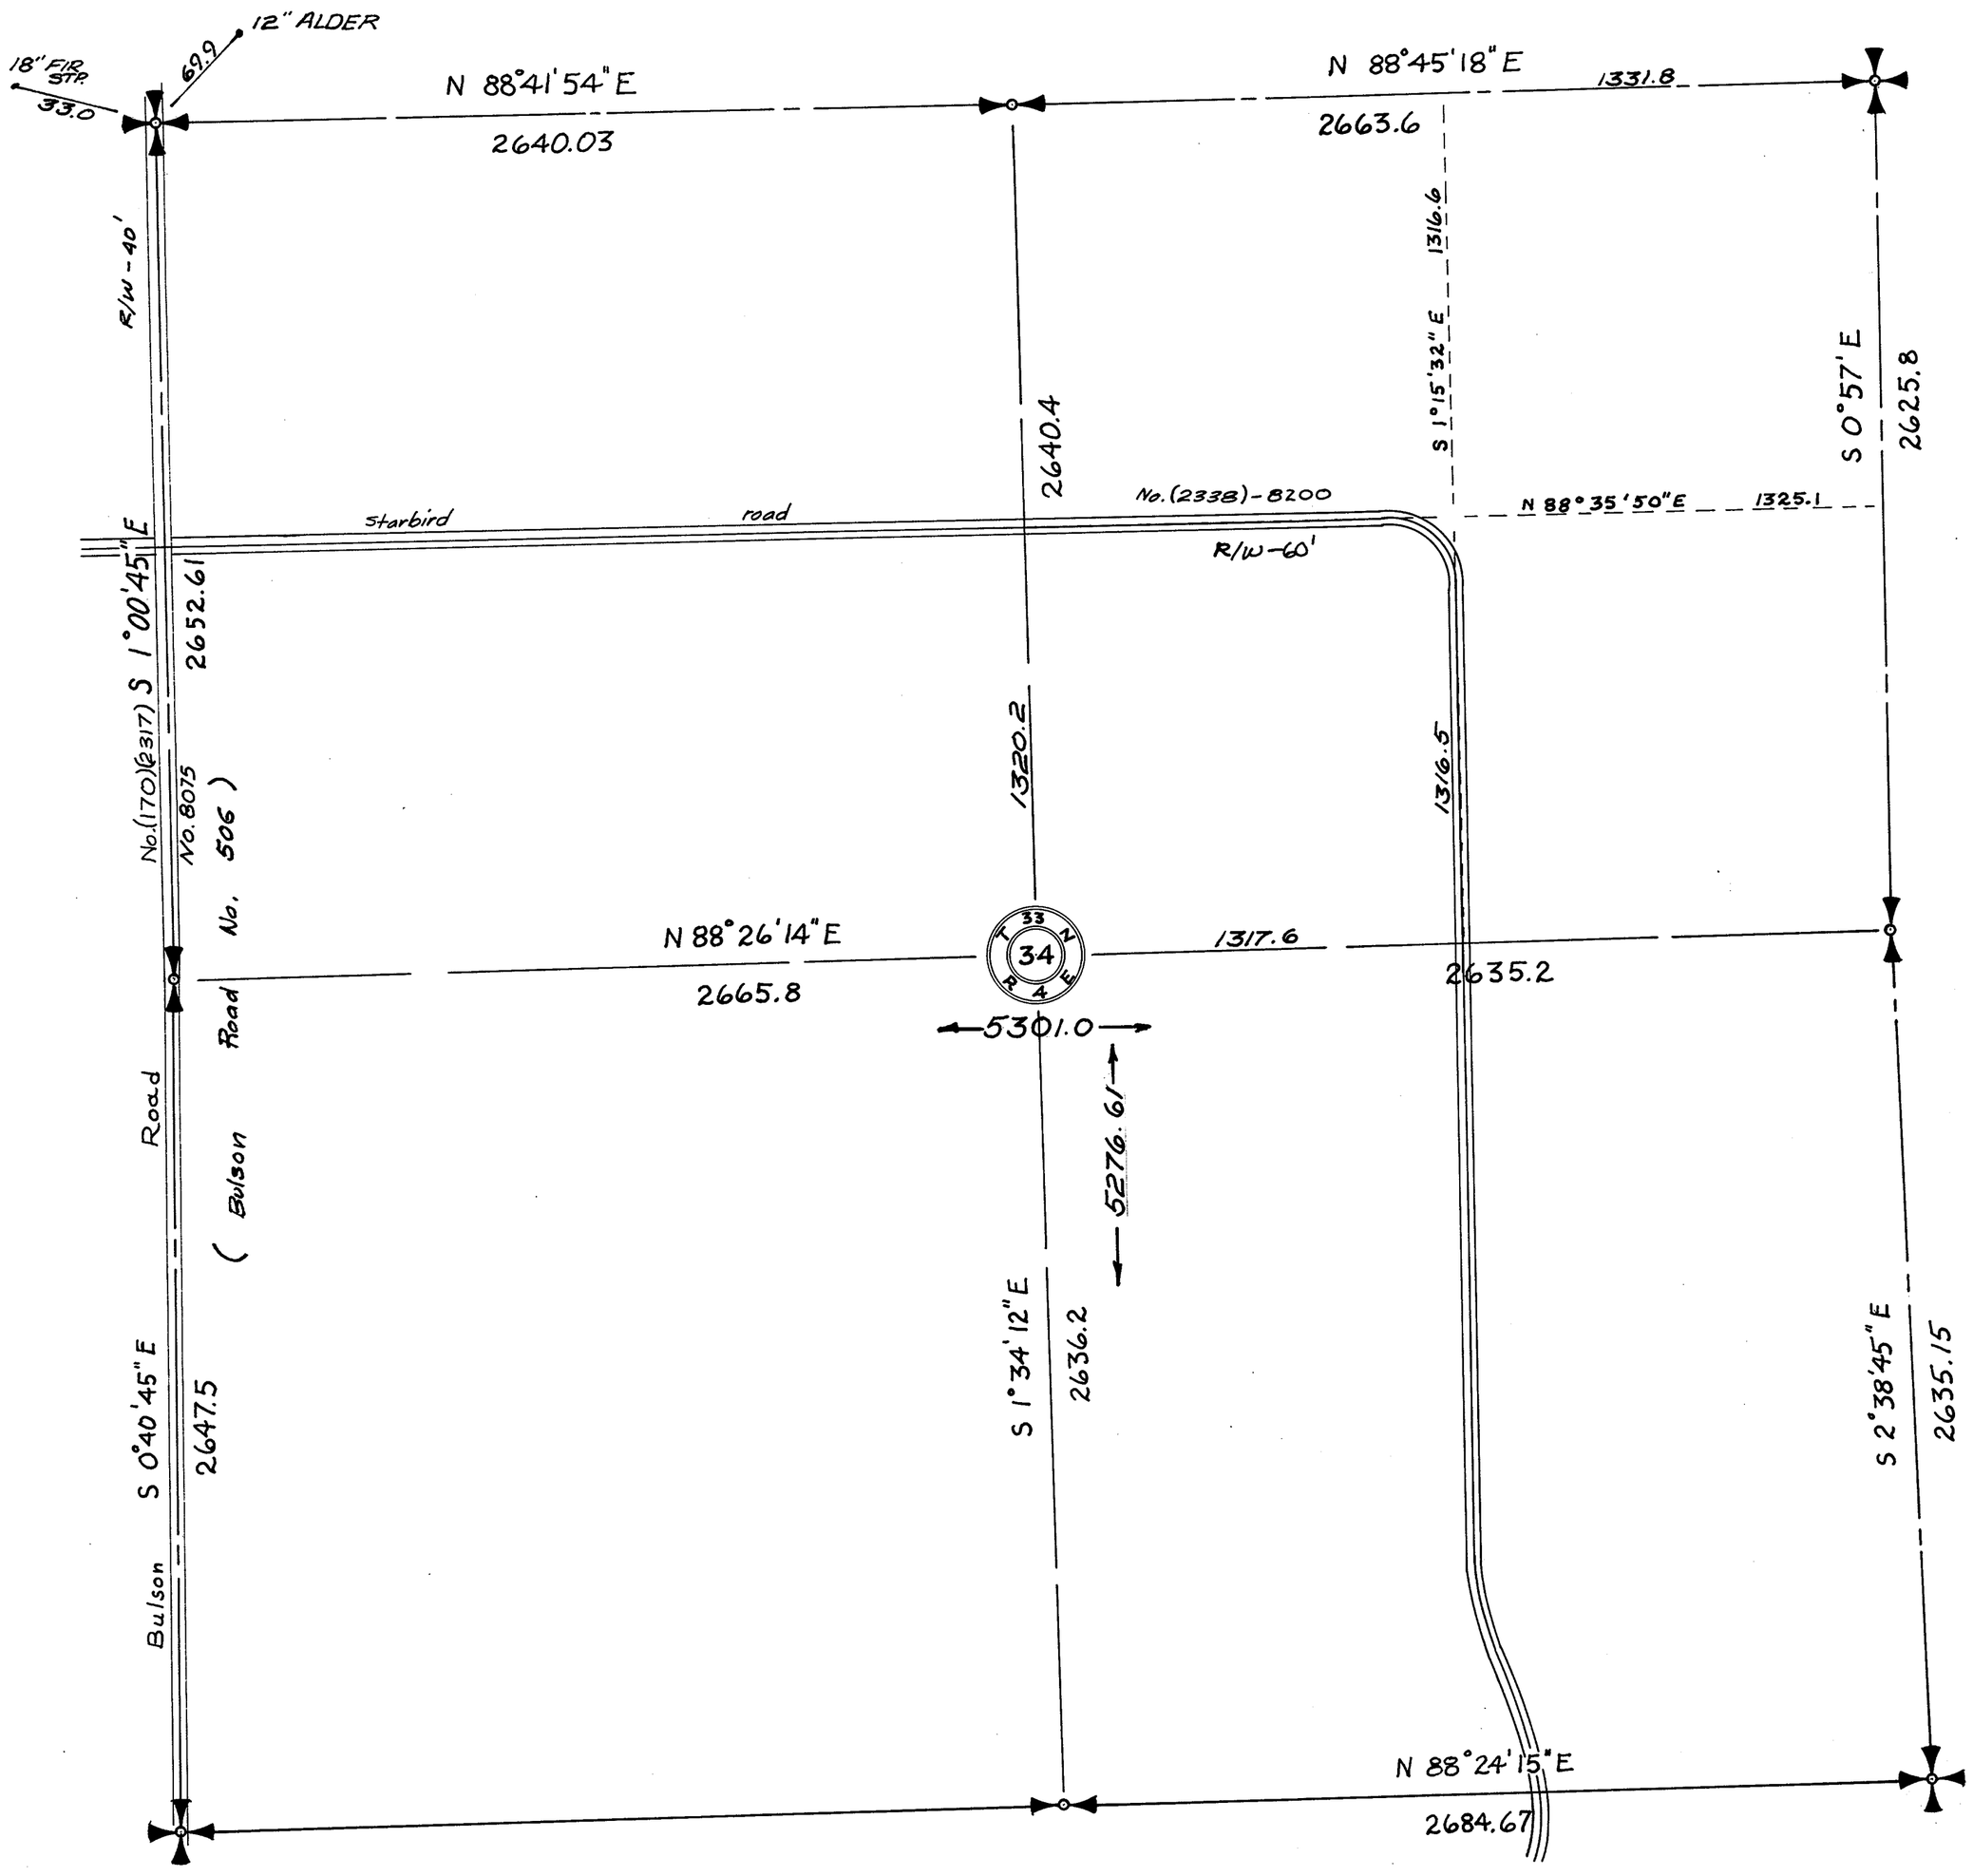


SECTION 36

TOWNSHIP 33 NORTH, RANGE 4 EAST, W.M.

SKAGIT COUNTY, WASH,

SCALE, 1 INCH ··· 400 FEET

Lloyd H. Johnson COUNTY ENGINEER

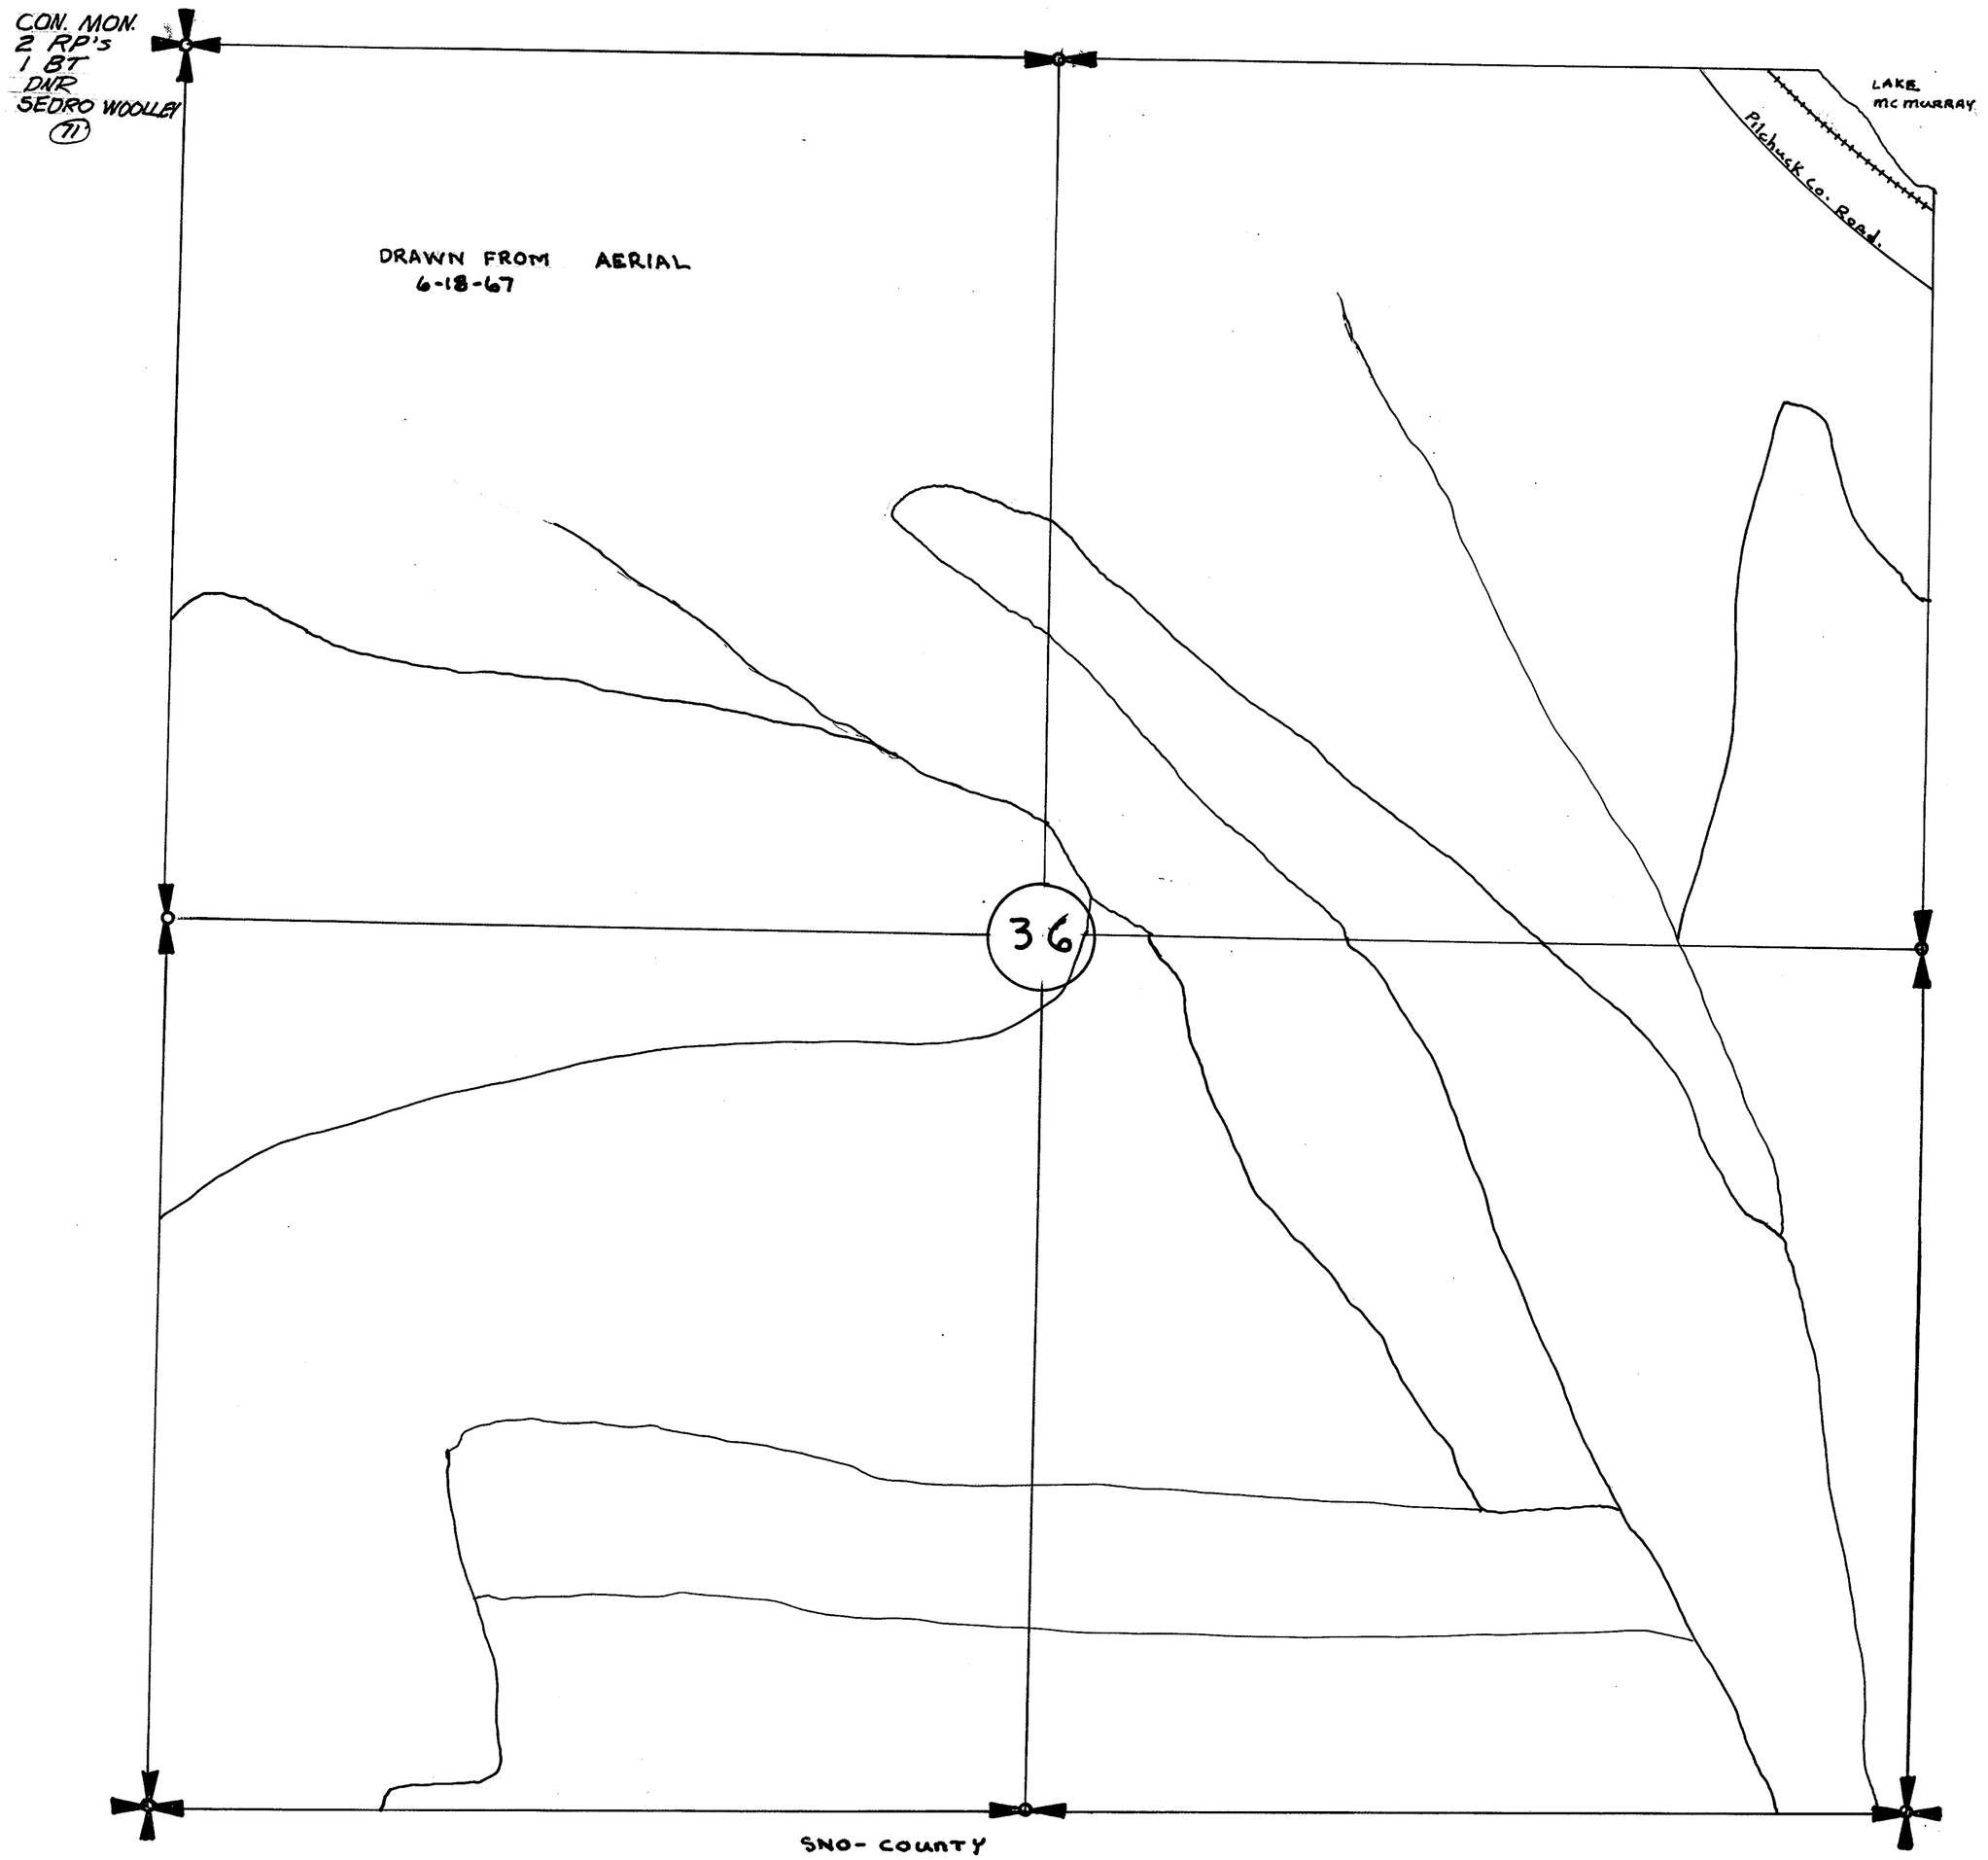

SECTION 4


TOWNSHIP 33 NORTH, RANGE 5 EAST, W. M.

SKAGIT COUNTY, WASH.

SCALE, 1 INCH -- 400 FEET

DATE 12-16-70

_____ COUNTY ENGINEER

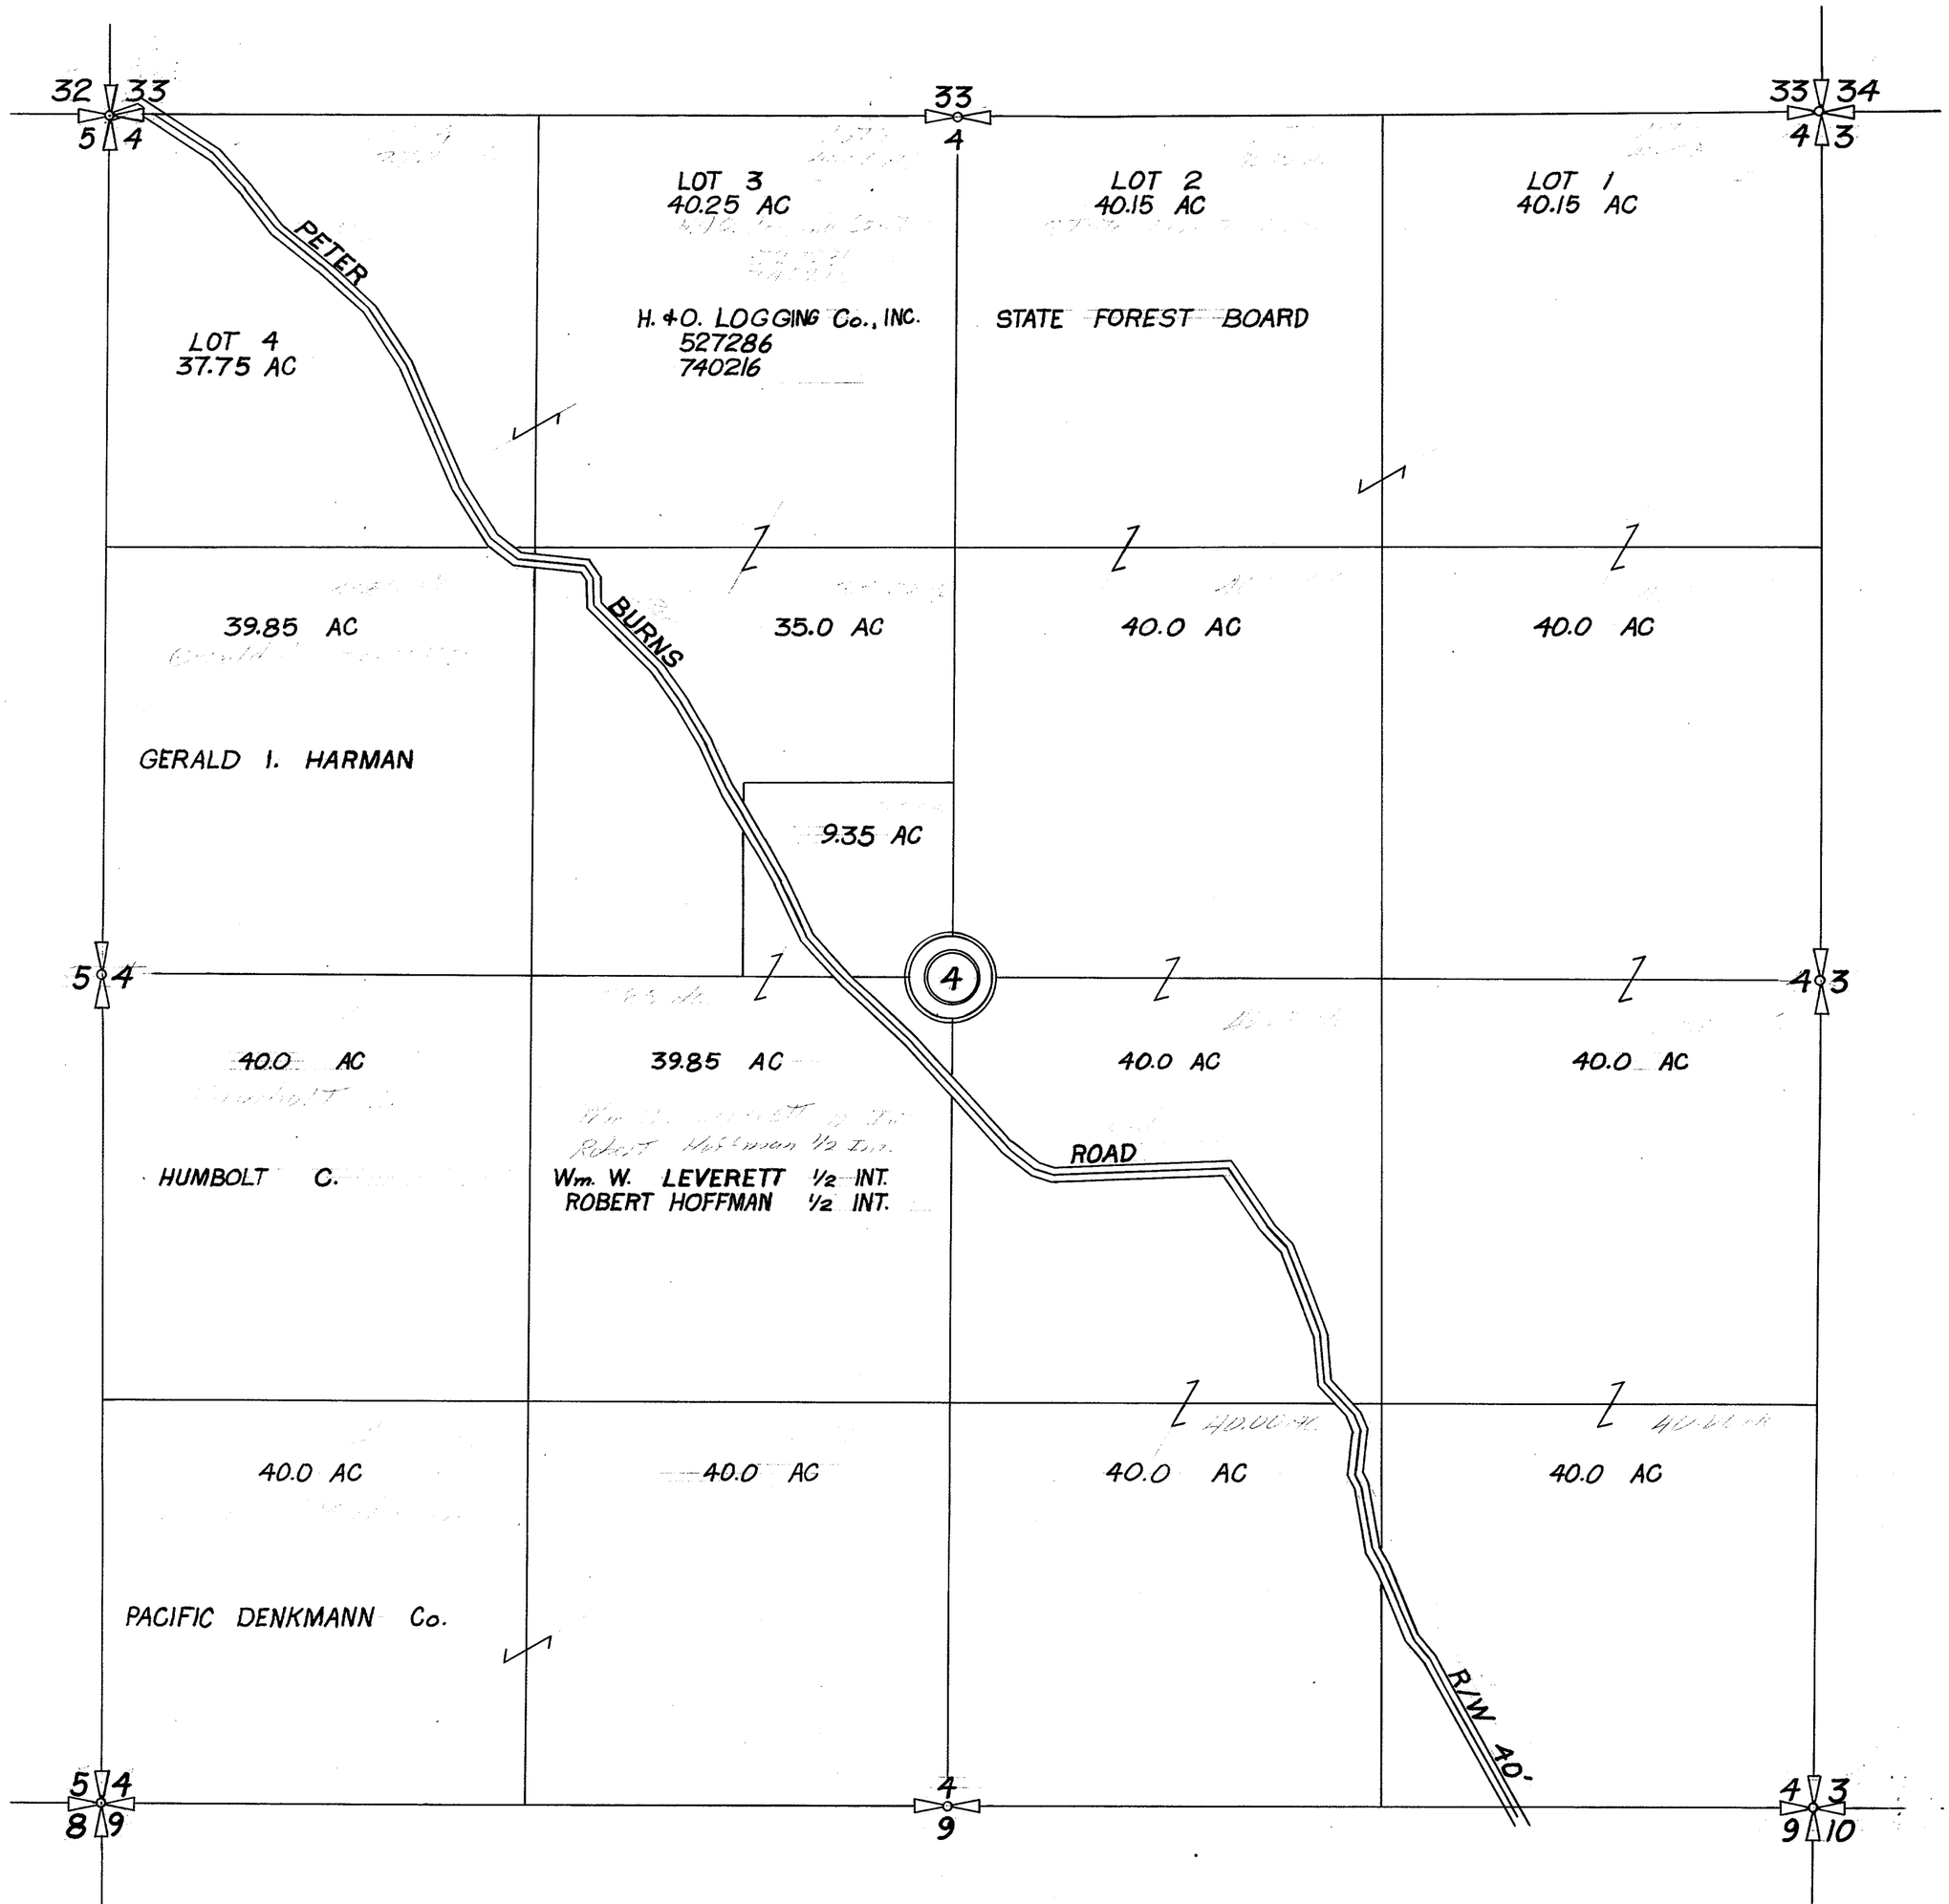

SECTION 6

TOWNSHIP 33 NORTH, RANGE 5 EAST, W. M.

SKAGIT COUNTY, WASH.

DATE Aug. 22, 1966

Lloyd Johnson COUNTY ENGINEER

SCALE, 1 INCH -- 400 FEET

TACK No. FACE P.P. #5897

45.77 TACK No. FACE T.P.

1" Pipe

71.44

TACK 4TH BOARD UP S.E COR. GARAGE

N89°05'E 2643.7

N88°33'E 2637.7

Walker Valley Road No. 0575 R/W - 30'

No. (2462)-(CXXVIII)

PLAT OF TOWN OF MONTBORNE VOL 2, 80

Montborne Road R/W - 50'

S.S.H. - 9

Reserve Addition to Montborne VOL 2 59

No. (2331)-(562)

No. 0450

WEST VIEW REPLAT of BLOCK 40, MONTBORNE VOL 6 Pg 5

West View Road No. (2327)-(389)-0500 R/W - 40'

Lee Road No. (2333)-0435 (708) R/W - 60'

2927.3

N0°17'20"W 2732.0

2645.4

Note: This Tracing Drawn From Aerial Photo - Not to Scale -----

Notes:

324

South West View Rd. No. 0502 added eq. 4.68

NORTHERN

T-33-N 6 R-5-E

S87°04"W

N87°04'E 2706.5

123+85.4 P.C.

P.I. 126+26.0
Δ 9°36
T 240.6'
L 480.0'

128+65.4 P.T.

N 53°42'30"E

West

P.I. 136+57.8
Δ 14°24'
T 181.0'
L 360.0'

134+76.8 P.C.

138+36.8 P.T.

Big Lake Blvd.

N 25°21'30"E

N 1°26'10"W

NOTE: See plan LL17 & Hrdshl A18/7

S0°17'20"E 2702.8

PACIFIC PLAT I SULPHUR SPRING LAND TRACTS VOL 5, 13

S.S.H. - 9

2736.0

S89°20'45"E

2704.1

SECTION 7


TOWNSHIP 33 NORTH, RANGE 5 EAST, W.M.

SKAGIT COUNTY, WASH.

SCALE 1 INCH ··· 400 FEET

DATE MAY 15, 1972

Lloyd H. Johnson COUNTY ENGINEER

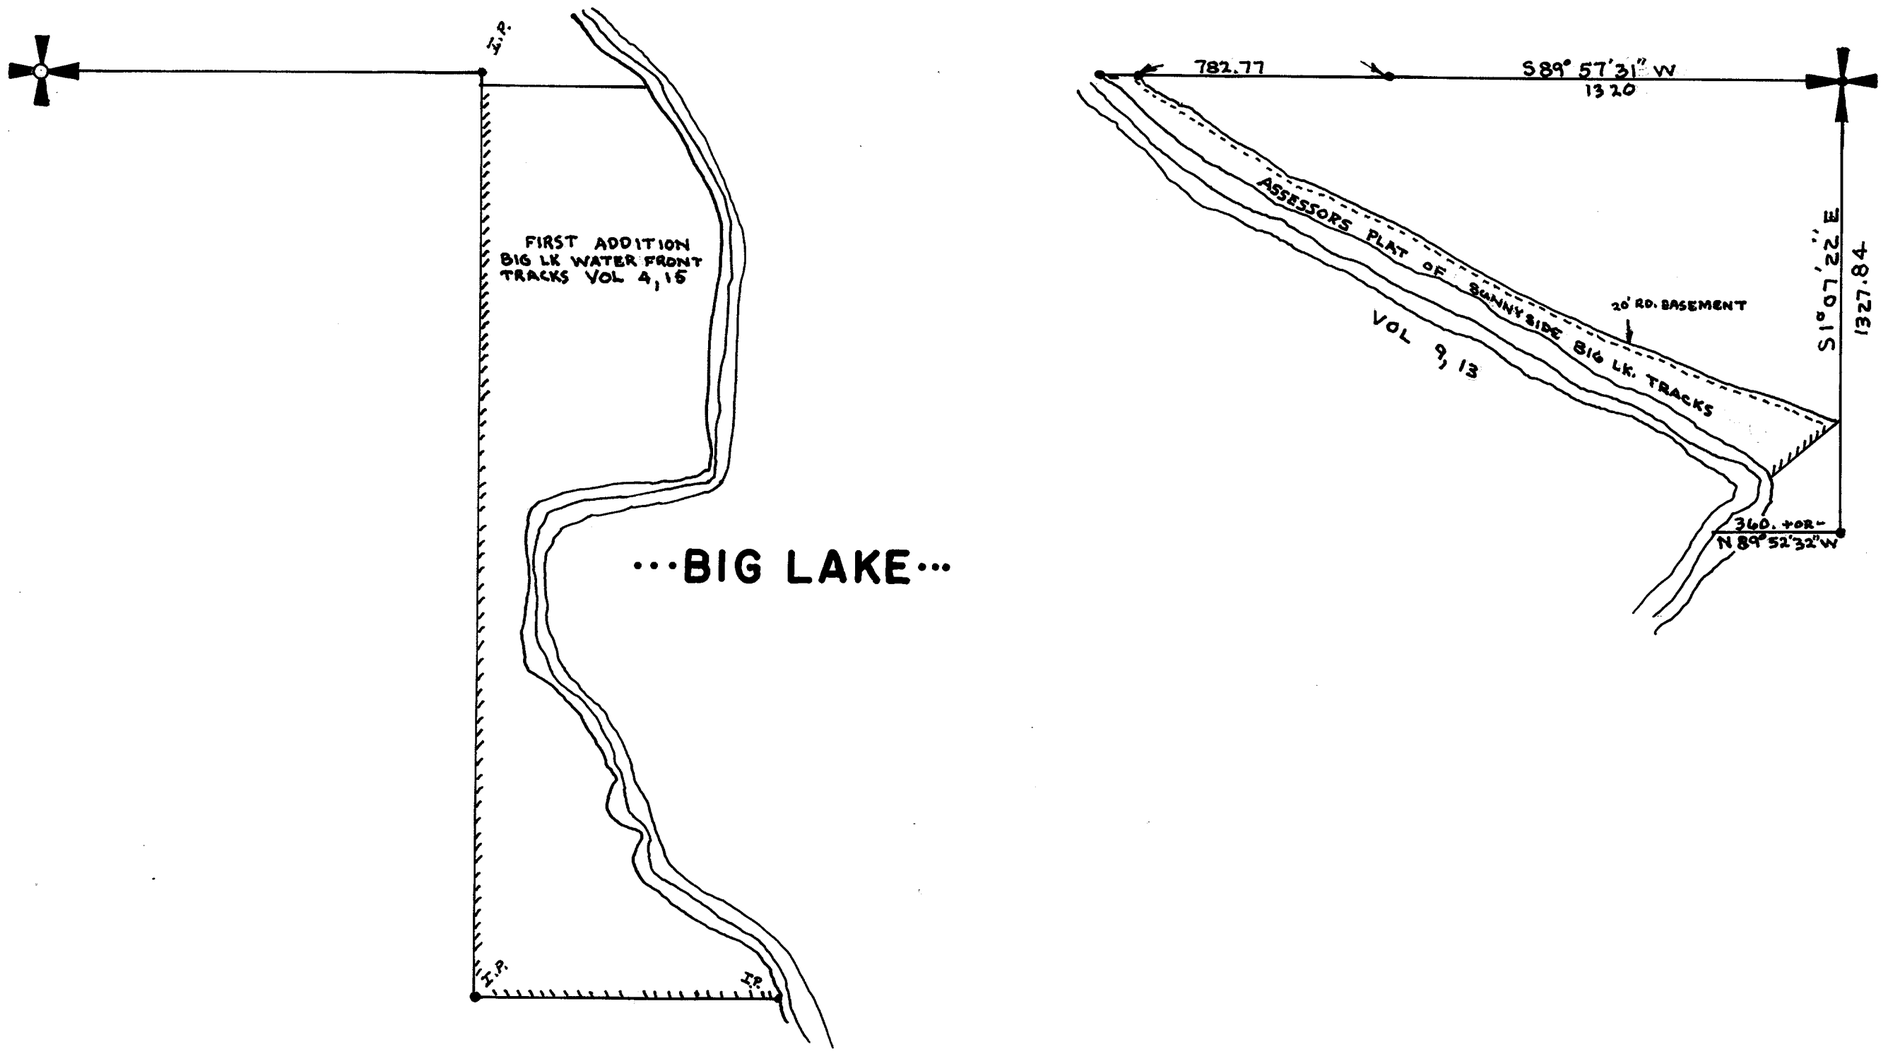

SECTION 7

TOWNSHIP 33 NORTH, RANGE 5 EAST, W. M.

SKAGIT COUNTY, WASH.

SCALE, 1 INCH -- 400 FEET

DATE Aug. 23, 1966

Lloyd Johnson COUNTY ENGINEER

20" CEDAR STP.
20.5
4x4 CEDAR HUB
9'
CEDAR LOOKS LIKE OLD "BT"

Notes:
632
539

S 52°21'32" E
157+82.2 P.C.
162+65.3 P.T.
P.I. 160+96.7
Δ 57°58'
C 12°
T 264.5'
L 483.1'

WEST
S 36°12'30" E
166+00.5 P.C.
P.I. 169+27.6
Δ 68°49'
C 12°
T 327.06'
L 573.47'
171+74.0 P.T.
S 36°12'30" E
BIG
180+89.06 P.C.
184+76.25 P.T.
P.I. 182+97.51
Δ 30°58'30"
D 8°
T 196.45'
L 387.19'
S 67°11' E
LAKE
188+46.29 P.C.
P.I. 192+71.79
Δ 33°05'
D 4°
T 425.45'
L 827.08
196+73.37 P.T.
S 33°53'30" E
EQUATION 198+61.60 AHD =
198+70.15 BK
BLVD
213+63.63 P.C.
P.I. 218+59.46
Δ 54°52'
D 6°
T 495.82'
L 914.45'
222+78.08 P.T.
S 88°59' E

BIG LAKE

NORTHERN PACIFIC
S.S.H. - 9
Lake Cavanaugh Road No. (2348)-(358)-0020
R/W - 60'
S.S.H. - 9

T-33-N
7
R-5-E

20" FIR (61)
27.60
Replaced 4"x4" Post with 1½" Pipe 1961
24.00
20" Hemlock Tack & Nail Top of STP. (61)
23.80
6" FIR STP. (61)

Note: See Plan LL17 & LL24 For R/W Details

12" FIR (61)
14.00
12.20
5" FIR (61)
2" Pipe
13.00
5" FIR (61)
9.00
8" FIR (61)

S 87°47'20" E

SECTION 7

TOWNSHIP 33 NORTH, RANGE 5 EAST, W. M.

SKAGIT COUNTY, WASH.

SCALE, 1 INCH--400 FEET

H.O. Walberg COUNTY ENGINEER

This subdiv. compiled from Records in Engineer's Office W.C.W. Sept. 30, 1946

¢ Sec. 6 as Laid out in Plat of Montborne

N 0° 05' E Sec. Line

N 0° 40' E Plat

S 1858.21 E 5409.81

Cedar Post

Sec. Line as shown in Plat

S 89° 51' E 13096

S 88° 22' 50" E 2627.3

I.P. in Plat S 1861.6 E 6719.4

of Big Lake W.F. Tracts

N 0° 15' 12" 2564.14

S 1865.1 E 8047.2

S 1943.60 E 8465.4 M.C. I.P.

S 1991.15 E 10644.80 1½" I.P.

S 1895.35 E 6722.9

1/16

℄ Sec. Line

S 1932.6 E 8036.0

S 88° 31' E 429.4

N 88° 45' W 2180.0

Creek

Plat Line S 0° 29' E

2660.7

BIG LAKE

N.P. Ry

S 0° 17' W 2659.97

Surveyed Not Closed

S 1453.57 E 5947.72

Plat Line S 89° 51' E 1320

S 88° 45' E

S 1453.91 E 6742.0 I.P. in Plat

903.8

I.P.

S 1456.42

Creek 1295.1

S 1593.2 E 8036.8

T 33 N R 5 E 7

S 88° 45' E 2594

S 1651.12 E 10631.6

380

2' I.P.

James Shrader

W.C. Whitnall

NE¼ of SW¼

Adolph Stone

Nelson Neal Co.

N 0° 01' 10" W

2654.7

Helen Millward

2617.

Ralph Millward

S 0° 42' W

State Road

David L. Howell

S 1710.2 E 8037.6


12808

S 1730.5 E 10599.2

S 89° 01' E

SECTION 7
TOWNSHIP 33 NORTH, RANGE 5 EAST, W. M.
SKAGIT COUNTY, WASH.

SCALE, 1 INCH--400 FEET

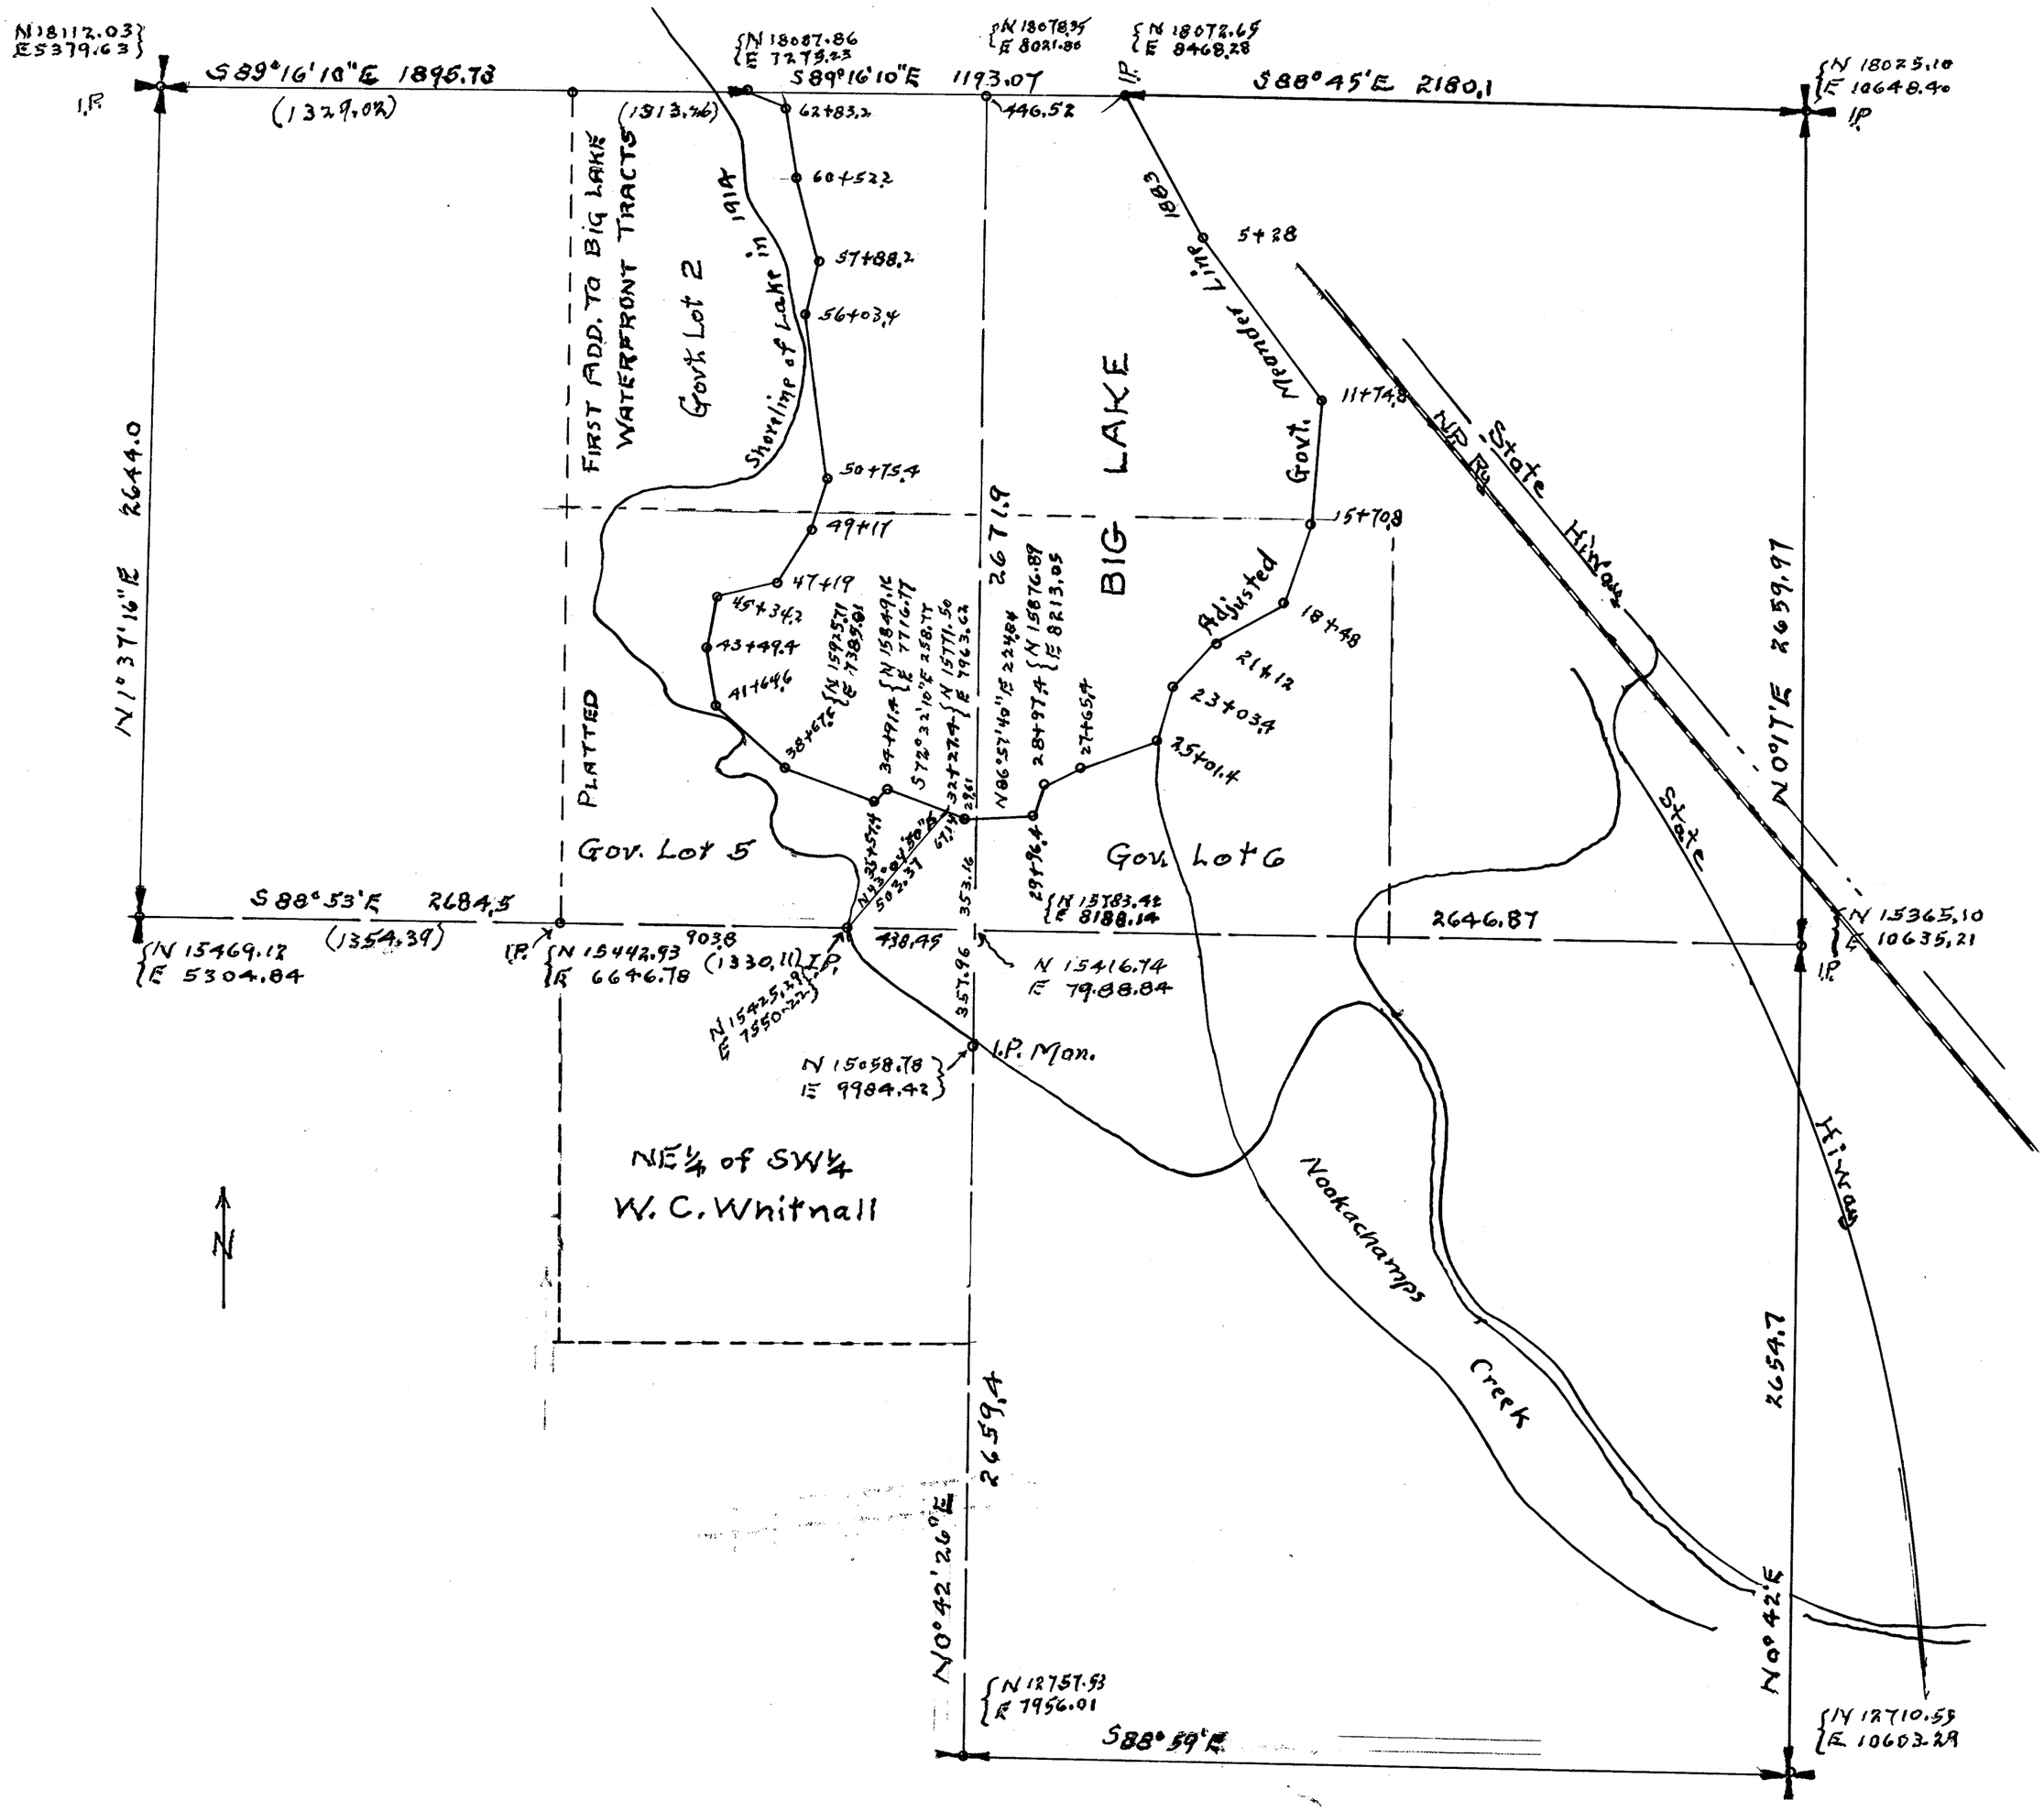

SECTION 8


TOWNSHIP 33 NORTH, RANGE 5 EAST, W. M.

SKAGIT COUNTY, WASH.

SCALE, 1 INCH--400 FEET
Road No. 358 Drawn From Notes 38/363 & Hardshell A-1/30
Subdivision of Subdivision Book

DATE December, 1959

Frank Gilkey COUNTY ENGINEER

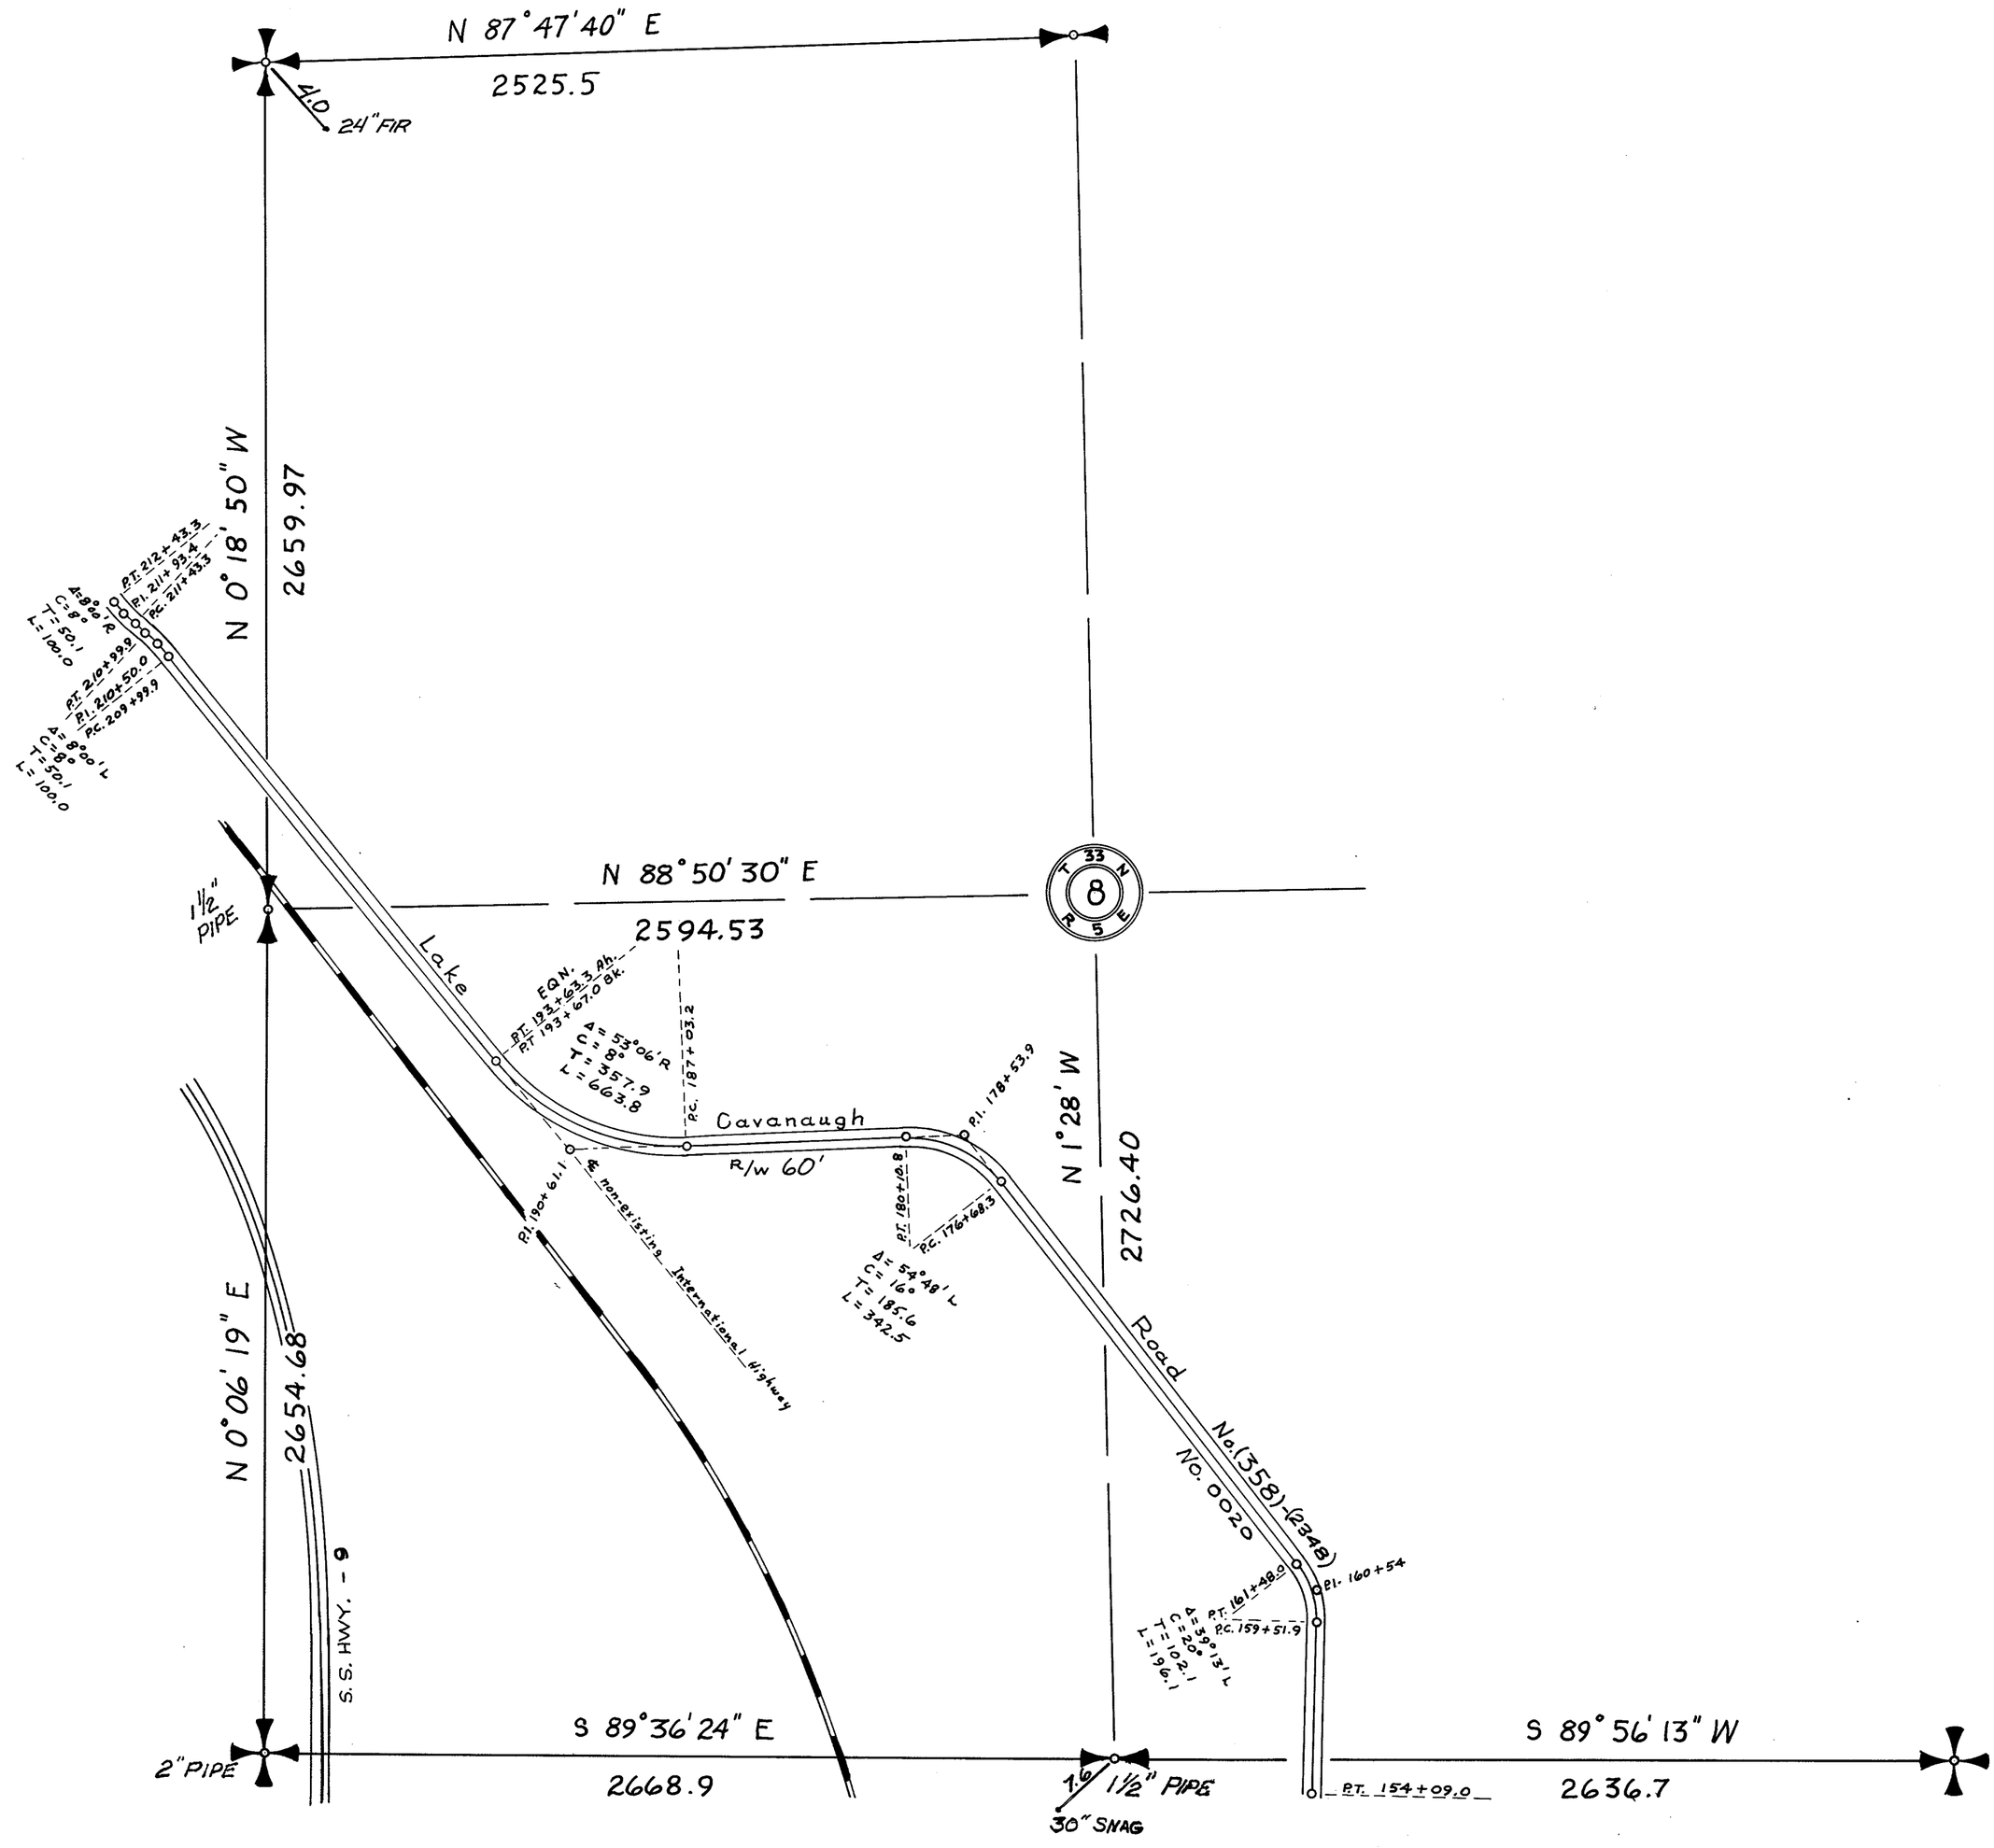


SECTION 8

TOWNSHIP 33 NORTH, RANGE 5 EAST, W. M.

SKAGIT COUNTY, WASH.

SCALE, 1 INCH–400 FEET

A. L. STRONG COUNTY ENGINEER

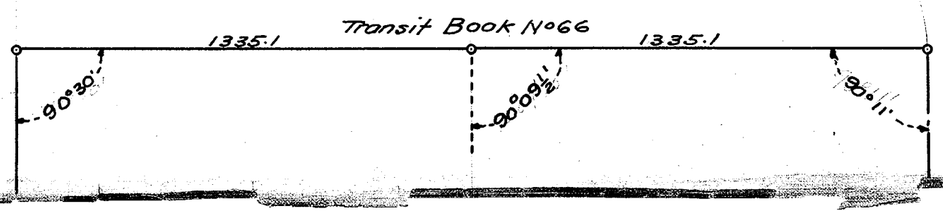

SECTION 13

TOWNSHIP 33 NORTH, RANGE 5 EAST, W. M.

SKAGIT COUNTY, WASH.

SCALE, 1 INCH--400 FEET

DATE Aug. 18, 1966

_____ COUNTY ENGINEER

NOTES:
307

T-33-N
13
R-5-E


Cavanaugh Road
No. (2348)-(358) 0020
R/W - 60'

Lake

30" FIR
20.0
5' CED.
15'
15'
42" HEM.

2" PIPE

SEC. 13-33-5

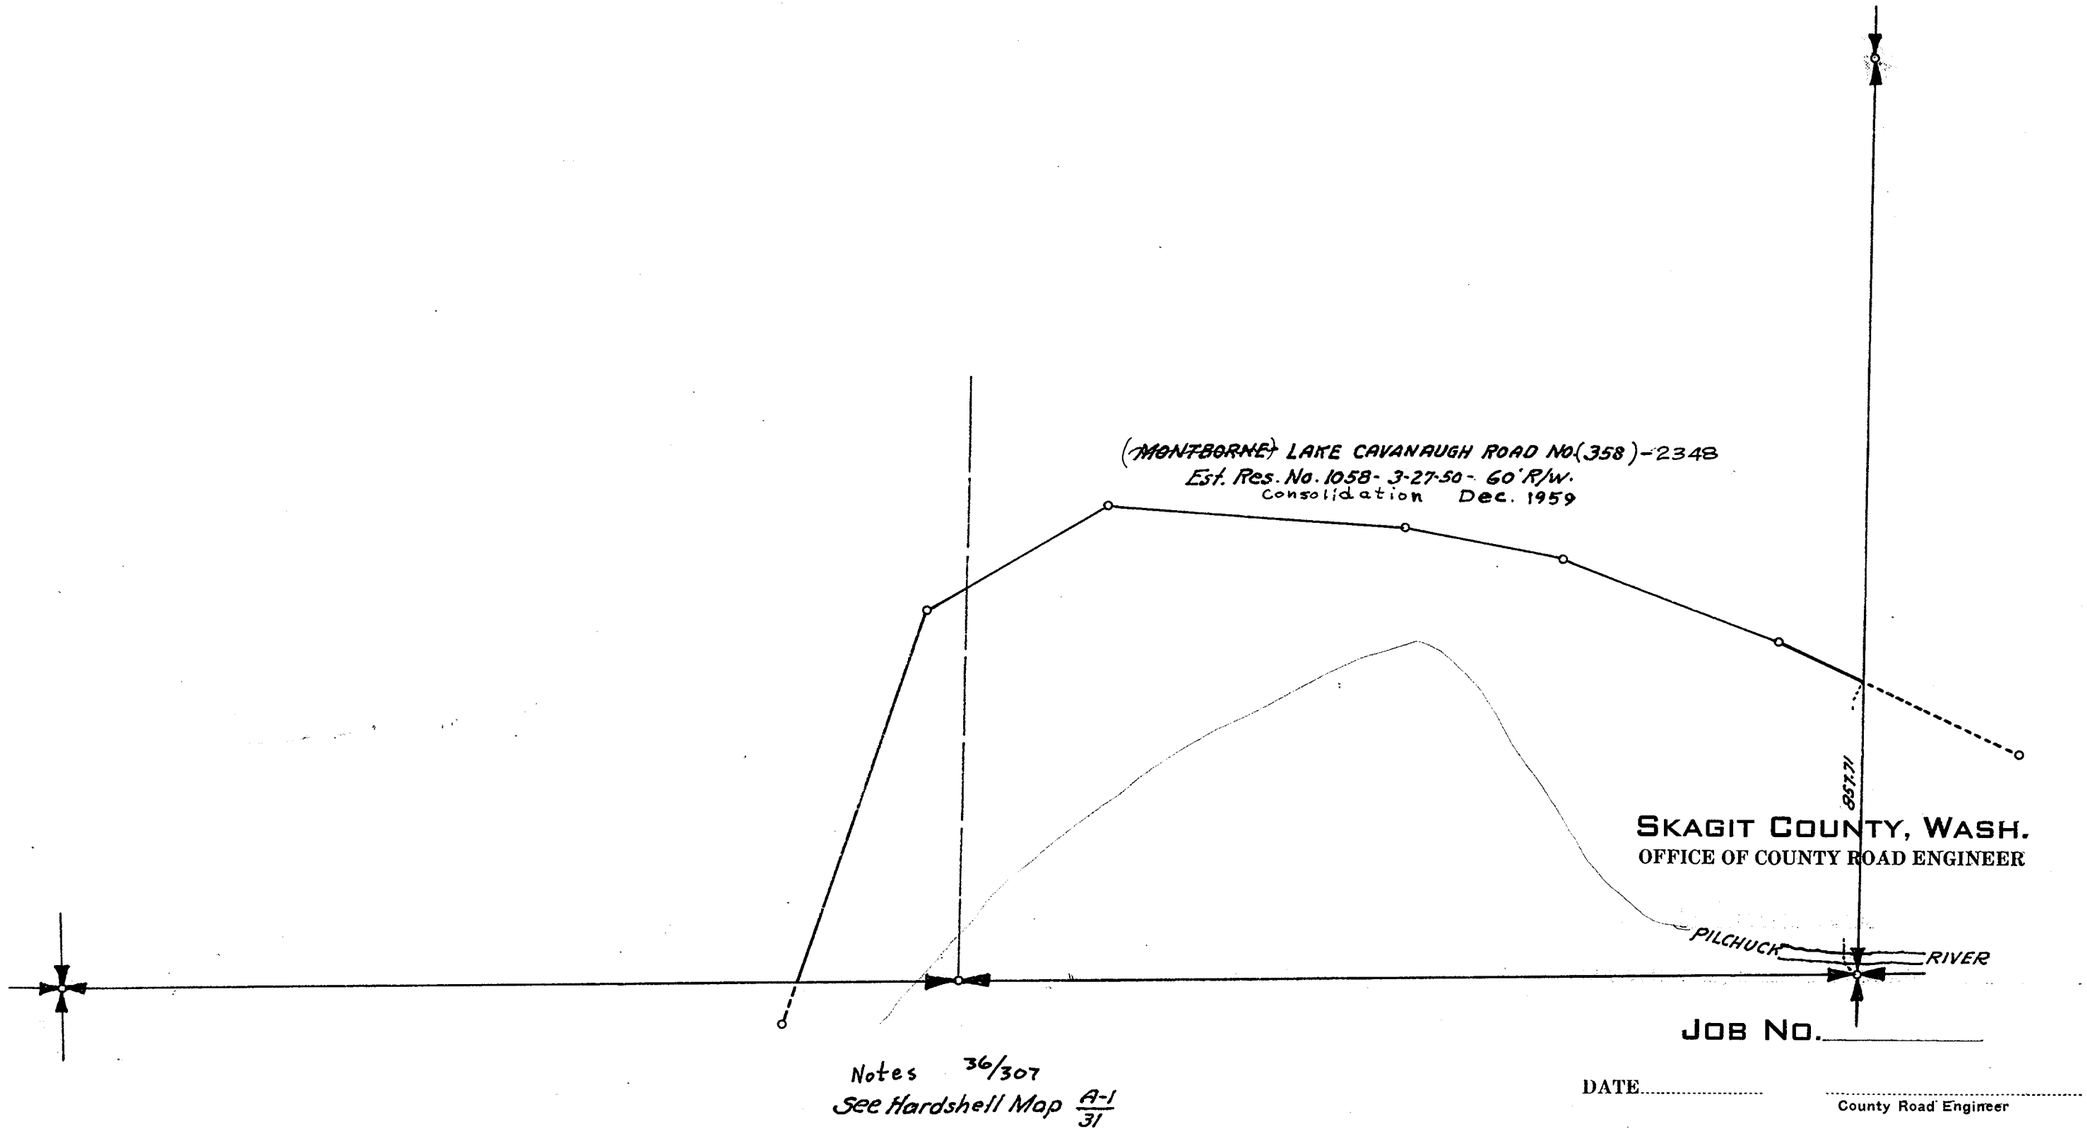

Notes 36/307
See Hardshell Map A-1/31

DATE..... County Road Engineer

APPROVED..... 194....

Chairman-Board of County Commissioneers

SECTION 16

TOWNSHIP 33 NORTH, RANGE 5 EAST, W. M.


SKAGIT COUNTY, WASH.

SCALE, 1 INCH--400 FEET

H.O. Walberg COUNTY ENGINEER

Notes 33/233
38/363
307

C.R.P. No. 1.

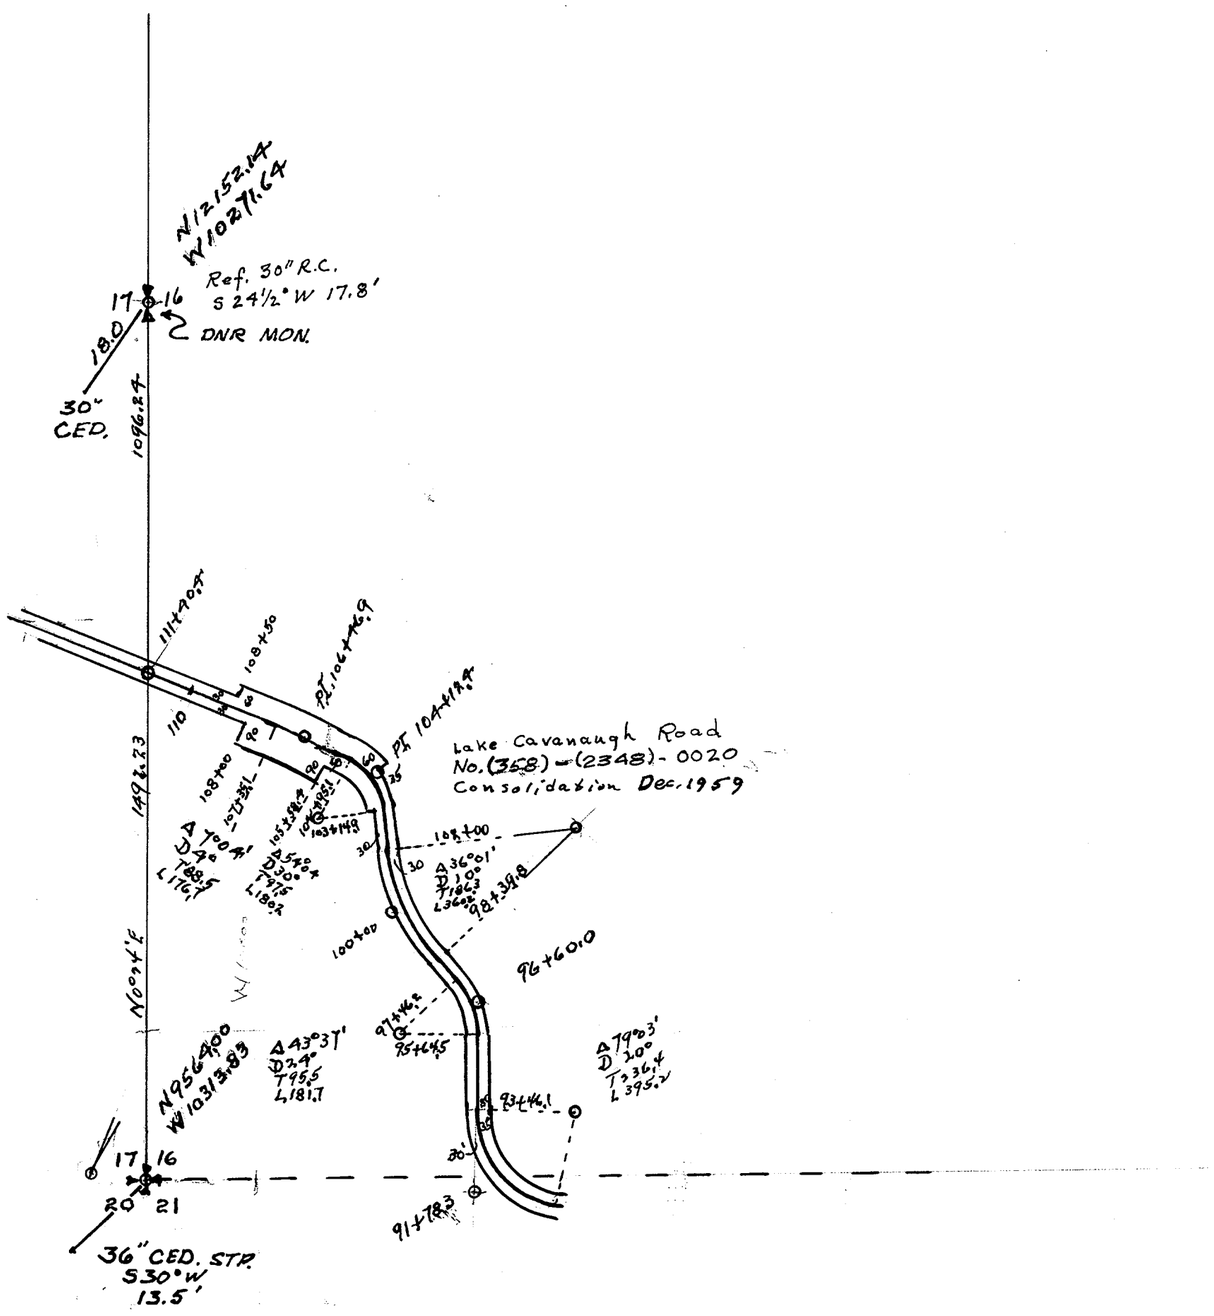


SECTION 17

TOWNSHIP 33 NORTH, RANGE 5 EAST, W. M.
SKAGIT COUNTY, WASH.

SCALE, 1 INCH = 400 FEET

A. L. STRONG COUNTY ENGINEER

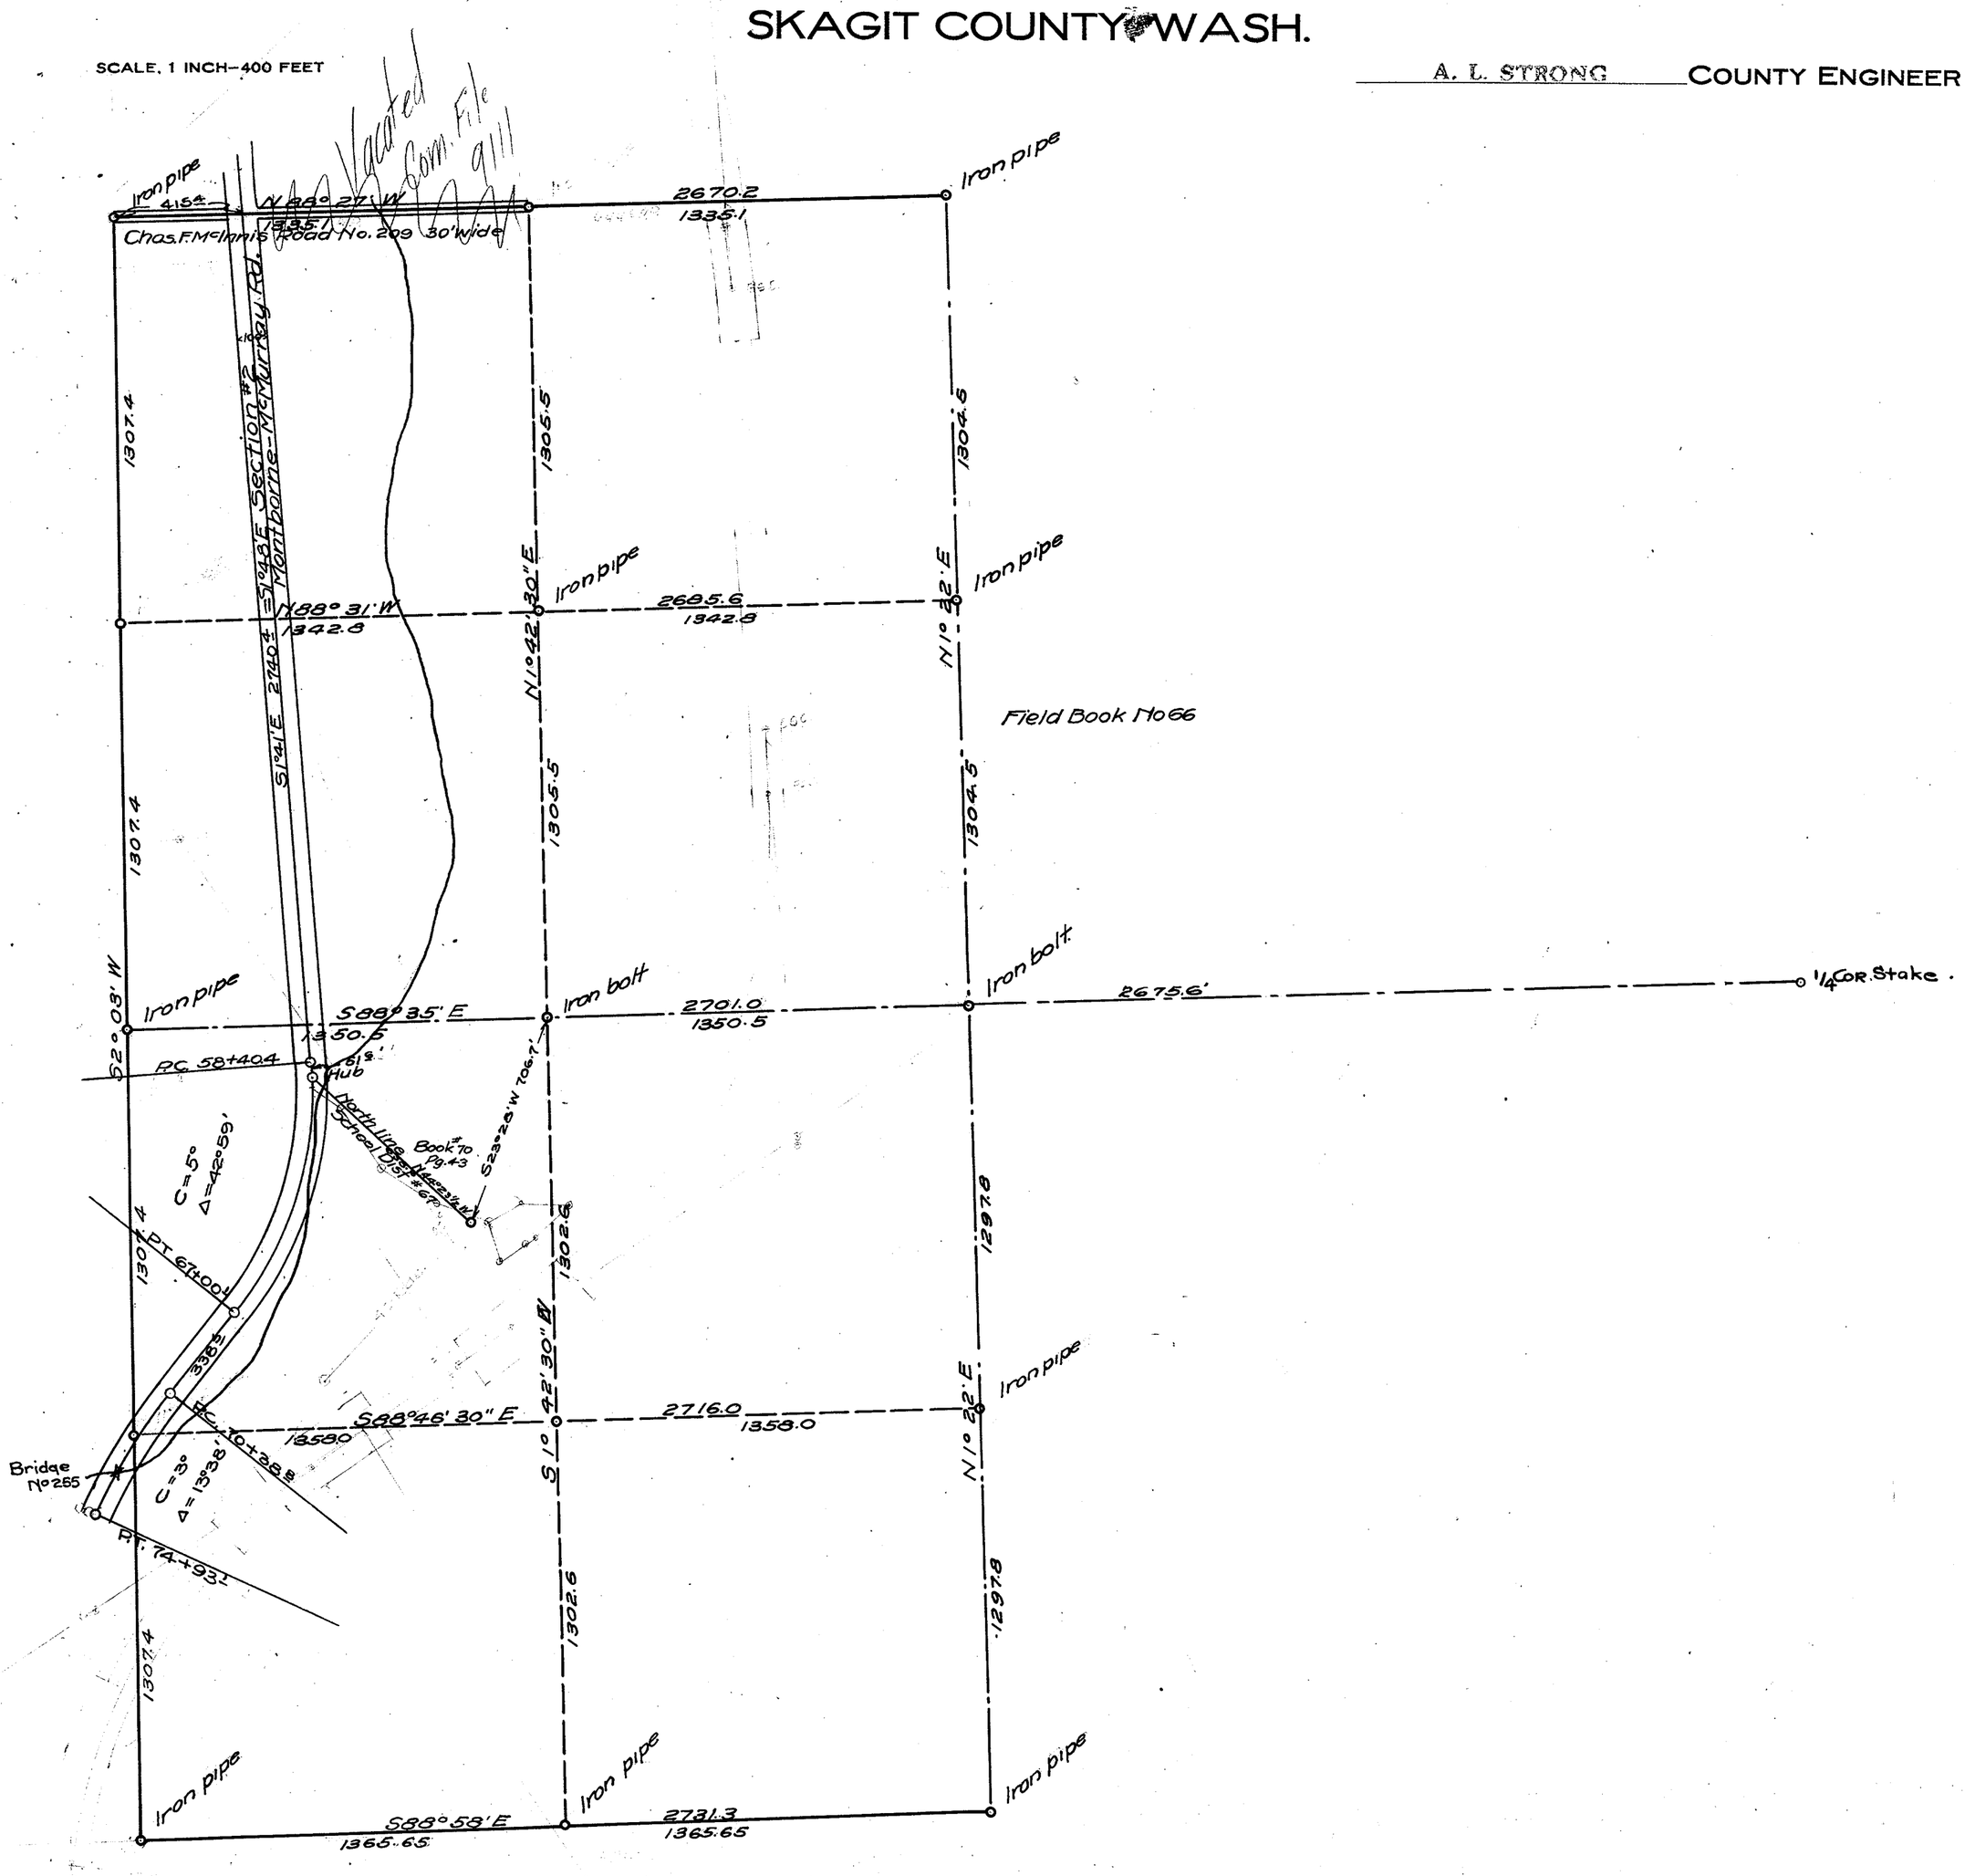


SECTION 17

TOWNSHIP 33 NORTH, RANGE 5 EAST, W. M.

SKAGIT COUNTY, WASH.

DATE December, 1959 — Frank Gilkey — COUNTY ENGINEER

SCALE, 1 INCH--400 FEET
Road No. 358 Drawn From Notes 38/363
Subdivision Drawn Subdivision Book and Hardshell A-1/30

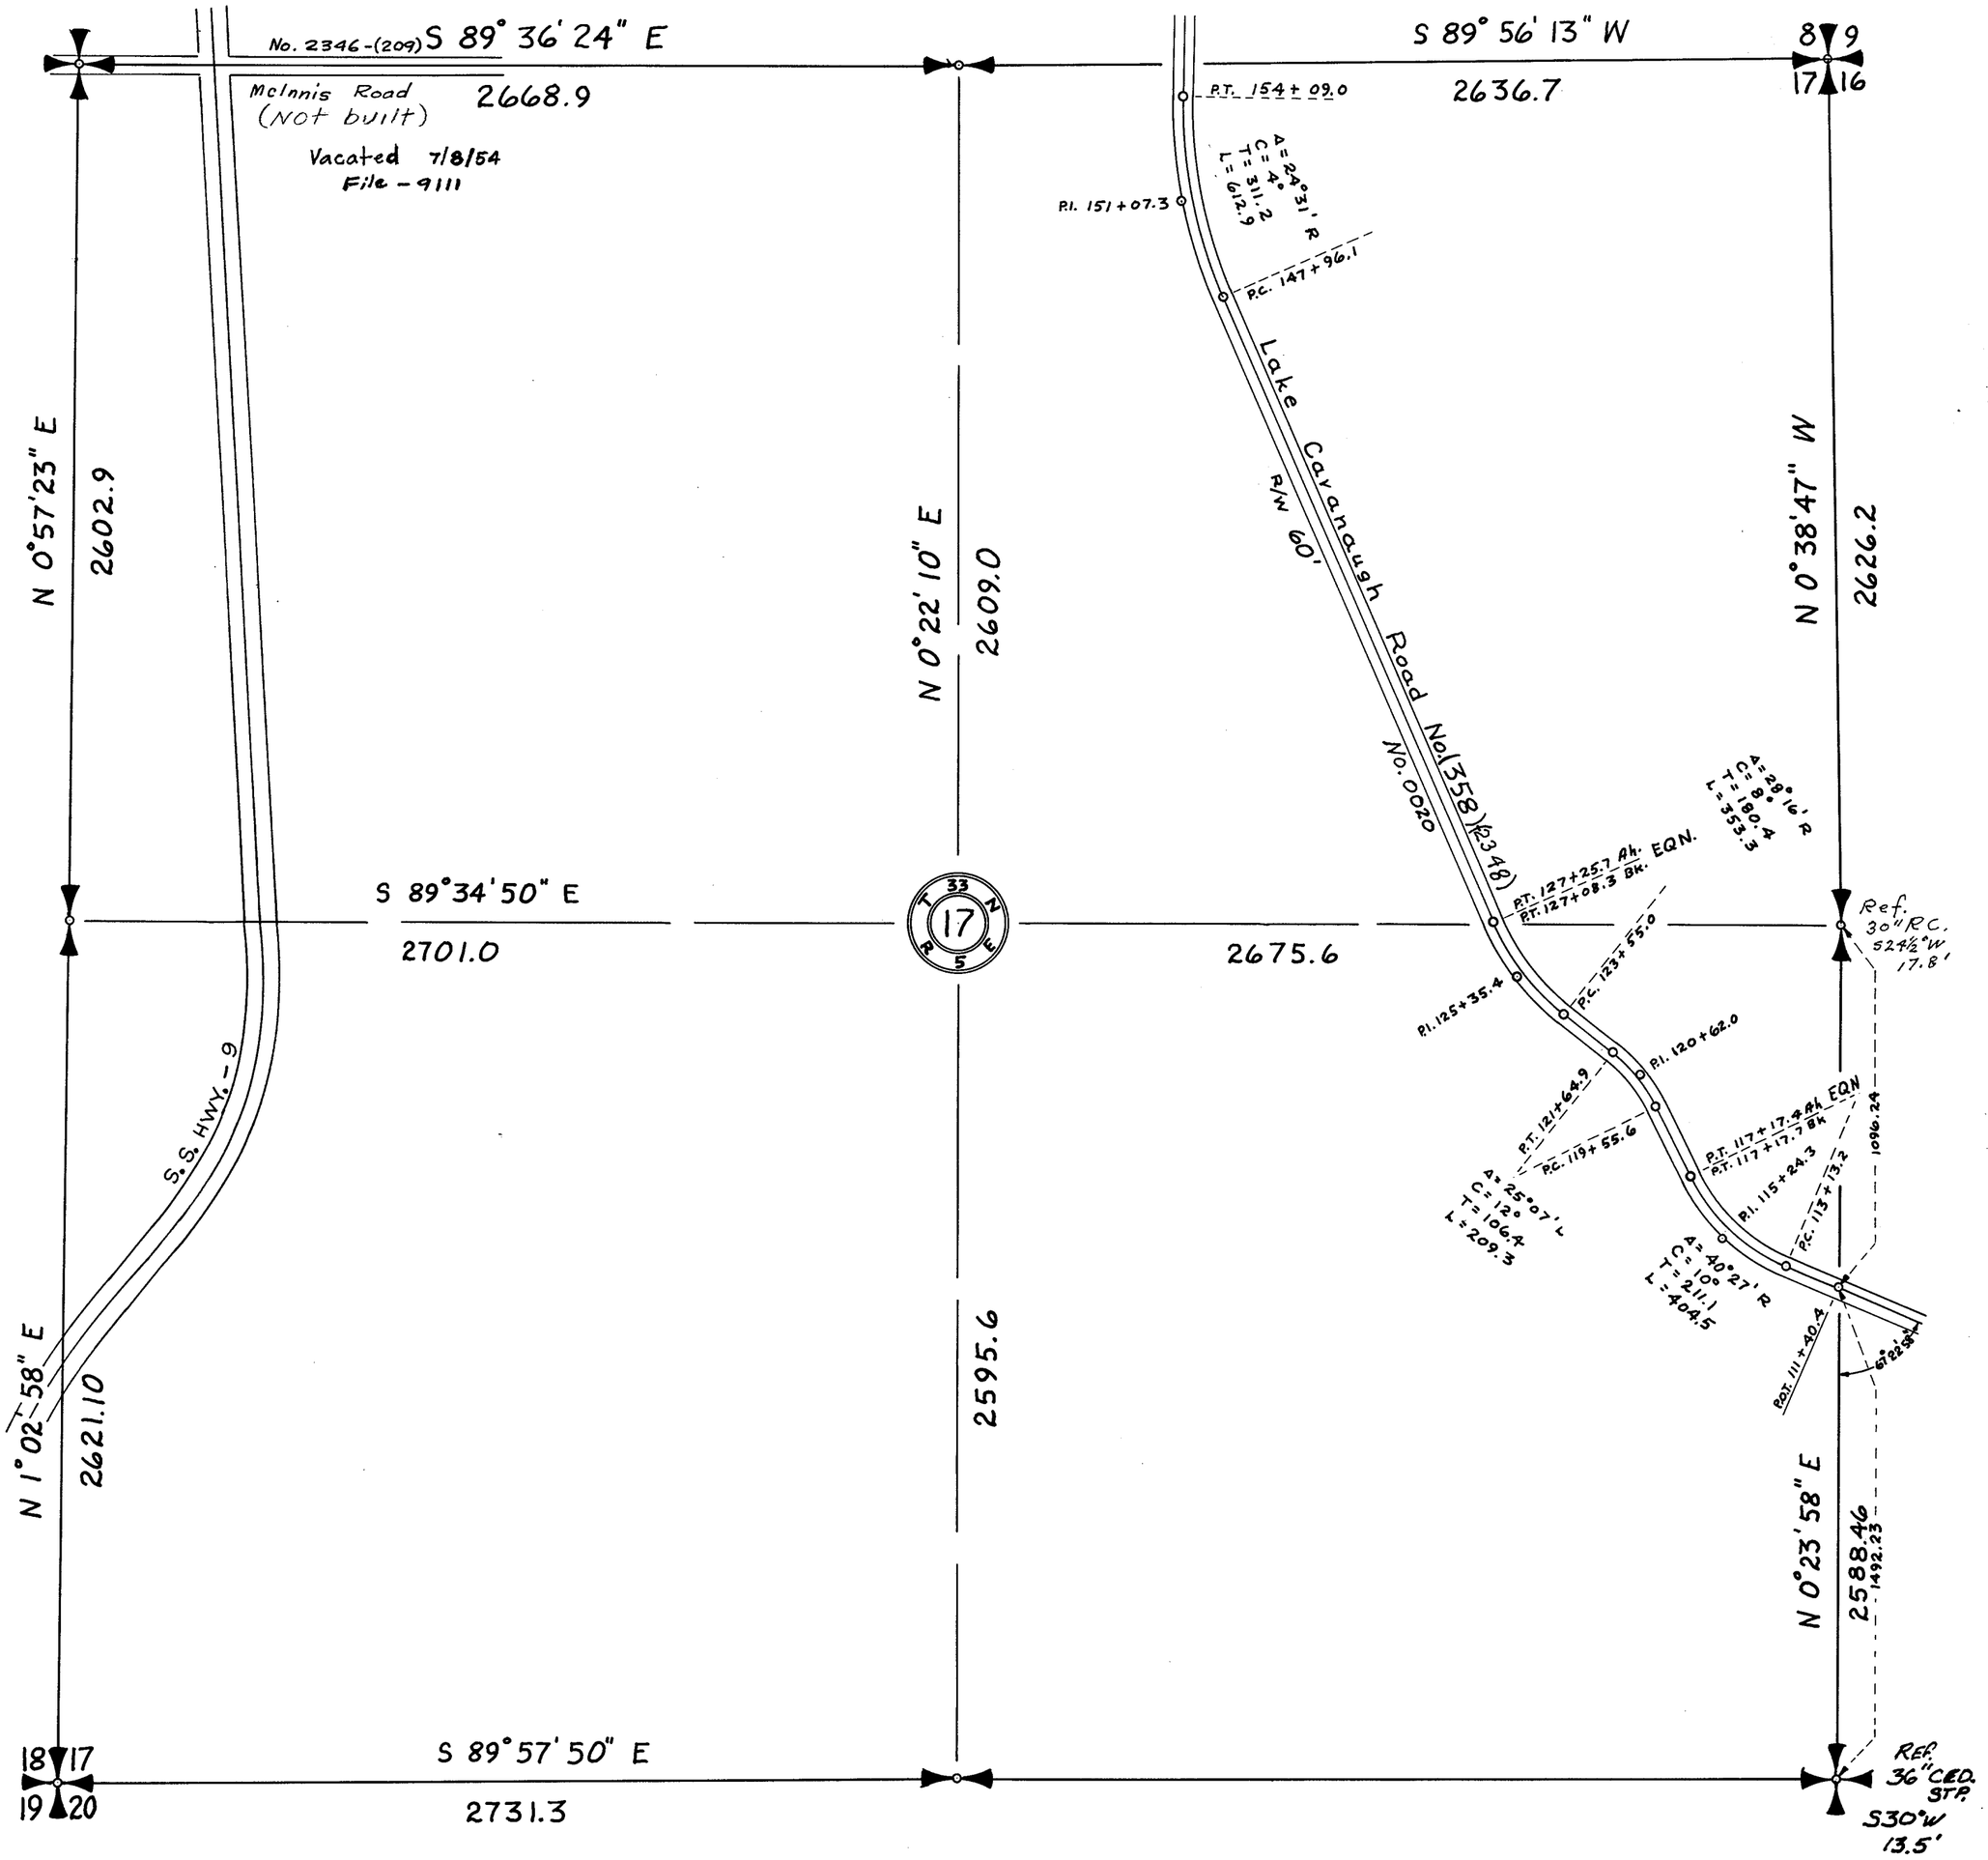


SECTION 18

TOWNSHIP 33 NORTH, RANGE 5 EAST, W. M.
SKAGIT COUNTY, WASH.

SCALE, 1 INCH–400 FEET

A. L. STRONG COUNTY ENGINEER

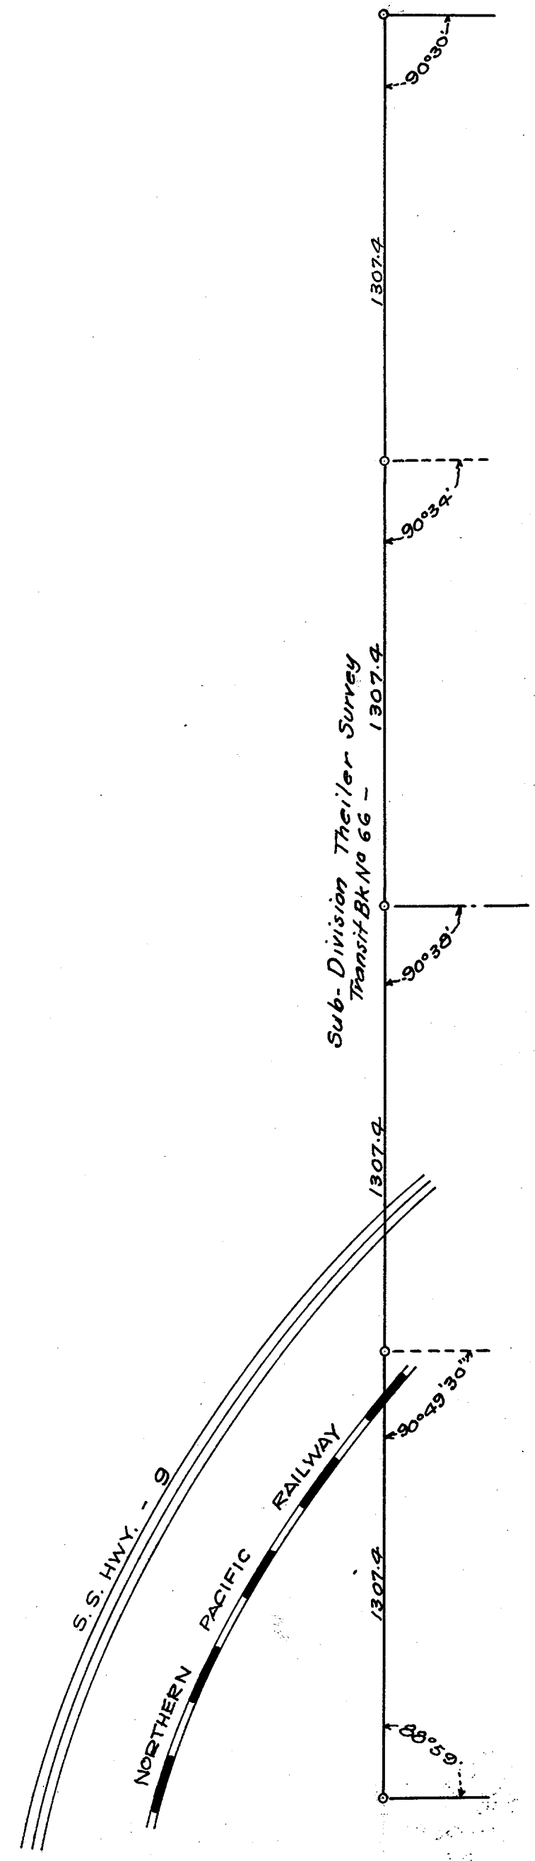

SECTION 19


TOWNSHIP 33 NORTH, RANGE 5 EAST, W. M.

SKAGIT COUNTY, WASH.

SCALE, 1 INCH–400 FEET

A. L. STRONG

COUNTY ENGINEER

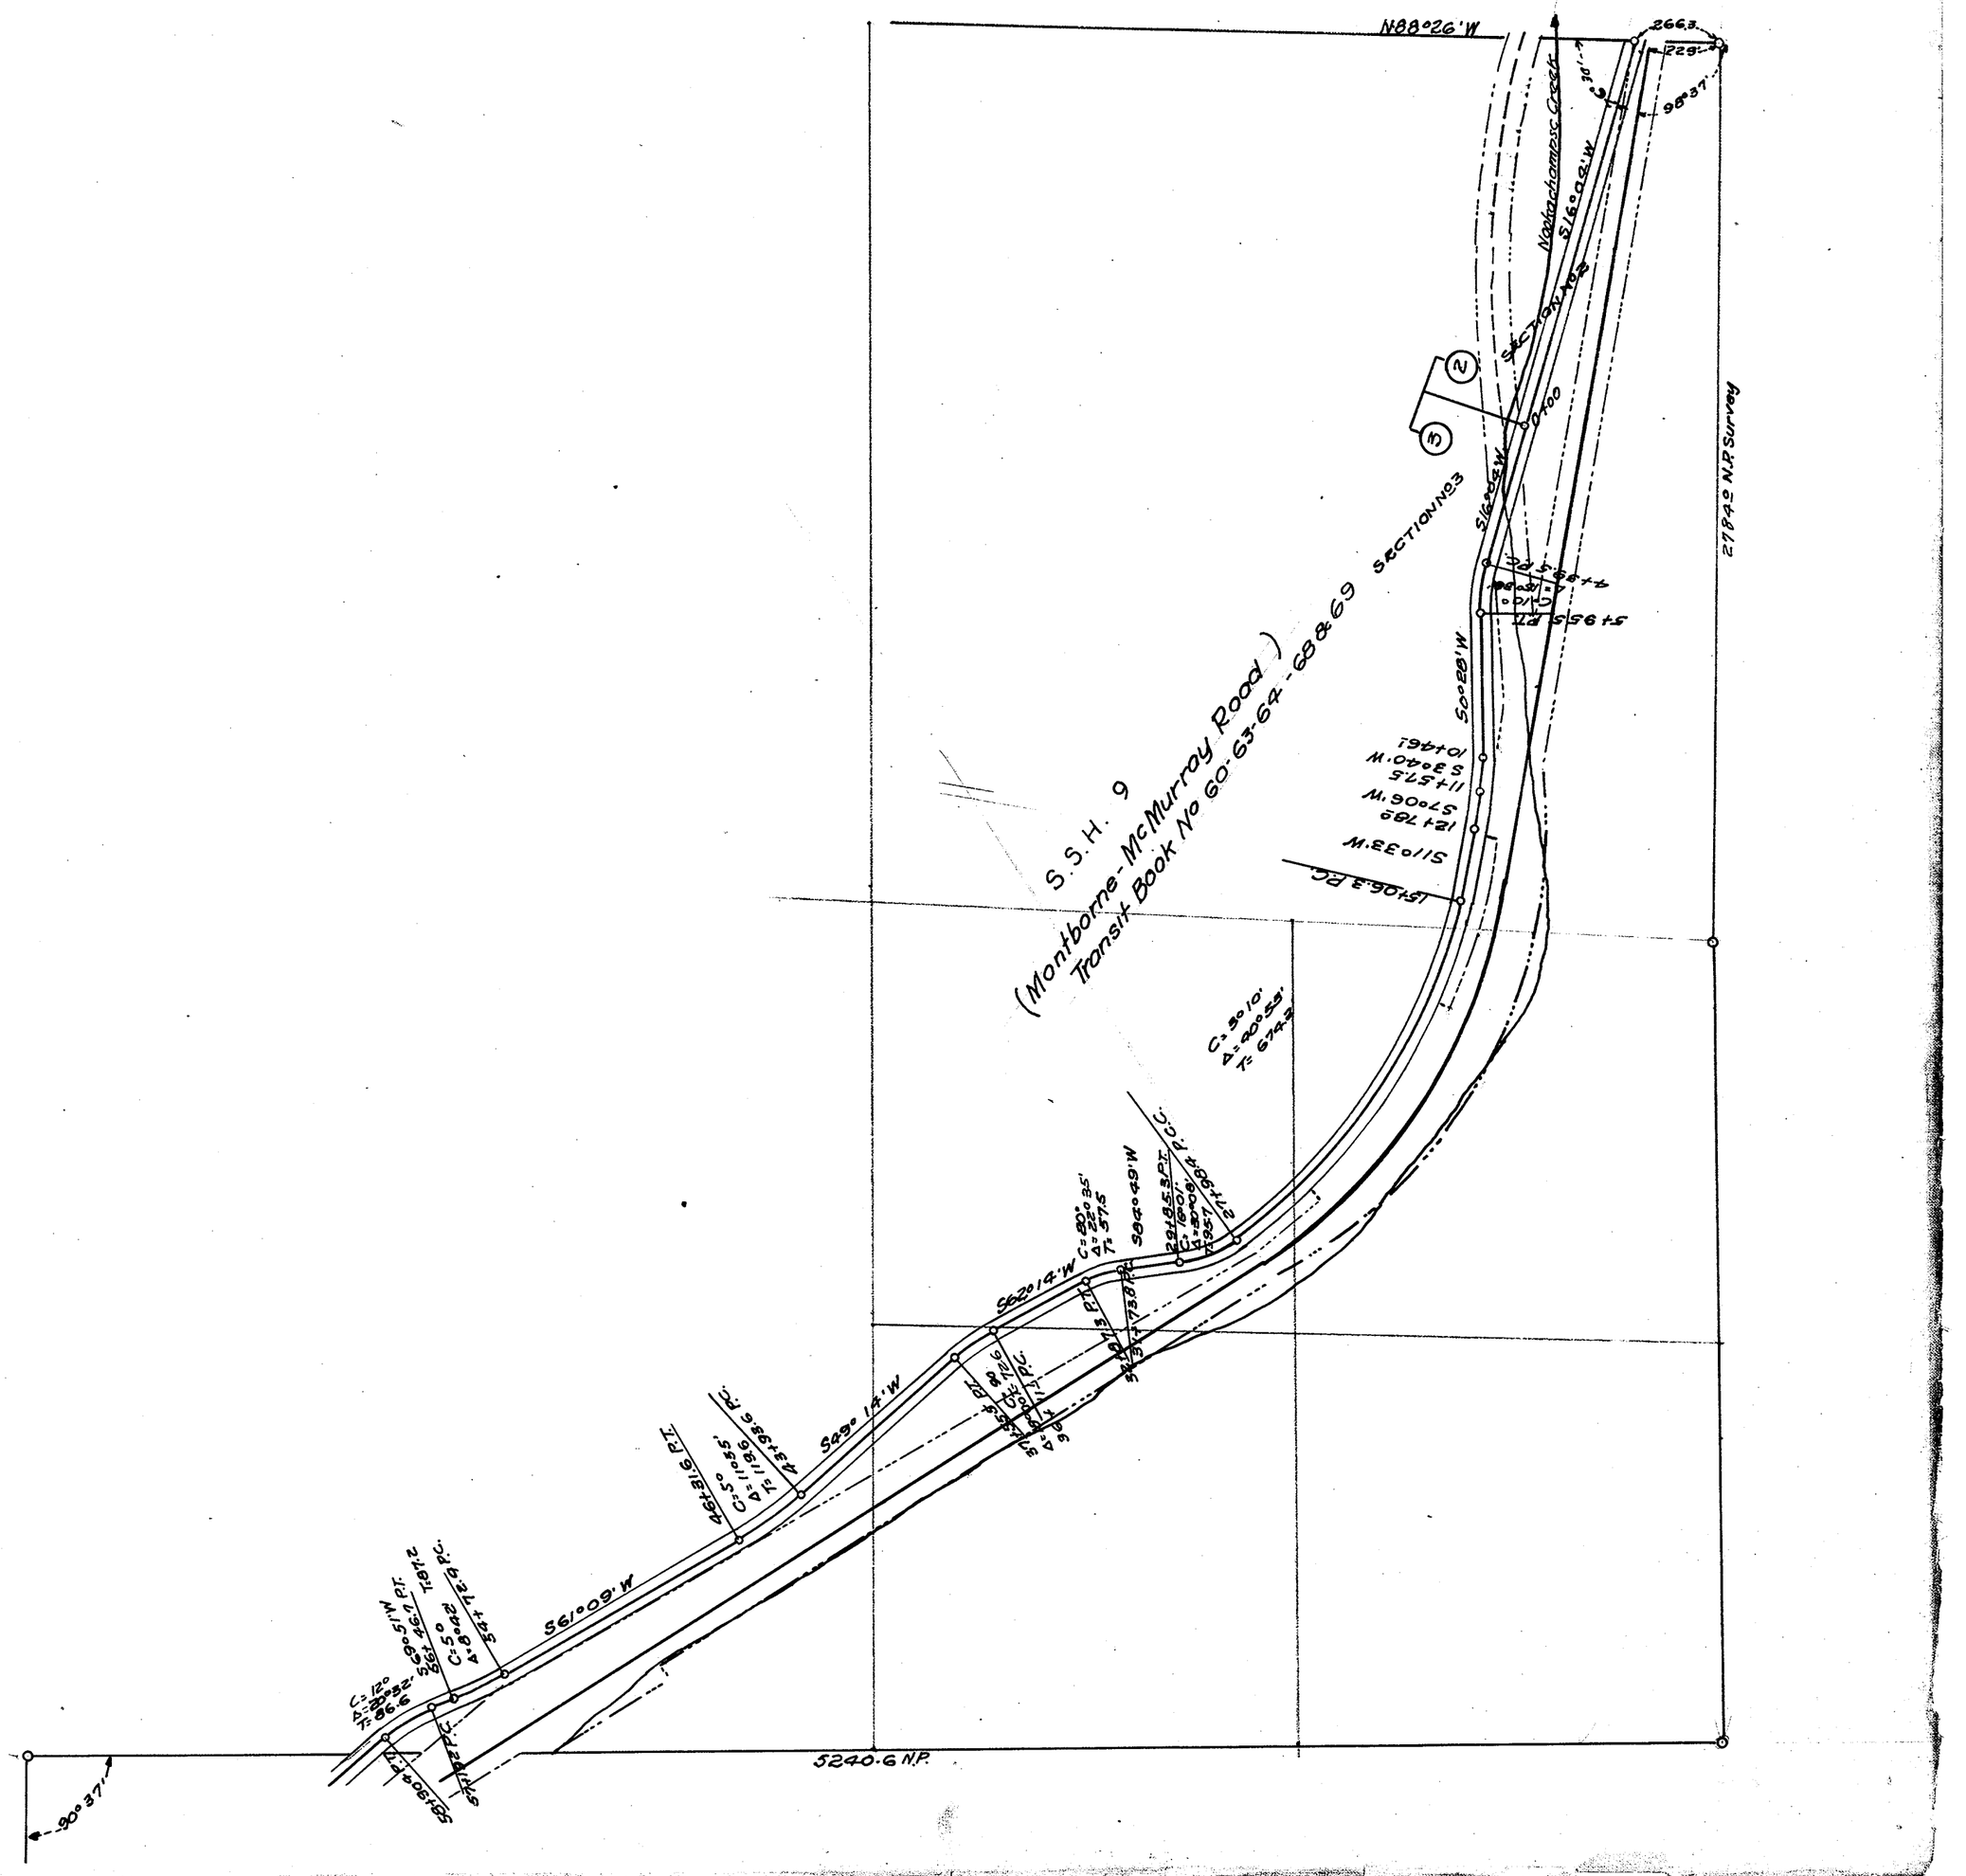


SECTION 21

TOWNSHIP 33 NORTH, RANGE 5 EAST, W. M.

SKAGIT COUNTY, WASH.

SCALE, 1 INCH--400 FEET
Road No. 358 Drawn From Notes 38/363
Road No. 116 Drawn From Bk. 31, P. 53

DATE December, 1959 Frank Gilkey COUNTY ENGINEER

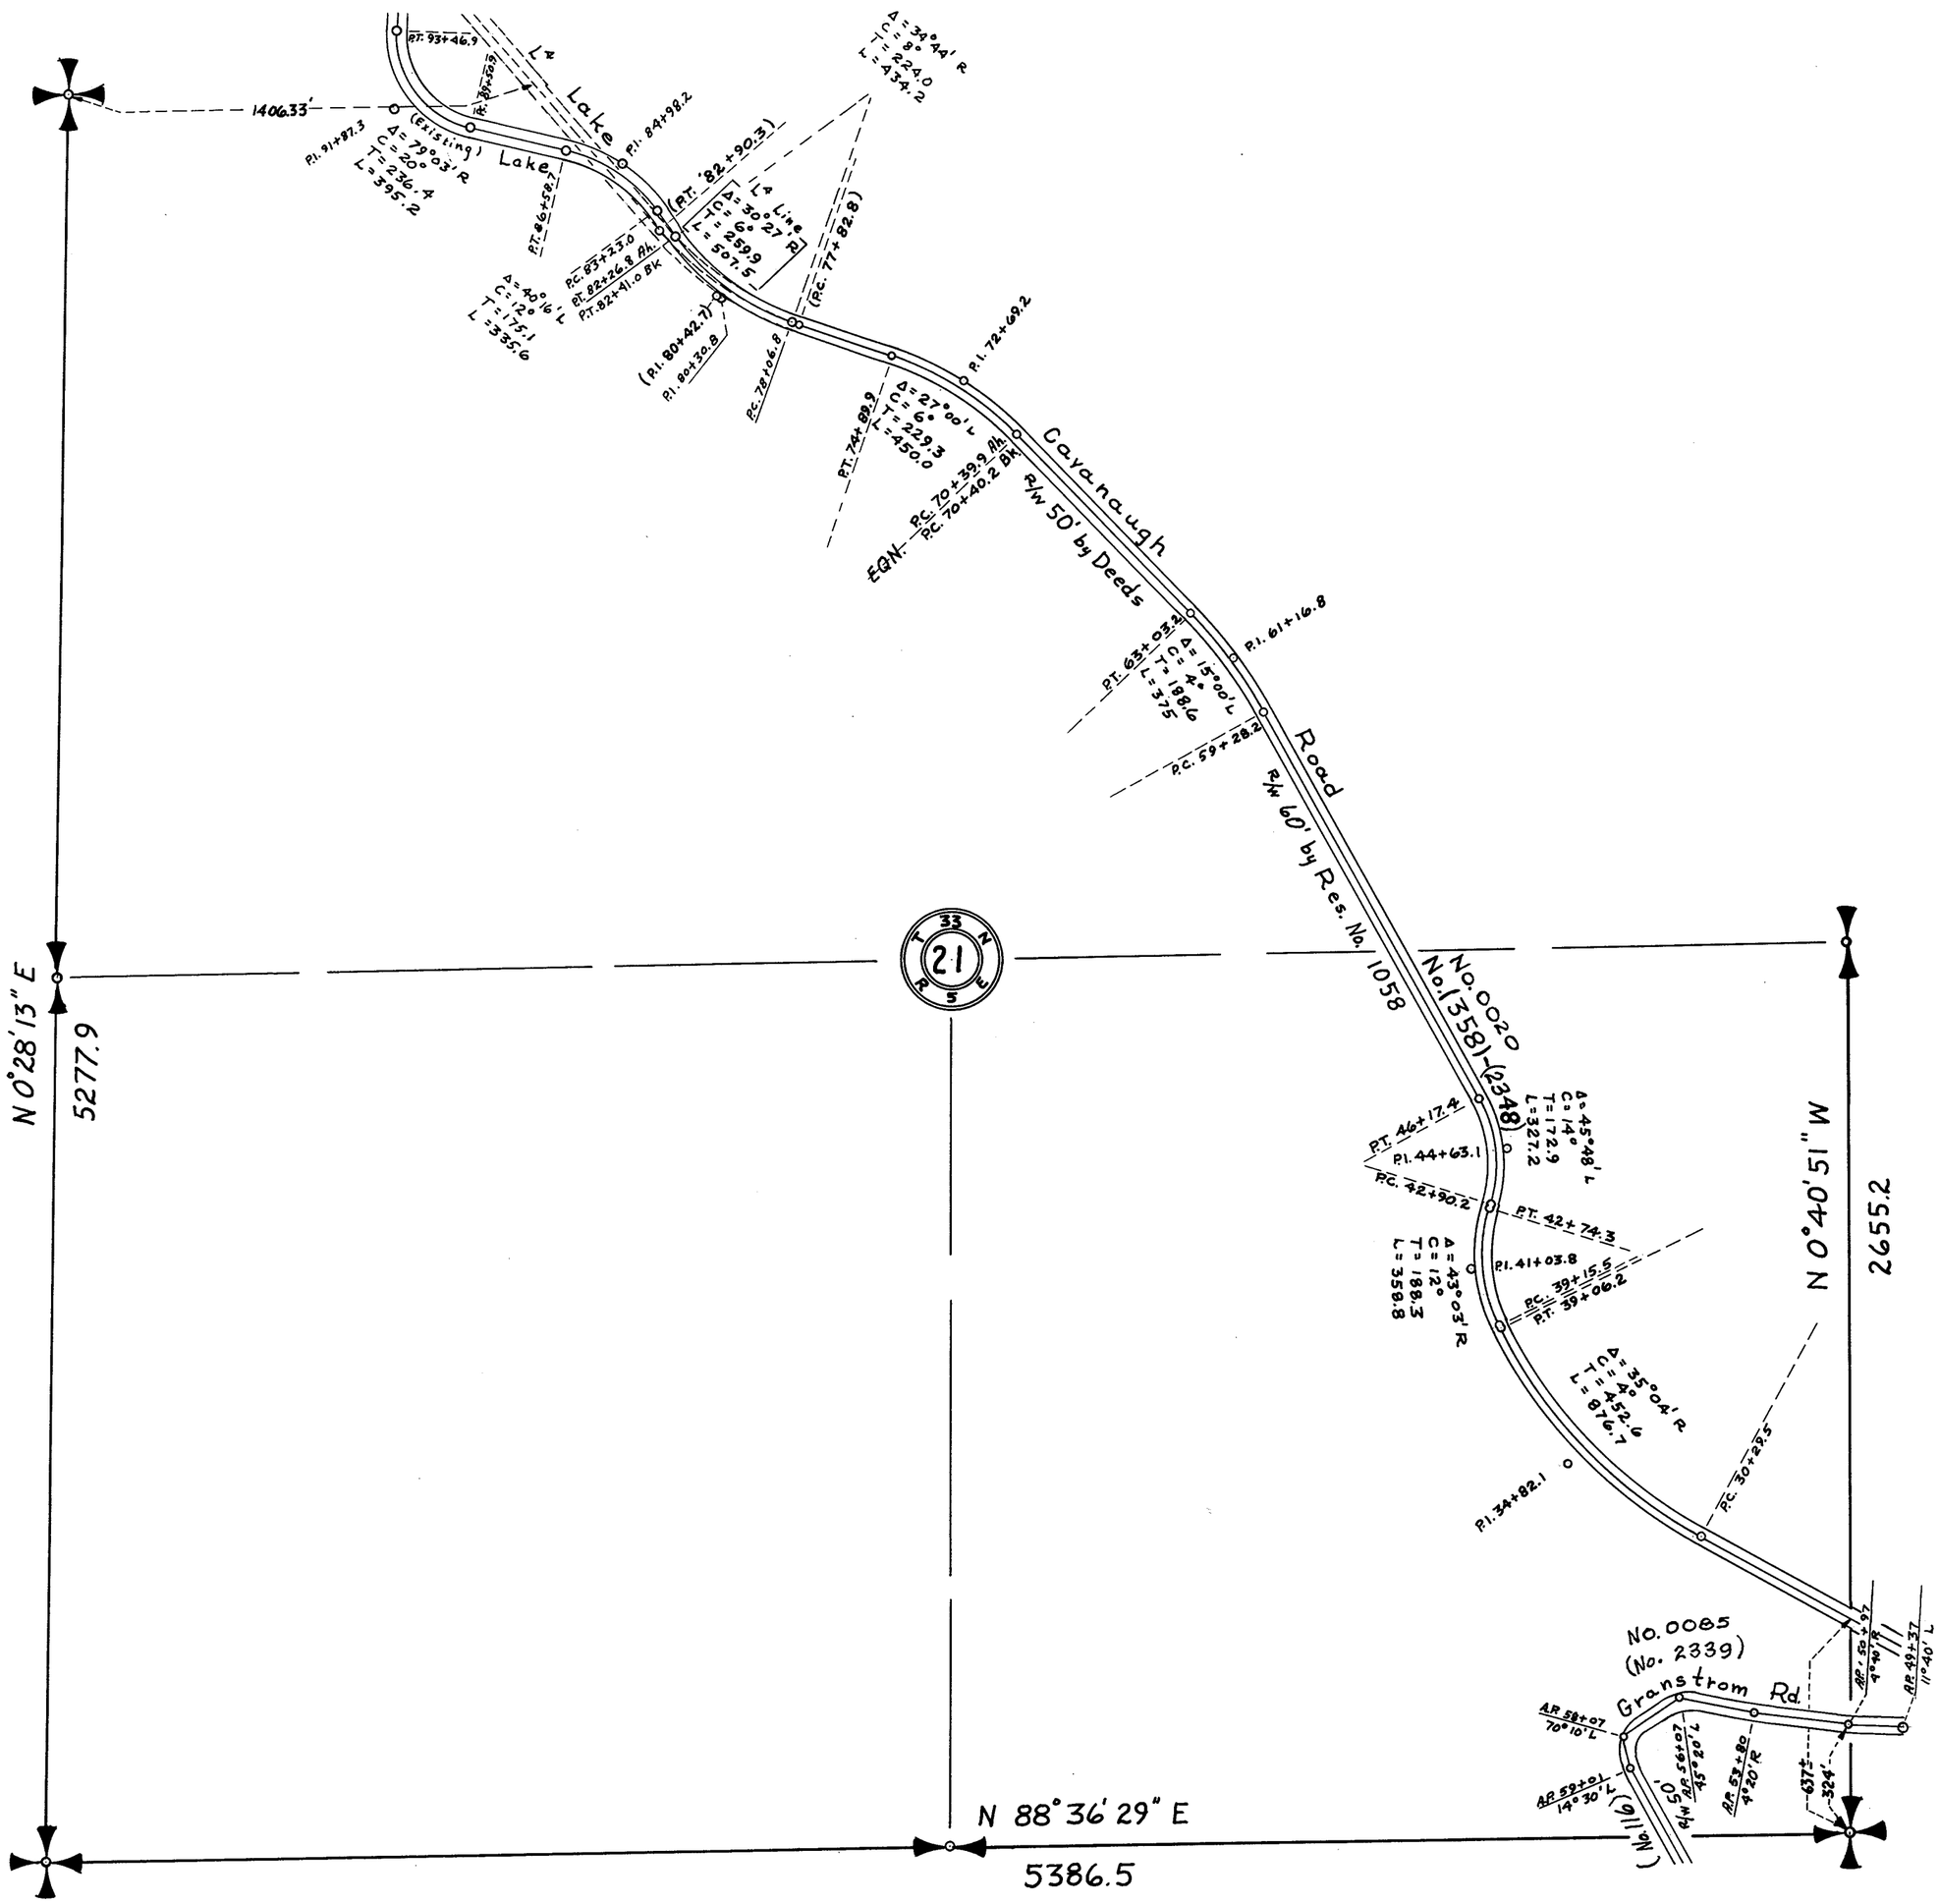


SECTION 22

TOWNSHIP 33 NORTH, RANGE 5 EAST, W. M.

SKAGIT COUNTY, WASH.

DATE December, 1959 Frank Gilkey COUNTY ENGINEER

SCALE, 1 INCH--400 FEET
Road No. 358 From 0+00.9 to P.C. 30+29.5 From Notes 38/363
Road No. 358 From 0+00 to A.P. 39+11.3 From Notes 36/307
Road No. 116 Drawn From Bk. 31, P. 52 & 53

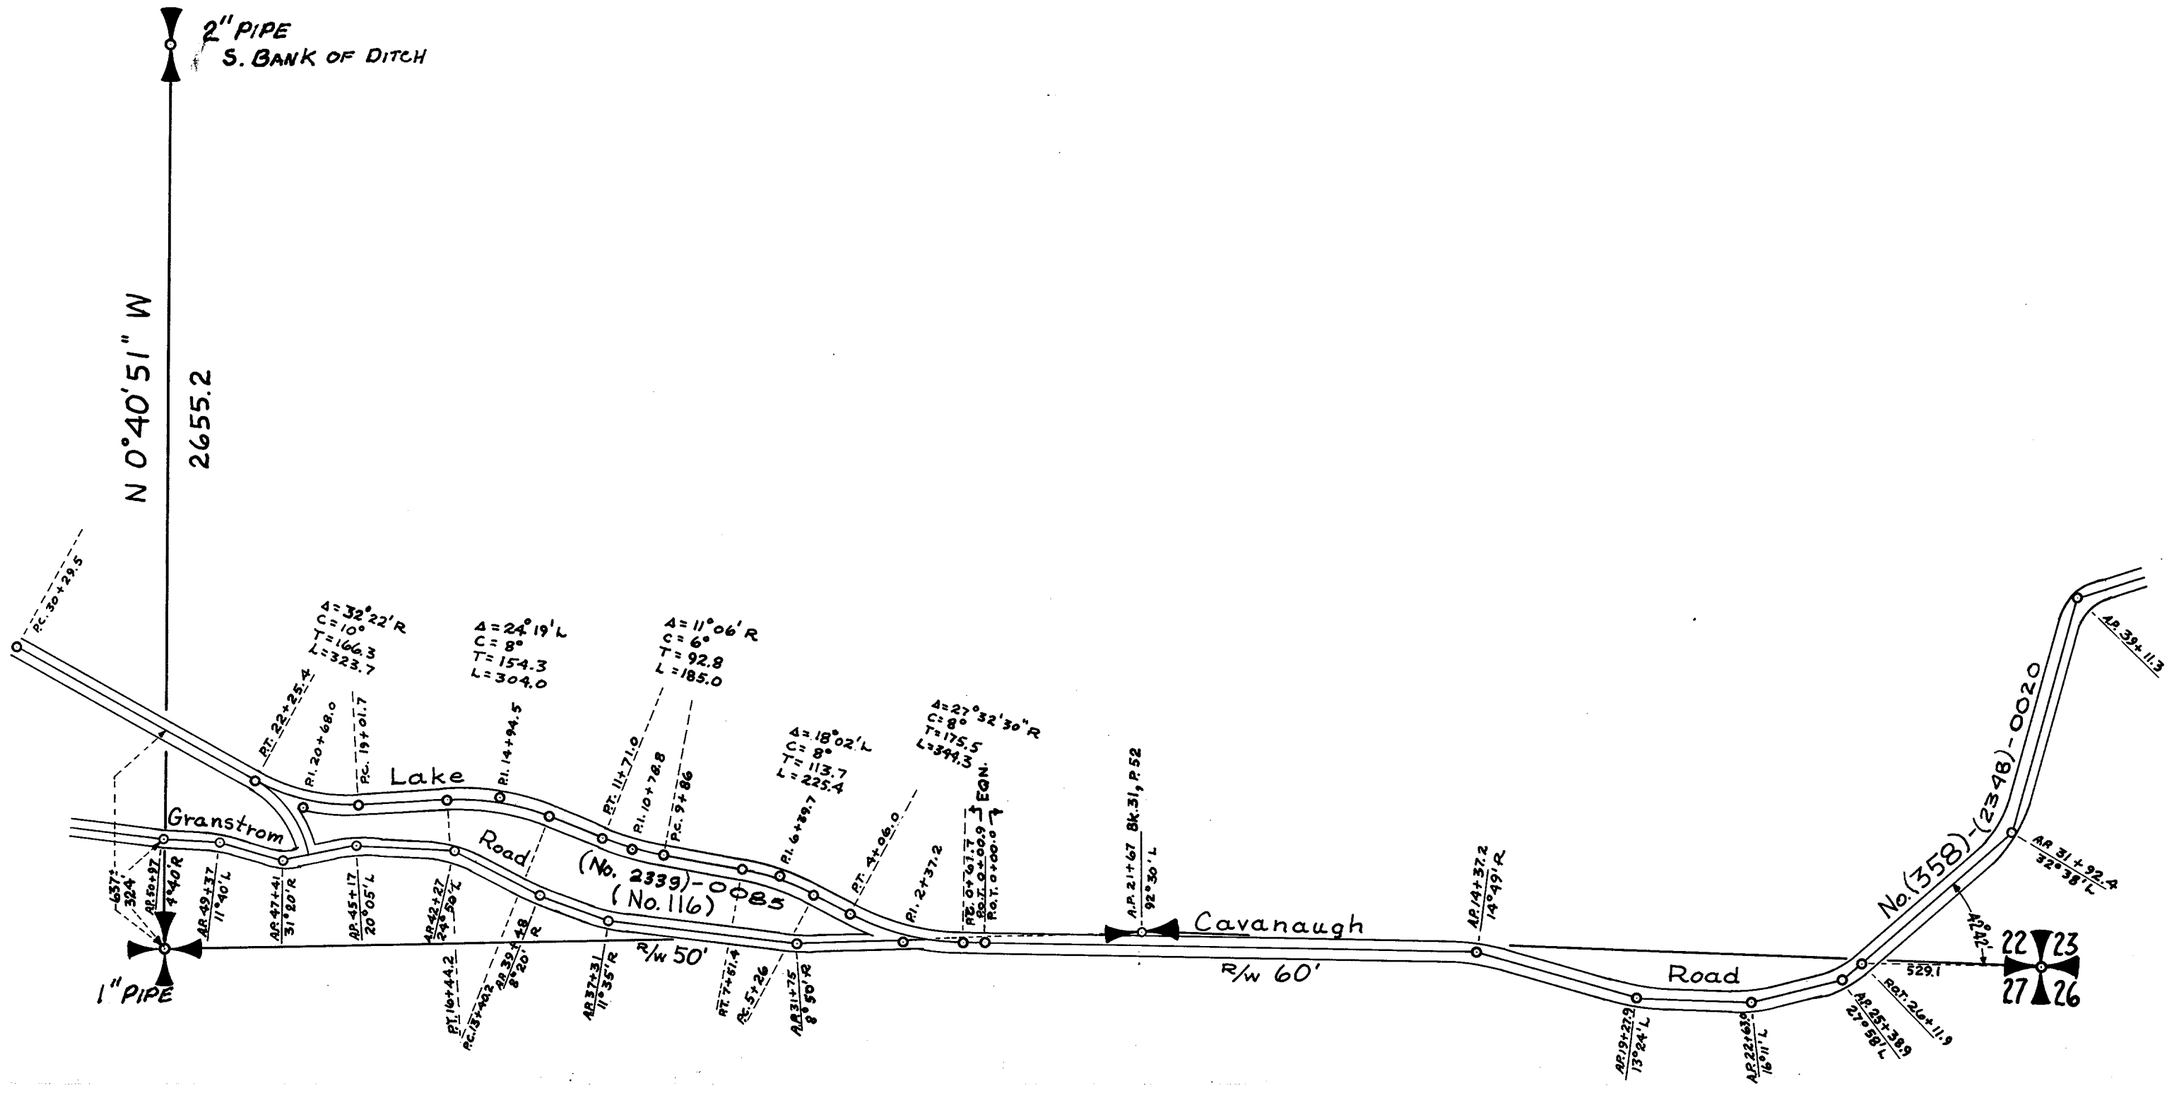


SECTION 22 & 27

TOWNSHIP 33 NORTH, RANGE 5 EAST, W. M.

SKAGIT COUNTY, WASH.

SCALE, 1 INCH--400 FEET


H.O. Walberg. COUNTY ENGINEER

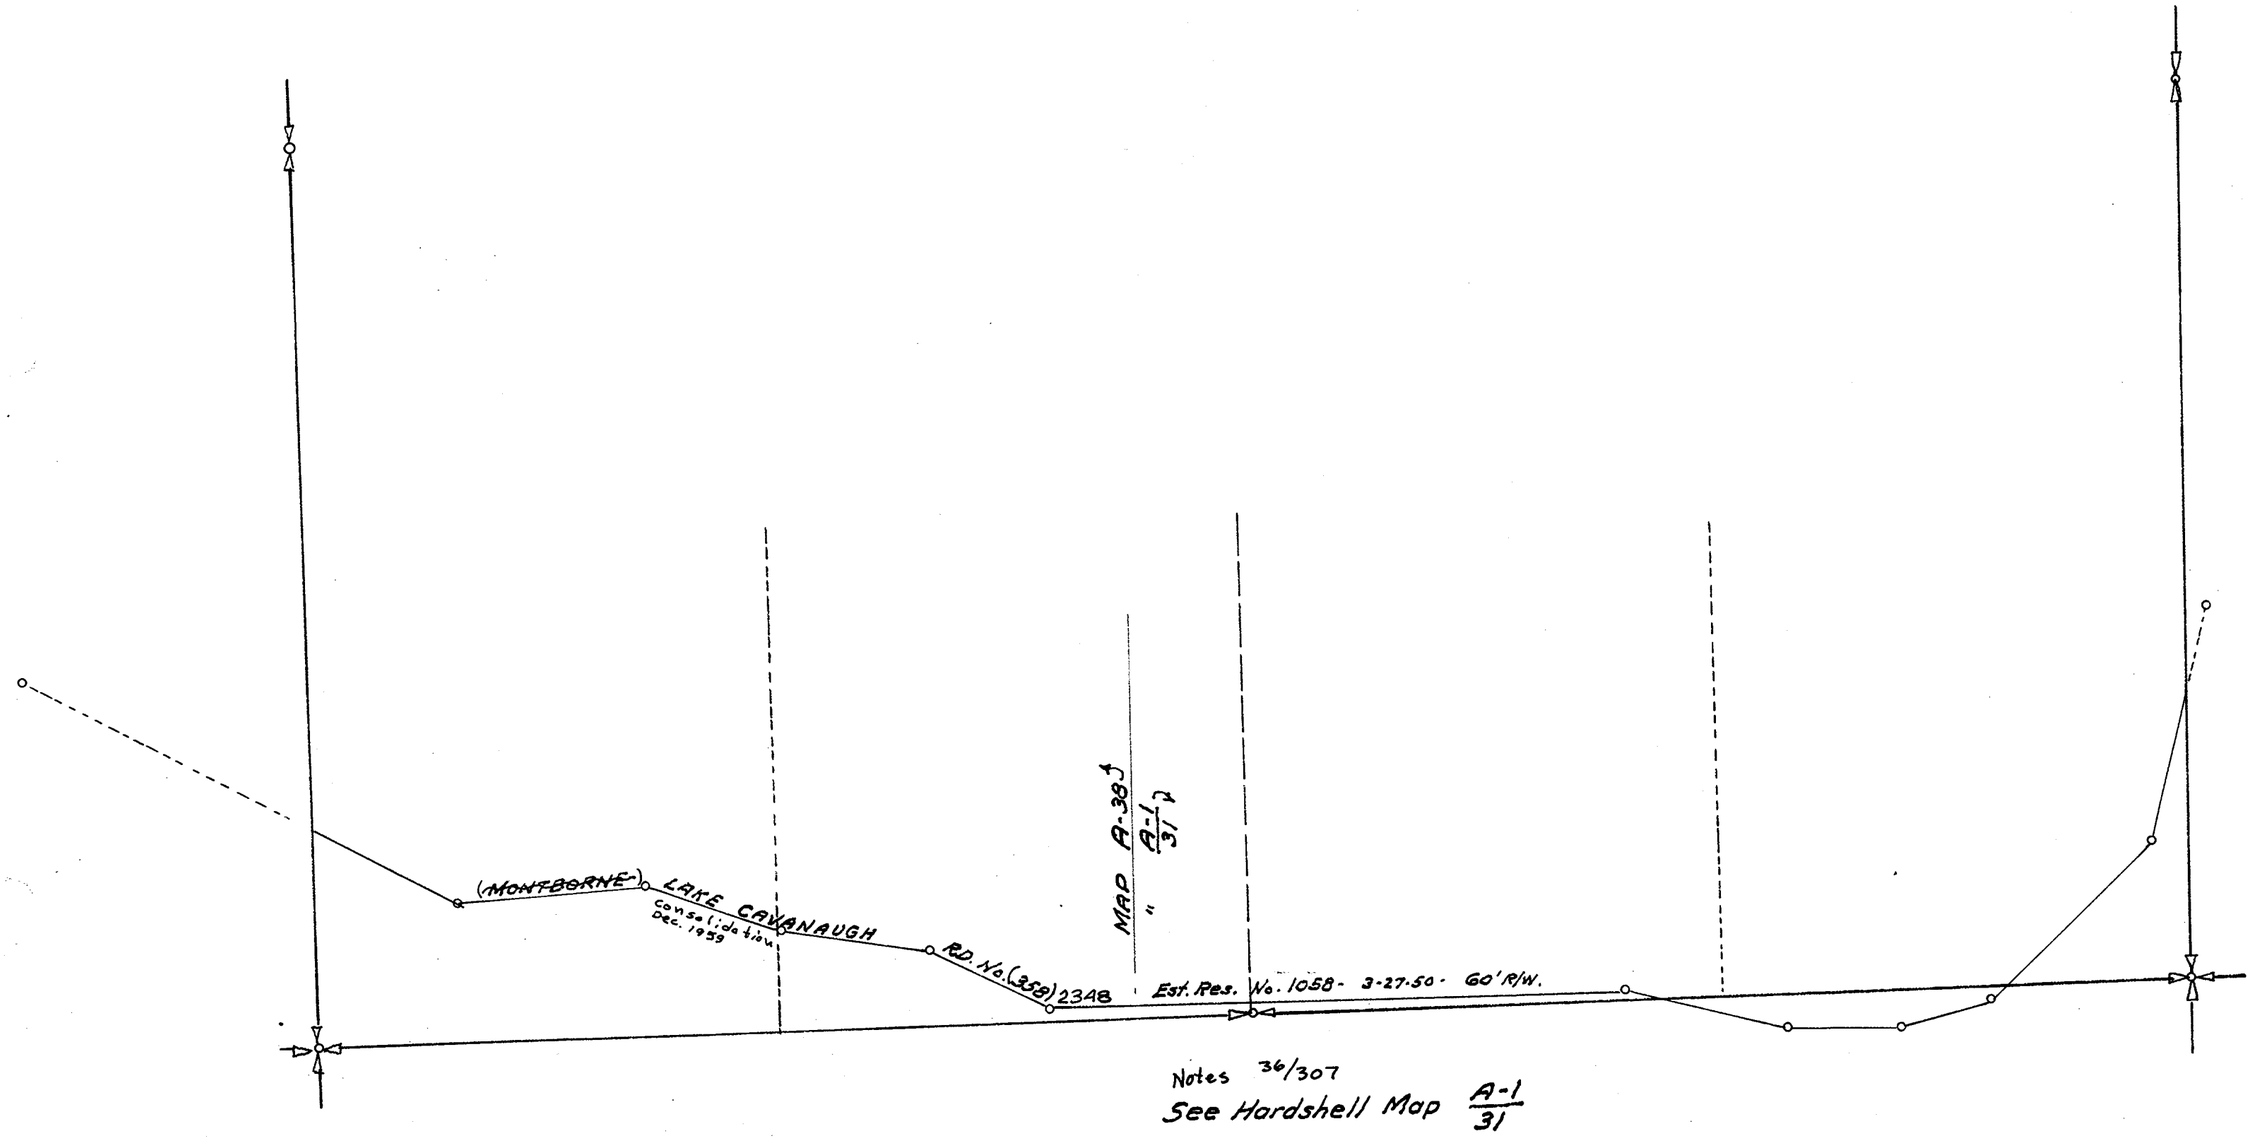

Notes 36/307

See Hardshell Map A-1/31

SEC. 23-33-5

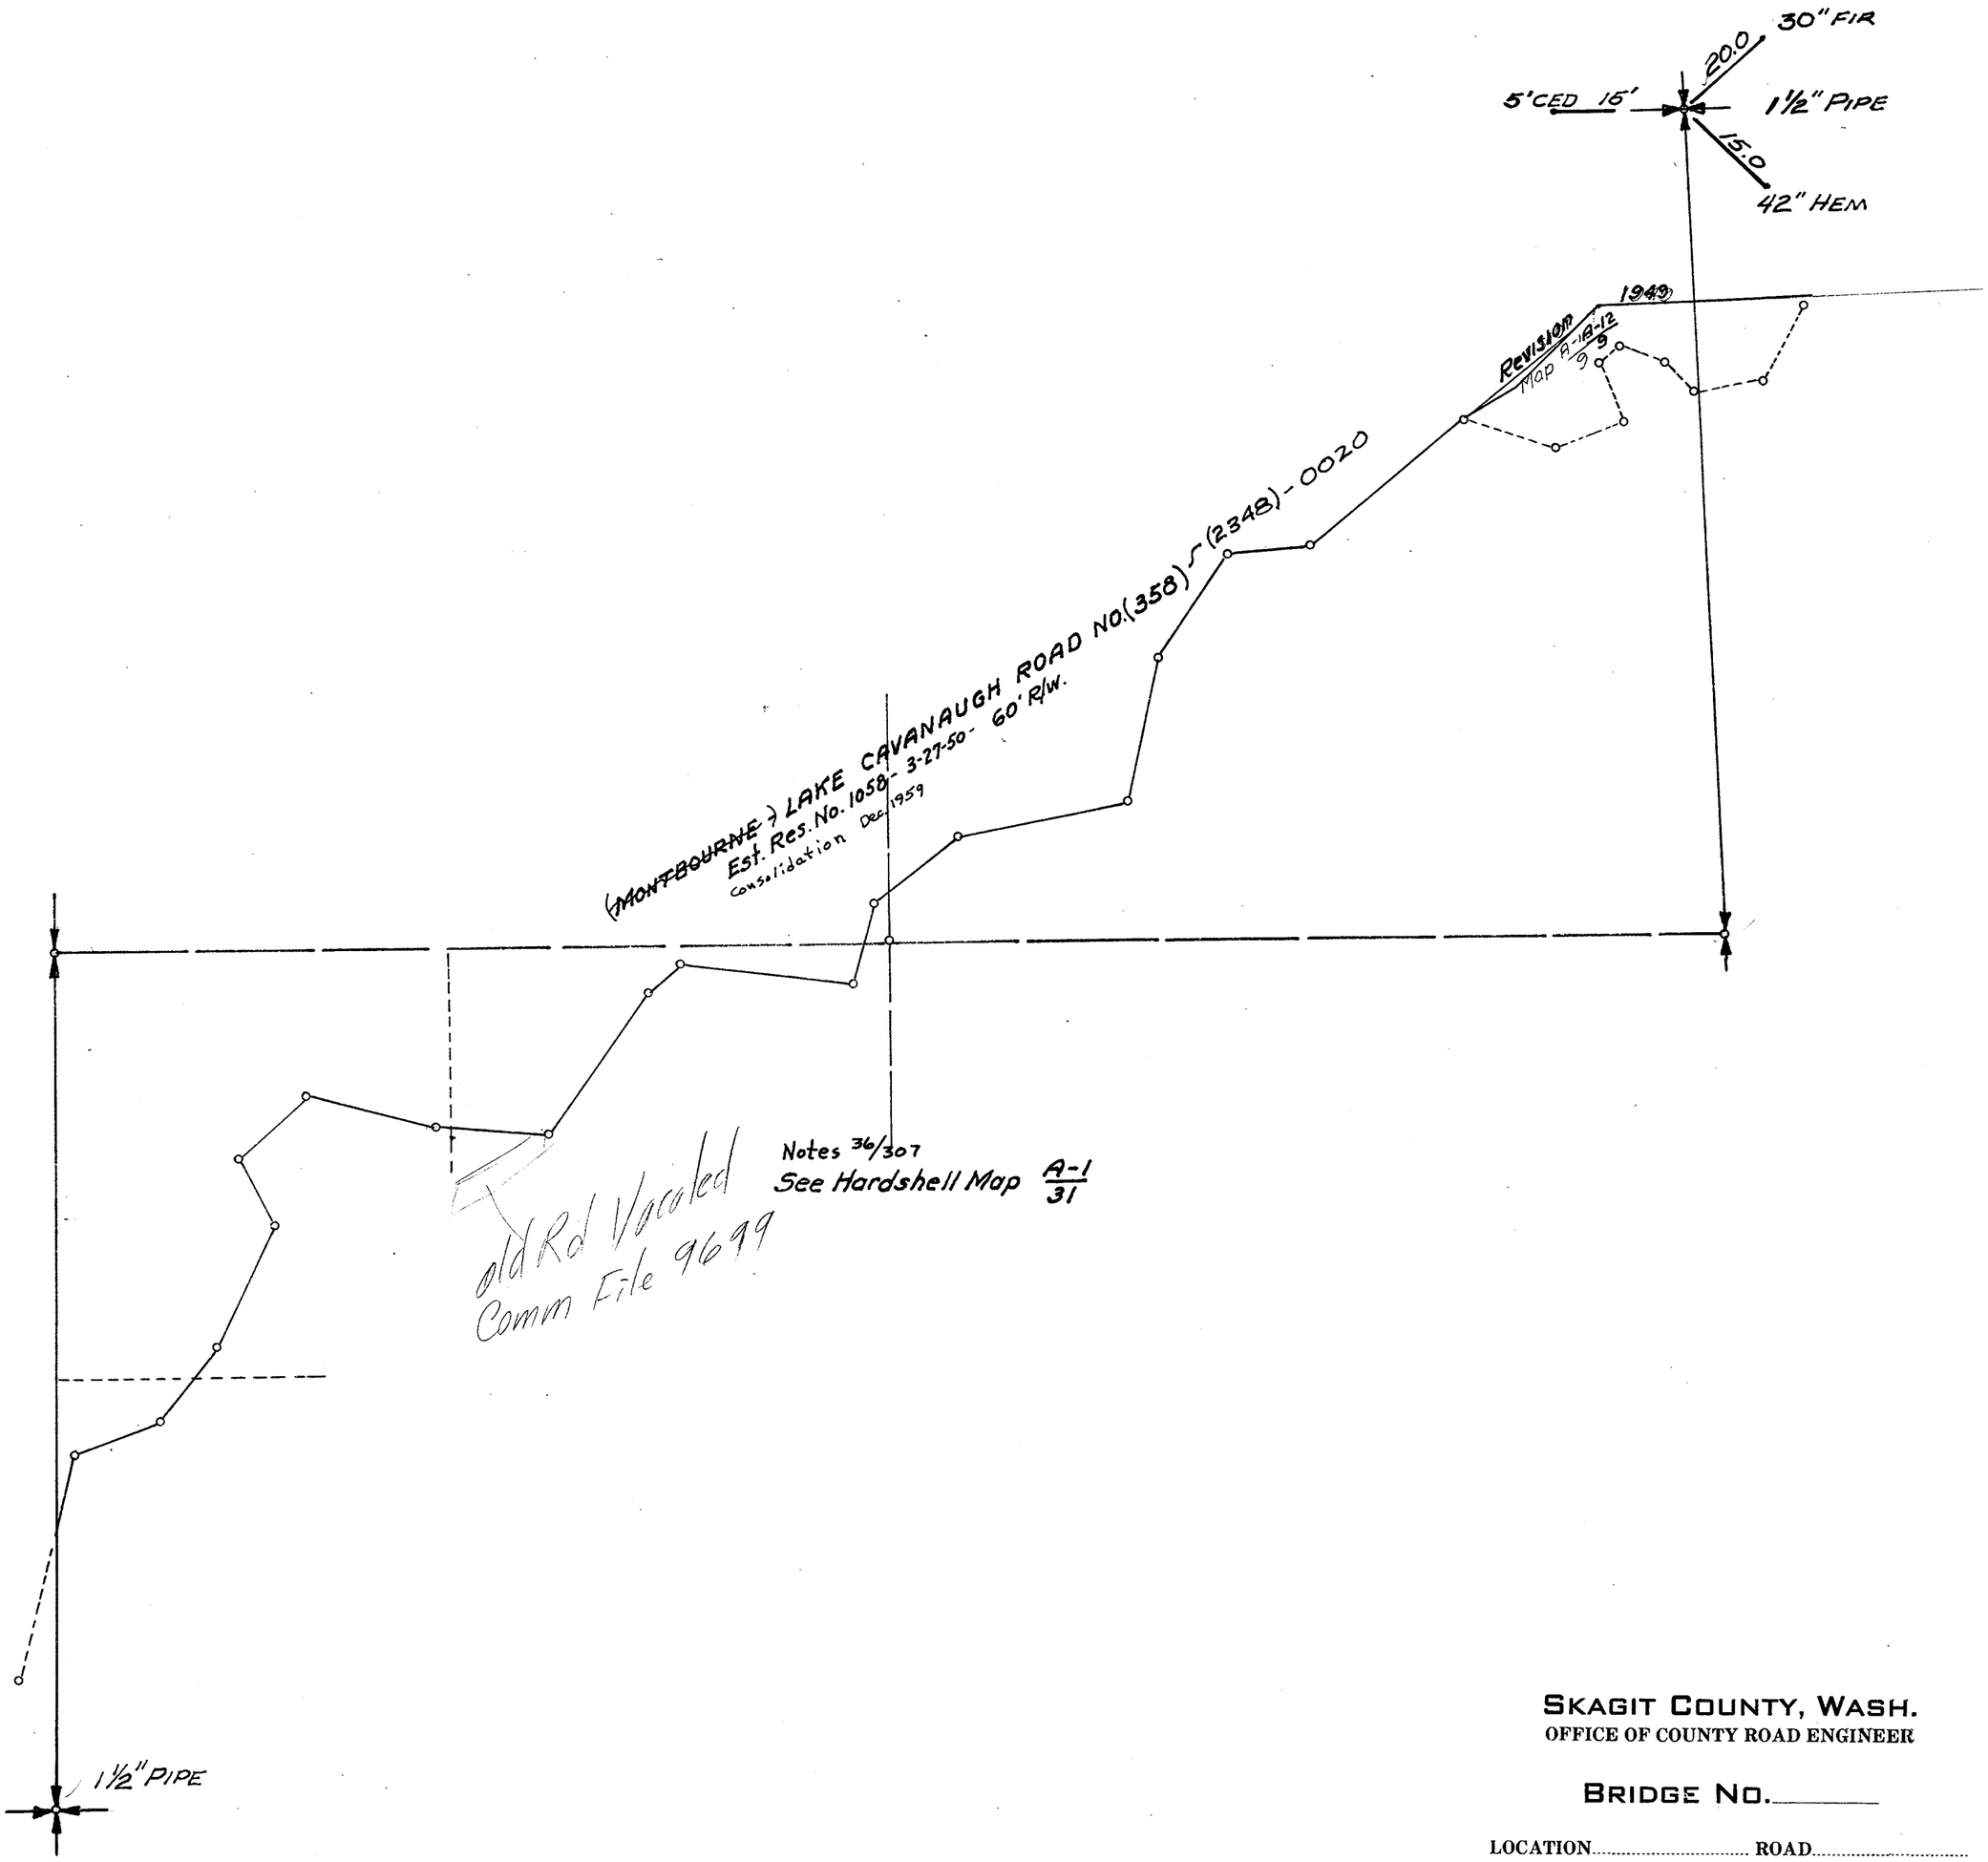

SKAGIT COUNTY, WASH.
OFFICE OF COUNTY ROAD ENGINEER

BRIDGE NO._____

LOCATION..... ROAD.....

JOB NO._____


DATE.....

.....
County Road Engineer

APPROVED..... 194....

.....
Chairman-Board of County Commissioneers

SEC. 24-33-5

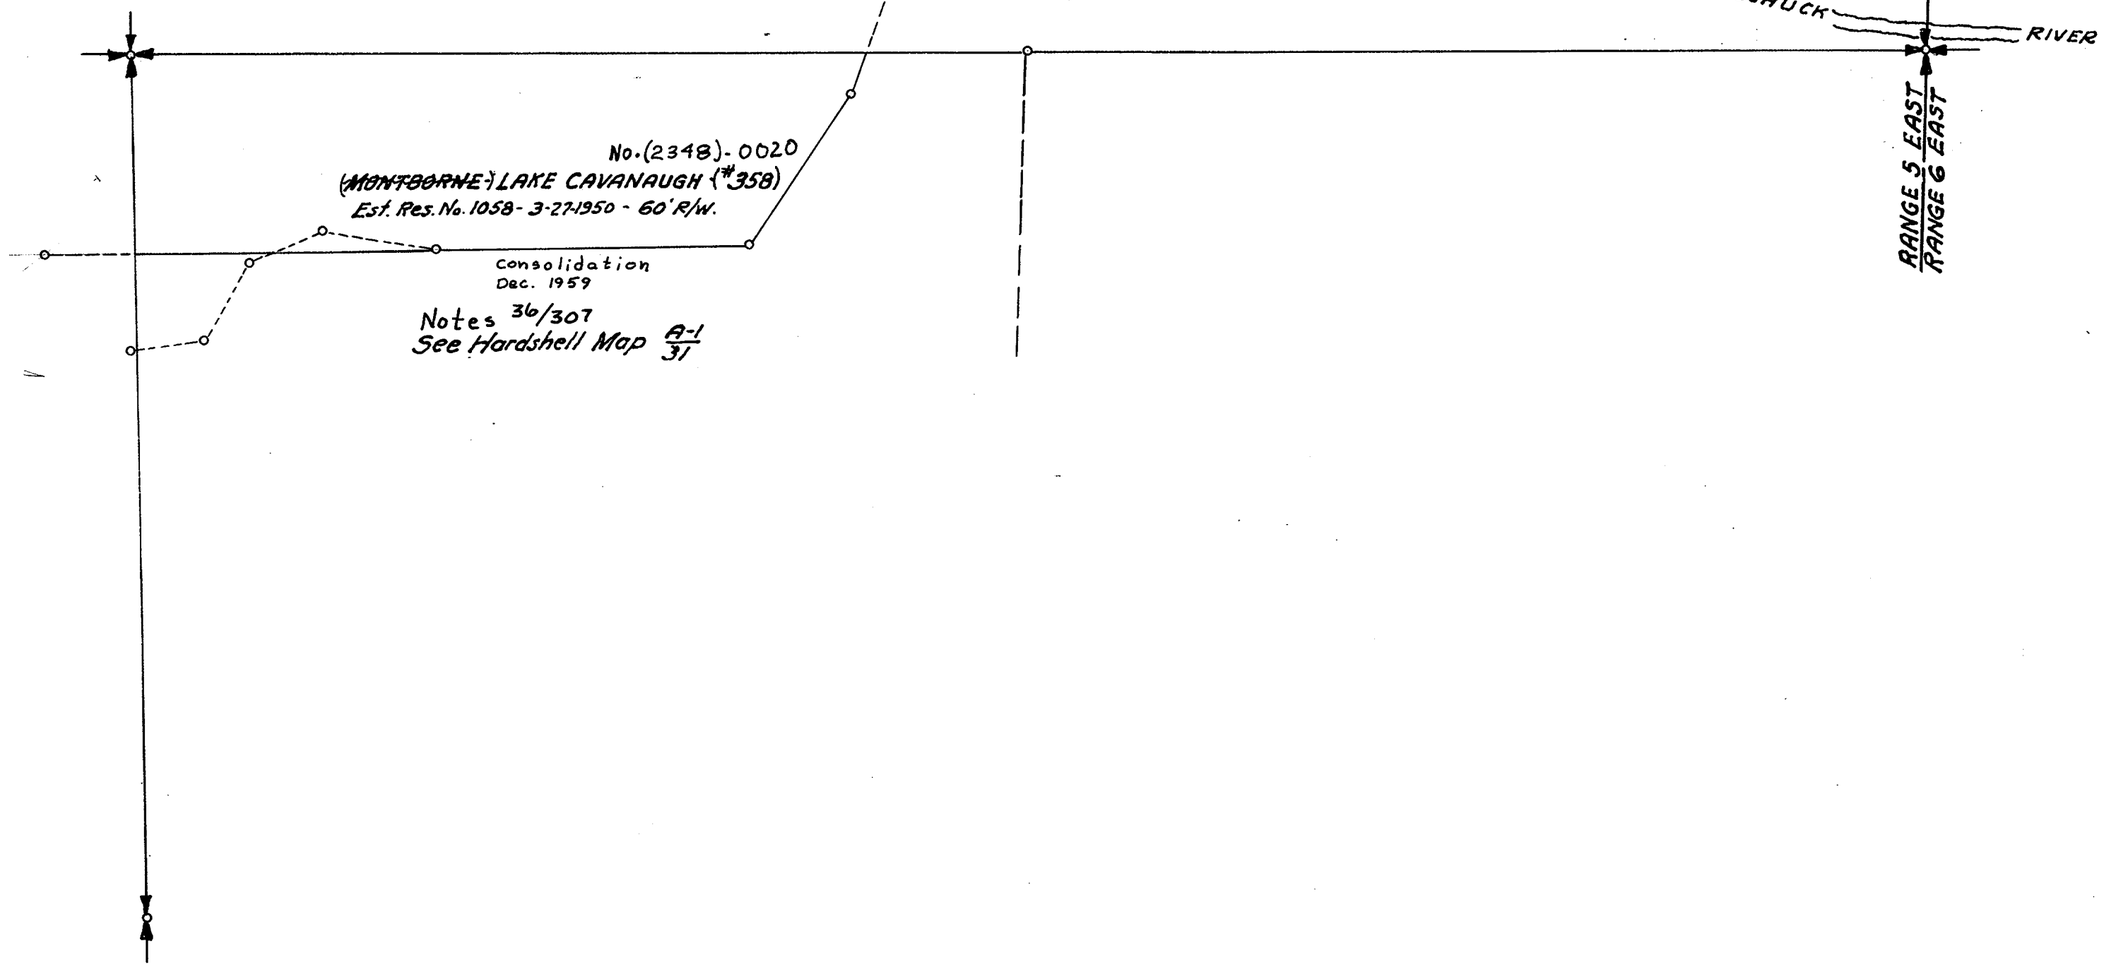

SKAGIT COUNTY, WASH.
OFFICE OF COUNTY ROAD ENGINEER

BRIDGE NO._____

LOCATION..... ROAD.....

JOB NO._____

DATE..... .....
County Road Engineer

APPROVED..... 194.....

.....
Chairman-Board of County Commissioners

SECTION 28


TOWNSHIP 33 NORTH, RANGE 5 EAST, W. M.

SKAGIT COUNTY, WASH.

SCALE, 1 INCH--400 FEET
Road No. 116 from A.P. 62+00 to P.T. 123+18.9 Drawn From Notes D-81
Road No. 116 from A.P. 59+01 to A.P. 69+73 Drawn From Bk. 31, P. 53

DATE November, 1959

Frank Gilkey COUNTY ENGINEER

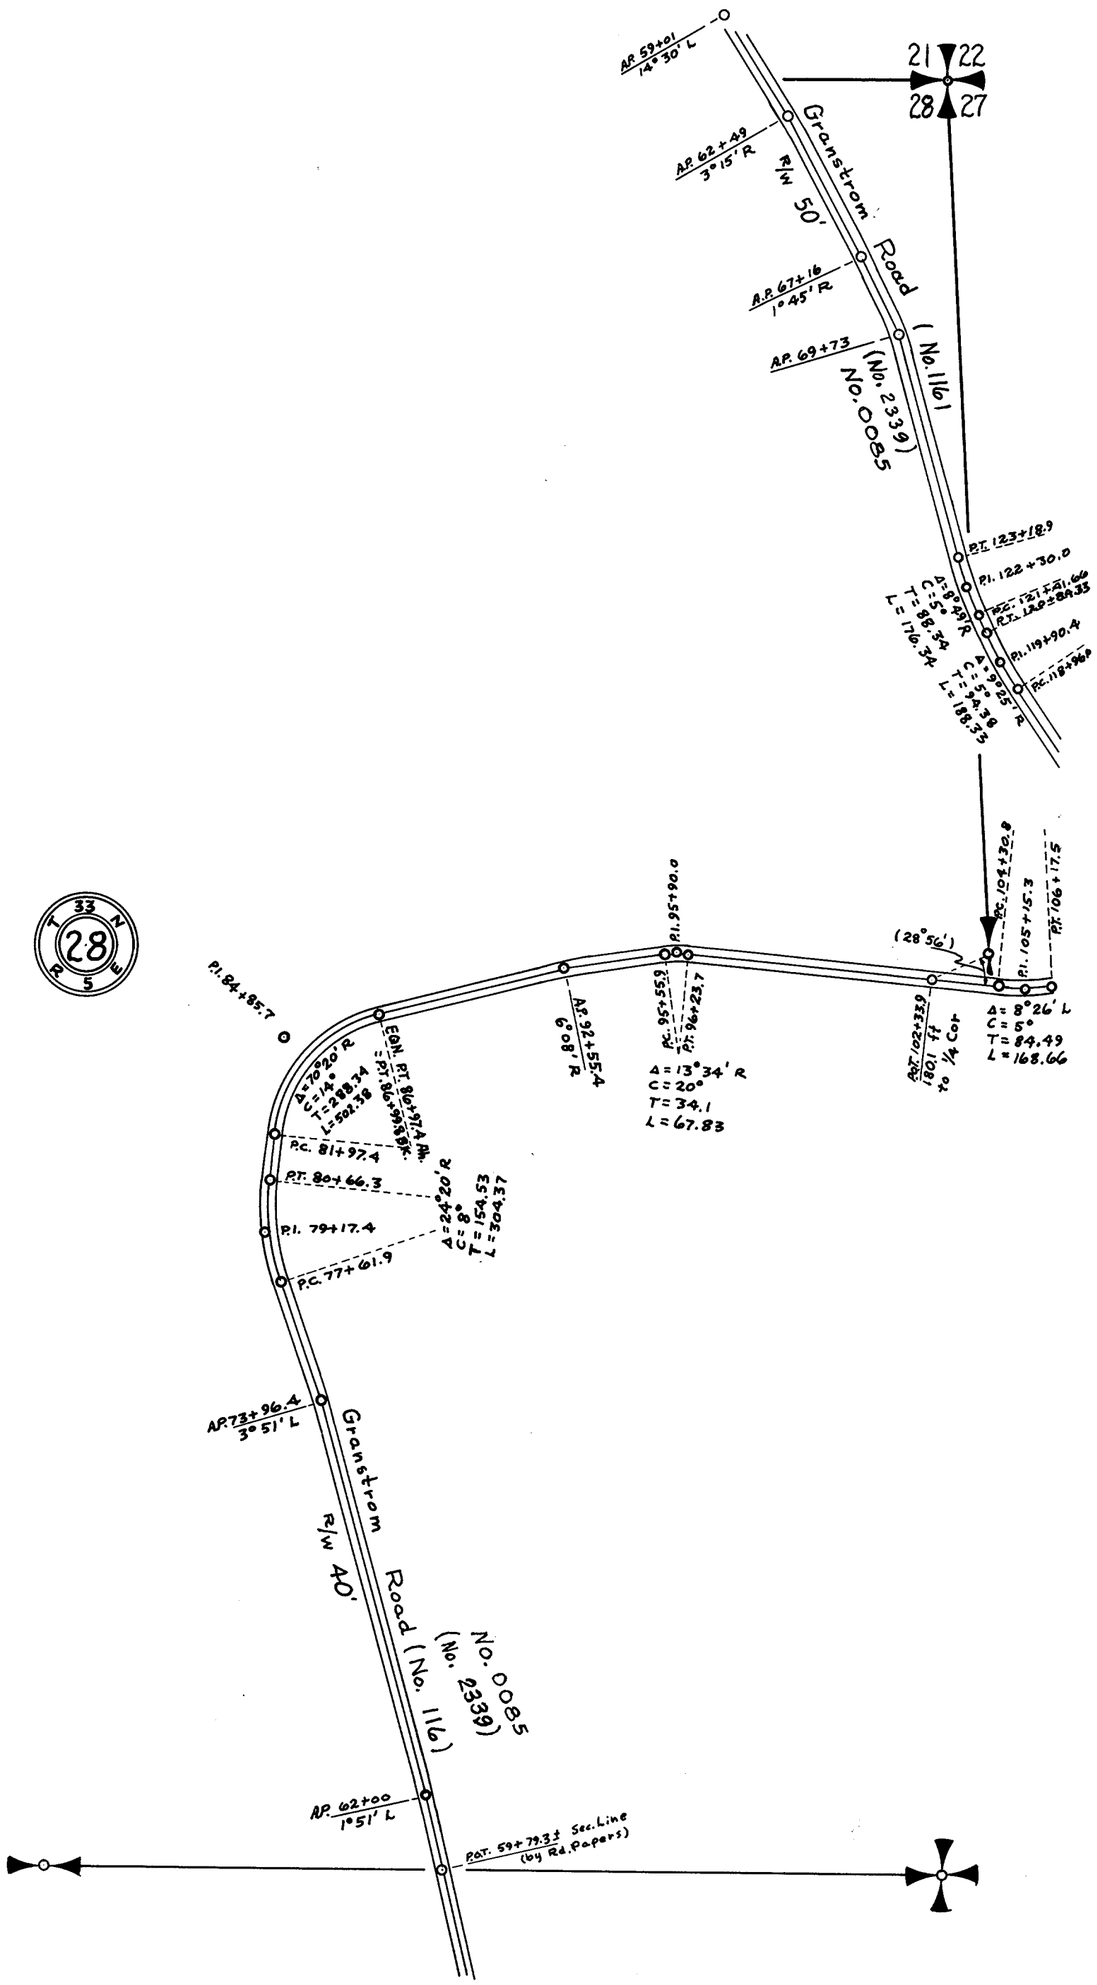

SECTION 30


TOWNSHIP 33 NORTH, RANGE 5 EAST, W. M.

SKAGIT COUNTY, WASH.

SCALE, 1 INCH -- 400 FEET

DATE August 1968

Lloyd Johnson COUNTY ENGINEER

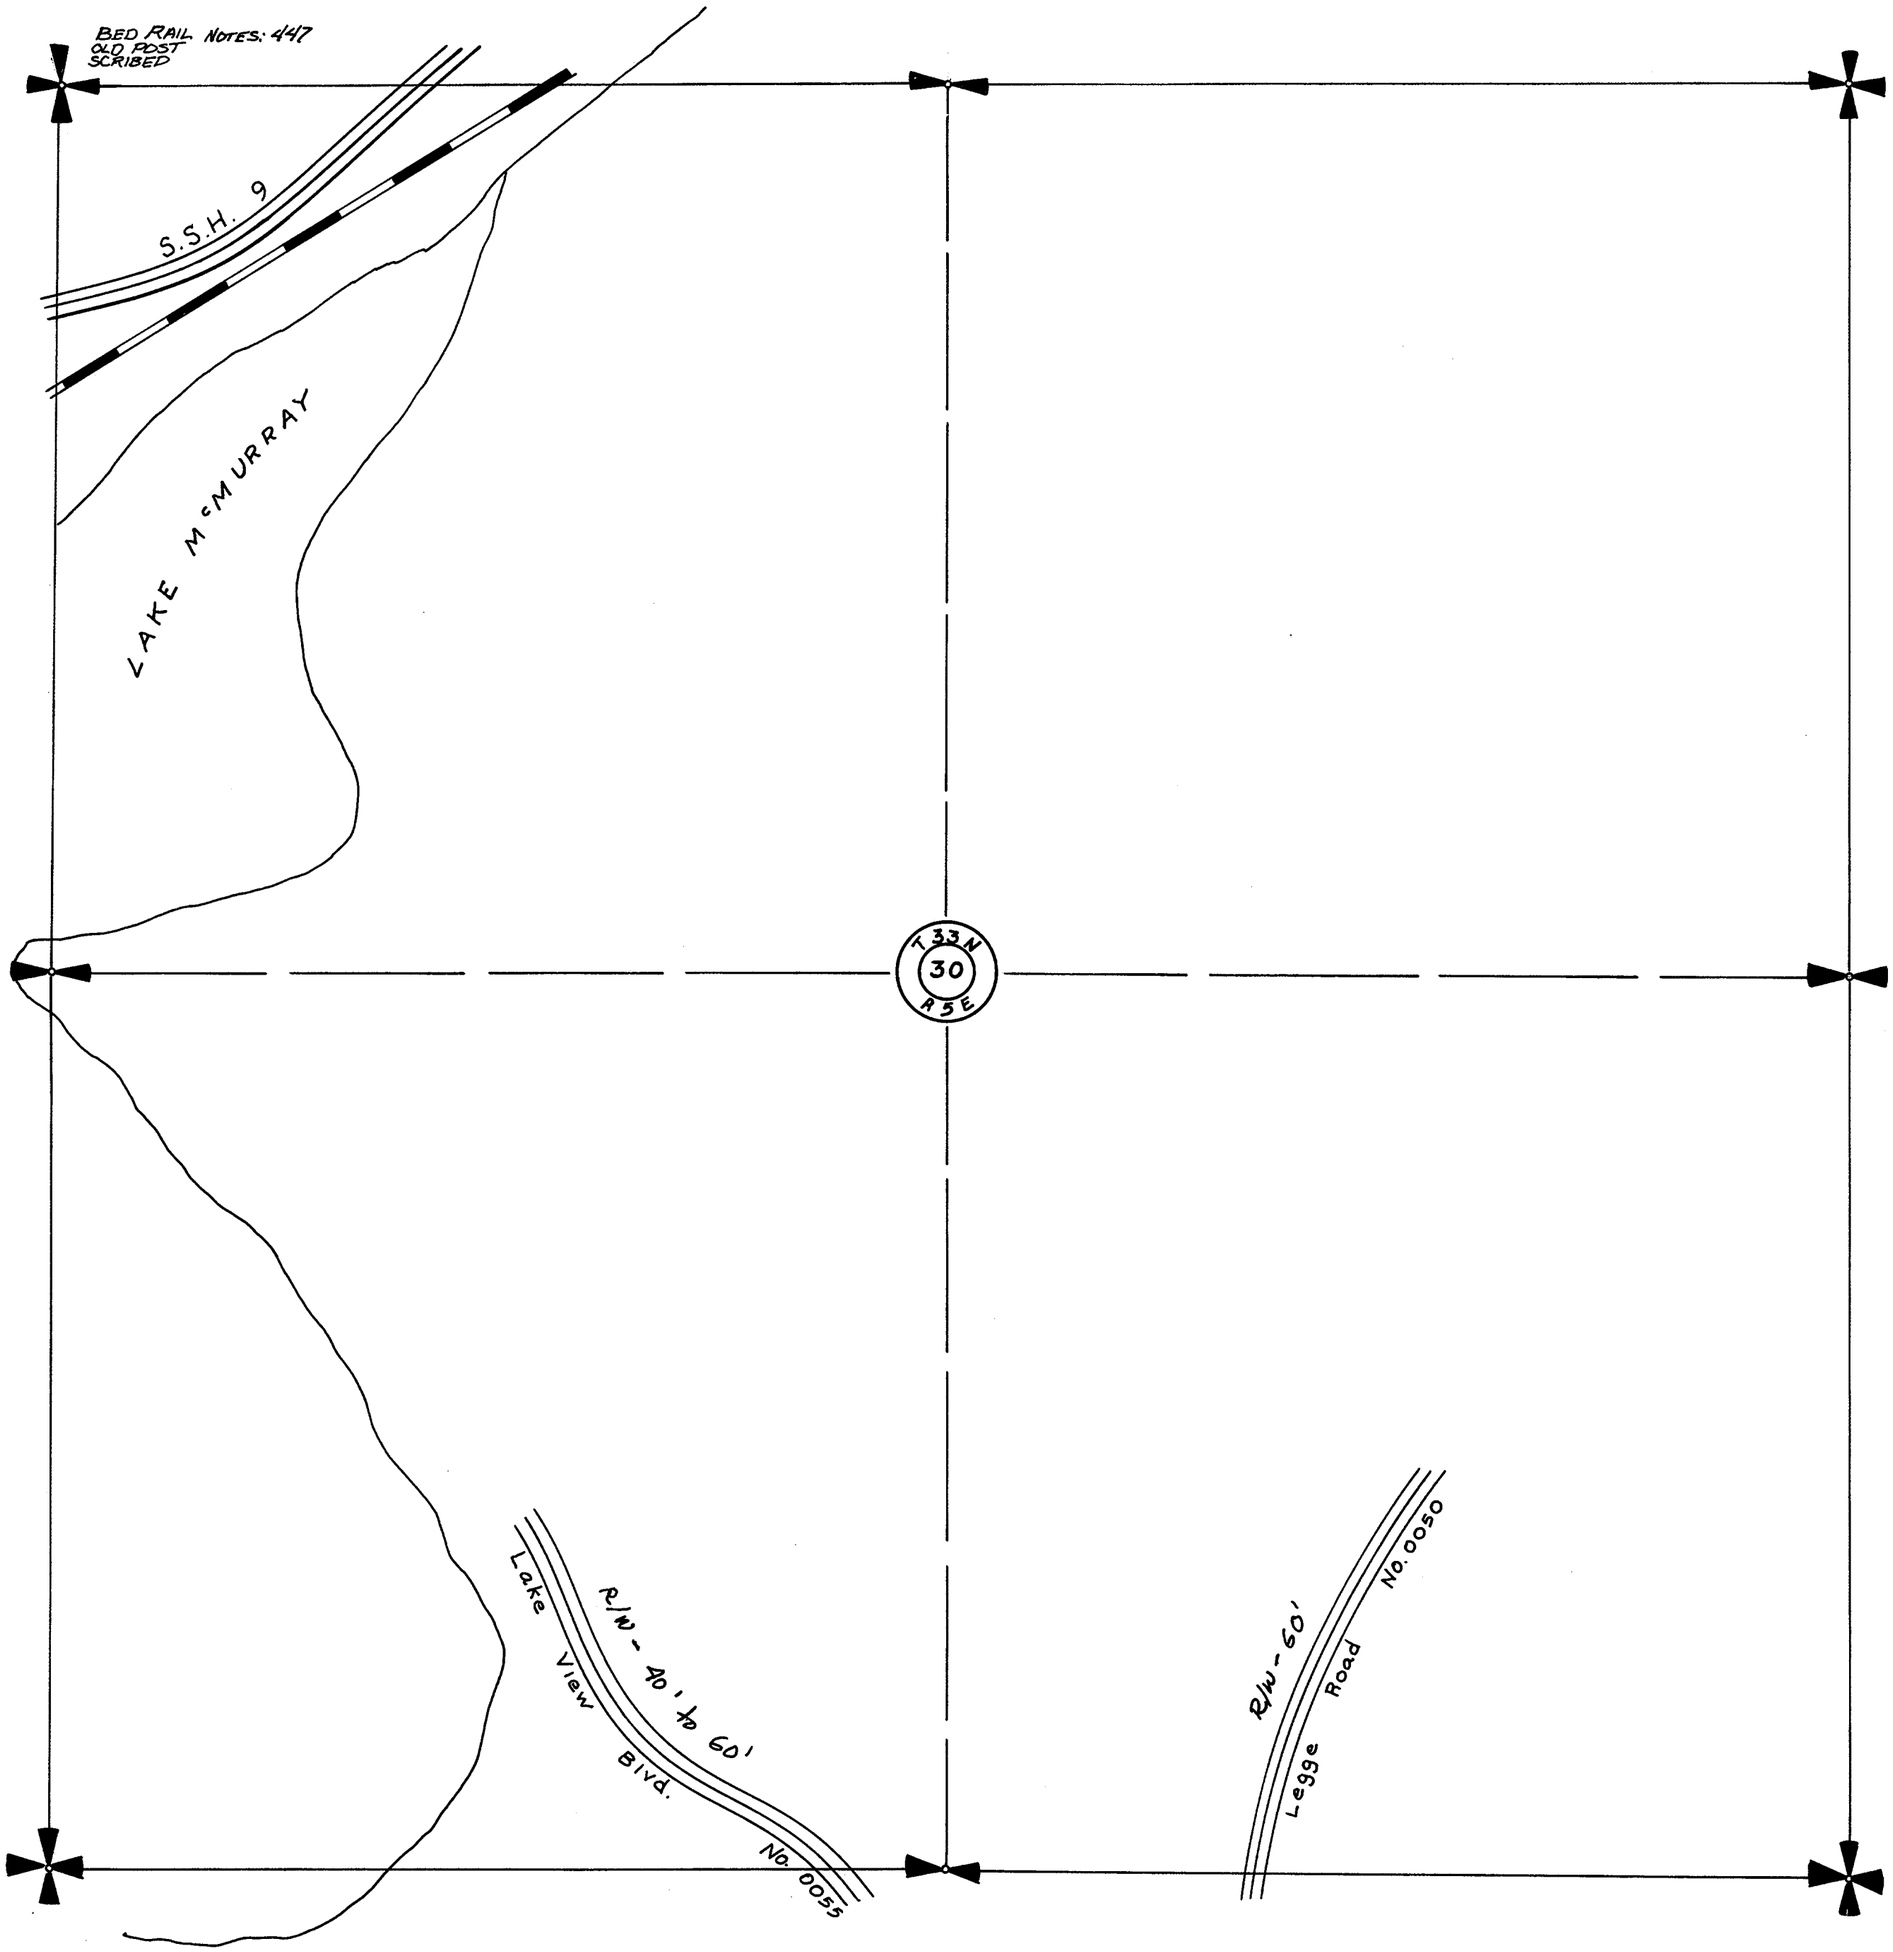


SECTION 30

TOWNSHIP 33 NORTH, RANGE 5 EAST, W. M.

SKAGIT COUNTY, WASH.

SCALE, 1 INCH–400 FEET

A. L. STRONG COUNTY ENGINEER

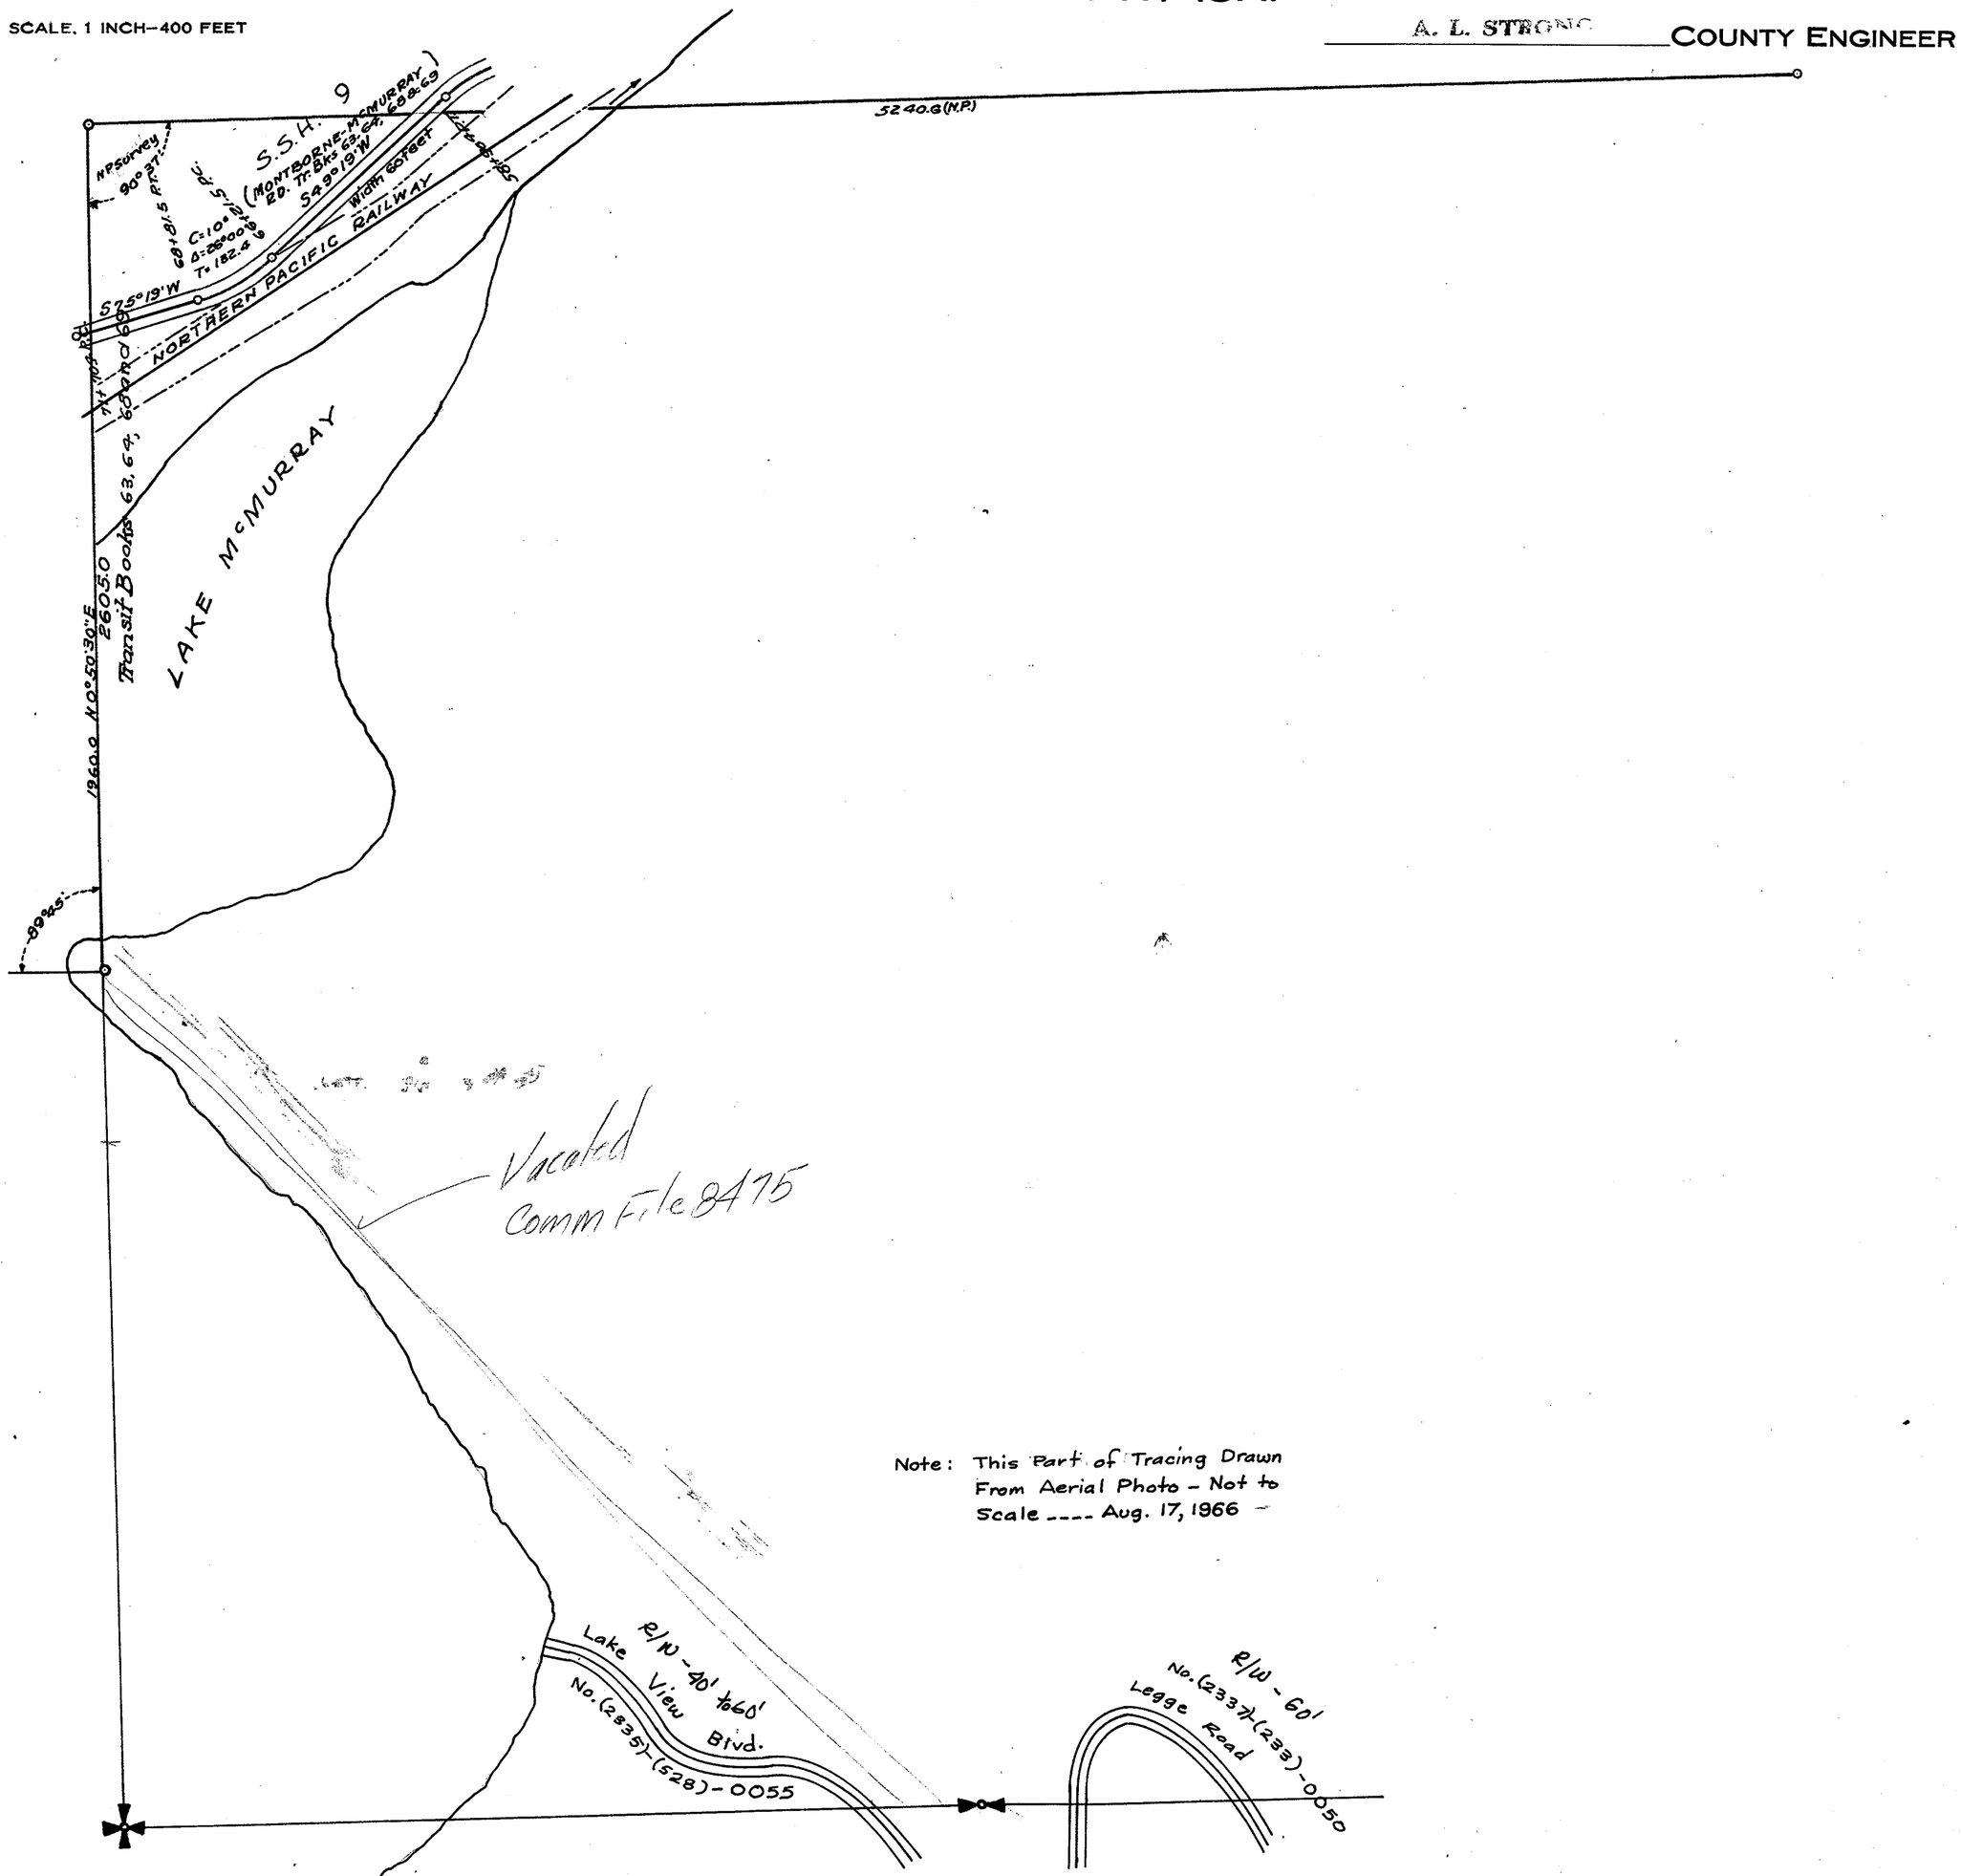


SECTION 31

TOWNSHIP 33 NORTH, RANGE 5 EAST, W. M.
SKAGIT COUNTY, WASH.

SCALE, 1 INCH–400 FEET

Arthur L. Strong COUNTY ENGINEER

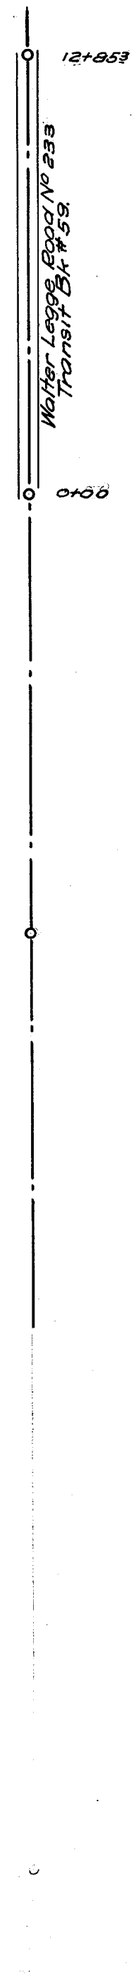

⚠ Assessors Plat of BERGMANS LAKE McMURRAY TRACKS Vol-8-P-89

SECTION 31


TOWNSHIP 33 NORTH, RANGE 5 EAST, W. M.

SKAGIT COUNTY, WASH.

SCALE, 1 INCH--400 FEET

DATE APRIL 6, 1972

Lloyd H. Johnson COUNTY ENGINEER

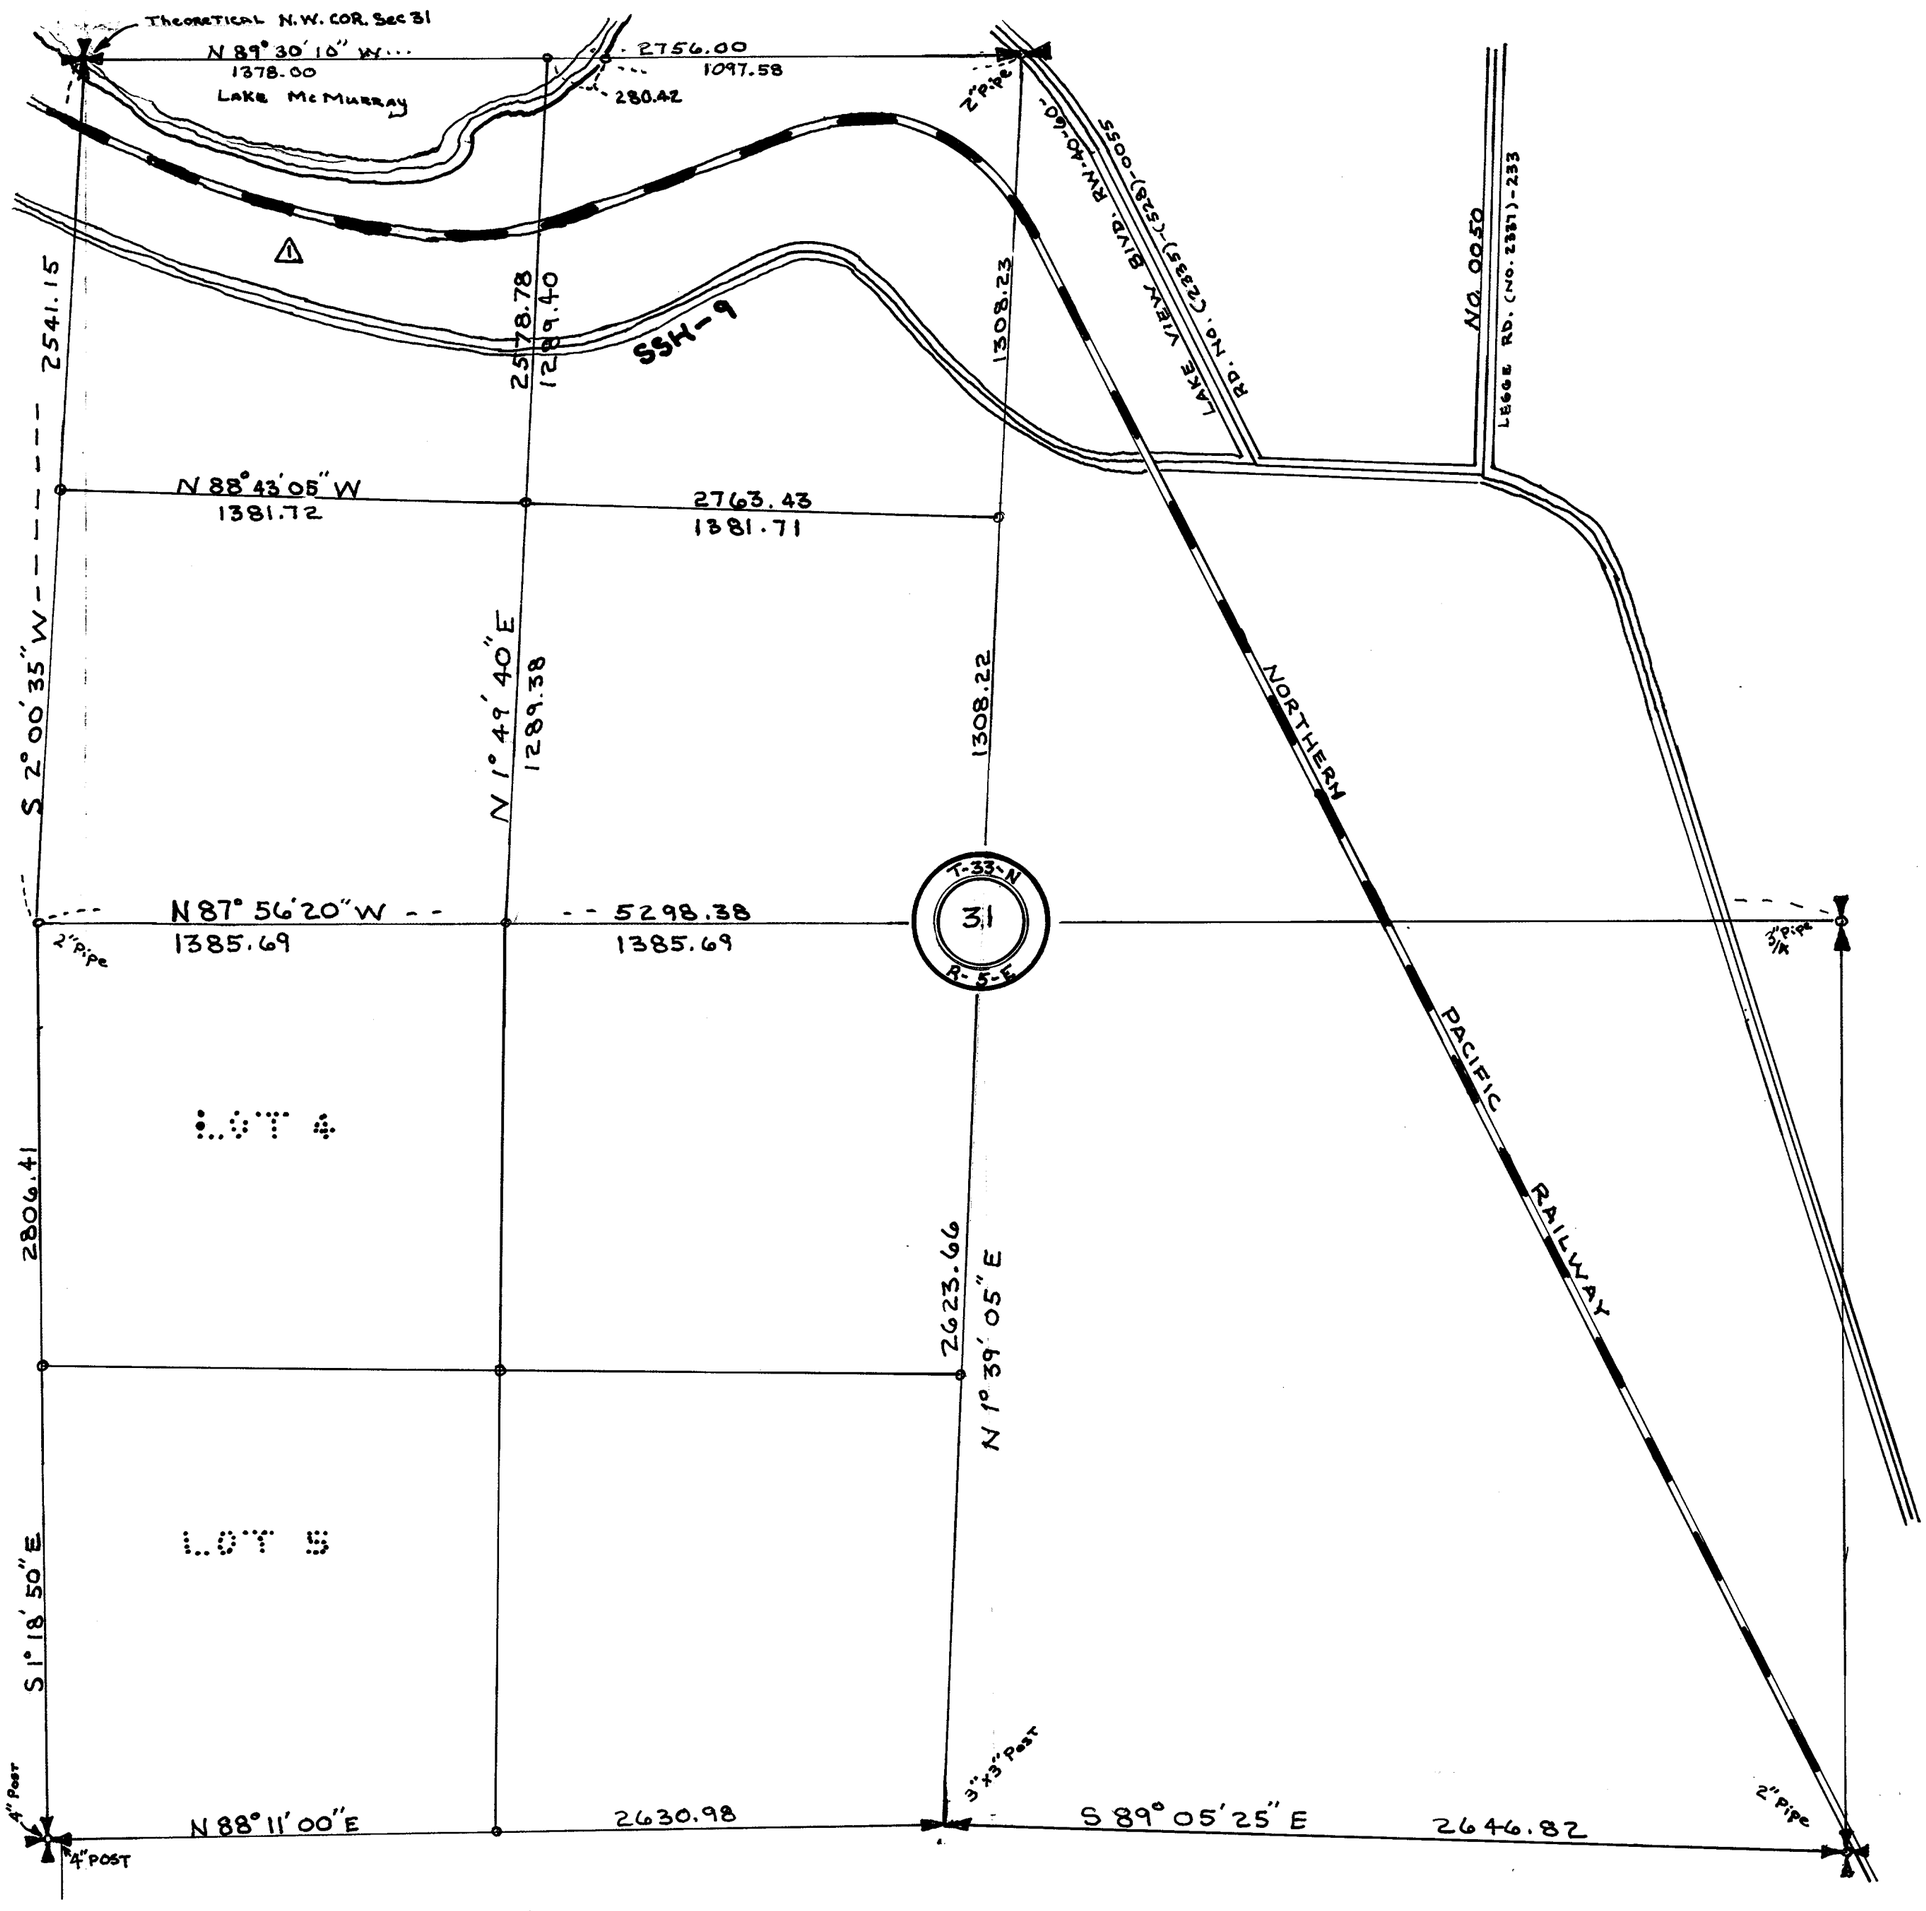


SECTION 31

TOWNSHIP 33 NORTH, RANGE 5 EAST, W. M.

SKAGIT COUNTY, WASH.

SCALE, 1 INCH--400 FEET

DATE Aug. 19, 1966 Lloyd Johnson COUNTY ENGINEER

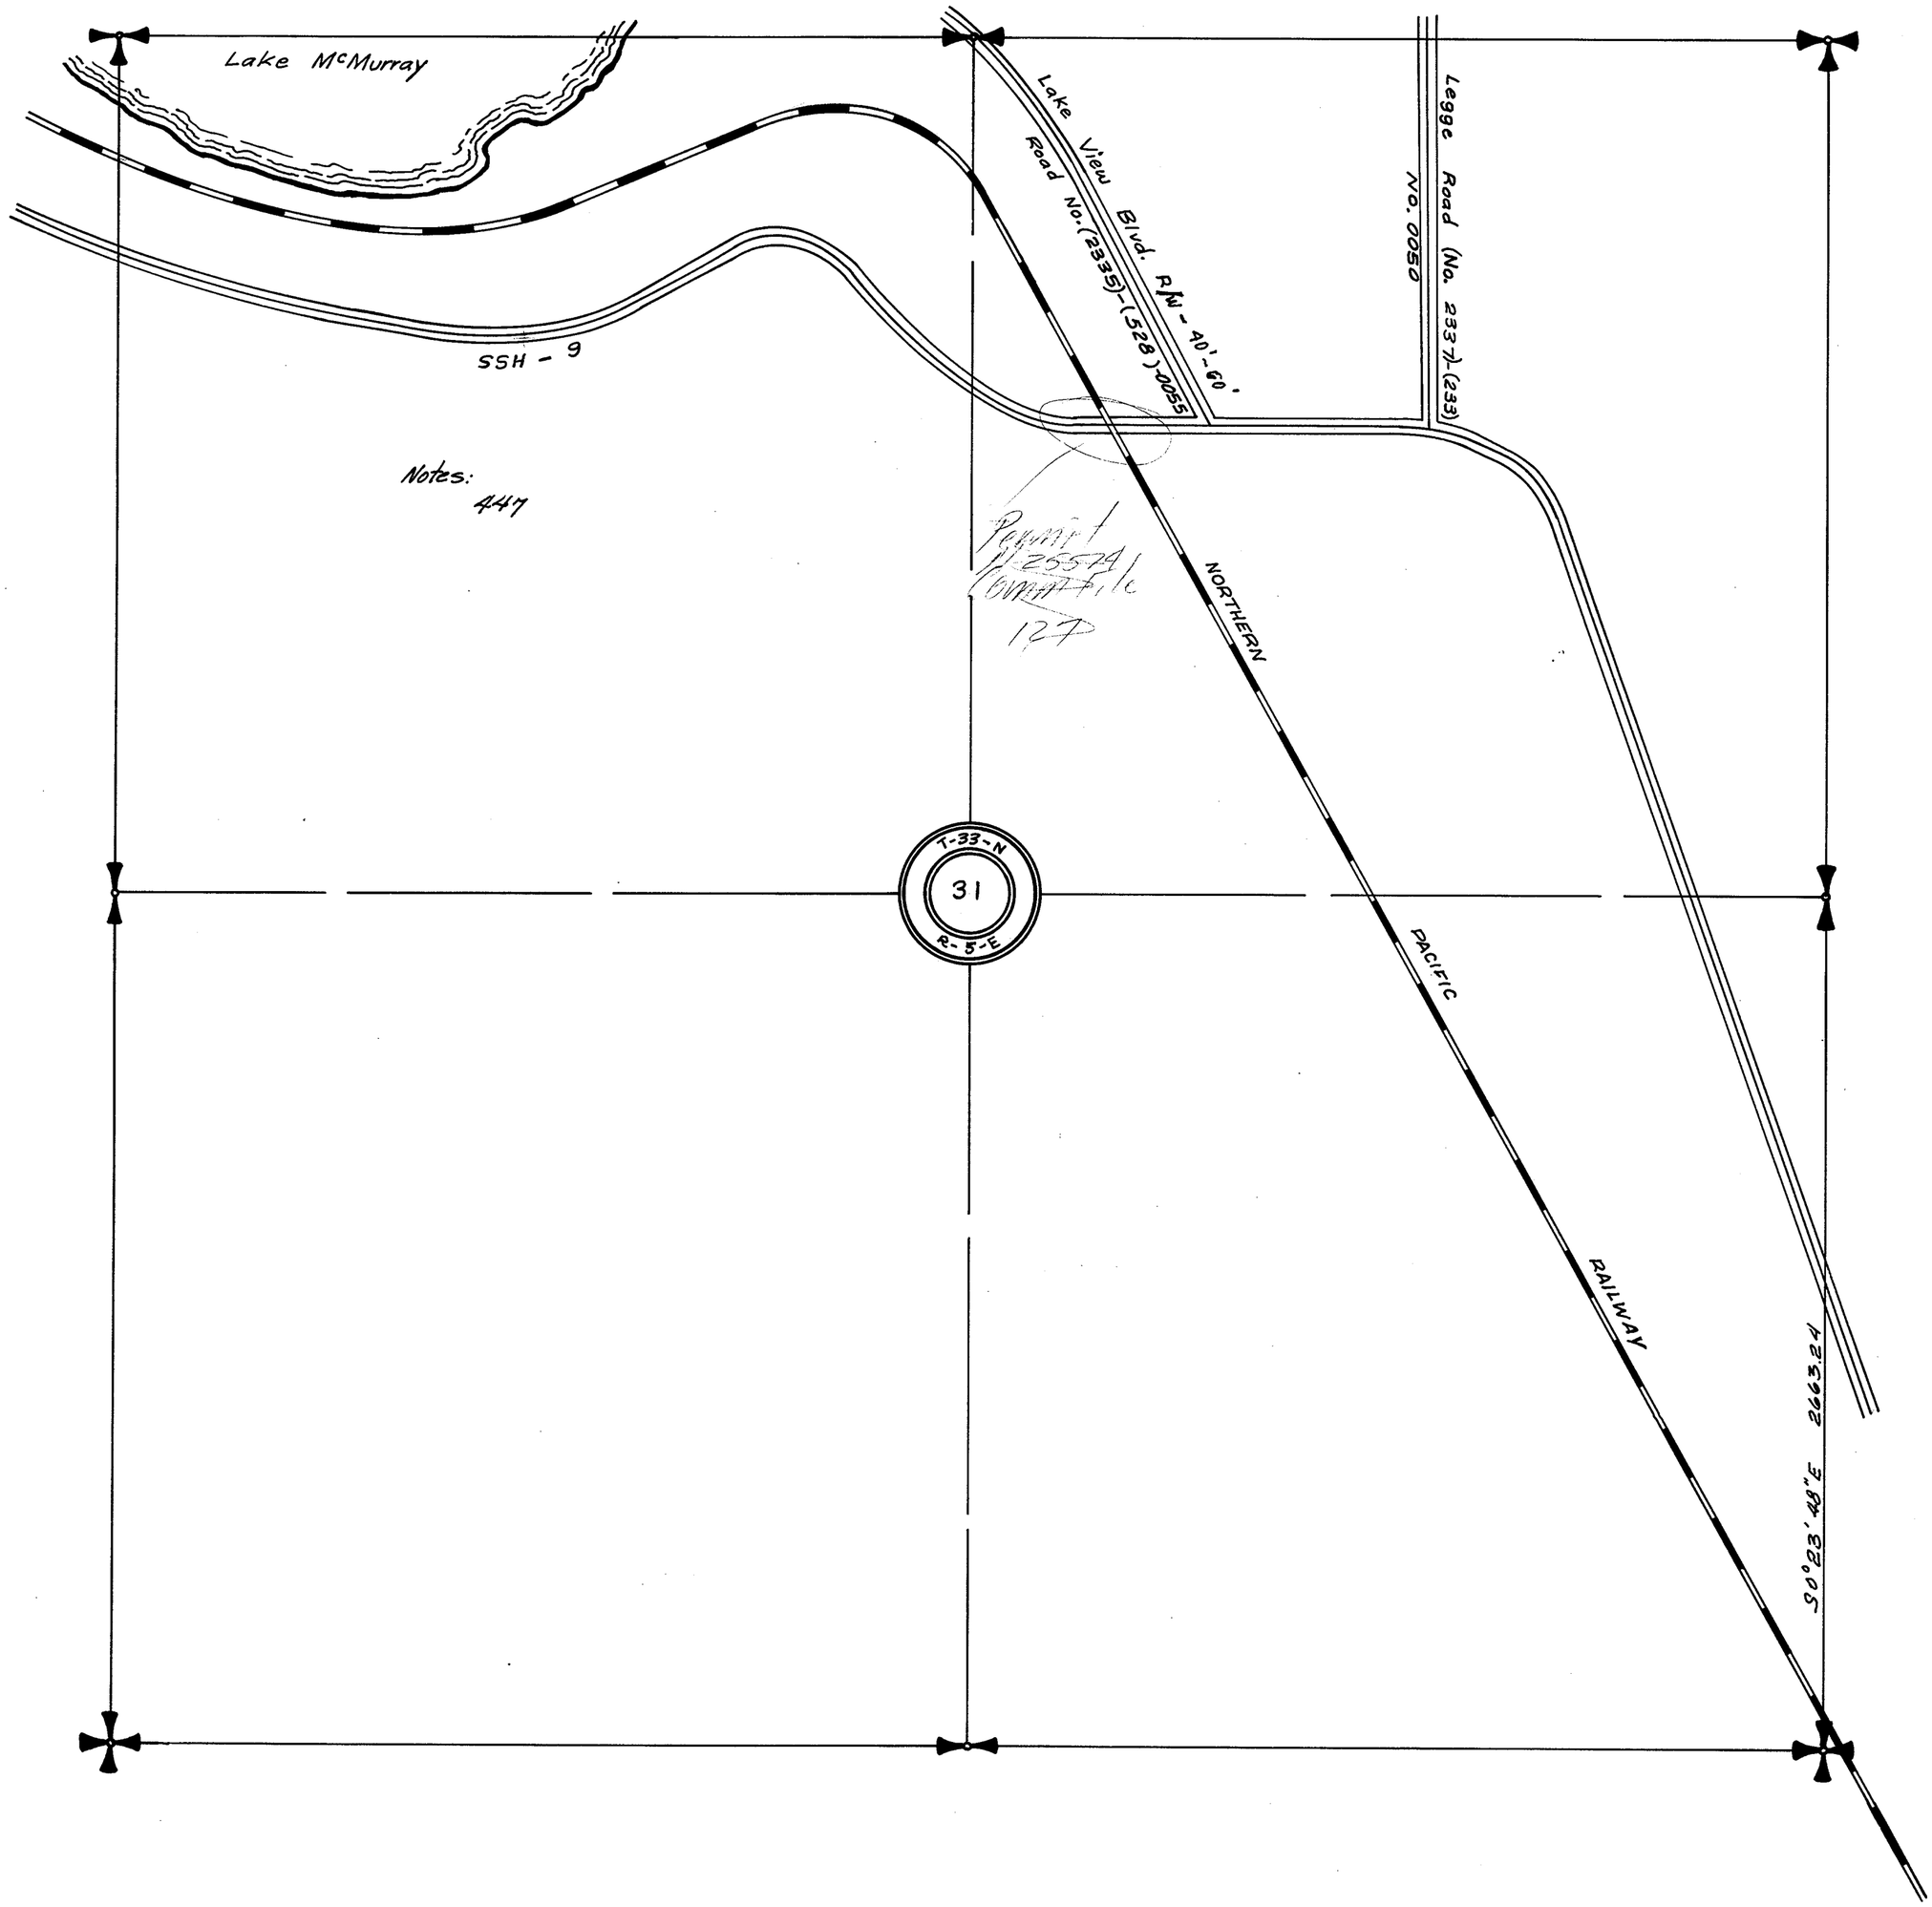

Notes:
447

Permit
#25574
COMM File
127


SECTION 33

TOWNSHIP 33 NORTH, RANGE 5 EAST, W. M.

SKAGIT COUNTY, WASH.

SCALE, 1 INCH--400 FEET
Road No. 116 Drawn From Notes D-81


DATE November, 1959 Frank Gilkey COUNTY ENGINEER

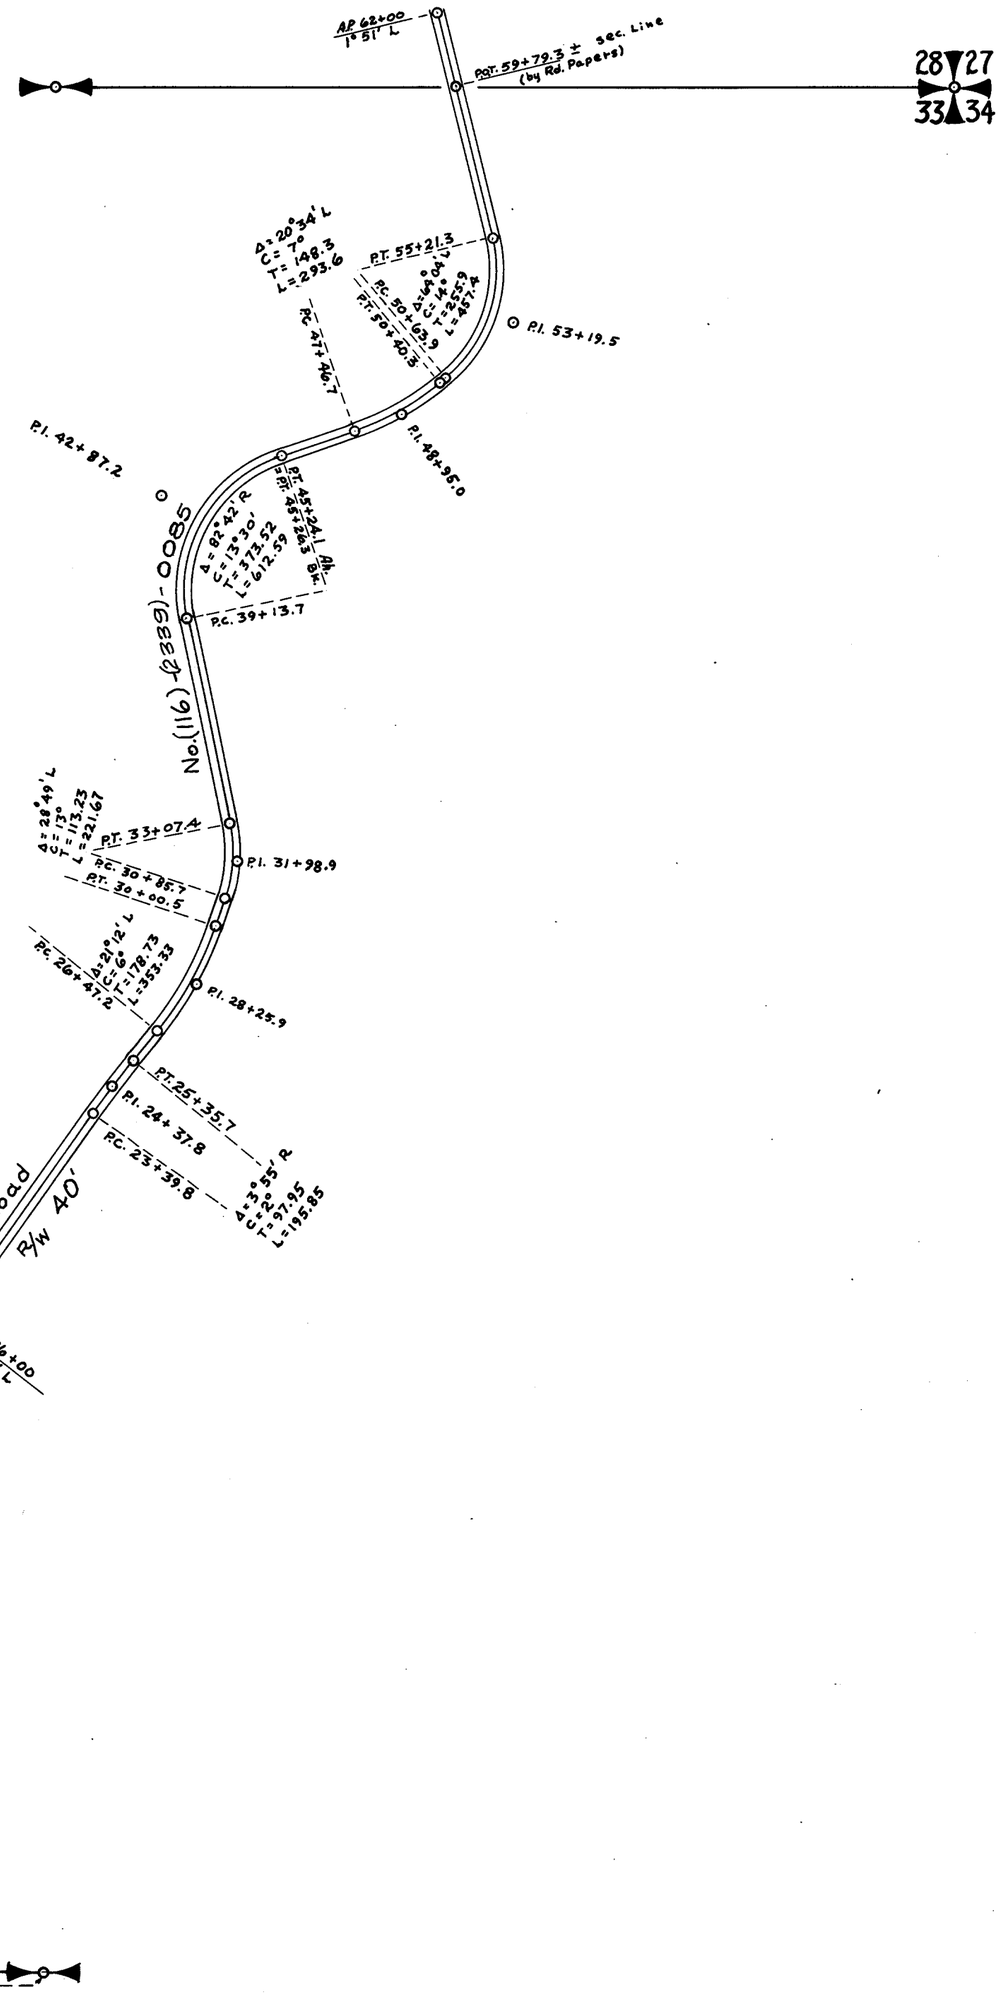

SEC. 17-33-6

Ref. NE Cor
10" R.C. N13°E 25.7'
12" R.C. S20°W 39.7'
14" R.C. N35½°W 23.5'

Ref E¼ Cor
8" R.C. S80°E 20.9'
6" Hem. S48°W 19.1'

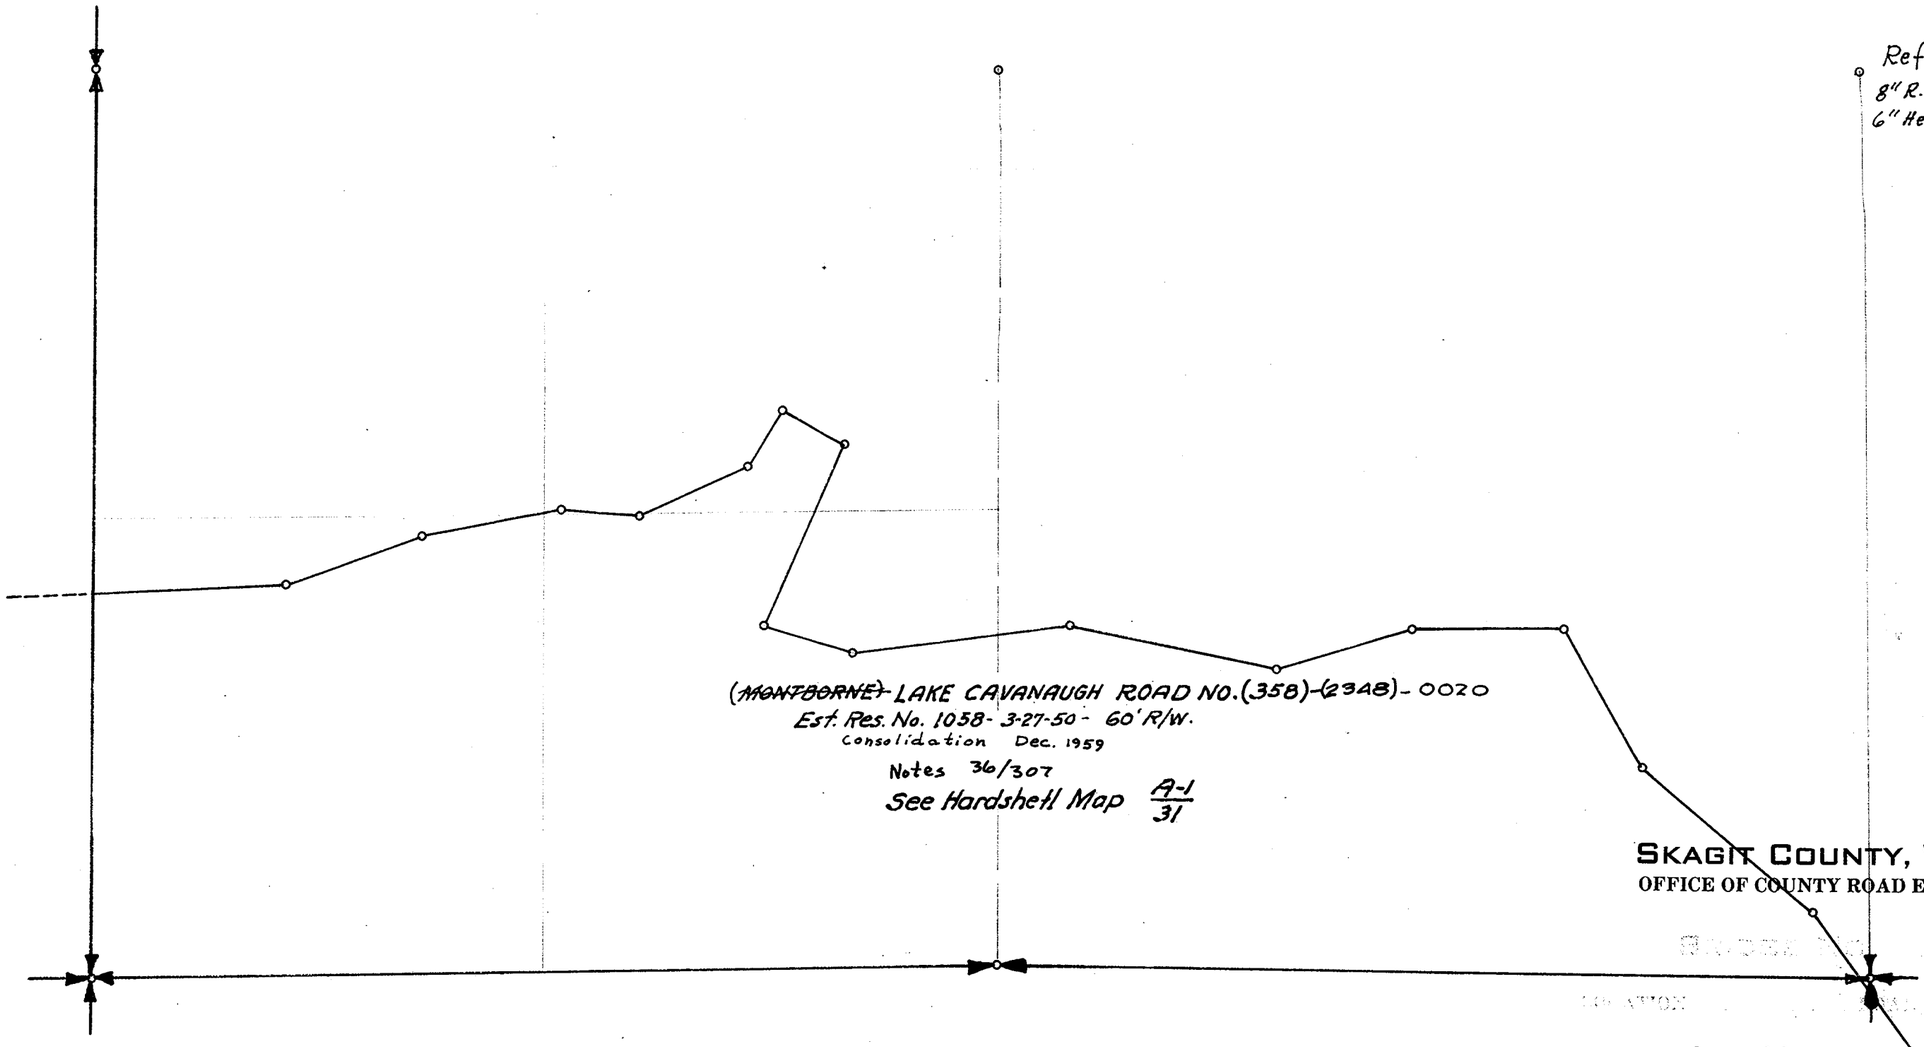

(~~MONTBORNE~~) LAKE CAVANAUGH ROAD NO. (358)-(~~2348~~)-0020
Est. Res. No. 1058 - 3-27-50 - 60' R/W.
Consolidation Dec. 1959
Notes 36/307
See Hardshell Map A-1/31

SKAGIT COUNTY, WASH.
OFFICE OF COUNTY ROAD ENGINEER


JOB NO. _____

DATE _____ _____
County Road Engineer

APPROVED _____ 194____

_____
Chairman-Board of County Commissioners

SEC. 18-33-6

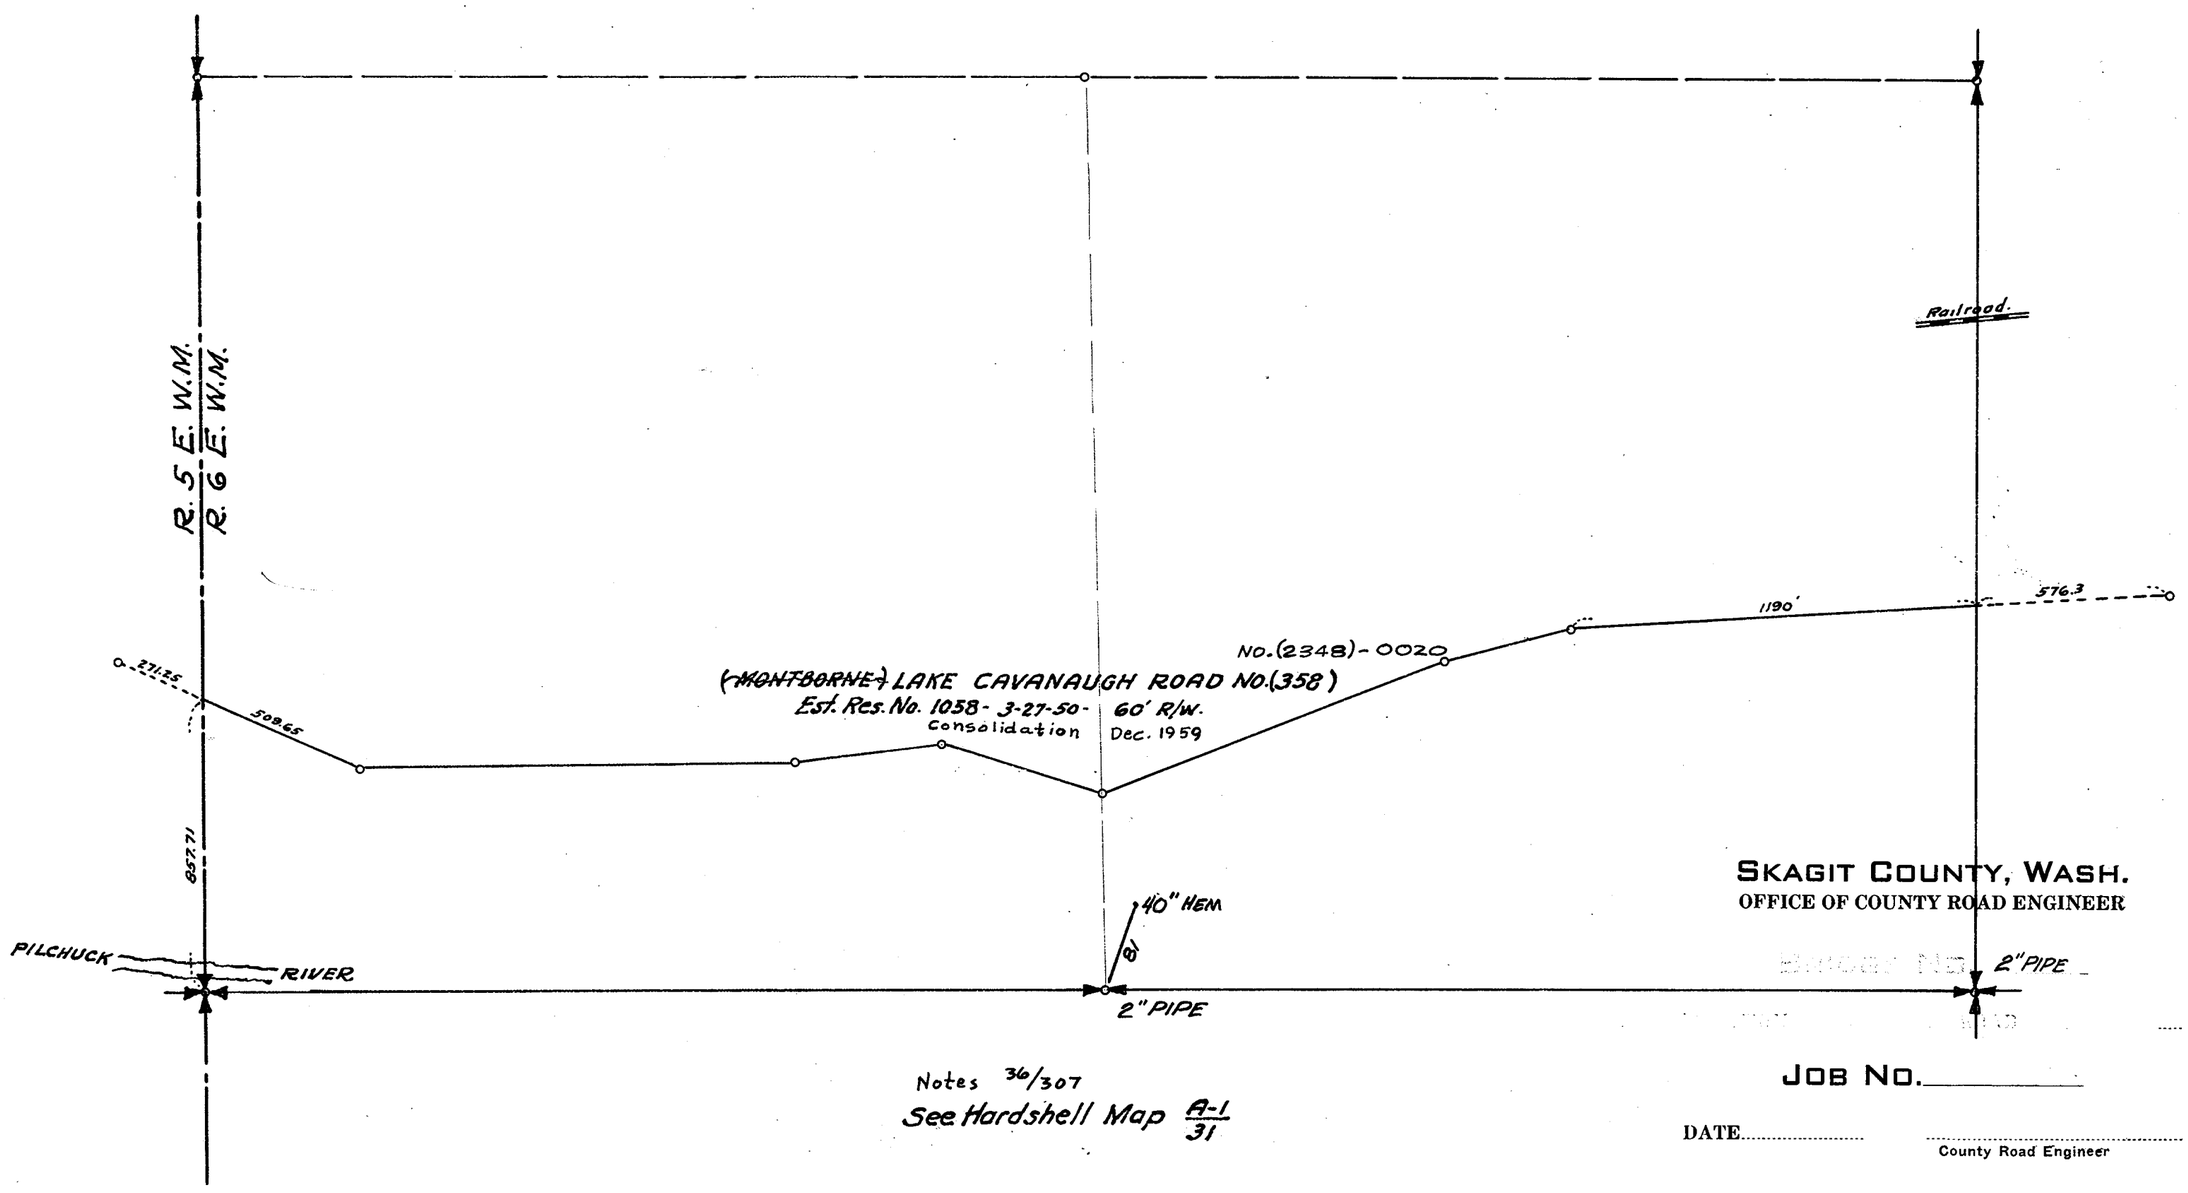

Notes 36/307

See Hardshell Map A-1/31

SKAGIT COUNTY, WASH.
OFFICE OF COUNTY ROAD ENGINEER


JOB NO. _____

DATE _____ _____
County Road Engineer

APPROVED _____ 194____

_____
Chairman-Board of County Commissioners

SEC. 20-33-6

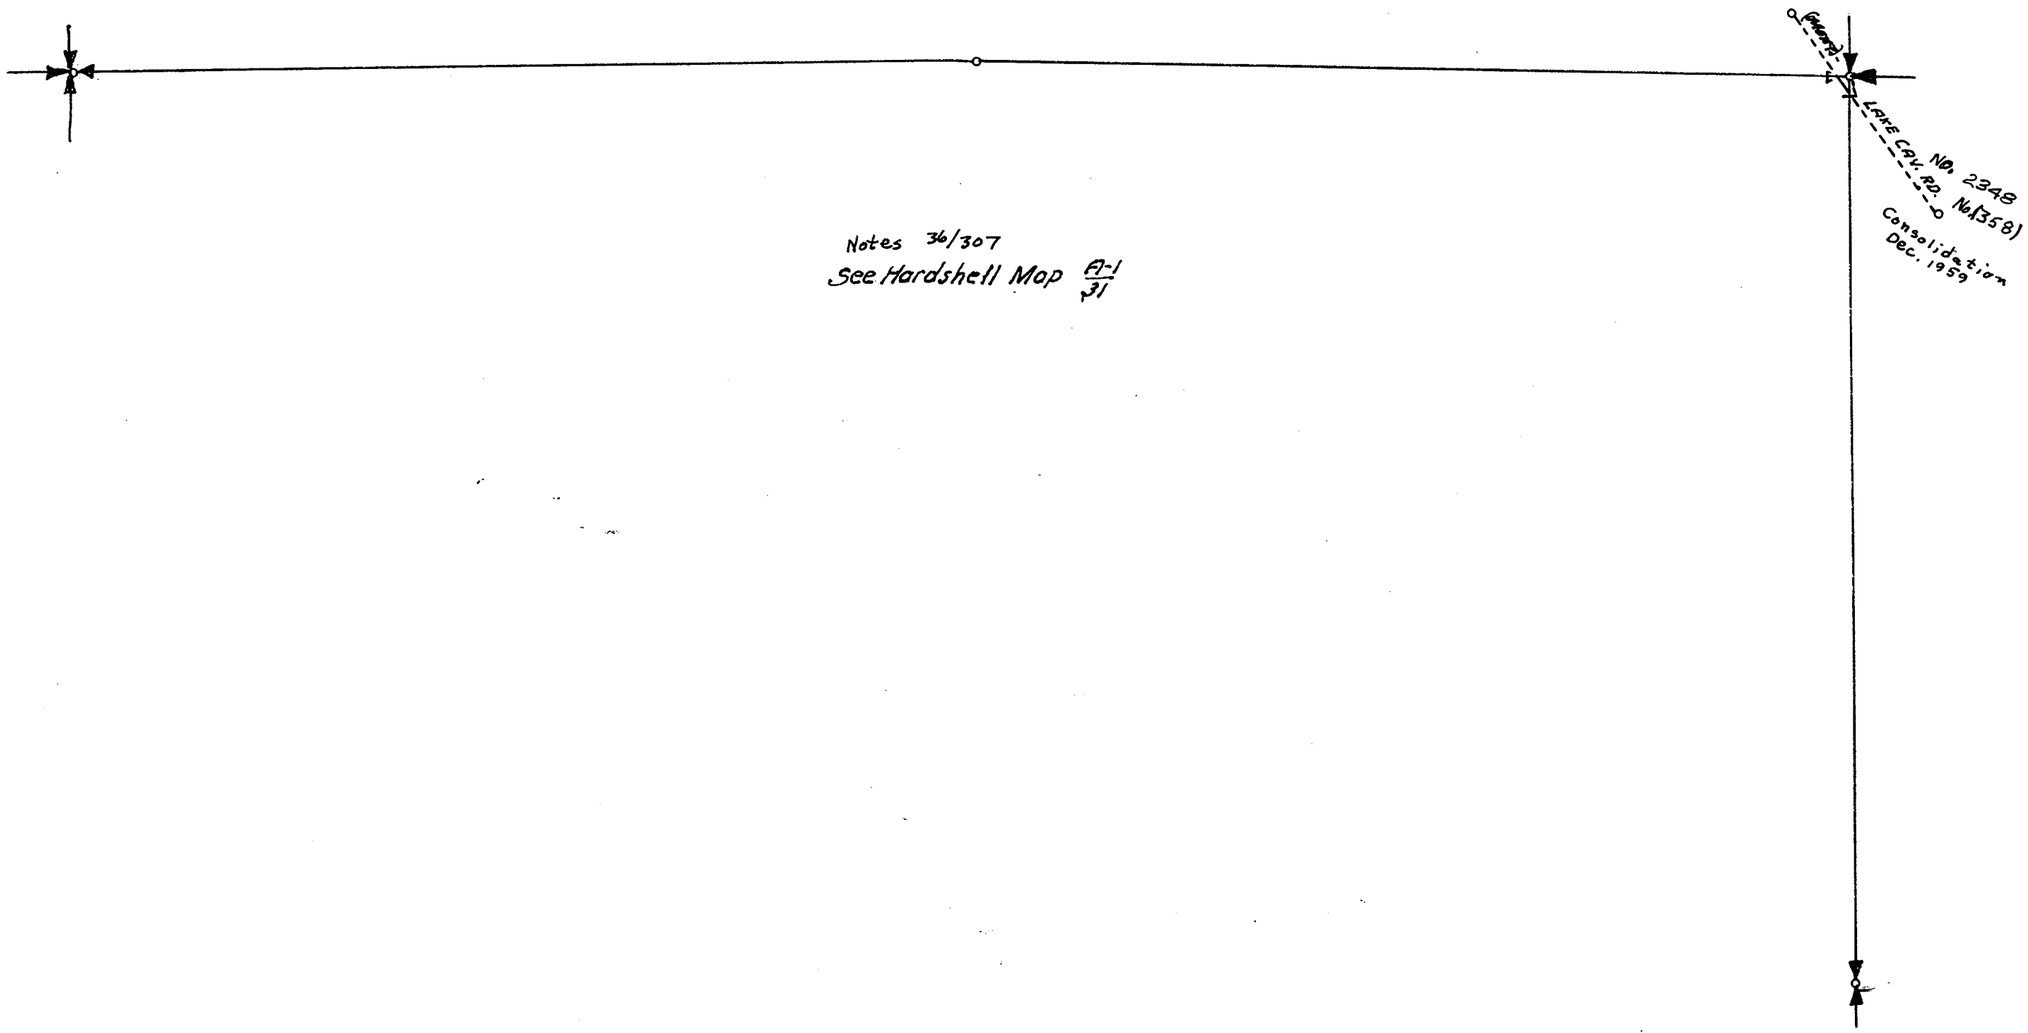

SKAGIT COUNTY, WASH.
OFFICE OF COUNTY ROAD ENGINEER

BRIDGE NO._____

LOCATION..... ROAD.....

JOB NO._____

DATE.....

.....
County Road Engineer


APPROVED..... 194.....

.....
Chairman-Board of County Commissioneers


SECTION 21
TOWNSHIP 33 NORTH, RANGE 6 EAST, W. M.
SKAGIT COUNTY, WASH.

SCALE. 1 INCH--400 FEET
Road No. 358 (298+49.5 to 349+56.2) From Notes 36/307
Road No. 508 (349+56.2 to 372+55.5) From Notes 36/307
Roads in SW¼ of SW¼ of Sec. From Plat, Vol. 6, P. 29

DATE December, 1959 Frank Gilkey COUNTY ENGINEER

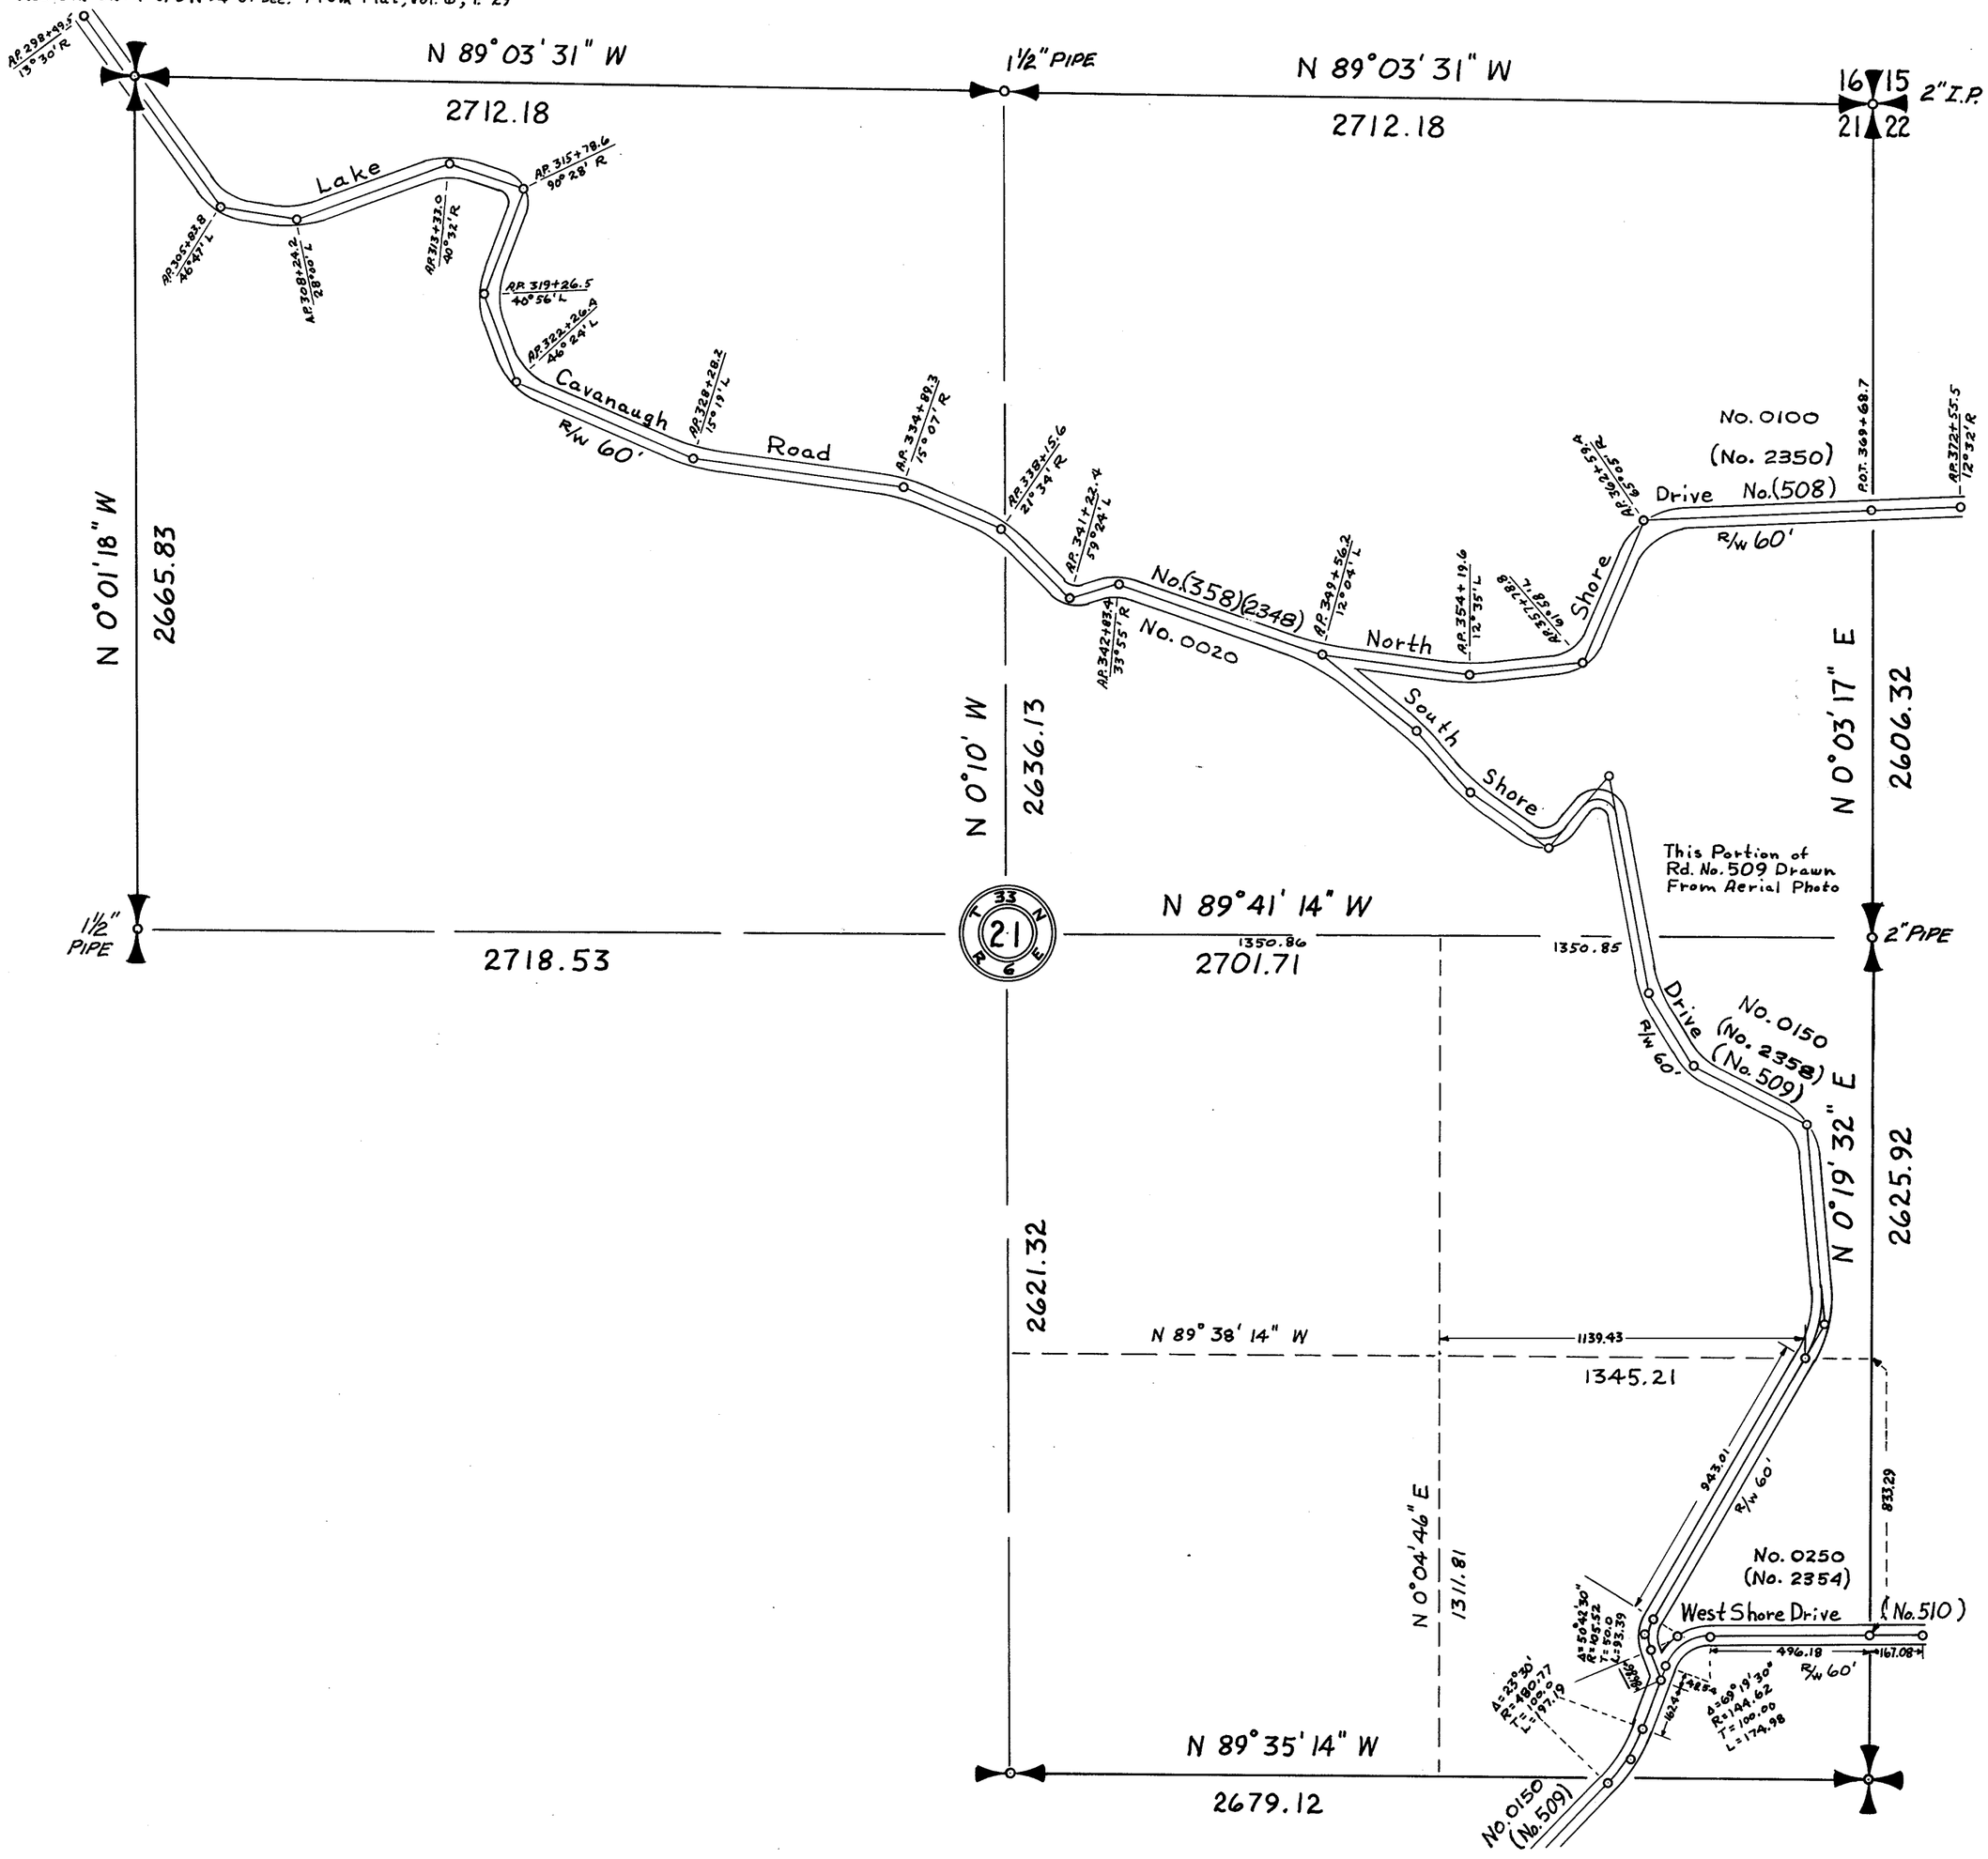

SEC. 21-33-6

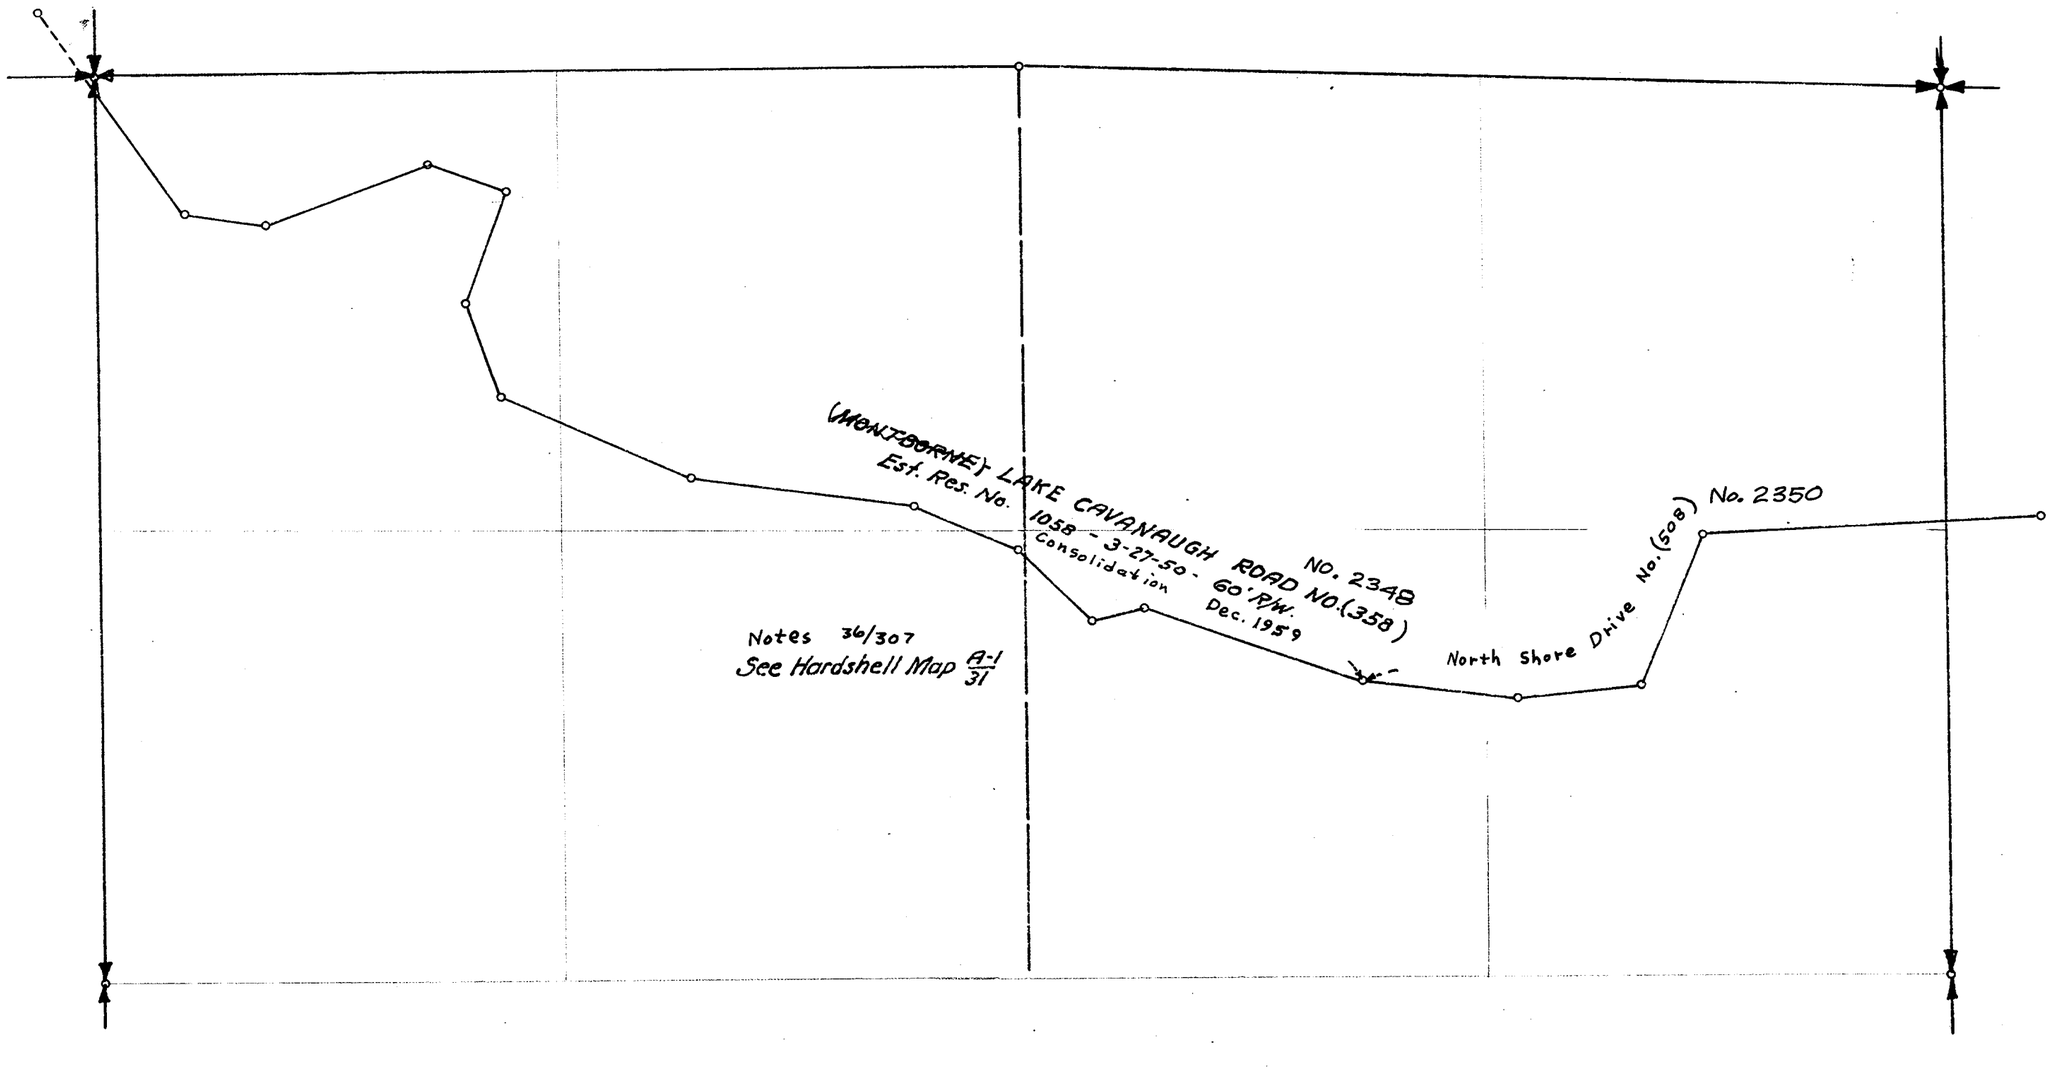

SKAGIT COUNTY, WASH.

OFFICE OF COUNTY ROAD ENGINEER

BRIDGE NO._____

LOCATION..... ROAD.....

JOB NO._____

DATE..... .....
County Road Engineer

APPROVED..... 194.....


.....
Chairman-Board of County Commissioners

SECTION 22
TOWNSHIP 33 NORTH, RANGE 6 EAST, W.M.
SKAGIT COUNTY, WASH.

SCALE 1 INCH ··· 400 FEET

DATE MAY 16, 1972

Lloyd H. Johnson COUNTY ENGINEER

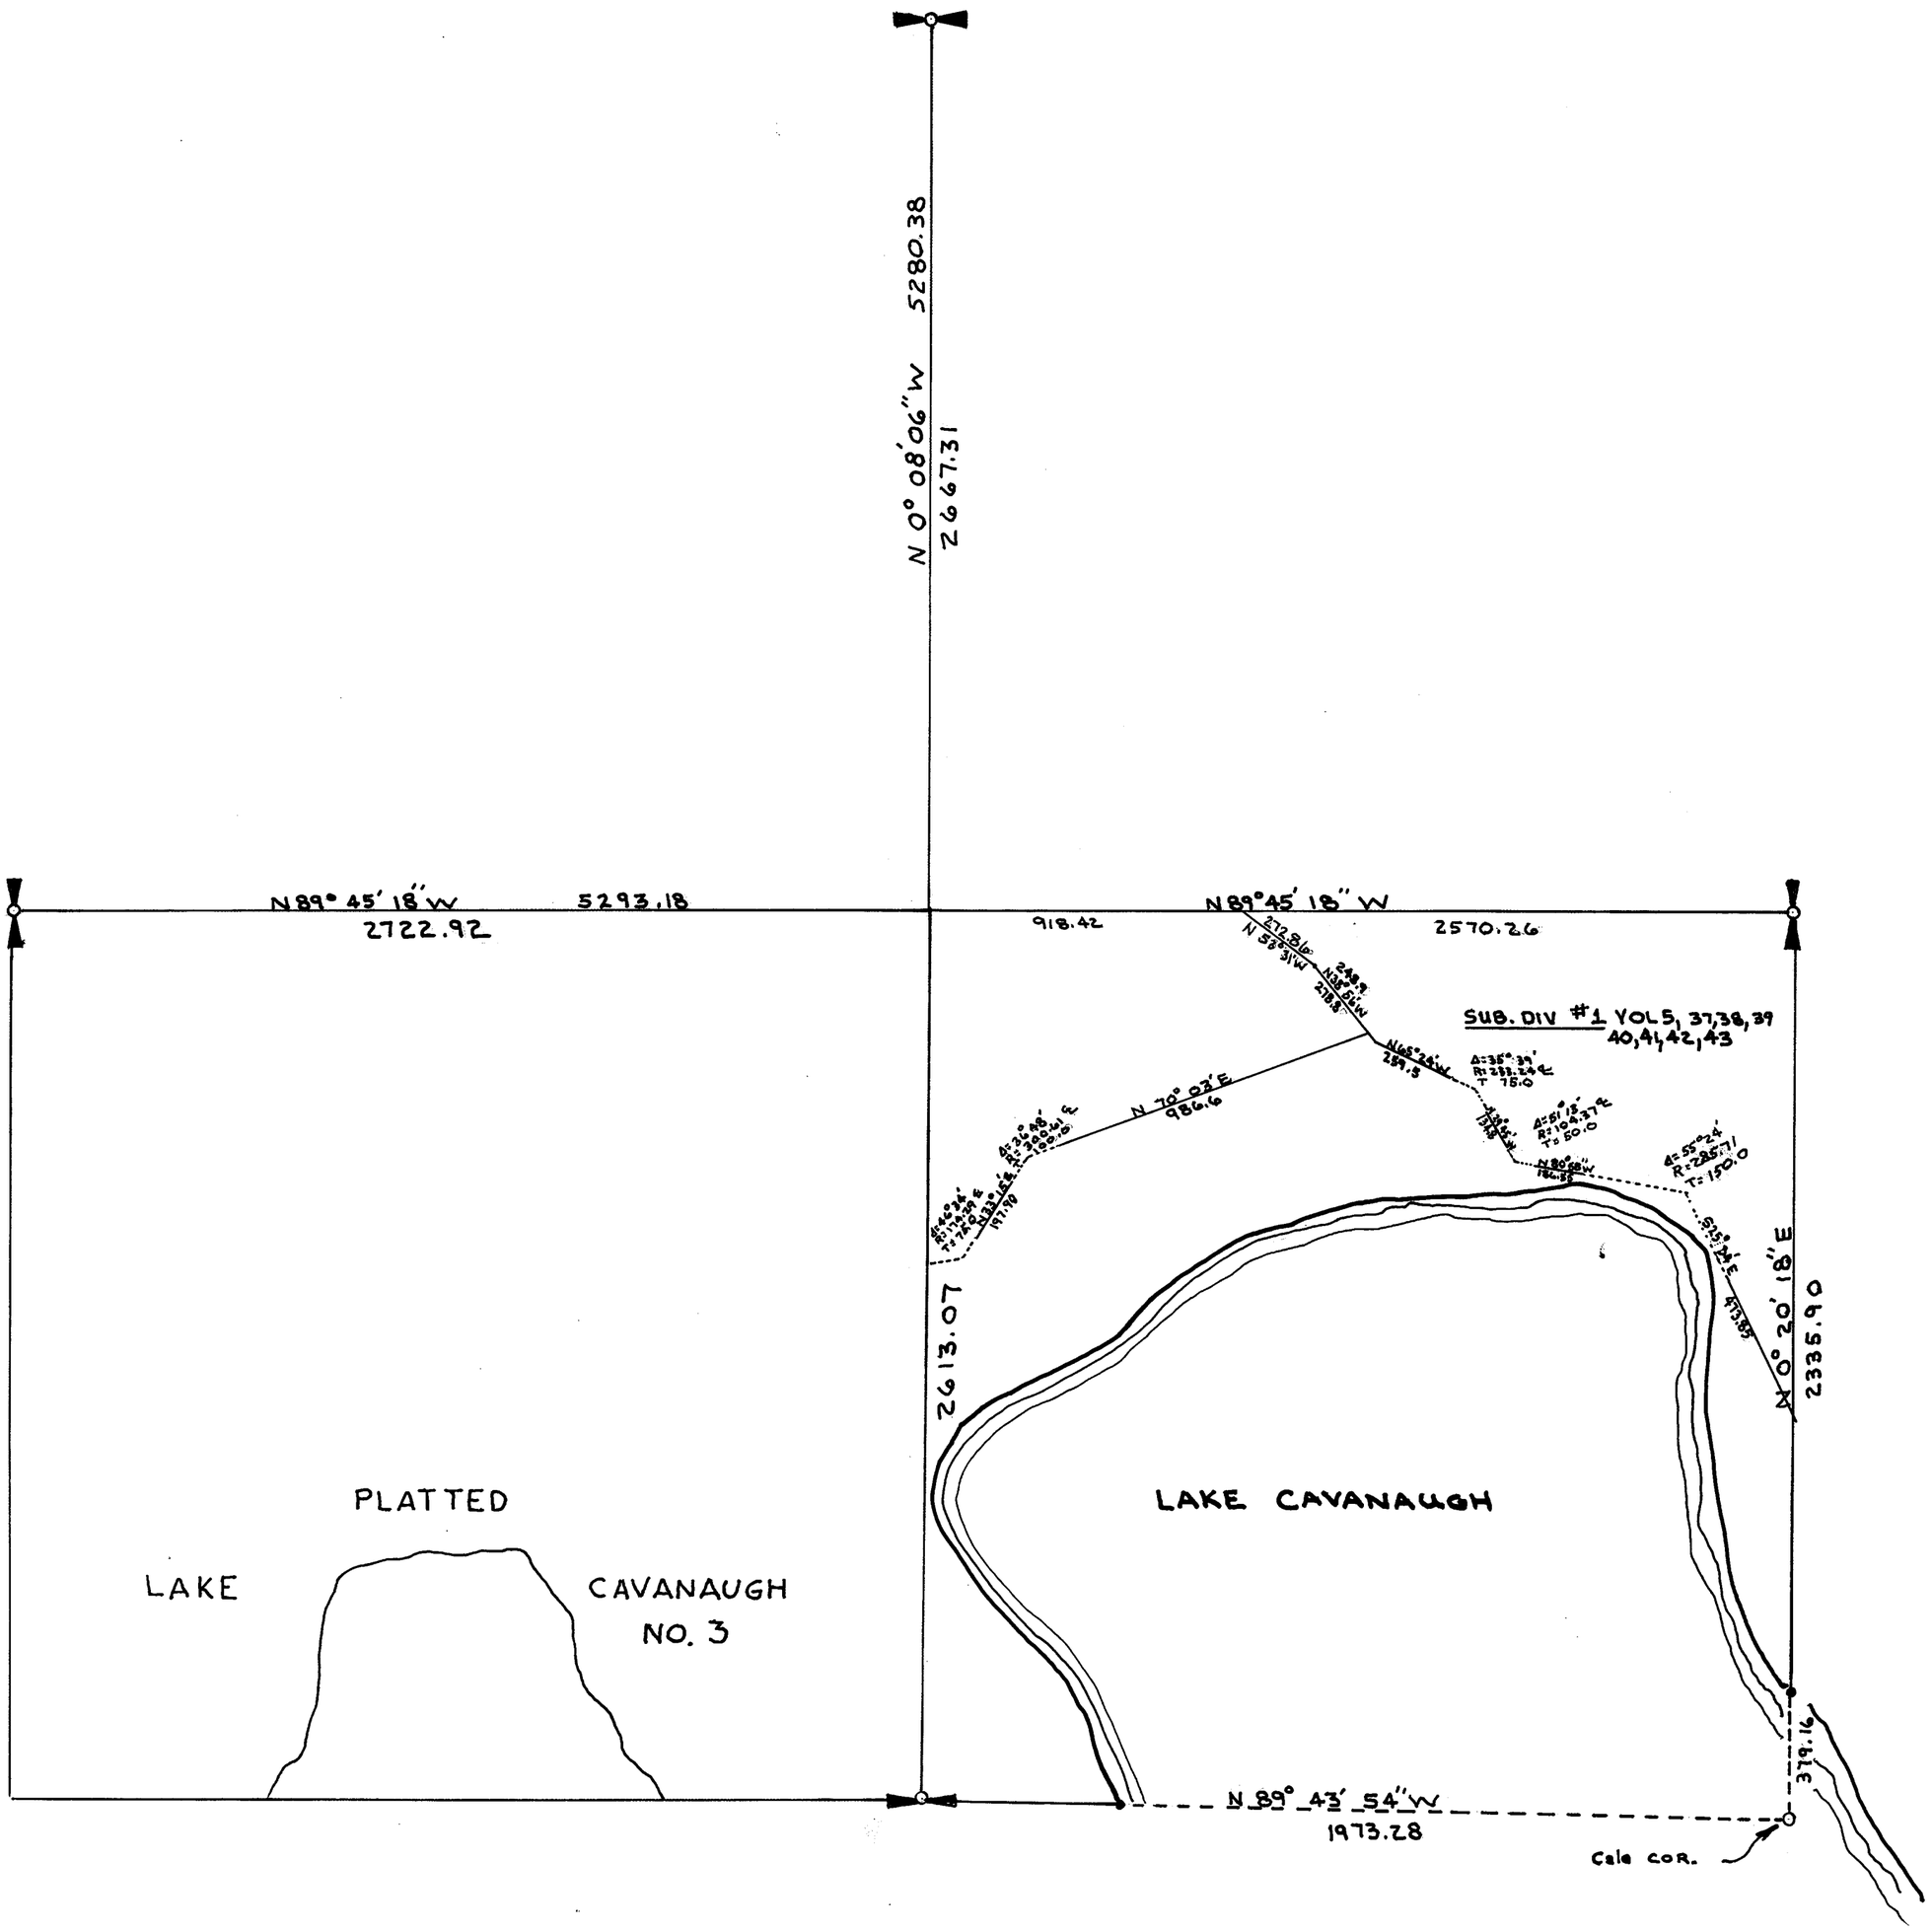

SECTION 22


TOWNSHIP 33 NORTH, RANGE 6 EAST, W. M.

SKAGIT COUNTY, WASH.

SCALE, 1 INCH--400 FEET

DATE Aug. 19 1966

Lloyd Johnson COUNTY ENGINEER

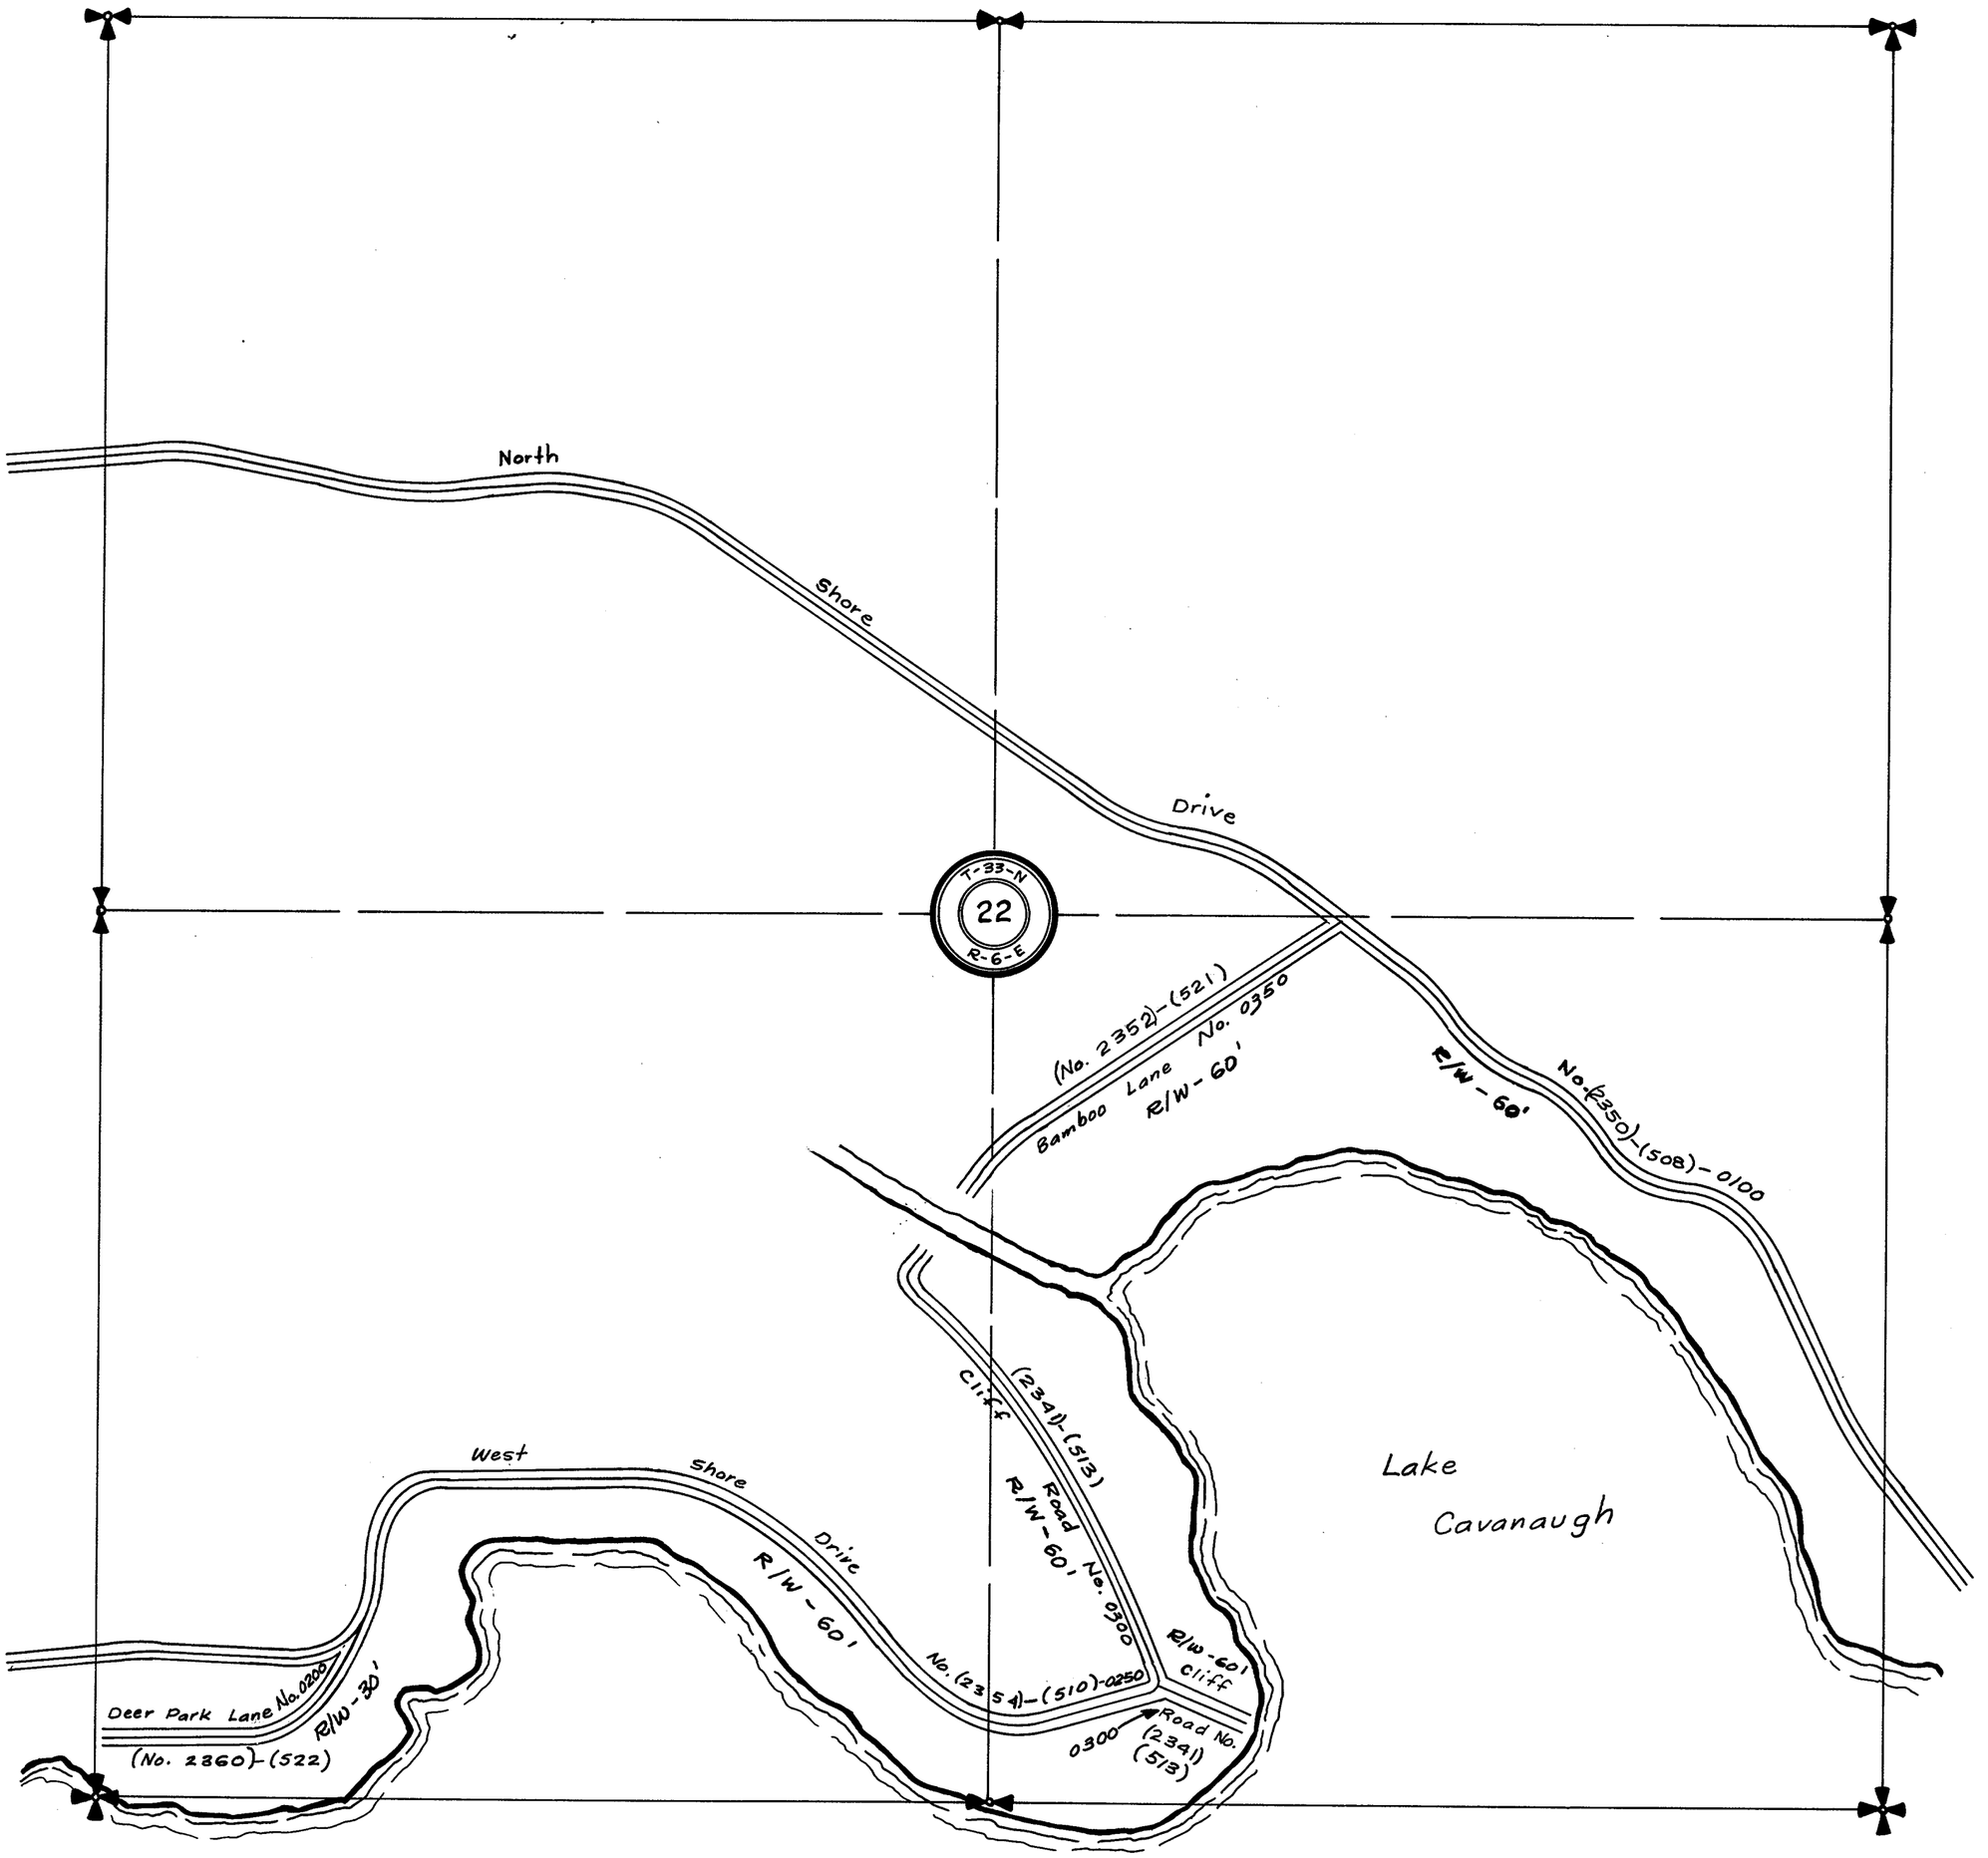

SEC. 22-33-6

S 59131.32
E 52472.76

S 61740.59
E 52472.40

MONTBORNE - LAKE CAVANAUGH ROAD NO. (358) - 2348
Est. Res. No. 1058 - 3-27-1950 - 60' R/W.

See Hardshell Map A-1/31

PILCHUCK RIVER

LAKE CAVANAUGH

SKAGIT COUNTY, WASH.
OFFICE OF COUNTY ROAD ENGINEER

BRIDGE NO. _____

LOCATION..... ROAD.....

JOB NO. _____


DATE.....

.....
County Road Engineer

APPROVED..... 194....

.....
Chairman-Board of County Commissioneers

SEC. 23 & 26- 33-6

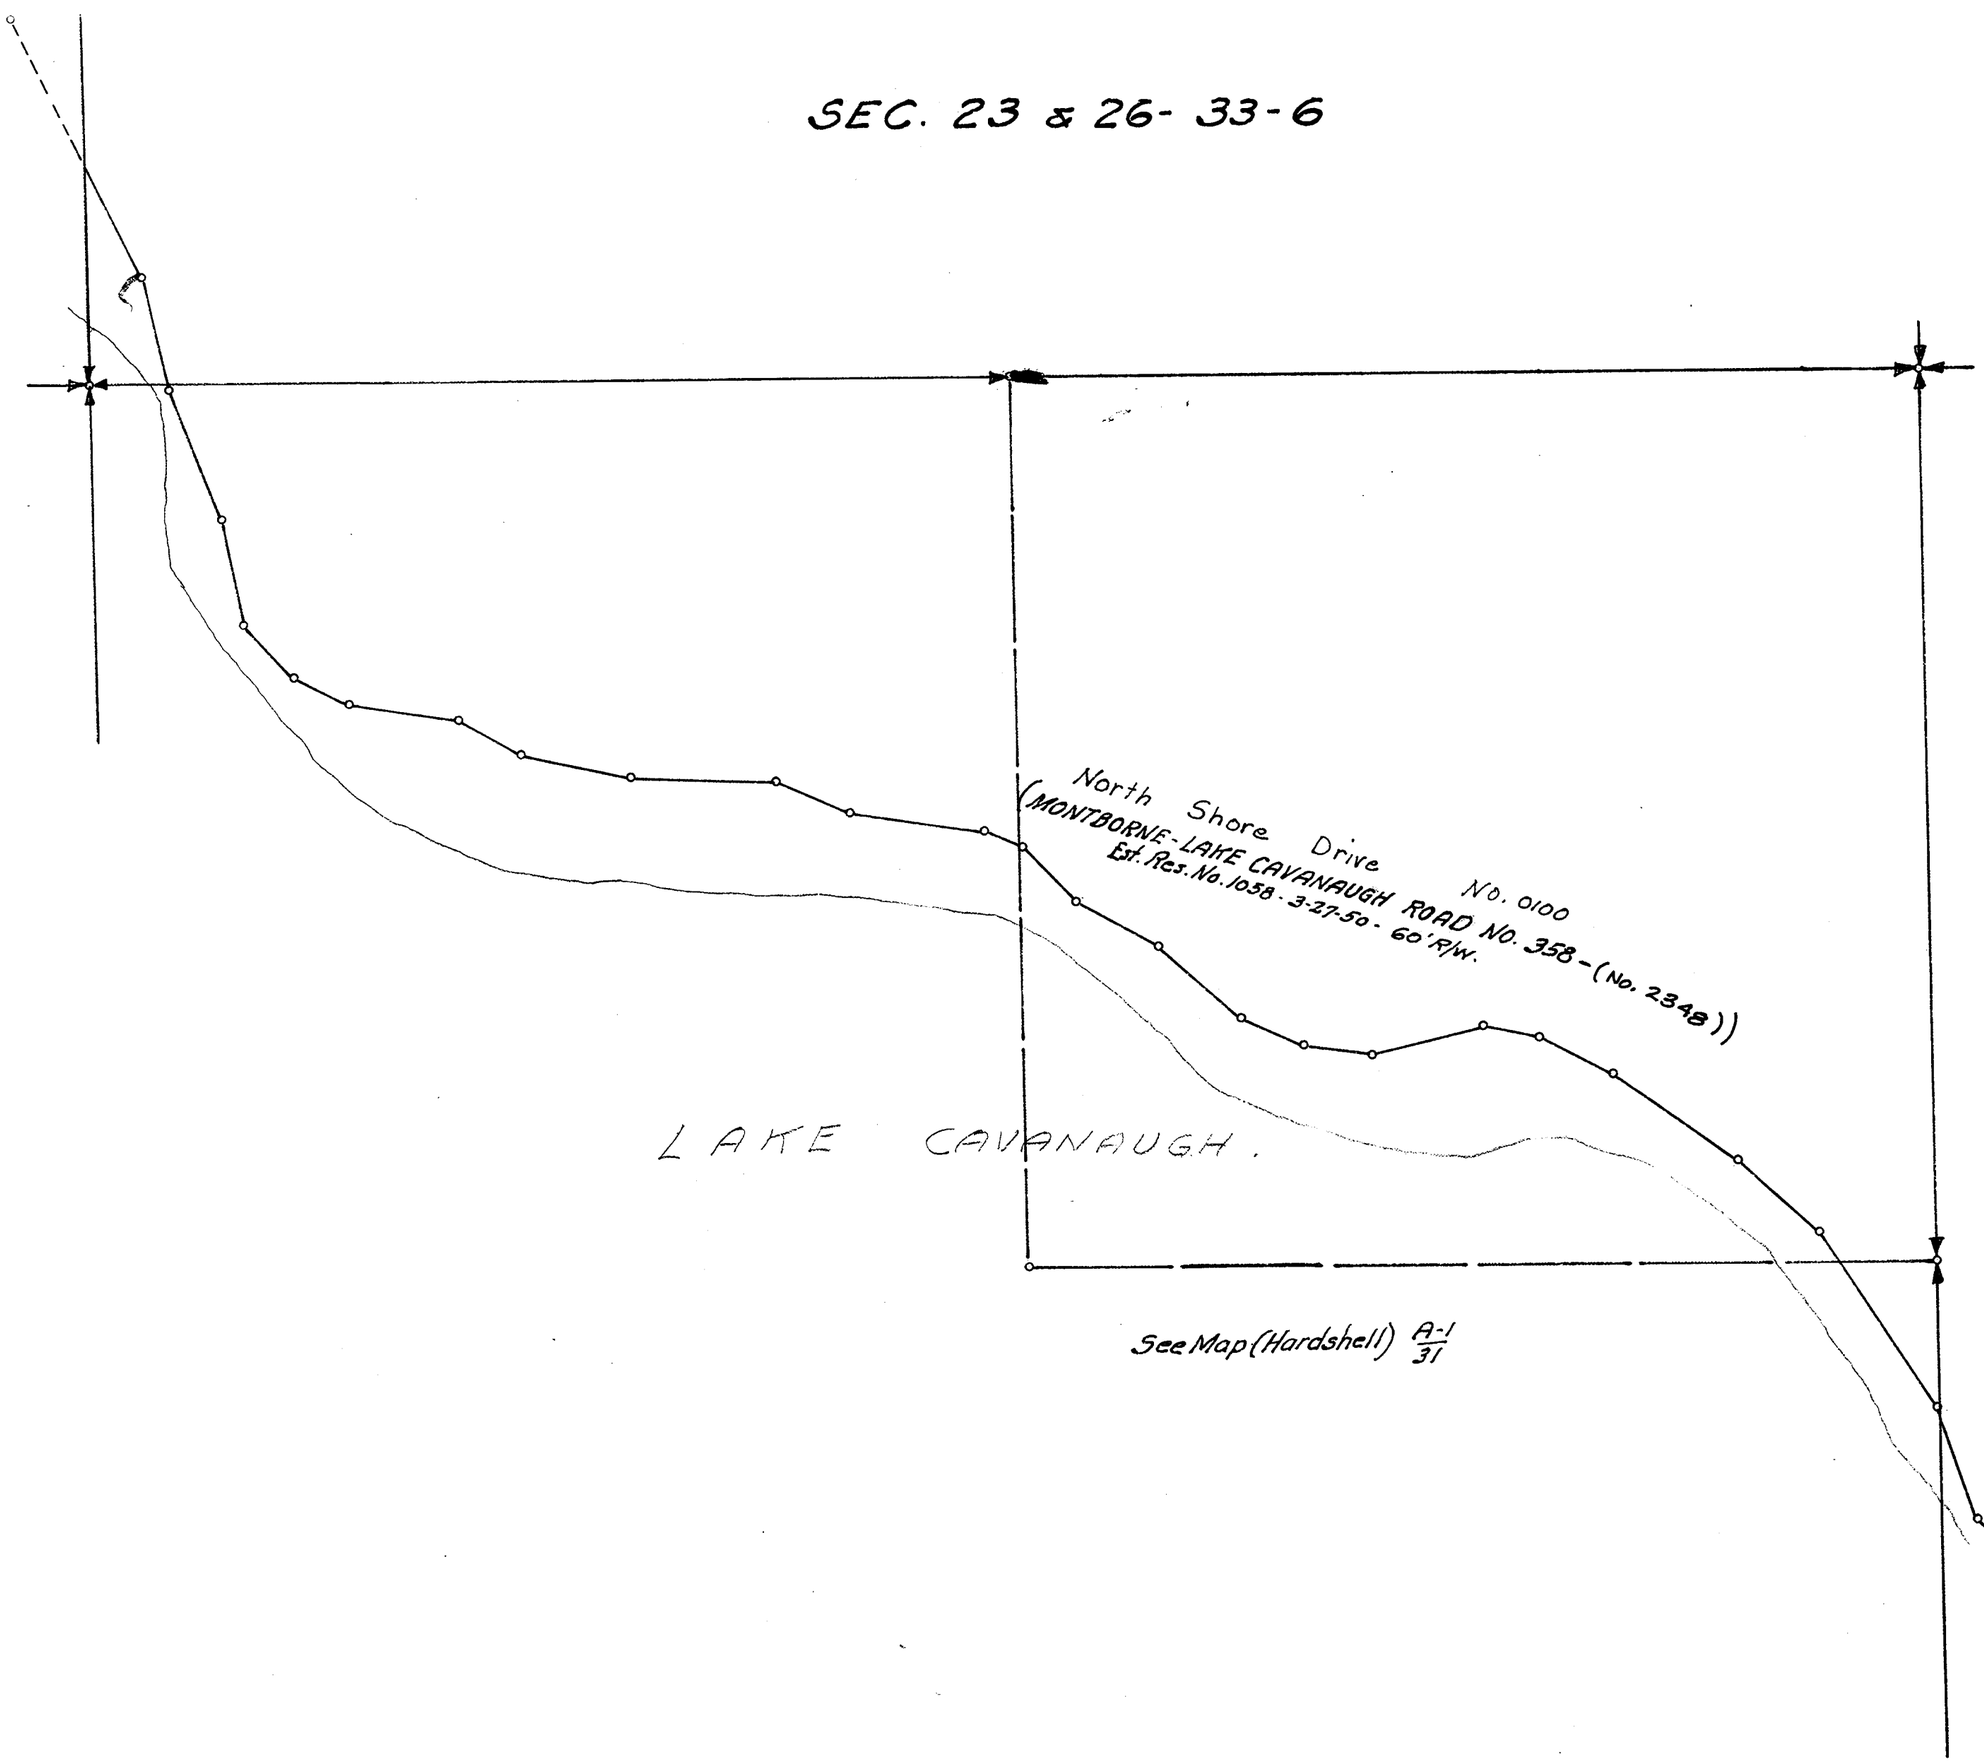

See Map (Hardshell) A-1/31

SKAGIT COUNTY, WASH.
OFFICE OF COUNTY ROAD ENGINEER

BRIDGE NO._____

LOCATION..... ROAD.....

JOB NO._____

DATE.....

.....
County Road Engineer

APPROVED..... 194....

.....
Chairman-Board of County Commissioners

SEC. 25-33-6

North Shore Drive No. 0100
(MONTBOURNE-LAKE CAVANAUGH ROAD NO.(358)-(2348)-0020)
Est. Res. No. 1058-3-27-50- 60' R/W.

LAKE CAVANAUGH

See Hardshell Map A-1/31

SKAGIT COUNTY, WASH.
OFFICE OF COUNTY ROAD ENGINEER

JOB NO._____

DATE_____ _____
County Road Engineer

APPROVED_____ 194____


_____
Chairman-Board of County Commissioners

SECTION 25
TOWNSHIP 33 NORTH, RANGE 6 EAST, W. M.
SKAGIT COUNTY, WASH.

SCALE 1 INCH... 400 FEET

DATE MAY 23, 1972

LLOYD H. JOHNSON COUNTY ENGINEER

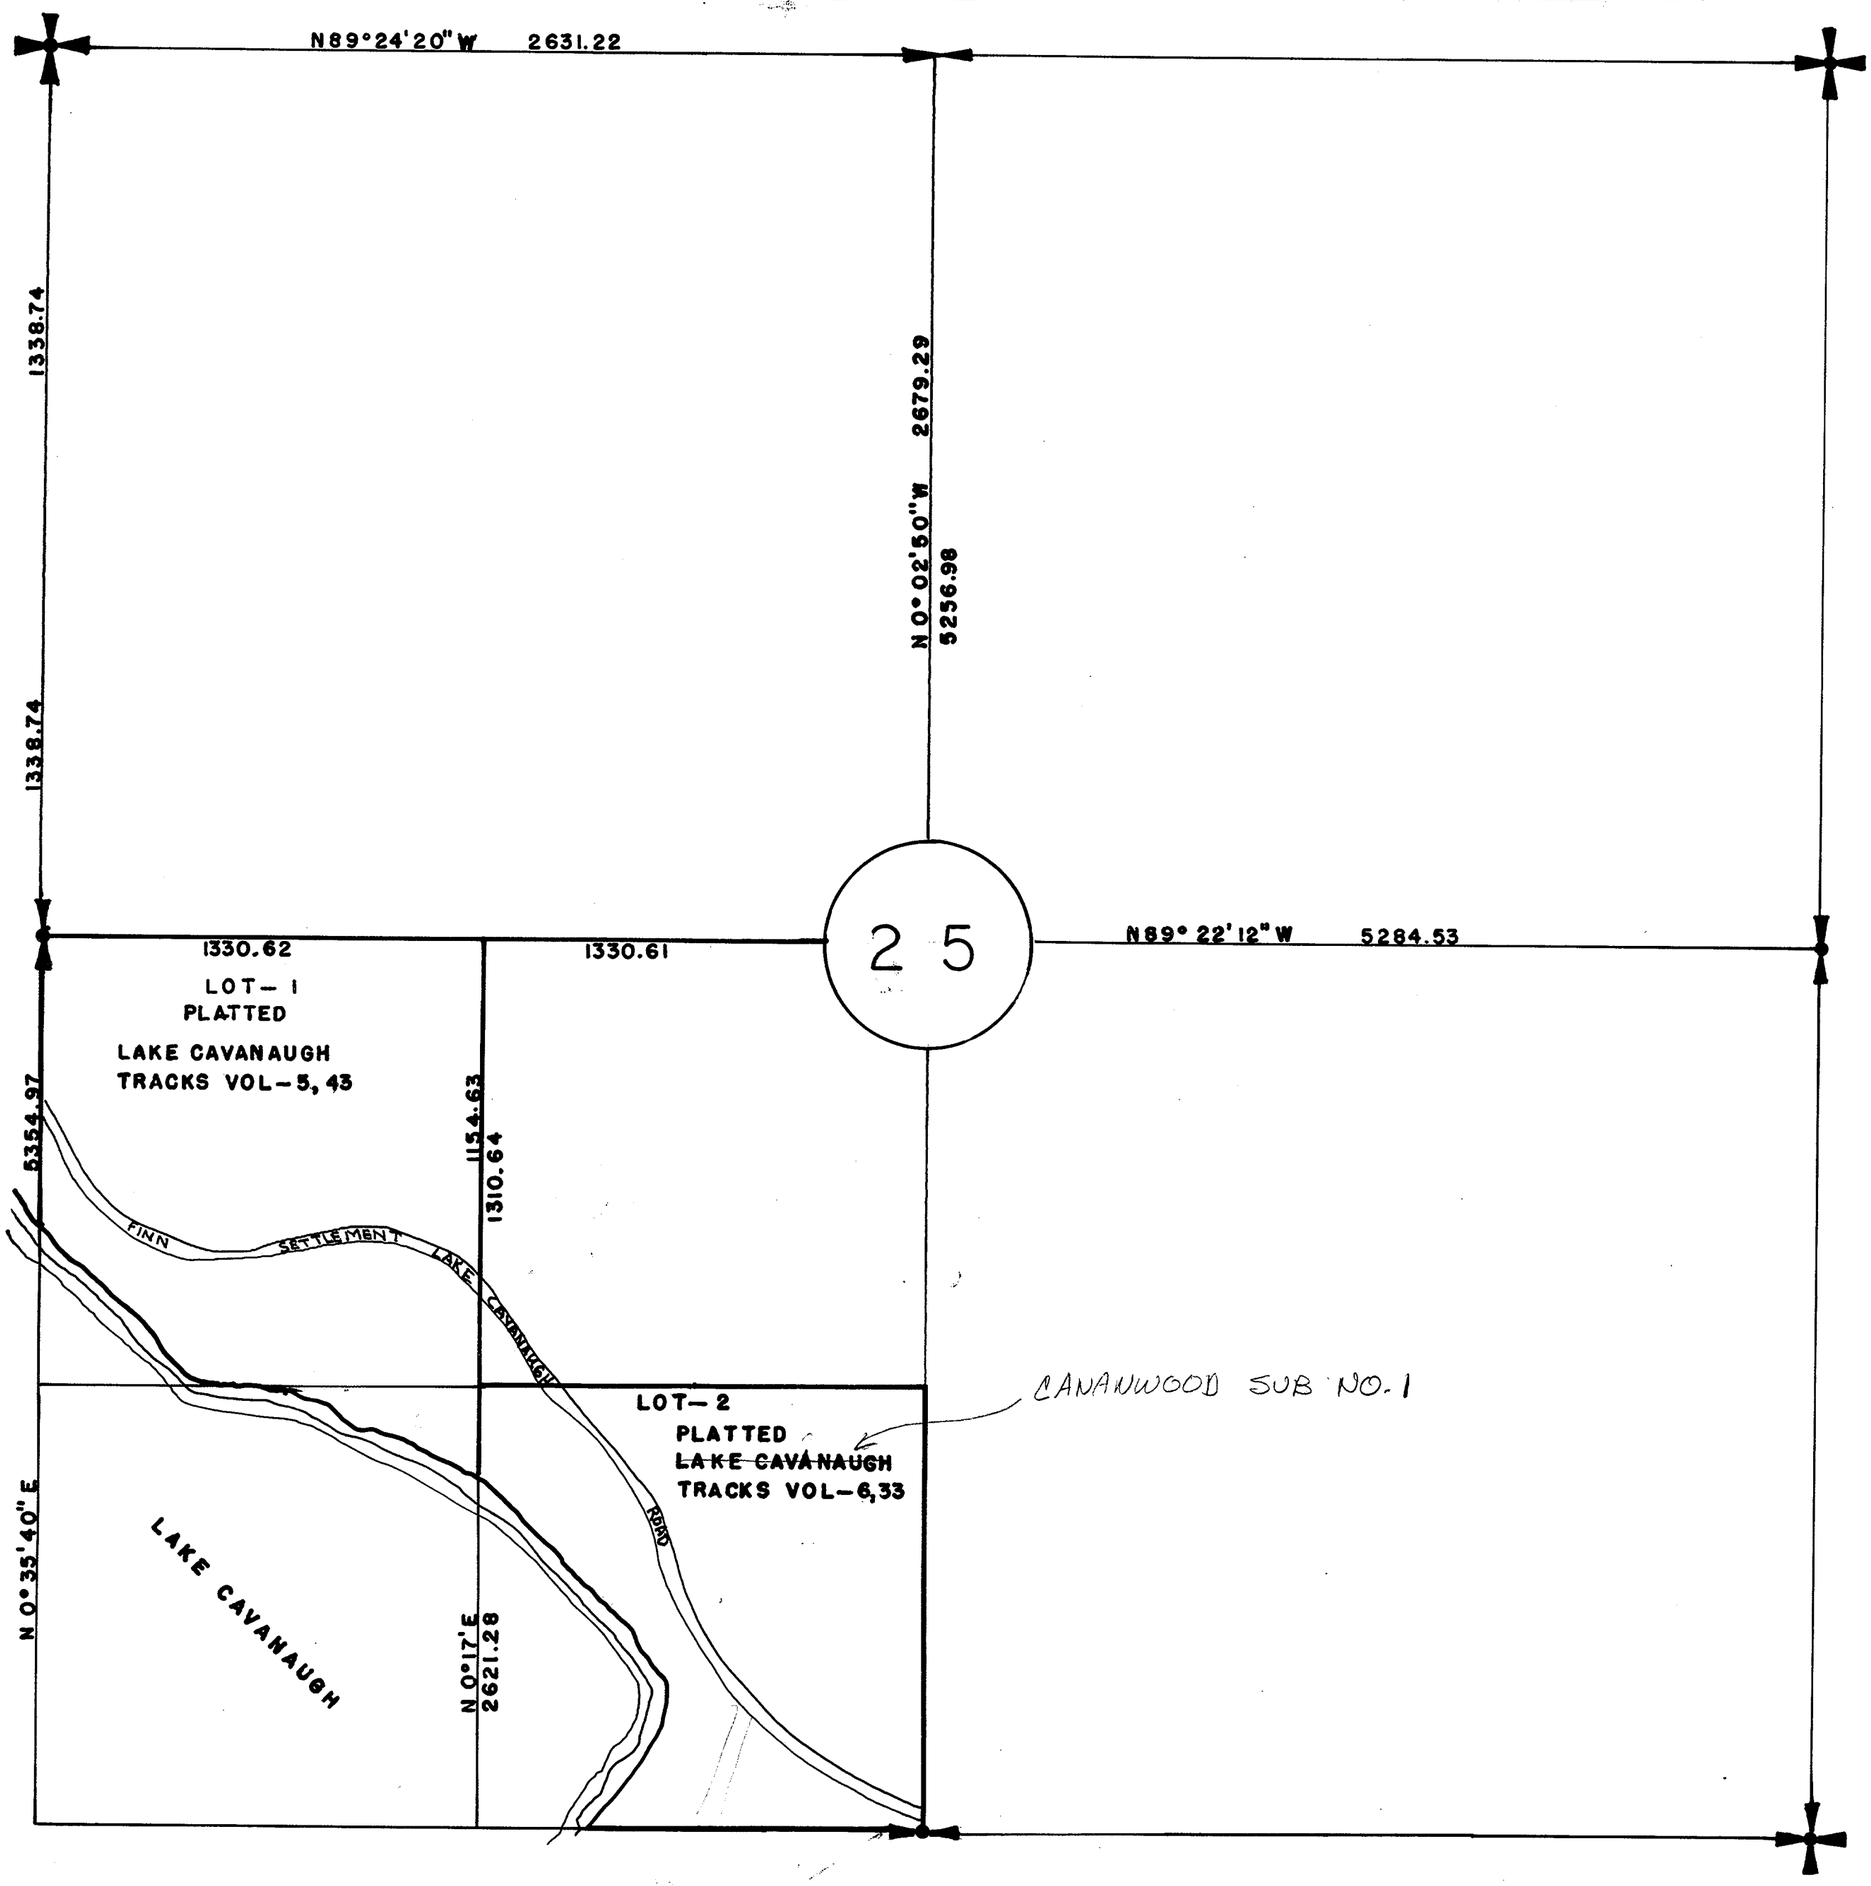

SECTION 26


TOWNSHIP 33 NORTH, RANGE 6 EAST, W. M.

SKAGIT COUNTY, WASH.

SCALE, 1 INCH--400 FEET

DATE August 1968

Lloyd Johnson COUNTY ENGINEER

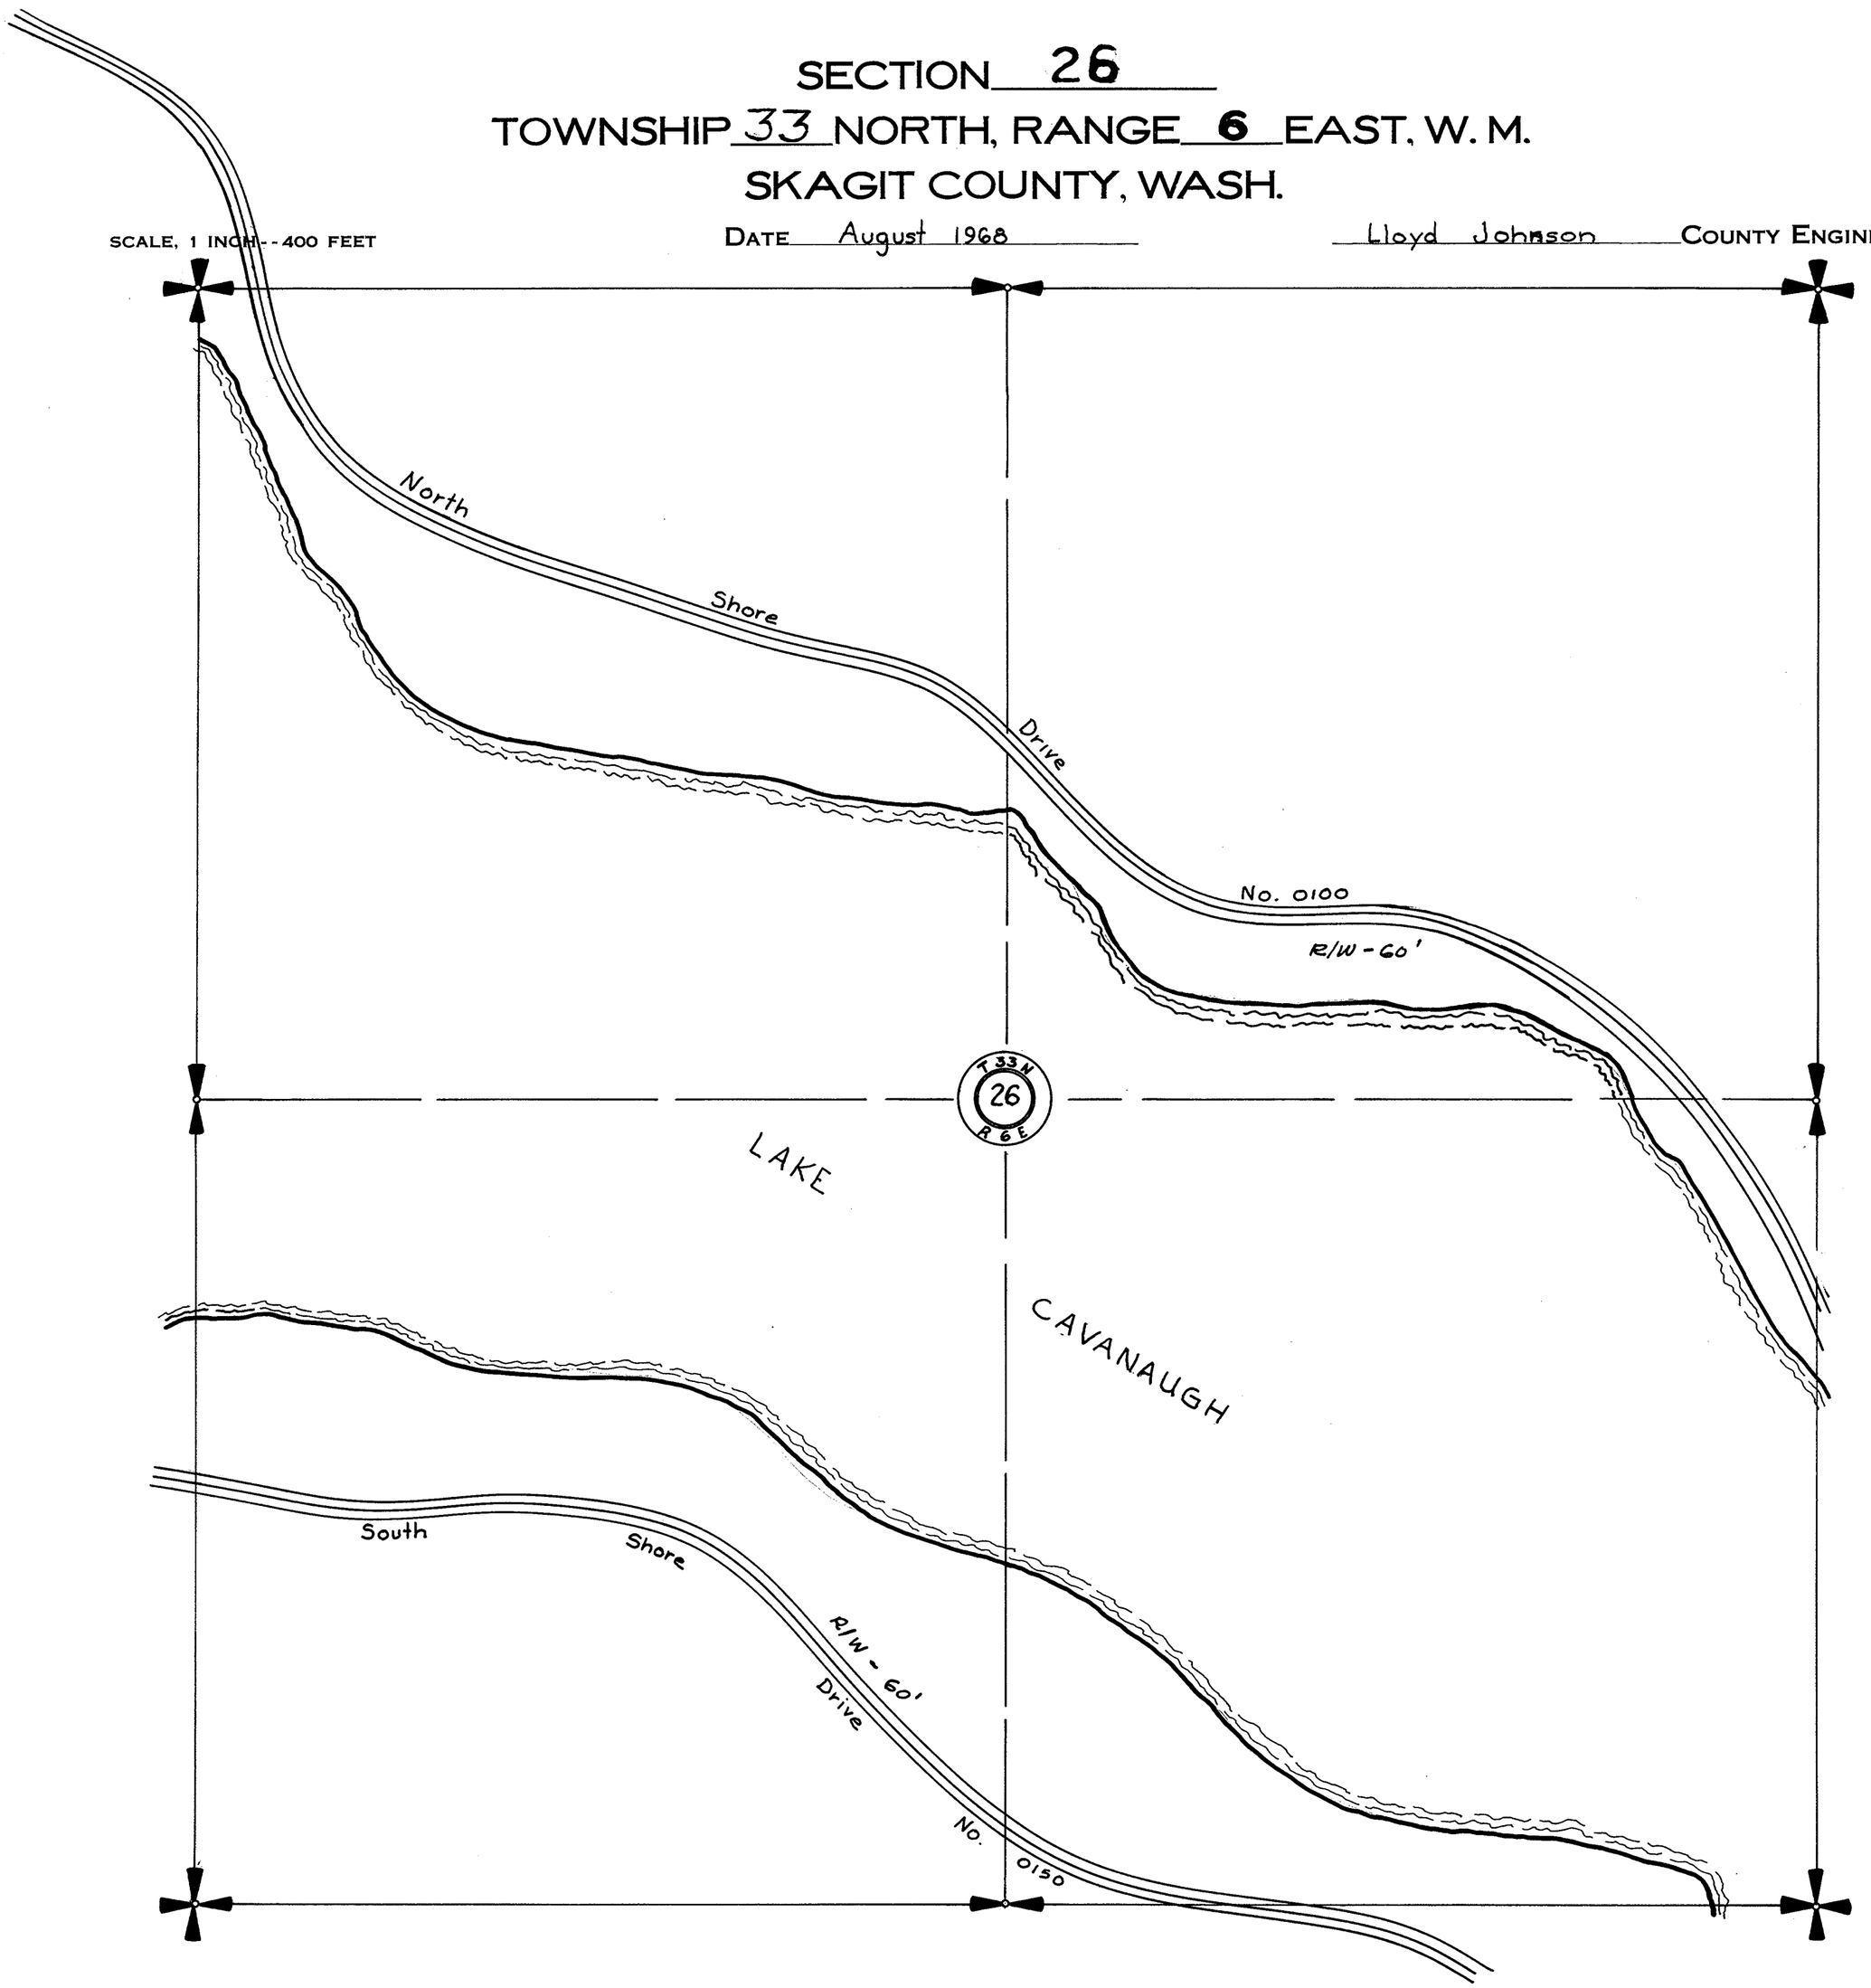


SUB. DIV. by HOWARD F. SIEVERS

SECTION 26
TOWNSHIP 33 NORTH, RANGE 6 EAST, W. M.
SKAGIT COUNTY, WASH.

SCALE 1 INCH ... 400 FEET

DATE MAY 23, 1972

LLOYD H. JOHNSON COUNTY ENGINEER

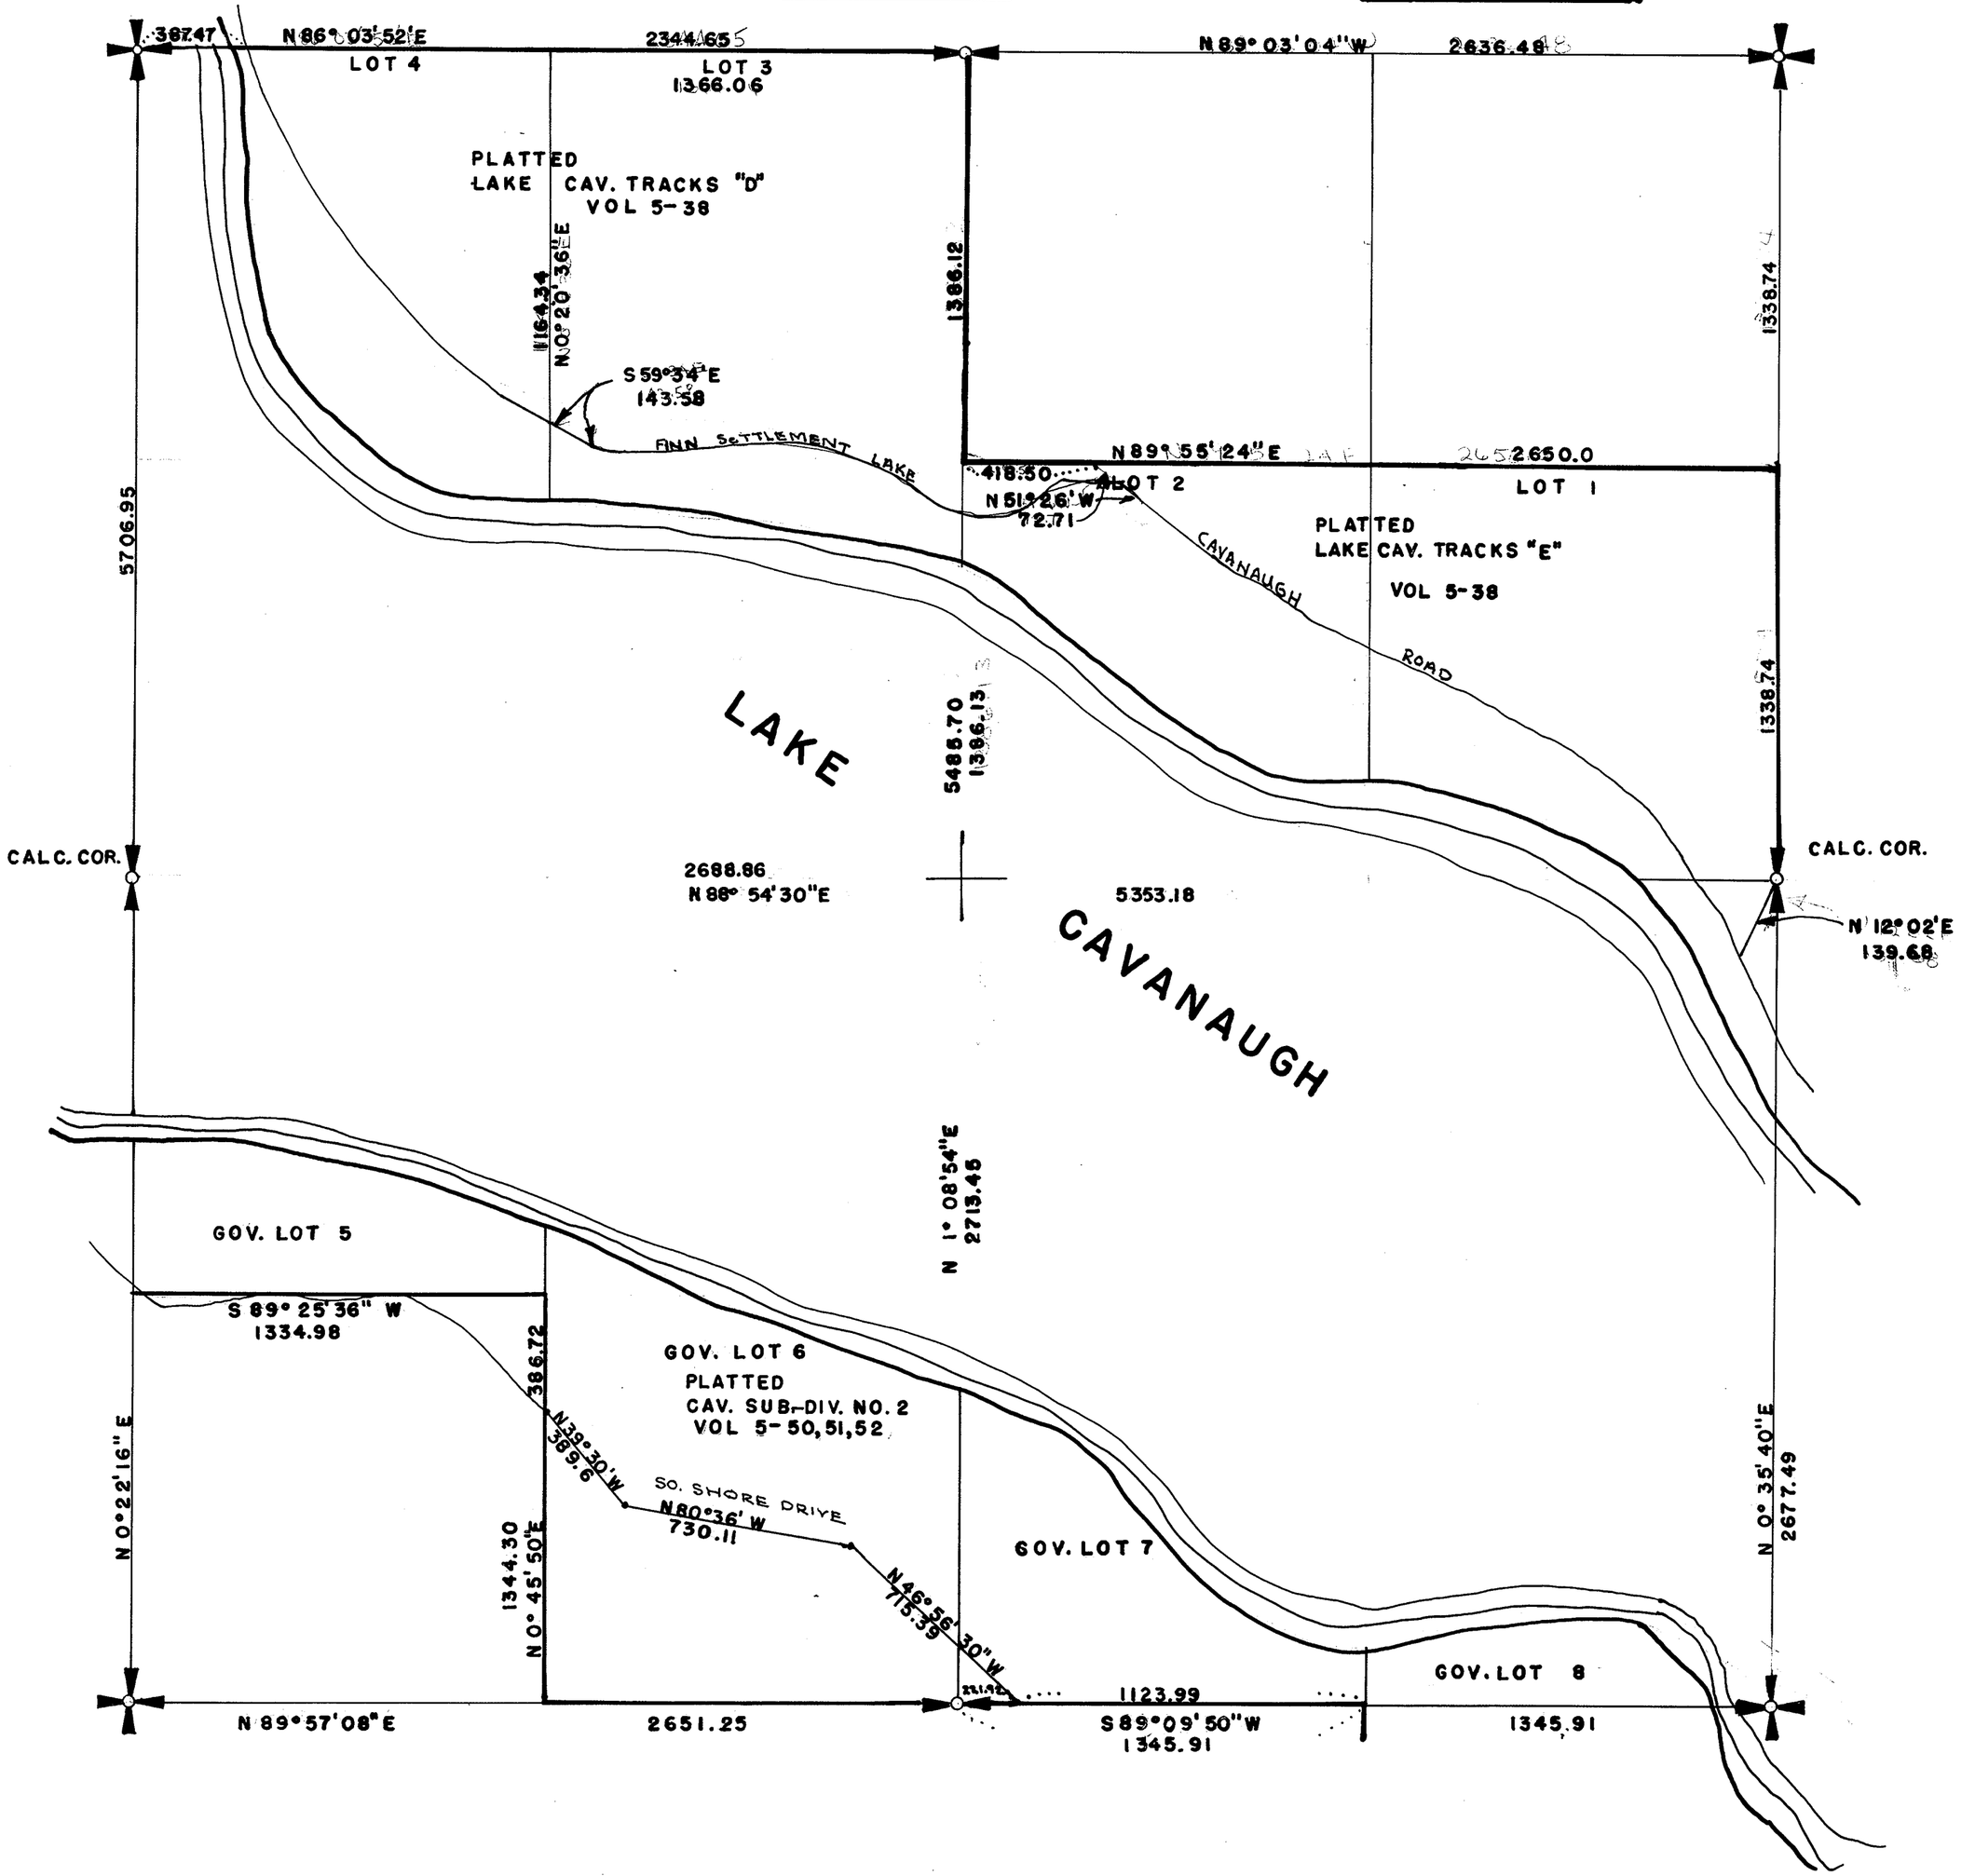


SUB. DIV. by Howard F. SIEVERS 1949

SECTION 27
TOWNSHIP 33 NORTH, RANGE 6 EAST, W. M.
SKAGIT COUNTY, WASH.

SCALE 1 INCH = 400 FEET

DATE MAY 23, 1972

LLOYD H. JOHNSON COUNTY ENGINEER

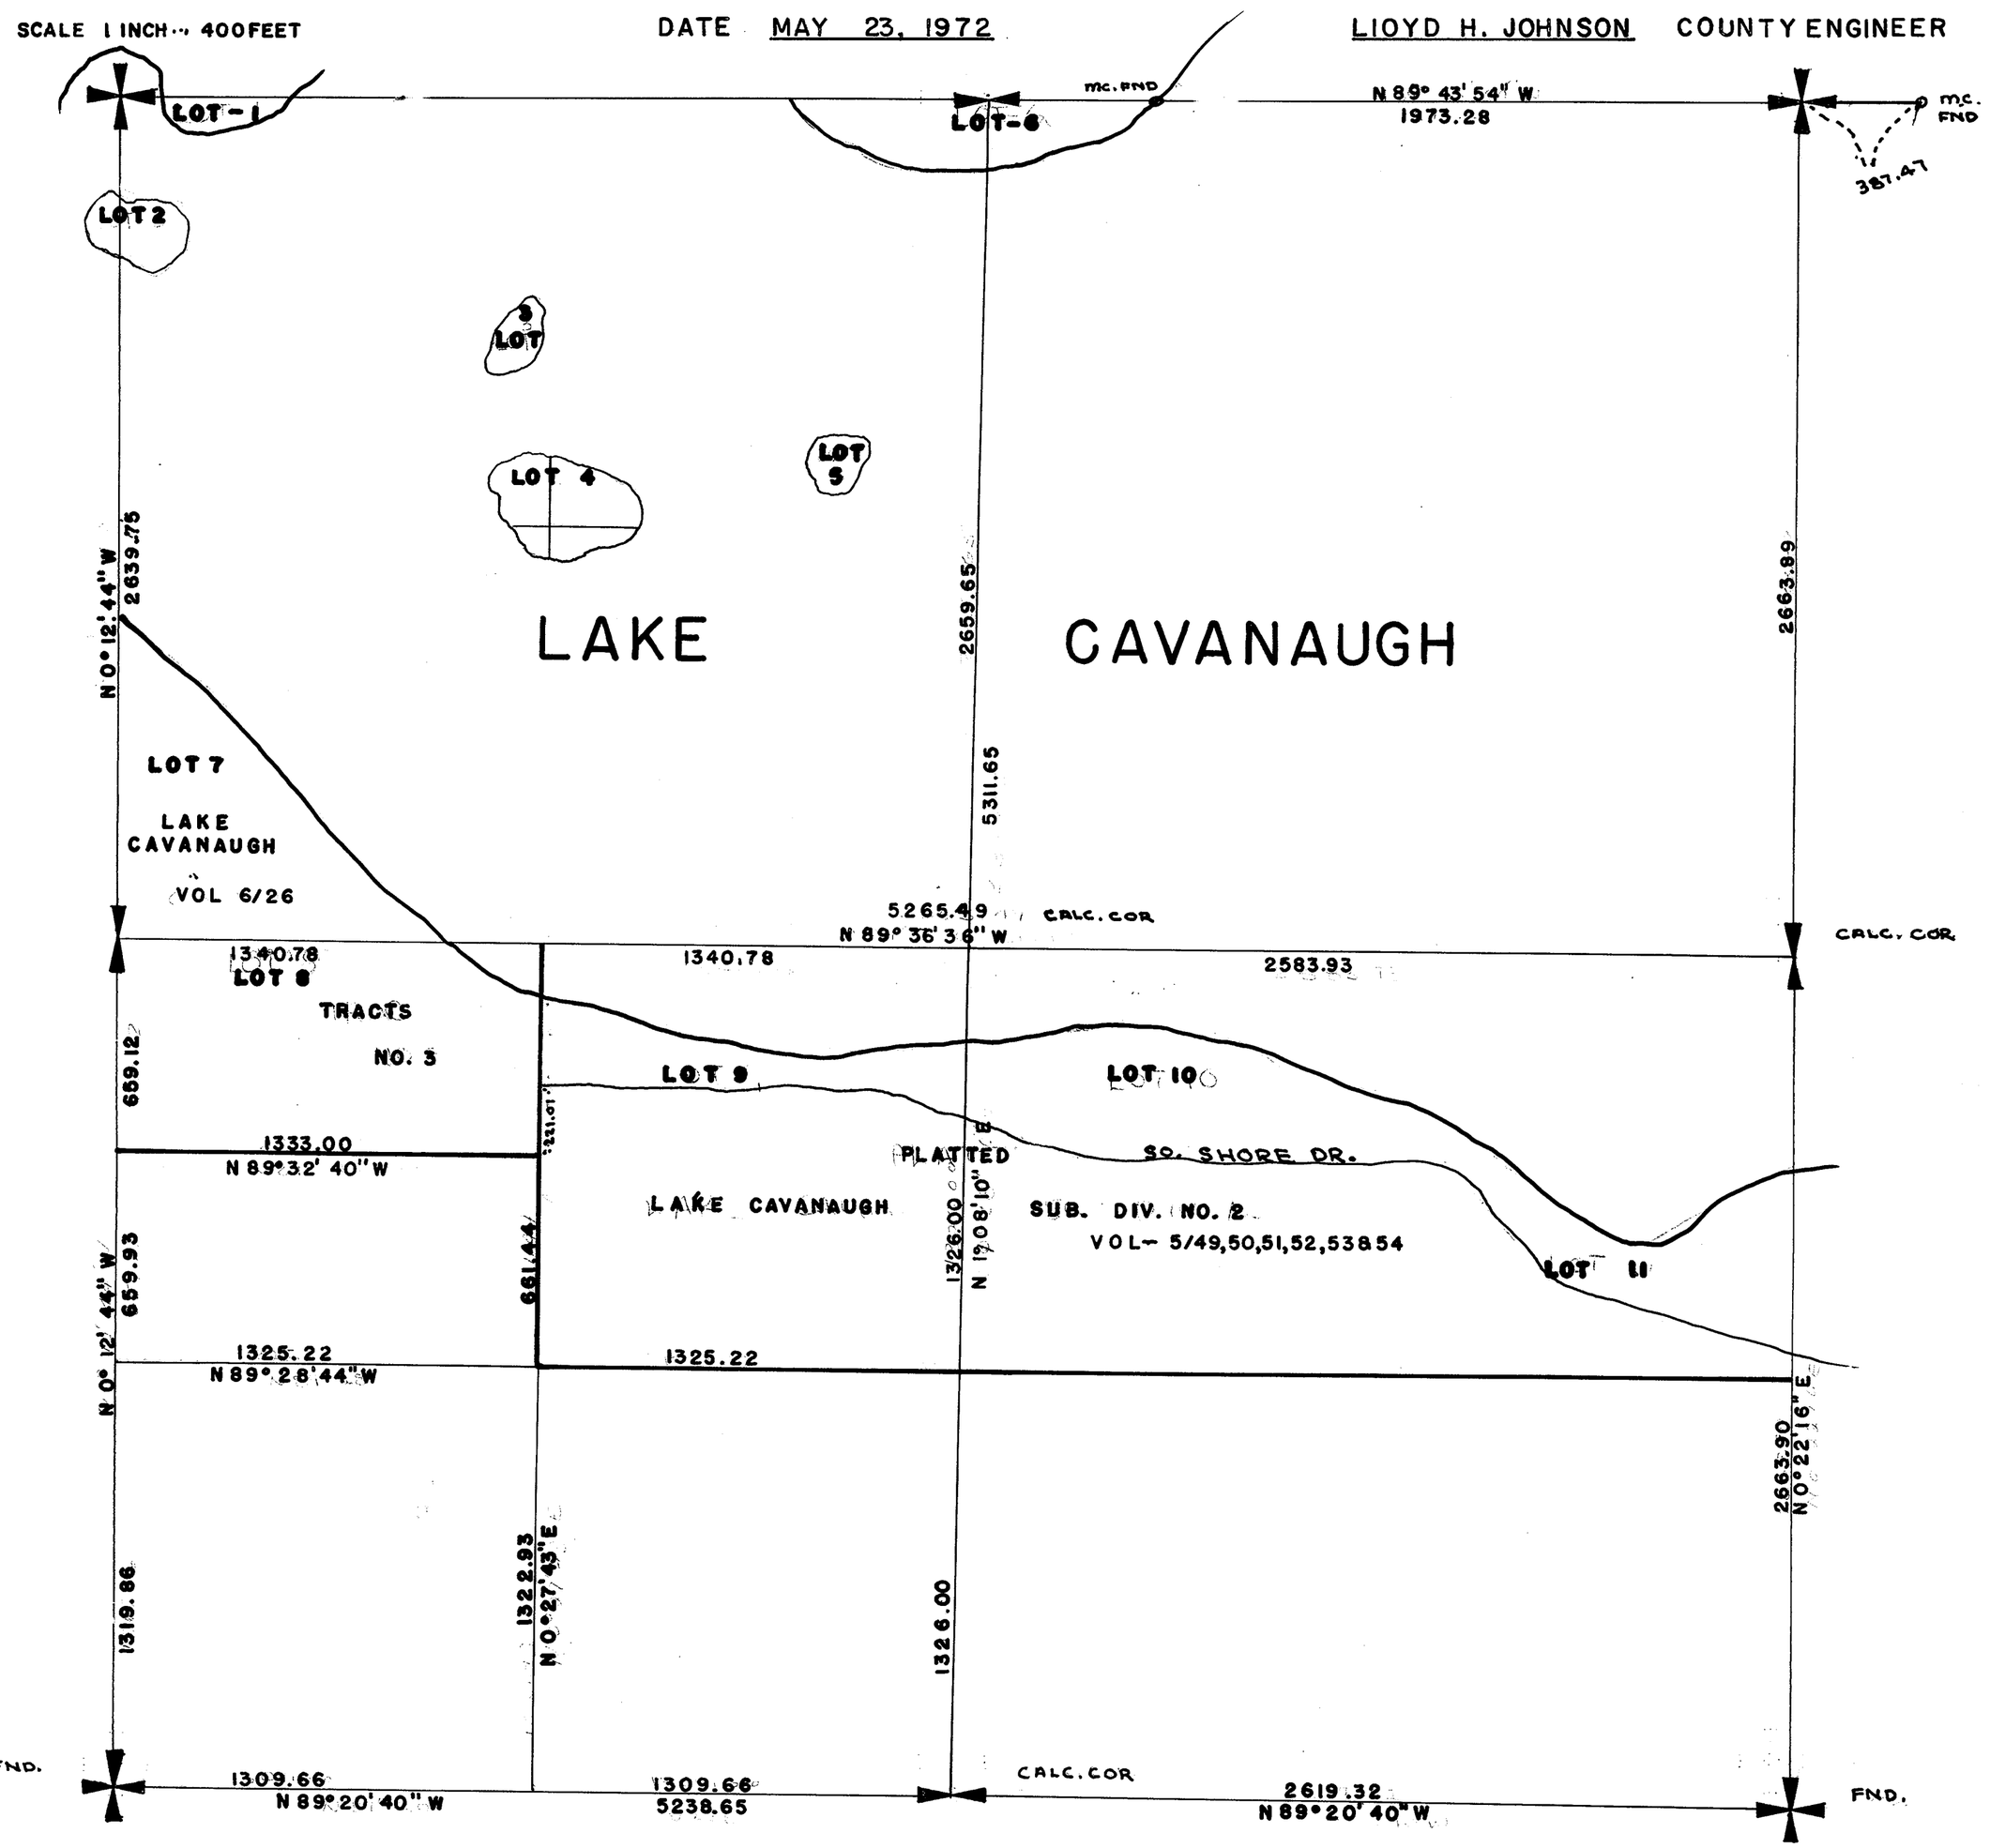


Sievers & Duecy
Sub. Div. 1948

SECTION 28
TOWNSHIP 33 NORTH, RANGE 6 EAST, W. M.
SKAGIT COUNTY, WASH.

SCALE 1 INCH 400 FEET


LLOYD H. JOHNSON COUNTY ENGINEER

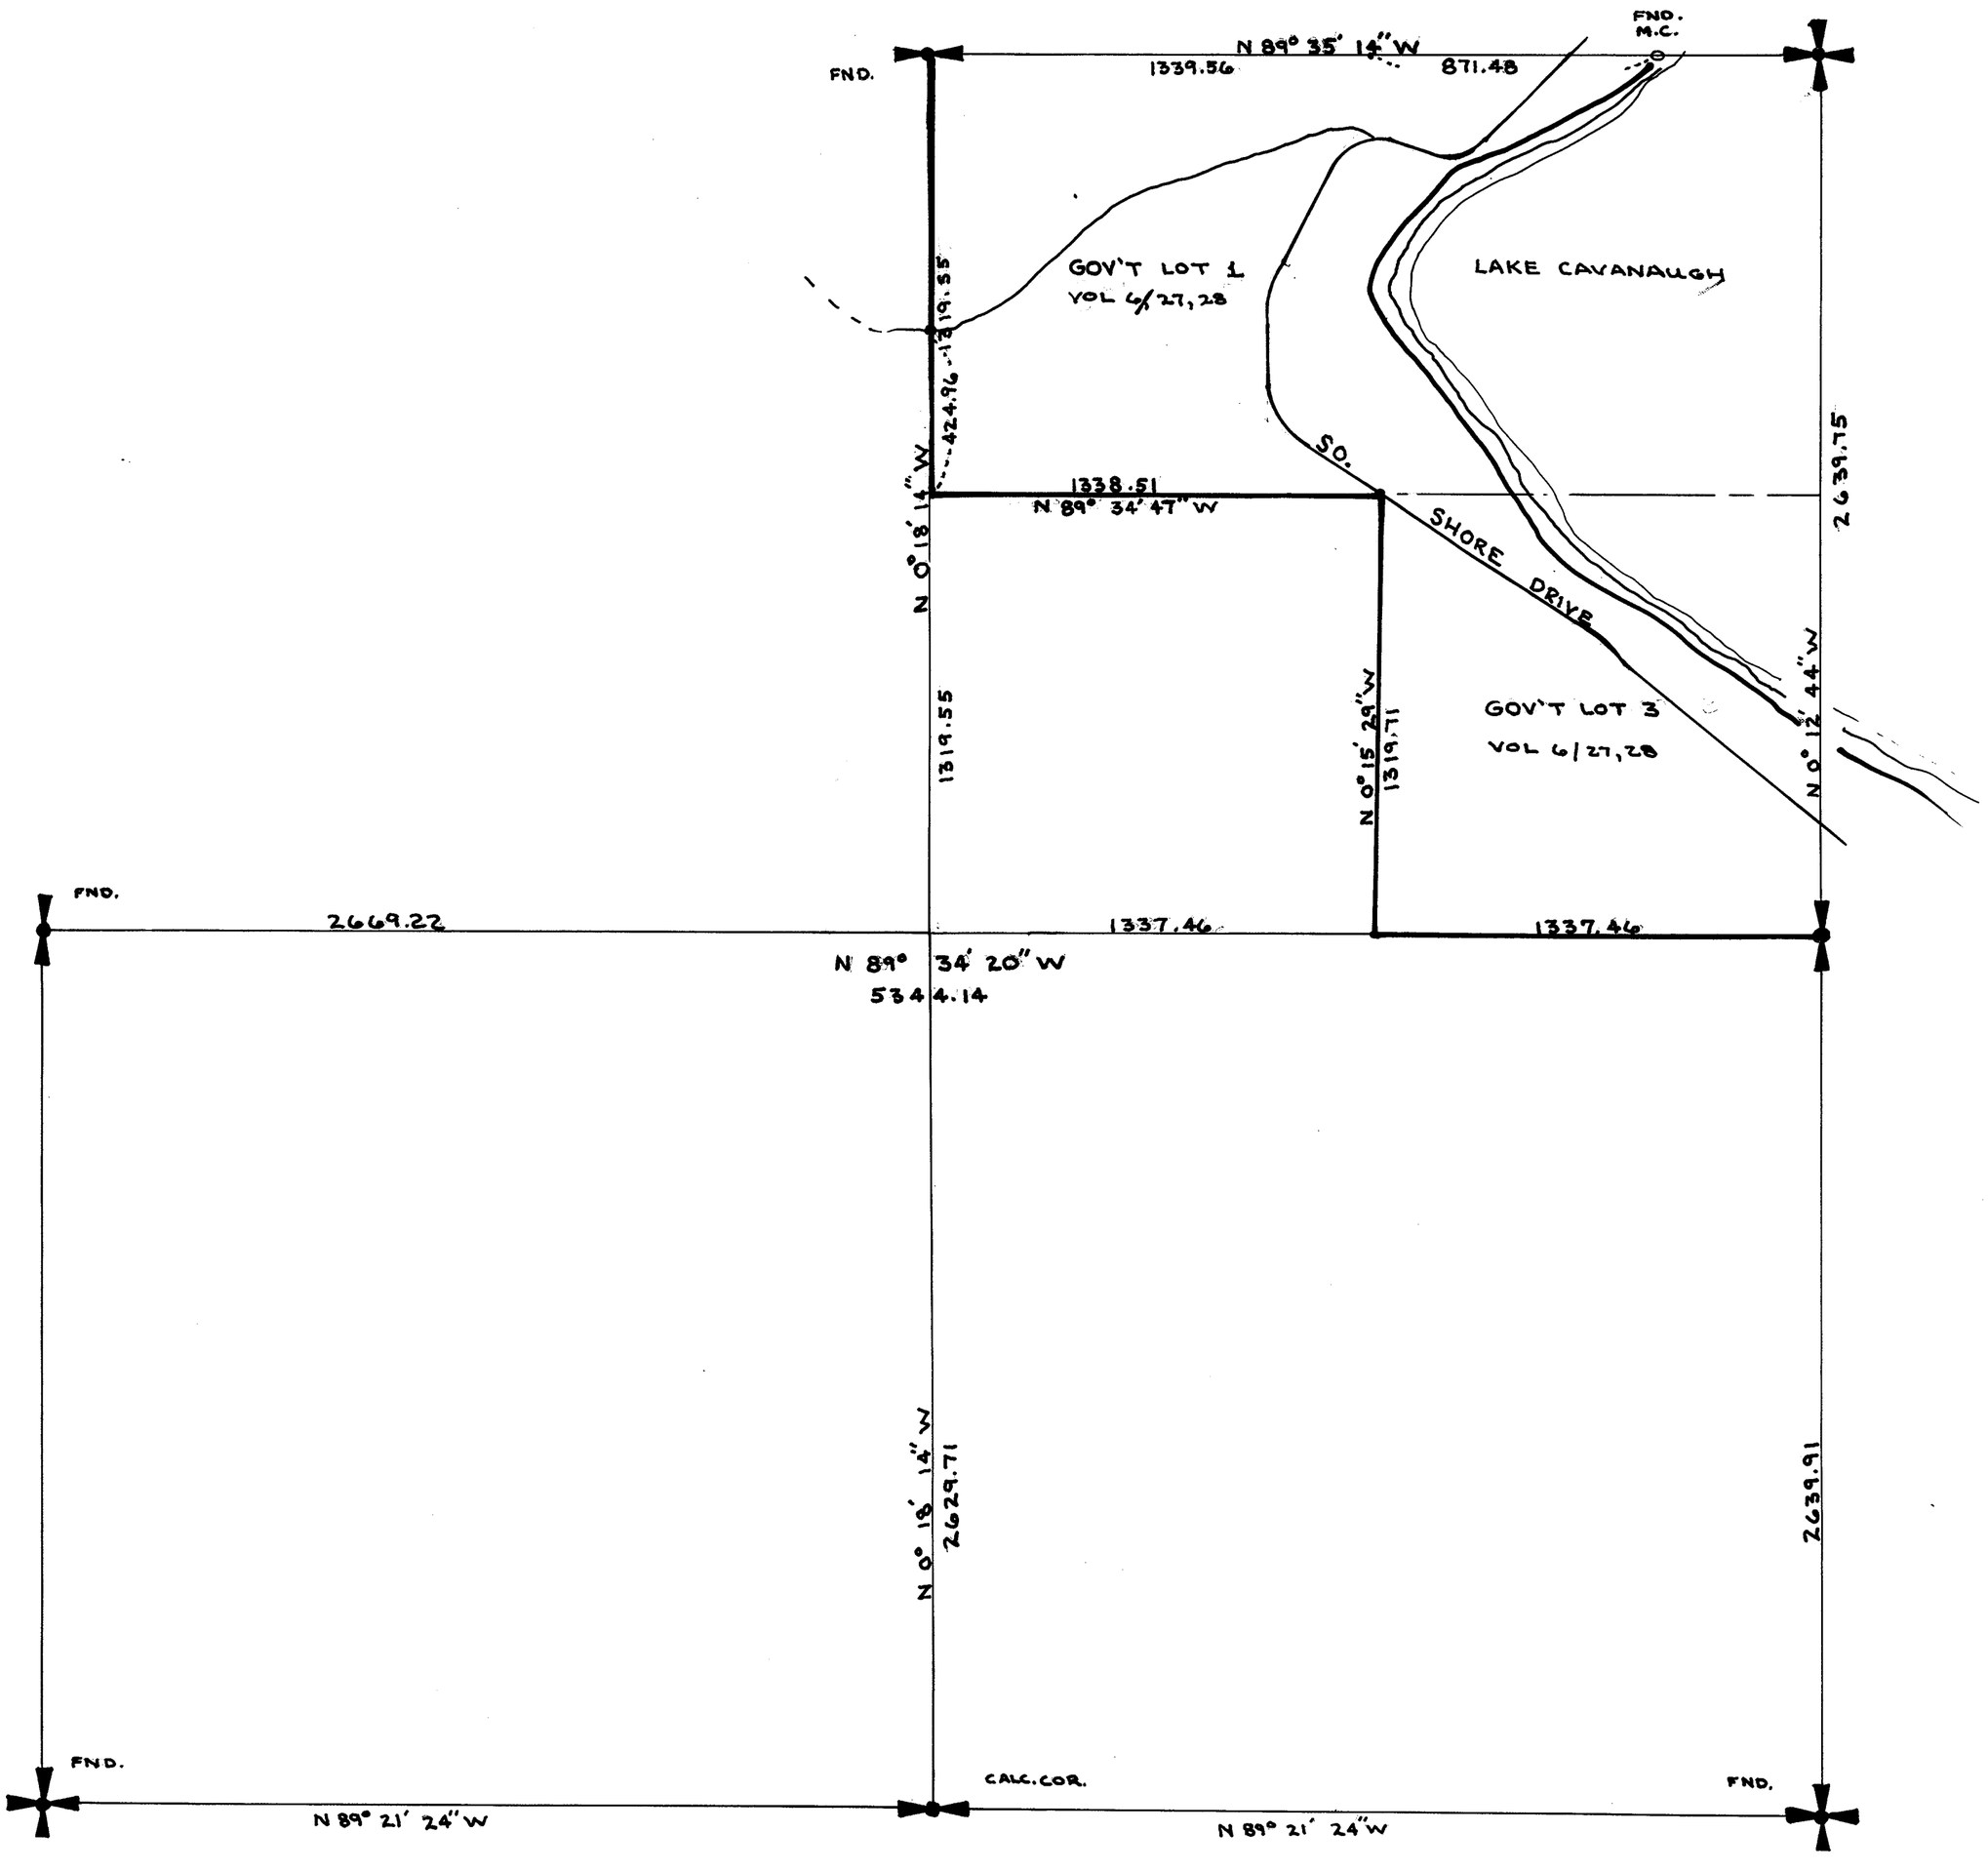

SECTION 28


TOWNSHIP 33 NORTH, RANGE 6 EAST, W. M.

SKAGIT COUNTY, WASH.

SCALE, 1 INCH--400 FEET

DATE Aug. 18, 1966

Lloyd Johnson COUNTY ENGINEER

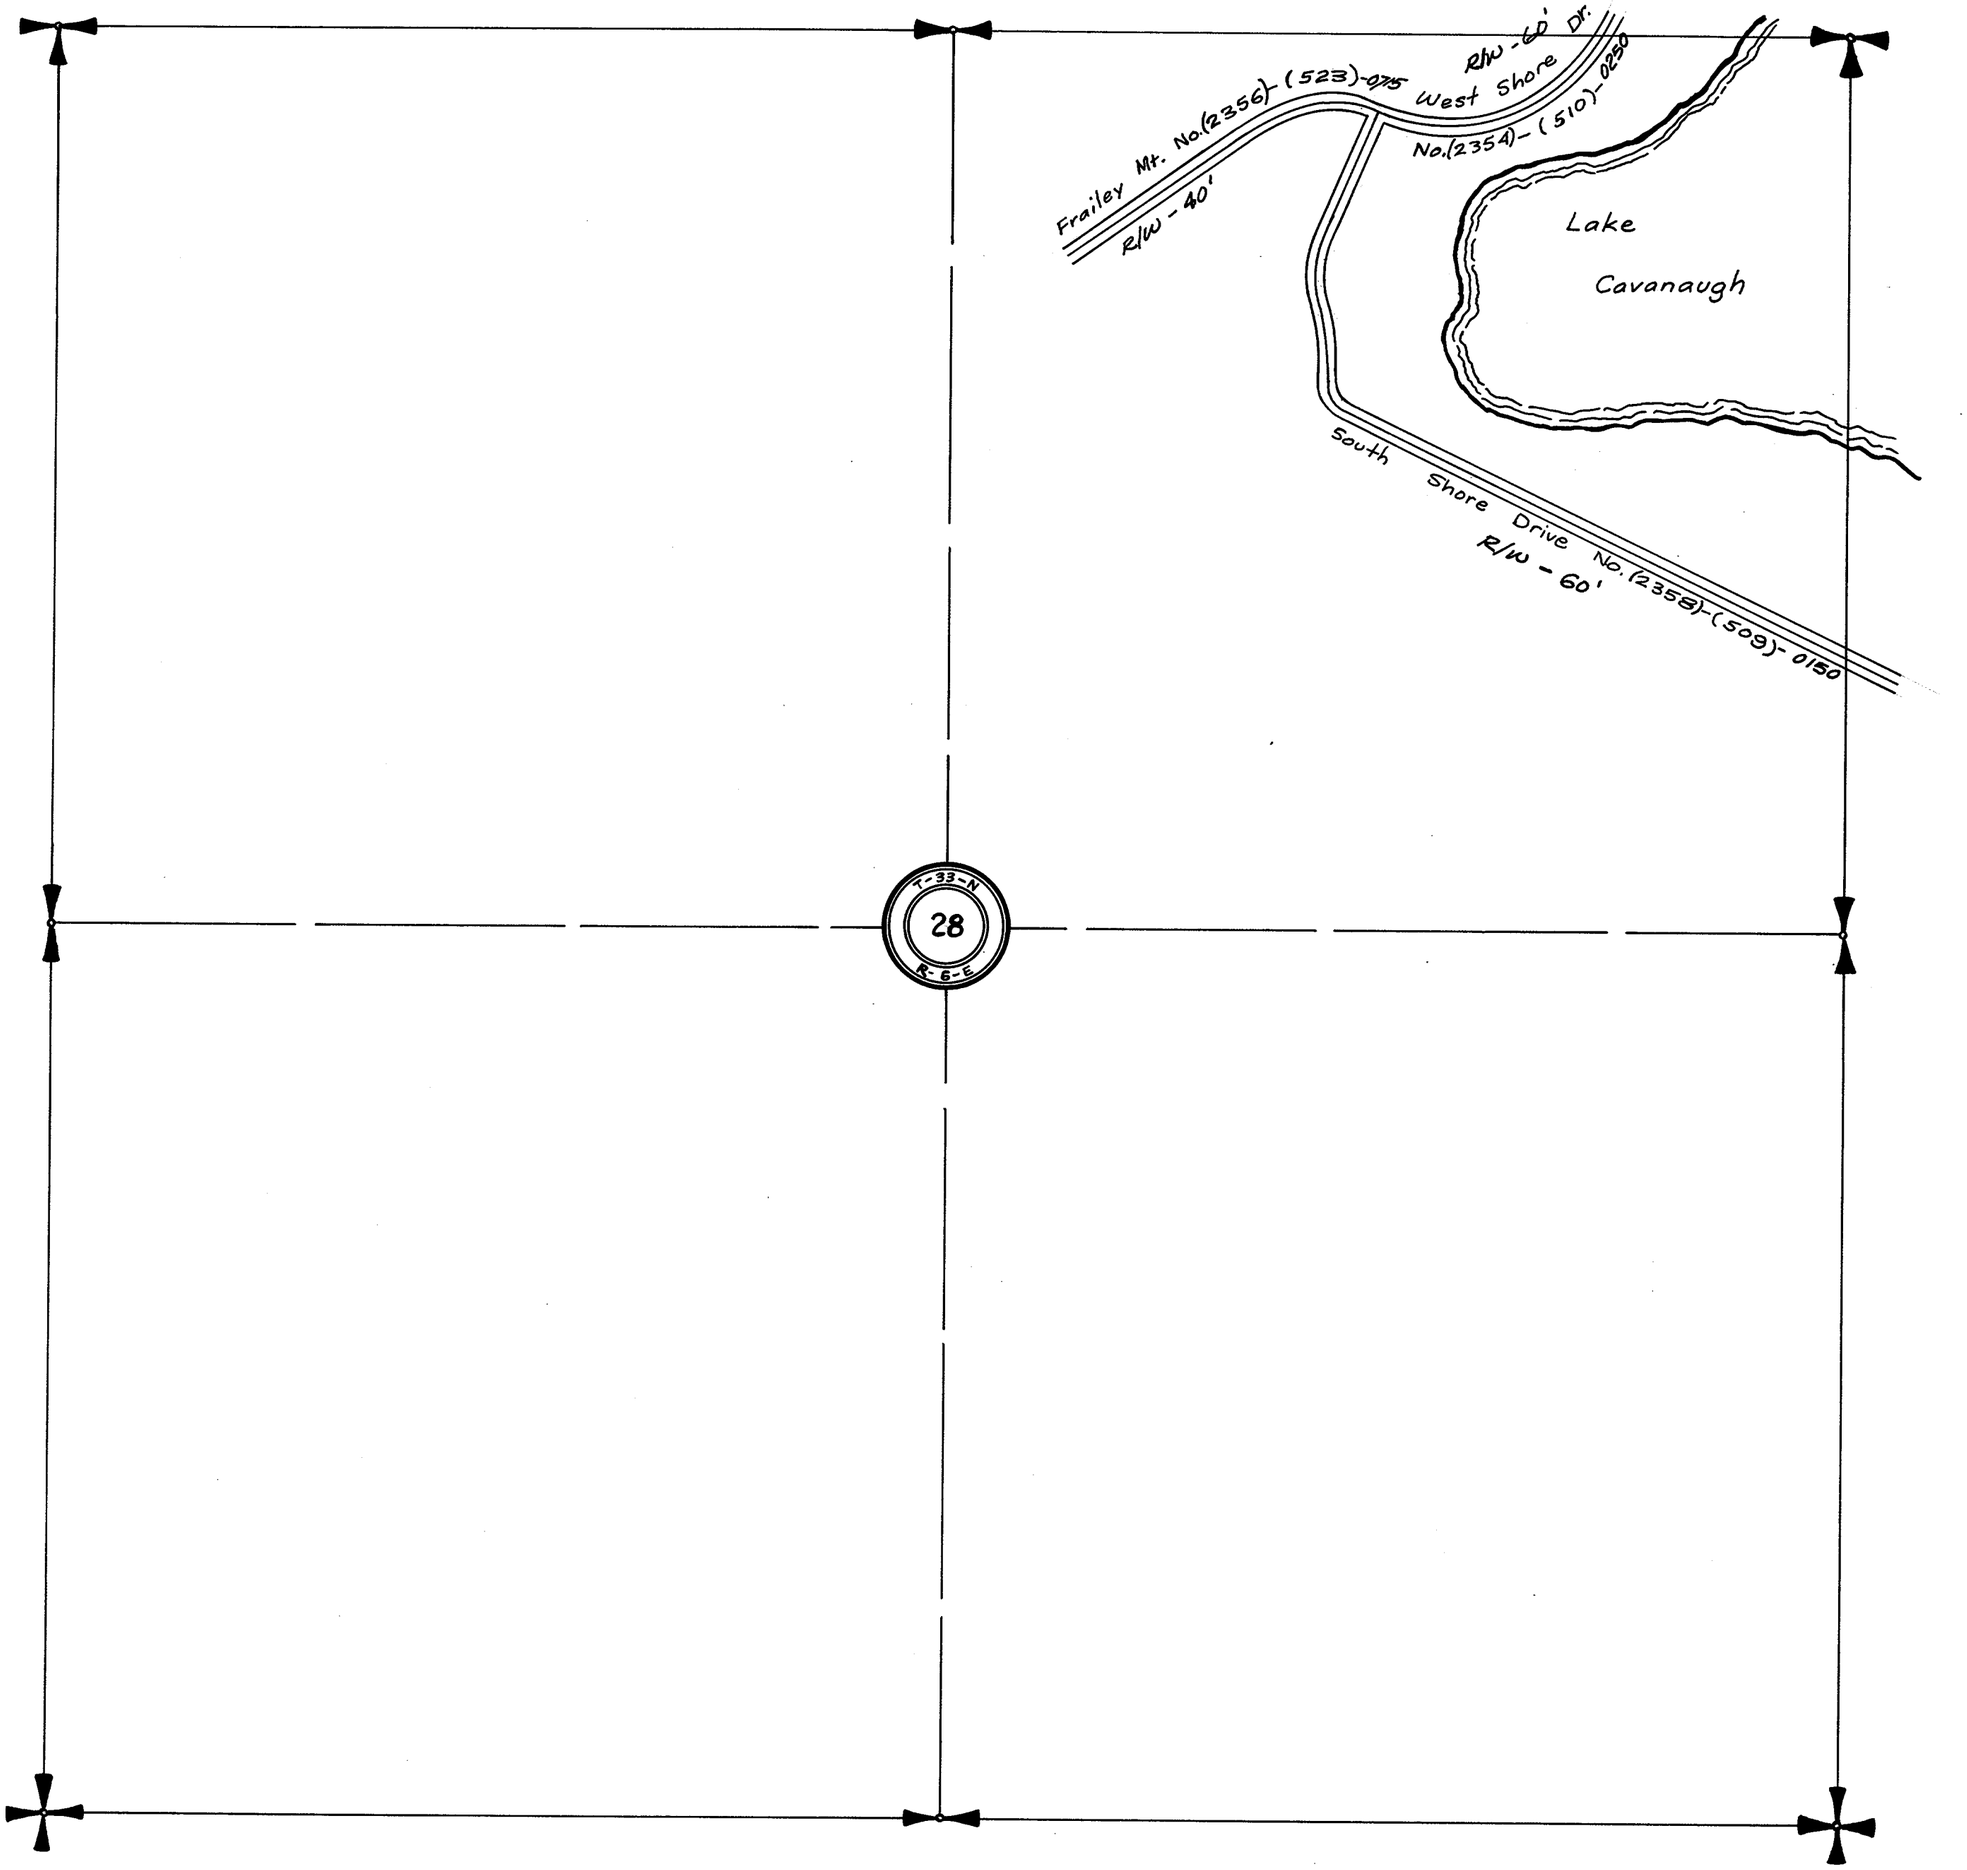


Sievers & Duecy
Sub Div 1946

SECTION 35
TOWNSHIP 33 NORTH, RANGE 6 EAST, W.M.
SKAGIT COUNTY, WASH.

SCALE 1 INCH 400 FEET

DATE MAY 30, 1972

LLOYD H. JOHNSON COUNTY ENGINEER

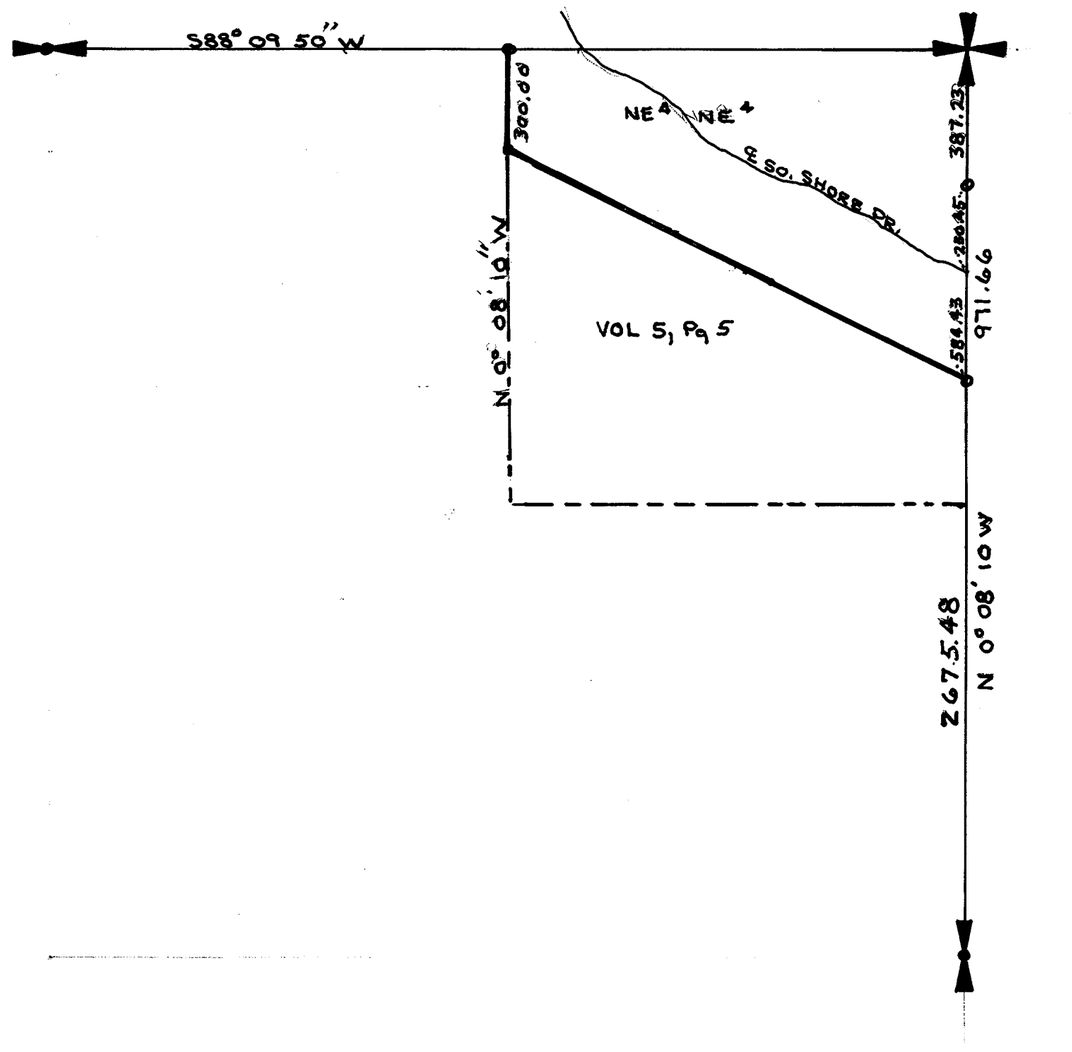


SECTION 36

TOWNSHIP 33 NORTH, RANGE 6 EAST, W. M.

SKAGIT COUNTY, WASH.

SCALE, 1 INCH--400 FEET

_____ COUNTY ENGINEER

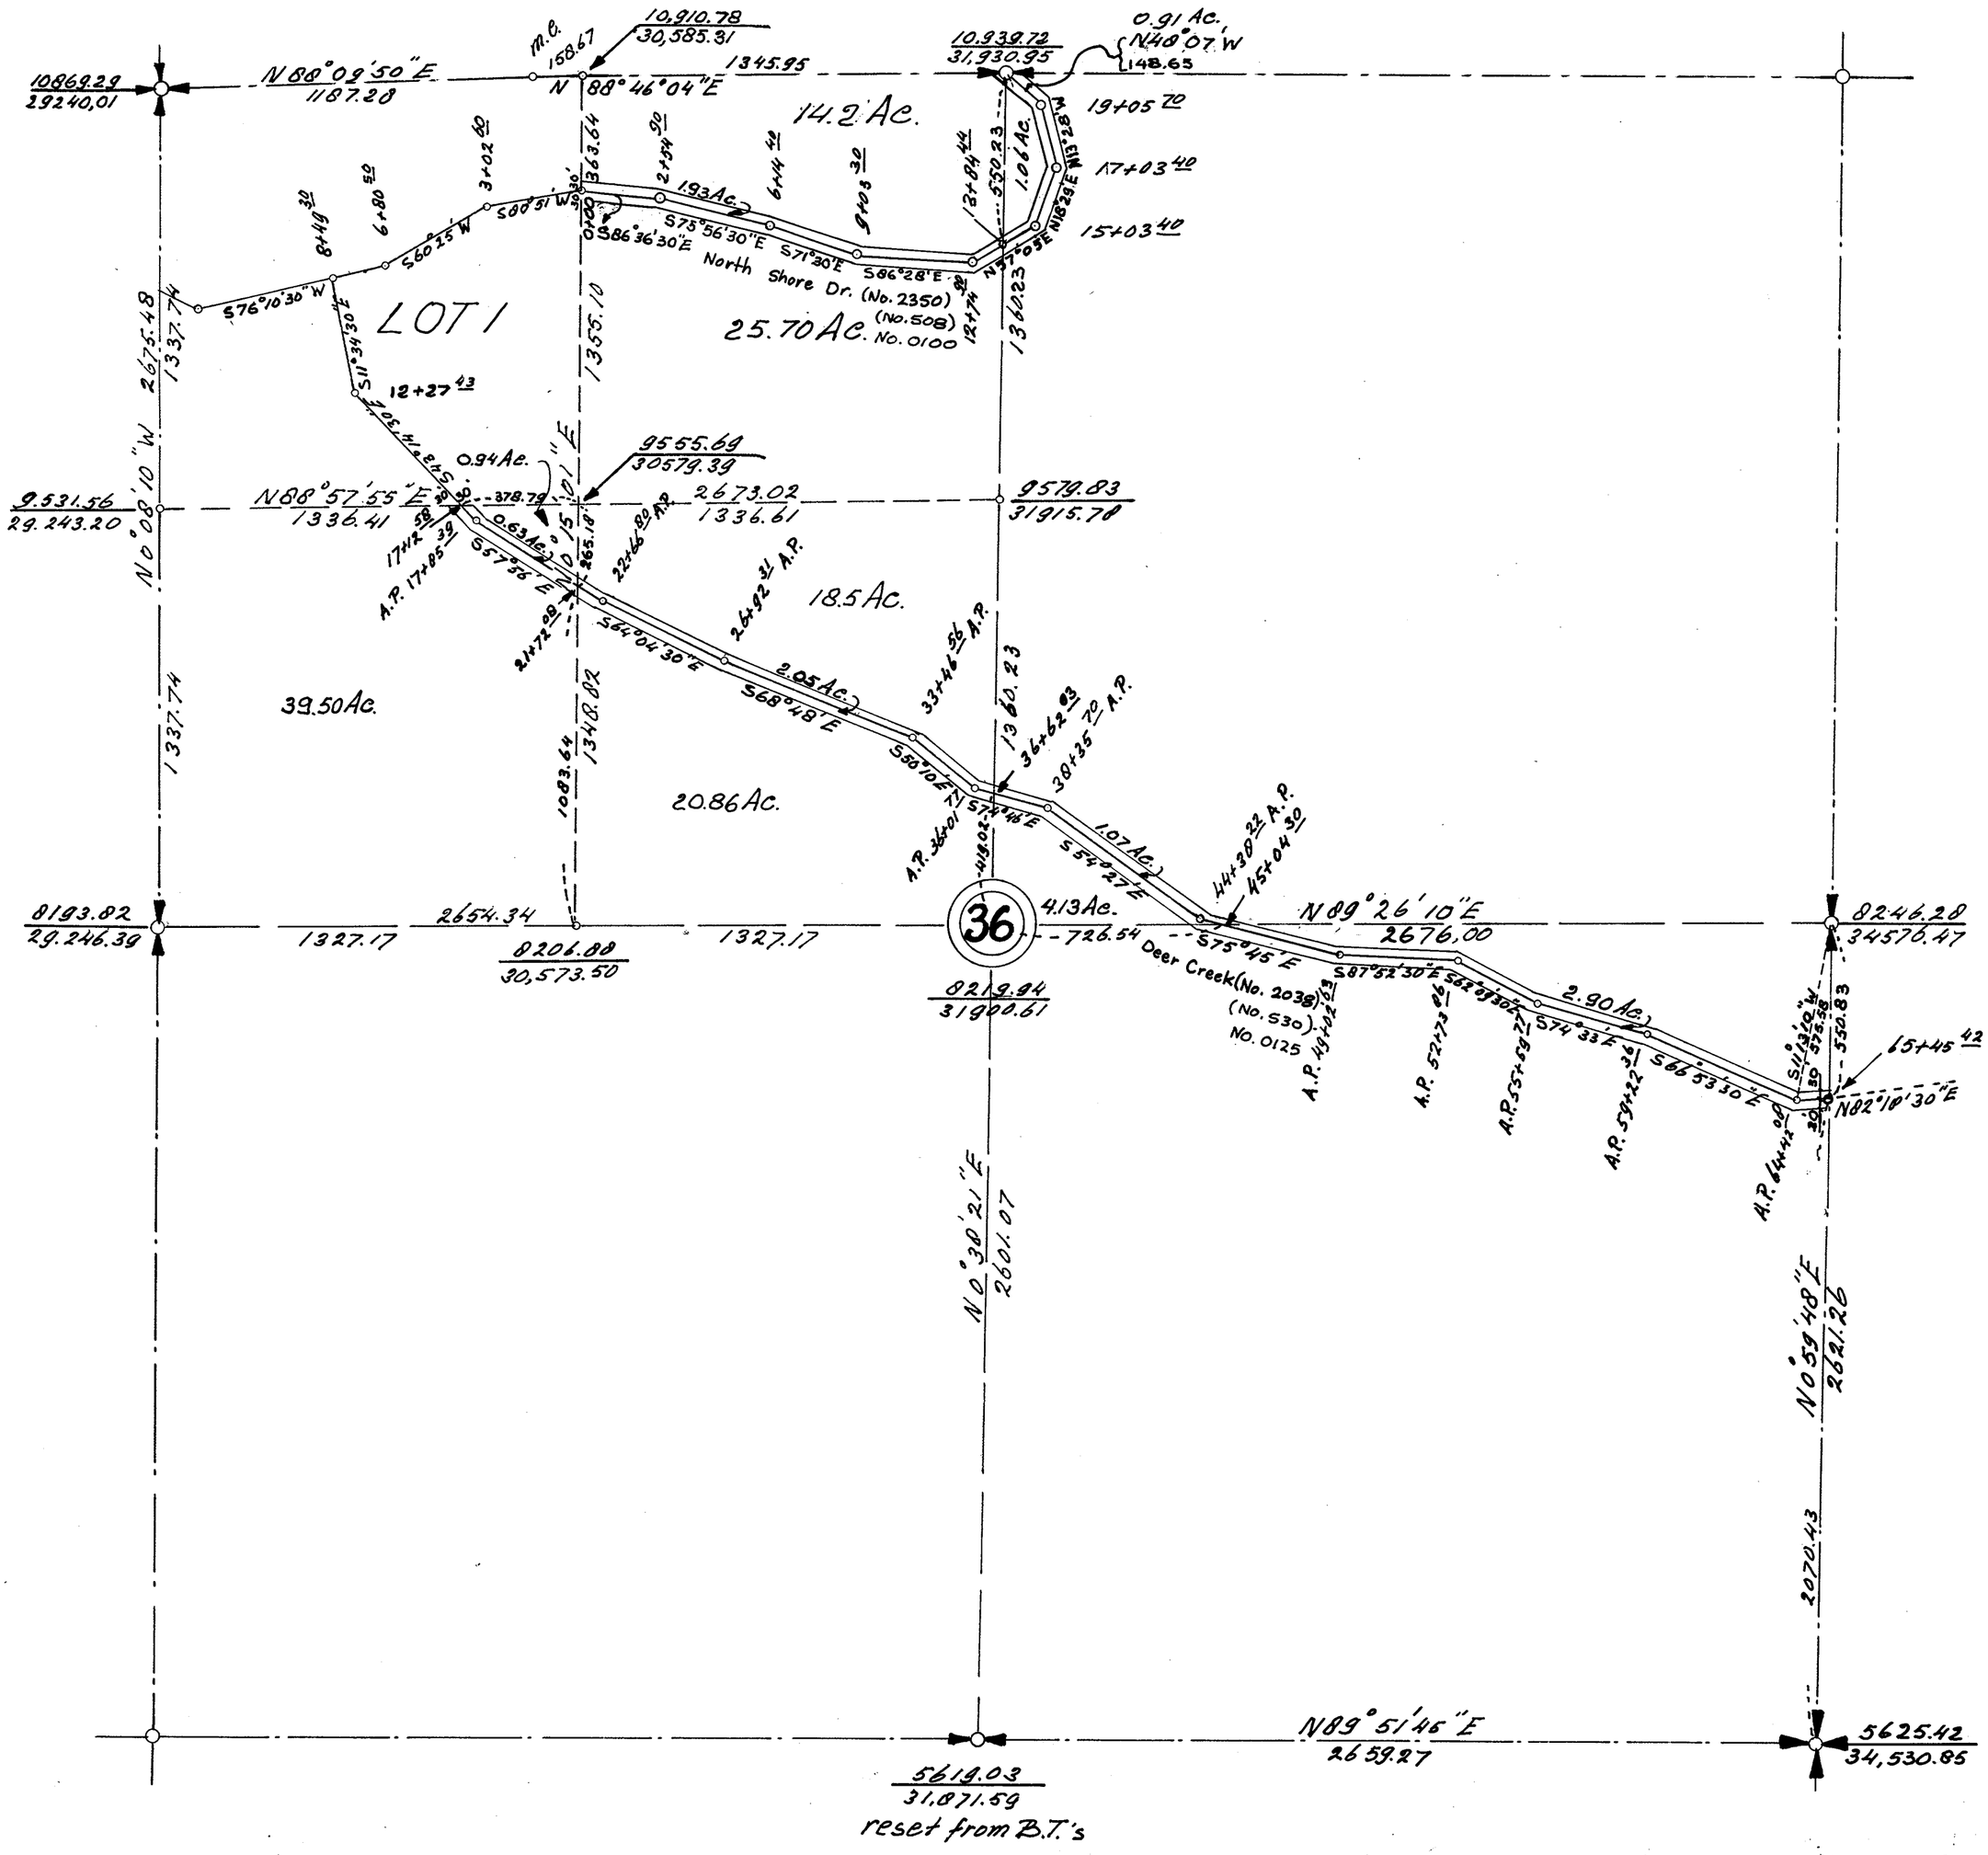


SECTION 36
TOWNSHIP 33 NORTH, RANGE 6 EAST, W.M.
SKAGIT COUNTY, WASH.


SCALE 1 INCH 400 FEET

DATE MAY 31, 1972

LLOYD H. JOHNSON COUNTY ENGINEER

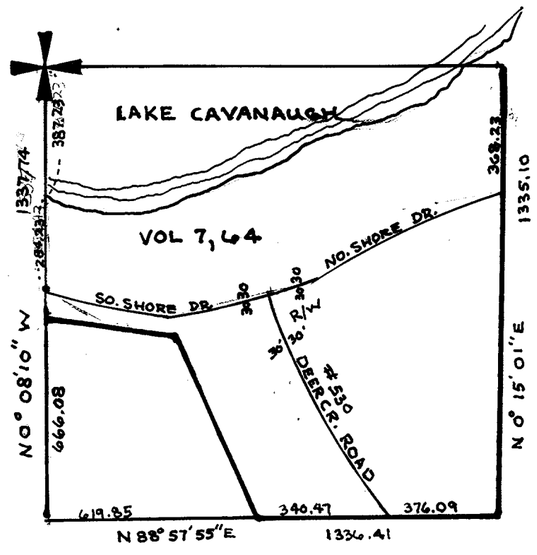

SEC. 36-33-6

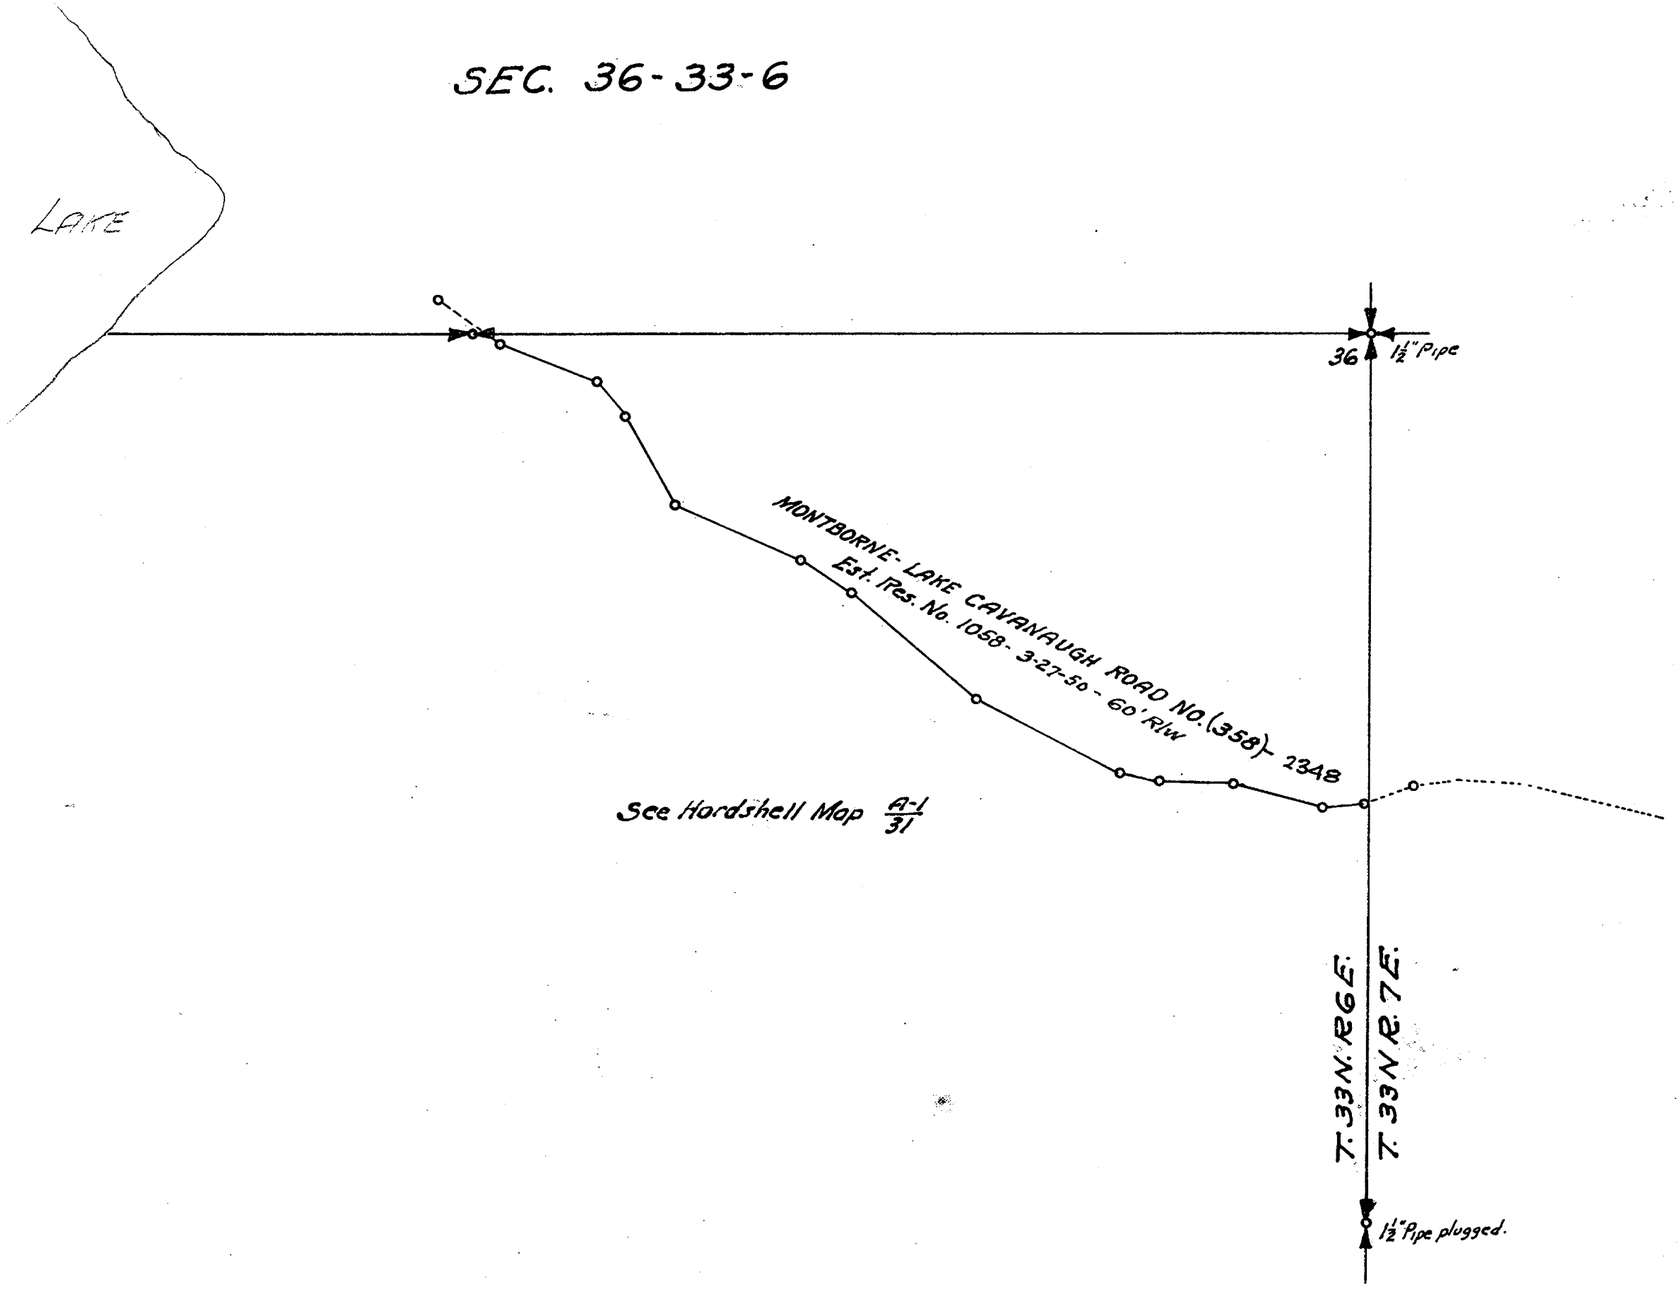

SKAGIT COUNTY, WASH.
OFFICE OF COUNTY ROAD ENGINEER

BRIDGE NO._____

LOCATION..... ROAD.....

JOB NO._____

DATE.....

.....
County Road Engineer

APPROVED..... 194....

.....
Chairman-Board of County Commissioners


SECTION 5

TOWNSHIP 33 NORTH, RANGE 10 EAST, W. M.

SKAGIT COUNTY, WASH.

SCALE, 1 INCH--400 FEET

H.O. Walberg COUNTY ENGINEER

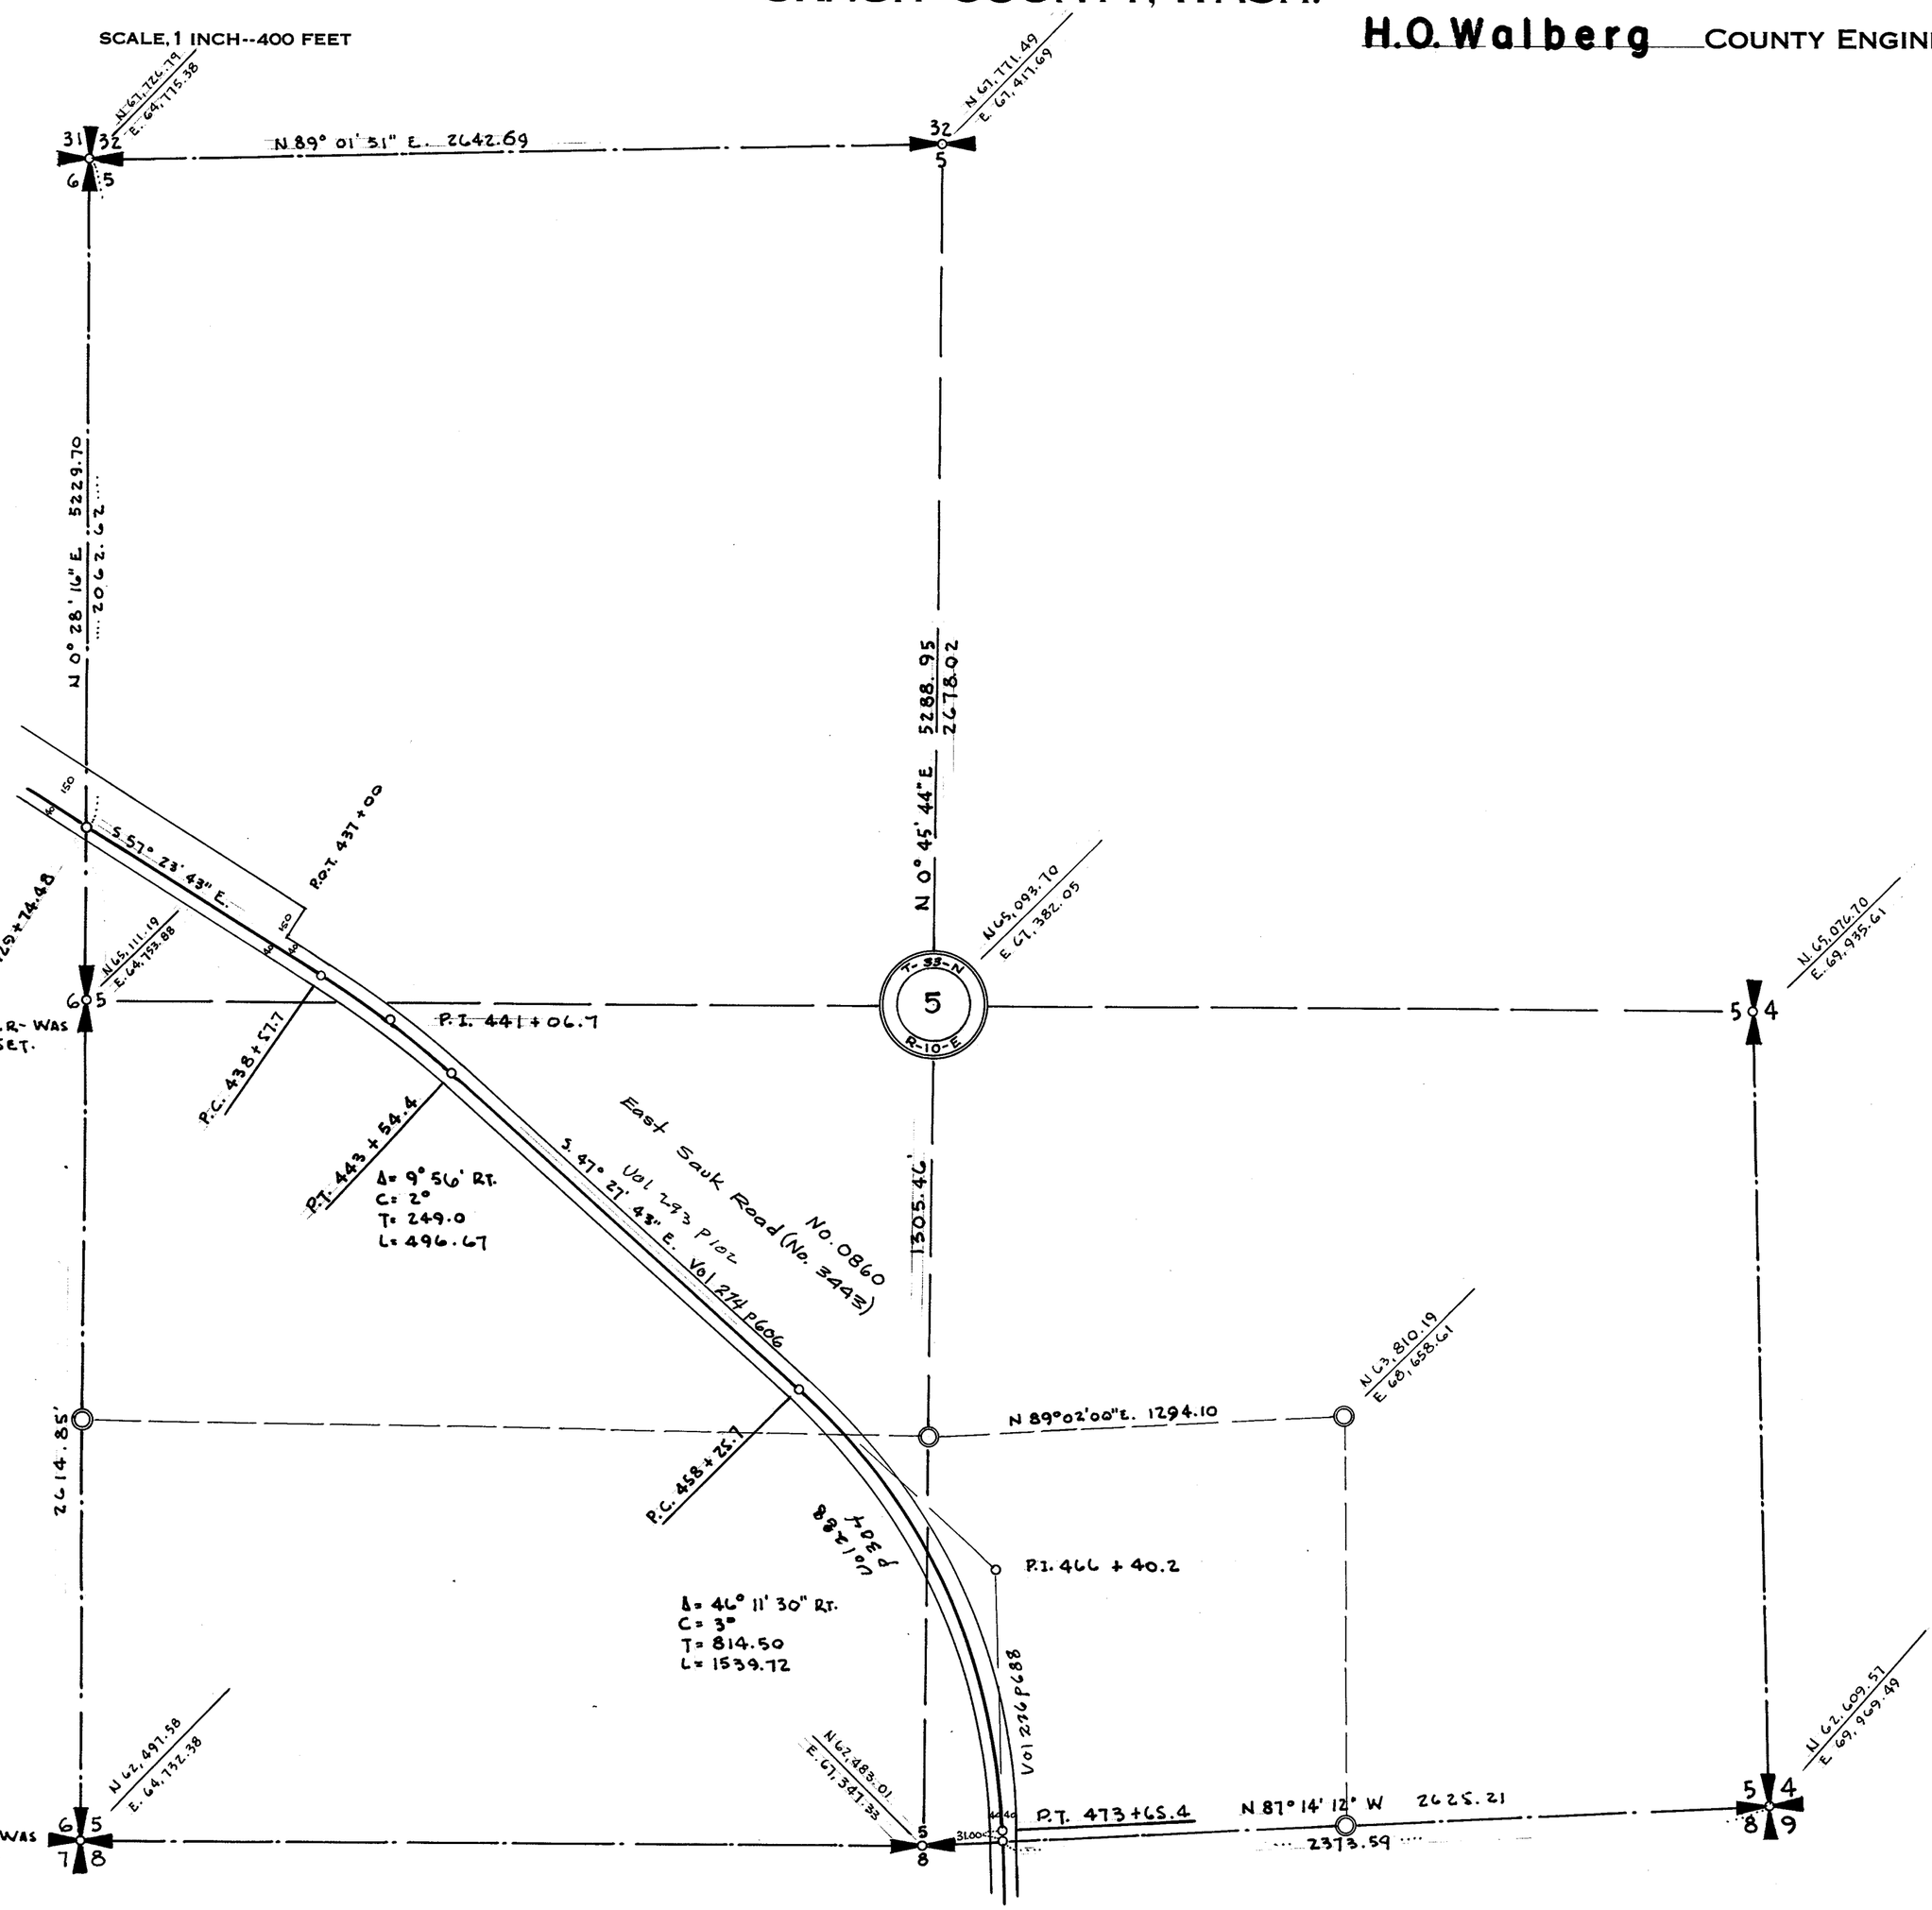

SECTION 6


TOWNSHIP 33 NORTH, RANGE 10 EAST, W. M.

SKAGIT COUNTY, WASH.

SCALE, 1 INCH -- 400 FEET

DATE August 1968


Lloyd Johnson COUNTY ENGINEER

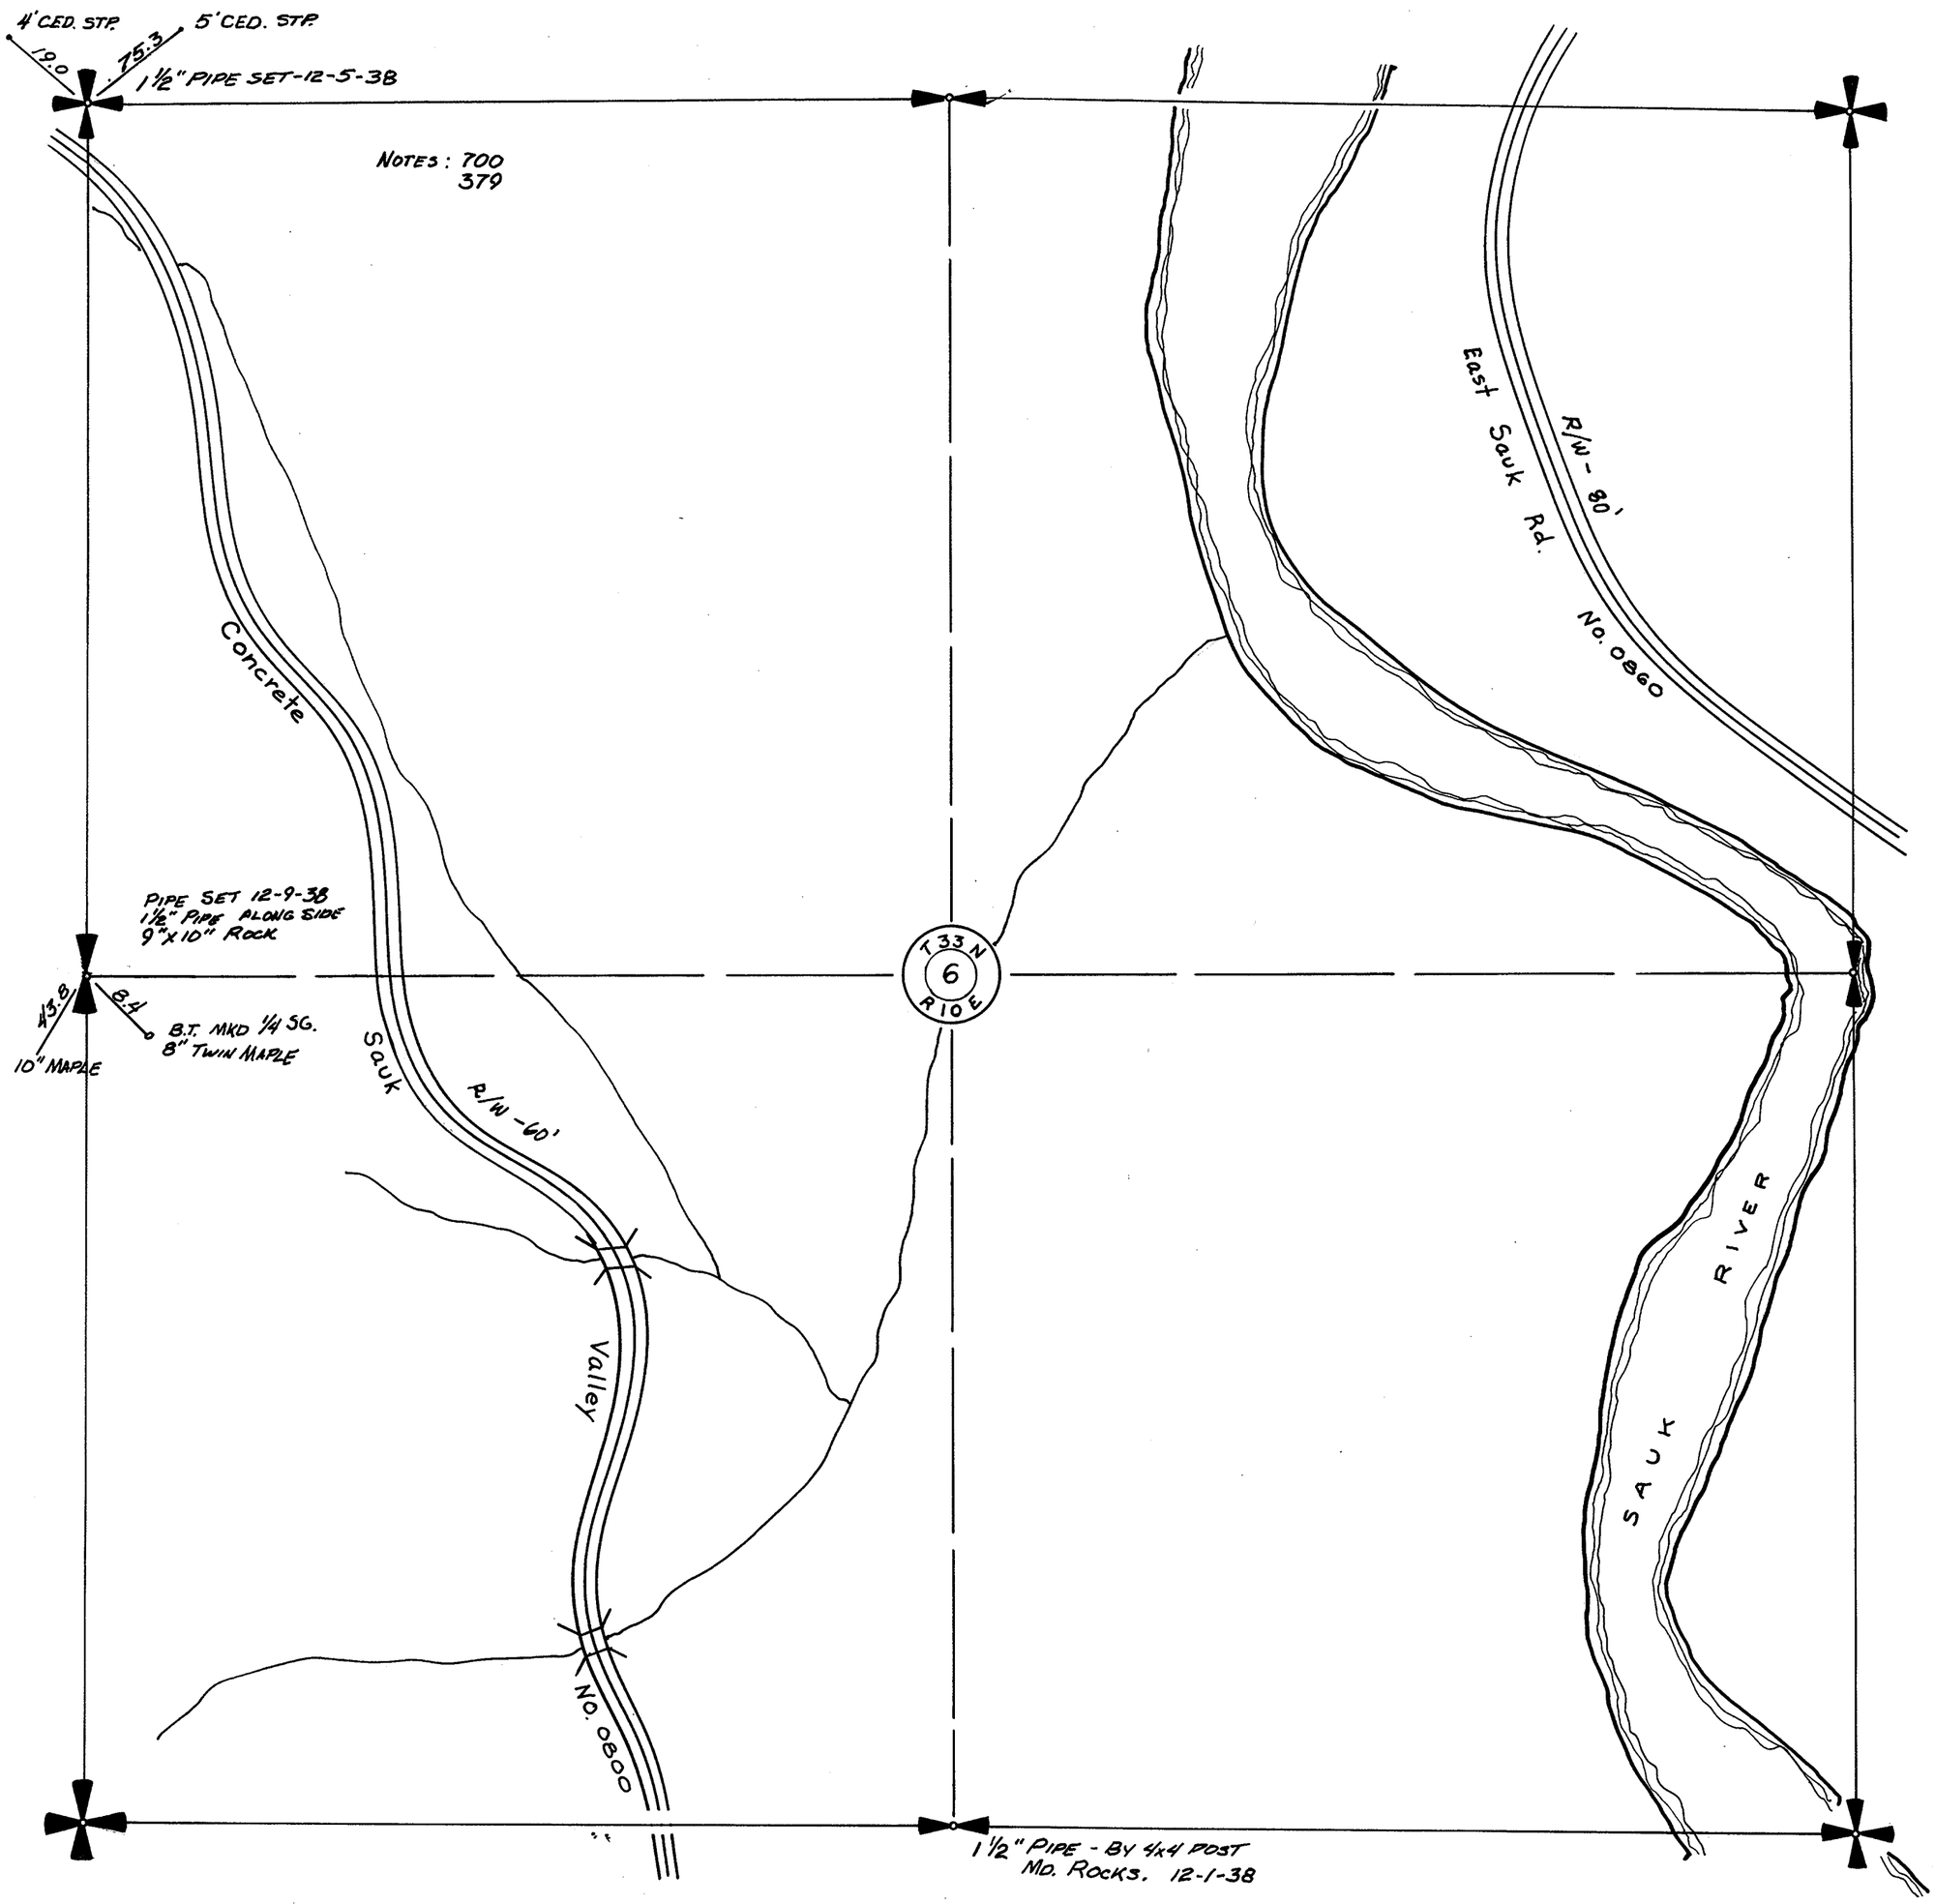

SECTION 6

TOWNSHIP 33 NORTH, RANGE 10 EAST, W. M.

SKAGIT COUNTY, WASH.

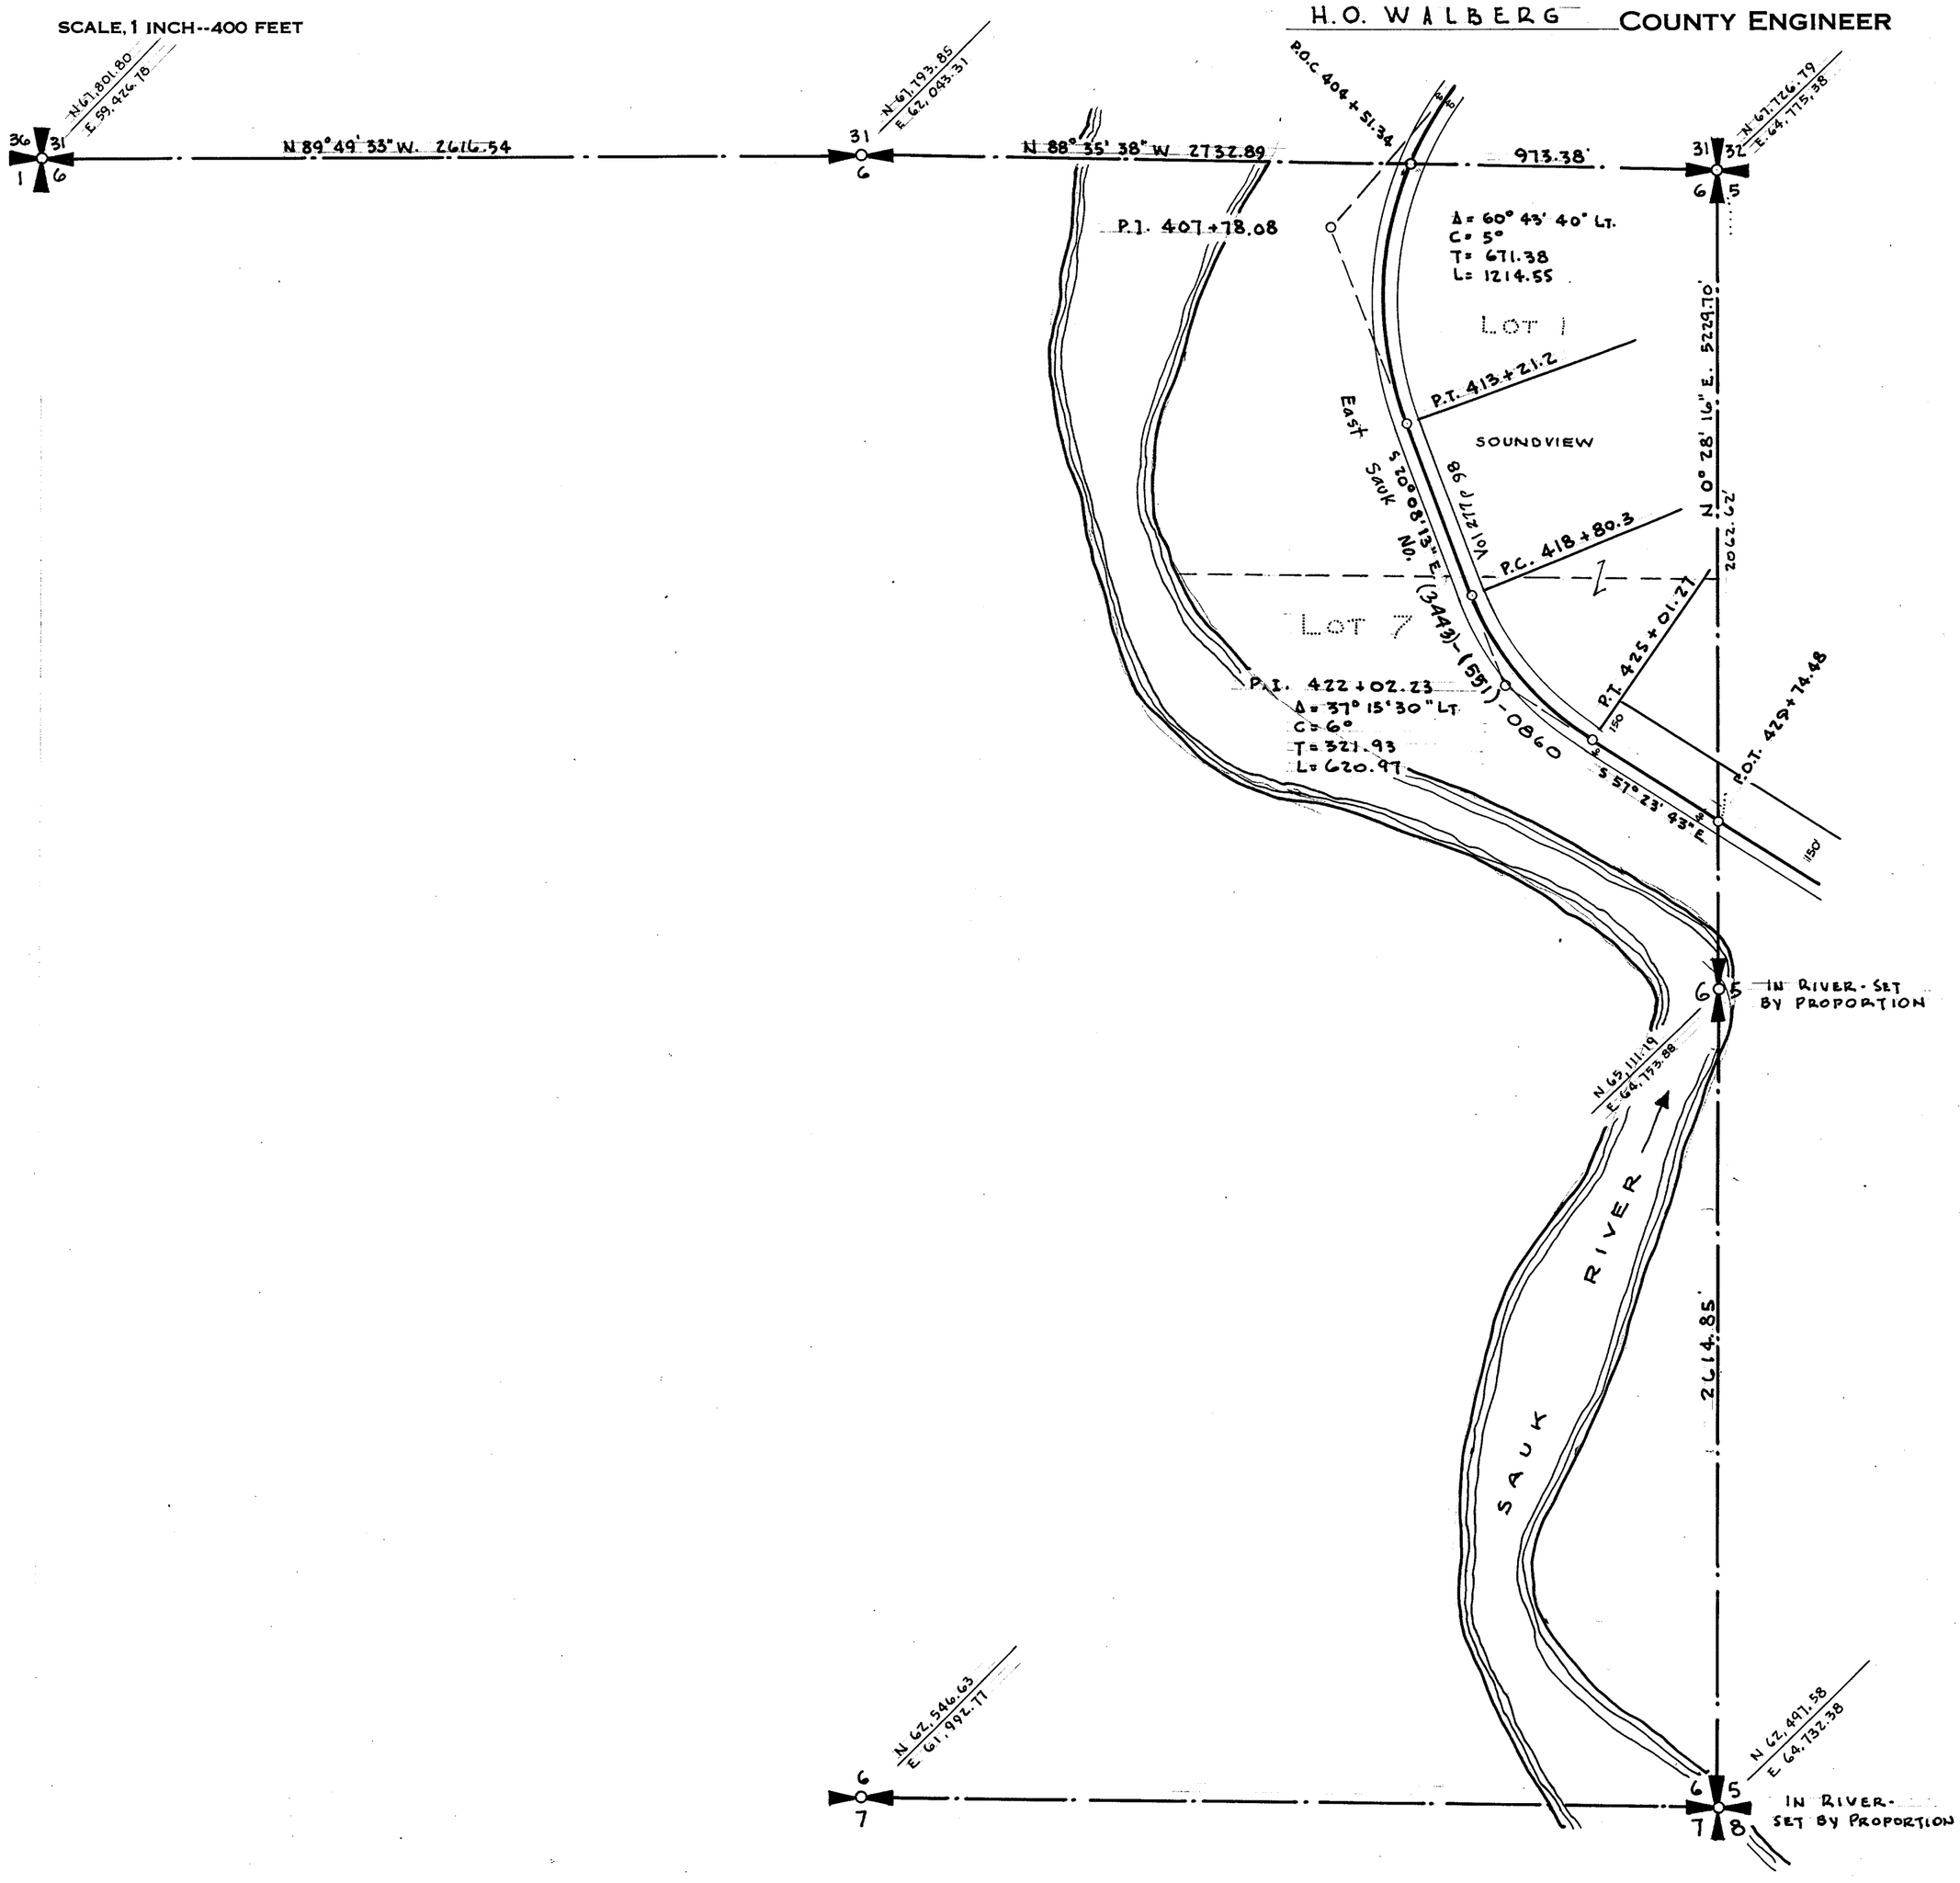

SECTION 7


TOWNSHIP 33 NORTH, RANGE 10 EAST, W. M.

SKAGIT COUNTY, WASH.

SCALE, 1 INCH -- 400 FEET

DATE 3 SEPT 1968

Lloyd H Johnson COUNTY ENGINEER

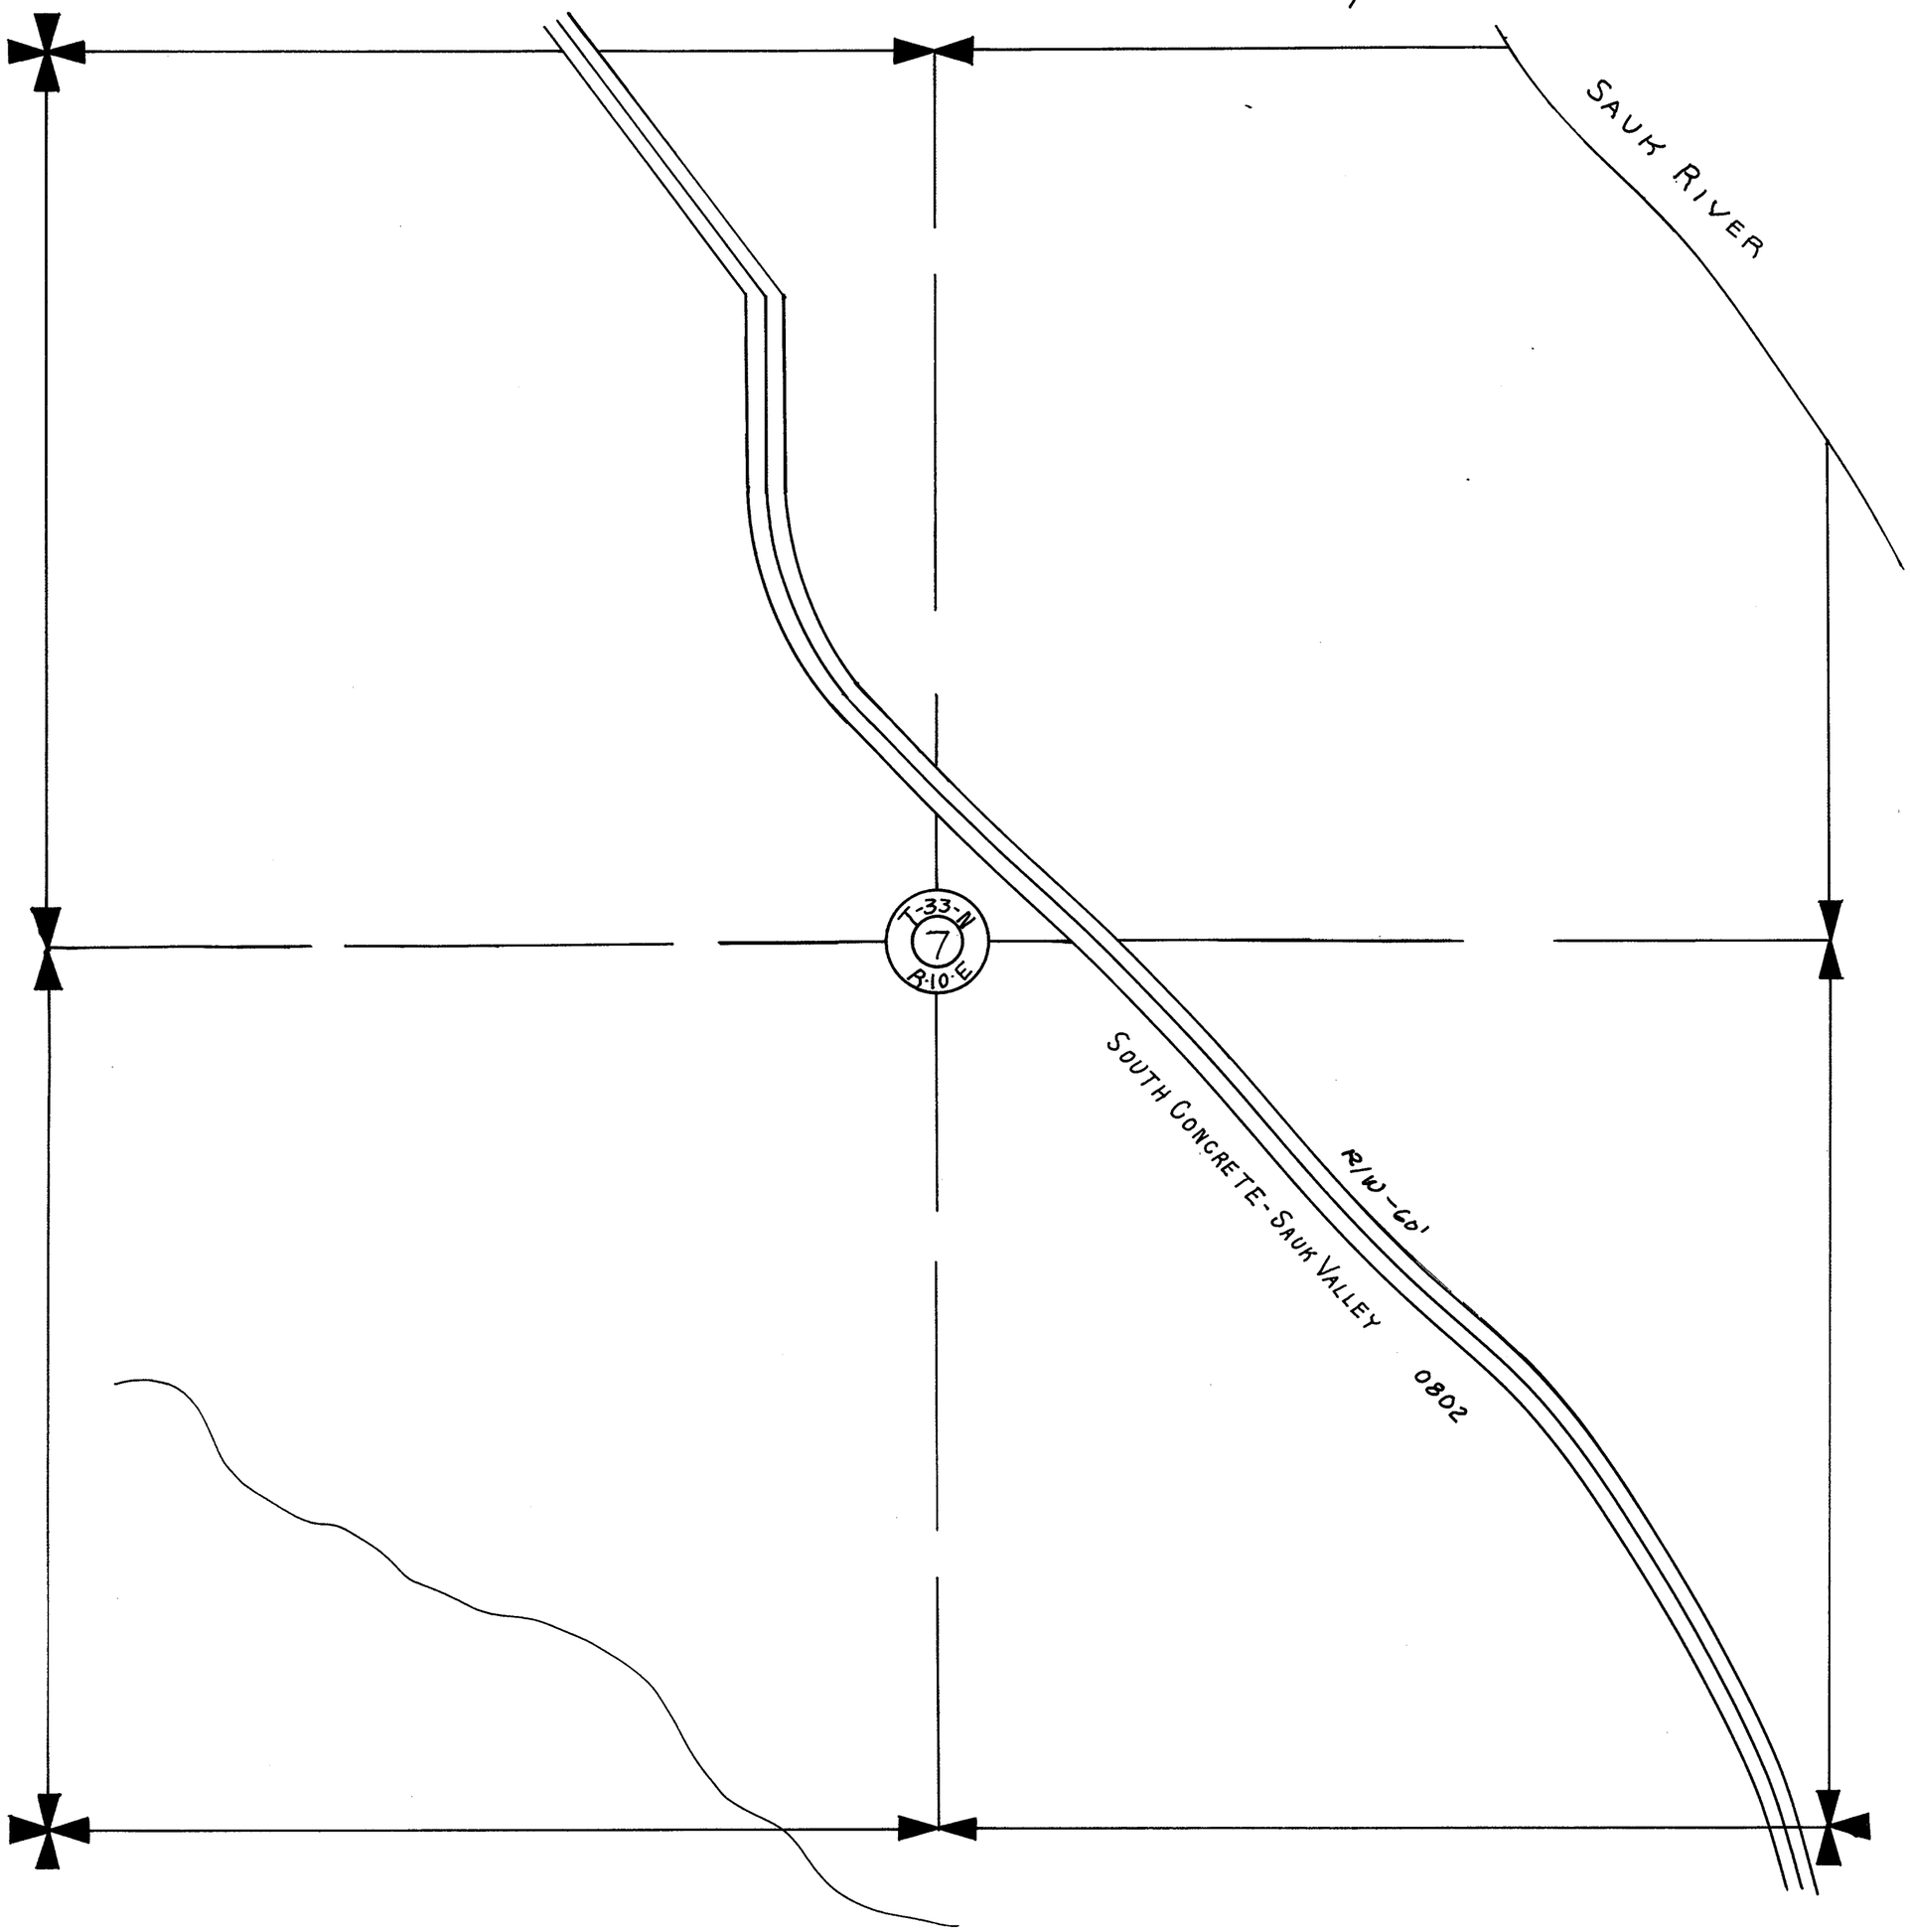

SECTION 8
TOWNSHIP 33 NORTH, RANGE 10 EAST W.M.
SKAGIT COUNTY, WASH.

Scale 1 inch = 400 feet

O. Walberg **County Engineer**

Sec. Cor. in River
Never Set
Located by Prop.

N 62,497.58
E 44,732.38

N 89°40'51" W 2614.99

P.T. 473+65.4

Located from B.T.'s

N 62,483.02
E 47,347.31

P.C. 458+25.7

A = 46°11'30" Rt.
C = 3°
T = 814.50
L = 1539.72

Sta. 464+42.36

P.I. 466+40.2

33.67 Ac.

N 89°02'00"E 1294.10

1 1/2" Pipe

N 0°45'44" E 1305.46

1.75 Ac.

2.97 Ac.

Sta. 473+96.42

N 87°14'12" E 251.65

Location by Prop.

2625.21

N 0°00'34" E 1263.90

5 4 / 8 9

1 1/2" Pipe

N 62,409.57
E 49,949.49

A = 15°33' Lt.
C = 4°
T = 195.58
L = 388.75

P.C. 476+04.42

P.I. 478+00.0

P.T. 479+93.17

27.97 Ac.

9.60 Ac.

N 0°39'07"E 1345.01

N 0°27'43" E 2763.85

P.C. 482+73.1

2616.26

2.45 Ac.

P.I. 485+58.0

A = 16°58' Rt.
C = 3°
T = 284.90
L = 565.56

N 2° 05' 44" E 5221.61

1315.51
496.40

N 88°51'11" E

P.T. 488+38.7

N 0°51'09" E 5191.09

15.27 Ac.

R/W - 80'

Vol 276 p 688

22.41 Ac.

2.43 Ac.

Lost in River
Located by Prop.

N 53,888.52
E 44,634.91

N 89°32'21" W 5310.46

2671.58

515.55

0860

Pipe
CON. MON.,
2 RP'S E/ B.T.
DNR SEDRO WOOLLEY
71

2638.88

15.54 Ac.

21.16 Ac.

2574.83

Road No. (5.51) - (3443)

N 0°57'27" E 1297.60

2.37 Ac.

N89°05'50"W 1313.26

532.28

2615.58

N 1°16'47" E

East Sauk

Vol 276 p 688

20.31 Ac.

15.69 Ac.

2610.80

N 57,232.49
E 47,270.09

N 57,230.88
E 49,888.78

Iron Rod
6" / 6" Post

Washed Out
Location from - 1924
Survey by City Light

N 57,279.46
E 44,541.44

N 89°43'35" E 2720.68

549.01

N 88°38'08" W 2619.41

Iron Pipe
5"/5" Post

Sta. 526+37.95

7 8 / 18 17

8 9 / 17 16

SECTION 15


TOWNSHIP 33 NORTH, RANGE 10 EAST, W. M.

SKAGIT COUNTY, WASH.

SCALE, 1 INCH -- 400 FEET

DATE August 1968

Lloyd Johnson COUNTY ENGINEER

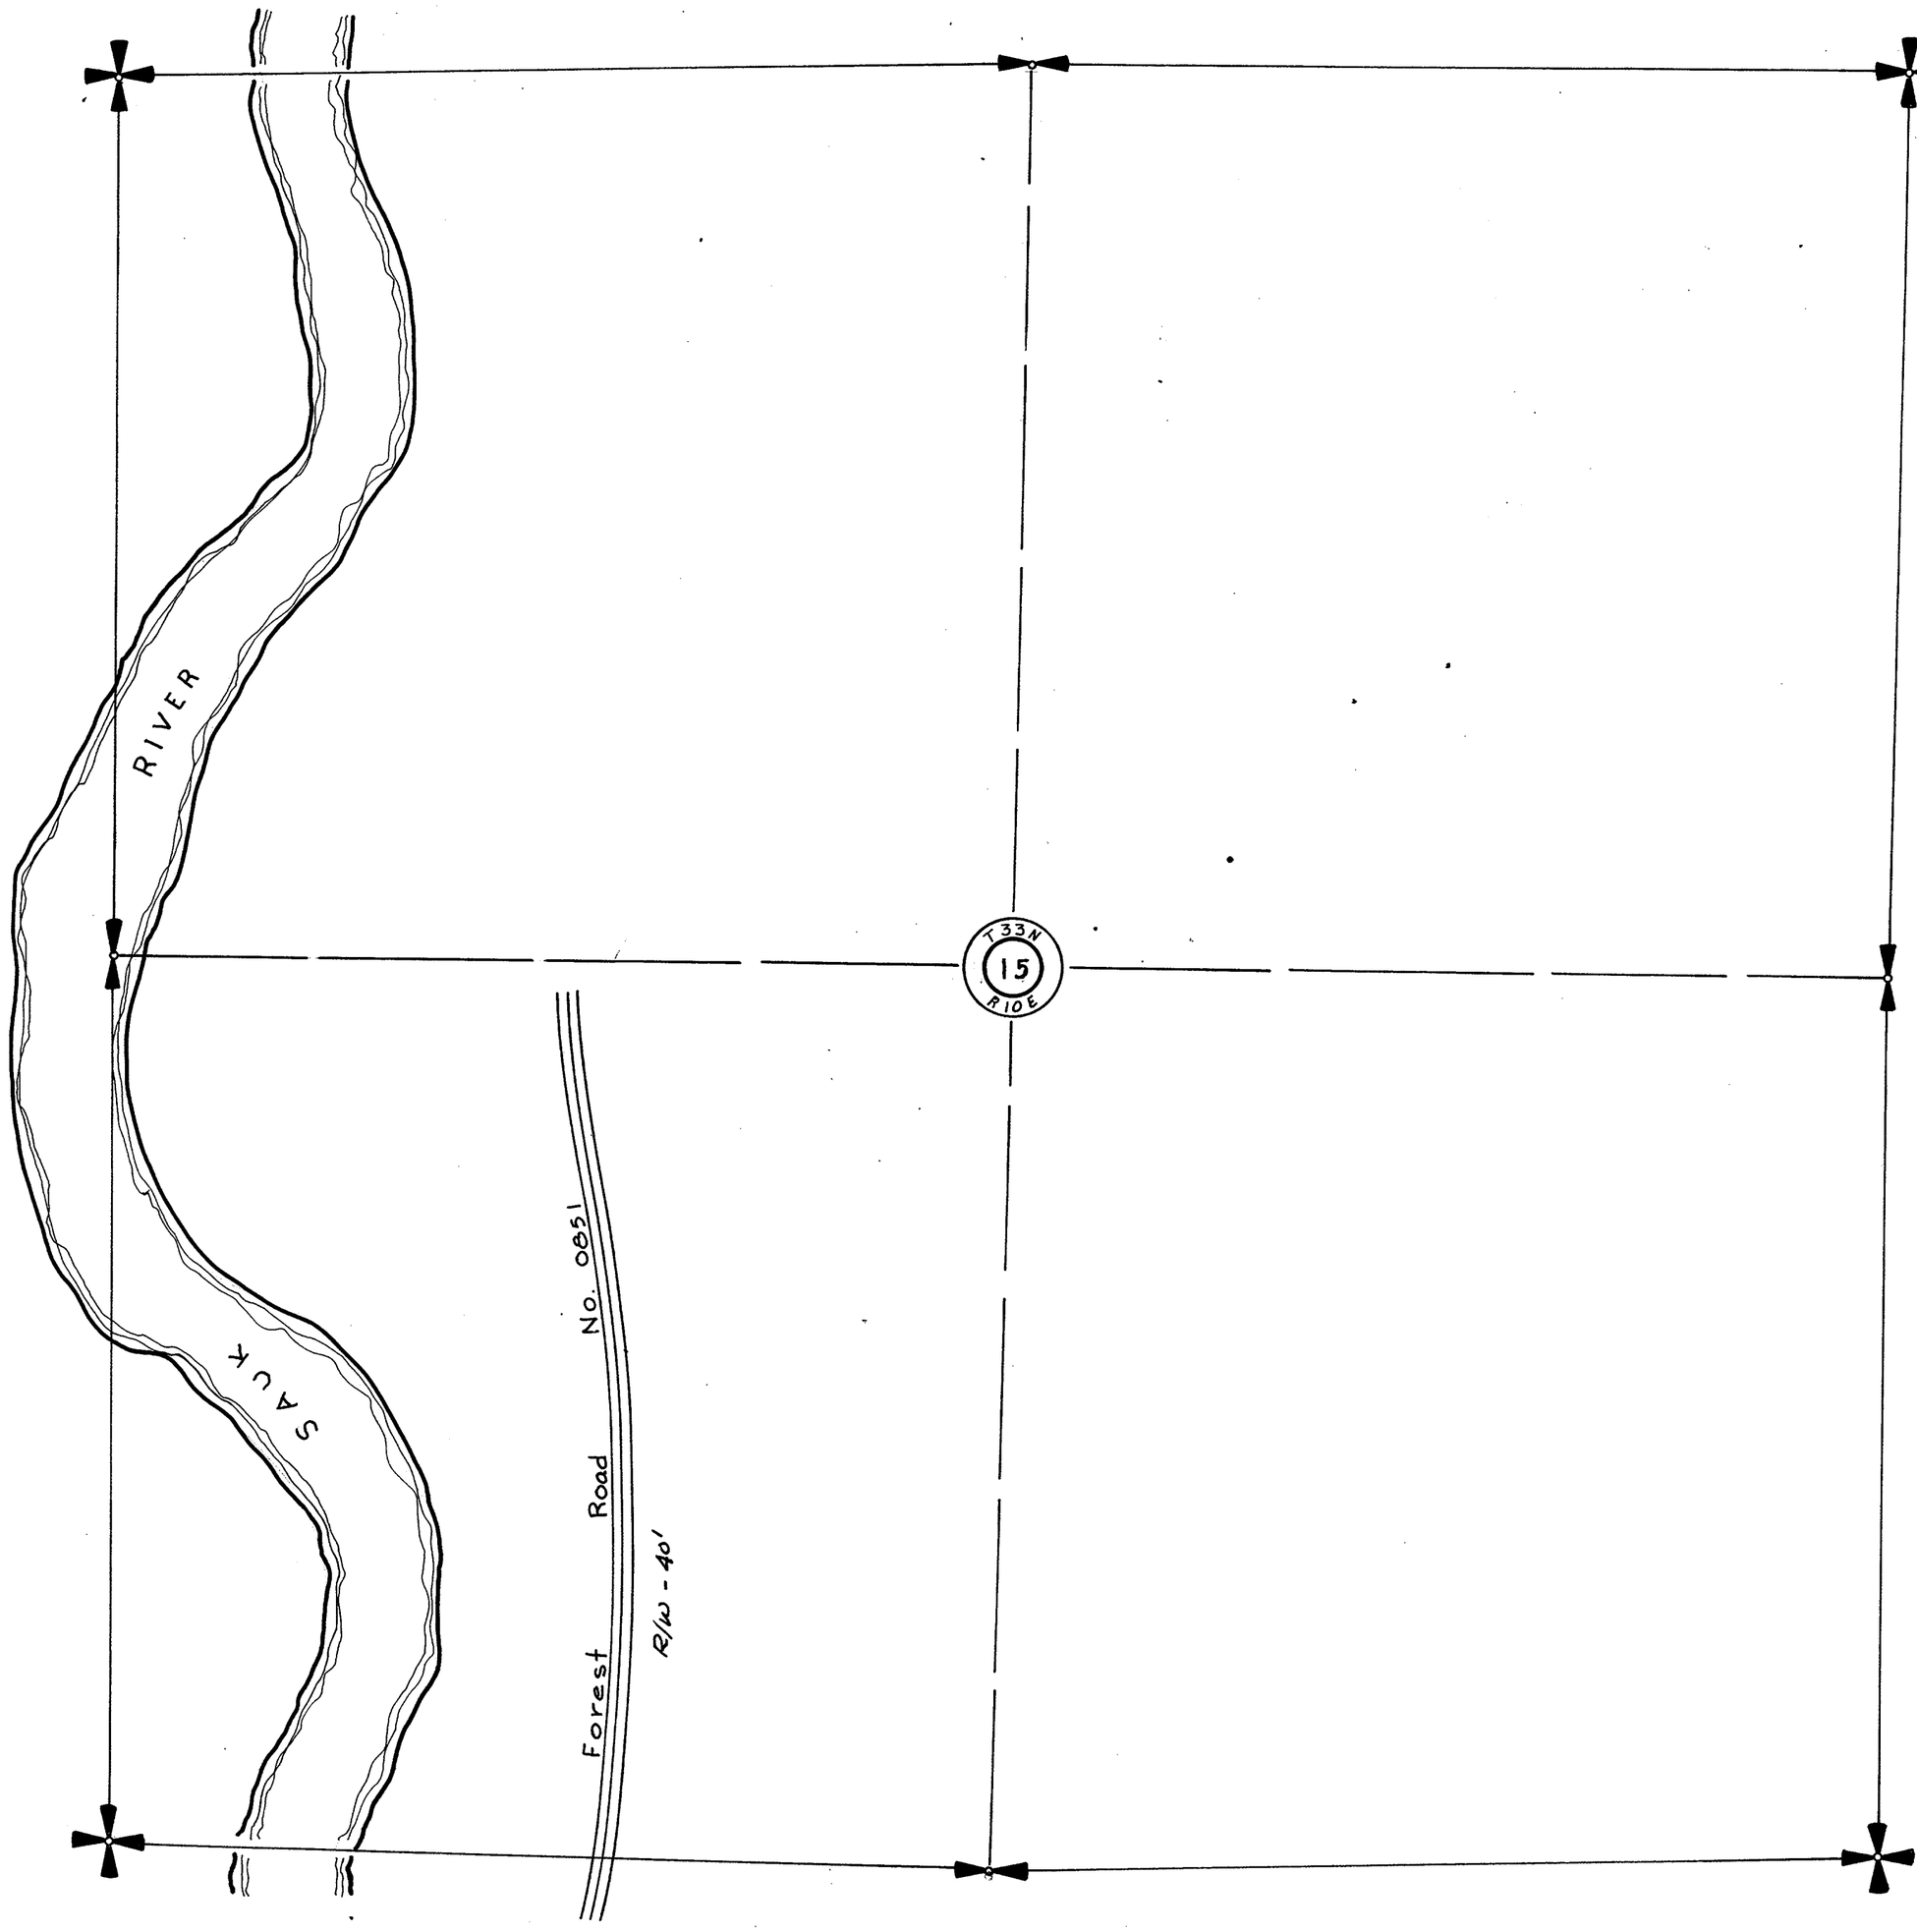

SECTION 17

TOWNSHIP 33 NORTH, RANGE 10 EAST, W. M.

SKAGIT COUNTY, WASH.

SCALE, 1 INCH--400 FEET

H. O. WALBERG COUNTY ENGINEER

CON. MON. 2 RPIs & 1 B.T. O.N.R. SEDRO WOOLLEY (71)

FROM CITY LIGHT 1924 SURVEY

N. 57,279.46
E. 64,541.44

N 89° 43' 35" E 2728.68

N. 57,292.49
E. 67,270.09

N 88° 39' 08" W 2619.41

.... 2072.40' ....

R.O.T. 526+37.95

N. 57,230.88
E. 69,888.78

N 1° 03' 47" E 5273.93'

N. 54,442.95
E. 64,492.52

NOT FOUND.
PROP. FROM CITY
LITE SURVEY

N 2° 03' 23" E 5403.84

S 0° 09' 02" W.

R/W - 80'

East Sauk Road No. (3443) - 0860

Vol 213 P 67

N 1° 20' 40" E. 2699.42

N 88° 47' 59" W
5287.94

N. 54,532.19
E. 69,779.30

P.C. 586 + 99.52

Δ = 99° 20' 40" Rt.
C = 6°
T = 1124.98'
L = 1655.74
R = 954.93

P.I. 591 + 44.80

P.T. 573 + 55.26

N 80° 30' 18" W.

Δ = 104° 42' Lt.
C = 10° 30'
T = 707.35
L = 997.14

P.C. 584 + 37.45

P.I. 568 + 24.50

N 1° 21' 48" E. 2642.41

N 1° 03' 47" E

Vol. 287/p. 236

P.T. 594 + 84.59

S 5° 12' 18" E.

S A U K

R I V E R

TK. G.R. POST

5.20

TK G.R. POST
N 52,006.44
E 64,448.59

NOT FOUND

634.87

603+28.83


N. 51,892.13
E 67,076.18

N 89° 57' 55" W 2640.25

N. 51,890.53
E 69,716.43

NOTE:
COR. MRK BY 3/4" BOLT 2 1/2' LONG,
ON MAY 29, 1950 BY: A. MOBERG


SECTION 20

TOWNSHIP 33 NORTH, RANGE 10 EAST, W. M.

SKAGIT COUNTY, WASH.

SCALE, 1 INCH--400 FEET

_____ COUNTY ENGINEER

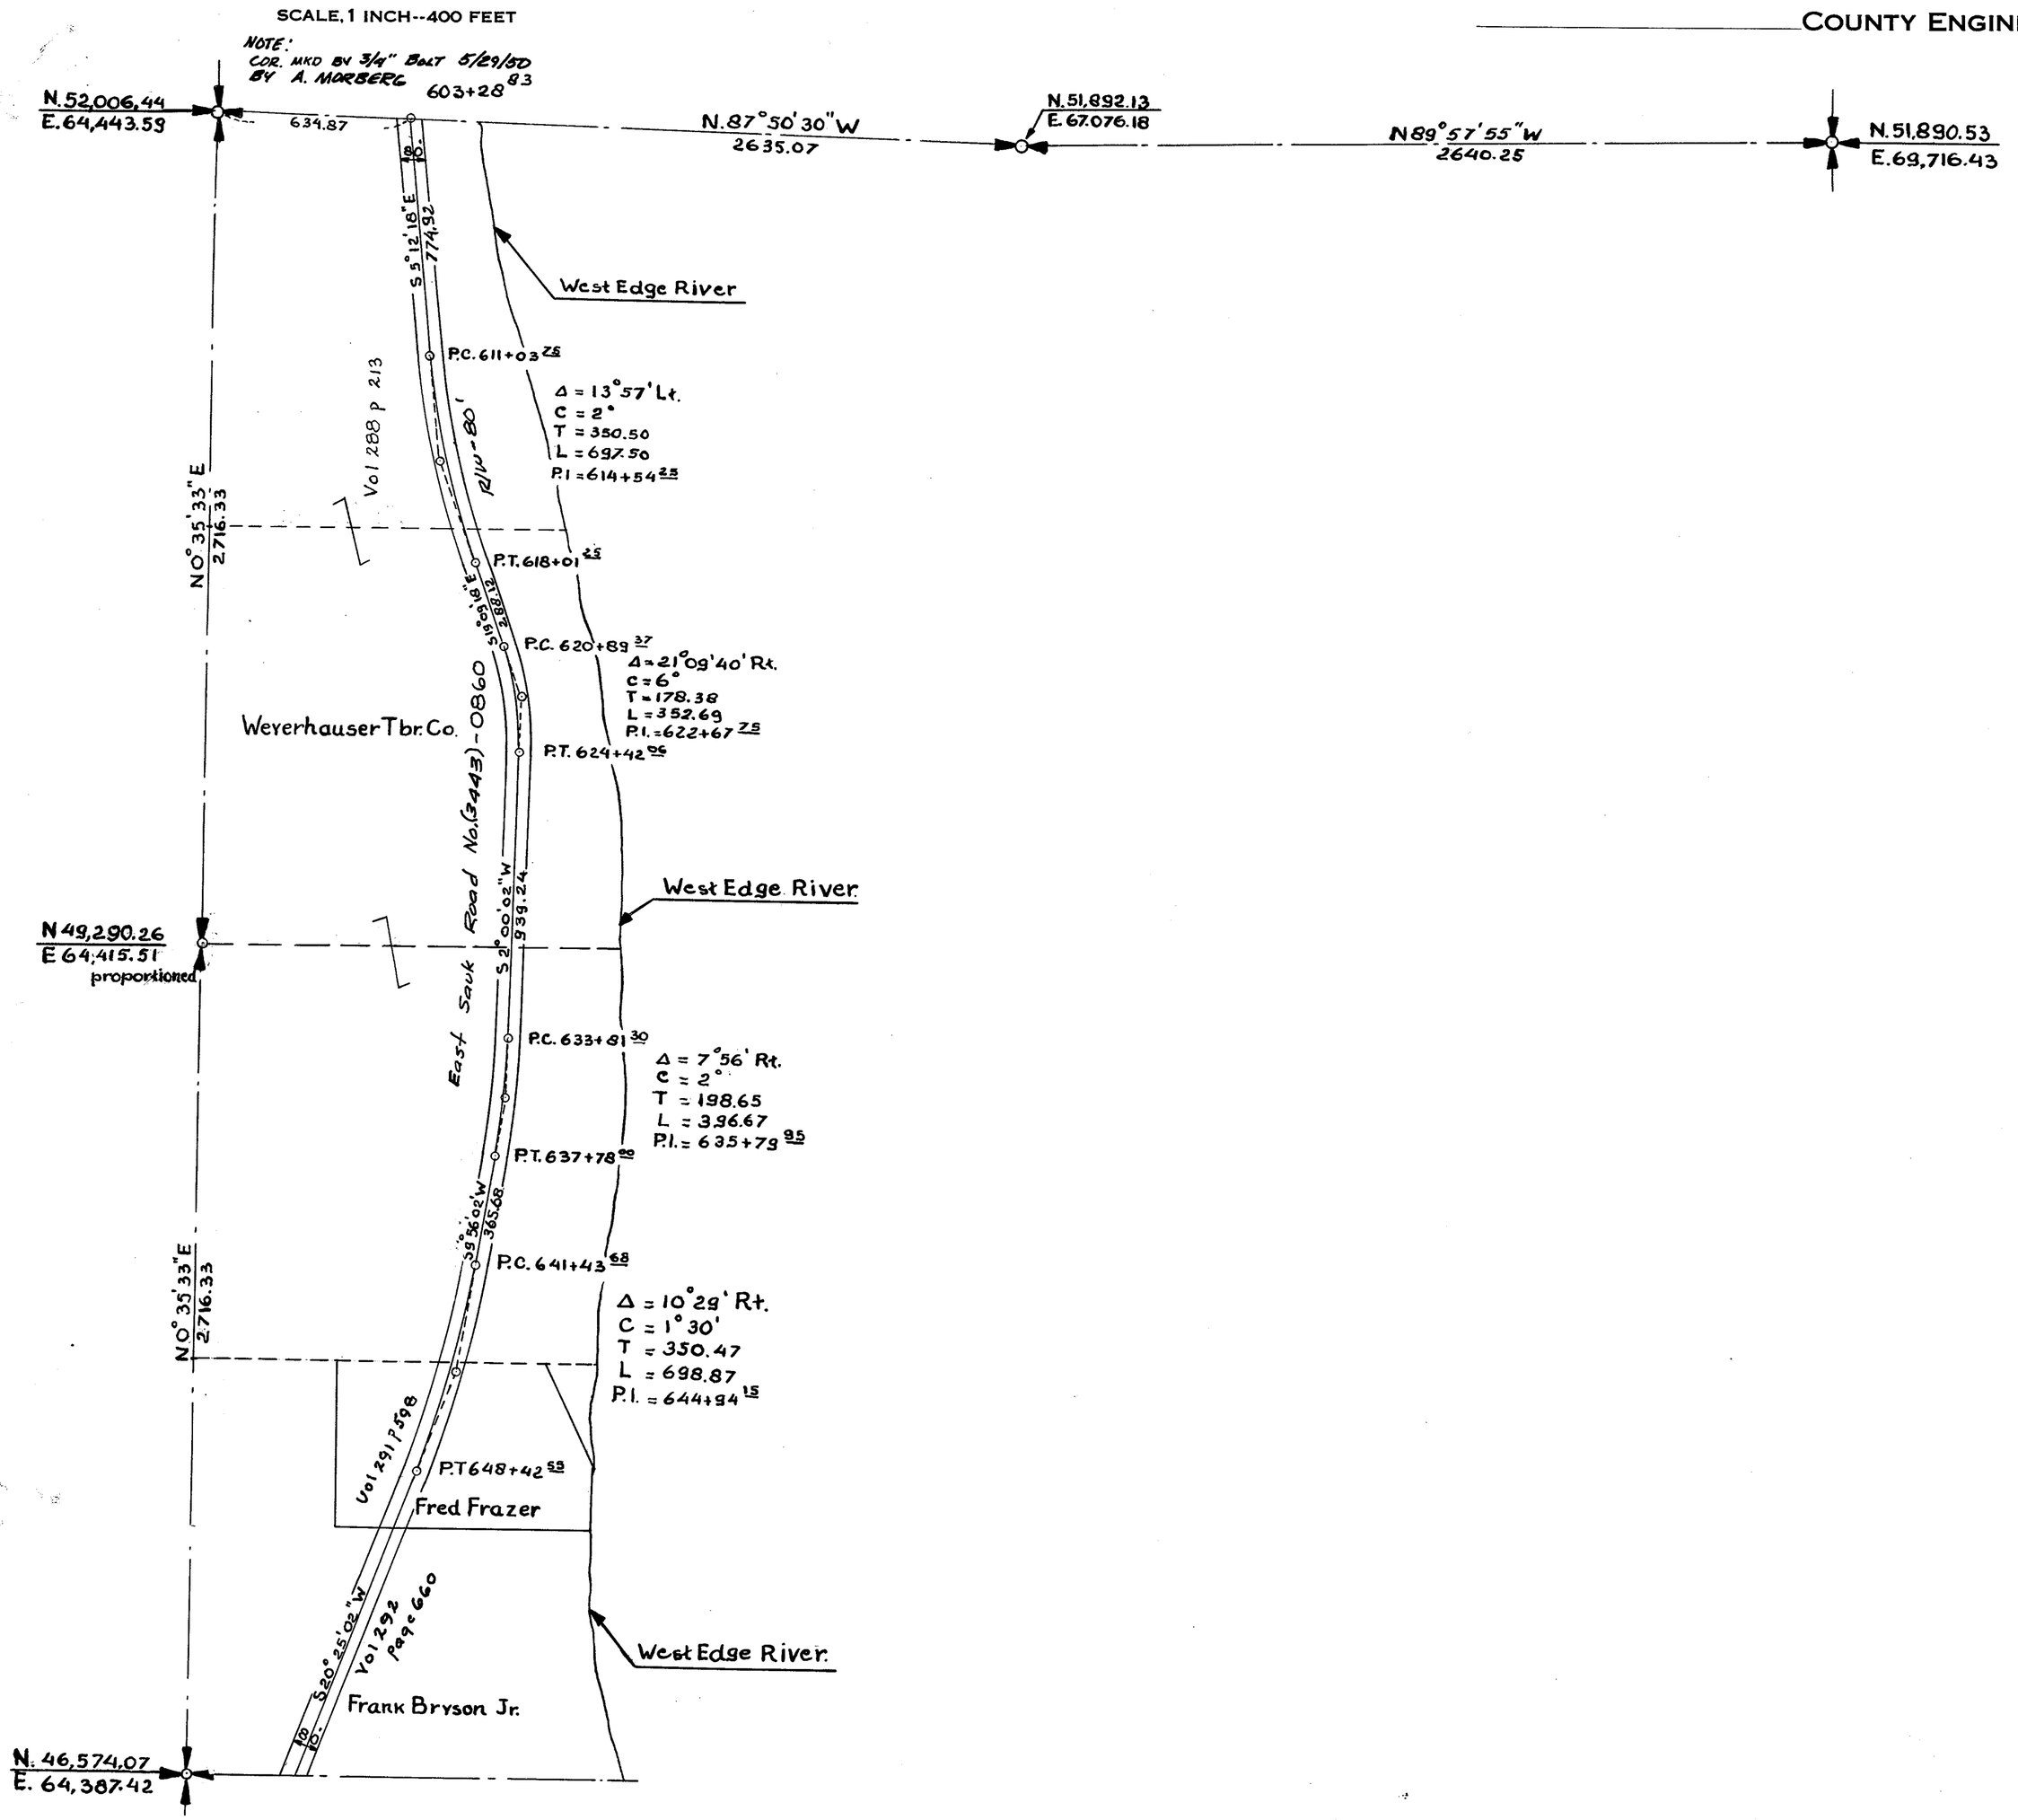

SECTION 21

TOWNSHIP 33 NORTH, RANGE 10 EAST, W. M.

SKAGIT COUNTY, WASH.

SCALE, 1 INCH -- 400 FEET

DATE 3 SEPT 1968

Lloyd H Johnson COUNTY ENGINEER

T-33-N
21
R-10-E

SUIATTLE RIVER

FOREST ROAD 0851

R/W - 40'

SECTION 22


TOWNSHIP 33 NORTH, RANGE 10 EAST, W. M.

SKAGIT COUNTY, WASH.

SCALE, 1 INCH -- 400 FEET

DATE August 1968

Lloyd Johnson COUNTY ENGINEER

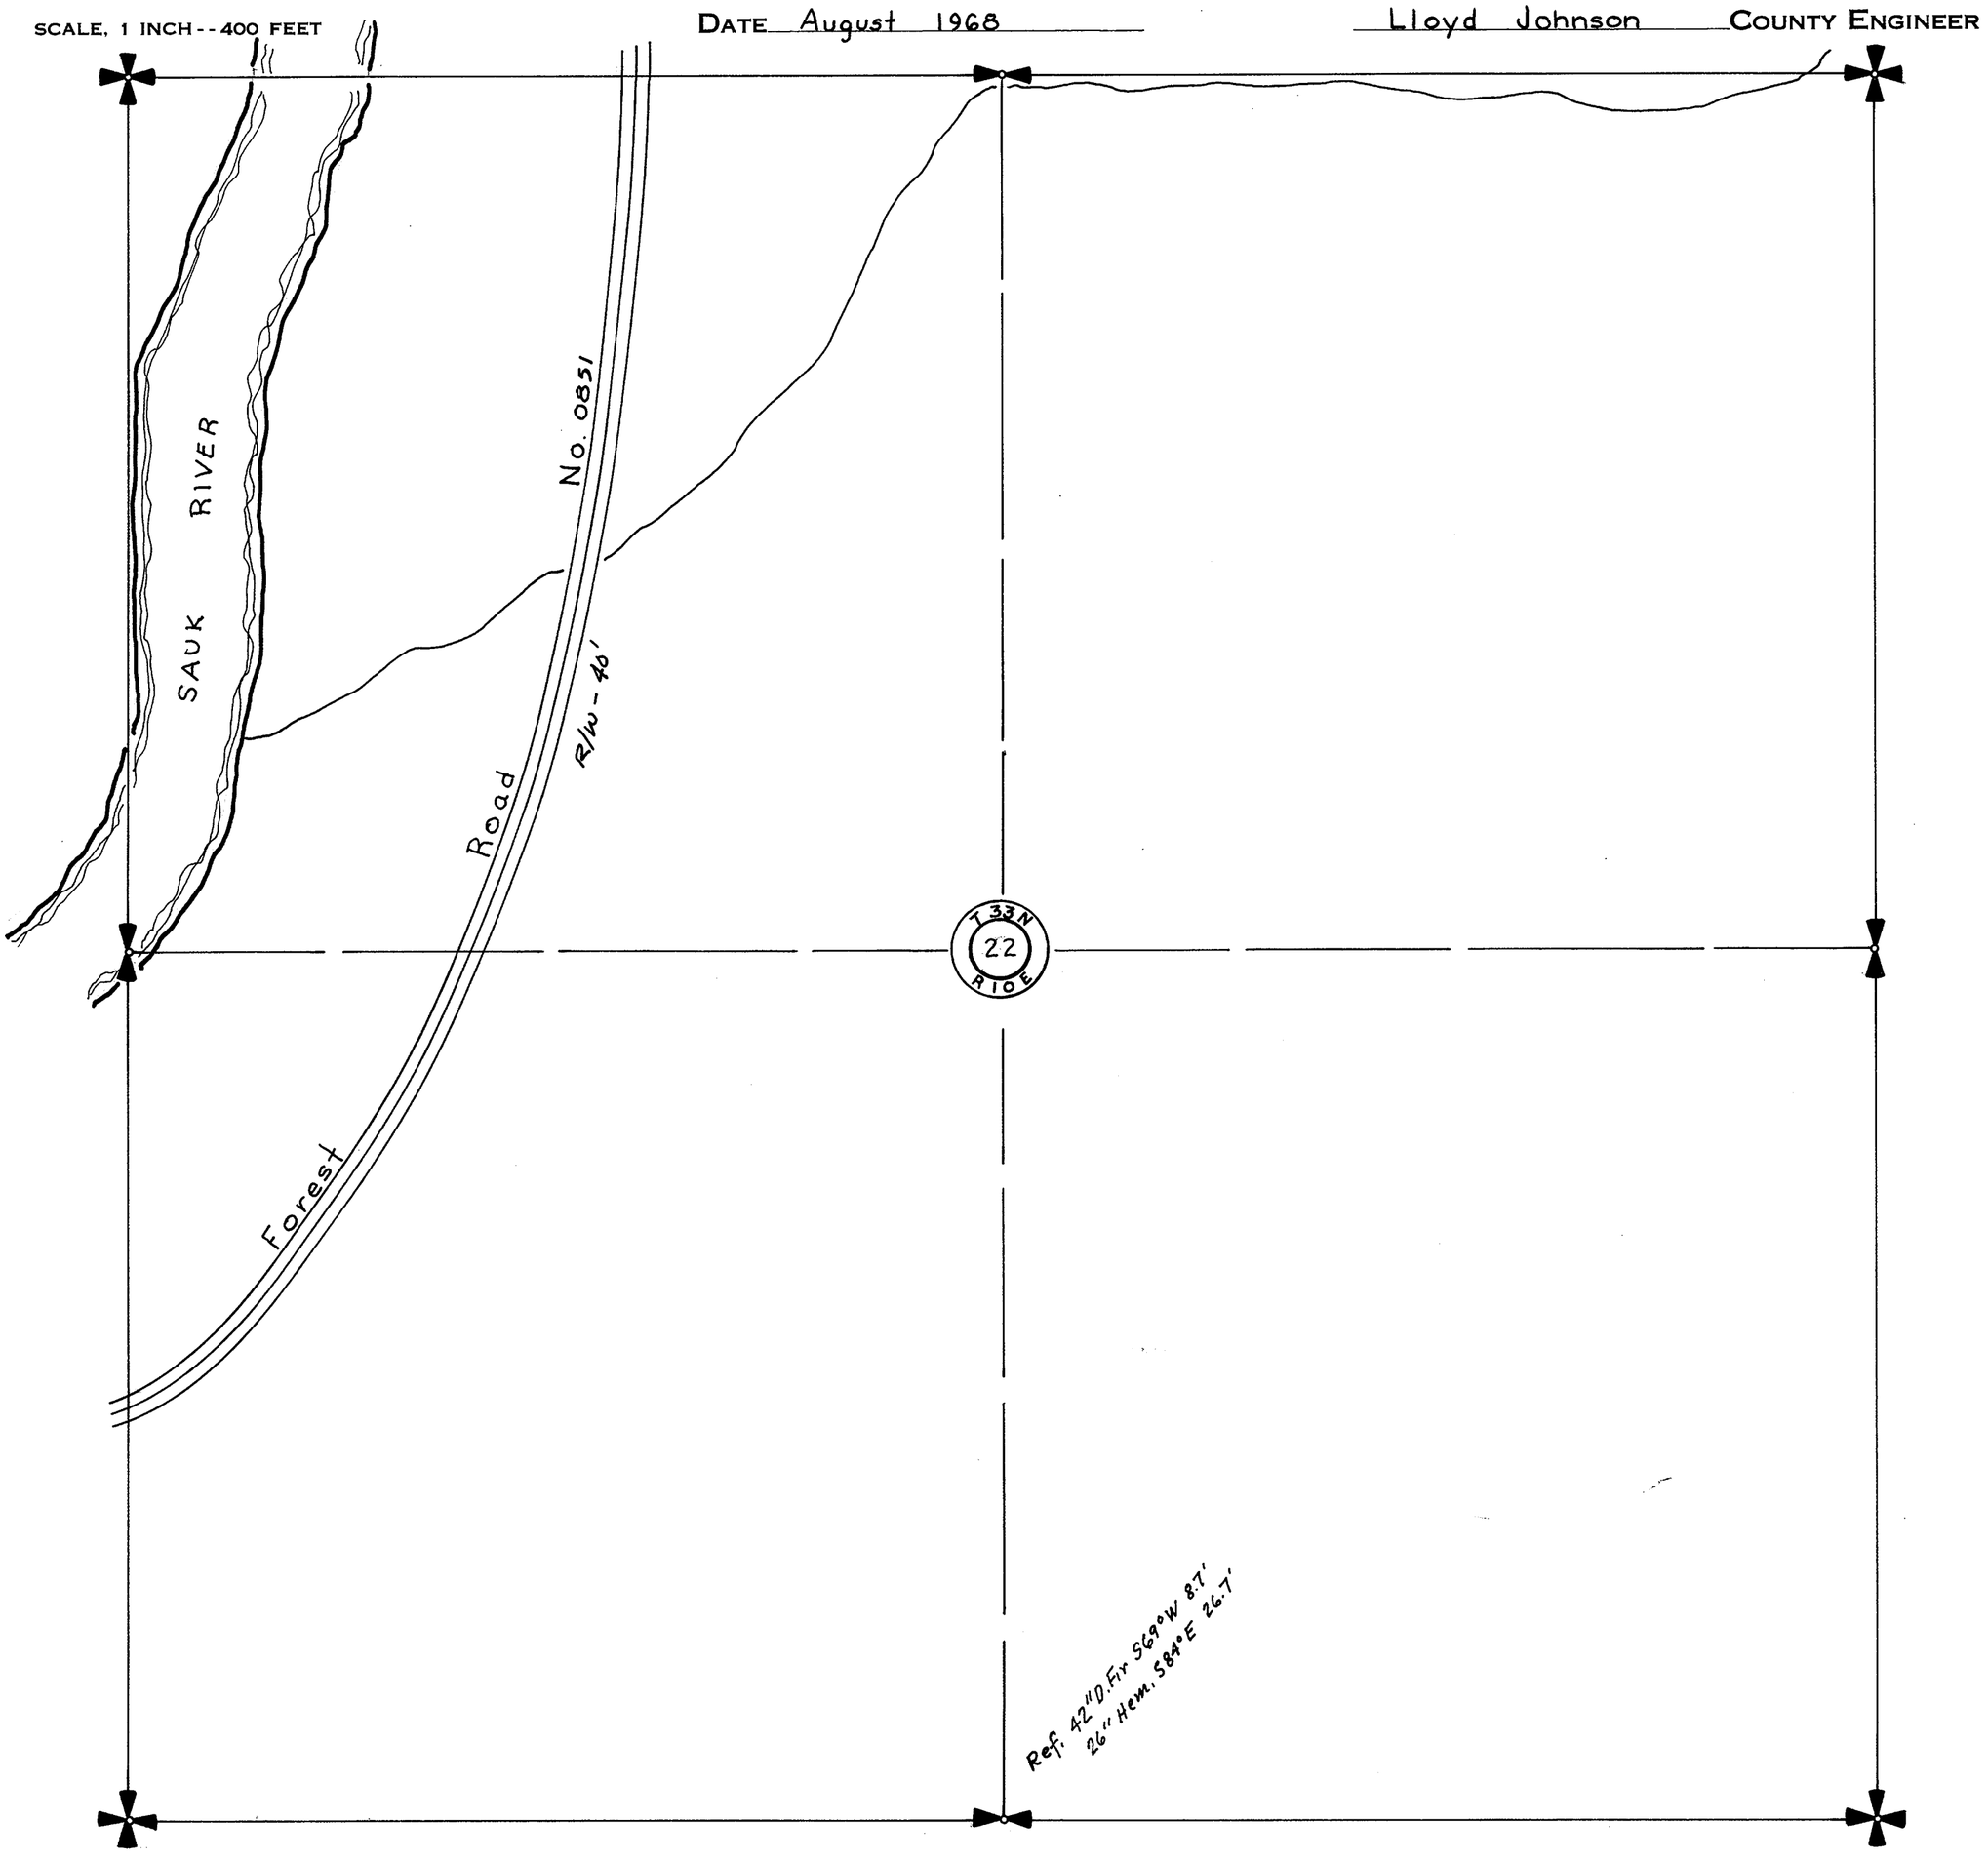

SECTION 28


TOWNSHIP 33 NORTH, RANGE 10 EAST, W. M.

SKAGIT COUNTY, WASH.

SCALE, 1 INCH--400 FEET

DATE Aug. 24, 1966

Lloyd Johnson COUNTY ENGINEER

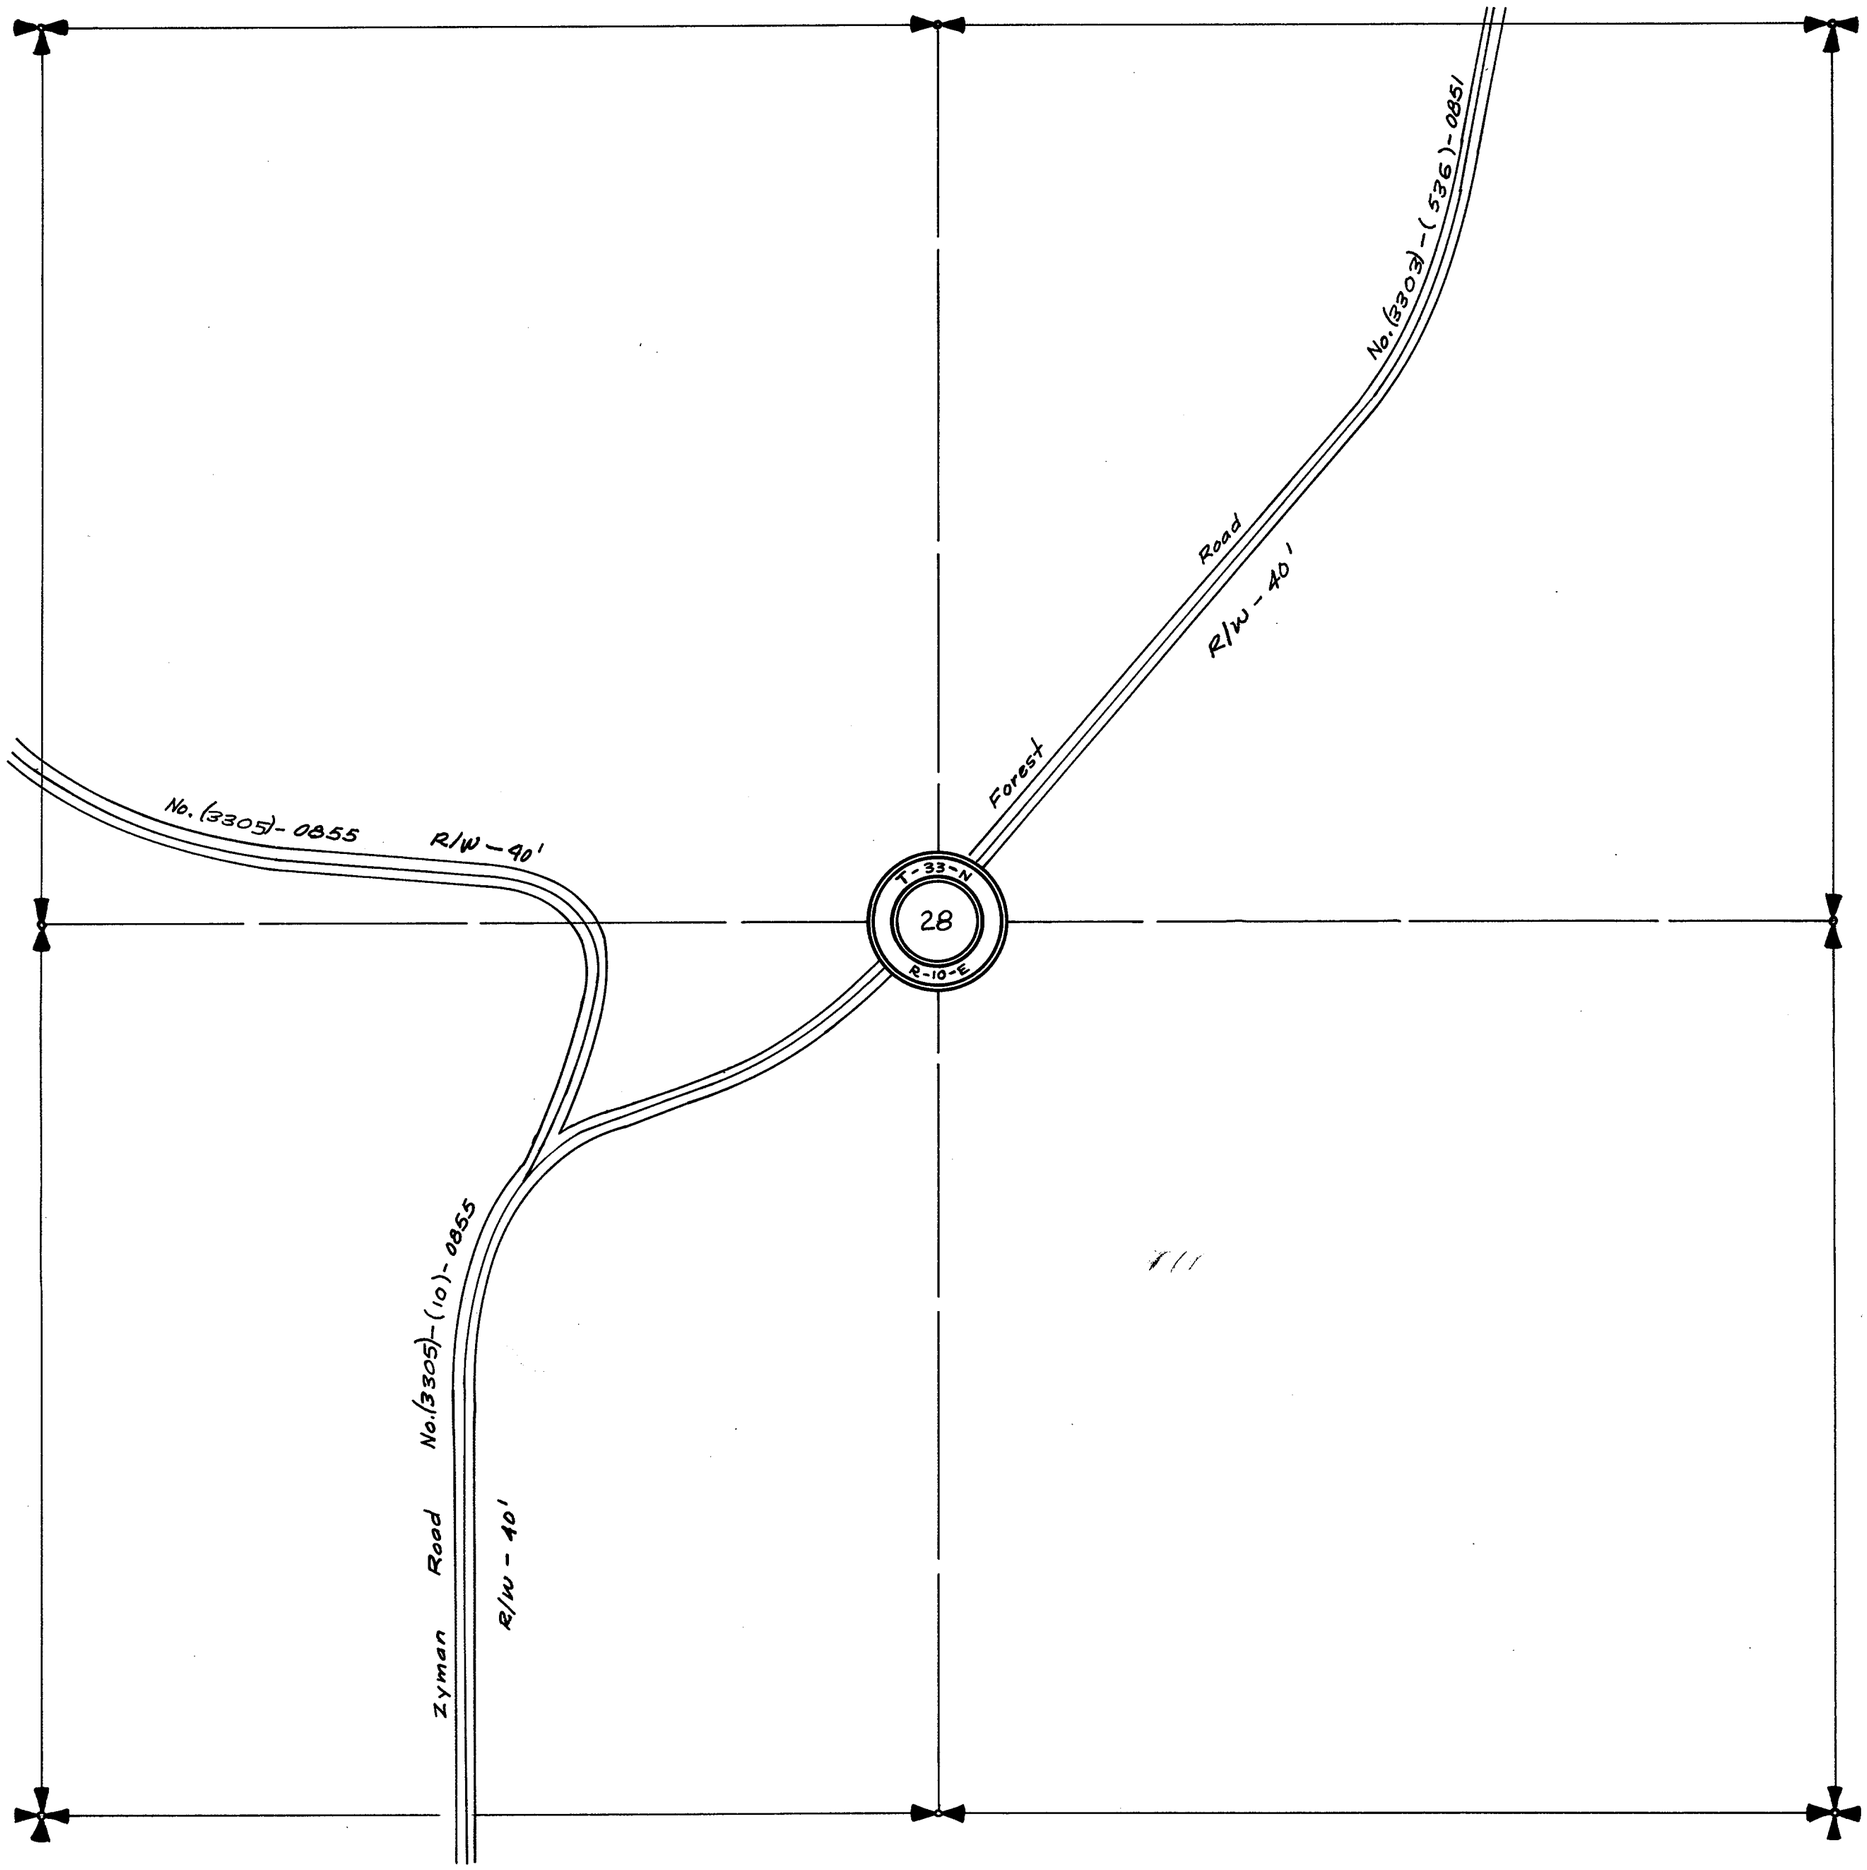


SECTION 29

TOWNSHIP 33 NORTH, RANGE 10 EAST, W. M.

SKAGIT COUNTY, WASH.

DATE Feb 24, 1972 — LLOYD JOHNSON — COUNTY ENGINEER

SCALE, 1 INCH -- 400 FEET

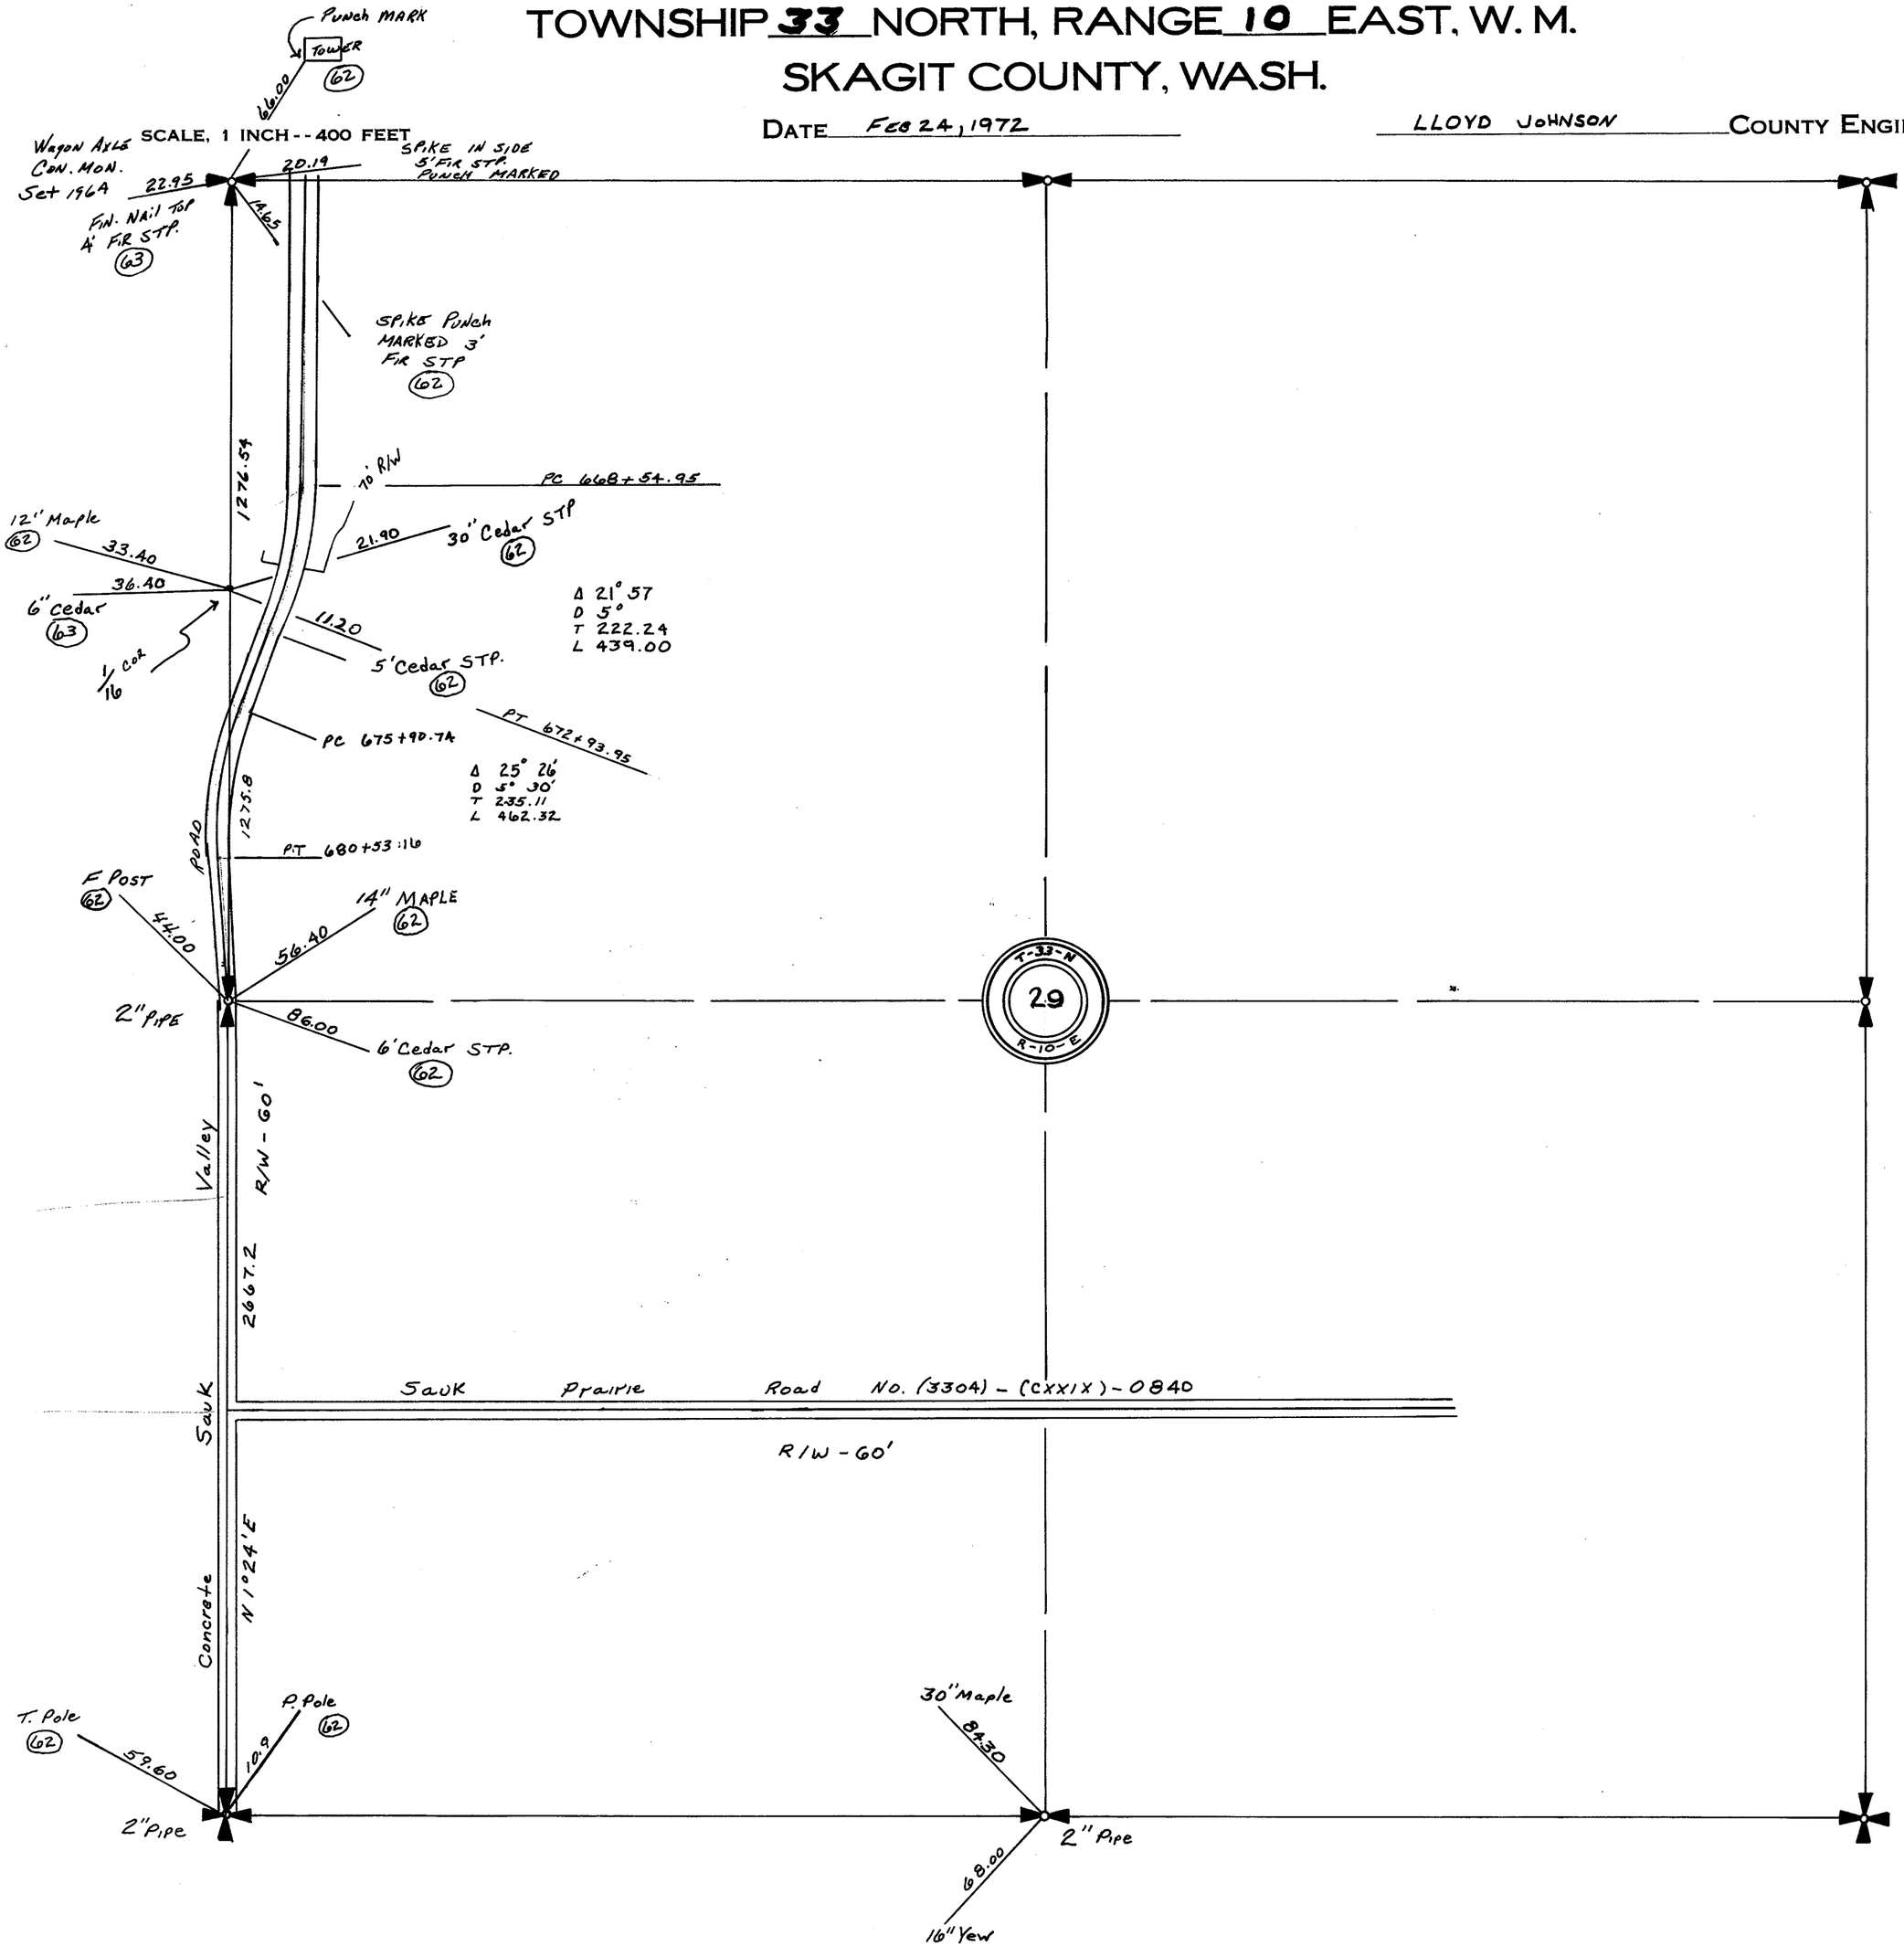

SECTION 29

TOWNSHIP 33 NORTH, RANGE 10 EAST, W. M.

SKAGIT COUNTY, WASH.

SCALE, 1 INCH -- 400 FEET


Lloyd Johnson COUNTY ENGINEER

Punch Mark TOWER (62)










12" Maple (62)

33.40

36.40

6" Cedar (62)

21.90 30" Cedar Stp. (62)

11.20 5' Cedar Stp. (62)



1275.8

F. Post (62)

44.00


2" Pipe

86.00 6' Cedar Stp. (62)

T-33-N
29
R-10-E

Road

Valley

R/W - 60'

2667.2

Sauk Prairie Road No. (3304) - (CXXIX) - 0840

R/W - 60'

Sauk

Concrete

N 1°24'E

T. Pole (62)

59.60

P. Pole (62)


2" Pipe

30" Maple

SW 30

2" Pipe

68.00

16" Yew

SECTION 31

TOWNSHIP 33 NORTH, RANGE 10 EAST, W. M.

SKAGIT COUNTY, WASH.

SCALE, 1 INCH -- 400 FEET

DATE FEB 24, 1972

LLOYD JOHNSON COUNTY ENGINEER

NOTES : 257

T. 33 N
31
R. 10 E

T. Pole (63) 59.50

1" Pipe Placed 1/4" Pipe over 1" Pipe (43) 83.80

95.10

15" Tack Window Sill

N.W. 4" Cedar STP (63)

No. (3301)-(3661)-0800

N 1° 43' E 2664.7

R/W - 60'

Road

24" Cedar STP. 68.30

T. Pole (63) 51.82

24" Cedar STP (63) 94.04

Drove 1/4" Pipe (63) 94.20

30" Cotton Wood (63)

58.00

14" Cotton Wood (63)

PC. 744+03.95

Valley

D = 13° 30'

R = 425.37

T = 50.55

L = 100.25

PT. 749+58.12

PT. 746+89.10

Fortner Road

No. (3302)-(539)-(0300)-0808

R/W - 30'

Sauk

Concrete

Car Axle West Side of Road

SECTION 31

TOWNSHIP 33 NORTH, RANGE 10 EAST, W. M.

SKAGIT COUNTY, WASH.

SCALE, 1 INCH - - 400 FEET

DATE _____

Lloyd Johnson COUNTY ENGINEER

Notes: 257

T. Pole (63) 59.50

1" Pipe Placed 1¼" Pipe over 1" Pipe (43) 93.80

95.10

Hub Tack Window sill

N.W. 4' Cedar Stp. (63)

N 1° 43' E 2664.7




















SECTION 33


TOWNSHIP 33 NORTH, RANGE 10 EAST, W. M.

SKAGIT COUNTY, WASH.

SCALE, 1 INCH -- 400 FEET

DATE Aug. 24, 1966

Lloyd Johnson COUNTY ENGINEER

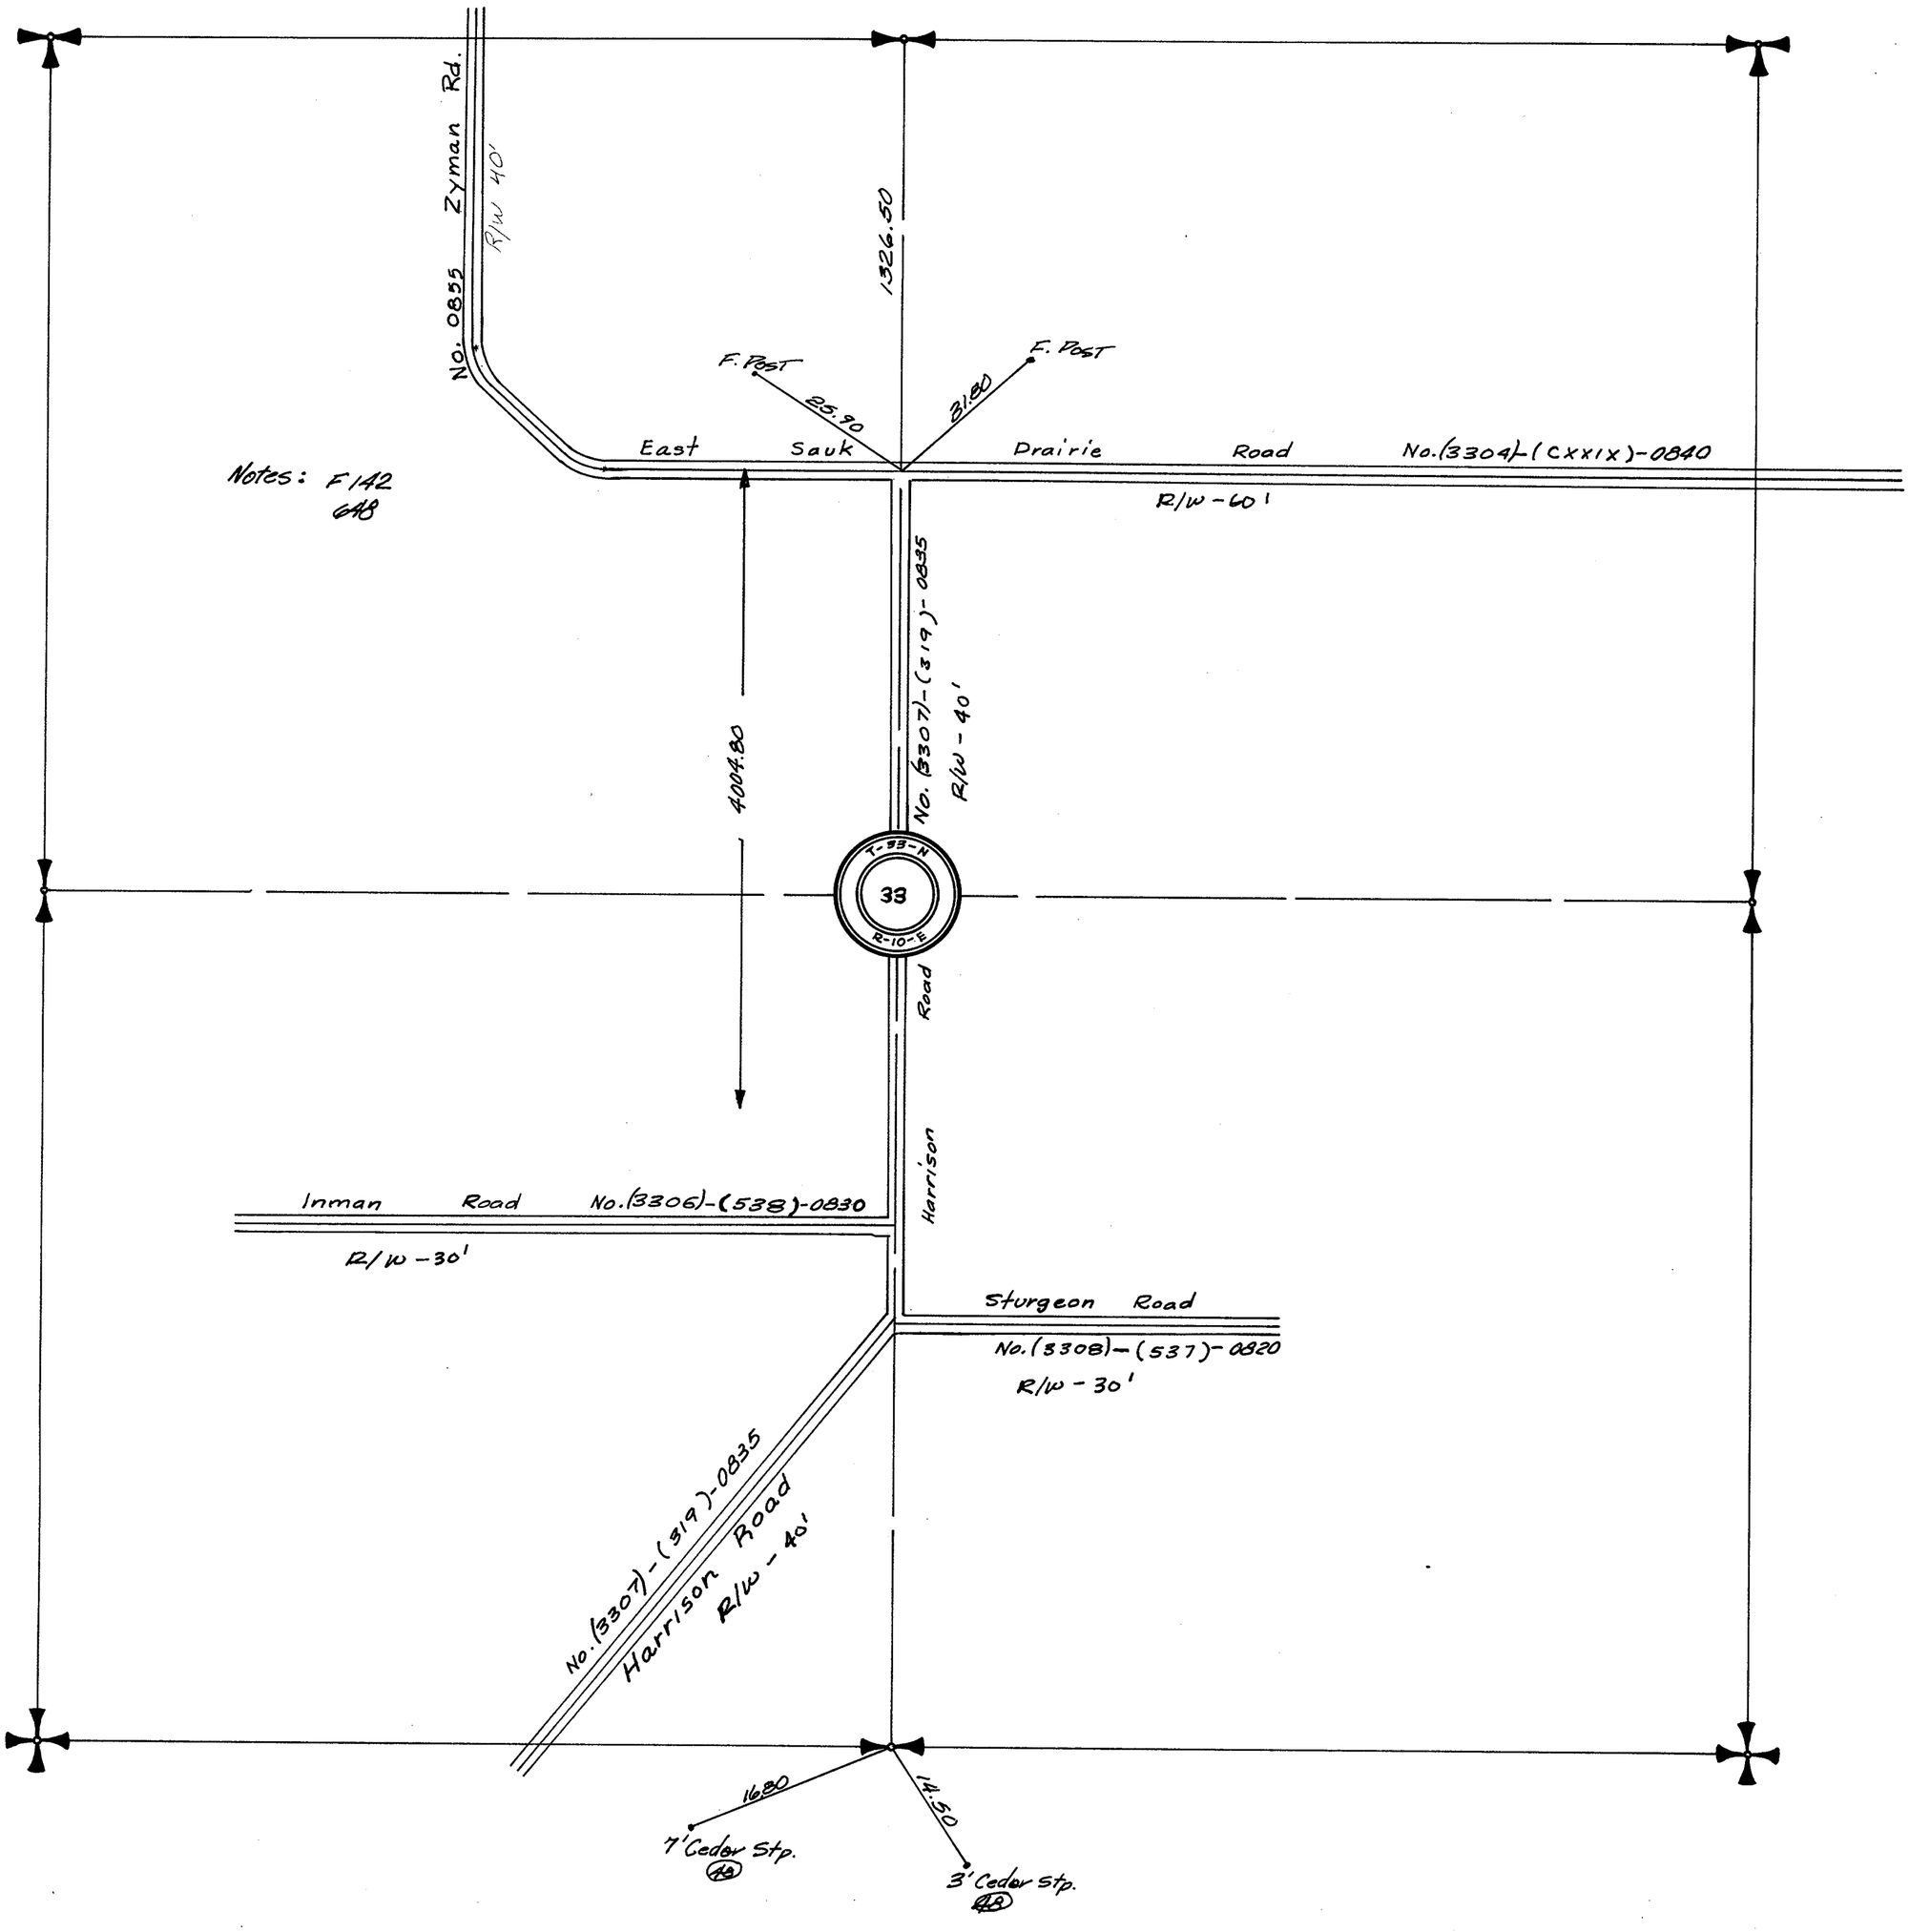

① SUIATTLE RIVER FOREST SITES
② SUIATTLE RIVER FOREST SITES


SECTION 32

TOWNSHIP 33 NORTH, RANGE 11 EAST, W. M.

SKAGIT COUNTY, WASH.

SCALE, 1 INCH--400 FEET

DATE APRIL 7, 1972 Lloyd H. Johnson COUNTY ENGINEER

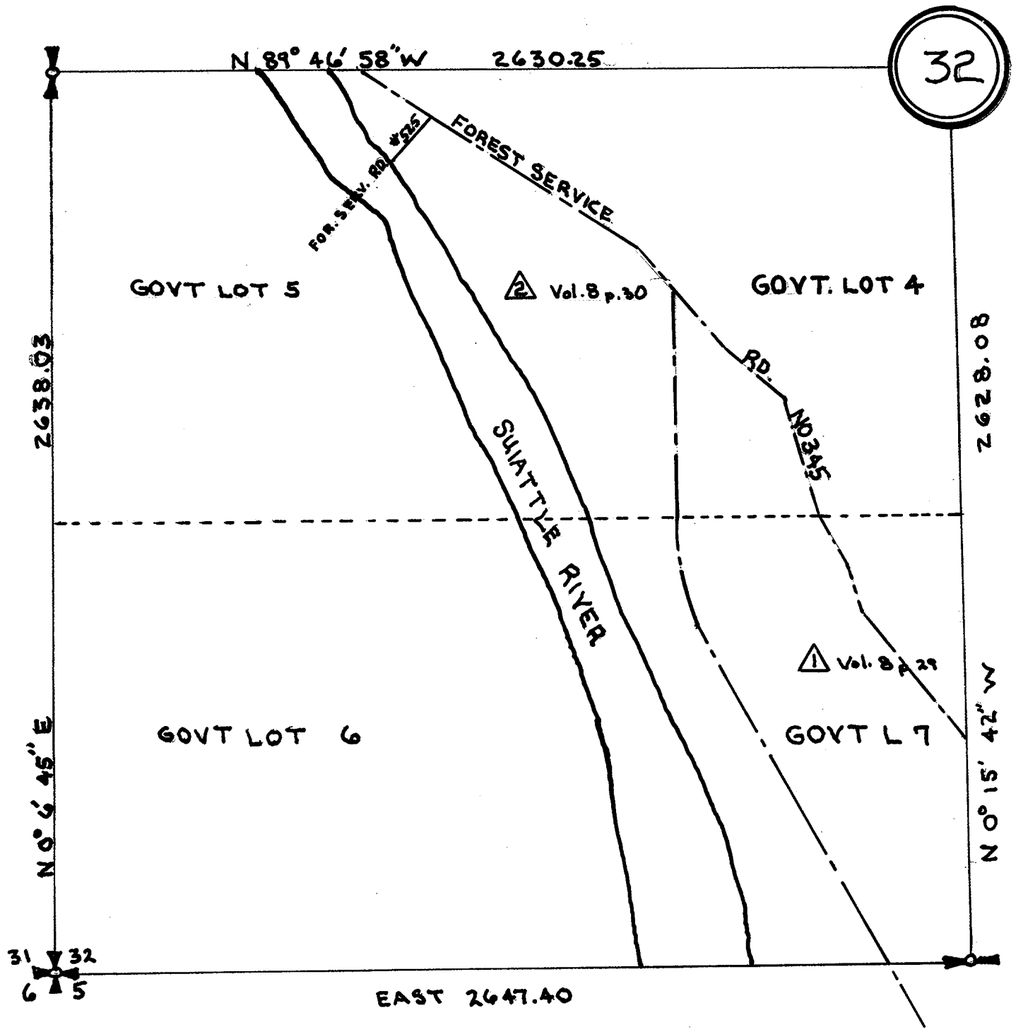


SECTION 1

TOWNSHIP 34 NORTH, RANGE 1 EAST, W. M.

SKAGIT COUNTY, WASH.

SCALE, 1 INCH--400 FEET
Road No. 2 from Notes 48/618

G. D. LeGro
July 1958
COUNTY ENGINEER

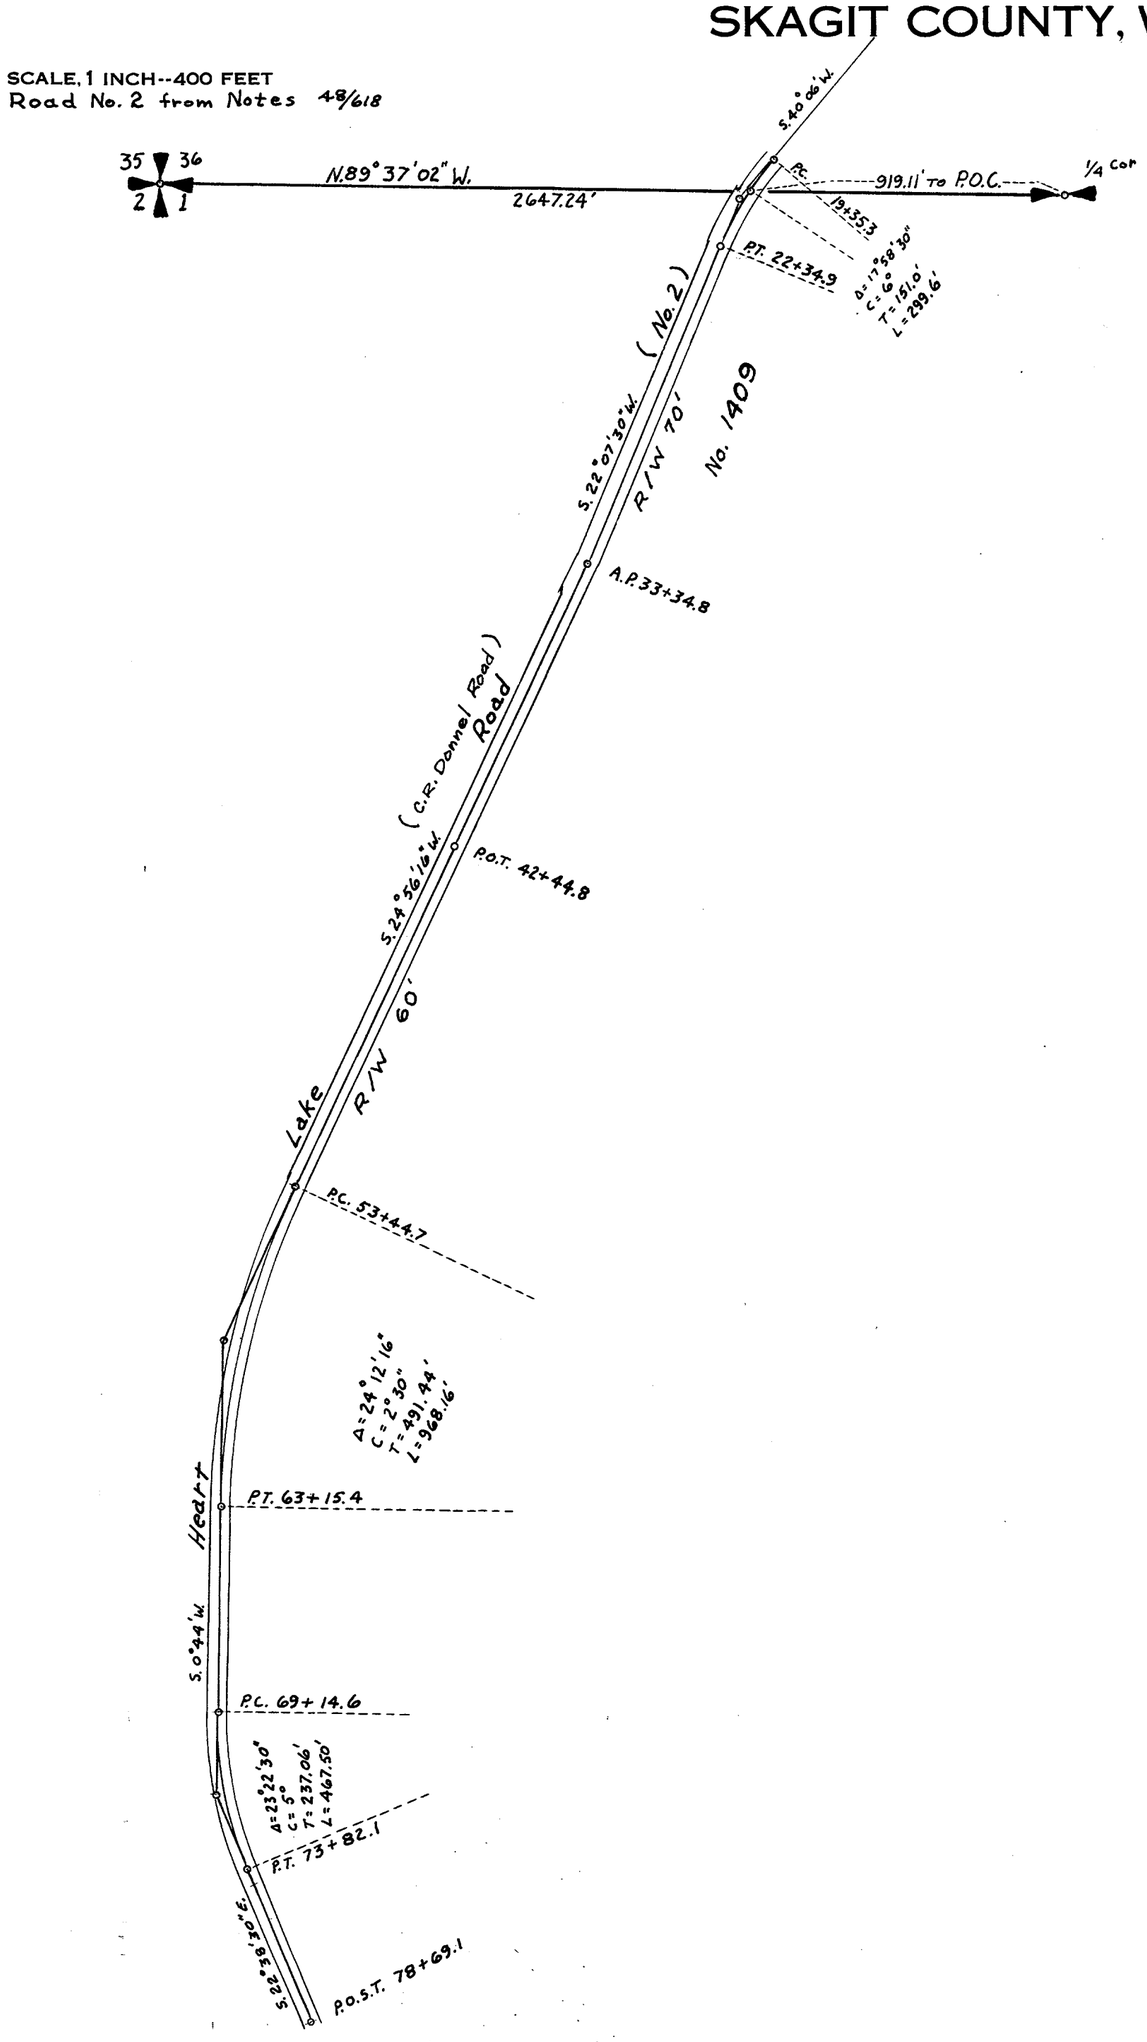

SECTION 1


TOWNSHIP 34 NORTH, RANGE 1 EAST, W. M.

SKAGIT COUNTY, WASH.

SCALE, 1 INCH--400 FEET

DATE June 20, 1966

Lloyd H. Johnson COUNTY ENGINEER

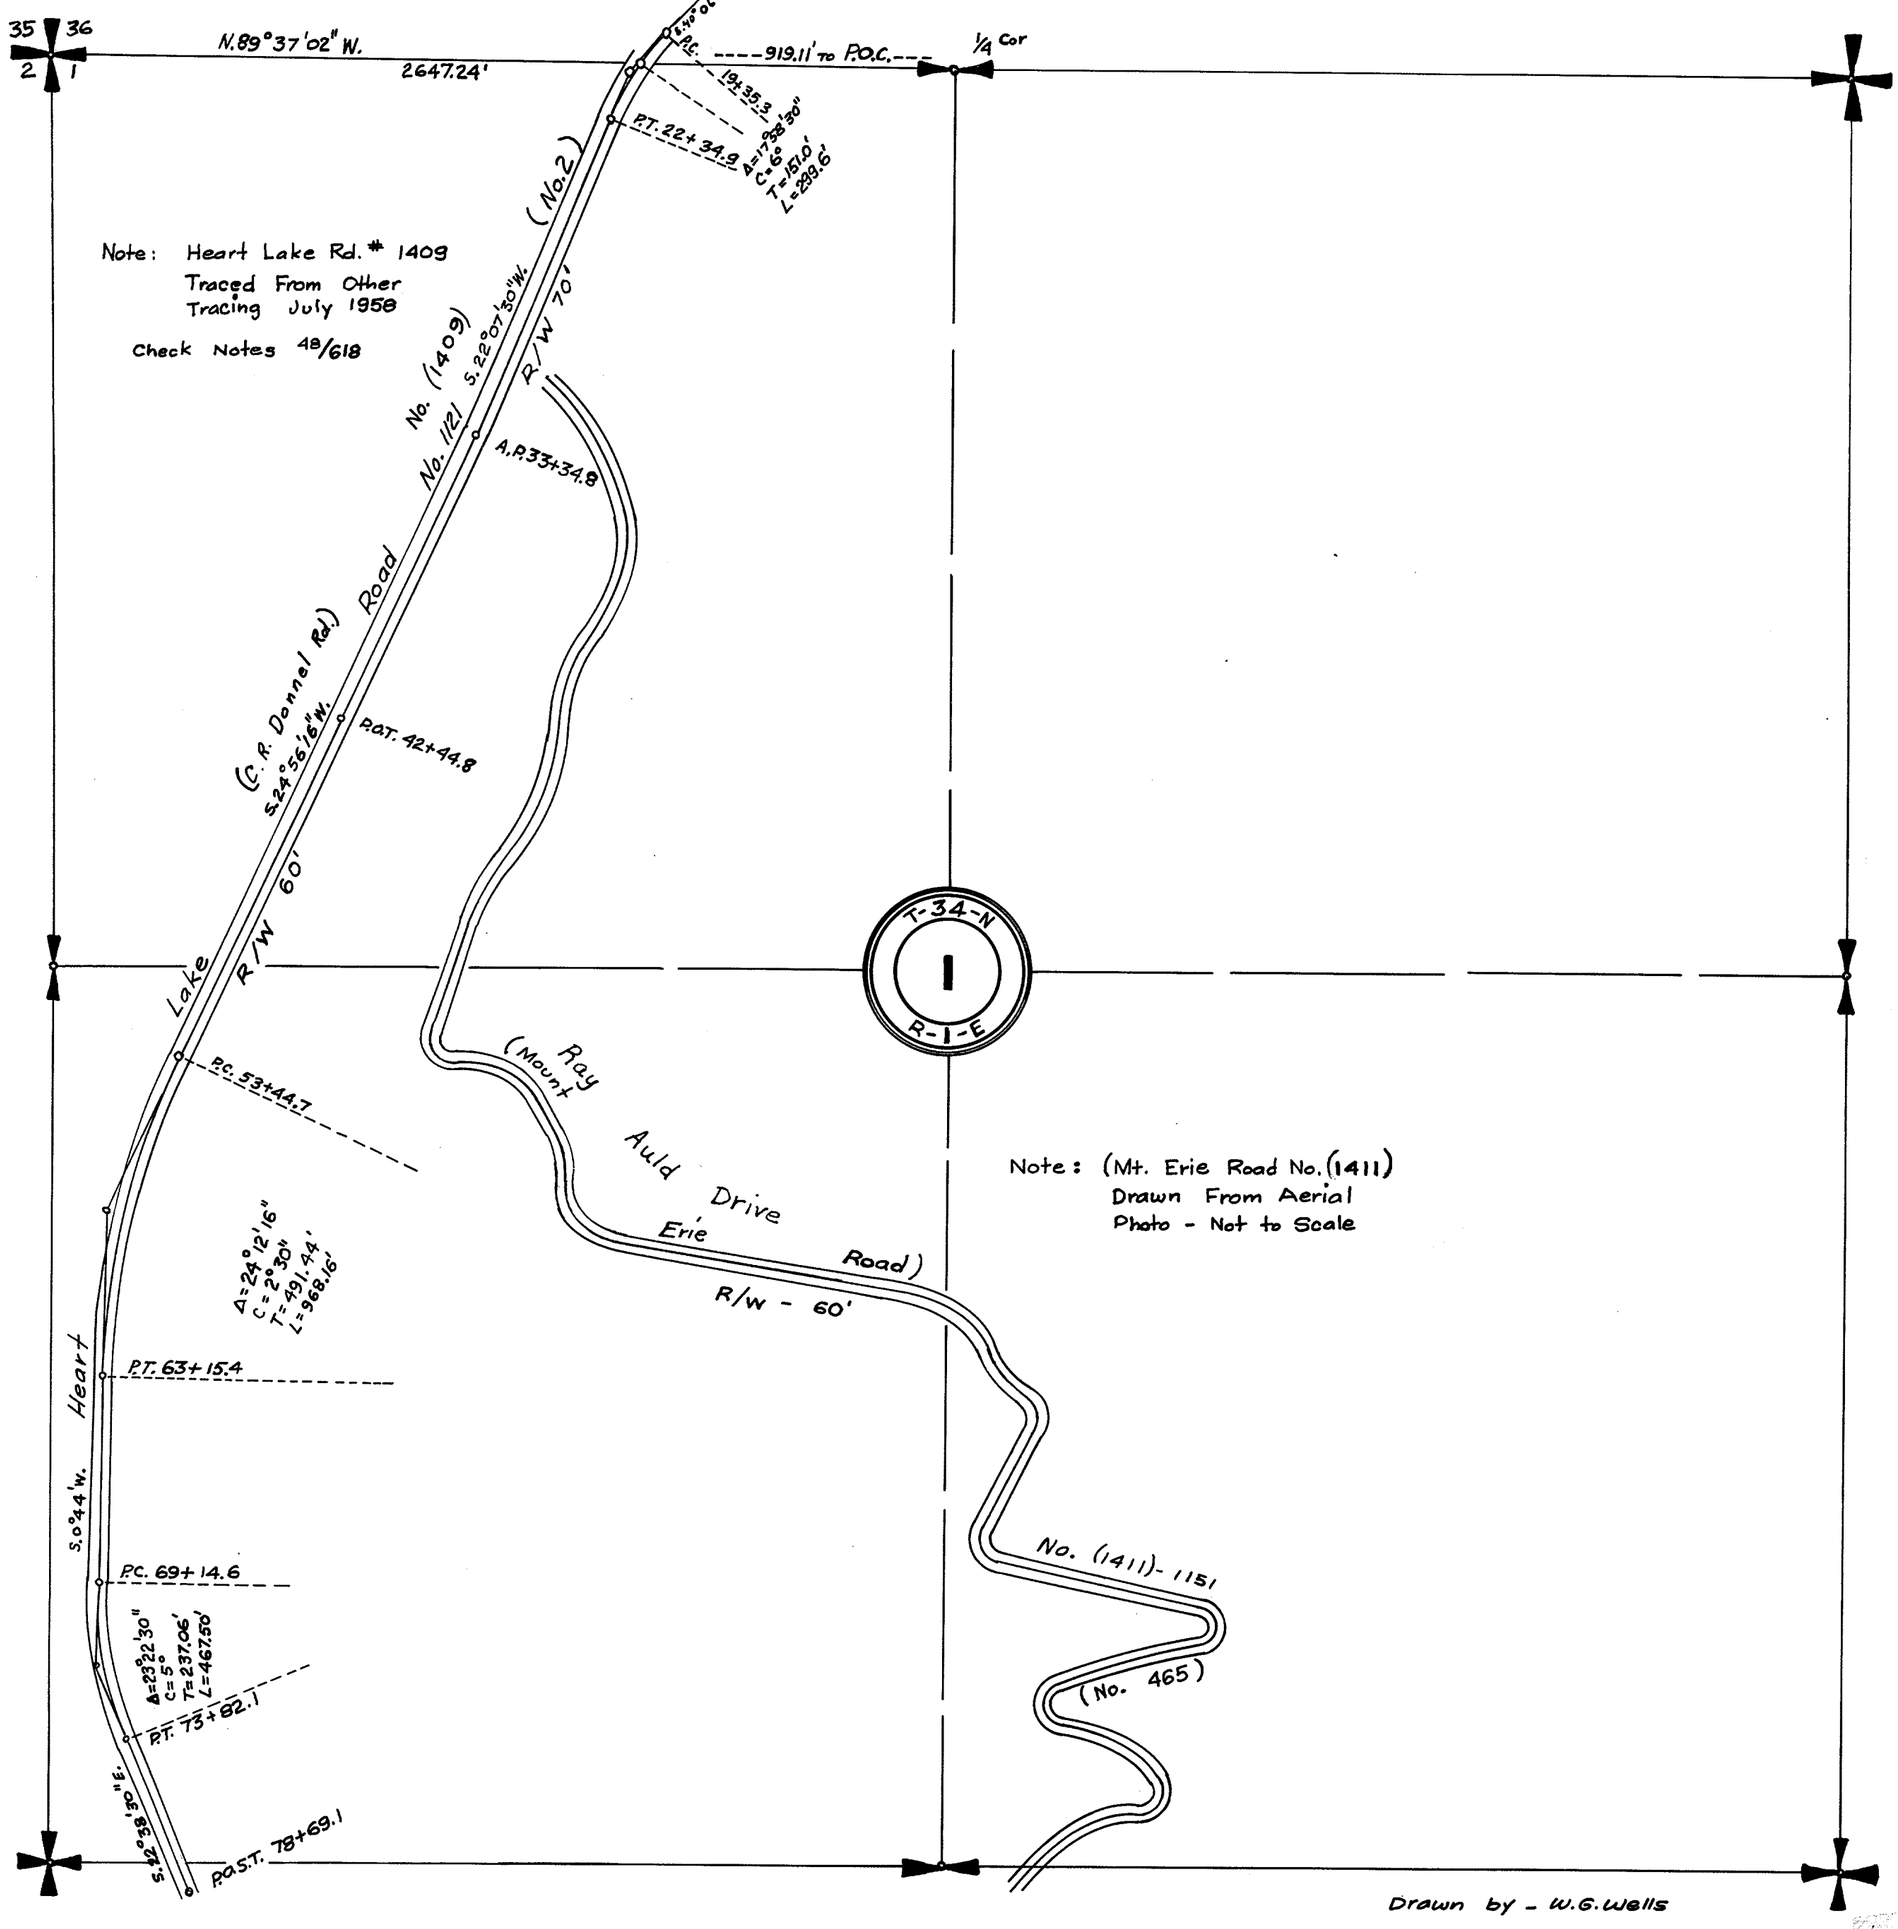

Drawn by - W.G. Wells

SECTION 2


TOWNSHIP 34 NORTH, RANGE 1 EAST, W. M.

SKAGIT COUNTY, WASH.

SCALE, 1 INCH--400 FEET

Frank Gilkey - 1945 ~~COUNTY~~ ENGINEER

See also Plat "Rancho Del Mar"

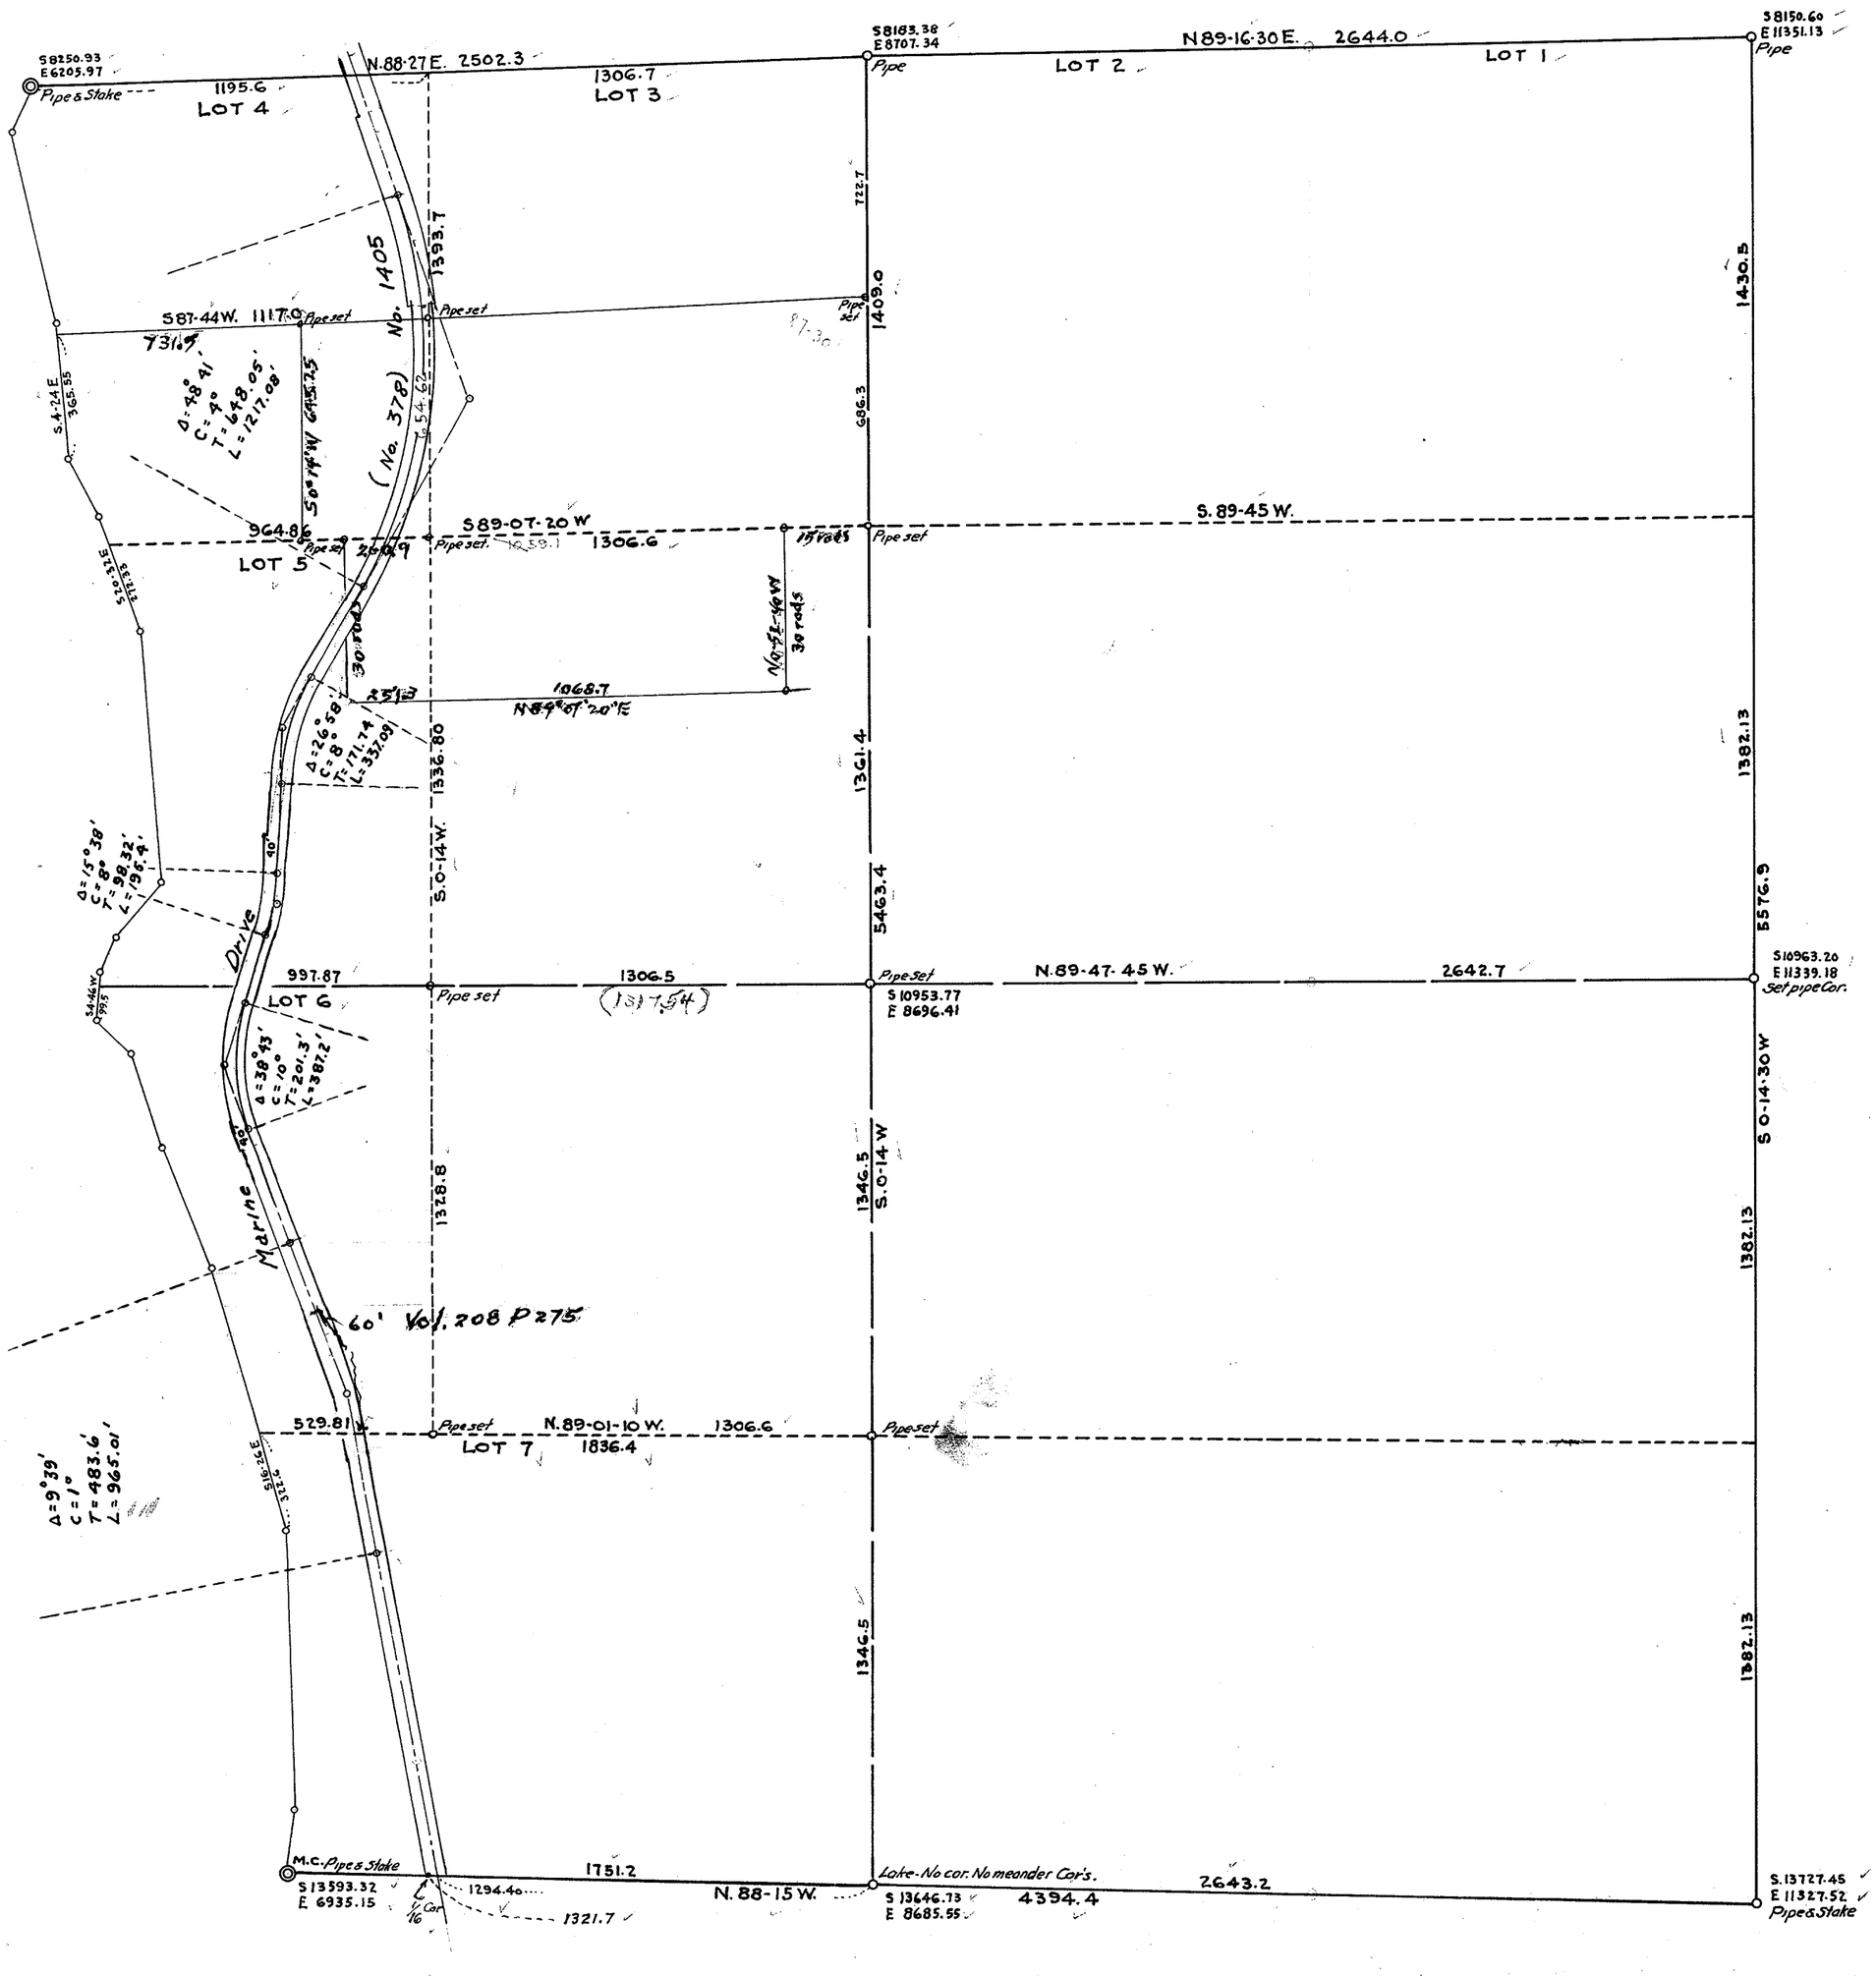


SECTION 2

TOWNSHIP 34 NORTH, RANGE 1 EAST, W. M.

SKAGIT COUNTY, WASH.

SCALE, 1 INCH--400 FEET

DATE June 20, 1966 — Lloyd Johnson COUNTY ENGINEER

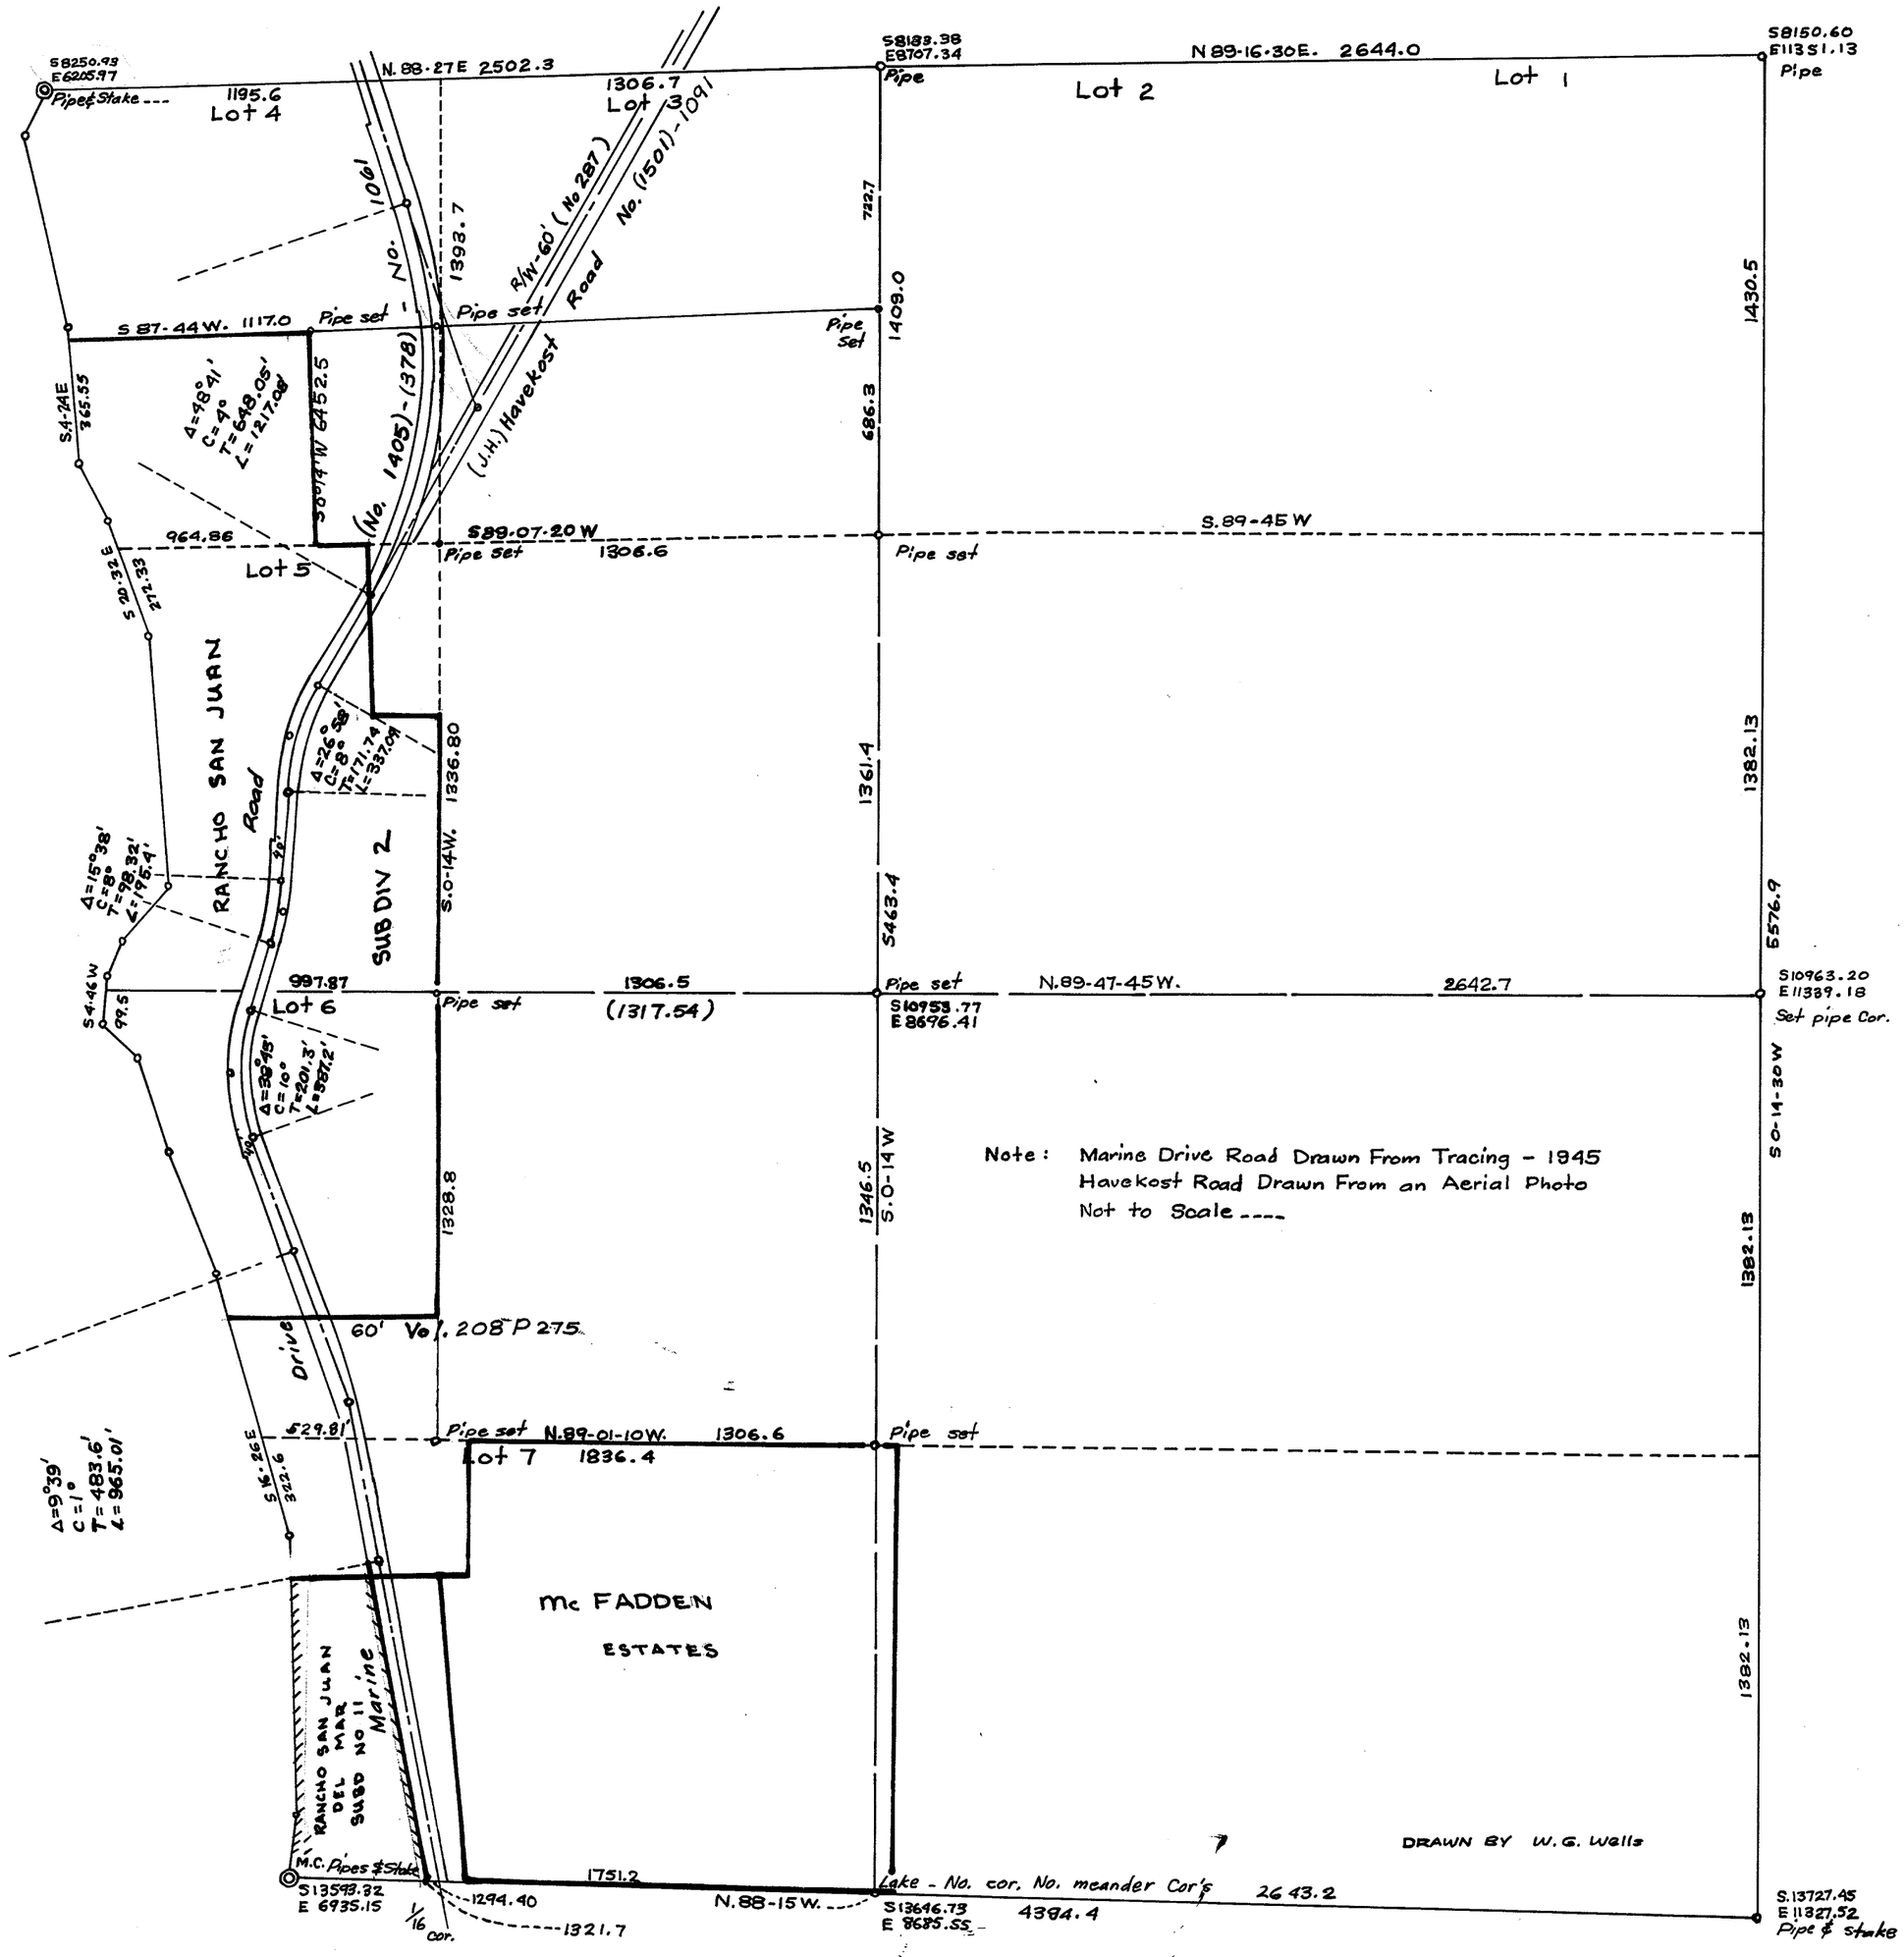

SECTION 2


TOWNSHIP 34 NORTH, RANGE 1 EAST, W. M.

SKAGIT COUNTY, WASH.

Subdiv. by Frank Gilkey 1945

SCALE, 1 INCH--400 FEET

_____ COUNTY ENGINEER

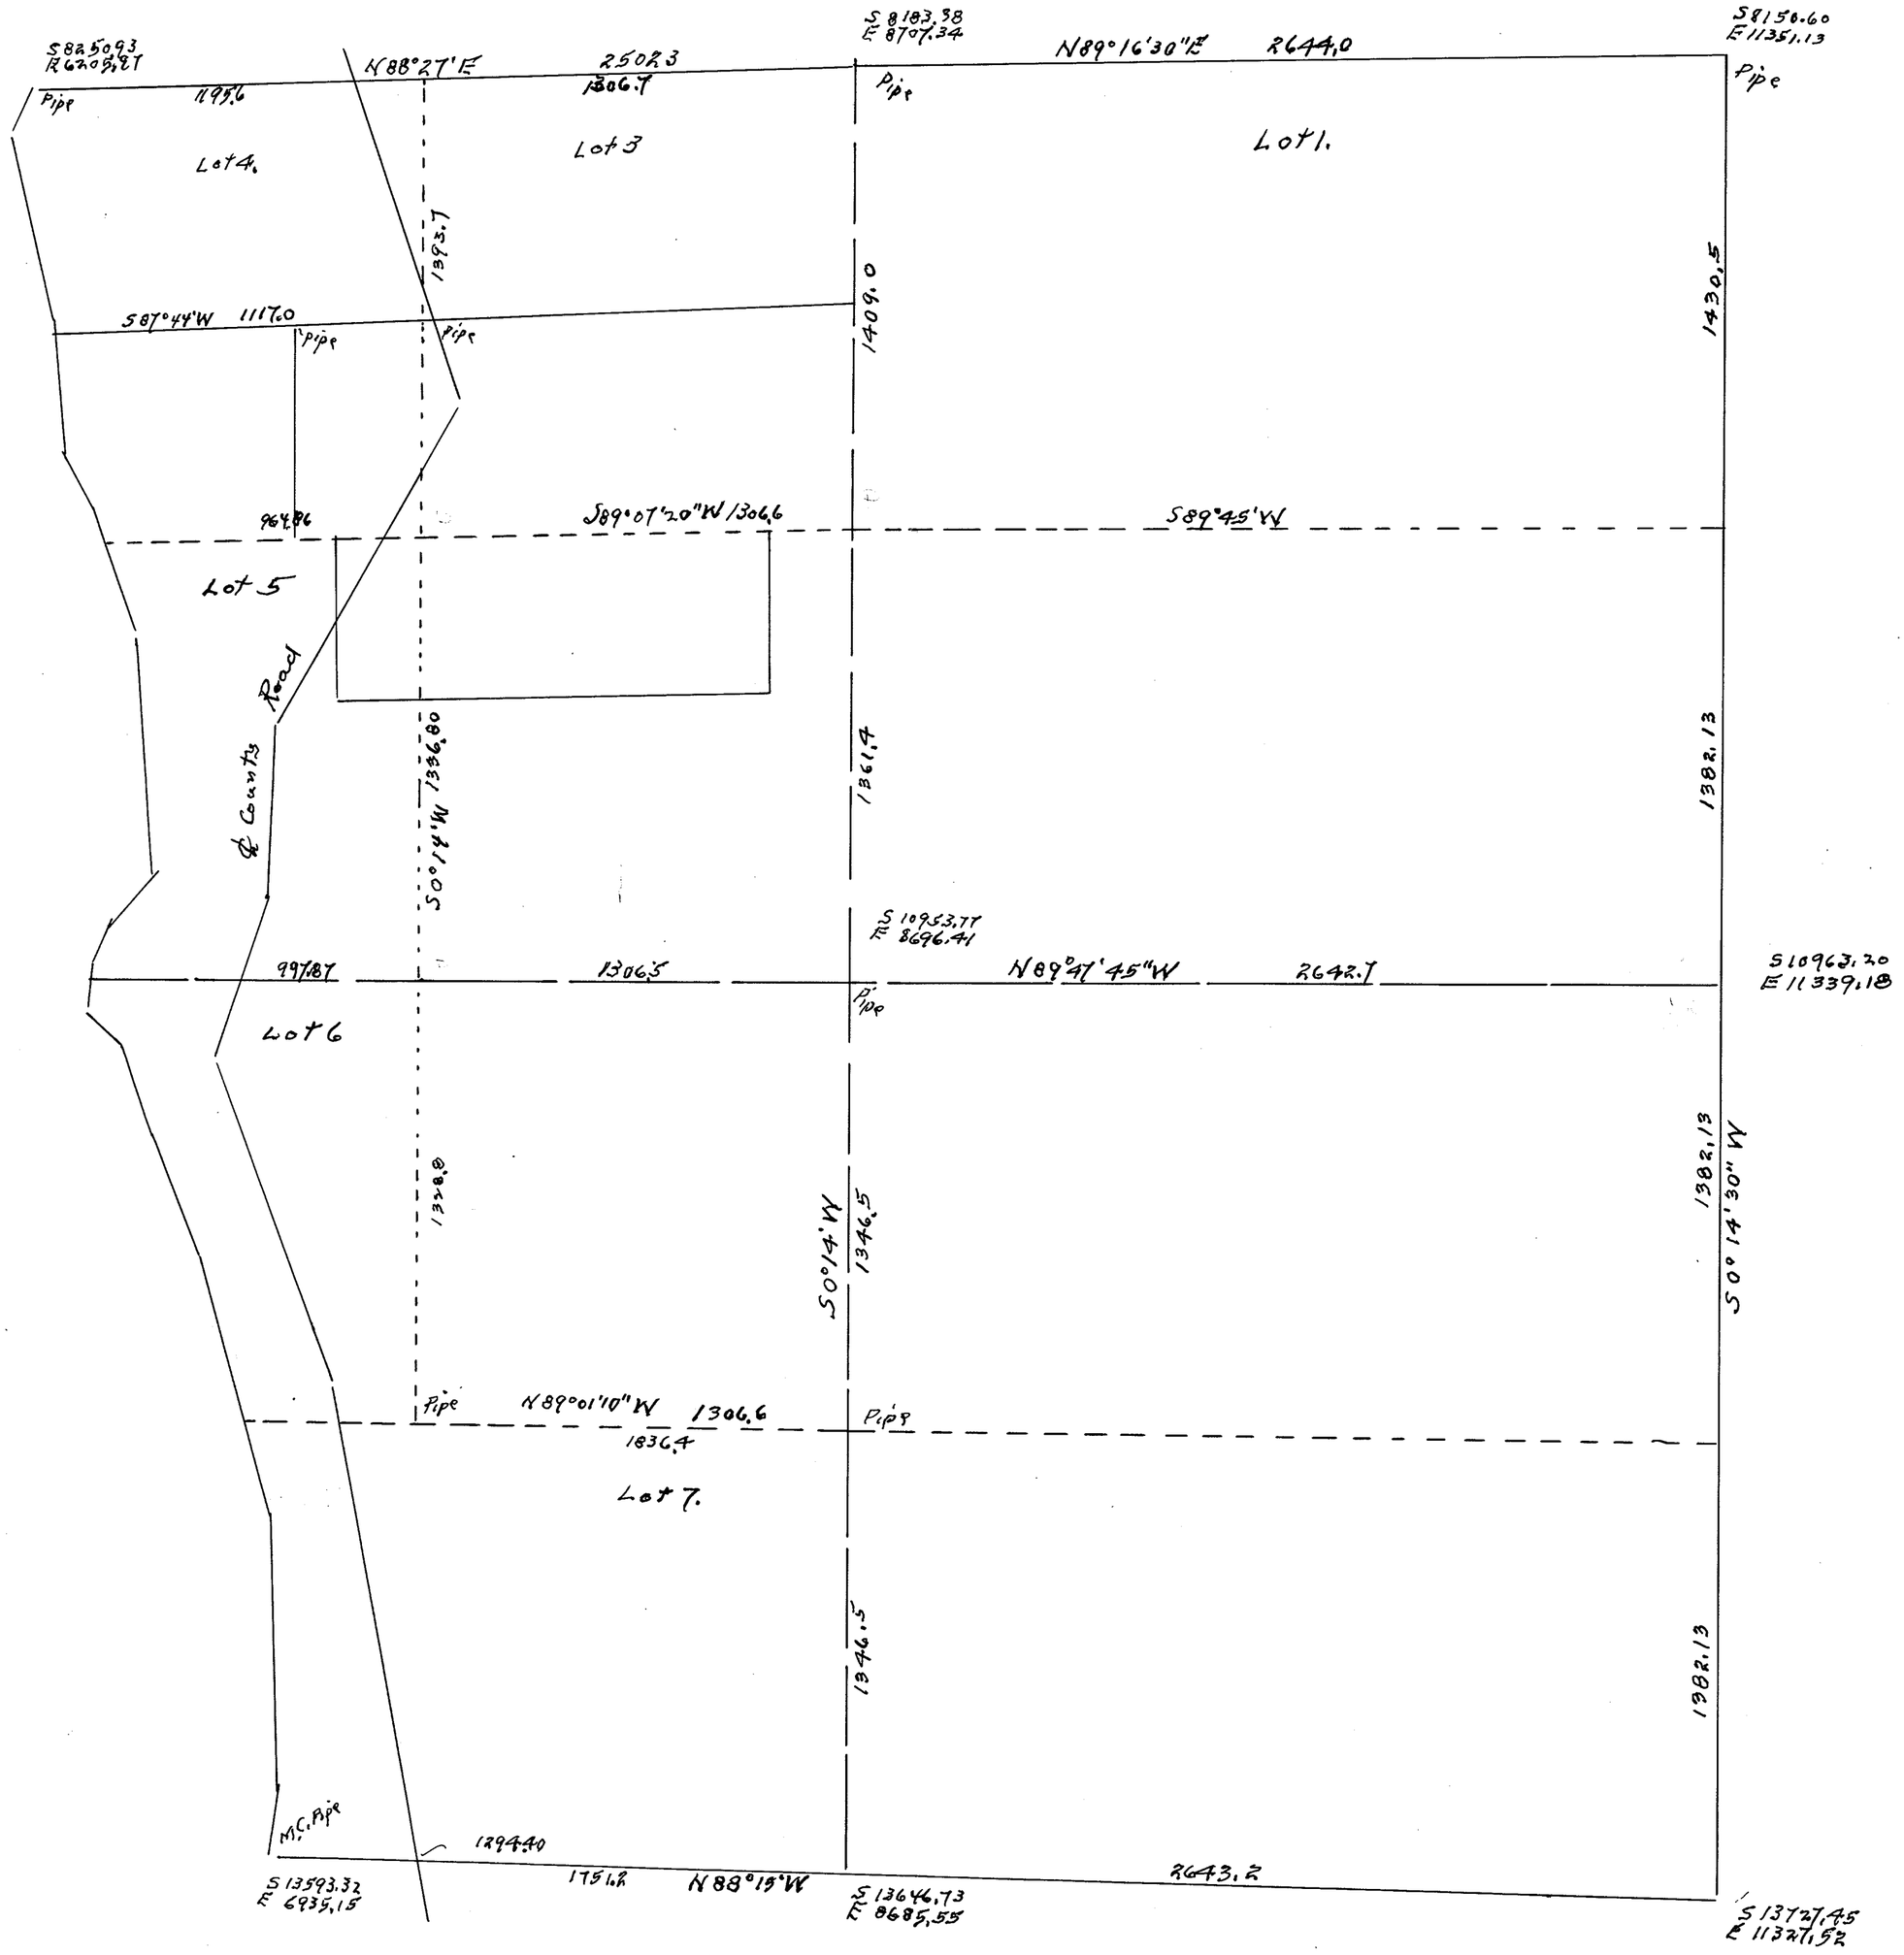


SECTION 10

TOWNSHIP 34 NORTH, RANGE 1 EAST, W. M.

SKAGIT COUNTY, WASH.

SCALE, 1 INCH--400 FEET

DATE June 21, 1966 Lloyd Johnson COUNTY ENGINEER

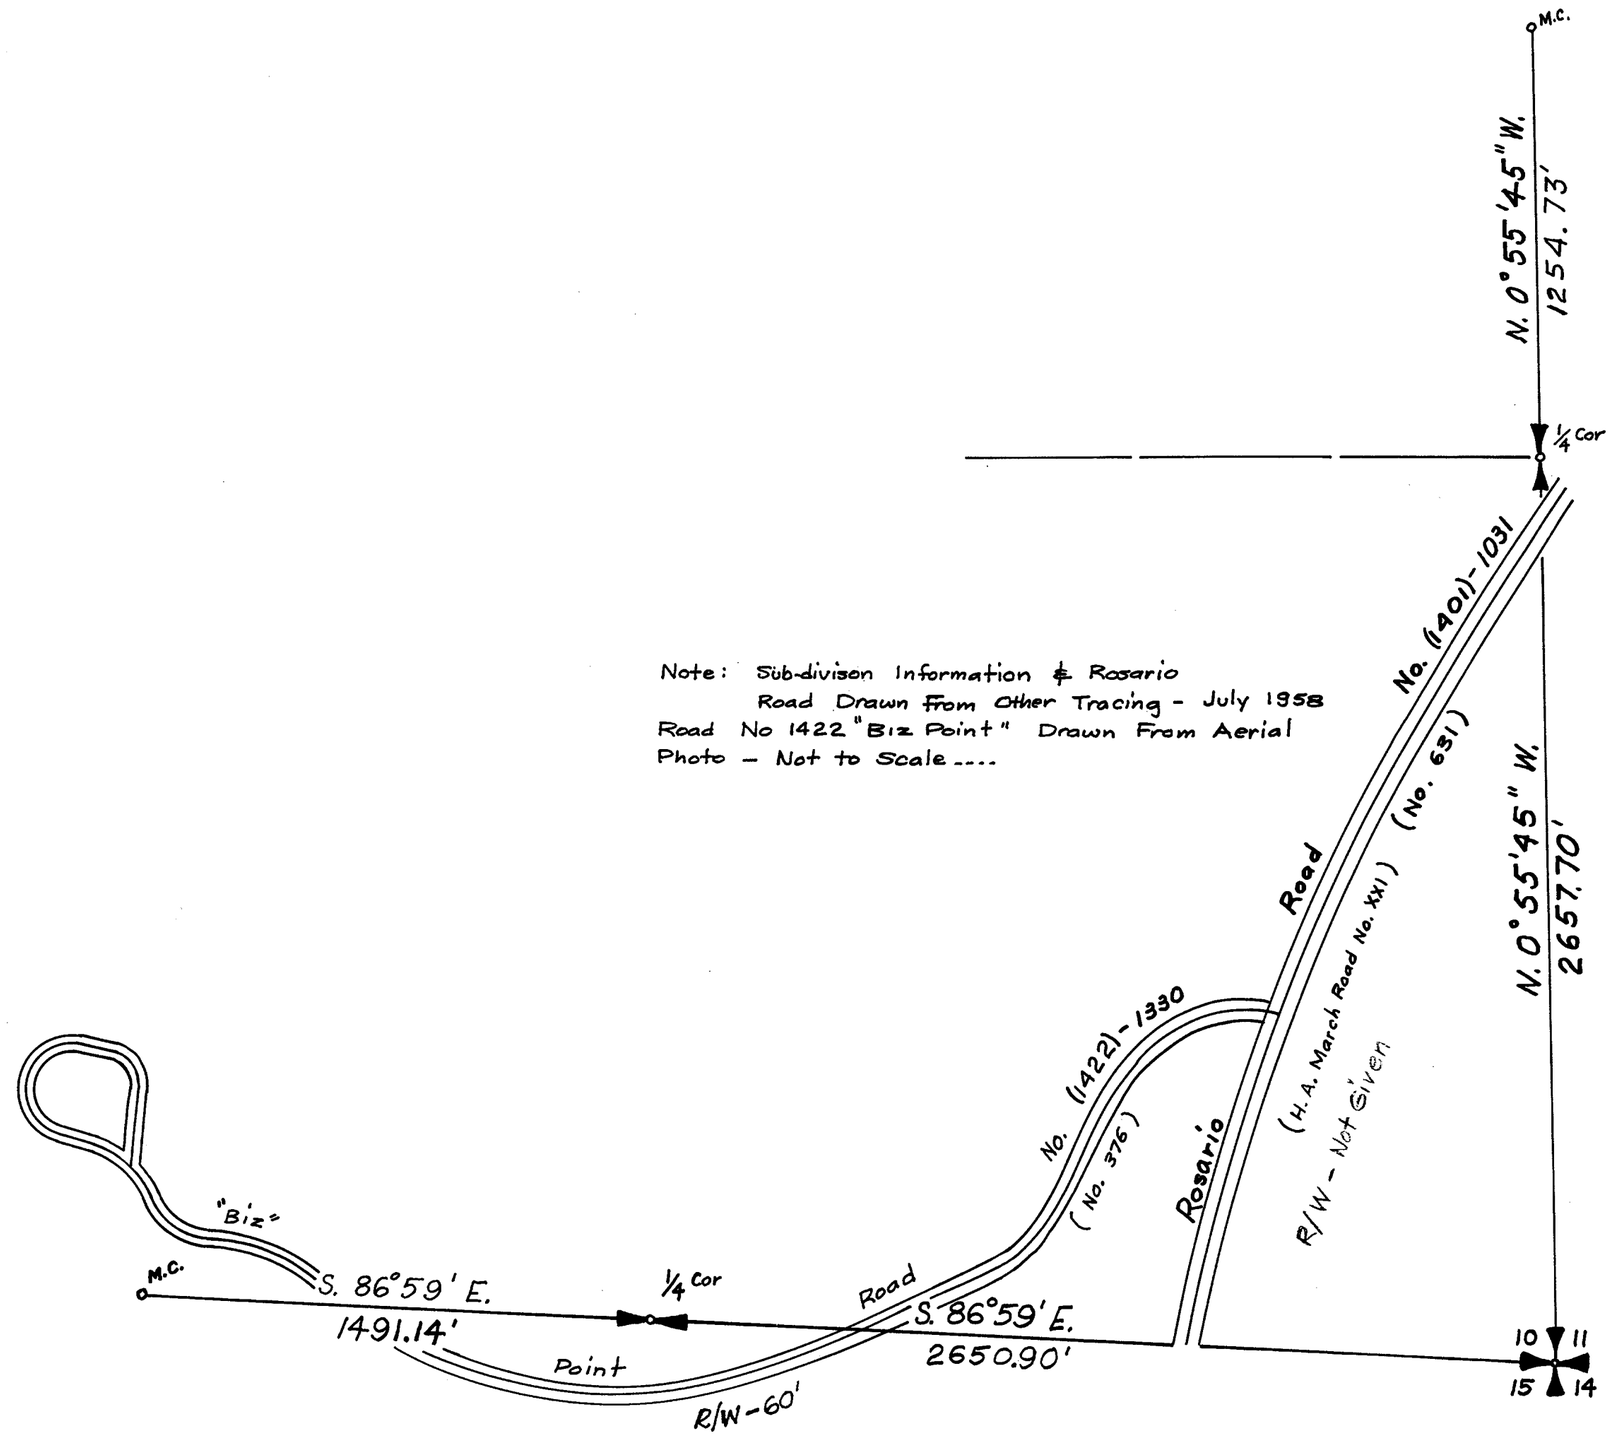


SECTION 10
TOWNSHIP 34 NORTH, RANGE 1 EAST, W.M.
SKAGIT COUNTY, WASH.

SCALE, 1 INCH 400 FEET

DATE MAY 2, 1972

LLOYD H. JOHNSON COUNTY ENGINEER

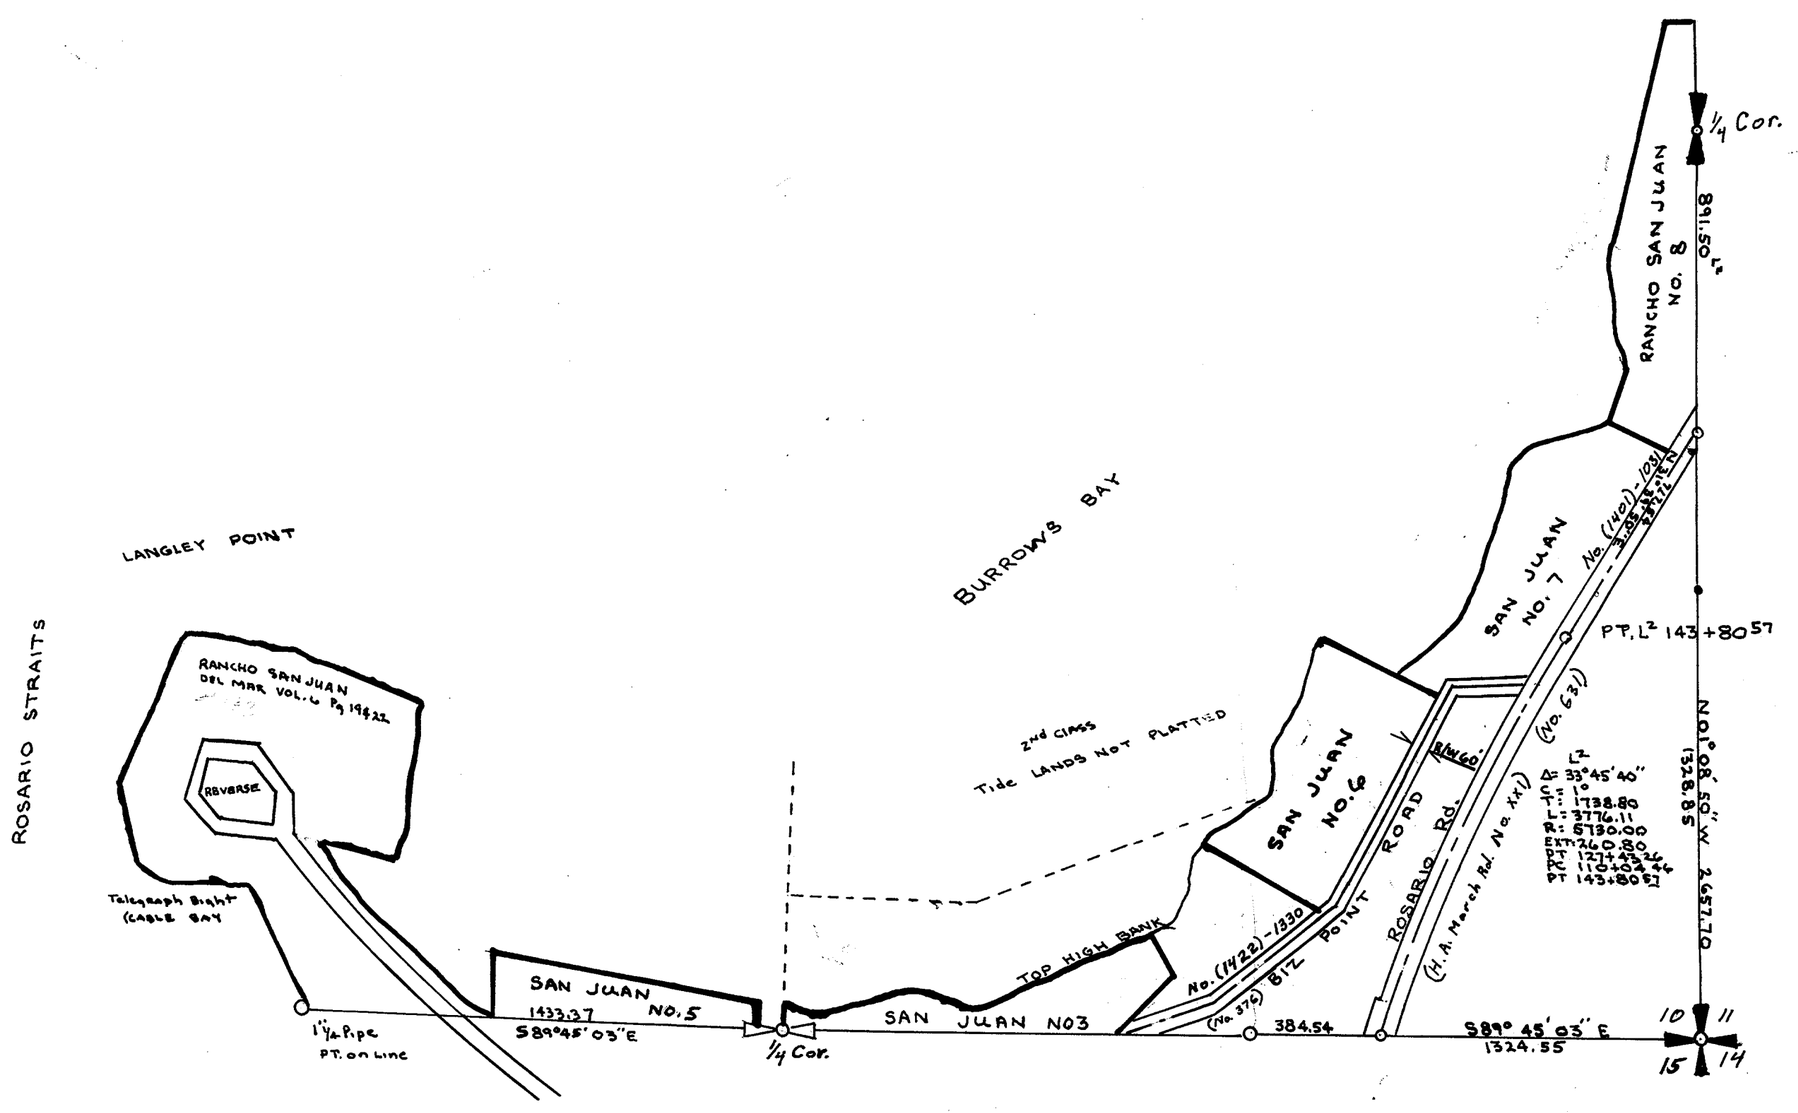

⚠ RANCHO SAN JUAN DEL MAR
SUBDIVISIONS No. 4 PLATE 3
VOL-6 Pg-22


SECTION 11

TOWNSHIP 34 NORTH, RANGE 1 EAST, W. M.

SKAGIT COUNTY, WASH.

SCALE, 1 INCH -- 400 FEET

DATE APRIL 10, 1972 Lloyd H. Johnson COUNTY ENGINEER

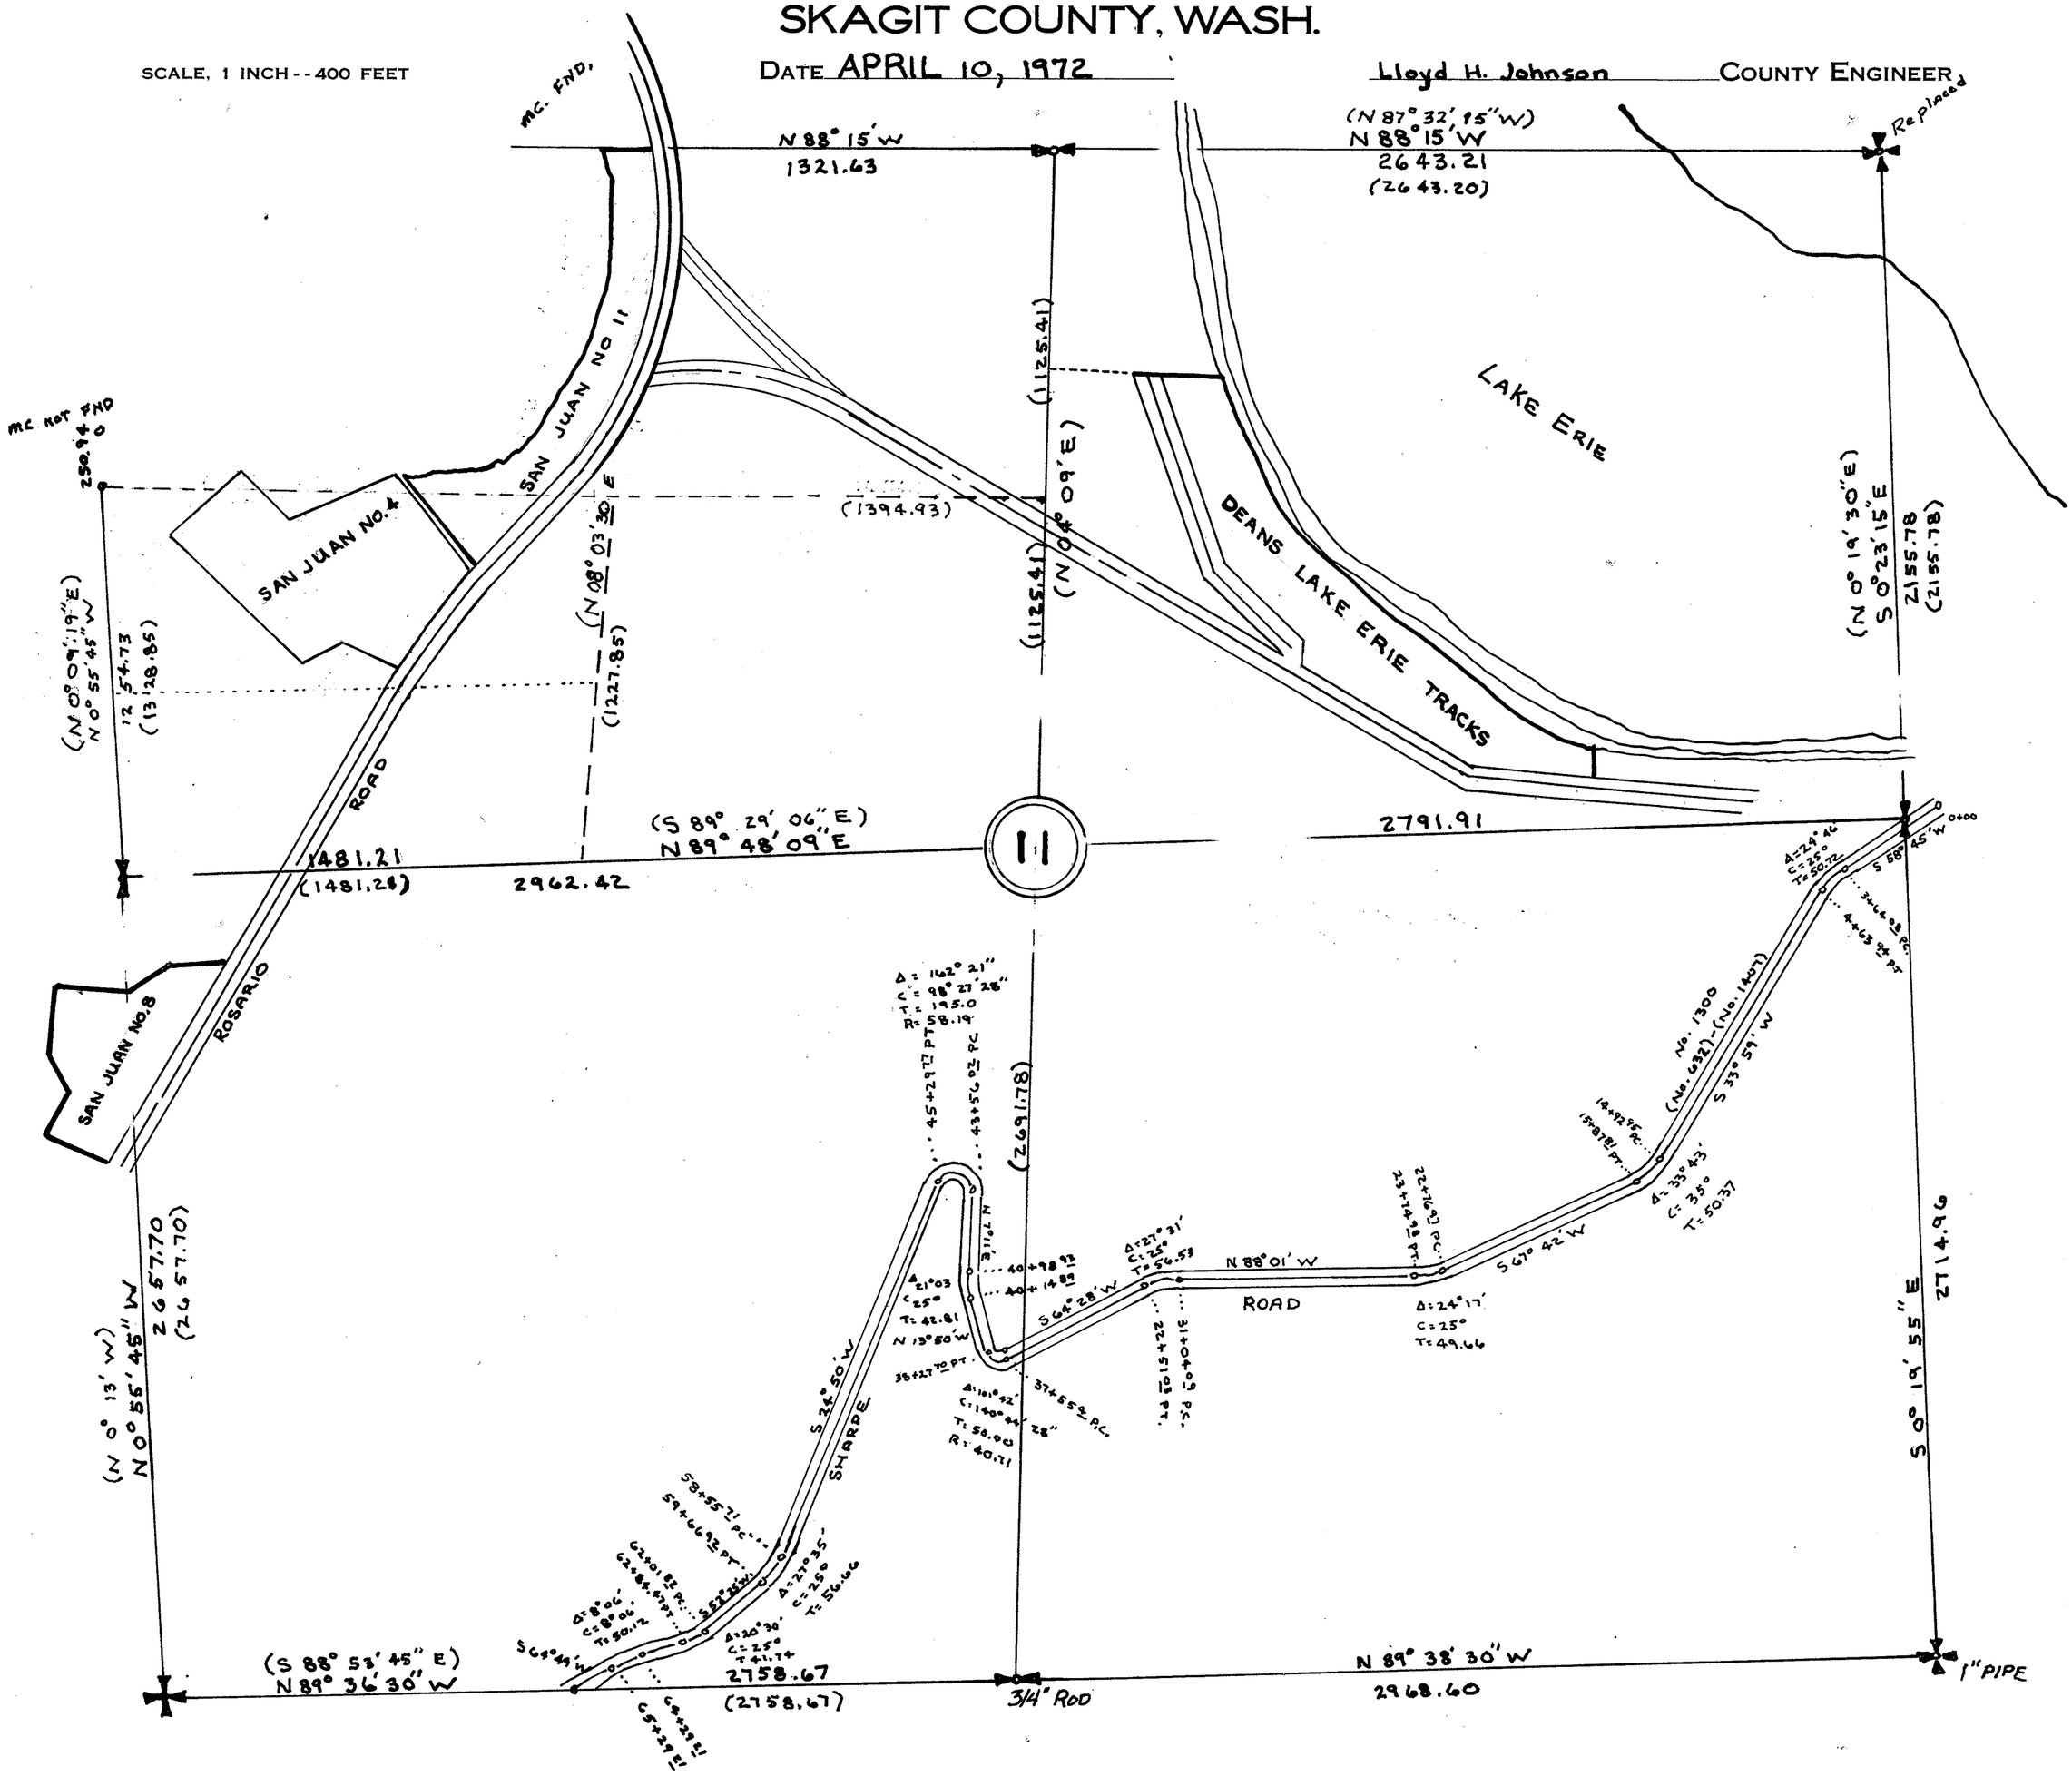

SECTION 11

TOWNSHIP 34 NORTH, RANGE 1 EAST, W. M.

SKAGIT COUNTY, WASH.

Subdivision by Frank Giffey

See case No. 19658

SCALE, 1 INCH--400 FEET

H. O. Walberg COUNTY ENGINEER

Not Fd. B.C.

Not Fd. B.C.

Projected Record Dist & Brg.

N0°55'45"W 1254.73

230.92

429.37

N88°15'W 1321.63

N88°15'W 2643.21

Replaced

Marine Drive (No. 1405)-1061 (No. 378)

Lake Erie

S0°23'15"E 2155.78

Road

2250.83

1125.42

Rosario

N89°48'09"E 2962.42

1481.21

2791.97

R/W-Not Given

(No. 631) - No. (1401) - 1031

(H.A. March Road No. XXI)

Δ = 162° 21"
C = 98° 27' 28"
T = 395.0'
R = 58.19'

N 30° E 2691.68

45+29.77 P.T.

43+56.02 P.C.

N. 7° 11' E.

40+98.83 P.T.

14.89 P.C.

40+

Δ = 21° 01'
C = 25°
T = 42.81'

N. 13° 50' W.

38+27.70 P.T.

Δ = 101° 24' 28"
C = 140° 41' 28"
T = 60.00
R = 40.71

37+55.4 P.C.

S. 64° 28' W.

Δ = 27° 31'
C = 25°
T = 56.53

N. 88° 01' W.

22+76.43 P.T.

22+61.03 P.C.

31+40.09 P.C.

Road

Δ = 24° 17'
C = 25°
T = 49.66

S. 67° 42' W.

14+92.95 P.C.
13+67.81 P.T.

Δ = 33° 43'
C = 35°
T = 50.37

S. 33° 59' W.

No. 1300 (No. 632)-(No. 1407)

R/W-Not Given

Δ = 29° 46'
C = 25°
T = 50.72

S. 58° 45' W. 0+00

3+64.08 P.C.

4+63.94 P.T.

S. 64° 49' W.

58+55.71 P.C.
59+66.92 P.T.

S. 52° 25' W.

62+01.82 P.C.
61+84.47 P.T.

Δ = 8° 06'
C = 8° 06'
T = 50.12

Δ = 27° 35'
C = 25°
T = 56.66

Δ = 20° 30'
C = 25°
T = 41.74

Sharpe

N0°55'45"W 2657.70

2774.96

S0°19'55"E

N89°36'30"W 2758.67

64+29.21 P.C.

65+29.21 P.T.

N89°38'30"W 2968.6


(Fidalgo Island or R. H. Sharp Road No. LIV)

SECTION 11
TOWNSHIP 34 NORTH, RANGE 1 EAST, W.M.
SKAGIT COUNTY, WASH.

SCALE 1 INCH.. 400 FEET

DATE MAY 4, 1972

LLOYD H. JOHNSON COUNTY ENGINEER

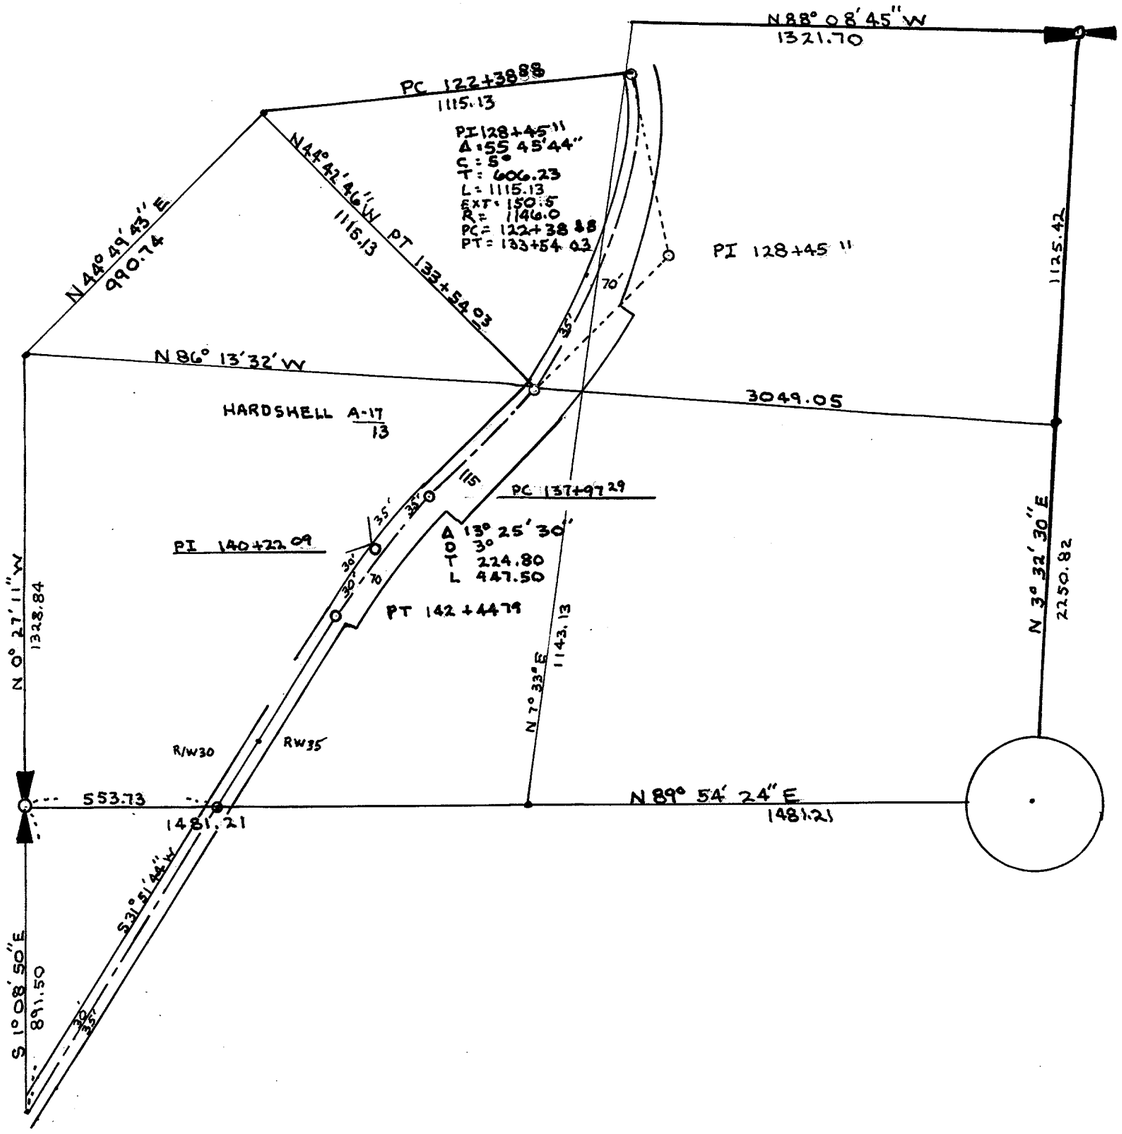


SECTION 12

TOWNSHIP 34 NORTH, RANGE 1 EAST, W. M.

SKAGIT COUNTY, WASH.

SCALE, 1 INCH--400 FEET
Road No. 2 from Notes 48/618

G. D. LeGro
July 1958
COUNTY ENGINEER

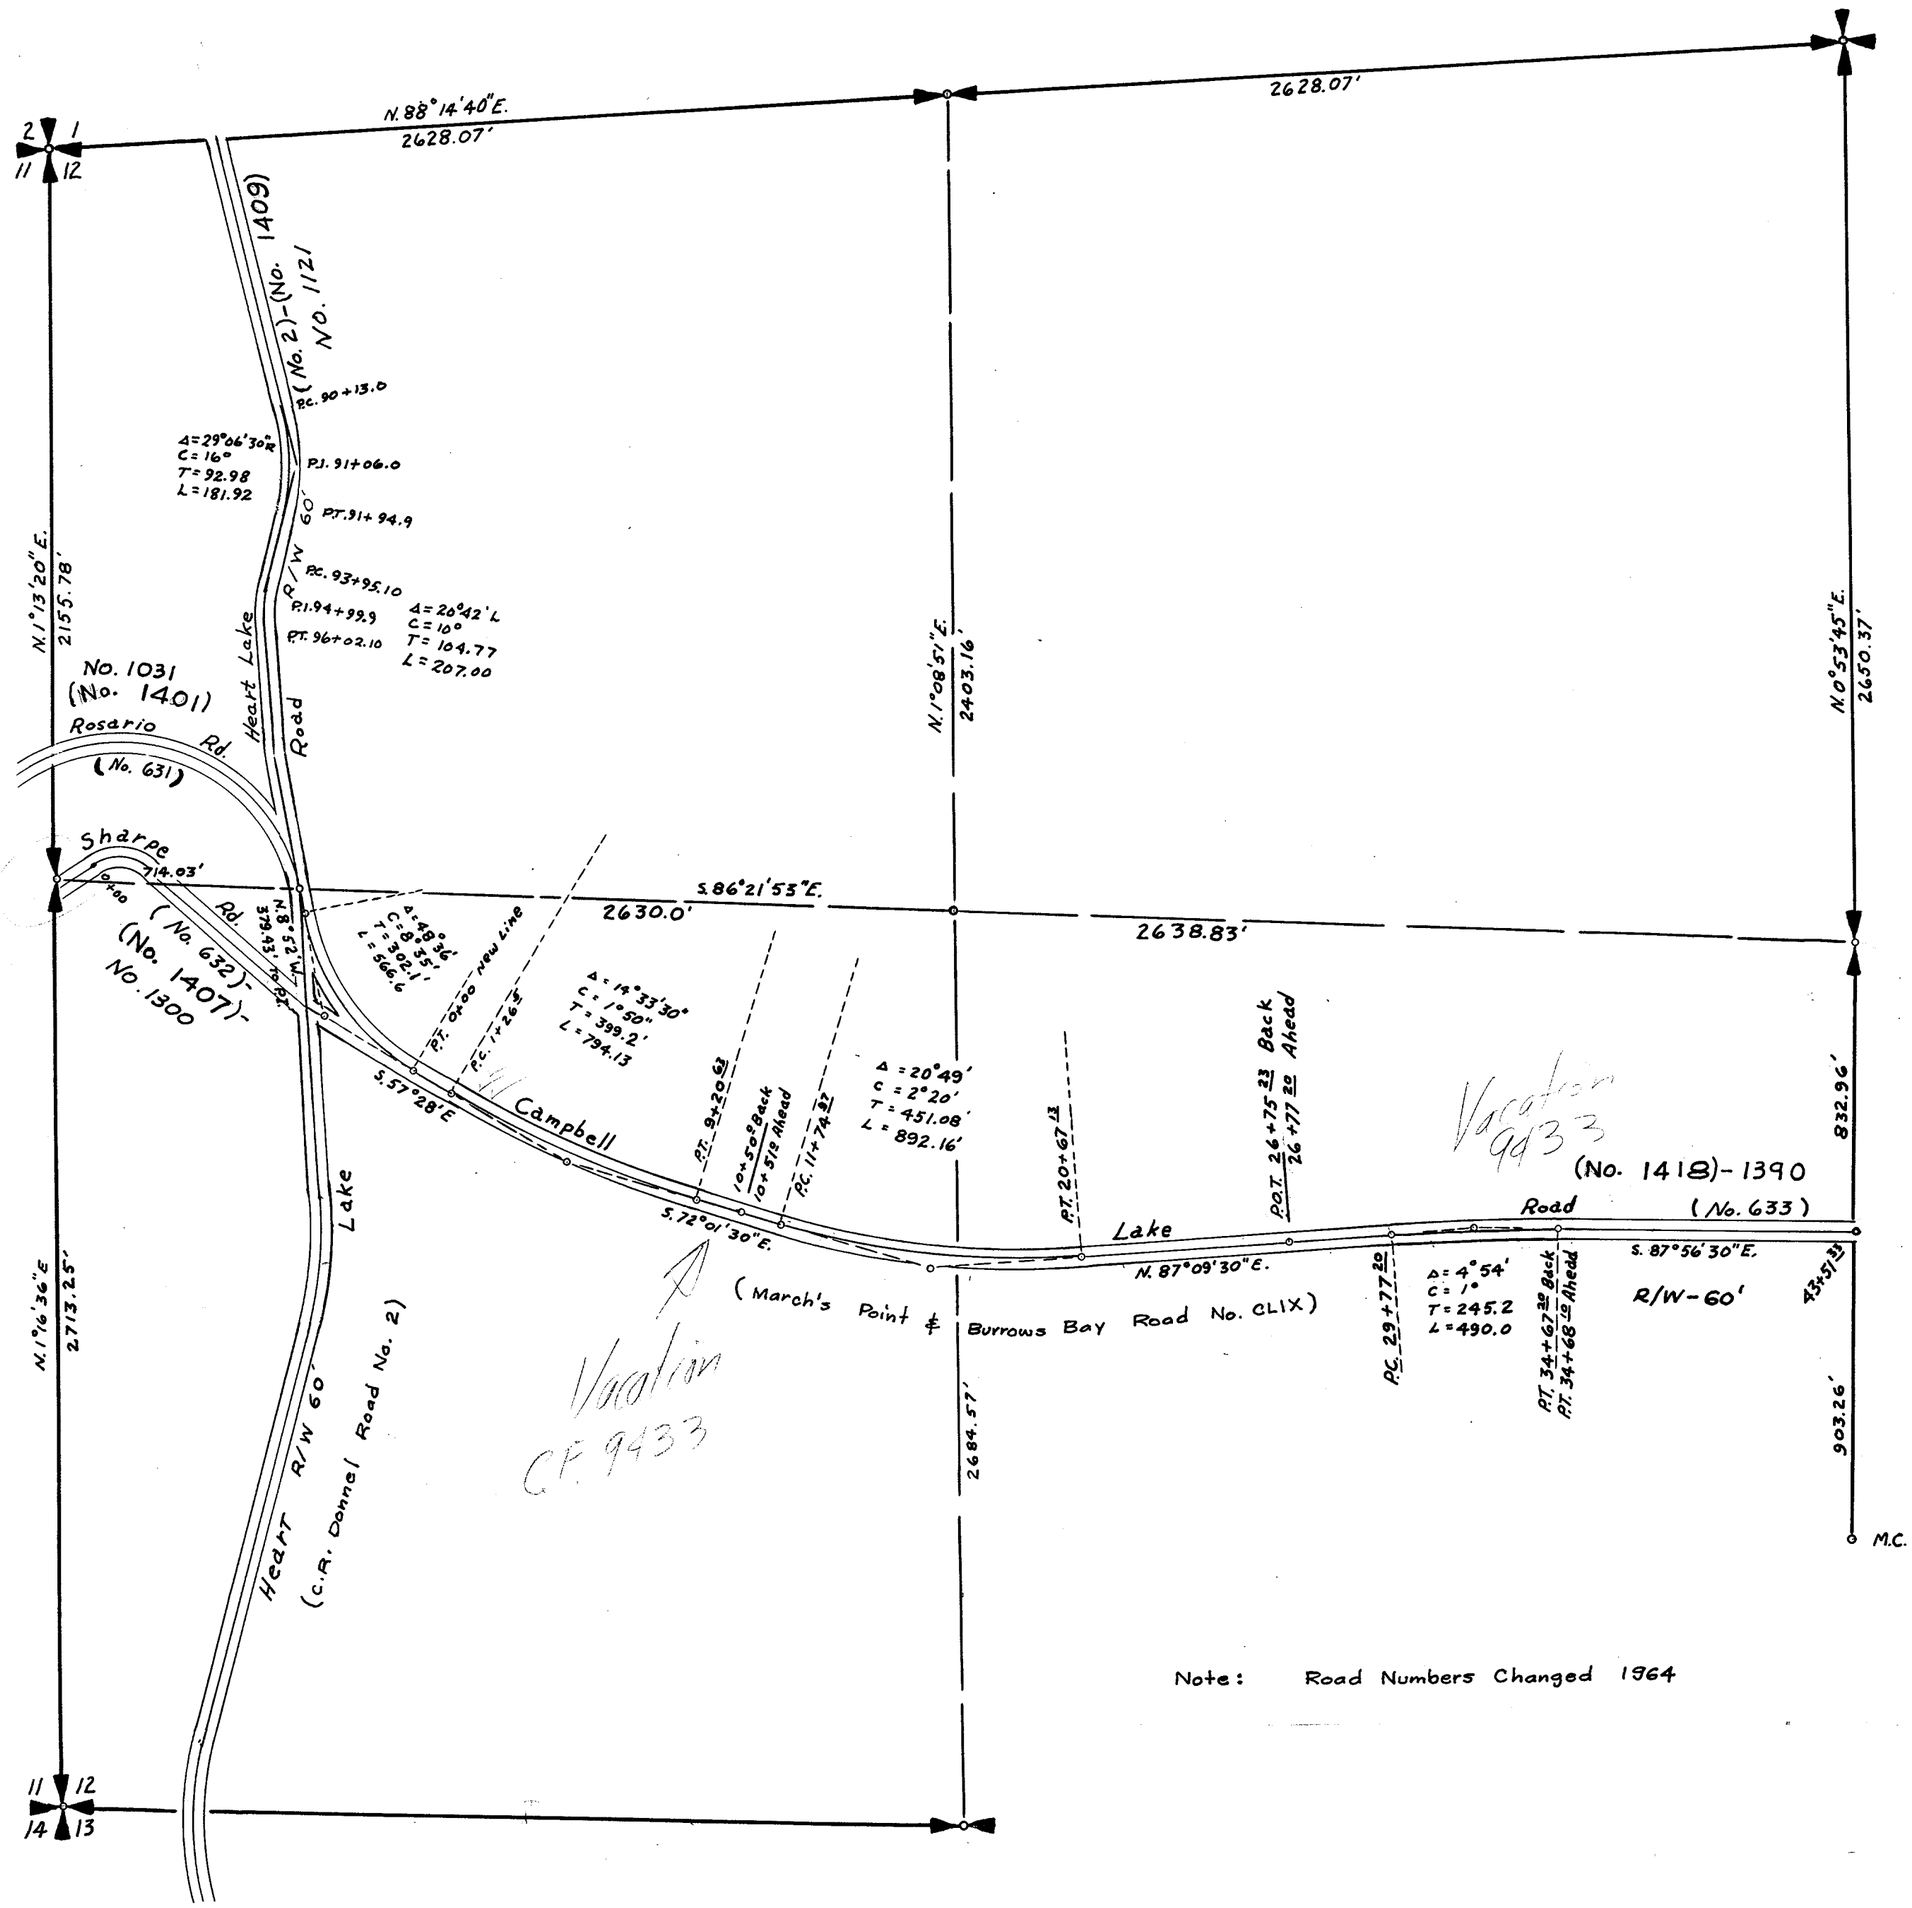

Note: Road Numbers Changed 1964

SECTION 13

TOWNSHIP 34 NORTH, RANGE 1 EAST, W. M.

SKAGIT COUNTY, WASH.

SCALE, 1 INCH--400 FEET

DATE June 21, 1966 — Lloyd Johnson COUNTY ENGINEER

Heart Lake Road No. 1121
(No. 1409) - (No. 2)
(Donnel, C.R. Road)
R/W - 60'

CAMPBELL LAKE

Note: 723
771

2703.34

1

2

3

4

5

FIDALGO CITY
VOL 2, 47

3/4" Pipe

9th Street — No. (1426) - (370) - 1240

N89°17'W 2623.95

R/W - See Plat Vacations

N0°09'W 324.32
N 4°35'50"E 324.63

24" Fir

P. Pole

Stump

70.50

T-34-N
13
R-1-E

5164.64

2403.14

2668.27

2668.27


N1°17'E 2623.14

Found 1/2" Pipe in White Stake
(62)

SECTION 14
TOWNSHIP 34 NORTH, RANGE 1 EAST, W. M.
SKAGIT COUNTY, WASH.

SCALE 1 INCH 400 FEET

DATE June 12, 1972 — Lloyd H. Johnson — COUNTY ENGINEER

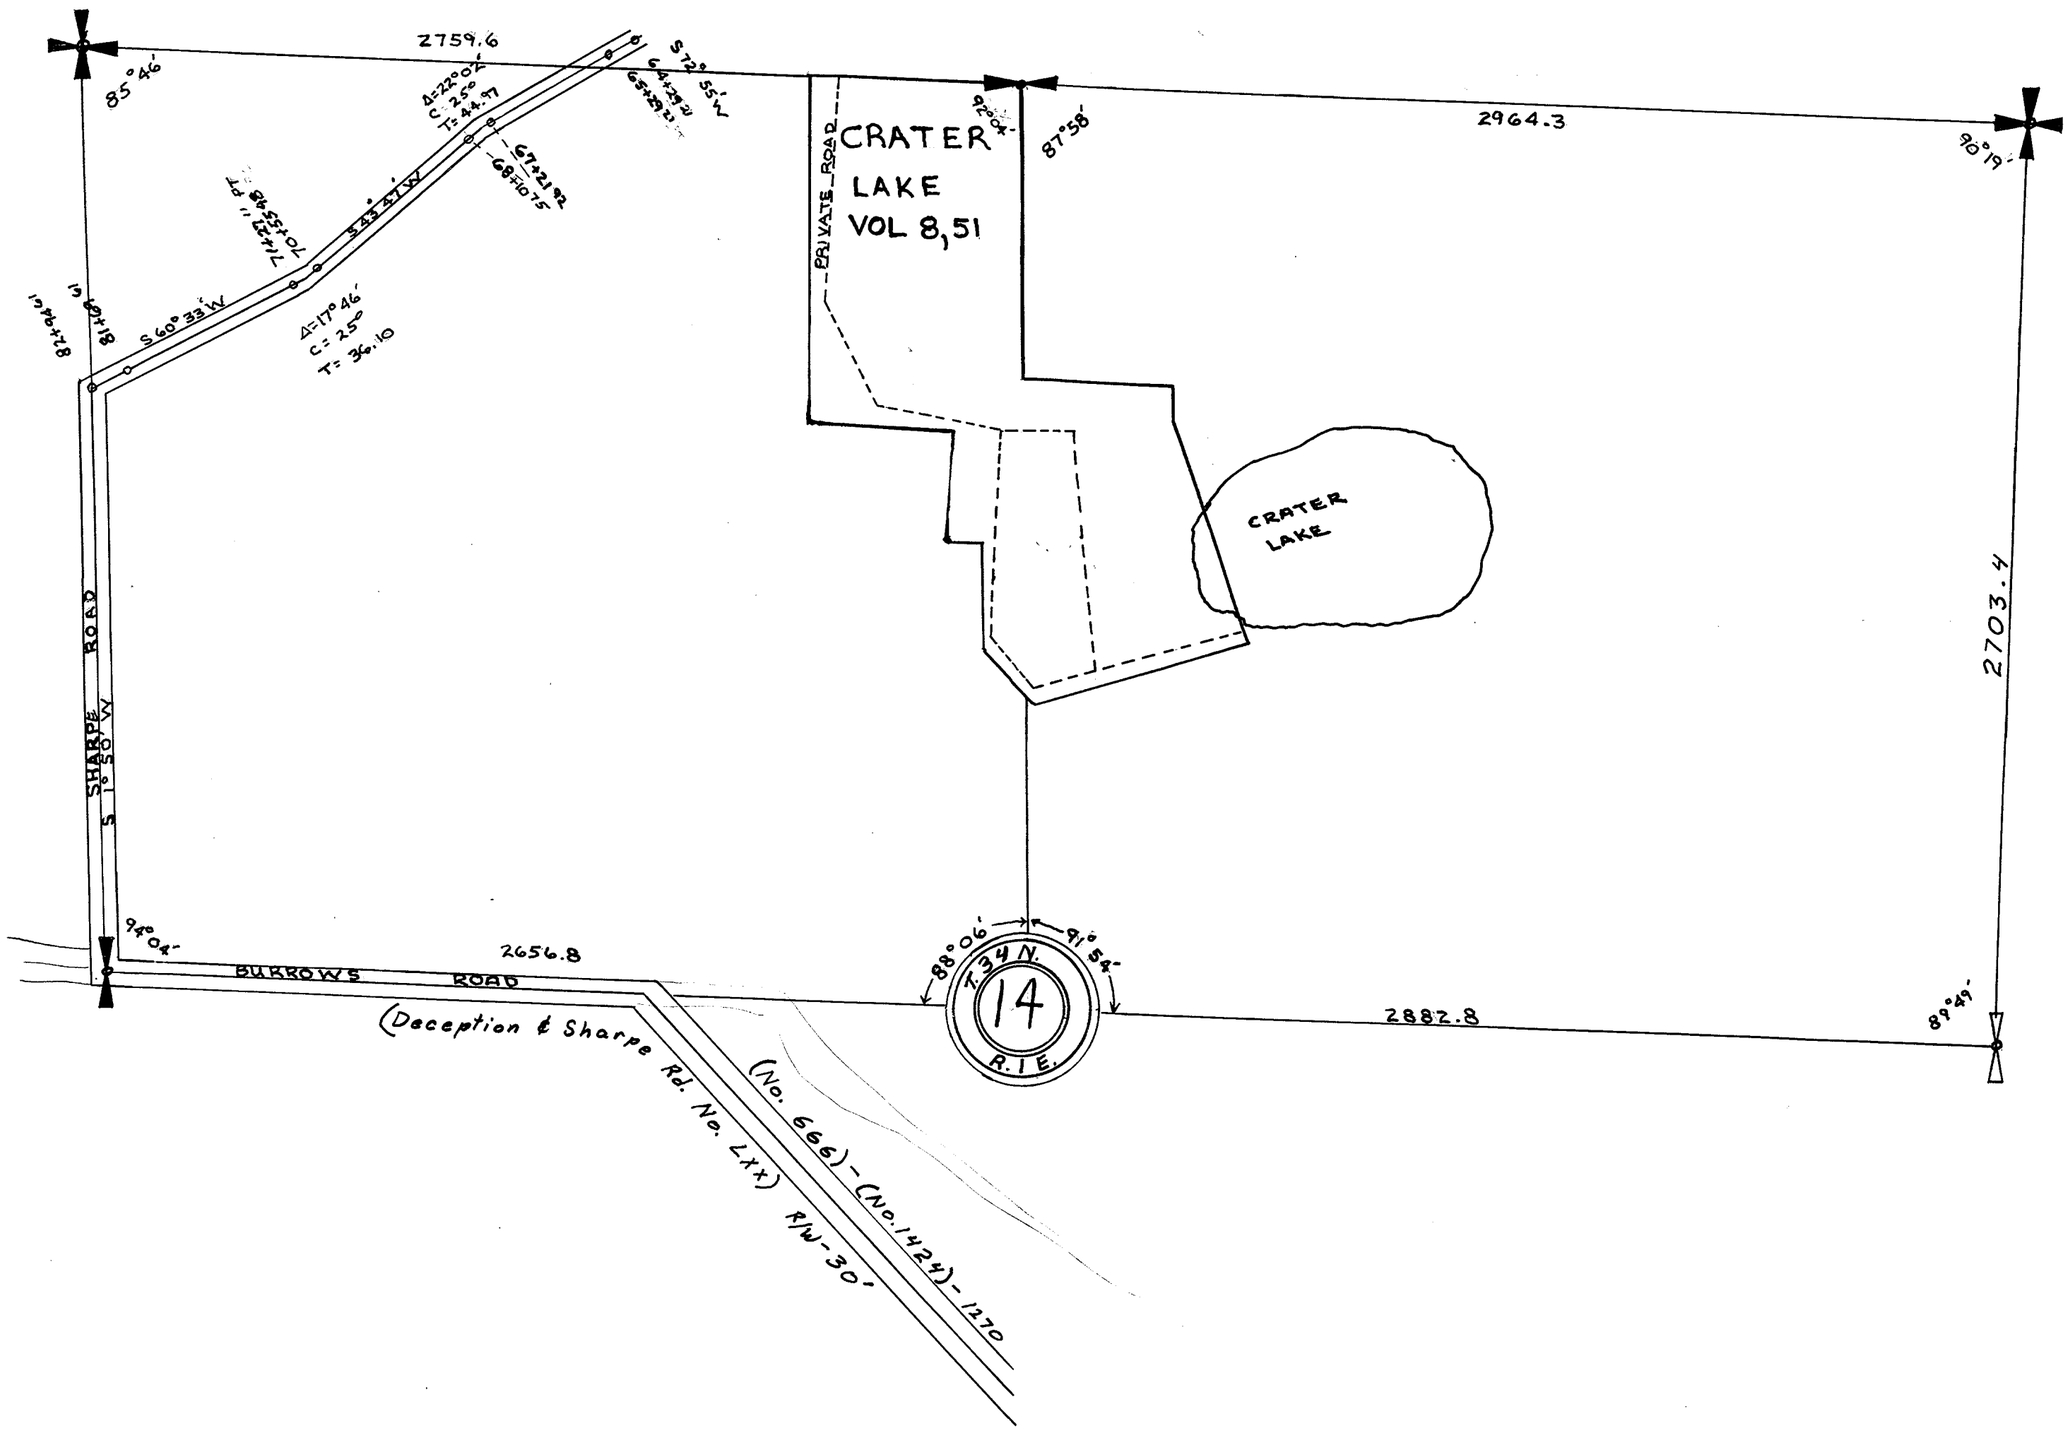

SECTION 14

TOWNSHIP 34 NORTH, RANGE 1 EAST, W. M.

SKAGIT COUNTY, WASH.

SCALE, 1 INCH—400 FEET

R.E.L. Knapp COUNTY ENGINEER

Apr. 1929

Revision

Goodier Road No LIV

2759.4

Conc Mon

S.64°49'W.

S.72° 55'W.

Δ=22° 02'
G=25°
T=49.97

67+21.92 P.C.
68+10.75 P.T.

S.43° 47' W.

Δ=17° 16'
G=26°
T=36.10

64+29.21 P.C.
65+29.21 P.T.

Δ=80° 06'
G=80° 06'
T=50.12'

85-46

92-04

87-58

2964.3

2969.5

90-19

81+69 61

S.60°33'W.

Road (No. 632)-
(No. 1407)-
No. 1300
R/W - Not Given

82+94 61

2722.10

2724.4

S.1°50'W.

Sharpe

(Deception & Burrough Bay Road No LXX)

2711.8

2703.4

94-04

Burrows

2656.8

88-06

91-54

T. 34 N.
14
R. 1 E.

2882.8

89-49

(Deception & Sharpe Road No. LXX) Road (No. 666)- (No. 1424)- 1270

R/W - 30'

Conc Mon

2403 14

1¼" PIPE

2730.24

2710.61

1 SUN SET WEST VOL-9 Pg.99

2 ROSARIO RD HARDSHELL A7 36

SECTION 15

TOWNSHIP 34 NORTH, RANGE 1 EAST, W. M.


SKAGIT COUNTY, WASH.

APRIL 4, 1972

Lloyd H. Johnson COUNTY ENGINEER

SCALE, 1 INCH--400 FEET

SUBDIVISION by LEGRO & JUDY

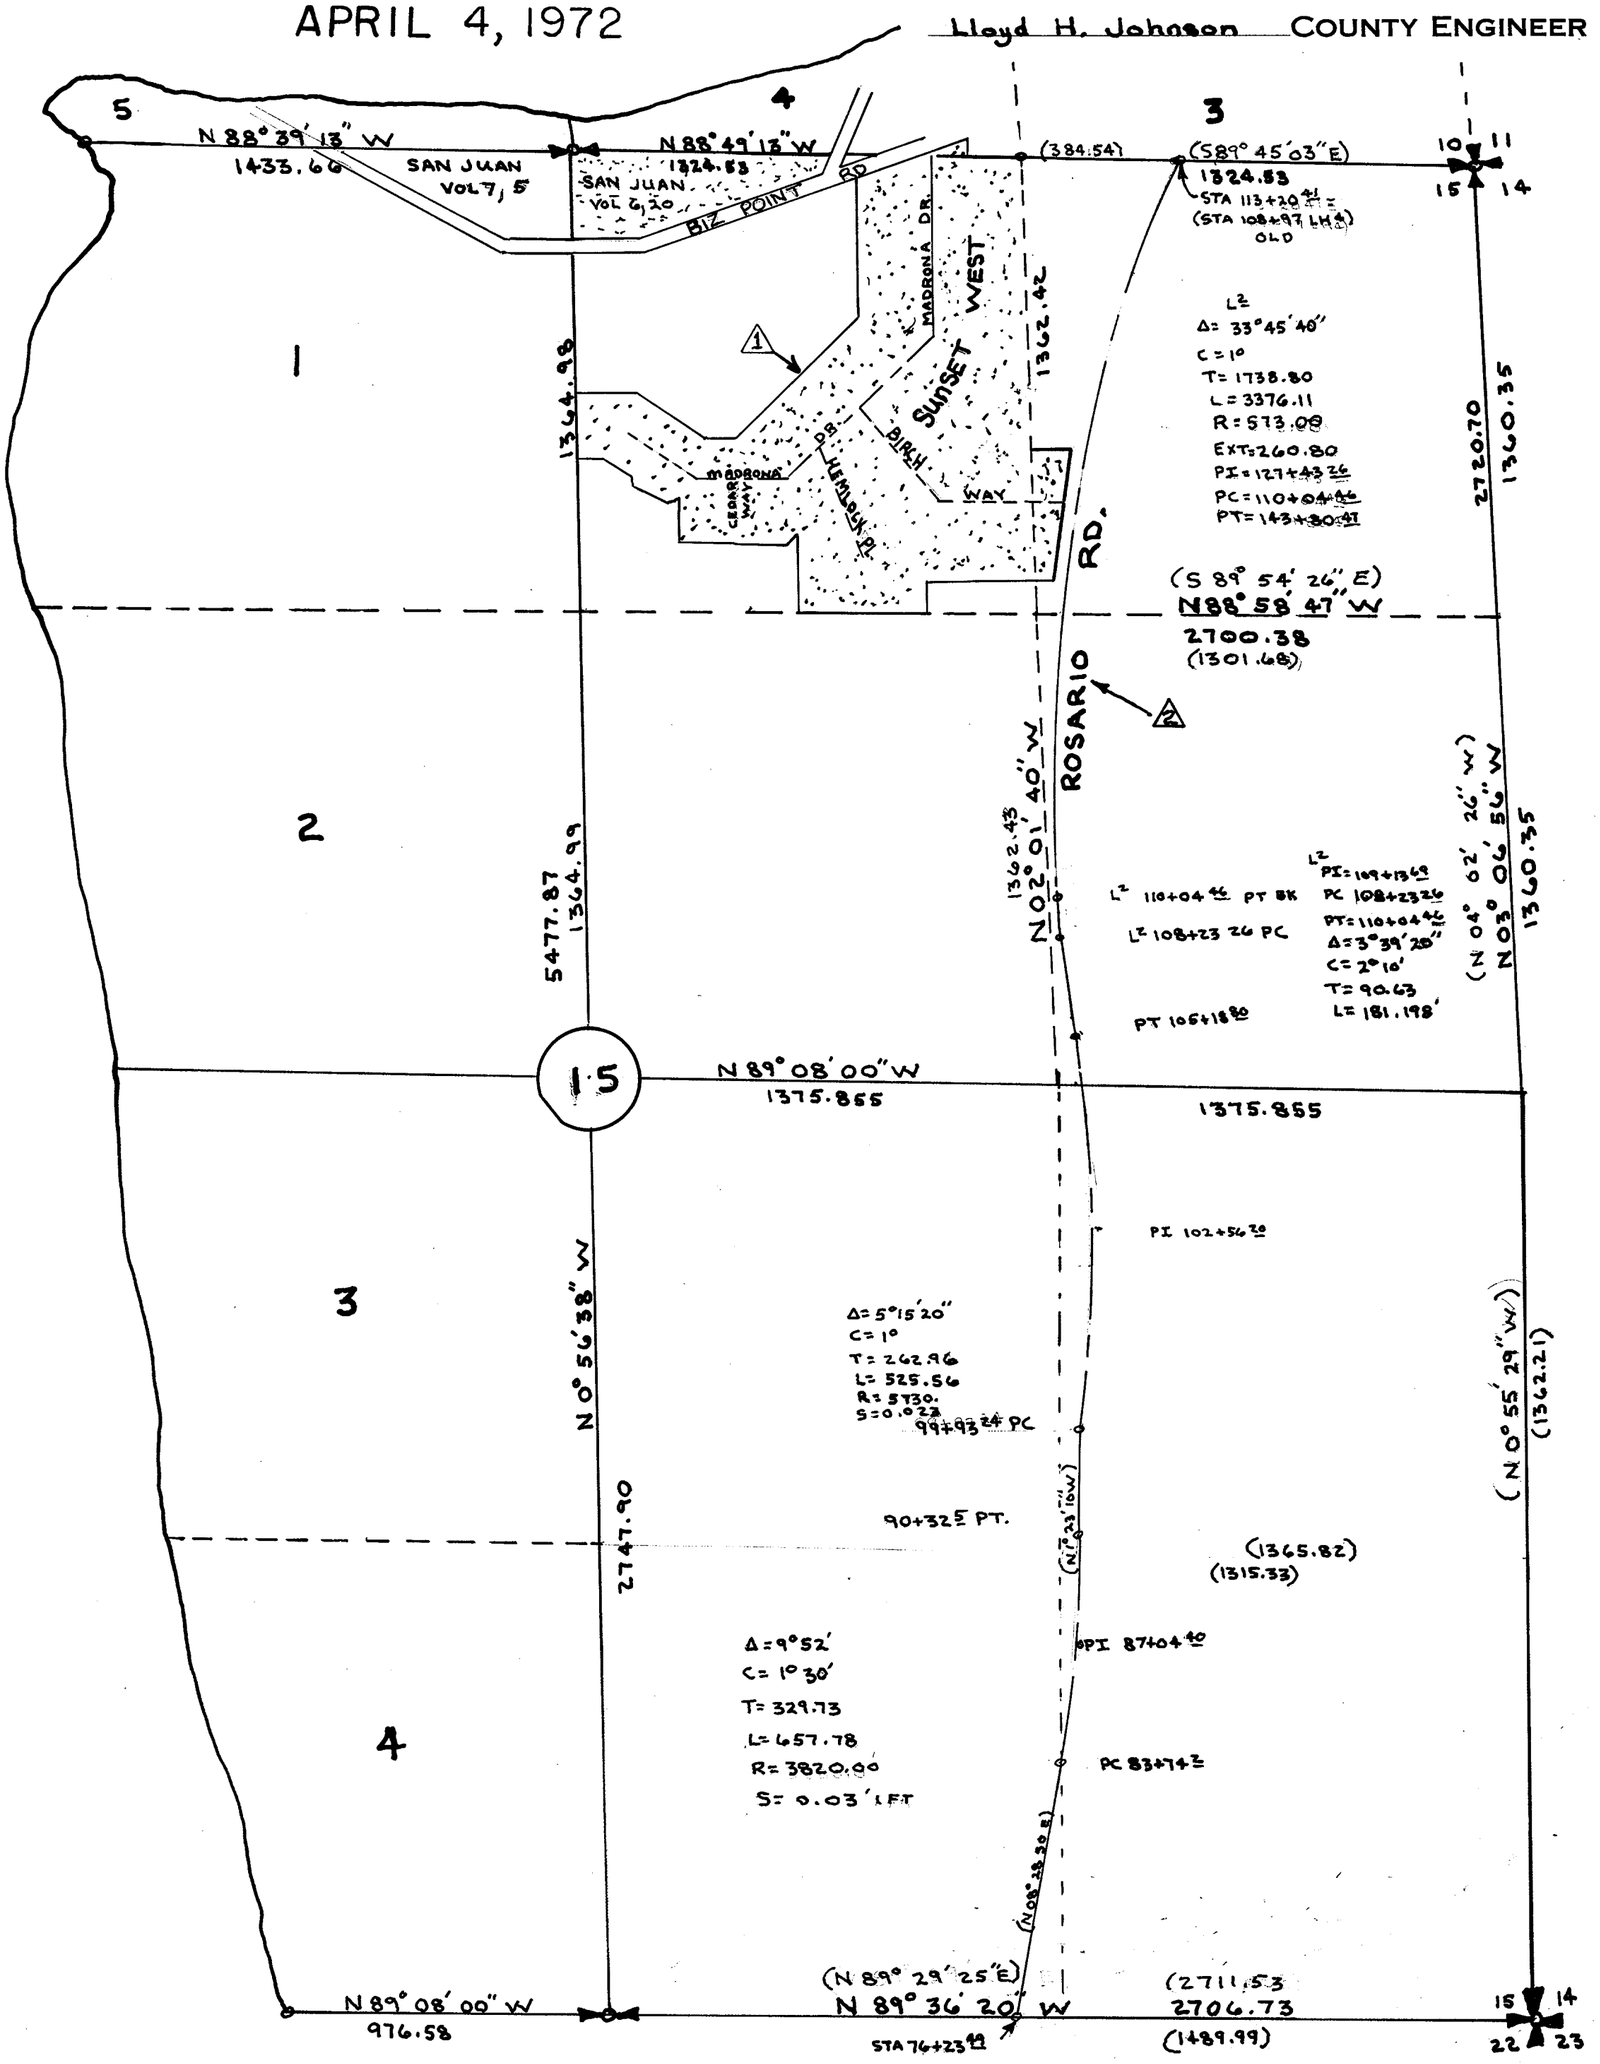

SECTION 15


TOWNSHIP 34 NORTH, RANGE 1 EAST, W. M.

SKAGIT COUNTY, WASH.

SCALE, 1 INCH--400 FEET

G. D. LeGro
July 1958
COUNTY ENGINEER

Vacated 8936

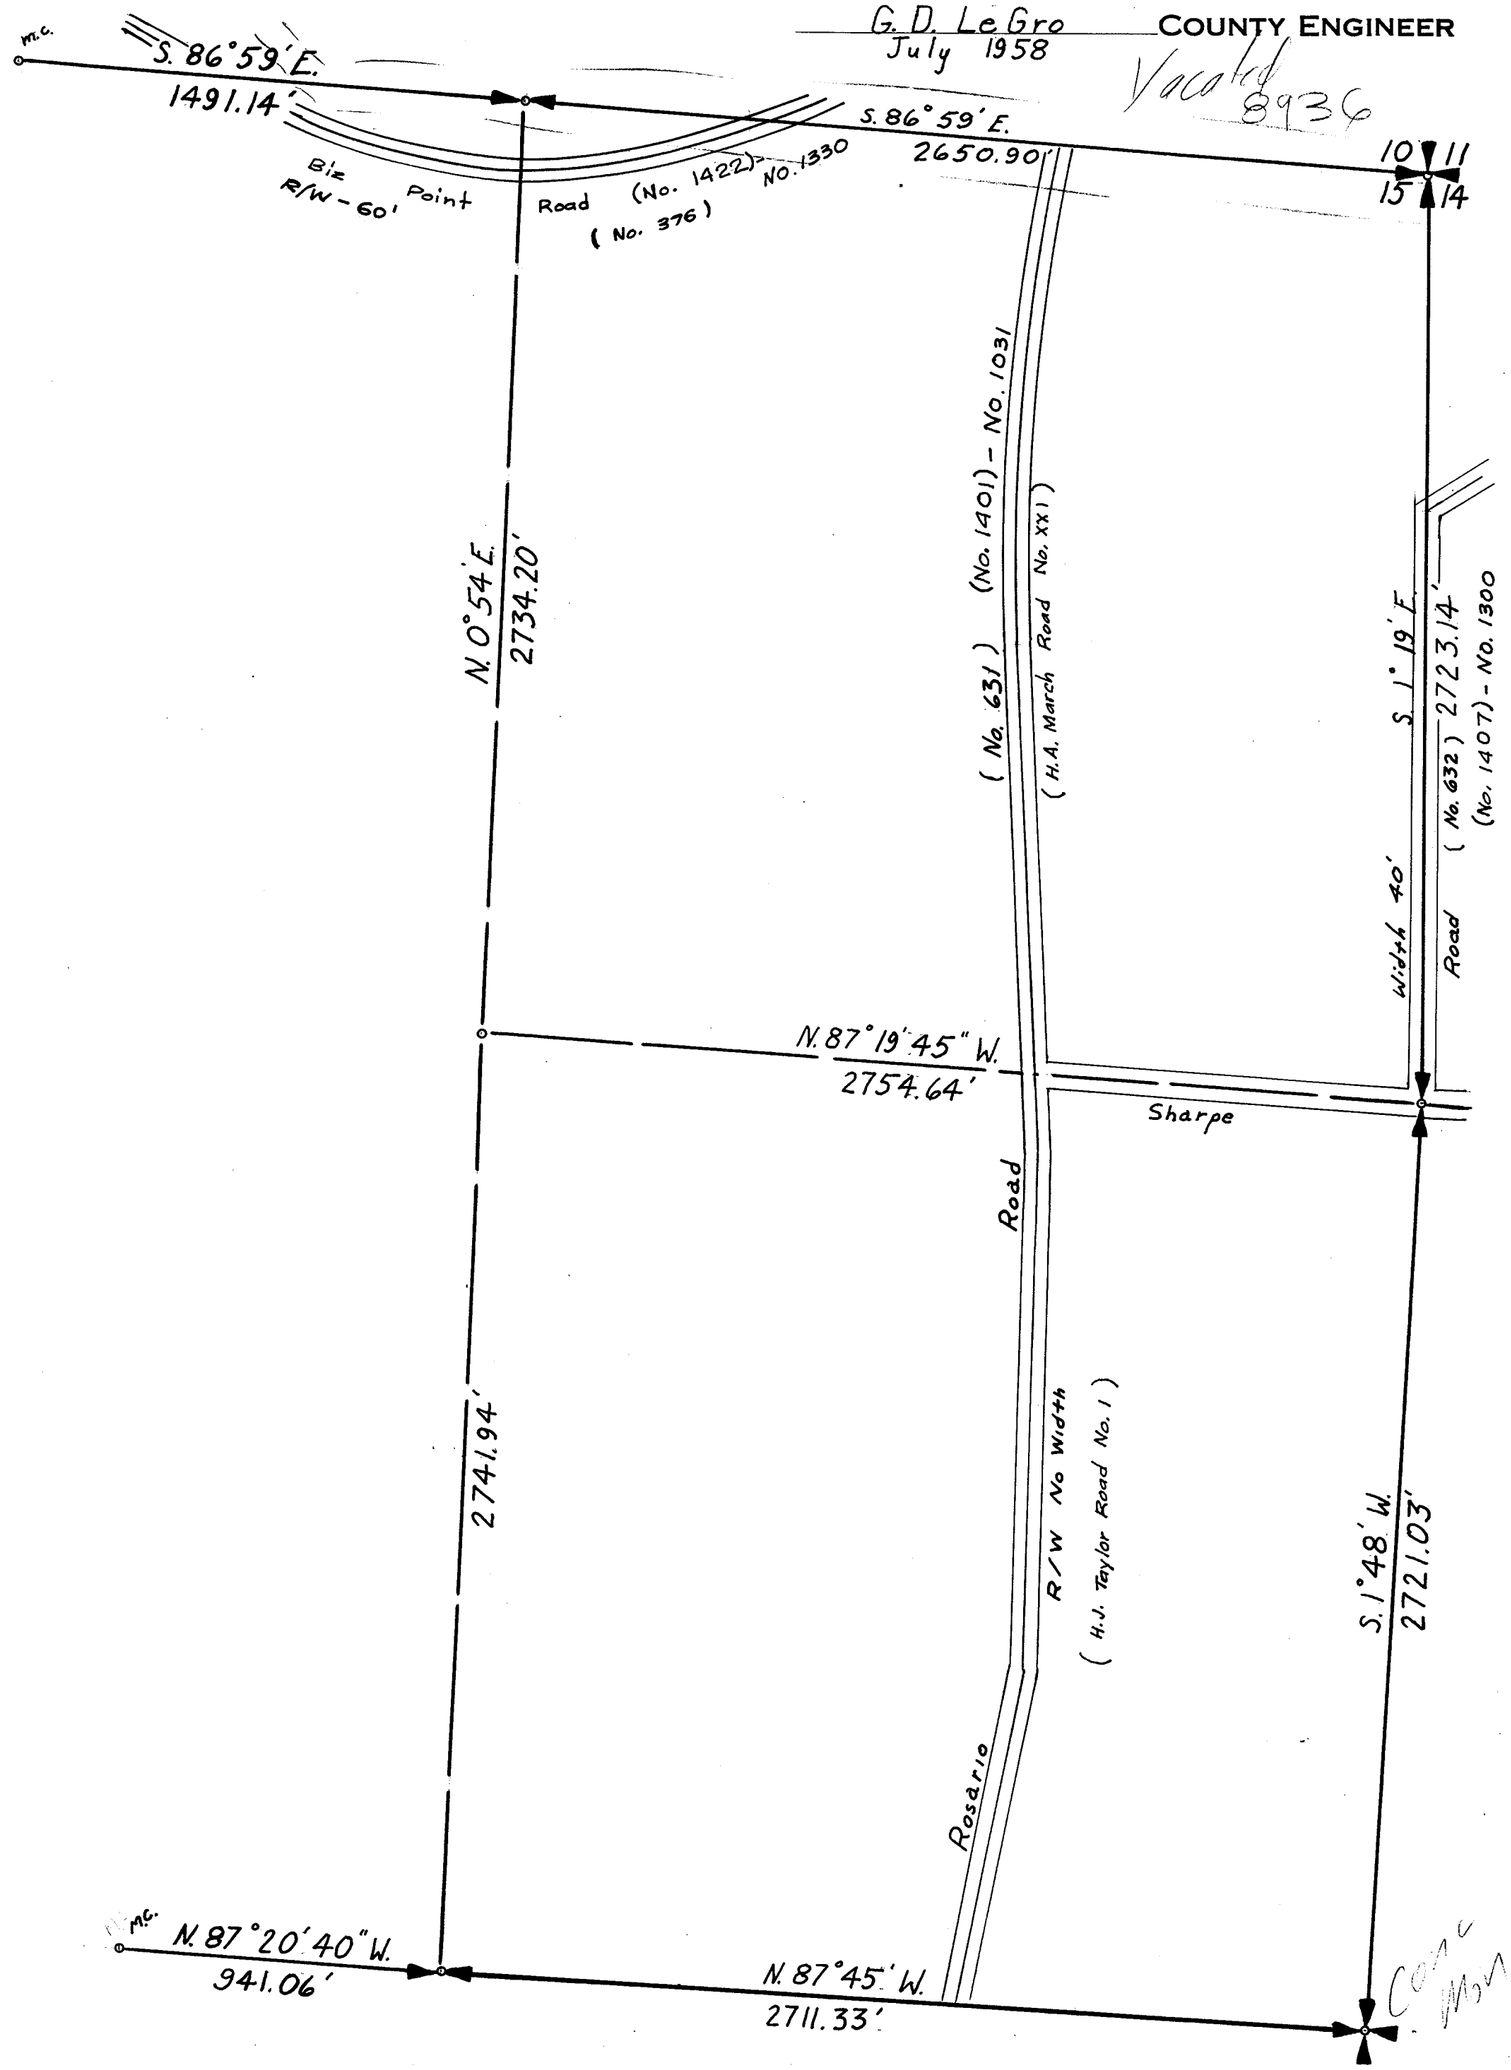


SECTION 15

TOWNSHIP 34 NORTH, RANGE 1 EAST, W. M.

SKAGIT COUNTY, WASH.

SCALE, 1 INCH - - 400 FEET

DATE MARCH 1972 — G.D. LeGro — COUNTY ENGINEER

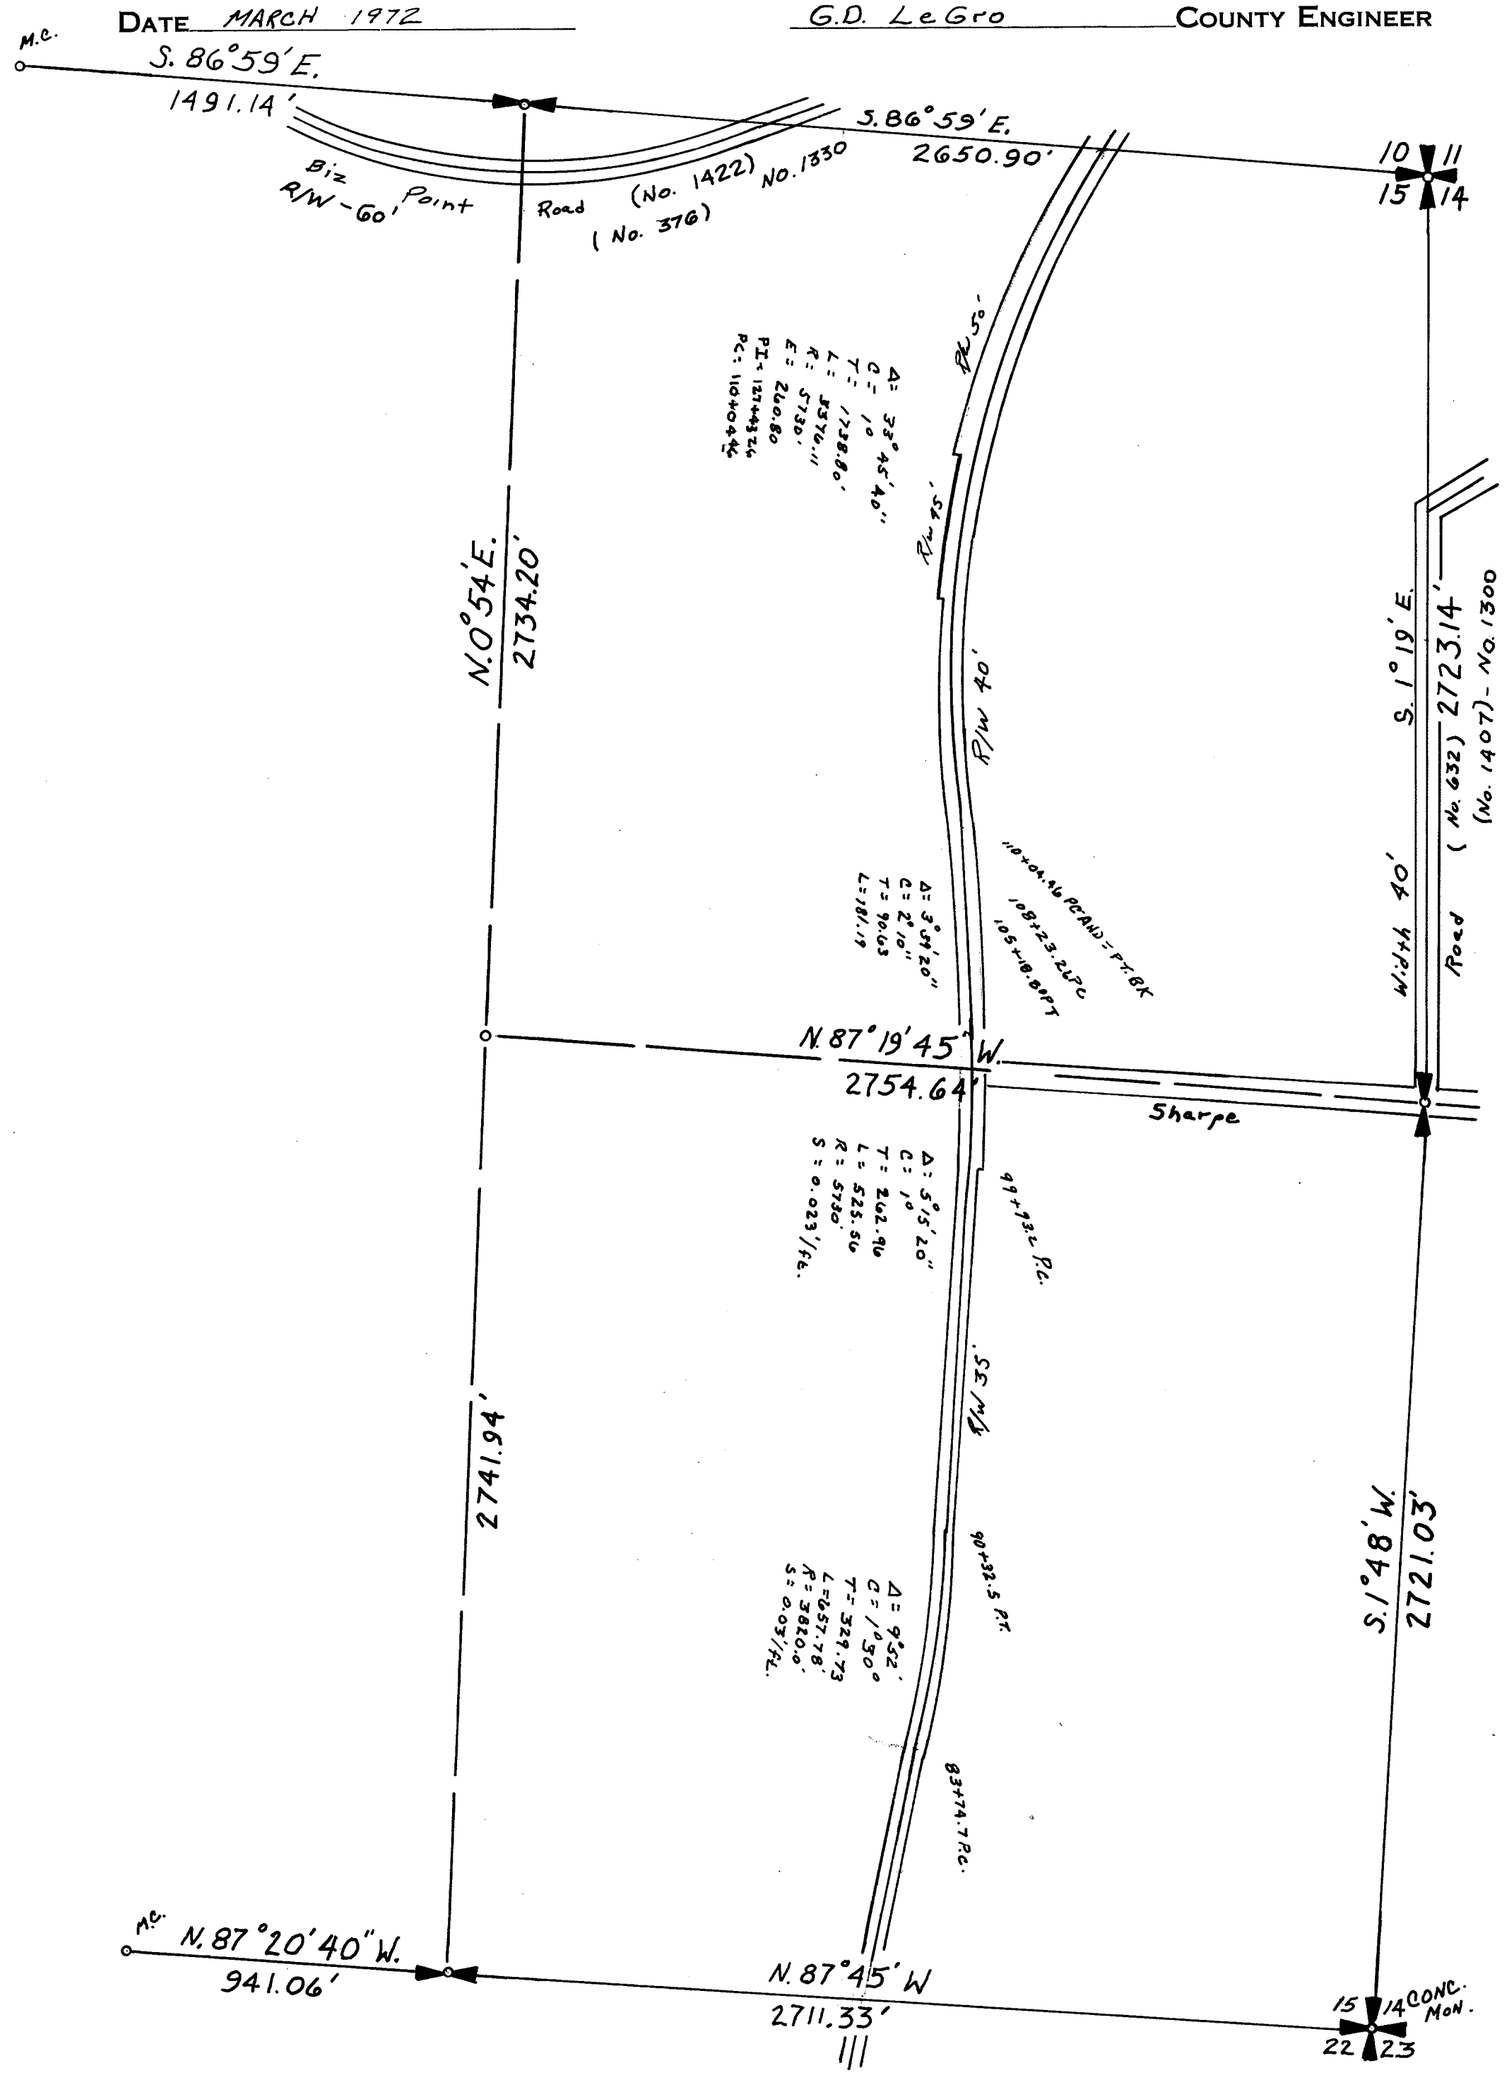


SECTION 22

TOWNSHIP 34 NORTH, RANGE 1 EAST, W. M.

SKAGIT COUNTY, WASH.

SCALE, 1 INCH--400 FEET

G. D. LeGro
August 1958
COUNTY ENGINEER

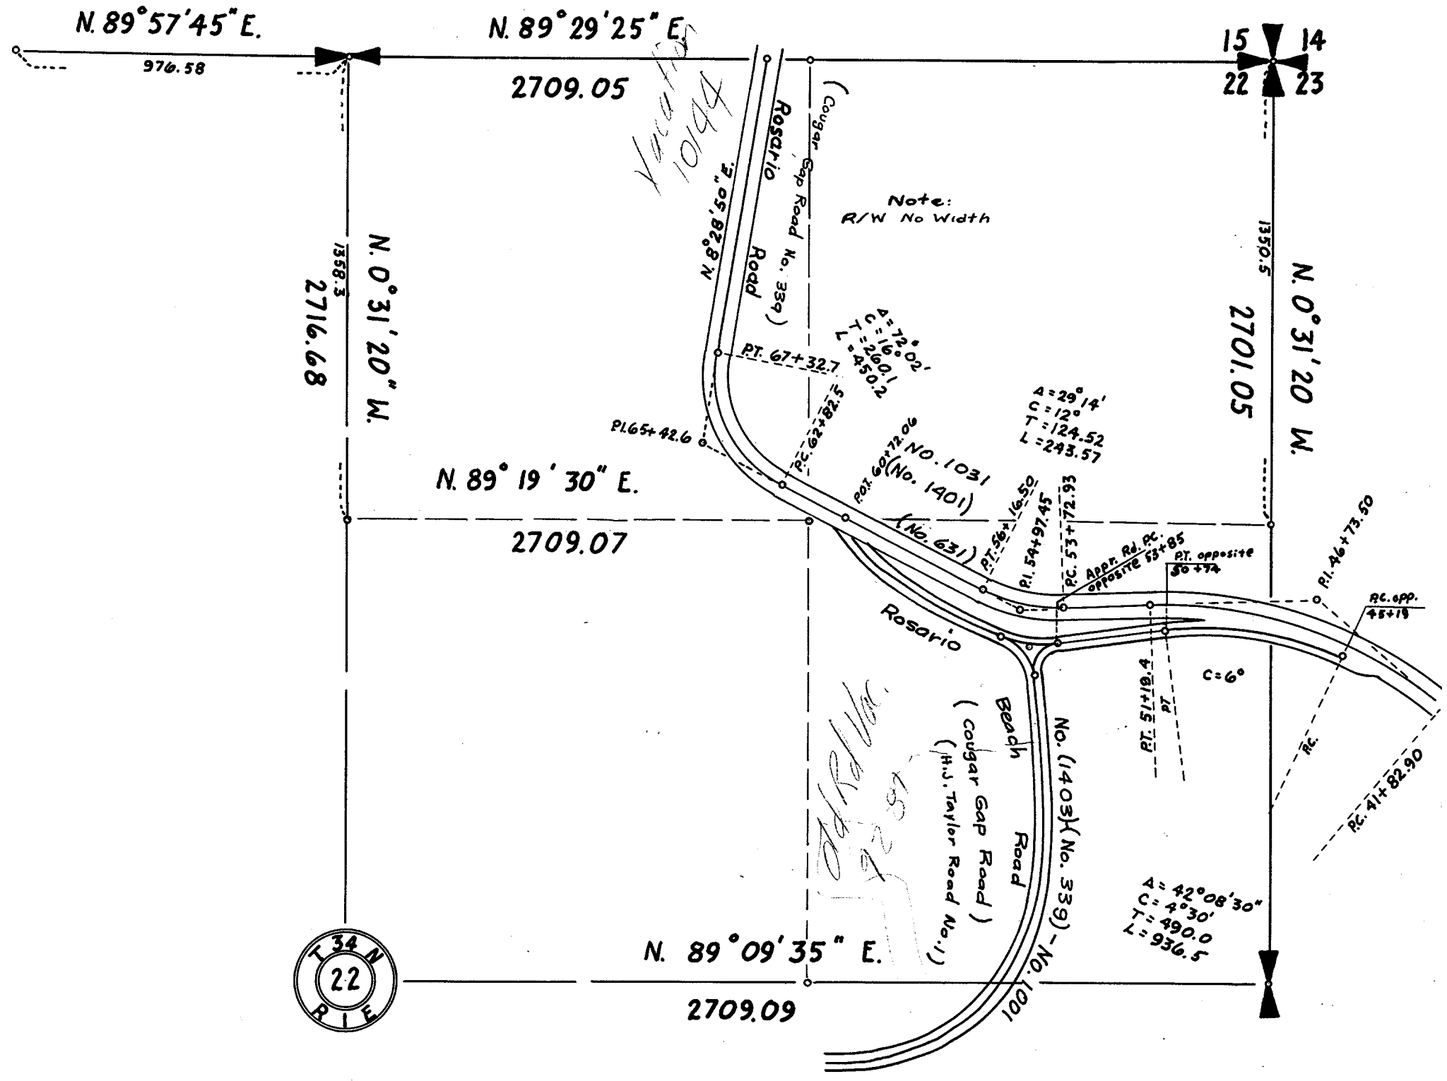

Note: The Rosario Beach Road (No. 1403)
Drawn From Aerial Photo Not
to Scale ---- June 1966

SECTION 22
TOWNSHIP 34 NORTH, RANGE 1 EAST, W. M.
SKAGIT COUNTY, WASH.

SCALE, 1 INCH--400 FEET

SECTION 22


TOWNSHIP 34 NORTH, RANGE 1 EAST, W. M.

SKAGIT COUNTY, WASH.

SCALE, 1 INCH--400 FEET

DATE August 1968

Lloyd Johnson COUNTY ENGINEER

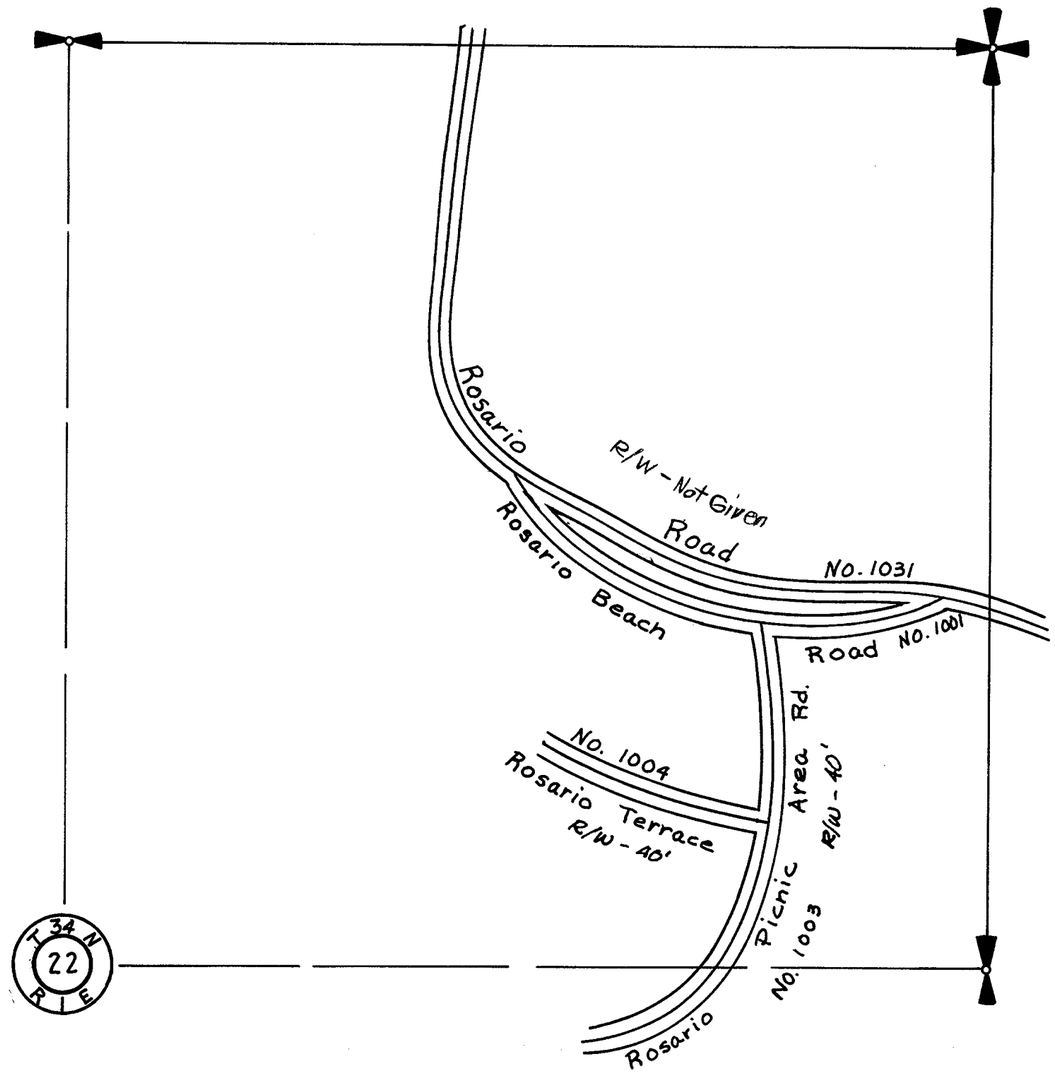

Notes 36/316

SECTION 23
TOWNSHIP 34 NORTH, RANGE 1 EAST, W. M.
SKAGIT COUNTY, WASH.

H.O. Walberg COUNTY ENGINEER

SCALE, 1 INCH--400 FEET

N 22,870.89
E 7,327.13

N 88° 21'E
2701.36'

N 22,948.67
E 10,027.37
Relocated

N 88° 21'E.
2710.61'

8"X8" Cedar Post
Found

N23,026.46
E 12,737.80

N0°38'46"W
2618.88
2701.05

N0°38'10" W
1224.50

V 222-159
V 222-158
V 213-512

V 181-308

5078.37'
2579.90

M.C.
N 21,802.04
E 12,751.39
Post Found

Rosario Road
40' 40'
(COUGAR)

No. 1031
(No. 1401)
(No. 631)

N0°17'E
1314.69

N 26368.77
E 10027.72

Concrete Mon. & P.
(GAP)

N 20,487.37
E 12,744.89

5393.41'
2719.77

N 87° 30' E
2673.64

N 20,252.17
E 7,356.64
Conc. Mon.
Found

LAKE
PASS

N0°11'10"W.
513.15'

(ROAD)

N19,739.02
E 7,358.31
M.C
Relocated With Mean
Bearing of E.& W. Lines
Of Section

Concrete Mon.

R/W
Vol. 221 D450

N0°00'30"W
2498.47

N0°17'E
2539.20

BOWMANS BAY

S.S.H No. 1-D

M.C.
Relocated With
Bearing Parallel
To North Line

N88° 21'E
946.88

N 17,870.30
E 10,028.07
Relocated

N 88° 21' E
2705.38'
Dist. Prop. from Nly.

N 17,948.20
E 12,732.33
Iron Pipe
Found

SEC. 23-T. 34N. R. 1E. W.M.

NOTES: 36/316

15 14 22 23 N22,870.89 E 7,327.13

N. 22000 E 7000 E 8000 E 11000 E 13000

N. 0° 38' 46" W 2618.88

POST M.C. N 21784.91 E 12749.35

Rosario Road No. 631 (Cougar Gap Road Estab.) July 8, 1940, By Resol. of Commrs. File No. 5974

45+88.7

Δ 65°-17'-30" C. 8-00 ₹ 458.9 L. 816.1

N 38° 13' W

Δ 60°-05'-30" C 16-00 T. 233.0 L. 413.1

49+45.9

41+29.8

38+35.5

341 22.4

COUGAR GAP

Douglas Allmond

S. 75-41-30 W

25+92.2

N. 0° 55' E.

Sarah Graham V. 213 P512 Deed Recd 4-26-46

S. 60° 07' 09" W 944.26'

36+55.4

N 20722.60 E 8175.39

18+94.6

Δ 105°-13'-30" C 10-00 ₹ 749.8 L. 1052.2

9.42 Chan. Sec.

STA. 18+46.35 CONC. MON. Mkd. "S.P."

18+42.4 P.C. N. 87-32 E.

273.8

52.5

18+46.4

STATE PARK.

1/4 COR. Conc. Mon. NORTH 1998.8 LINE N. 87° 32' E.

N. 10252.17 E 7356.64

CONC. MON. Mkd. "S.P."

LOT 3

PASS LAKE

Δ 75°-40' C 16-00 ₹ 278.1 L. 472.9

16+87.7

12+14.8

14+92.9

Easement from State Park Bd Recd 6-10-46

N. 74° 45' W.

N. 53-46 W. STA. 2+00.9

11+80.95

4+25.4

Δ 20-59 C. 10-00 ₹ 106.1 L. 209.8

5+29.1

3+19.3

N. 83-26 W.

12°C

N. 41-25 W.

125+38.77

N. 67-09 W.

10°C.

S. 58-19 W.

138+80

NO. 1-D

11°C.

119+13.04

131+73.7

2068.19

10°C.

6°C.

S. 23-00 W.

ROAD

104+53.5

S. 50° 45' 16" E. 1491.81

STATE

S. 41-26 W.

N. 0° 15' 16" E. 1768.55

RESERVATION BAY (BOWMANS)

N. 18000

N. 20000

M.C. Not found

93+09.5

Approx 1/4 Cor. not found

10°C.

23

26 25

IRON PIPE N 17948.20 E 12732.33

Original drawing on file State Dept. Pub. Lands.

SECTION 24

TOWNSHIP 34 NORTH, RANGE 1 EAST, W. M.

SKAGIT COUNTY, WASH.

SCALE, 1 INCH--400 FEET

DATE June 22, 1966

Lloyd Johnson COUNTY ENGINEER

N. 23,026.59
E. 12,736.86

8"X8" Cedar Post
Found
Found 6"x6" Post
Mound rock
old fence cor. (42)

S89° 46' 50" E.
2668.27'

N. 23,016.37
E. 15,405.18
Relocated

S 89° 46' 50" E
2668.27'

N 23,006.15
E 18,073.50
Conc. Mon.
Found

N0° 38' 10" W
1224.50

Notes: 283
562

Note: Roads Drawn From Tracings & Aerial Photos - Not to scale ----

Check R/W with Plat

N21,802.09
E 12,751.44

M.C.

Set ½" Pipe 1947
6"x6" Post Rotted

N0° 42' 10" E
2589.32

N0° 17' E
1314.69

PASS LAKE

N20,487.40
E 12,744.89

S88° 41' E
2629.23

N20,427.02
E 15,373.42

S88° 41' F
2624.79

N 1° 39' E
2640.53'

Dewey Crest Lane
R/W - 50'

No. (1415)-1181
(No. 611)

R/W-50

North Dewey Beach Dr.
No. (1481)-(6127-1241)

Central Ave.
R/W-50'
(No. 371)

1030
No. (1417)

Deception Road No. (1440)-1211
R/W-60'
(Deception & Lake Campbell)

Old Roads Vacated
Comm File 7304

No. (1-D) 525

Tank W.W. Cert. Hwy. No. 678

N20,366.70
E 17,997.52

Conc. Mon. Found

Yokeko Drive No. (1419)-1000
(GRAND AVENUE)
(No. 337)
R/W-50'

N 1° 16' E
1883.41

Conc. Mon. on Sec. Line

445.55

M.C.
Found

N 18,483.75
E 17,965.25

N18,591.69
E16,062.51

Original ℄ Starr St. Road
No. CLX Extension

N18,601.07
E17,306.11

FOR DETAIL
SEE
FIDALGO CITY

STATE HIGHWAY

N0° 17" E
2539.20'

Iron Pipe Found
N 17,948.20
E 12,732.33

S89°46' 50"E
767.12

M.C.
Relocated by running parallel
to North Line and proportional distance

N0° 24' 28" W
892.30'

M.C. Relocated by running mean distance & bearing
from W. Line Sec. 23, E. Line Sec. 24, & Line between Secs. 23 & 24

DECEPTION PASS

SECTION 24

TOWNSHIP 34 NORTH, RANGE 1 EAST, W. M.

SKAGIT COUNTY, WASH.

SCALE, 1 INCH--400 FEET

H.O. Walberg COUNTY ENGINEER

N. 23,026.59
E. 12,736.86

8"X8" Cedar Post
Found

S89° 46' 50" E.
2668.27'

N. 23,016.37
E. 15,405.18

Relocated

S 89° 46' 50" E
2668.27'

N 23,006.15
E 18,073.50

Conc. Mon.
Found

N0° 38' 10" W
1224.50

N21,802.09
E 12,751.44

M.C.

N0° 42' 10" E
2589.32

N1° 39' E
2640.53'

N0° 17' E
1314.69

PASS LAKE

N20,487.40
E 12,744.89

S88° 41' E
2629.23

N20,427.02
E 15,373.42

S88° 41' E
2624.79

N 20,366.70
E 17,997.52

Conc. Mon.
Found

State Road No. 1-D

GRAND AVENUE

R/W - 50'

N1° 16' E
1883.41'

N0° 17" E
2539.20'

Conc. Mon. on Sec. Line

445.55

N18,591.69
E16,062.51

Original ℄ Starr St.

N18,601.07
E17,306.11

Road No. CLX Extension

M.C.
Found

N 18,483.75
E 17,965.25

Iron Pipe Found

N17,948.20
E 12,732.33

S89°46'50"E
767.12

M.C.

Relocated by running parallel
to North Line and proportional distance

N0°24'28"W
892.30'

DECEPTION PASS

M.C. Relocated by running mean distance & bearing
from W. Line Sec. 23, E. Line Sec. 24, & Line between Secs. 23 & 24


SECTION 2

TOWNSHIP 34 NORTH, RANGE 2 EAST, W. M.
SKAGIT COUNTY, WASH.

SCALE, 1 INCH=400 FEET

A. L. STRONG COUNTY ENGINEER

Vacated CJ 12 pg 248 1976

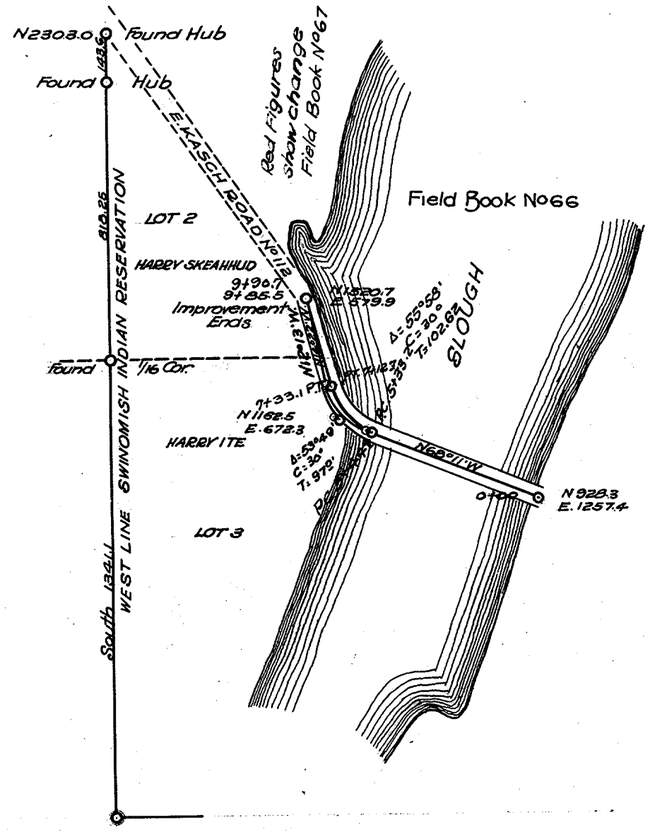

SECTION 3

TOWNSHIP 34 NORTH, RANGE 2 EAST, W. M.


SKAGIT COUNTY, WASH.

SCALE. 1 INCH--400 FEET

W. A. COSTELLO COUNTY ENGINEER

JAN. 1940 - A1 Notes: 40457

See also: Bk. No. 66

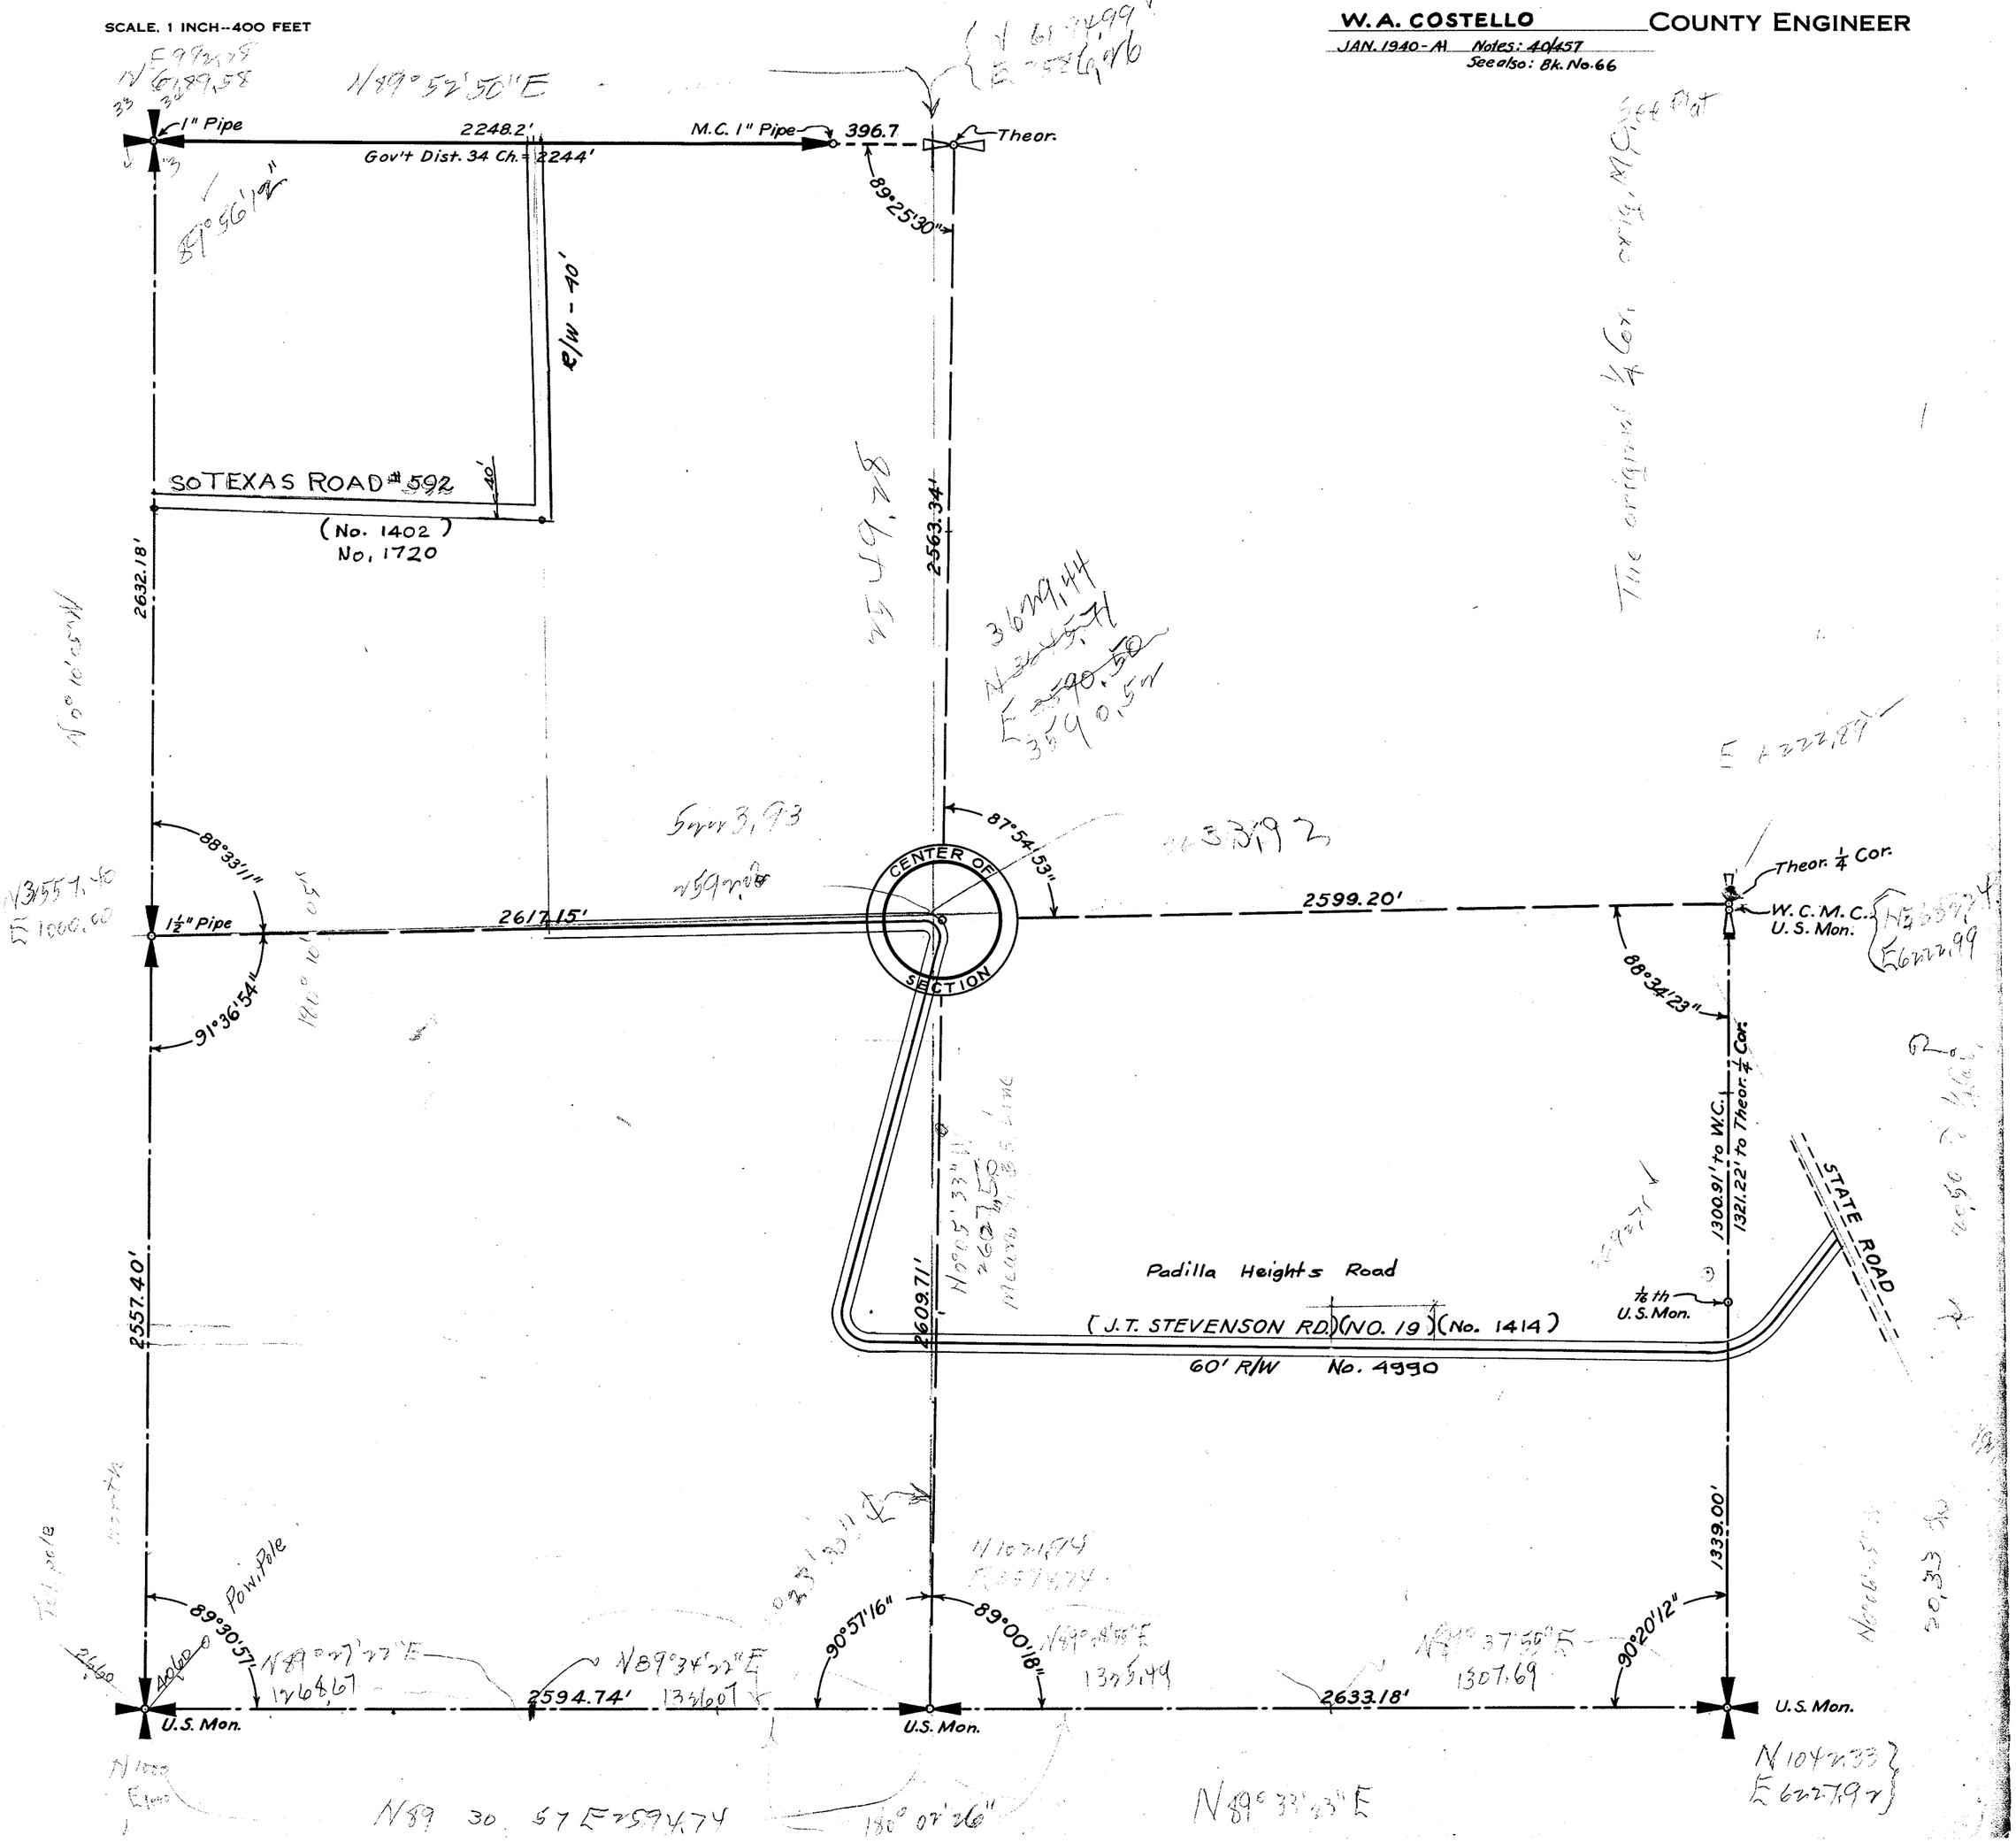

SECTION 3

TOWNSHIP 34 NORTH, RANGE 2 EAST, W. M.

SKAGIT COUNTY, WASH.

SCALE, 1 INCH--400 FEET Notes 40/457

N6189.98
E992.28

H. O. Walberg COUNTY ENGINEER

Apr. 1951. W.

Q4

1947 - 1½" I.P.

1" pipe N89° 54' 50" E 2583.98

N619499
E3586.76

34.52

30+11.0

M.C. 1" pipe

March's Point Rd. No. 184
Consolidation Aug. 1958

March's Point Road (No. 184)

P.C. 35+98.1

P.T. 38+35.1

P.I. 37+16.8

Δ = 7°07'
T = 3+18.7
L = 237.0

1509

70°02'
65°55'

A.G.N. R.R.

4390.9

44+77.0

N0°10'05" W 2632.18

2549.28

E and W Lines

N.S. ℄ = mean of

P.S.H. (No. 1)
New Hwy Location
This portion called
South March's Point Road
No. 1466

35+00

No. 4021
(No. 1435)
(No. 204)

R/W - 40'

38/351

5223.94

3629.44
N0°57'W
E3590.50

2588.81 to Fence

N88° 24' 55" E
2633.92

1/4 (or) {3762.40 / 6222.89}

M.C. 25 Nails Set

N3557.40
E1000.00

1½" Pipe

N88°-02'-26" E 2592.00

S89°43'20"E 1294.61

2585.77 to P.C.

N3549.96
E3585.77

0.8 Chain = 89.99

U.S. Mon. W.S.M.C.

1 Ch. = 66.59

North 2557.40

Reservation Rd. No. 204
Consolidation
Aug. 1958

N.0°26'22"E. Road

16+66.8

P.S. = 8+99.6

13+64.0

P.T. 10+61.1

P.C. 7+28.3

Δ = 33°17'
C = 10°
T = 171.3
L = 332.8

P.I. 8+99.6

Reservation Road

N.0°25'22"E.
769.73'

Δ = 32°27'
C = 16°
T = 104.2
L = 202.8

P.I. 1+25.2

P.T. 2+23.8

P.C. 0+21.0

0+00

1/16 Cor.

N1000
E1000

U.S. Mon.

N89°27'27"E 1268.67

N89°34'22"E 1326.07

N0°05'33"W 1408.8

N1021.94
E3594.74

U.S. Mon.

N89°28'55"E 1325.49

N89°37'55"E 1307.69

U.S. Mon.

N1042.33
E6227.92

N114°14'E 1358.73

2623.77

1319.22

N2230.74
E3592.81

341.08

N89°38'03"W 2632.92

N2232.92
E3251.73

1/16 U.S. Mon.

167.4

N2213.93
E6225.67

117.6 ℄ to ℄ Rd

1339.00 to 1/16

N0°06'25"W 2677.91

1352.48

1341.27

Indian Survey

SECTION 3

TOWNSHIP 34 NORTH, RANGE 2 EAST, W. M.


SKAGIT COUNTY, WASH.

Subdiv. by W.C.W.
From 40/451 TB66

SCALE, 1 INCH--400 FEET

H.O. Walberg COUNTY ENGINEER

NOTES: 457
450
309
351
241
246

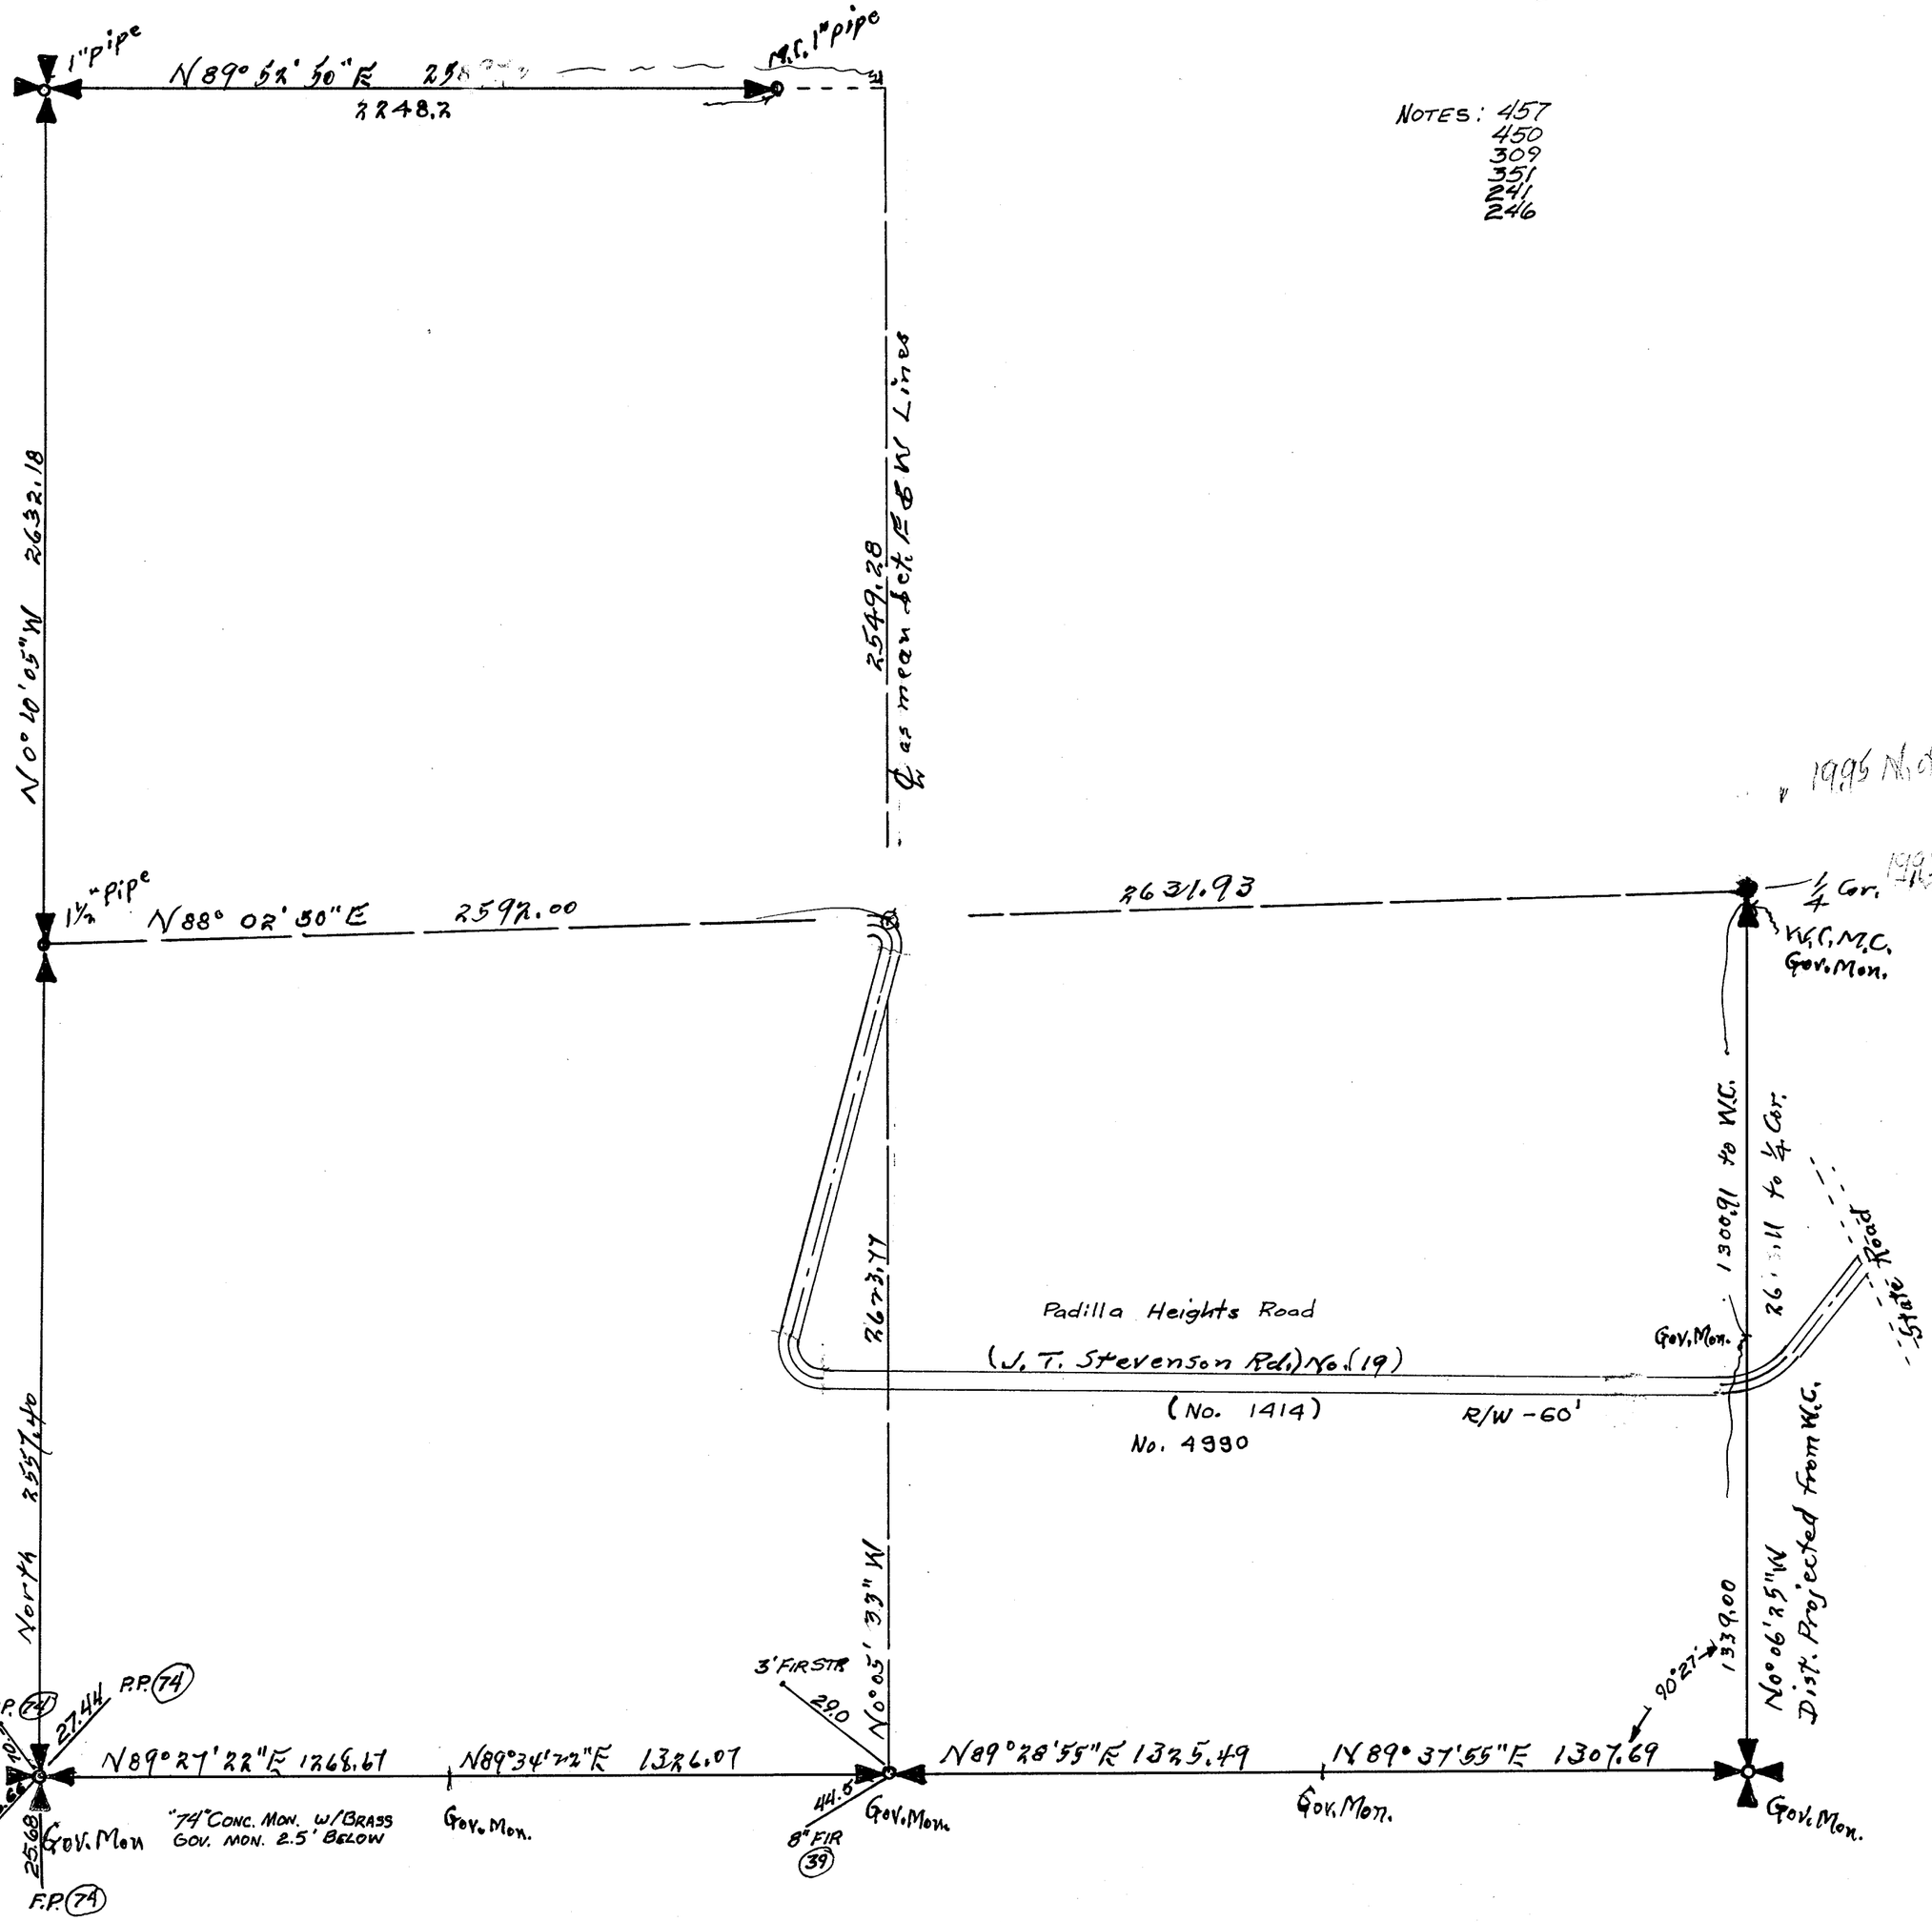


1995 N. of W.S.

SECTION 3

TOWNSHIP 34 NORTH, RANGE 2 EAST, W. M.

SKAGIT COUNTY, WASH.

SCALE, 1 INCH--400 FEET DATE June 27, 1966 Lloyd Johnson COUNTY ENGINEER

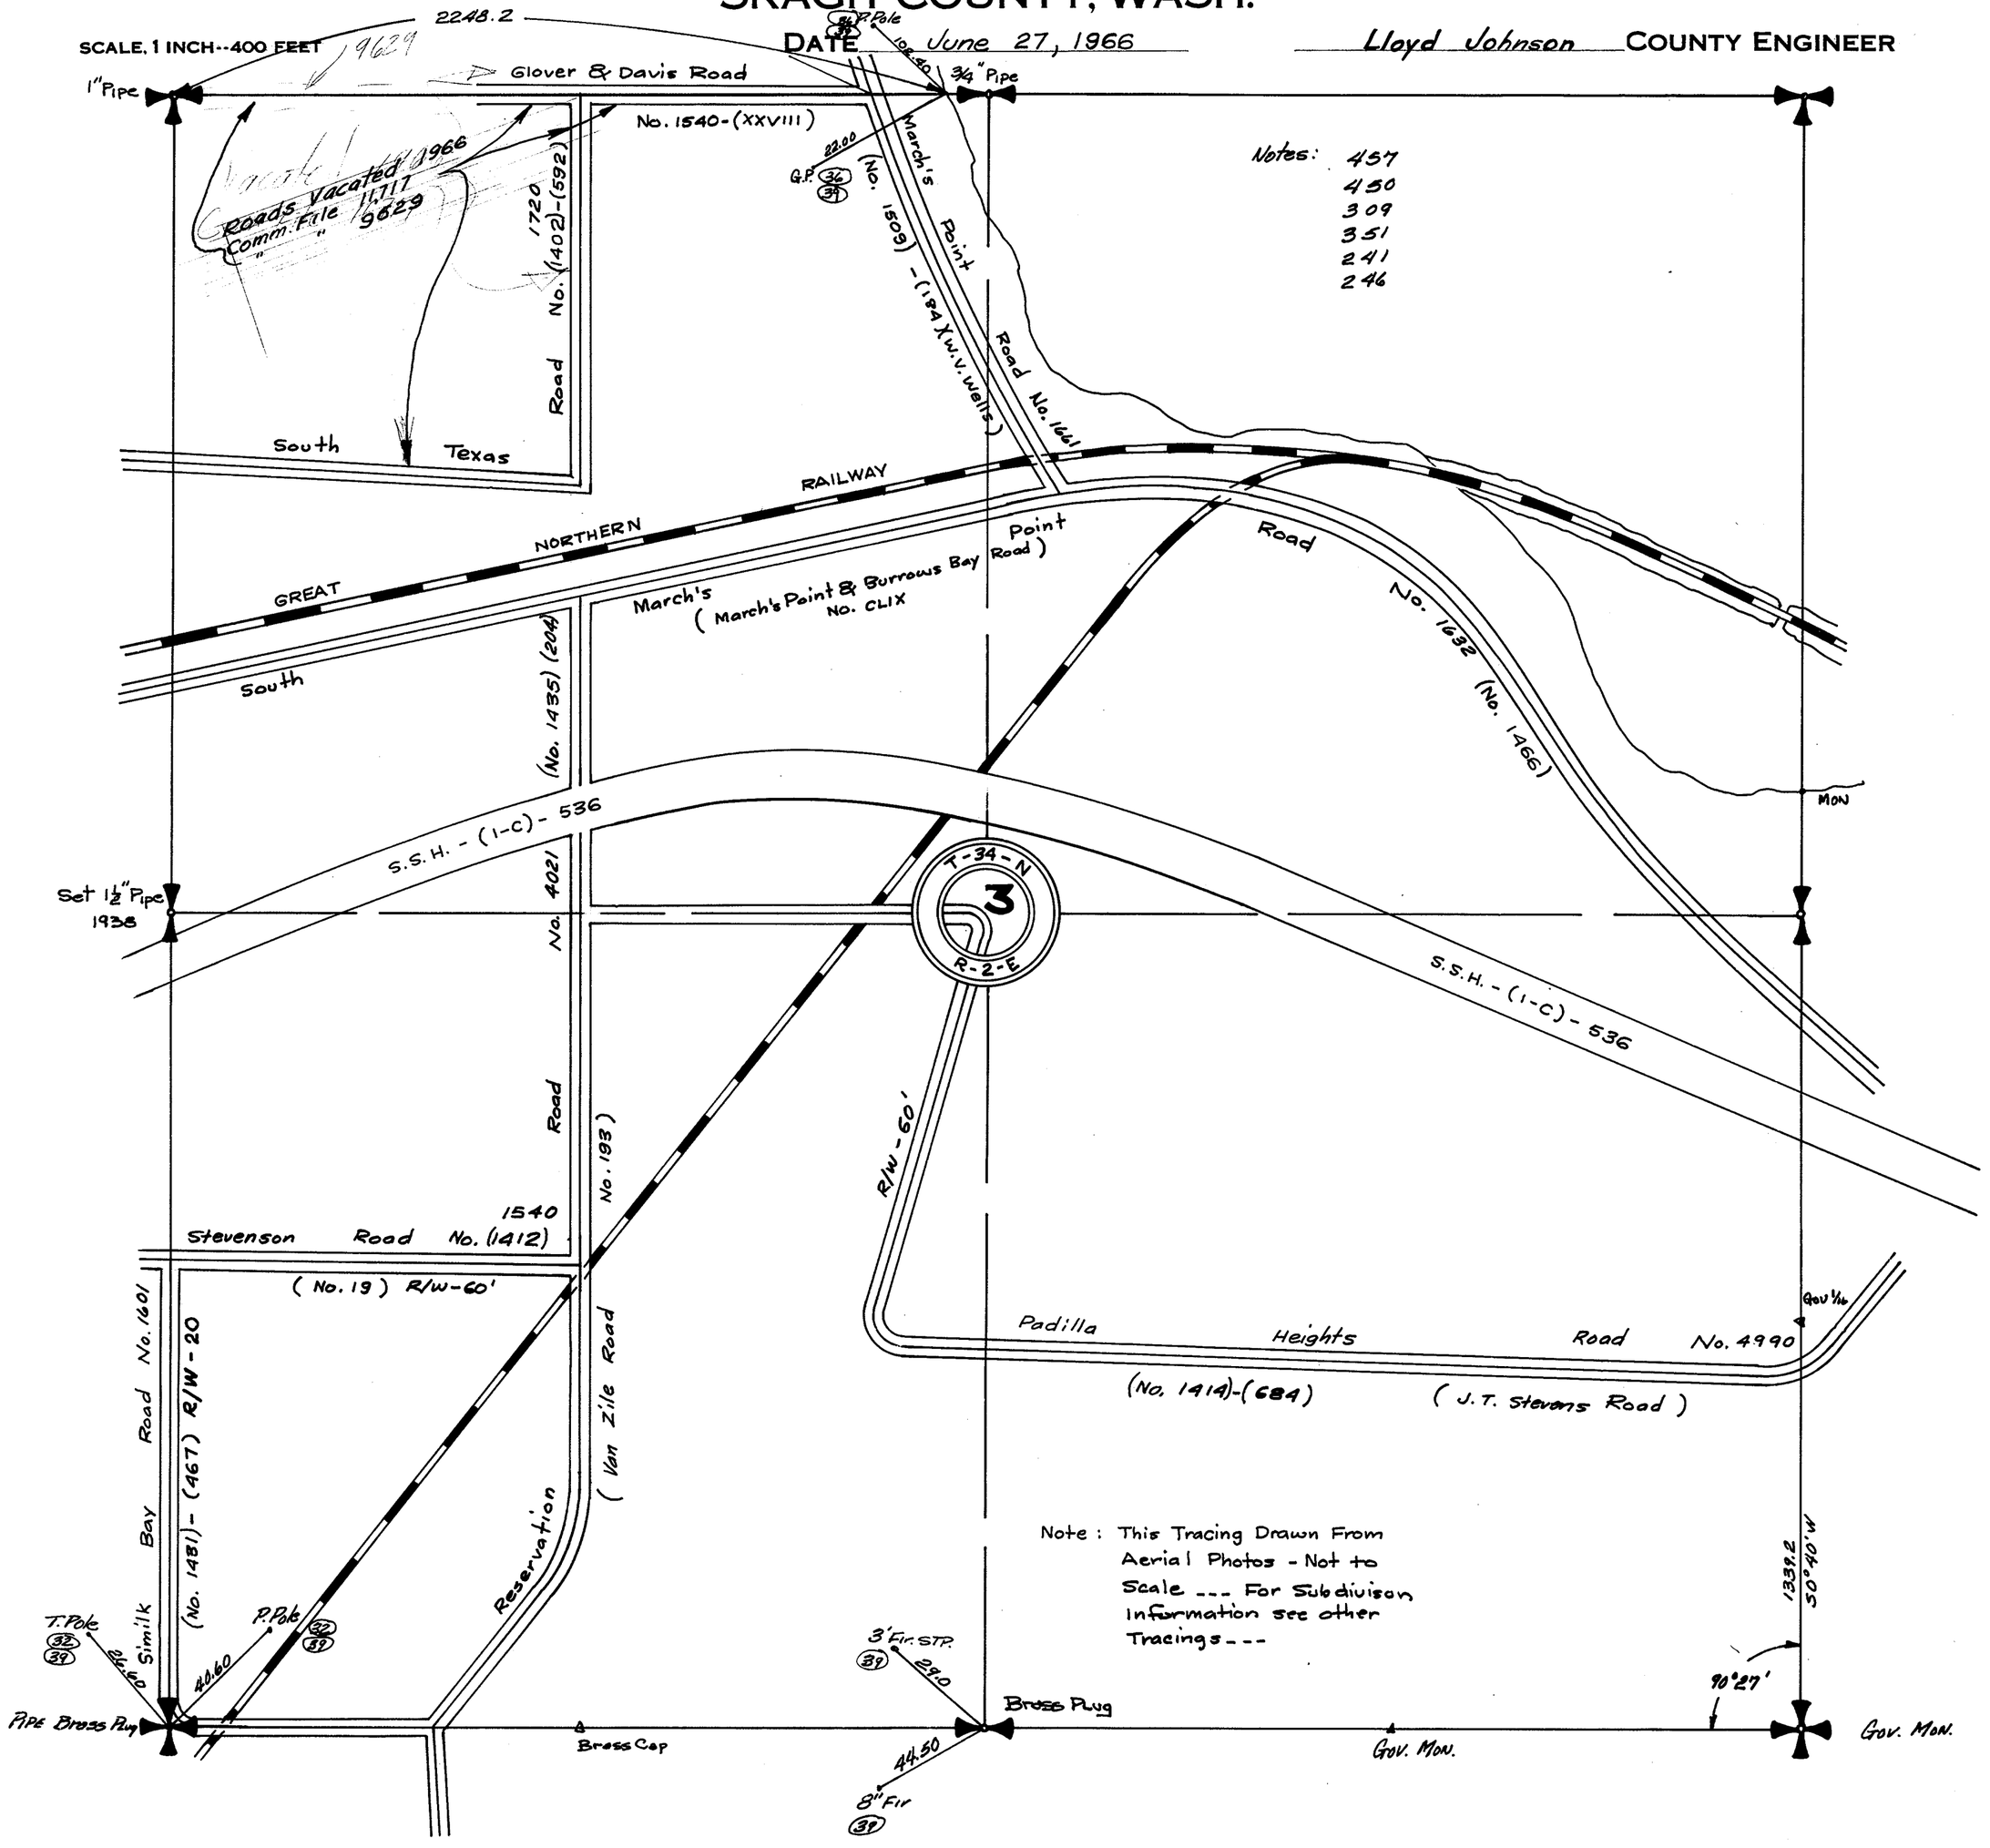

SECTION 4


TOWNSHIP 34 NORTH, RANGE 2 EAST, W. M.

SKAGIT COUNTY, WASH.

SCALE, 1 INCH - - 400 FEET

DATE 3 SEPT 1968

Lloyd H. Johnson COUNTY ENGINEER

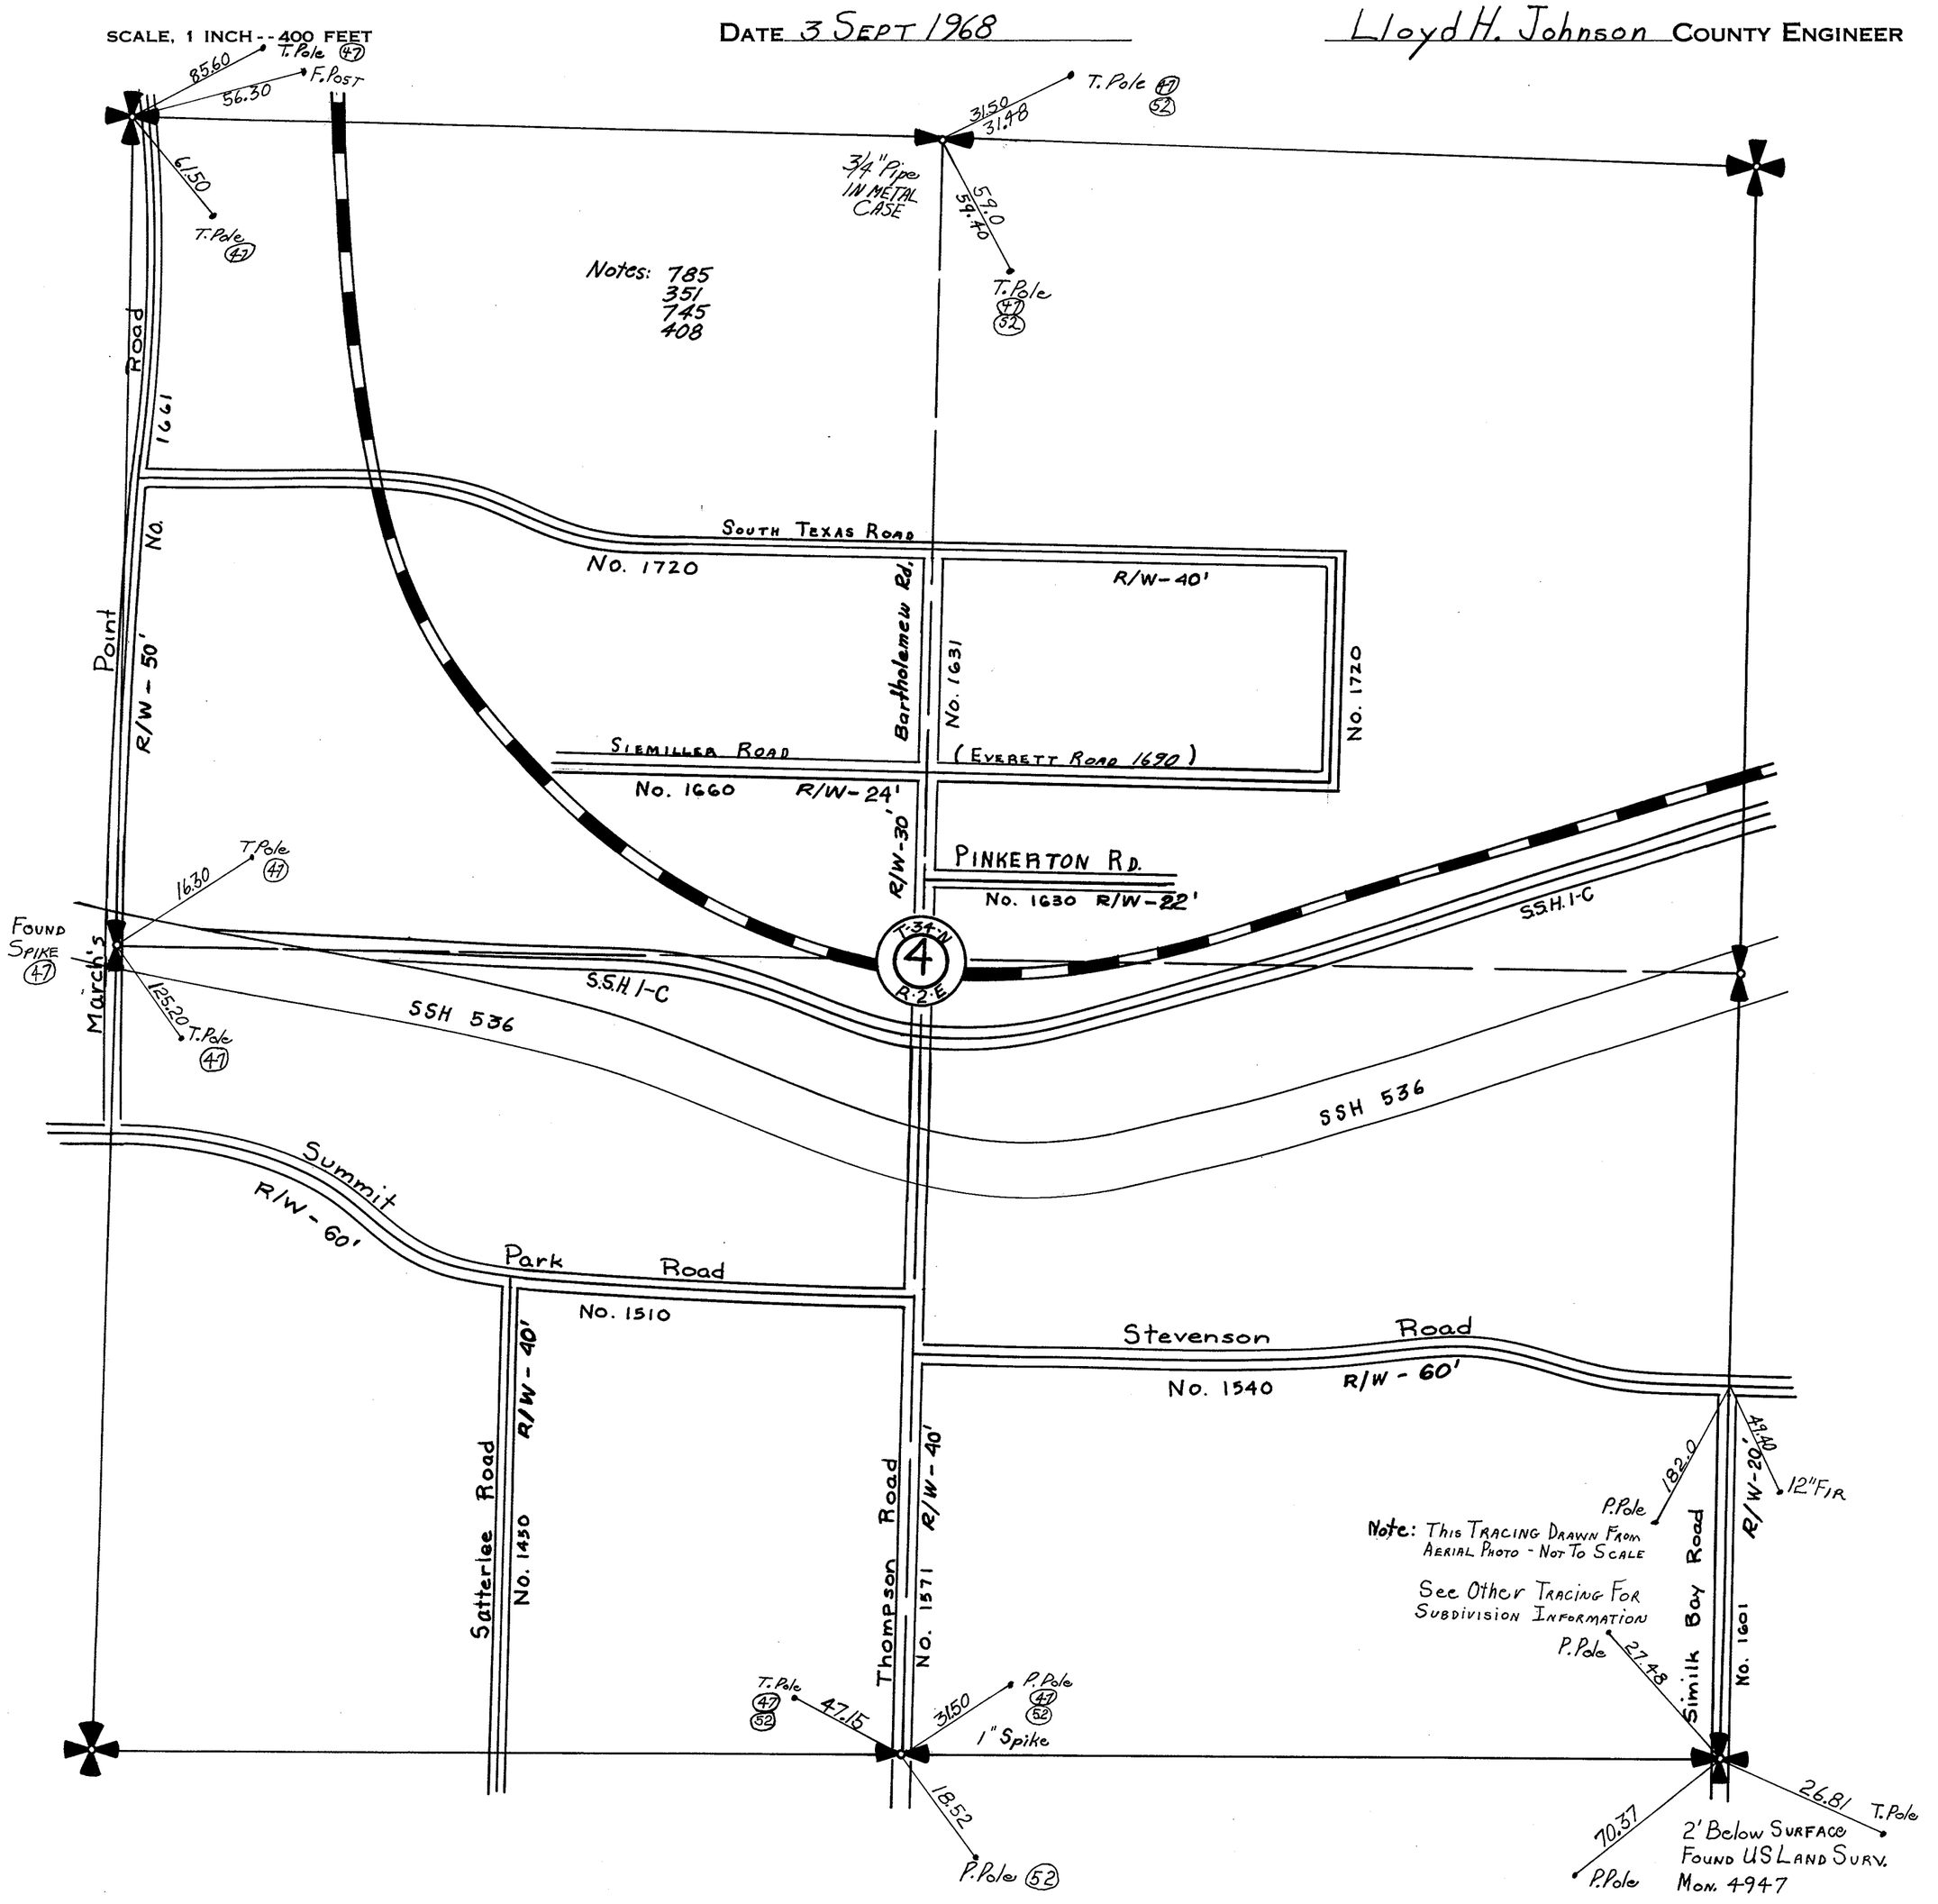


SECTION 4

TOWNSHIP 34 NORTH, RANGE 2 EAST, W. M.

SKAGIT COUNTY, WASH.

SCALE, 1 INCH=400 FEET

Arthur L. Strong COUNTY ENGINEER

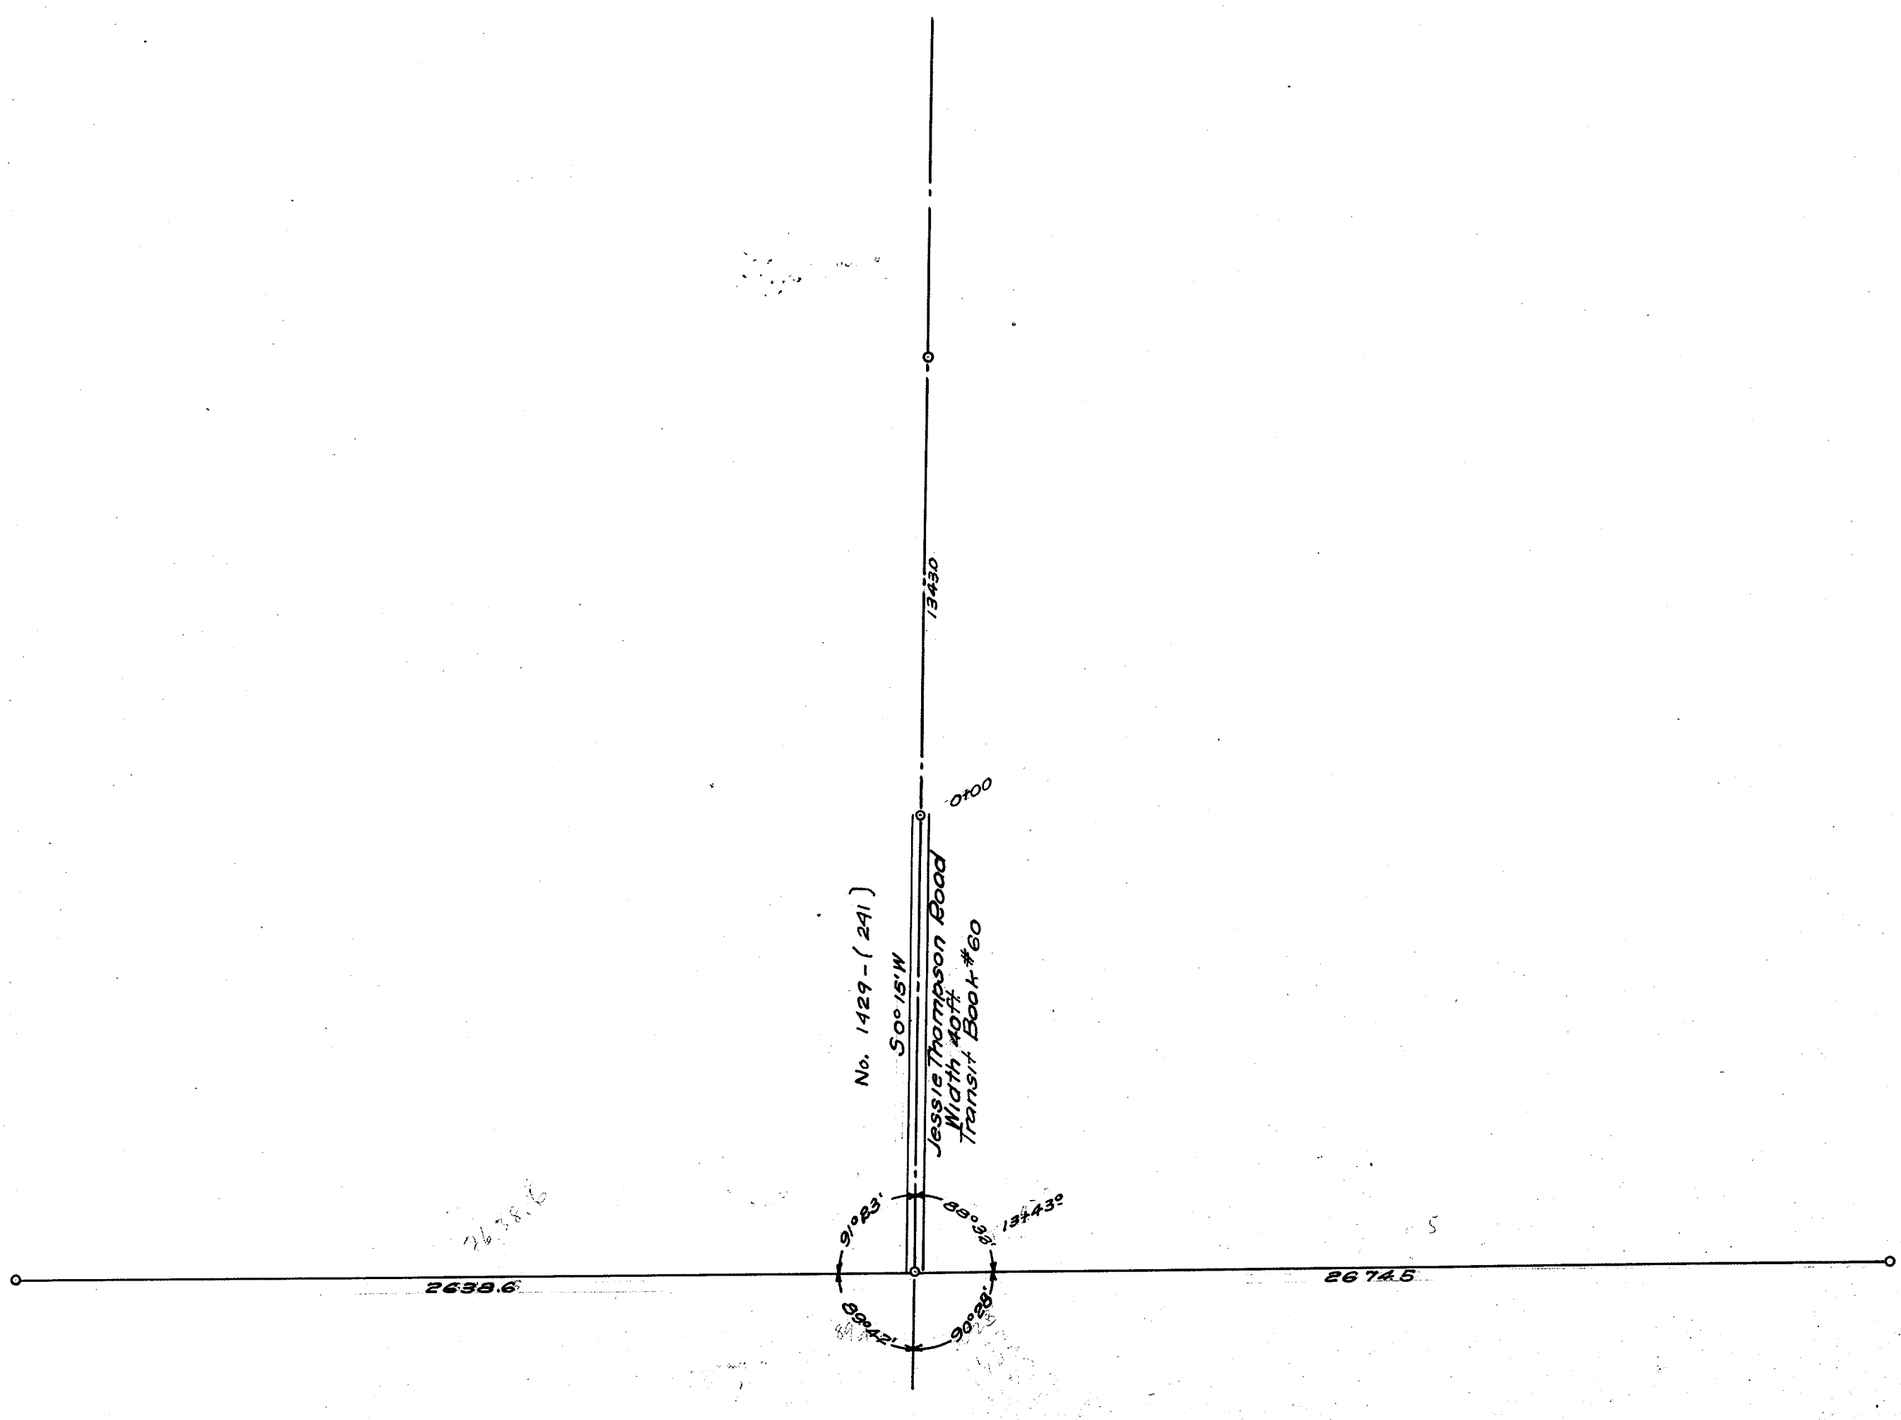

SECTION 4


TOWNSHIP 34 NORTH, RANGE 2 EAST, W. M.

SKAGIT COUNTY, WASH.

SCALE, 1 INCH = 400 FEET

DATE June 24, 1966

Lloyd Johnson COUNTY ENGINEER

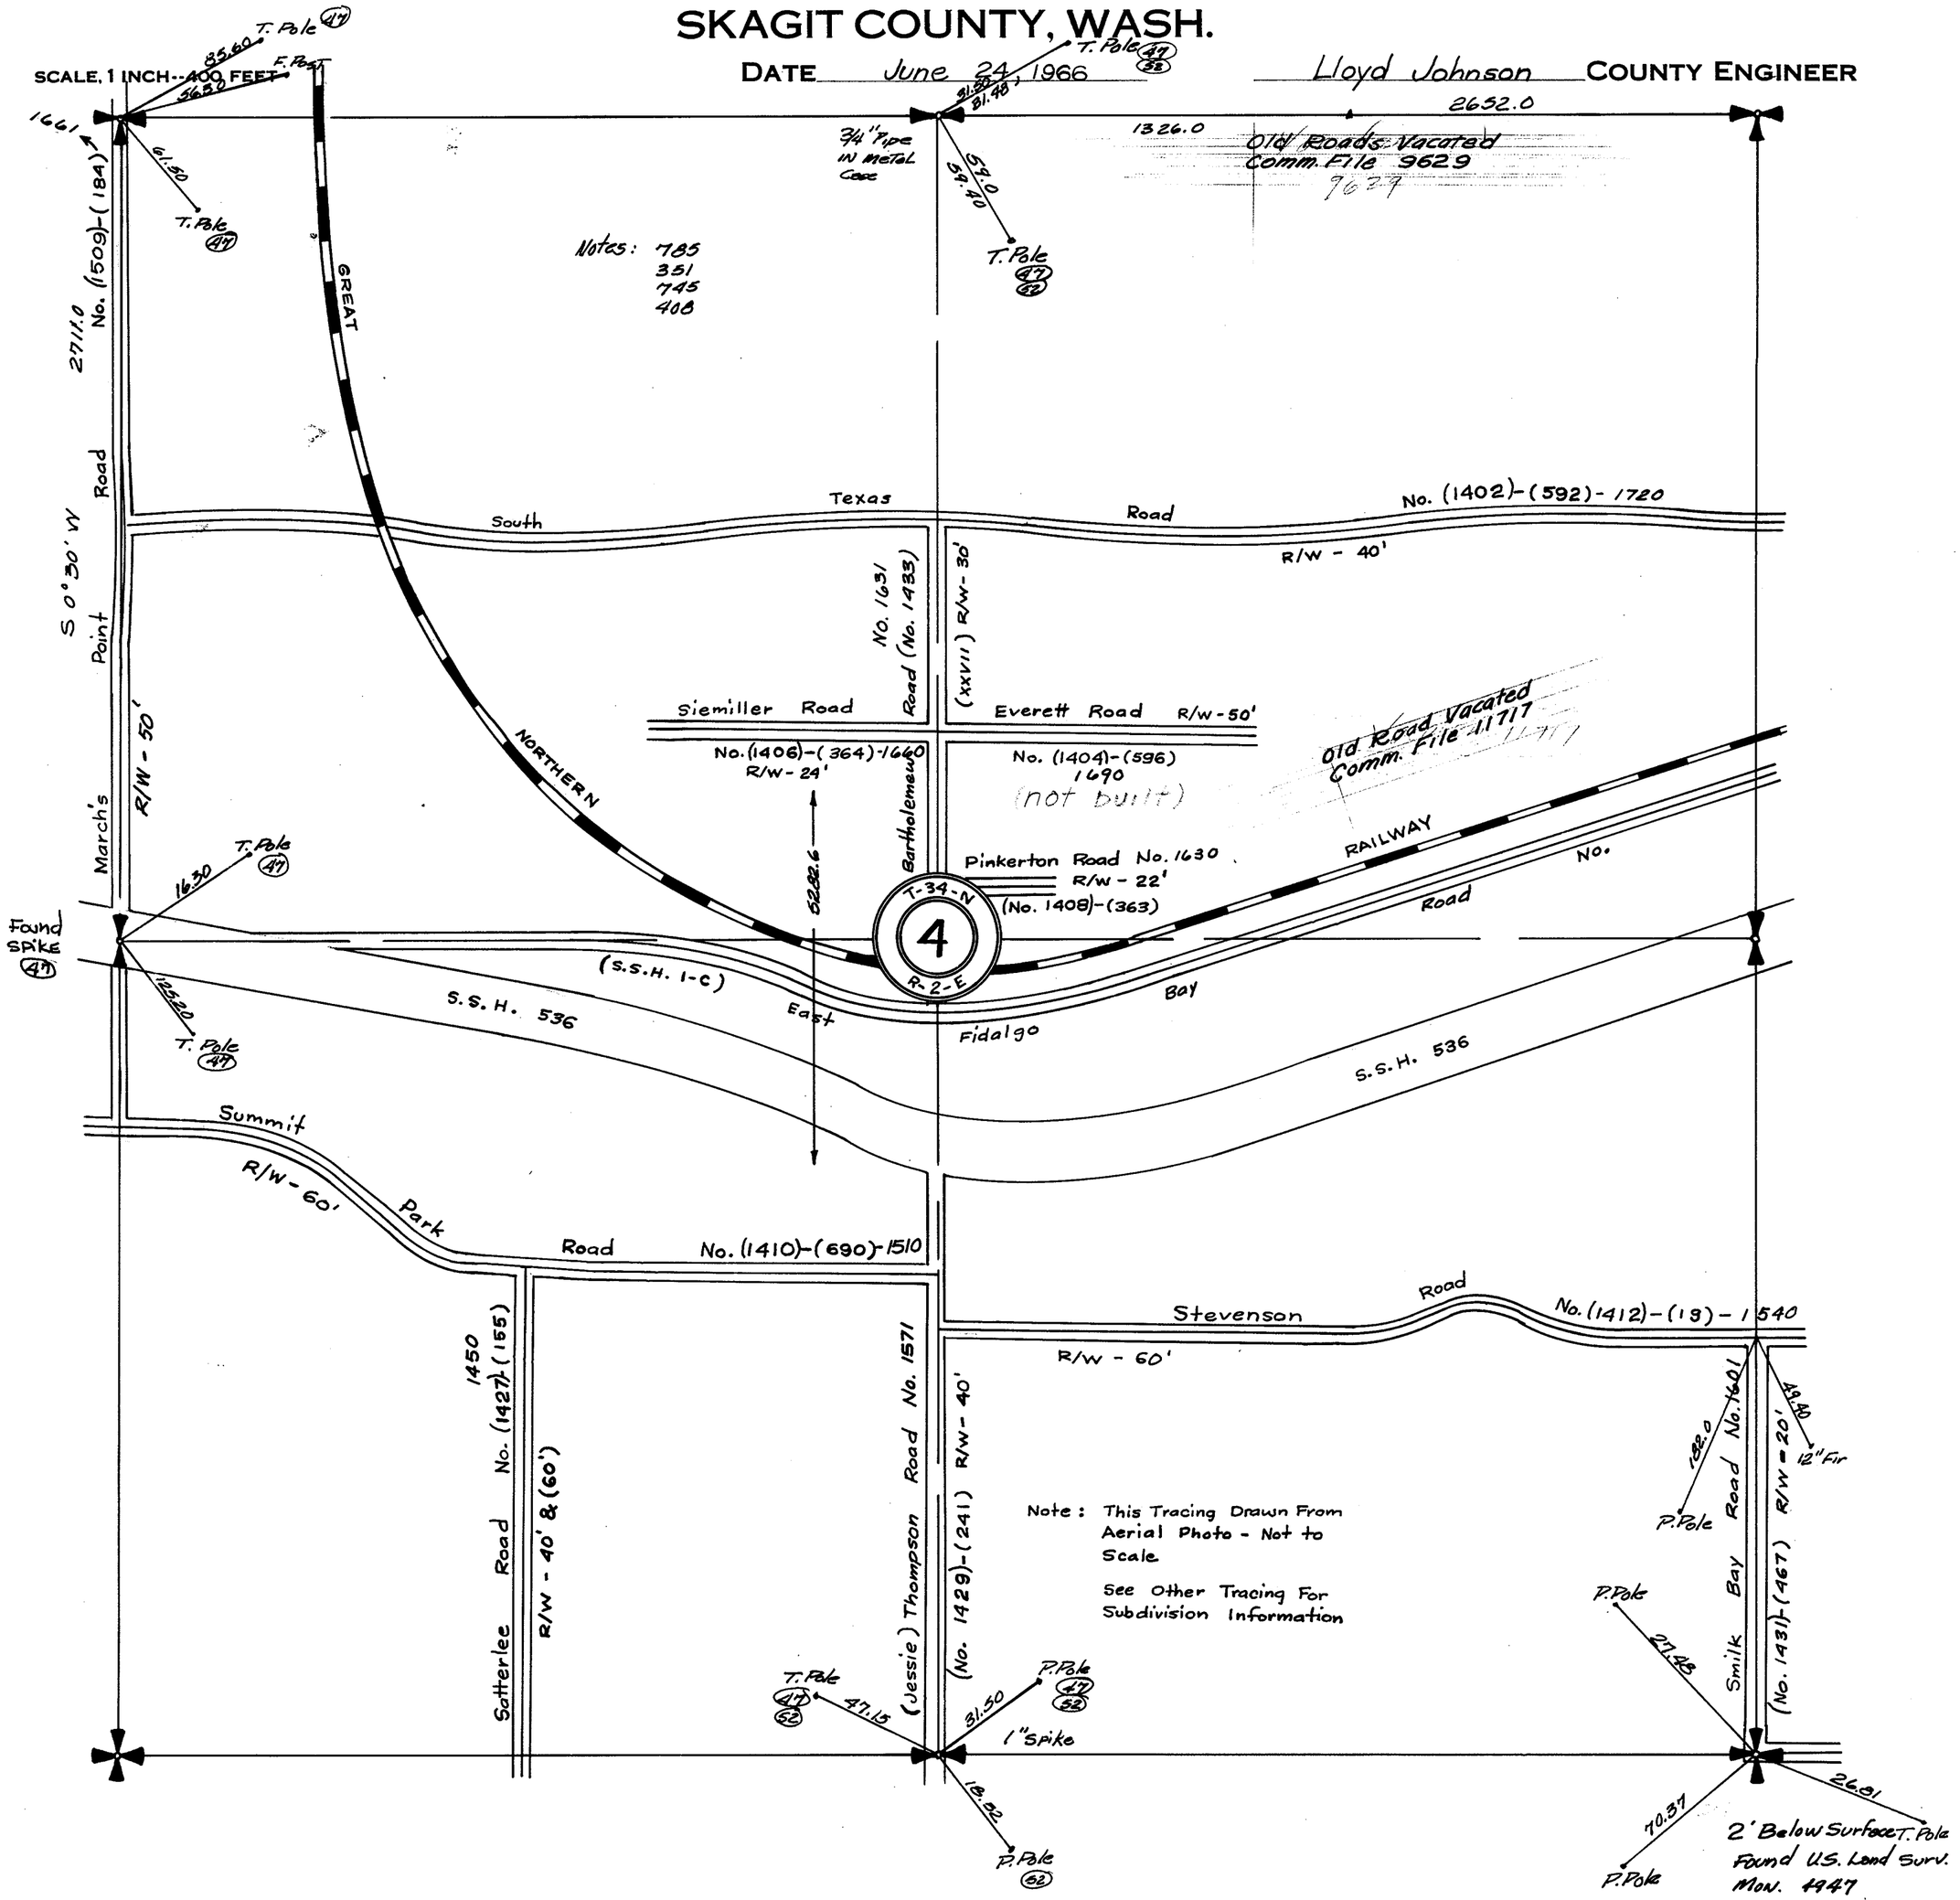

Note: This Tracing Drawn From Aerial Photo - Not to Scale

See Other Tracing For Subdivision Information


NW¼ SECTION 4

TOWNSHIP 34 NORTH, RANGE 2 EAST, W. M.

SKAGIT COUNTY, WASH.

SCALE, 1 INCH--400 FEET


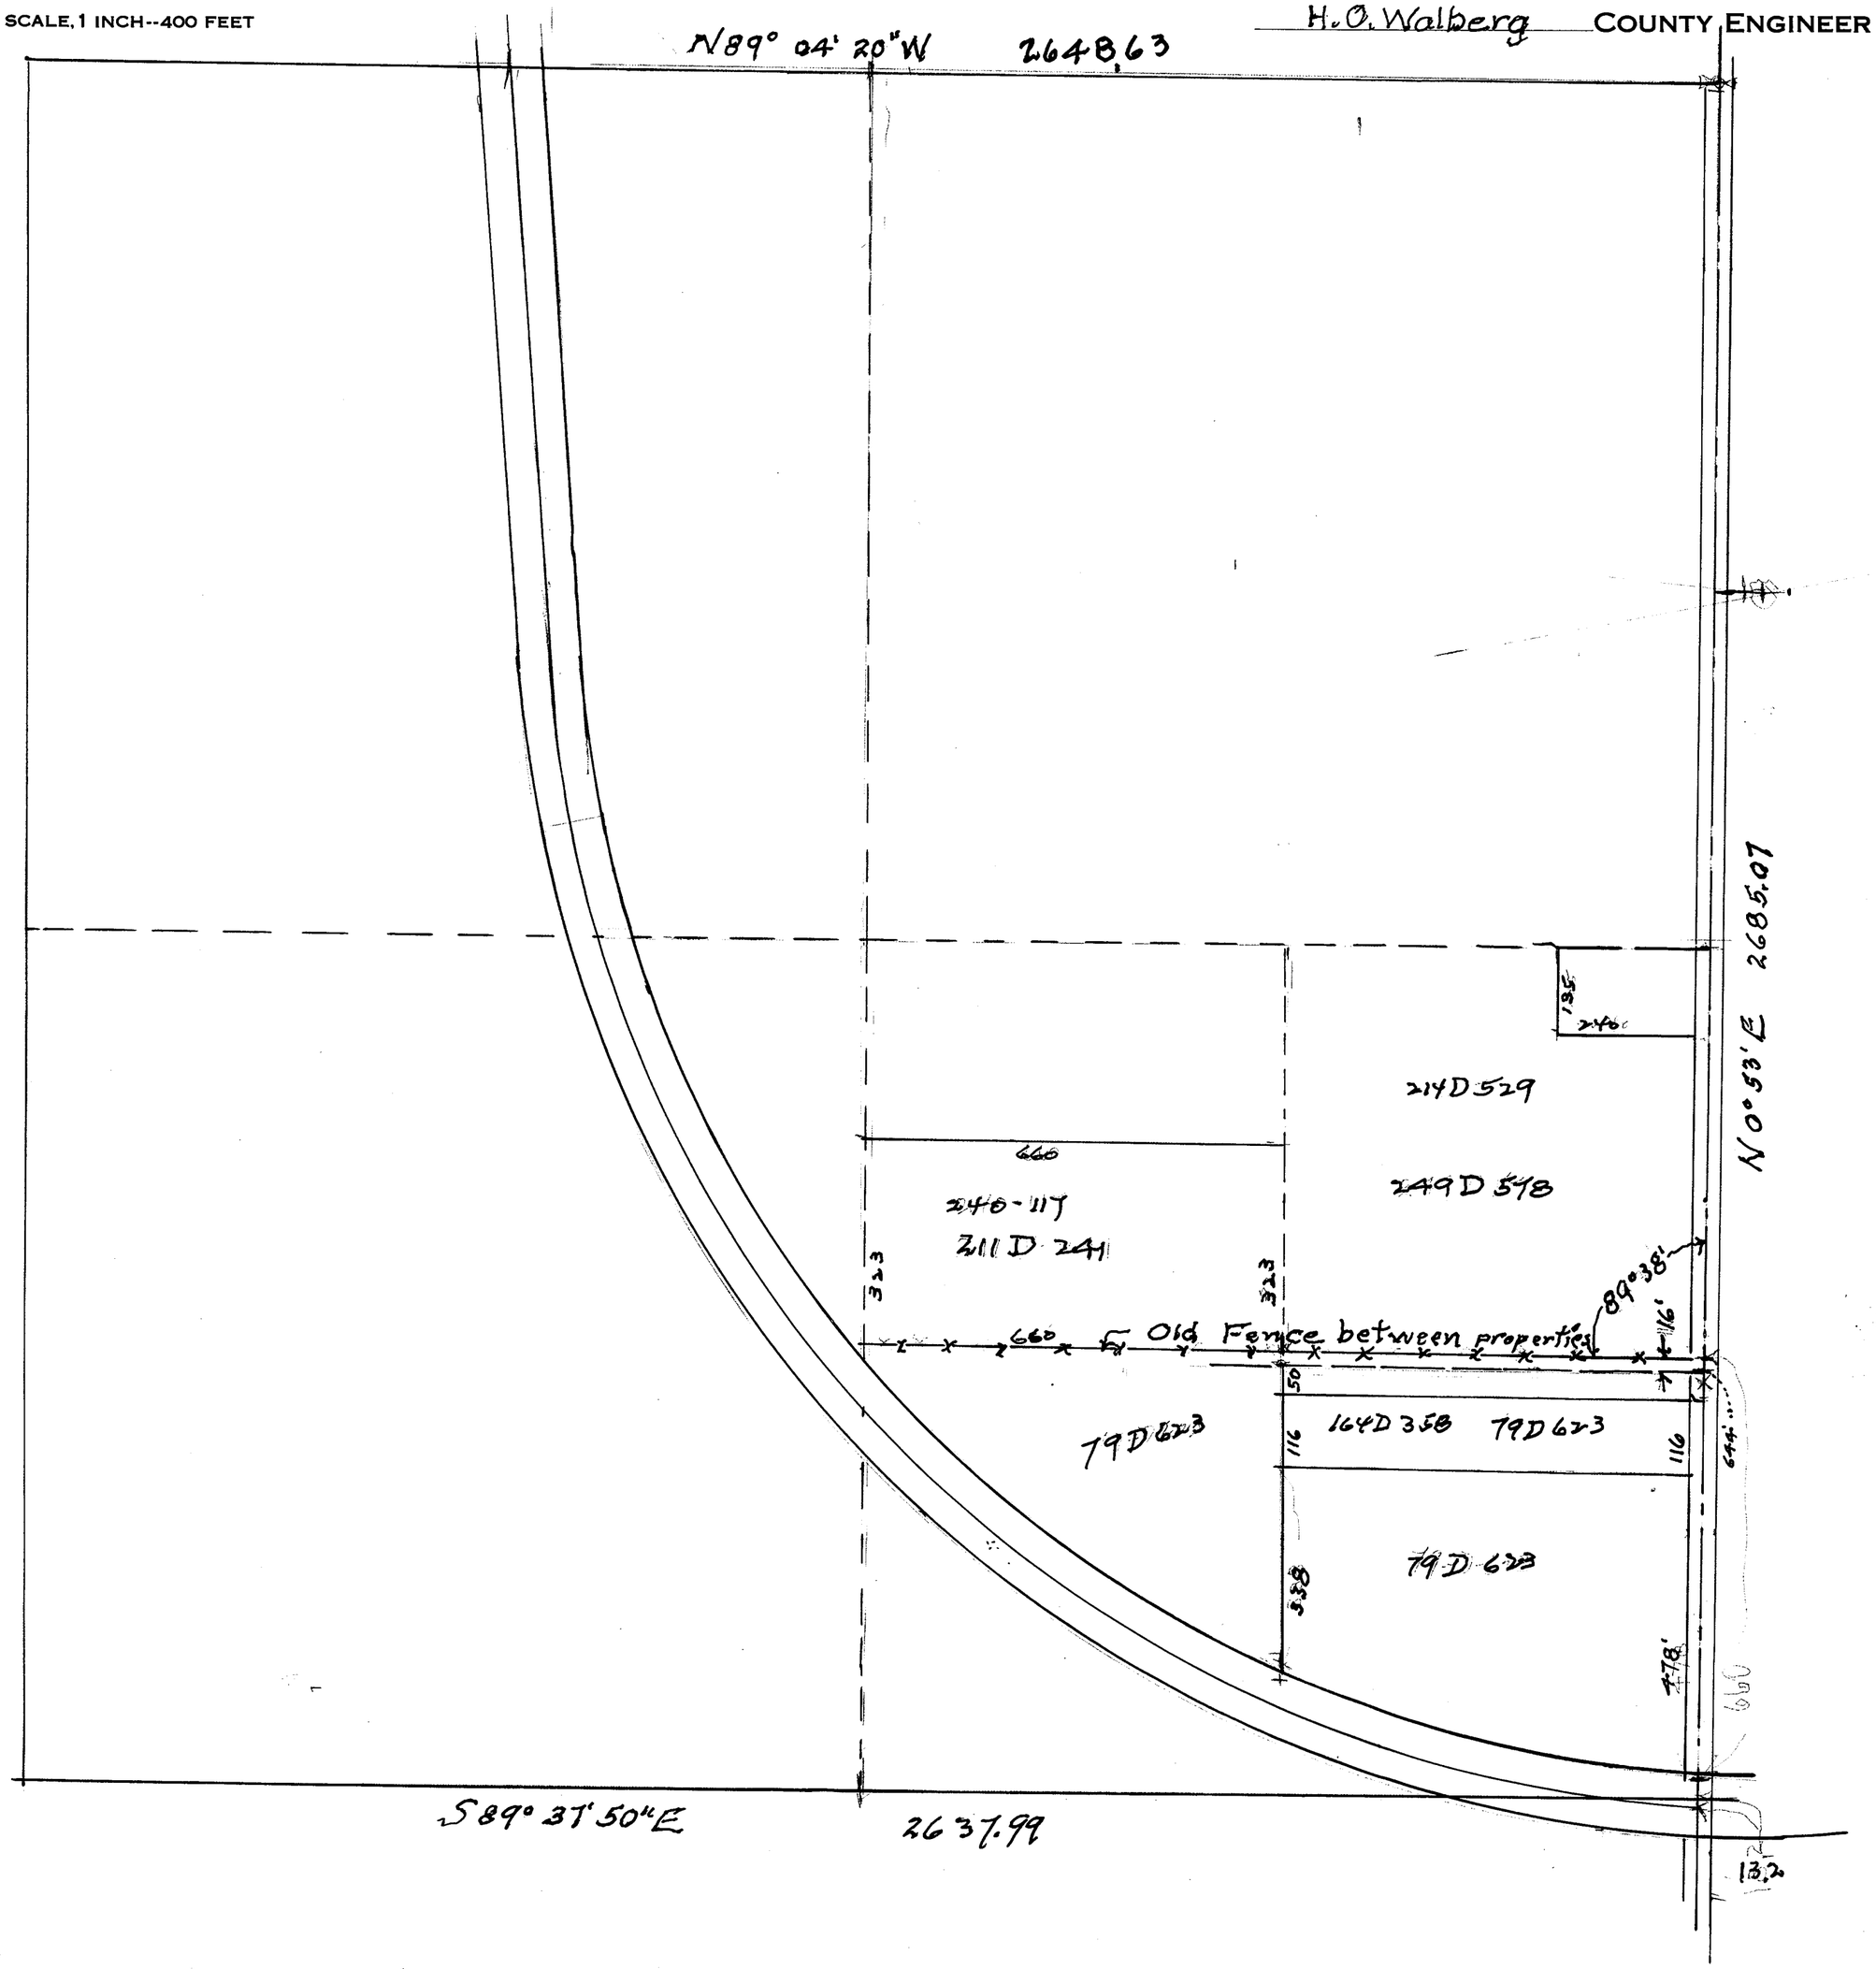

A9-2

SECTION 4

TOWNSHIP 34 NORTH, RANGE 2 EAST, W. M.

SKAGIT COUNTY, WASH.

38/351


720

40/457

42/576

SCALE, 1 INCH--400 FEET

H. O. Walberg COUNTY ENGINEER

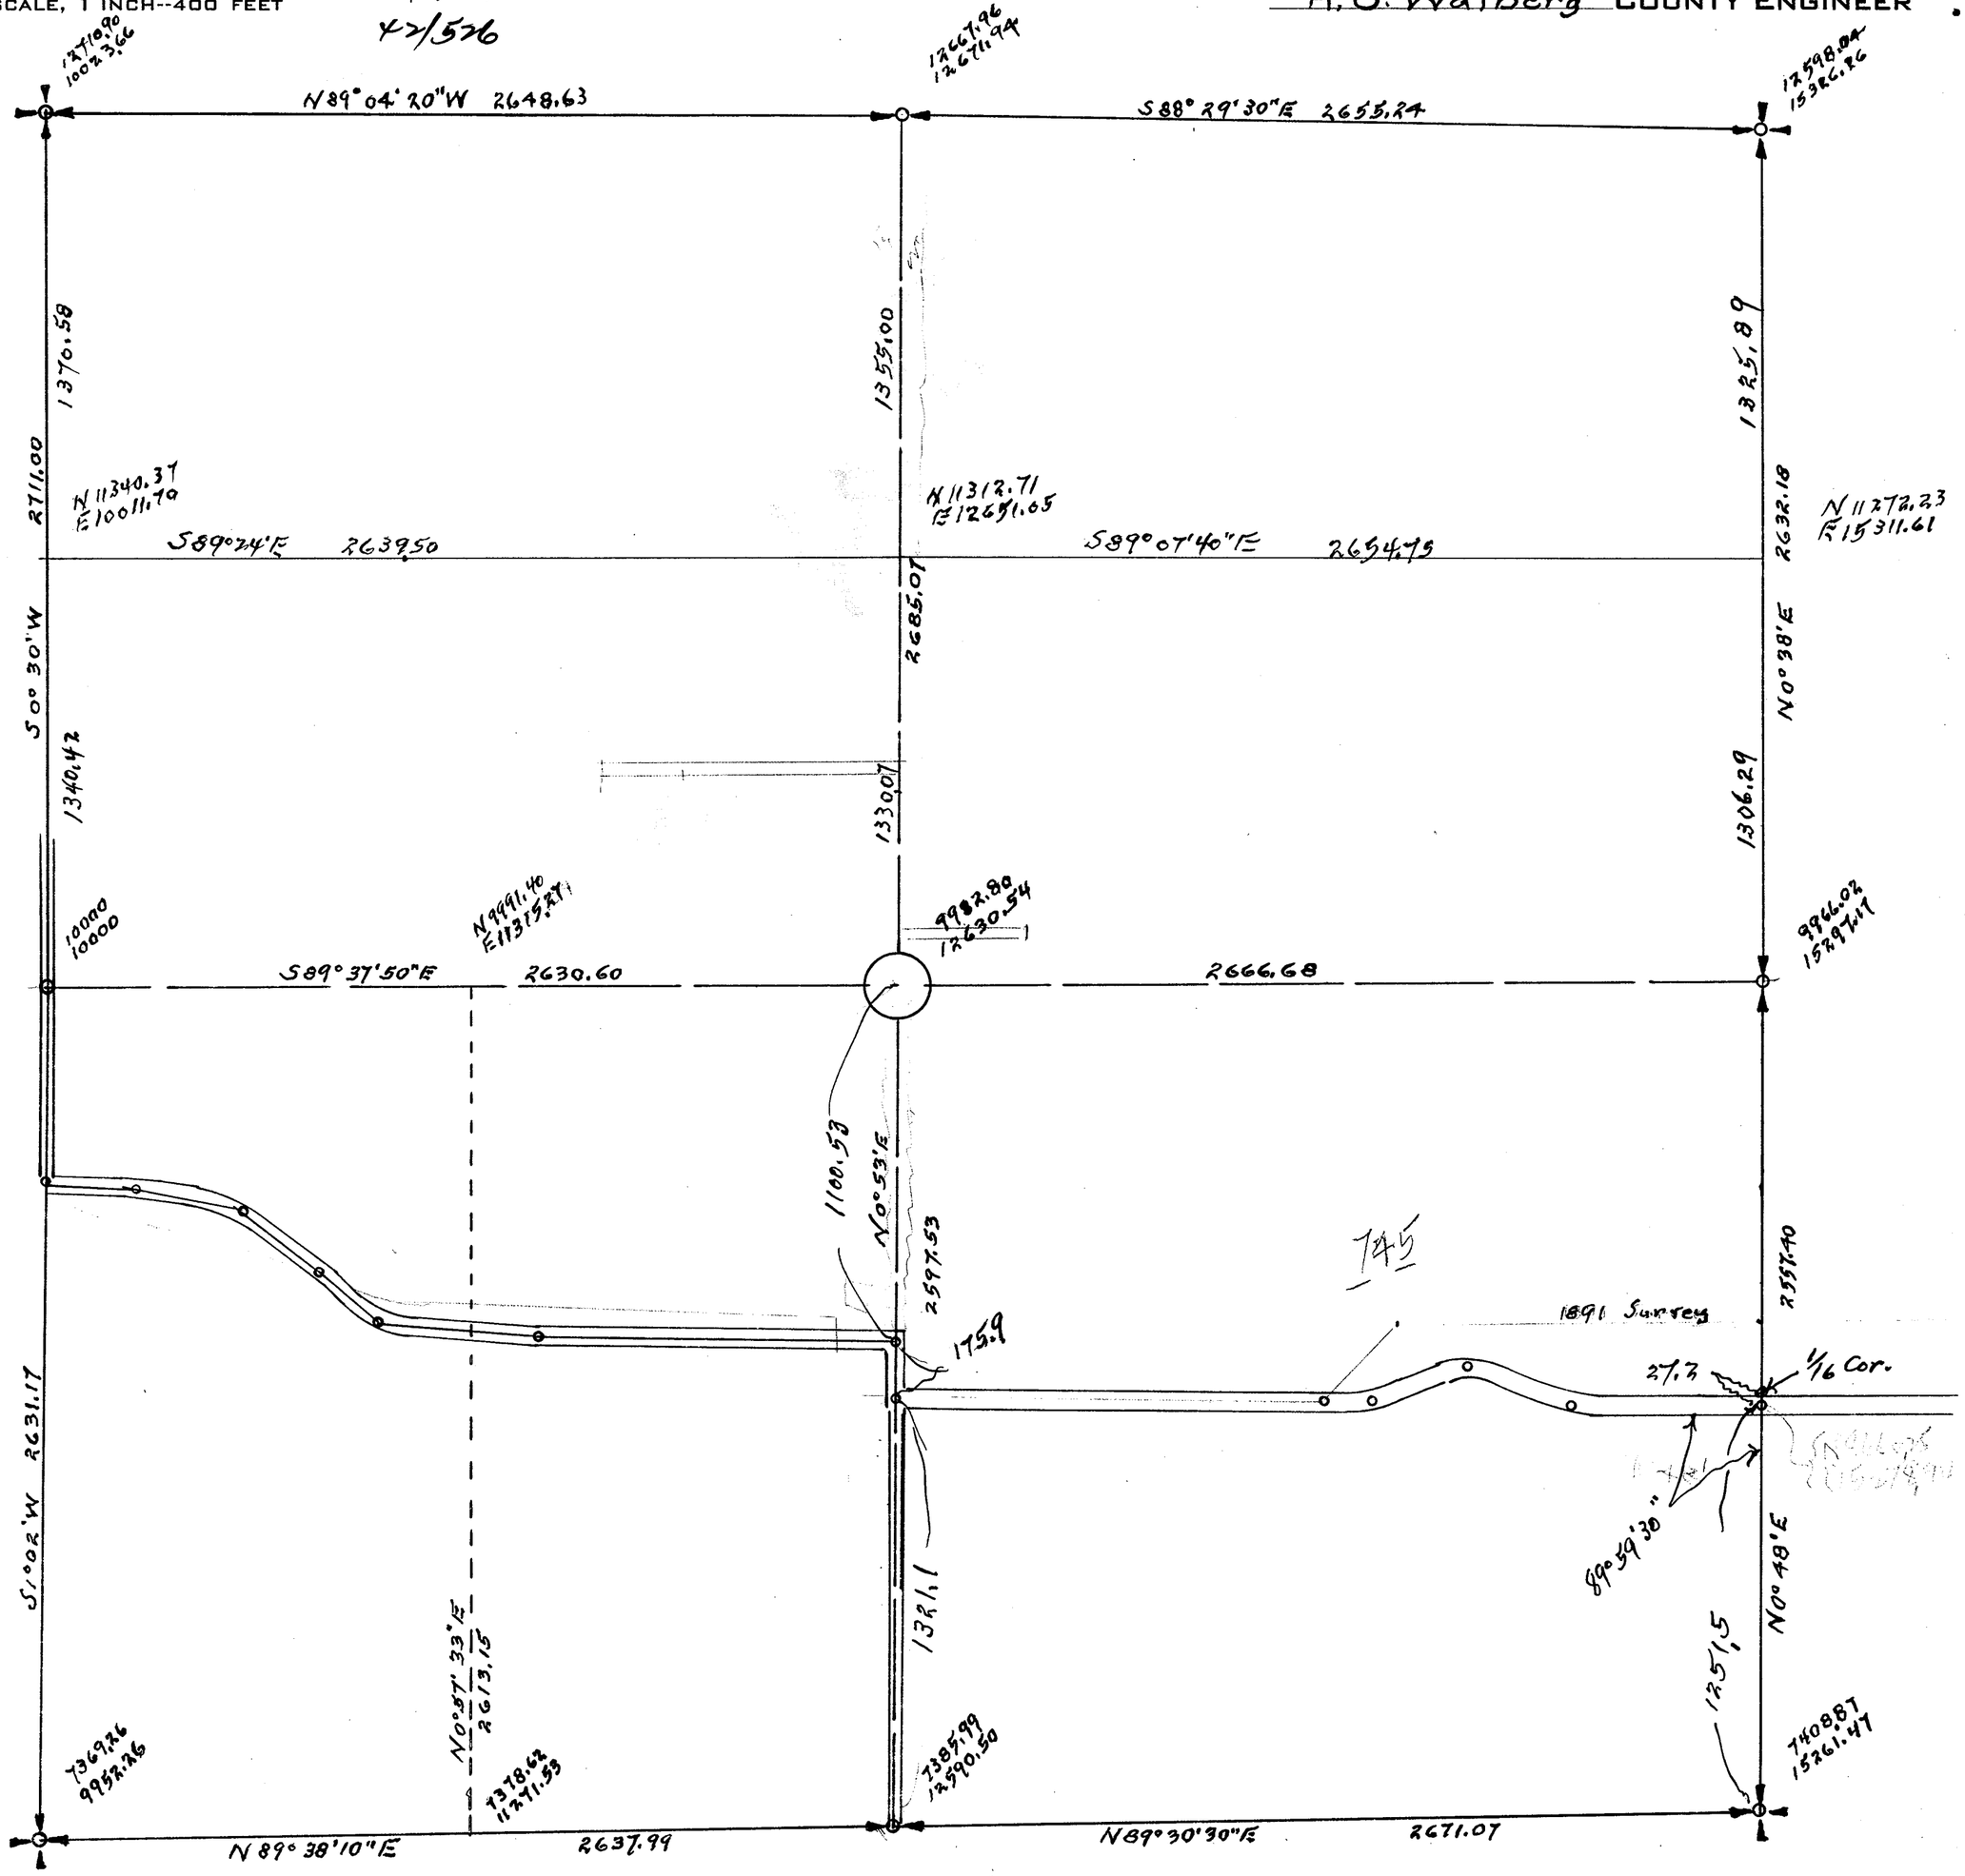


SECTION 4

TOWNSHIP 34 NORTH, RANGE 2 EAST, W. M.

SKAGIT COUNTY, WASH.

H.O. Walberg COUNTY ENGINEER

SCALE, 1 INCH--400 FEET

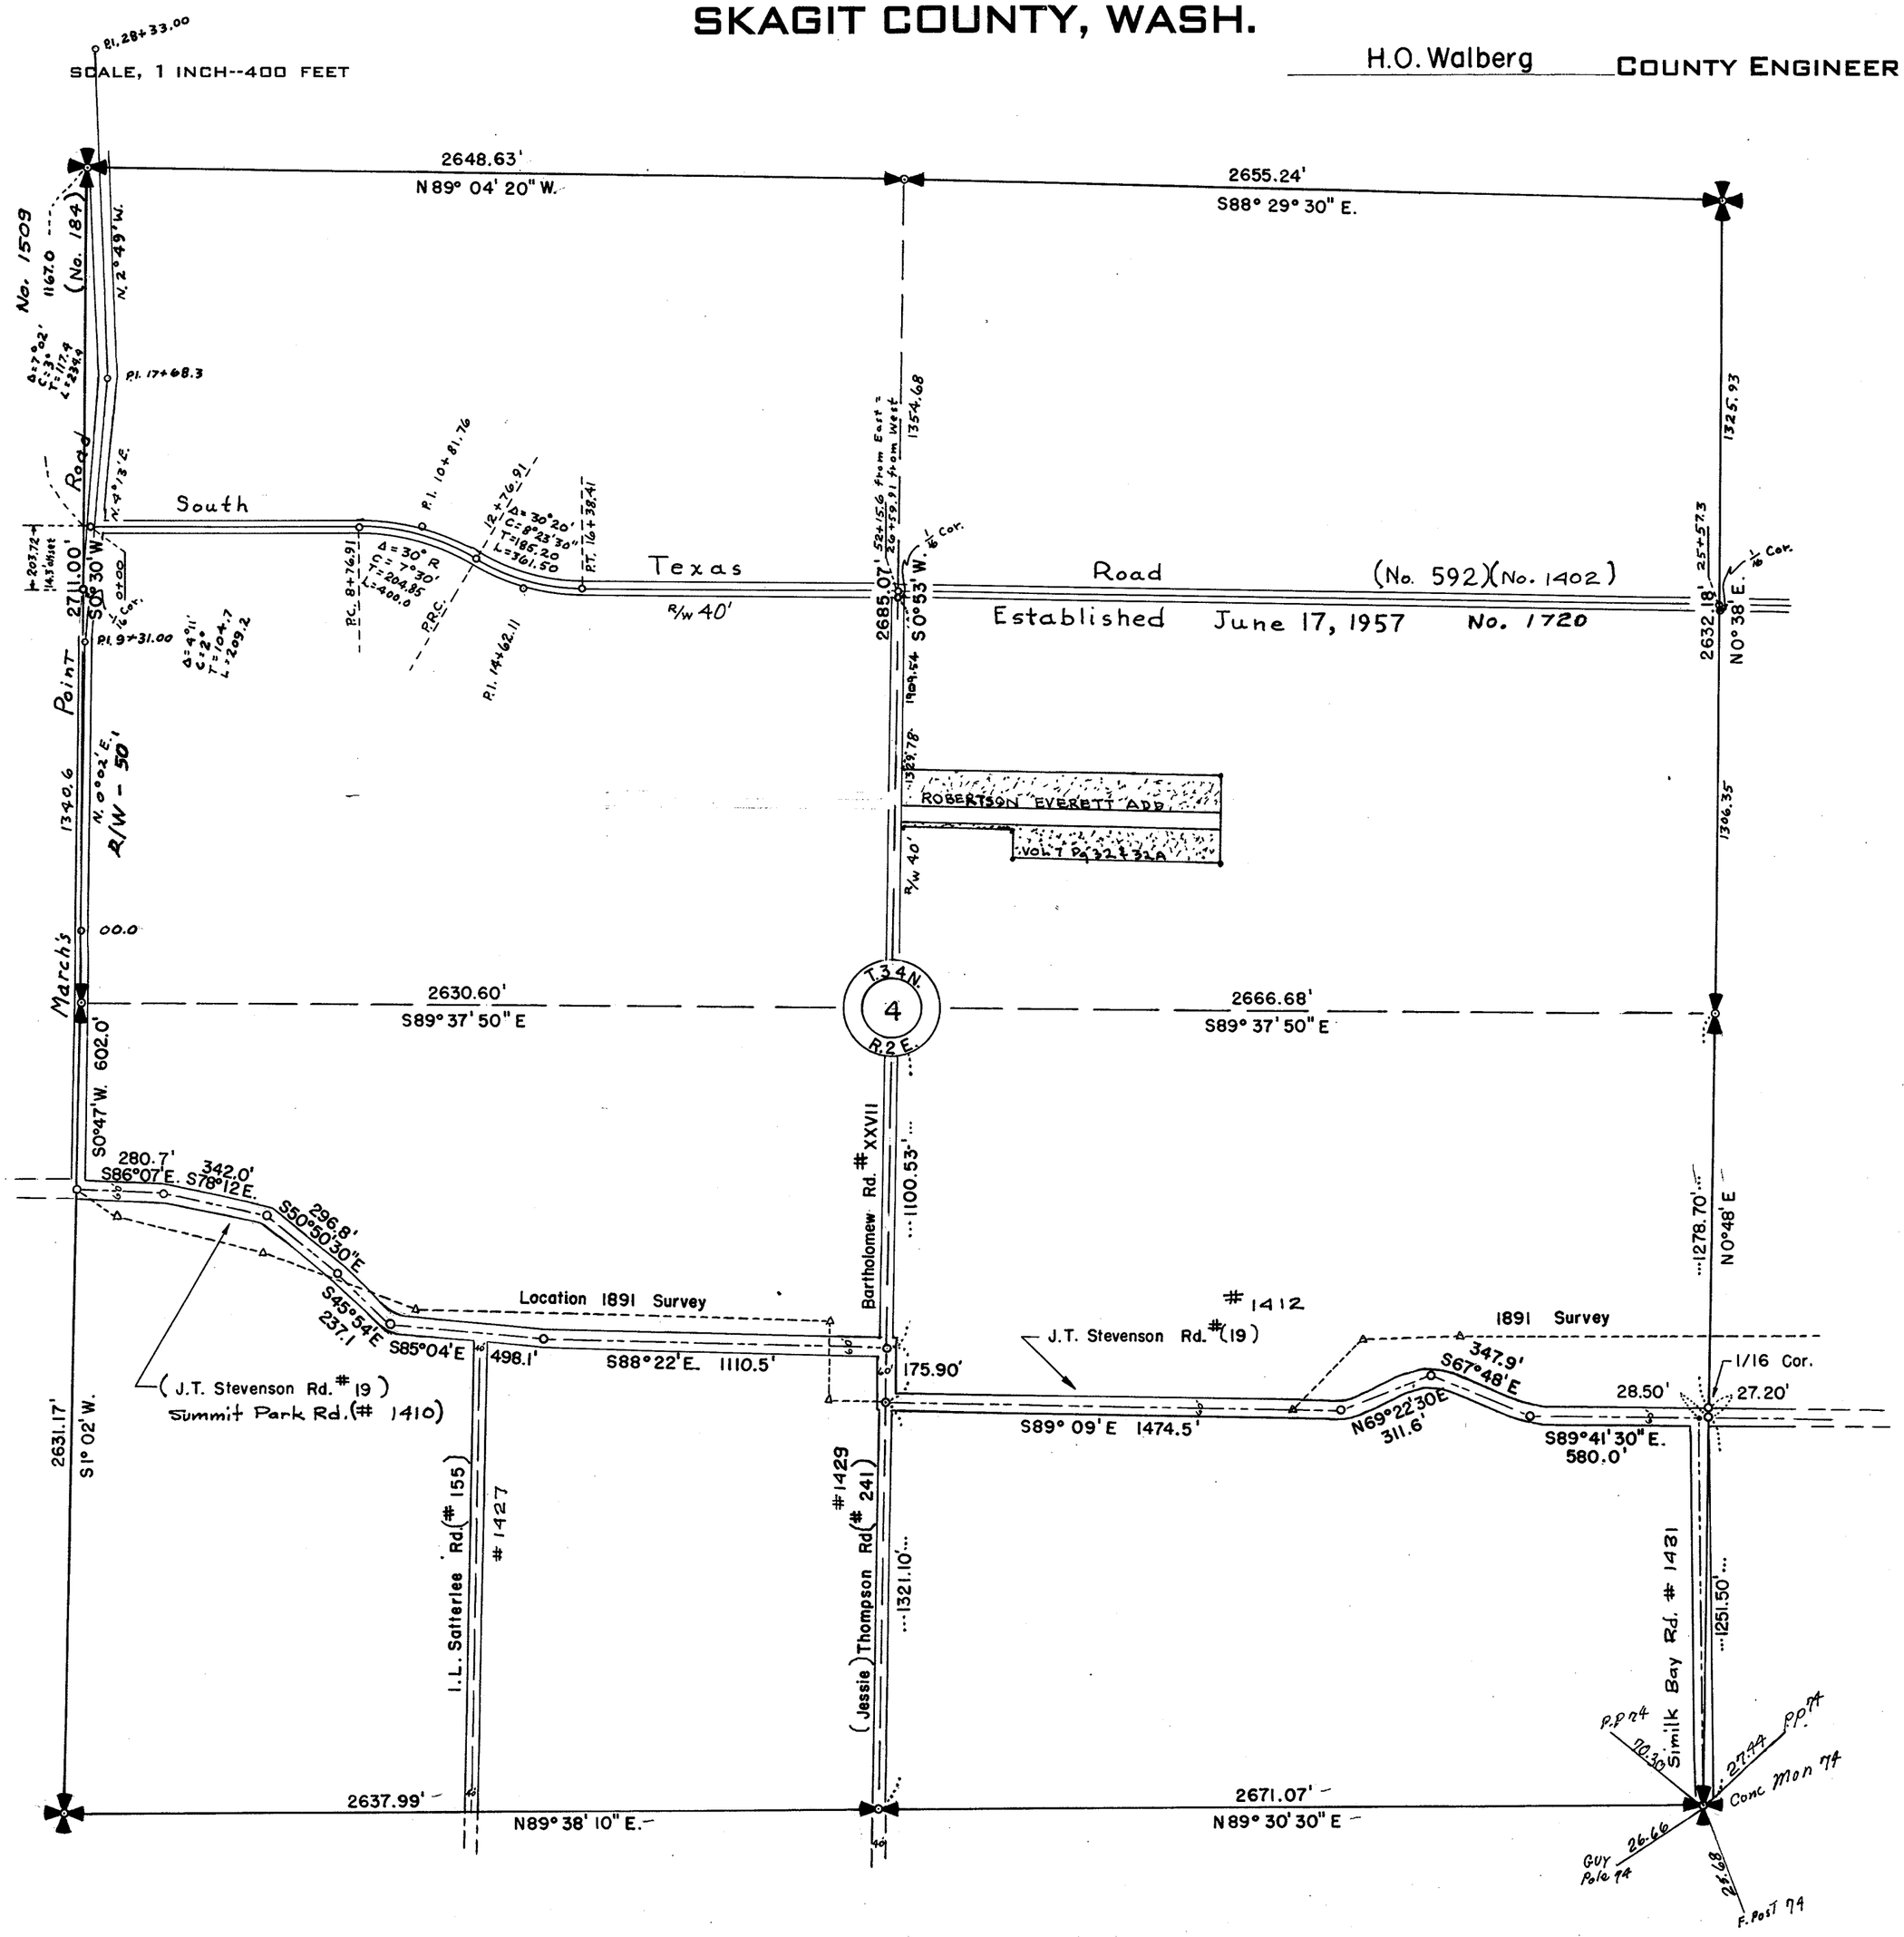

SECTION 5

TOWNSHIP 34 NORTH, RANGE 2 EAST, W. M.

SKAGIT COUNTY, WASH.

SCALE, 1 INCH -- 400 FEET

DATE 3 Sept 1968

Lloyd H Johnson COUNTY ENGINEER

4" Cedar 15' S10°W Faint Scribe

N 88° 02' W 1618.8

1471

Fidalgo Bay Road R/W-60'

S 88° 05' E

Rock on Beach with x 1½" Pipe

T. Pole (32) (42) 86.00

T. Pole (32) (42) 61.40

Note: 51 873 526 E115 H 208

N 0° 03' 30" E 2669.55

N 1° 16' 10" E 1327.01 1327.65

1353.54 1354.10

5276.94

137.54

N 1° 43' 40" E 2713.49 2711.00

1340.42 S 0° 30' W

T. Pole (48) 16.30

125.20 T. Pole (42)

91° 01' 20"

89° 16' 30"

477.24 474.61

S.S.H.-536

S 87° 42' 33" E 2635.11

N 88° 55' 22" W 2632.04 2631.59

T-34-N 5 R-2-E

Note: This Tracing Drawn From Aerial Photo -Not to Scale ----

Resol. # 9709

Old Brook Lane

~~G Miller Road~~ # 1600

R/W - 30'

N 0° 43' 13" E 2626.29

N 1° 54' E 2625.30

Fern Hill Cemetery No. 1570

R/W - 30'

S.S.H. 525 N 0° 15' 30" E 2669.69

R/W - 40

No. 1571 Road

M. Christianson

N 2° 15' 40" E 2654.92 2631.17

S 1° 02' W

91° 17' 24"

91° 19'

88° 14' 53"

88° 21'

90° 41' 40"

1" IRON Pipe

N 86° 47' W 2651.57 Miller Road No. 1420

S 87° 59' 23" E 2654.25

S 88° 26' E 2609.49

30" Cedar

26.80

22.60 18" Fir

¾" Square Rod

14.80 10" Fir

31.00

53.50

P. Pole (28)

4" Fir Stp.


SECTION 5

TOWNSHIP 34 NORTH, RANGE 2 EAST, W. M.

SKAGIT COUNTY, WASH.

SCALE, 1 INCH--400 FEET

DATE June 27, 1966 — Lloyd Johnson COUNTY ENGINEER

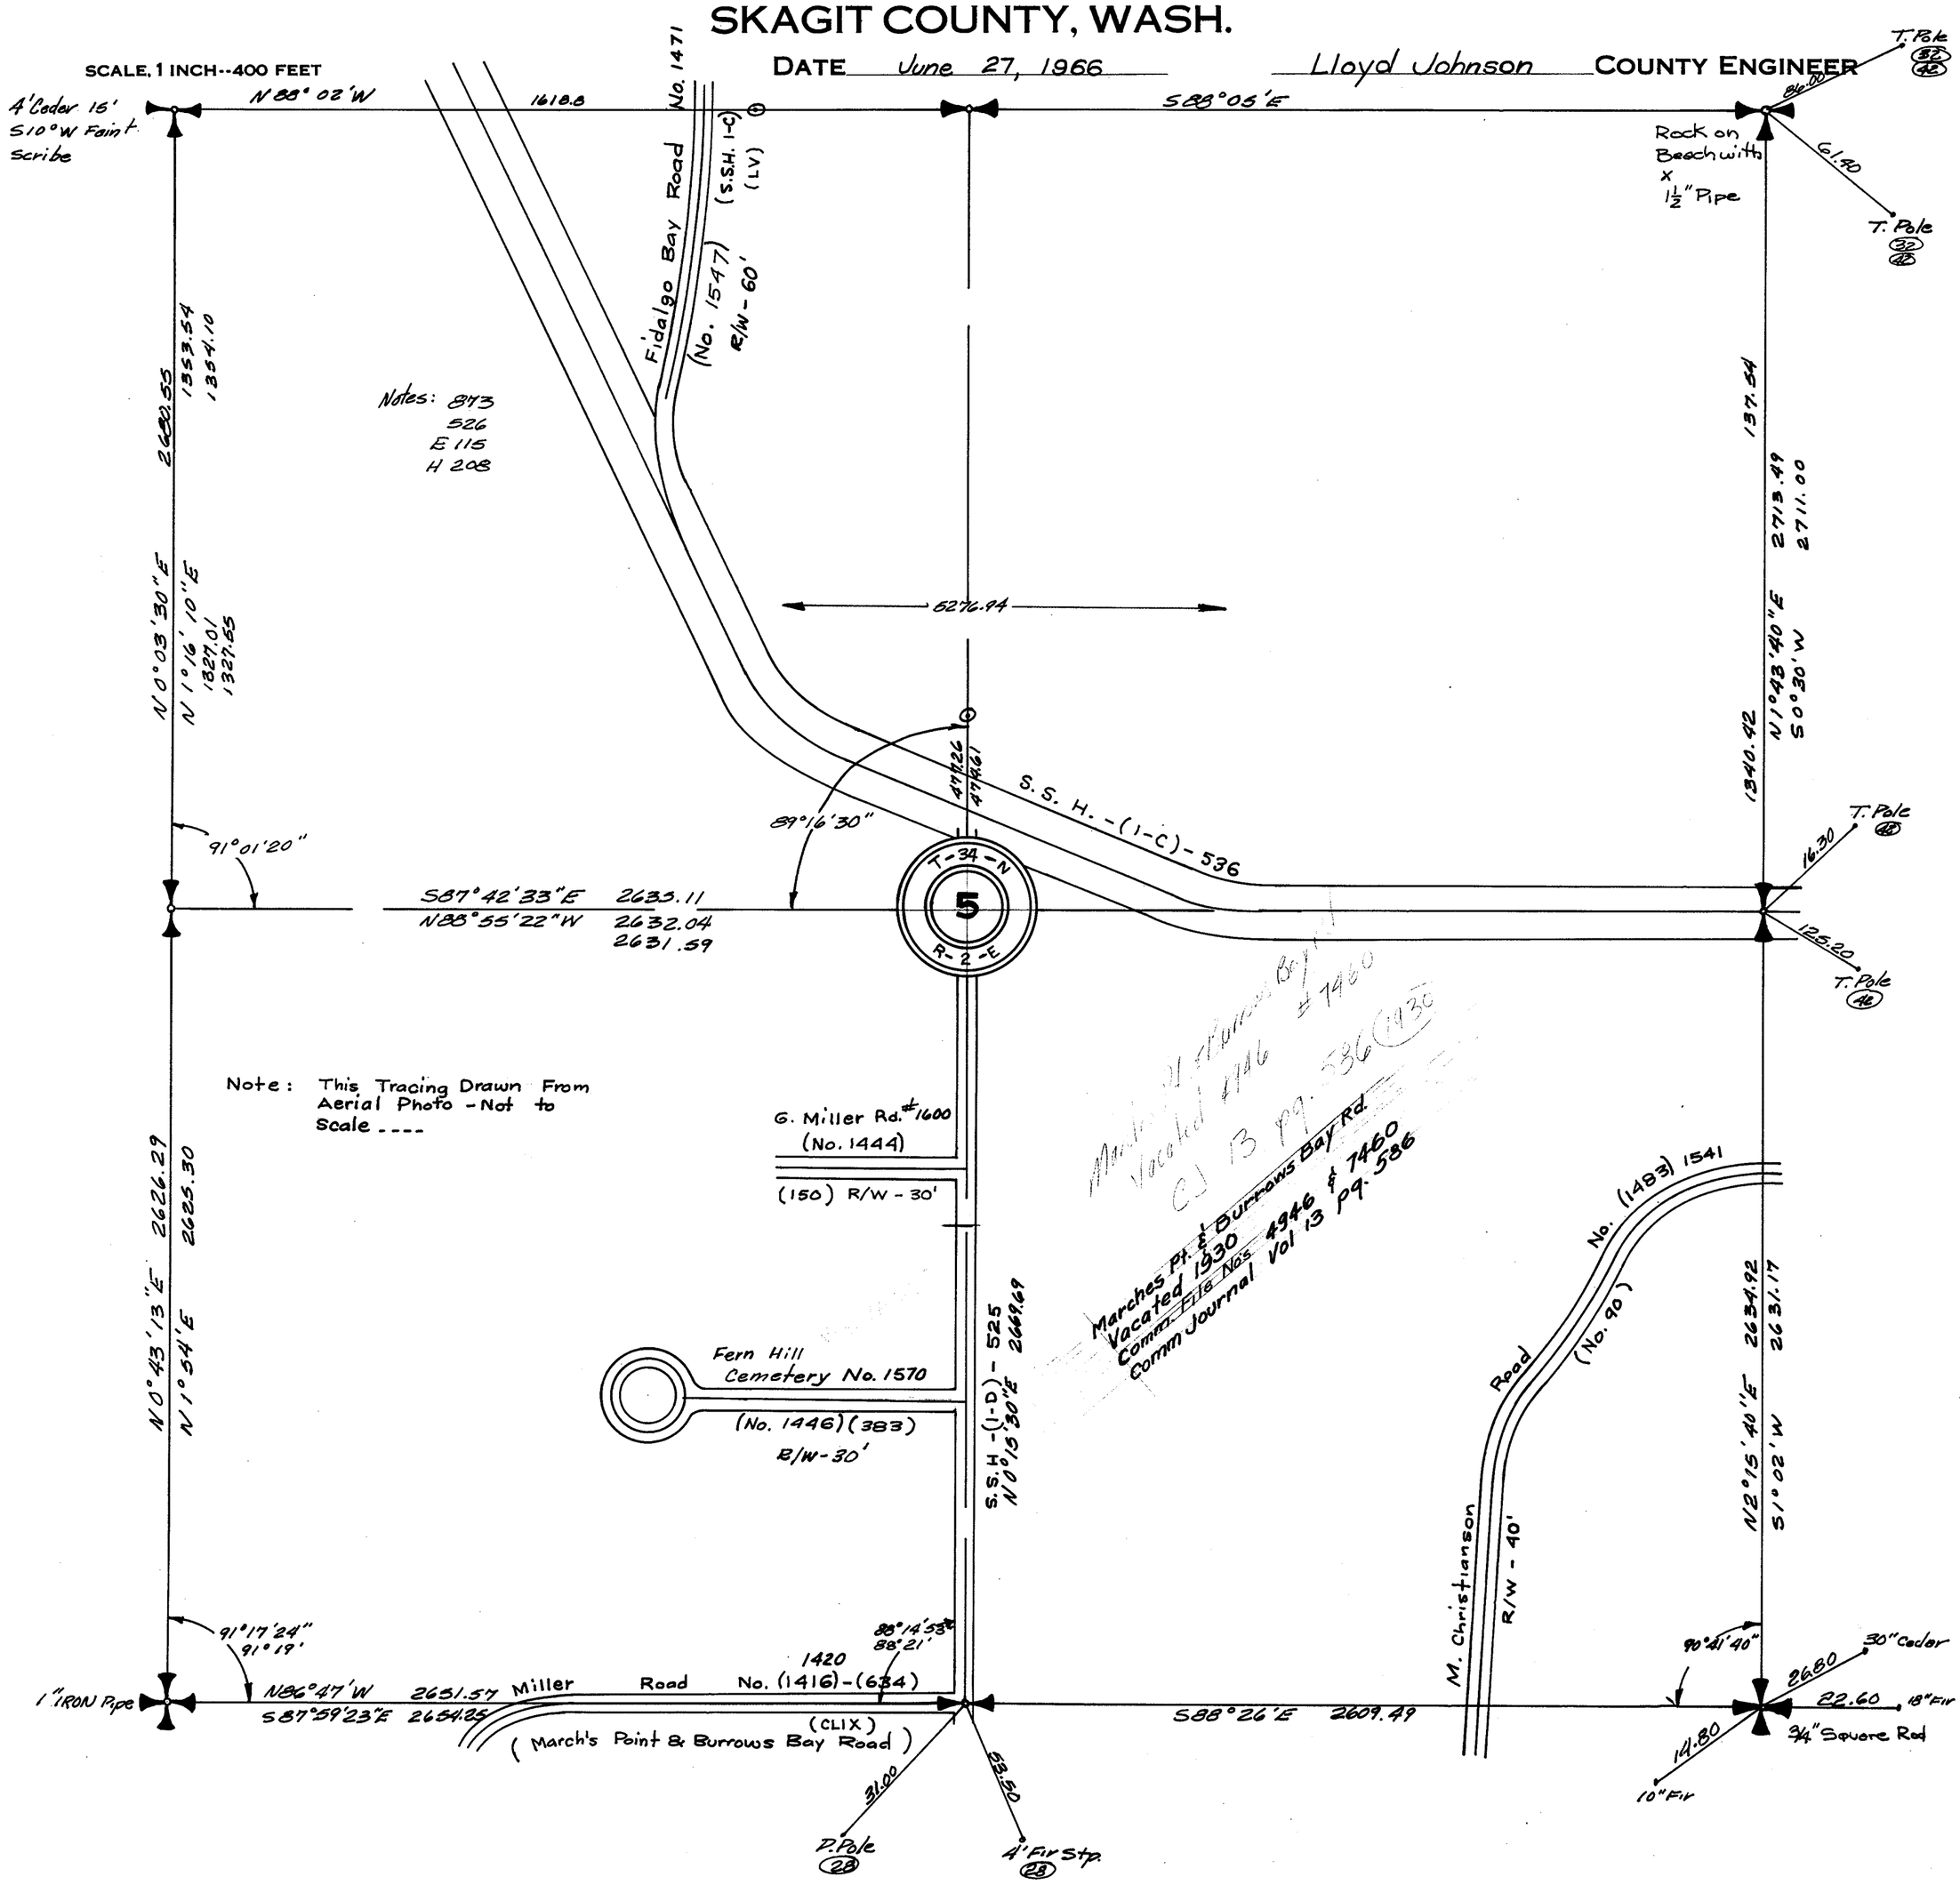


SECTION 7

TOWNSHIP 34 NORTH, RANGE 2 EAST, W. M.

SKAGIT COUNTY, WASH.

SCALE, 1 INCH--400 FEET

G. D. Le Gro
July 1958
COUNTY ENGINEER

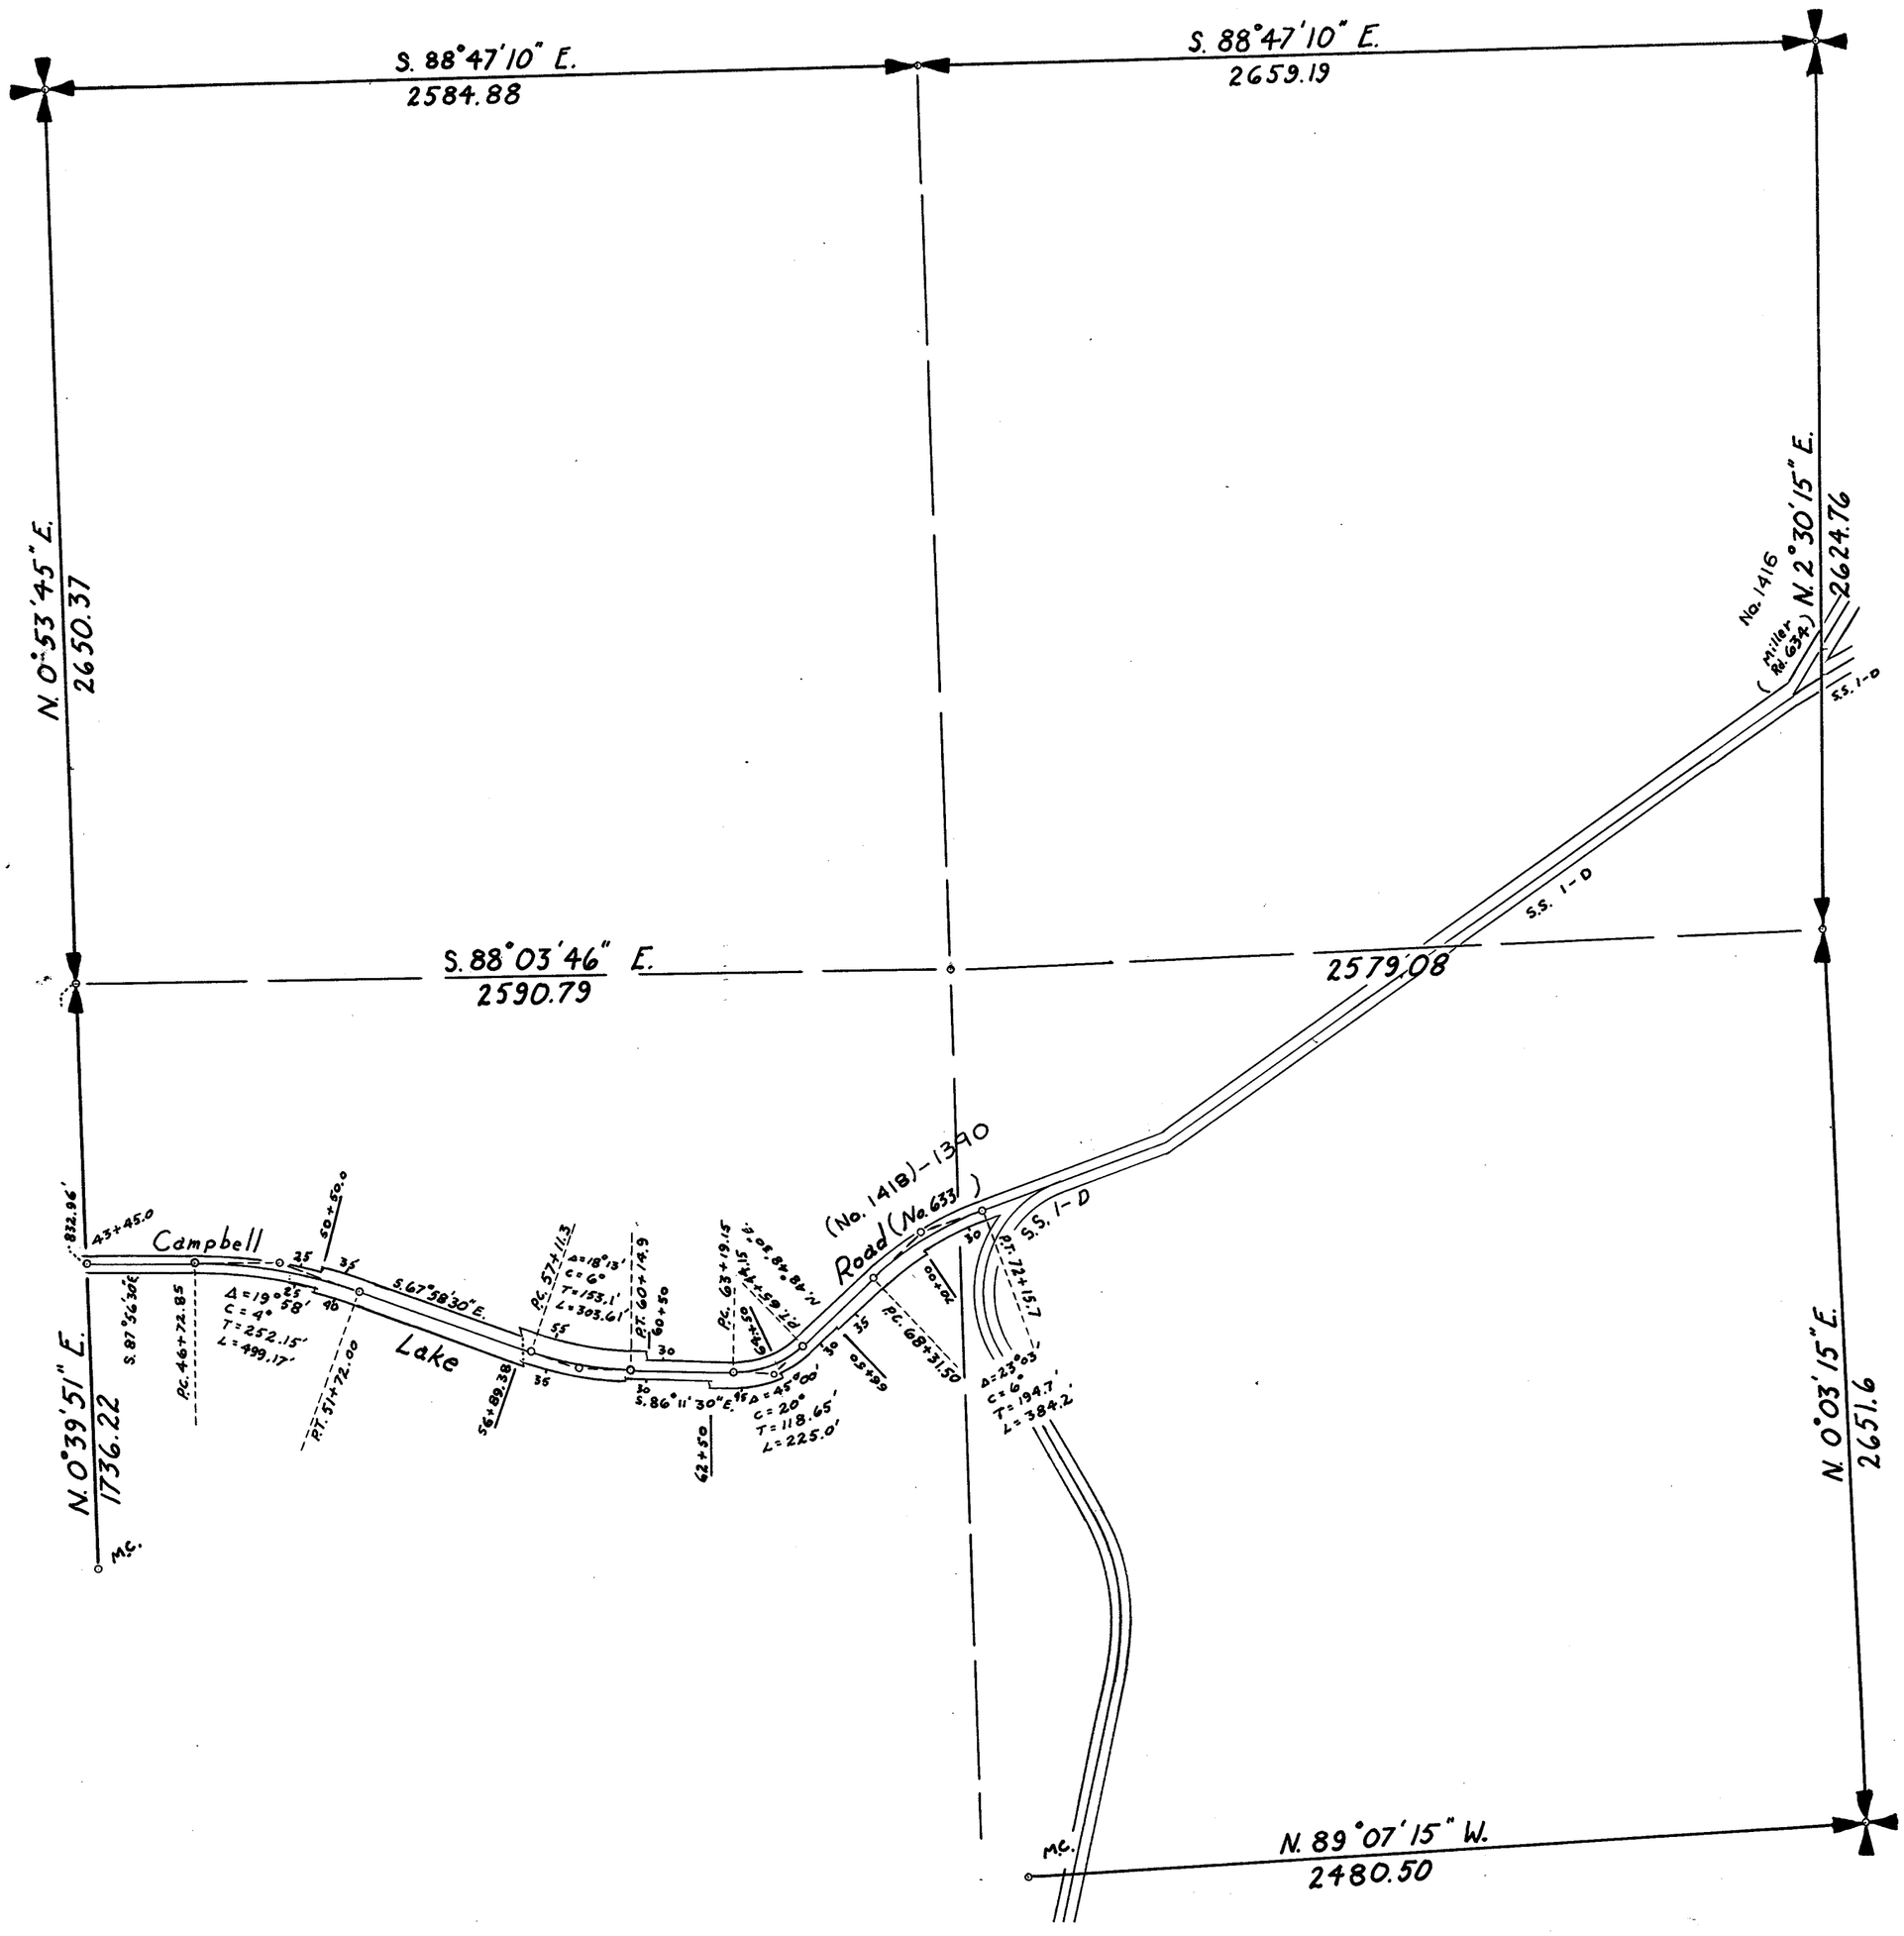

SECTION 8


TOWNSHIP 34 NORTH, RANGE 2 EAST, W. M.

SKAGIT COUNTY, WASH.

SCALE, 1 INCH -- 400 FEET

DATE 3 Sept 1968

Lloyd H Johnson COUNTY ENGINEER

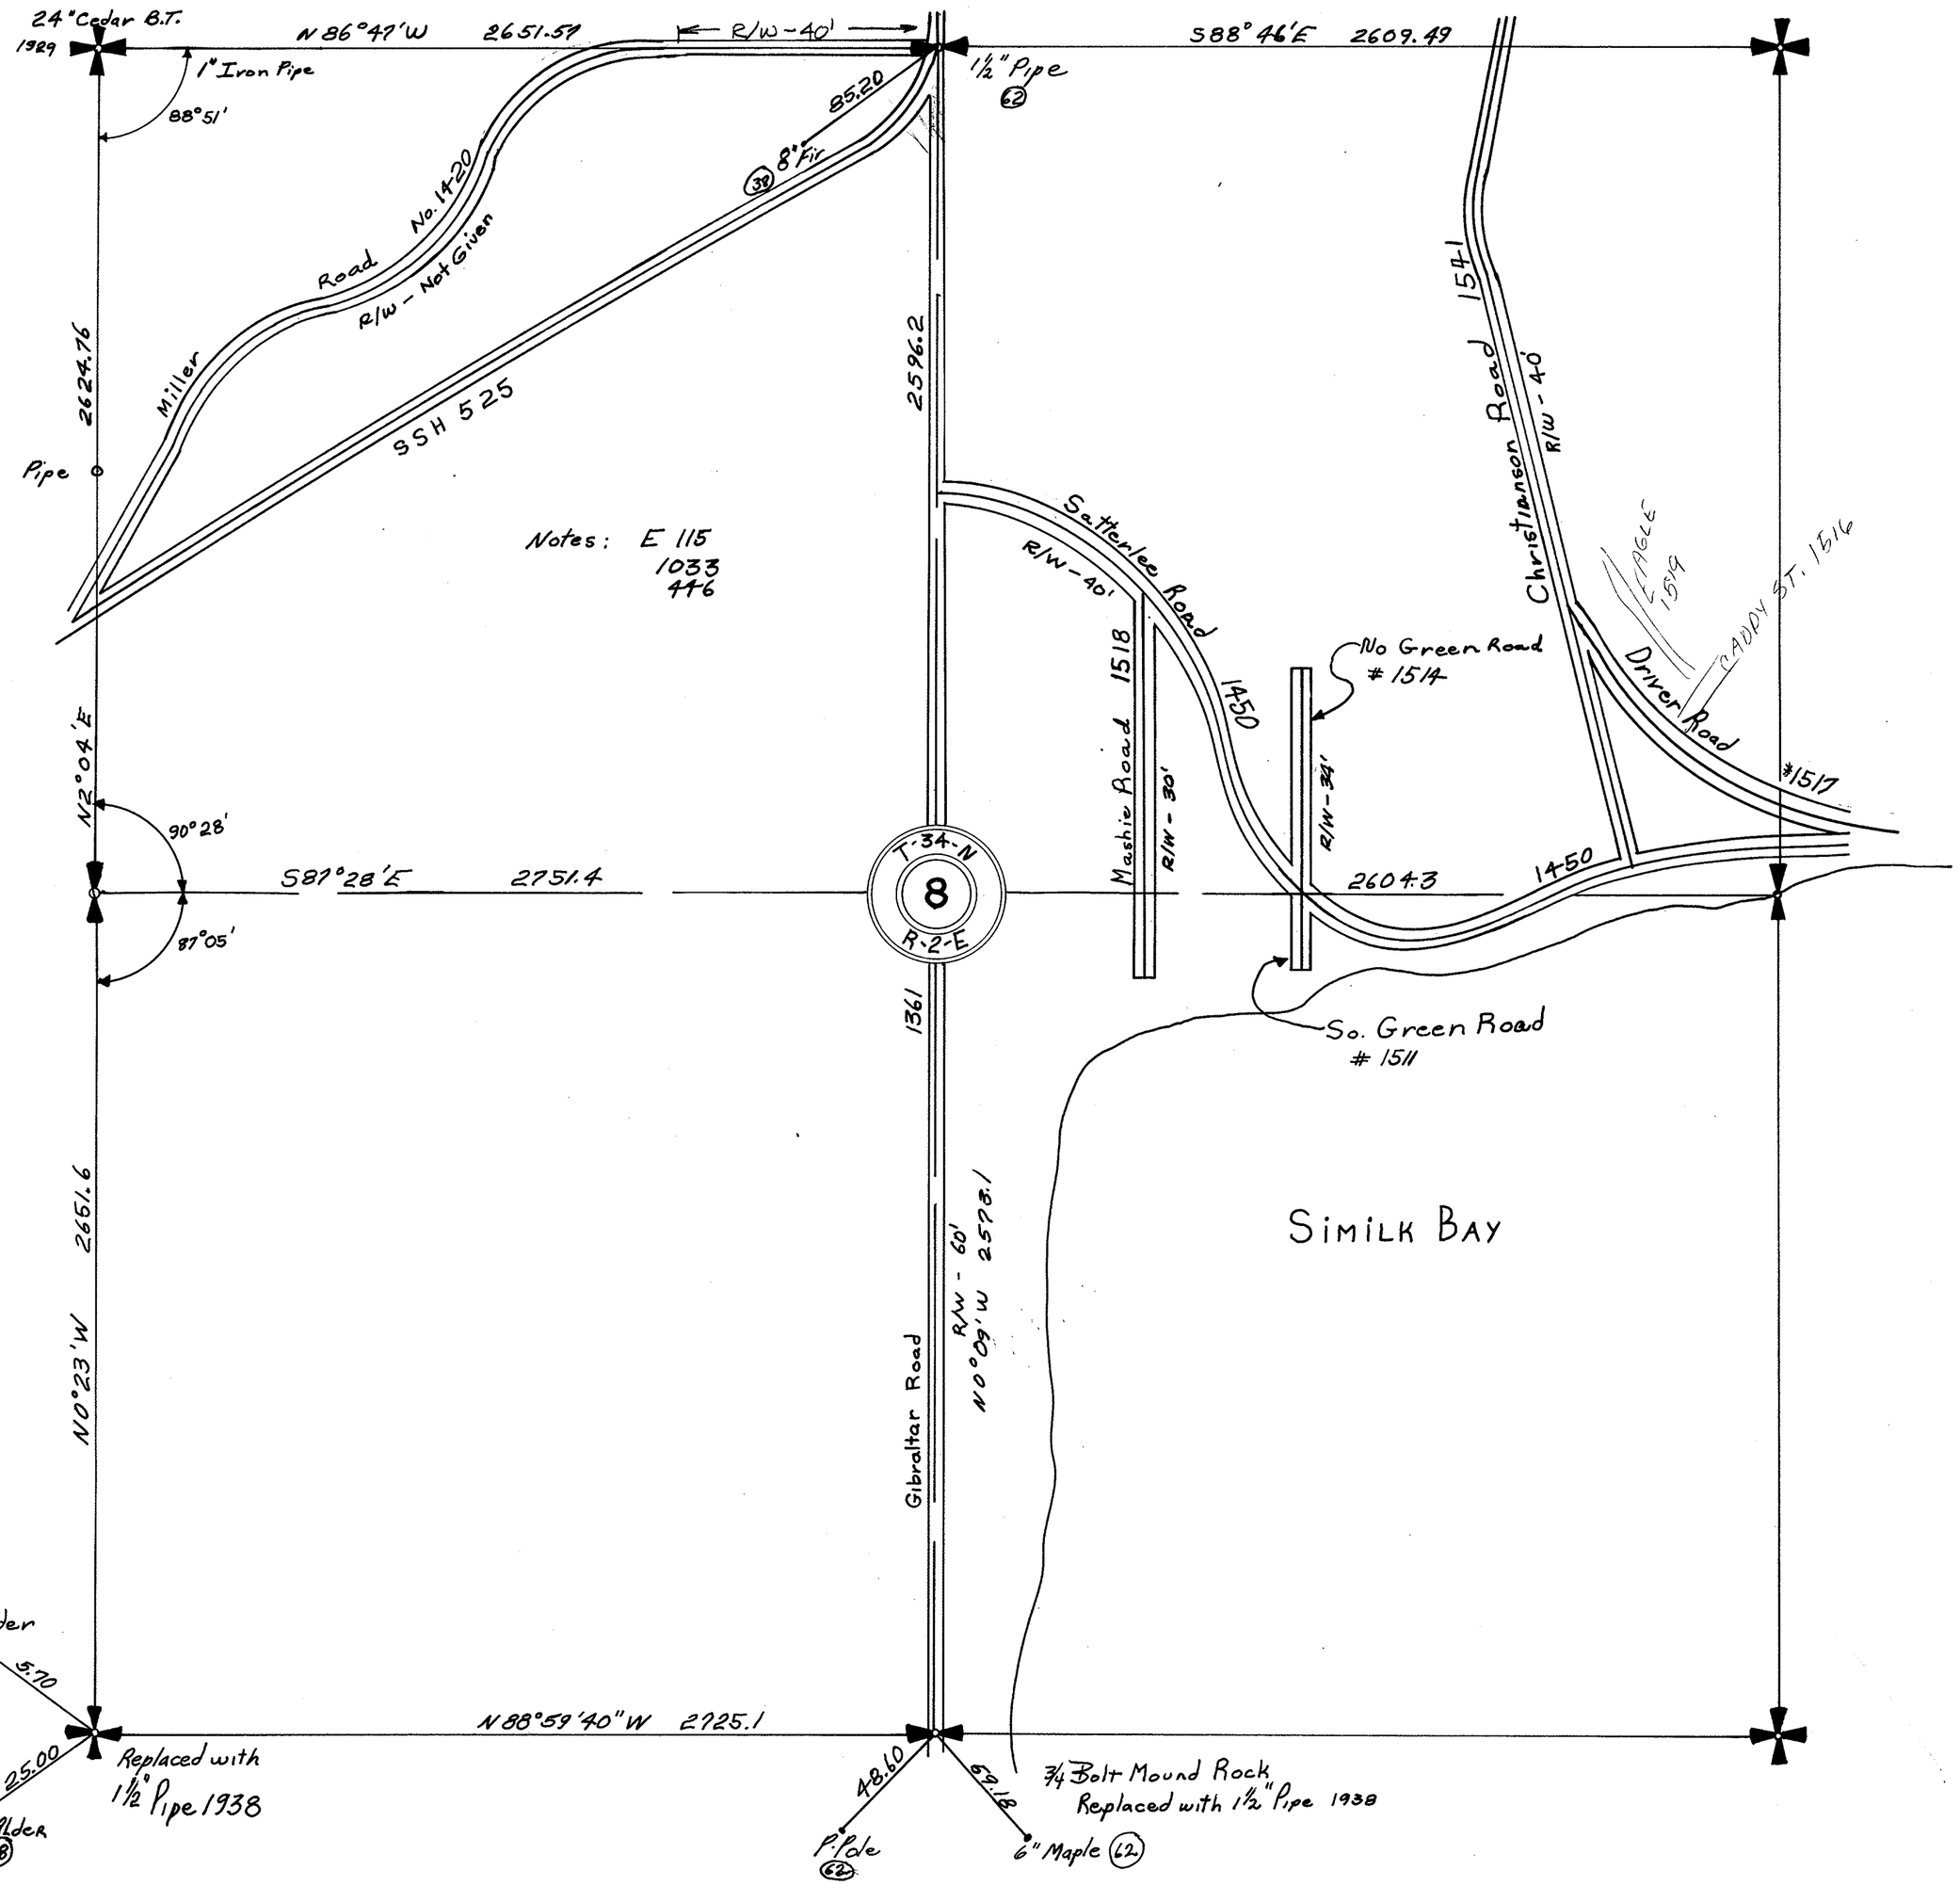

SECTION 8


TOWNSHIP 34 NORTH, RANGE 2 EAST, W. M.

SKAGIT COUNTY, WASH.

SCALE, 1 INCH--400 FEET

DATE June 24, 1966

Lloyd Johnson COUNTY ENGINEER

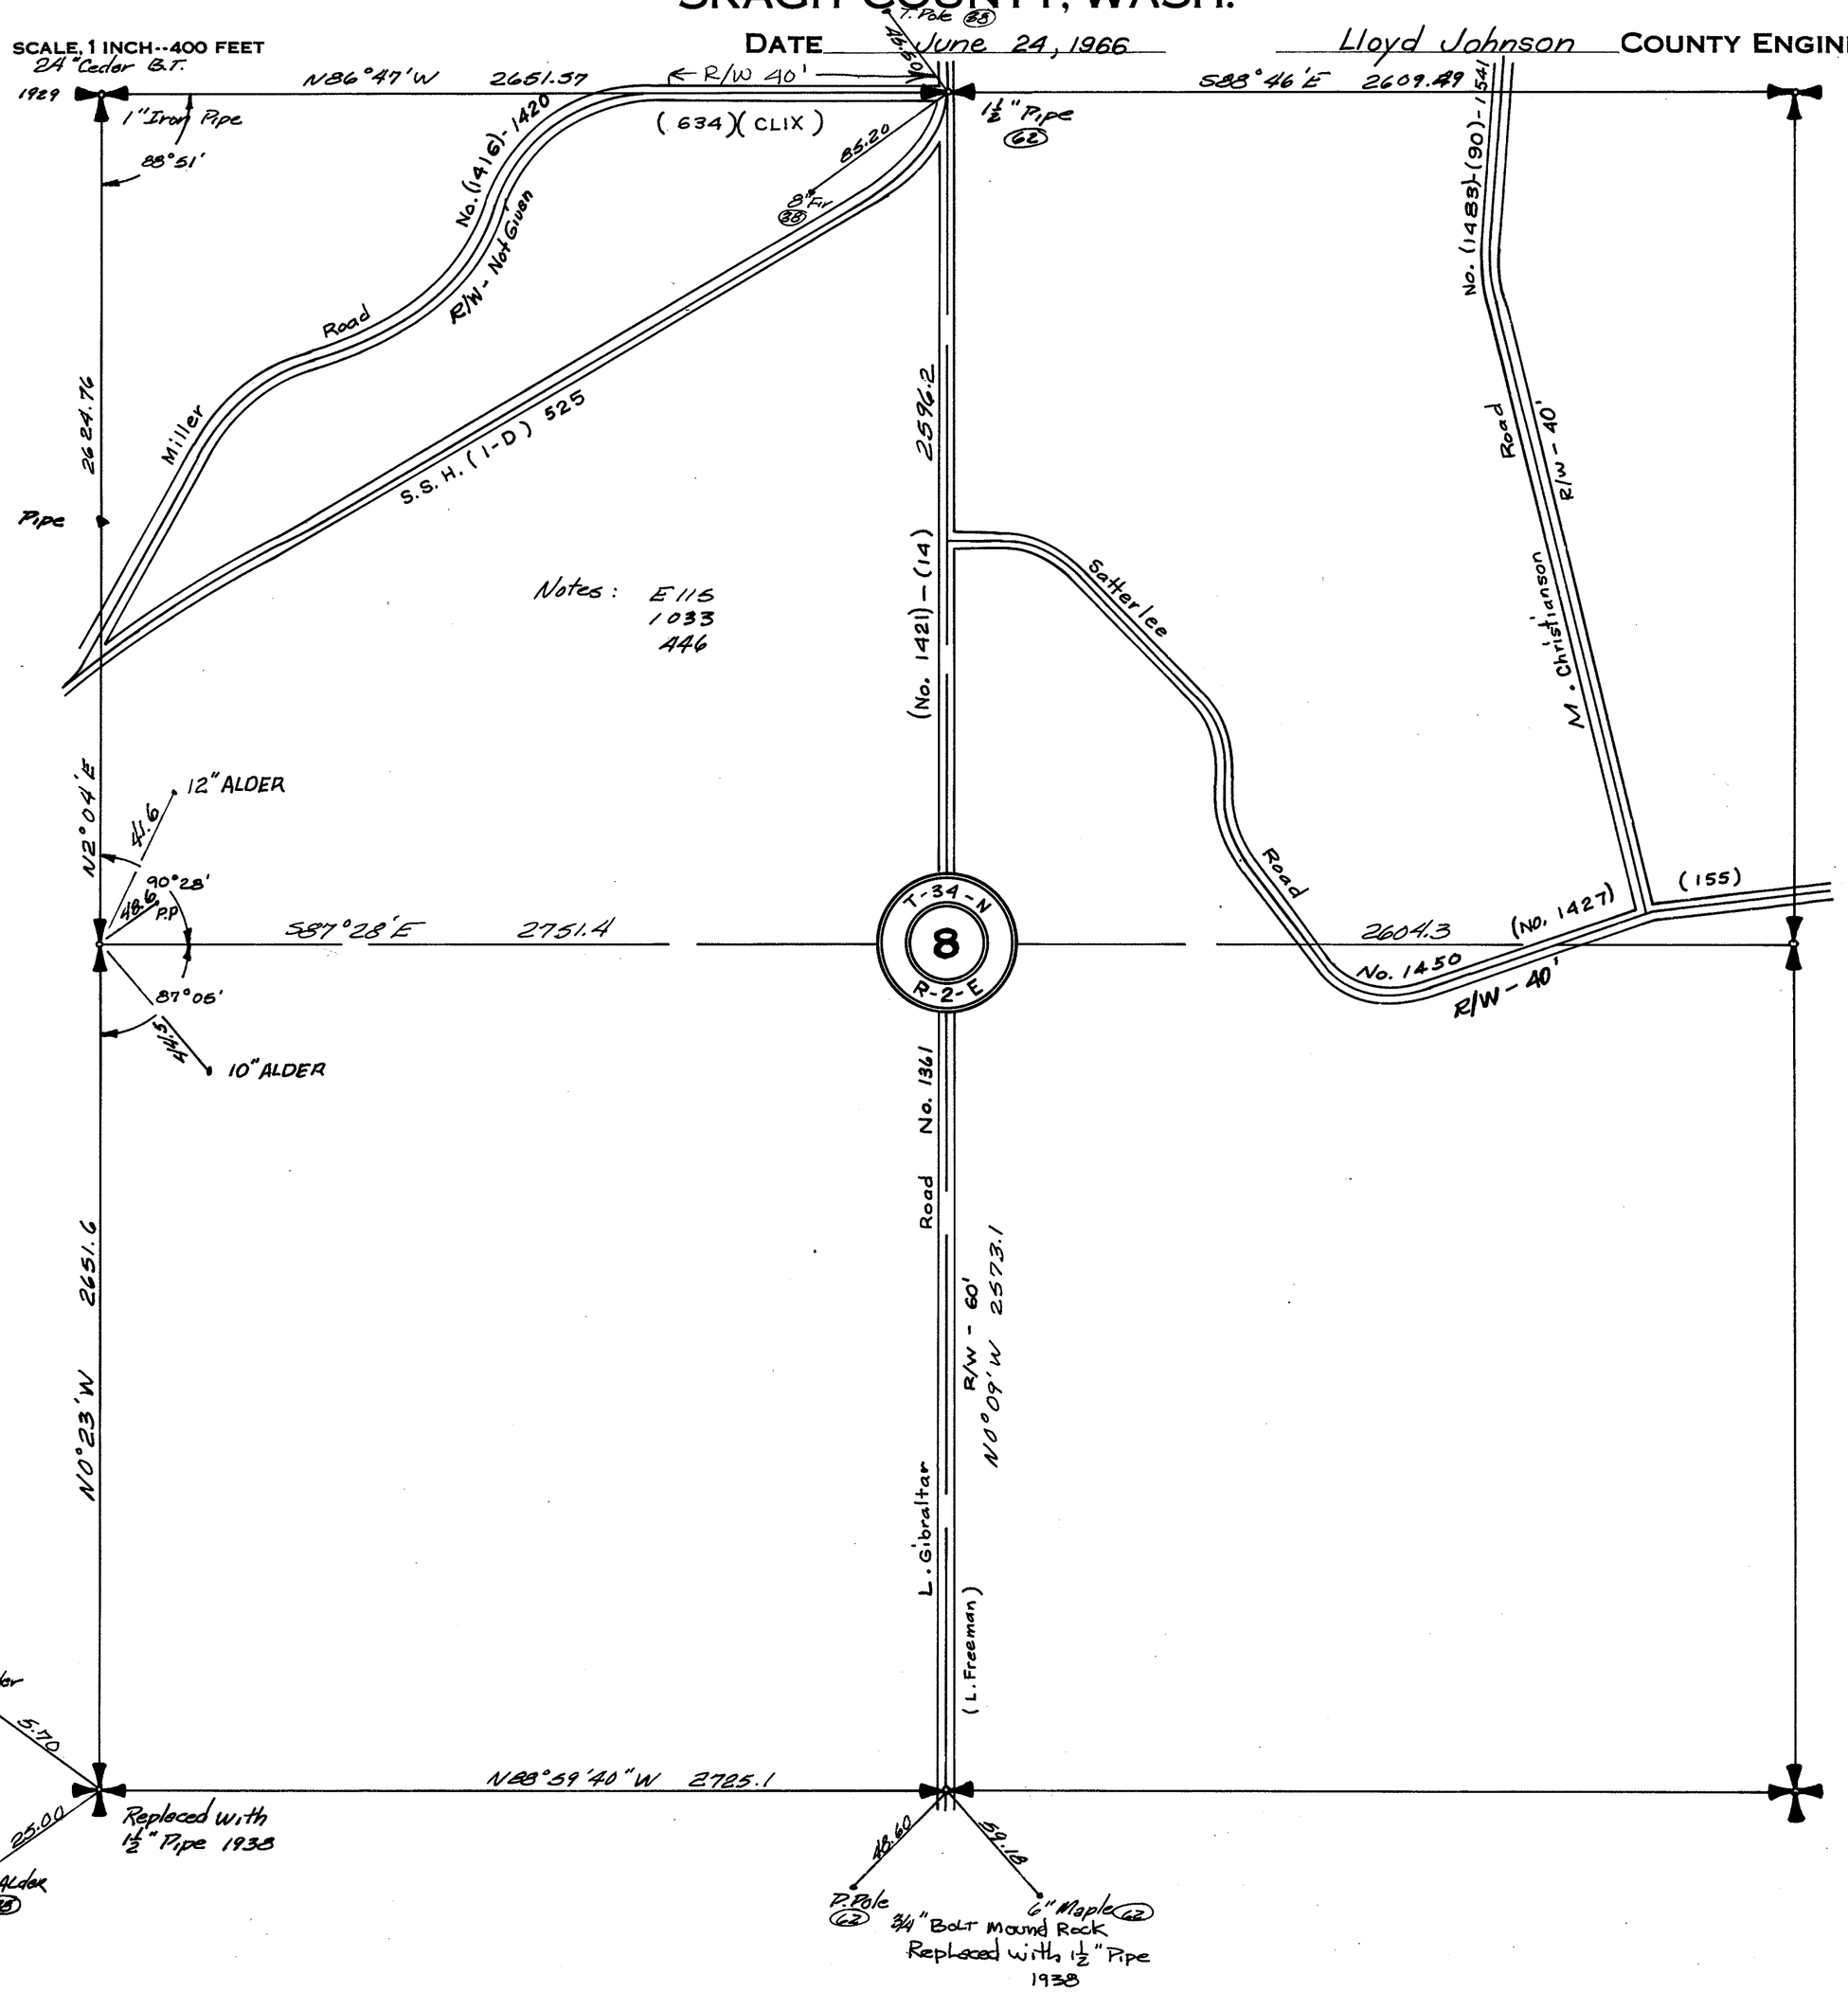


SECTION 8

TOWNSHIP 34 NORTH. RANGE 2 EAST. W. M.
SKAGIT COUNTY. WASH.

SCALE. 1 INCH–400 FEET

Arthur L Strong COUNTY ENGINEER

Robt E.L.Knapp all but E. line-1928-

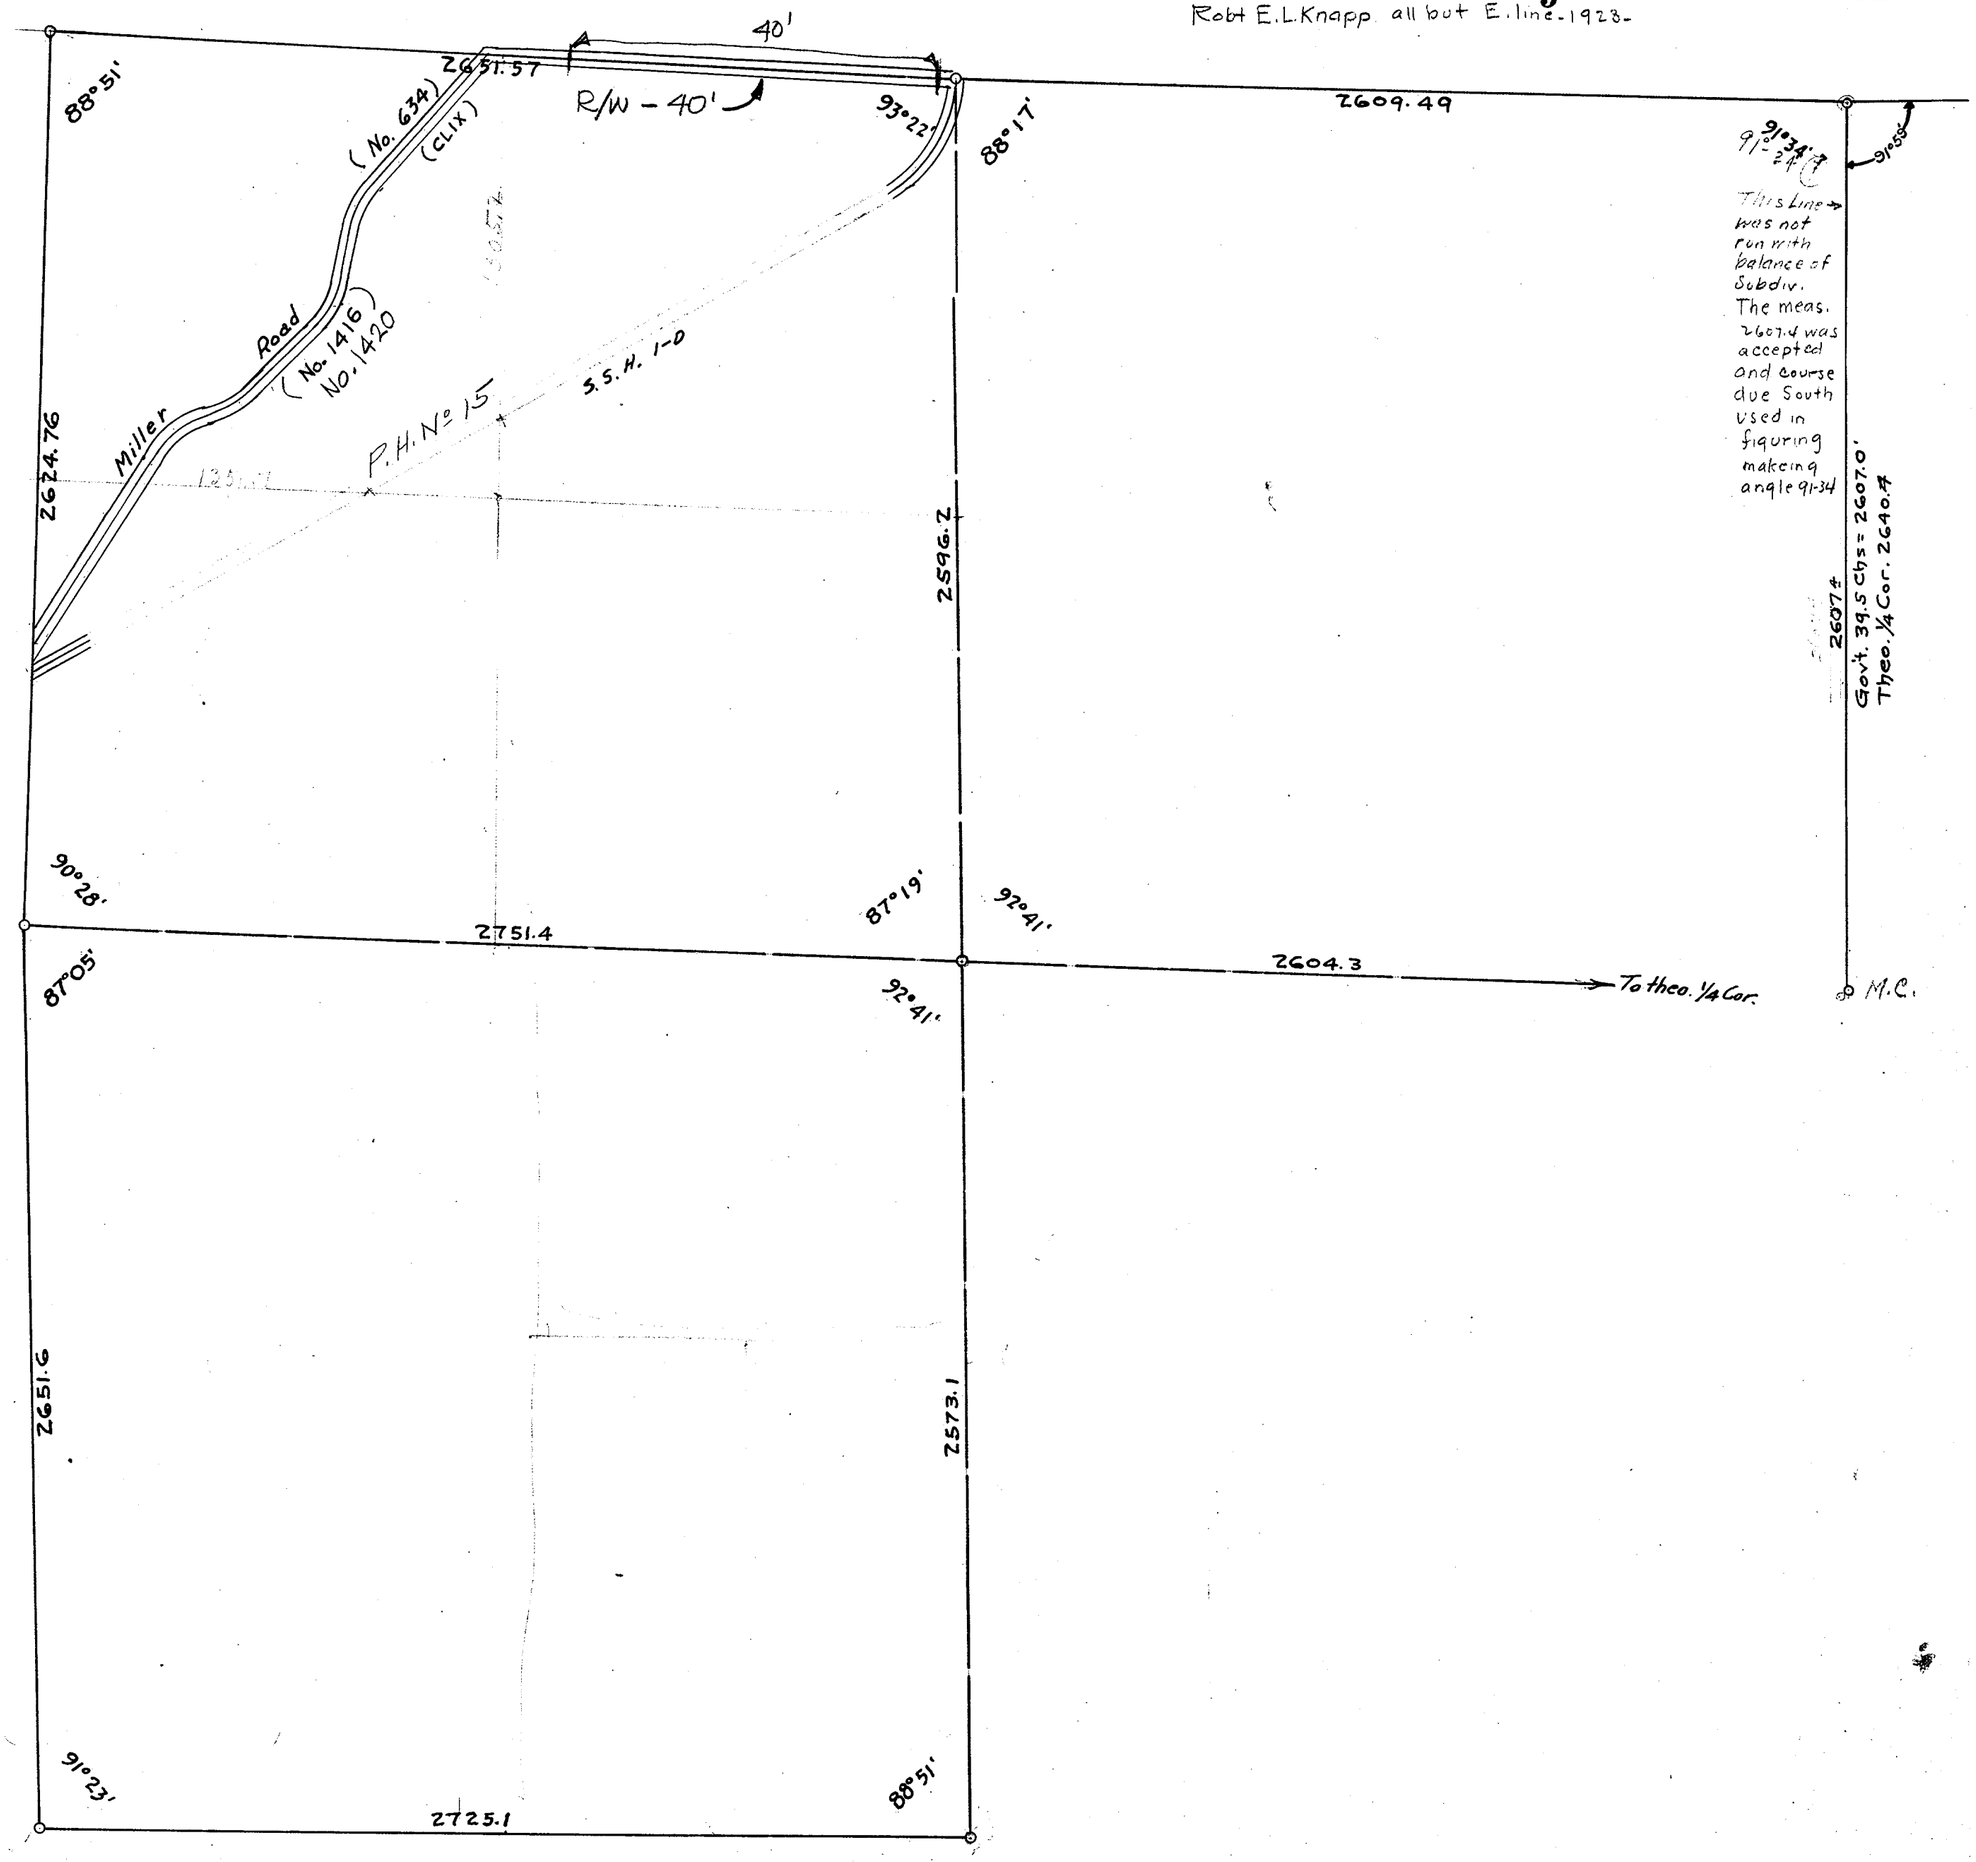

Notes 832

S. part of NW¼ SECTION 9

TOWNSHIP 34 NORTH, RANGE 2 EAST, W. M.
SKAGIT COUNTY, WASH.

SCALE, 1 INCH--400 FEET

COUNTY ENGINEER

{N 10000
{E 10000

N 88° 31' E

2634.00

{N 10063.44
{E 12633.23

Govt. Lot 6

See Case No. 21207
Superior Court Record

Δ 58° 38'
D 16° R 358'
T 201.3
L 366.46

Ctr. Curve {N 7885.65
{E 10970.88

Δ 30° 52'
D 8° R 716.2
T 197.8
L 385.9

N 1° 23' W

S 1° 07' E

2635.13

℄ Jessie Thompson Rd.
No. 241 = 40' wide

2640.5

N 1° 39' W

2607.50 M.C. to Sec. Cor

N 34° 41' E

N 34° 28' 45" W

341.66

NE Cor. L. 17 B6
{N 7518.59
{E 10071.48

3+80.6

S 86° 35' E 581.9

236.02

23.85

6+22.96 POST
=20+10.6
{N 7578.91
{E 10794.04

76.36

S 62° 19' 30" E
563.7
Finely Road

NW Cor. L. 16 B6
{N 7525.94
{E 10171.21

4 PT 5+81.9
{N 7516.19
{E 10750.48

M.C.
33.02

N 88° 29' 20" E

W¼ Cor {N 7359.99
{E 10076.03

Gov. Lt. 5

1" Pipe
{N 1394.40
{E 11380.38
¼ 16

260.42

1" Pipe
{N 1411.37
{E 12033.21

Centre Sec.
{N 7428.81
{E 12684.54
From W¼ Cor.
thru ¼ 16

Gov. Lt. 4

1411.3

1+46.9

270.2

468.0

N 86° 48' E

134.1

6+96.7 {N 7118.30
{E 12039.77

N S ℄
N 7154.61
E 12689.79

651.03

139 125 66 93 93 124

1152

Hub 5.96 E. of N S ℄


P.I. 9+88.6 {N 7099.93
{E 11707.79

SECTION 9

TOWNSHIP 34 NORTH, RANGE 2 EAST, W. M.
SKAGIT COUNTY, WASH.

SCALE, 1 INCH–400 FEET

Arthur L Strong COUNTY ENGINEER

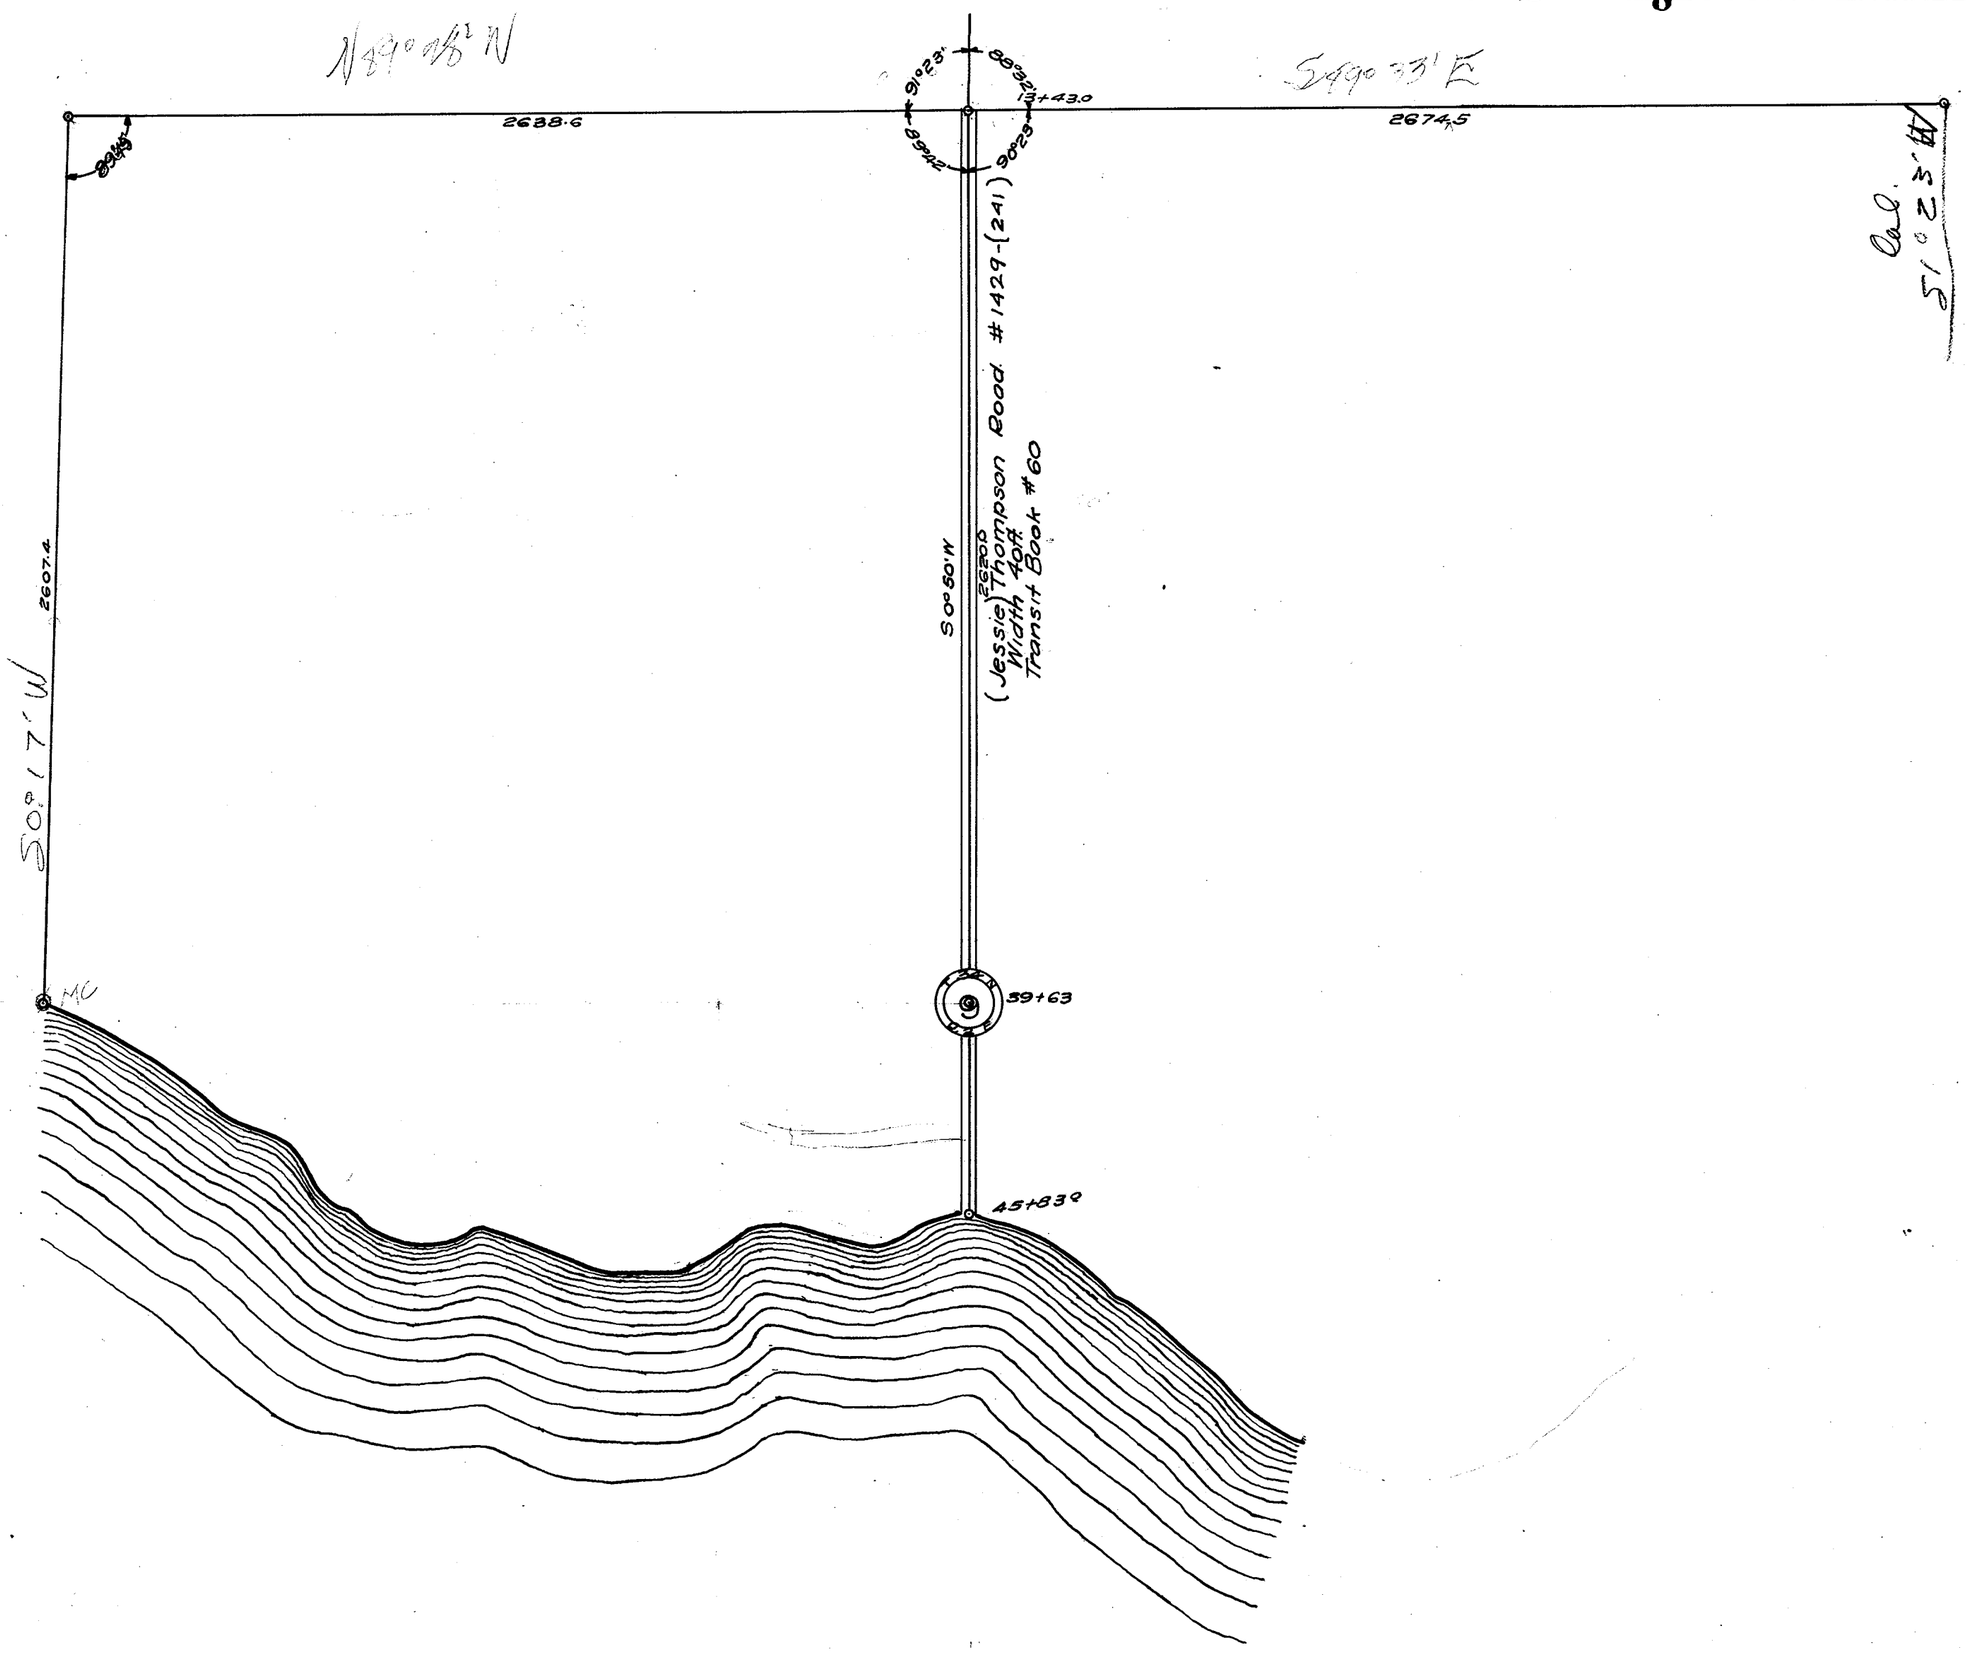

SECTION 9


TOWNSHIP 34 NORTH, RANGE 2 EAST, W. M.

SKAGIT COUNTY, WASH.

SCALE, 1 INCH--400 FEET

DATE June 24, 1966

Lloyd Johnson COUNTY ENGINEER

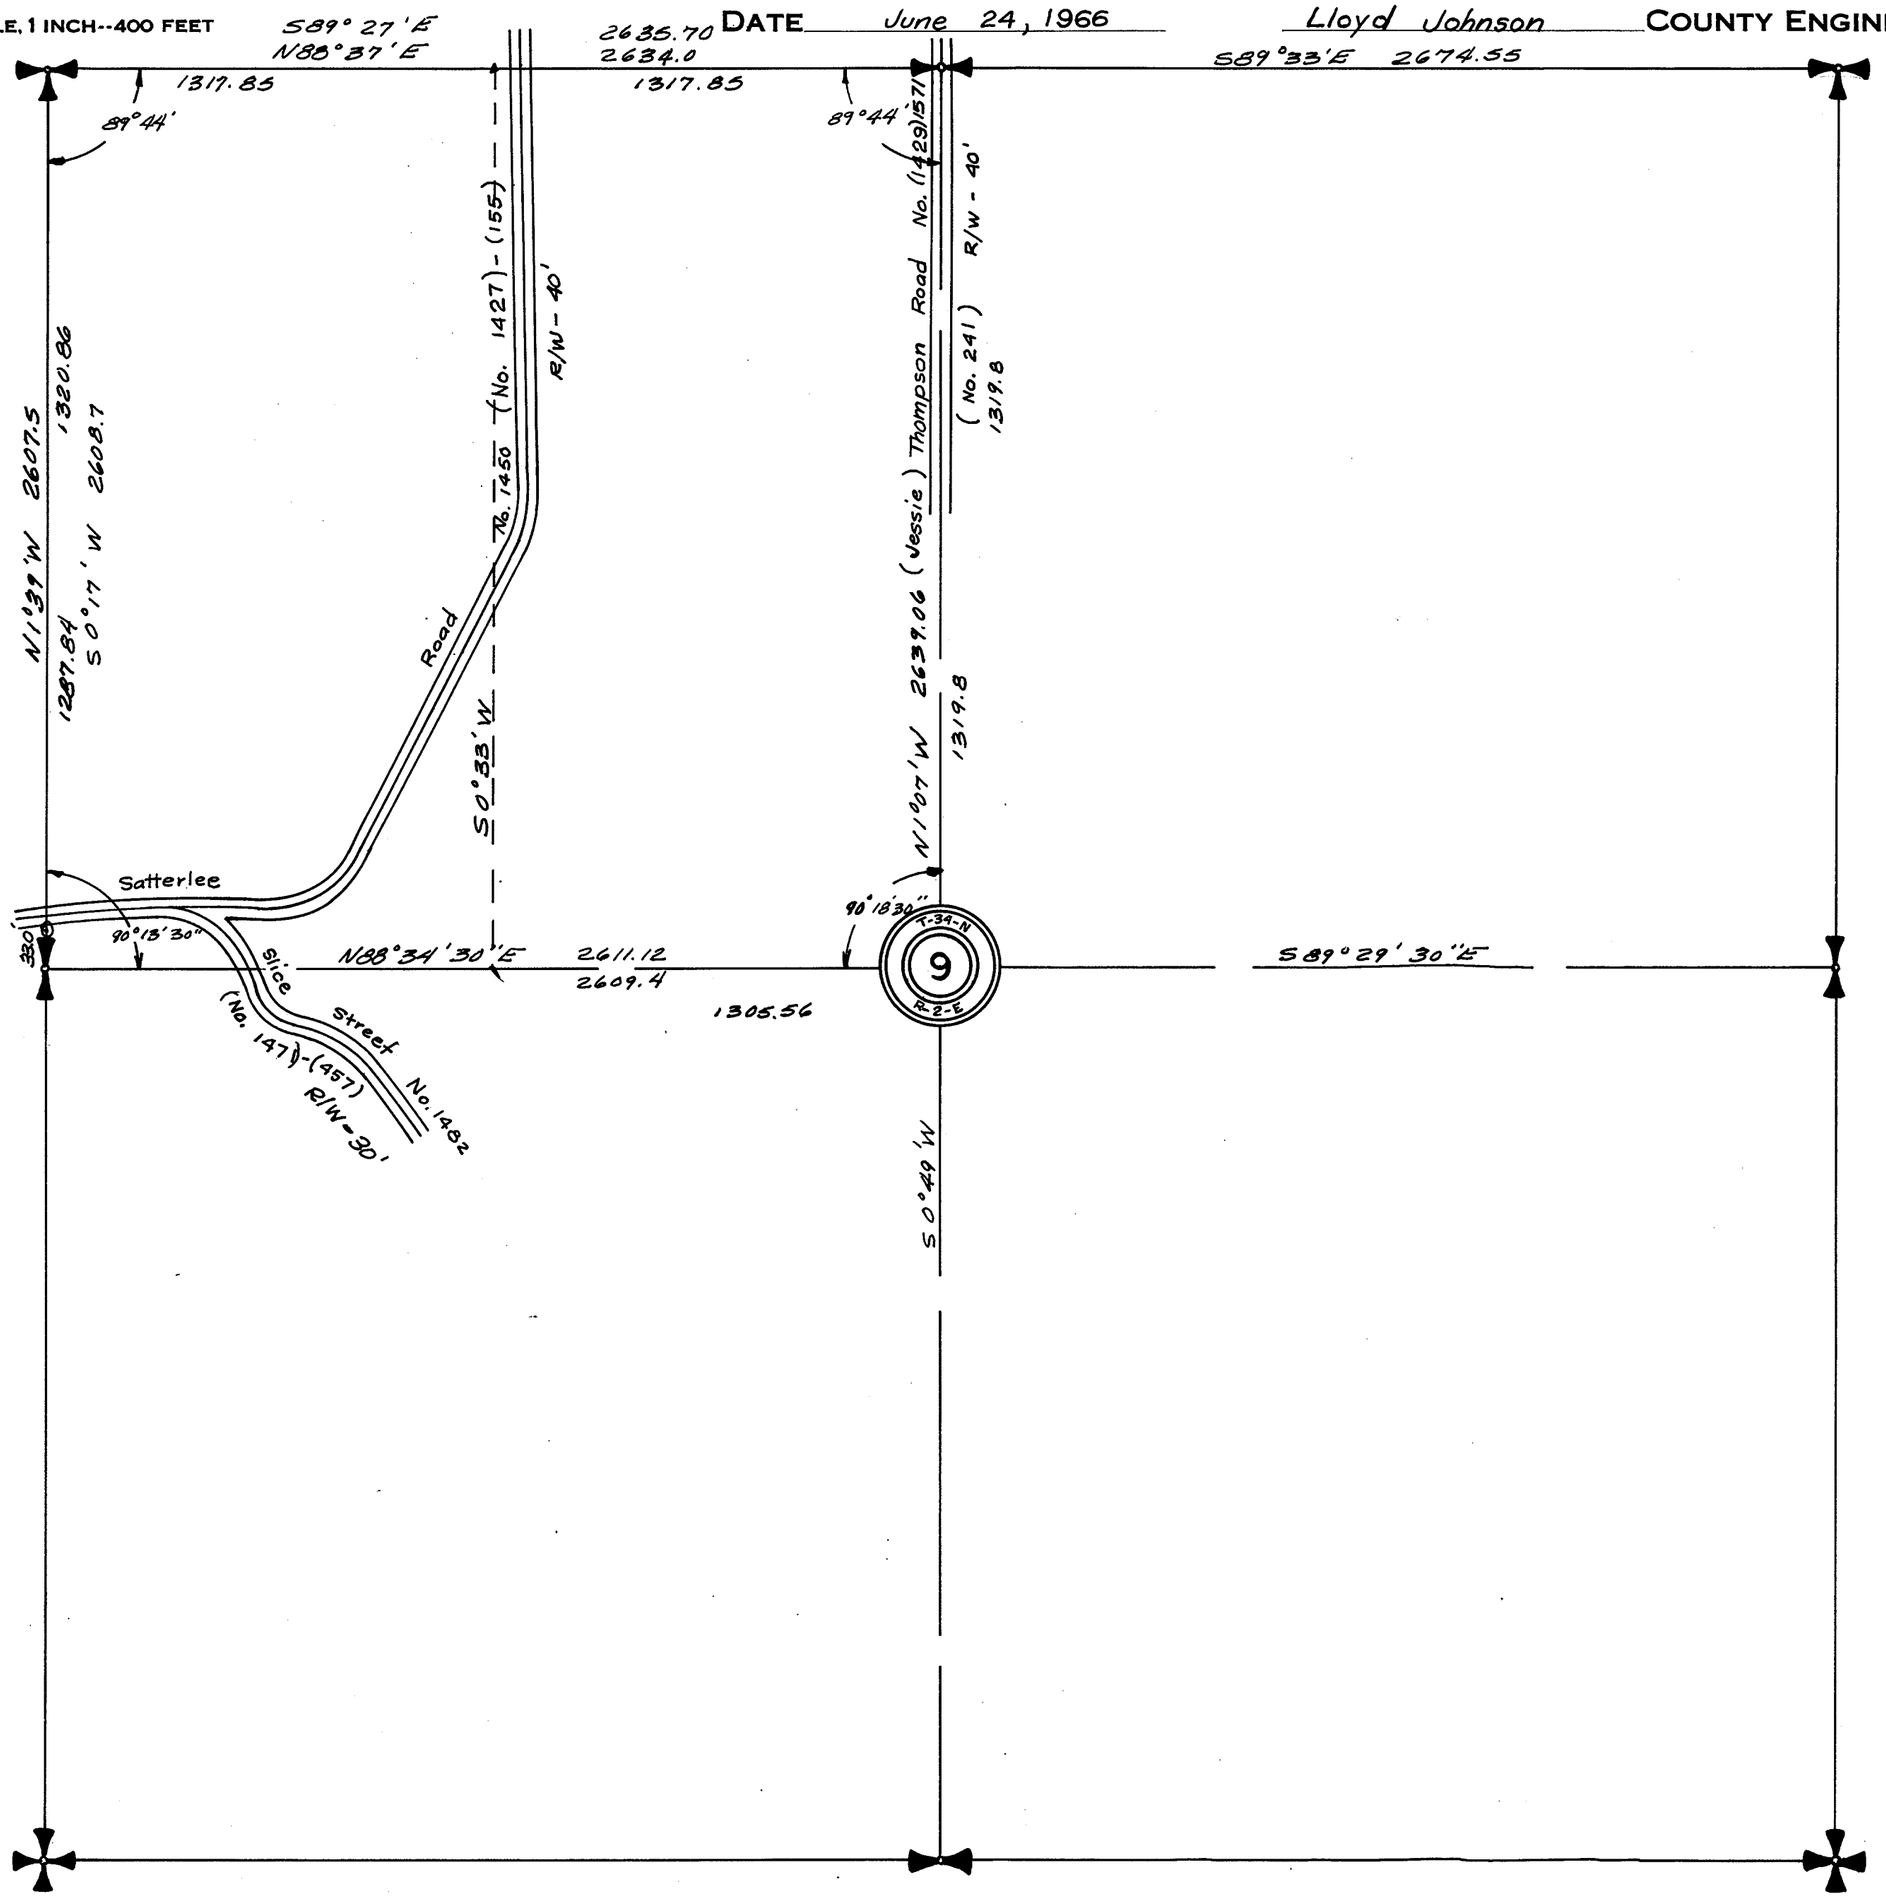


SECTION 10

TOWNSHIP 34 NORTH, RANGE 2 EAST, W. M.

SKAGIT COUNTY, WASH.

SCALE, 1 INCH--400 FEET

G. D. LeGro
August 1958
COUNTY ENGINEER

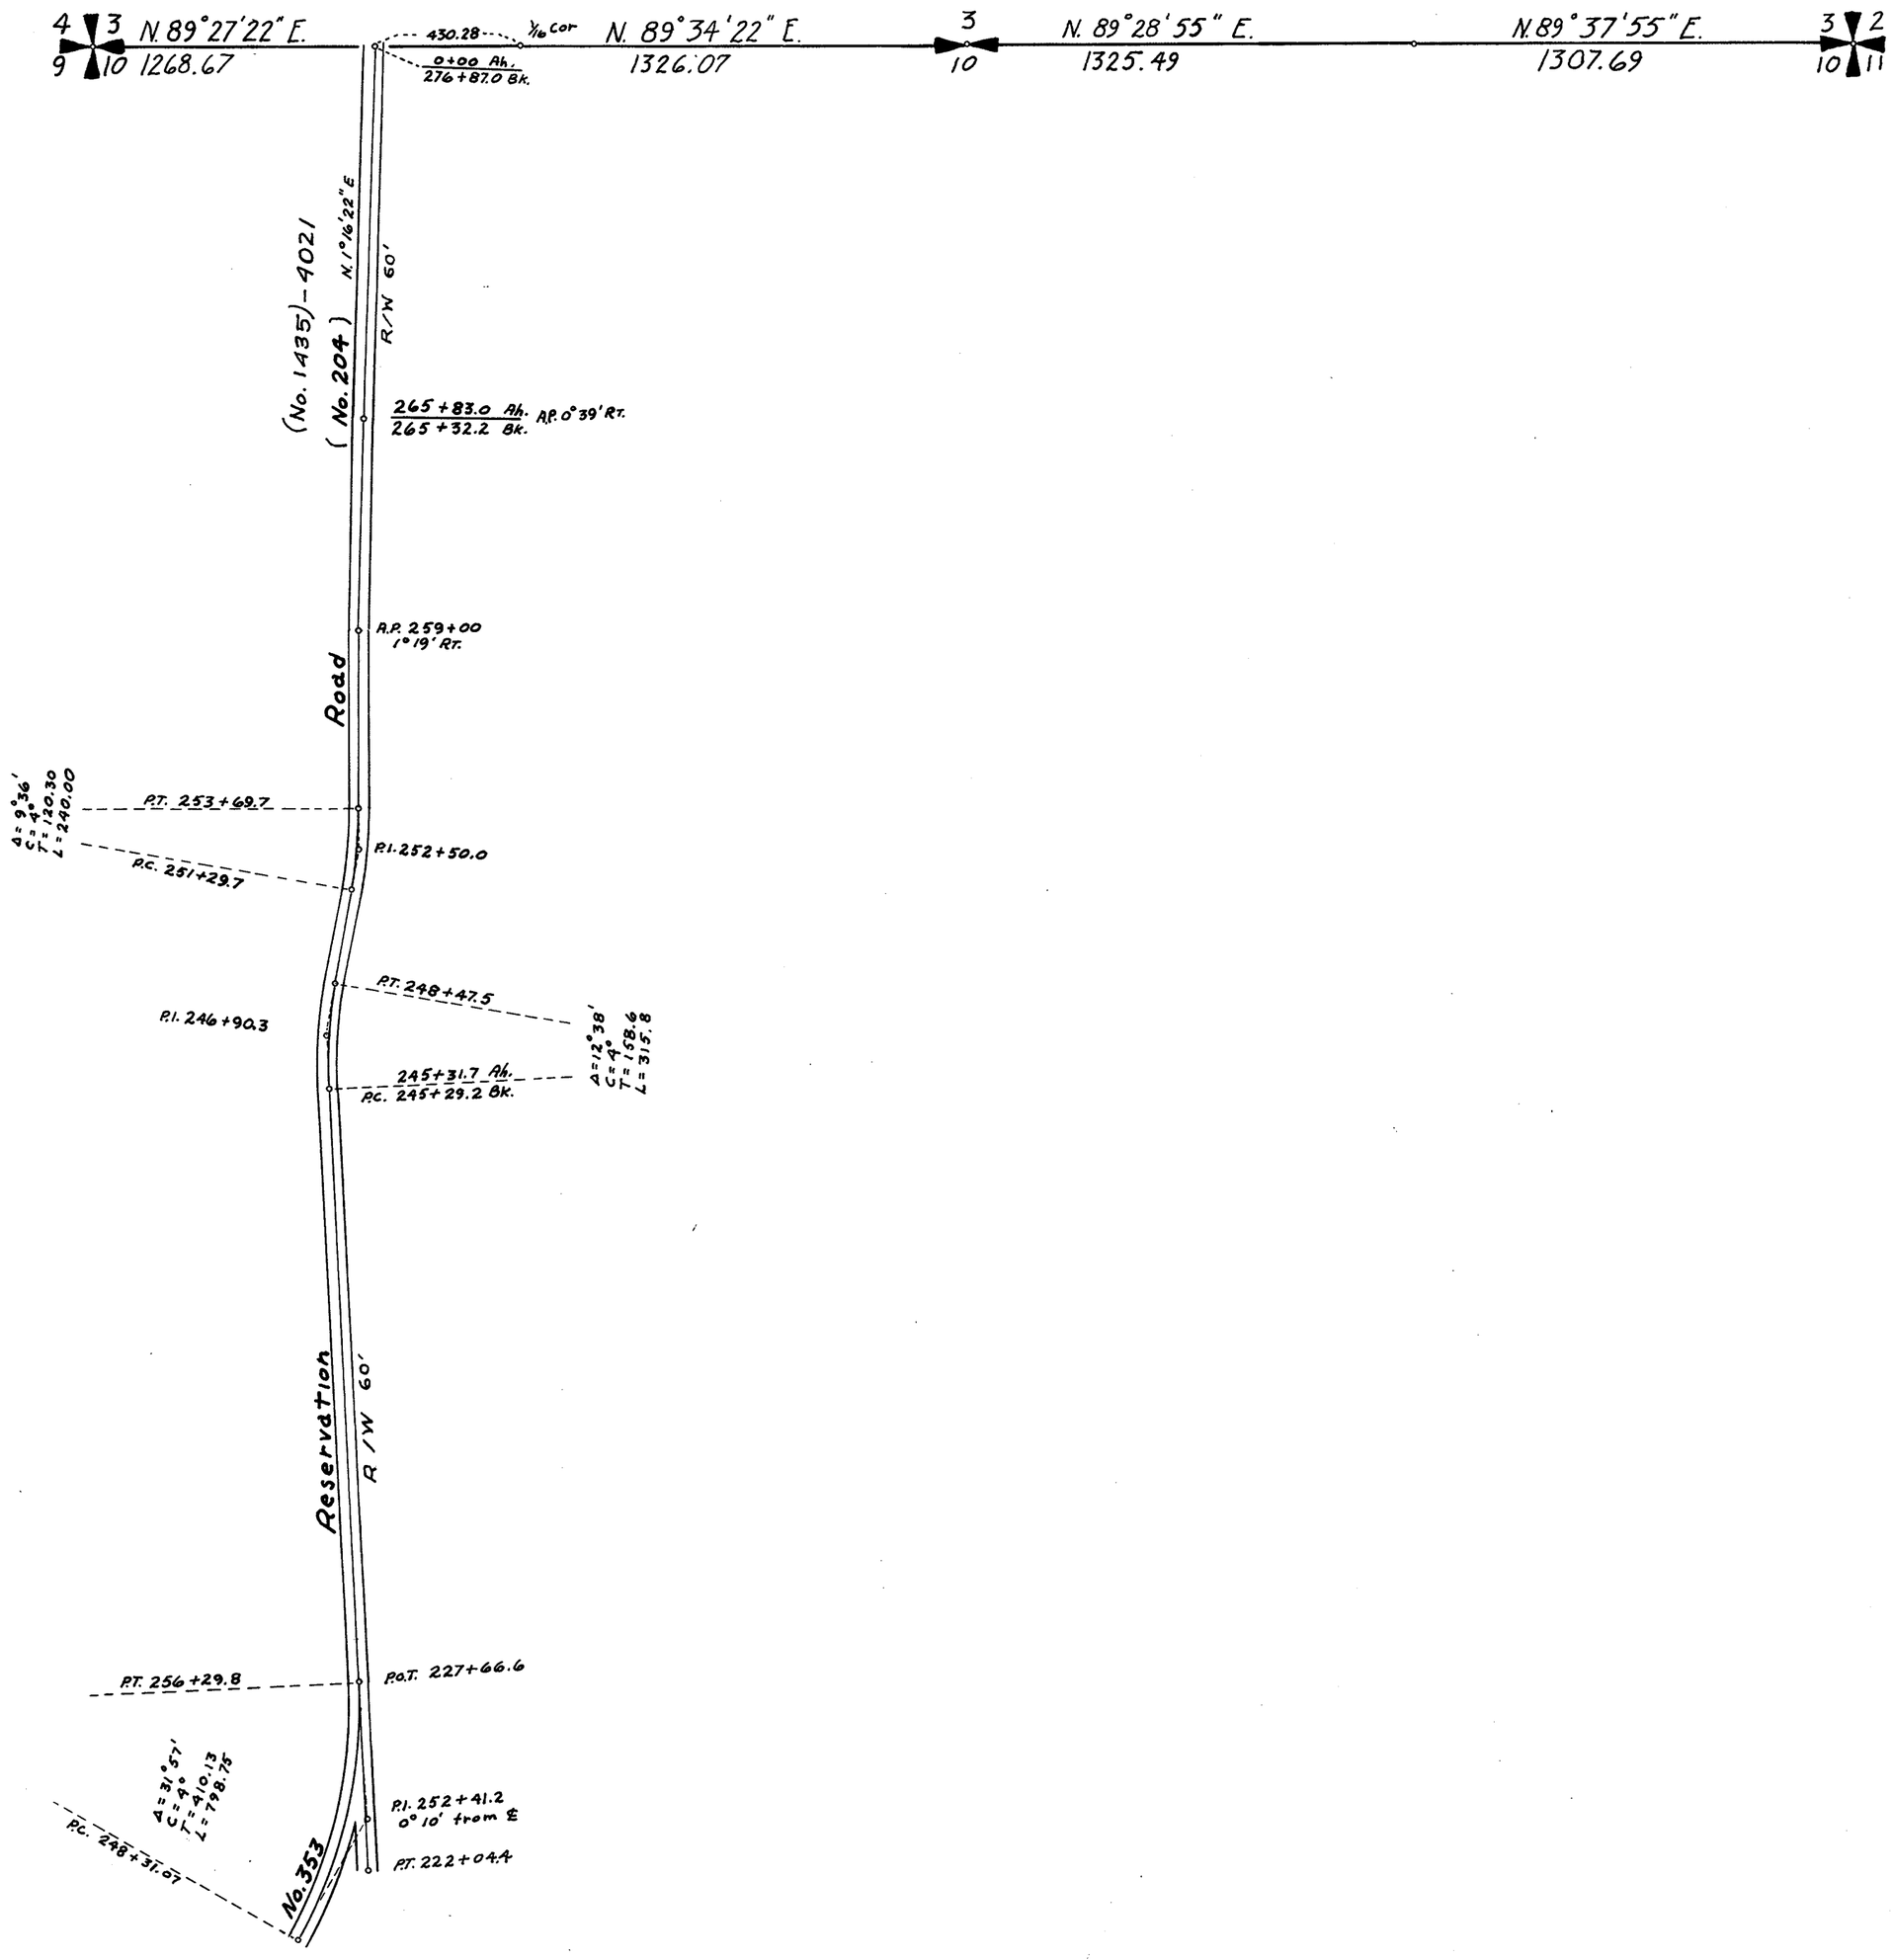


SECTION 14


TOWNSHIP 34 NORTH, RANGE 2 EAST, W. M.

SKAGIT COUNTY, WASH.

SCALE, 1 INCH--400 FEET

G. D. LeGro
August 1958
COUNTY ENGINEER

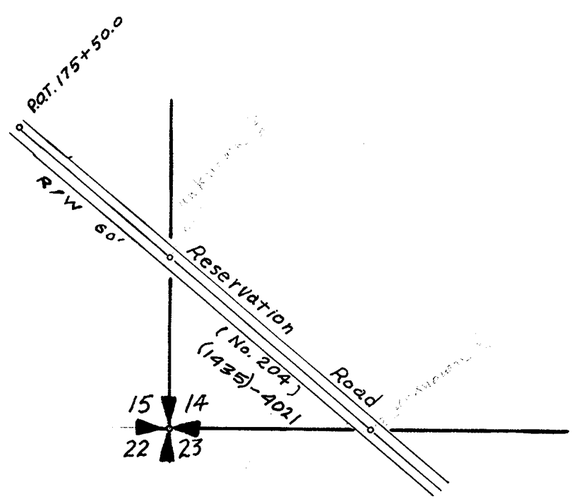

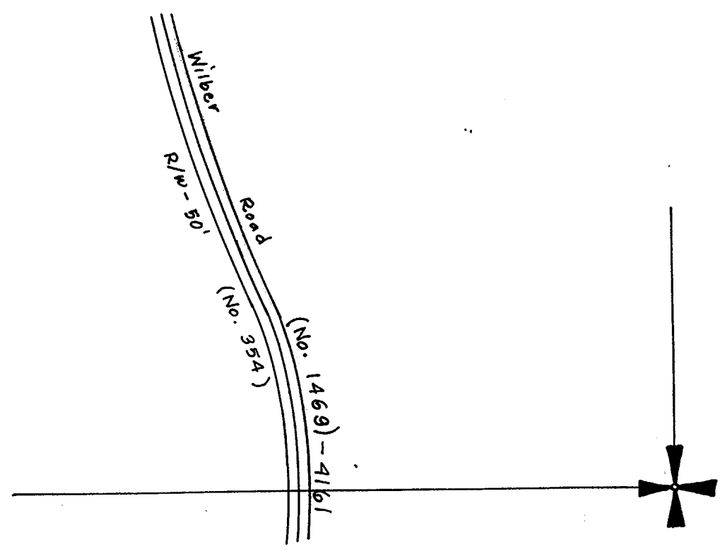


SECTION 15

TOWNSHIP 34 NORTH, RANGE 2 EAST, W. M.

SKAGIT COUNTY, WASH.

SCALE, 1 INCH--400 FEET

G.D. LeGro COUNTY ENGINEER
July 1958

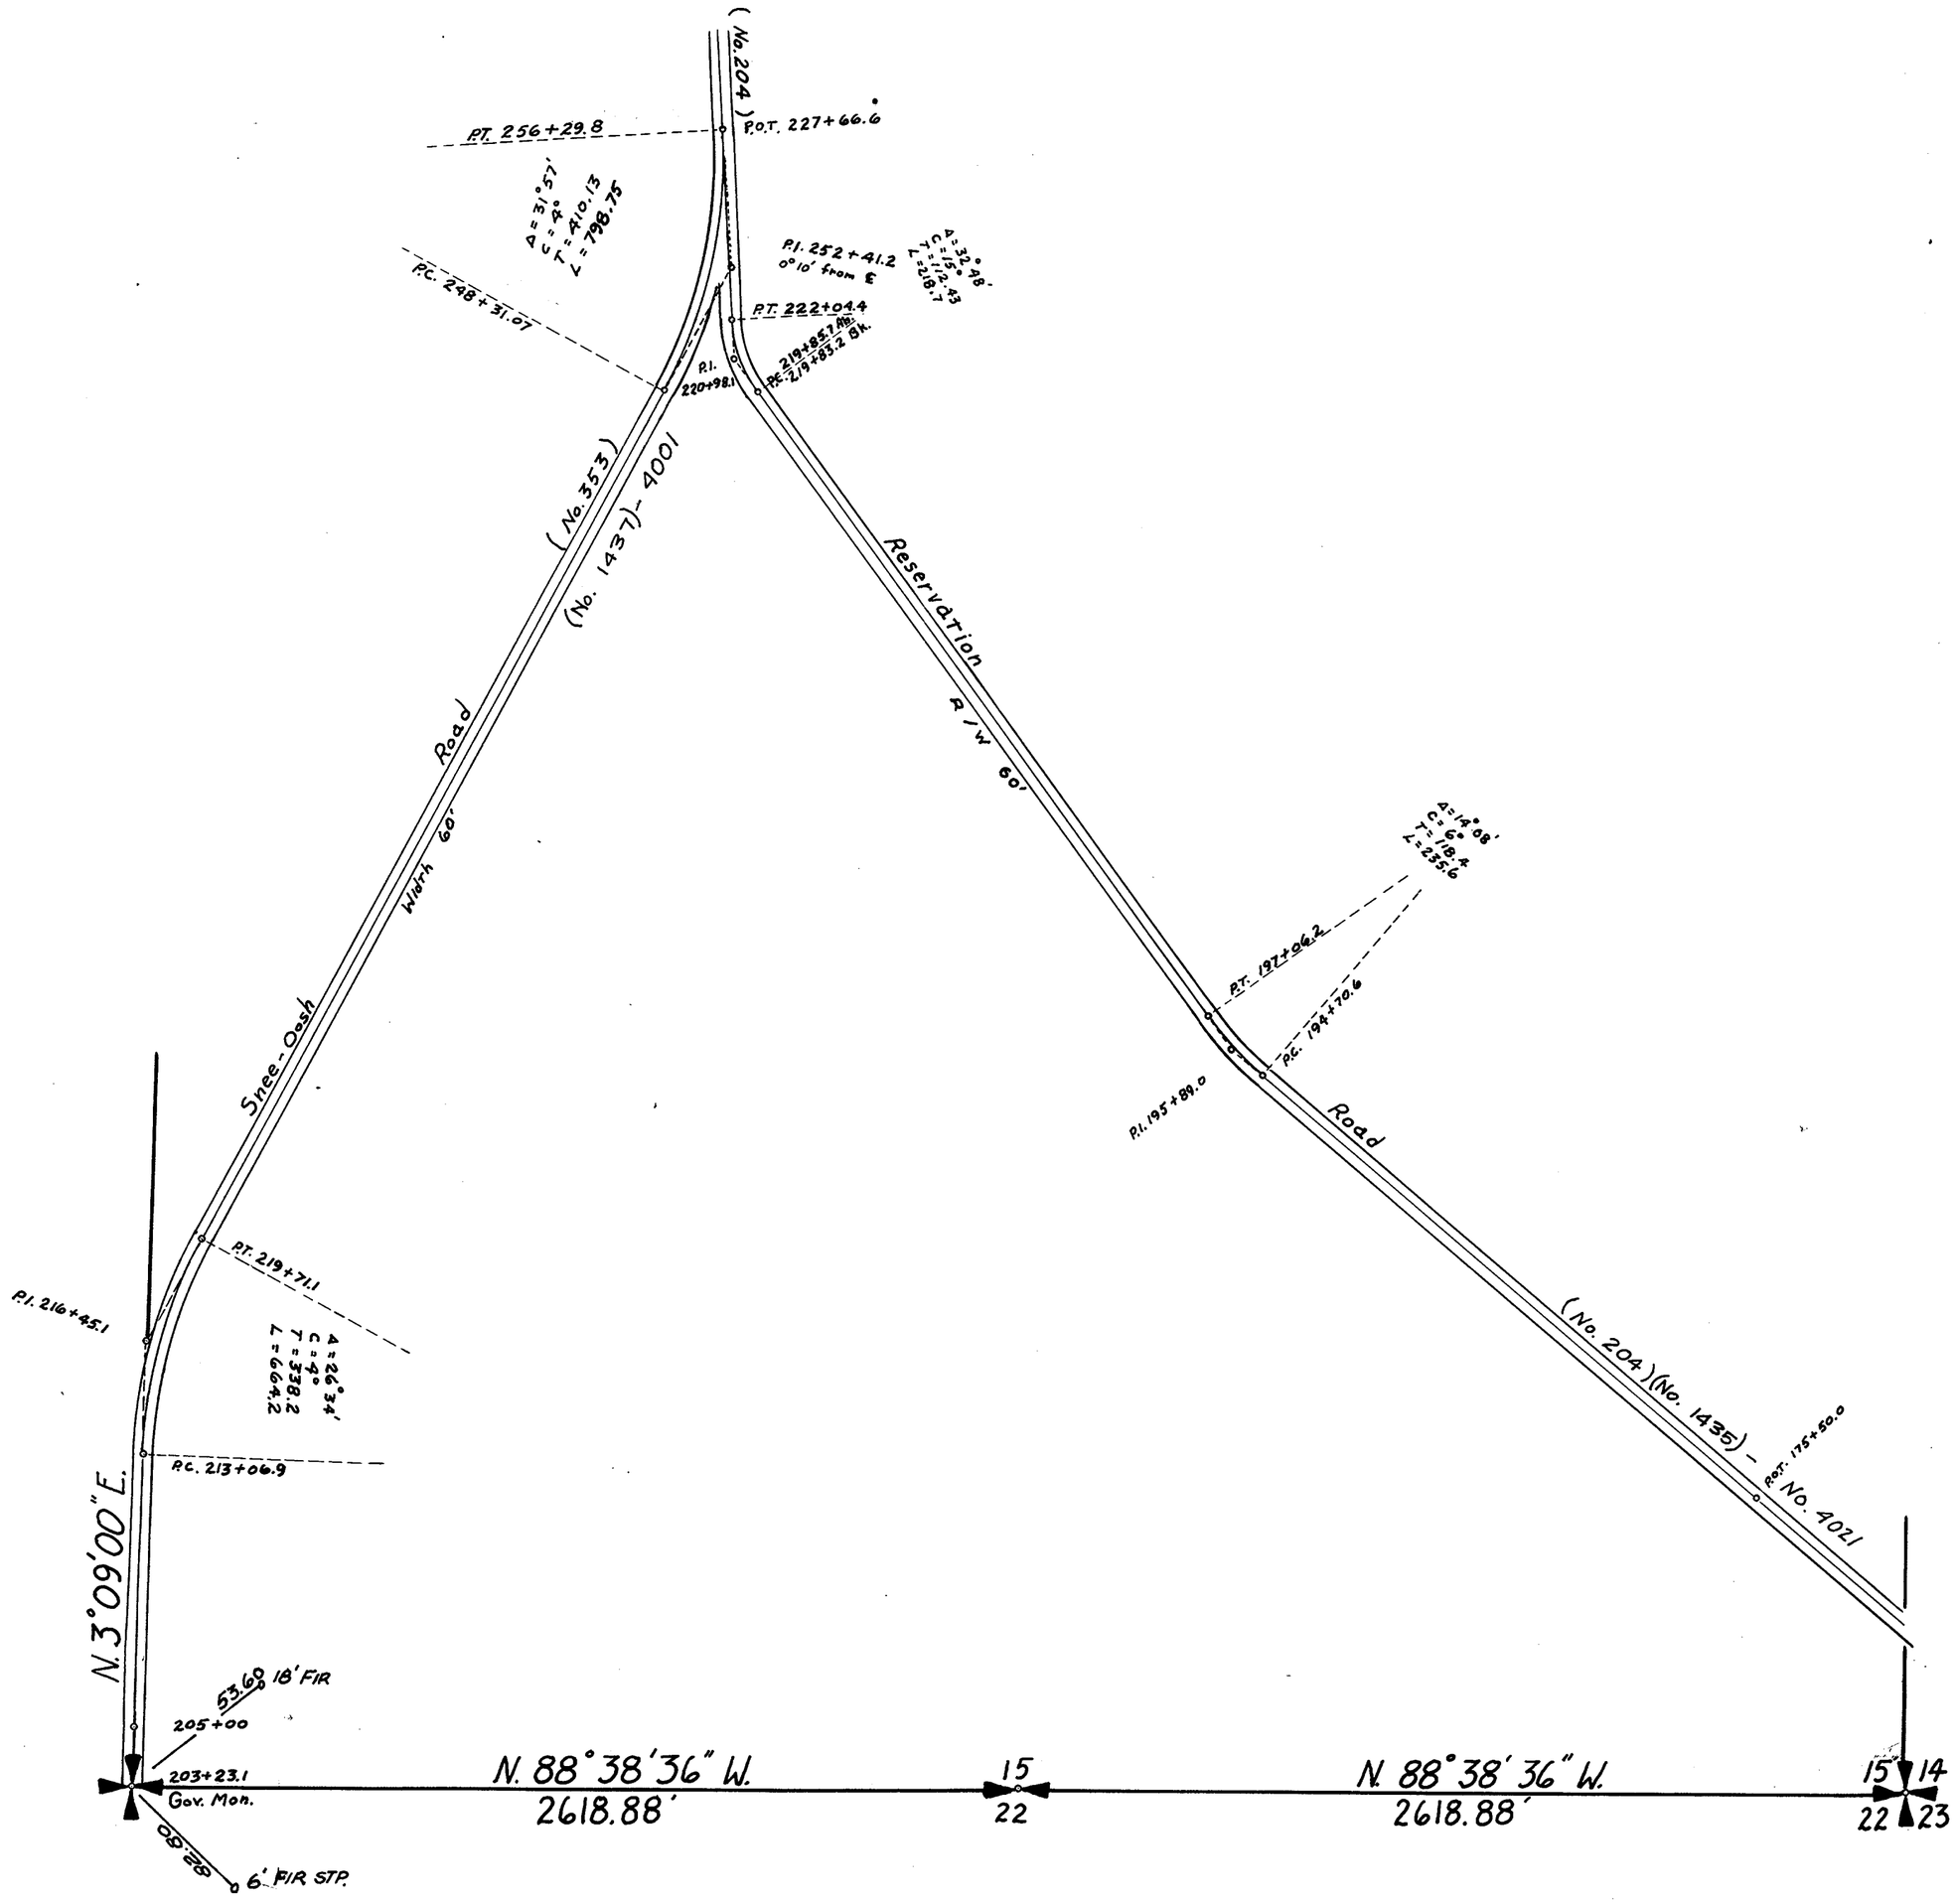


SECTION 17

TOWNSHIP 34 NORTH, RANGE 2 EAST, W. M.

SKAGIT COUNTY, WASH.

FRANK GILKEY COUNTY ENGINEER

SCALE, 1 INCH--400 FEET

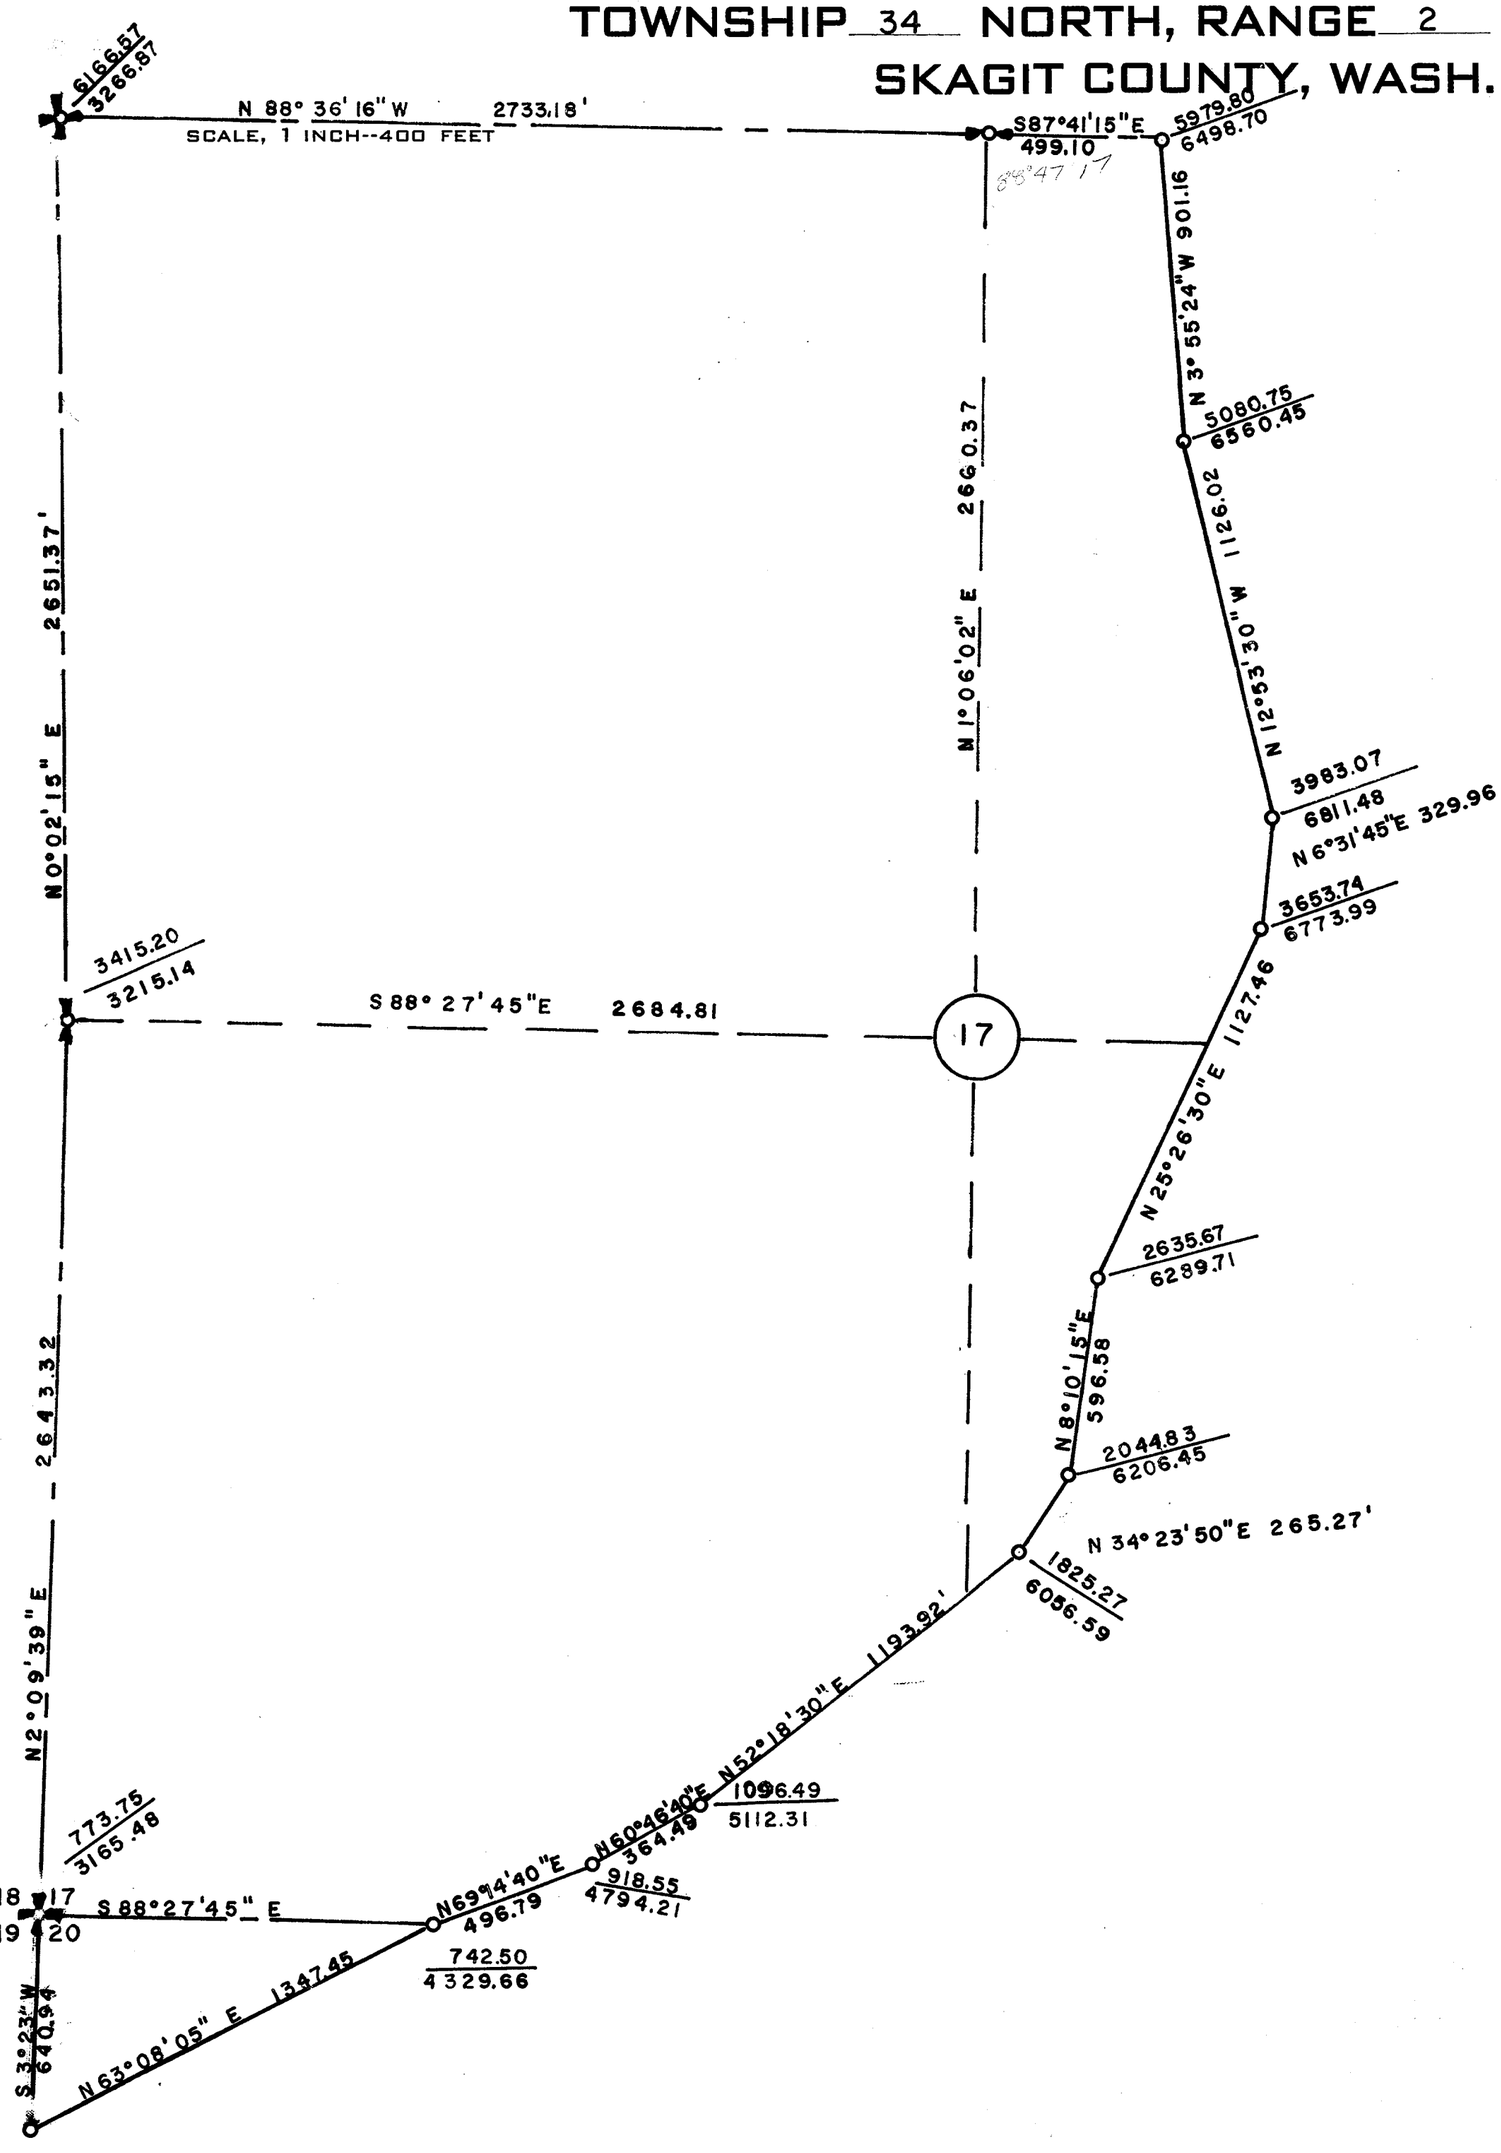

87 41 15
1 06 32
88 47 17

MEANDER IN SECTIONS 17 & 20

Calculated from Skagit County Engineer's Surveys and General Land Office Notes 6-1-46

W. C. Whitnal, Registered Engr.

SECTION 17


TOWNSHIP 34 NORTH, RANGE 2 EAST, W. M.

SKAGIT COUNTY, WASH.

6-26-41 W.C.W. Notes H-122 & F-138

SCALE, 1 INCH--400 FEET

H. O. WALBERG COUNTY ENGINEER

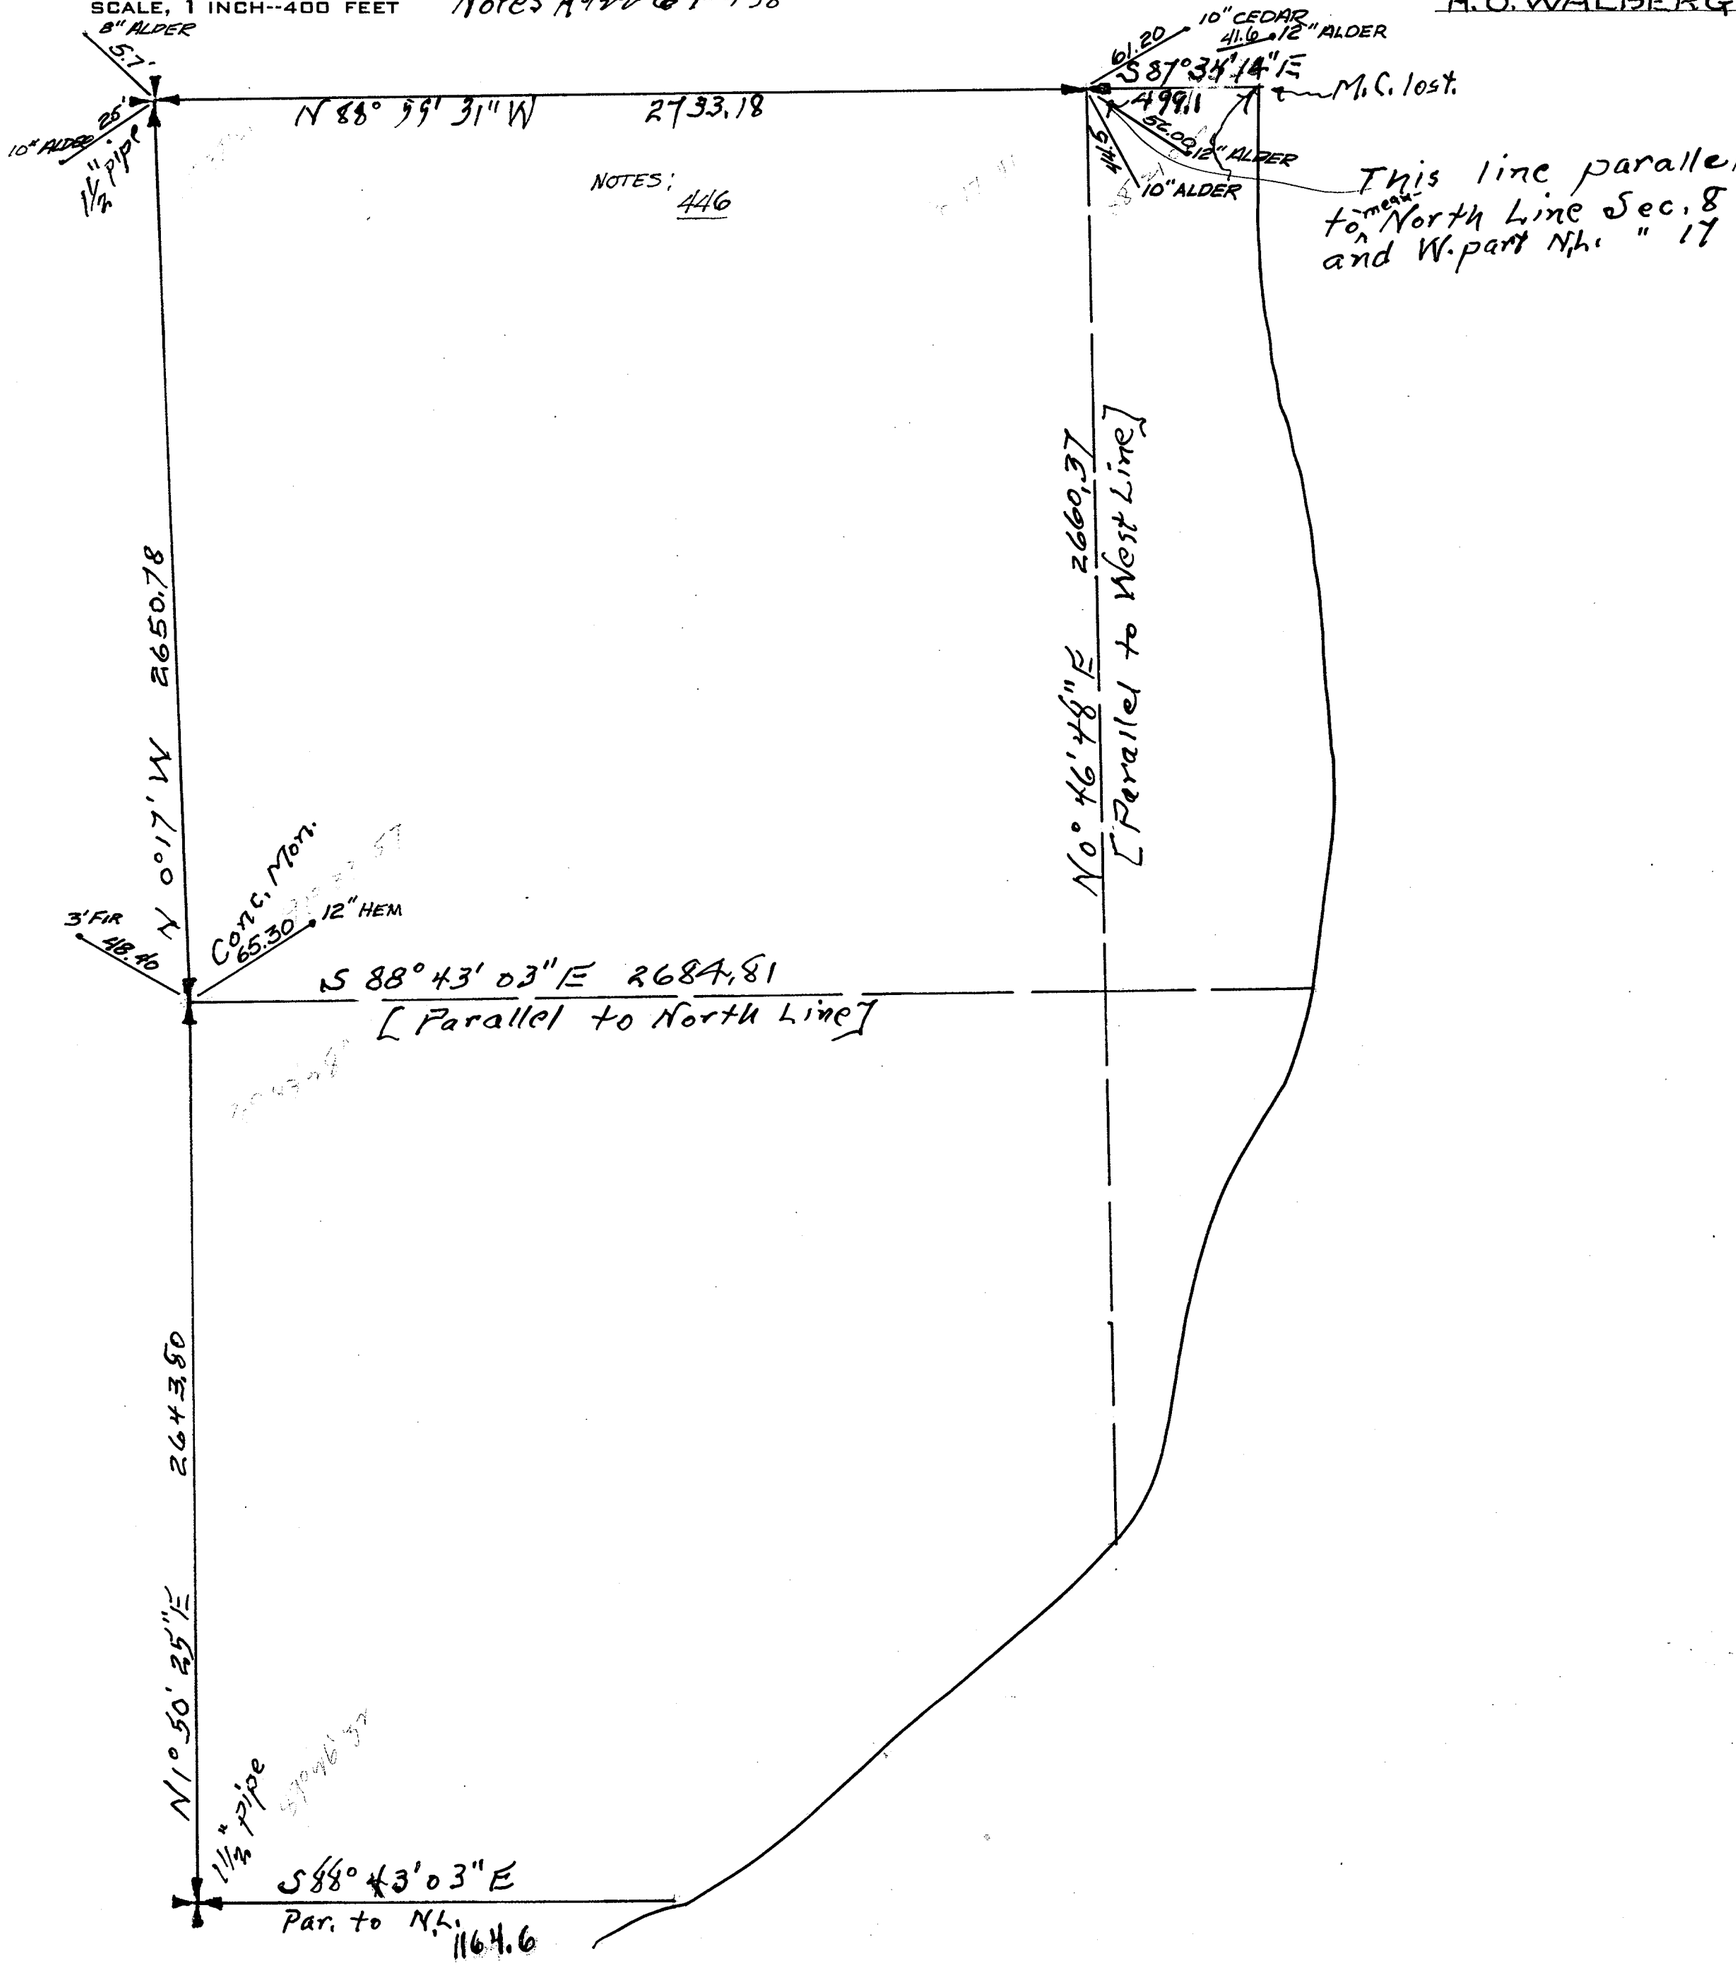


⚠ ENTNERS TRACTS SUBDIVISION #1
VOL-8 Pg 73, 74

SECTION 17
TOWNSHIP 34 NORTH, RANGE 2 EAST, W. M.
SKAGIT COUNTY, WASH.

SCALE, 1 INCH -- 400 FEET

DATE 3 Sept 1968

Lloyd H. Johnson COUNTY ENGINEER

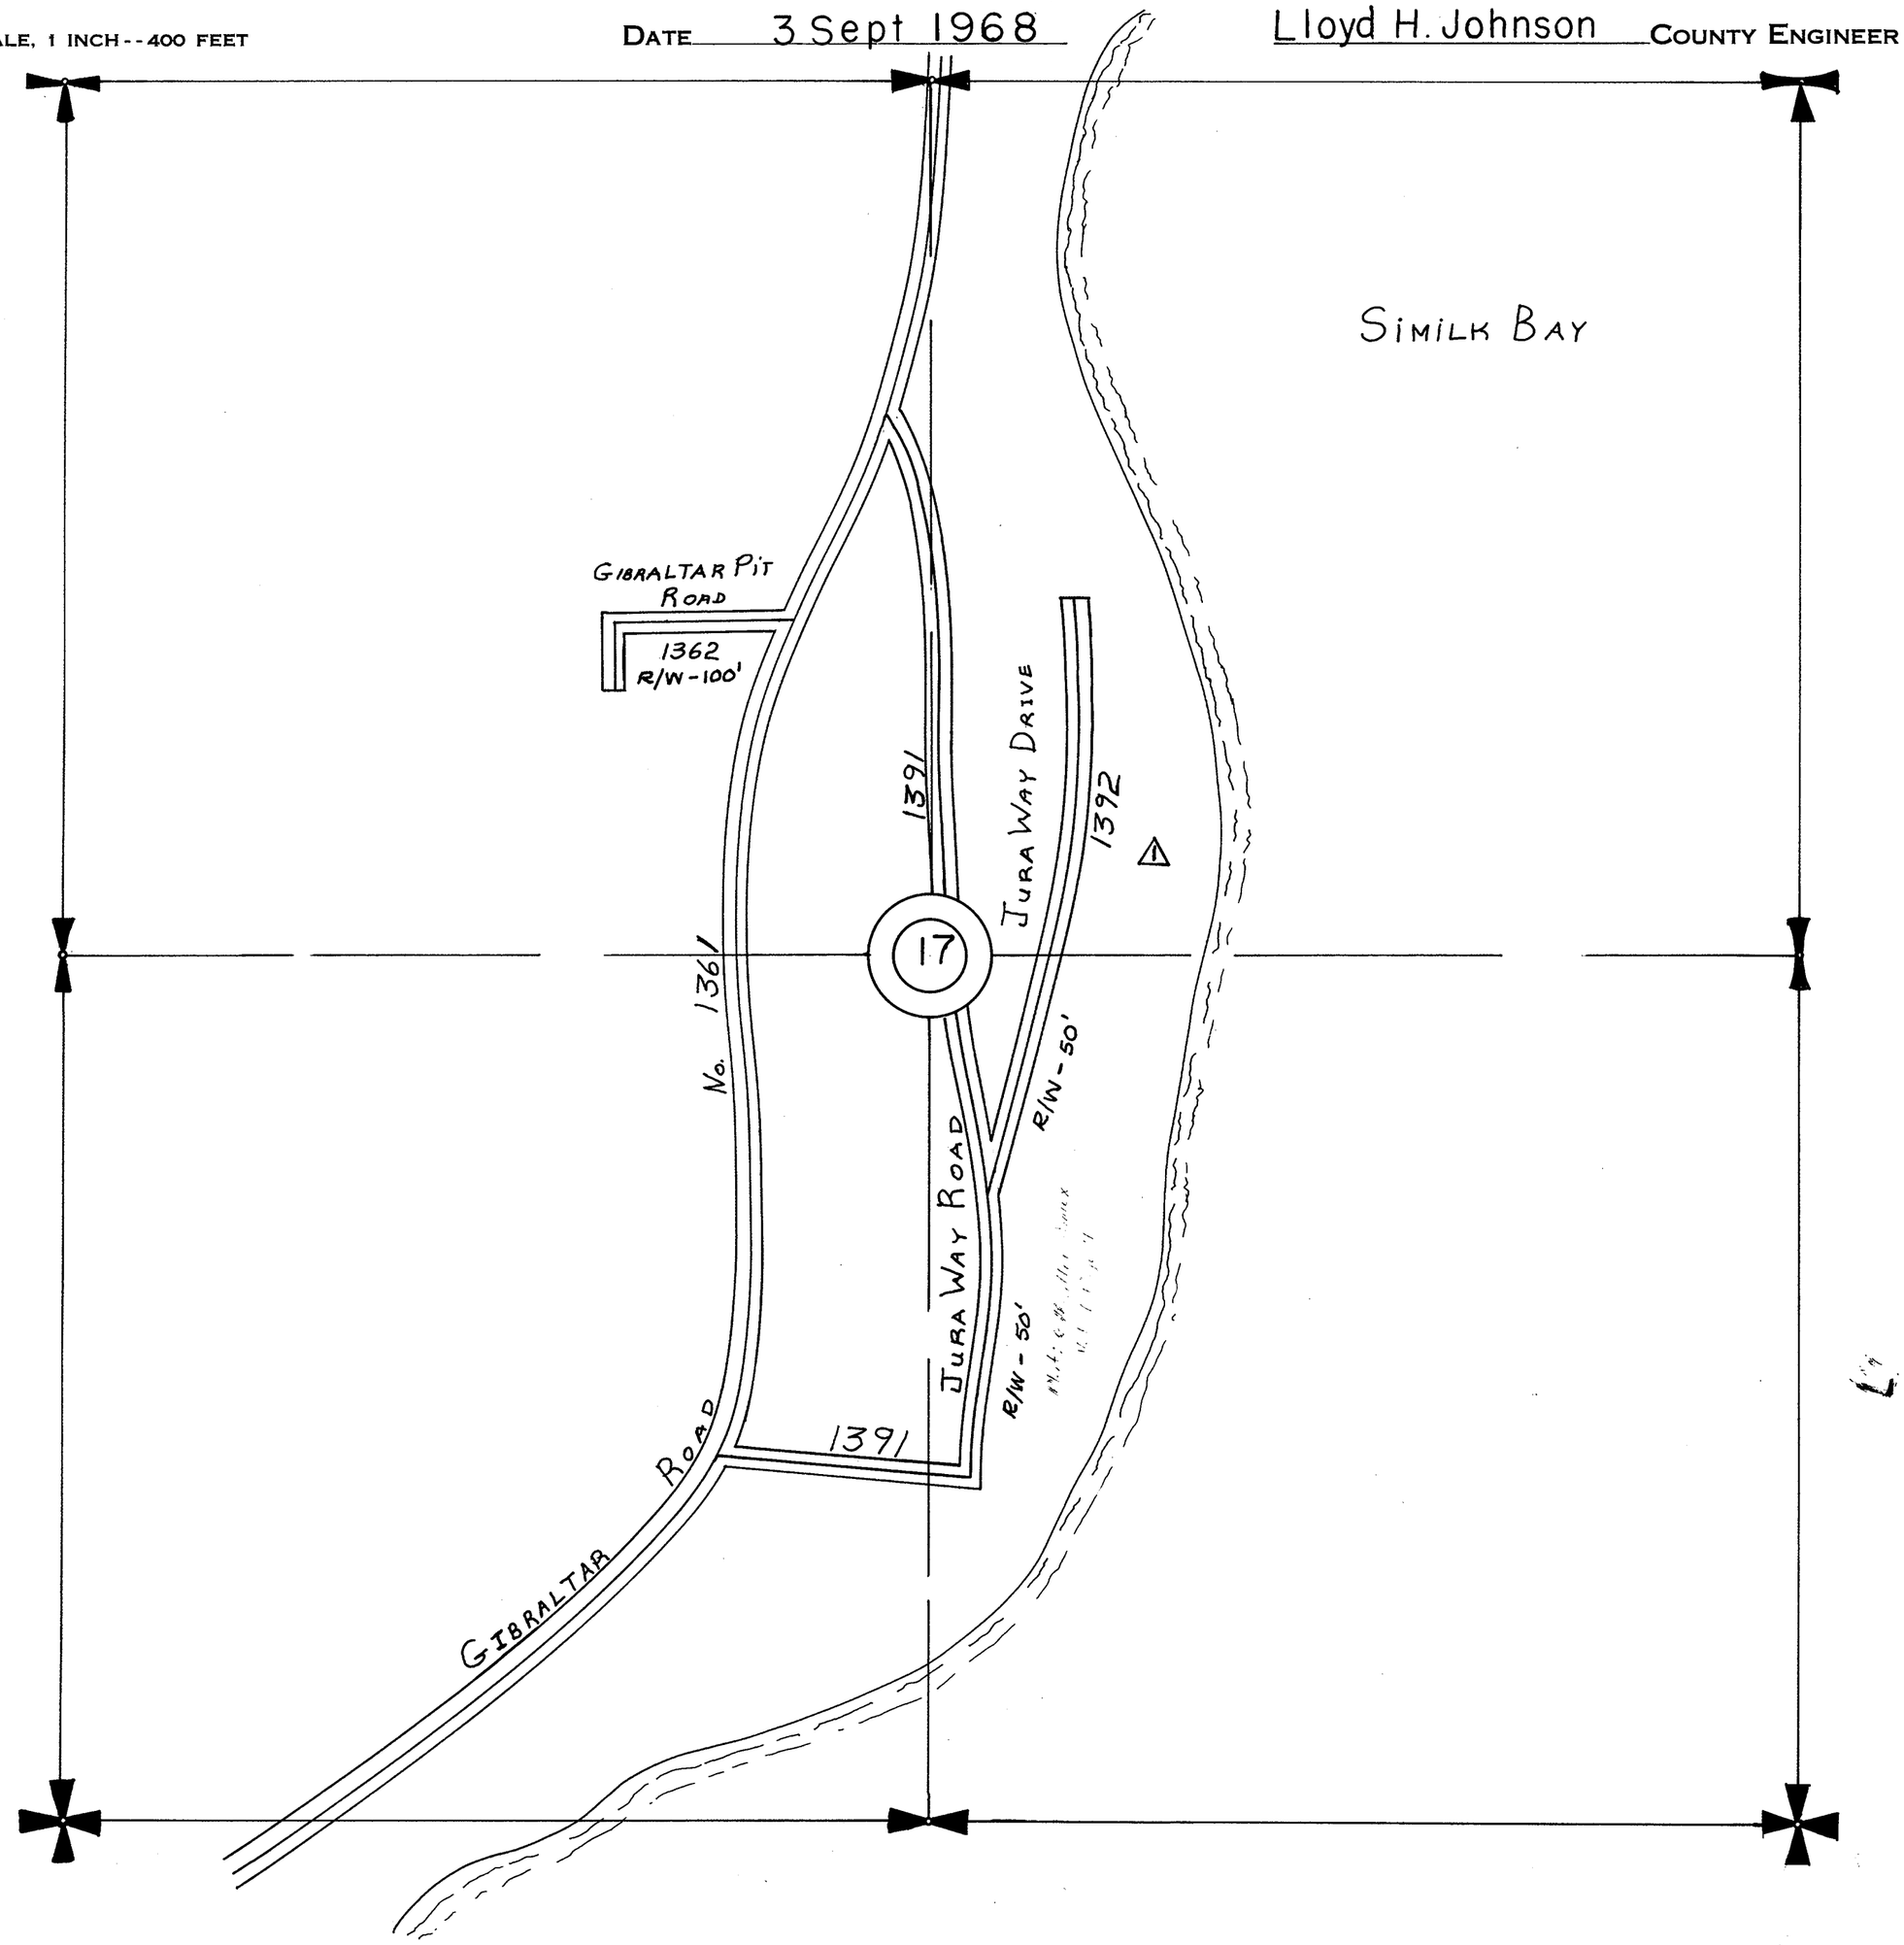

⚠ FUNK & KELLERS CAMPBELL LAKE TRACKS
SUBDIVISION #1 VOL-8 pg 80-81


SECTION 18

TOWNSHIP 34 NORTH, RANGE 2 EAST, W. M.

SKAGIT COUNTY, WASH.

SCALE, 1 INCH--400 FEET

DATE June 21, 1966 Lloyd Johnson COUNTY ENGINEER

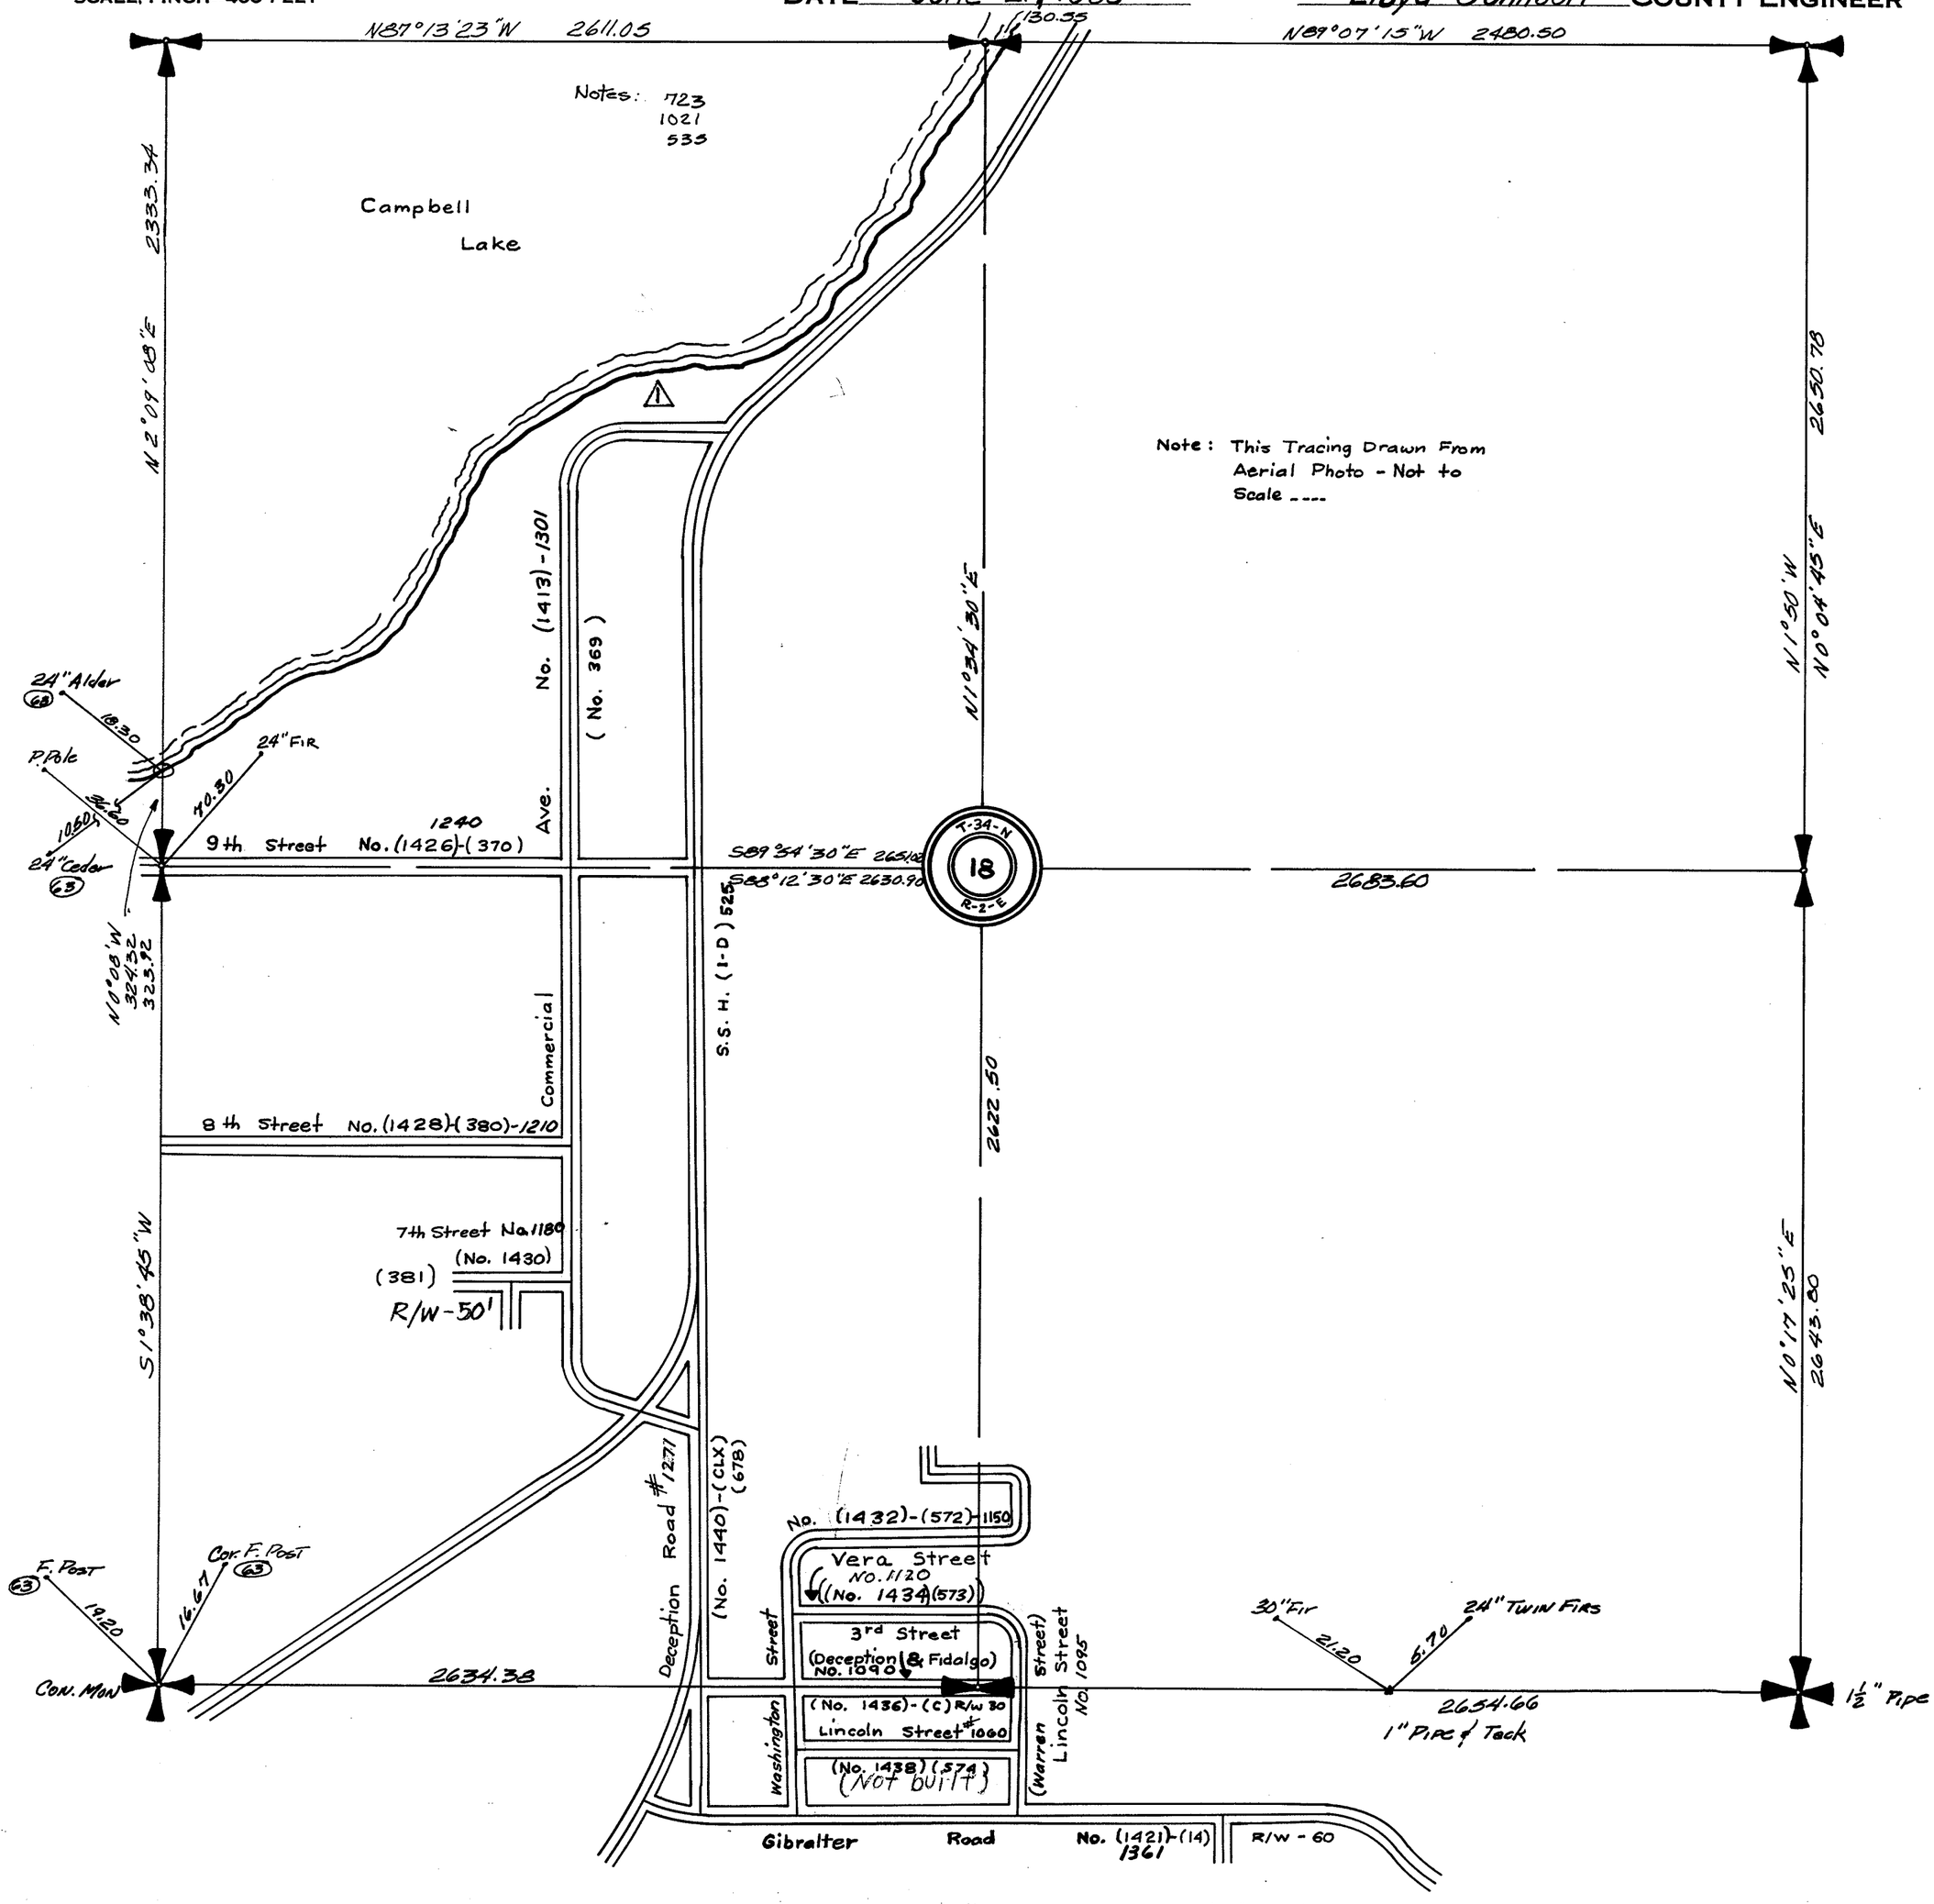

SECTION 18

TOWNSHIP 34 NORTH, RANGE 2 EAST, W. M.

SKAGIT COUNTY, WASH.

SCALE, 1 INCH--400 FEET

Assembled from Surveys in connection with P.M. No. 18

6-25-41 W.C.V.

Notes H-222

Plan A 24

H.O. WALBERG COUNTY ENGINEER

Campbell Lake

N89°29'W 49°

1½" pipe

This line evidenced by existence of old fences

S 5°

S 57°37'W

Stone Mon.

M.C. N 49°35'50"E - ?
32.46
90°13'30" — Msd. by F.C. - 9-20-19

E.W. & S88°34'15"E

2630.90

1467.19 ?

1005.19 to Mon.

Mon.

Mon. E. of Center
Prob. Center of Sec.

Cond. W. Sec. Line

2683.60

N 0°17' W 2650.78

Conc. Mon.

N 1°17'E 2623.14

N 1°19'E P.M. No. 18

N 1°12'50"E 2622.50 [N.S. & mean bar. Lines]

N 1°39'E 2621.75 to Mon.

N 1°50'25"E 2643.80

P.O.S.T. 172+46

S88°38'E 2634.38

990.00

S88° 06' 14"E 2654.66

1½" pipe along side old post & rod

SECTION 19


TOWNSHIP 34 NORTH, RANGE 2 EAST, W. M.

SKAGIT COUNTY, WASH.

SCALE, 1 INCH--400 FEET

Comp. Plan 41 W.C.W.
Note H-222 Plan B-24

H.O.WALBERG COUNTY ENGINEER

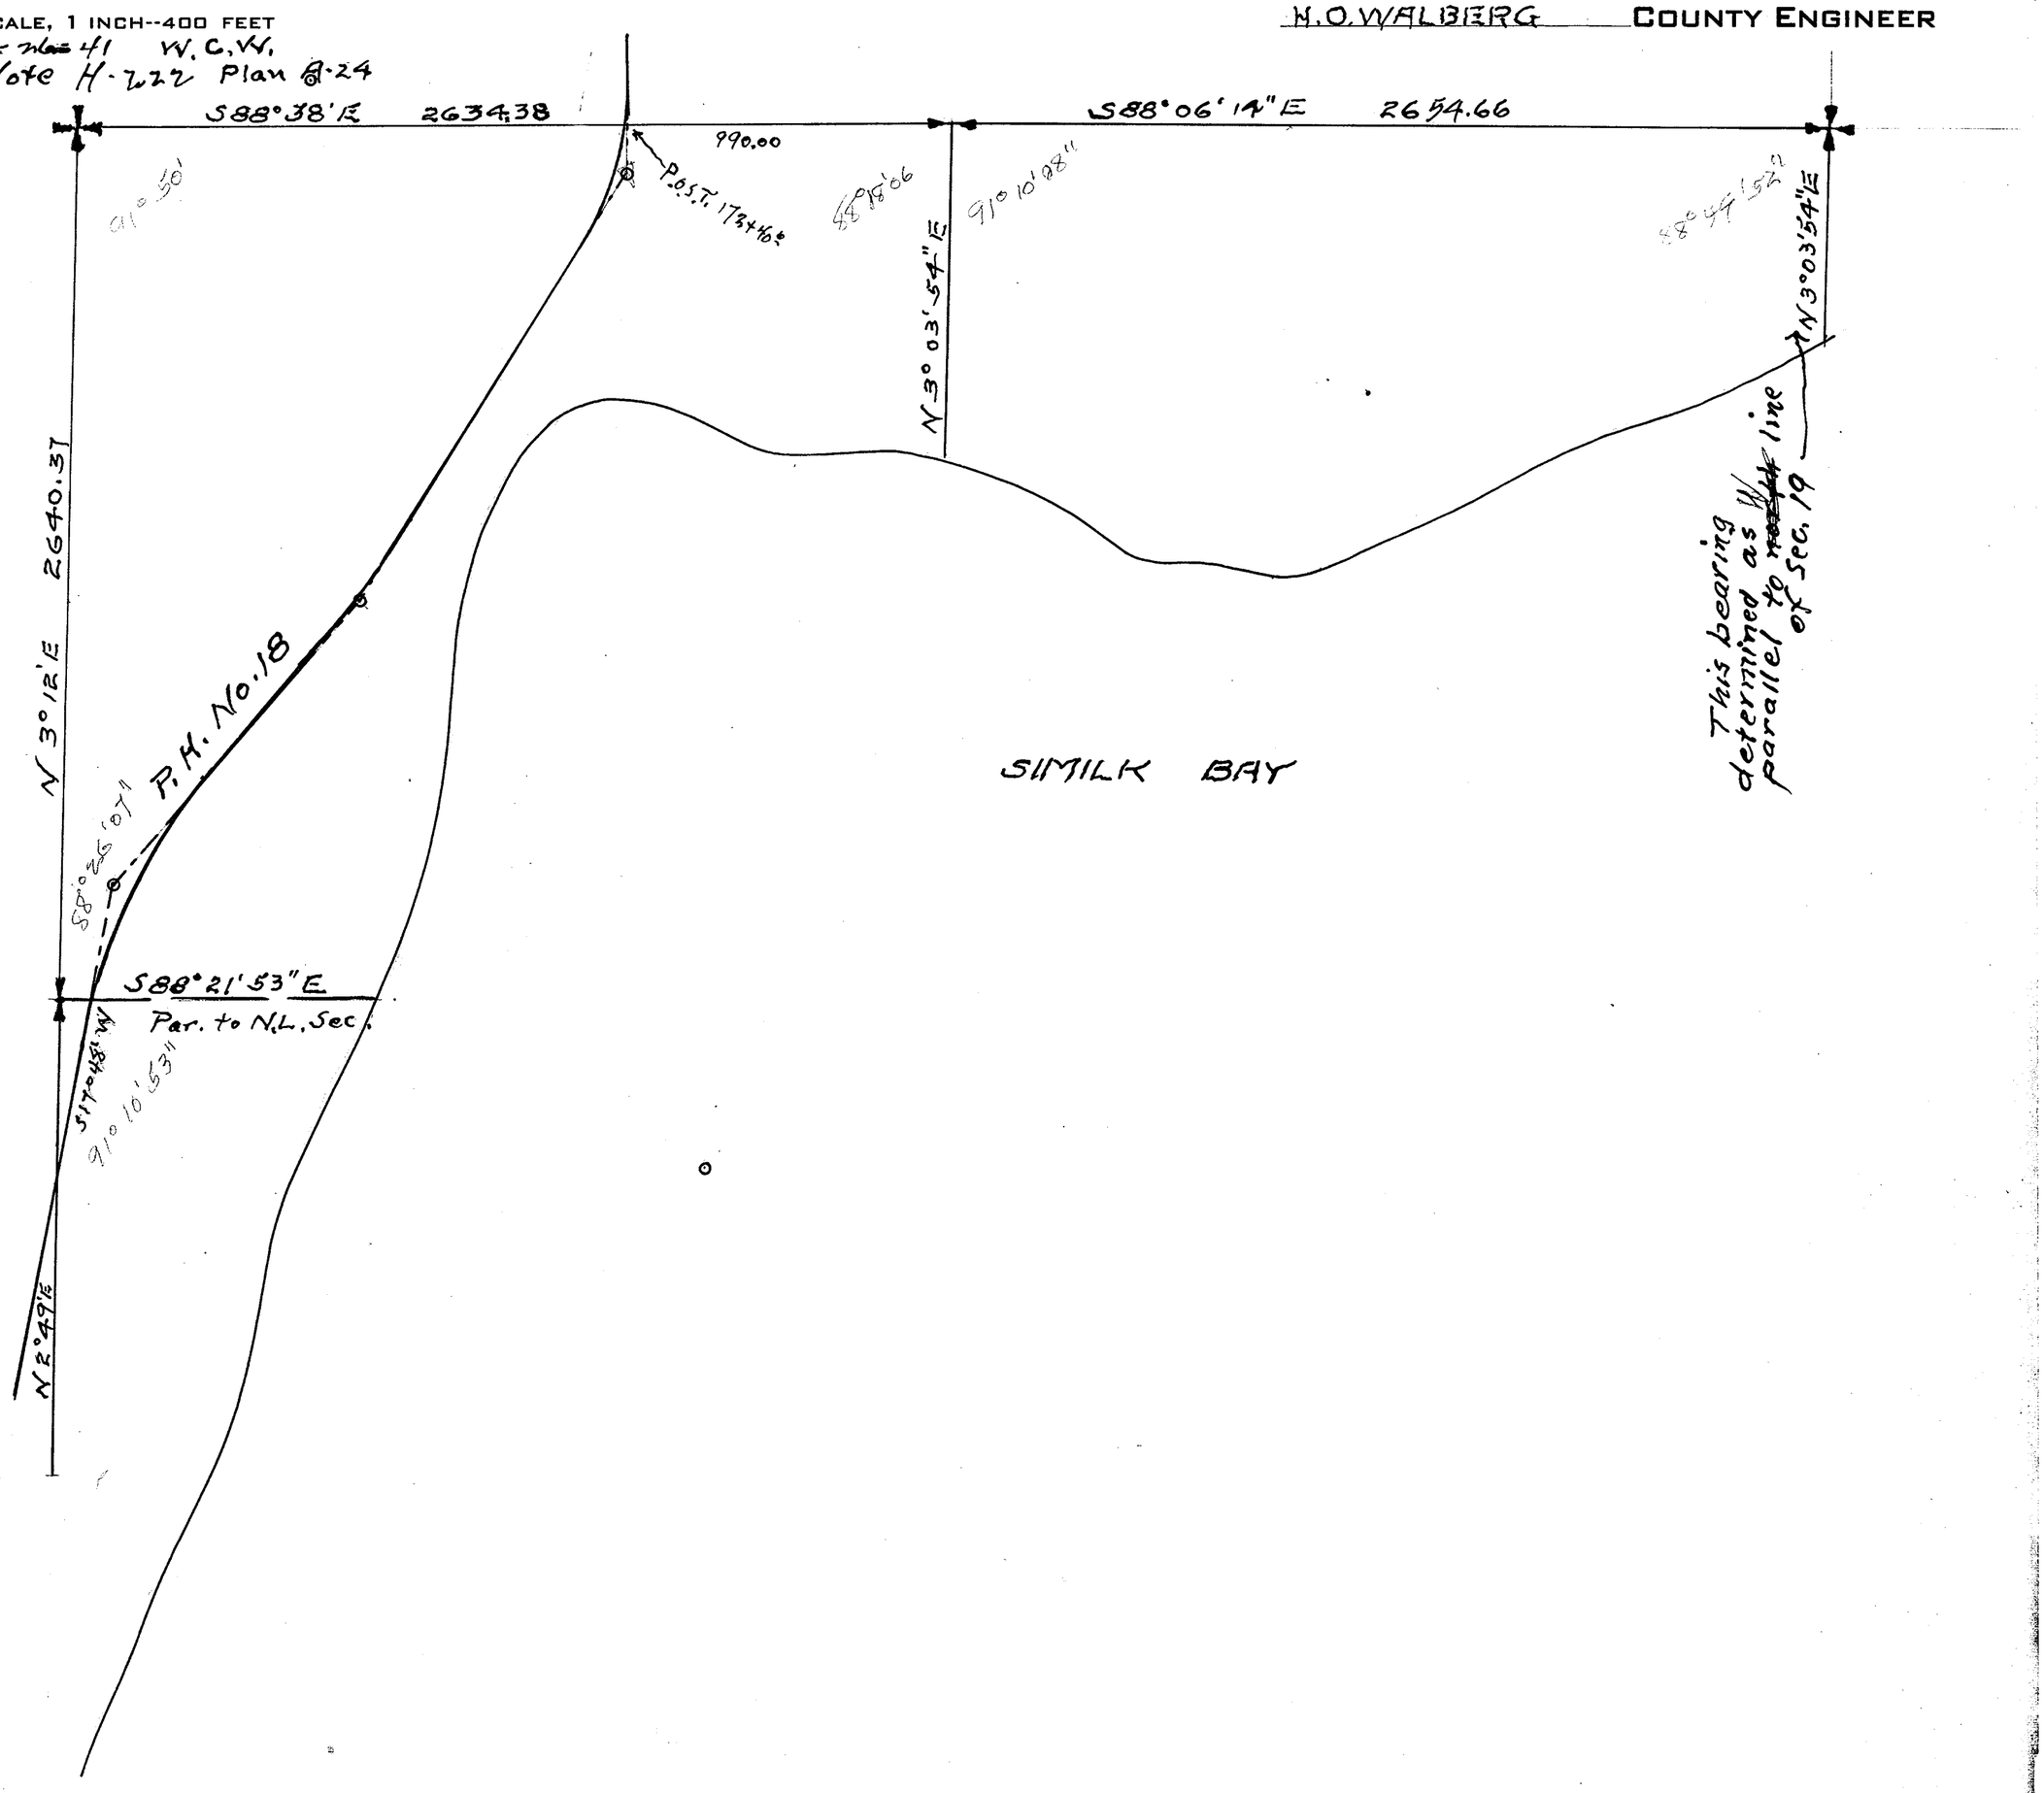


SECTION 19

TOWNSHIP 34 NORTH, RANGE 2 EAST, W. M.

SKAGIT COUNTY, WASH.

Comp. by W.C.W.
SCALE, 1 INCH--400 FEET
Notes H 222
Deception Pass Road

H.O. Walberg COUNTY ENGINEER

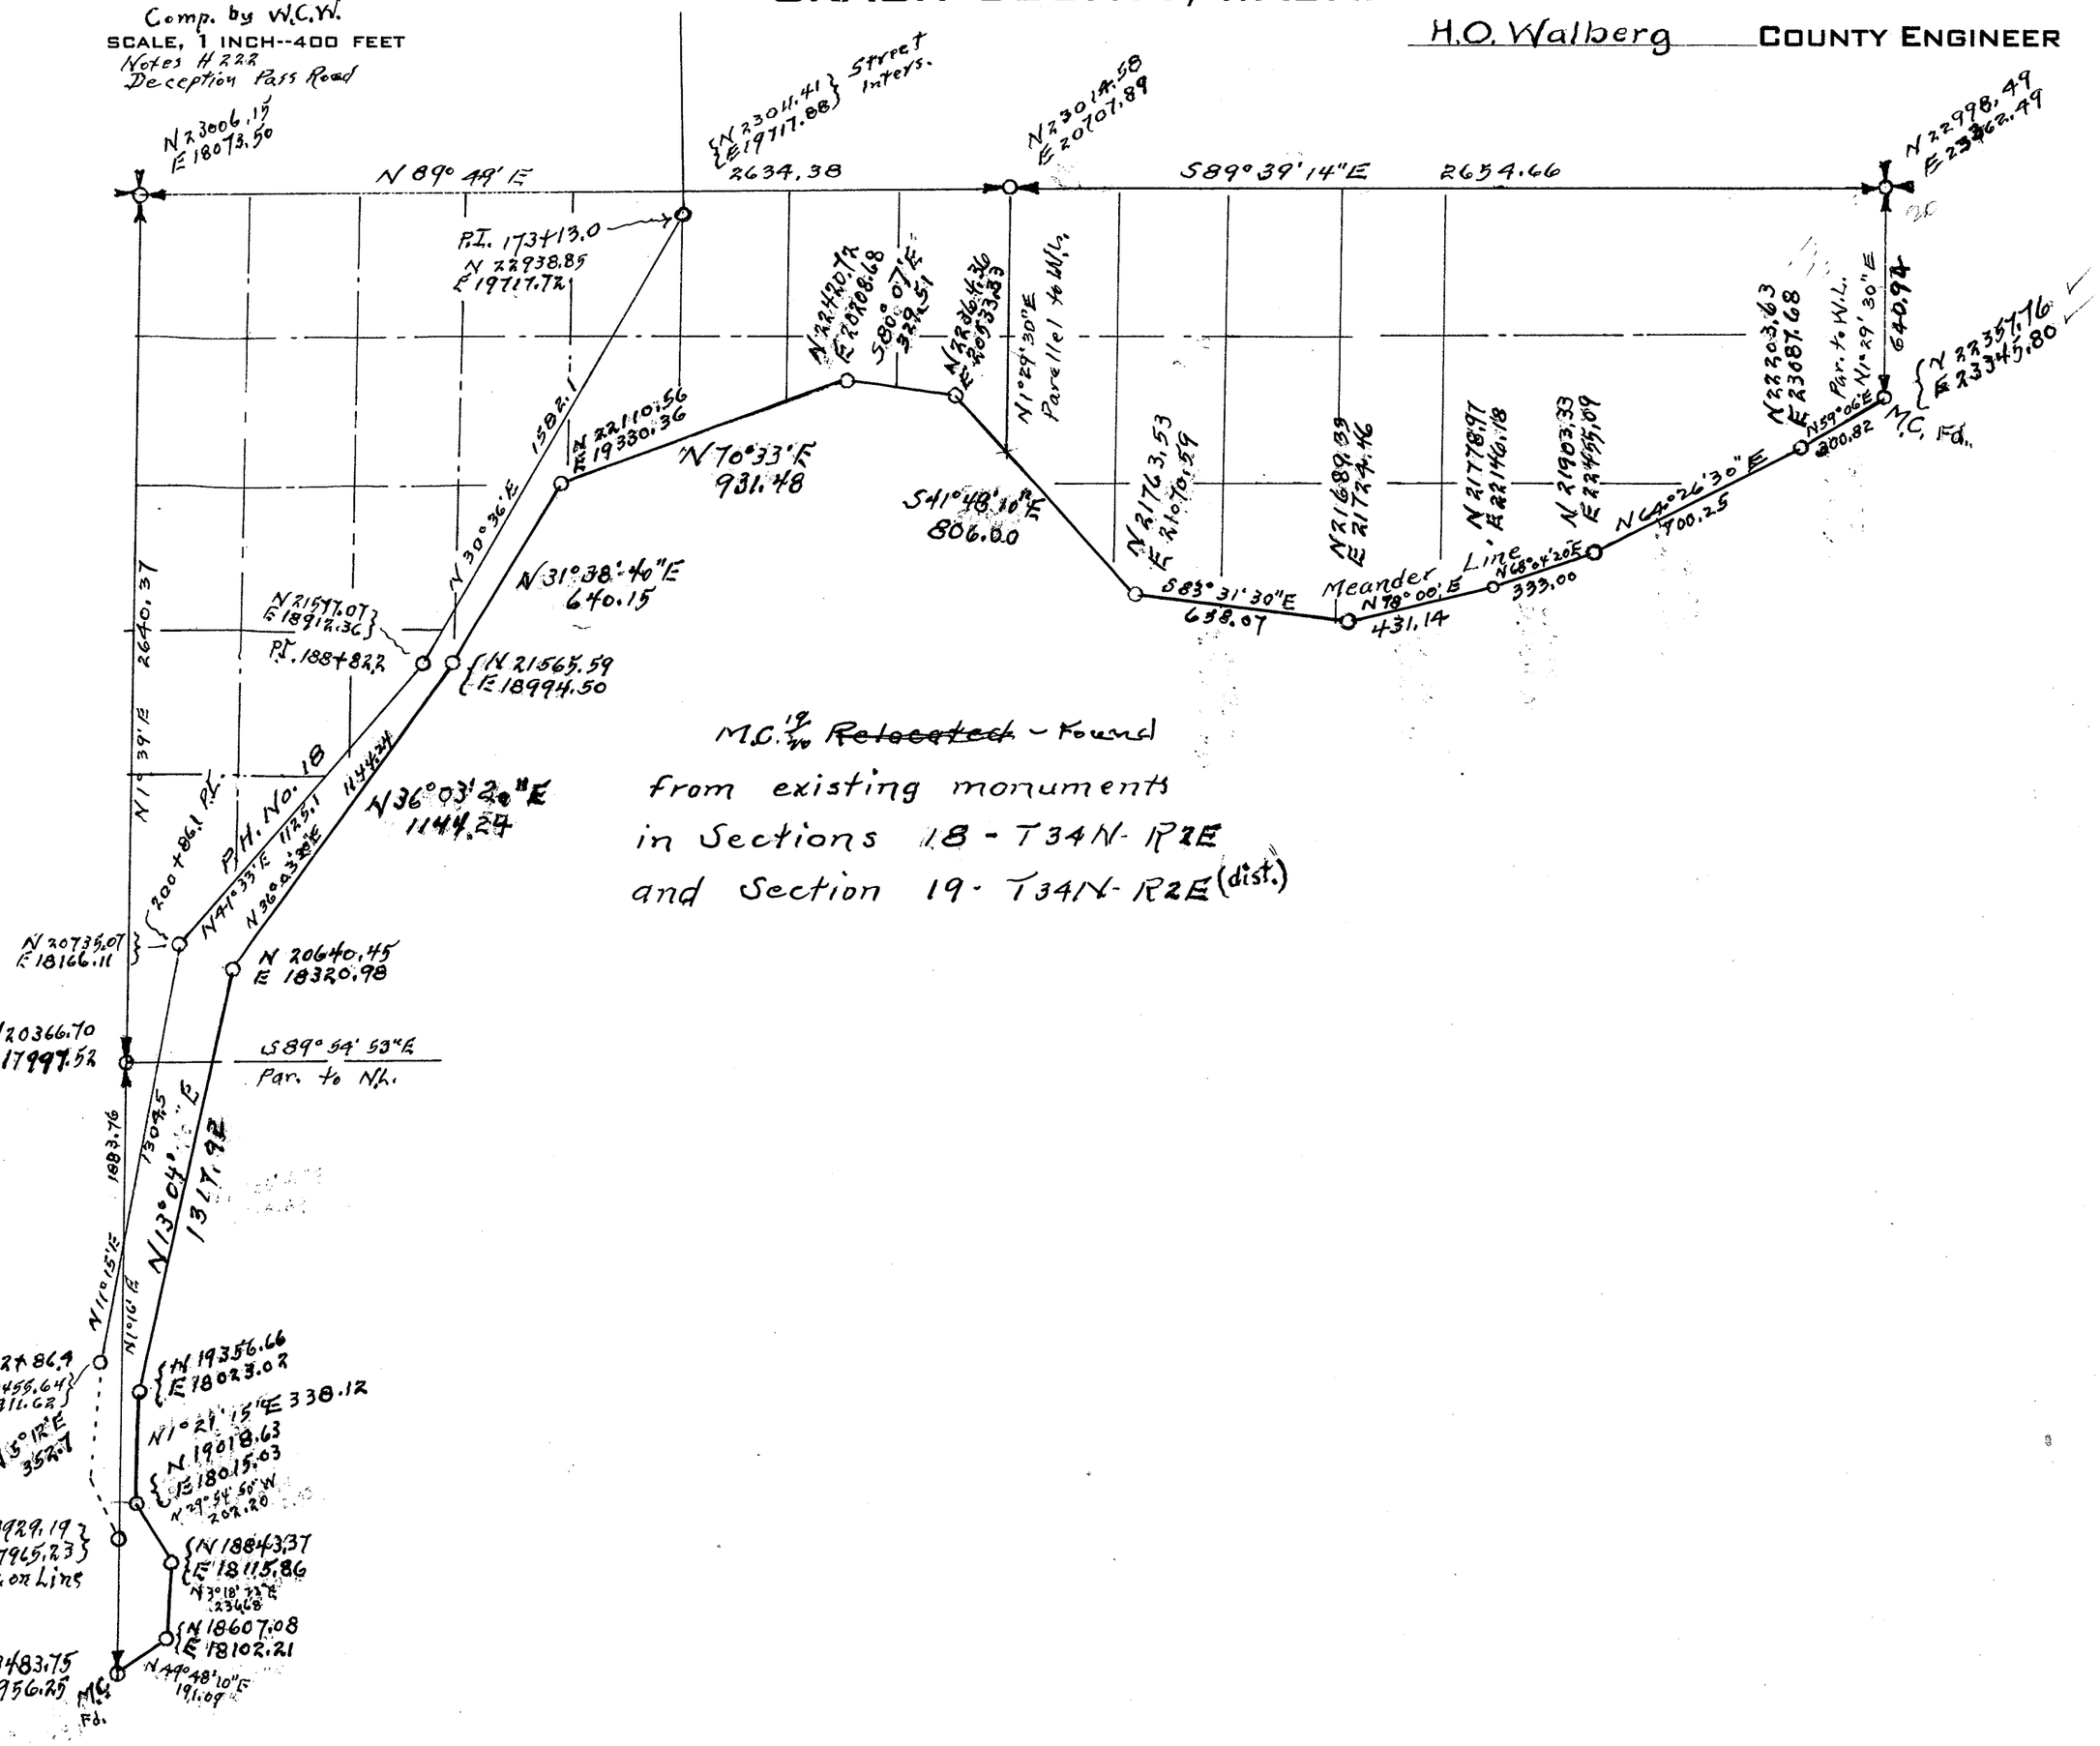

M.C. 19/20 ~~Relocated~~ - Found
from existing monuments
in Sections 18 - T34N - R2E
and Section 19 - T34N - R2E (dist.)

SECTION 19


TOWNSHIP 34 NORTH, RANGE 2 EAST, W. M.

SKAGIT COUNTY, WASH.

SCALE, 1 INCH--400 FEET

DATE June 22, 1966

Lloyd Johnson COUNTY ENGINEER

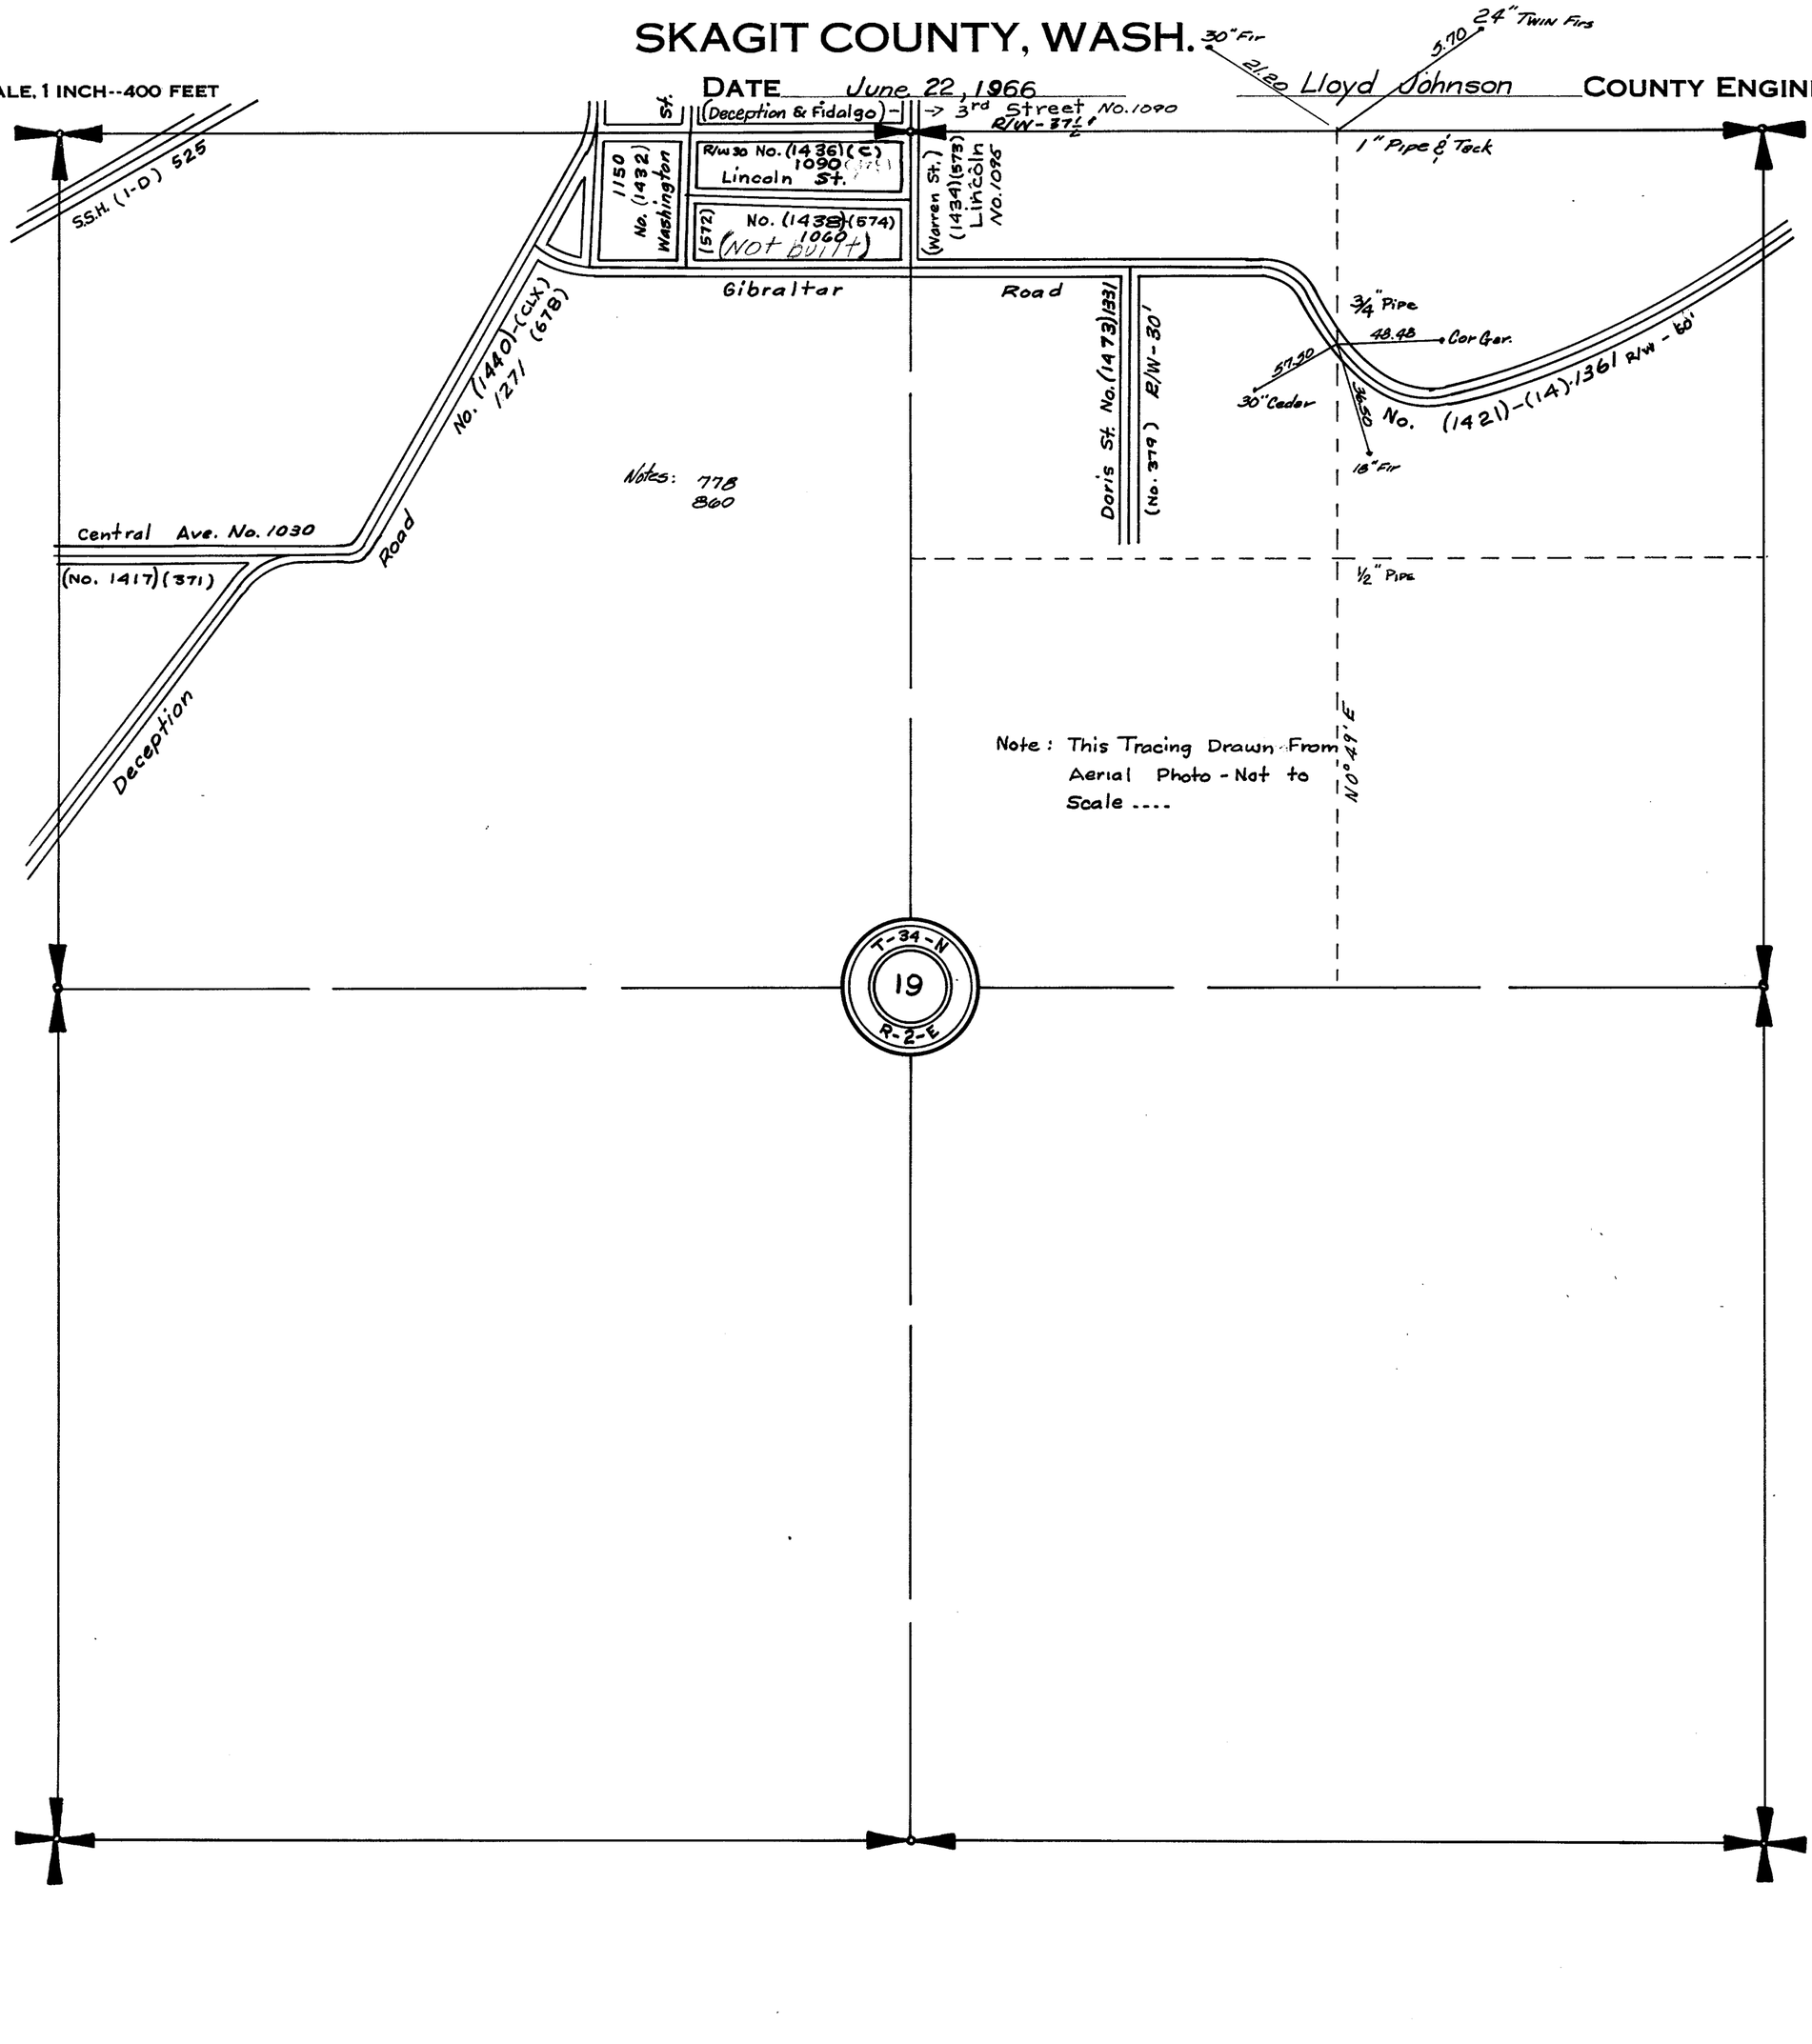


SECTION 22

TOWNSHIP 34 NORTH, RANGE 2 EAST, W. M.

SKAGIT COUNTY, WASH.

SCALE, 1 INCH--400 FEET

G. D. Le Gro COUNTY ENGINEER
August 1958

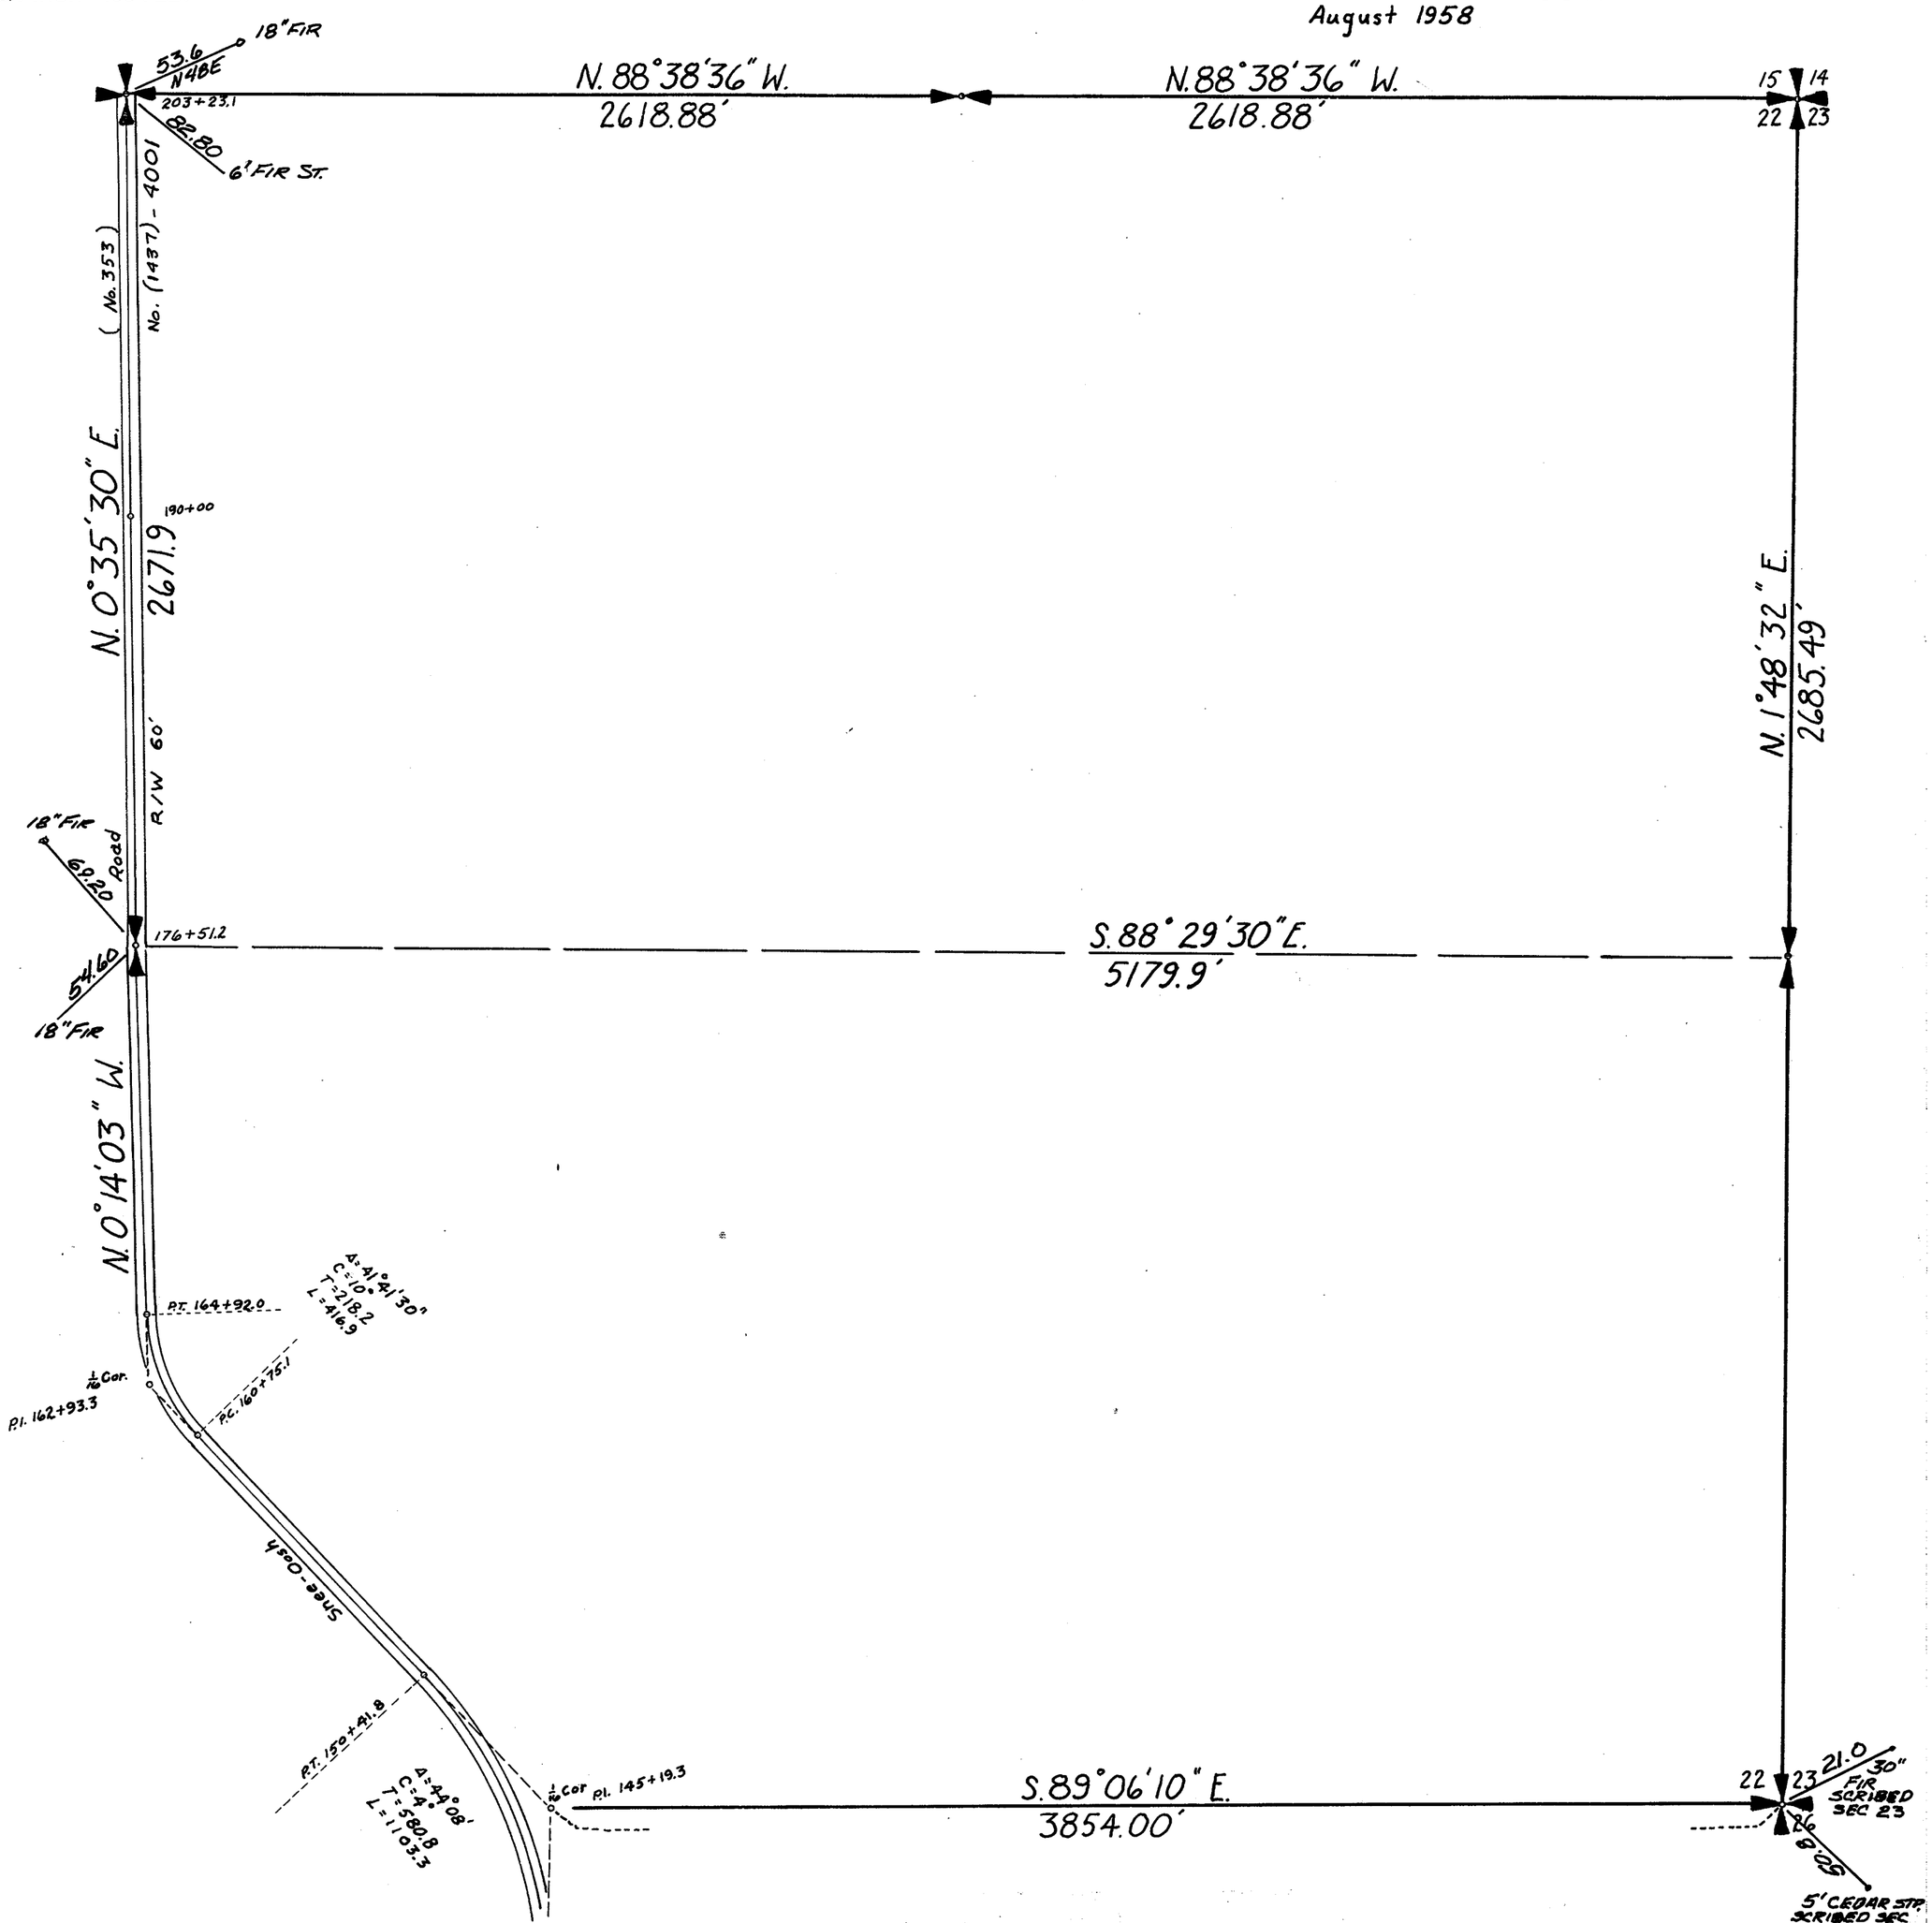

SECTION 23


TOWNSHIP 34 NORTH, RANGE 2 EAST, W. M.

SKAGIT COUNTY, WASH.

SCALE, 1 INCH--400 FEET

DATE 3 Sept 1968

Lloyd H. Johnson COUNTY ENGINEER

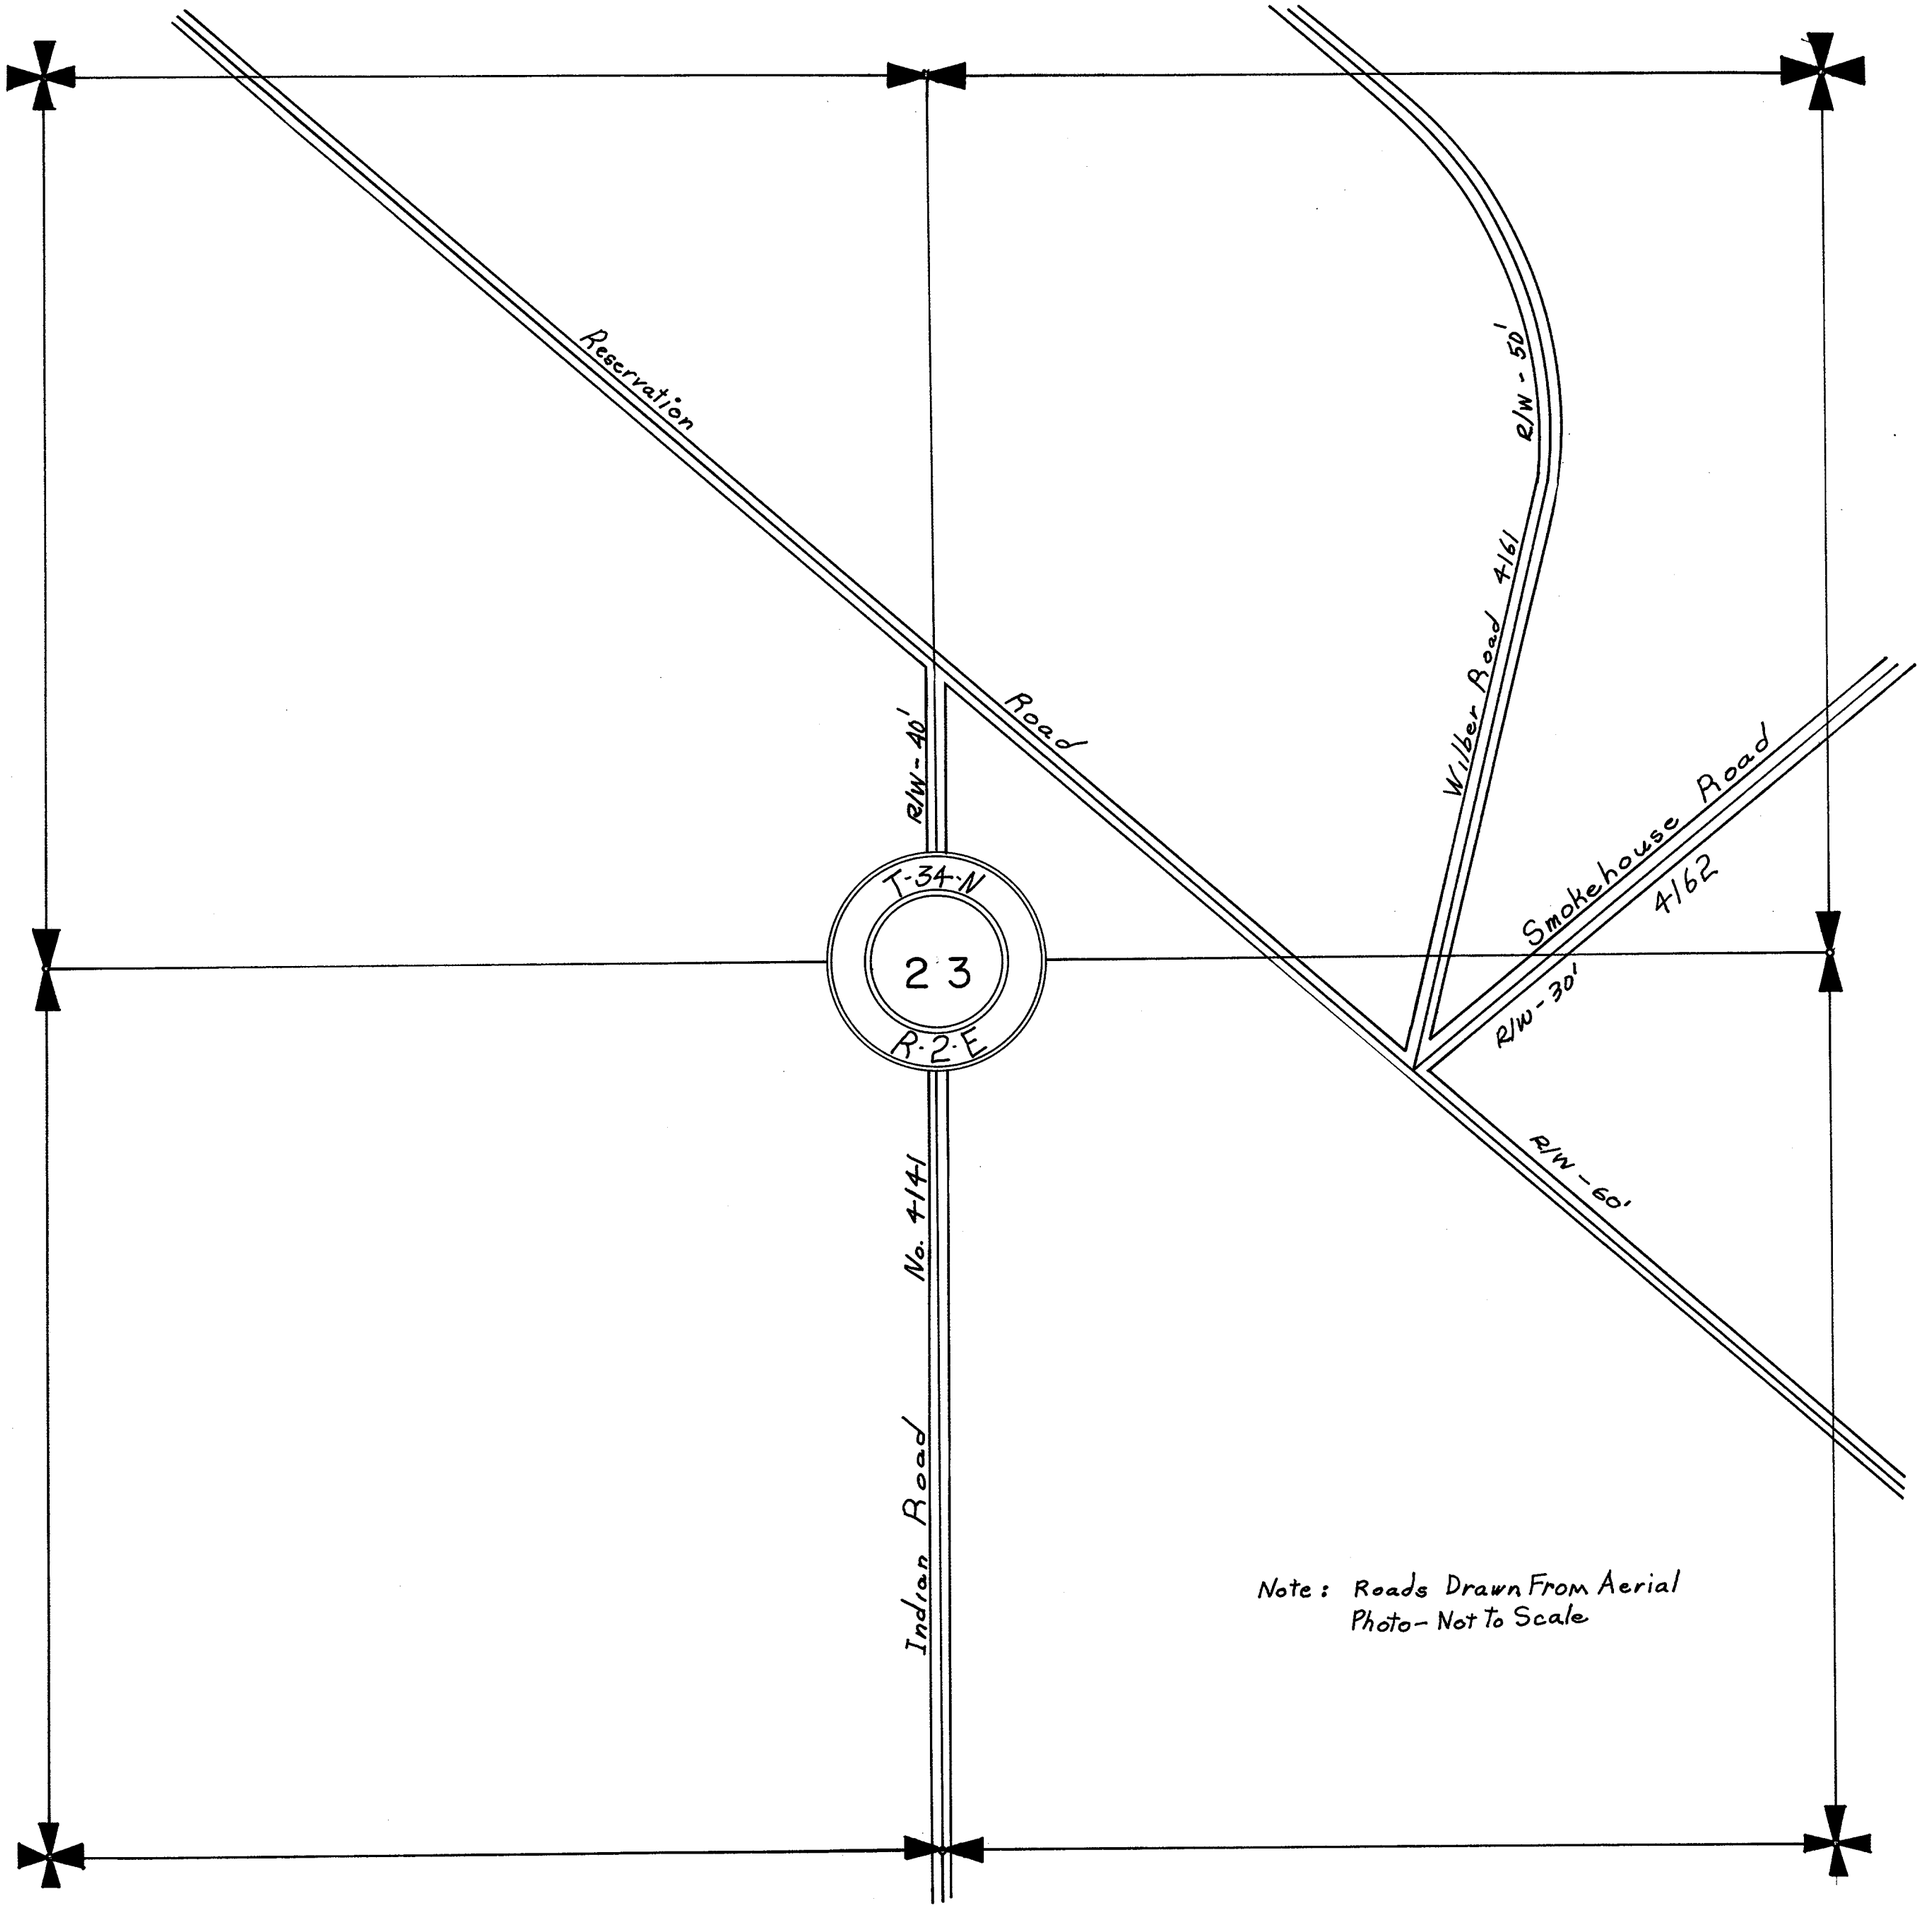


Note: Roads Drawn From Aerial Photo- Not To Scale

SECTION 23
TOWNSHIP 34 NORTH, RANGE 2 EAST, W. M.
SKAGIT COUNTY, WASH.

SCALE, 1 INCH--400 FEET

G. D. Le Gro COUNTY ENGINEER
August 1958

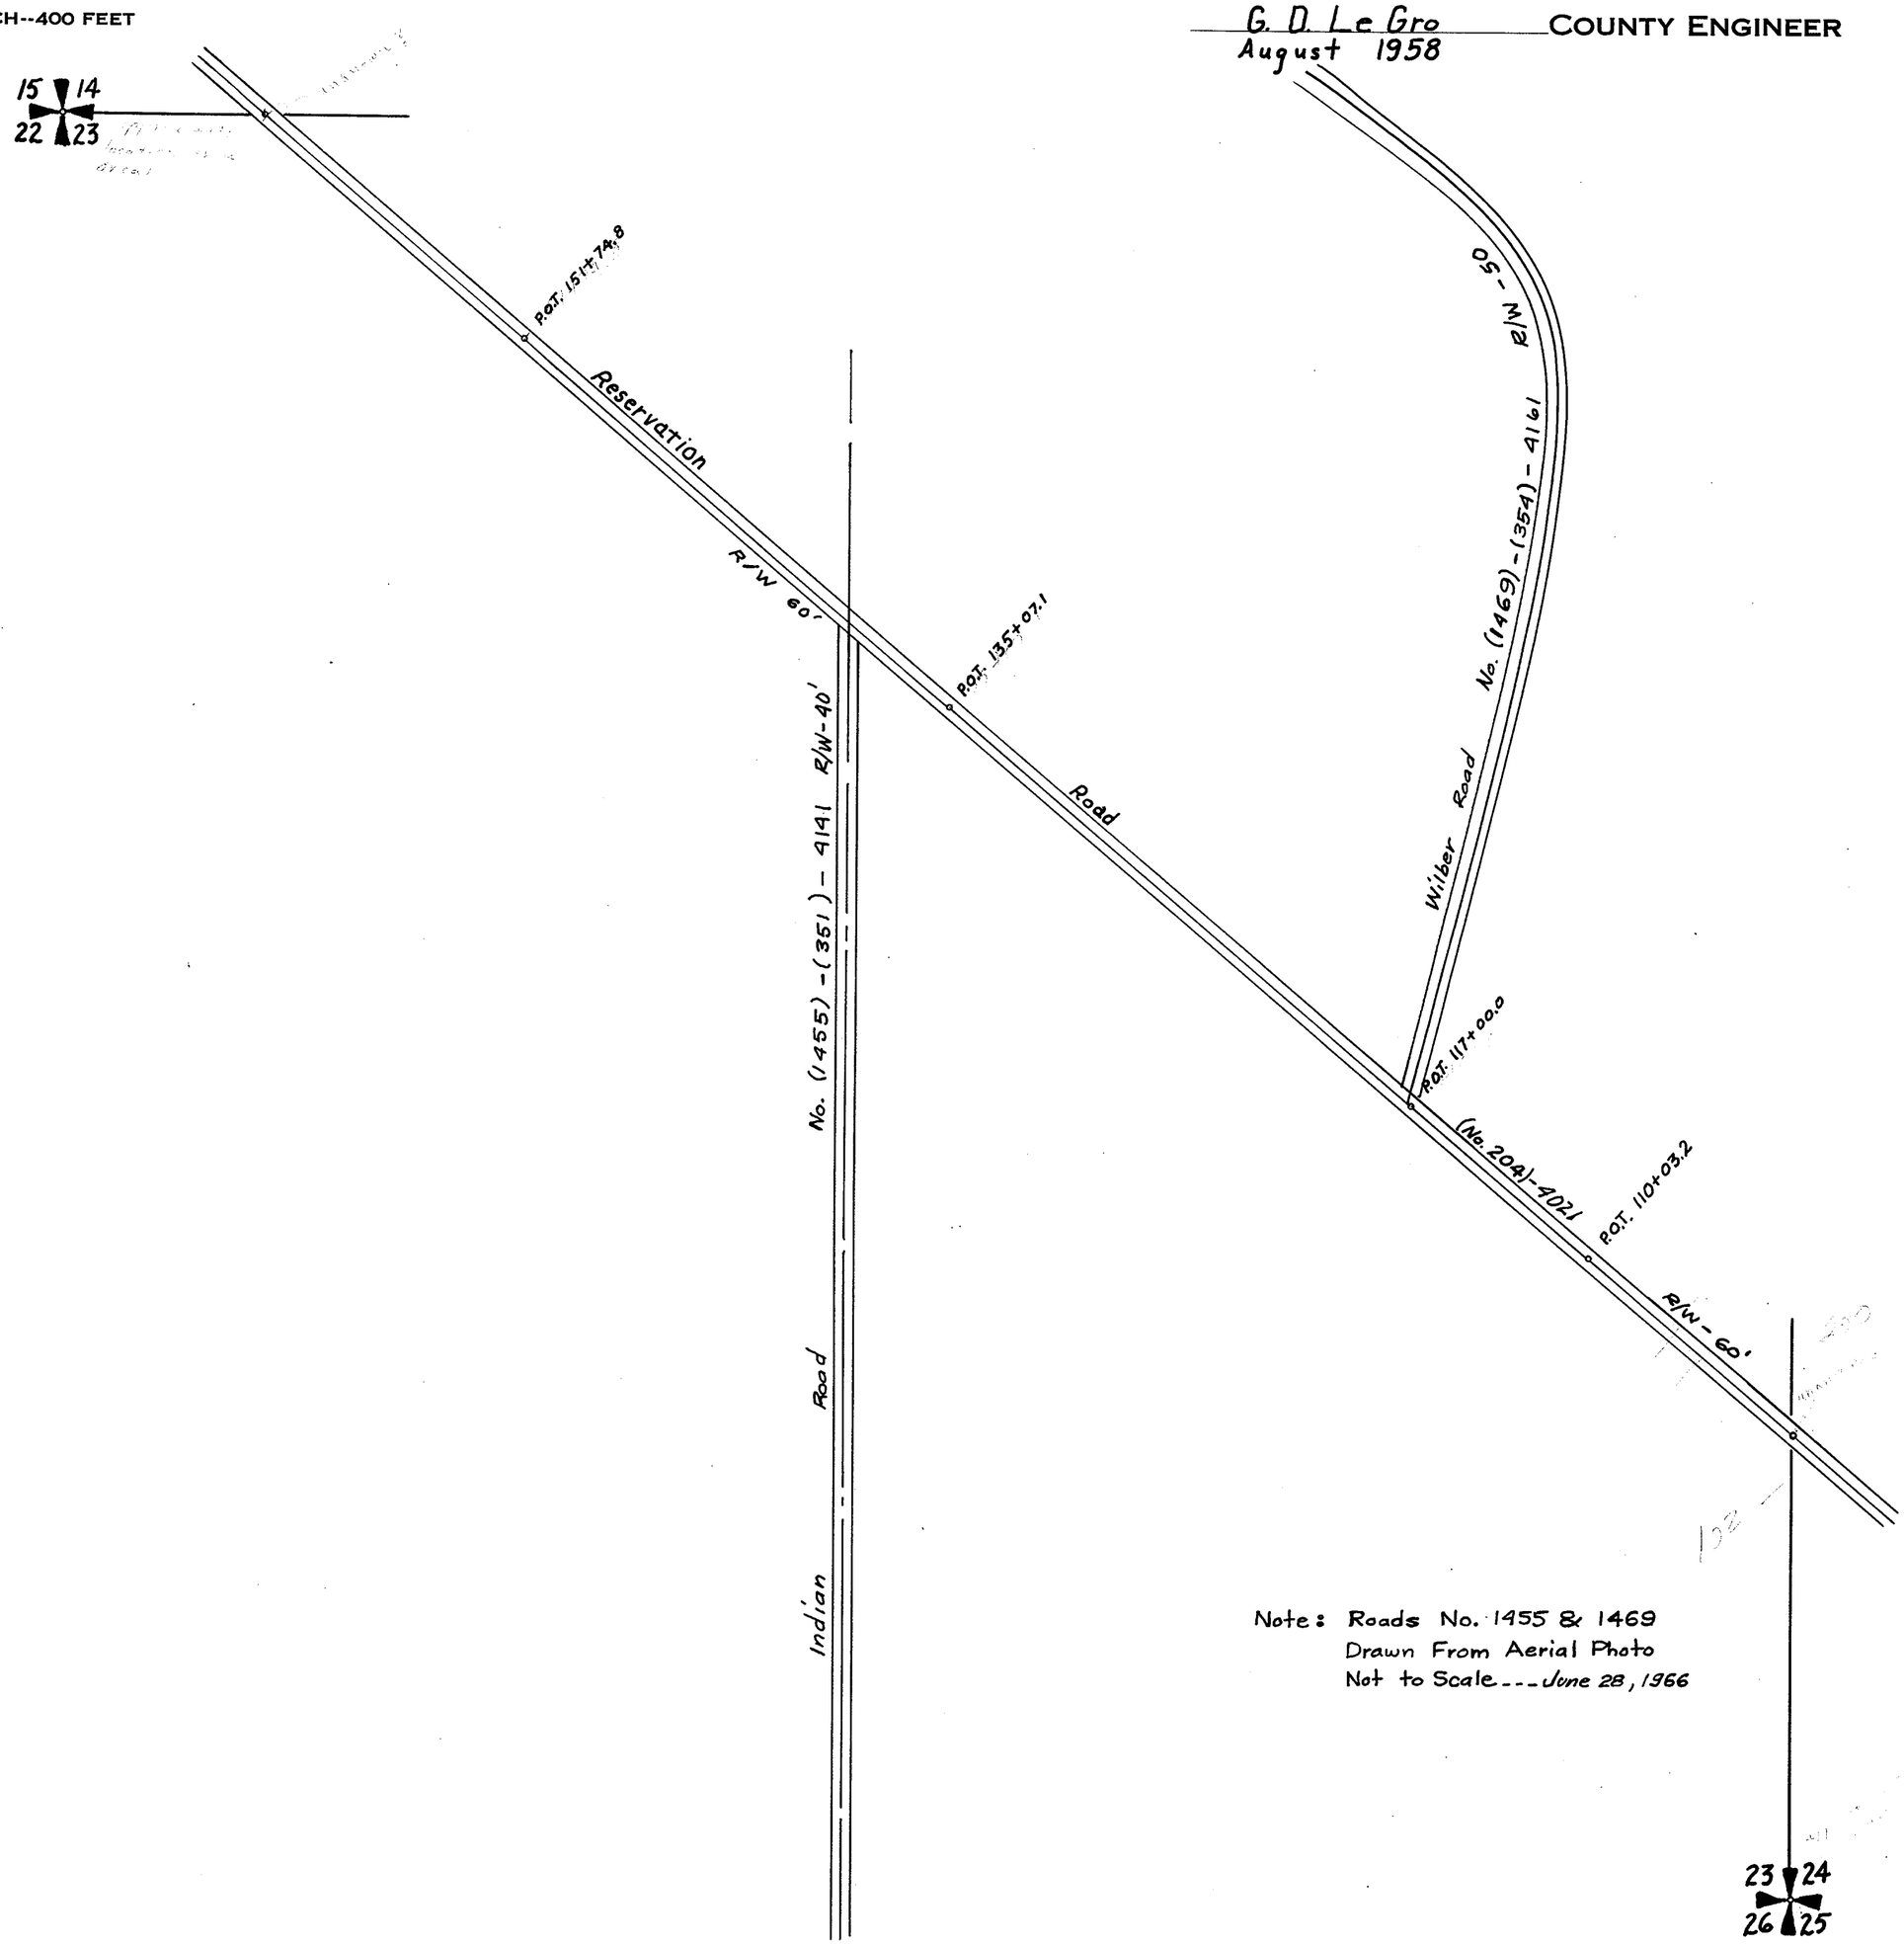

Note: Roads No. 1455 & 1469
Drawn From Aerial Photo
Not to Scale---June 28, 1966

SECTION 24

TOWNSHIP 34 NORTH, RANGE 2 EAST, W. M.


SKAGIT COUNTY, WASH.

SCALE, 1 INCH--400 FEET

G. D. LeGro
August 1958
COUNTY ENGINEER

Downey Road No. (1442)-(15) - 4380

R/W - 35'

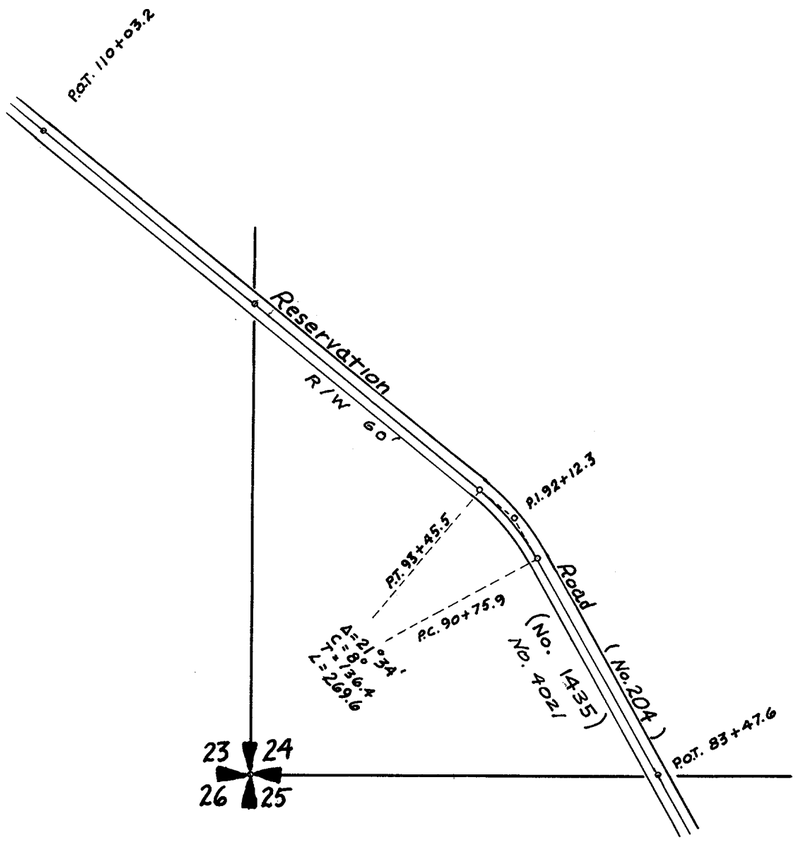

1 PLAT OF SKAGIT BEACH #2
A REPLAT OF TRACT "D" OF SKAGIT BEACH #1
VOL-9 pg 25
2 PLAT OF SKAGIT BEACH #3 VOL 9 Pg 26


SECTION 24

TOWNSHIP 34 NORTH, RANGE 2 EAST, W. M.

SKAGIT COUNTY, WASH.

SCALE, 1 INCH -- 400 FEET

DATE 3 Sept 1968 Lloyd H Johnson COUNTY ENGINEER

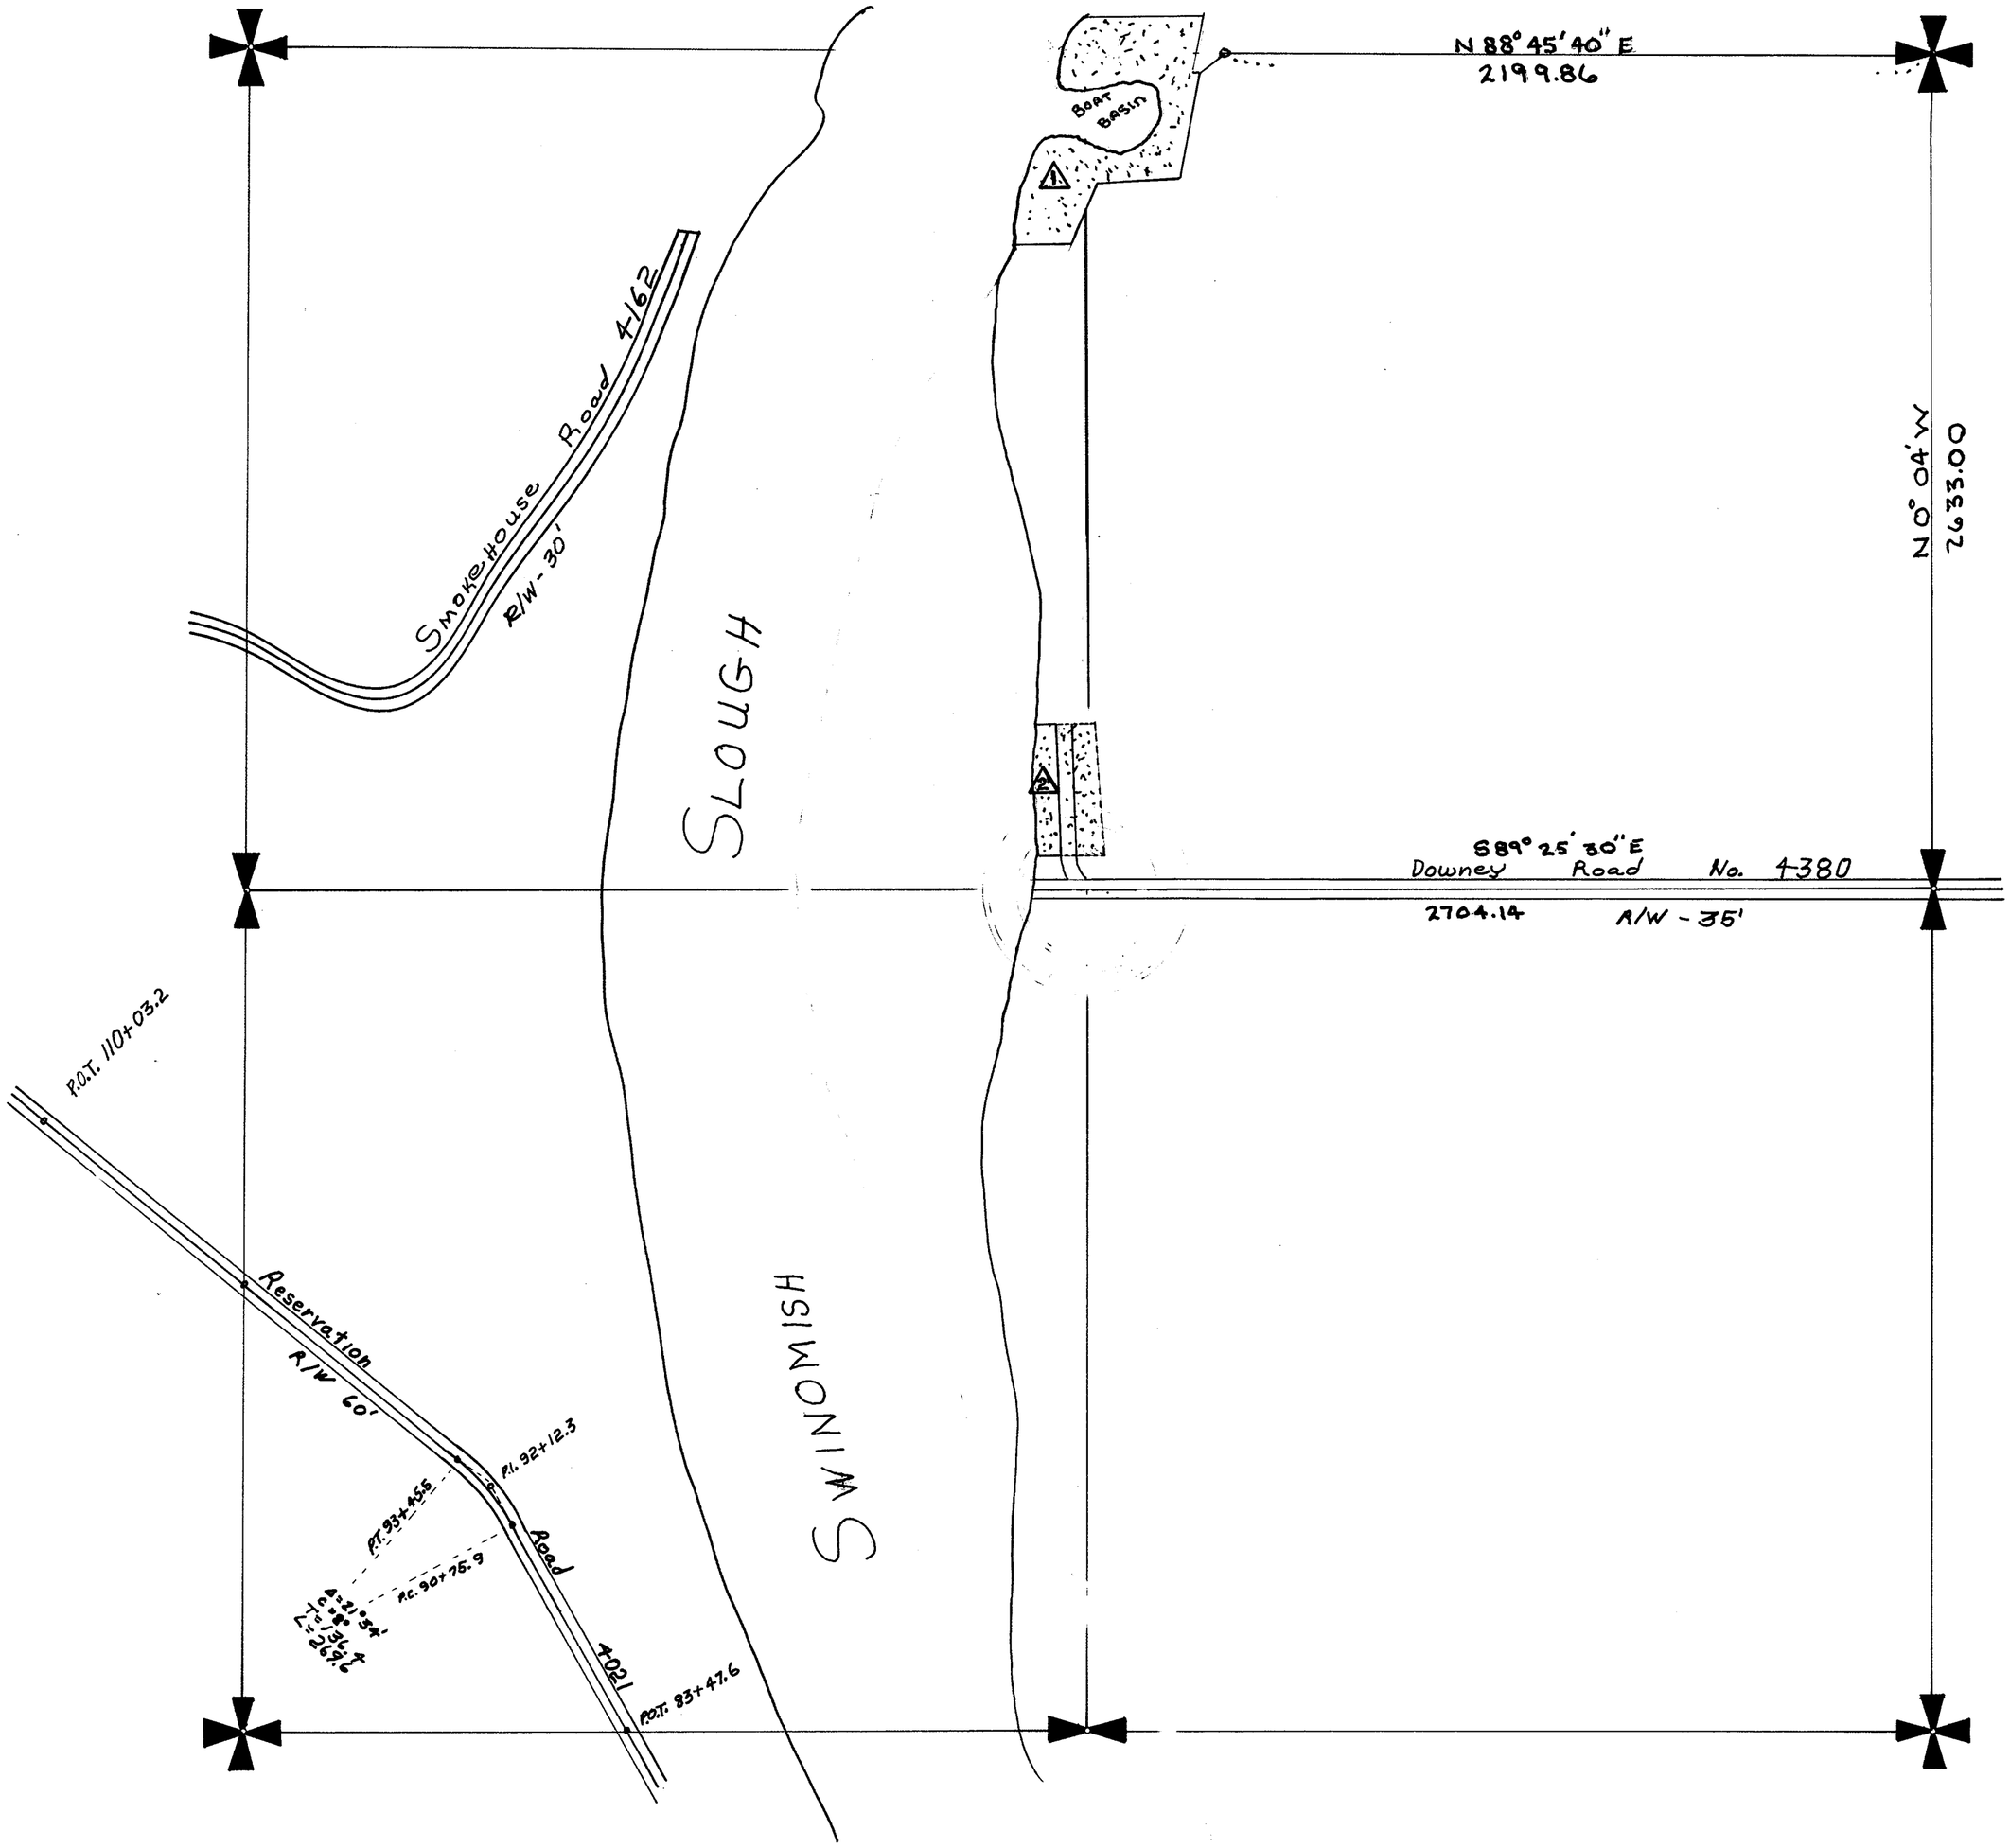


SECTION 25

TOWNSHIP 34 NORTH, RANGE 2 EAST, W. M.

SKAGIT COUNTY, WASH.

SCALE, 1 INCH--400 FEET

G. D. LeGro
August 1958
COUNTY ENGINEER

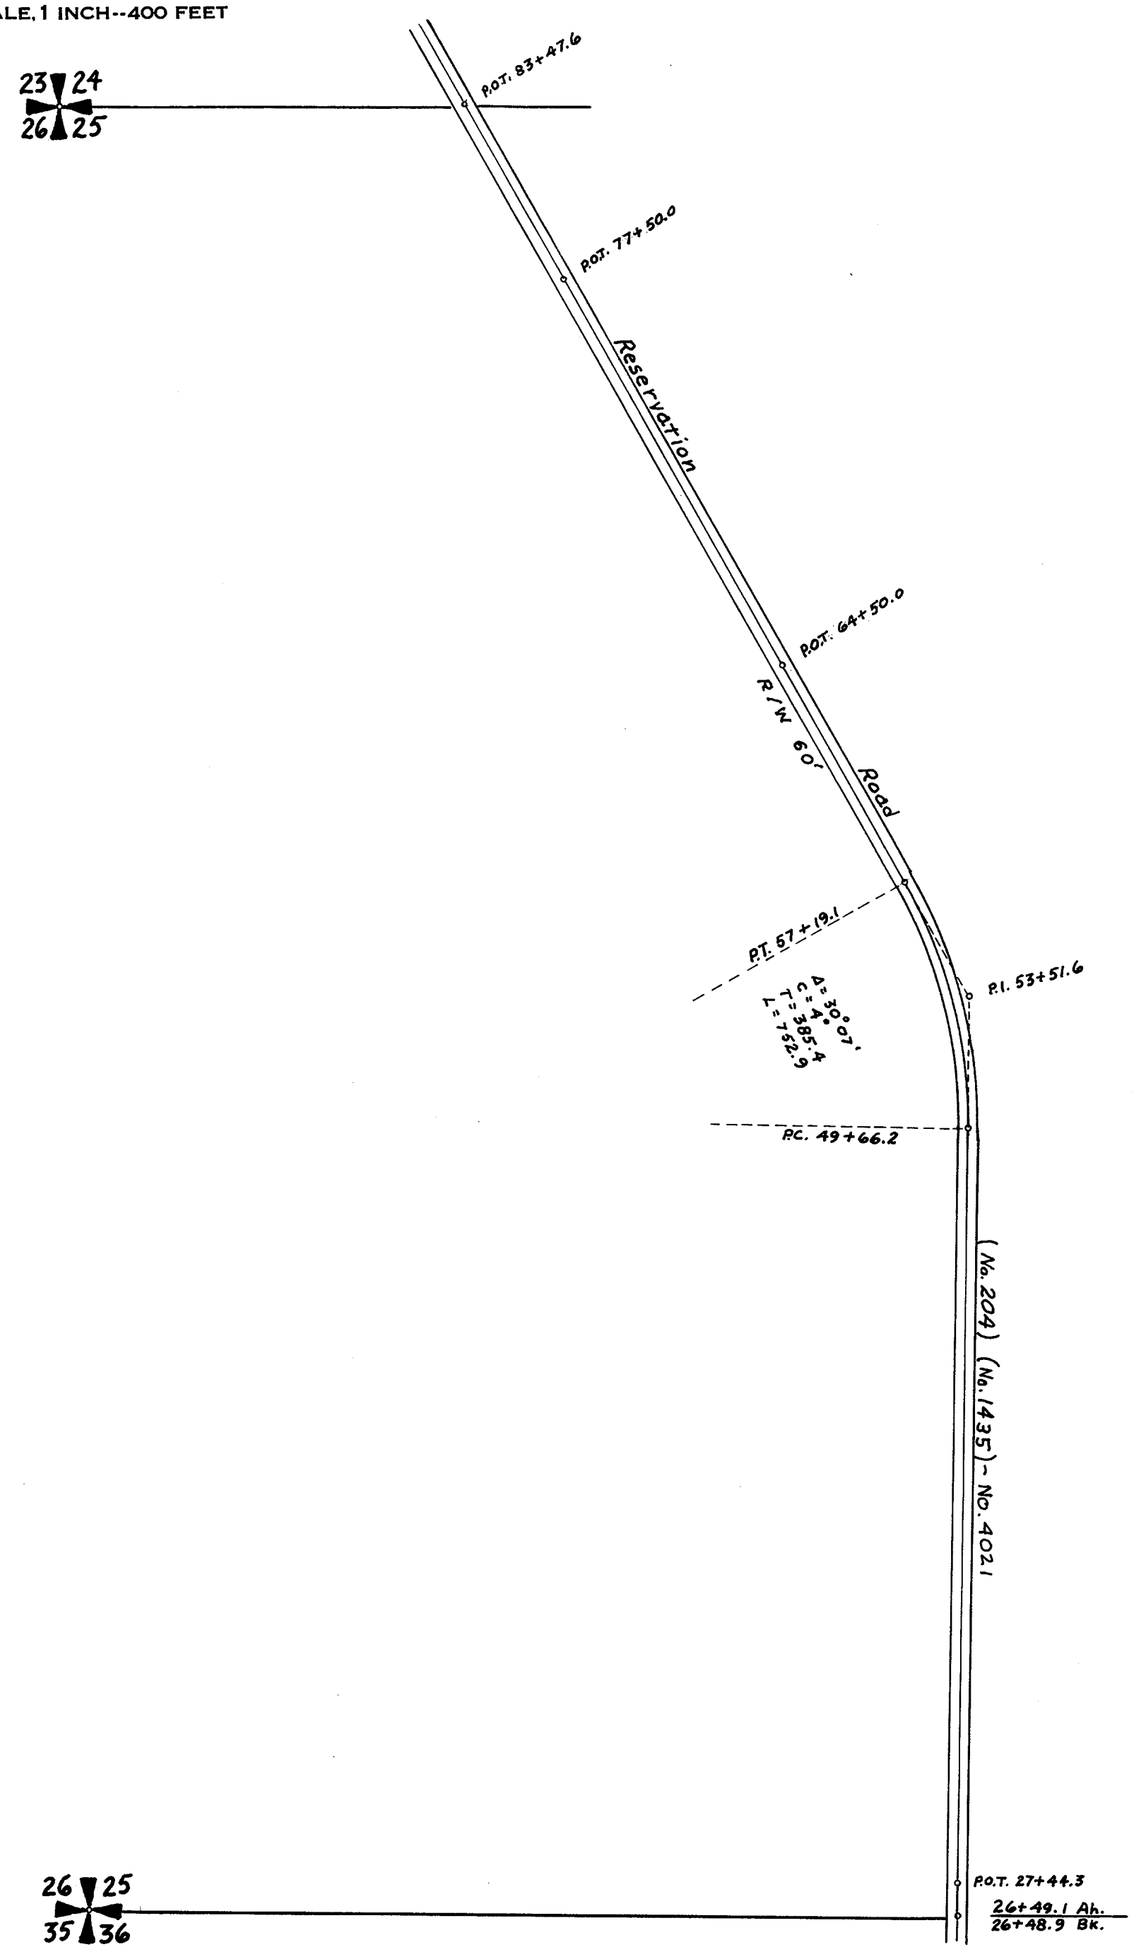

SECTION 26


TOWNSHIP 34 NORTH, RANGE 2 EAST, W. M.

SKAGIT COUNTY, WASH.

SCALE, 1 INCH--400 FEET

DATE June 28, 1966

Lloyd Johnson COUNTY ENGINEER

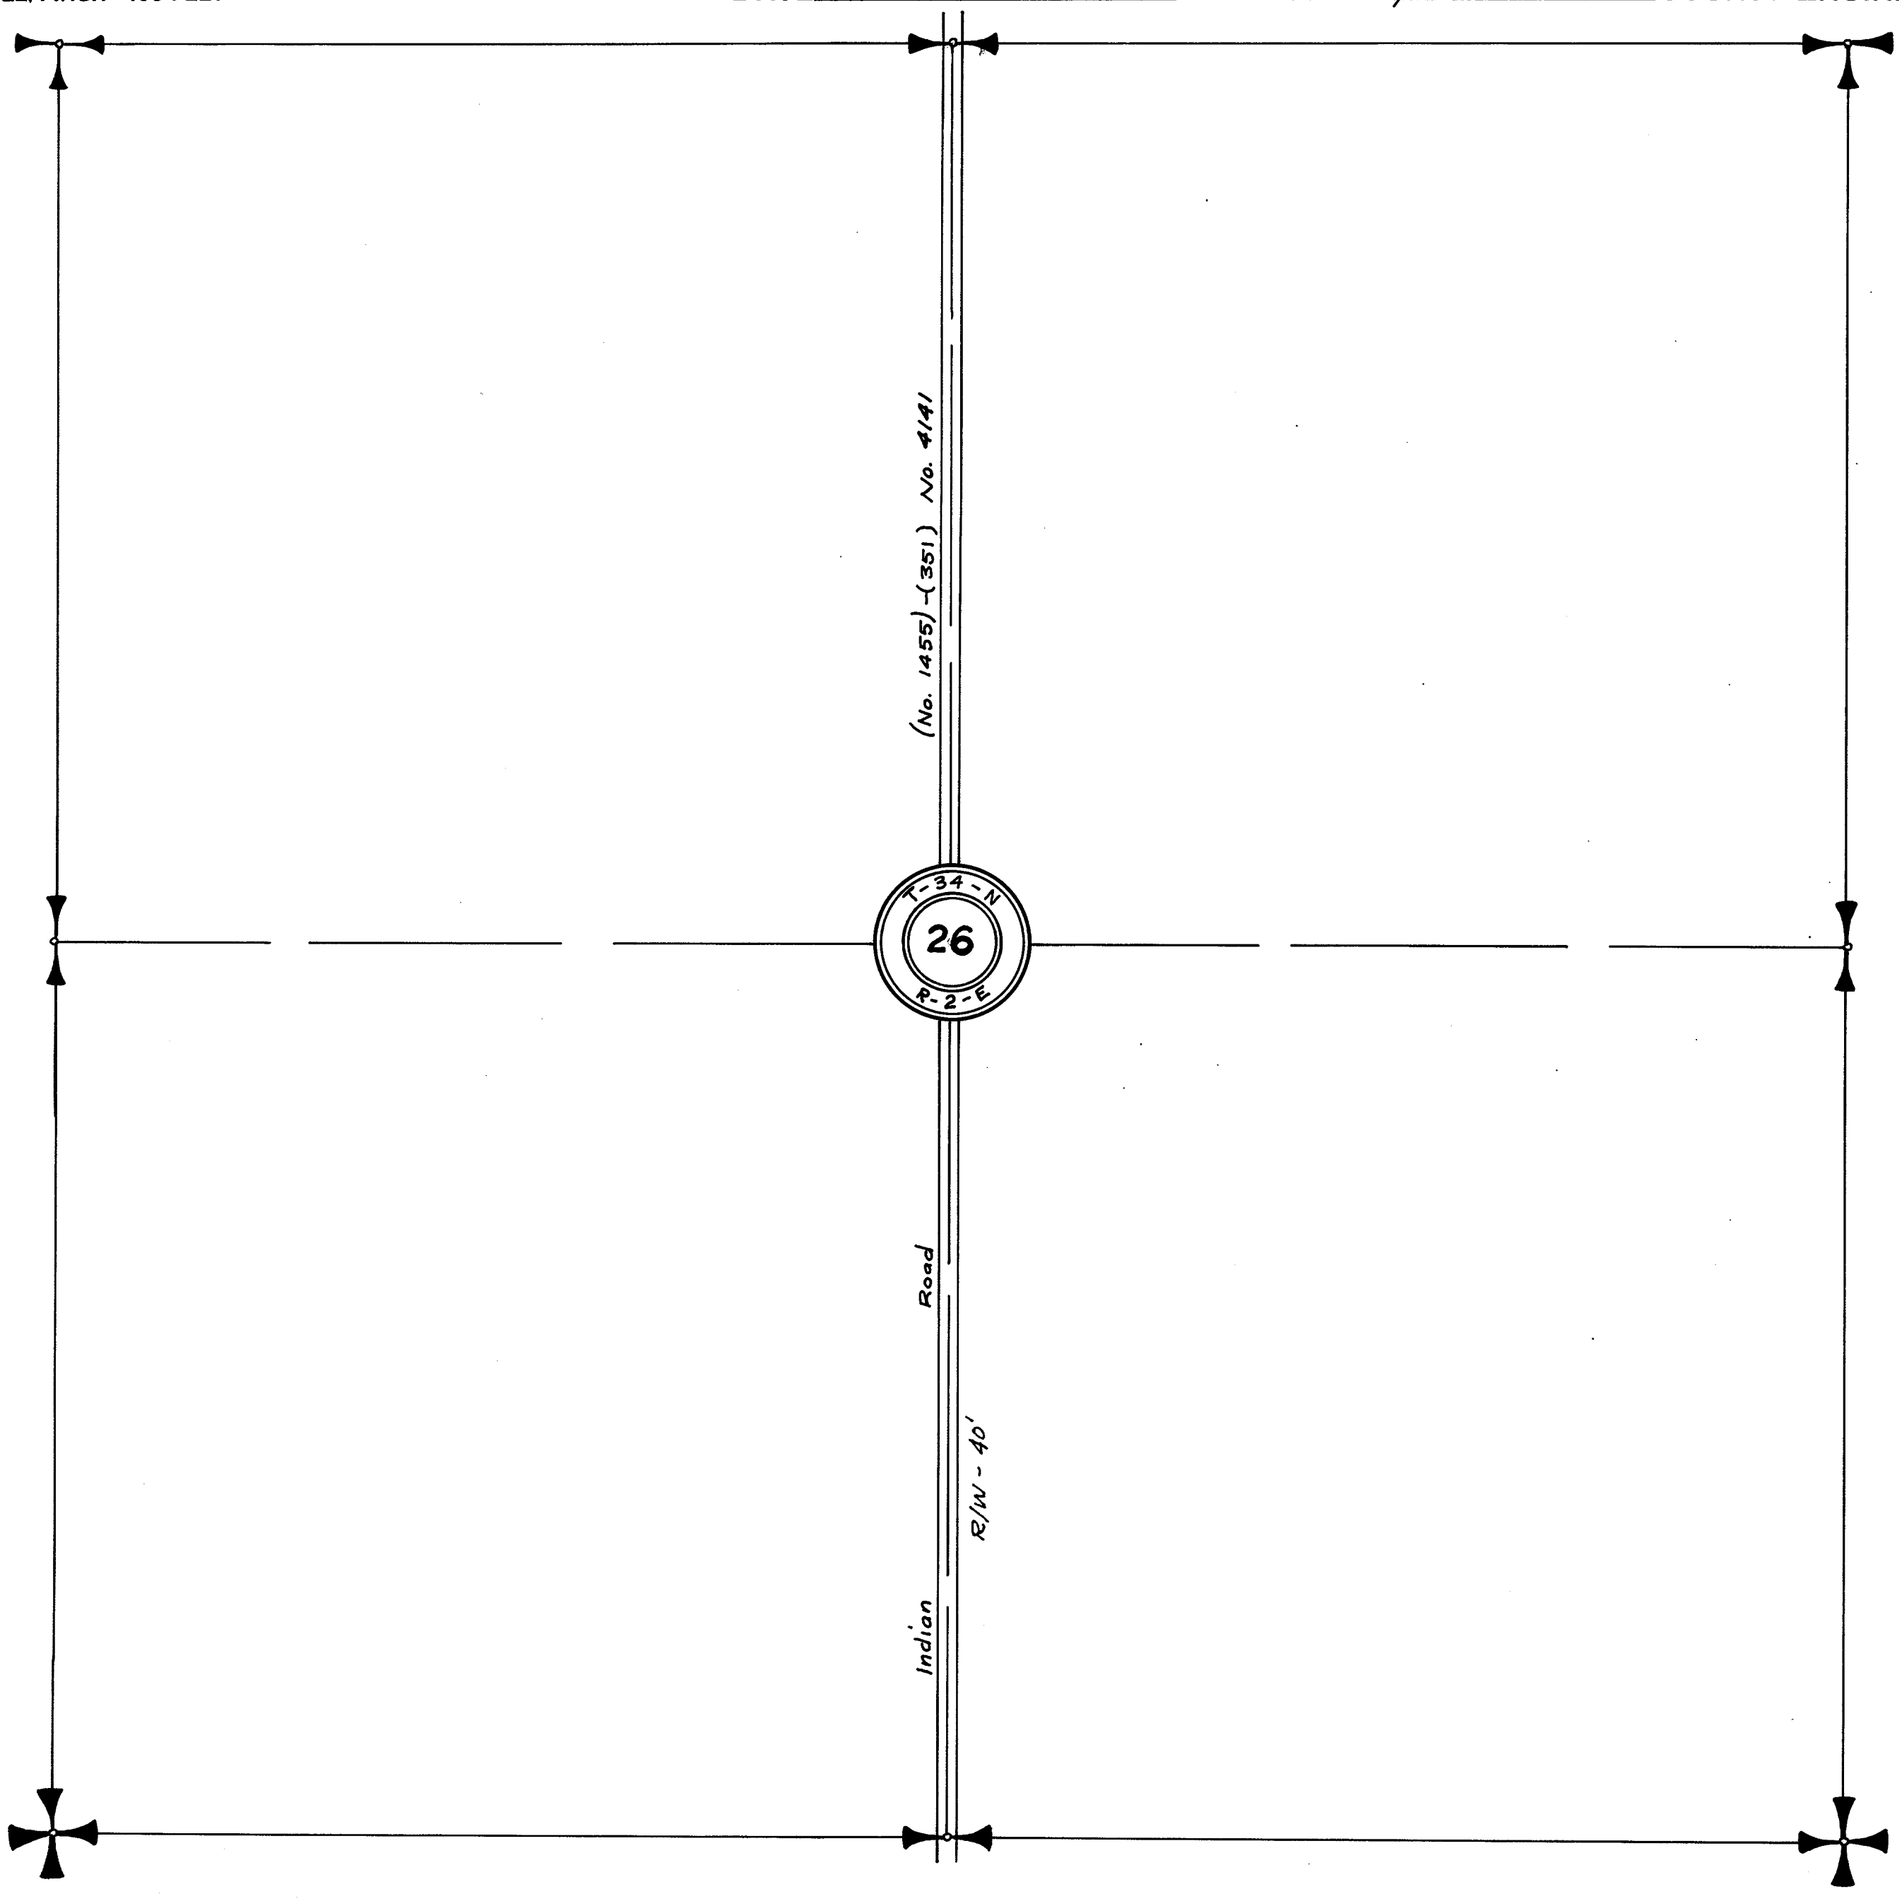

SECTION 27


TOWNSHIP 34 NORTH, RANGE 2 EAST, W. M.

SKAGIT COUNTY, WASH.

SCALE, 1 INCH -- 400 FEET

DATE 3 Sept 1968

Lloyd H. Johnson COUNTY ENGINEER

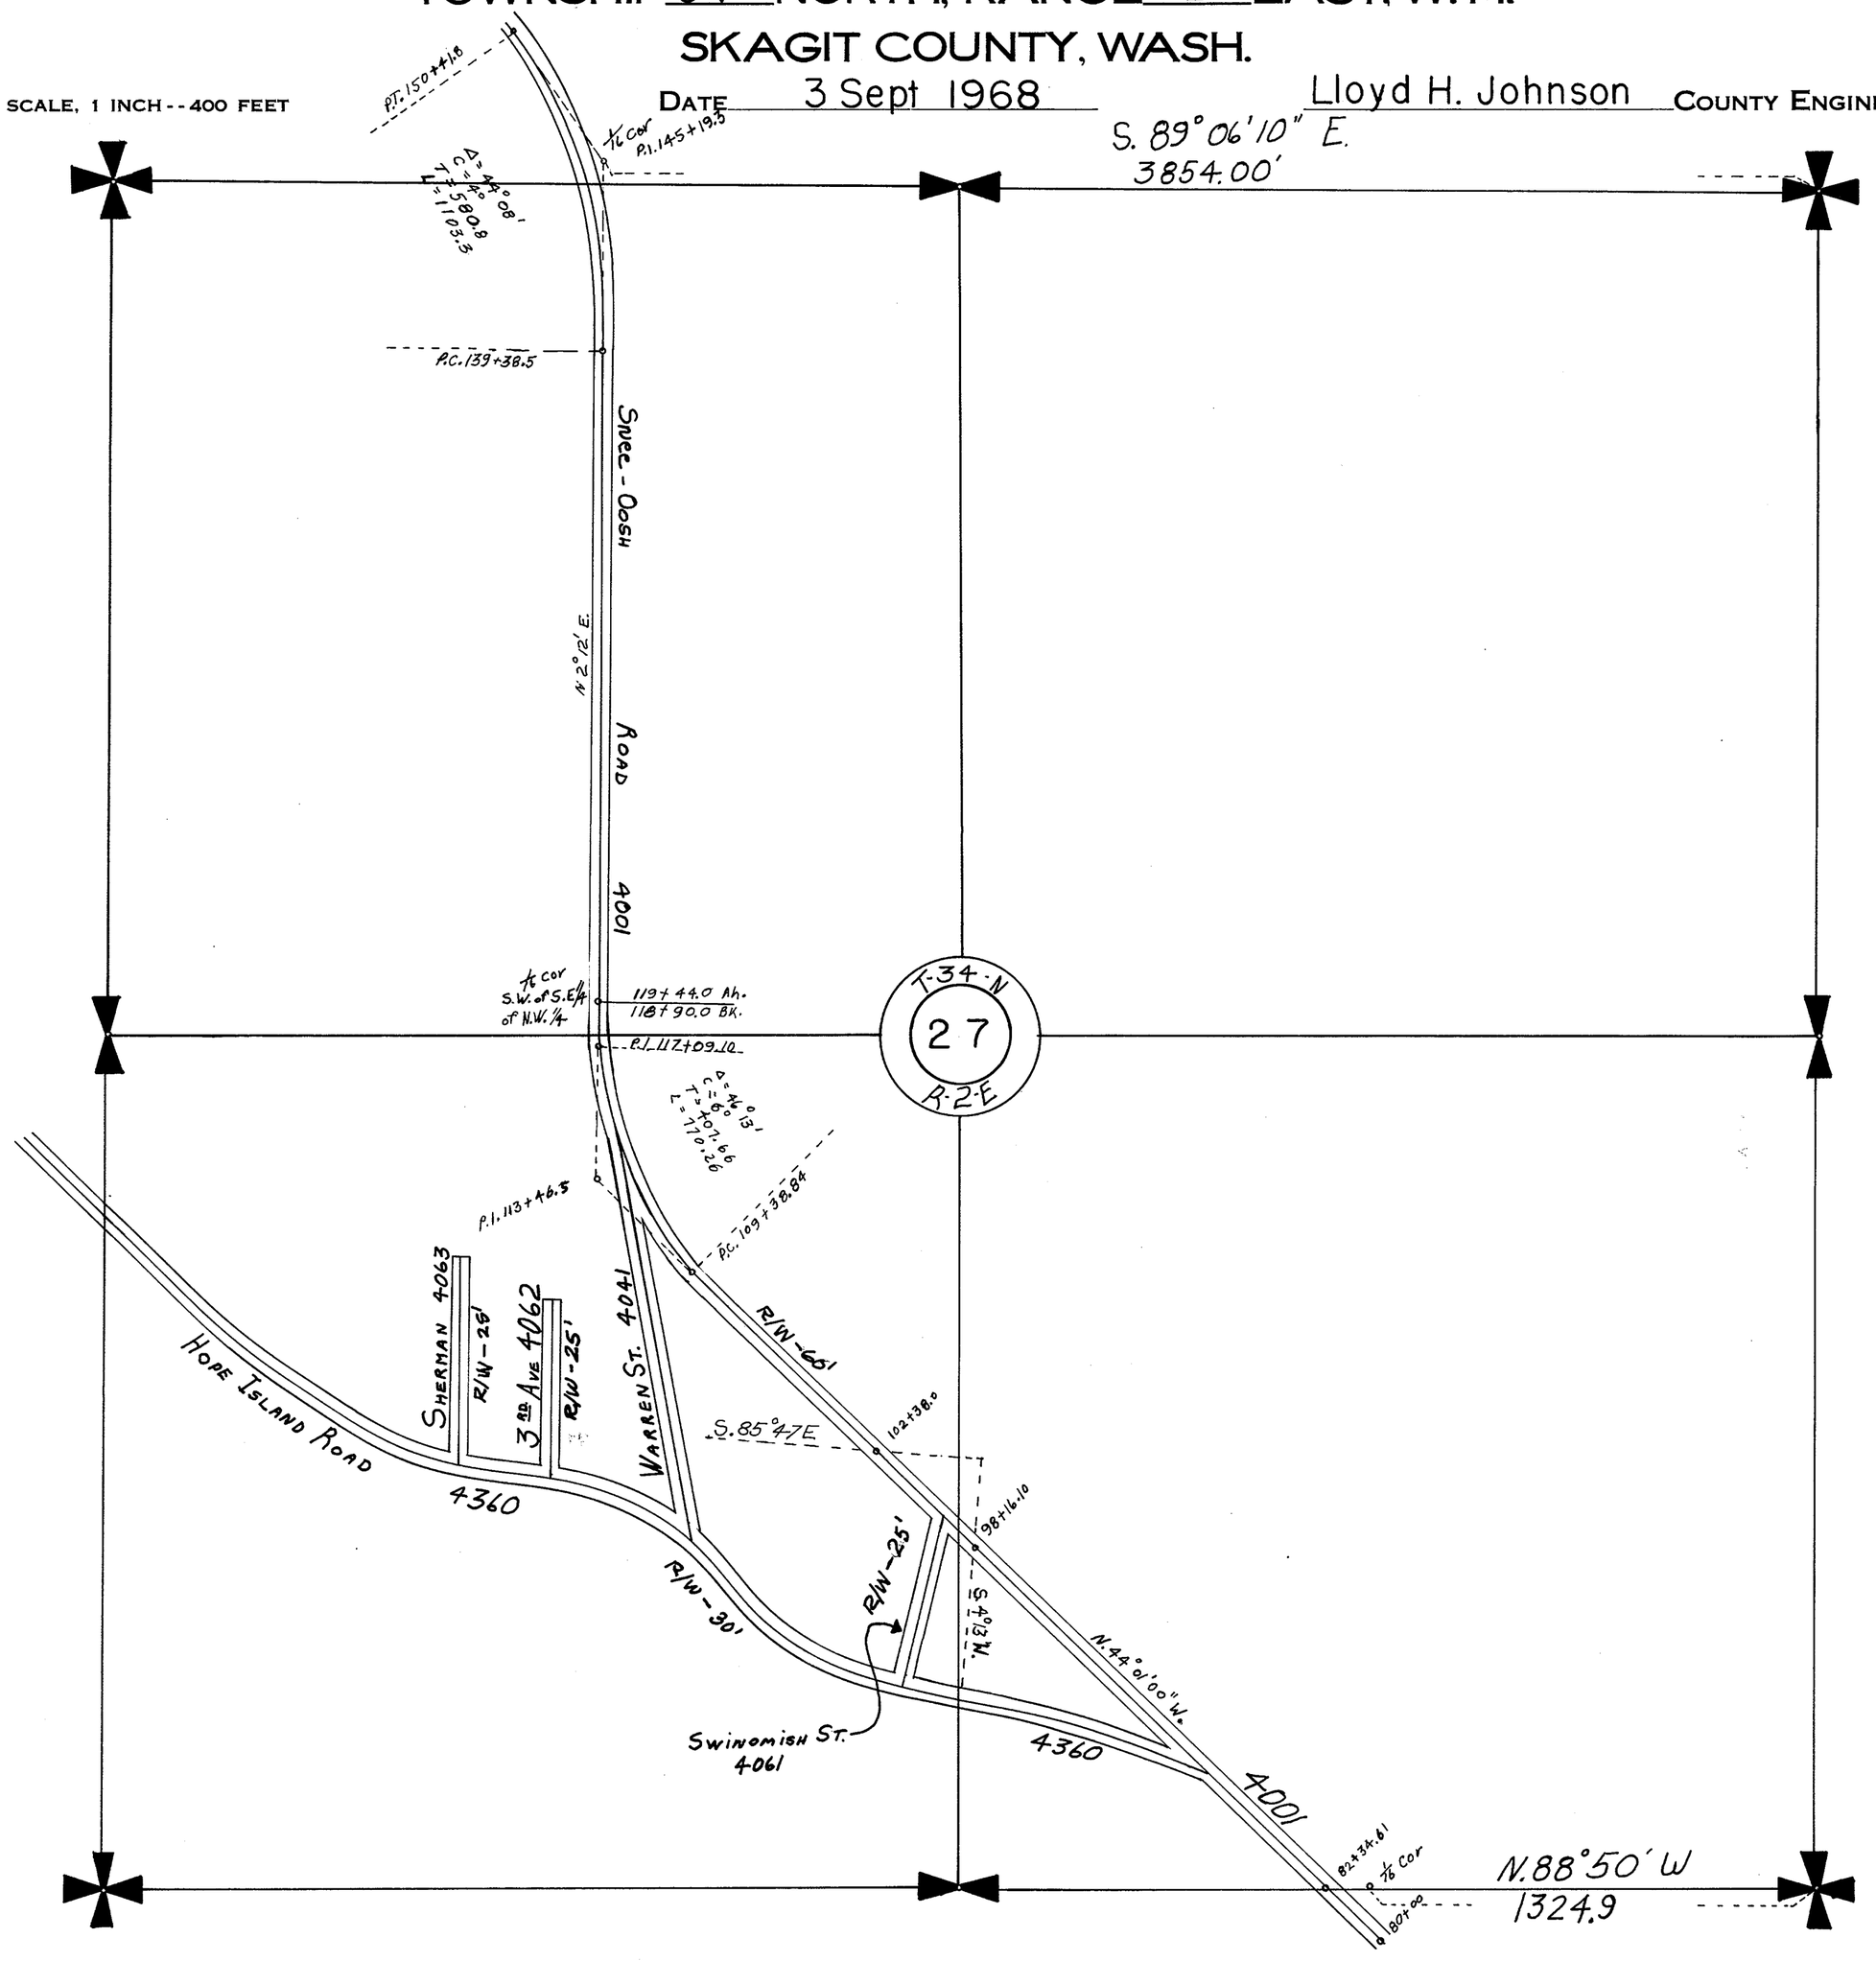


SECTION 27

TOWNSHIP 34 NORTH, RANGE 2 EAST, W. M.

SKAGIT COUNTY, WASH.

SCALE, 1 INCH--400 FEET

G. D. Le Gro COUNTY ENGINEER
August 1958

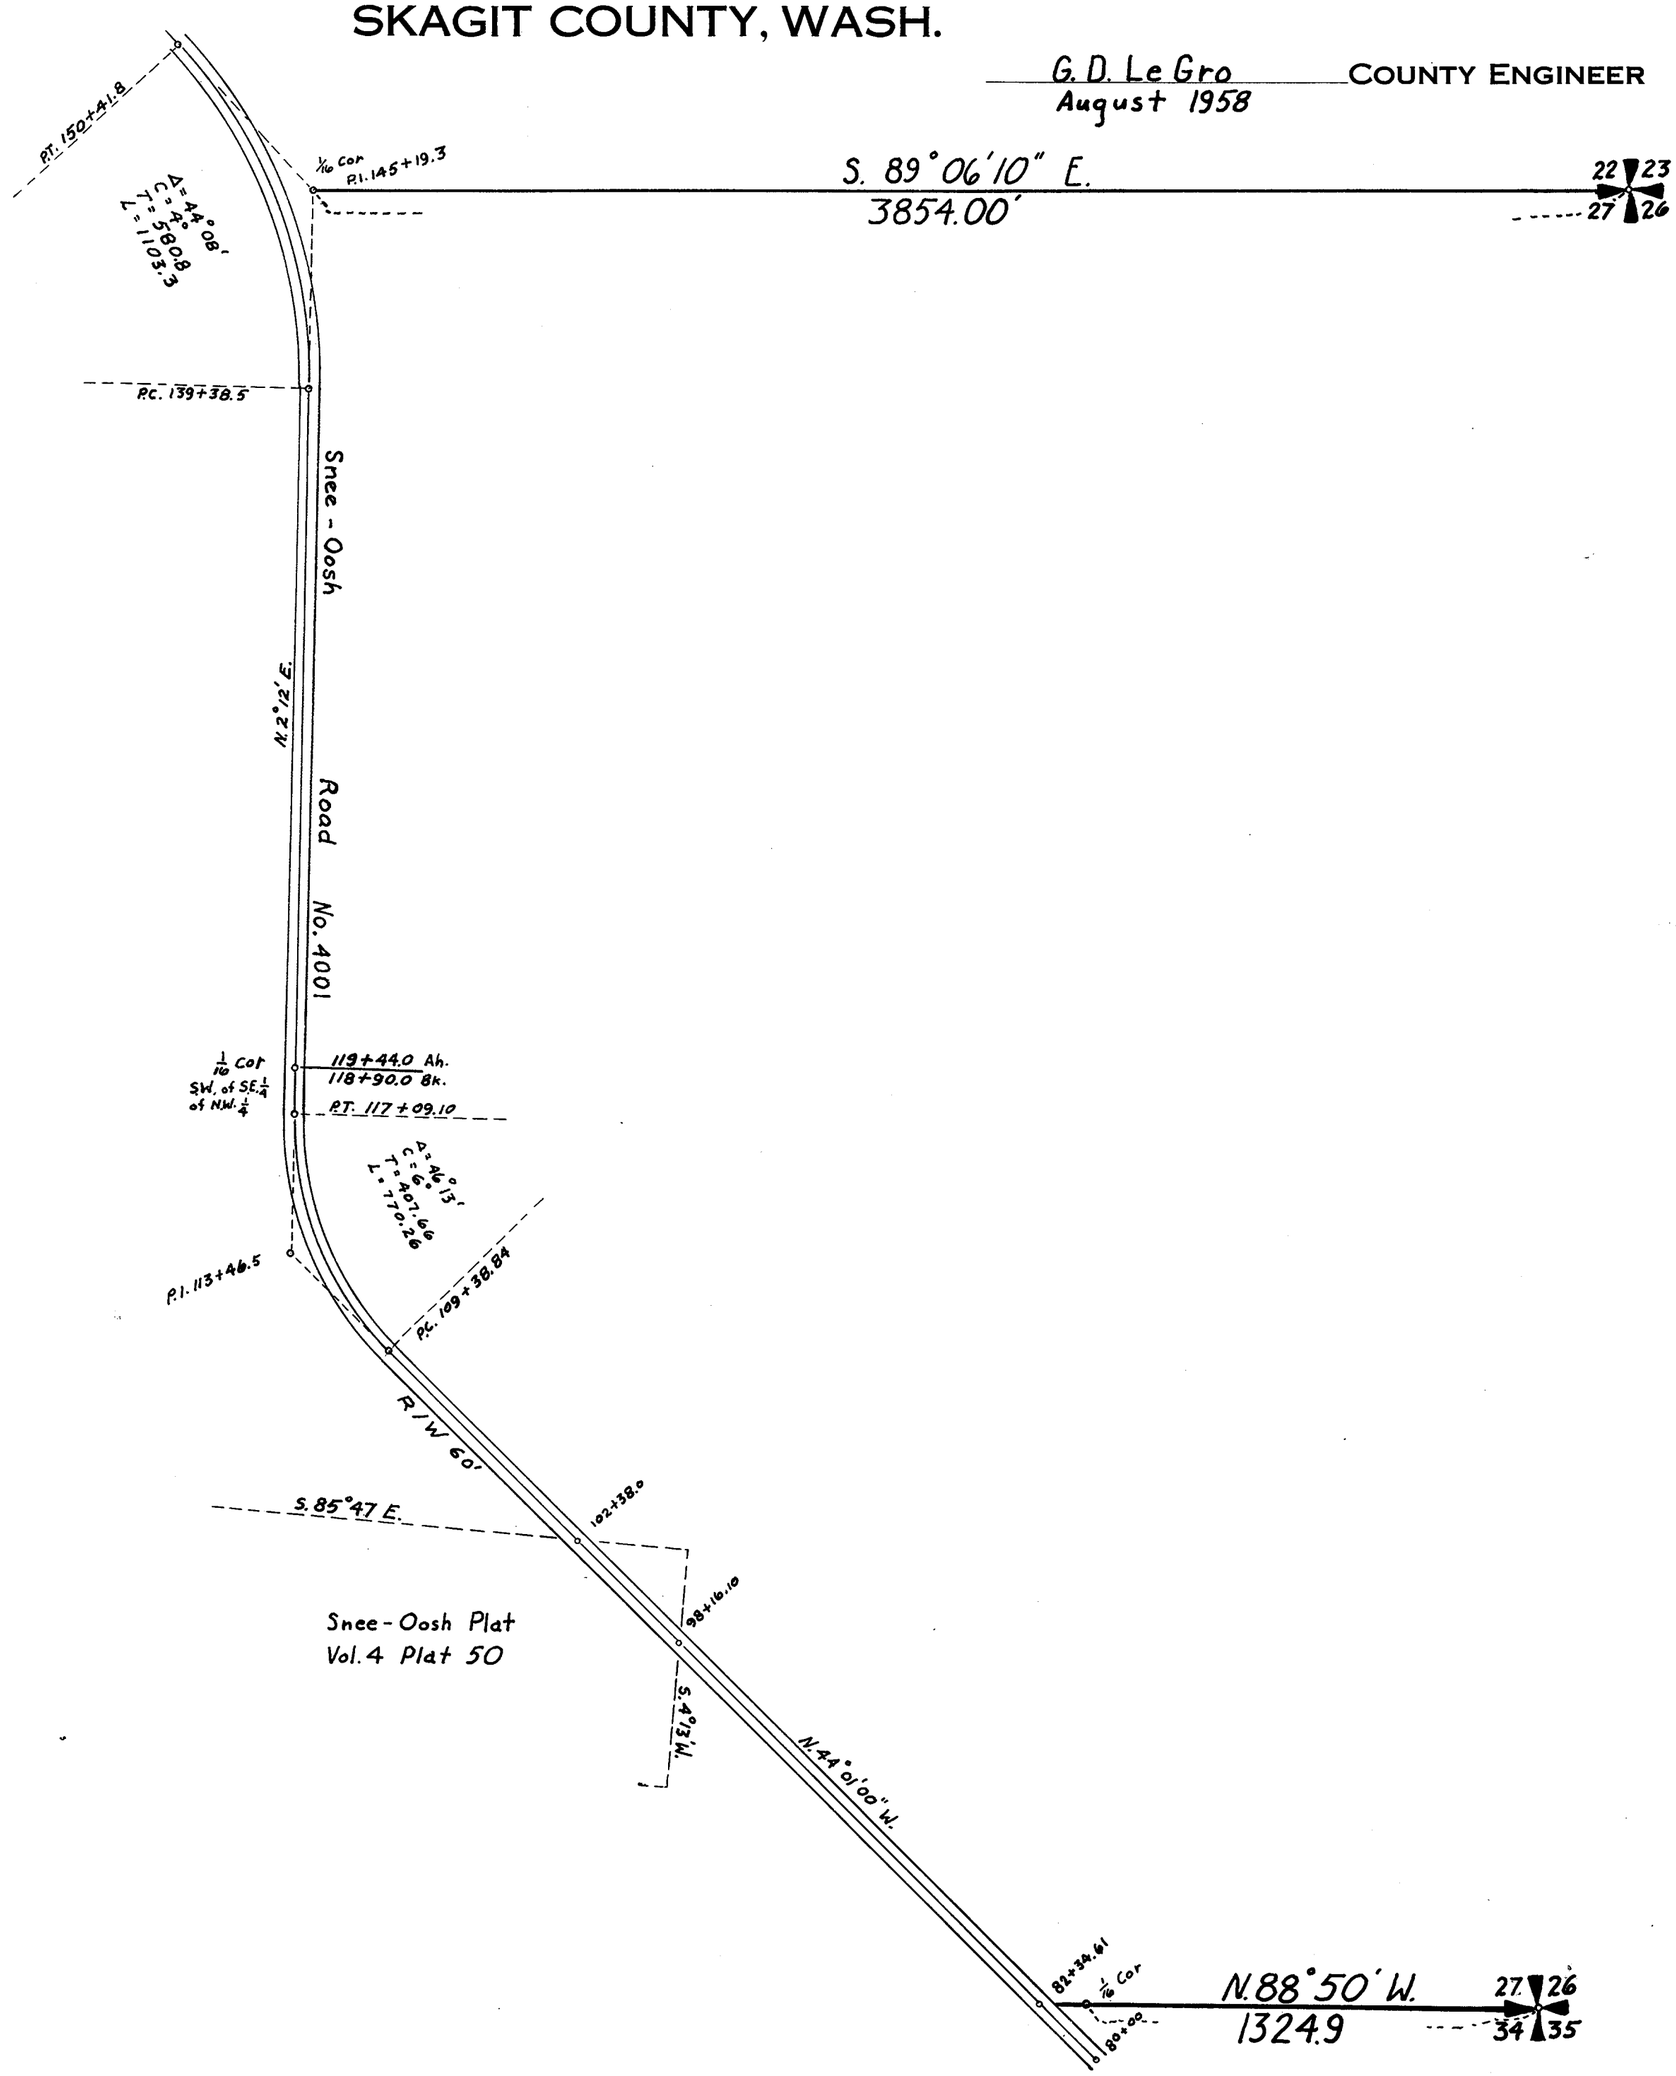

Snee - Oosh Plat
Vol. 4 Plat 50

SECTION 27

TOWNSHIP 34 NORTH, RANGE 2 EAST, W. M.
SKAGIT COUNTY, WASH.

SCALE, 1 INCH = 100 FEET
TRACED FROM RECORDED PLAT & OWNERSHIPS TAKEN FROM ASSESSORS PLAT

_____ COUNTY ENGINEER

SNEE-OOSH SUBDIVISION OF LOT 4



FAHLENS SNEE-OOSH TRACTS VOL 8 Pg 86
SHOREWOOD VOL 9 Pg 83
SUNNY SLOPE VOL 9 Pg 41

SECTION 27


TOWNSHIP 34 NORTH, RANGE 2 EAST, W. M.

SKAGIT COUNTY, WASH.

APRIL 13, 1972

Lloyd H. Johnson COUNTY ENGINEER

SCALE, 1 INCH--400 FEET

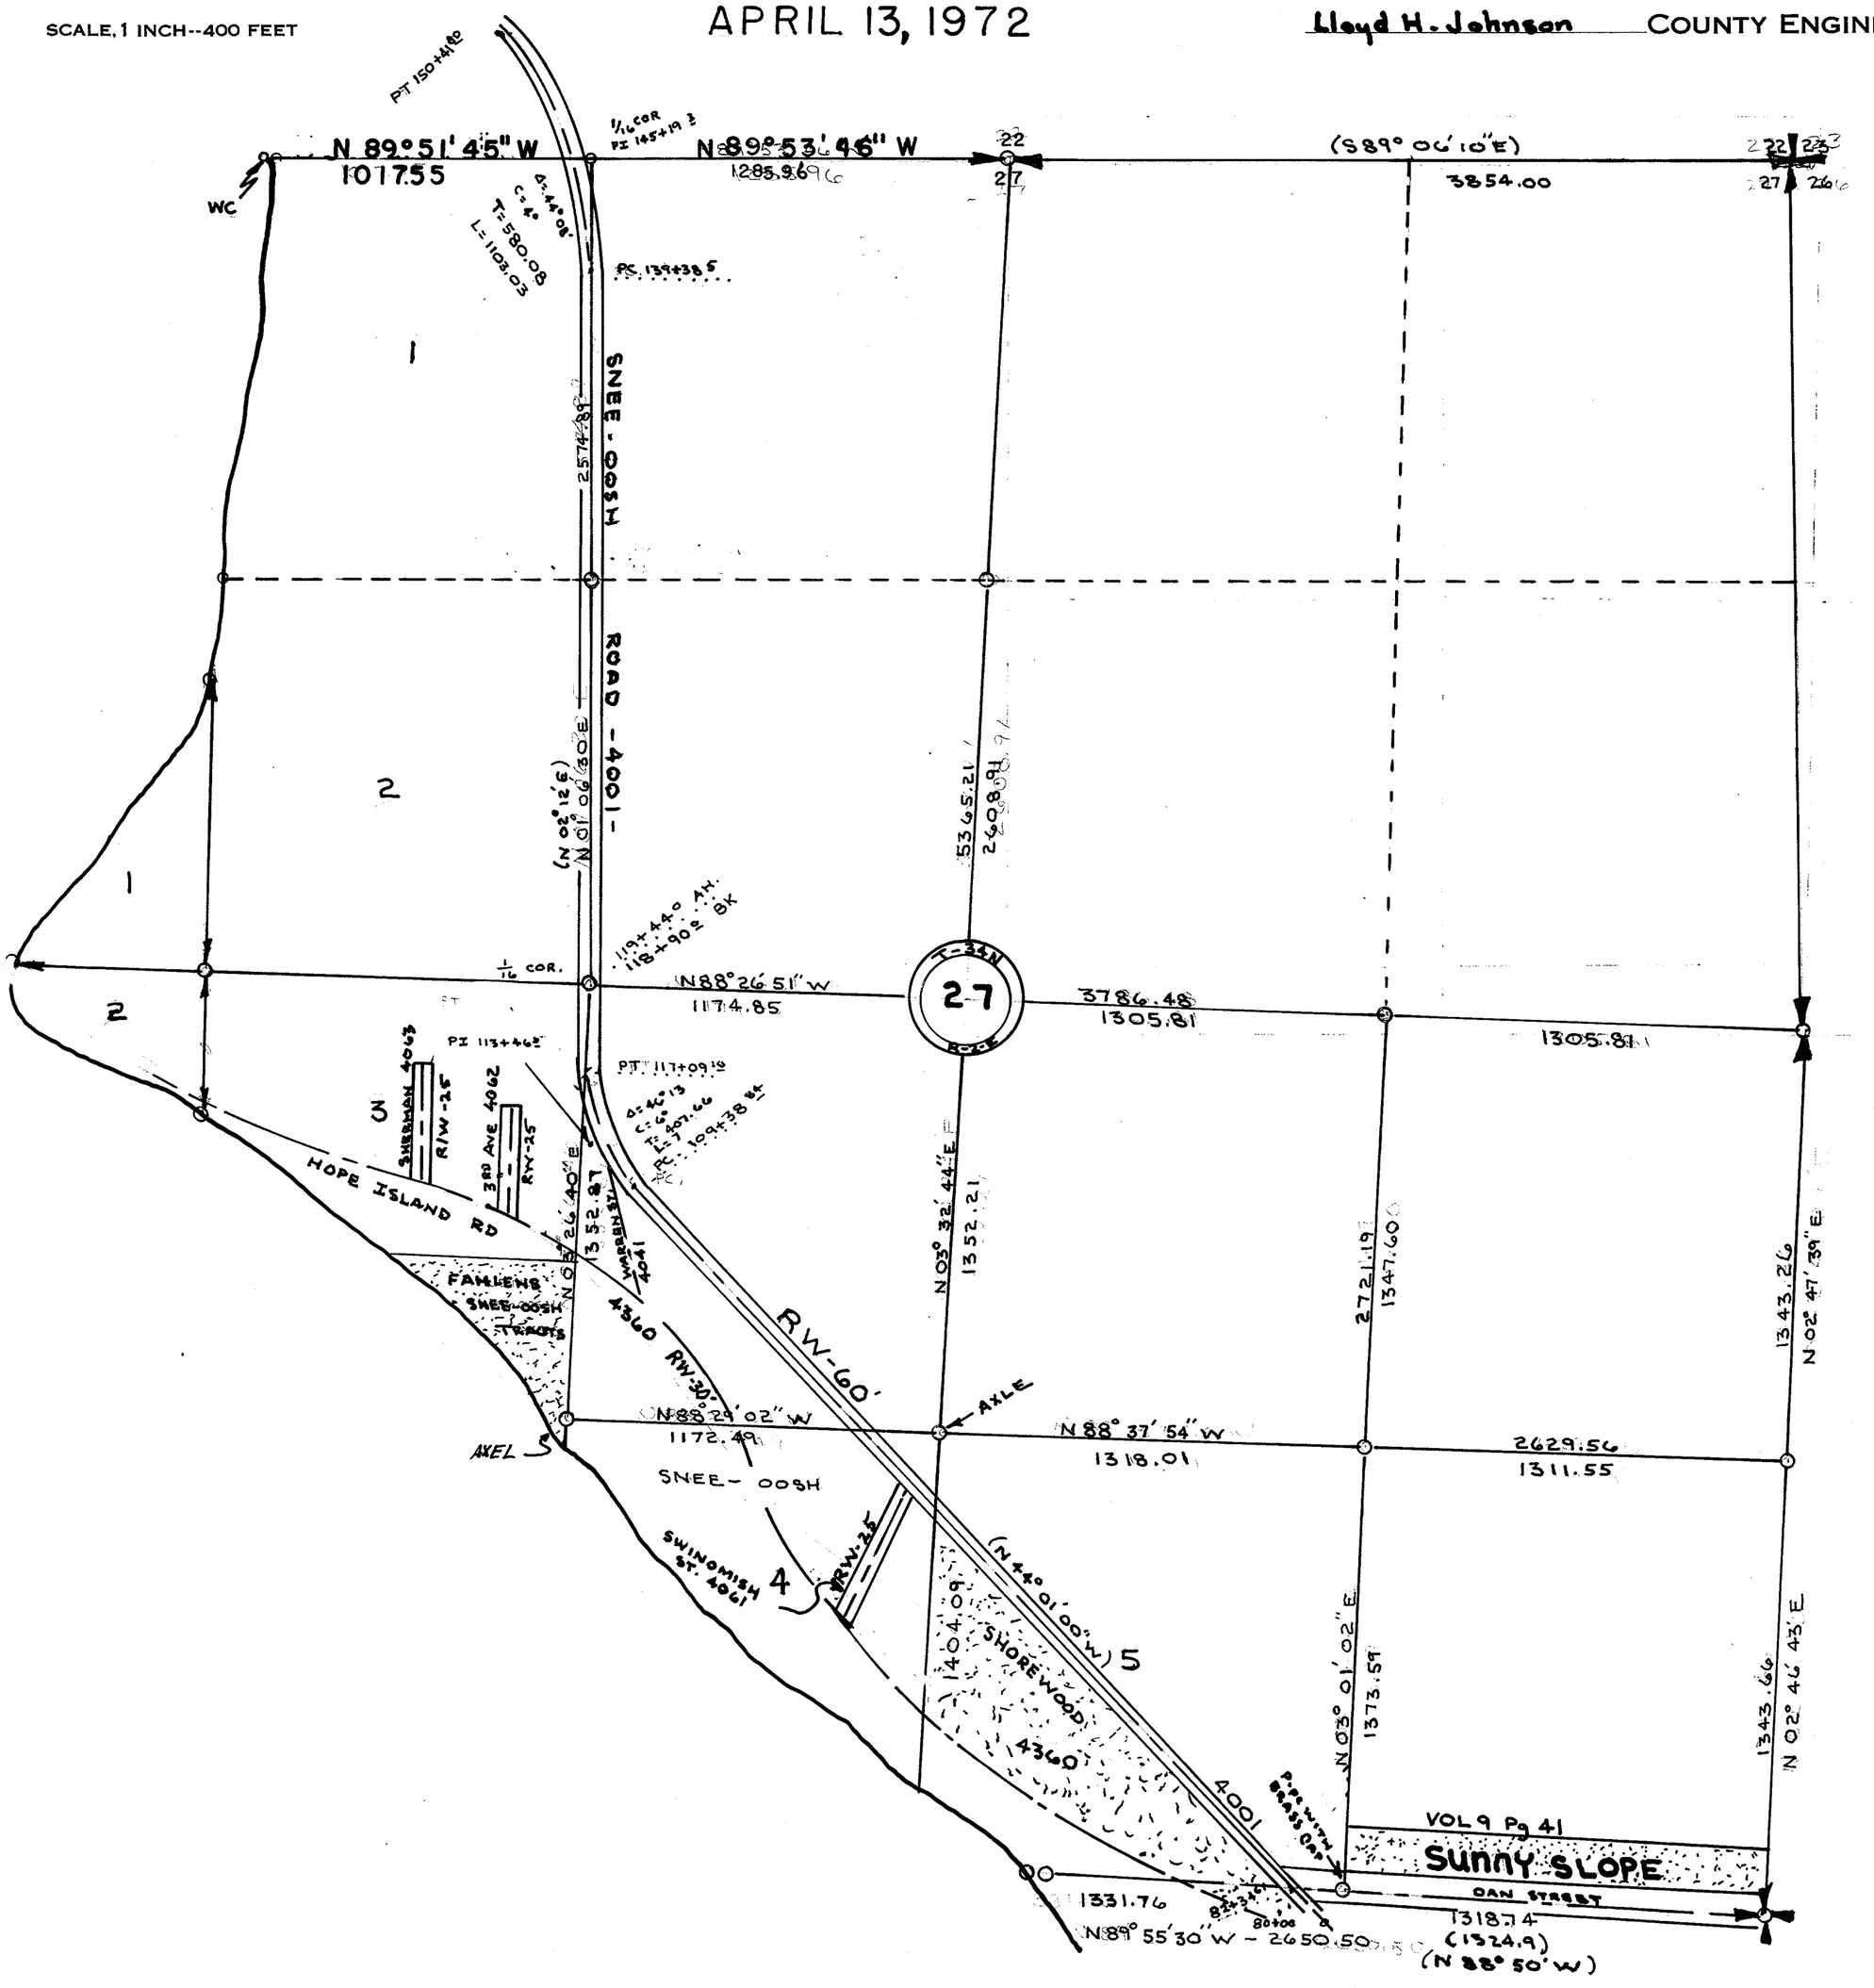


MORRIS DAN WATERFRONT TRACTS VOL 7 PG 98
SHOREWOOD VOL 9 PG 83
WAGNERS HOPE ISLAND ADDITION VOL 6 PG 12
REPLAT BLOCK #5 WAGNERS HOPE ISLAND ADD. VOL 10-9

SECTION 34
TOWNSHIP 34 NORTH RANGE 2 EAST, W.M.
SKAGIT COUNTY, WASH.

SCALE INCH 400 FEET

DATE APRIL 14, 1972

Lloyd H. Johnson COUNTY. ENGR.

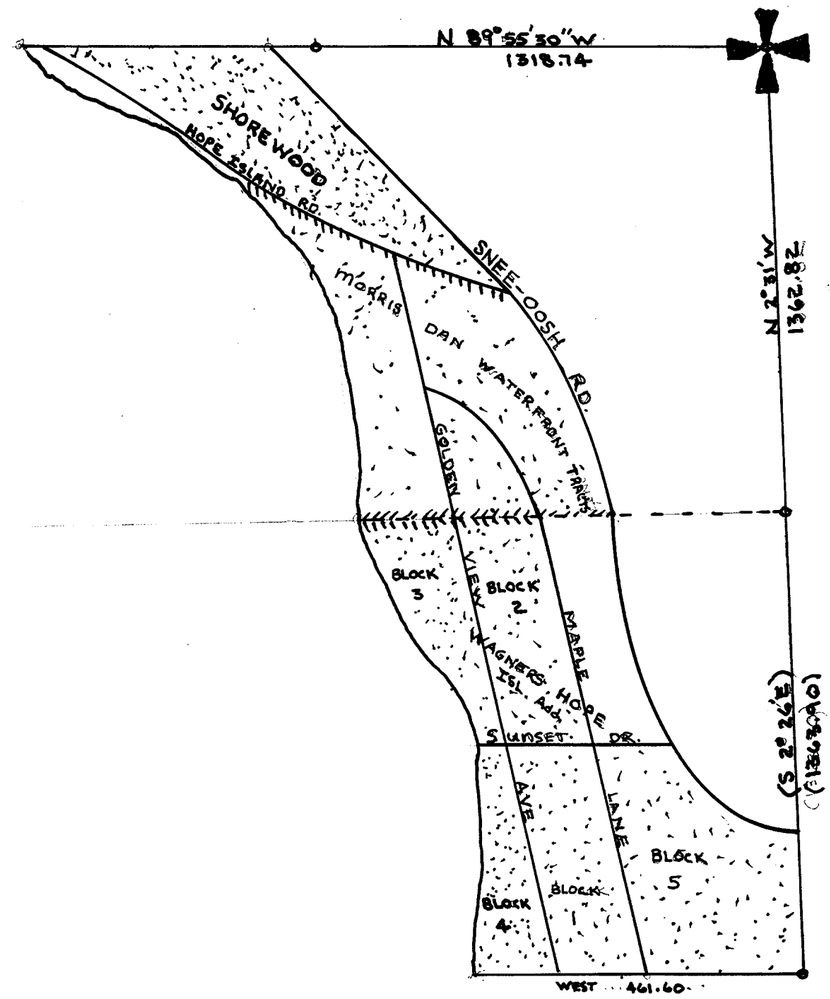


SECTION 34

TOWNSHIP 34 NORTH, RANGE 2 EAST, W. M.

SKAGIT COUNTY, WASH.

SCALE, 1 INCH--400 FEET

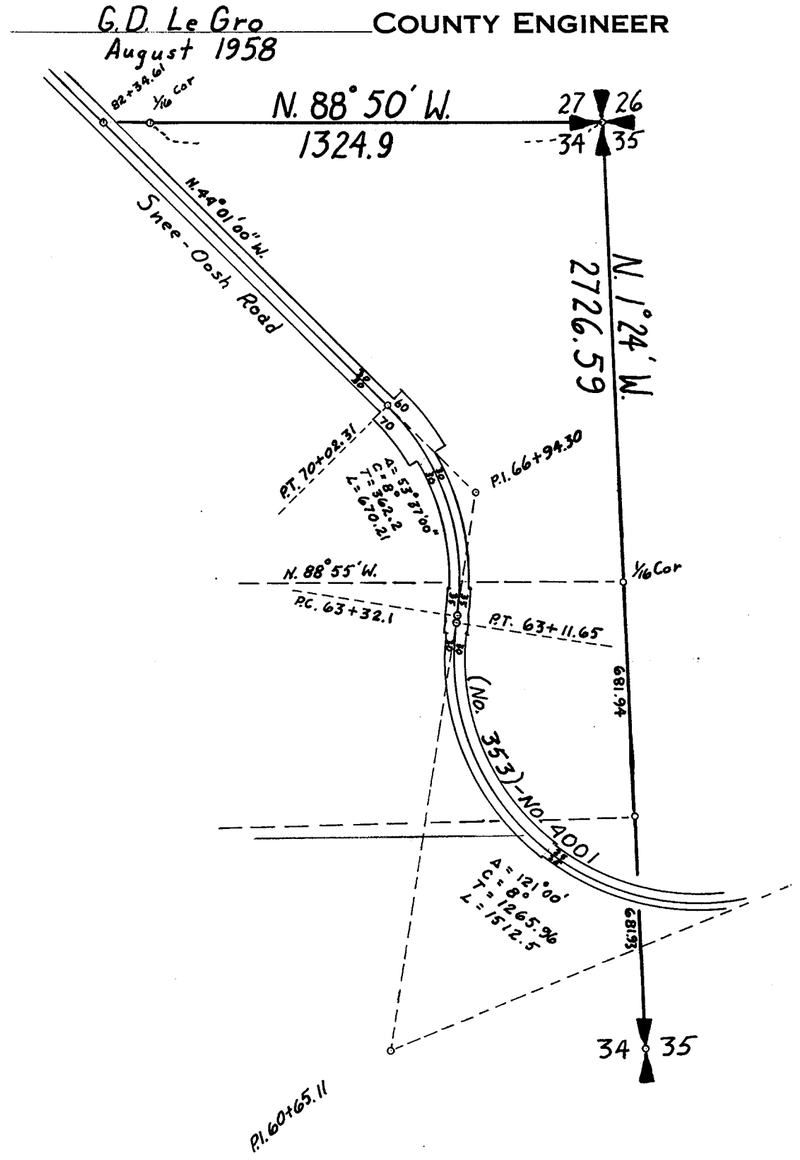

SECTION 34


TOWNSHIP 34 NORTH, RANGE 2 EAST, W. M.

SKAGIT COUNTY, WASH.

SCALE, 1 INCH -- 400 FEET

DATE 3 Sept 1968


Lloyd H. Johnson COUNTY ENGINEER

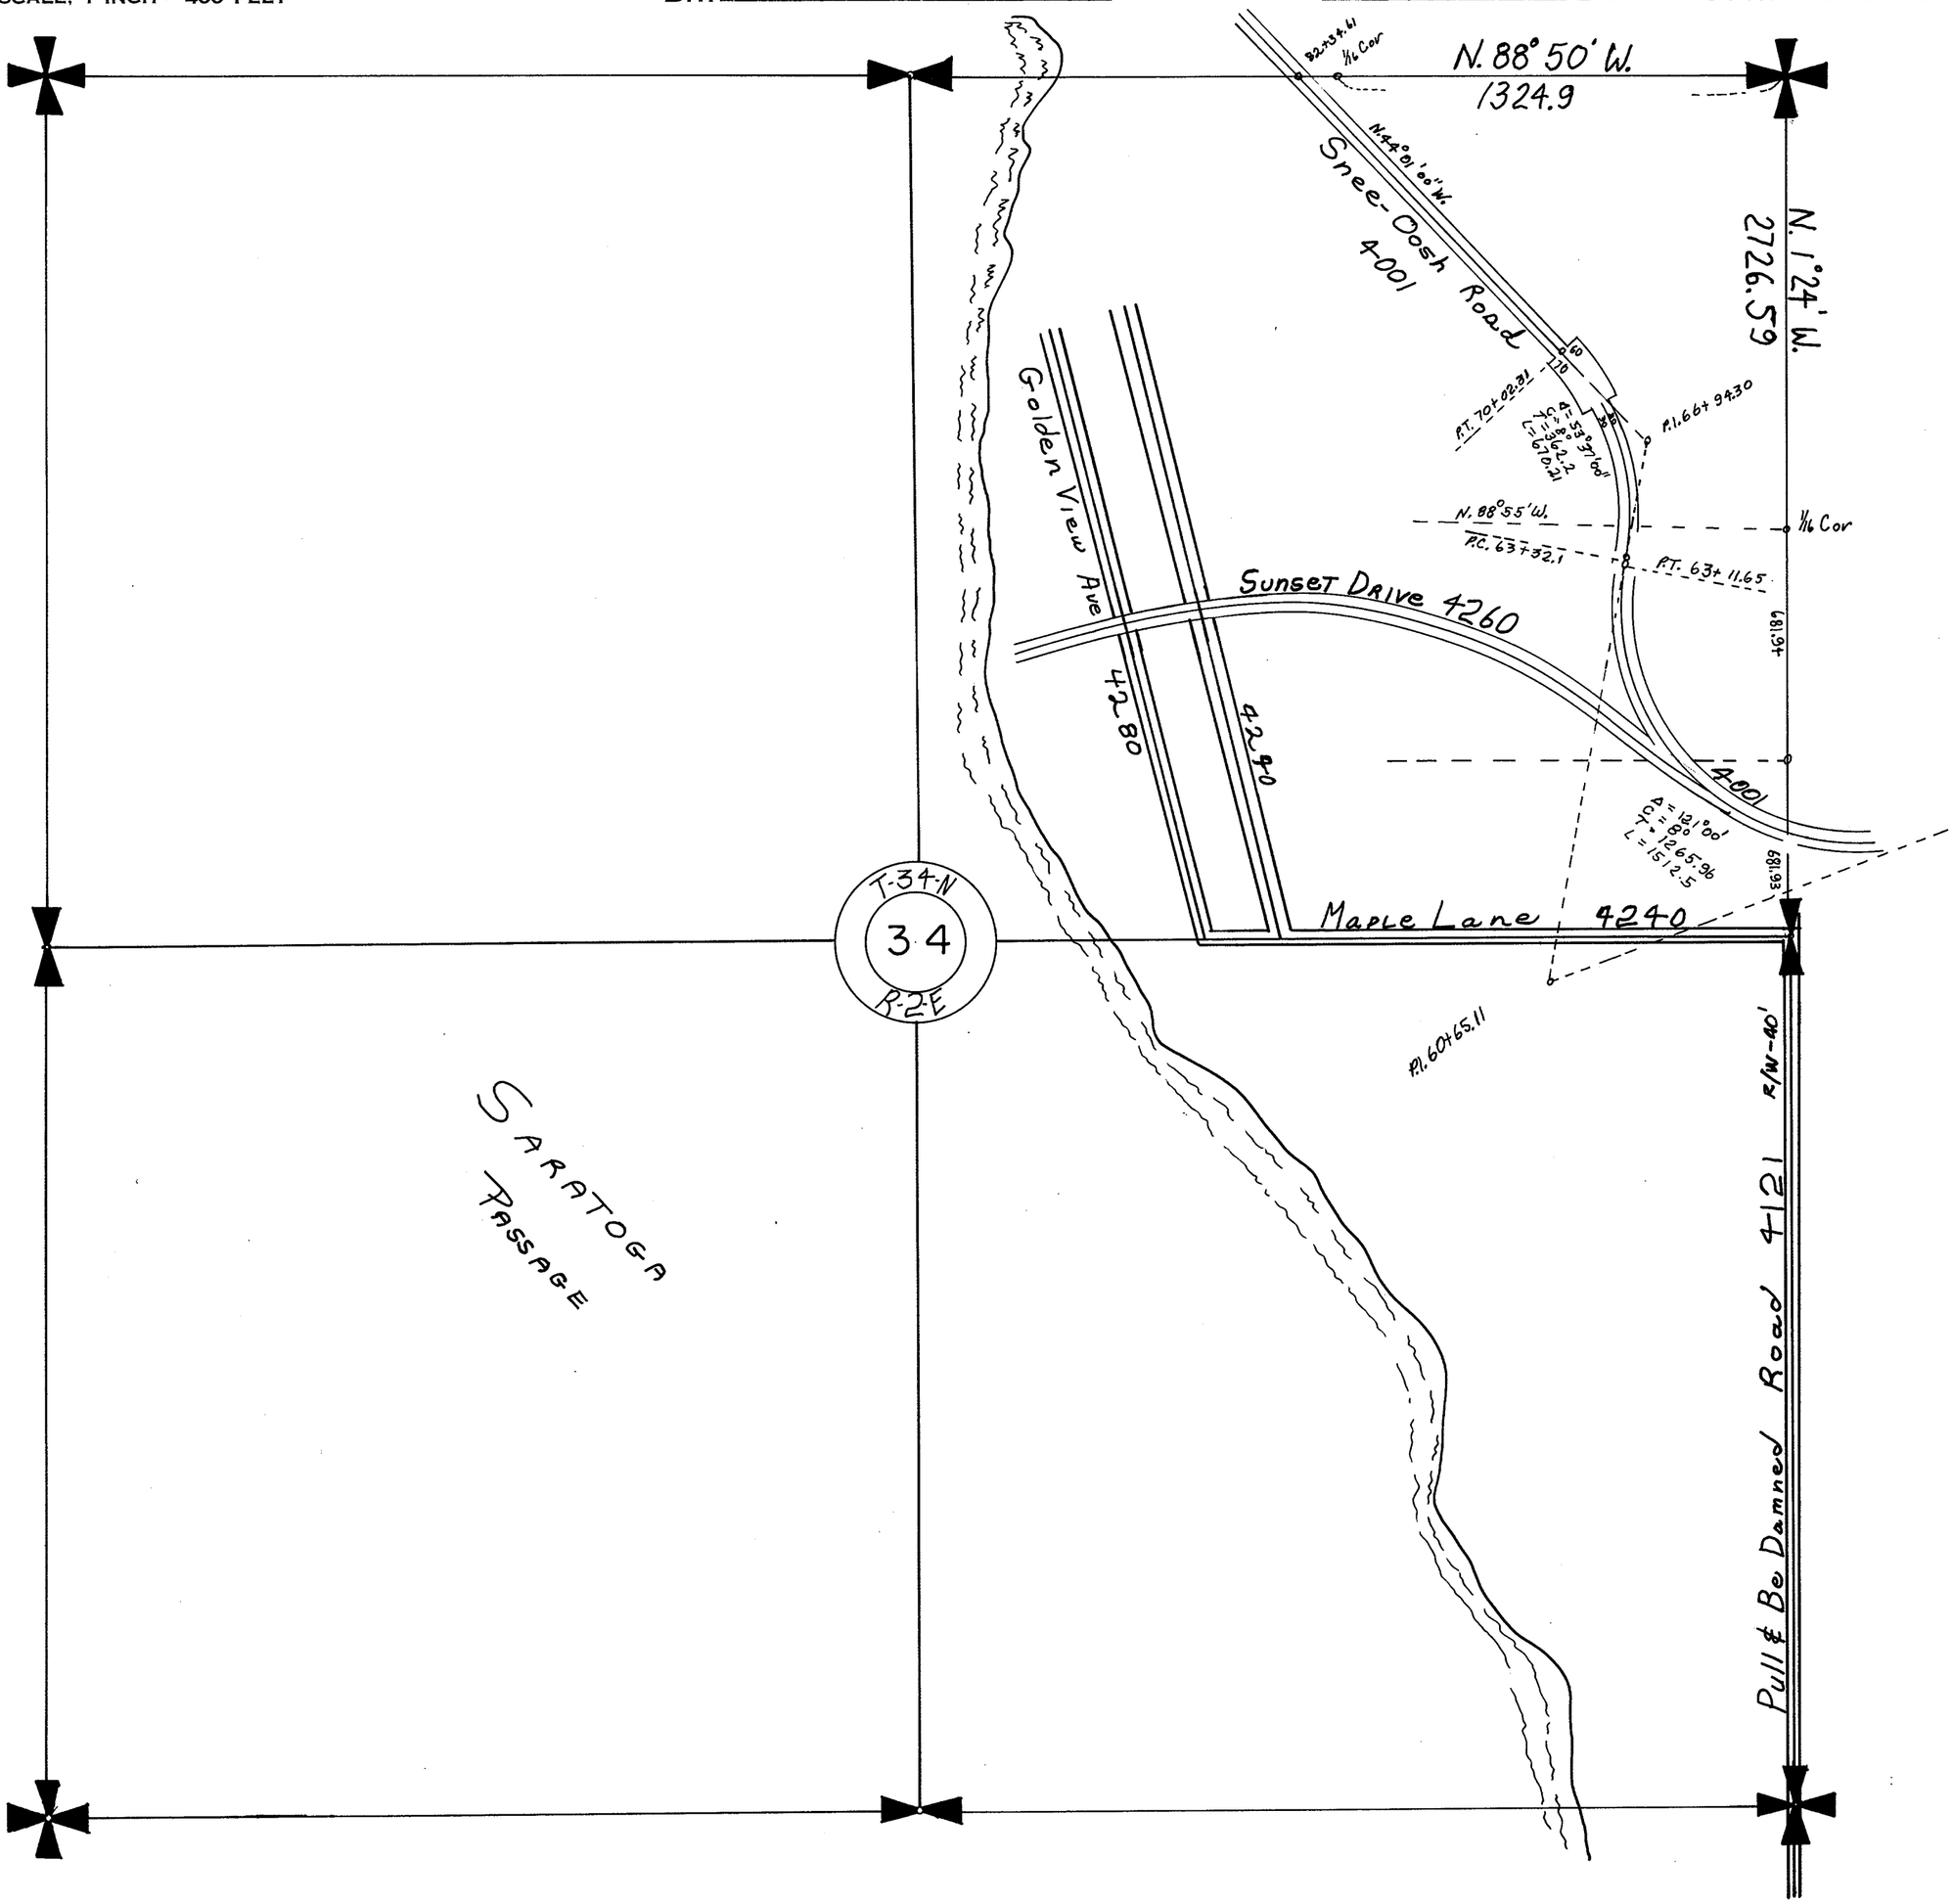

SECTION 35
TOWNSHIP 34 NORTH, RANGE 2 EAST, W. M.
SKAGIT COUNTY, WASH.

SCALE, 1 INCH--400 FEET


G. D. LeGro
August 1958
COUNTY ENGINEER

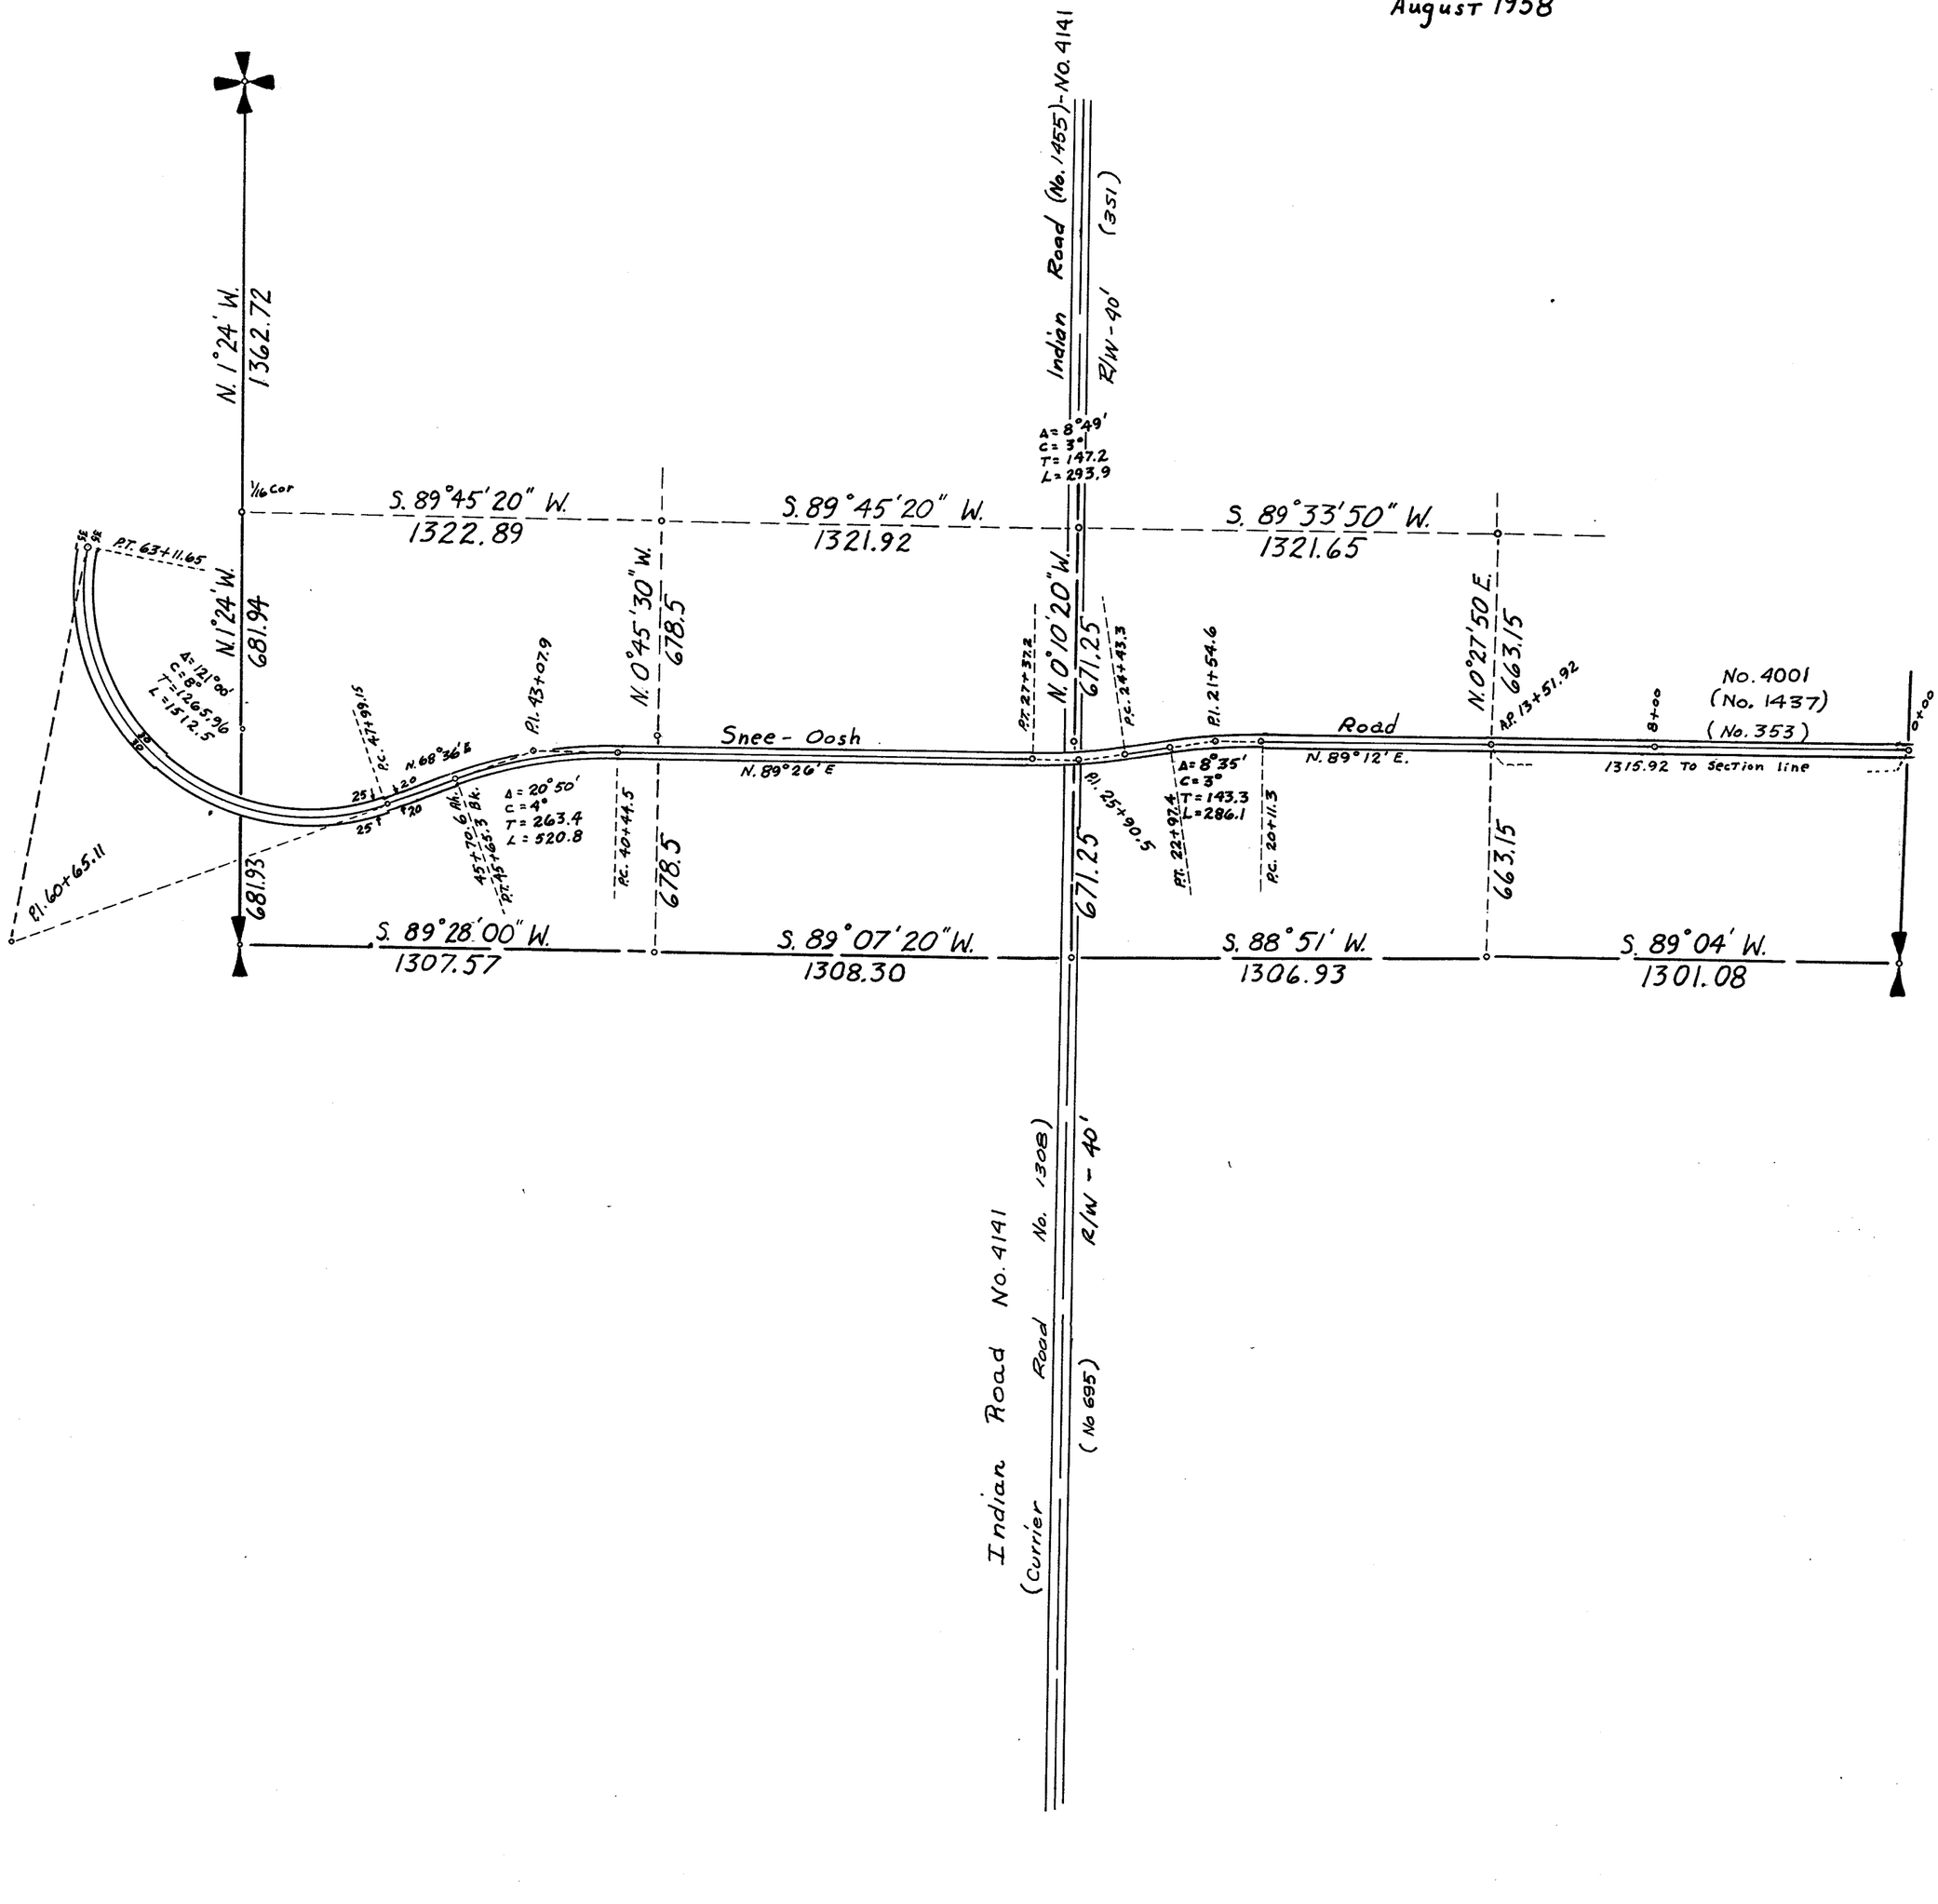

SECTION 36
TOWNSHIP 34 NORTH, RANGE 2 EAST, W. M.
SKAGIT COUNTY, WASH.

H.O. WALBERG COUNTY ENGINEER

SCALE, 1 INCH--400 FEET

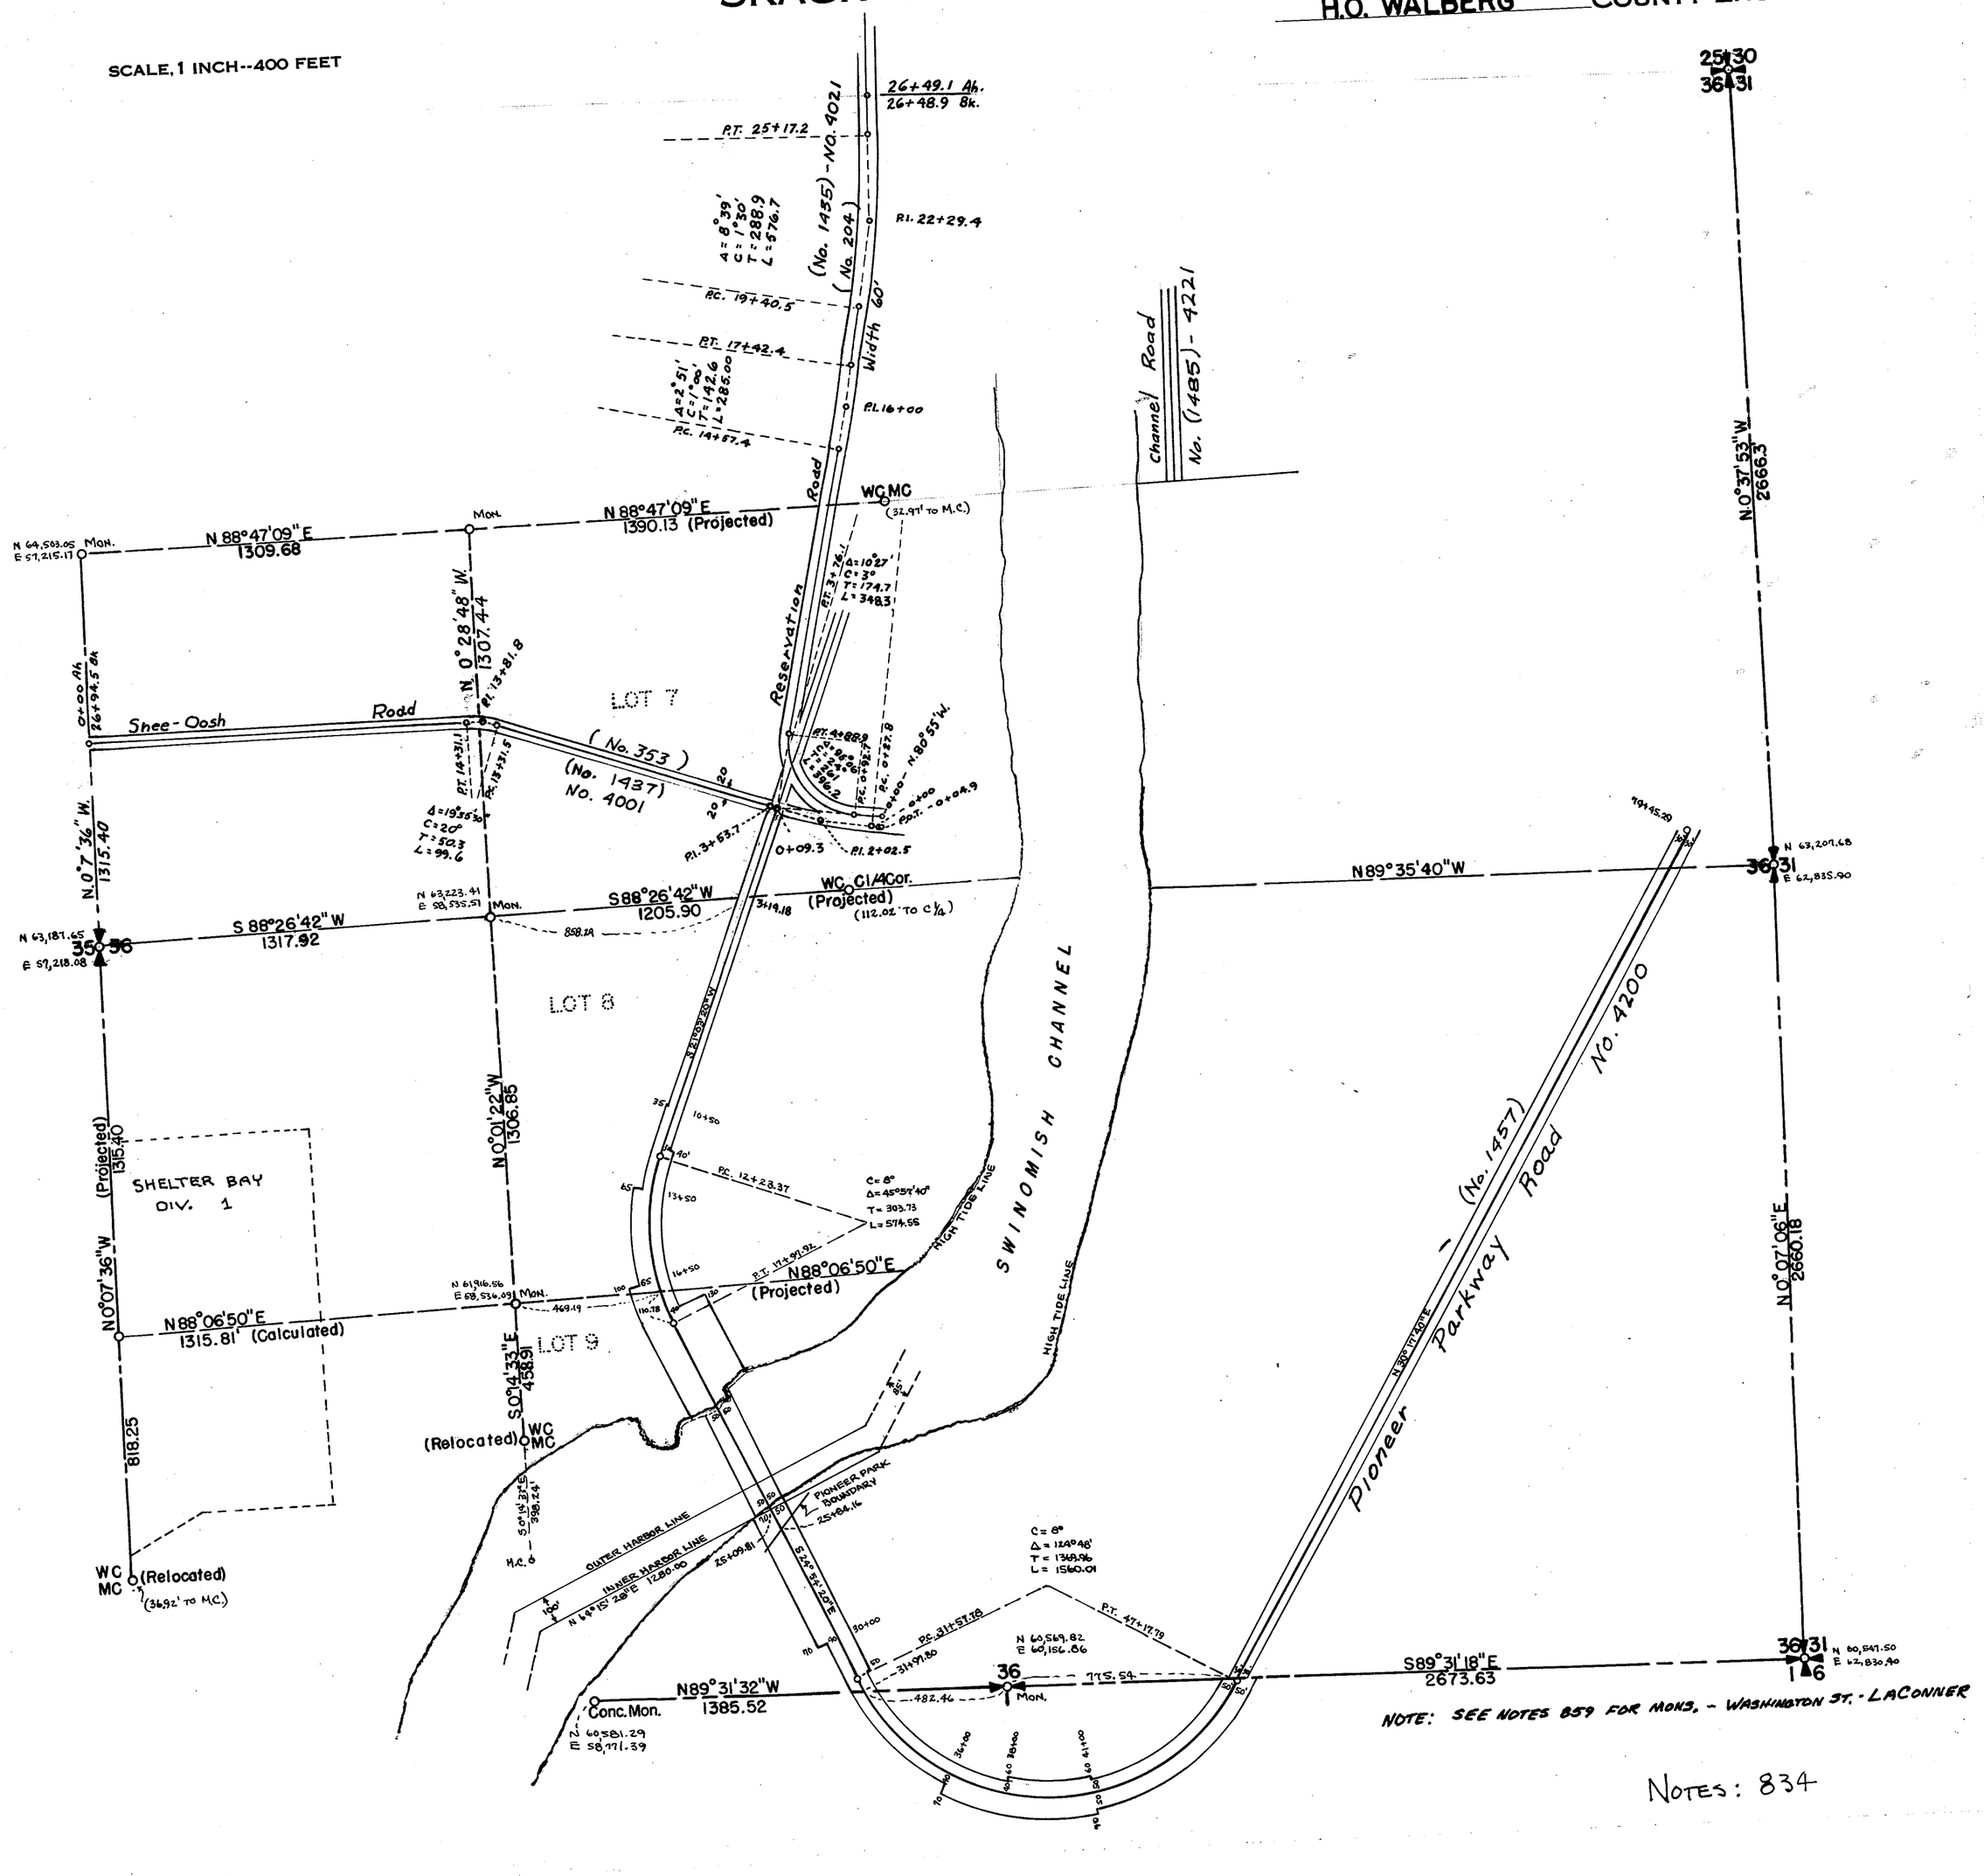

NOTE: SEE NOTES 859 FOR MONS. - WASHINGTON ST. - LACONNER

NOTES: 834

SECTION 1
TOWNSHIP 34 NORTH, RANGE 3 EAST, W. M.
SKAGIT COUNTY, WASH.

DATE June 29, 1966

Lloyd Johnson COUNTY ENGINEER

SCALE, 1 INCH--400 FEET

Notes: 872

Note: This Tracing Drawn From Aerial Photo - Not to Scale ---

T-34-N
1
R-3-E

P. Pole # 14582 (53)

2630

(No. 2501)

No. 2402

Found Hollow 1" Rod (53)

Road No. 3238

T. Pole (53) (No. 2486)-(641) Marlee Drive

38.7 12" Cedar (53)

24.1

(BAY VIEW-OLYMPIA MARCH ROAD)

Peterson Road

S89°49'E 2624.25

S89°49'E (53) 2624.29

No. (2402)-(691)-3240

Pipe in Mon. Case

PLAT - Vedere Terrace Vol. 7 page 84

No. (2483)-(639) 3229

No. (2482)-(640)

GAILEE DRIVE R/W-50 No. 3227

DRIVE

R/W-50

HILYNN

No. (2501)-3311 (HARVEY SMITH ROAD)

Allen Road

R/W-60'

Avon

NORTH Sound Est. No. 1 Vol. 9, 6 (122)

2731.58

S0°48'13"E

2680.94

(No. 2503)-(541 X CL1)

R/W - 40'

No. 3441

(1293.33)

(N 89° 39' 47" E)

(1294.40)

SLIND ADDITION VOL. 7 Pg 46

SUBDIVISION FILED AUG 12, 1955

(NORTH) (1315.34)

(N 88° 22' E) (1283.62)

I.P.

I.P.

(N 0°24'17"E) Road

(1284.10)

Pulver

RAILWAY

(S 43° 57' W)

NORTHERN

GREAT

S.S.H - (1-c) - 536


SECTION II

TOWNSHIP 34 NORTH, RANGE 3 EAST, W. M.

SKAGIT COUNTY, WASH.

SCALE, 1 INCH–400 FEET

_____ COUNTY ENGINEER

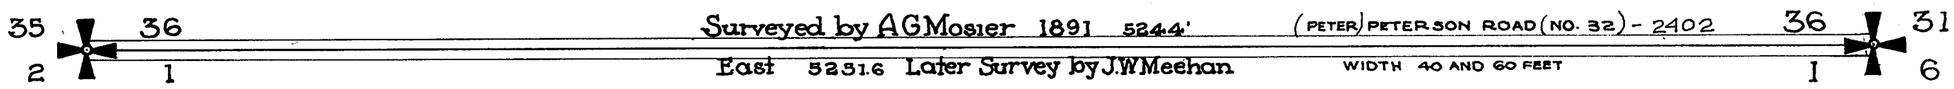


SECTION 1

TOWNSHIP 34 NORTH, RANGE 3 EAST, W. M.

SKAGIT COUNTY, WASH.

SCALE, 1 INCH--400 FEET

H.O.Walberg COUNTY ENGINEER
1943

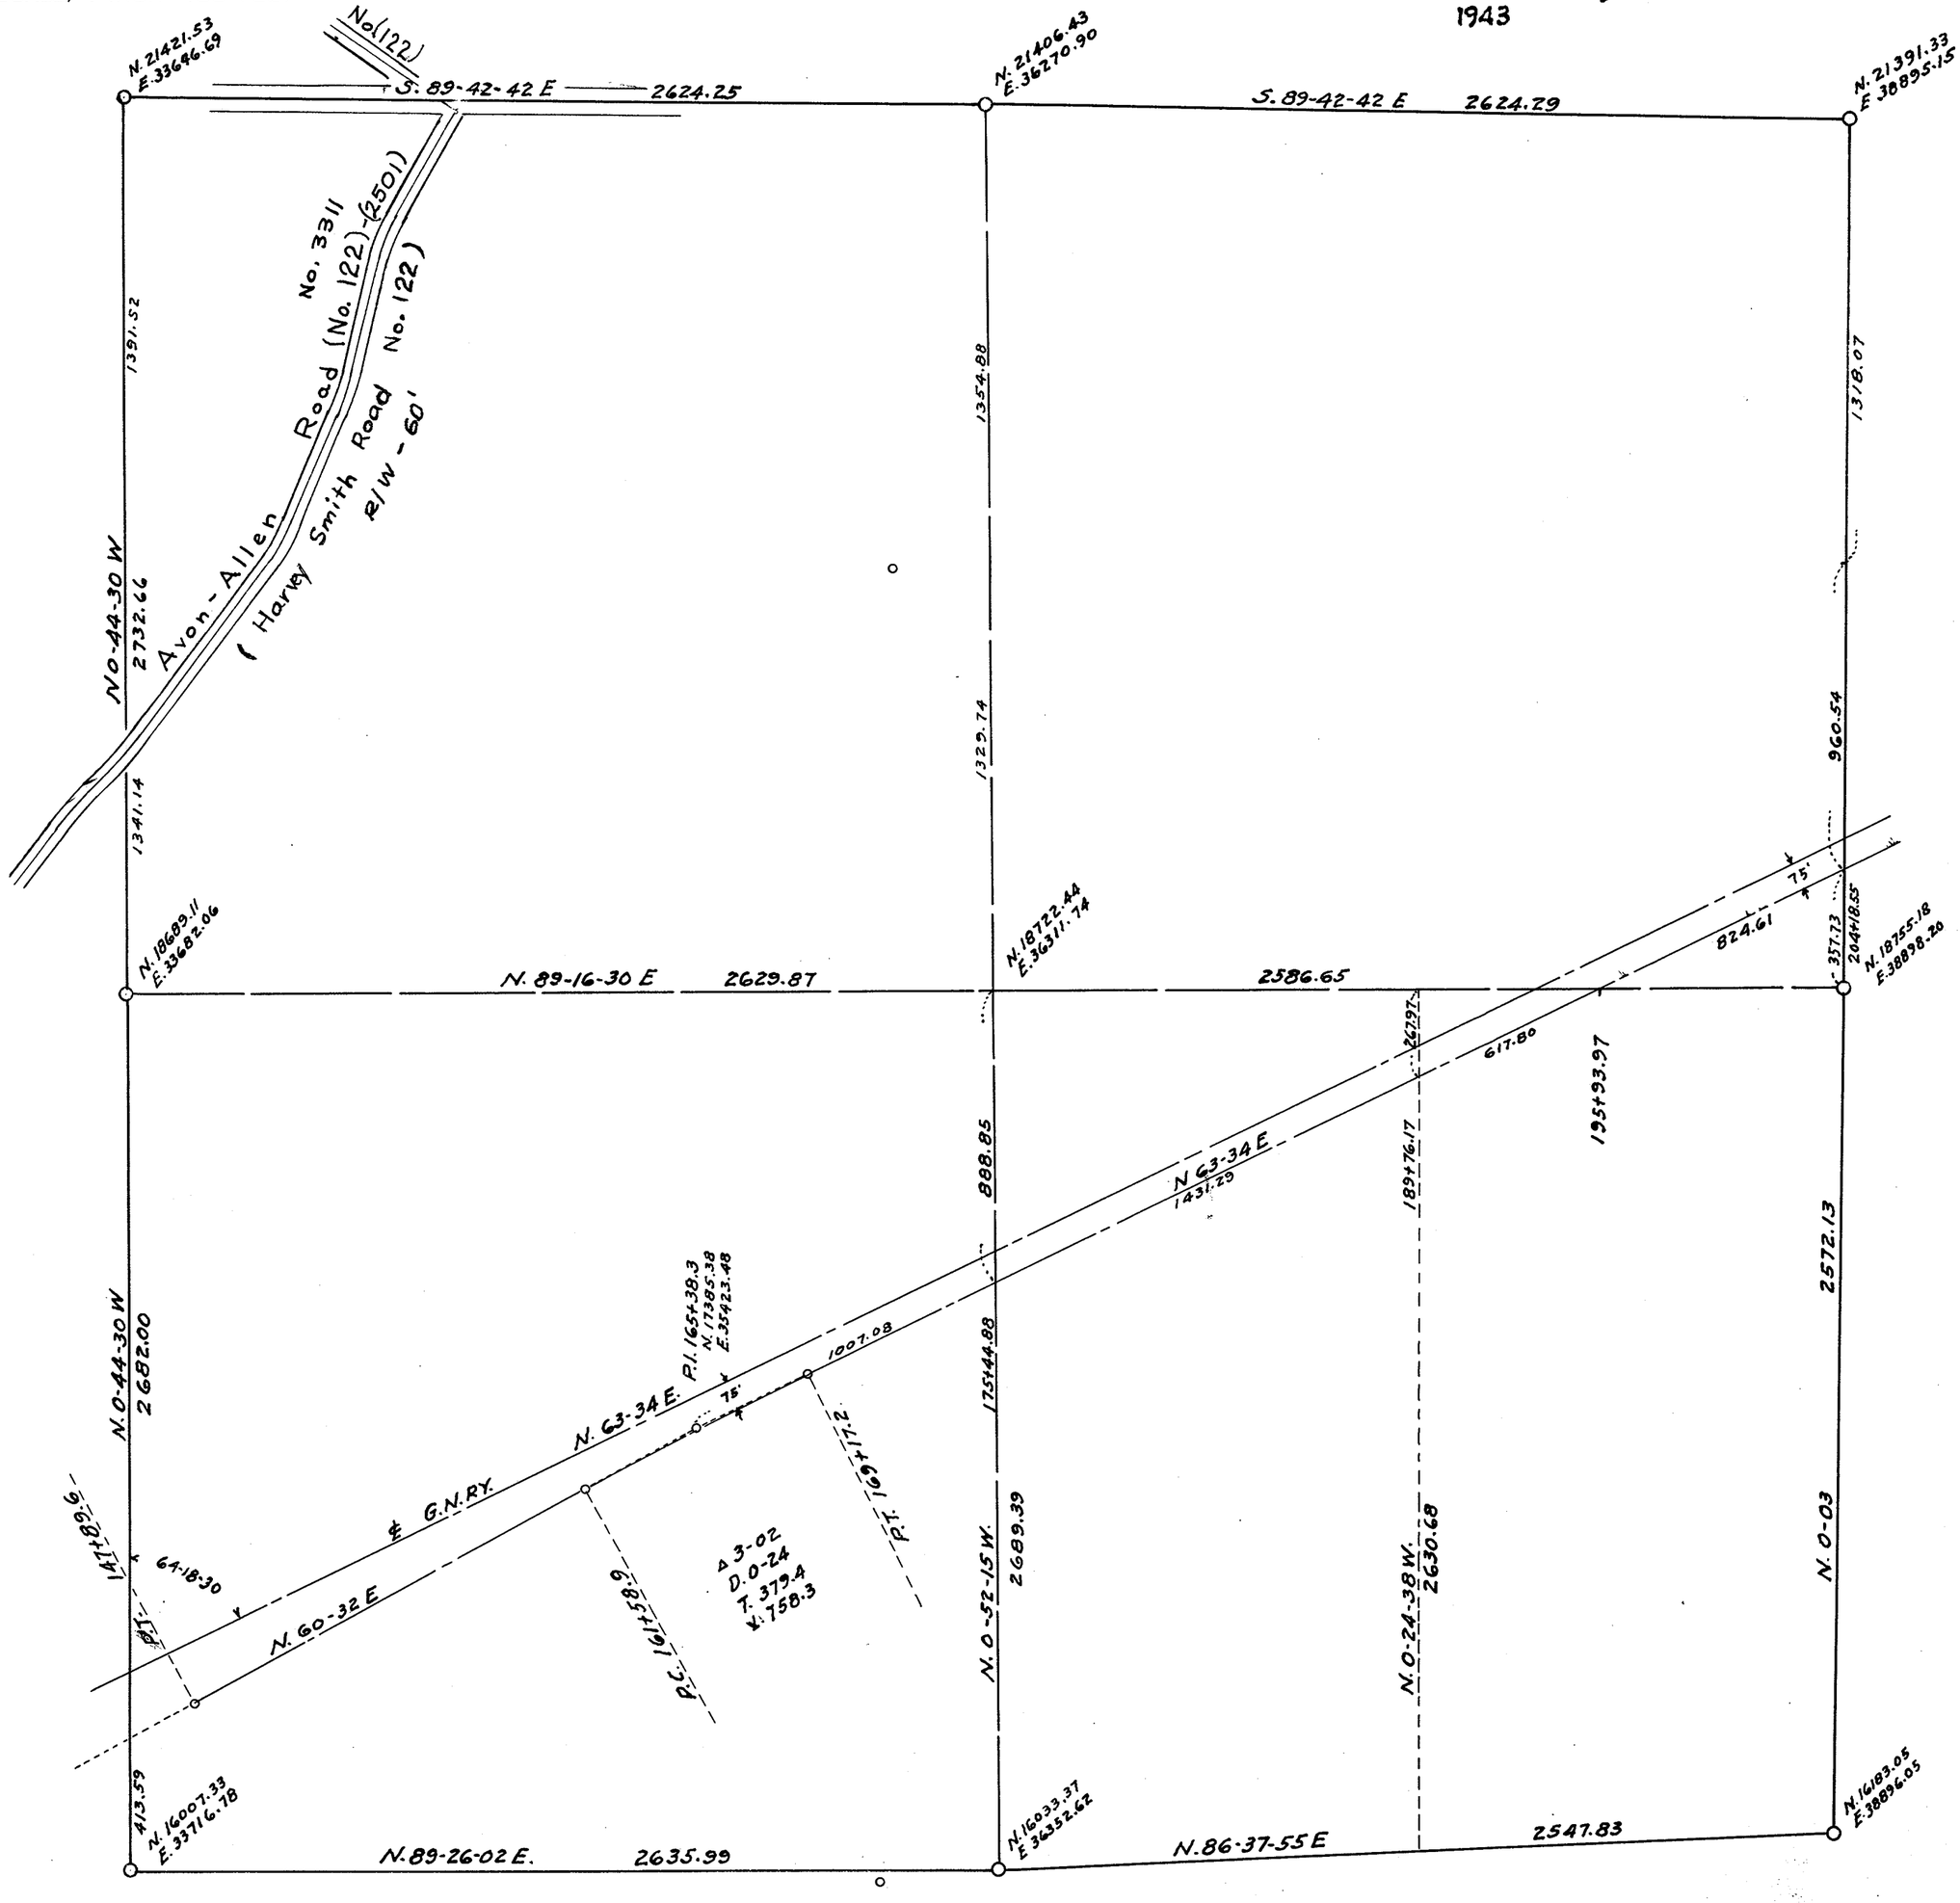

SECTION 2


TOWNSHIP 34 NORTH, RANGE 3 EAST, W. M.

SKAGIT COUNTY, WASH.

SCALE, 1 INCH--400 FEET

DATE June 29

Lloyd Johnson COUNTY ENGINEER

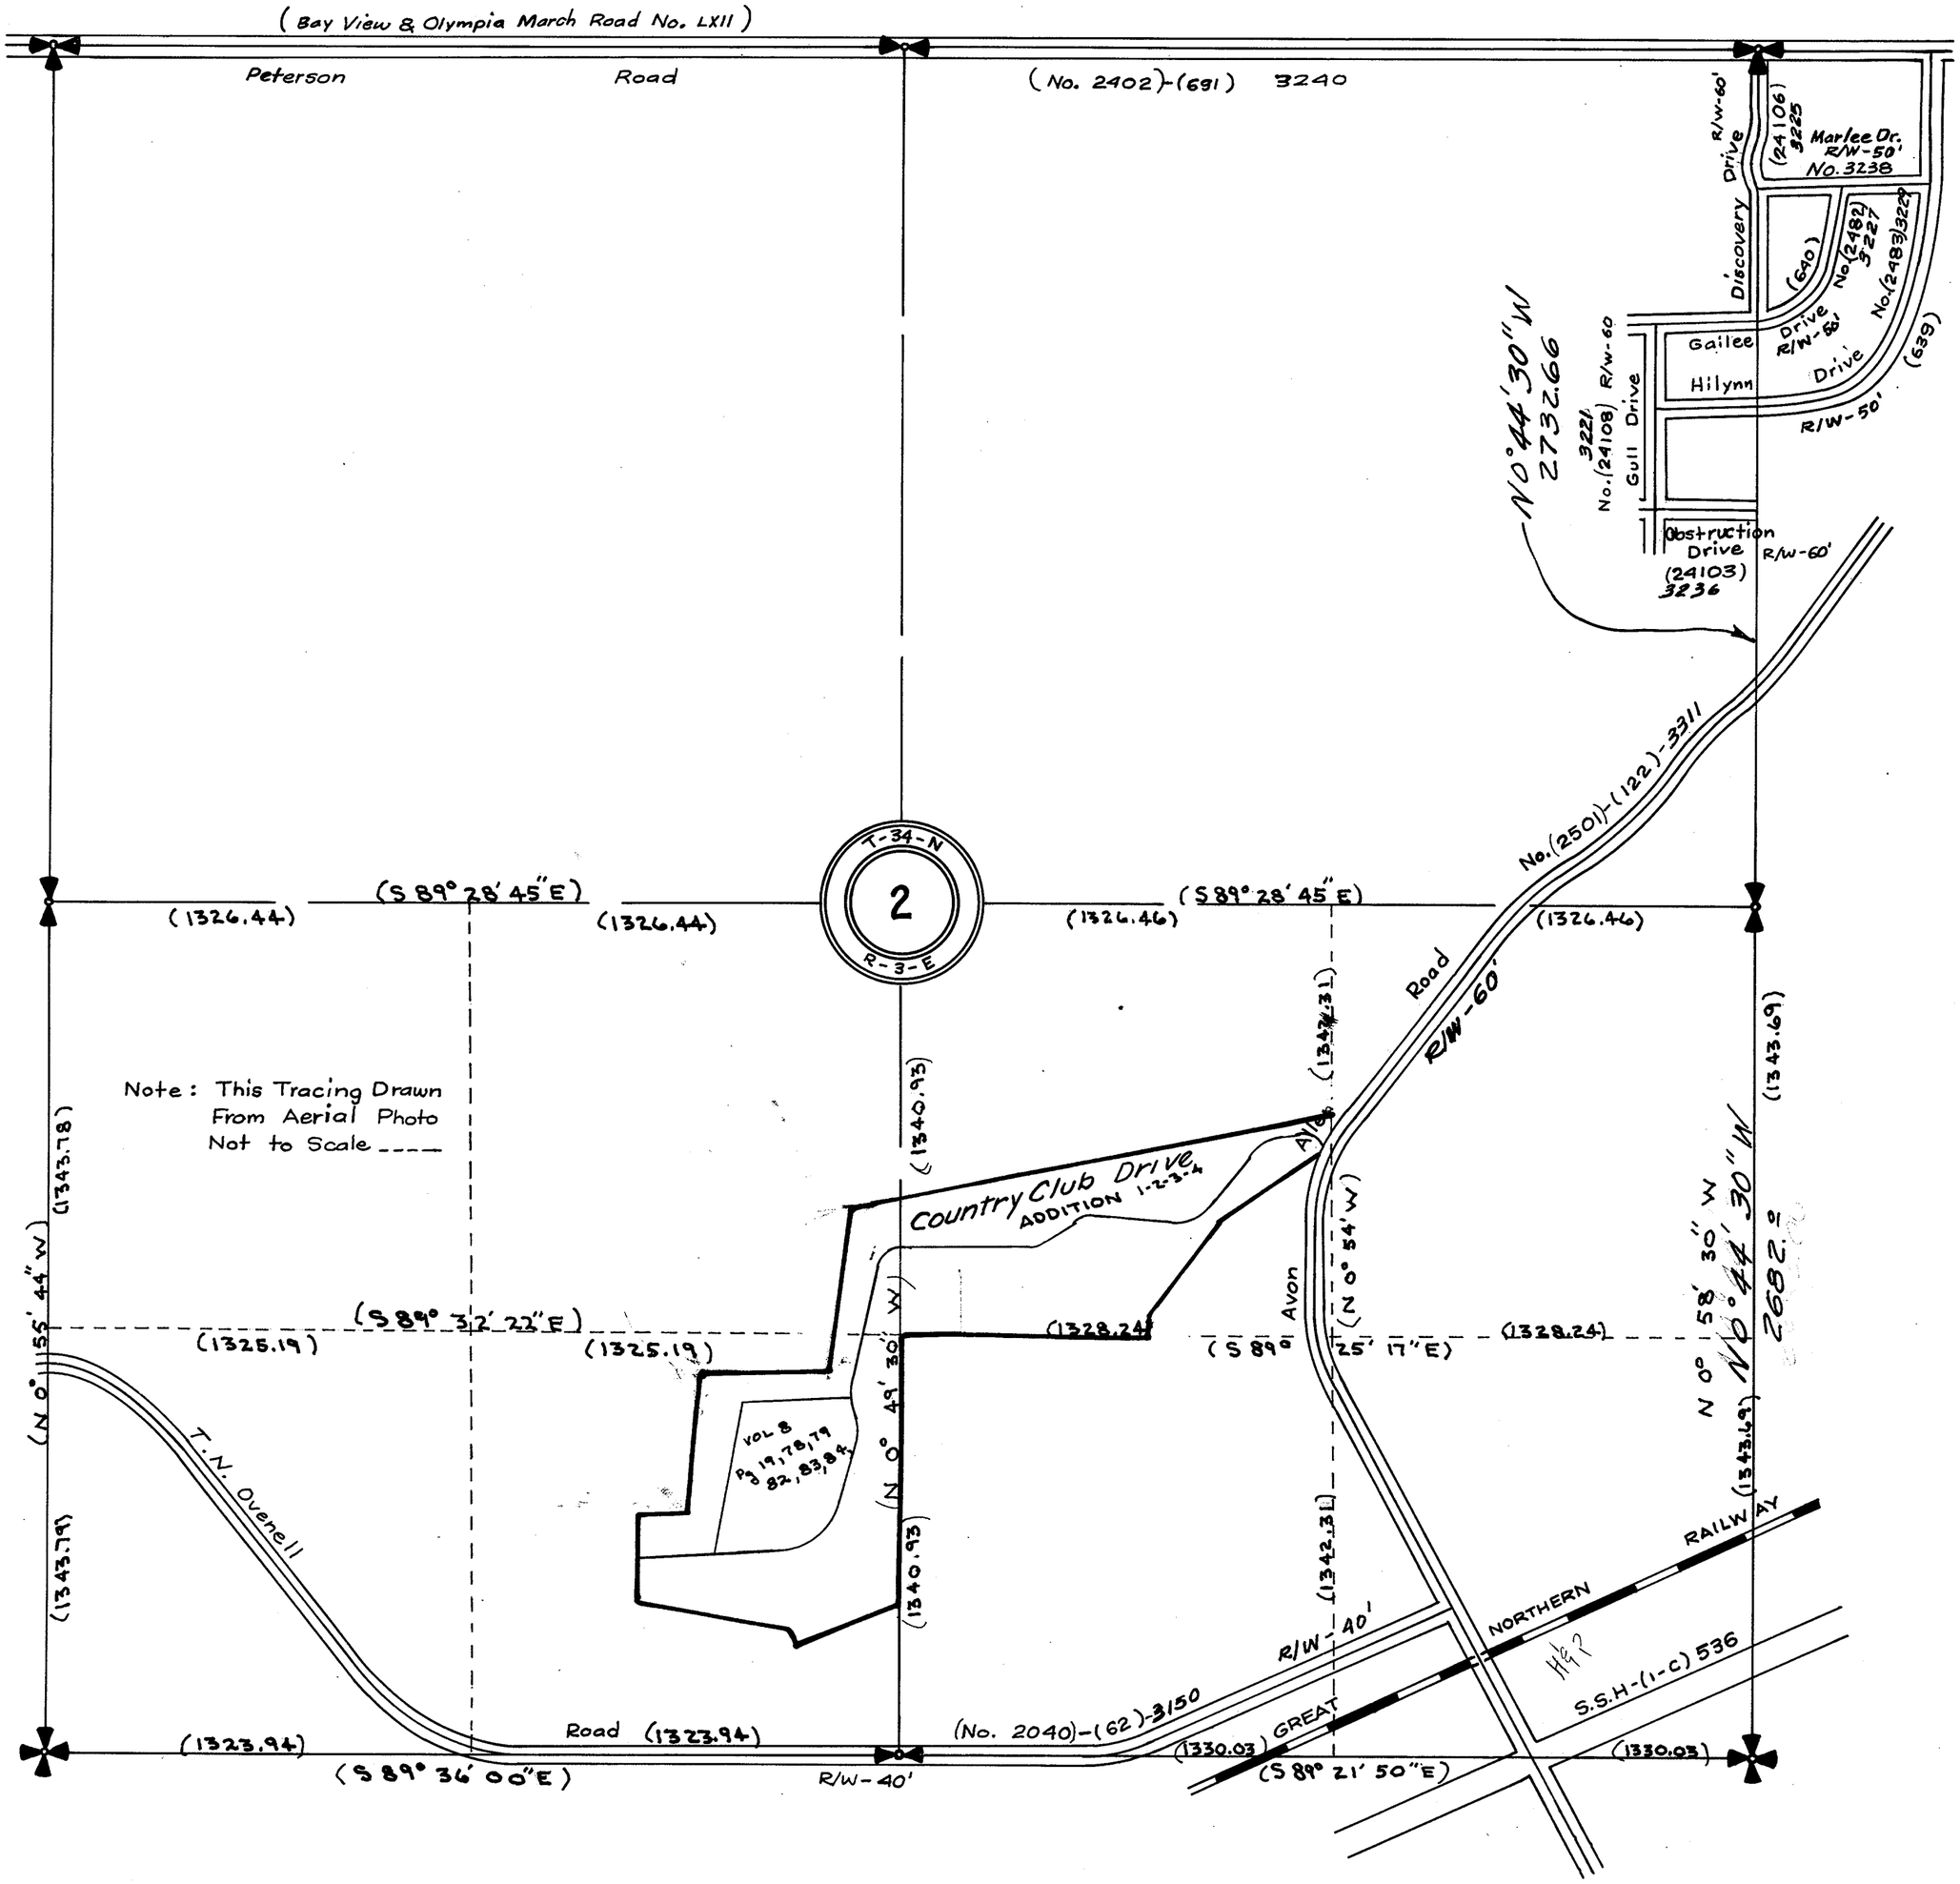


SECTION 2

TOWNSHIP 34 NORTH, RANGE 3 EAST, W. M.

SKAGIT COUNTY, WASH.

SCALE, 1 INCH--400 FEET

DATE June, 1959 Frank Gilkey COUNTY ENGINEER

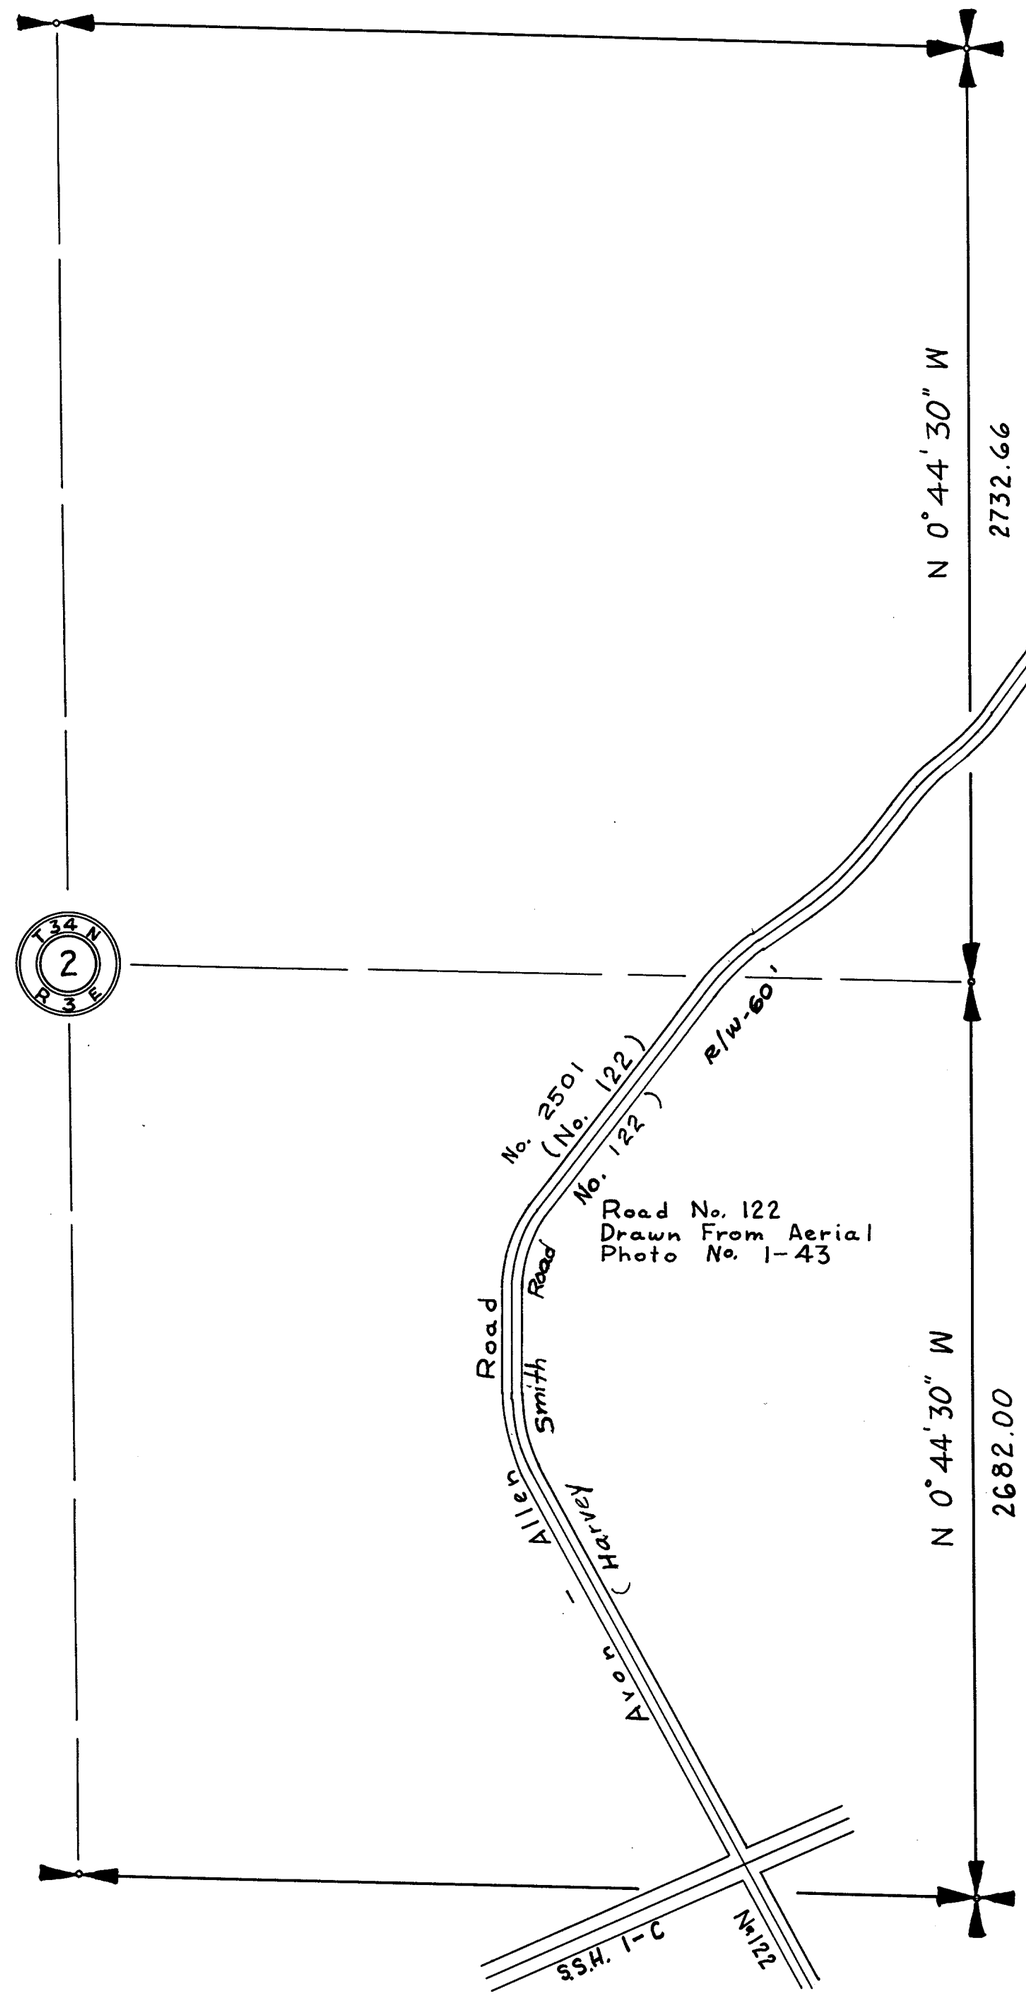

SECTION 2


TOWNSHIP 34 NORTH. RANGE 3 EAST. W. M.

SKAGIT COUNTY. WASH.

SCALE, 1 INCH—400 FEET

LLOYD JOHNSON COUNTY ENGINEER

DATE JULY 1974

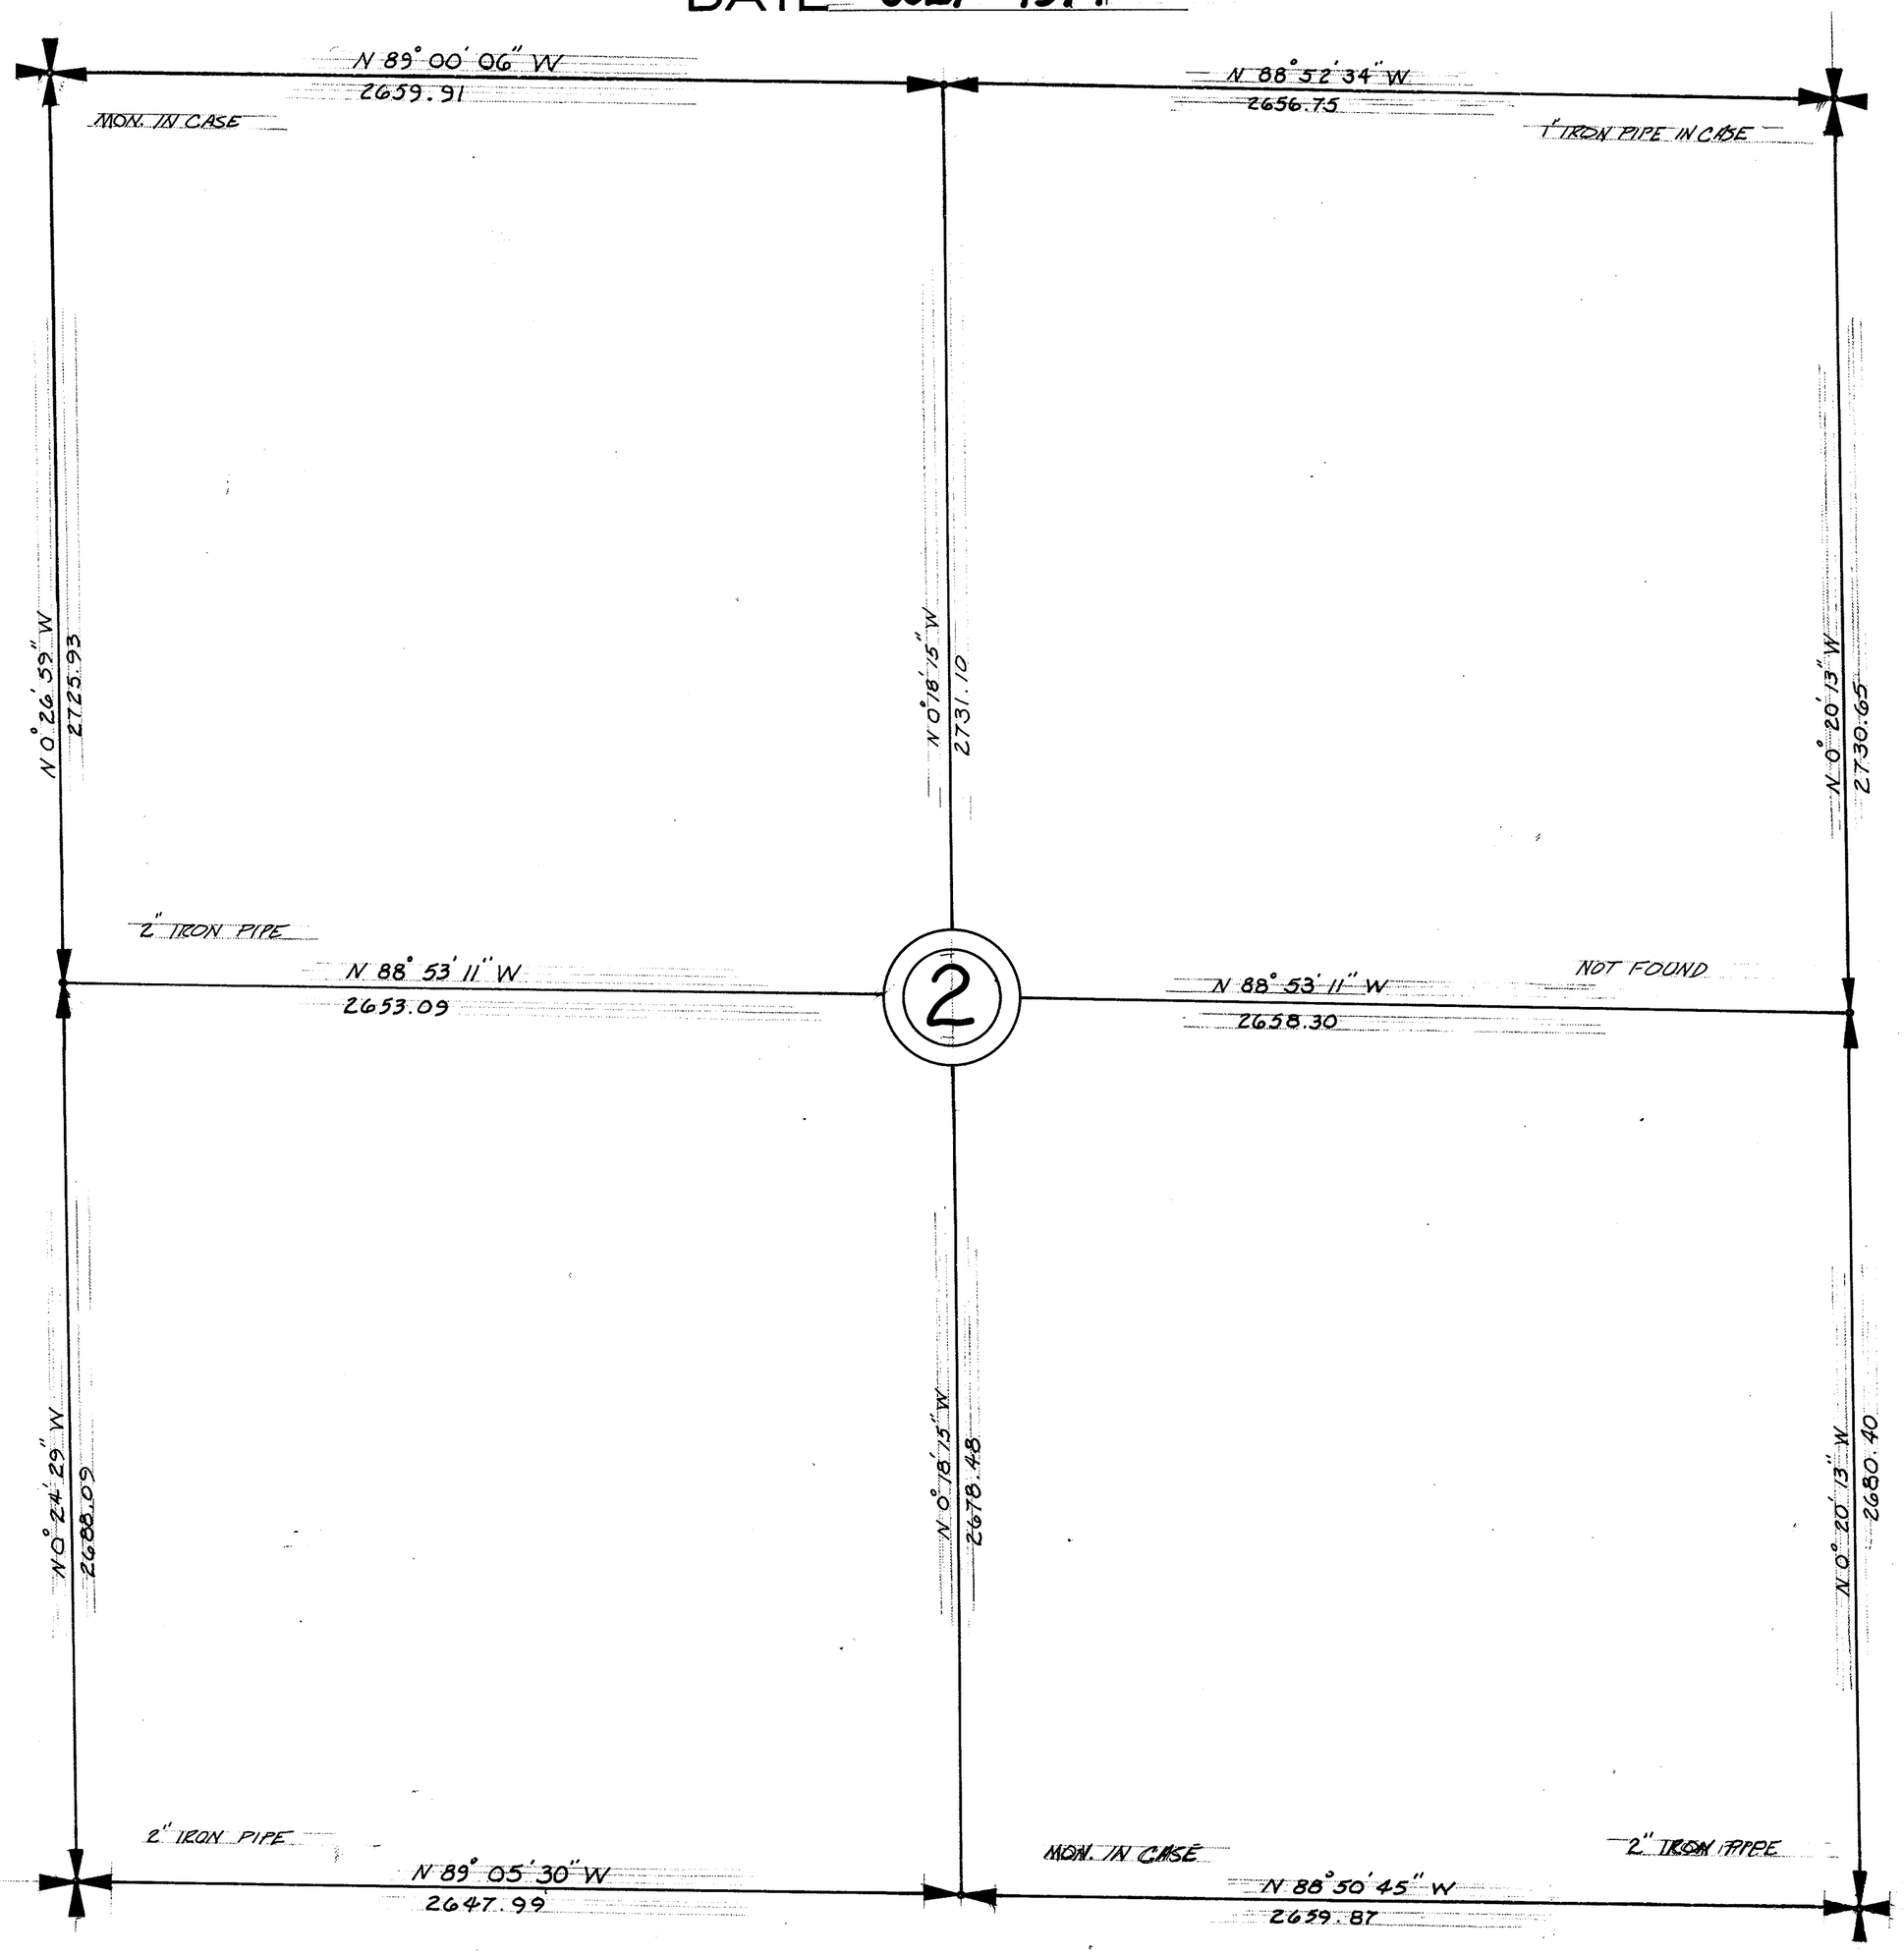


SECTION 3

TOWNSHIP 34 NORTH, RANGE 3 EAST, W. M.

SKAGIT COUNTY, WASH.

SCALE, 1 INCH--400 FEET

DATE June 29, 1966 Lloyd Johnson COUNTY ENGINEER

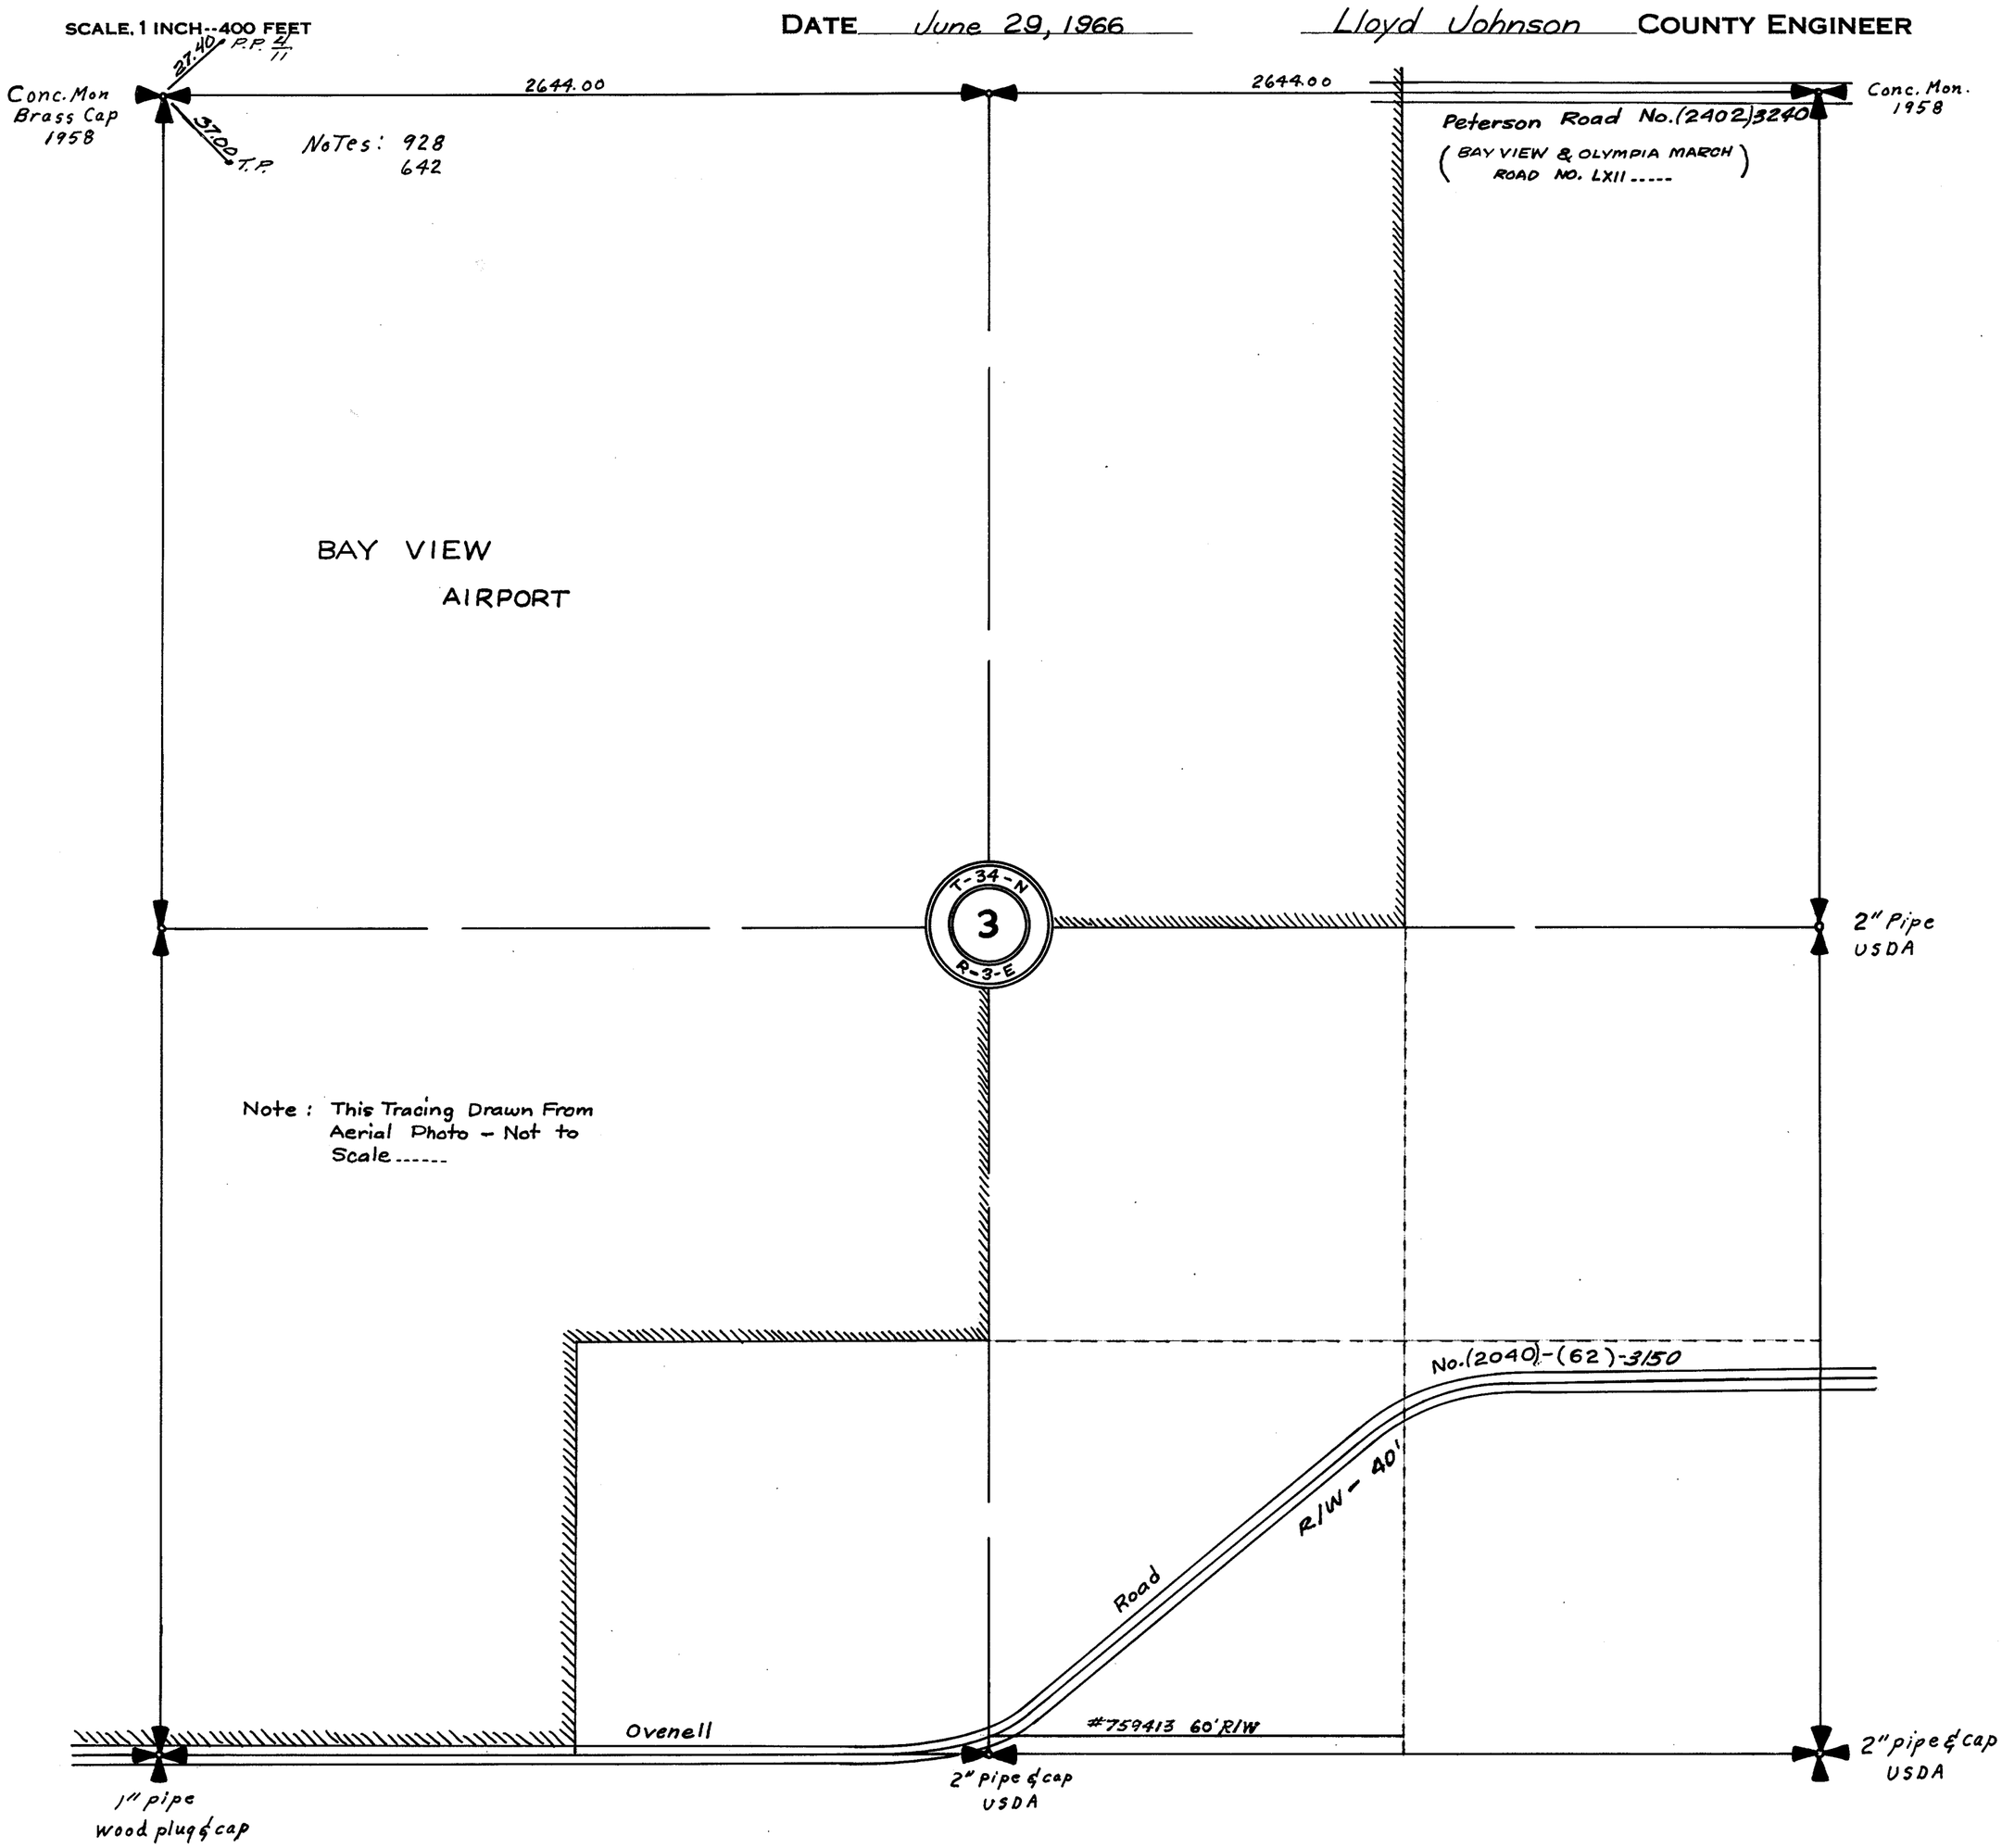

SECTION 4

TOWNSHIP 34 NORTH, RANGE 3 EAST, W. M.

SKAGIT COUNTY, WASH.

SCALE, 1 INCH--400 FEET

DATE June 29, 1966 Lloyd Johnson COUNTY ENGINEER

Bay View

Road No. 3210

64.30 Road No. (1542)

T. Pole (671) (60)

1½" Pipe

49.00

T. Pole

90°44'09"

2602.6

P. Pole (59) 30.70

P. Pole 31.00 (59)

112.30

P. Pole (58)

S89°06'W (33)

Rock with Cross

27.40

T. Pole (37)

2602.6

2602.48 (58)

Tack Loaded in 3" Rock 72.05

P. Pole (33) (28)

27.40

Set Conc. Mon with Brass Cap (58)

37.00

T. Pole (33) (40)

79.20

Tack Loaded in 30" Rock (28)

BAY VIEW AIR PORT

Notes: 251
473
928
1020

S.S.H. - (1-C) - 537

T-34-N
4
R-3-E

Cedar Stp.

37.1

55.0

12" Maple (58)

78.00

P. Pole (58)

75.60

4' Cedar Stp. (58)

12" Maple in Cluster (58)

N 0° 36' 38" W

S.S.H. - (1-C) - 537

3' Fir Stp.

30.20

12" Fir Stp.

42.00

N 88° 36' 22" E (63)

2" Pipe

Ovenell Road No. 3150 (No. 1040 — 2040) - (62) R/W - 40'

DIST. NO. 1 | DIST. NO. 2


SECTION 4

TOWNSHIP 34 NORTH, RANGE 3 EAST, W. M.

SKAGIT COUNTY, WASH.

SCALE, 1 INCH--400 FEET

_____ COUNTY ENGINEER

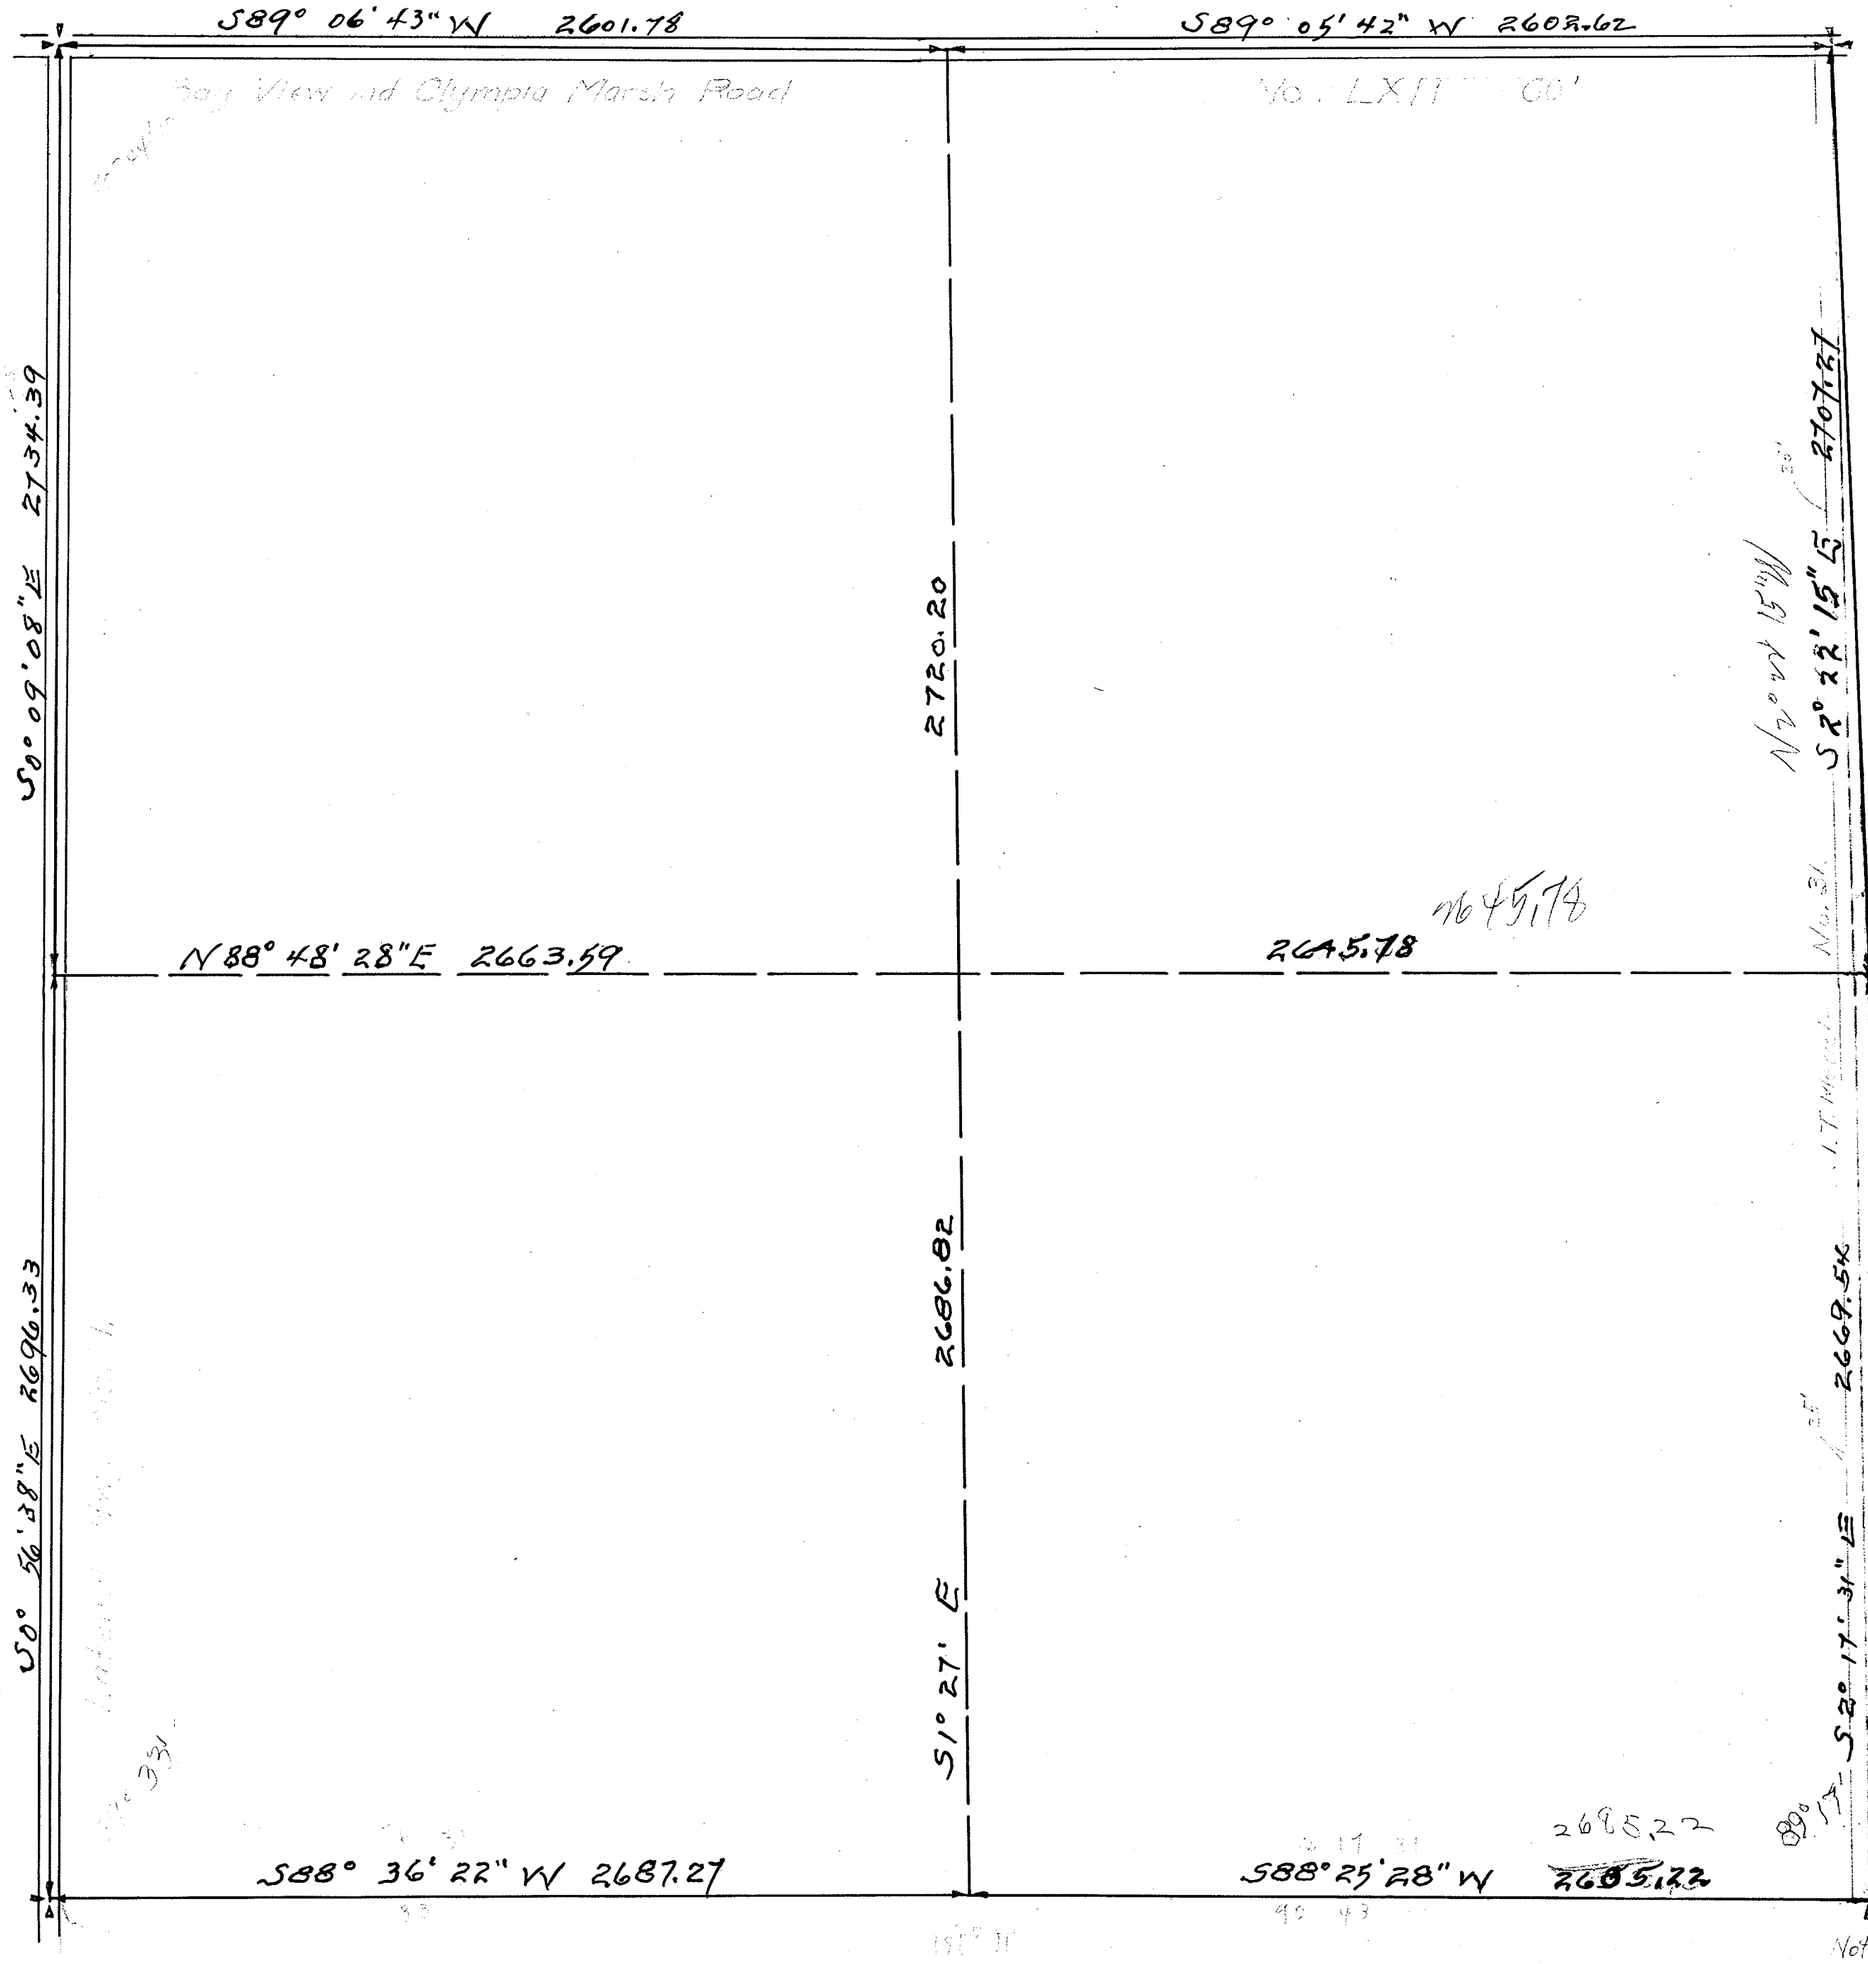


SECTION 4

TOWNSHIP 34 NORTH, RANGE 3 EAST, W. M.
SKAGIT COUNTY, WASH.

SCALE, 1 INCH–400 FEET

W.E. Costello COUNTY ENGINEER

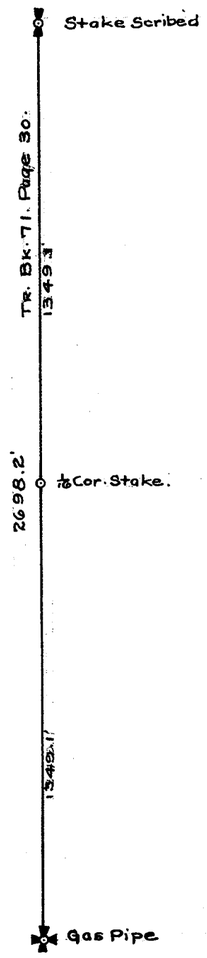

SECTION 5


TOWNSHIP 34 NORTH, RANGE 3 EAST, W. M.

SKAGIT COUNTY, WASH.

SCALE, 1 INCH--400 FEET

DATE July 16, 1963

COUNTY ENGINEER

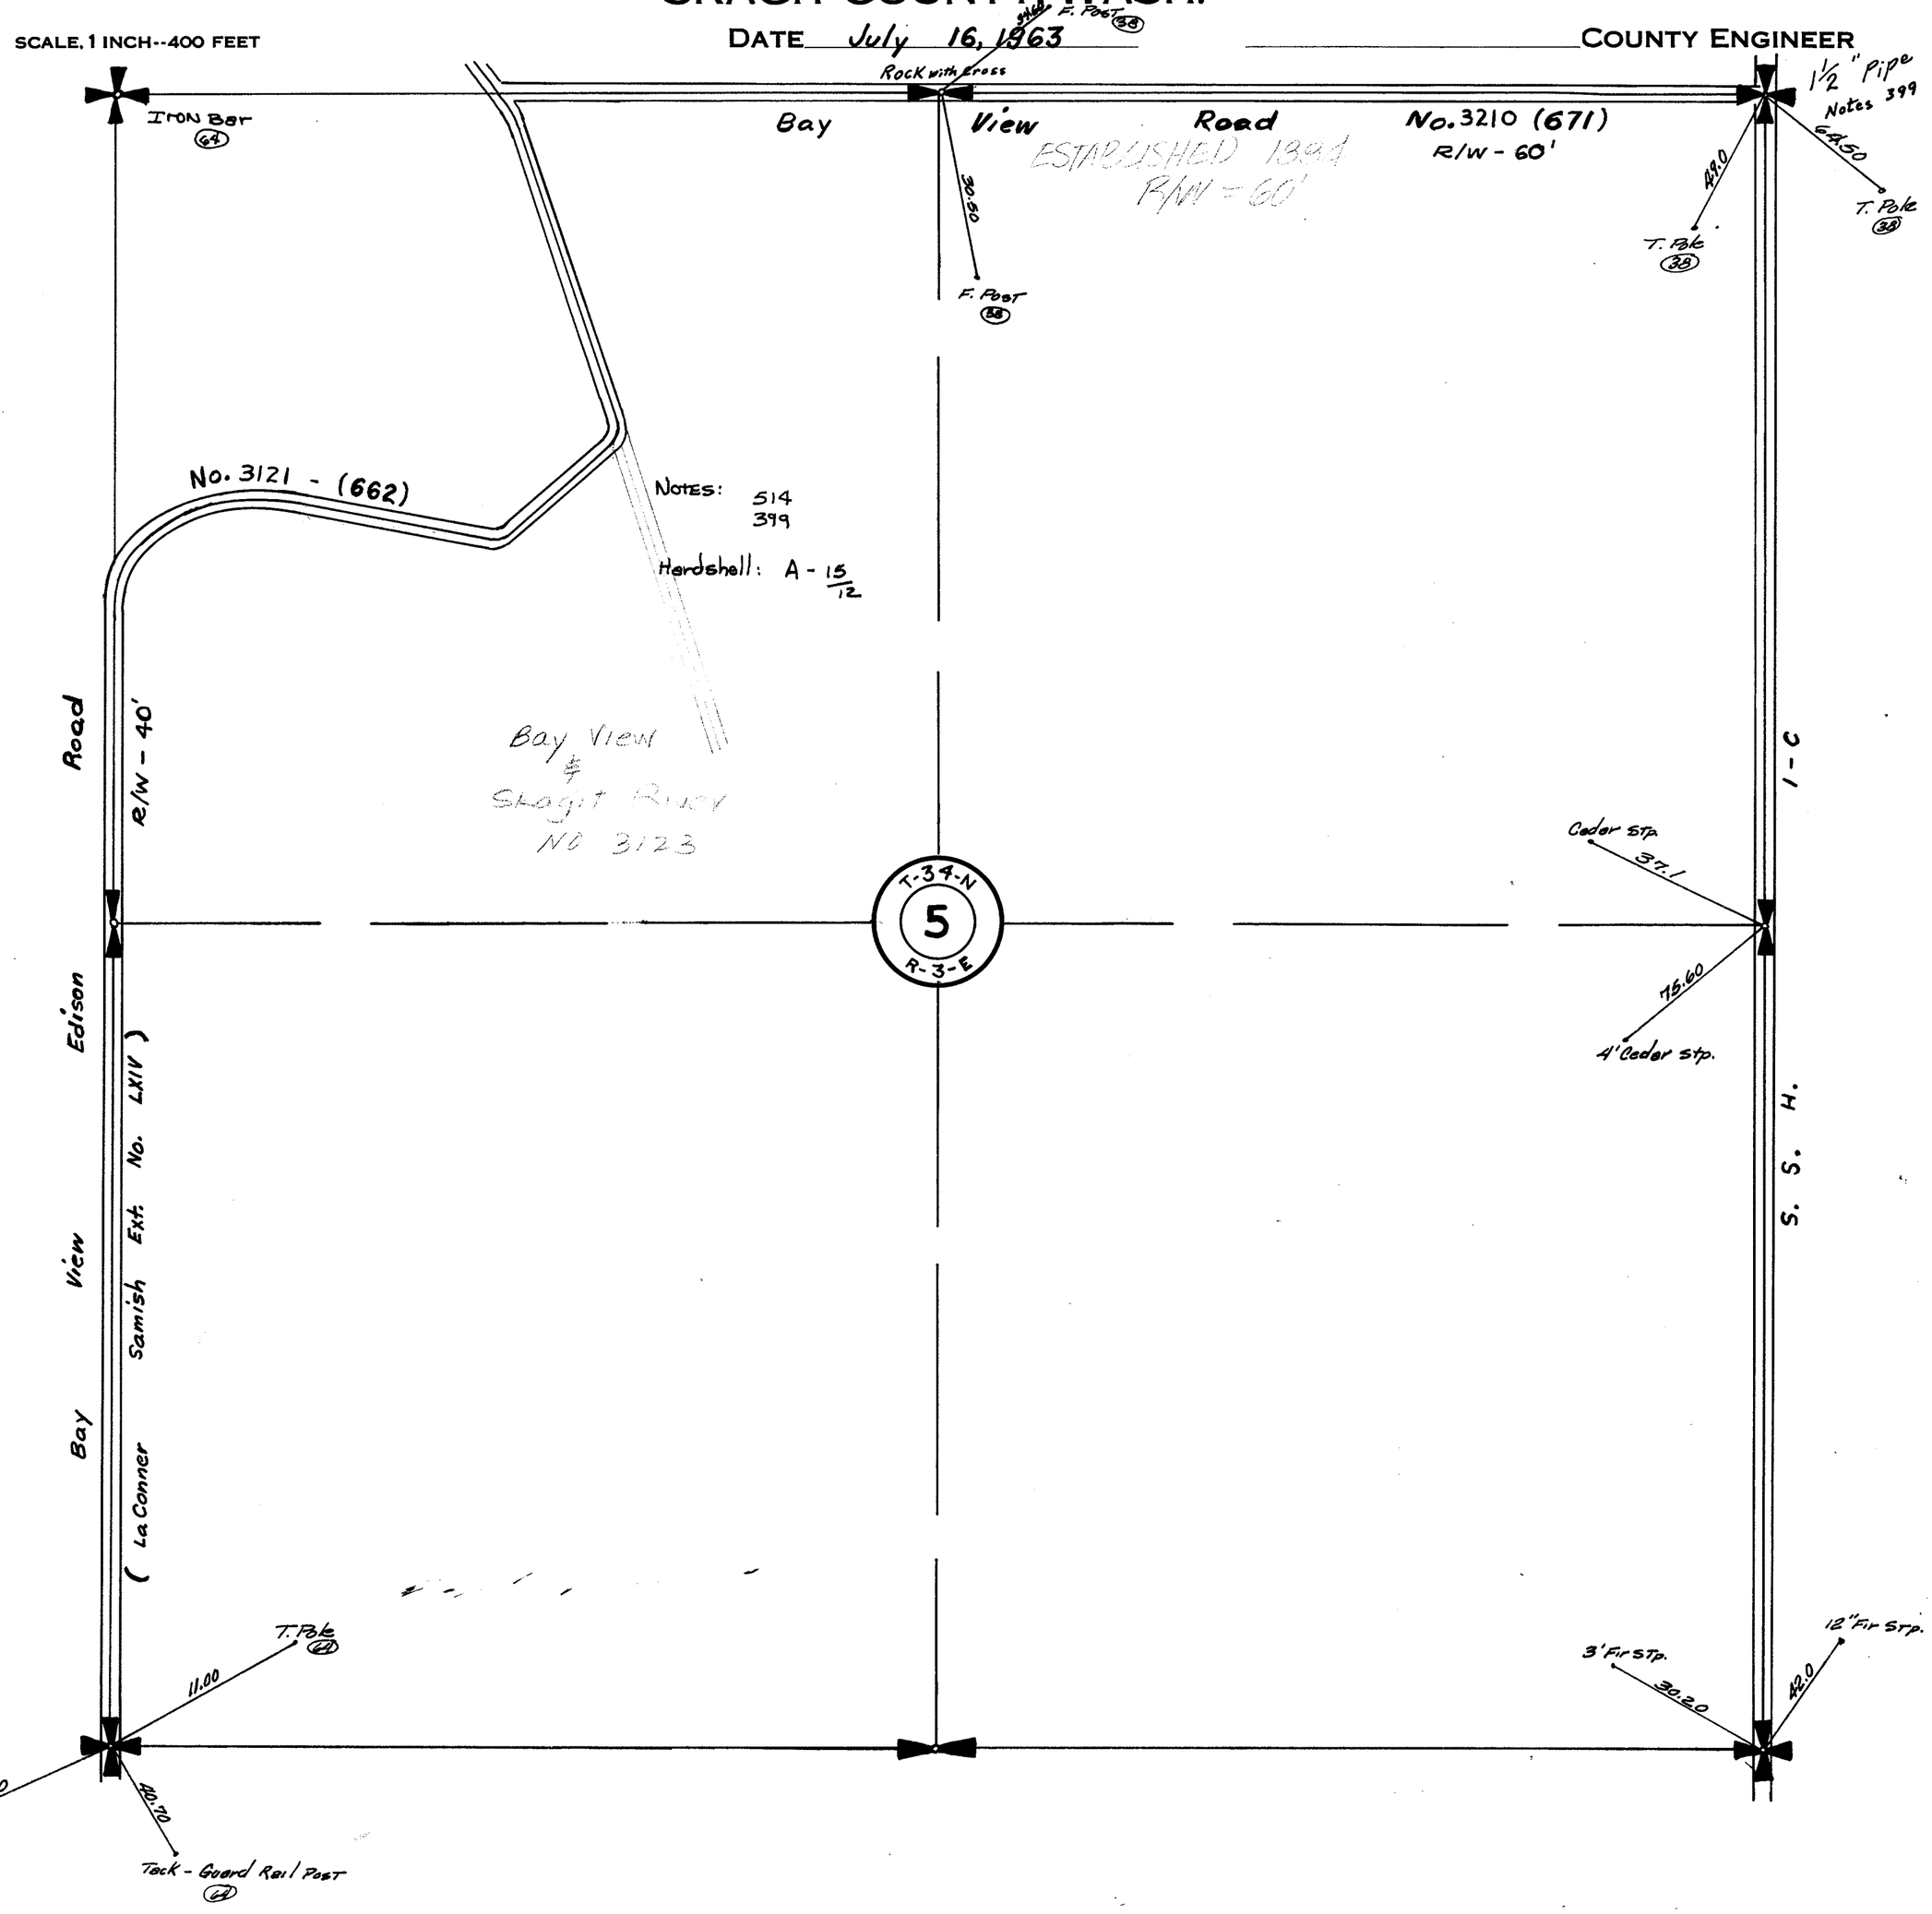


SECTION 5

TOWNSHIP 34 NORTH, RANGE 3 EAST, W. M.

SKAGIT COUNTY, WASH.

SCALE, 1 INCH–400 FEET

W.E. Costello COUNTY ENGINEER

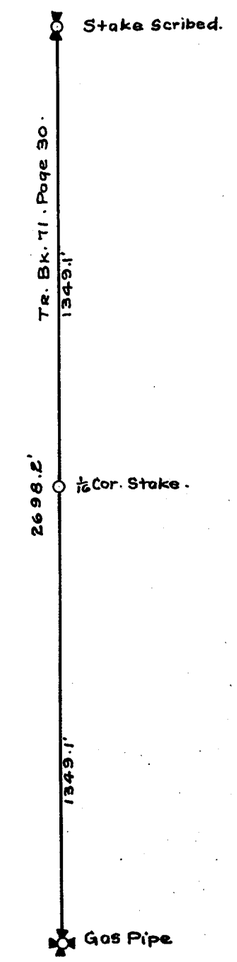


SECTION 5

TOWNSHIP 34 NORTH, RANGE 3 EAST, W. M.

SKAGIT COUNTY, WASH.

SCALE, 1 INCH--400 FEET

DATE June, 1959 Frank Gilkey COUNTY ENGINEER

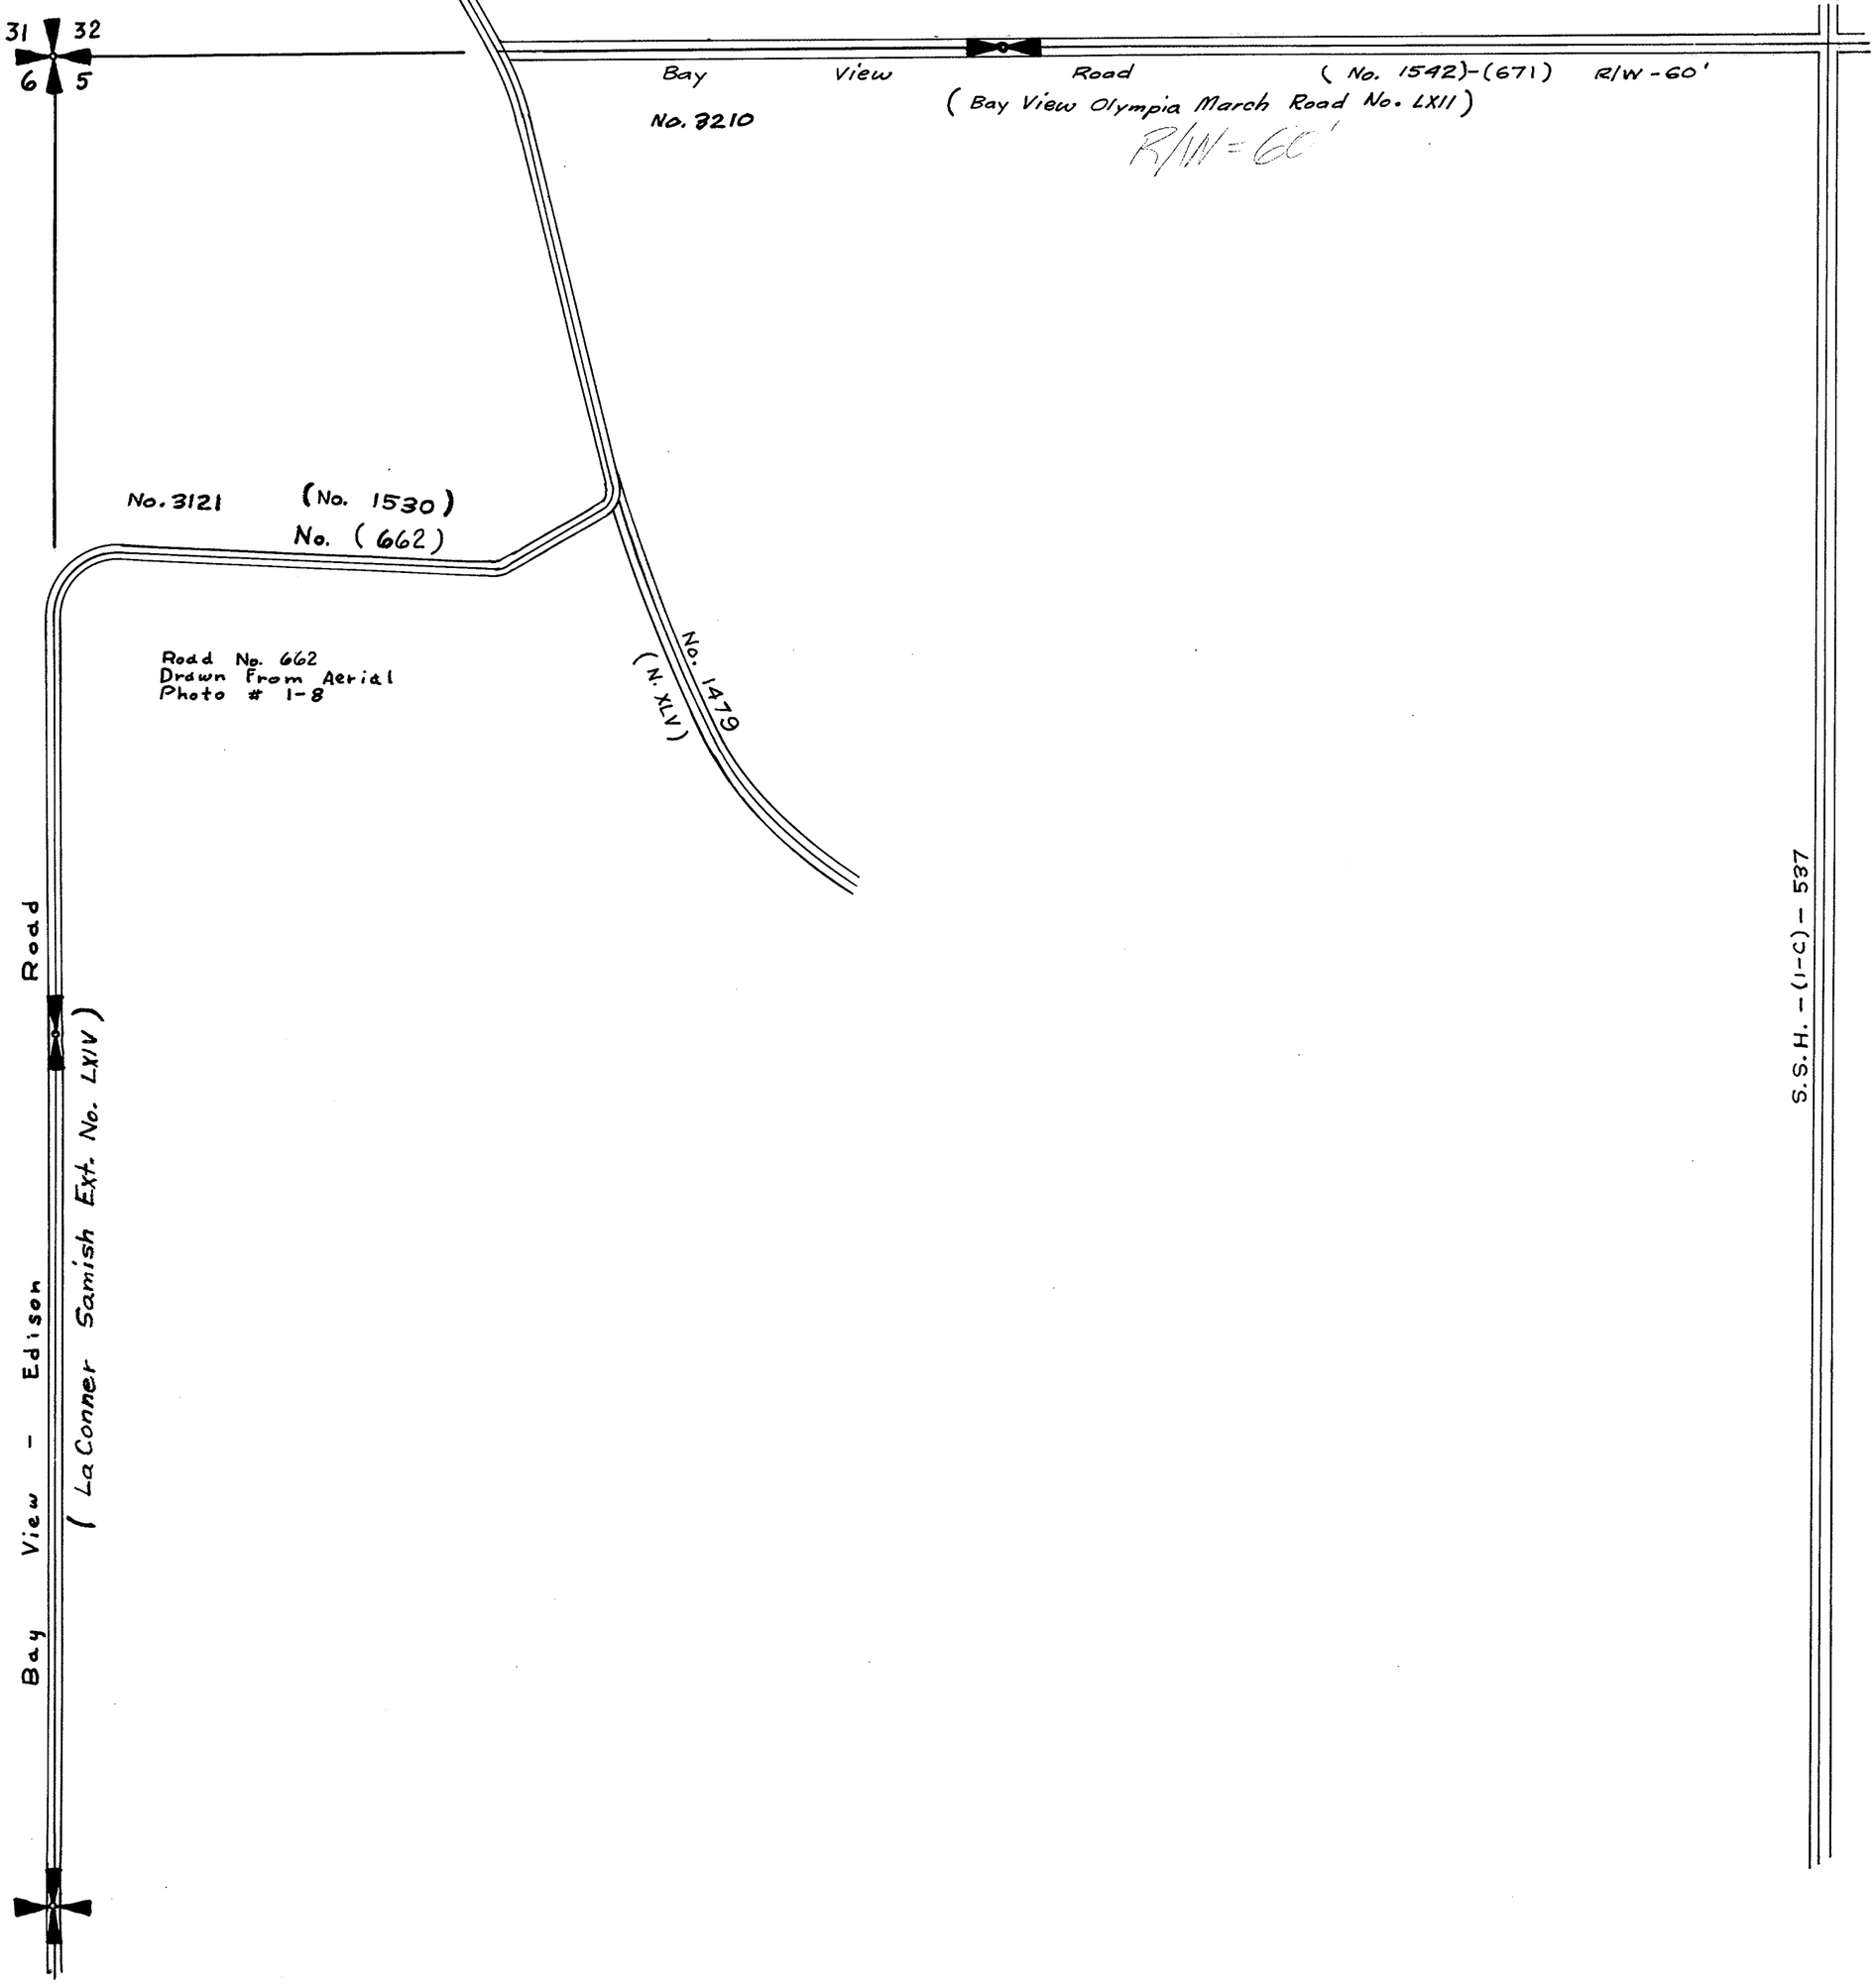

SECTION 6


TOWNSHIP 34 NORTH, RANGE 3 EAST, W.M.

SKAGIT COUNTY, WASH.

SCALE 1 INCH = 400 FEET

DATE APRIL 20, 1972

LLOYD H JOHNSON COUNTY ENGINEER

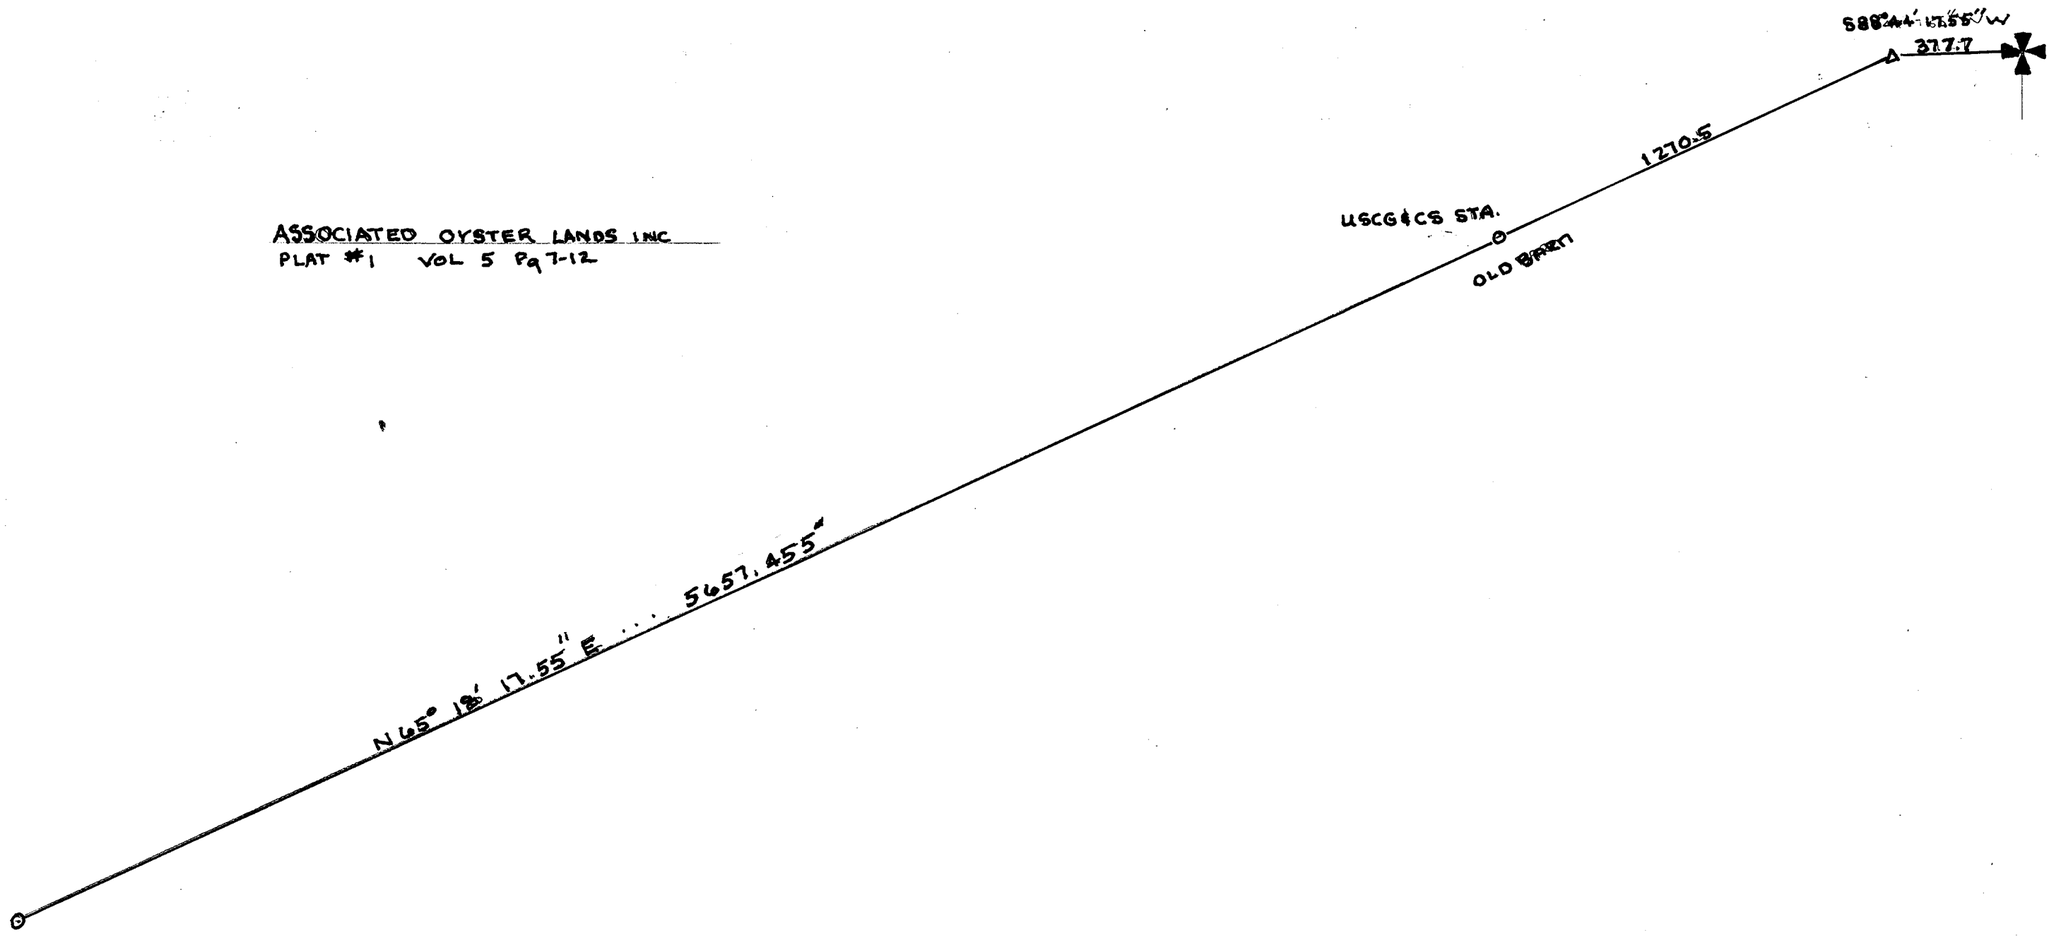

SECTION 7
TOWNSHIP 34 NORTH, RANGE 3 EAST, W. M.
SKAGIT COUNTY, WASH.

SCALE, 1 INCH--400 FEET

G.D LeGro COUNTY ENGINEER
August 1958

NOTES: 514

GATE P.
53.70
12.60 T.P.
87.00
GRAINARY

Road (No. 662) (No. 1513)-No. 3121
Bay View - Edison

T 34 N
7
R 3 E

Road No. 637 Drawn
From Aerial No. 1-6
June, 1959

R/W - 40'

(No. 1513)
(No. 662)
View - Edison)
(Bay Whitney - to - Bayview No. 3122
R/W - 40

La Conner - Whitney Road (No. 4241)
(No. 1459)
(La Conner - Whitney Rd. No. 635)
(La Conner-Samish Ext. LX1V)
R/W - 40'

S. 89°57' E.
2642.5
1/16 cor
1321.25
7
8
18
17

SECTION 8

TOWNSHIP 34 NORTH, RANGE 3 EAST, W. M.


SKAGIT COUNTY, WASH.

SCALE, 1 INCH--400 FEET

DATE Aug. 8, 1963

COUNTY ENGINEER

Dr. By W.G. Wells

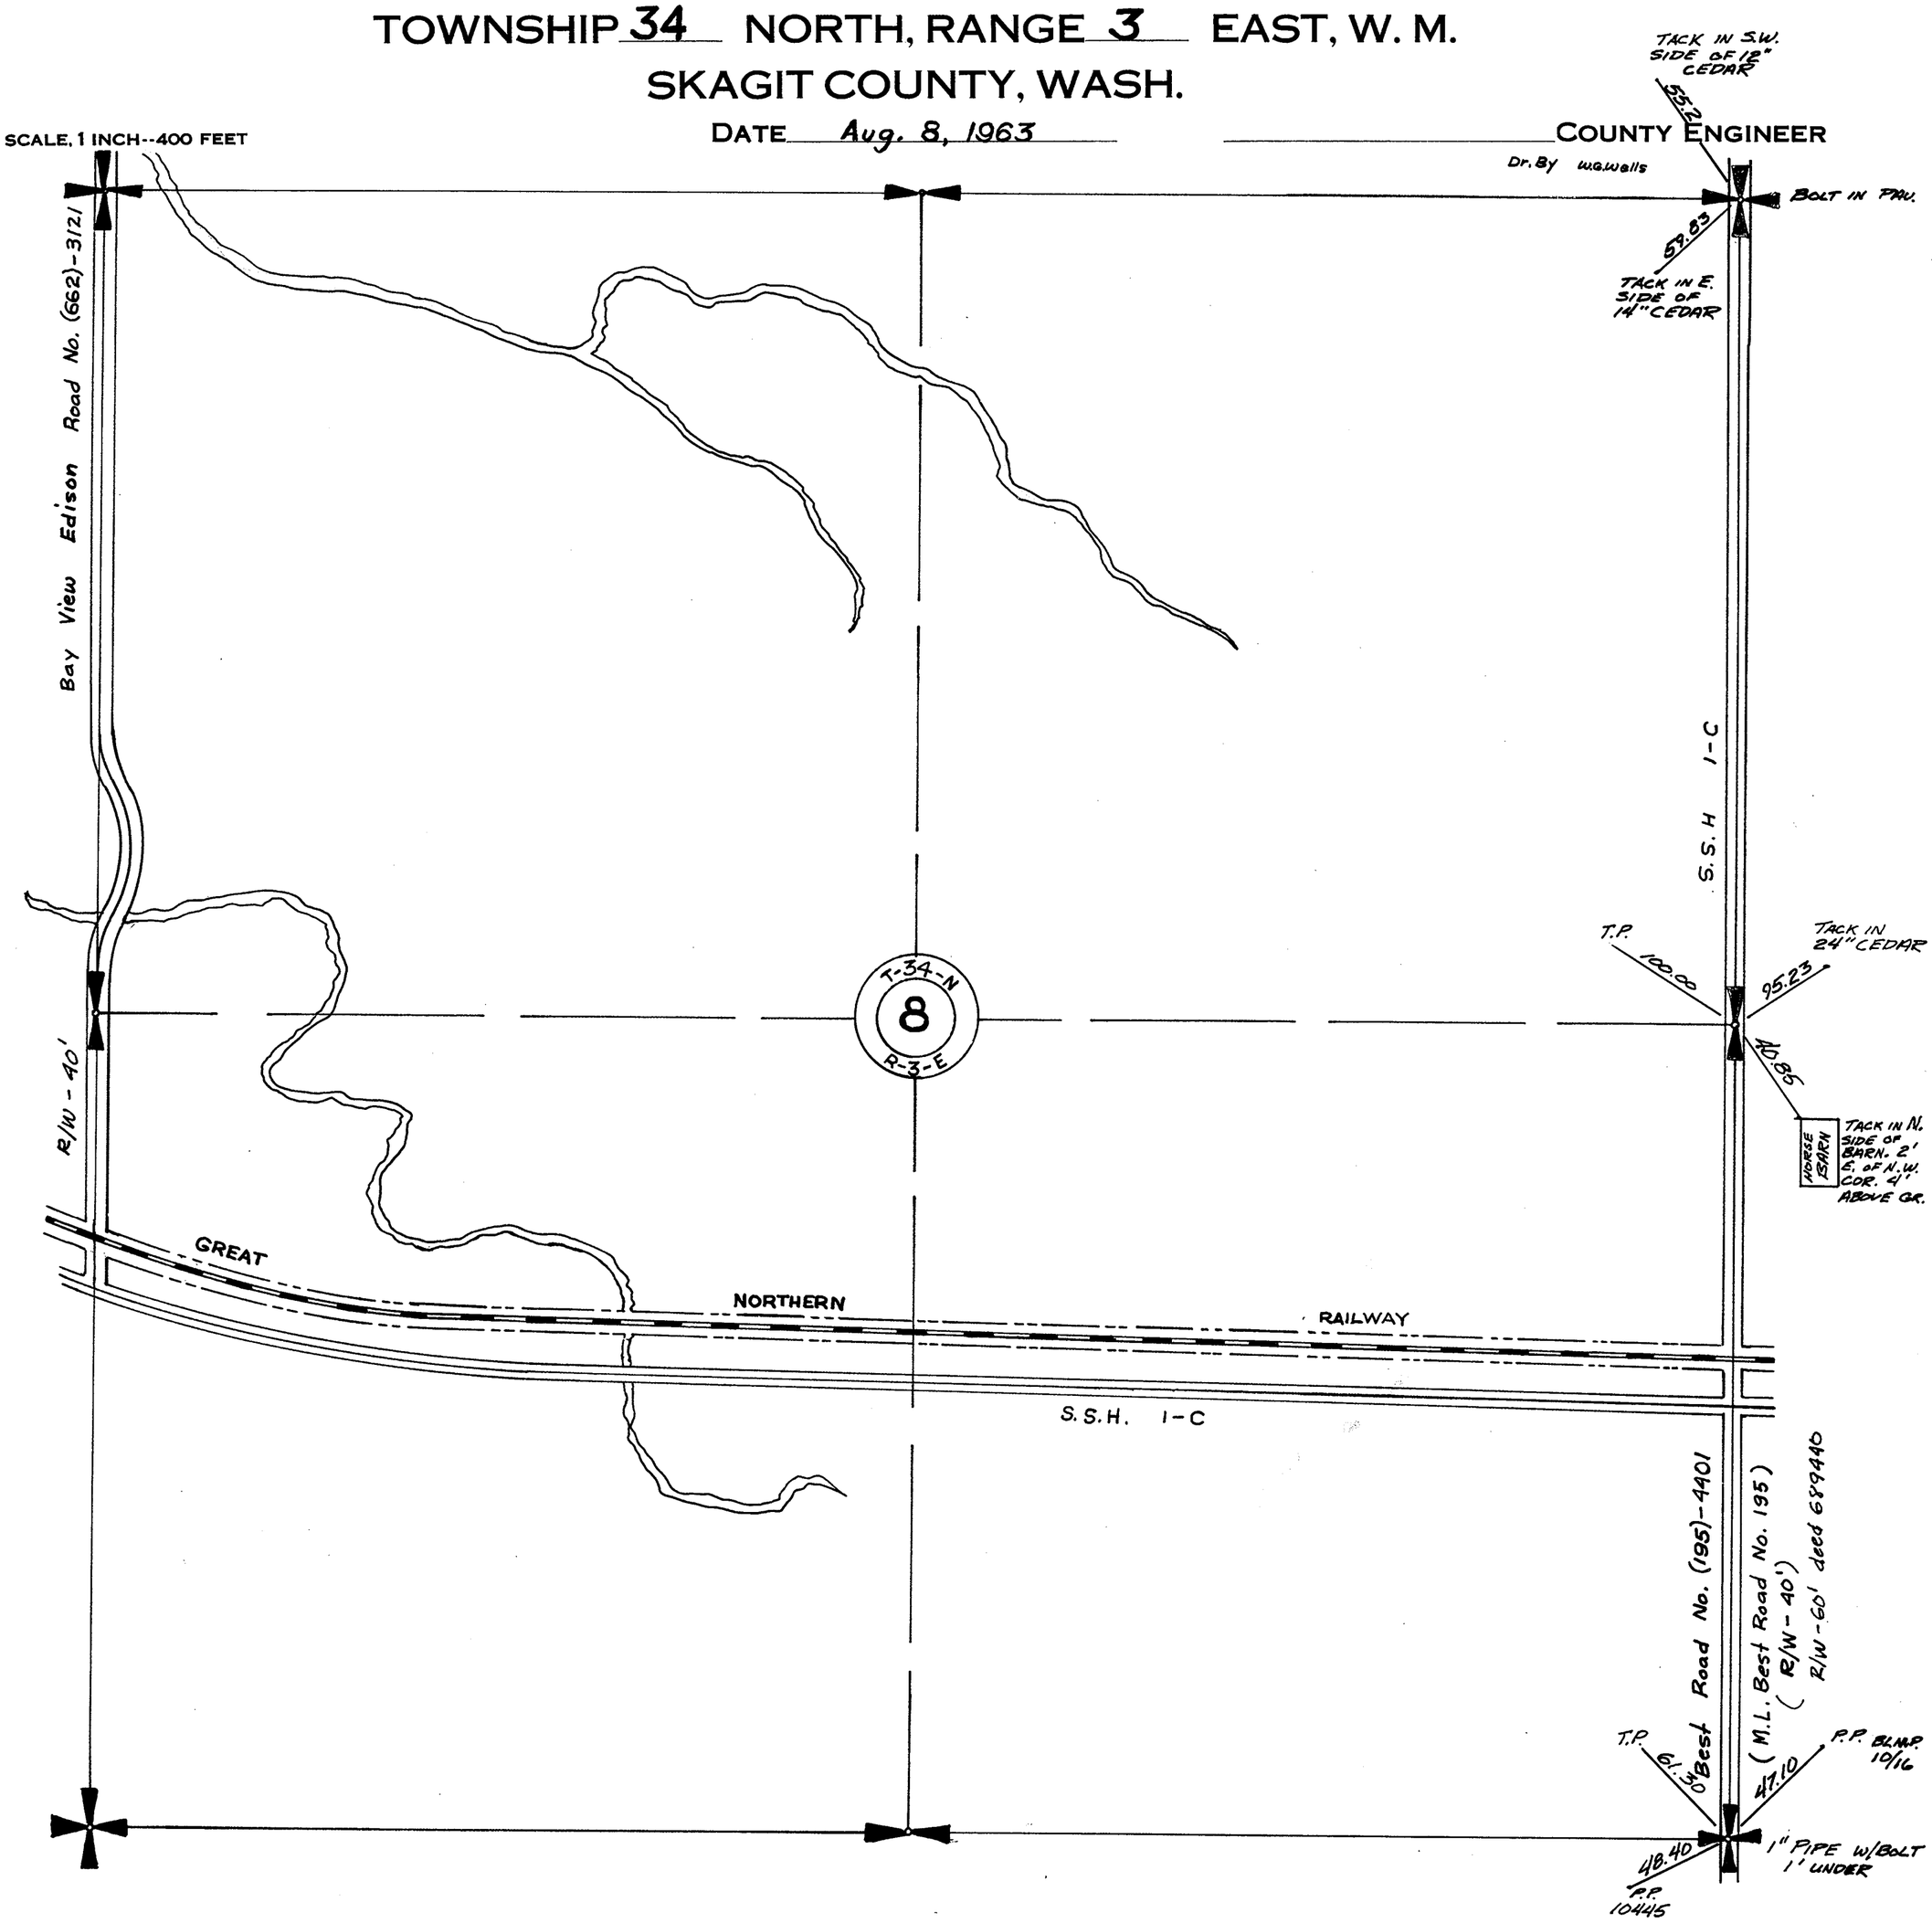


SECTION 8


SKAGIT COUNTY, WASH.

SCALE, 1 INCH—400 FEET


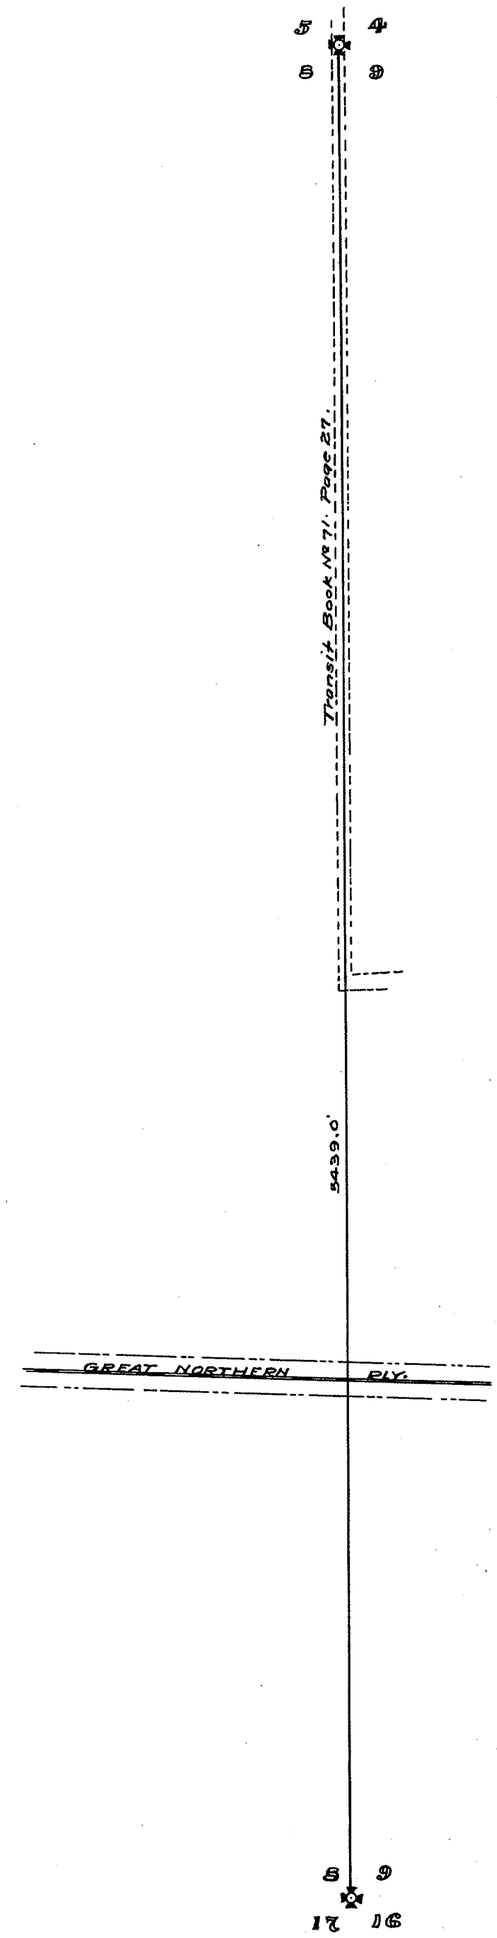

SECTION 9

TOWNSHIP 34 NORTH, RANGE 3 EAST, W. M.

SKAGIT COUNTY, WASH.

DATE July 1, 1966 — Lloyd Johnson COUNTY ENGINEER

SCALE, 1 INCH--400 FEET

3' Fir Stp.
30.20
12" Fir Stp.
42.00
2" Pipe

Notes: 736
F 161

T. Pole
100.00
S.S.H. - (1-C) - 537
95.23
24" Cedar
Tack & Nail
40.85
Tack
Horse Shed

CAR AXEL 18" B.S.
N 45° 30' E
12" Alder
S 78° 15' E
29.50
F. Post

RAILWAY
NORTHERN
GREAT
(Swinomish Ave. & Mill Street)
No. (1450)-(394) 3090
Fredonia R/W - 80' - (see plat)
S.S.H. - (1-C)
S.S.H. - (1-C) - 536

440'
Best Road No. (1467)-(195)
(R/W - 40')
R/W - 60'
deed #689440

P. Pole # 10444
(52)
42.20
47.10
P. Pole
48.20
P. Pole # 10445
(52)

S. R. Young Road (No. 1042) (No. 2042) No. 4600
Set Spike top of O.L.
(52)
MON.
Dist. #1
Dist. #2
Found old hub with 60 penny spike
(58)
R/W - 40'
MON.
25.0
F. Post
(53)
21.44
T. Pole
(53)


SECTION 9

TOWNSHIP 34 NORTH, RANGE 3 EAST, W. M.

SKAGIT COUNTY, WASH.

SCALE, 1 INCH–400 FEET

W.E. Costello COUNTY ENGINEER

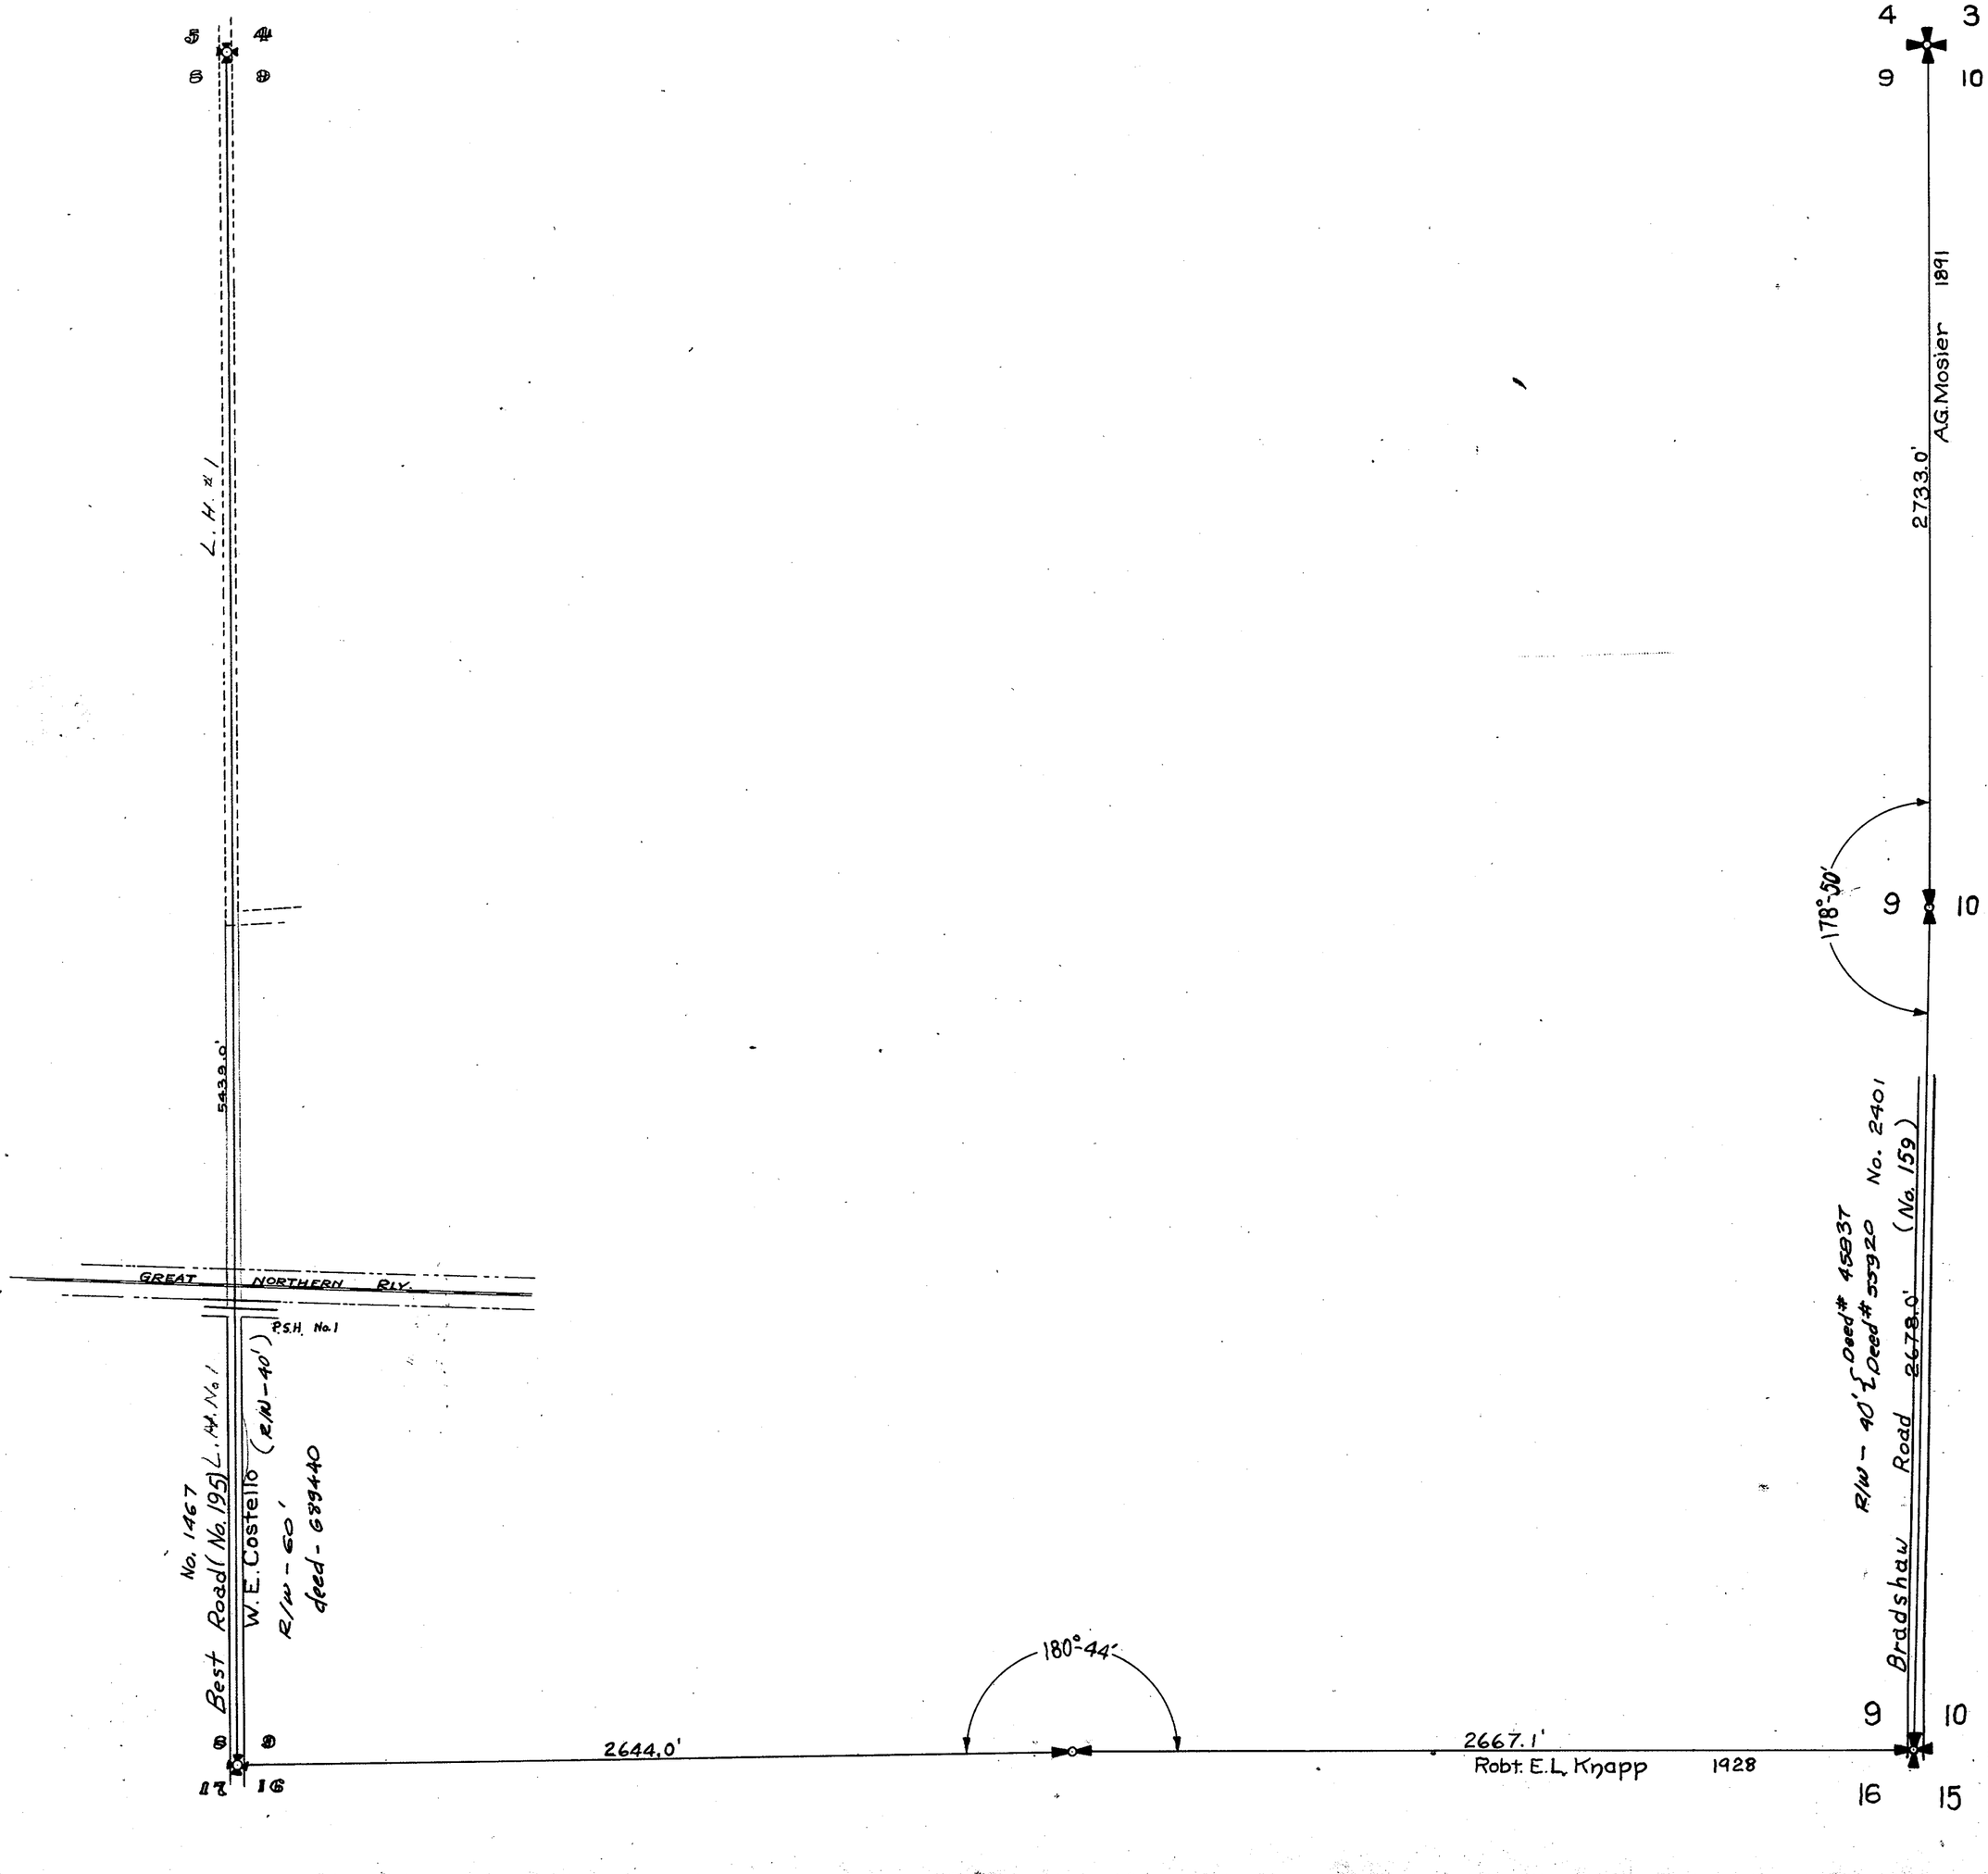


SECTION 9

TOWNSHIP 34 NORTH. RANGE 3 EAST. W. M.
SKAGIT COUNTY. WASH.

SCALE. 1 INCH–400 FEET
Platted – R.A.K.

Robt. E.L. Knapp COUNTY ENGINEER
Oct. 1931.


Notes G 189/187 89
G 187

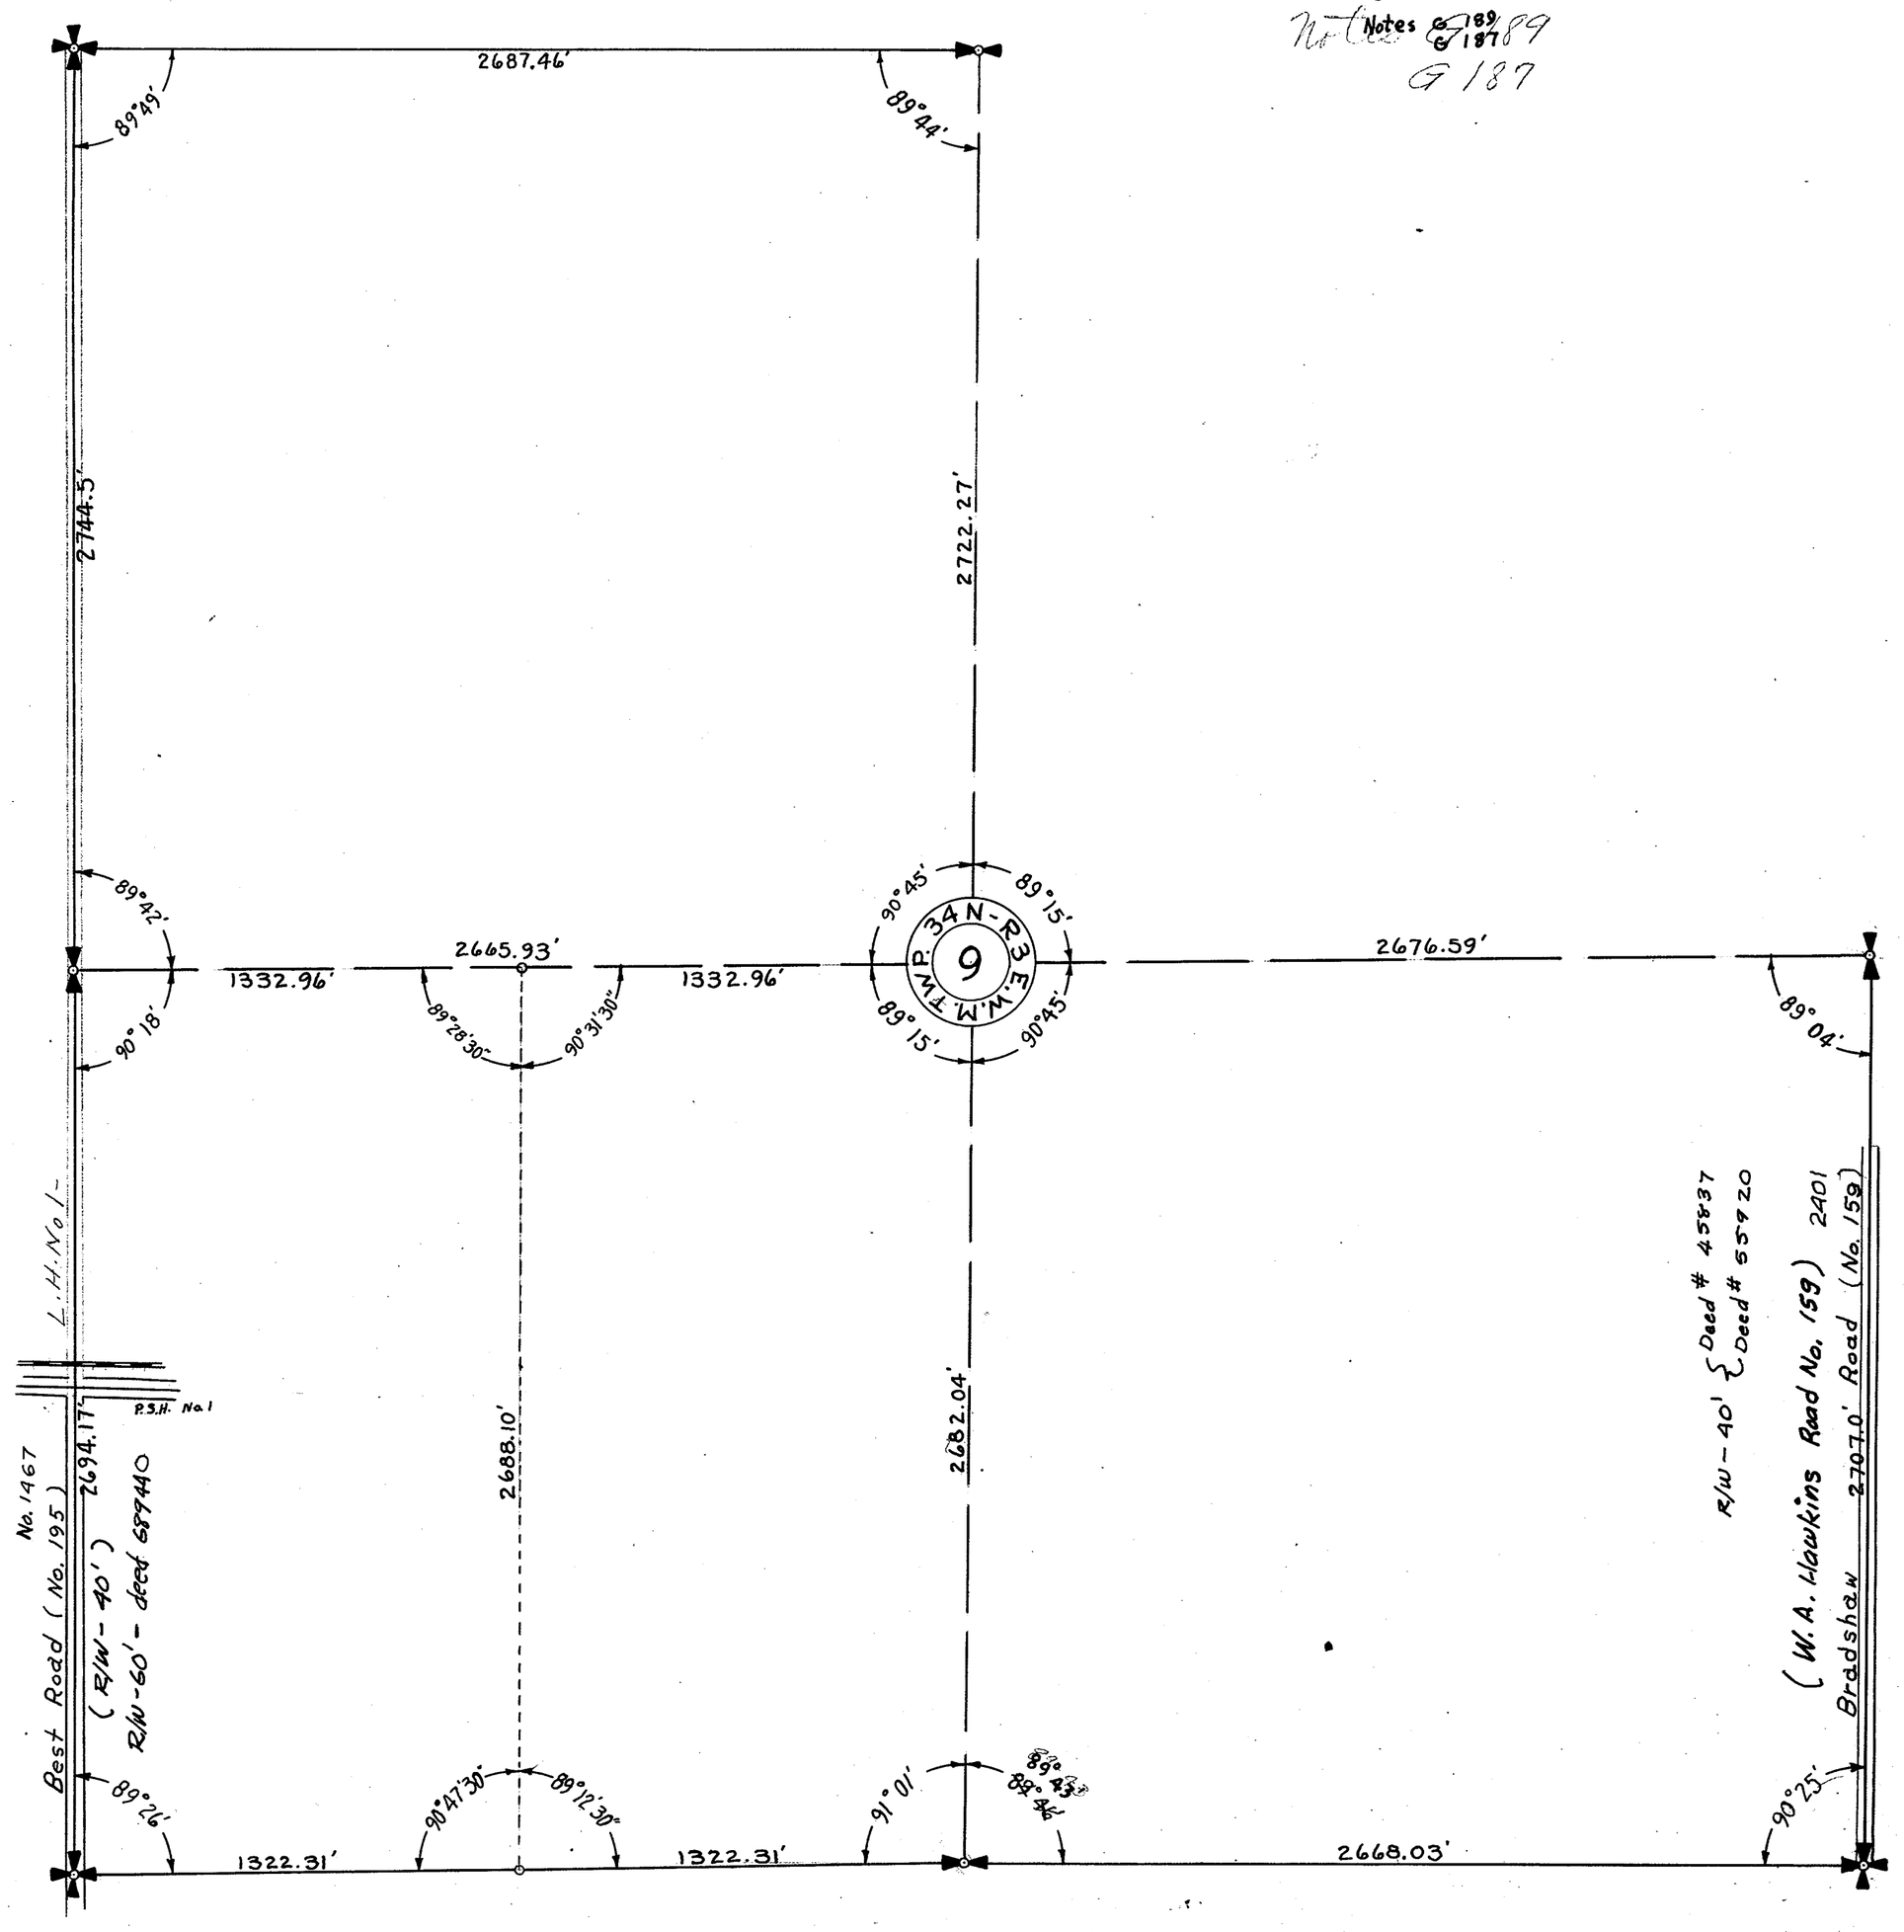

SECTION 10
TOWNSHIP 34 NORTH, RANGE 3 EAST, W. M.
SKAGIT COUNTY, WASH.

SCALE, 1 INCH--400 FEET
Platted 6-20-41 WCW.

H.O. WALBERG COUNTY ENGINEER
Notes H-224
F-161

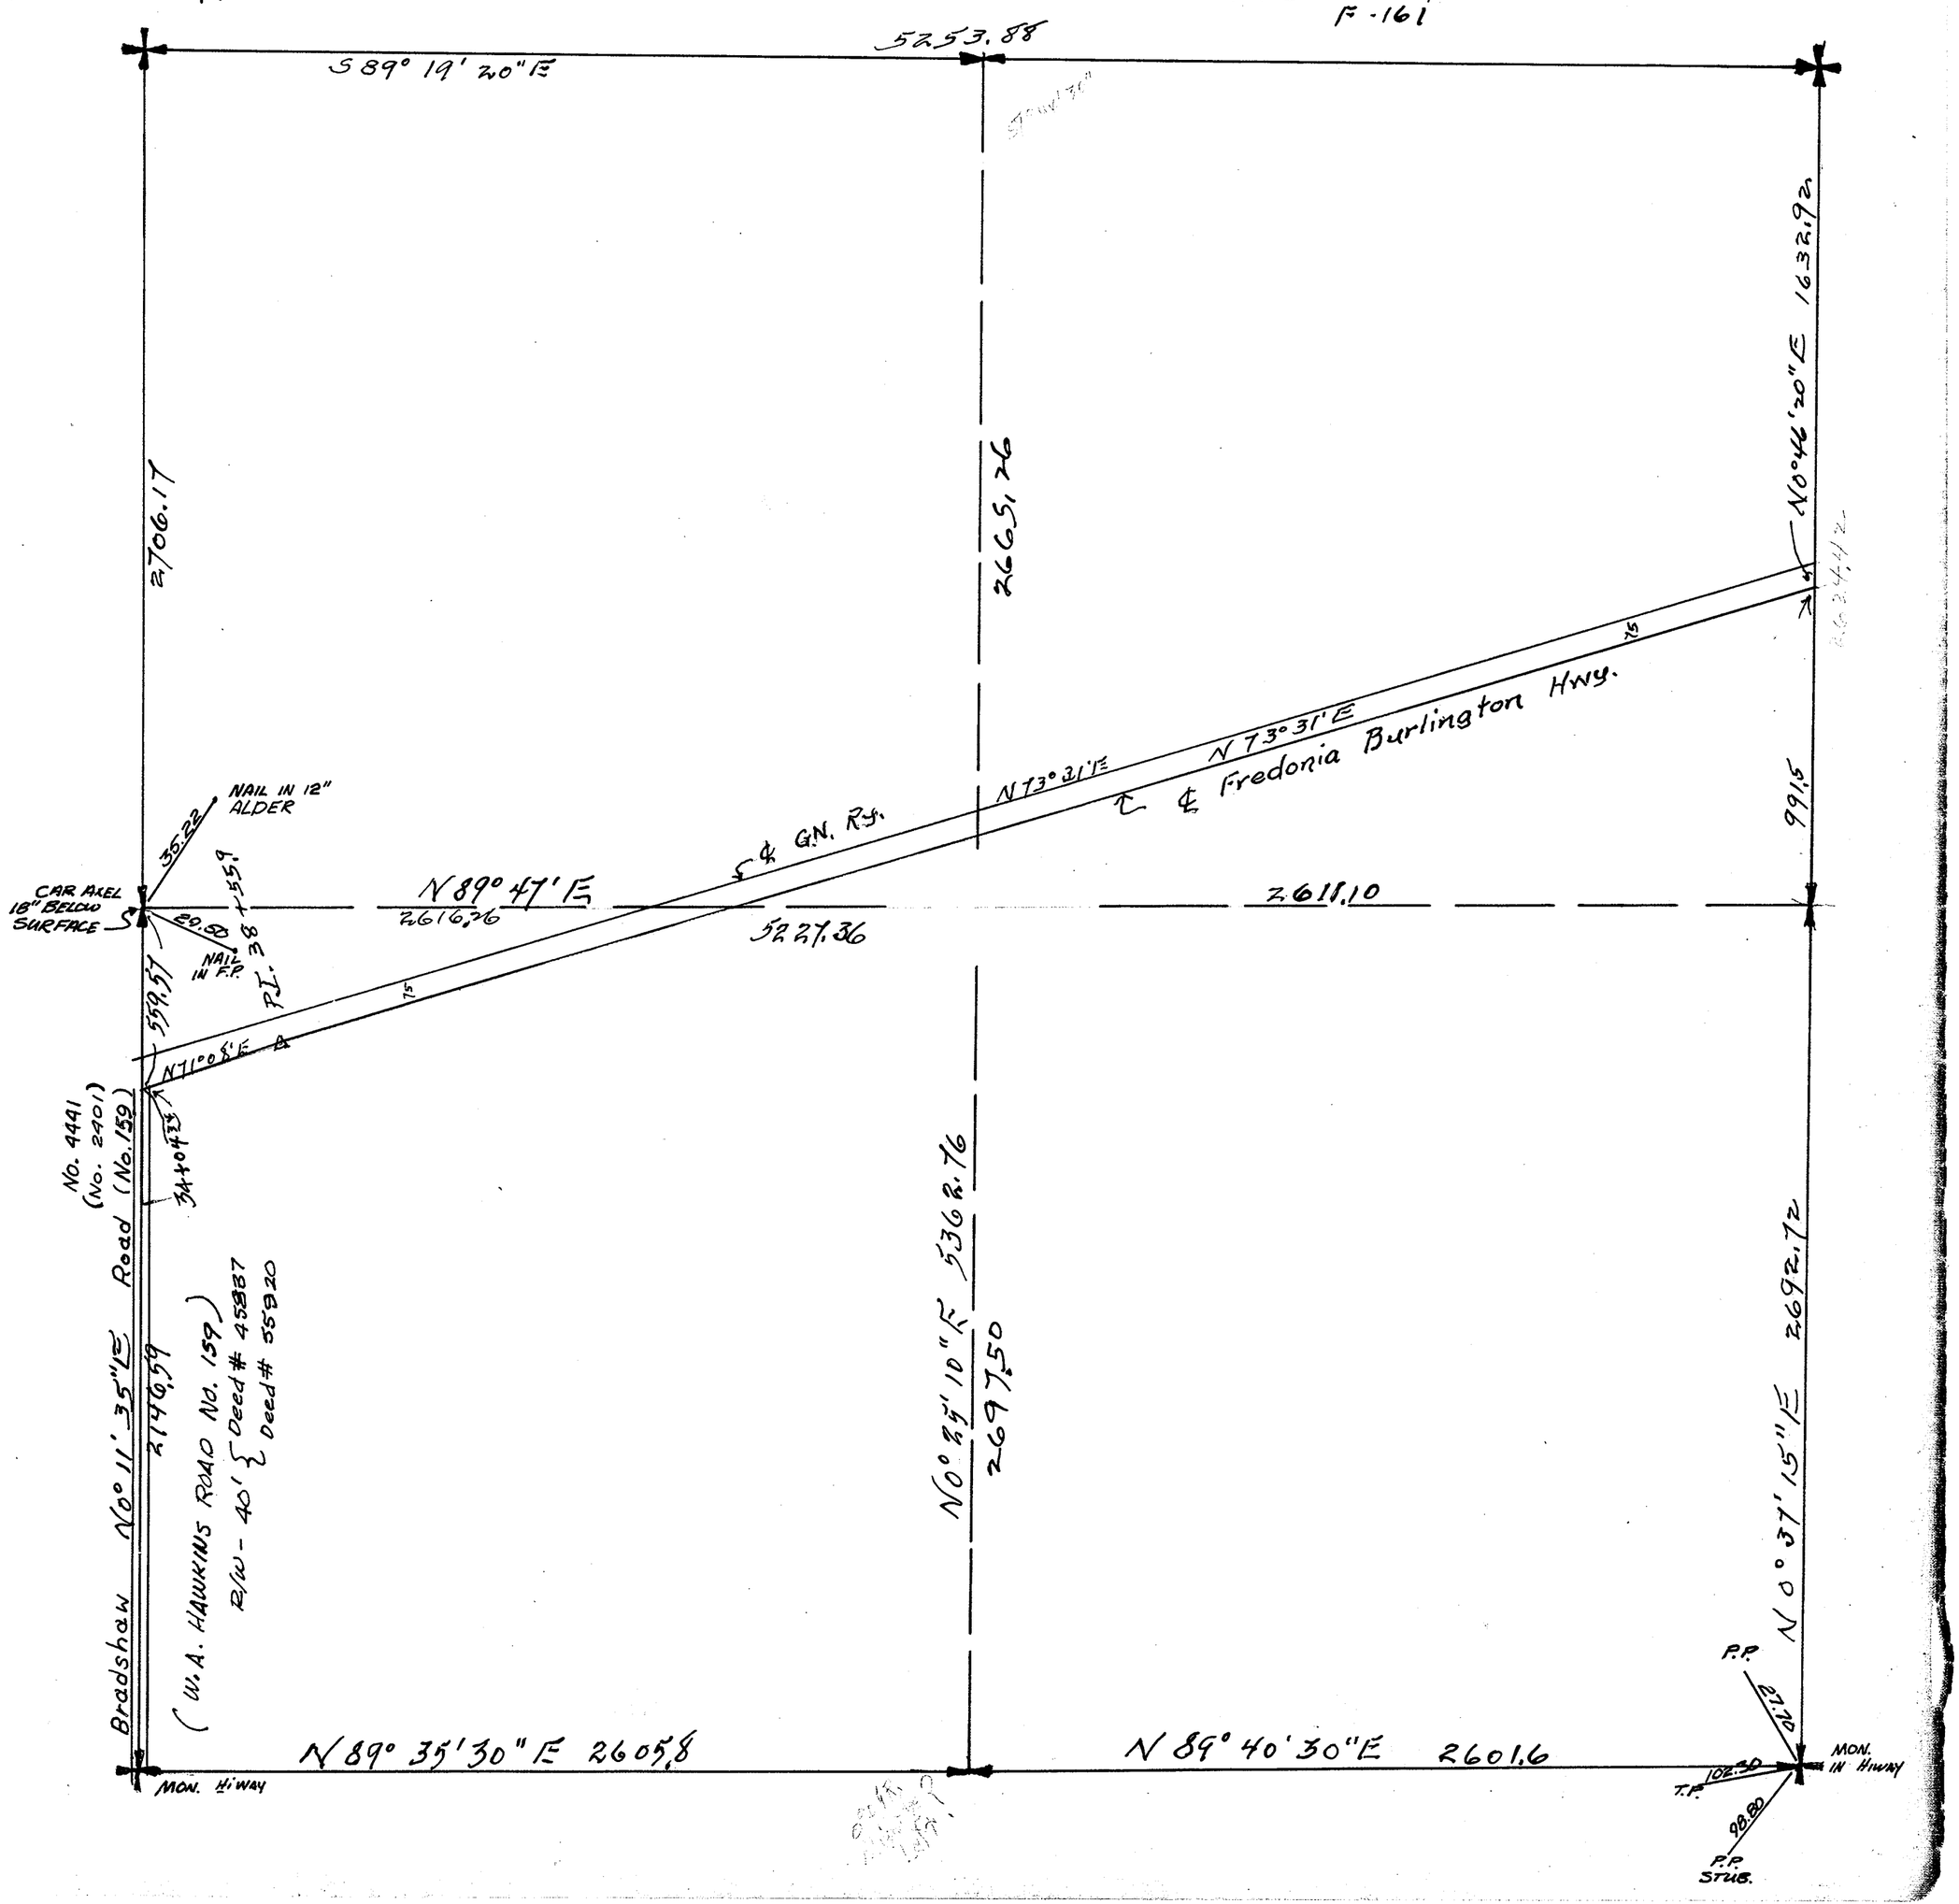


SECTION 10

TOWNSHIP 34 NORTH, RANGE 3 EAST, W. M.
SKAGIT COUNTY, WASH.

SCALE, 1 INCH–400 FEET

_____ COUNTY ENGINEER

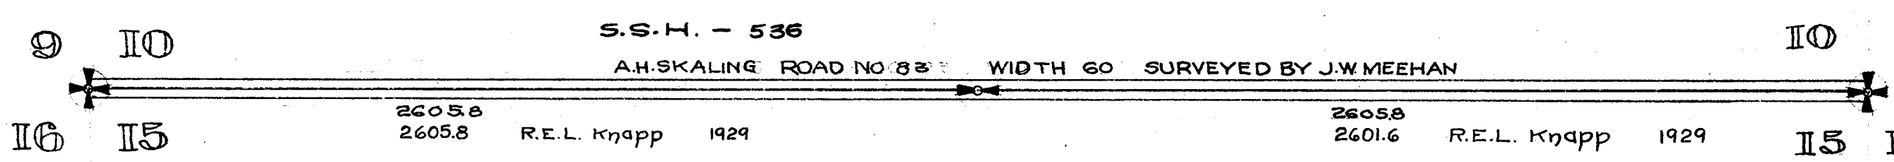

SECTION 11

TOWNSHIP 34 NORTH, RANGE 3 EAST, W. M.

SKAGIT COUNTY, WASH.

SCALE, 1 INCH--400 FEET

G. D. LeGro
August 1958
COUNTY ENGINEER

2" PIPE USDA

R/W - 40'

Ovenell Road

P.P. 65.82

PLACED 1" PIPE

No. (2040)-(62)-3150

S.S.H. 1-C

2" PIPE BY USDA

2 1 11 12

Z.P. 2.8e

T.P.

41.30

12" ALDER STP

NOTES: 673

Note: Road No. 2040 Drawn From Aerial Photo - Not to Scale July 1, 1966 _____

(No. 122)-(2501)-3311

Road N. 0° 54' 52" E. 2692.31 R/W - 60'

S. 88° 39' 35" E.
2655.45

T 34 N
11
R 3 E
CENTER SEC. CONC. MON.

S. 88° 39' 35" E.
2645.35

MON. IN PAV.

(Avon-Bay View Road No. LXIX)

Avon - Allen

N. 0° 34' 21" E.
2684.26

1/16 HUB

N. 0° 35' 31" E.
2674.65

N. 0° 24' E.
2665.20

P.P. 27.70

102.30 T.P.

98.80 P.P. STUB

MON IN PAV.

N. 88° 52' W.
2654.32

P.S.H.

2345.5 to P.I.

Pc: 307+11.94 Ah.
Pc: 317+94.81 Ah.

A = 36° 45'
C = 3°
T = 634.46
L = 1225.0

(PH #17) P.S.H.

Pt: 330+19.81

148.40 18" CHERRY

90.60 P.P.

152.80 T.P.

(Bay View & Skagit River XLV)

Bennett Road

N. 88° 52' W.
2654.32

R/W - 60'

STUB 35.70

No. 3000 (No. 2420) (No. 132)

MON. PAV.

29.30 STUB

SECTION 12


TOWNSHIP 34 NORTH, RANGE 3 EAST, W. M.

SKAGIT COUNTY, WASH.

SCALE, 1 INCH -- 400 FEET

DATE 23 Sept 1968

Lloyd H. Johnson COUNTY ENGINEER

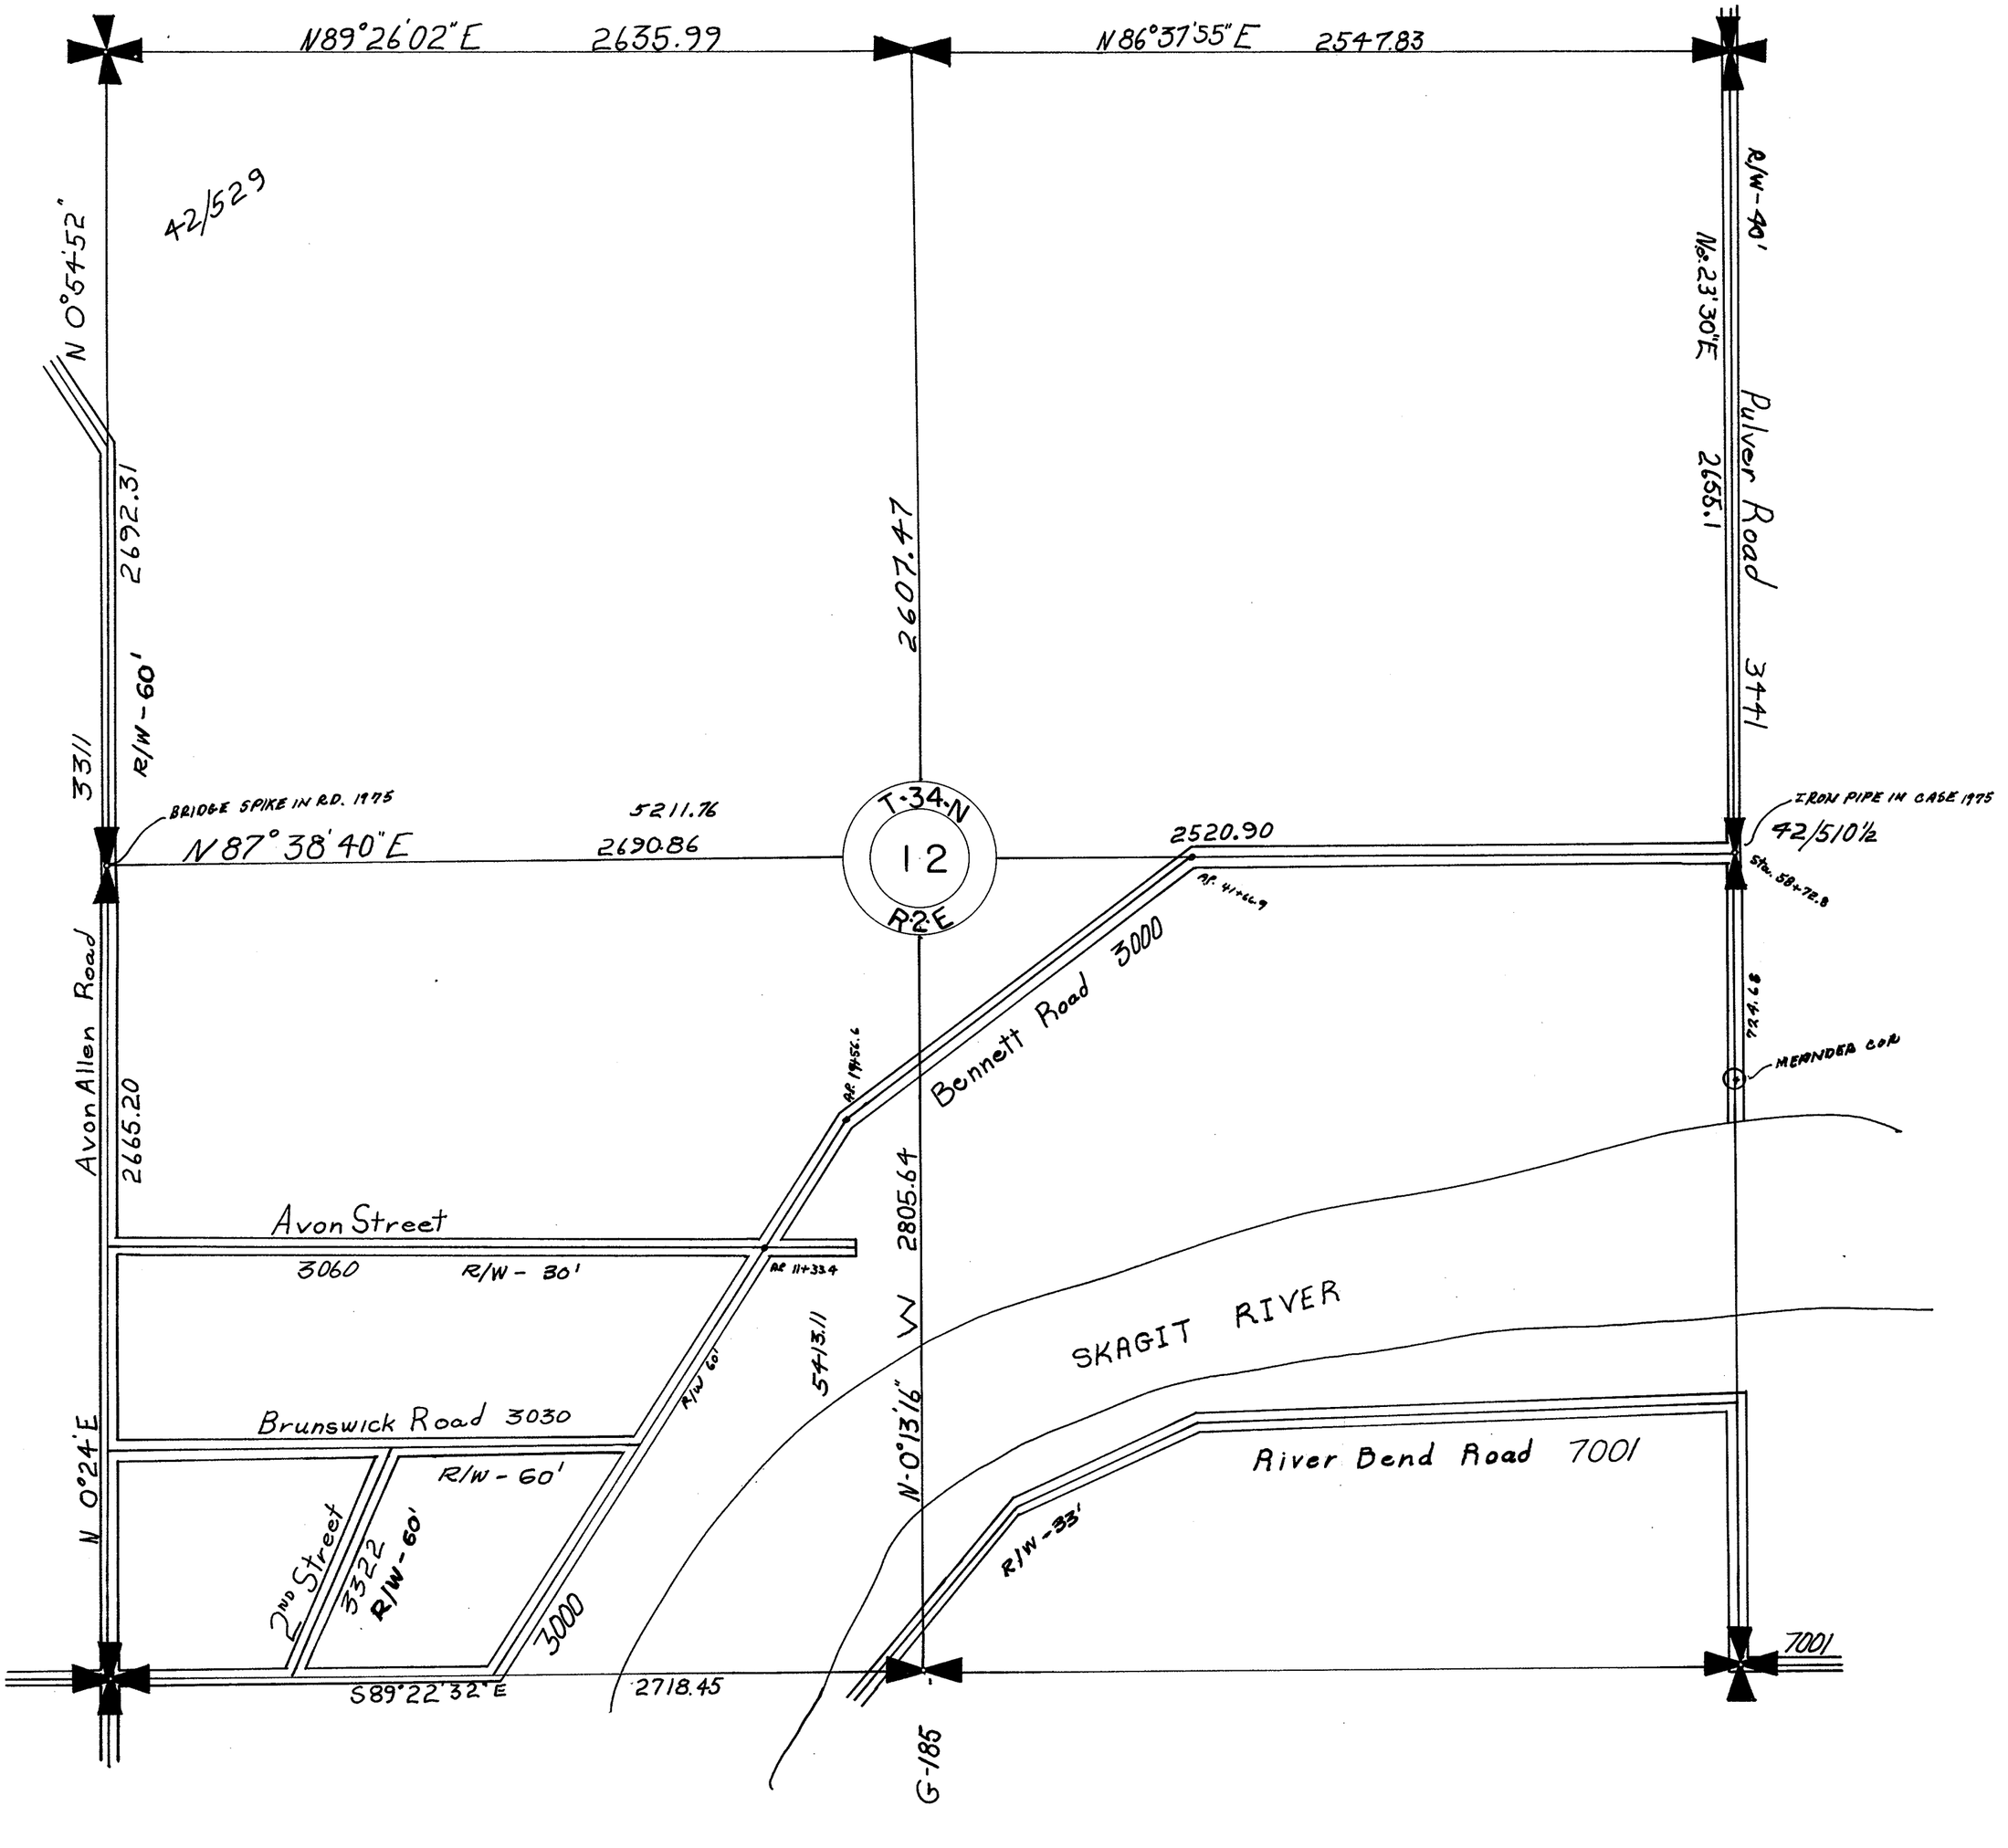

SECTION 12
TOWNSHIP 34 NORTH, RANGE 3 EAST, W. M.
SKAGIT COUNTY, WASH.

H.O. Walberg COUNTY ENGINEER
1951

SCALE, 1 INCH--400 FEET




SECTION 13

TOWNSHIP 34 NORTH, RANGE 3 EAST, W. M.

SKAGIT COUNTY, WASH.

SCALE, 1 INCH—400 FEET

Robt. F. L. Knapp COUNTY ENGINEER
May 1932
Notes: G 185 & 186

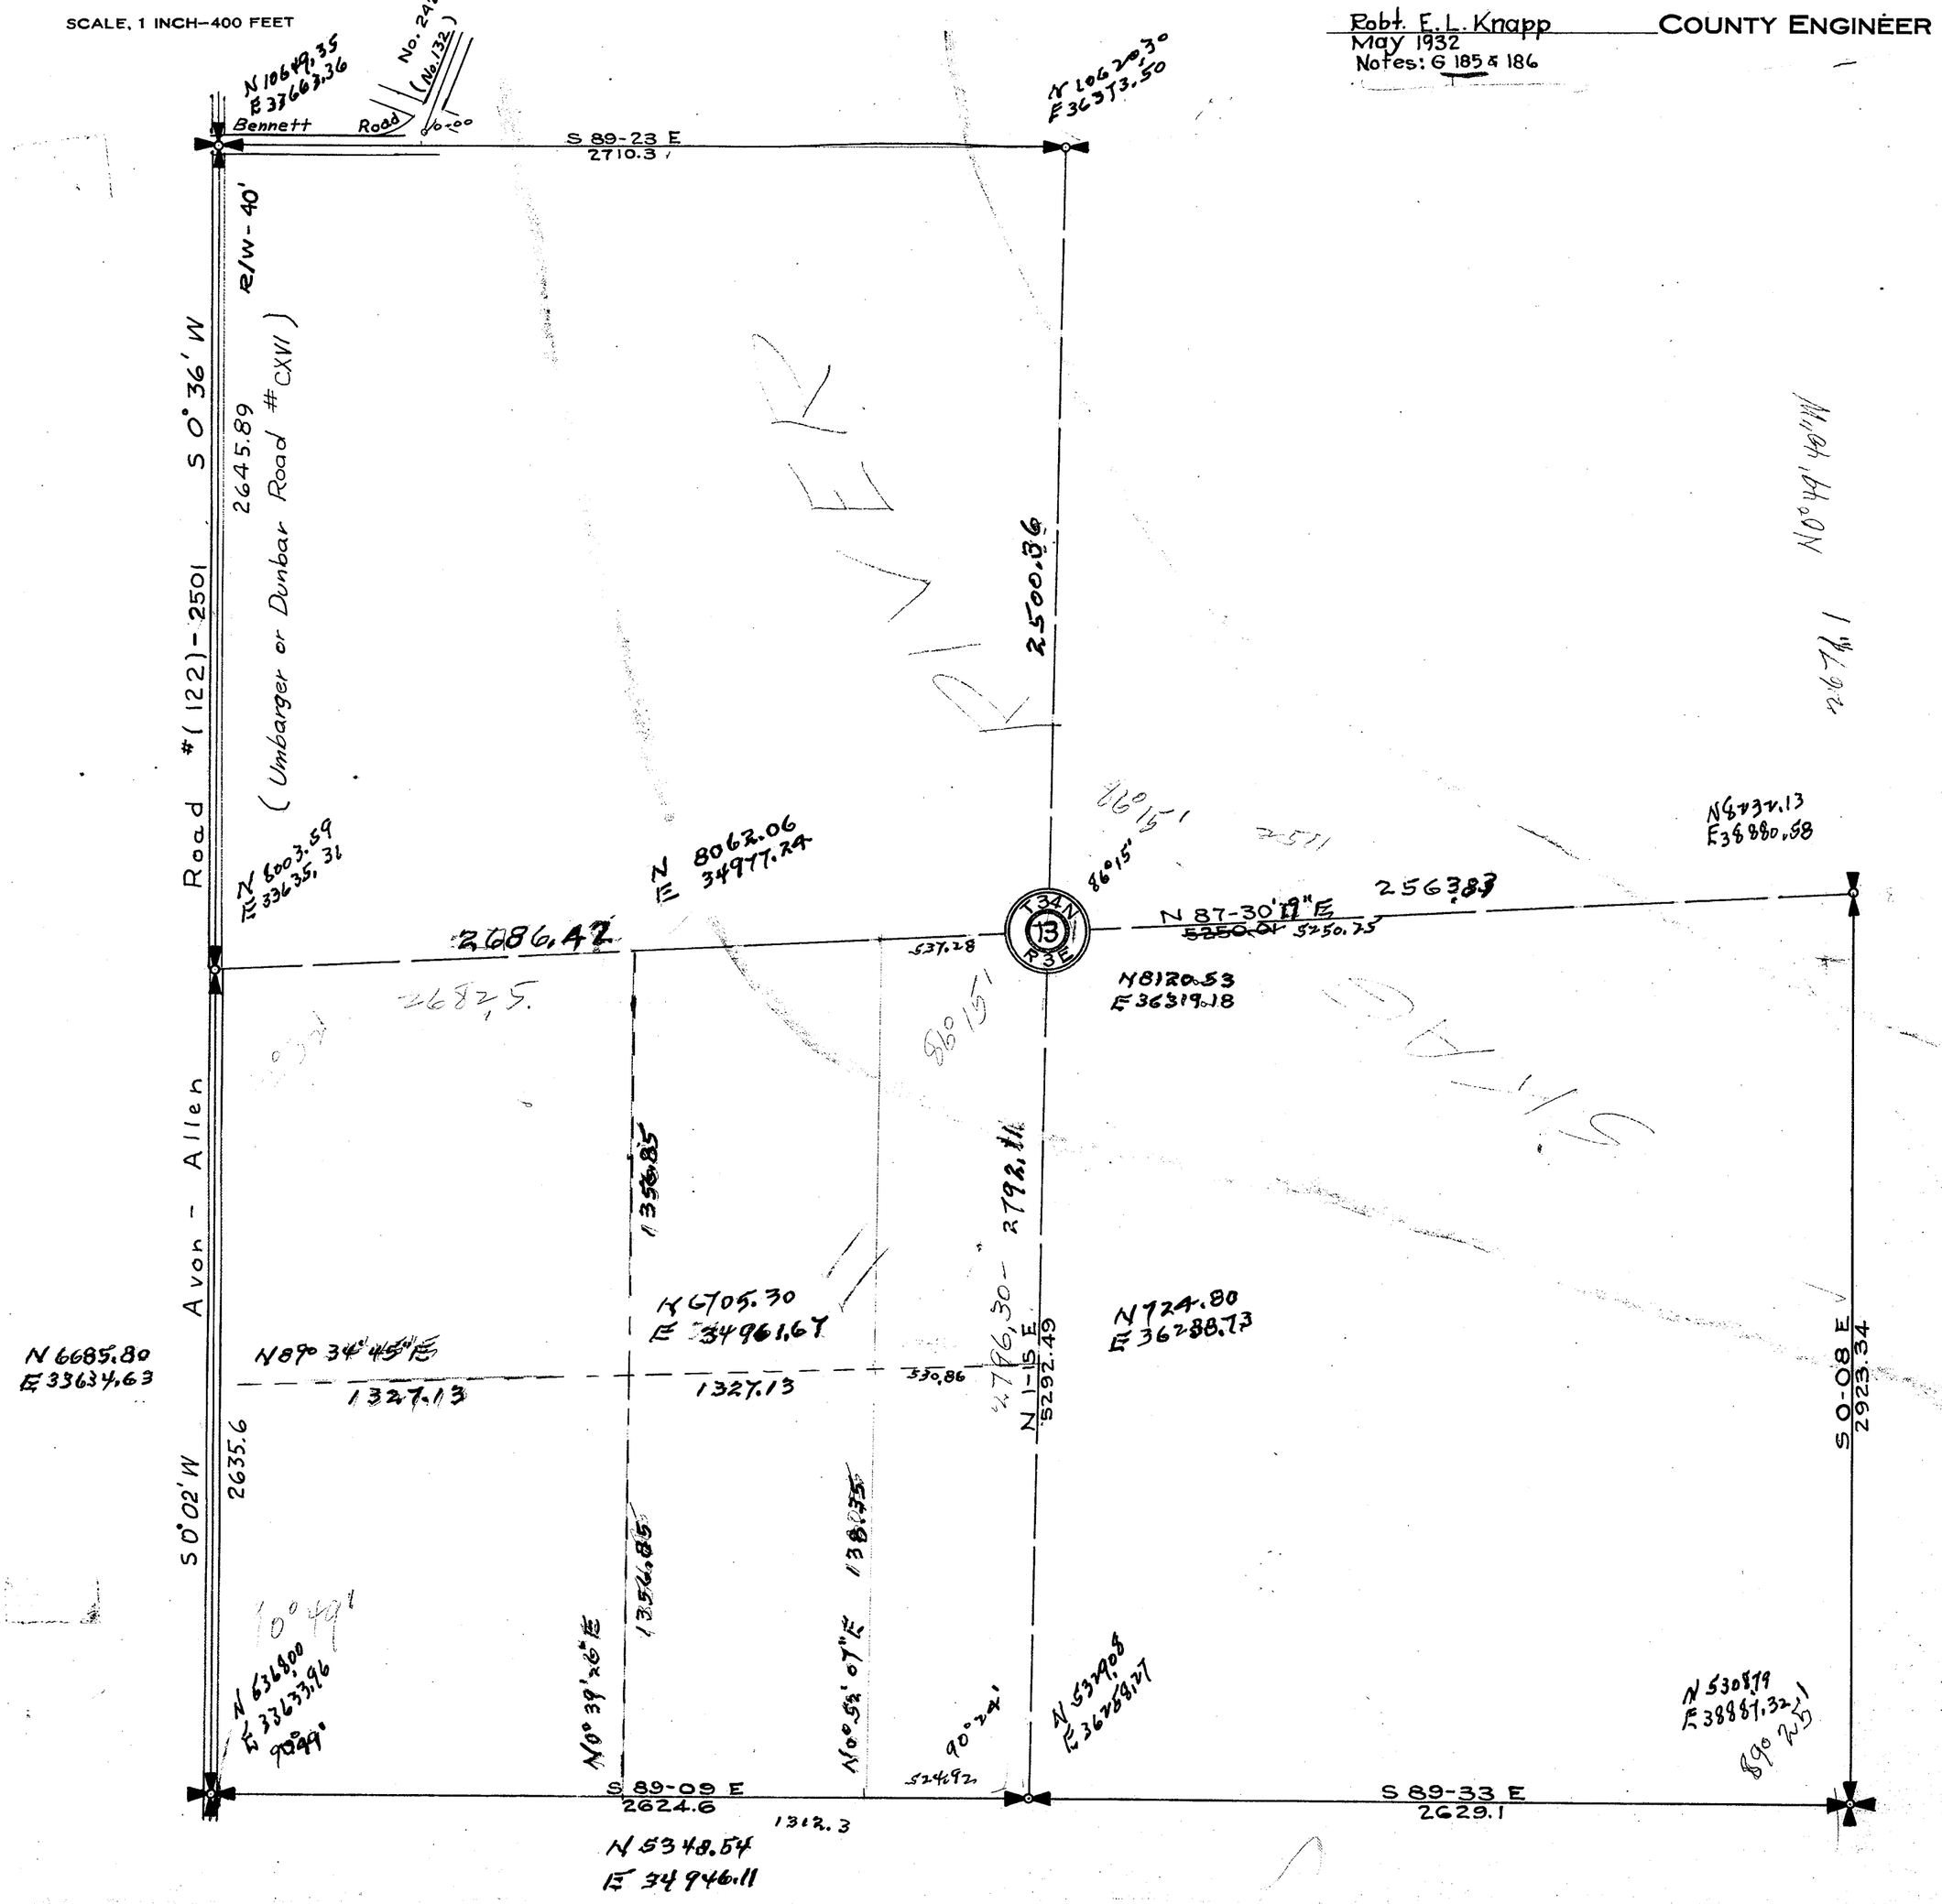

T. Bk. 34 P 12
P54

SECTION S.W 1/4 - 13

TOWNSHIP 34 NORTH, RANGE 3 EAST, W. M.

SKAGIT COUNTY, WASH.

SCALE, 1 INCH - ~~100~~ 200 FEET

_____ COUNTY ENGINEER

Beginning at a point 525 ft west and 20 ft North of the South East corner of the South West 1/4 of Sec. 13 T. 34 N. R. 3 E., thence North 1491.4 ft, thence North 57°53' West, 252.3 ft, thence North 42°40' west. 91.5. thence South 1631.3 ft, thence South 89°25 East 275.7 to the place of beginning. Containing 10.00 Acres.

(No. 122) - 2501

AVON - ALLEN ROAD

SKAGIT RIVER

2682.5

2654.2'

531.2

Center Section (Cedar Post)

Hub 1/16

N42°40'W 91.5 Hub

N57°53'W 252.3 Hub

1361.6'

1361.6'

John Calbom 10.00 A

1491.4

N0.00W

S0.00E 1631.3

512.3'

275.7'

525'

90°00'

1/4 Cor.

County ROAD

2626.0'

A3-23

A3-23


SECTION 13

TOWNSHIP 34 NORTH, RANGE 3 EAST, W. M.

SKAGIT COUNTY, WASH.

DATE July 4, 1966 — Lloyd Johnson COUNTY ENGINEER

SCALE, 1 INCH--400 FEET

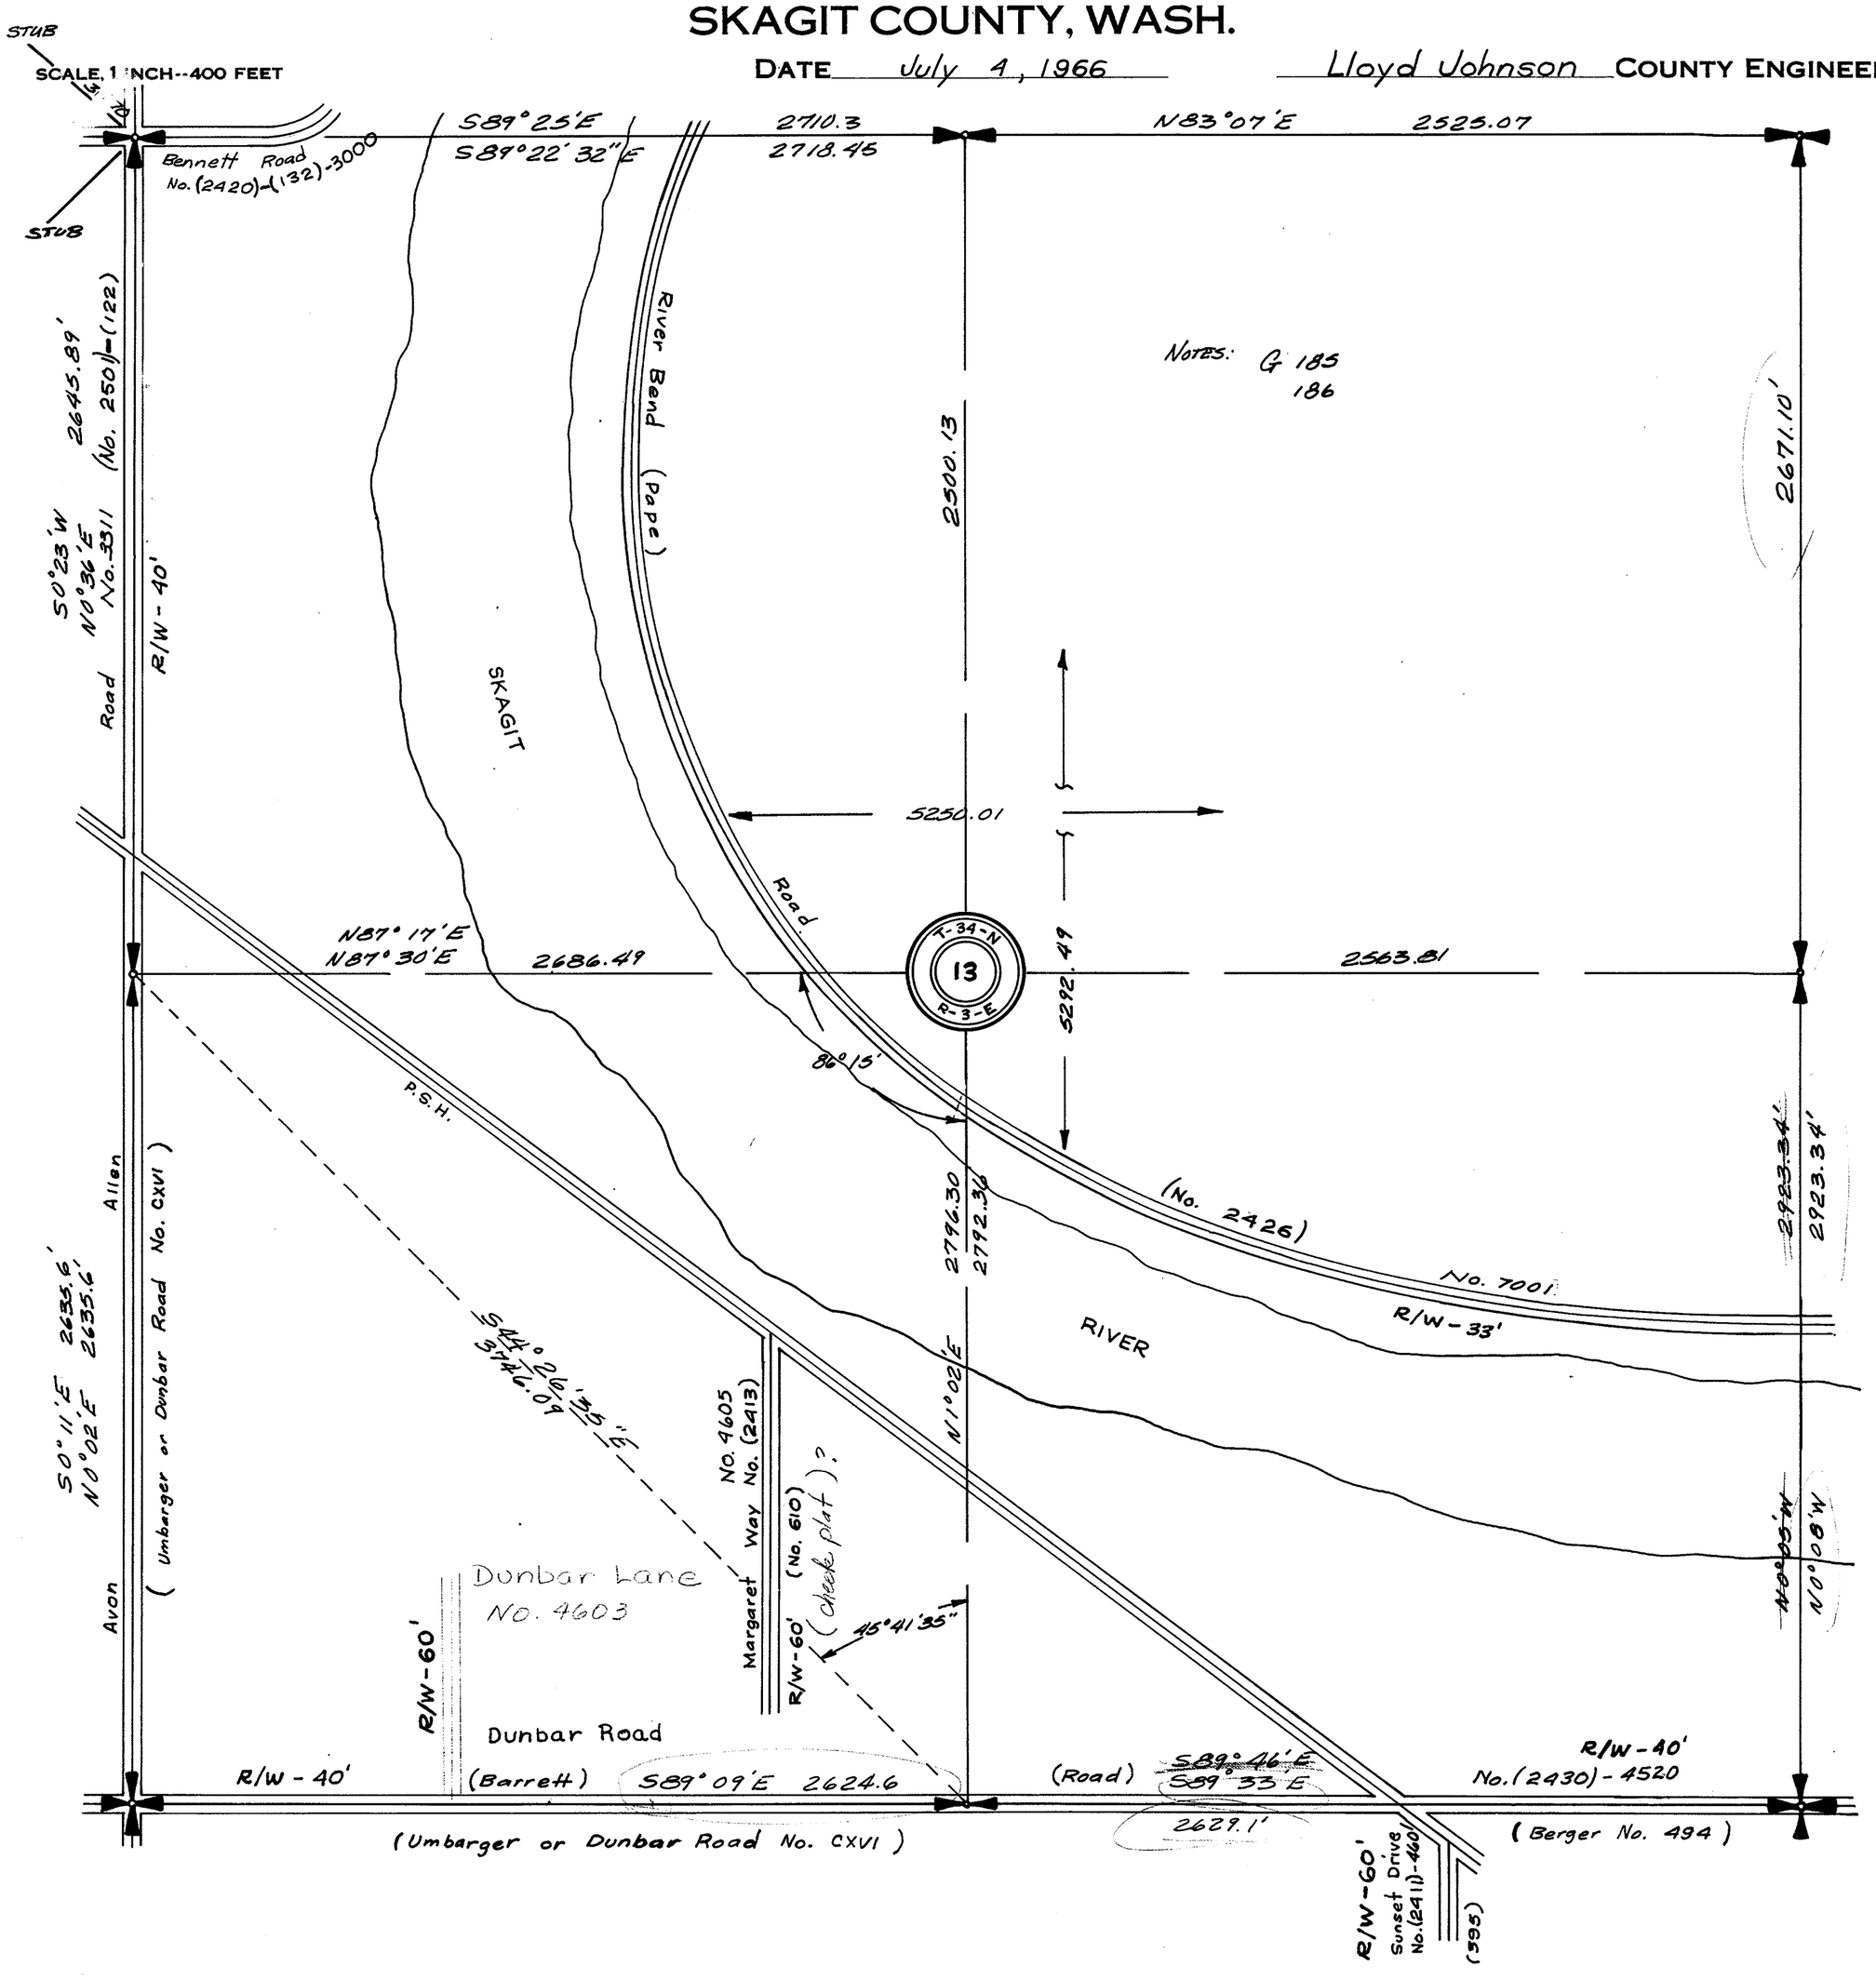


⚠ AVON ACRES FIRST ADDITION
VOL 7, Pg 93

SECTION 14
TOWNSHIP 34 NORTH, RANGE 3 EAST, W. M.
SKAGIT COUNTY, WASH.

SCALE, 1 INCH--400 FEET

G. D. LeGro
August 1958
COUNTY ENGINEER

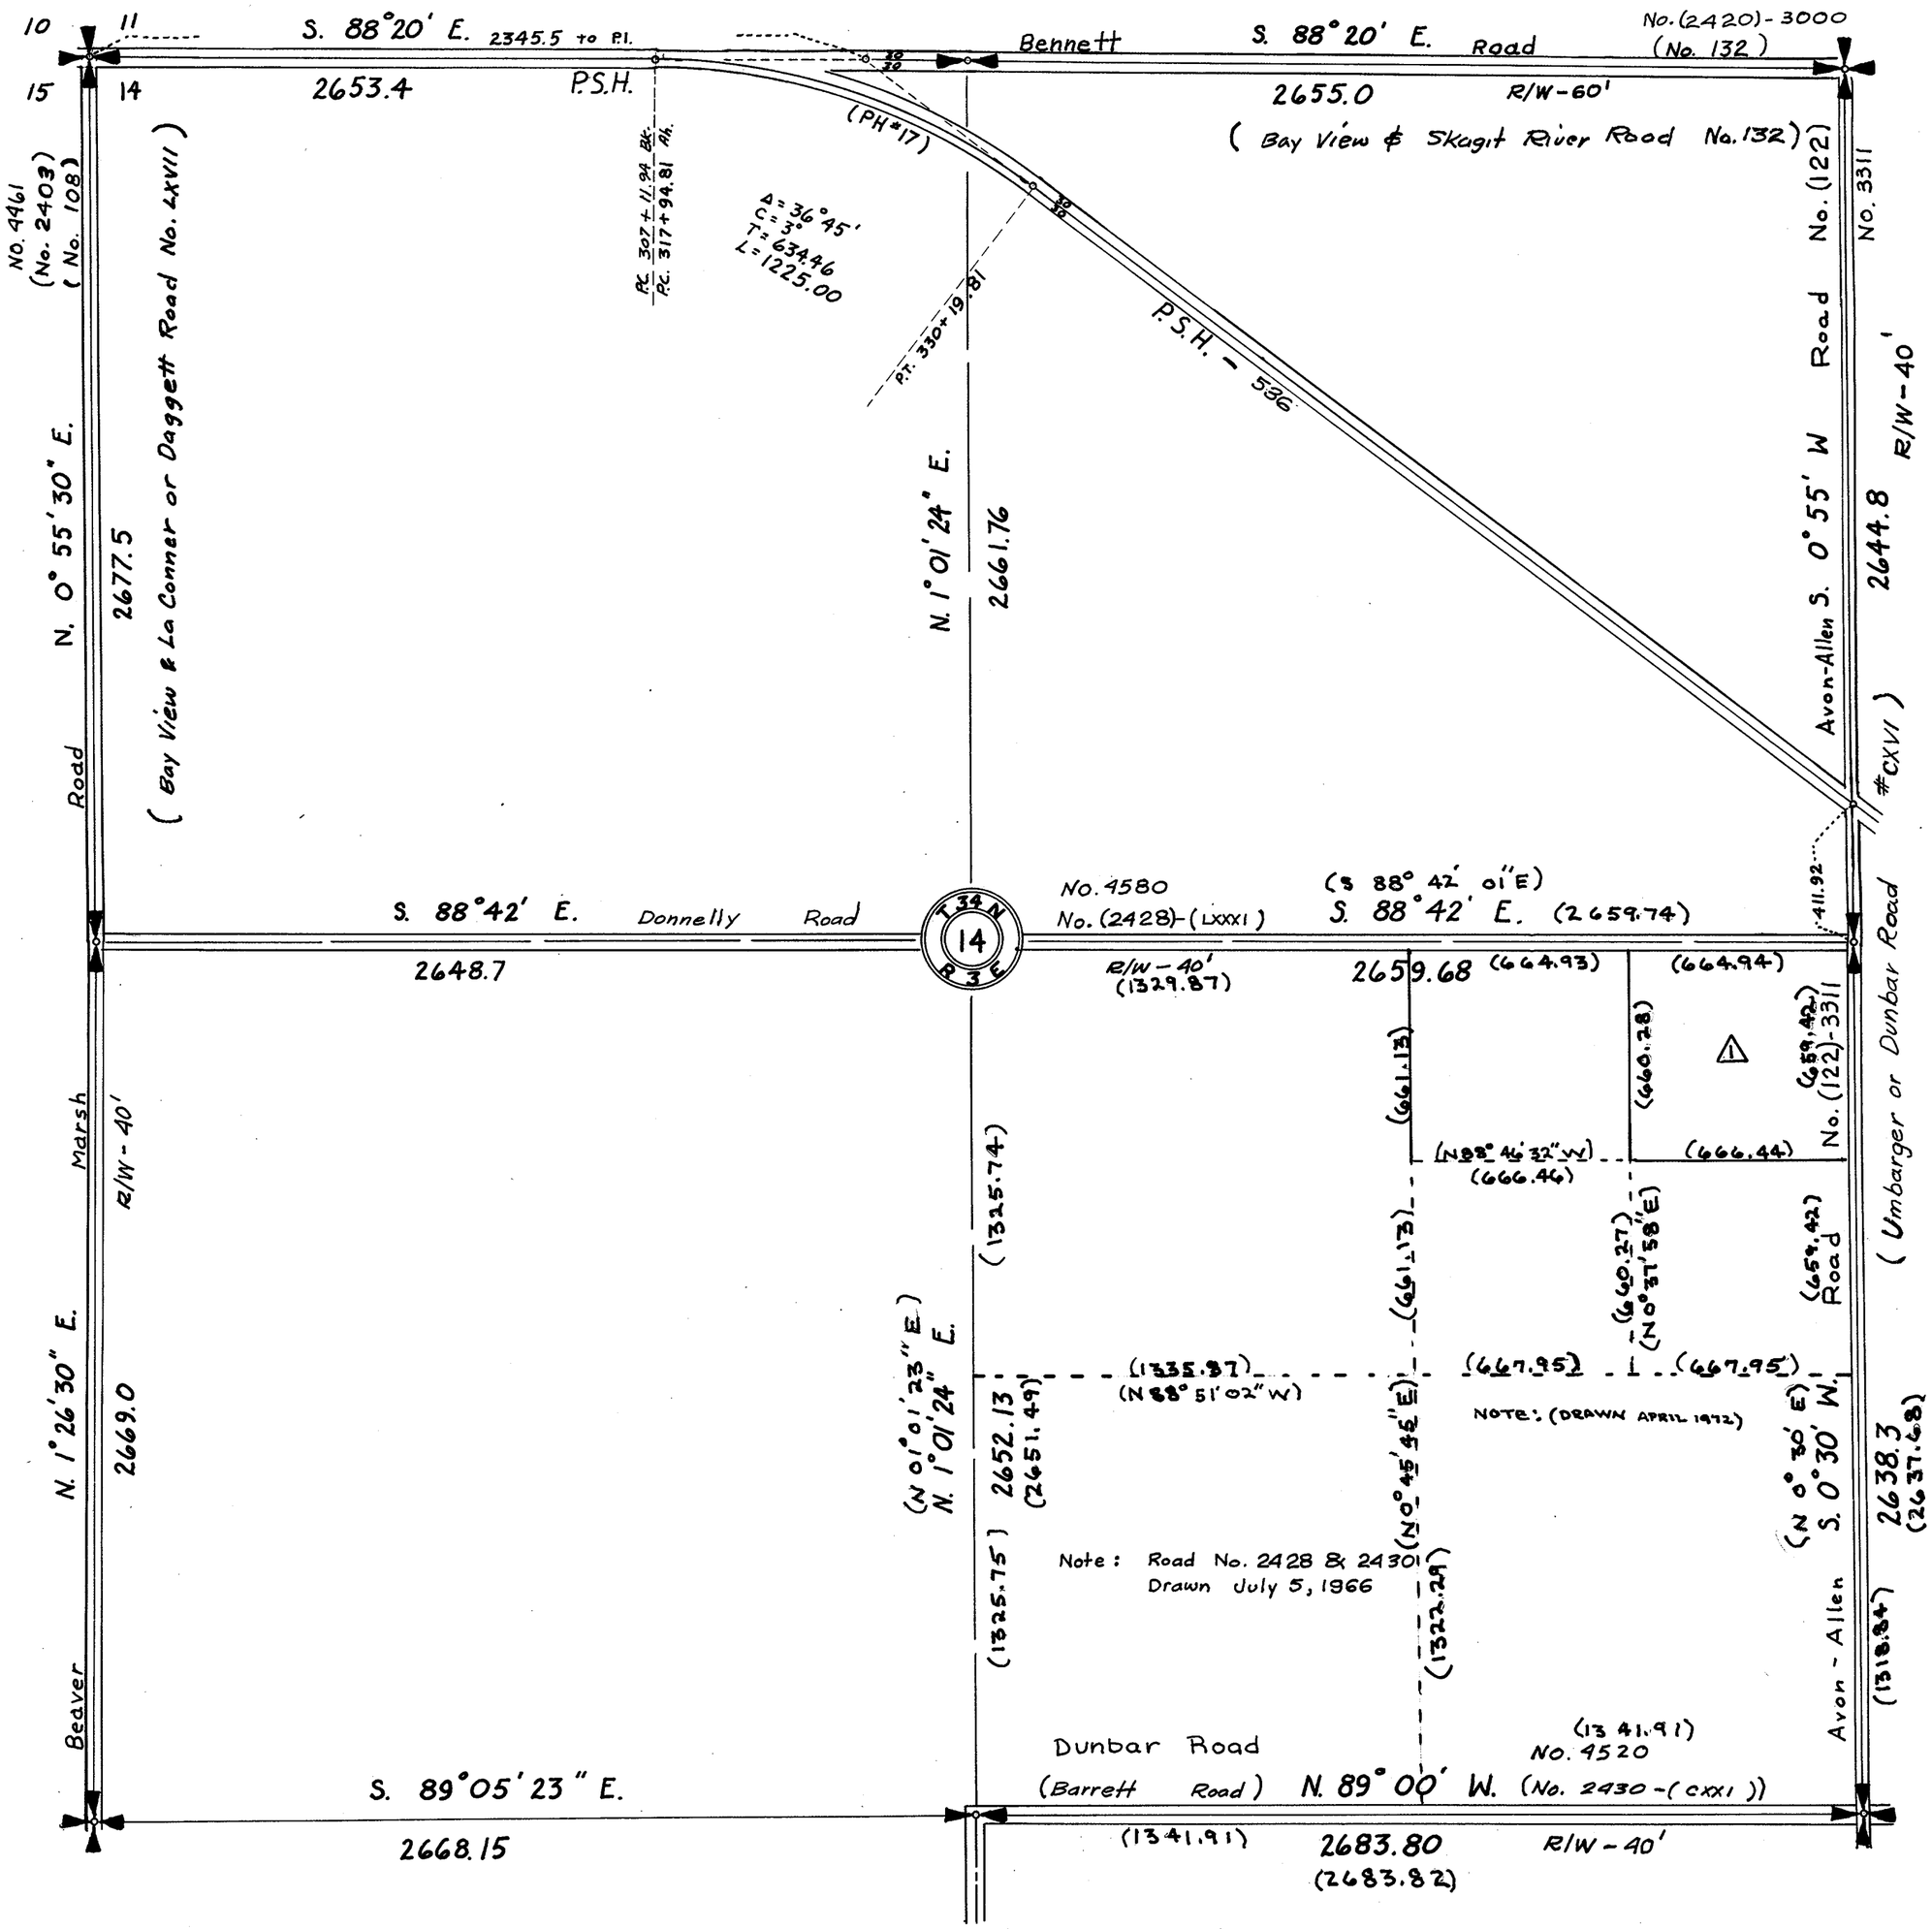


SECTION 14

TOWNSHIP 34 NORTH, RANGE 3 EAST, W. M.

SKAGIT COUNTY, WASH.

DATE 23 Sept 1968 — Lloyd H Johnson — COUNTY ENGINEER

SCALE, 1 INCH -- 400 FEET

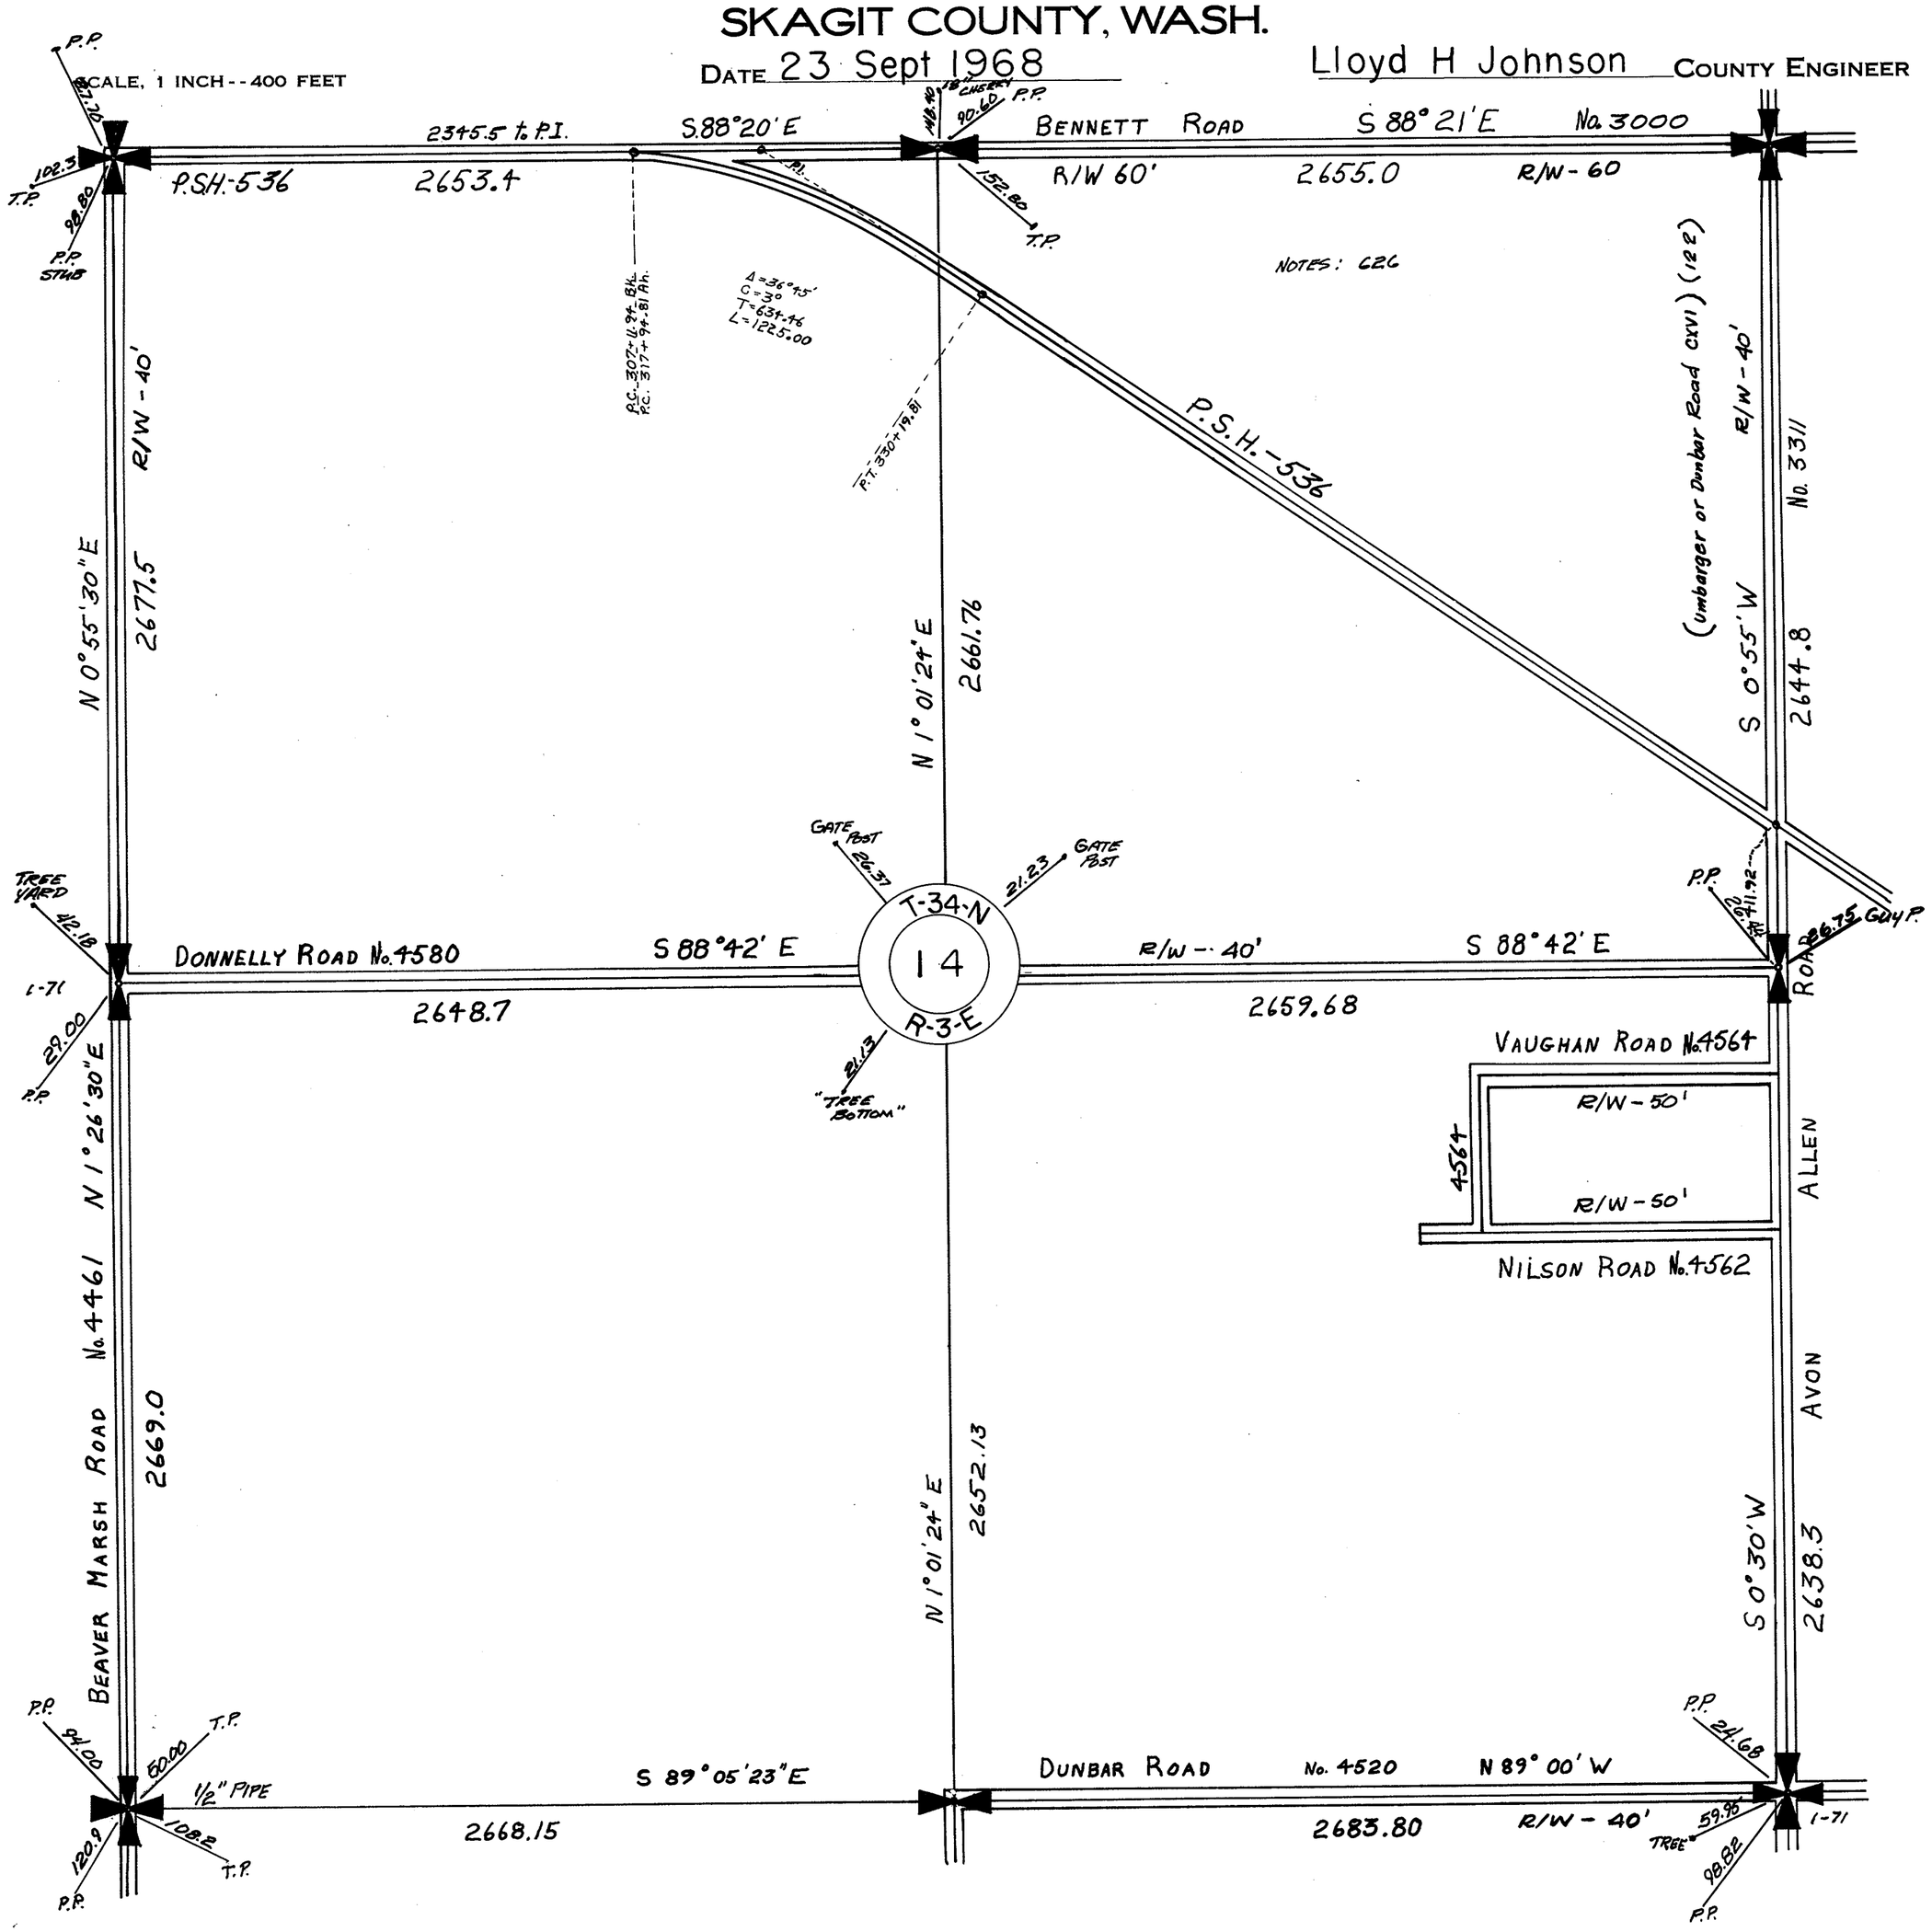

SECTION 15

TOWNSHIP 34 NORTH, RANGE 3 EAST, W. M.

SKAGIT COUNTY, WASH.

SCALE, 1 INCH--400 FEET

DATE July 5, 1966 — Lloyd Johnson COUNTY ENGINEER

P.S.H. No. 536

(No. 2401)-(159)(CXIX) NO. 4441

N 0°03' W 2724.2

(No. 2403)-(108) No. 4461

R/W - 33'

NOTES: 445 507 506

NOTES 507

P.P. 10.3 T.P. 98.80 P.P. STUB

P. Pole 31.40 — SET 1 1/2" Pipe OVER 1/2" RD.

Corner white house 68.25 — 19.07 — 4" I Beam Punch Mark on Top

86.30 — 18" Maple

MONUMENT CASE (Found 64)

Bradshaw Road

N 0°36' E 2630.1'

Marsh (Bay View - Conner or Doggett) (No. LXVII) Road

P. Pole 168.90 — S.E. Cor. Garage 37.60 — 1" Pipe

P. Pole #3871 28.70 — 72.70 — F. POST — 31.90 — Cor. F. Post

T-34-N 15 R-3-E

18" CHESTNUT 69.3 — Cor. F. Post 71.77 — T. Pole #14 20.50

MONUMENT CASE (Found 64)

65.83 — Von Weyaren — Ref. Tack Next To window seal

P. Pole 94.00 — 50.00 — T. Pole — 108.20 — T. Pole

120.9 — 1/2" Pipe — P. Pole

SECTION 16

TOWNSHIP 34 NORTH, RANGE 3 EAST, W. M.

SKAGIT COUNTY, WASH.

Notes G185
F161
39/445

T.B. 61

H.O. Walberg COUNTY ENGINEER

SCALE, 1 INCH--400 FEET

T.P. 61.30 — 47.10 P.P. — 0+00 — N89°01'30"E 2643.80 — P.P. 1730 — 53.61 POST 1-71 — N 89°45'35"E 2667.34 — P.S.H. (536) MON. IN HWY

SPIKE IN PAV. — S. R. Young Road — (1042) — 42.2 N — (2042) - (57) - 4600 — R/W - 40'

(Fred Eyre No. 68)

POST TOP — 21.40 T.P.

48.20 P.P. 10445

(No. 195) - (1467) - 4401

R/W - 60'

2643.3

2699.53

(No. 1159) - (2401) - 4991

R/W - 40'

2744.20

(#CX1X)

N0°10'20"E

Road

TACK CORNER HOUSE

73.25

26+44.1 — S 89° 42' 40" E 2636.95 — 2680.52

1" PIPE 8" UNDER

25.10 CONC. NAIL F.P. — 67.80 T.P.

P.P. 31.40

SET 1½" PIPE OVER ½" RB.

86.30 18" MAPLE

Road

2699.2

Culvert No. 431728
C.R.P. 325

Best

2663.02

N0°18'55"E

S0°42'W 2630.1

Bradshaw

N0°10'10"W

R/W - 40'

TACK F.P. 22.9 — 32.75 STEEL F.P.

53+44.9 — N89° 29' 50" E 2614.03 — N89° 34' 50" E 2663.93

69.30 18" CHESTNUT

54.30 PIN. NAIL TOP COR. F.P. — 34.0 TACK TOP F.P.

P.P. 66.50 — 37.10 T.P.

SECTION 17

TOWNSHIP 34 NORTH, RANGE 3 EAST, W. M.

SKAGIT COUNTY, WASH.

DATE July 5, 1966 — Lloyd Johnson COUNTY ENGINEER

SCALE 1 INCH = 400 FEET

P. Pole — 51.40 — T. Pole — 79.45

Set 8"x3" Post 1950

Set 5/8" Bolt with Square Nut 1953

S. R. Young Road

(Padilla & Avon Road No. CX1)

(No. 1042)-(57) No. 4600 R/W - 40'

T. Pole — 61.30 — P. Pole — 47.10

48.40 — P. Pole

1" Pipe w/Bolt 1 FT under

(No. 1467)-(195) No. 4401

Notes: G-185
761
623

GIBRALTER ANNEX VOL 7 Pg 9

WRONG SECTION 17-34-2

T-34-N
17
R-3-E

P. Pole — 51.30 — HSE Tack — 73.25 — 1" Pipe - 8" under

25.10 — Conc Nail F. Post

67.80 — T. Pole

Road

R/W - 40' & 60'

M.L. Best

TACK F.P. — 22.90 — STEEL F.P. 32.75

34.30 — FIN. NAIL TOP COR. F.P.

CONC. NAIL IN WASHER


34.00 — TACK TOP F.P.

SECTION 18

TOWNSHIP 34 NORTH, RANGE 3 EAST, W. M.
SKAGIT COUNTY, WASH.

SCALE, 1 INCH–400 FEET

W. E. COSTELLO COUNTY ENGINEER

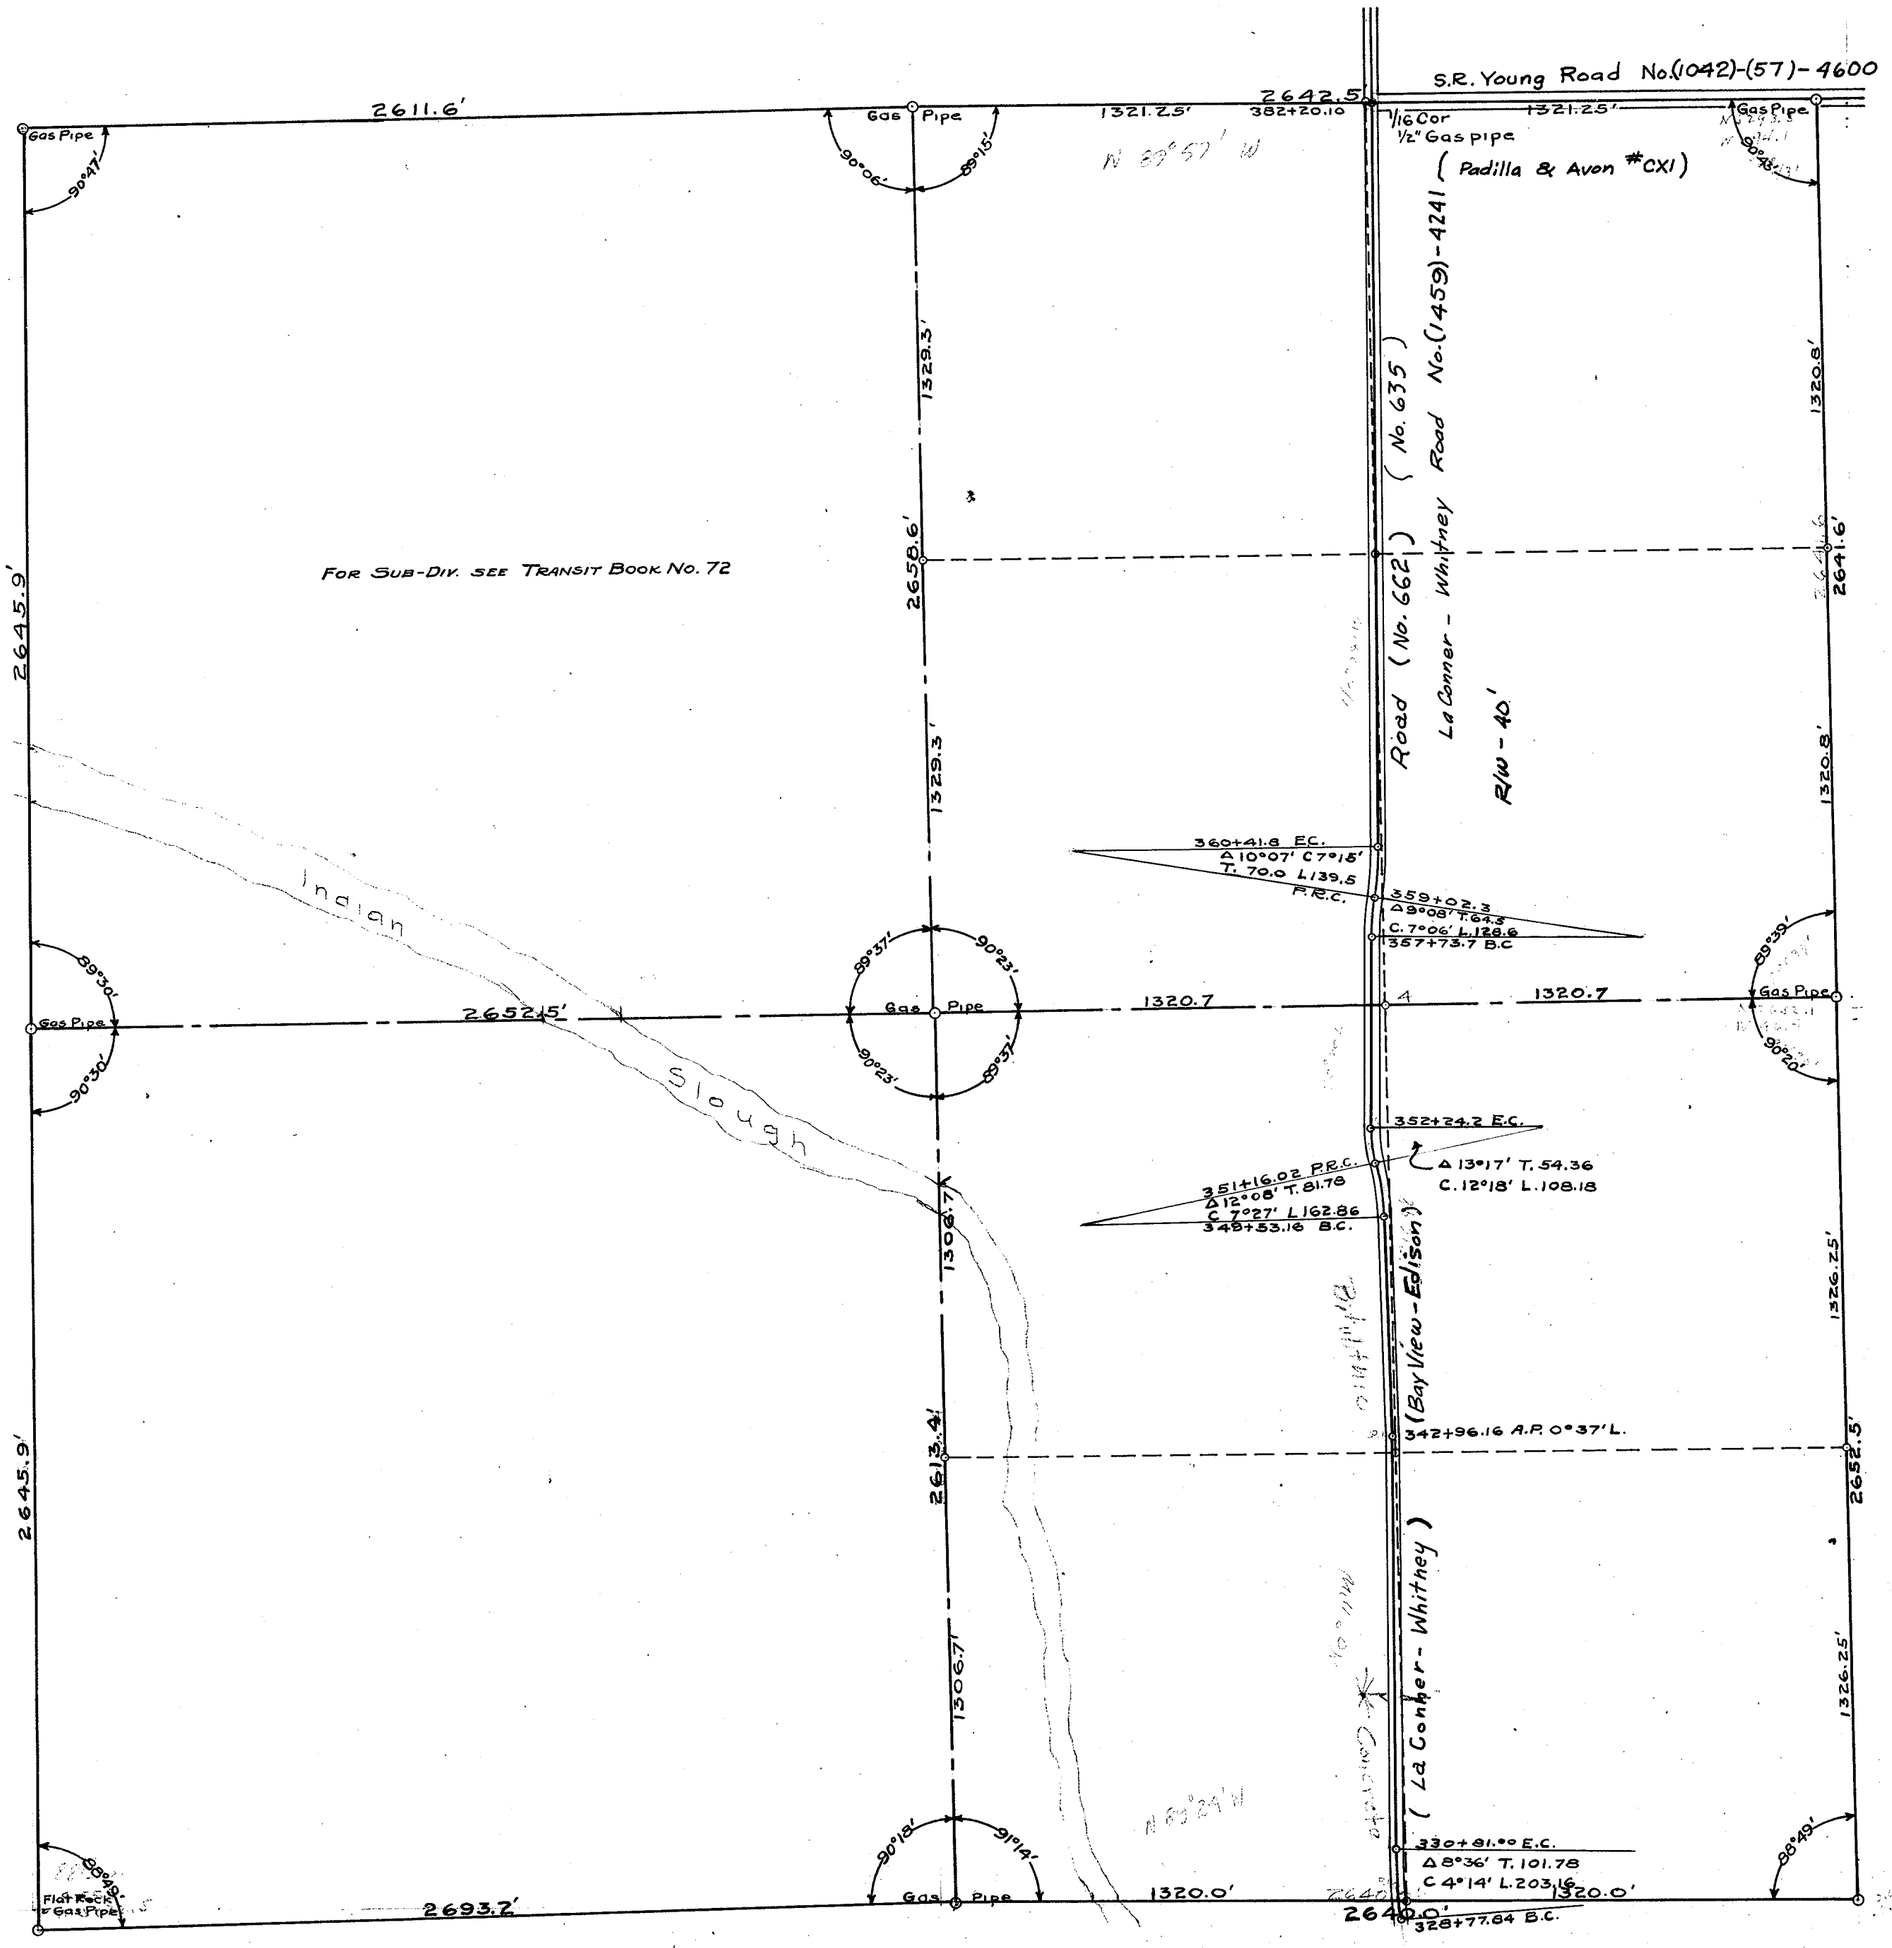

SECTION 19


TOWNSHIP 34 NORTH. RANGE 3 EAST. W. M.

SKAGIT COUNTY. WASH.

SCALE, 1 INCH--400 FEET

W.E. COSTELLO, COUNTY ENGINEER

LaConner-Whitney Road Alignment
From S. Sec. line to McLean Rd.
Revised 11/74 RWL

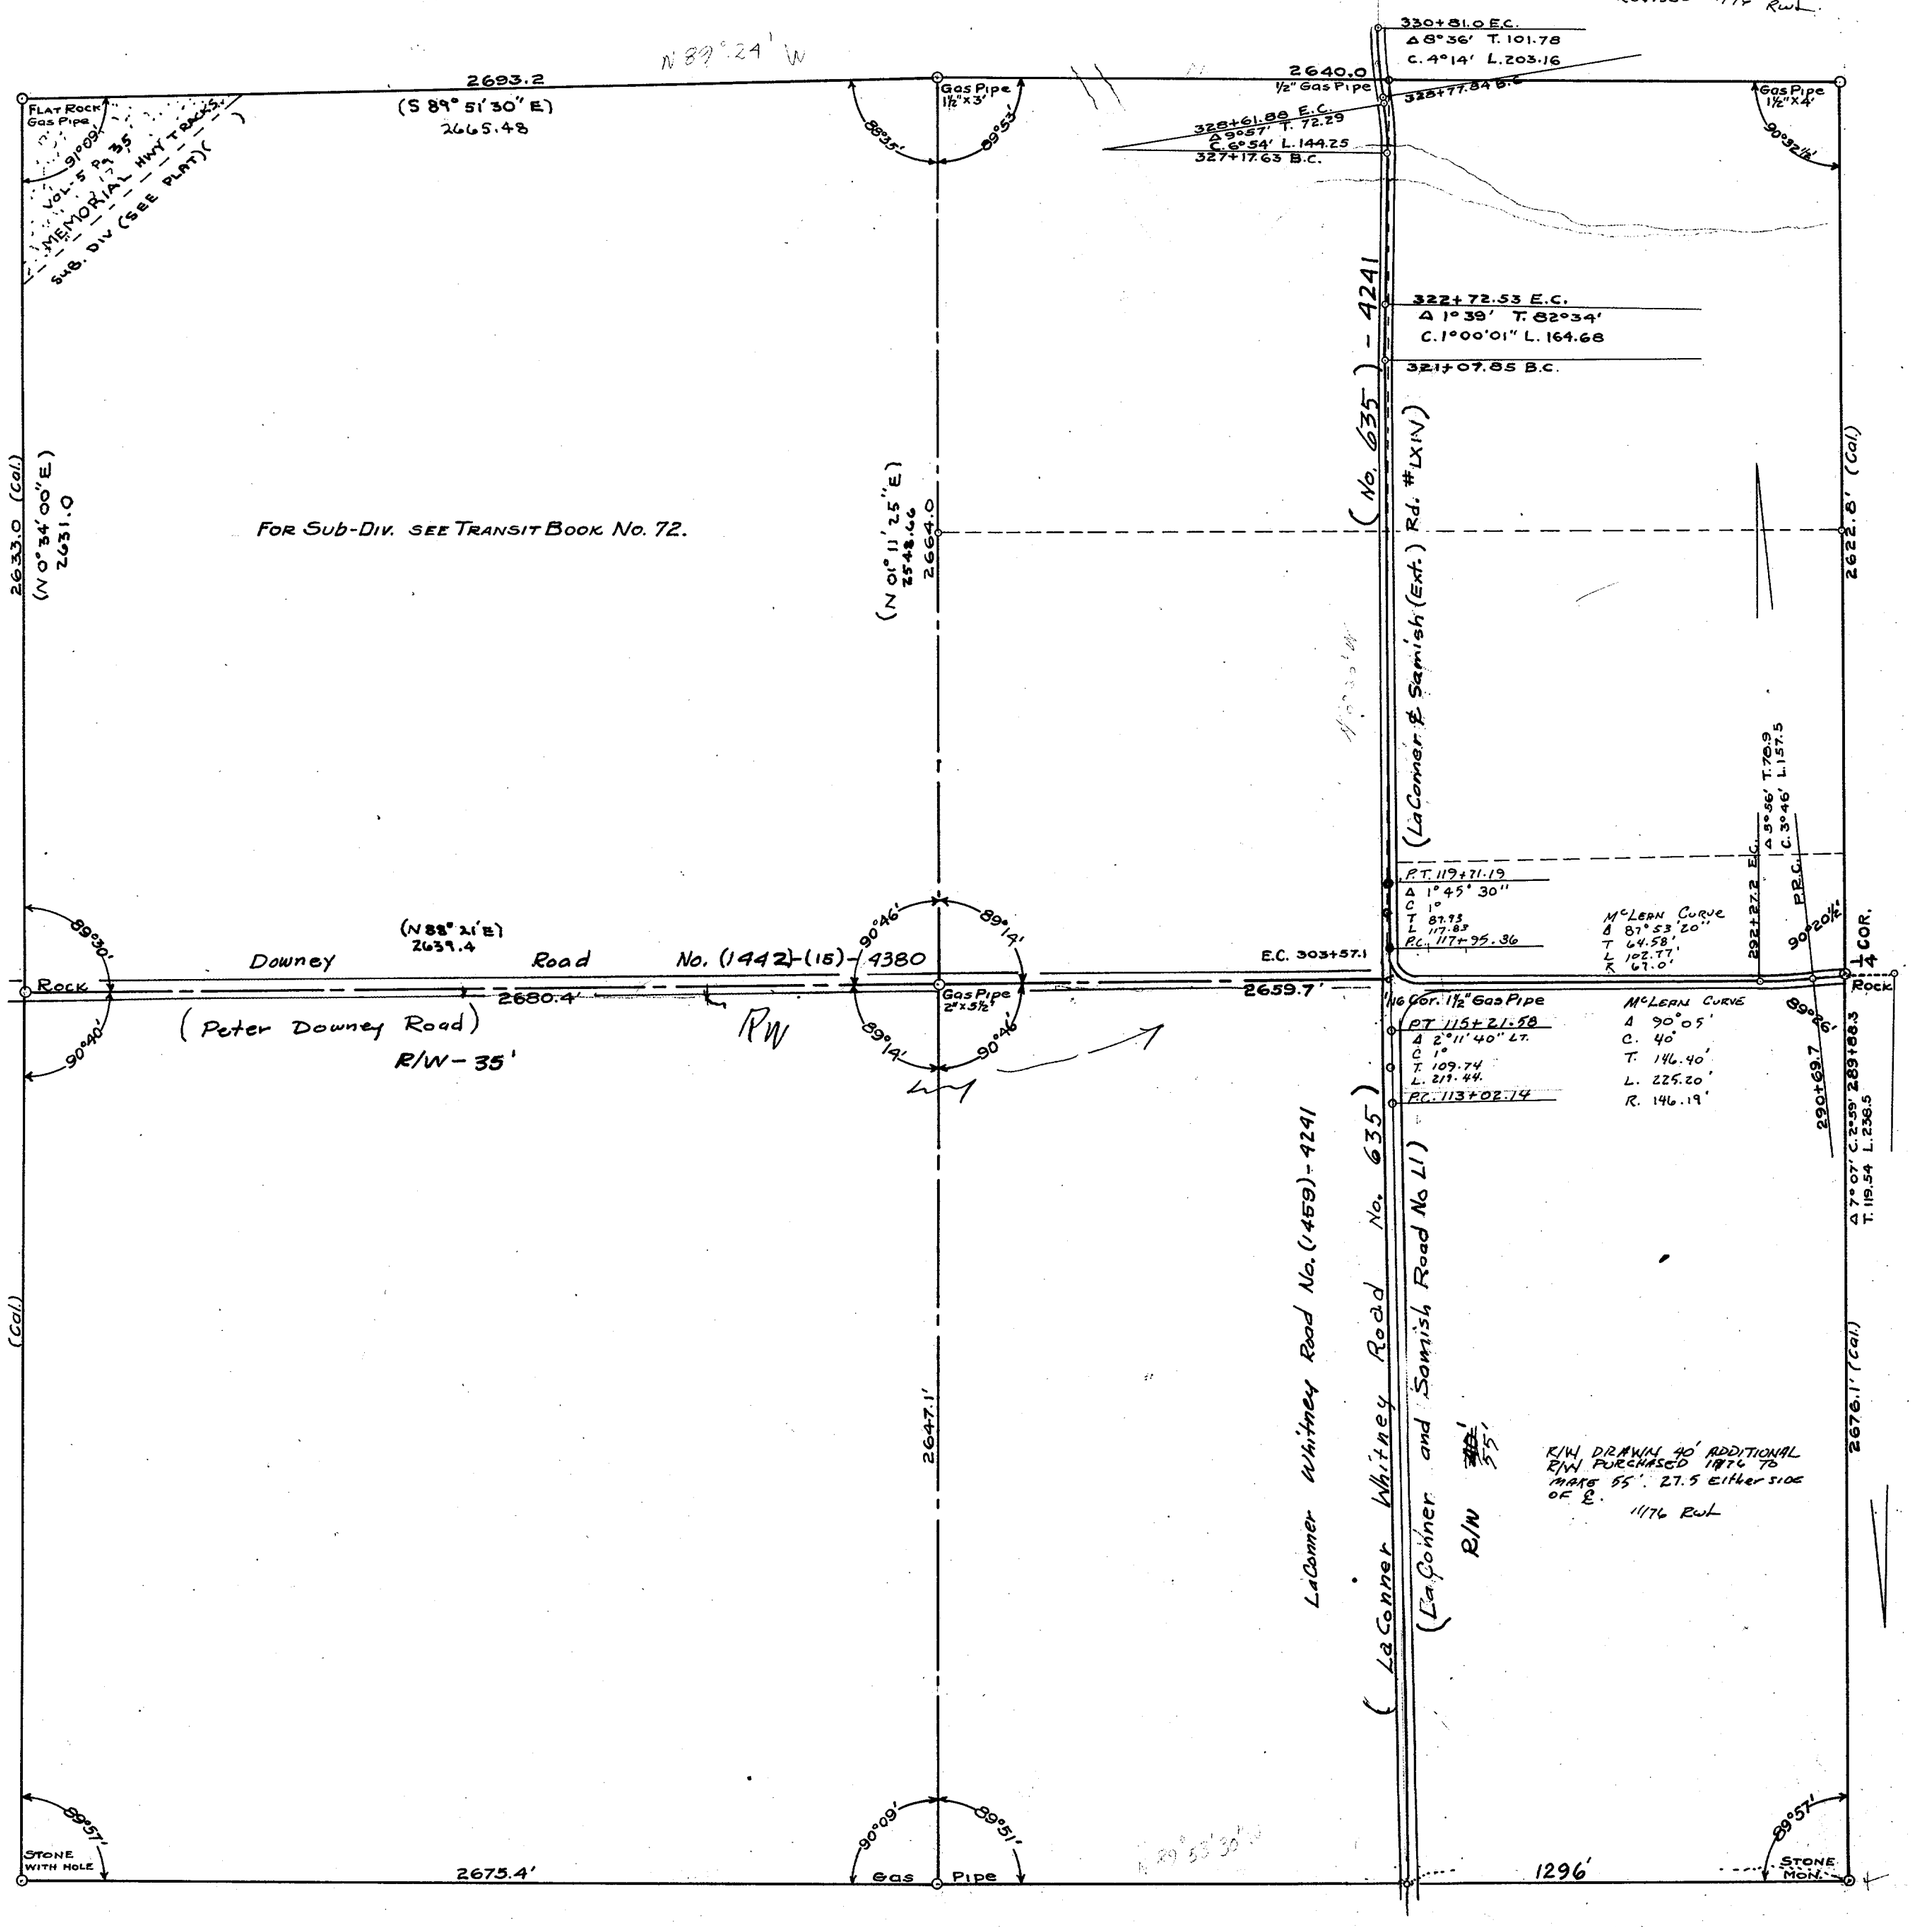

SECTION 20


TOWNSHIP 34 NORTH, RANGE 3 EAST, W. M.

SKAGIT COUNTY, WASH.

SCALE, 1 INCH--400 FEET

DATE July 2, 1963

COUNTY ENGINEER

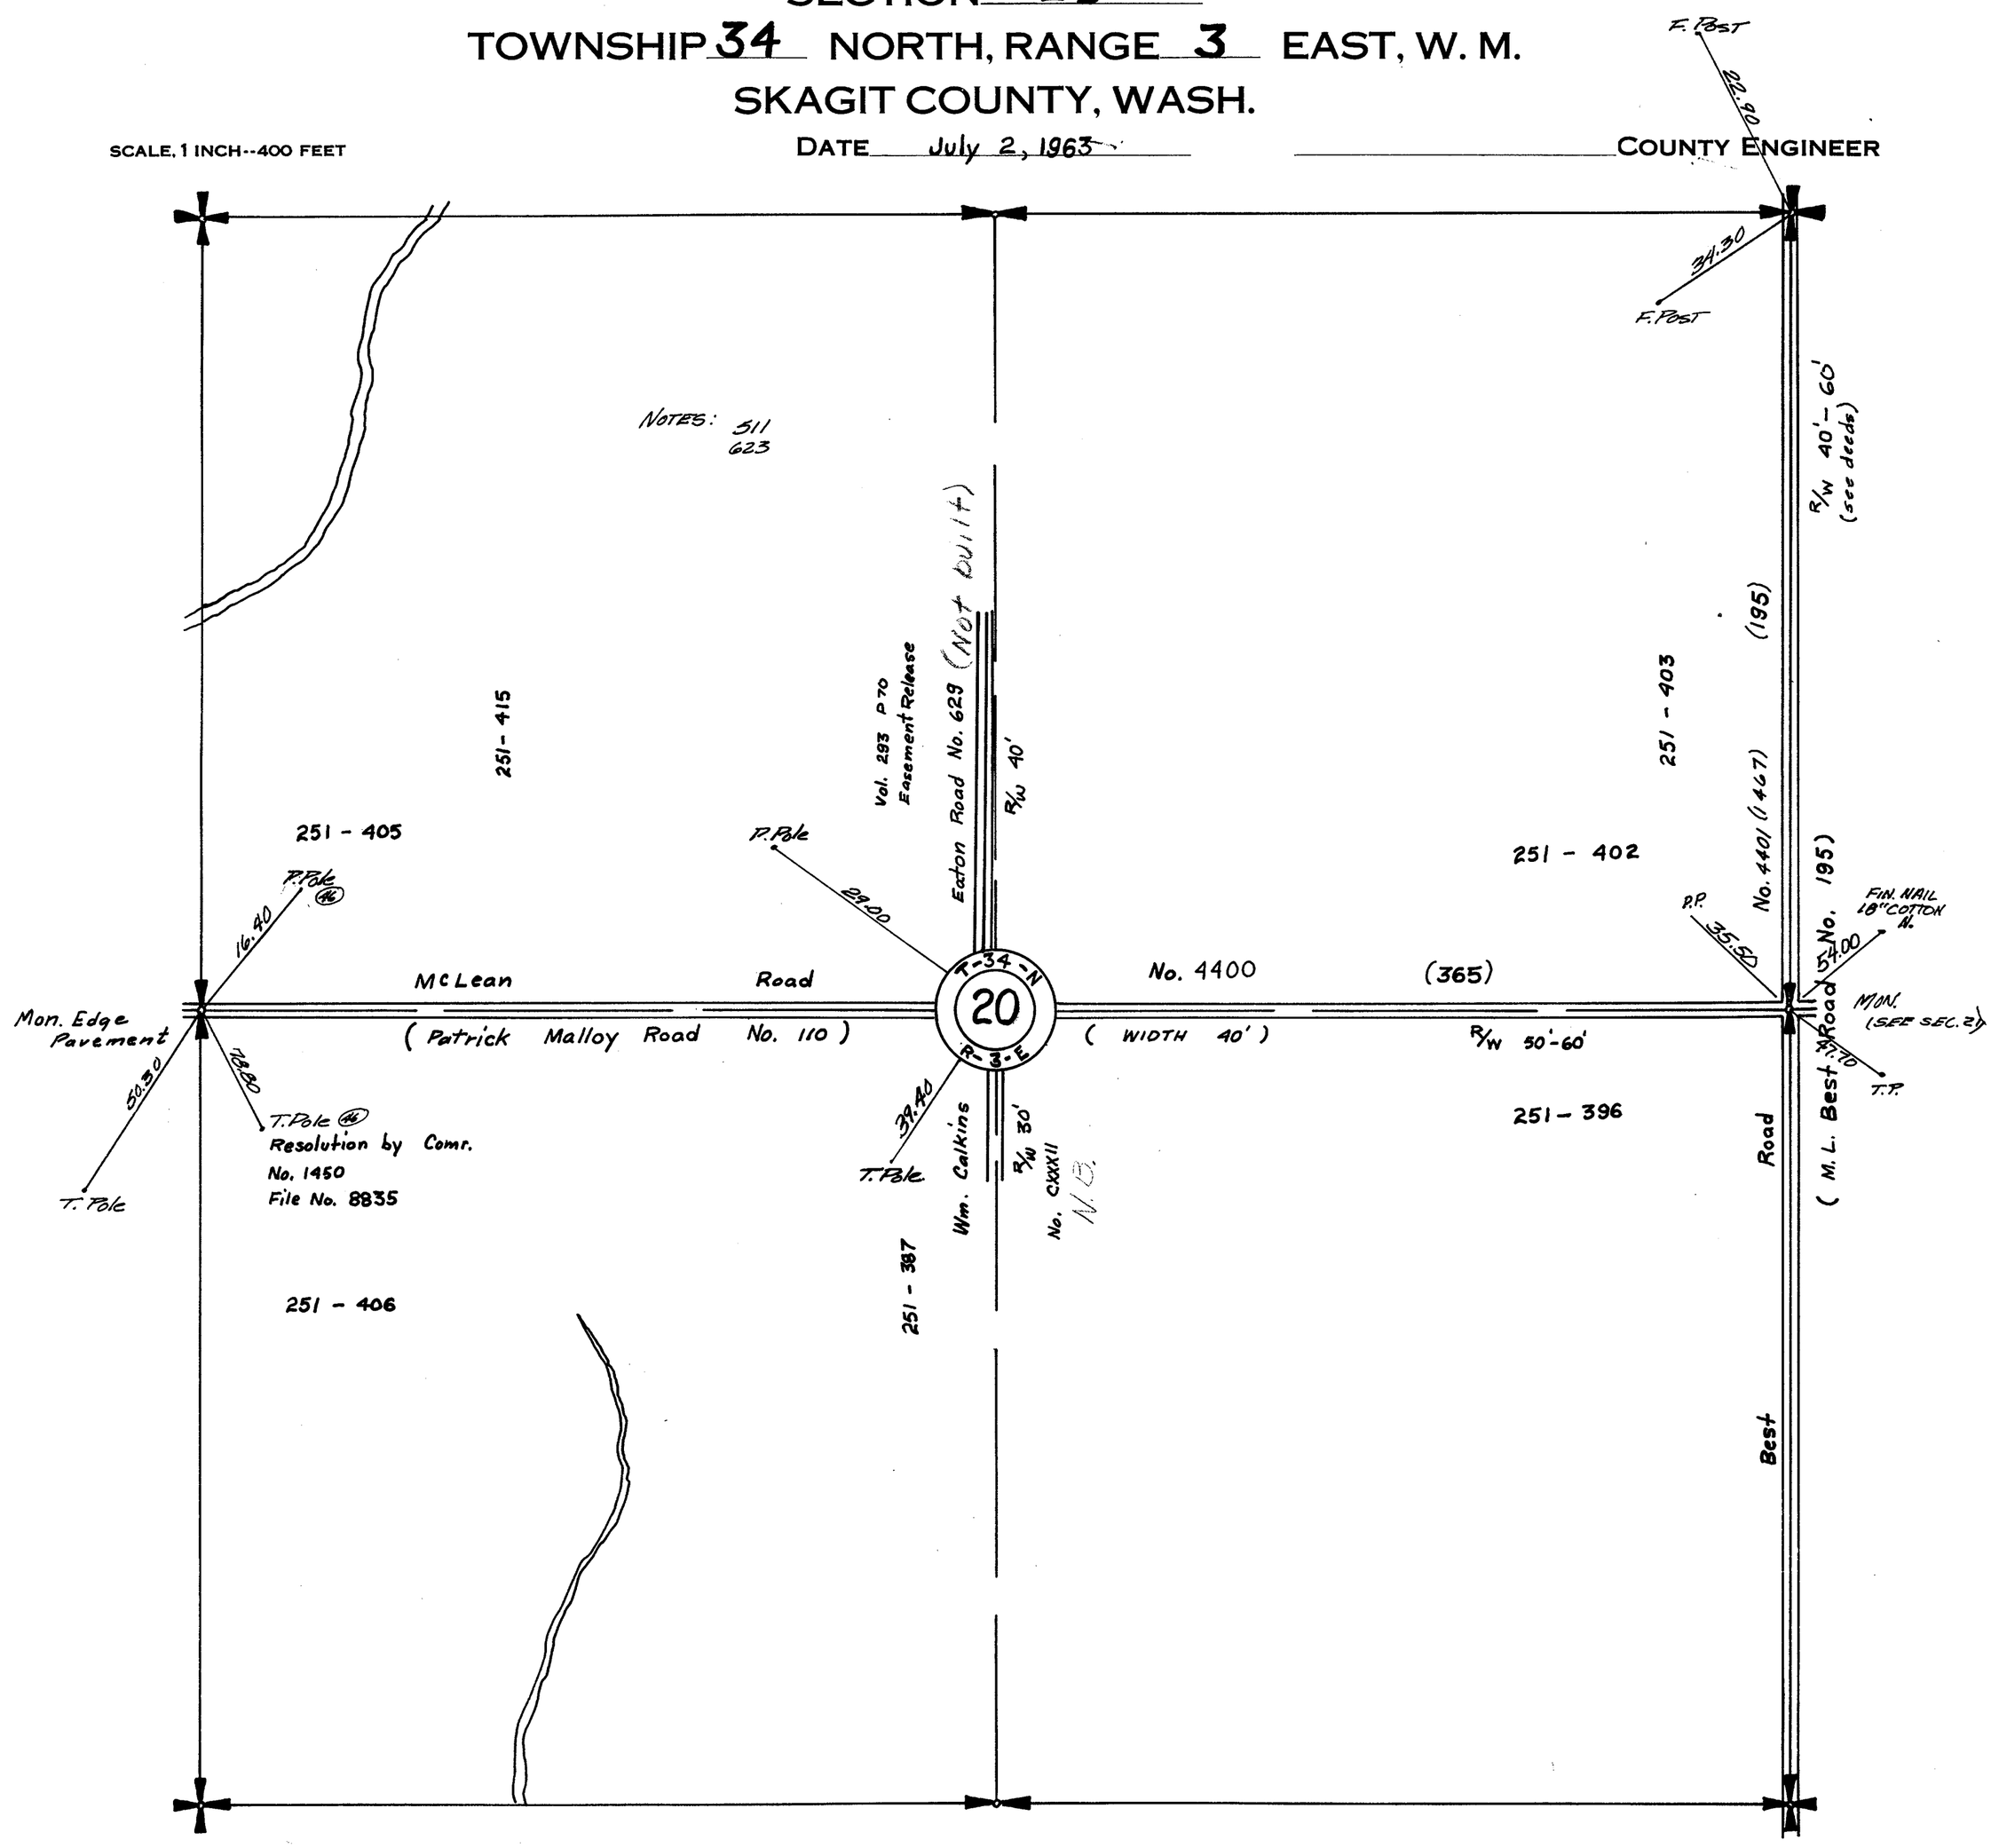

SECTION 21

TOWNSHIP 34 NORTH, RANGE 3 EAST, W. M.

SKAGIT COUNTY, WASH.

SCALE, 1 INCH = 400 FEET

A. L. STRONG COUNTY ENGINEER

FOR SUB-DIV. NOTES SEE TR. BK. Nº 61

TACK F.P.
STEEL F.P. FILED "X"
APPROX. CONC. NAIL IN WASHER 53+44.9
FIN. NAIL TOP COR. F.P.
TACK TOP F.P.
N. 89° 29' 50" E. 2614.03
N. 89° 34' 50" E. 2663.93
18" CHEST.
R.P.
No. (195)-(1467)-4401 Road
No. (159)-(2401)-4441 Road
40' & 60'
2651.6
2640.4
2624.5
S.W. MP3 1/4
79+96.5
2641.4
2616.5
(PERMANENT HIGHWAY No. 3A 40' WIDE TR. BK Nº 61) McLean Road NO. 4400
R/W - 50' & 60'
(ROAD No. CXIX) 40' WIDE
(ROAD No. LXIII) 49.5' WIDE
MON. CENT. PAV.
T.P.
No. 1012 Dist. #1
No. 2012 Dist. #2
T. POLE
P. POLE 1906
2652.4
2638.0
2621.5
Bradshaw
24.50
R/W - 49 1/2'
P. POLE
F.P.
106+48.9
1 1/4" PIPE MON.
T. POLE

SECTION 22

TOWNSHIP 34 NORTH, RANGE 3 EAST, W. M.

SKAGIT COUNTY, WASH.

Assembled by W.C.W. from LID 6
LID 7
PH 3A
39/445

SCALE, 1 INCH--400 FEET

H.O. WALBERG COUNTY ENGINEER

NOTES: 506
495

S 89° 27' 20" E 2603.00

N89° 24' 40" E 2576.92

18" CHEST. 69.30

66.50 P.P.

37.10 T.P.

No. (159) - (2401) - 4491

N0° 36' E 2622.12

P.P. 94.00

T.P. 52.00

120.0 P.

108.2 T.P.

(Bay View & LaConner or Daggett) Road No. LXVIII

No. (108) - (2403) - 4961

N0° 48' E 2626.90

Road

N.W. P. POLE SW. MA 3 16/7

NE. TACK COR. POST

35.68

Road

2600.5

M-A 3/17 P.P.

101.37

N.W. P. POLE 27.95

P.P. CUT OFF 39.16

East 2591.9

MON. PAU.

2576.7

MON.

McLean Road

No. (2012) - 4400

R/W - 50' - 60'

112.53 SW. P.P. 3085

36.10 T.P.

EVER GREEN SERVE U. T. S. E. COR.

Marsh

N0° 59' E 2621.7

Bradshaw

R/W - 49½'

N0° 49' 30" E 2619.57

(La Conner & Pleasant Ridge (Ext.) Road No. LXVIII)

Beaver

R/W - 33'

N0° 44' E 2617.5

N89° 57' 20" E 2599.18

N89° 57' 20" E 2580.92


SECTION 22

TOWNSHIP 34 NORTH, RANGE 3 EAST, W. M.

SKAGIT COUNTY, WASH.

SCALE, 1 INCH–400 FEET

A. L. STRONG COUNTY ENGINEER

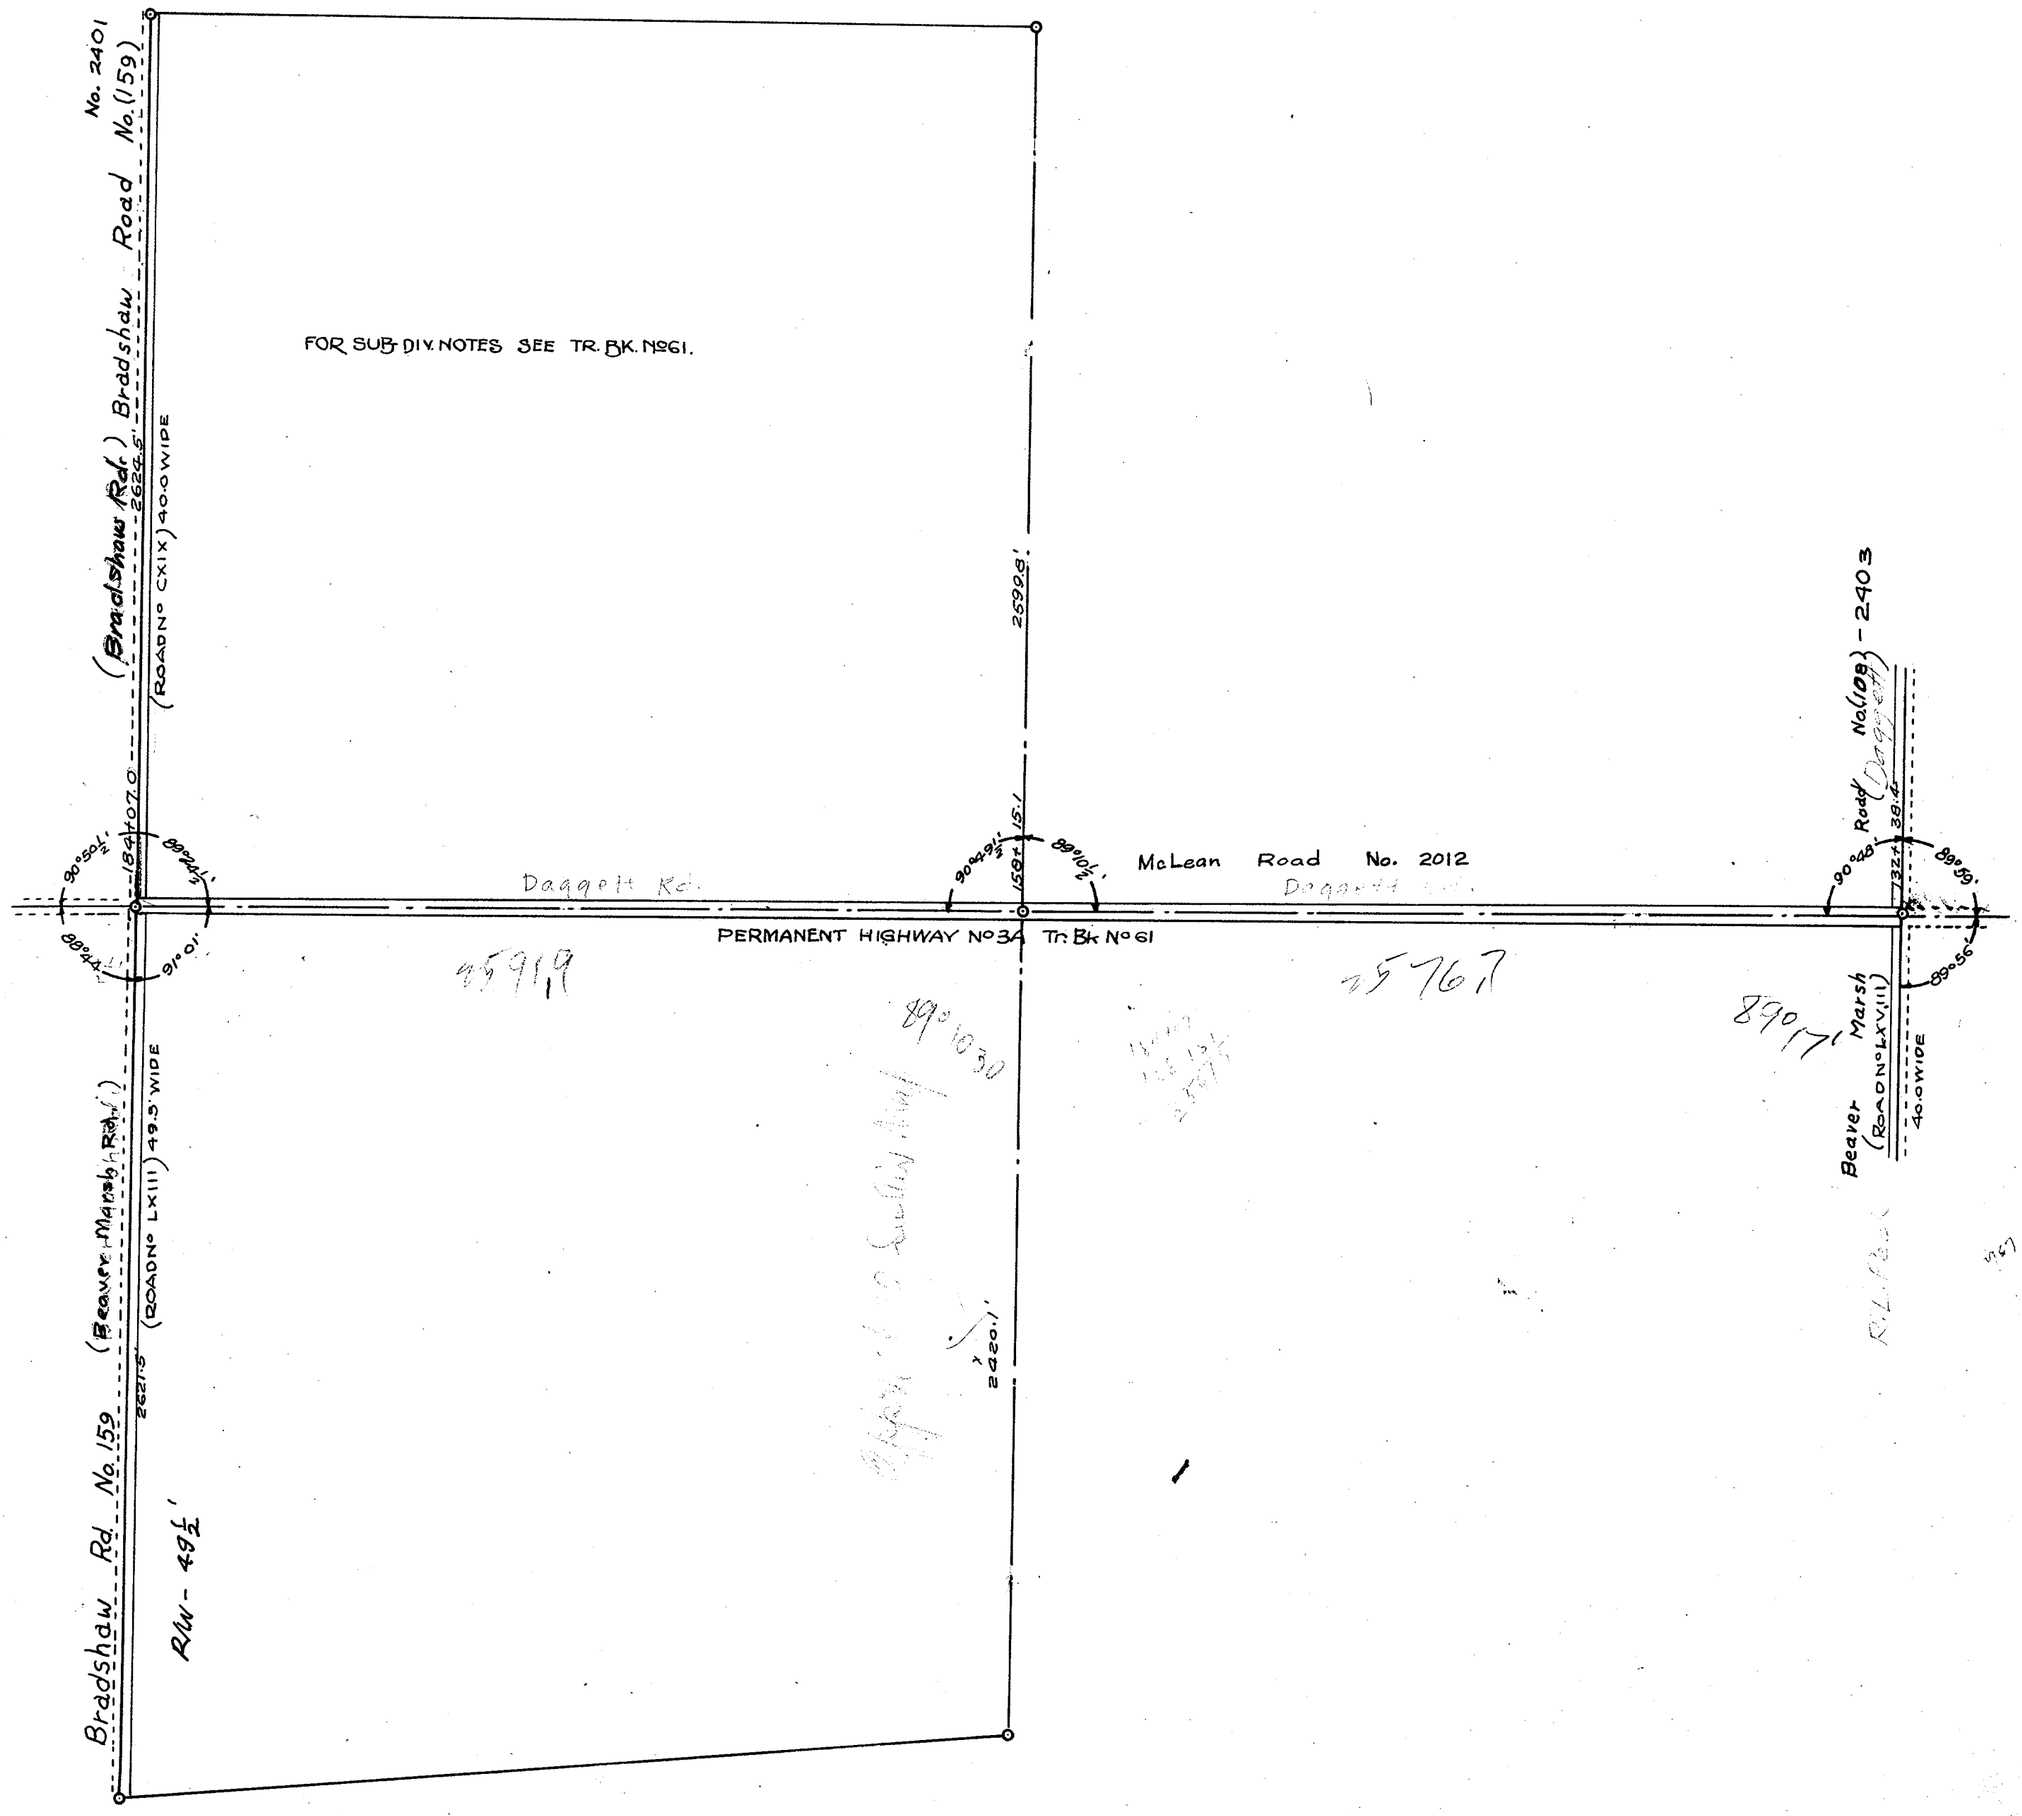

SECTION 23

TOWNSHIP 34 NORTH. RANGE 3 EAST. W. M.

SKAGIT COUNTY. WASH.

SCALE, 1 INCH—400 FEET

A.L.STRONG. COUNTY ENGINEER

(Barrett Road) No. (2430)

Dunbar Road No. 4520

NOTES: 611

P.P. 24.68

59.95 TREE

No. 3311

No. 2501

98.82 P.P.

Avon - Allen Road No. (122)

R/W - 40'

(No 2430) - (4500) - 4520

R/W - 40'

P.P. 94.00

60.00 T.P.

120.9 P.P.

100.20 T.P.

R/W - 33'

R.R SPIKE

La Conner or Daggett Road

No. LXVII

(No. 108) - No. 4461

1313.14'

R/W - 60'

No. 4440

No. (2496) - (644)

West Division

Bay View Road

Ginthner Drive

No. (2484) - (645) - 4471 R/W - 60'

Ginthner's Plat of Westview Manor Vol. 7 Page 89

N.E. P.D. S.W. MP-3 14/17

29.83

Center of Sec. 105+66.6

McLean Road No. (365) - (2012) - 4400

Resolution #1450 Commrs File #8835

Width 40 ft.

50' wide

Barrett Road

McLean Road No. (365) (2012) - 4400

Resolution #1450 Commrs File #8835

Width 60 ft.

Johnson Road No 1111

89°49'

89°45'

89°56'

1332+49.5 1/4 Cor.

La Conners Pleasant Ground No. LXVIII

Beaver Marsh No. 4461

PERMANENT HIGHWAY No 23

Transit Book No 61

1338.8

26.89

CONC. F.P.

G. POLE

S. 89° 52' W.

2677.6

1/16 Cor

0+00

33.64'

79.30 P.P.

78+87.9 1/4 Cor.

76.70 G.P.

79° 02'

267.70 T.P.

No. 4481 No (2405) No. (308)

Road

S. 0°49' W.

1315.0

13+16.51

4.23'

S. 0°25' 27" E.

2635.37

Kamb

R/W - 40'

S. 0°30' E.

2630.0

25.18'

26+32.82

1/16 Cor

N. 89° 45' E.

1340.63

2681.26

23 24

26 25

SECTION 24

TOWNSHIP 34 NORTH, RANGE 3 EAST, W. M.

SKAGIT COUNTY, WASH.

SCALE, 1 INCH -- 400 FEET

DATE 23 Sept 1968

Lloyd H. Johnson COUNTY ENGINEER

DUNBAR ROAD N 87°52'30" E 2624.12 R/W - 40' No. 4520 N. 87°28' E 2629.81

P. POLE 29.1 43.19 6" WALNUT PIPE & PLUG

89°18'

AVON ALLEN ROAD No. 3311 N 2° 49'30" W 2611.29 R/W - 40'

NOTES: 5/11/969

S 3°10'21" E 2612.56

S.S.H. 536

4601 R/W - 60'

4611

LANE SUNSET

COTTONWOOD LANE R/W - 60'

LIND ST. R/W - 30'

4602

4601

S 2°27'18" E 2630.53

P.T. 27+76.4 C=1° Δ=2°31' T=125.9 P.C. 25+24.7

P. POLE (48) S.E. 66.50

T. 34 N. R. 3 E. 24

S 89°52' W McLEAN ROAD No. 4400 2639.00 R/W 60'

(1298.59) (649.29) (649.30) (1298.59) (2597.18) (S89°07 E) S 89°52' W. 2597.1

2½" TREE (48) N.E. 10.30 179°29' 23.70 T. POLE (48) N.W.

83.70 T. POLE N.E.

68.4 T. POLE (48) N.W.

182°31'

N 2°55'30" W 2628.83

(1321.94) S 3°10'21" E 2643.88 (1321.94)

(2643.88) (S 0°89' E)

R/W 40'

(1313.27)

R/W 60' #4420 GREEN ACRES

(654.29) (654.29) (2617.19) (S 89°13'30" E) (1308.61) (1308.58)

(S 0°41'19" E) 2626.79 (1304.72)

(S 01°02'23" E) 2609.44

PENN RD #458

(1313.31) (S 0°35'31" E) (2642.68)

BEHREN'S & MILLETT ROAD R/W 40' No. 4582

(S 01°34'37" E) (1032.06) (1304.72)

SKAGIT RIVER

N 88°12'56" E 2646.28

(1318.65) (S 89°53'13" E) (2637.30) N. 87°28'48" E 2620.91 (1318.65)

88°42'12"


SECTION 24

TOWNSHIP 34 NORTH, RANGE 3 EAST, W. M.
SKAGIT COUNTY, WASH.

SCALE, 1 INCH--400 FEET

A. L. STRONG. COUNTY ENGINEER

Penn Road & Sub-Division added Aug., 1958

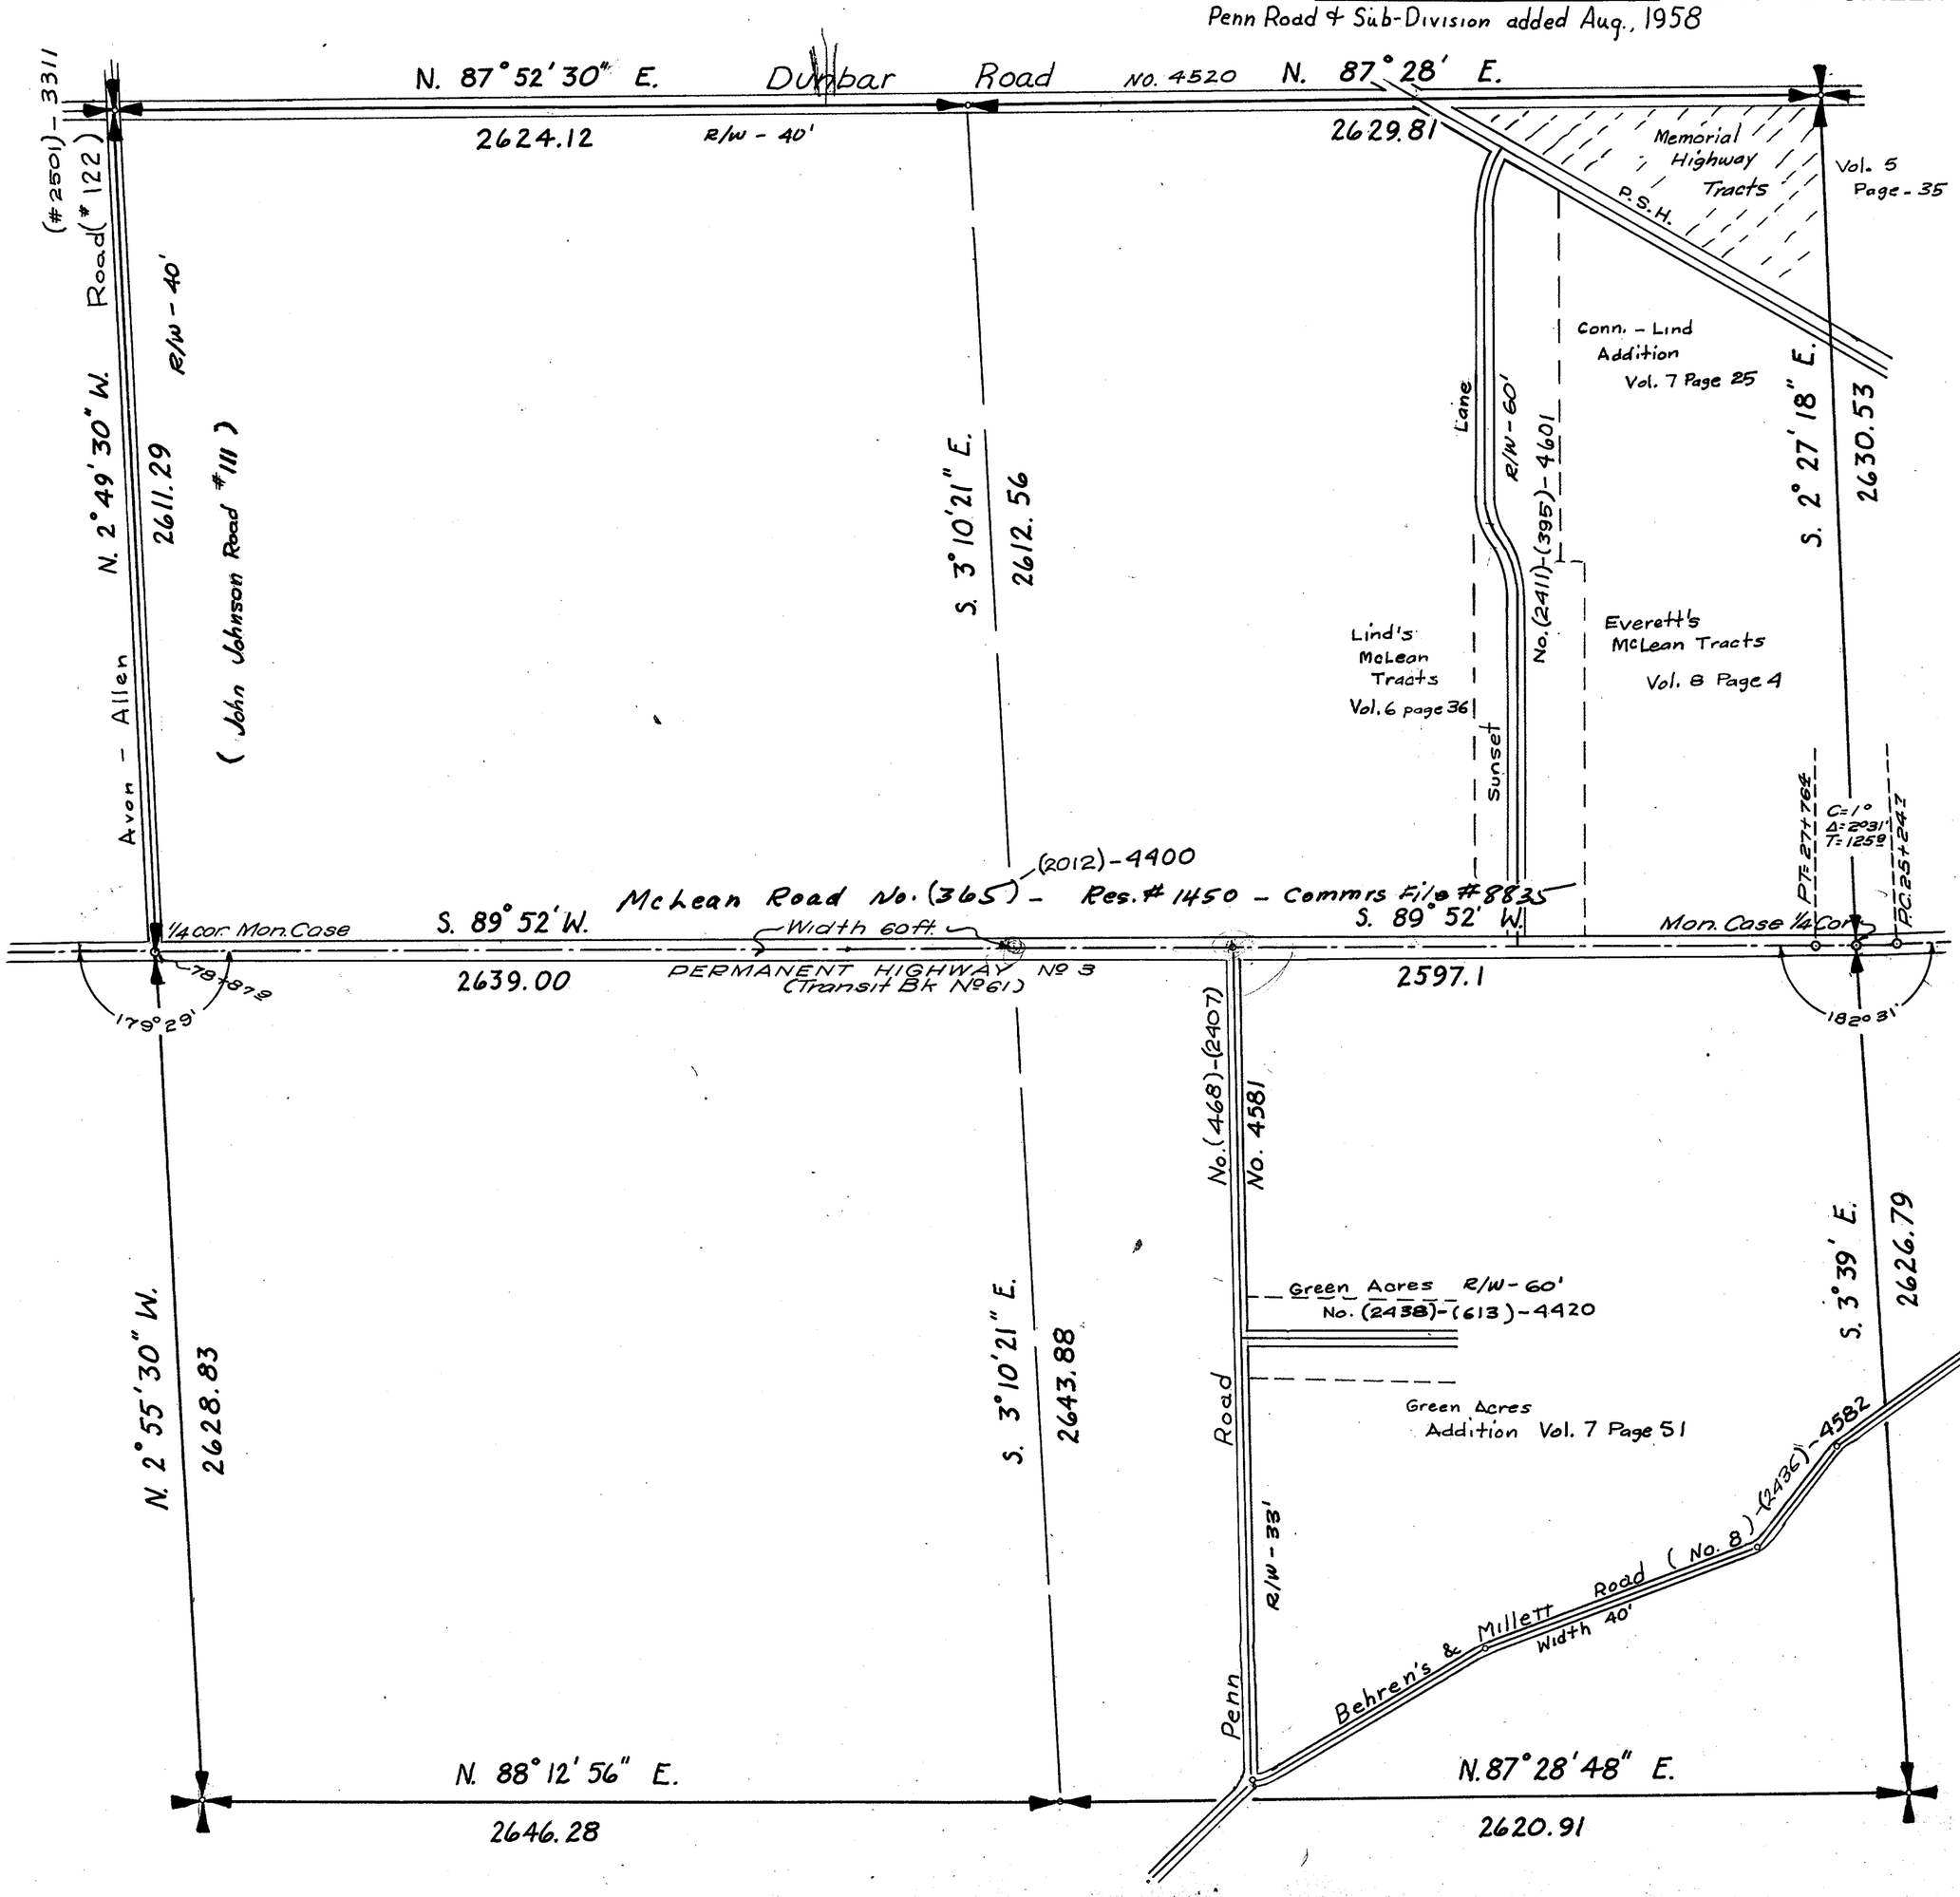


SECTION 25
TOWNSHIP 34 NORTH. RANGE 3 EAST. W. M.
SKAGIT COUNTY. WASH.

SCALE. 1 INCH—400 FEET

L. H. JOHNSON COUNTY ENGINEER

DATE Mar. 1976

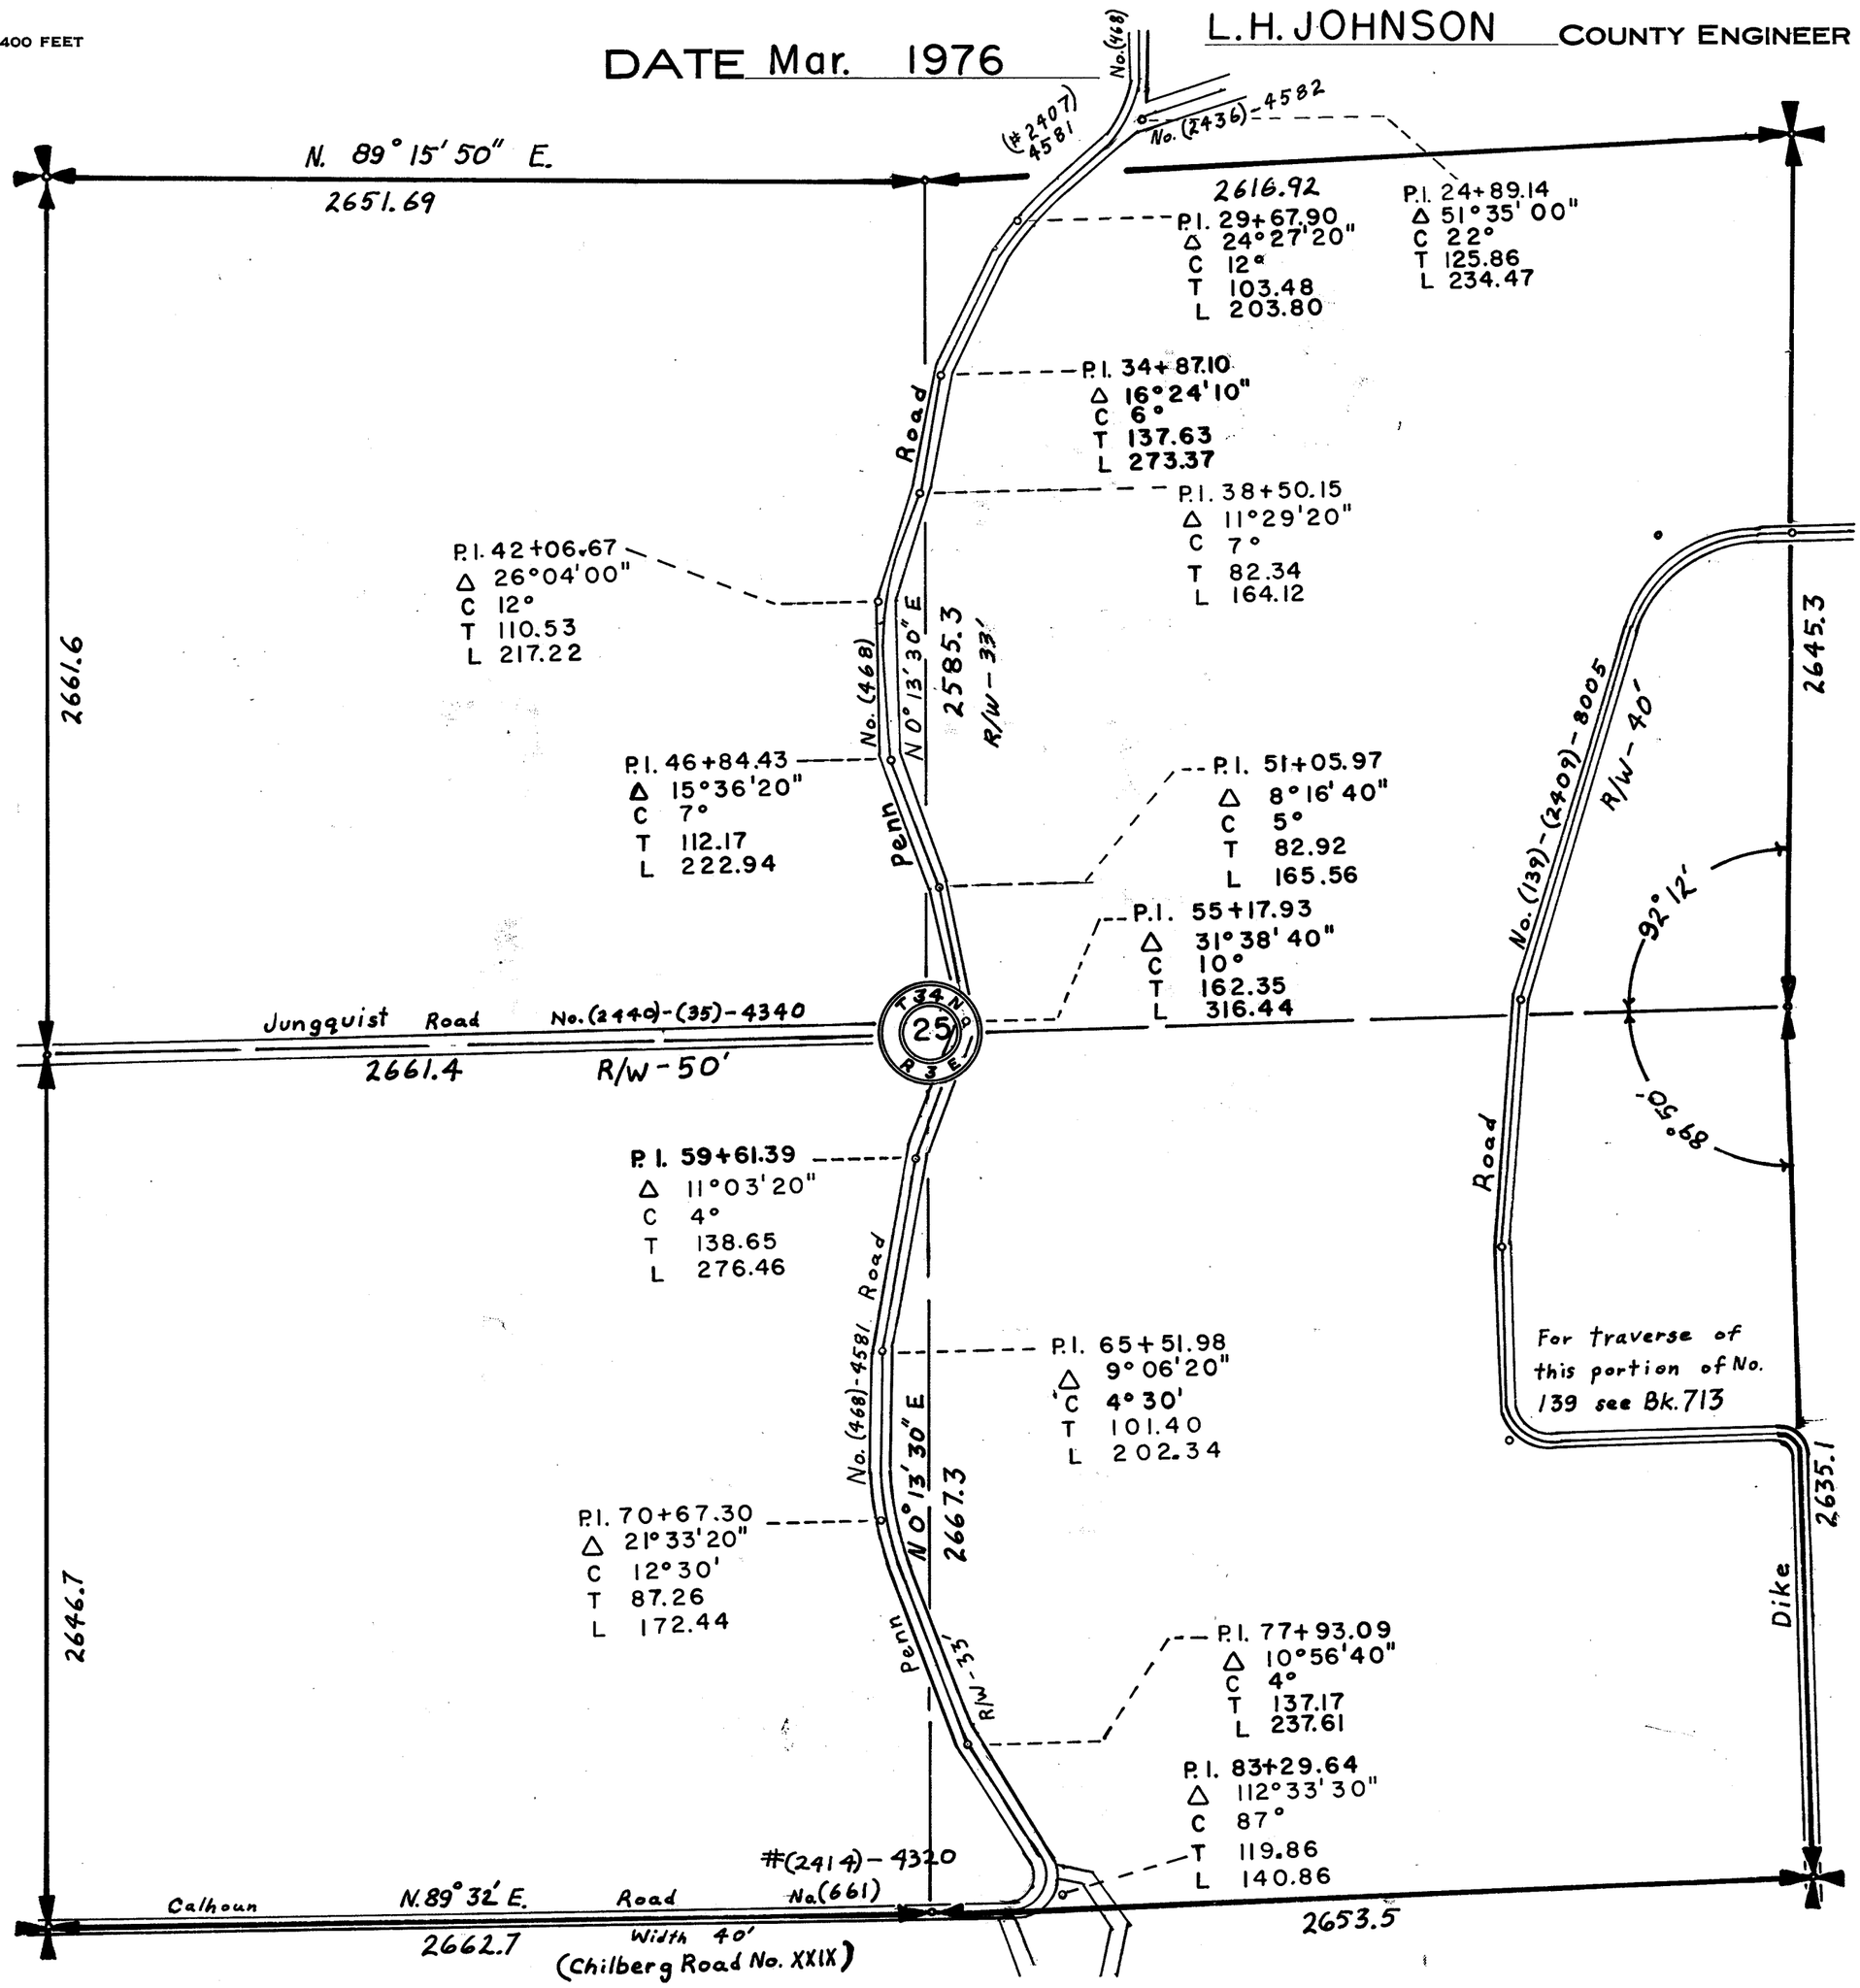

SECTION 26

TOWNSHIP 34 NORTH, RANGE 3 EAST, W. M.

SKAGIT COUNTY, WASH.

NOTES: 685
680
JUNQUIST ROAD SURVEY
1019
N-613

SCALE, 1 INCH--400 FEET

G.D. Le Gro
August 1958
COUNTY ENGINEER


N. 89° 45' E.
2681.26
POT. 26+32.82
25.18
1/4 Cor.
1340.63 to sec. cor.
23 24
26 25
PC. 26+62.7
PI. 27+54.51
PT 28+46.0
Δ = 7°20'
C = 4°
T = 91.81
L = 183.33
PC. 28+70.5
Δ = 6°42'
C = 3°
T = 111.82
L = 223.33
PI. 29+32.32
PT. 30+93.8
POT. 32+93.85
No. 4481
No.(2405)
No.(308)
POT. 39+53.5
R/W - 40'
Added June 25, 1963
Added June 25, 1963
No. (108)-(2403)-4461
N. 0°30' W.
2636.2
R/W-33'
S. 0°06'31" E.
2630.5
36" MAPLE
21.19
John Jungquist Road No. (182)-4340
John Jungquist
Road No. (35) R/W 50'
NO. 4340
MON. IN PAVE.
S. 89° 54' 04" E.
2676.7
R/W 40'-50'
T 34 N
26
R 3 E
Center of Sec. to 1/16 1328.75
3/4" BOLT SQ. HEAD
75.90
P. POLE
26.19
T.P.
P.O.T. 52+72.8
(pipe in mon. case)
S. 89° 54' 04" E.
2657.50
P. POLE
(70)
KAMB ROAD
R/W DEED NO.
737574
VOL. 44 PG. 584
738588
VOL. 45 PG. 803
736417
VOL. 43 PG. 19
NOTE NO. 63/1018
40" CEDAR
60.17
77.56
CLUMP CEDARS
P.O.T. 65+99.70
(spike)
Kamb Road
NEW ROAD ℄ IS 3.50' WEST OF SECTION LINE
R/W 40'
Beaver March Road No. (182)-4340
N. 0°30' W.
2645.7
S. 0°06'31" E.
S. 0°21'20" W.
2646.7
MON. IN PAVE.
S. 89° 44' E.
2655.8
Calhoun
(Chilberg Road No. XXIX)
R/W-40'
S. 89° 43' E.
2638.8
Road
No. (2014)-4320
No.(661)
T.P. 19.40
F.P.
41.70
35 26 25 36
38.58
FENCE POST
1/16 COR. 79+31.55
(pipe in top of oil)
25.86
55.15
R POLE
MAPLE TREE

SECTION 26
TOWNSHIP 34 NORTH, RANGE 3 EAST, W.M.
SKAGIT COUNTY, WASH.

SCALE, 1 INCH = 400 FEET

APRIL 25, 1972

LLOYD H. JOHNSON COUNTY ENGINEER

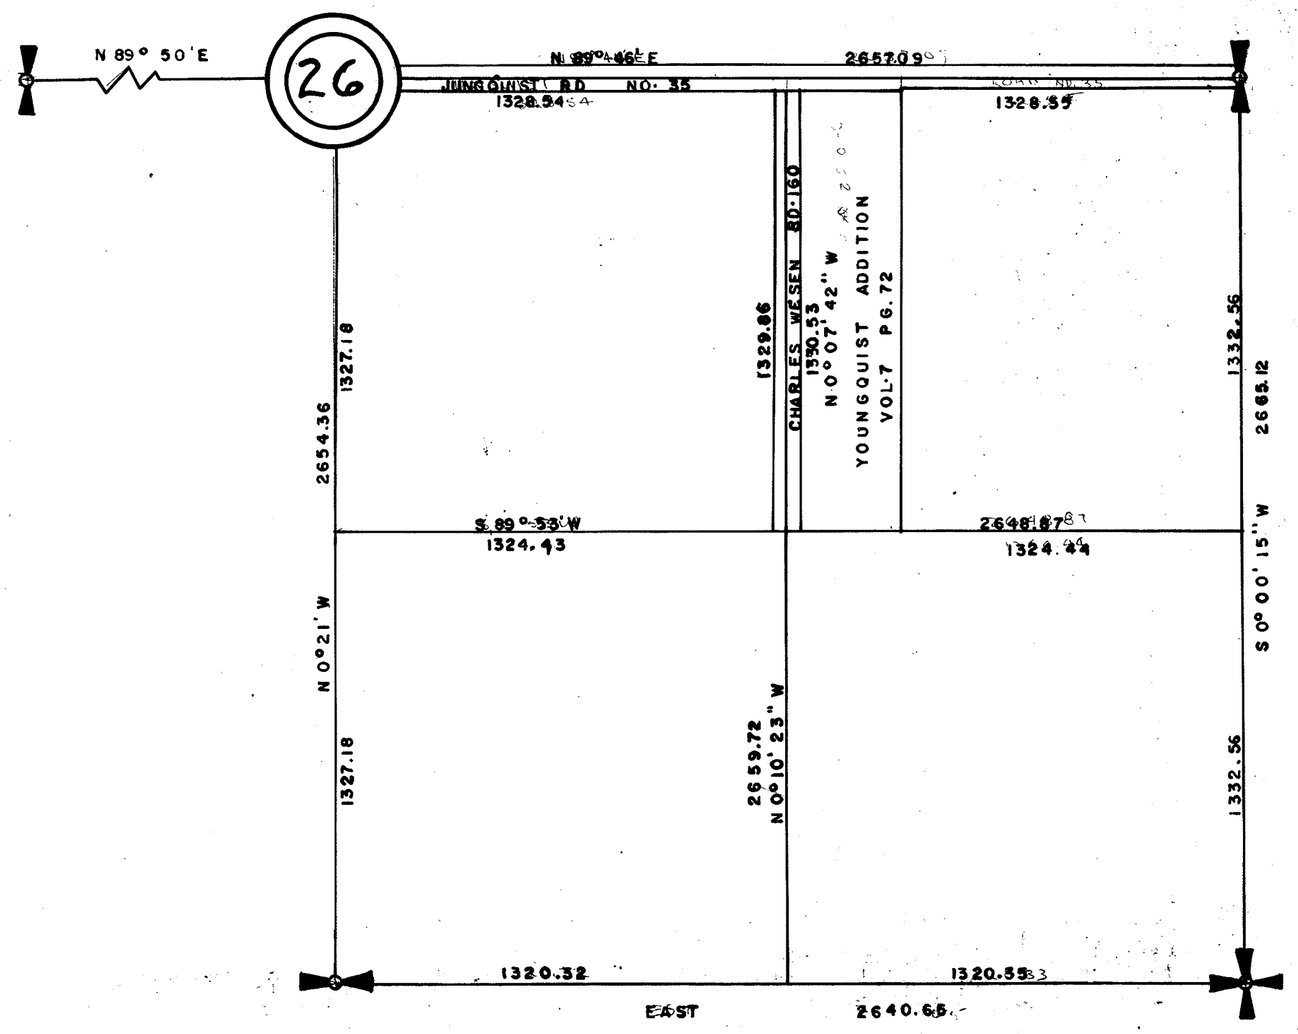

SECTION 27

TOWNSHIP 34 NORTH, RANGE 3 EAST, W. M.


SKAGIT COUNTY, WASH.

Assembled by W.C.W.

LID No.6
LID " 7
P.H. 3A

SCALE, 1 INCH--400 FEET

H. O. WALBERG COUNTY ENGINEER

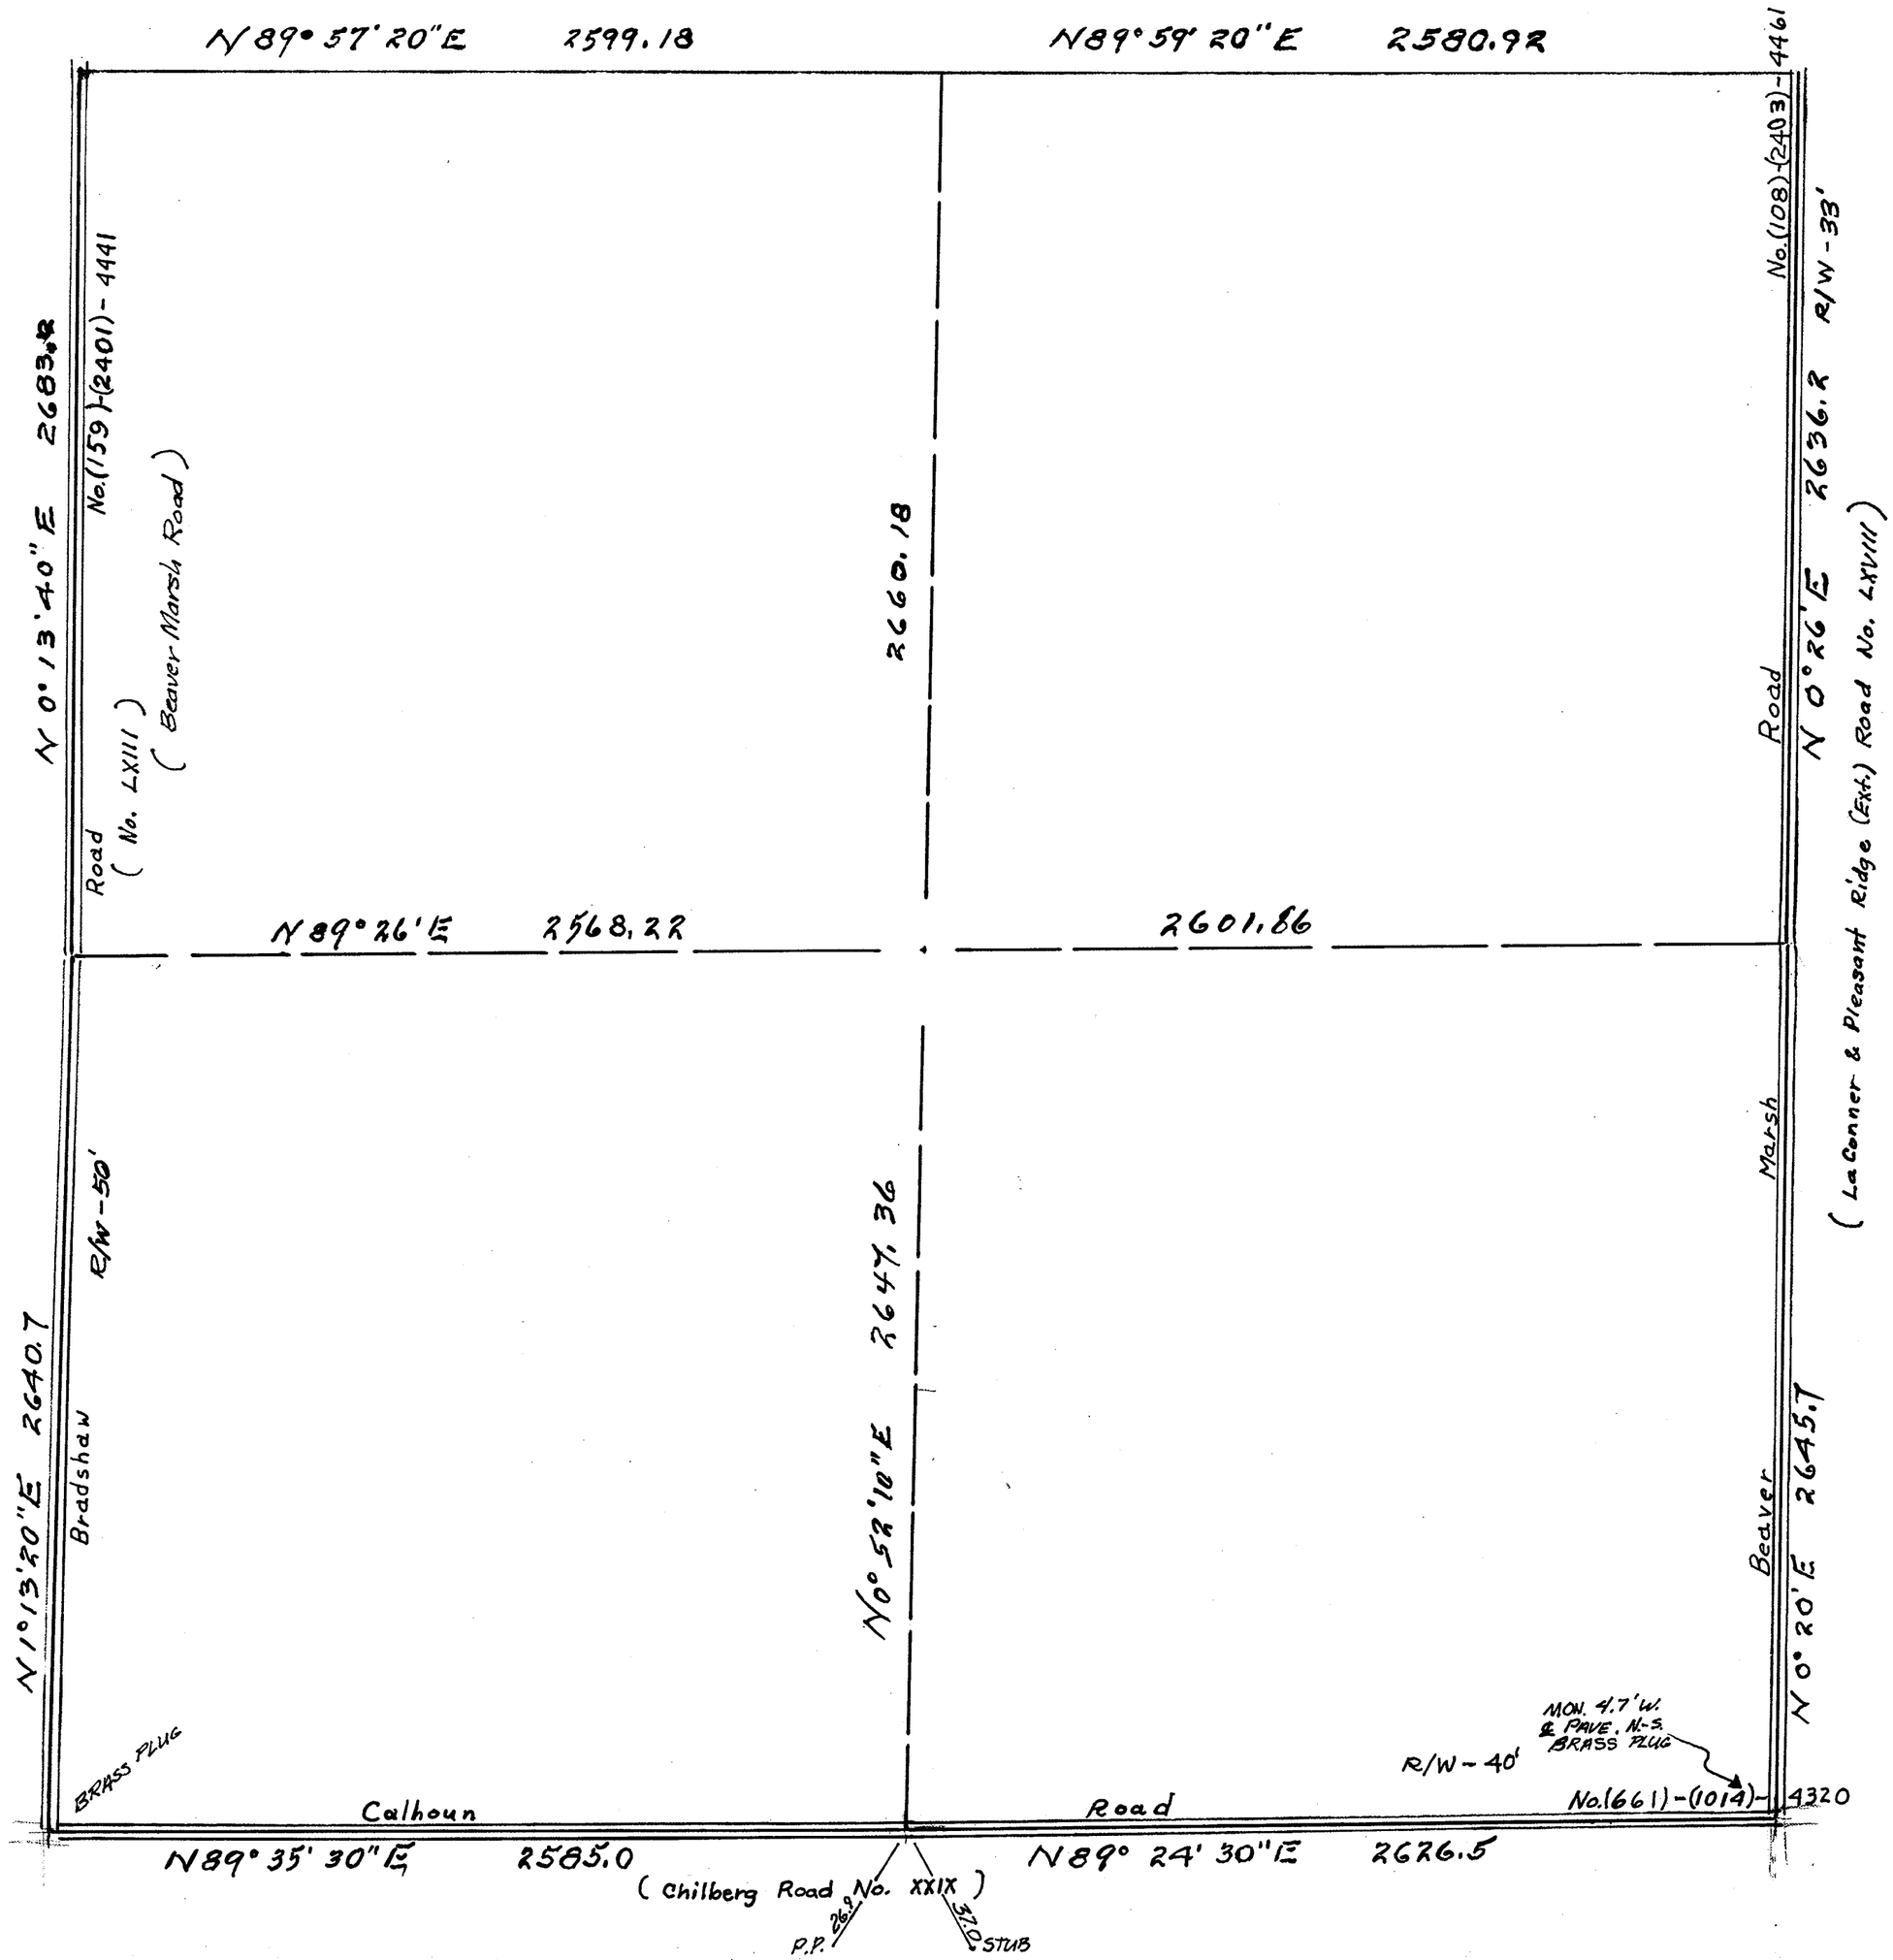

SECTION 28


TOWNSHIP 34 NORTH, RANGE 3 EAST, W. M.

SKAGIT COUNTY, WASH.

SCALE, 1 INCH--400 FEET

NOTES: 1037
831

G. D. LeGro
August 1958
COUNTY ENGINEER

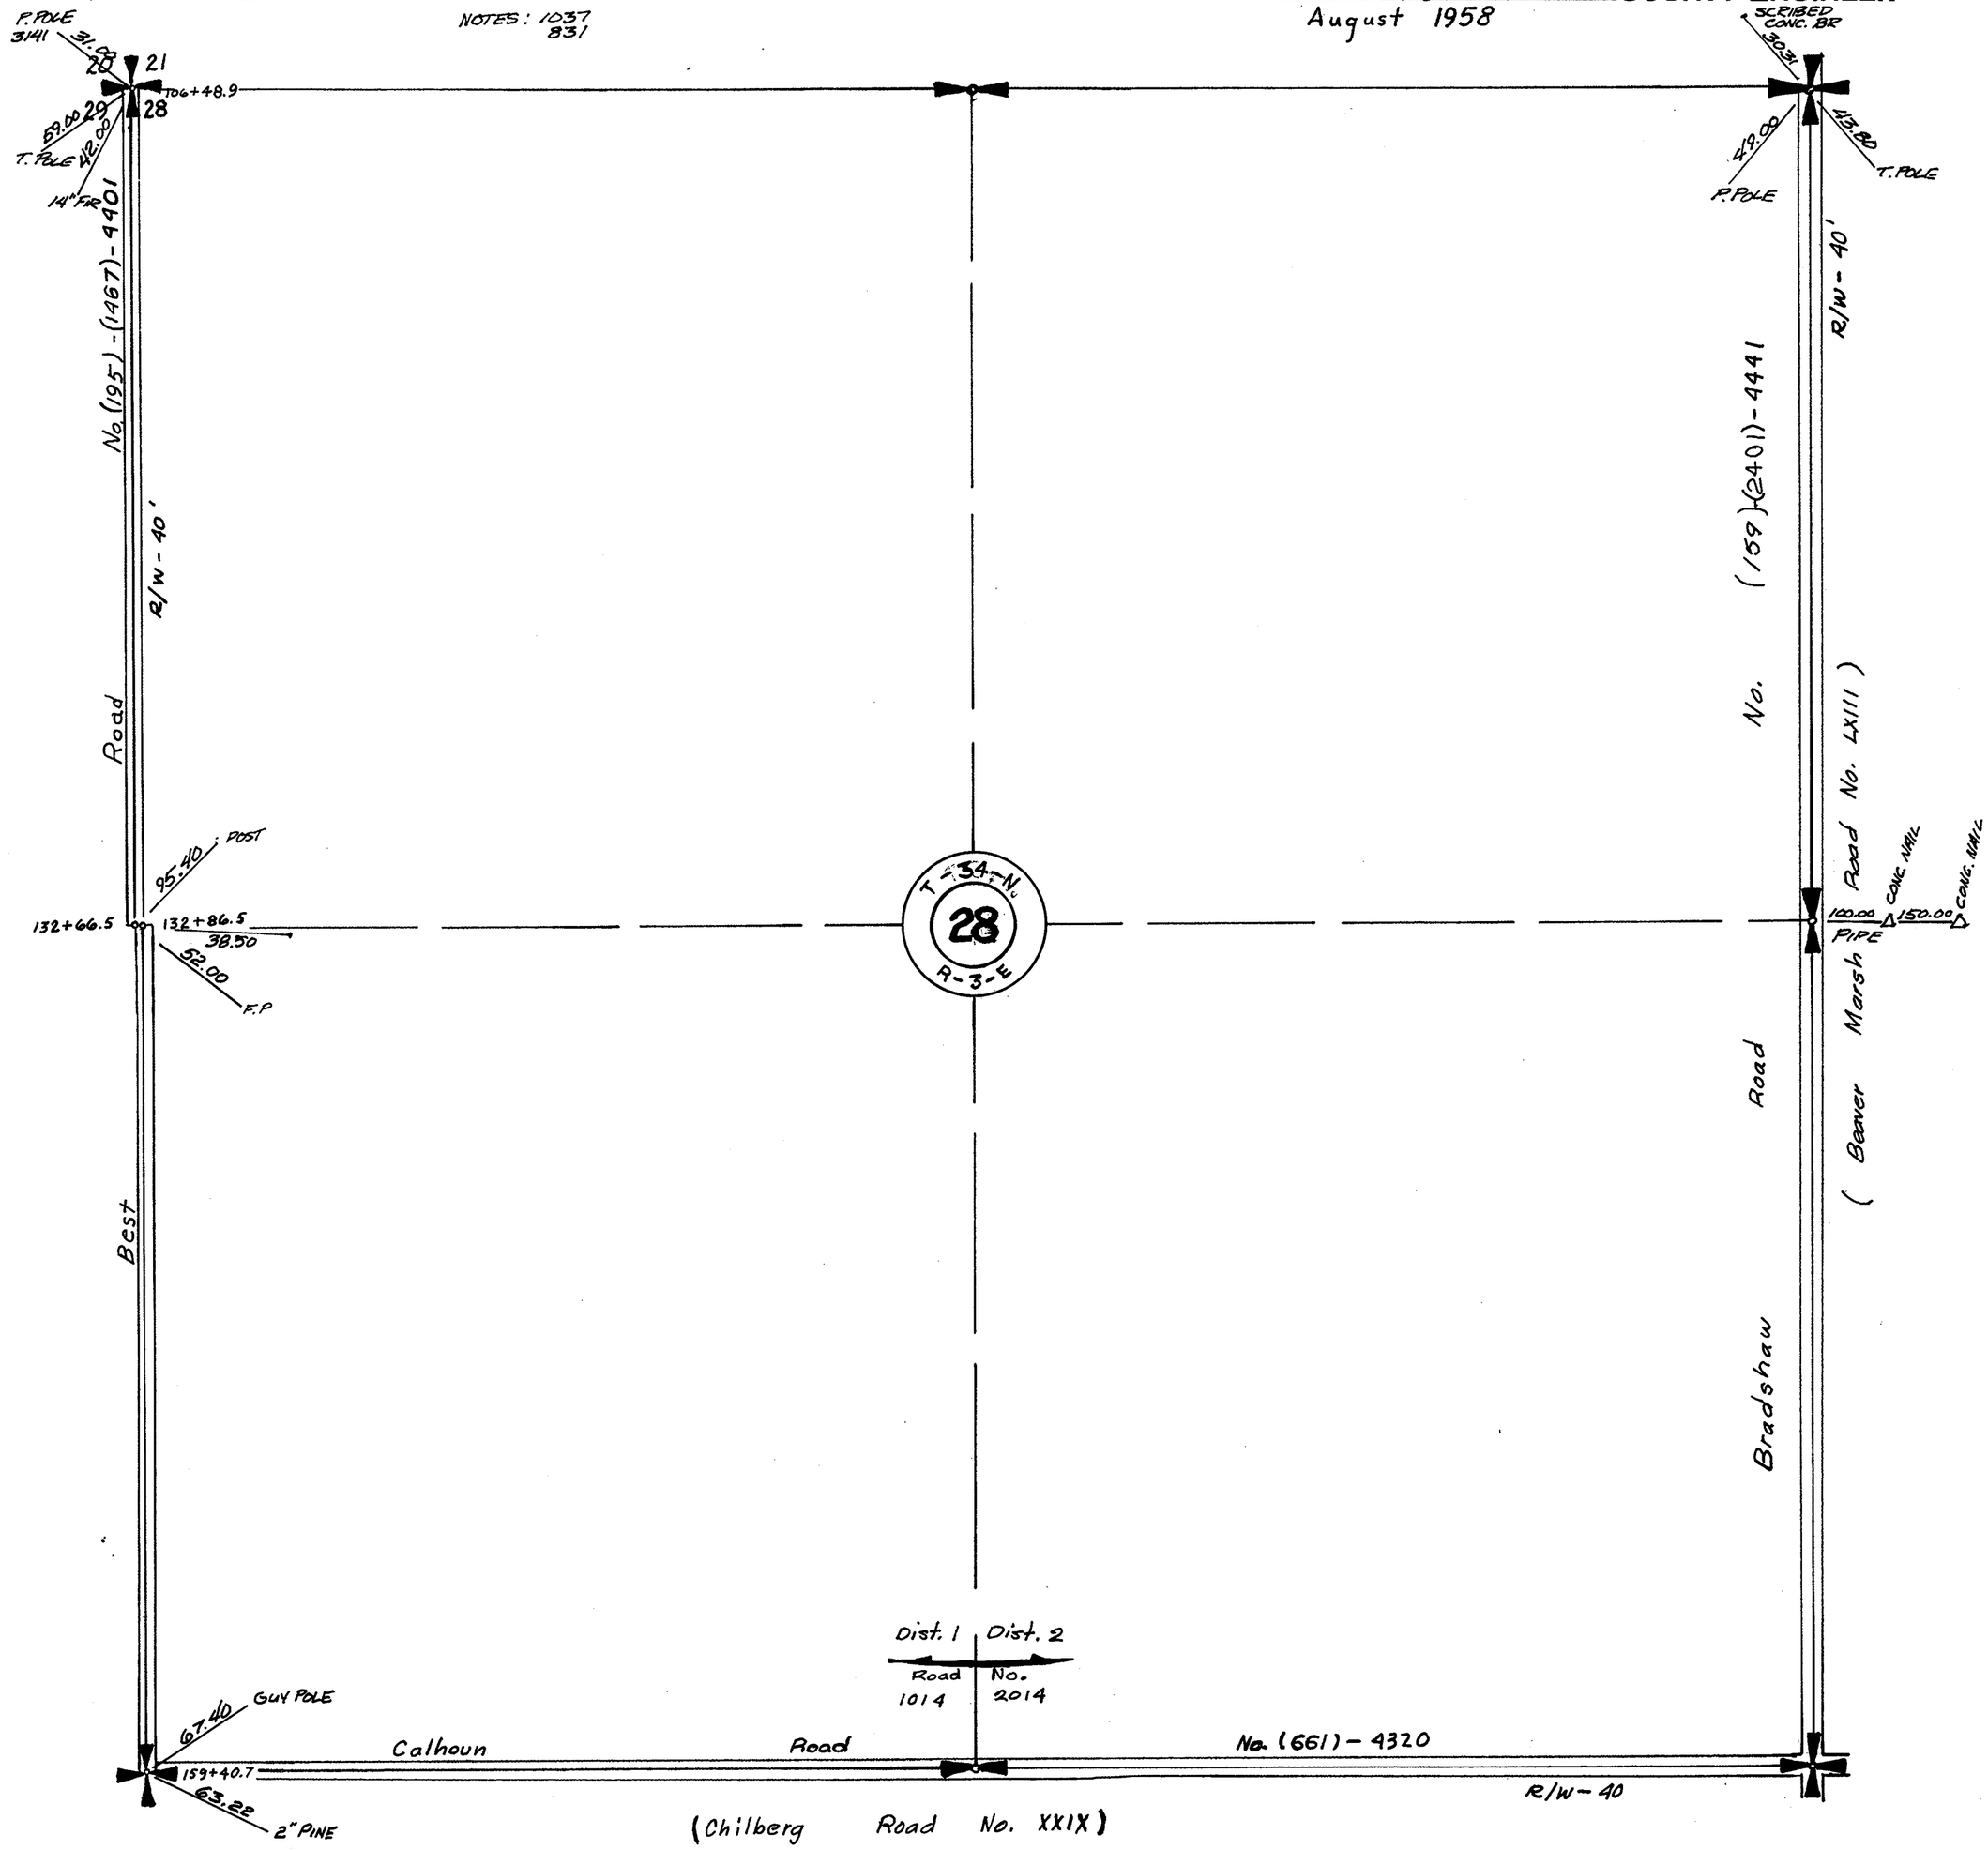

SECTION 29


TOWNSHIP 34 NORTH, RANGE 3 EAST, W. M.

SKAGIT COUNTY, WASH.

SCALE, 1 INCH--400 FEET

DATE July 2, 1963


_____ COUNTY ENGINEER

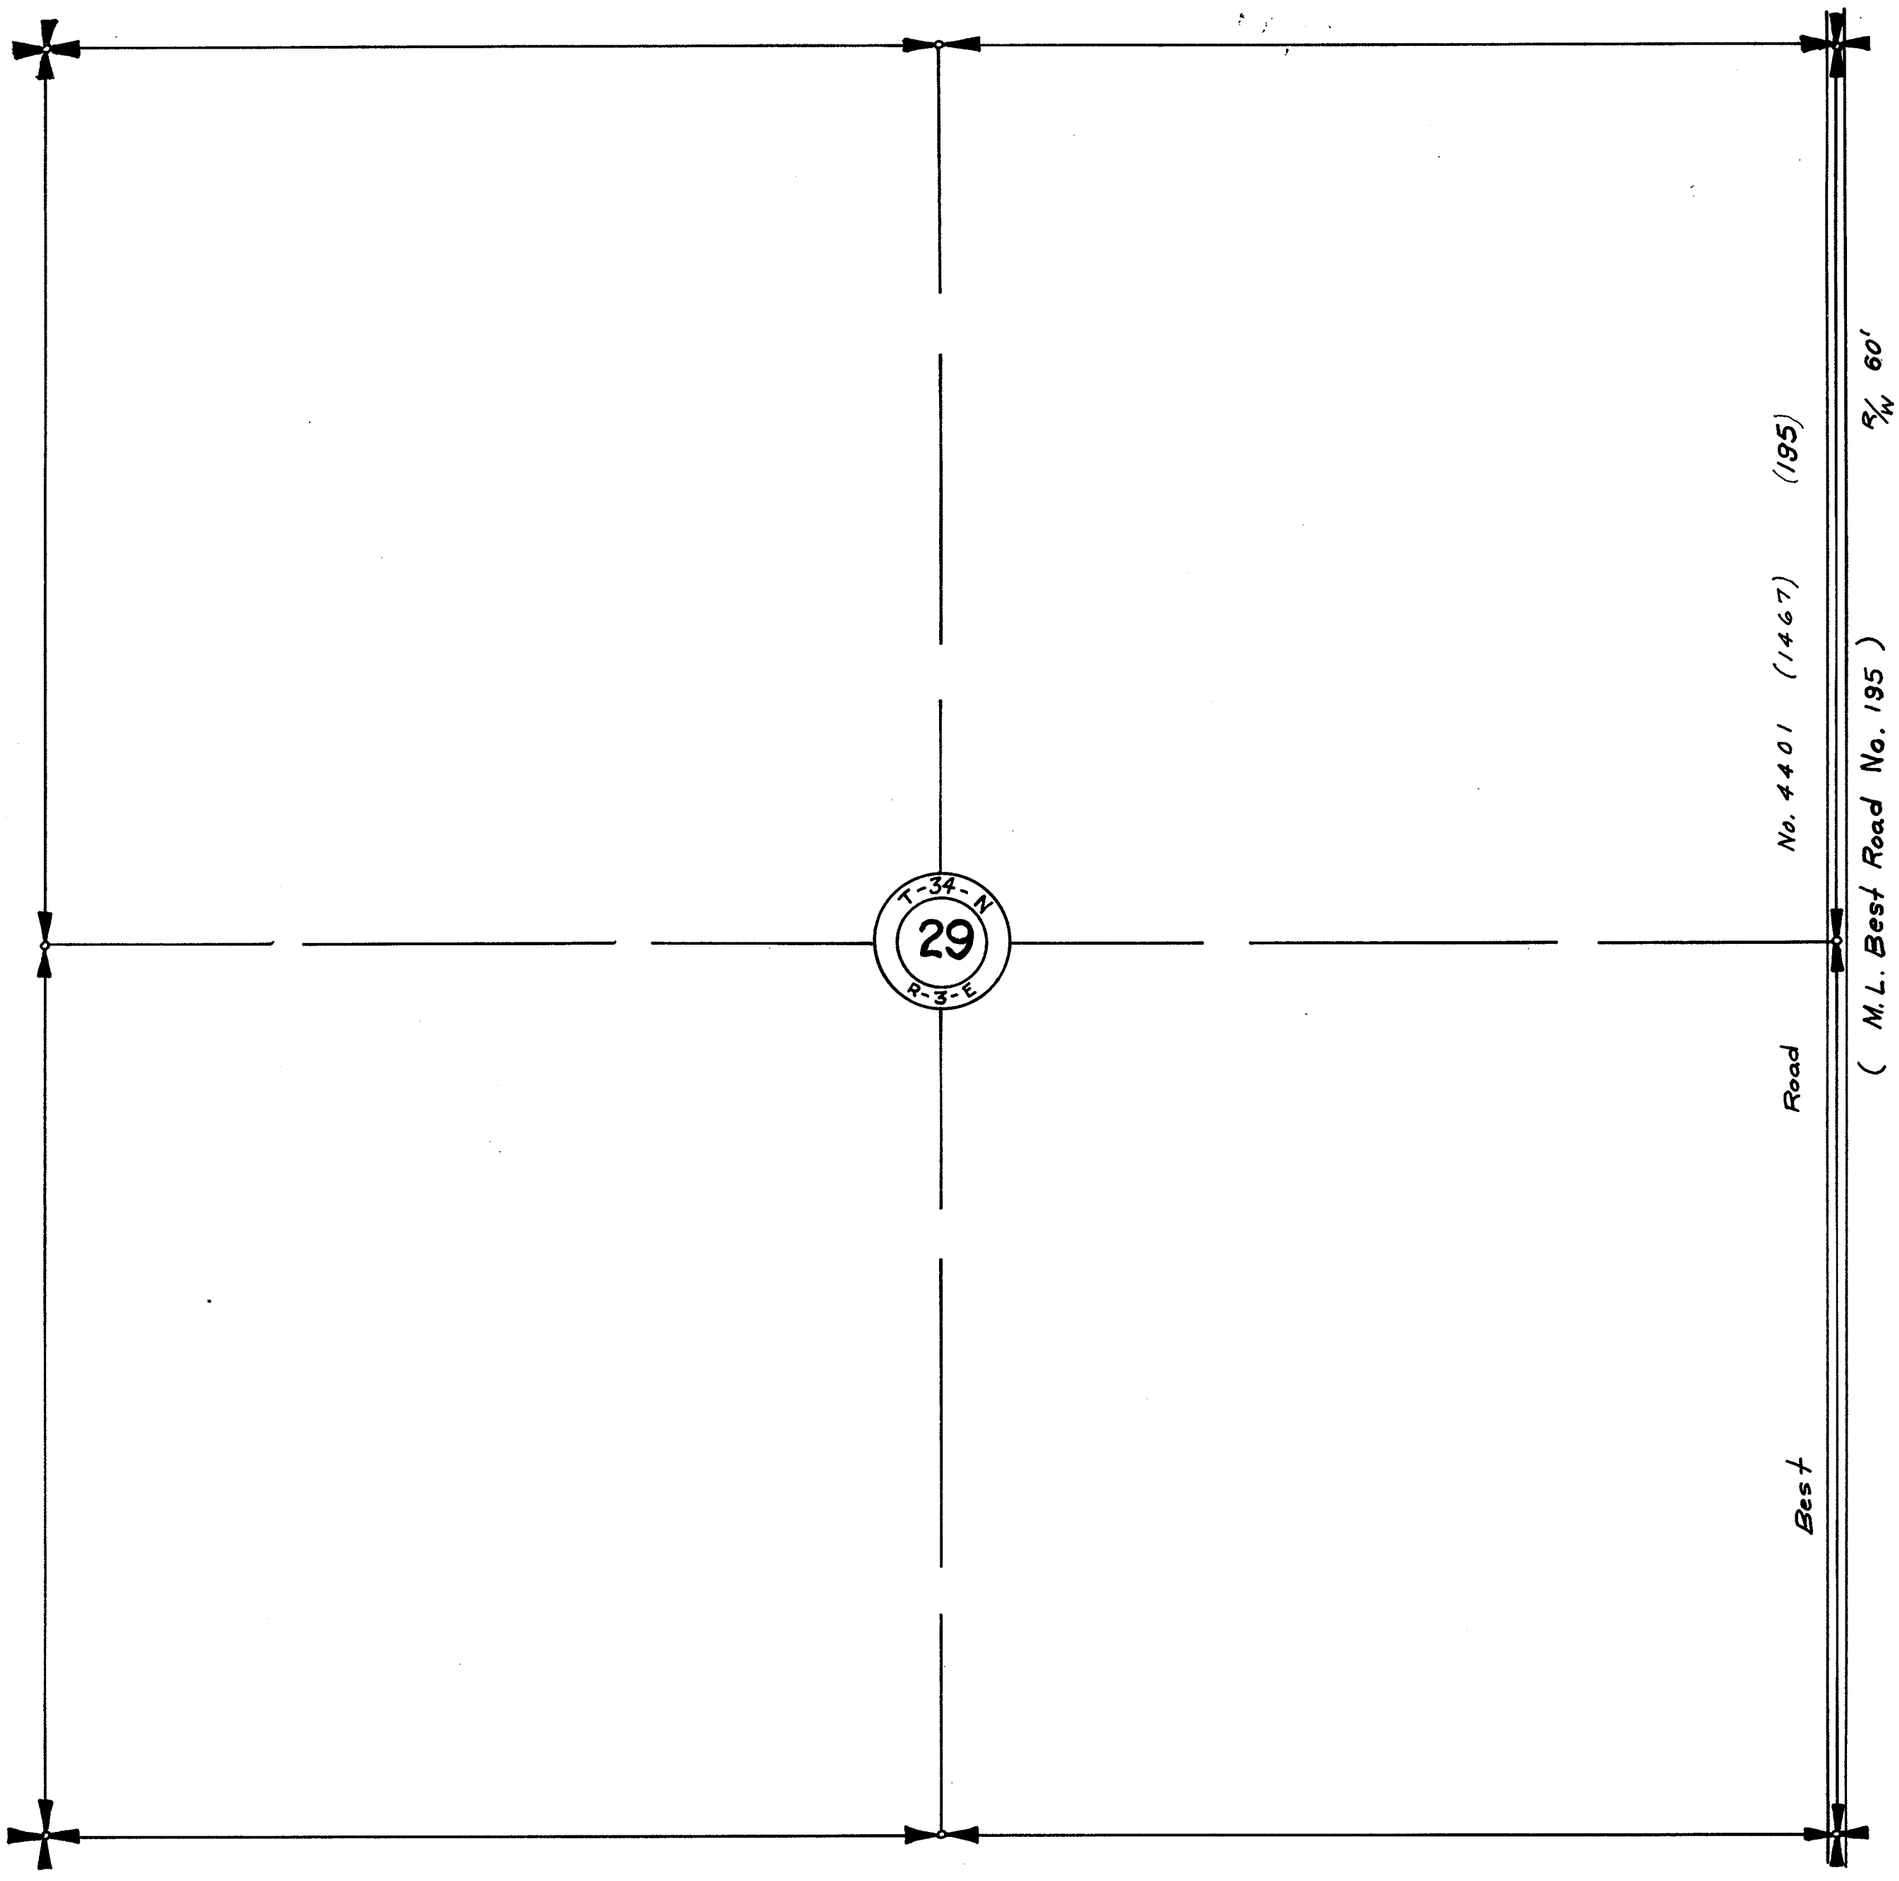

SECTION 30
TOWNSHIP 34 NORTH, RANGE 3 EAST, W. M.
SKAGIT COUNTY, WASH.

SCALE, 1 INCH--400 FEET

G. D. LeGro — COUNTY ENGINEER
August 1958
LACONNER-WHITNEY ROAD
ALIGNMENT REVISED 11/76 RWL

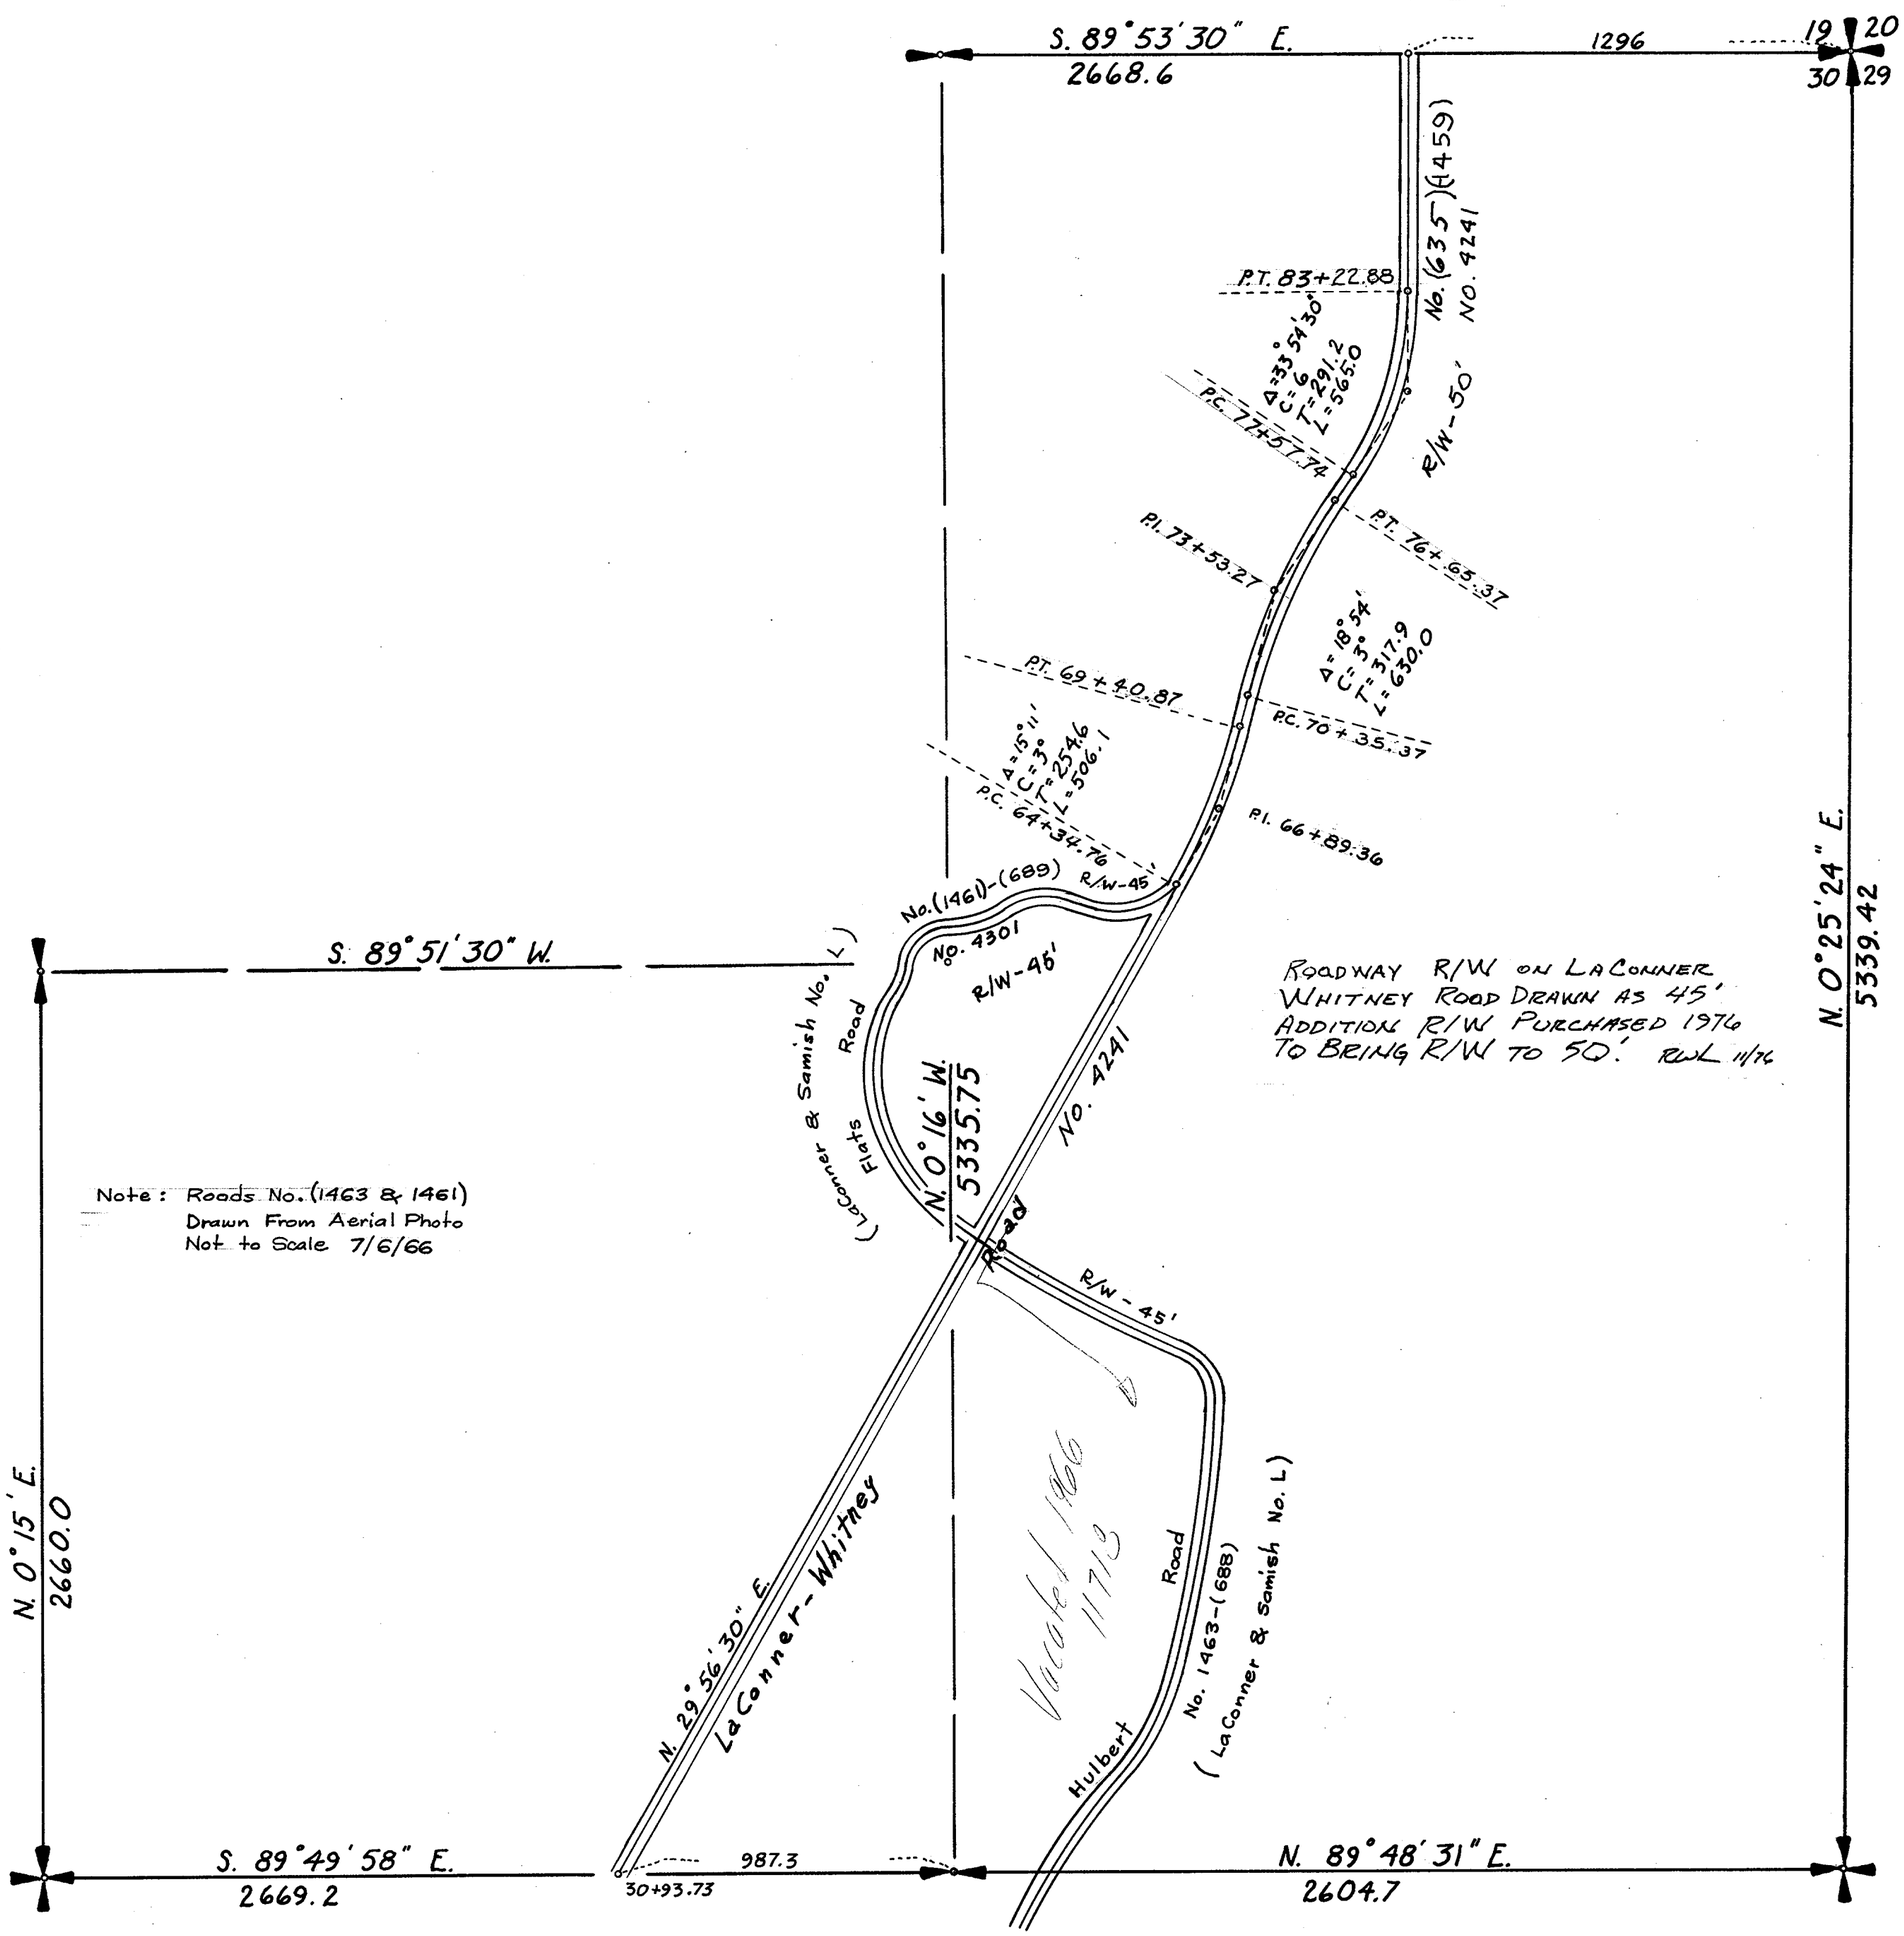


SECTION 31

TOWNSHIP 34 NORTH, RANGE 3 EAST, W. M.

SKAGIT COUNTY, WASH.

SCALE, 1 INCH--400 FEET

G. D. Le Gro COUNTY ENGINEER
August 1958

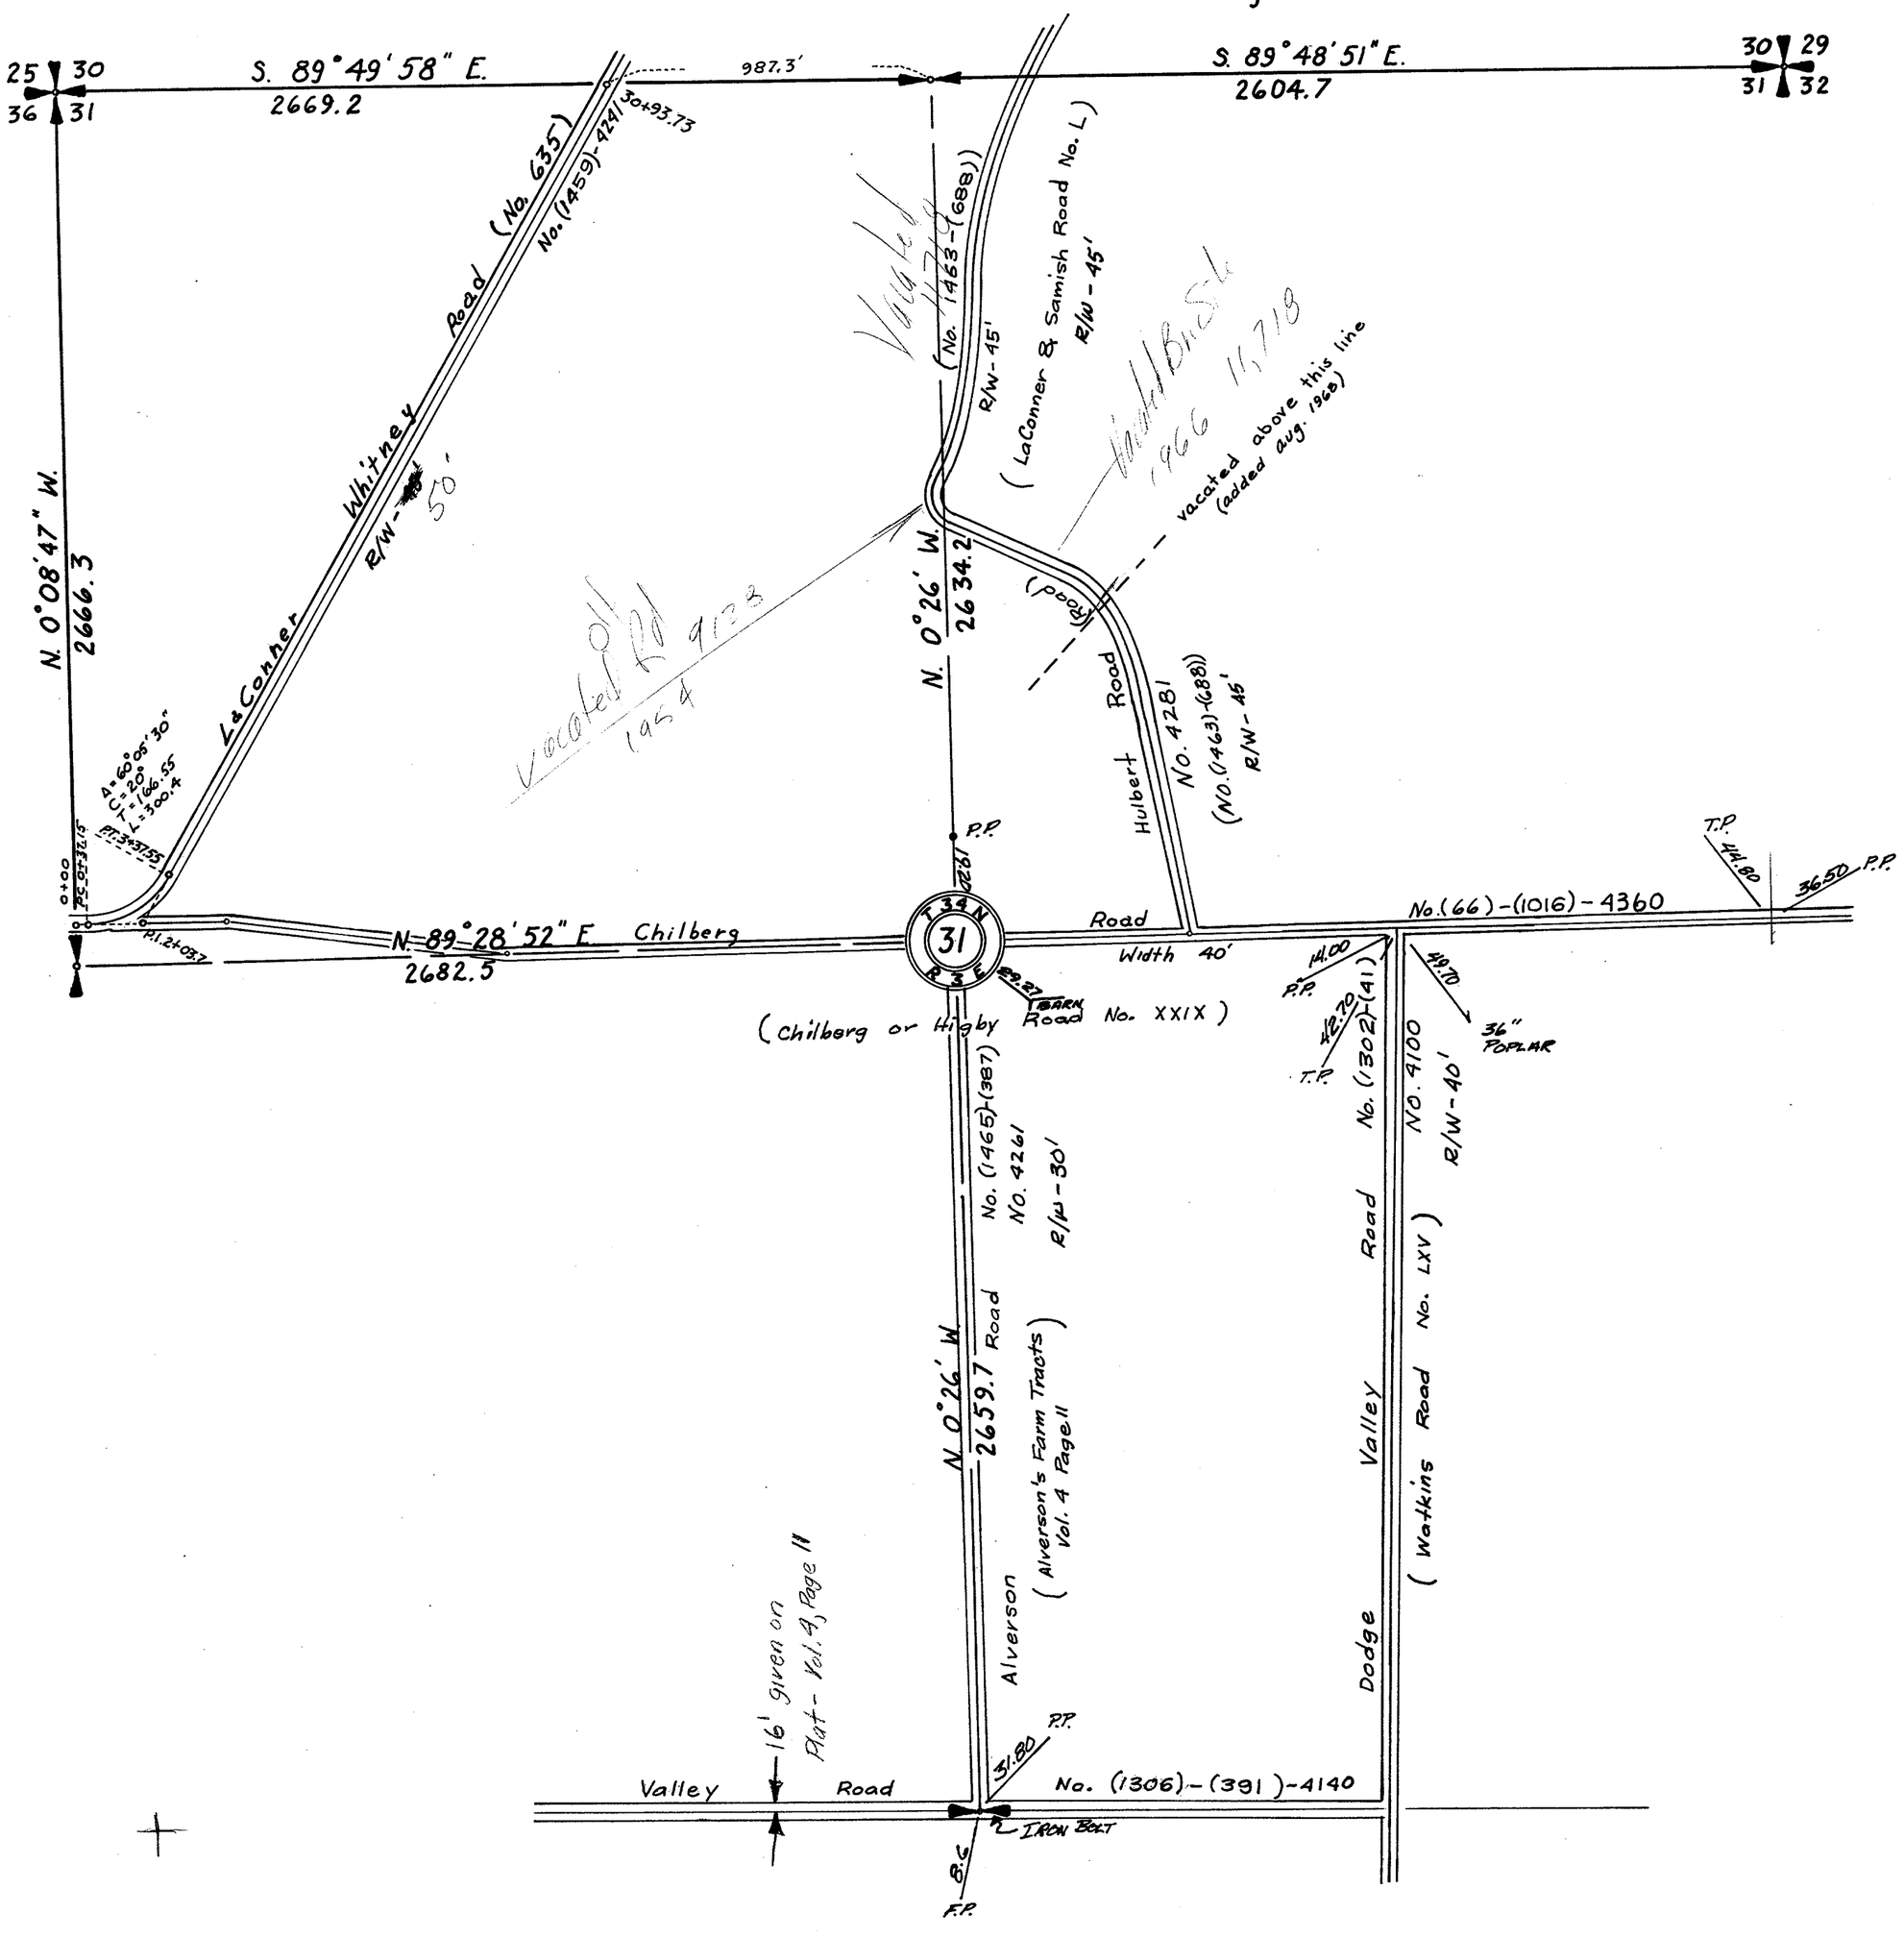

SECTION 32


TOWNSHIP 34 NORTH, RANGE 3 EAST, W. M.

SKAGIT COUNTY, WASH.

SCALE, 1 INCH–400 FEET

NOTES: 1037
1048


Robt. E. L. Knapp 1930. COUNTY ENGINEER

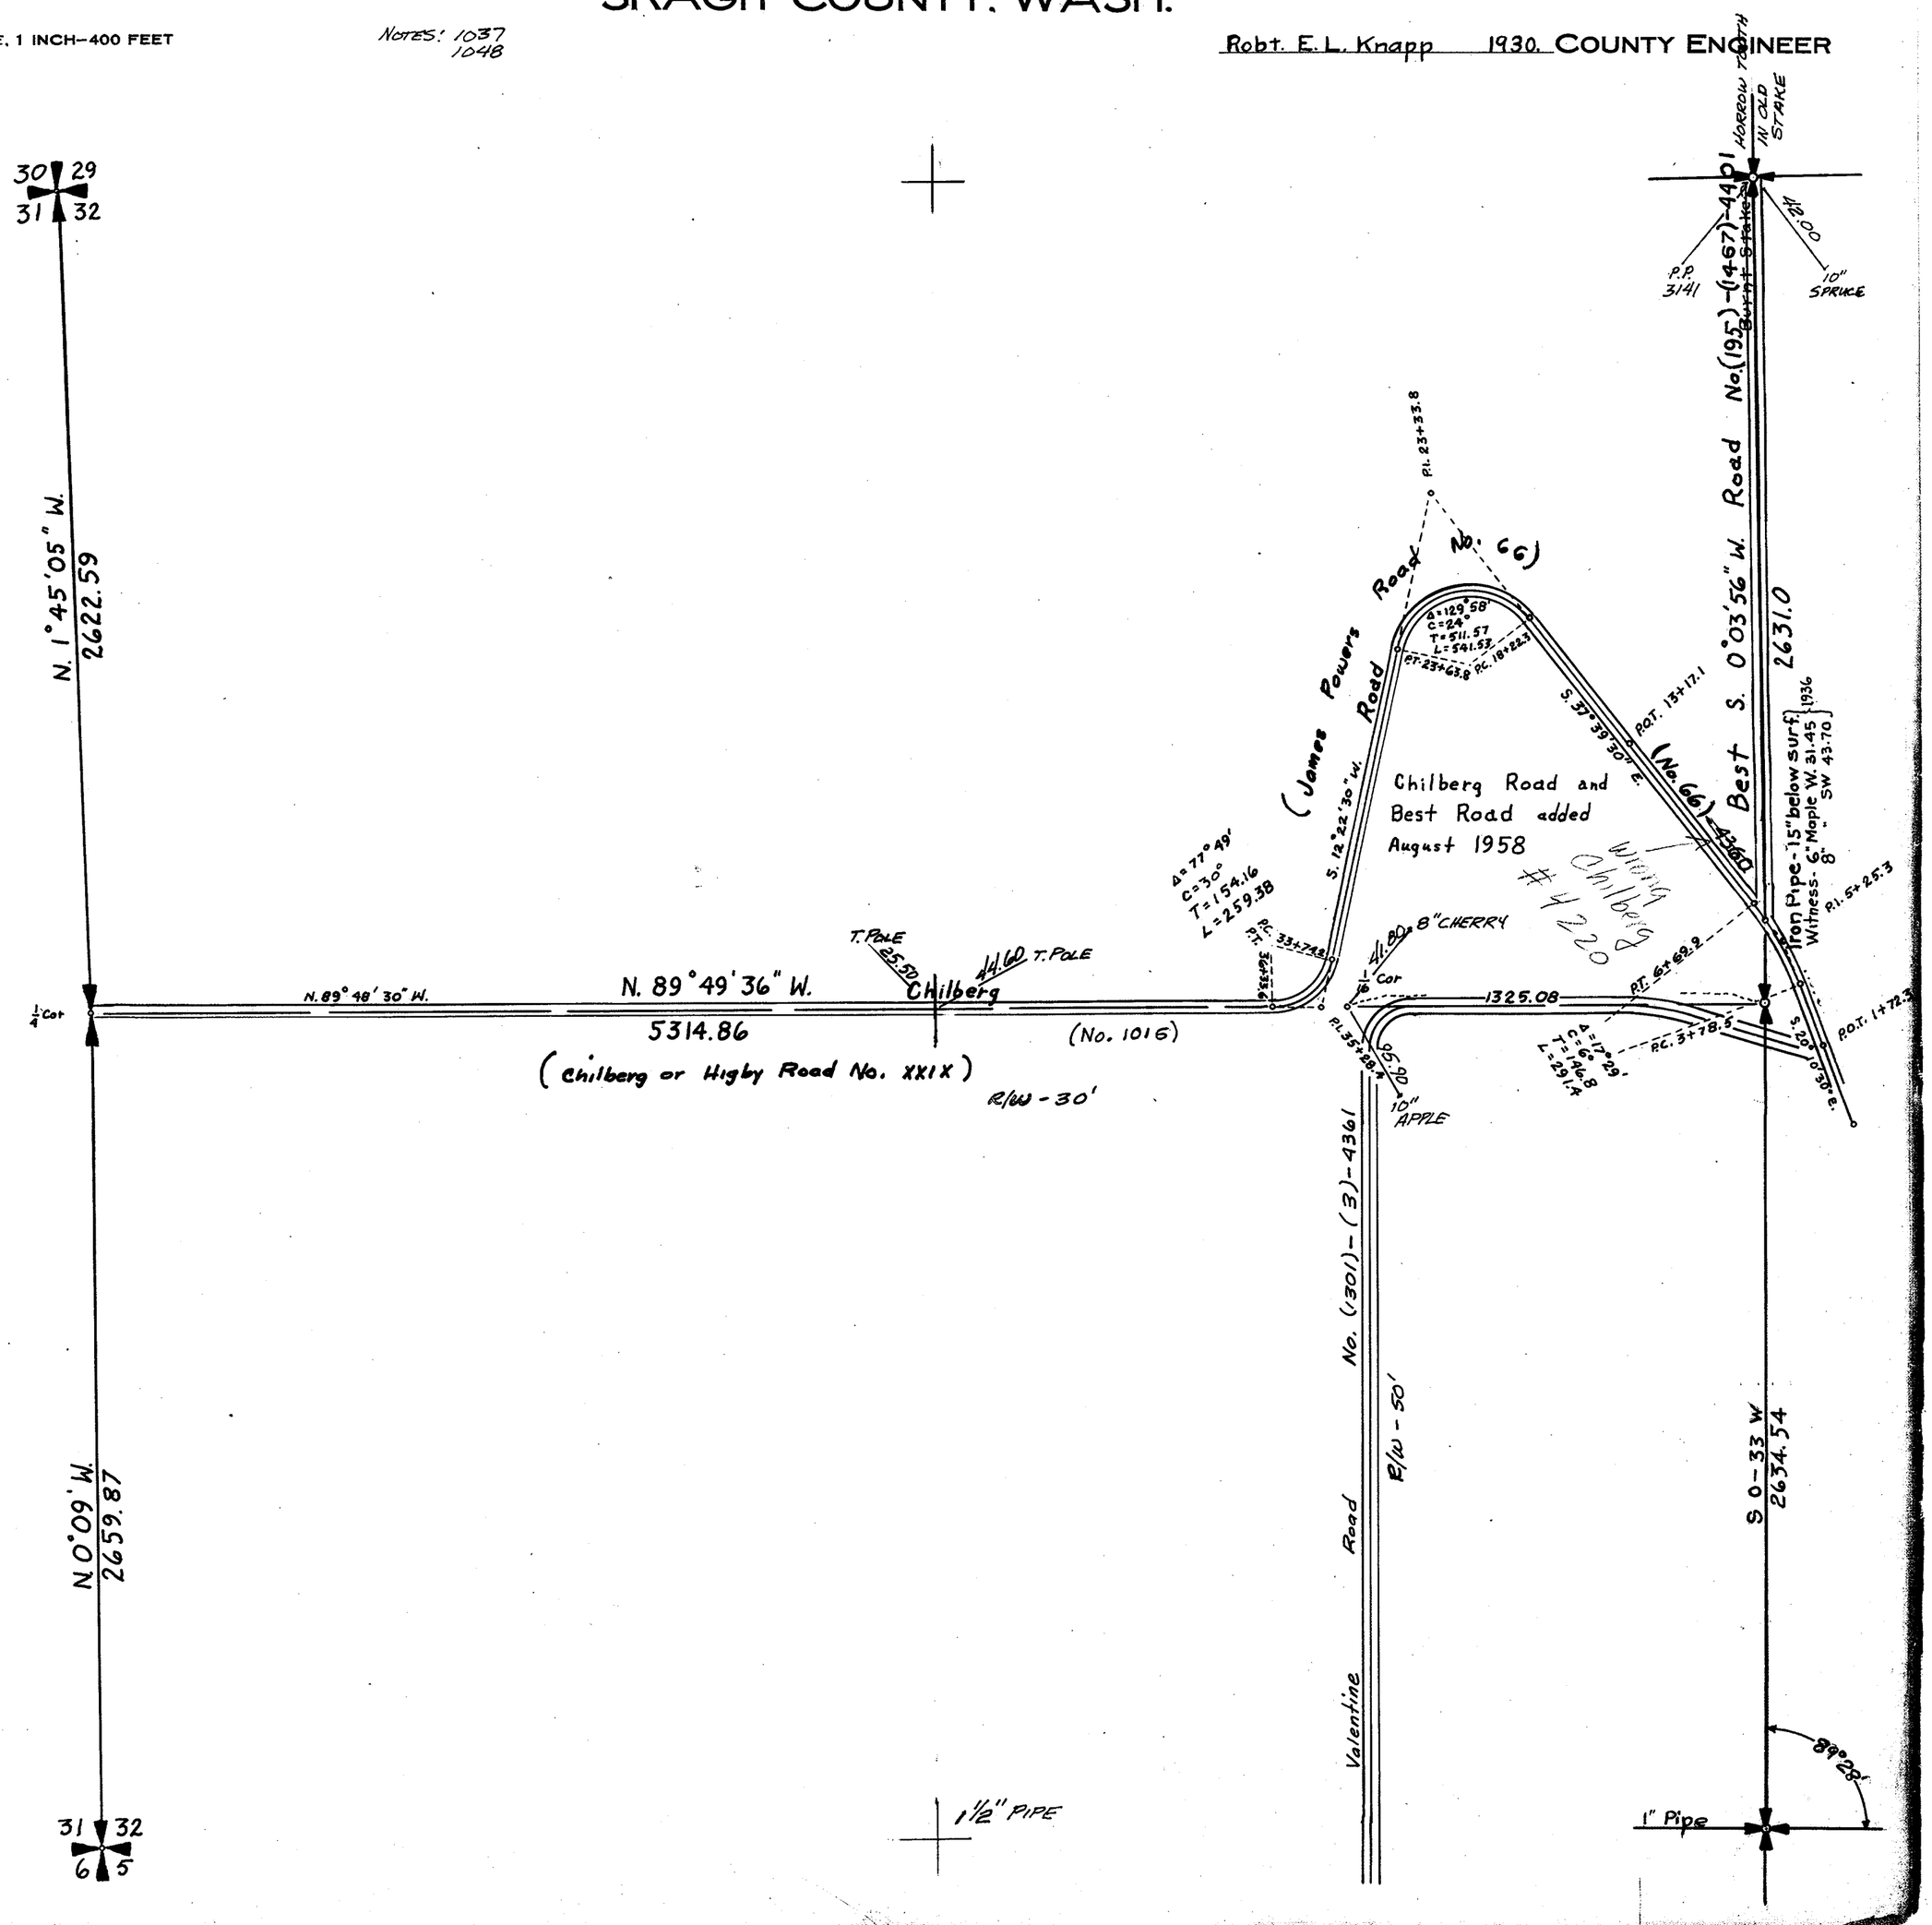

SECTION 33
TOWNSHIP 34 NORTH, RANGE 3 EAST, W. M.
SKAGIT COUNTY, WASH.

SCALE, 1 INCH--400 FEET

G. D. Le Gro
August 1958
COUNTY ENGINEER

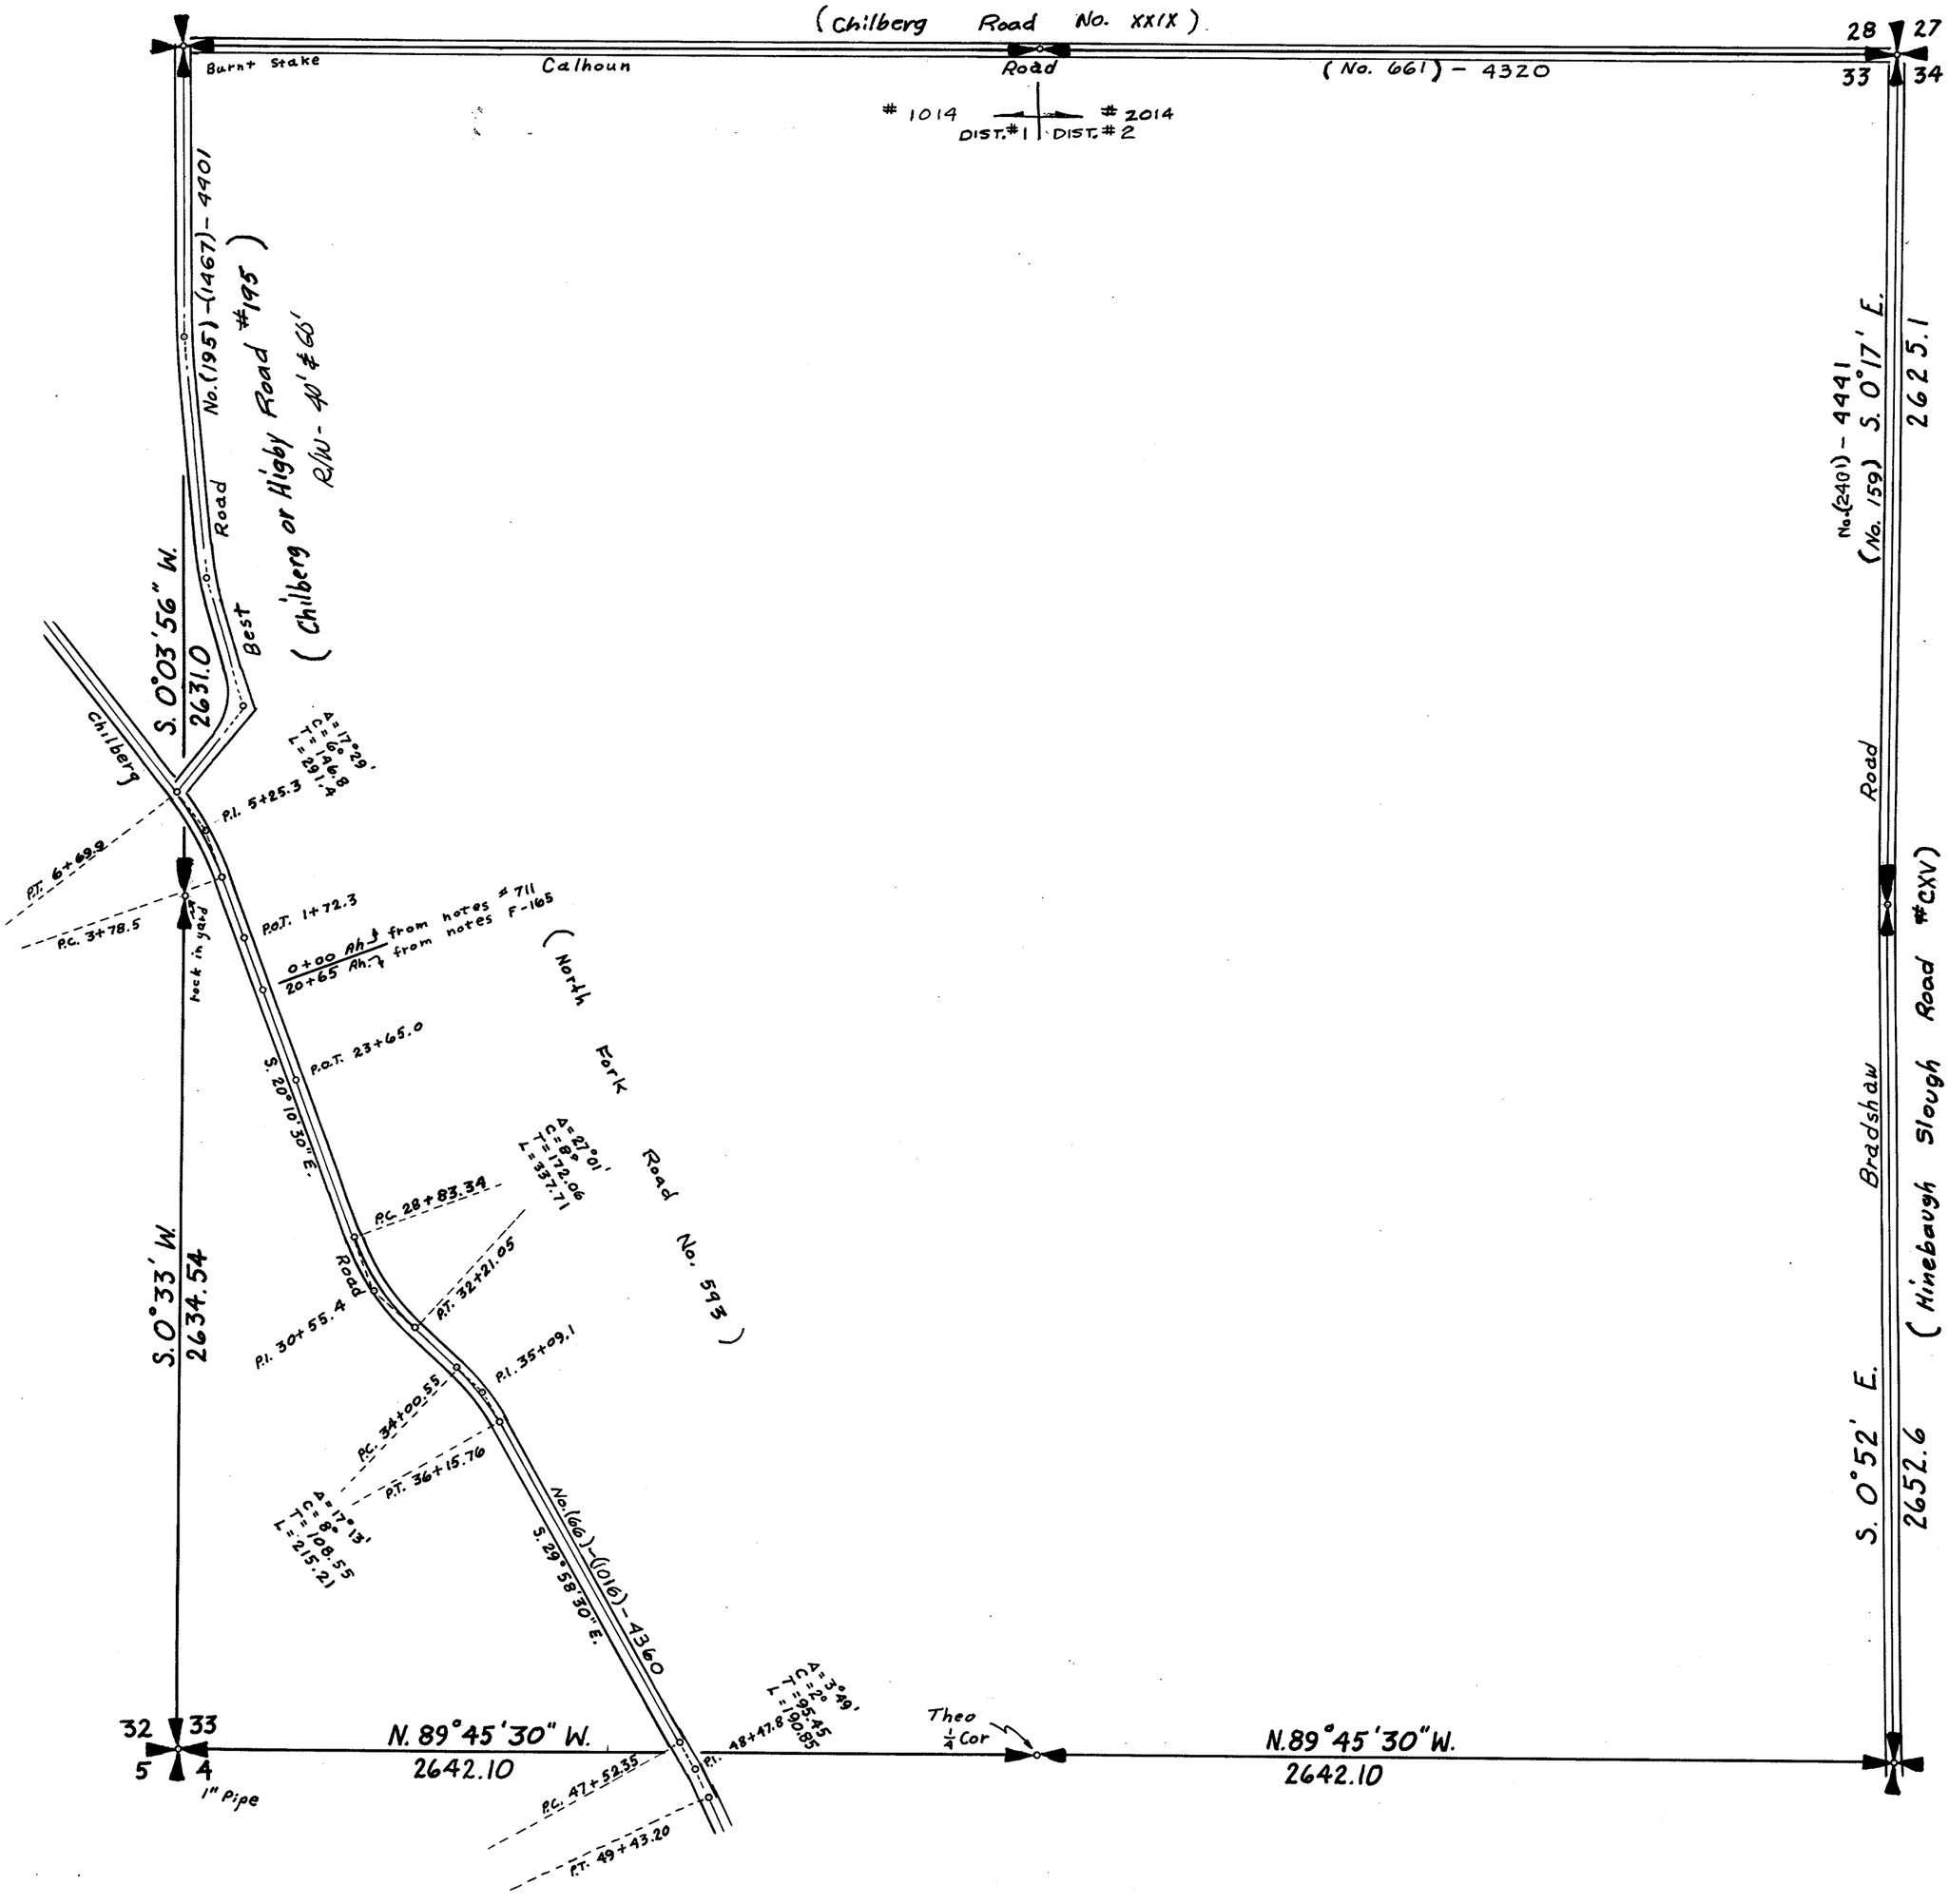


SECTION 34

TOWNSHIP 34 NORTH, RANGE 3 EAST, W. M.

SKAGIT COUNTY, WASH.

SCALE, 1 INCH--400 FEET

G.D. LeGro
August 1958
COUNTY ENGINEER

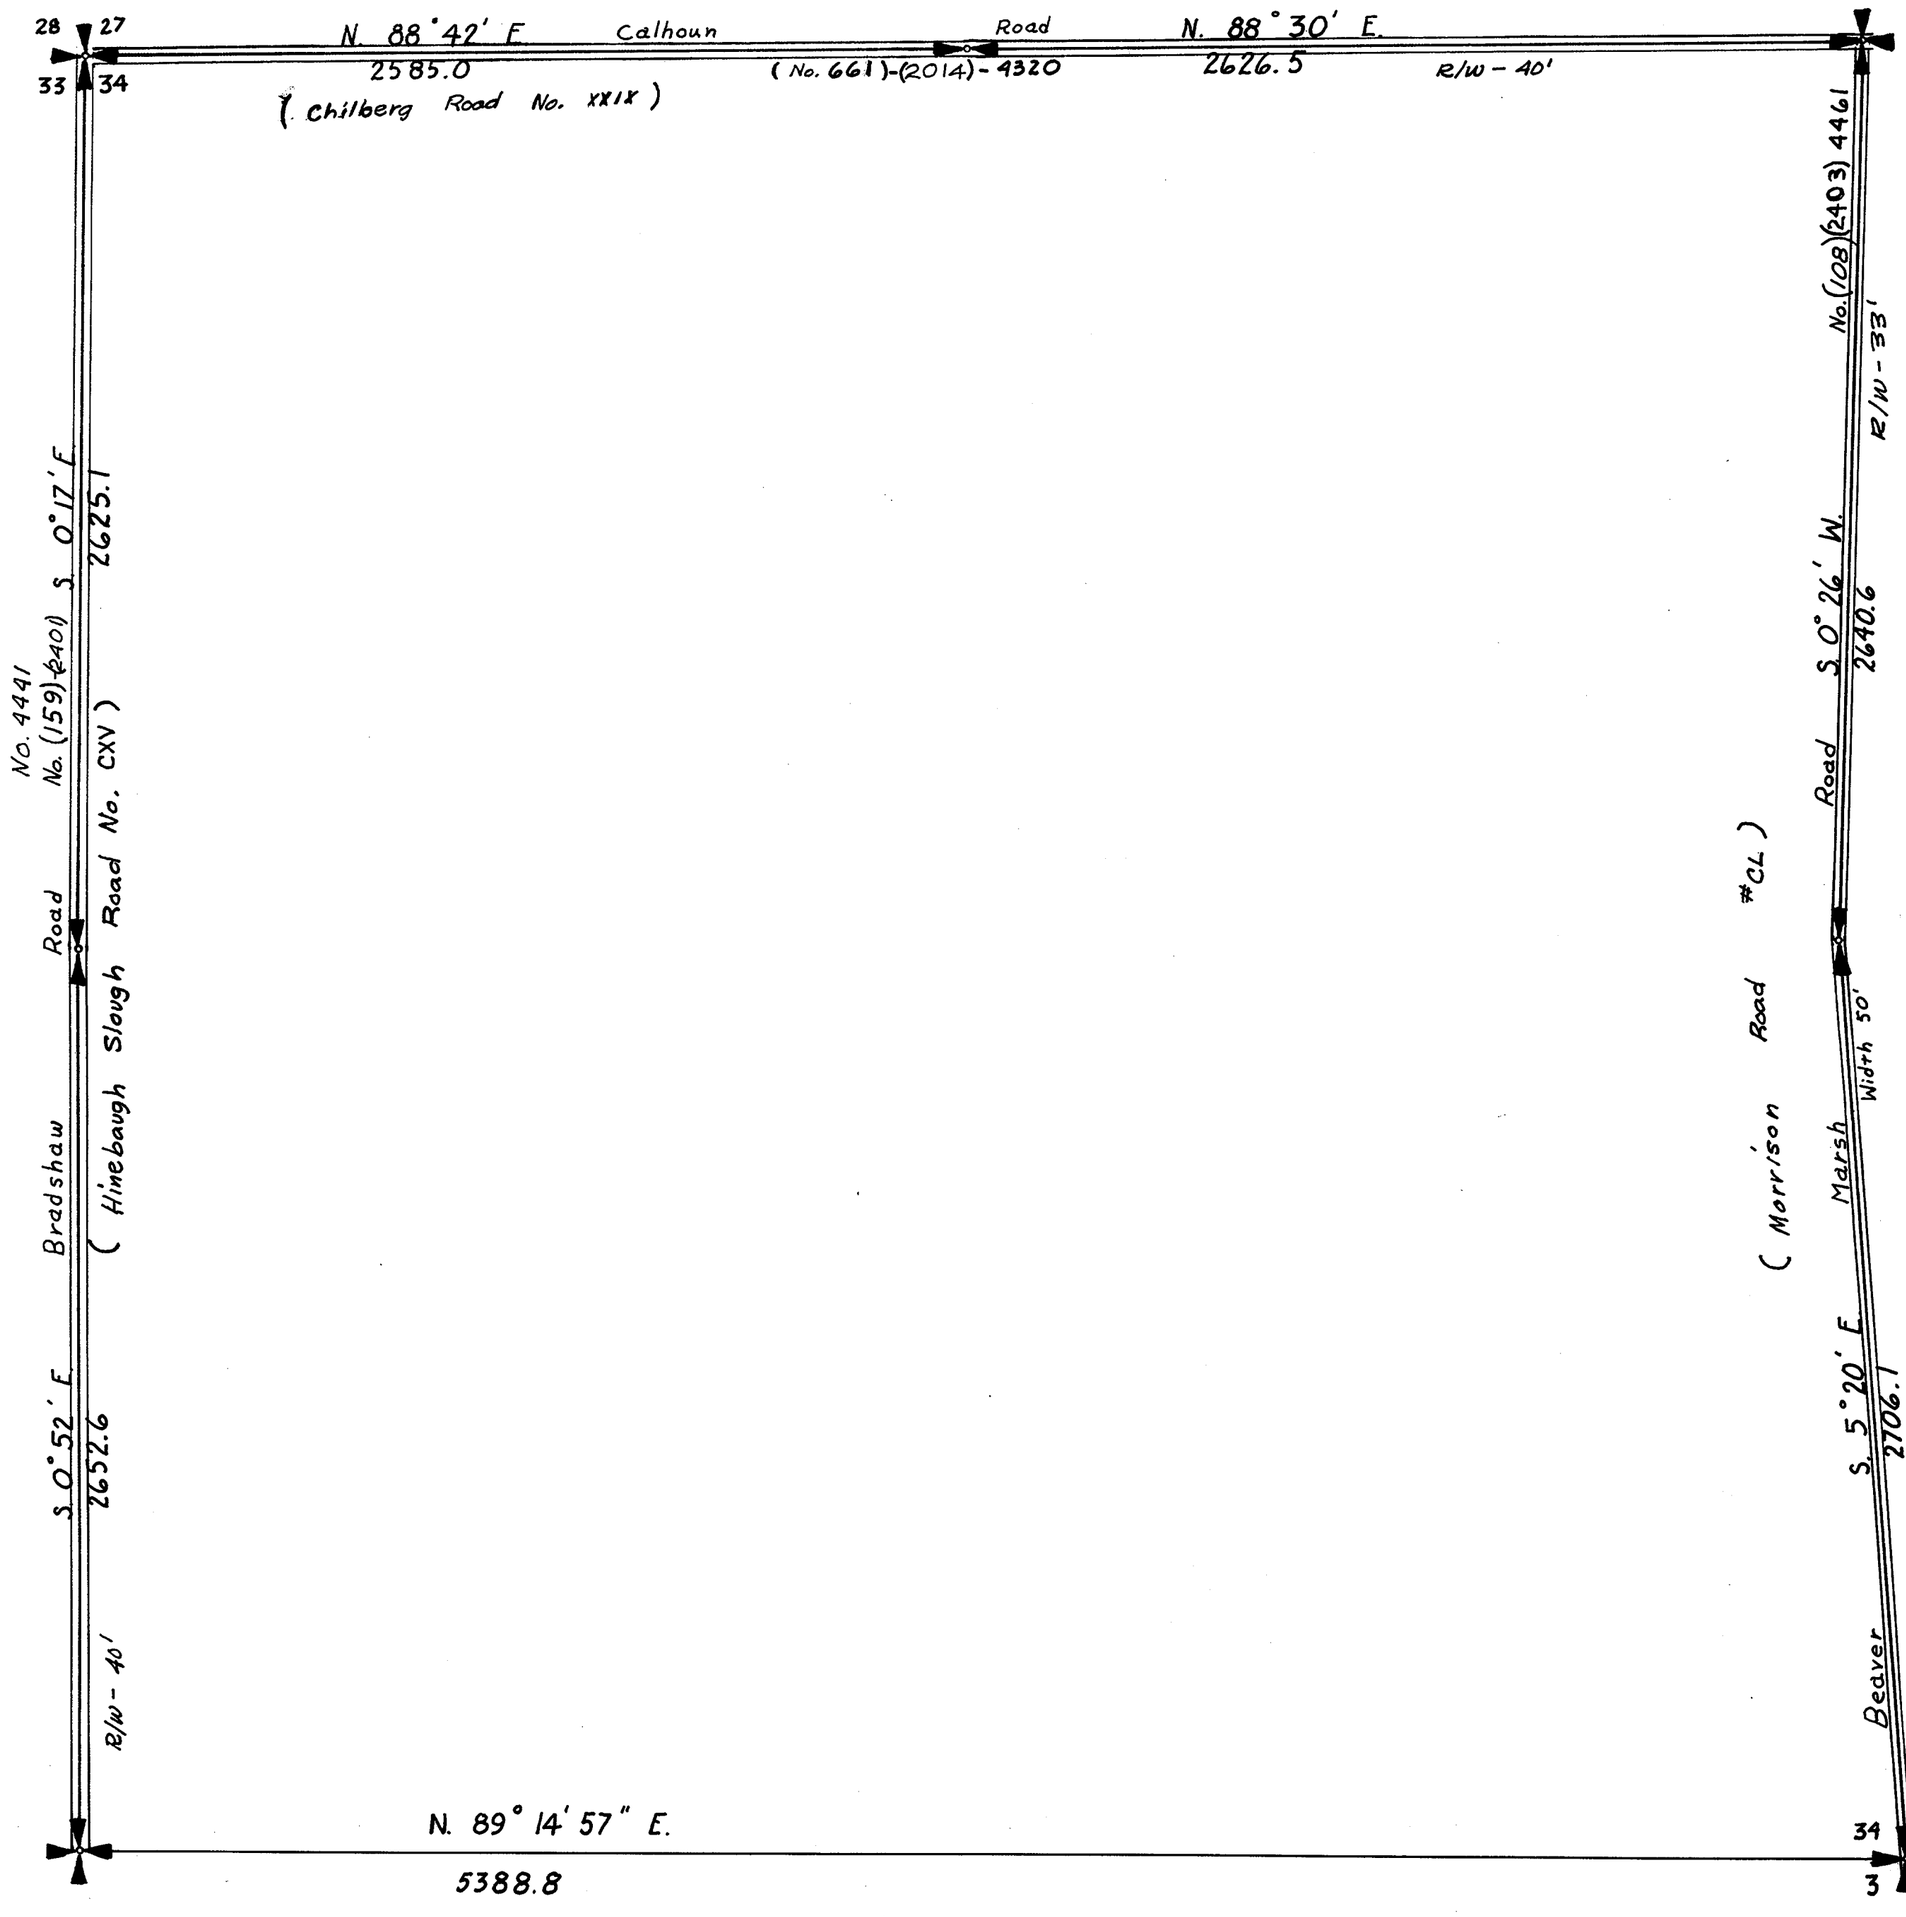


SECTION 35

TOWNSHIP 34 NORTH, RANGE 3 EAST, W. M.

SKAGIT COUNTY, WASH.

SCALE, 1 INCH--400 FEET

G. D. LeGro
August 1958
COUNTY ENGINEER

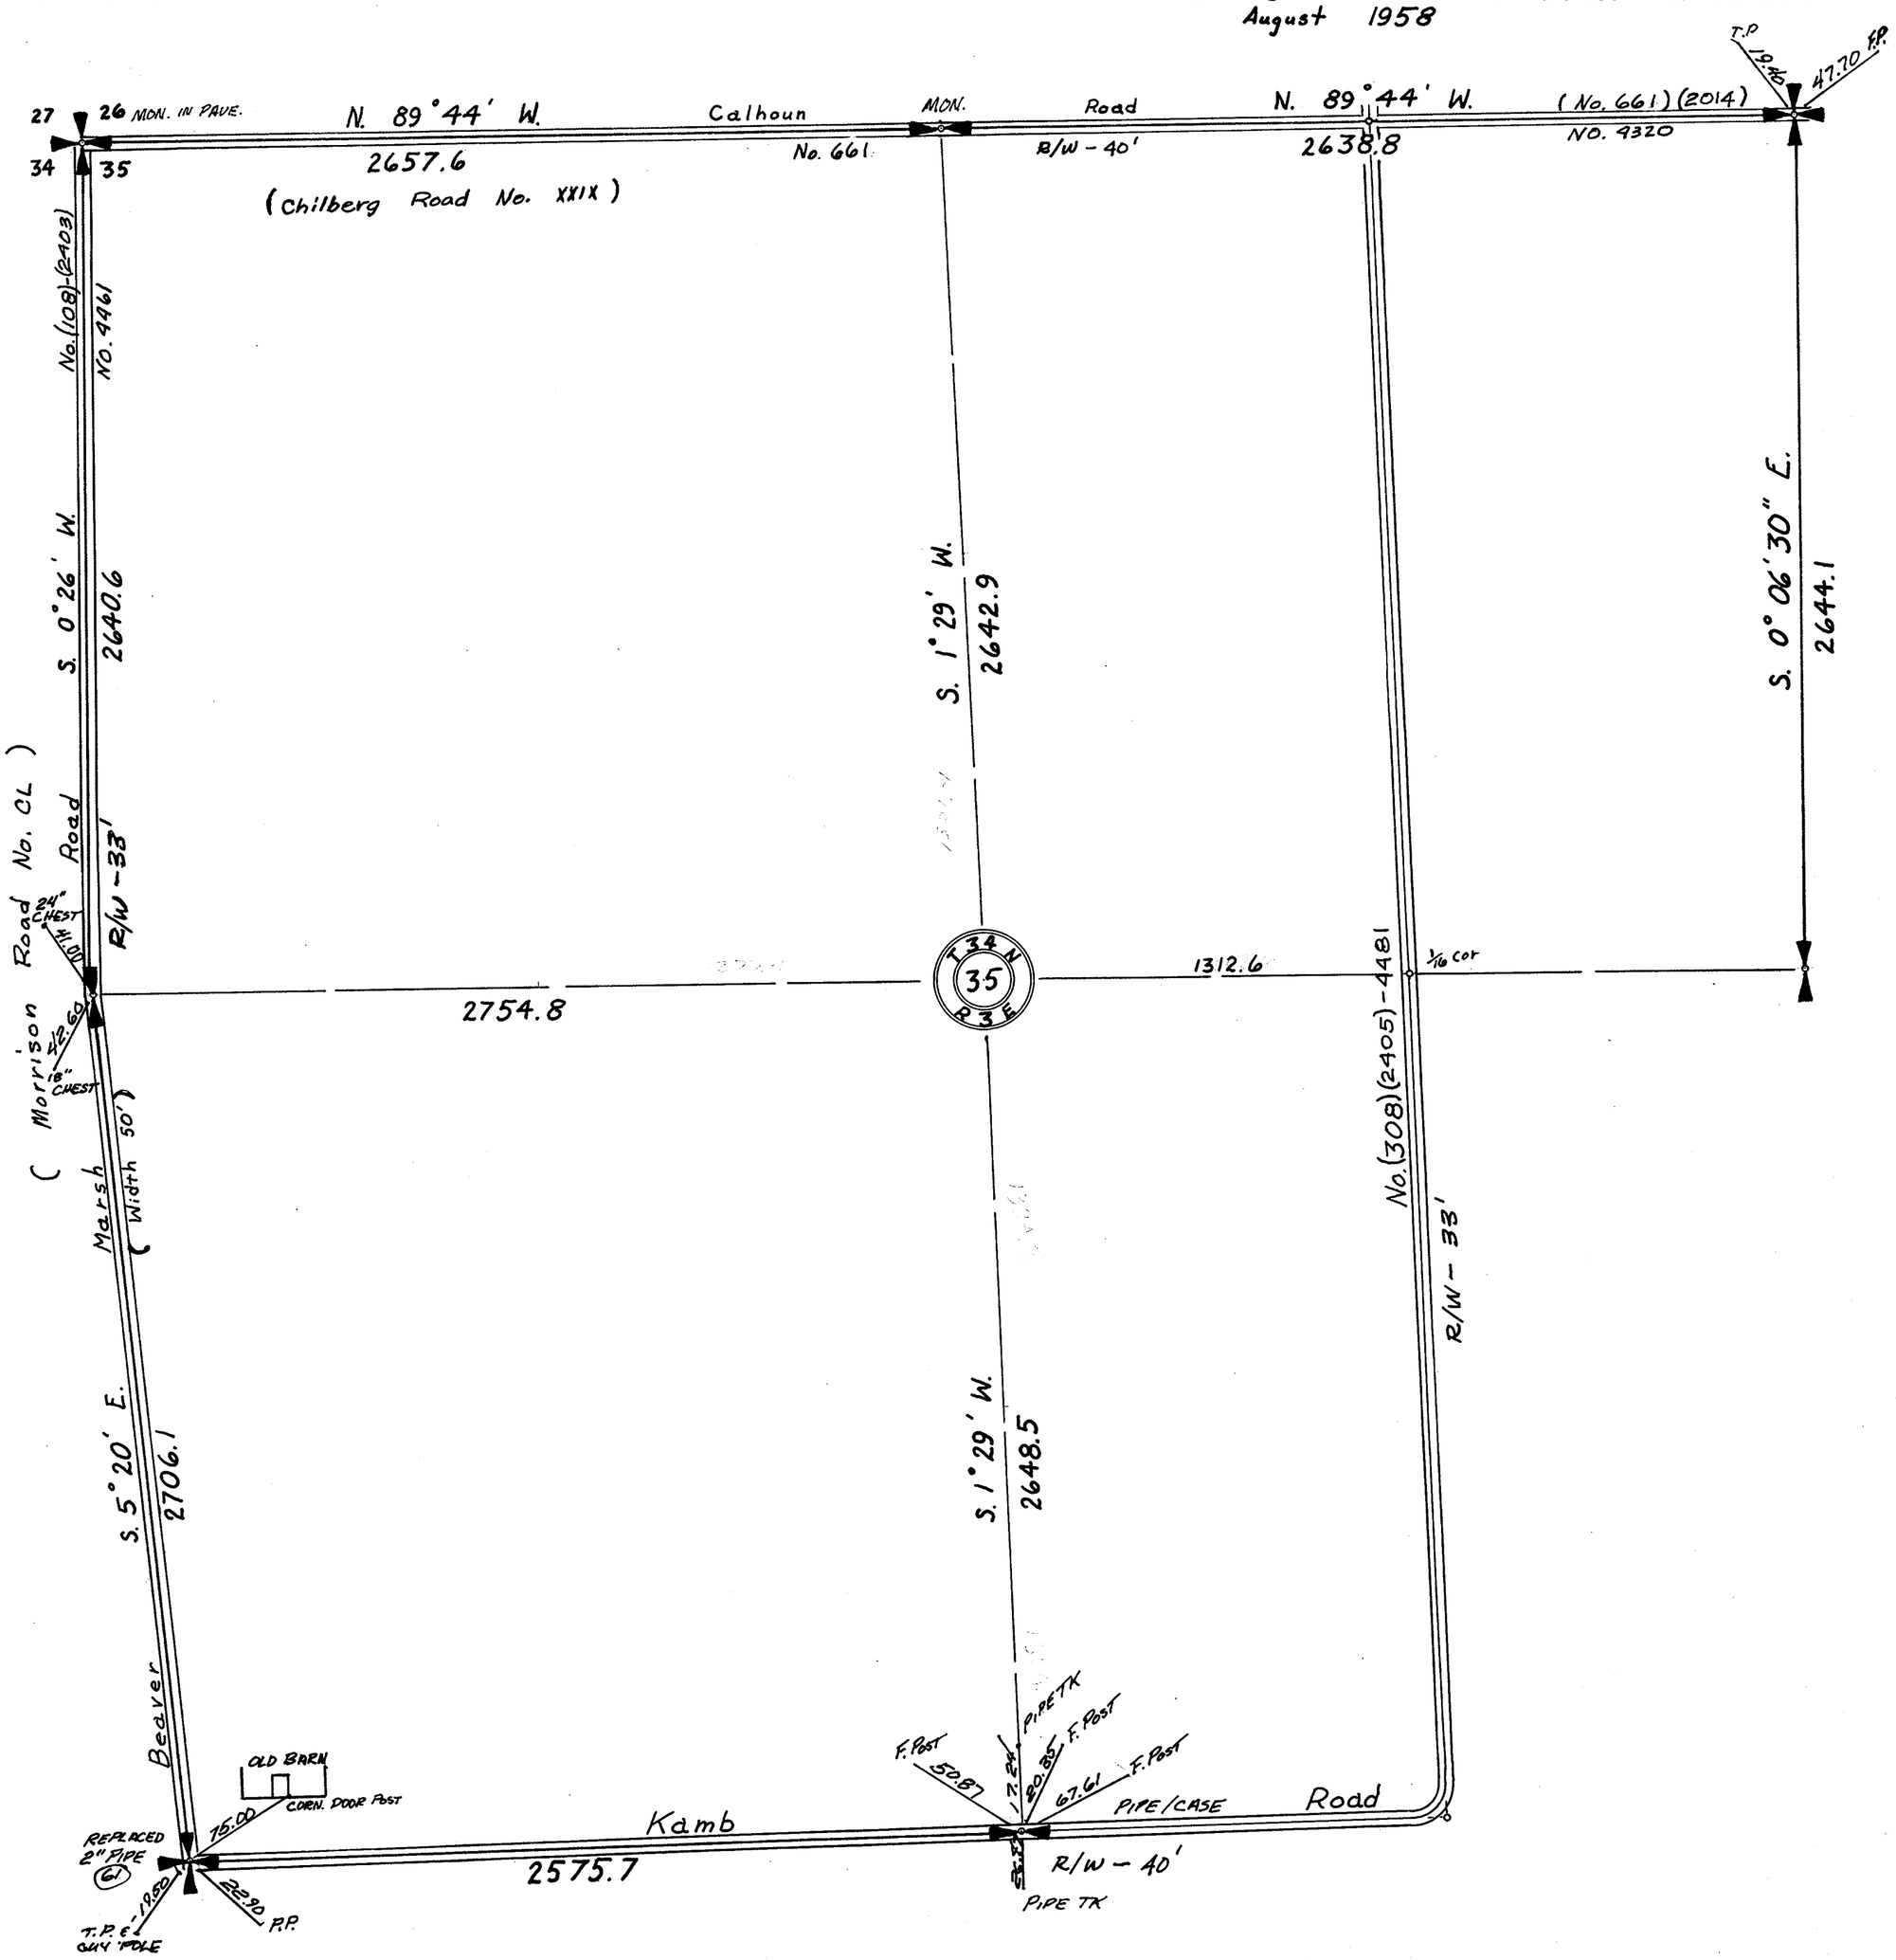

SECTION 36

TOWNSHIP 34 NORTH, RANGE 3 EAST, W. M.

SKAGIT COUNTY, WASH.

DATE July 6, 1966 — Lloyd Johnson — COUNTY ENGINEER

SCALE, 1 INCH--400 FEET

Fin. nail in Y of tree (61) — 61.50

5th Elm 10" tree (61) — 46.20 T.P. — 47.70 F.P. — 19.80 Pipe

N89°32'E 2661.37

Calhoun Road No. (2014)-(661)-4320

(Chilberg or Higby Road No. XXIX)

R/W - 40'

F. Post (61) — 20.70 — Reset 2"x3" Hub 1961 Found 1965

64.40 Pine Tree (61) — 48.80 P. Pole (61)

T. Pole (40)(61)(61) — 14.80 — 1¼" Pipe in Stone/Mon. Case 6" below Surf.

21.60 P. Pole (40)(61)(61) — 22.50 Guy Pole (40)(61)(61)

(A.J. Hannesdal Road No. 139)

No. (2409)-(139)-8005

RIVER

Note: This Tracing Drawn From Other Tracing and Aerial Photo - Not to Scale. Sub-division Information on other Tracing ---

Notes: 490, 713, 1027

Hardshell A- 18/16

T-34-N 36 R-3-E

P. POLE 51.97 — T. POLE 71.70 — MON. — 31.80 P. POLE

P. Pole (40)(61) — 52.00 — 31.80 P. Pole (61) — 82.20 Found 1½" Pipe '61 Brass Tack Found 1965 - 18" Below surface Set ¾" bolt to Bring to Surface

71.7 — 34.50 P. Pole (40)(61) — 57.00 T. Pole (40)(61)

SKAGIT

R/W - 33'

(Skagit River Road No. 1X)

Road

Dike

P. POLE — 24" COTTON — 44.70 — 14.00 — 22.50 G. POLE

R/W - 30'

(Dodson Road No. 100)

Dry Slough Road No. (2303)-(100)-4501


37.00 14" COTTON — 21.60 MON

SECTION 36
TOWNSHIP 34 NORTH, RANGE 3 EAST, W.M.
SKAGIT COUNTY, WASH.

SCALE 1 INCH = 400 FEET

DATE March 30 1962

_____ COUNTY ENGINEER

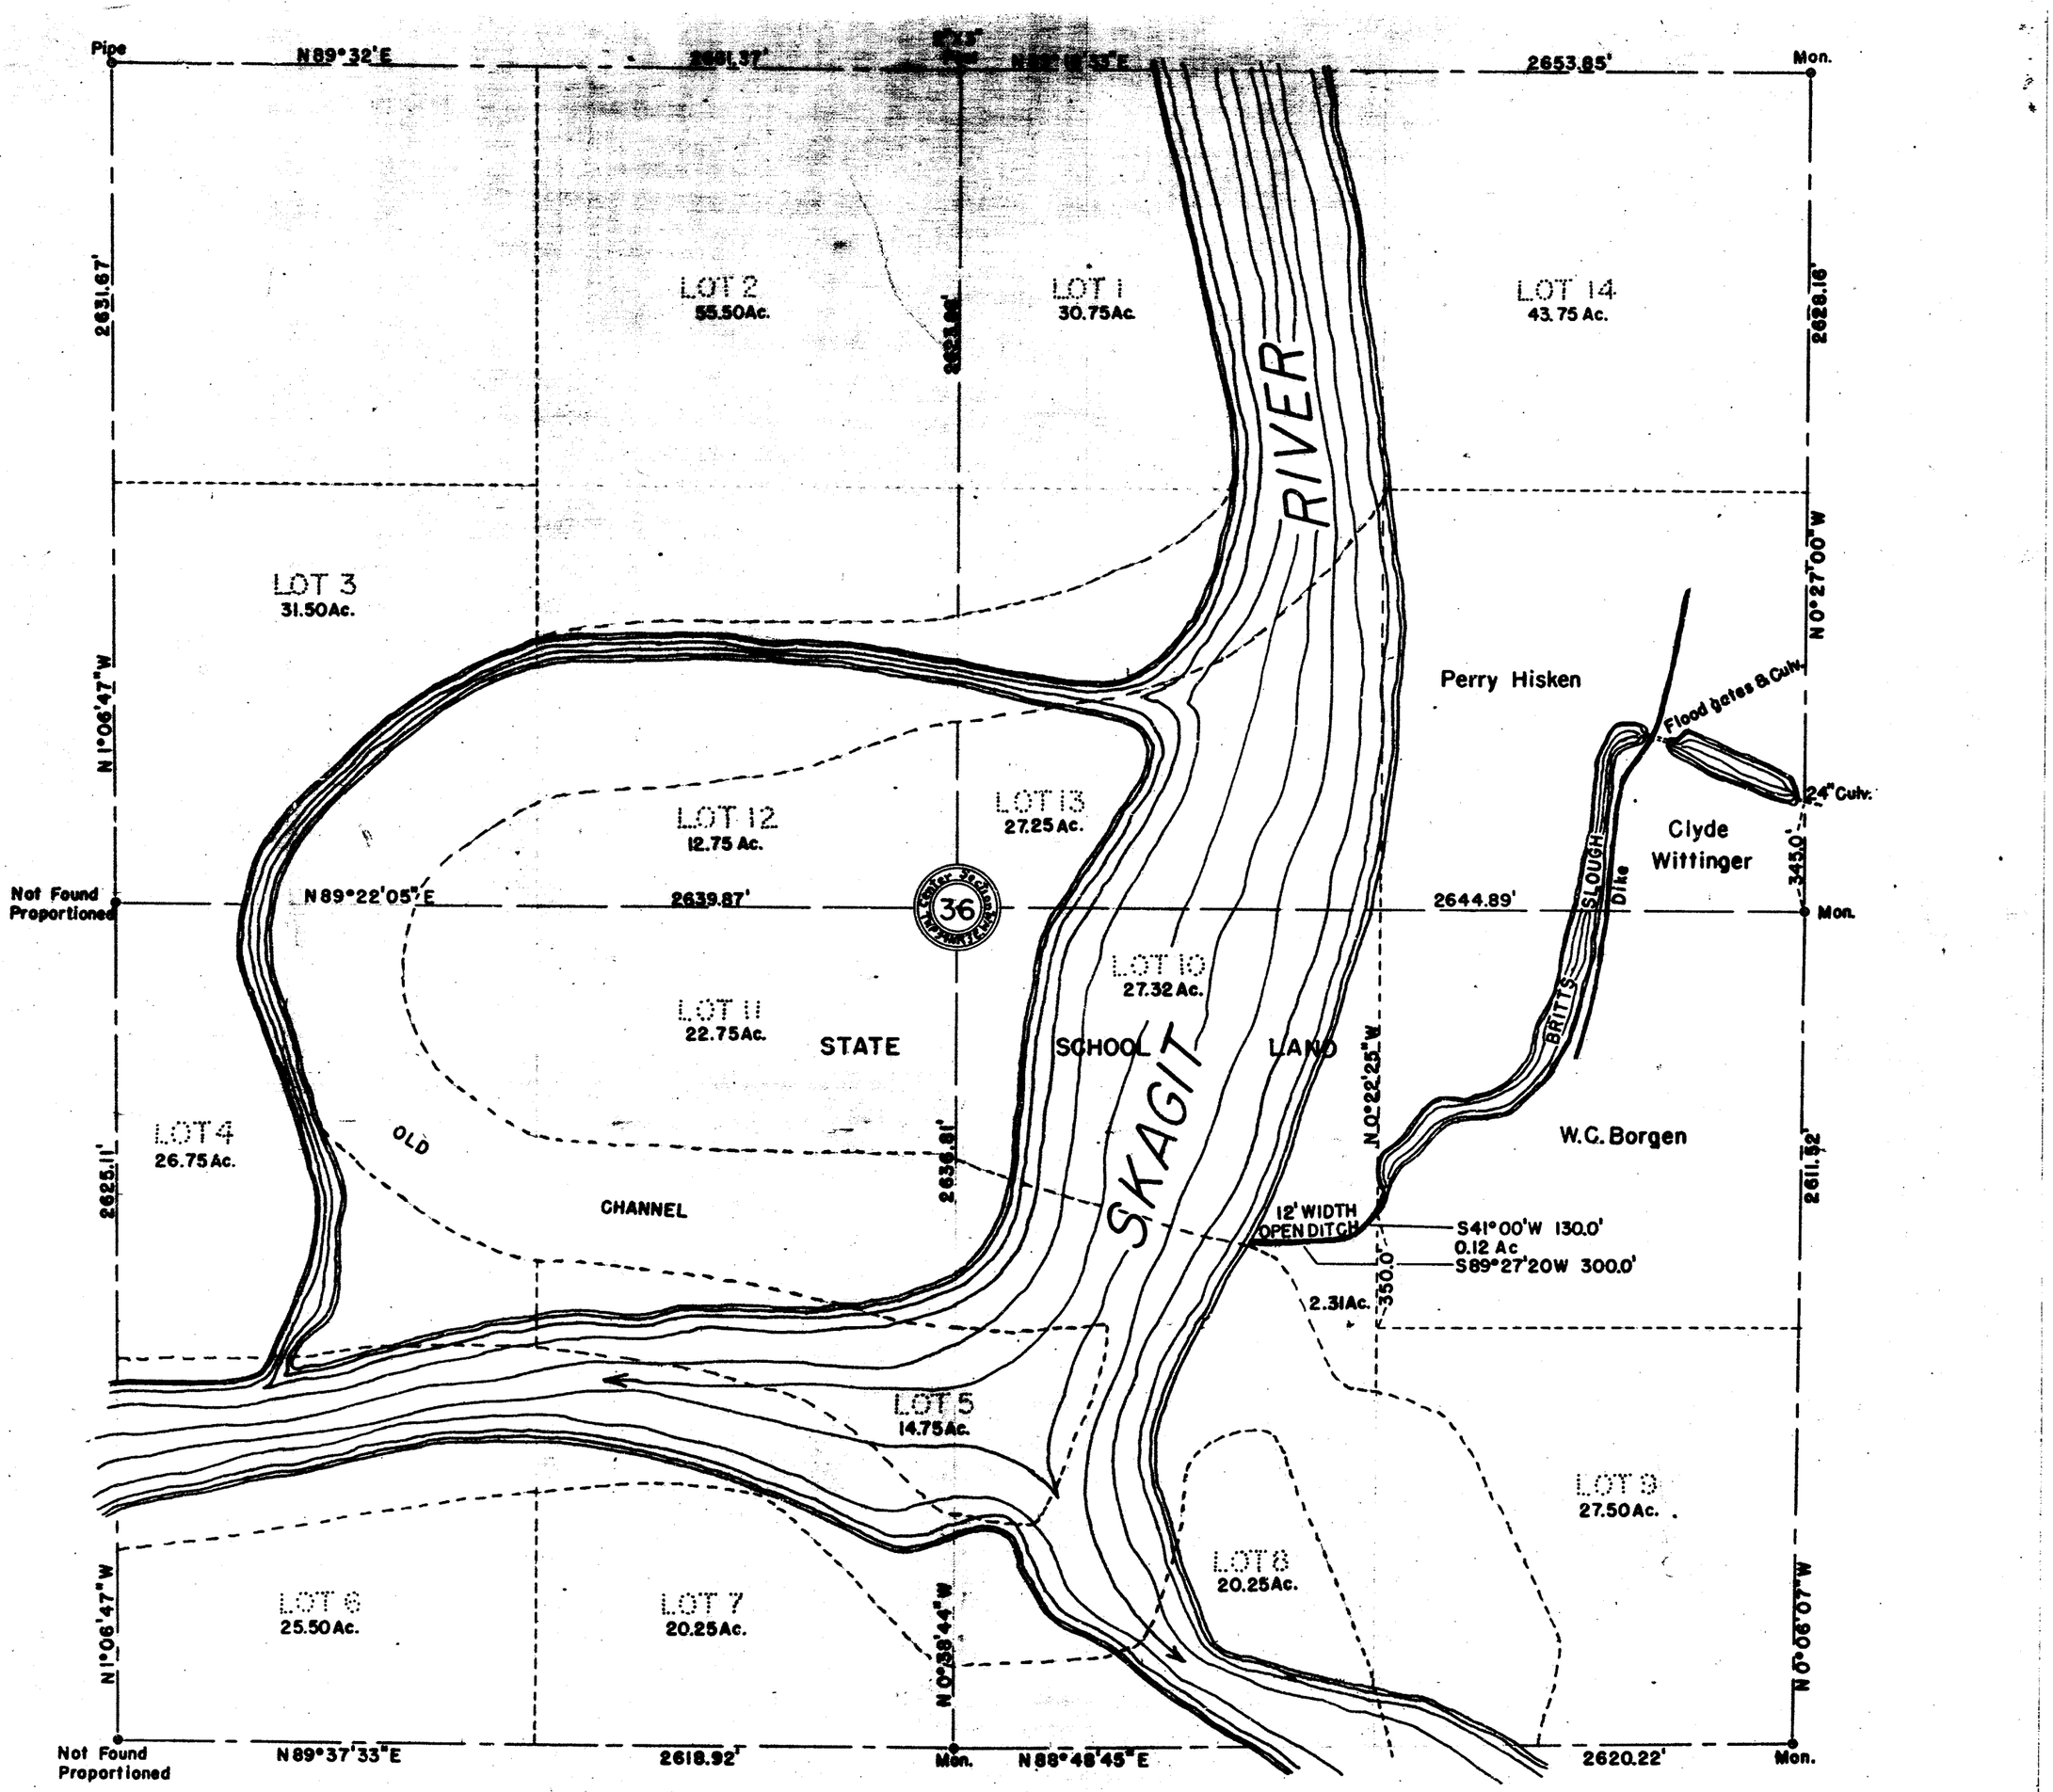

Original Tracing in with the I Geo. Washington File E Drawer (Steel Flat File)

E 24 4/3

E-23 2/3


SECTION 1

TOWNSHIP 34 NORTH, RANGE 4 EAST, W. M.

SKAGIT COUNTY, WASH.

SCALE, 1 INCH--400 FEET

DATE July 7, 1966 Lloyd Johnson COUNTY ENGINEER

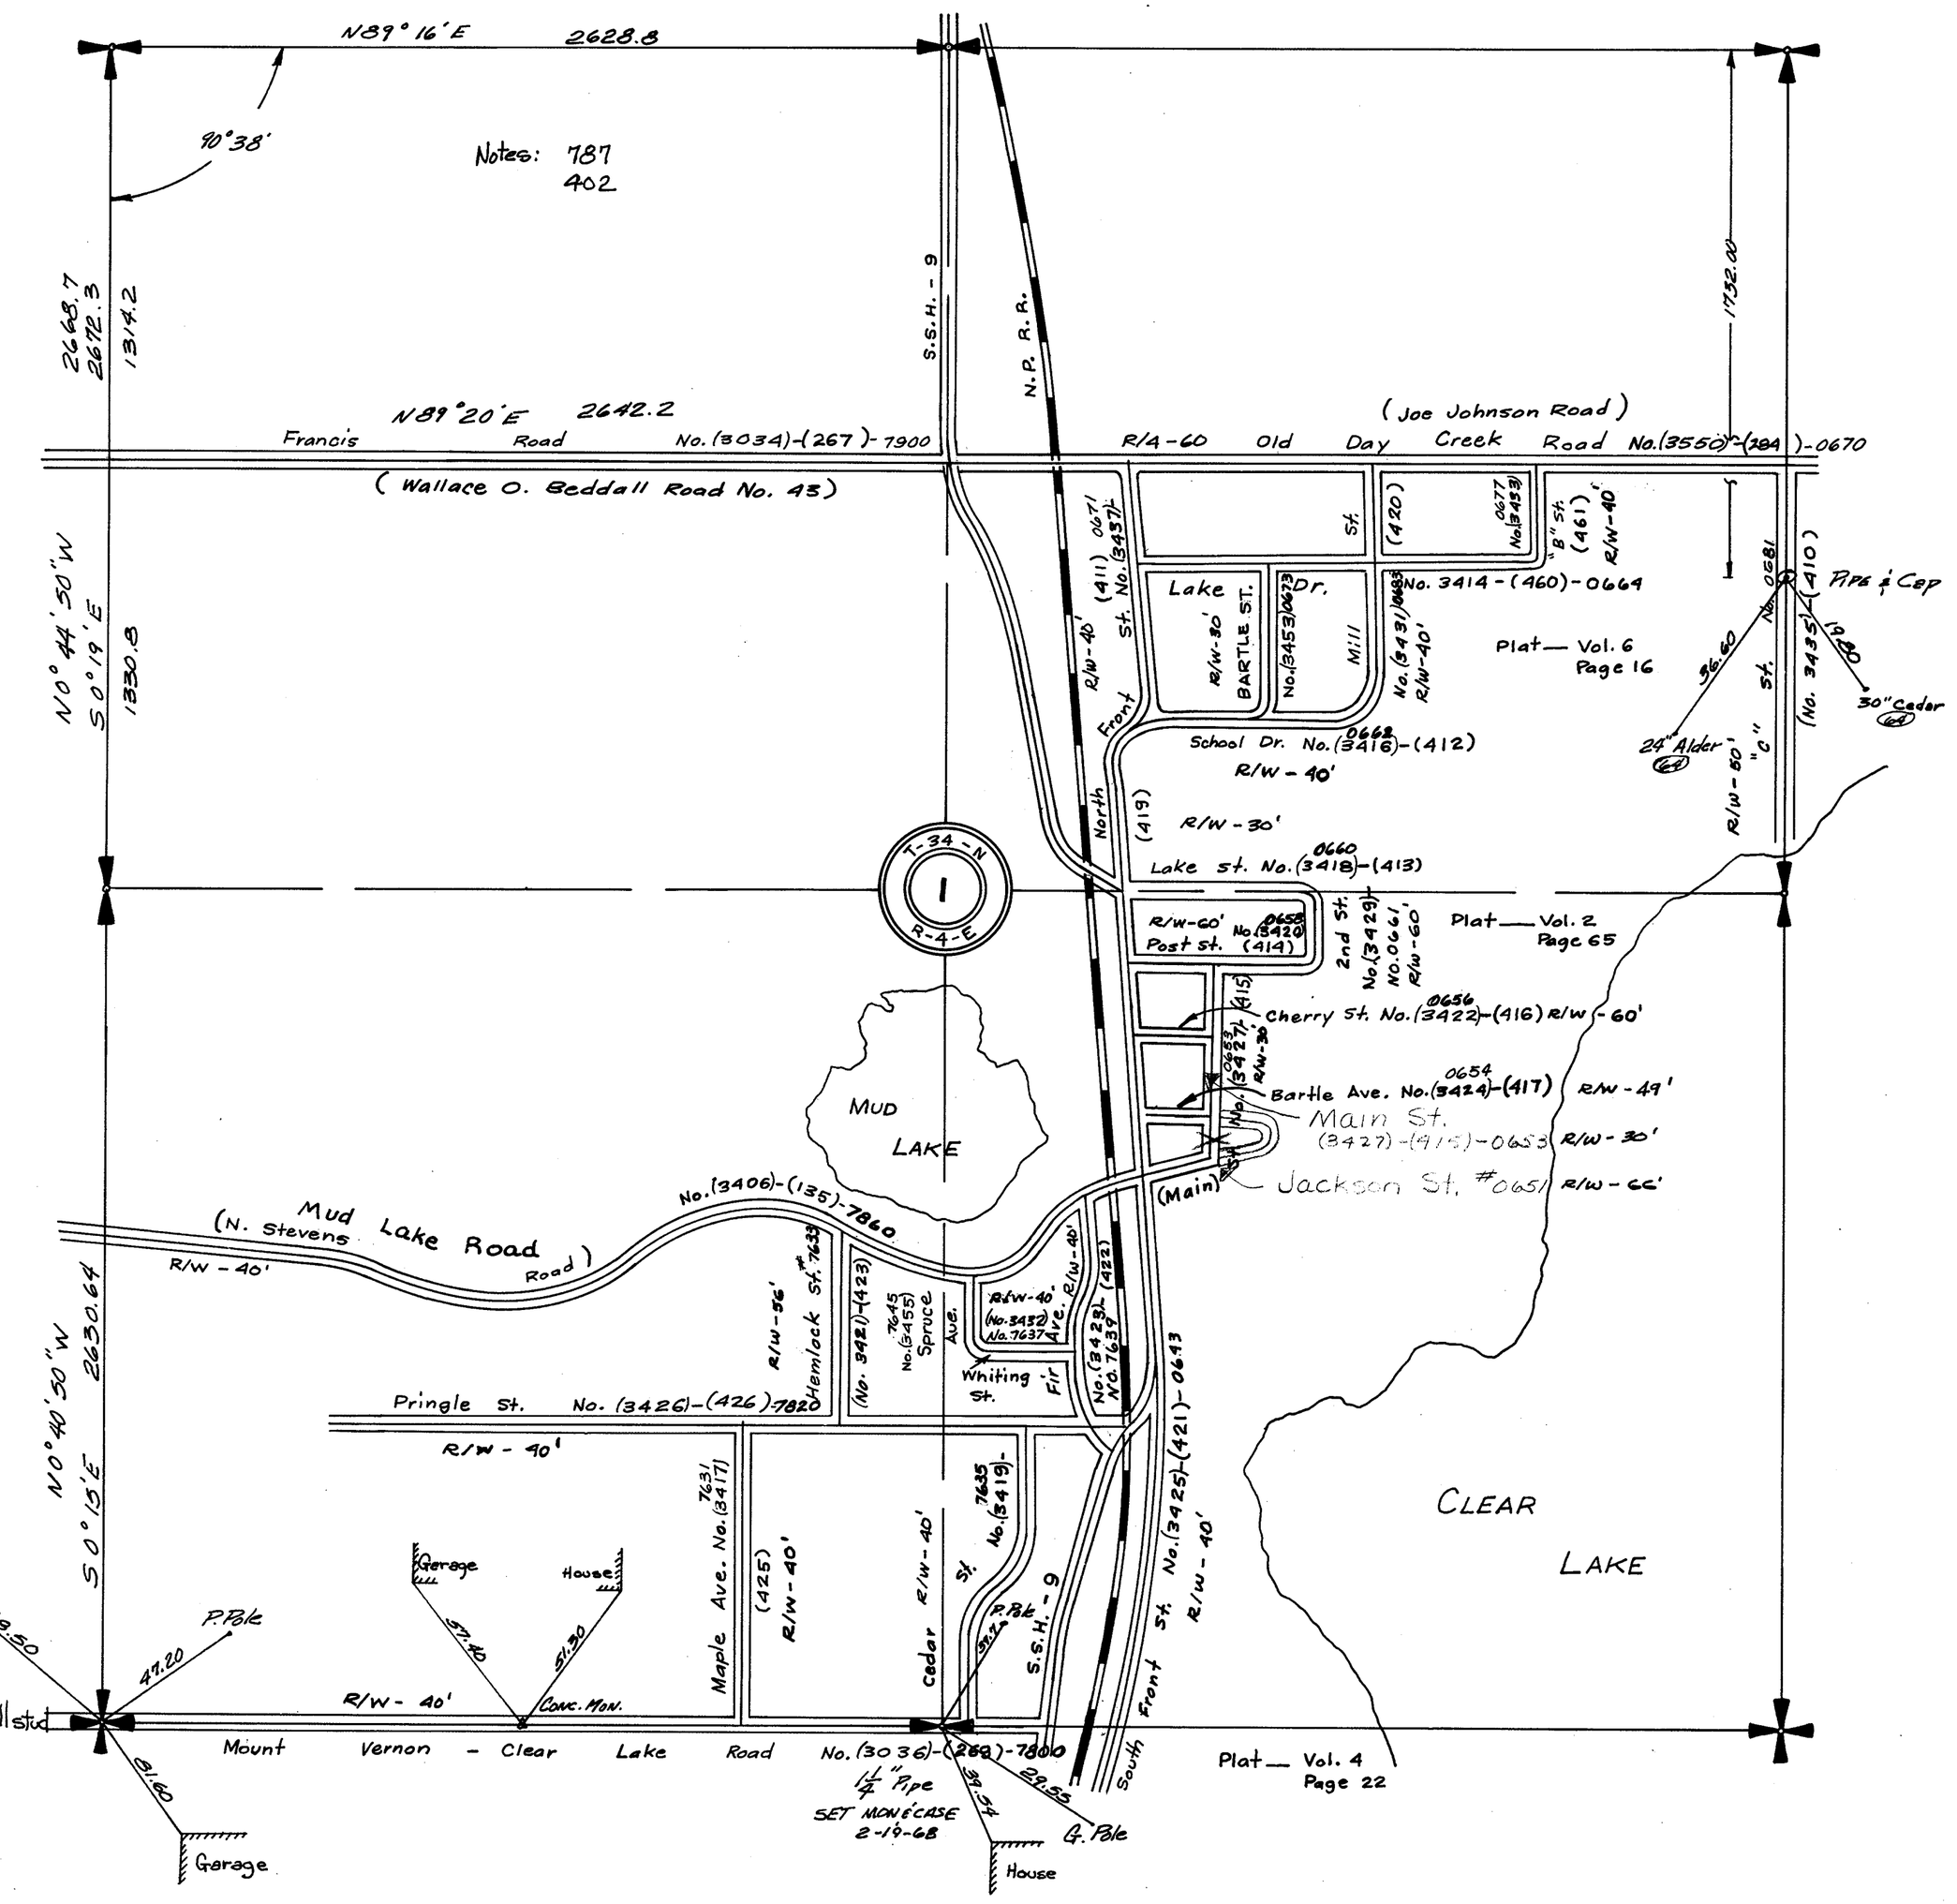


SECTION 1

TOWNSHIP 34 NORTH, RANGE 4 EAST, W. M.
SKAGIT COUNTY, WASH.

SCALE, 1 INCH—400 FEET

A.L. STRONG COUNTY ENGINEER

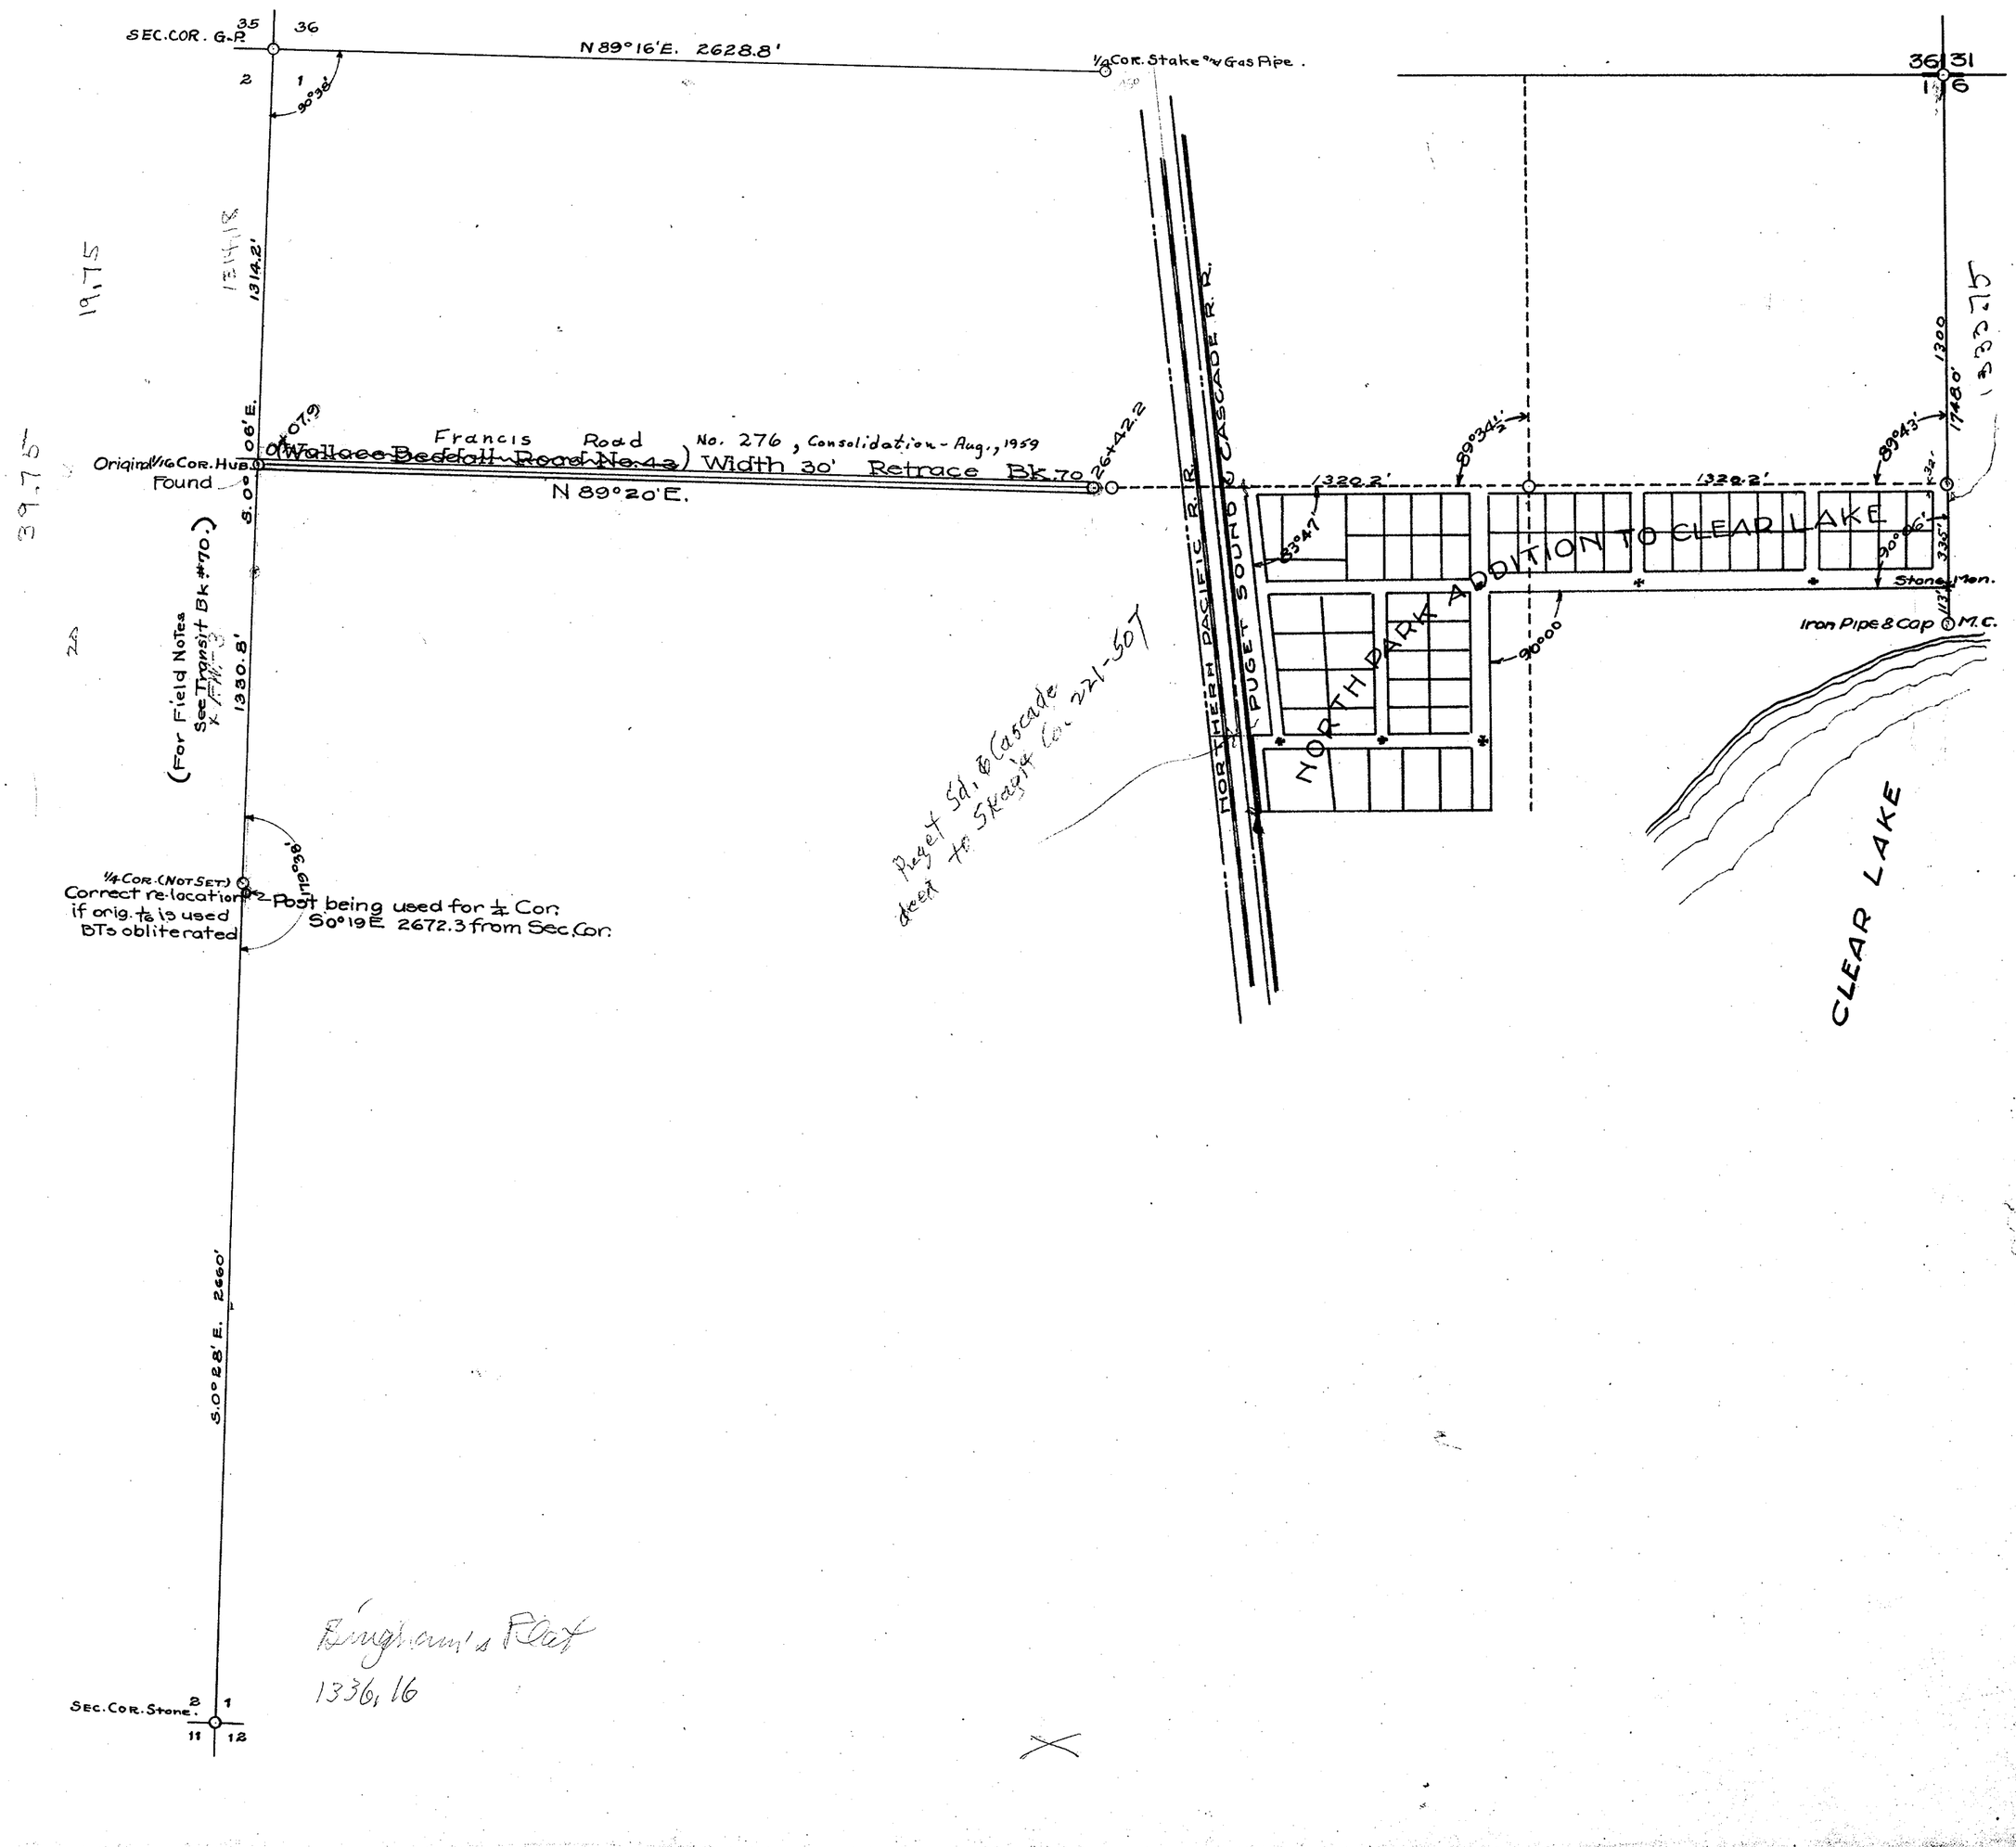


SECTION 1

TOWNSHIP 34 NORTH, RANGE 4 EAST, W. M.
SKAGIT COUNTY, WASH.

SCALE, 1 INCH--400 FEET

1940 W.A. COSTELLO COUNTY ENGINEER

Clear Lake-Day Cr. Rd. Notes: 38/402

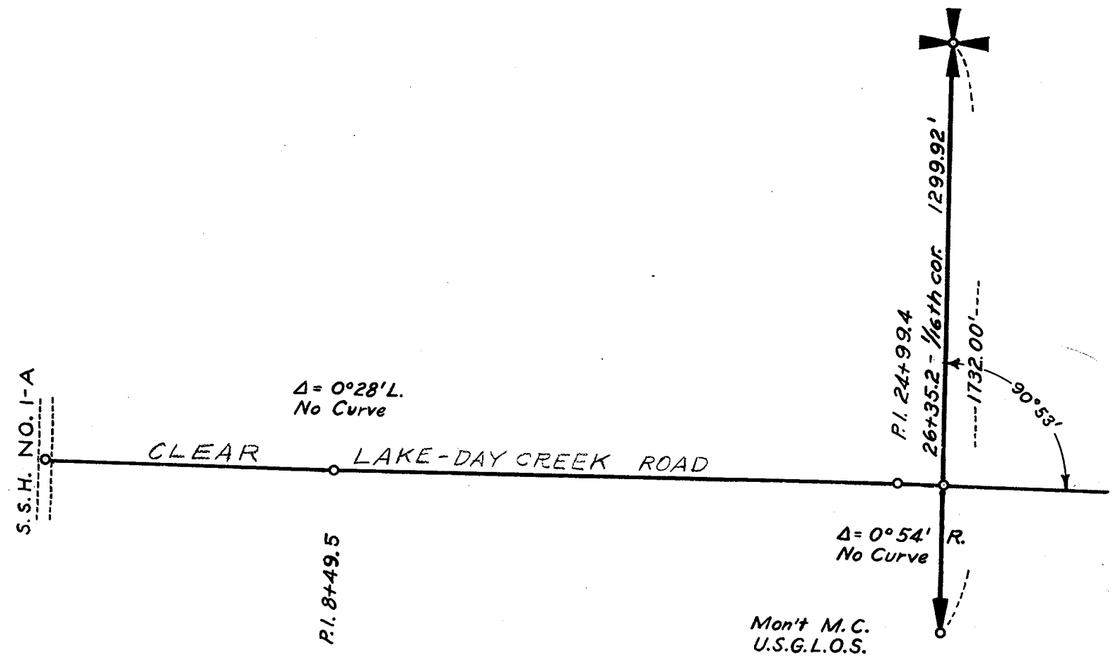


SECTION 1
TOWNSHIP 34 NORTH, RANGE 4 EAST, W.M.
SKAGIT COUNTY, WASH.

SCALE 1 INCH = 400 FEET

DATE MAY 1, 1972

LLOYD H. JOHNSON **COUNTY ENGINEER**

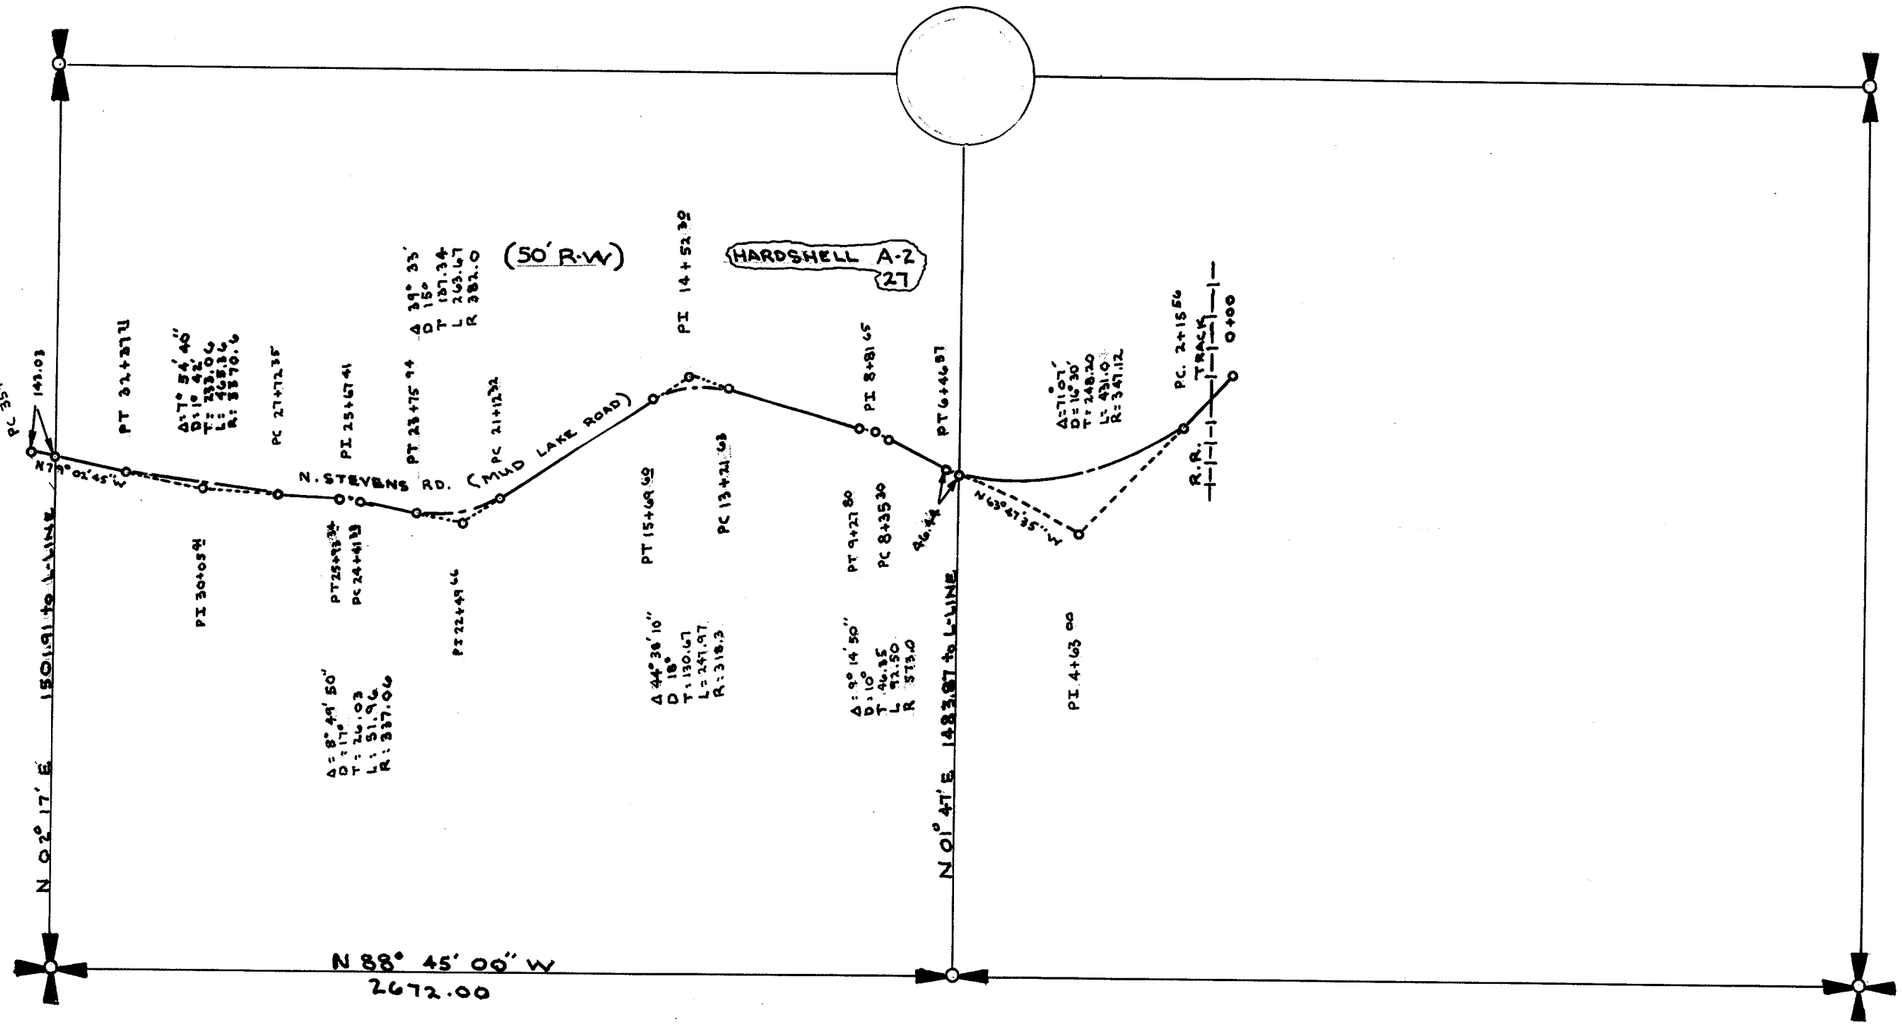


SECTION 2

TOWNSHIP 34 NORTH, RANGE 4 EAST, W. M.

SKAGIT COUNTY, WASH.

SCALE, 1 INCH--400 FEET

DATE August, 1959 Frank Gilkey COUNTY ENGINEER

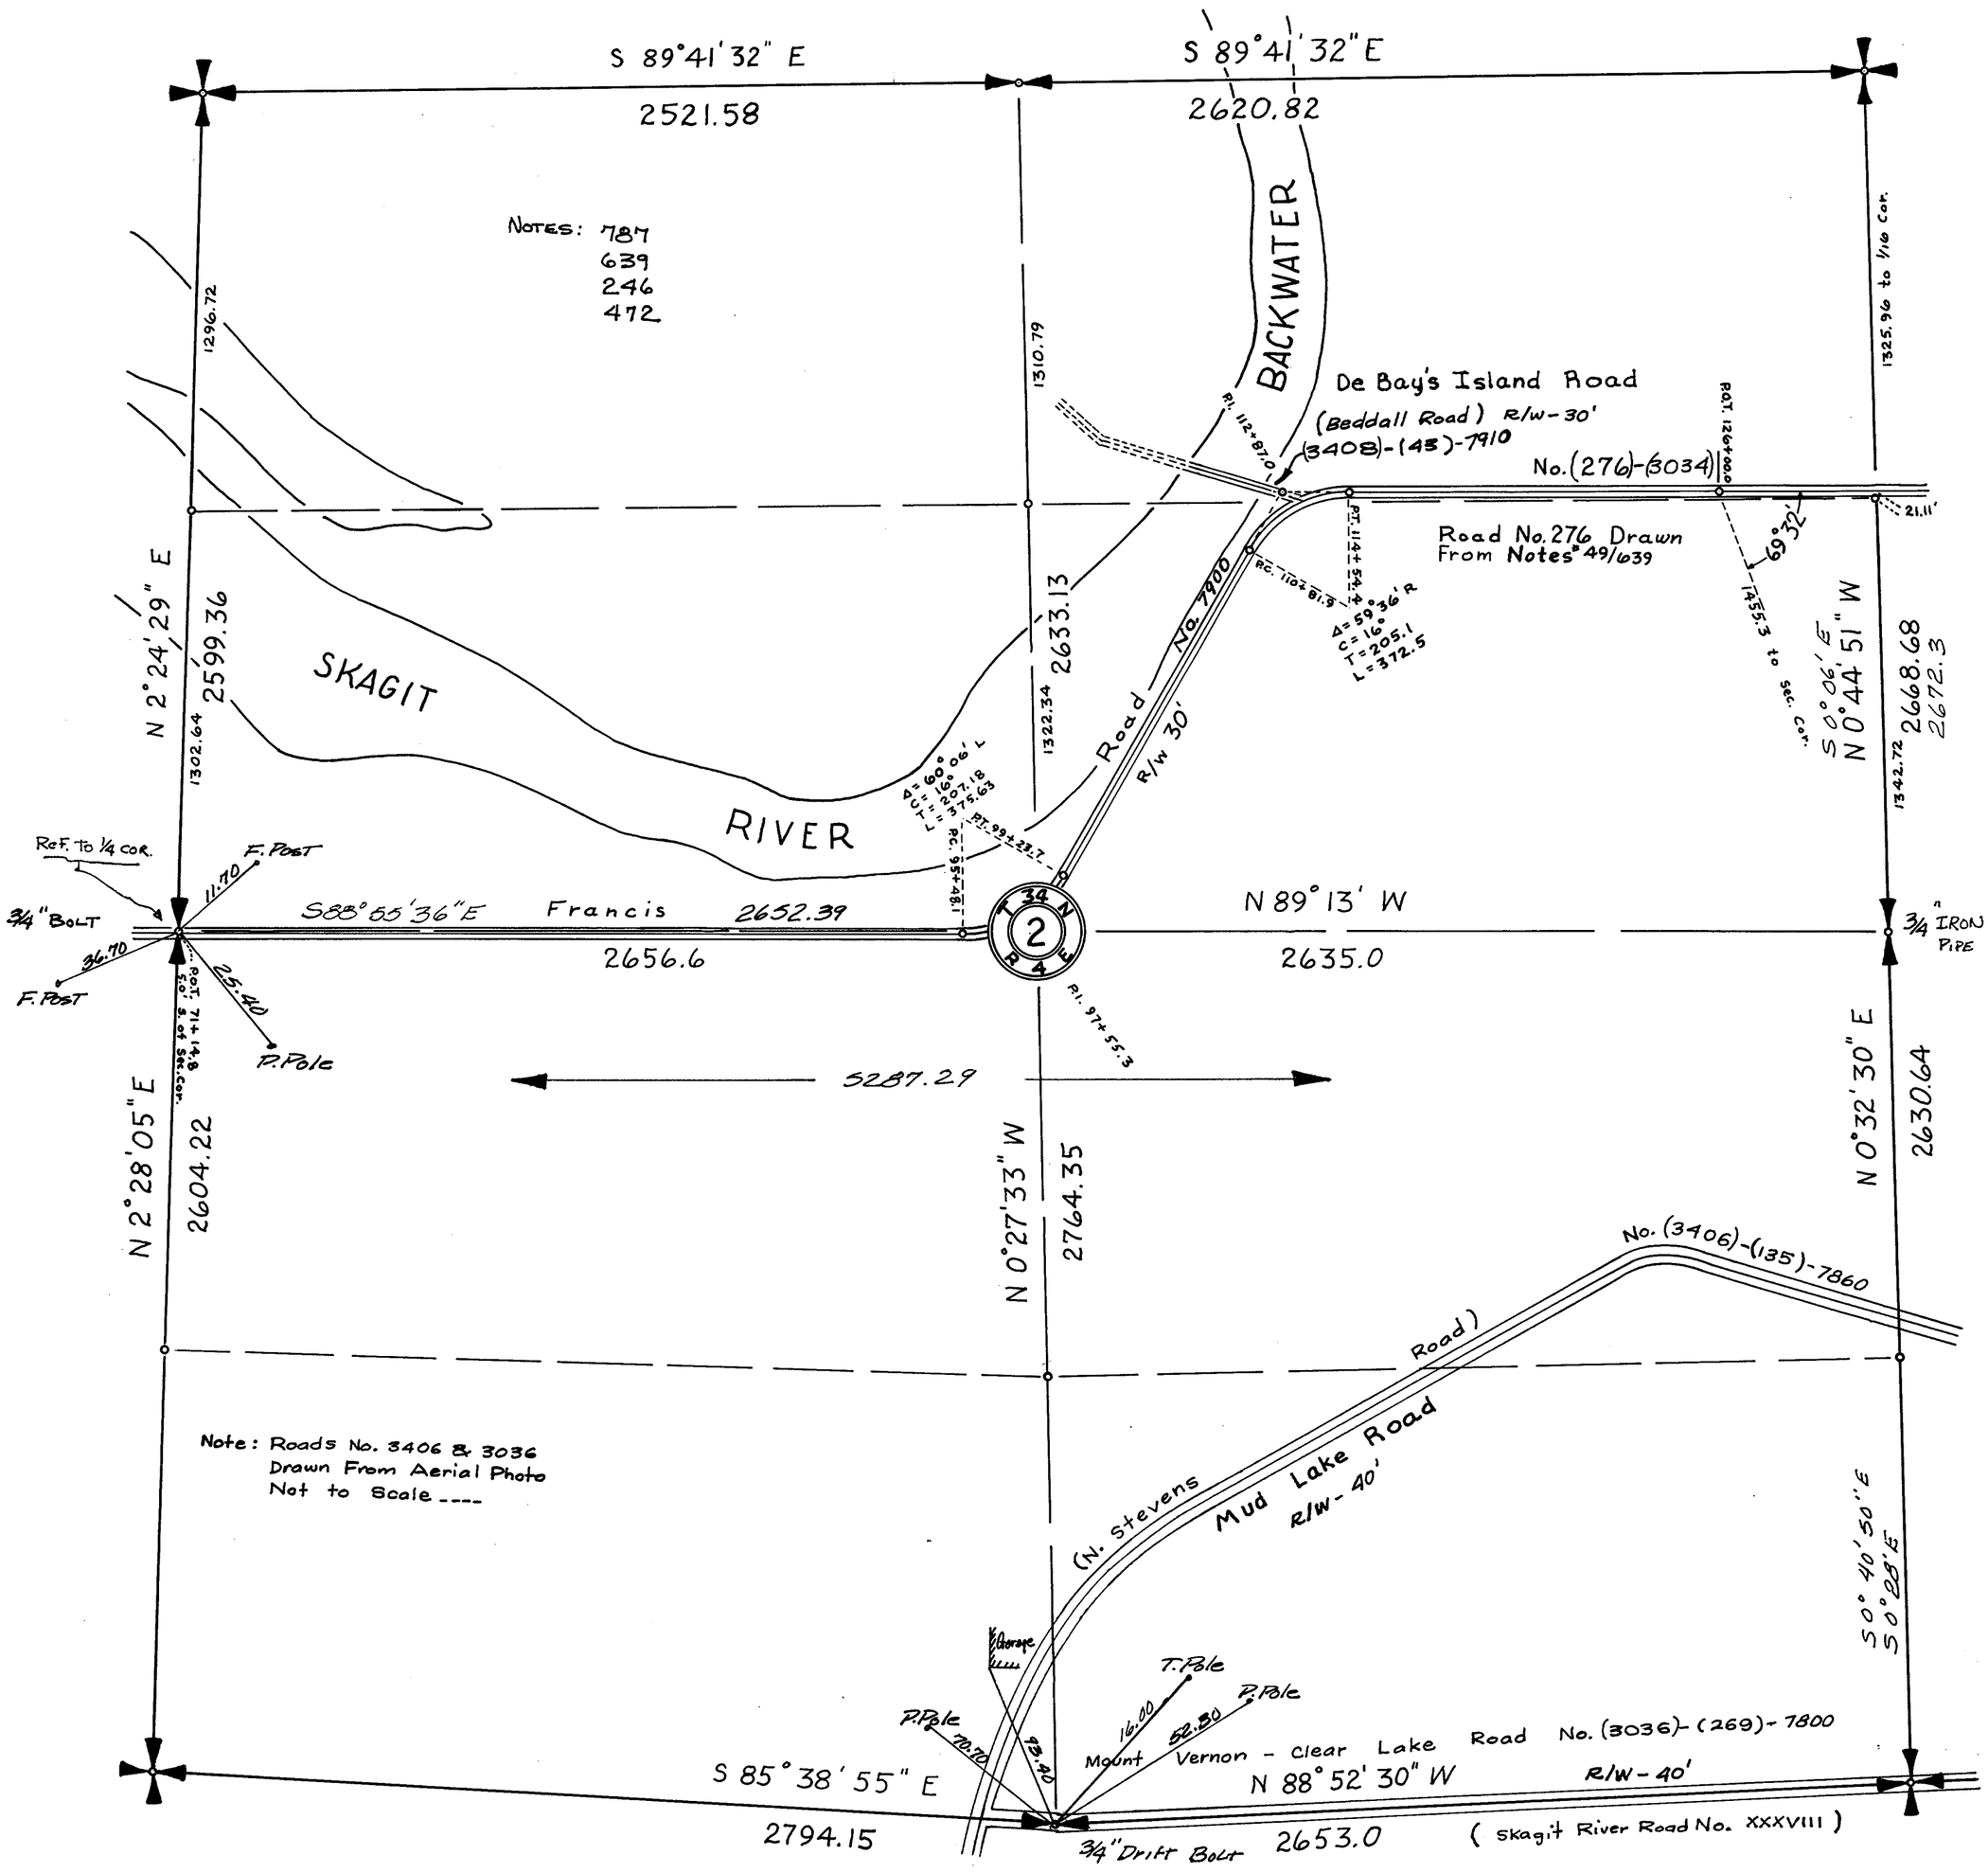


SECTION 2

TOWNSHIP 34 NORTH, RANGE 4 EAST, W. M.

SKAGIT COUNTY, WASH.

SCALE, 1 INCH–400 FEET

A. L. STRONG COUNTY ENGINEER

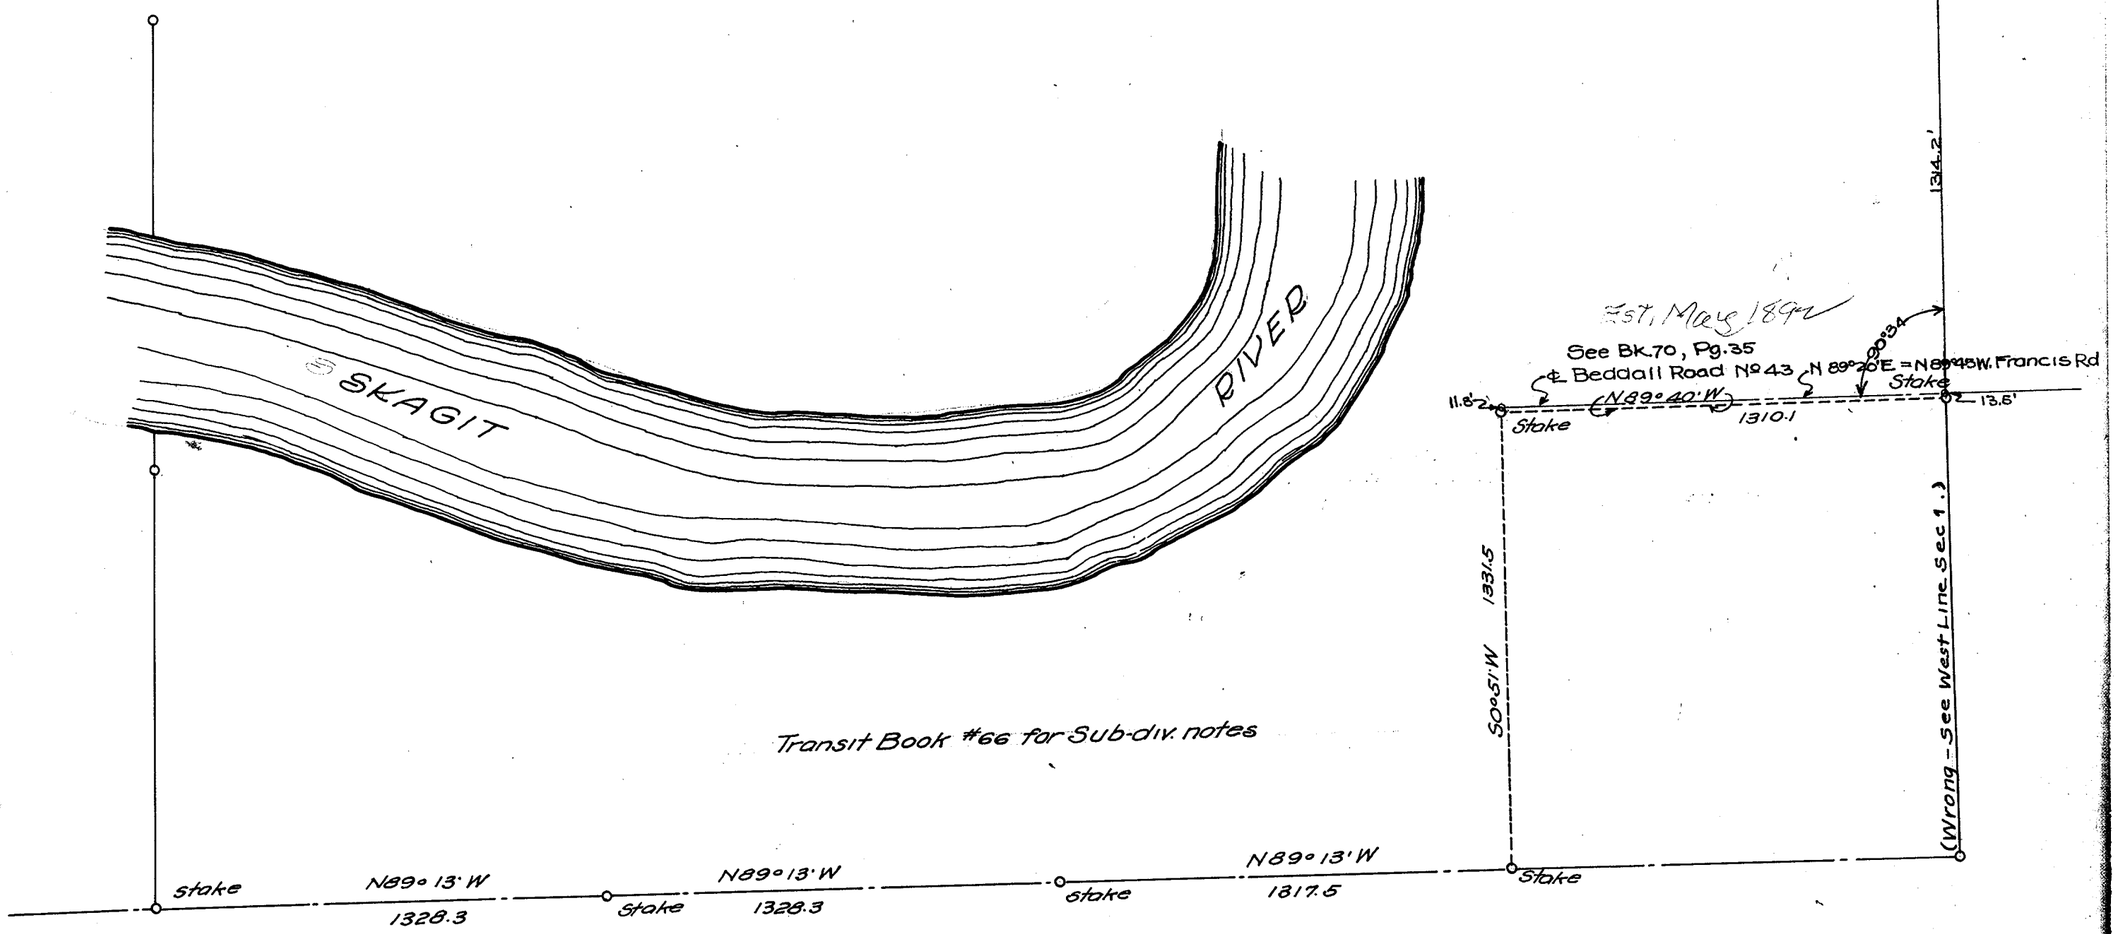


Ringland
2653,0

SECTION 2
TOWNSHIP 34 NORTH, RANGE 4 EAST, W.M.
SKAGIT COUNTY, WASH.

SCALE, 1 INCH 400 FEET

DATE MAY 2, 1972

LLOYD H JOHNSON COUNTY ENGINEER

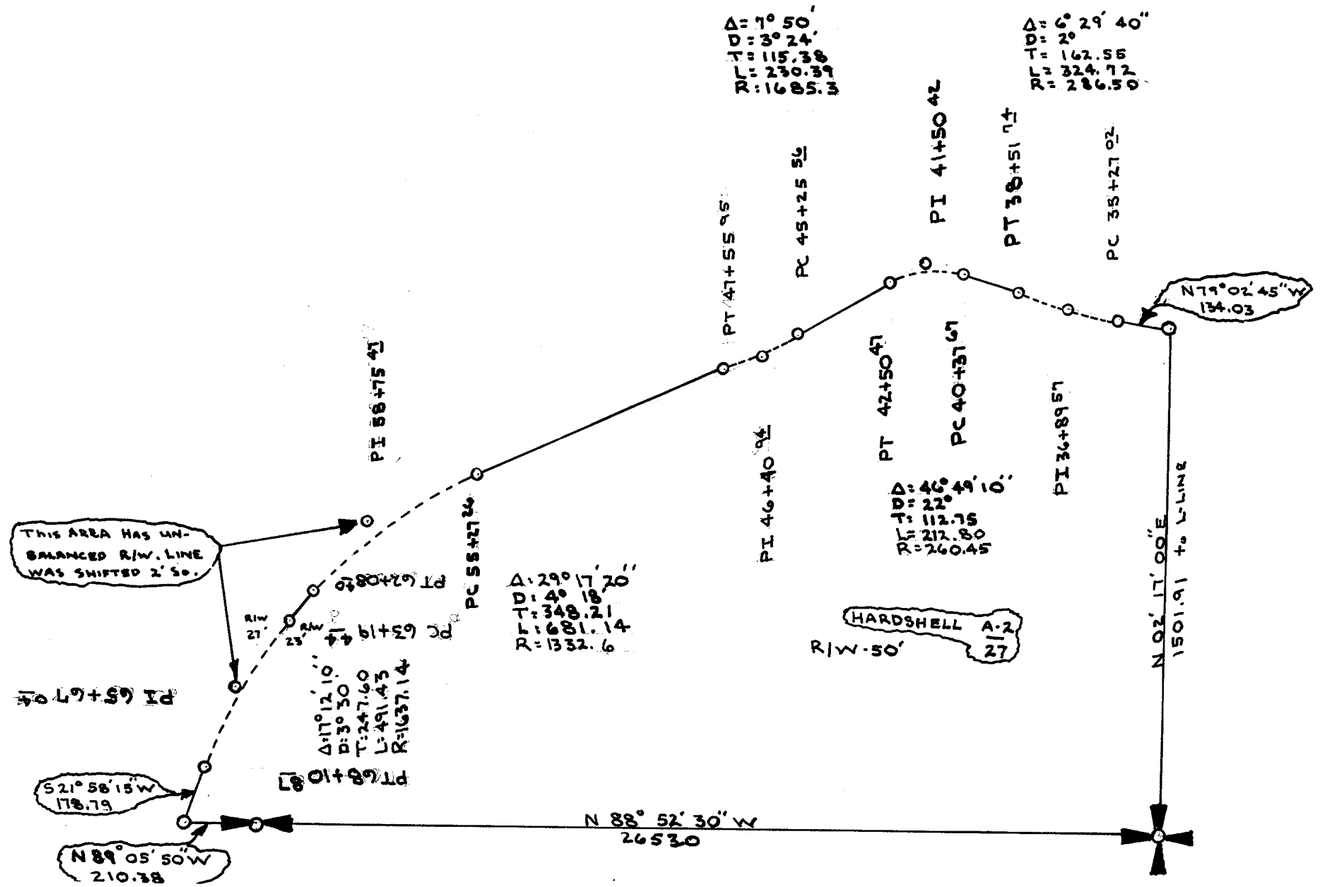


SECTION 3

TOWNSHIP 34 NORTH, RANGE 4 EAST, W. M.

SKAGIT COUNTY, WASH.

SCALE, 1 INCH--400 FEET

DATE August, 1959 Frank Gilkey COUNTY ENGINEER

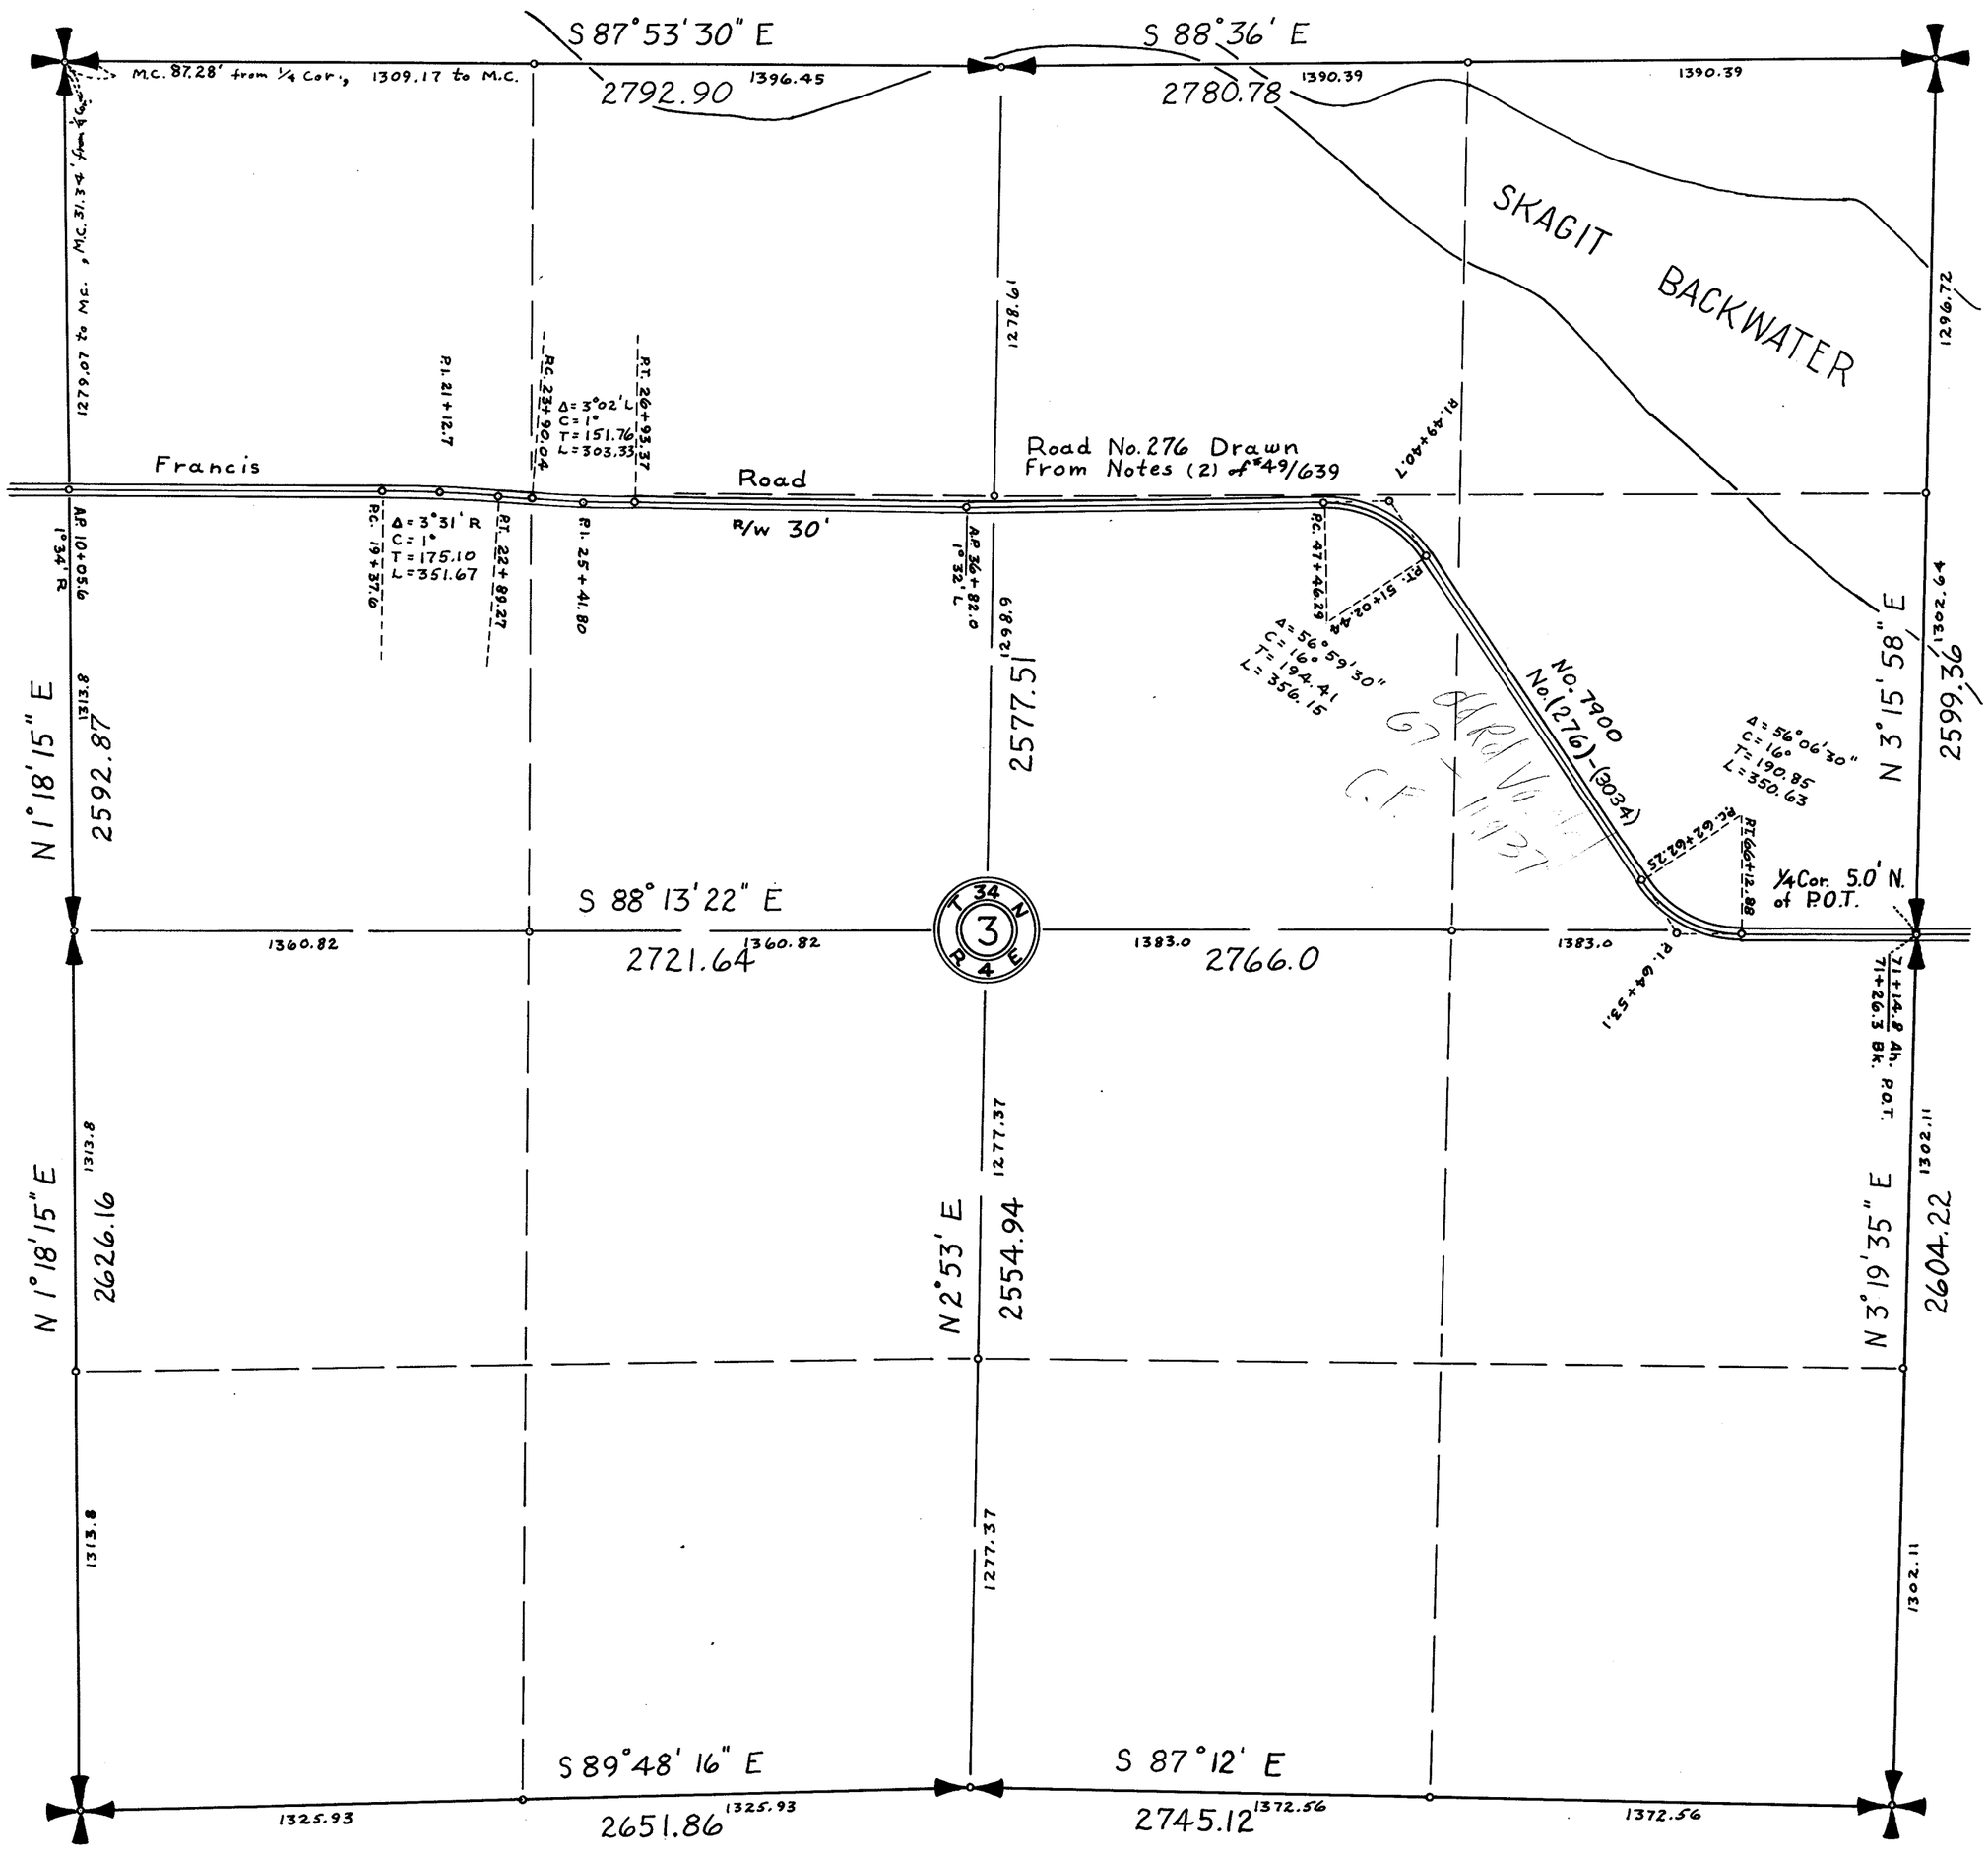


SECTION 3

TOWNSHIP 34 NORTH, RANGE 4 EAST, W. M.
SKAGIT COUNTY, WASH.

SCALE, 1 INCH=400 FEET
Notes: E-114.

Robt. E. L. Knapp COUNTY ENGINEER
Jan. 1931

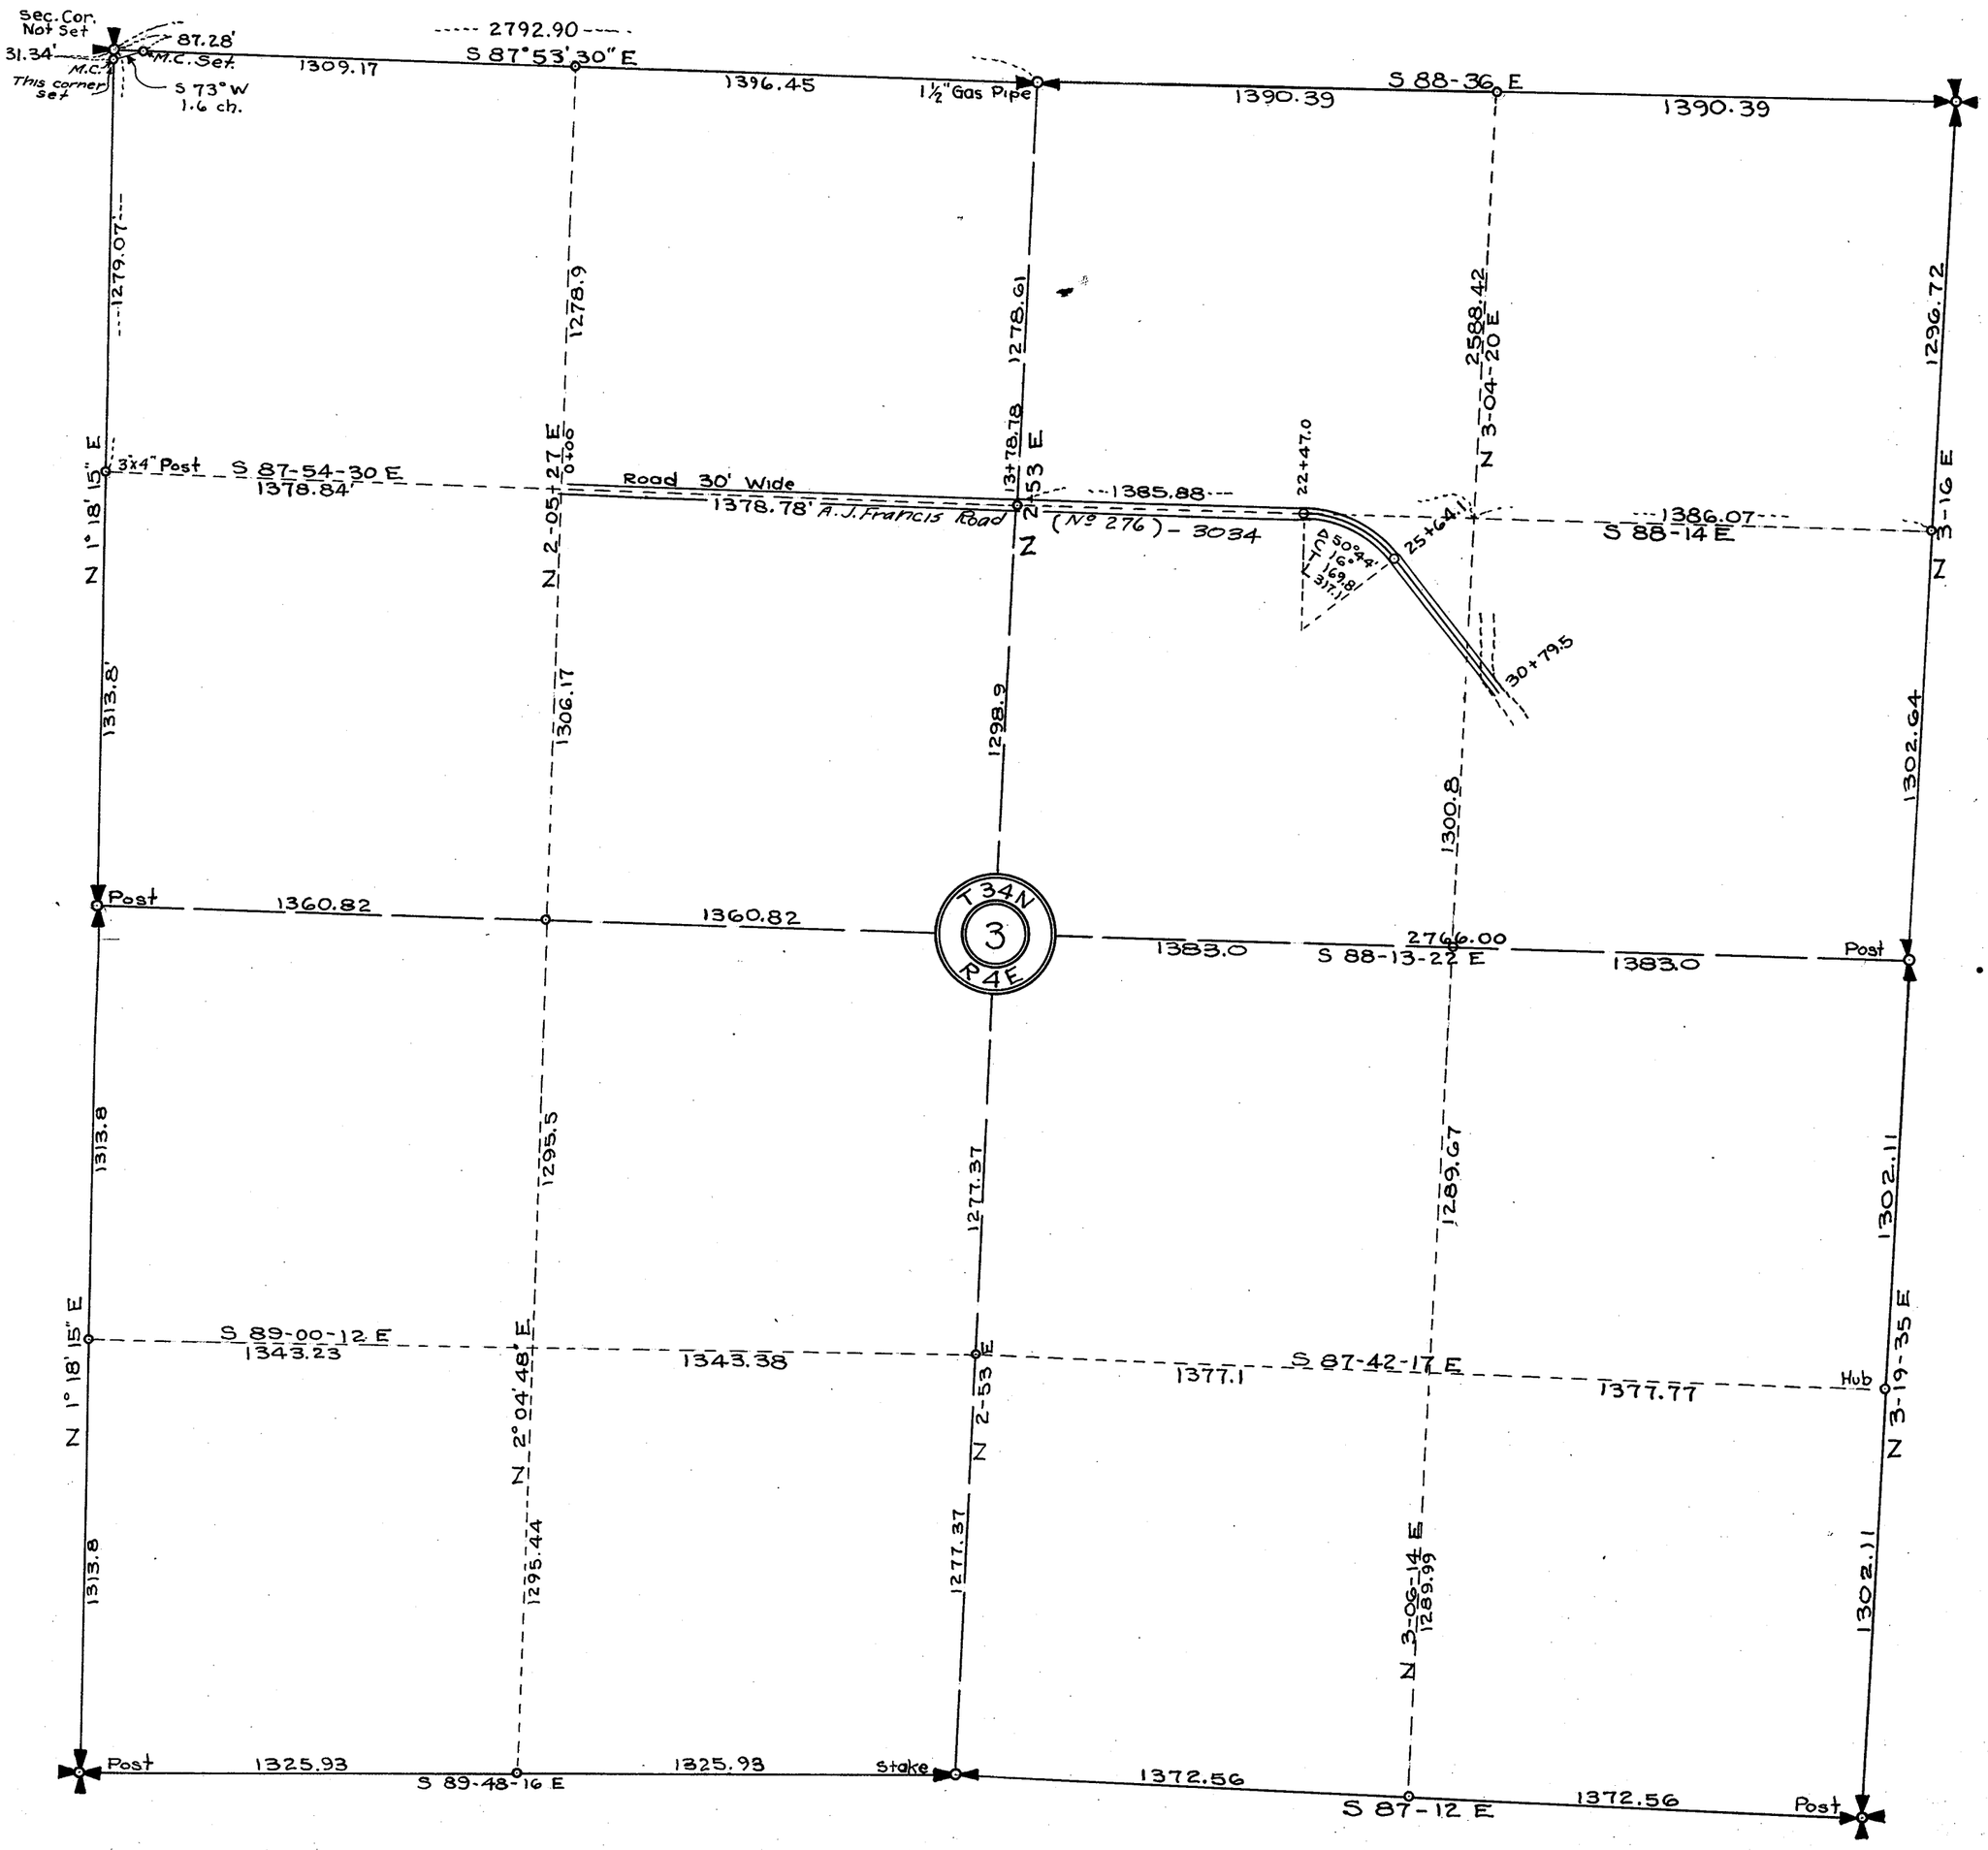



SECTION 3

TOWNSHIP 34 NORTH, RANGE 4 EAST, W. M.
SKAGIT COUNTY, WASH.

SCALE, 1 INCH–400 FEET

Arthur L Strong COUNTY ENGINEER

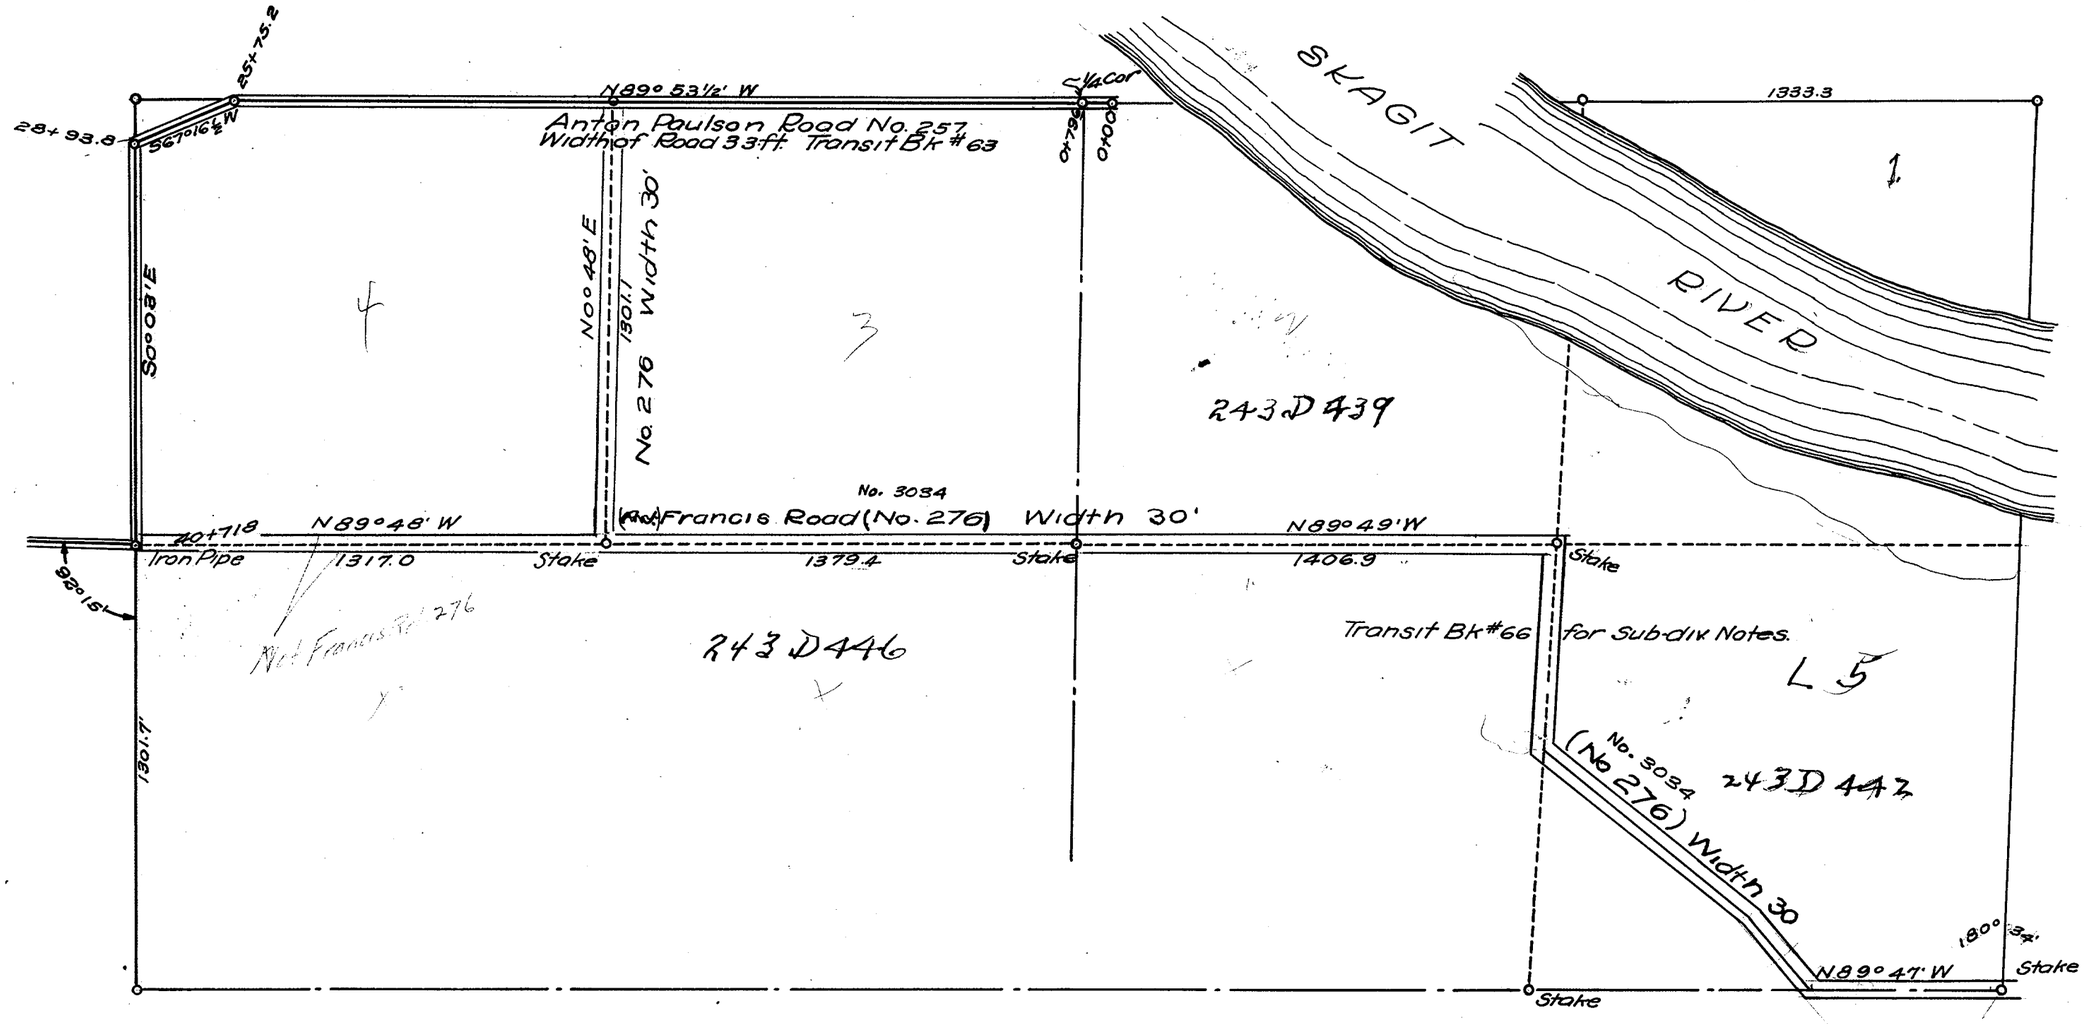

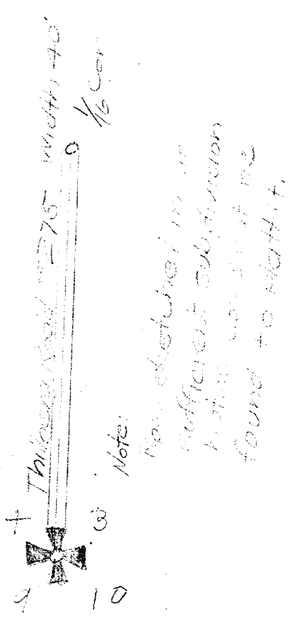


SECTION 4

TOWNSHIP 54 NORTH, RANGE 4 EAST, W. M.
SKAGIT COUNTY, WASH.

SCALE, 1 INCH–400 FEET

_____ COUNTY ENGINEER

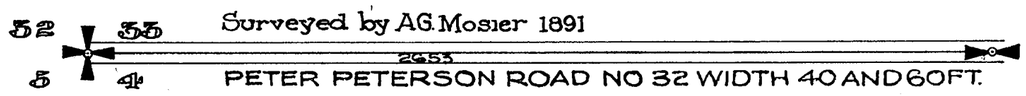

SECTION 4

TOWNSHIP 34 NORTH. RANGE 4 EAST. W. M.

SKAGIT COUNTY. WASH.


SCALE. 1 INCH—400 FEET

Notes: 855, 637, 982

Road No. (32) - 6040

DATE OCT. 1976

L.H. JOHNSON COUNTY ENGINEER

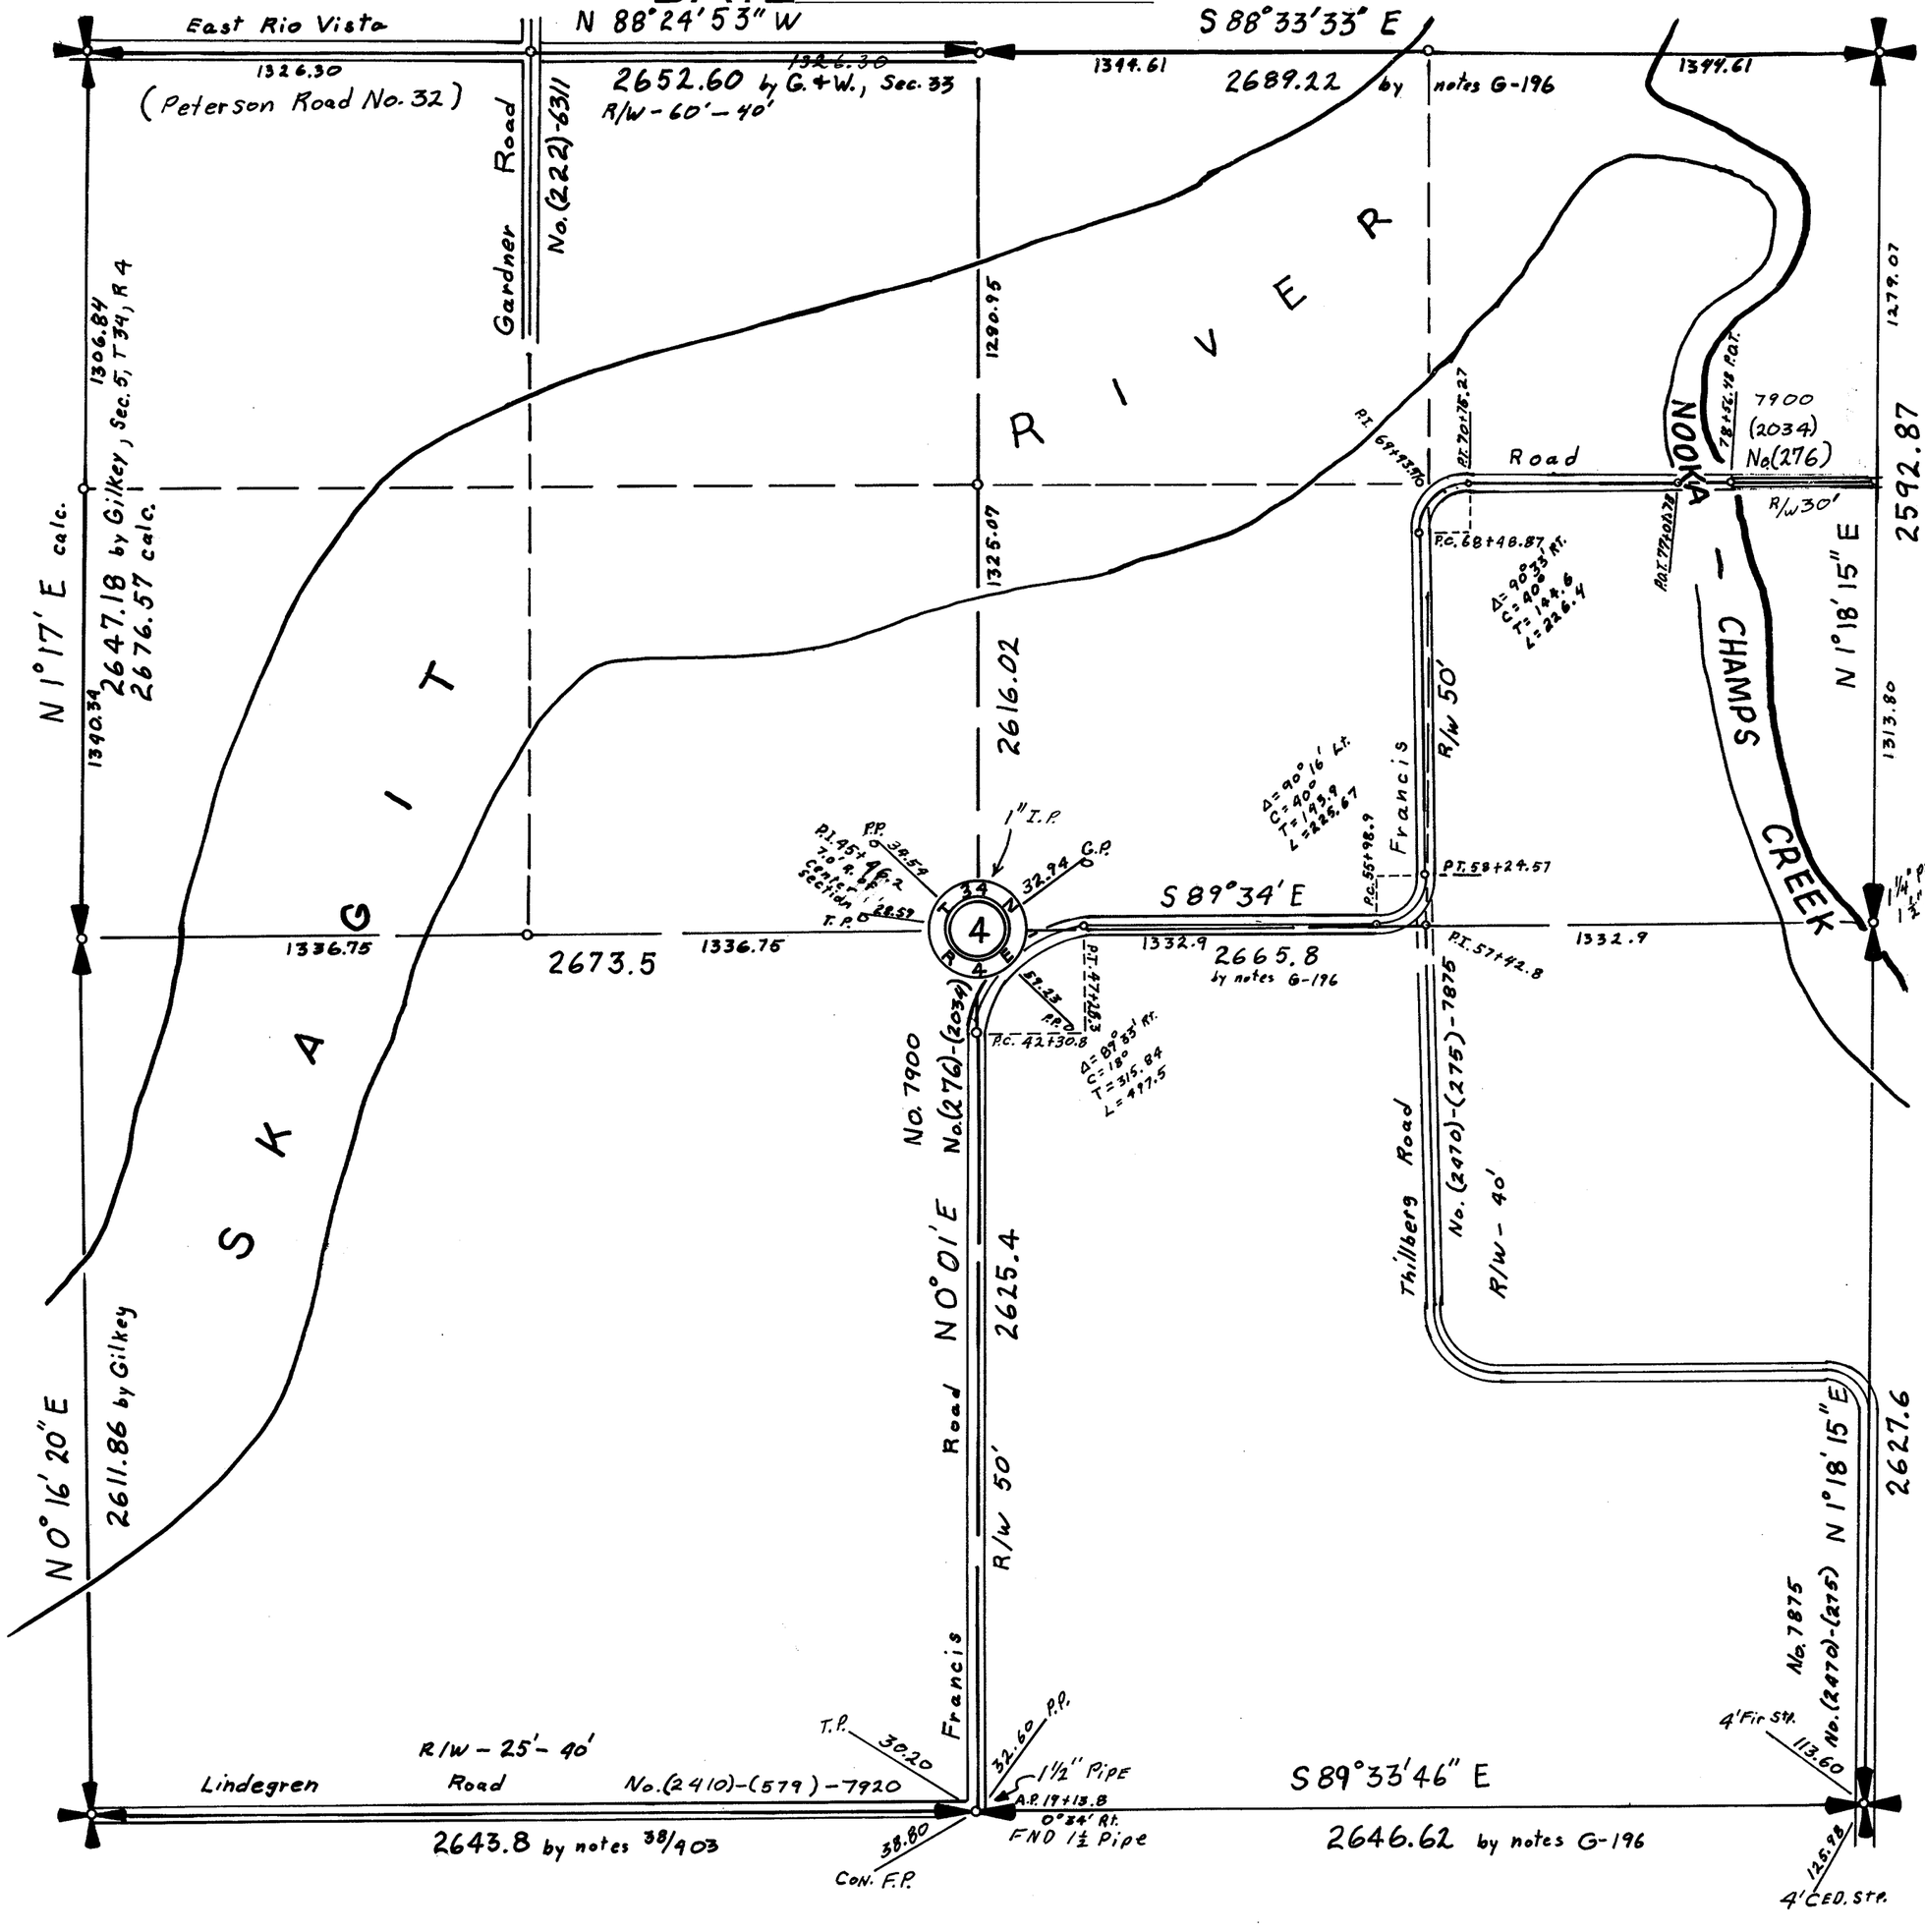


G196

SECTION 4

TOWNSHIP 34 NORTH, RANGE 4 EAST, W. M.
SKAGIT COUNTY, WASH.

SCALE, 1 INCH–400 FEET
Notes E-114

_____ COUNTY ENGINEER

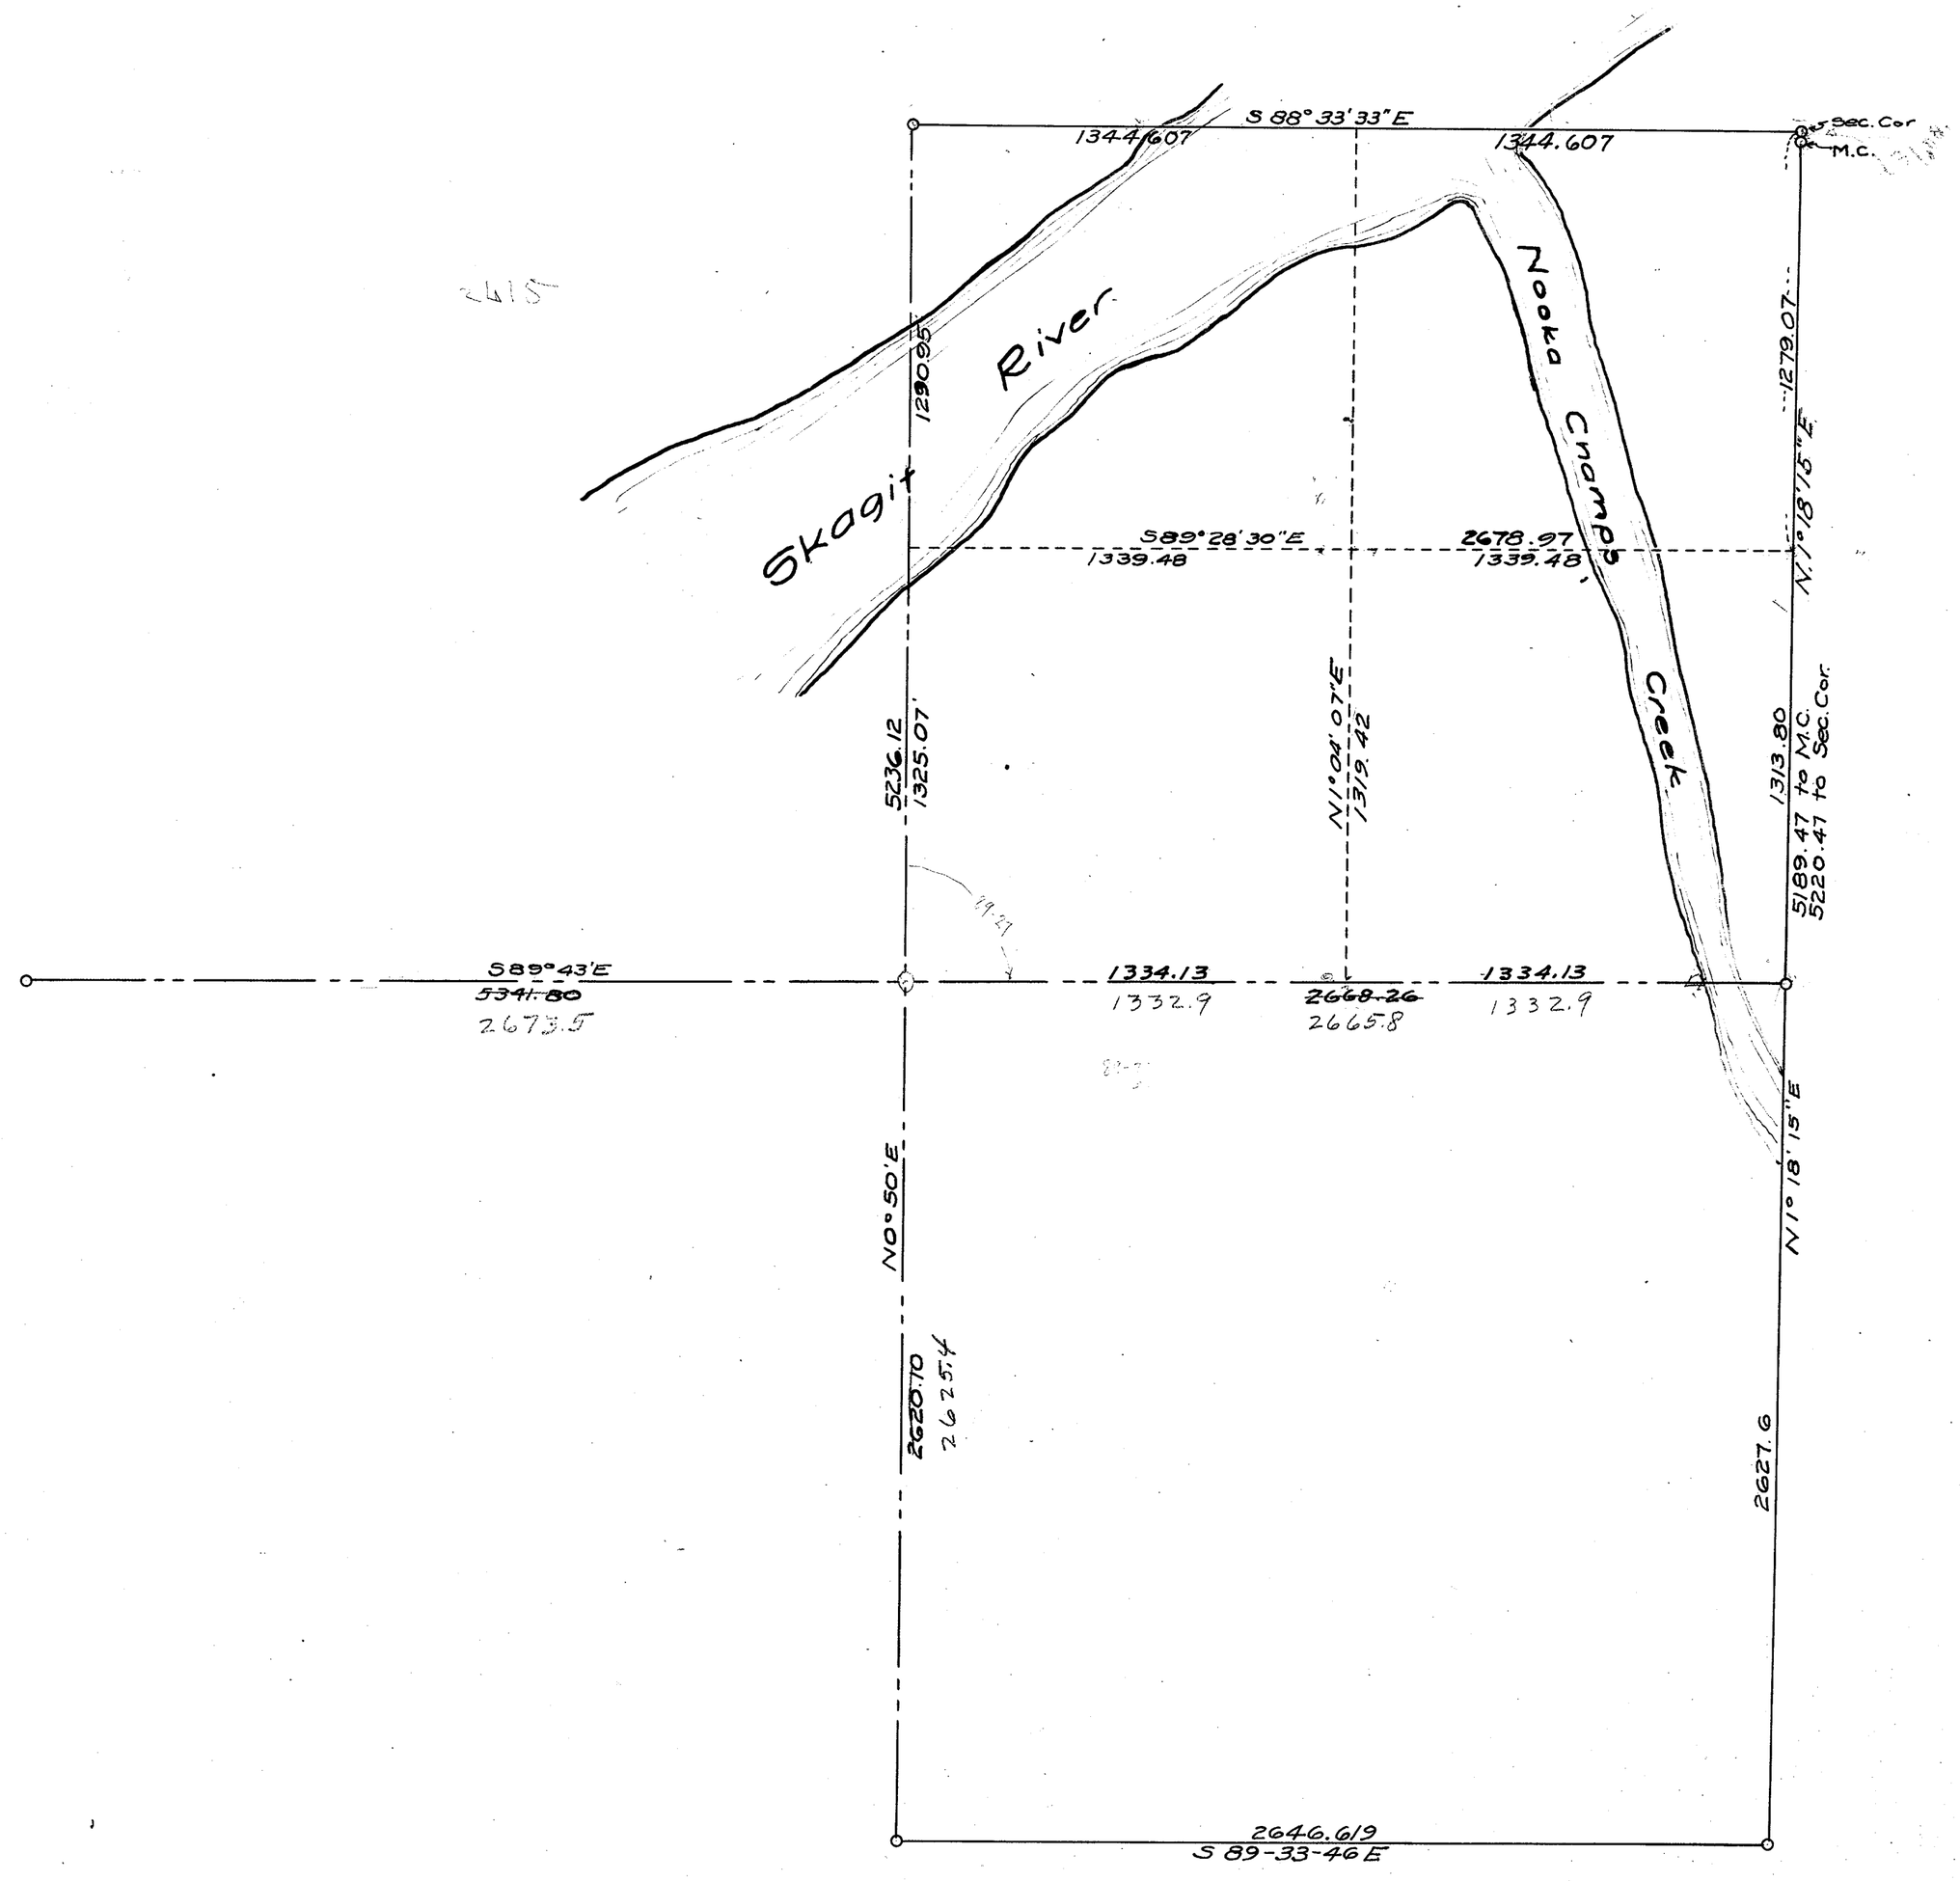

SECTION 5


TOWNSHIP 34 NORTH, RANGE 4 EAST, W. M.

SKAGIT COUNTY, WASH.

SCALE, 1 INCH–400 FEET

NOTES: 495

COUNTY ENGINEER

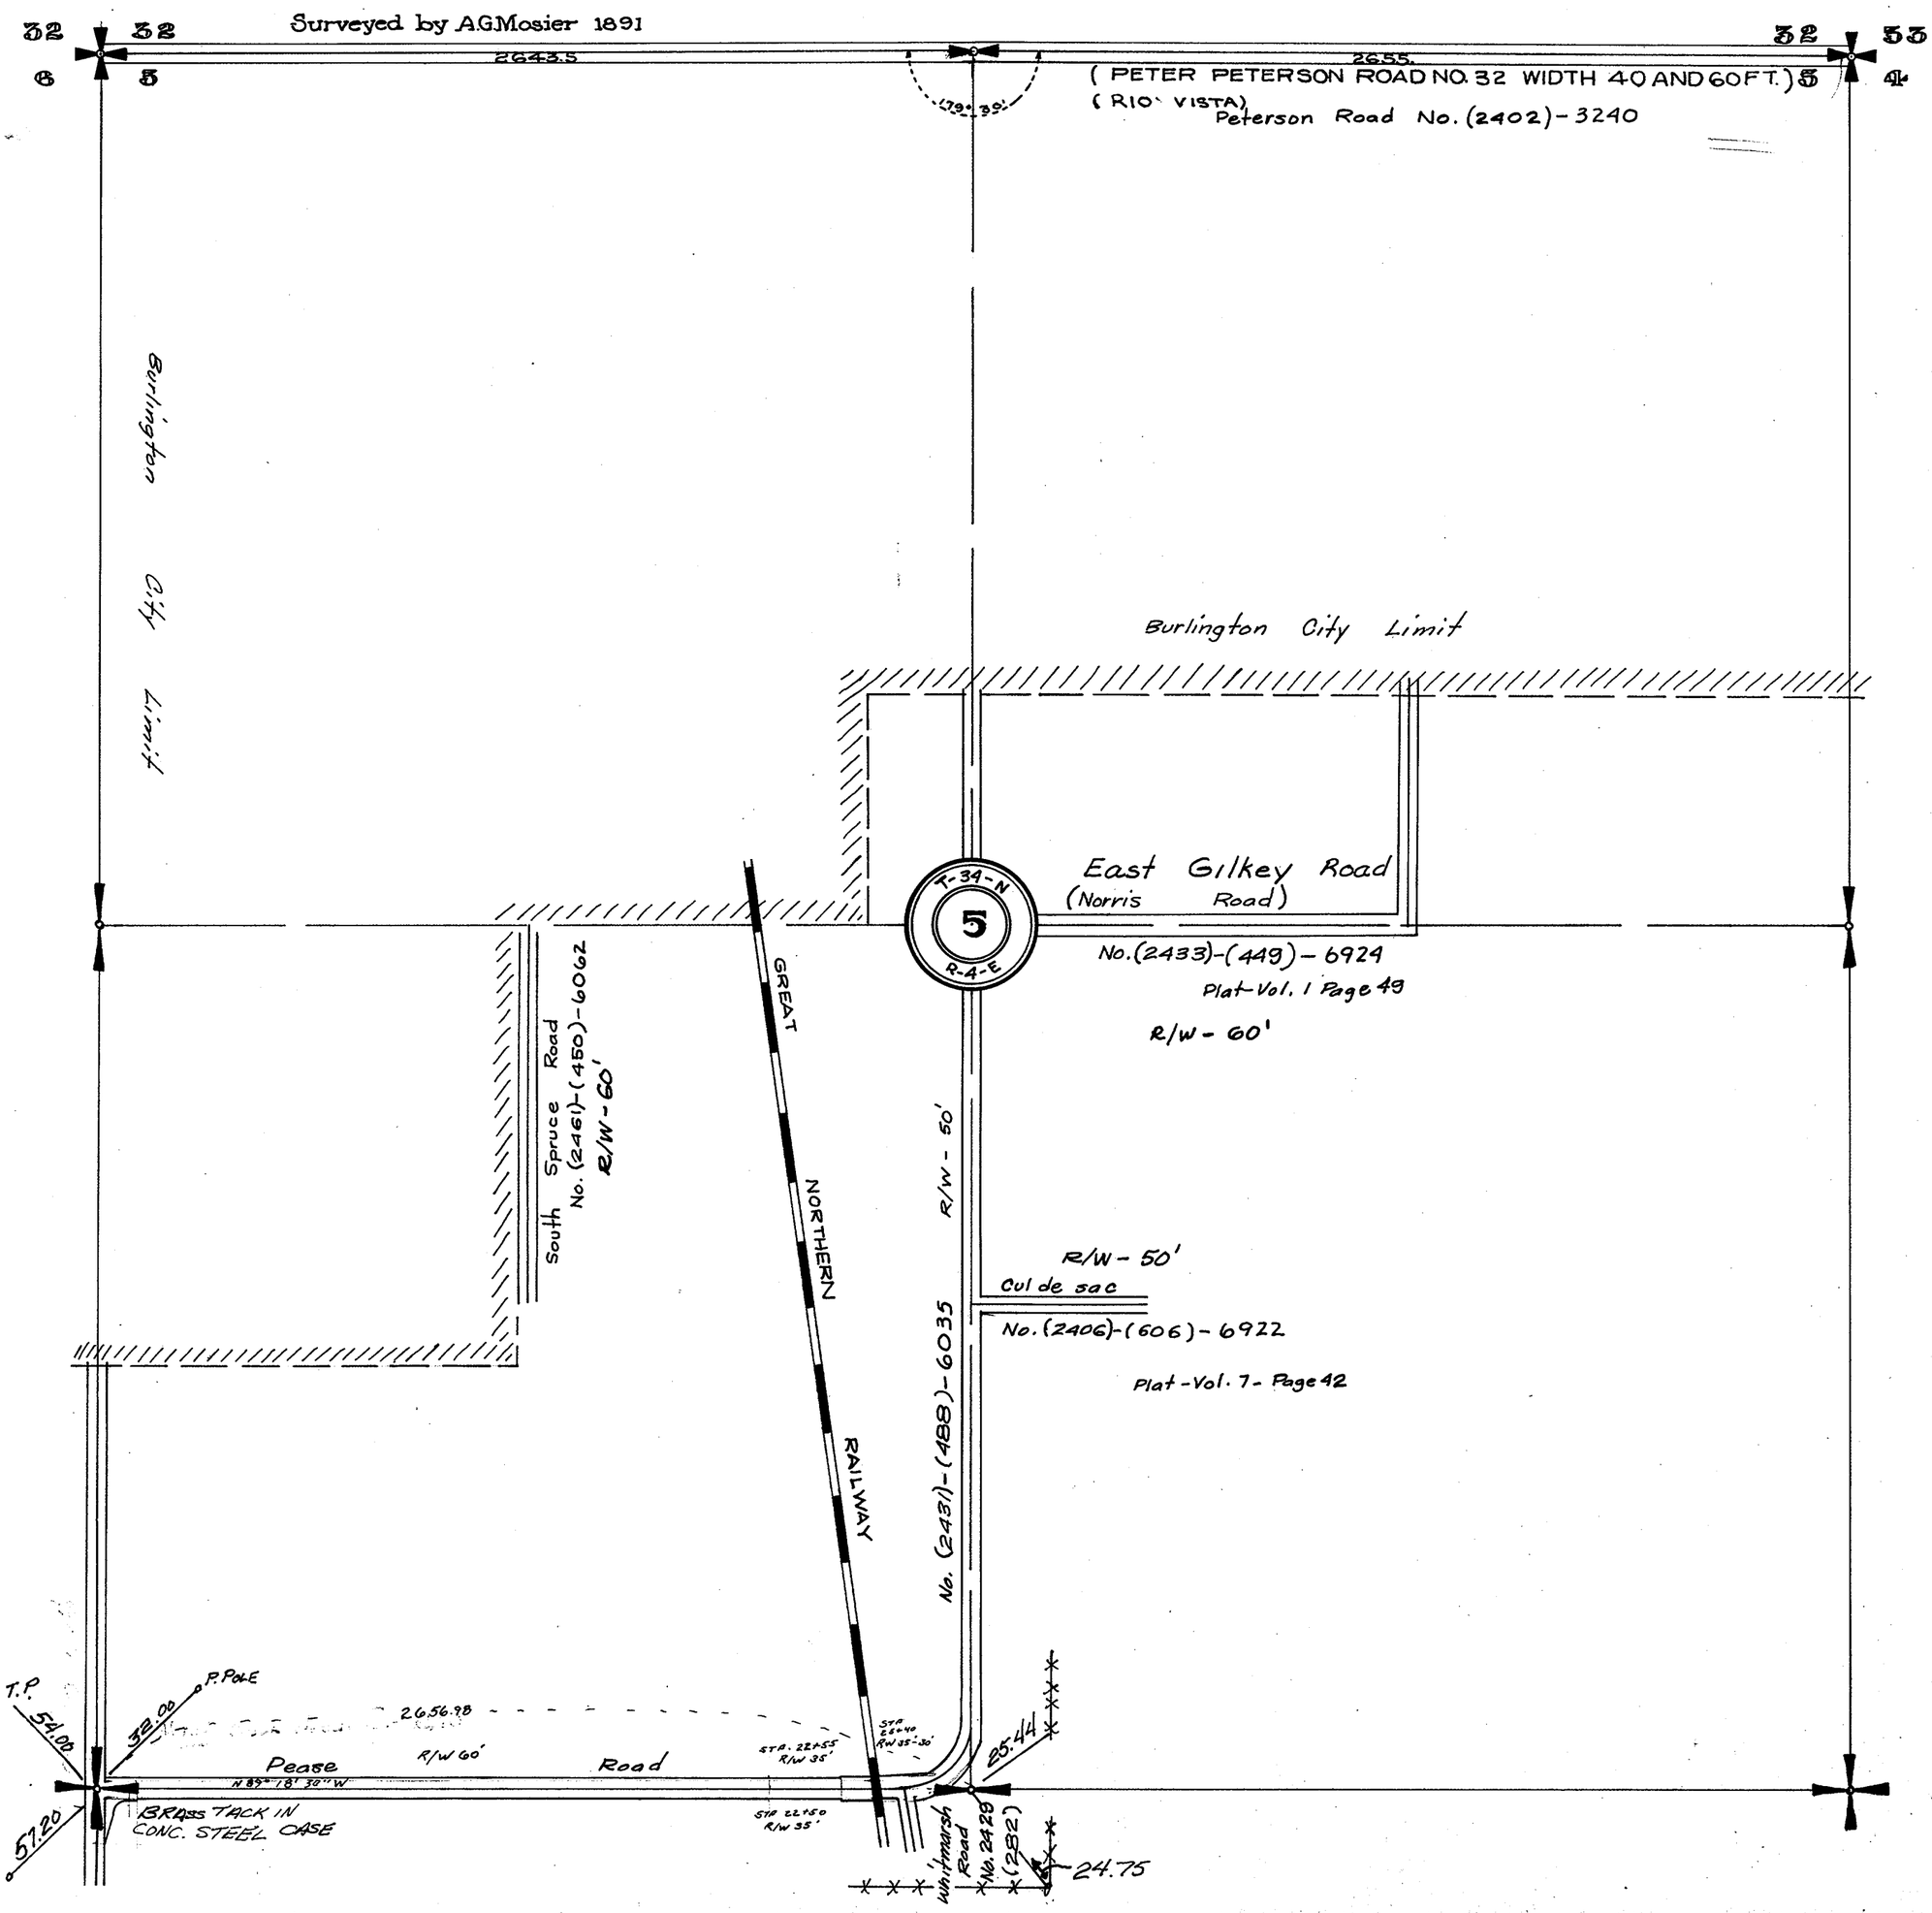


SECTION 5

TOWNSHIP 34 NORTH, RANGE 4 EAST, W. M.
SKAGIT COUNTY, WASH.

SCALE 1 INCH = 400 FEET

DATE MAY 4, 1972

Lloyd H. Johnson COUNTY ENGINEER

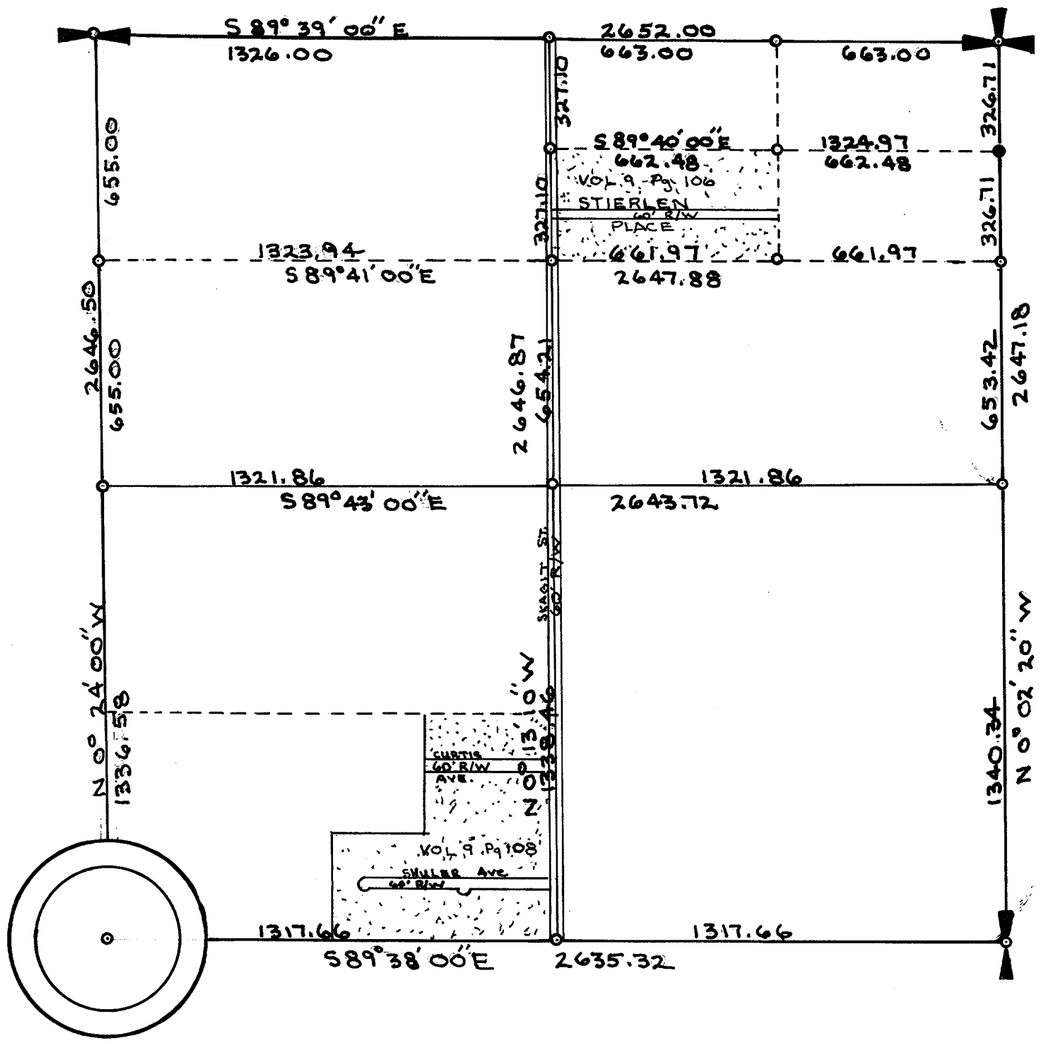

SECTION 6


TOWNSHIP 34 NORTH, RANGE 4 EAST, W. M.

SKAGIT COUNTY, WASH.

SCALE, 1 INCH = 400 FEET

DATE July 12, 1966

Lloyd Johnson COUNTY ENGINEER

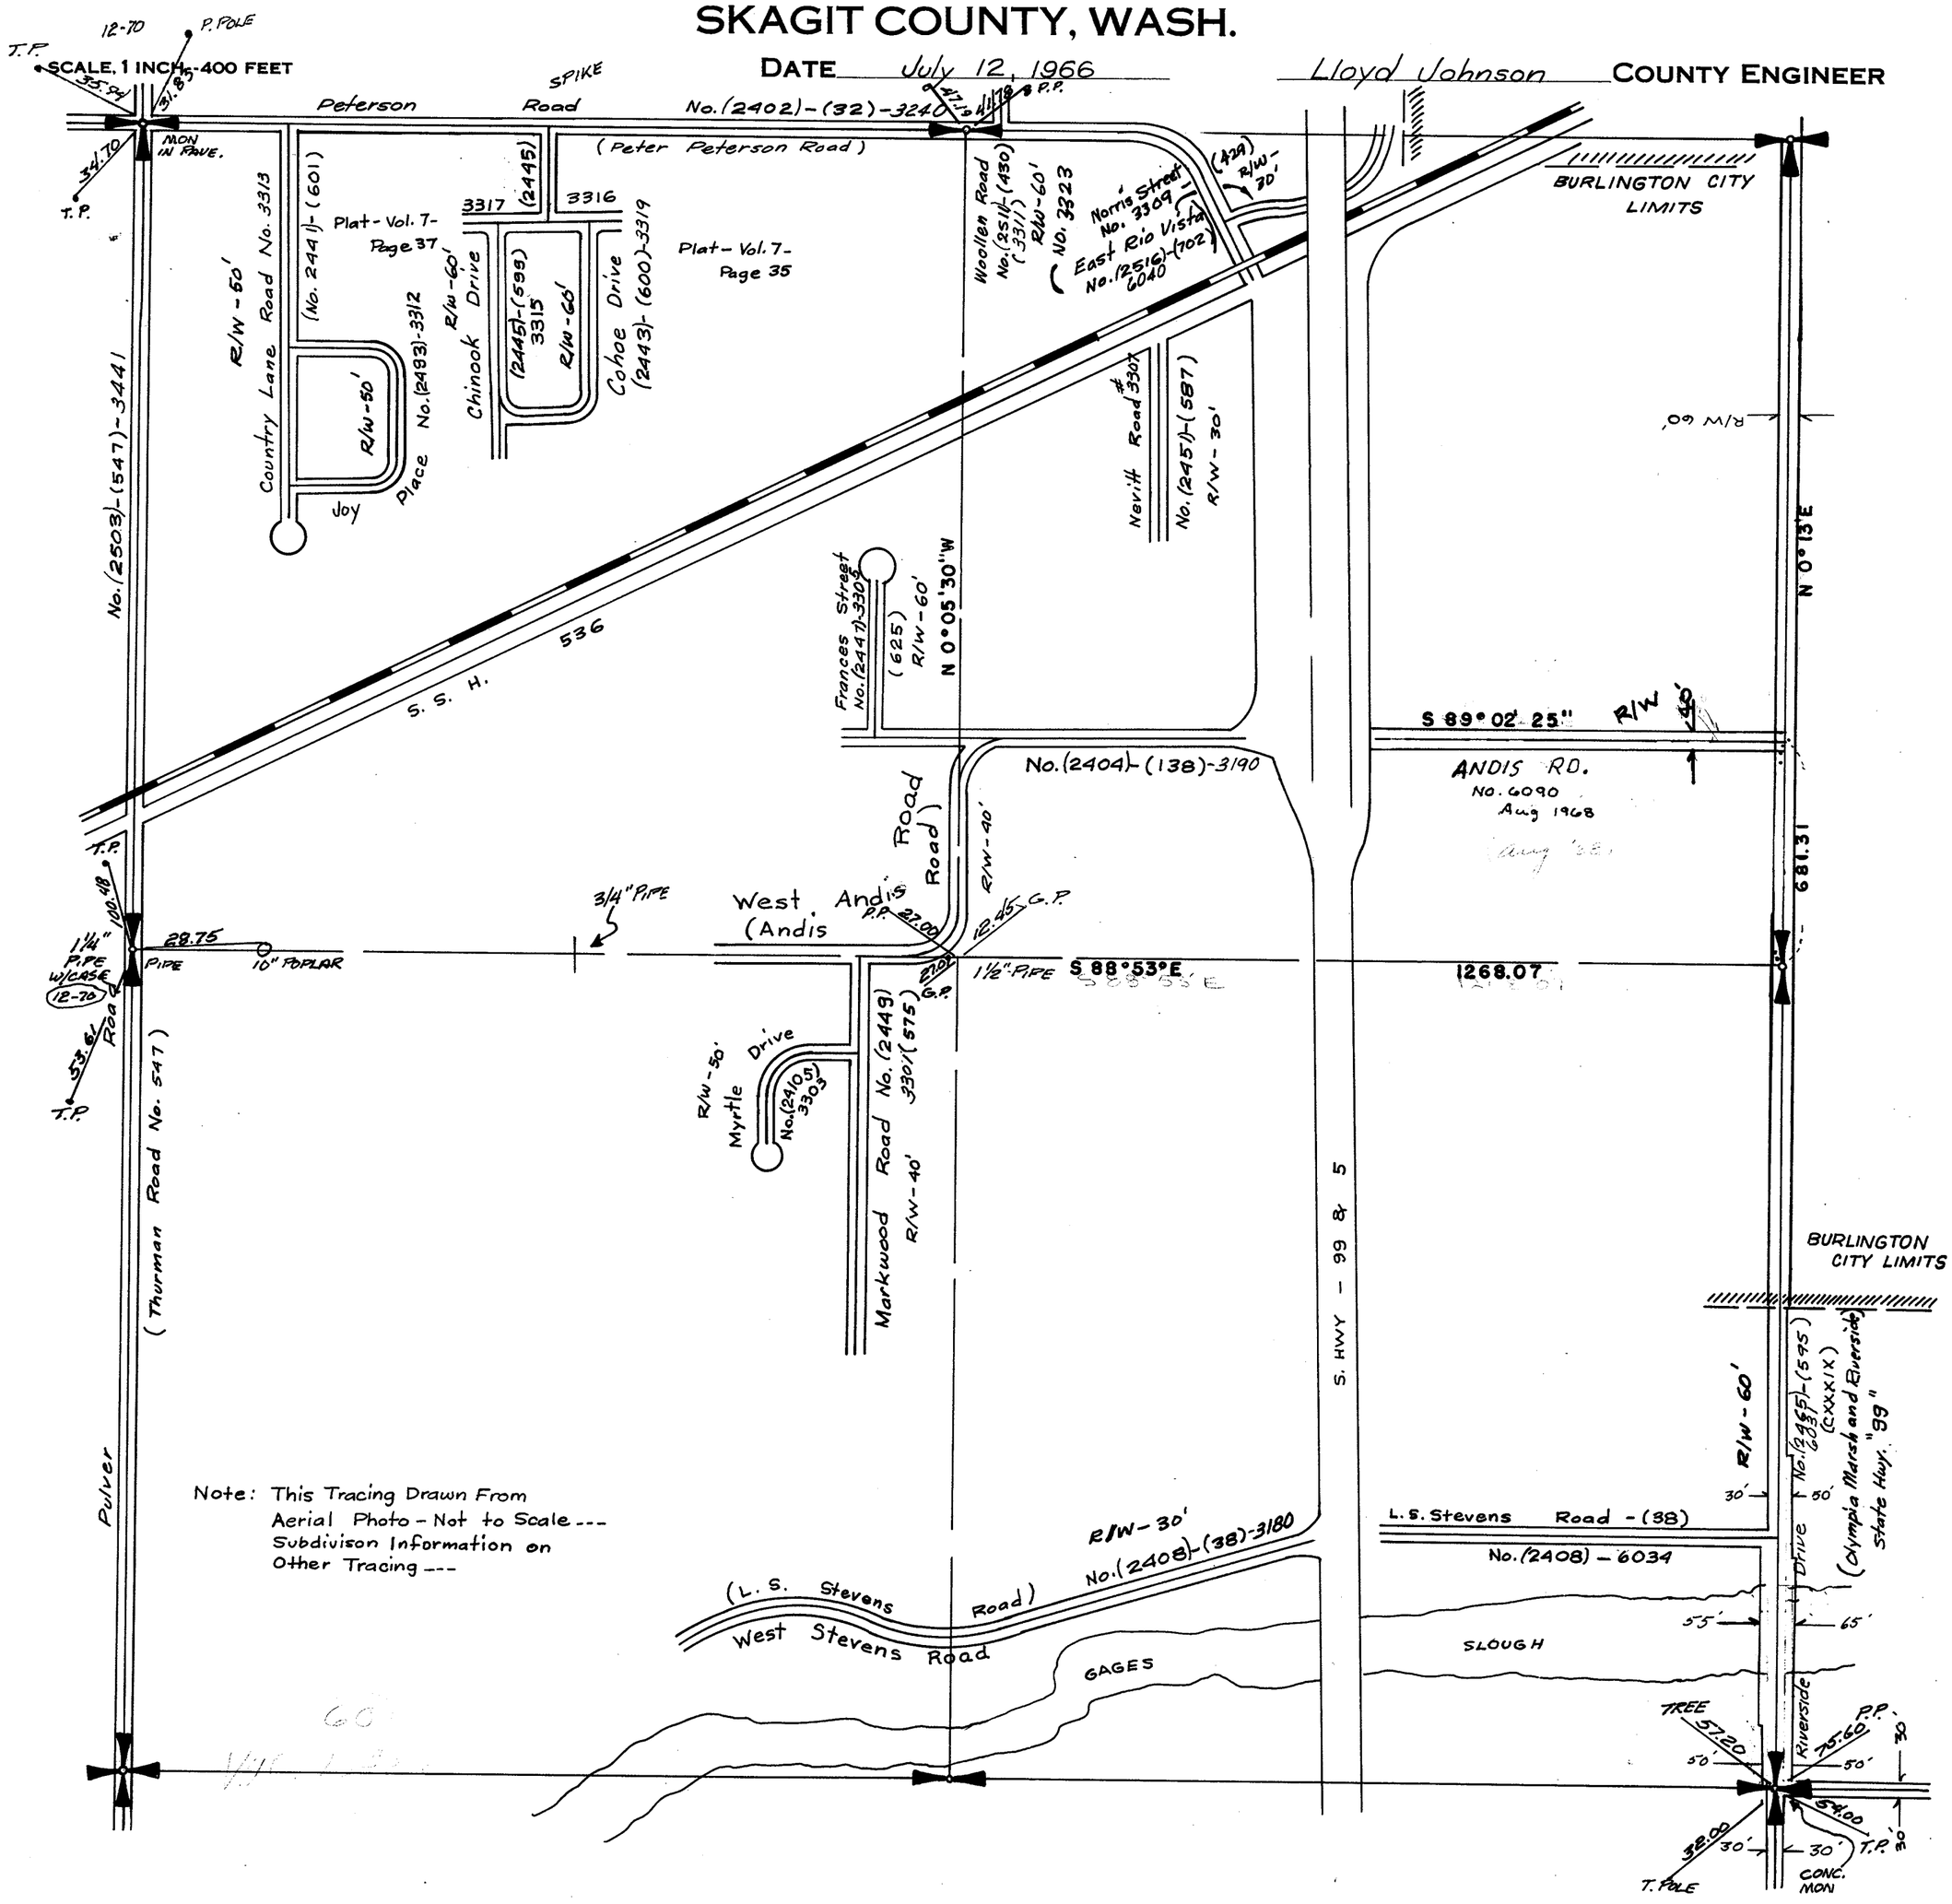

Note: This Tracing Drawn From Aerial Photo - Not to Scale --- Subdivison Information on Other Tracing ---

A8/14

SECTION 6


TOWNSHIP 34 NORTH, RANGE 4 EAST, W. M.

SKAGIT COUNTY, WASH.

SCALE, 1 INCH--400 FEET

H.O.WALBERG COUNTY ENGINEER

1943

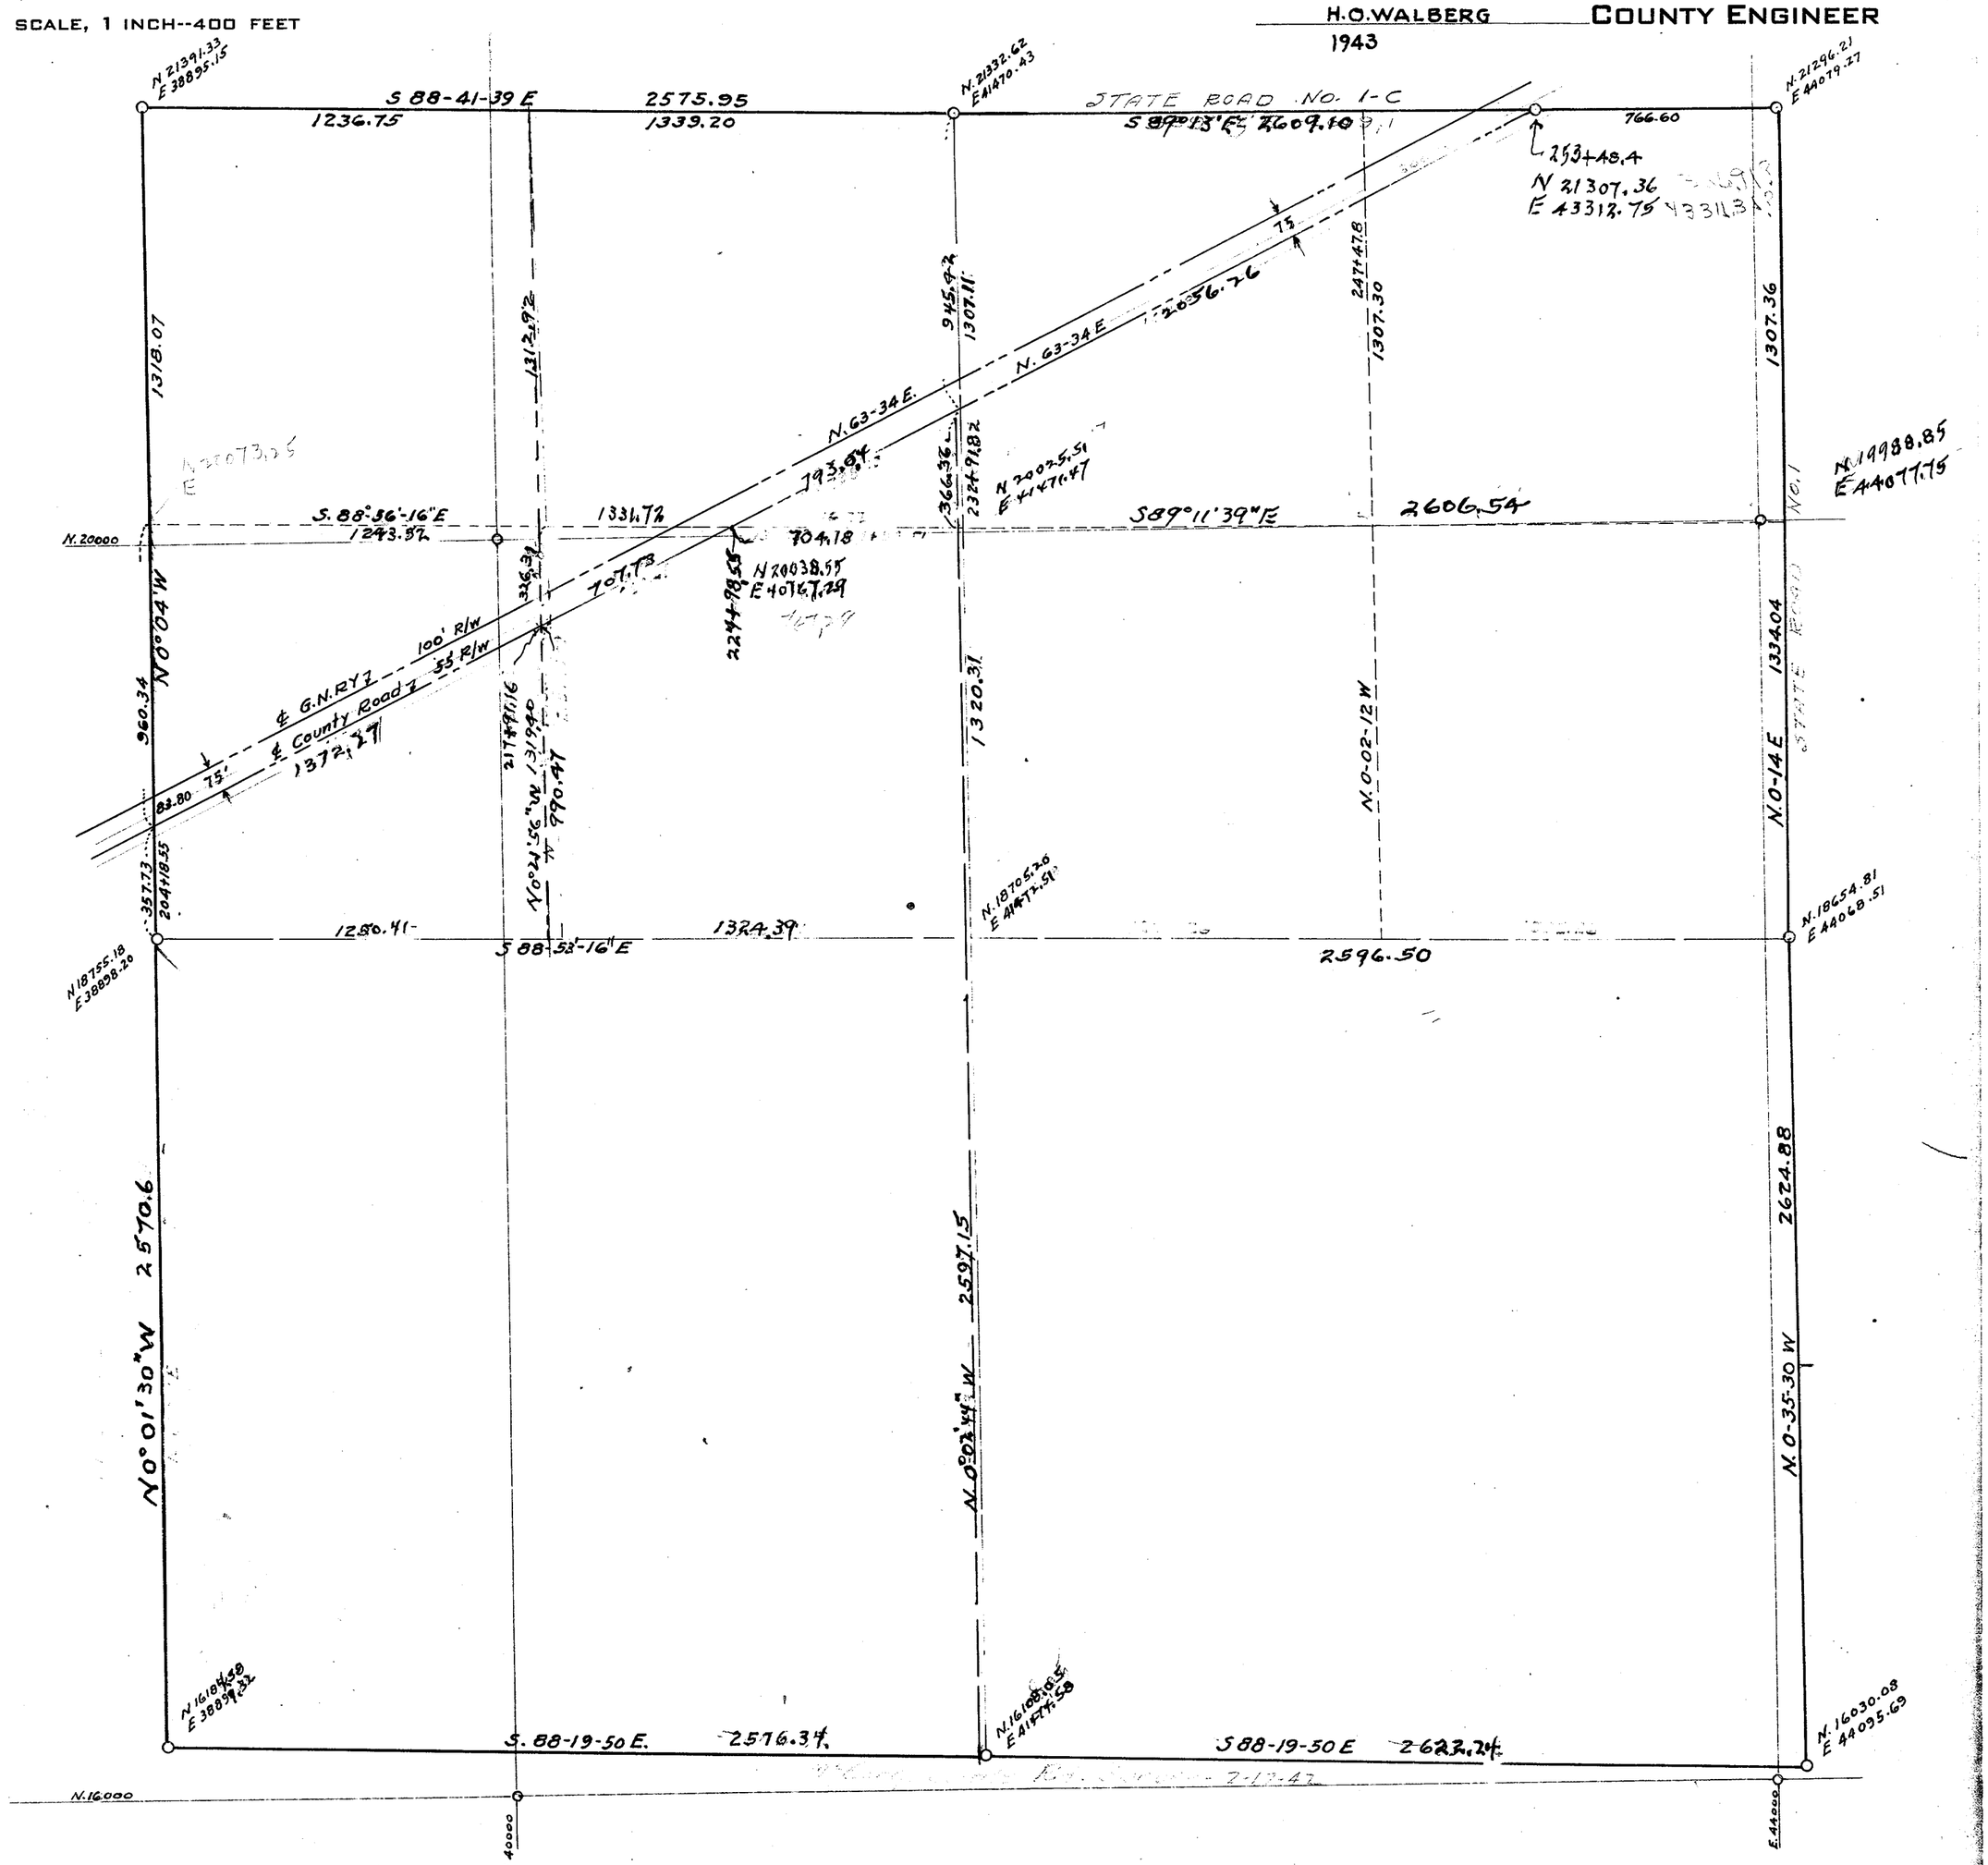


SECTION 6

TOWNSHIP 34 NORTH, RANGE 4 EAST, W. M.
SKAGIT COUNTY, WASH.

SCALE, 1 INCH–400 FEET

_____ COUNTY ENGINEER

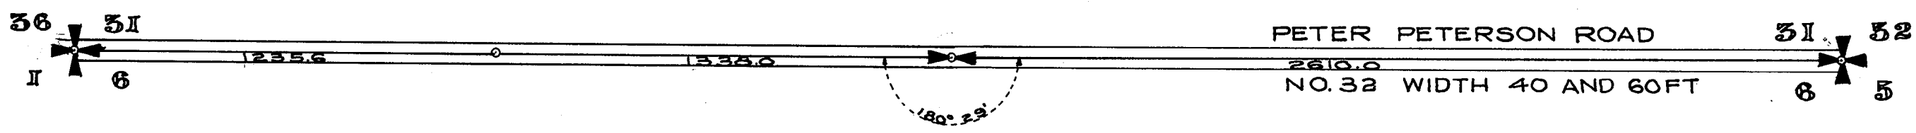

SECTION 7

TOWNSHIP 34 NORTH, RANGE 4 EAST, W. M.

SKAGIT COUNTY, WASH.

SCALE, 1 INCH = 400 FEET

DATE July 13, 1966

Lloyd Johnson COUNTY ENGINEER

Note: This Tracing Drawn From Aerial Photo - Not to Scale ...

Notes: 544

T-34-N 7 R-4-E

S88°19'50"E 2576.34

S88°19'50"E 2622.24

P.Pole 16.85 F.Post 24.40

F.Post 36.20

T.P. #1635 54.00 32.00 P.Pole

24" CHERRY TREE 51.20

P.Pole 25.40 55.00 T.Pole 2555.10

No.(2503)-(547)-3441 (CL1)

(John McCorquodale) No.(2414)-(141)-3120 S88°30'08"E

(No. 2414-(141)-(3120)) (CXXXIX)(595) No.(2465)-6031

West McCorquodale R/W-33'

John McCorquodale No. 6032 R/W-33'

(260) 46.00 T.Pole

Pulver Road N0°23'30"E

99-5 STATE

(Olympia Marsh and Riverside) (State Hwy. "99") S1°26'30"E

T.P. #1615-R3 48.2 Drive

R/W-60' 95.43 TACK N.E. COR 2 STORY HOUSE 27.00 P.P

62.00 P.P.

31.70 P.Pole 20.50 P.Pole

George Hopper Road R/W-88' No.(2466)-(238)-3020

N0°01'E 2606.59

SKAGIT RIVER

Riverside S2°13'32"E 2407.85

MOUNT VERNON CITY LIMITS

(E.S. Stewart Extn. Road) (No. 228)

F.P. 1.3

1337.31 River Bend Road 1380.10 No. 7001 180°12'10" R/W-40'

46.68 TACK IN R. SIDE P. POLE BLM P 6/68

13.83 F.P. (TK ON E. SIDE END) 52.00 F.P.

10.20 P.P. 58.22 TACK & NAIL W. SIDE 8" APPLE TREE S.E.

No.(2426)-(227)(E.S. Stewart Road) S89°27'40"E 2717.41

S89°15'30"E 2662.72


SECTION 7

TOWNSHIP 34 NORTH, RANGE 4 EAST, W. M.

SKAGIT COUNTY, WASH.

SCALE, 1 INCH–400 FEET

Arthur L Strong COUNTY ENGINEER

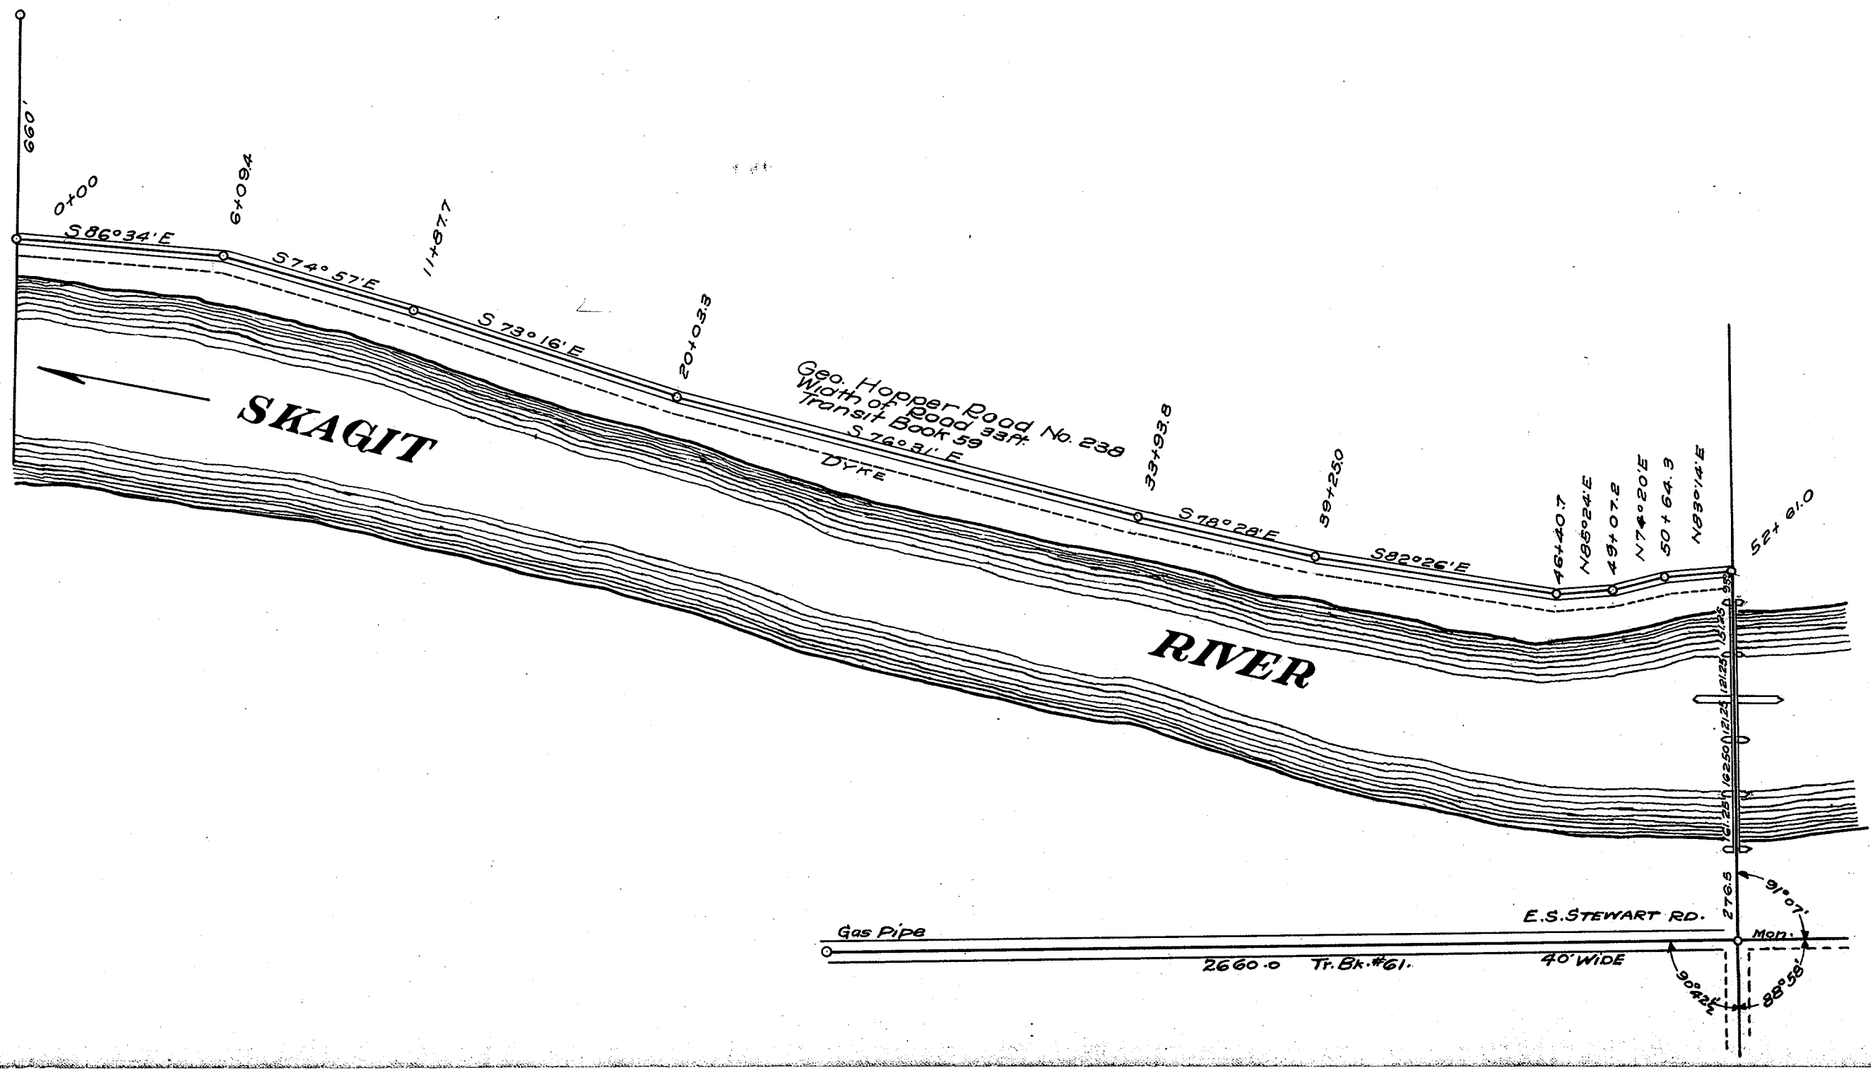


SECTION 8

TOWNSHIP 34 NORTH, RANGE 4 EAST, W. M.
SKAGIT COUNTY, WASH.

SCALE, 1 INCH–400 FEET

A. E. STEWART COUNTY ENGINEER

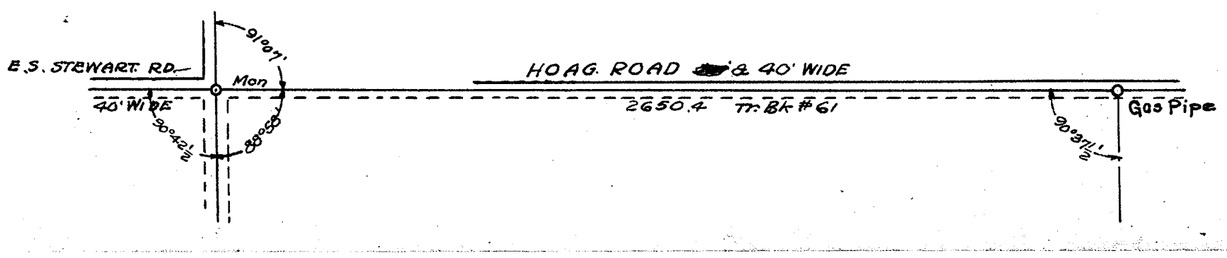


SECTION 8

TOWNSHIP 34 NORTH, RANGE 4 EAST, W. M.

SKAGIT COUNTY, WASH.

SCALE, 1 INCH--400 FEET

_____ COUNTY ENGINEER

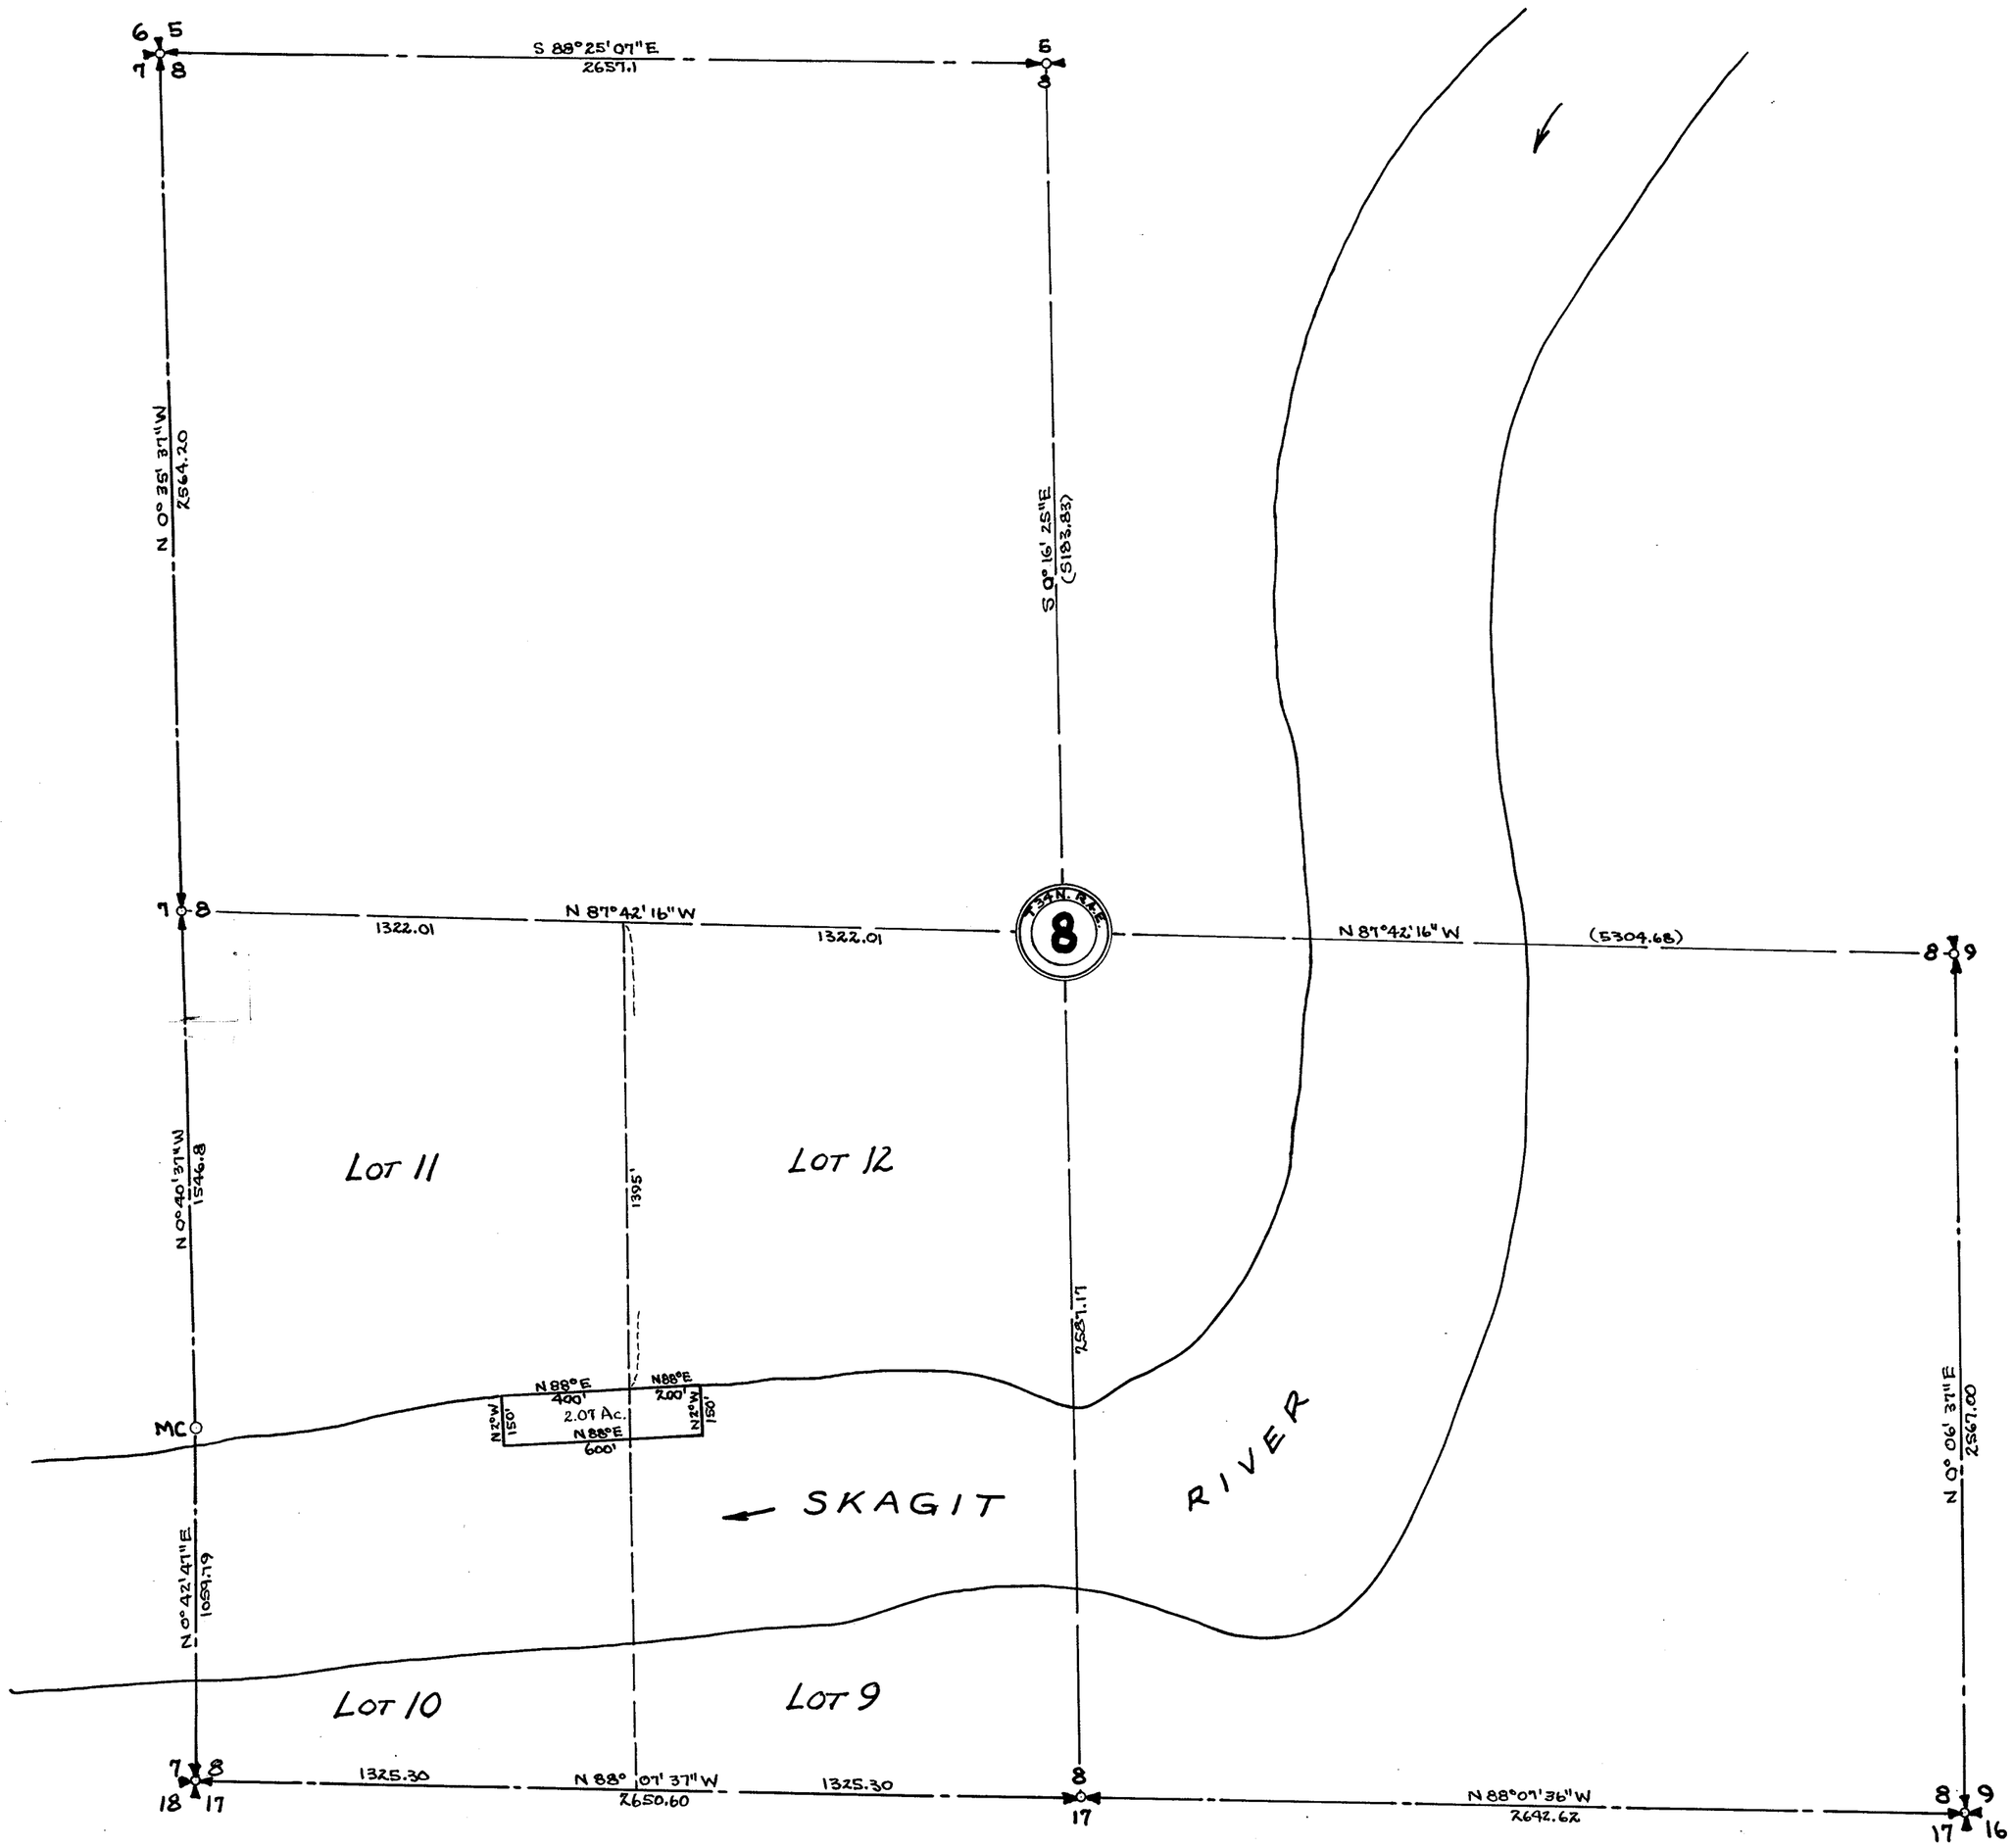

SECTION 8


TOWNSHIP 34 NORTH, RANGE 4 EAST, W. M.

SKAGIT COUNTY, WASH.

SCALE, 1 INCH--400 FEET

DATE July, 1959

Frank Gilkey COUNTY ENGINEER

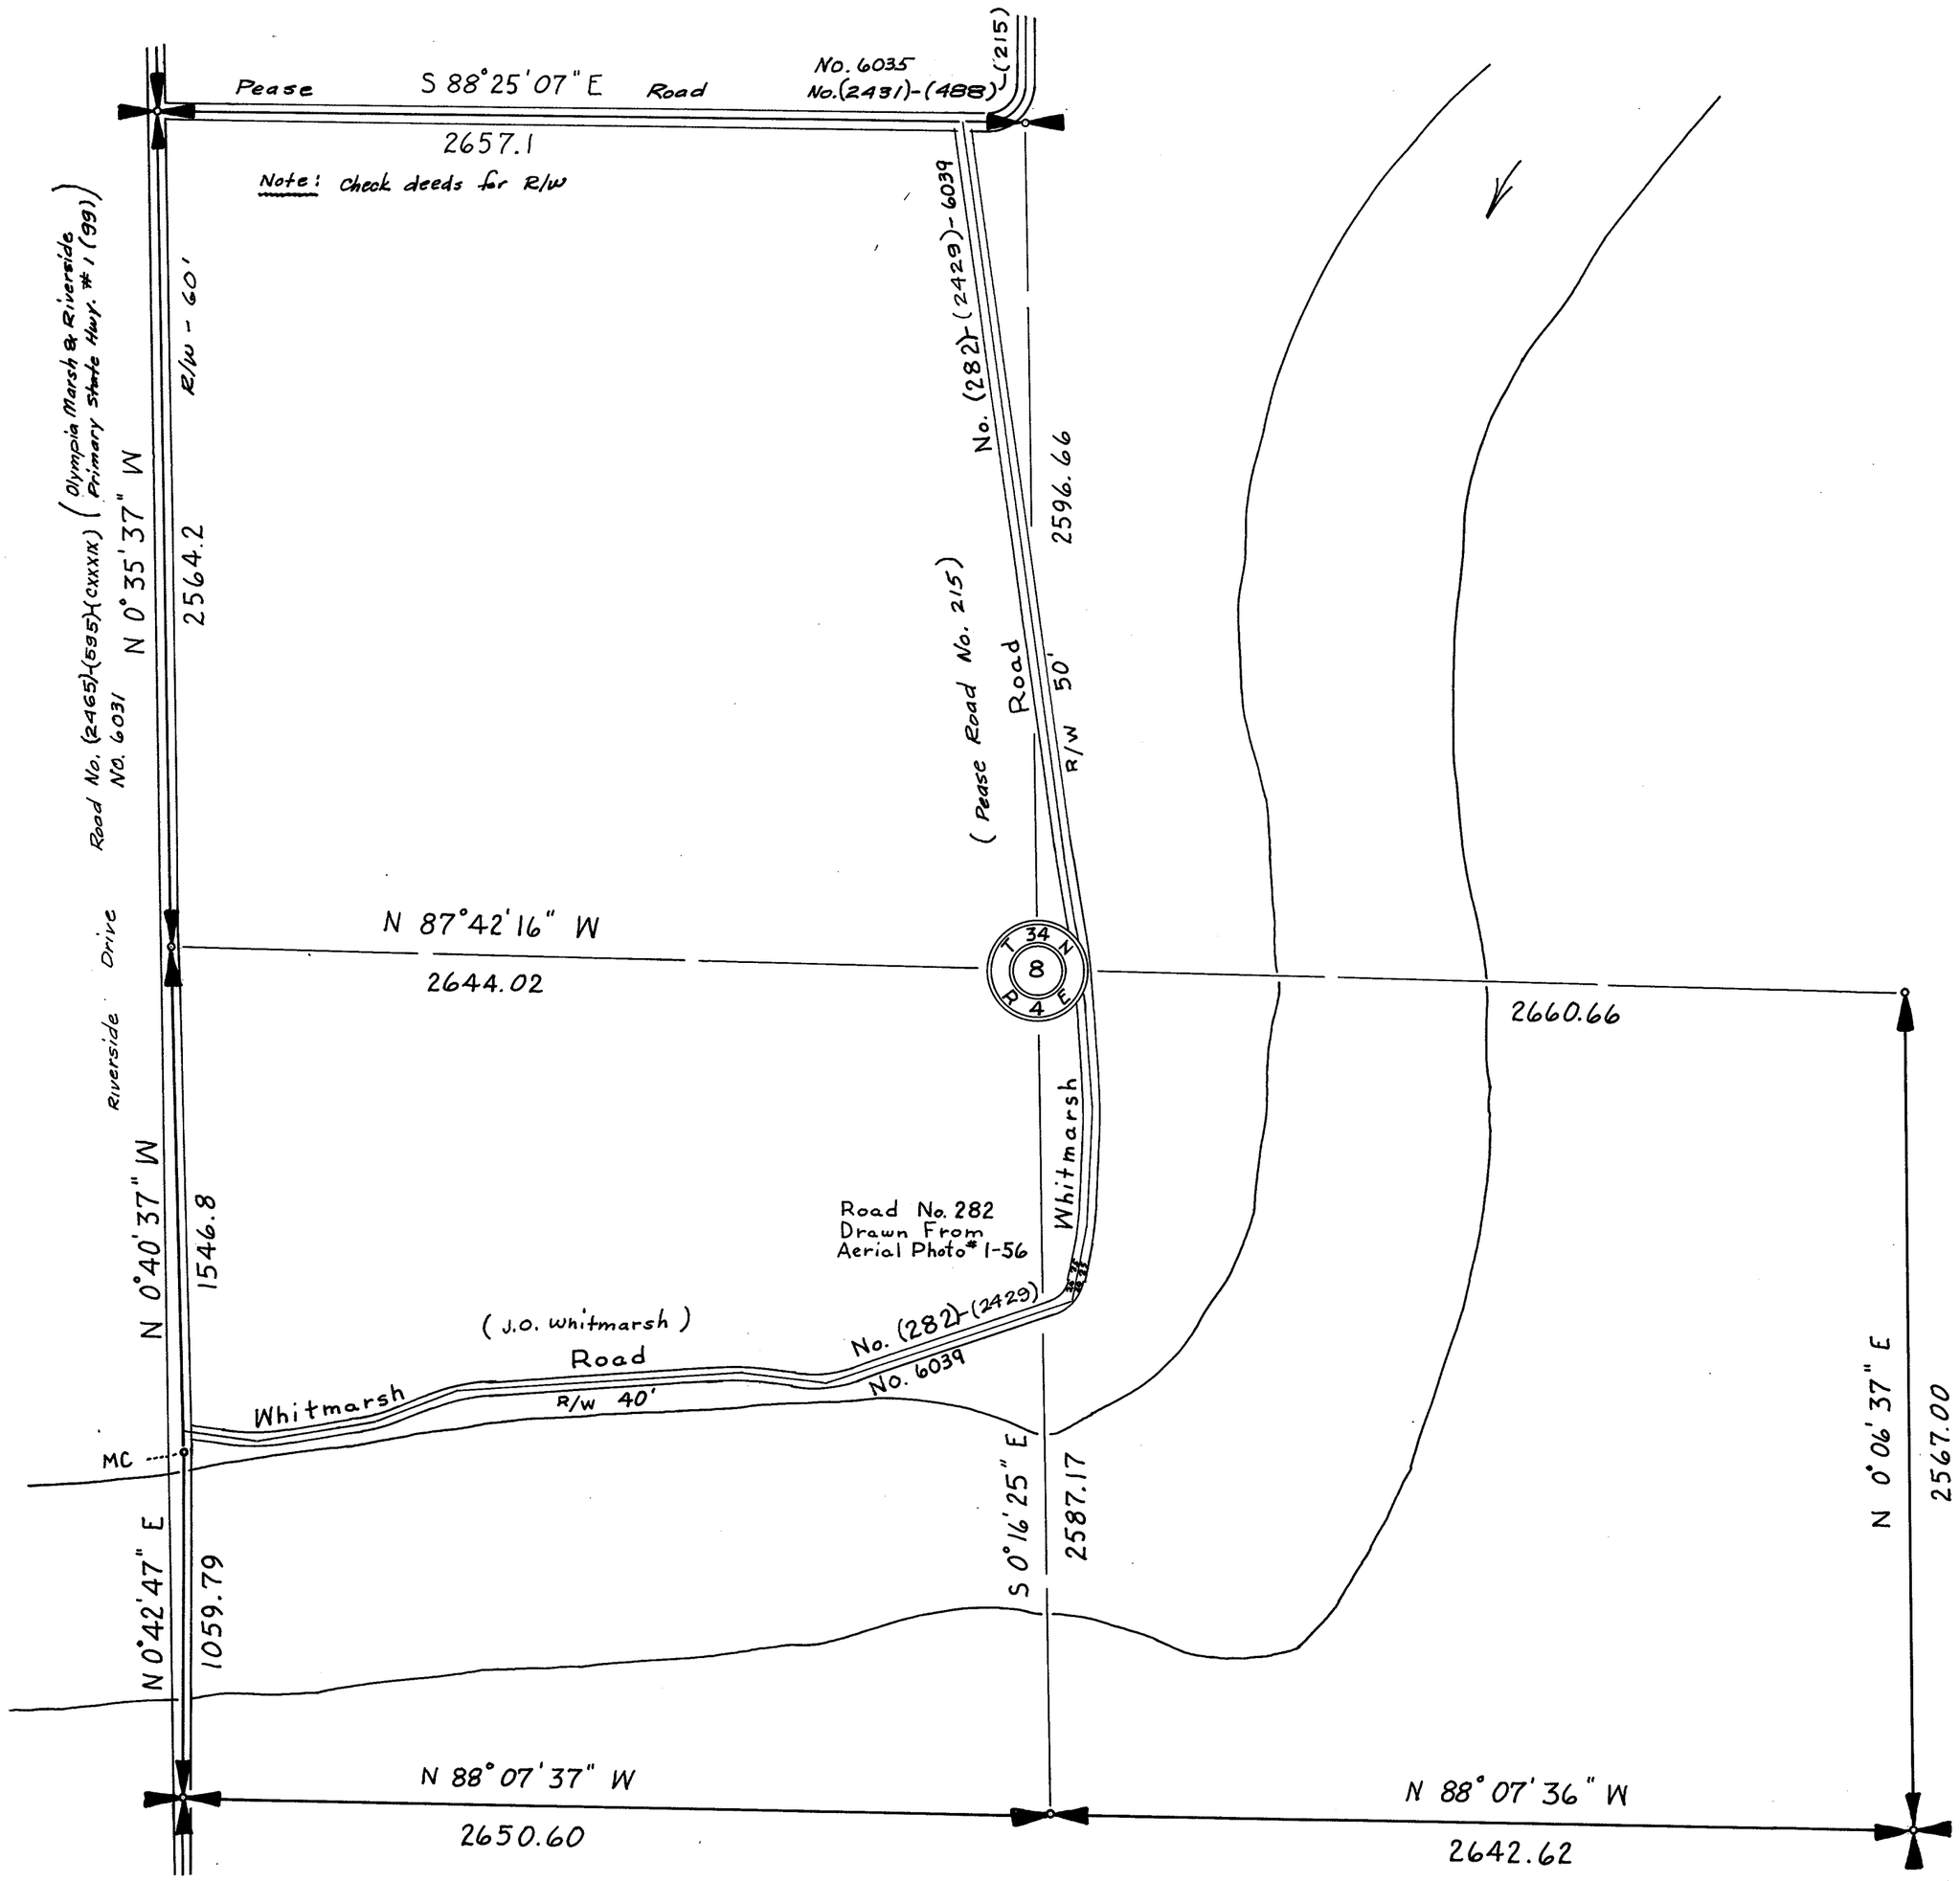



TOWNSHIP 34 NORTH, RANGE 4 EAST, W. M.

SKAGIT COUNTY, WASH.

SCALE, 1 INCH--400 FEET

DATE August, 1959 Frank Gilkey COUNTY ENGINEER

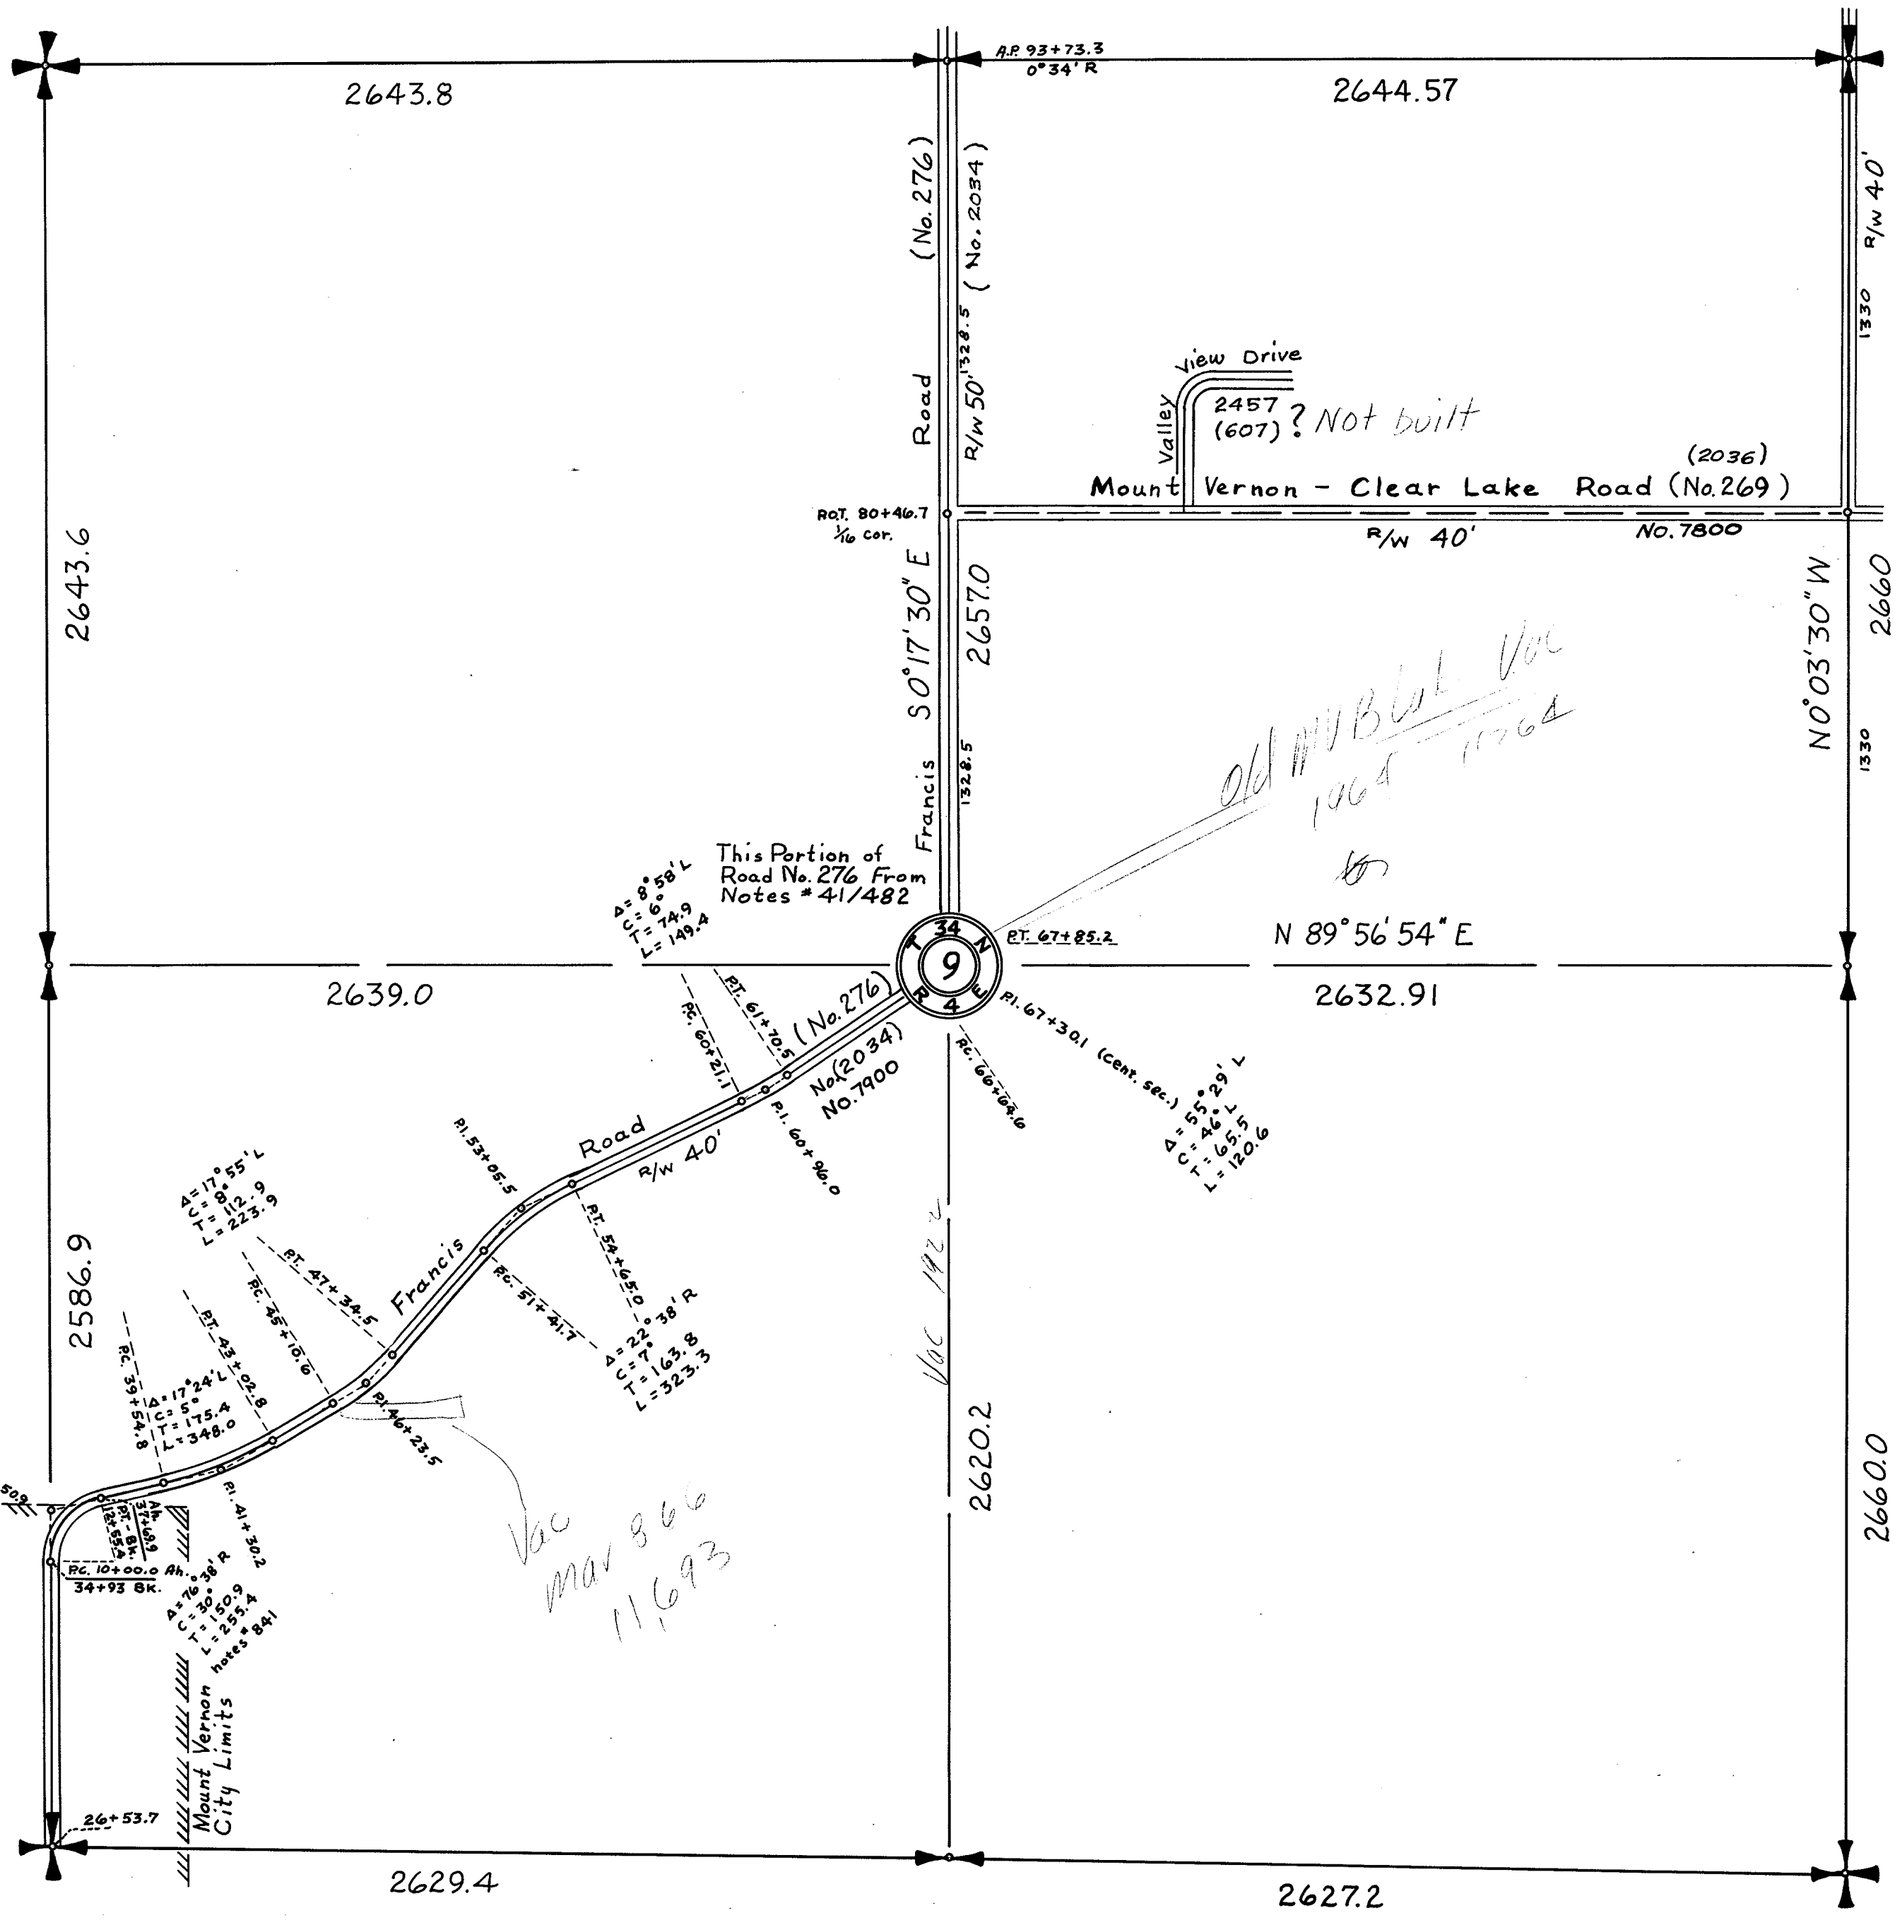


SECTION 9

TOWNSHIP 34 NORTH, RANGE 4 EAST, W. M.

SKAGIT COUNTY, WASH.

SCALE, 1 INCH–400 FEET

Arthur L. Strong COUNTY ENGINEER

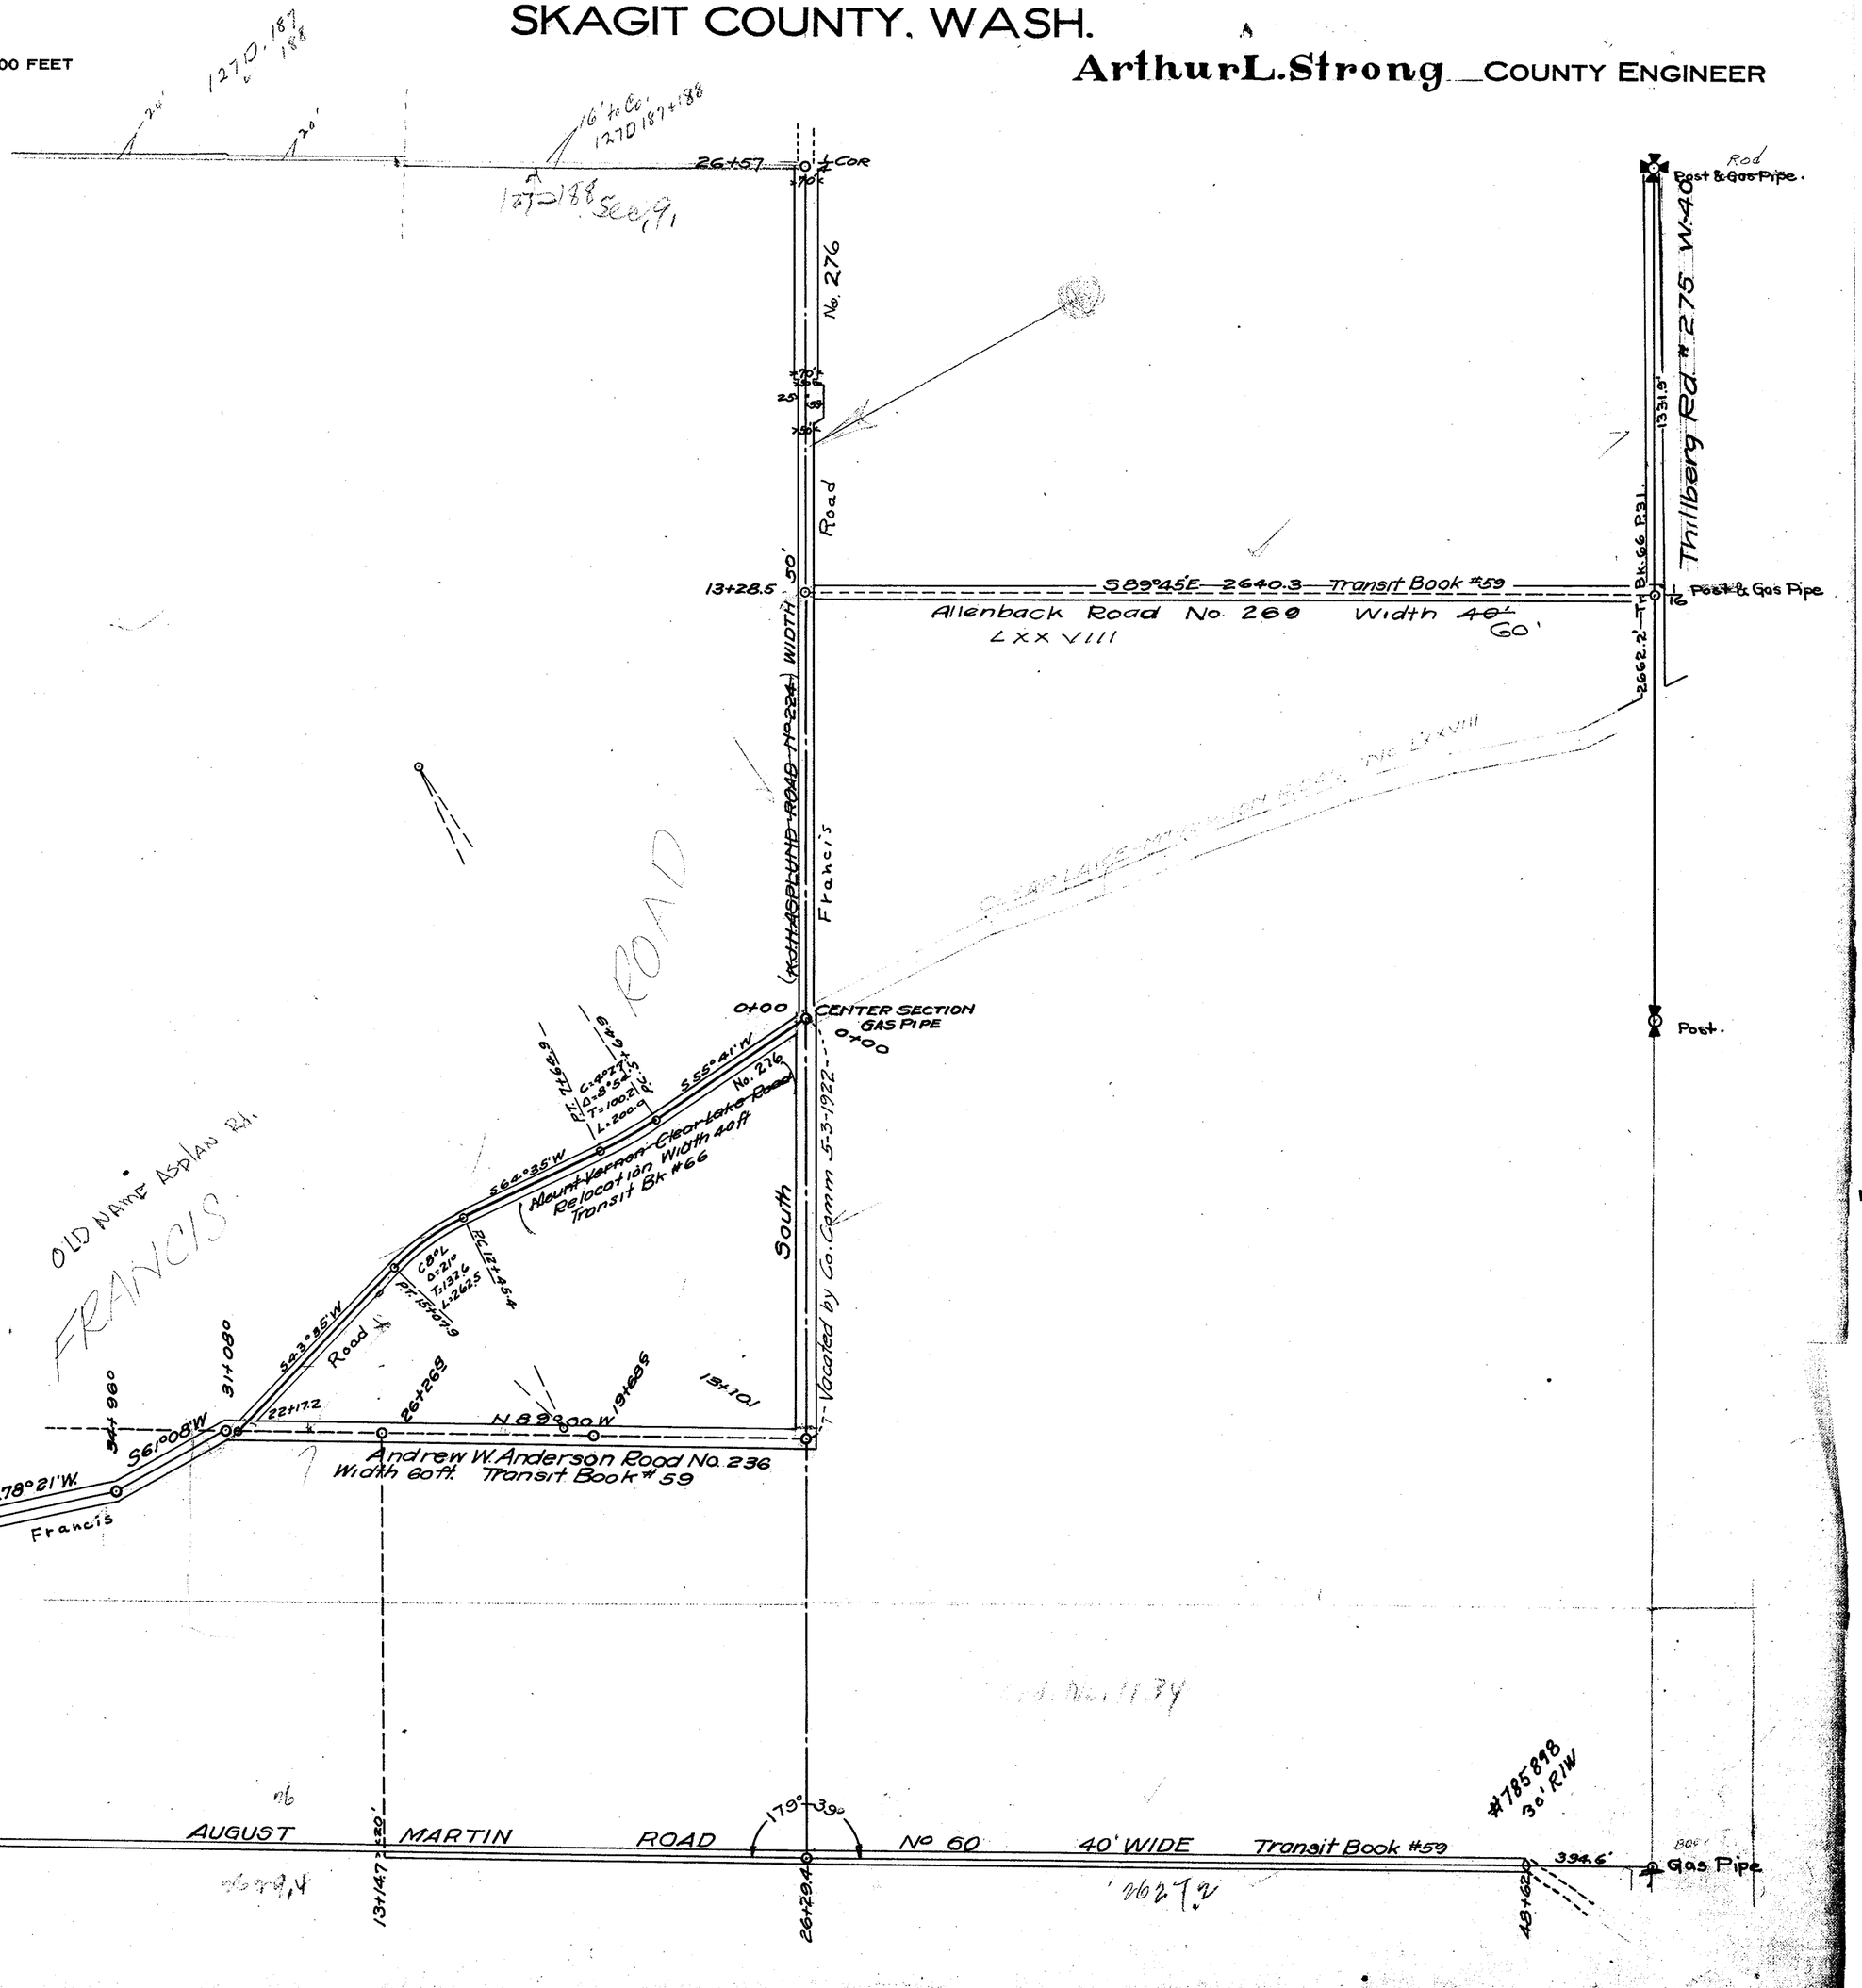


SECTION 9

TOWNSHIP 34 NORTH, RANGE 4 EAST, W. M.
SKAGIT COUNTY, WASH.

SCALE, 1 INCH–400 FEET


_____ COUNTY ENGINEER

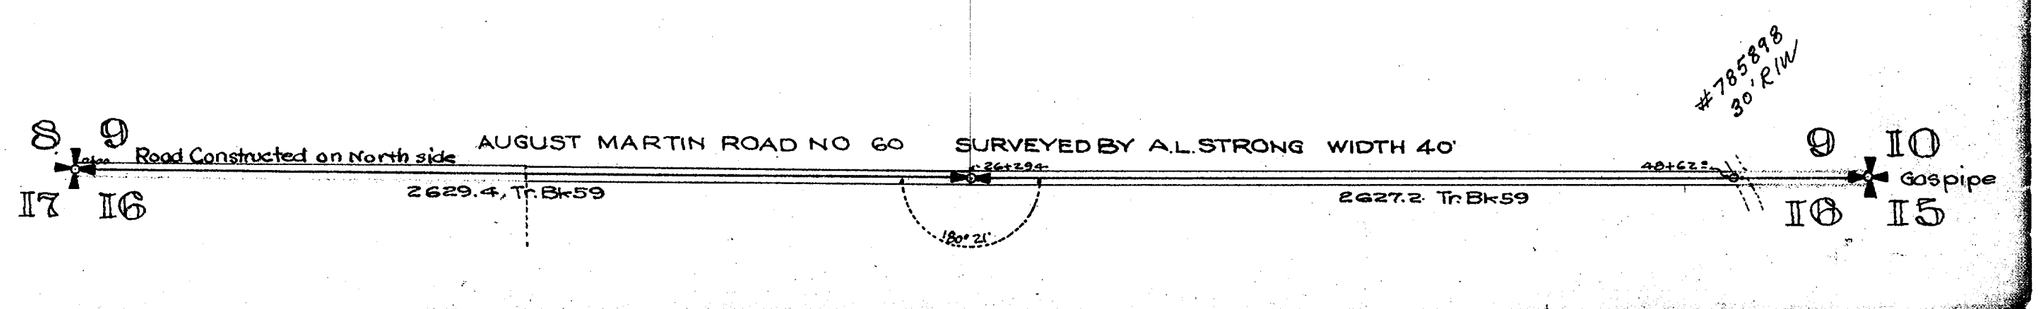

SECTION 10
TOWNSHIP 34 NORTH, RANGE 4 EAST, W. M.
SKAGIT COUNTY, WASH.

SCALE, 1 INCH--400 FEET

DATE August, 1959 Frank Gilkey COUNTY ENGINEER

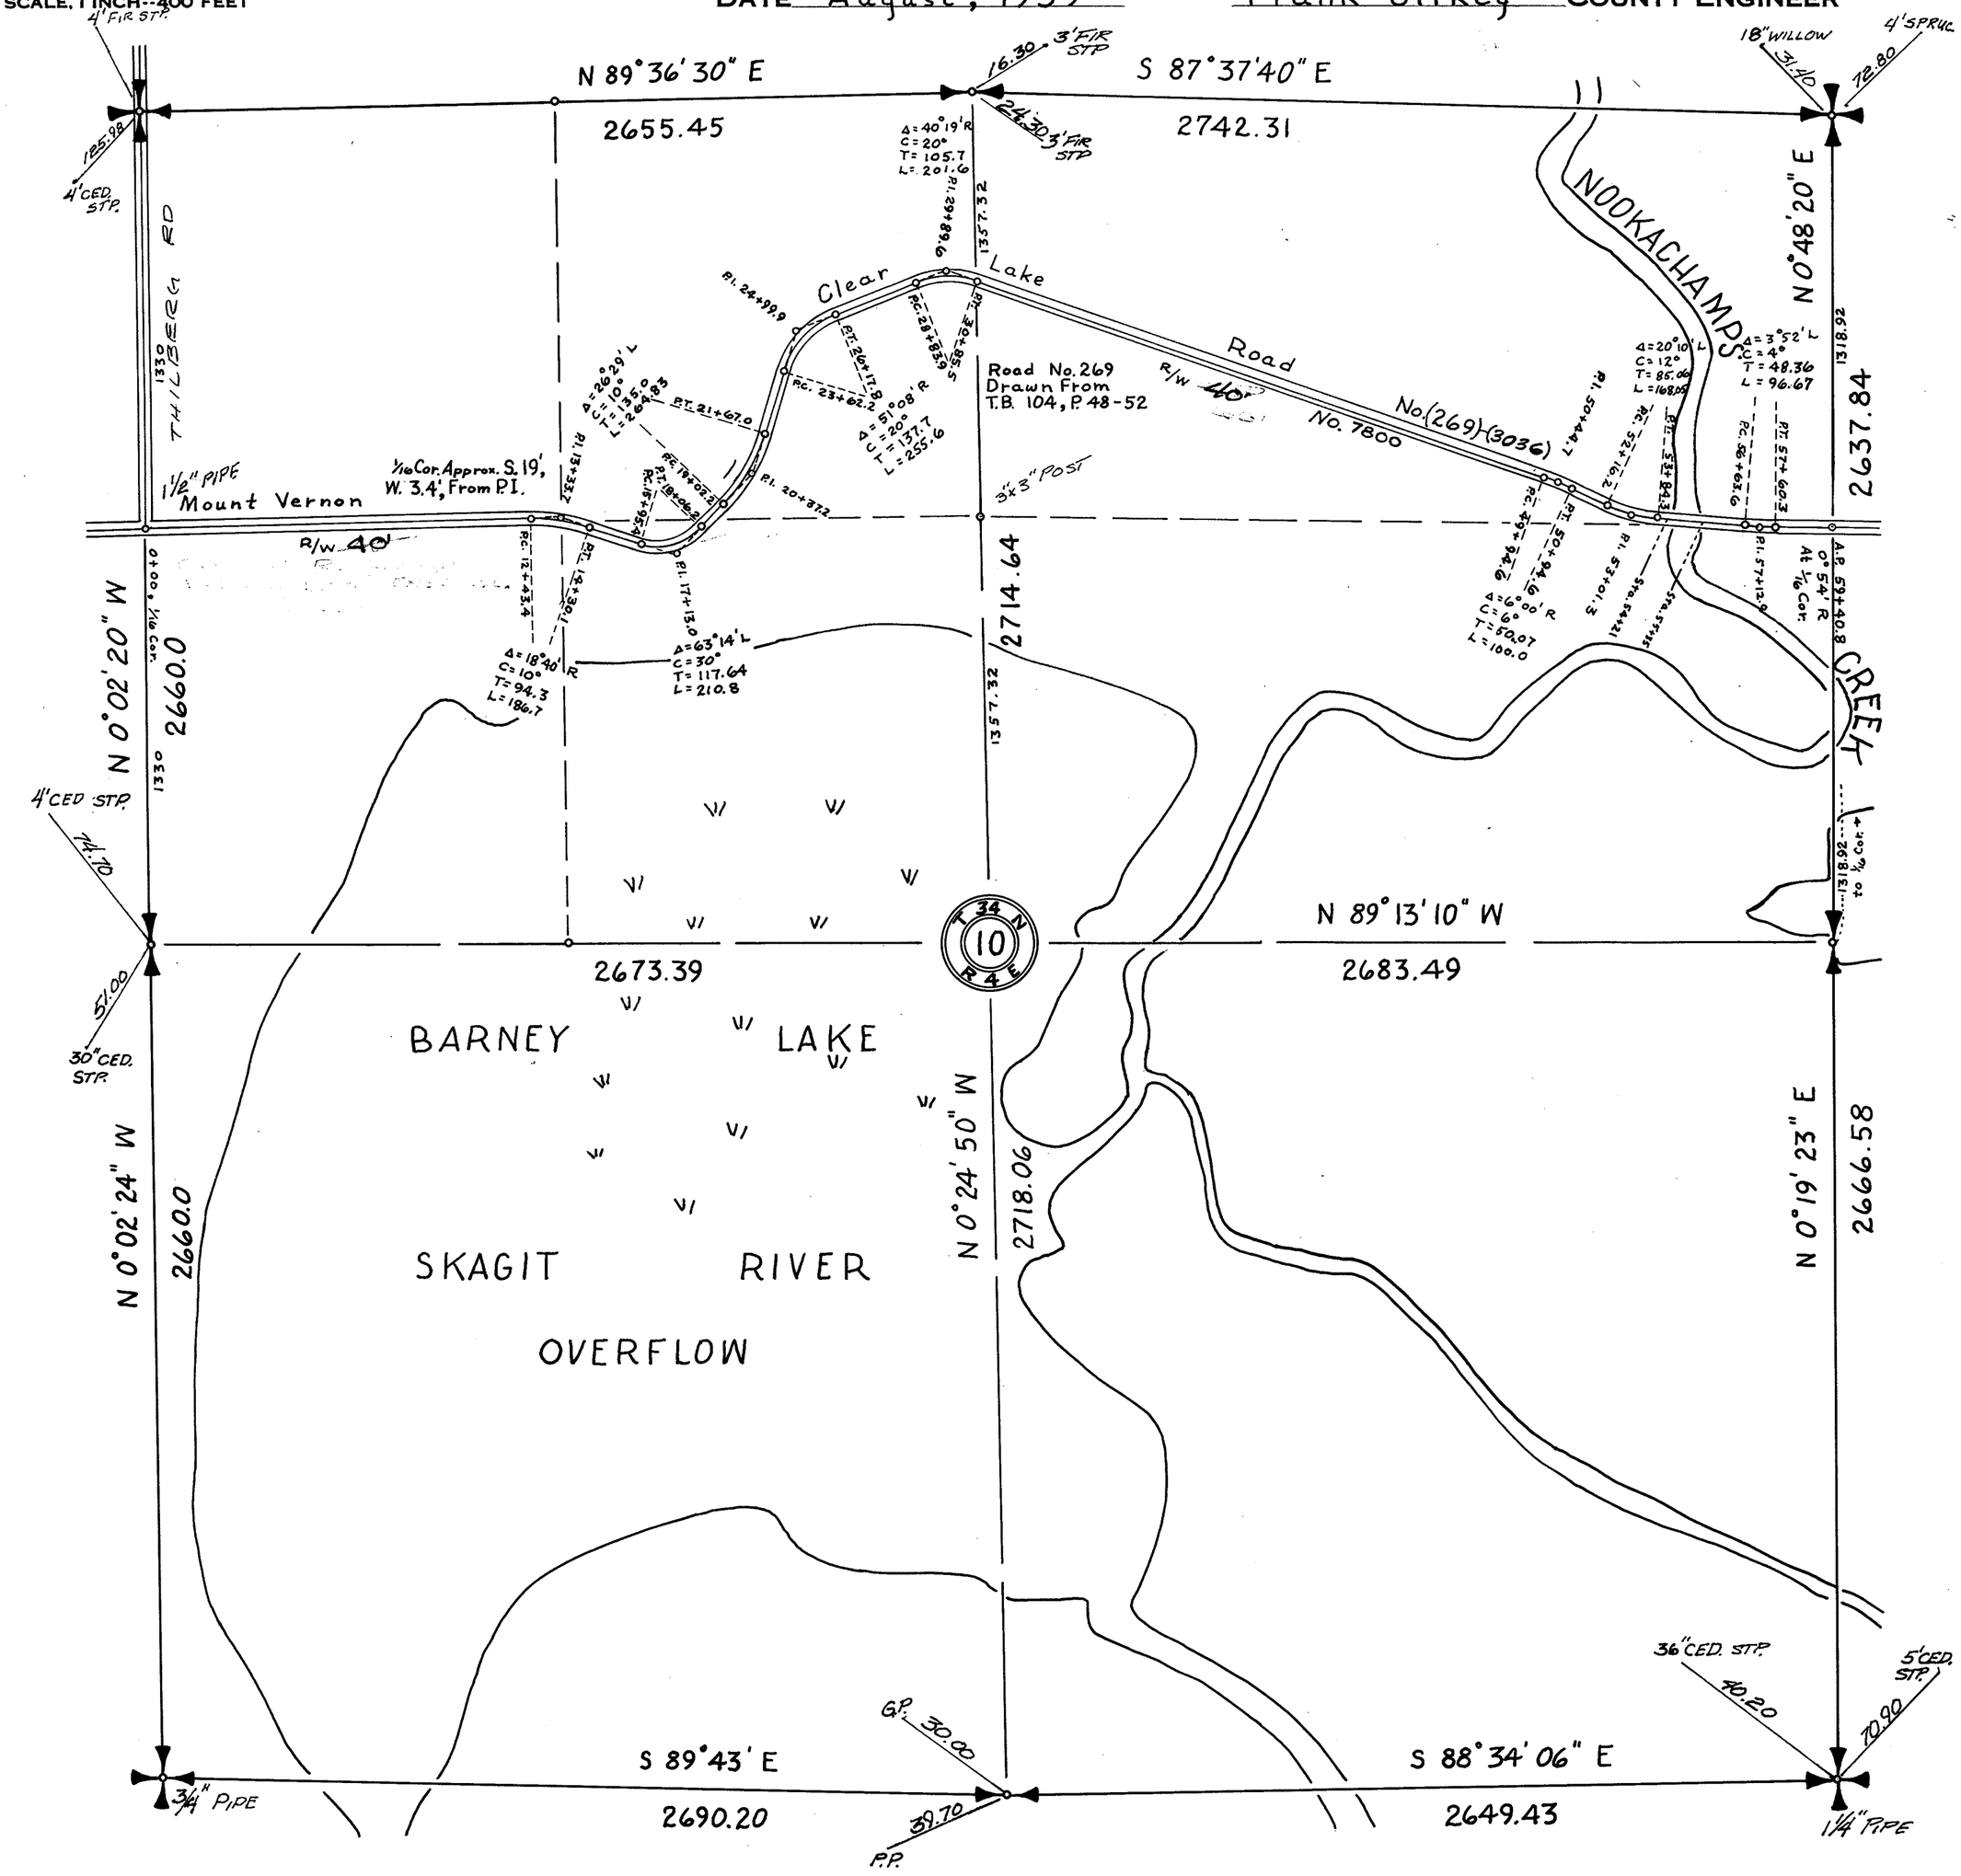


SECTION 10

TOWNSHIP 34 NORTH, RANGE 4 EAST, W. M.

SKAGIT COUNTY, WASH.

SCALE, 1 INCH–400 FEET

W.E. Costello COUNTY ENGINEER

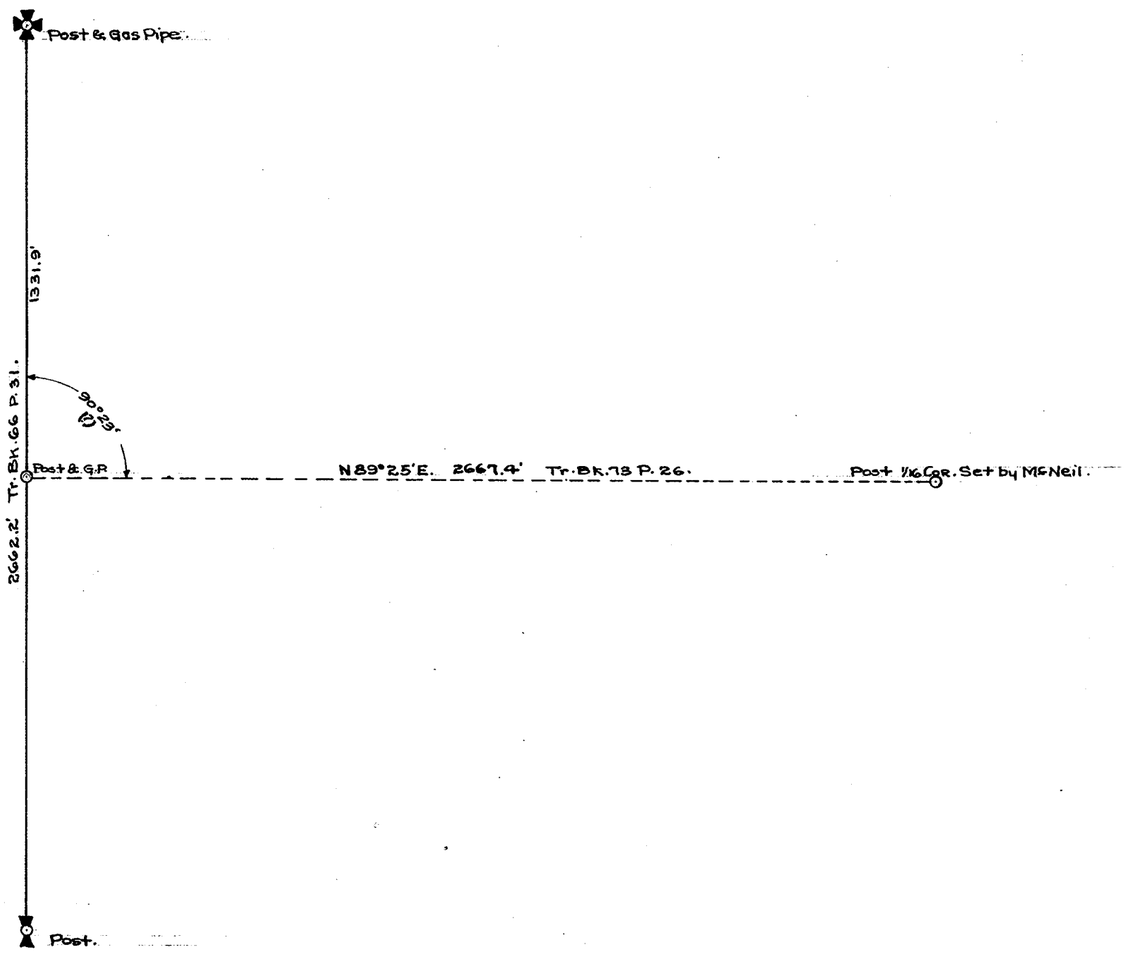

SECTION 10


TOWNSHIP 34 NORTH, RANGE 4 EAST, W. M.

SKAGIT COUNTY, WASH.

Notes 38/403

SCALE, 1 INCH--400 FEET

H.O. Walberg COUNTY ENGINEER

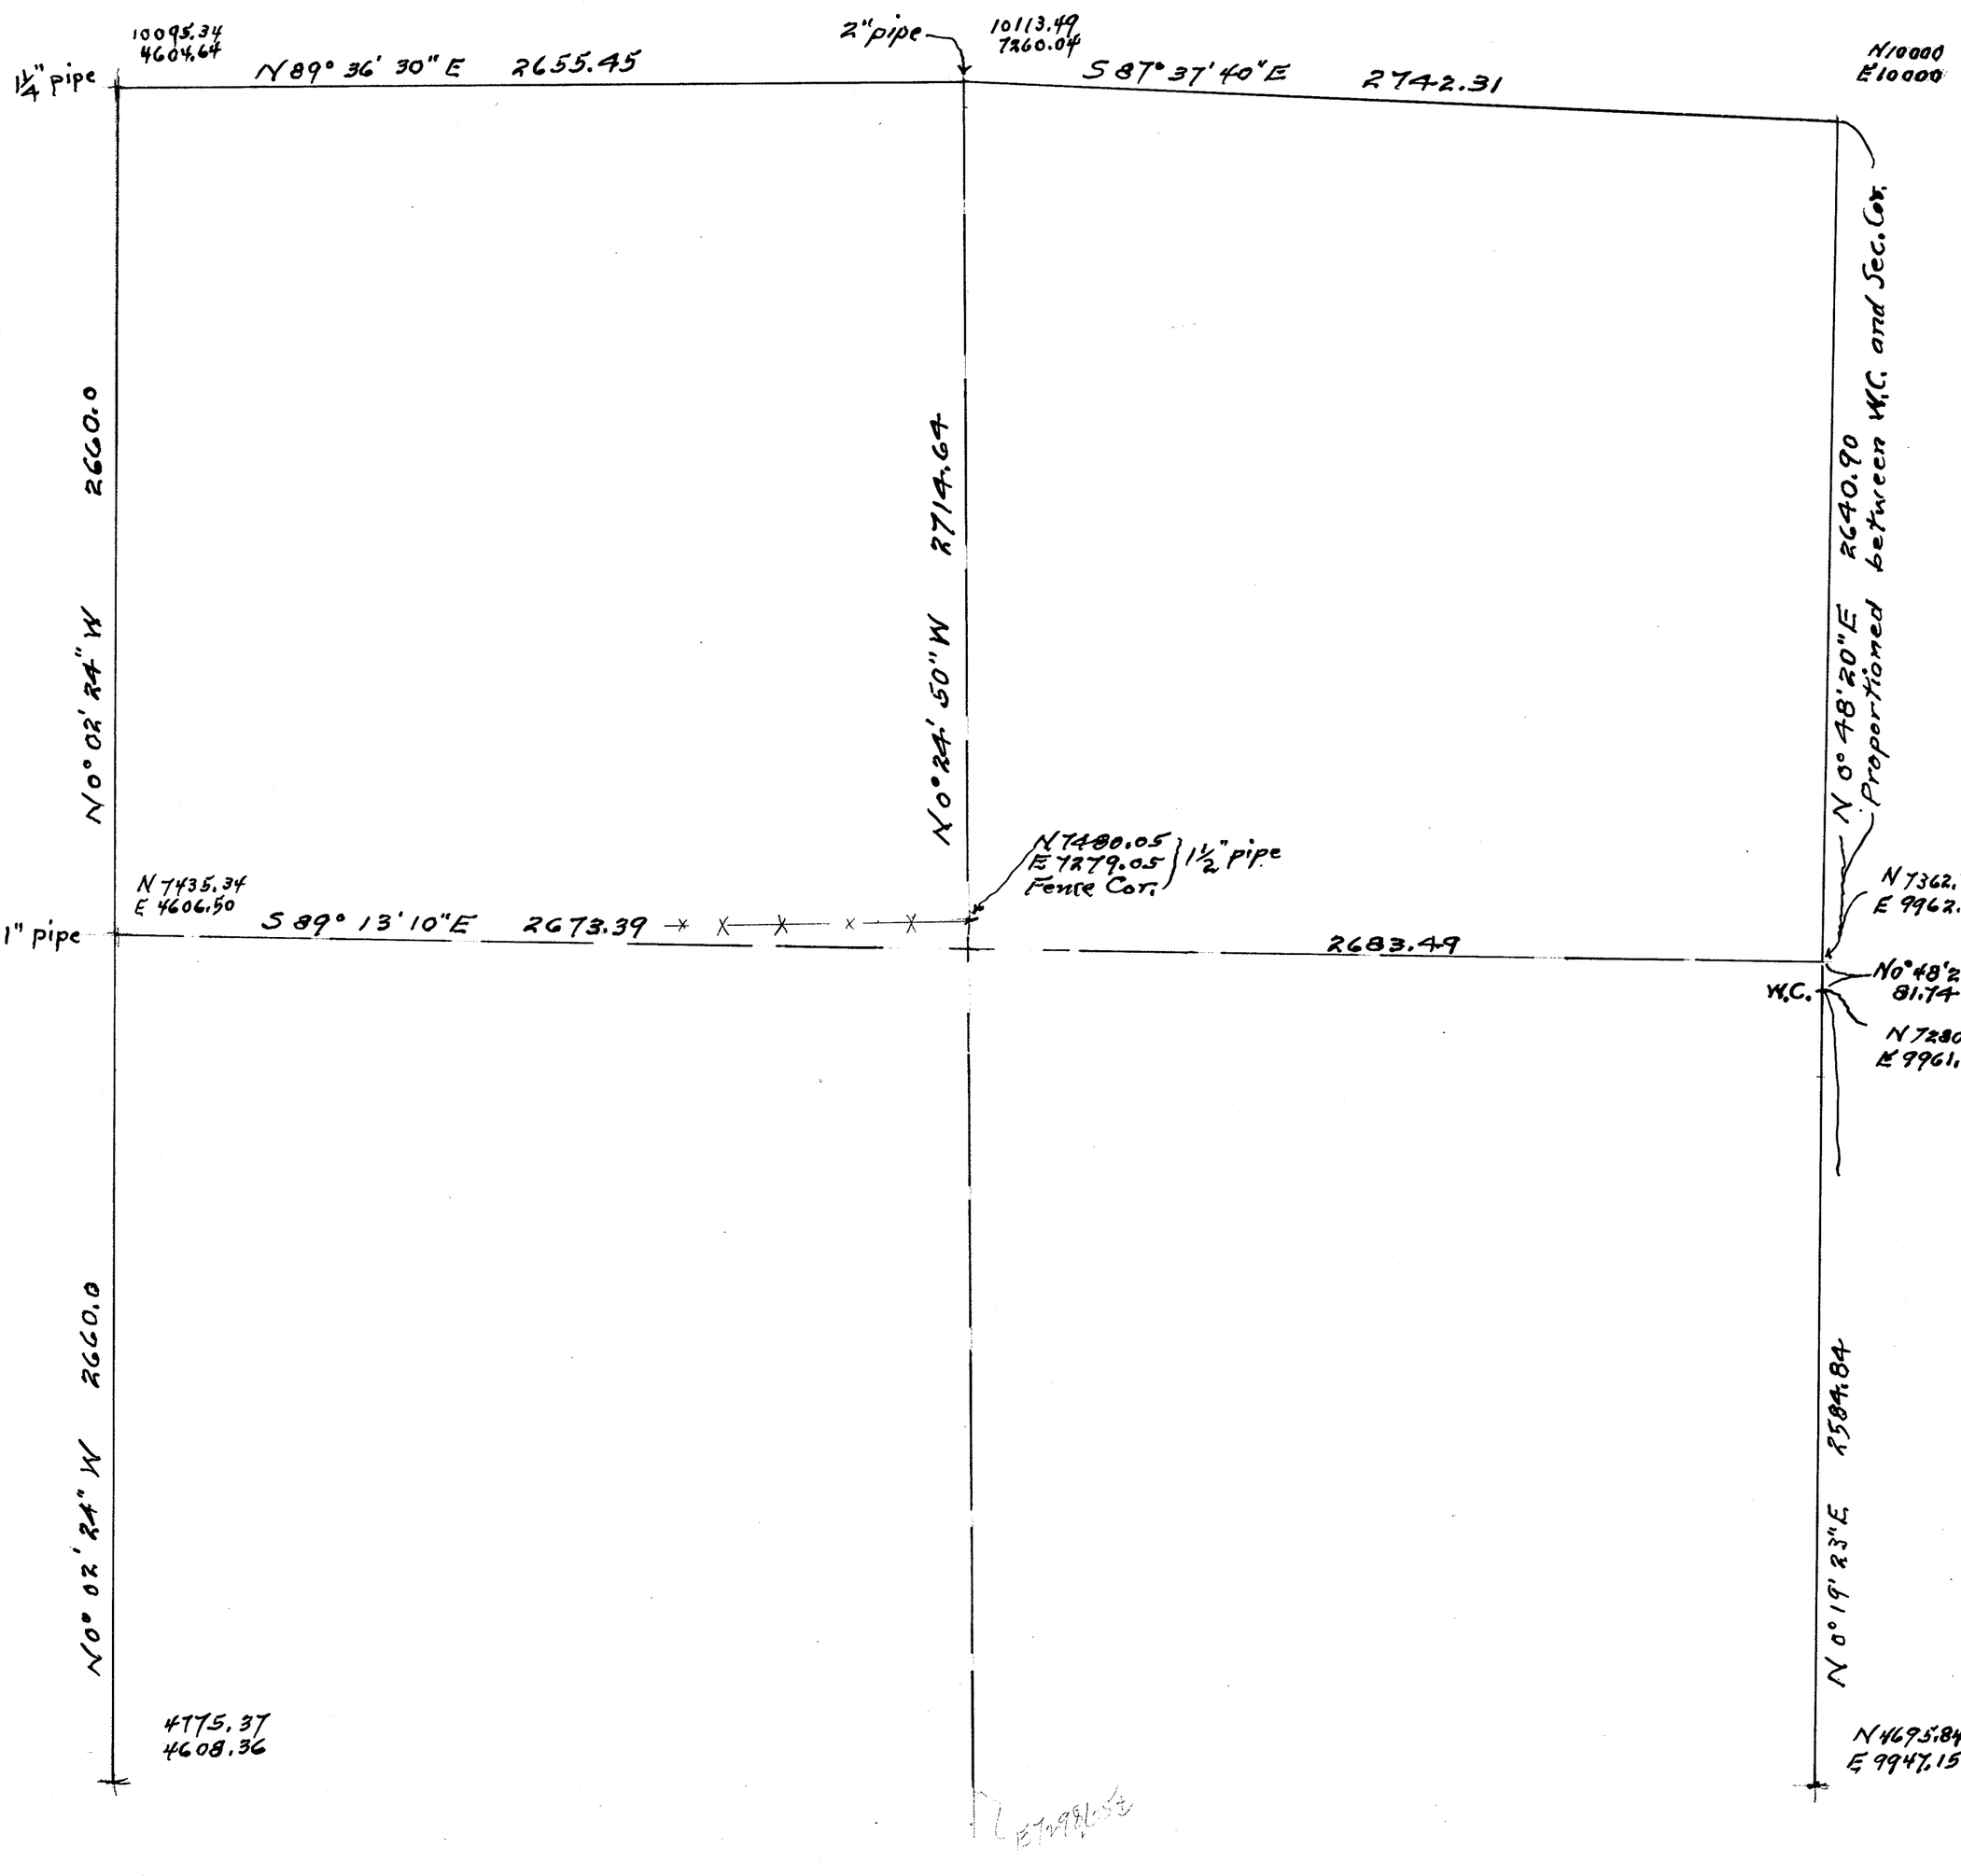

SECTION 10


TOWNSHIP 34 NORTH. RANGE 4 EAST. W. M.

SKAGIT COUNTY. WASH.

SCALE, 1 INCH—400 FEET

LLOYD H. JOHNSON COUNTY ENGINEER

DATE OCTOBER, 1976

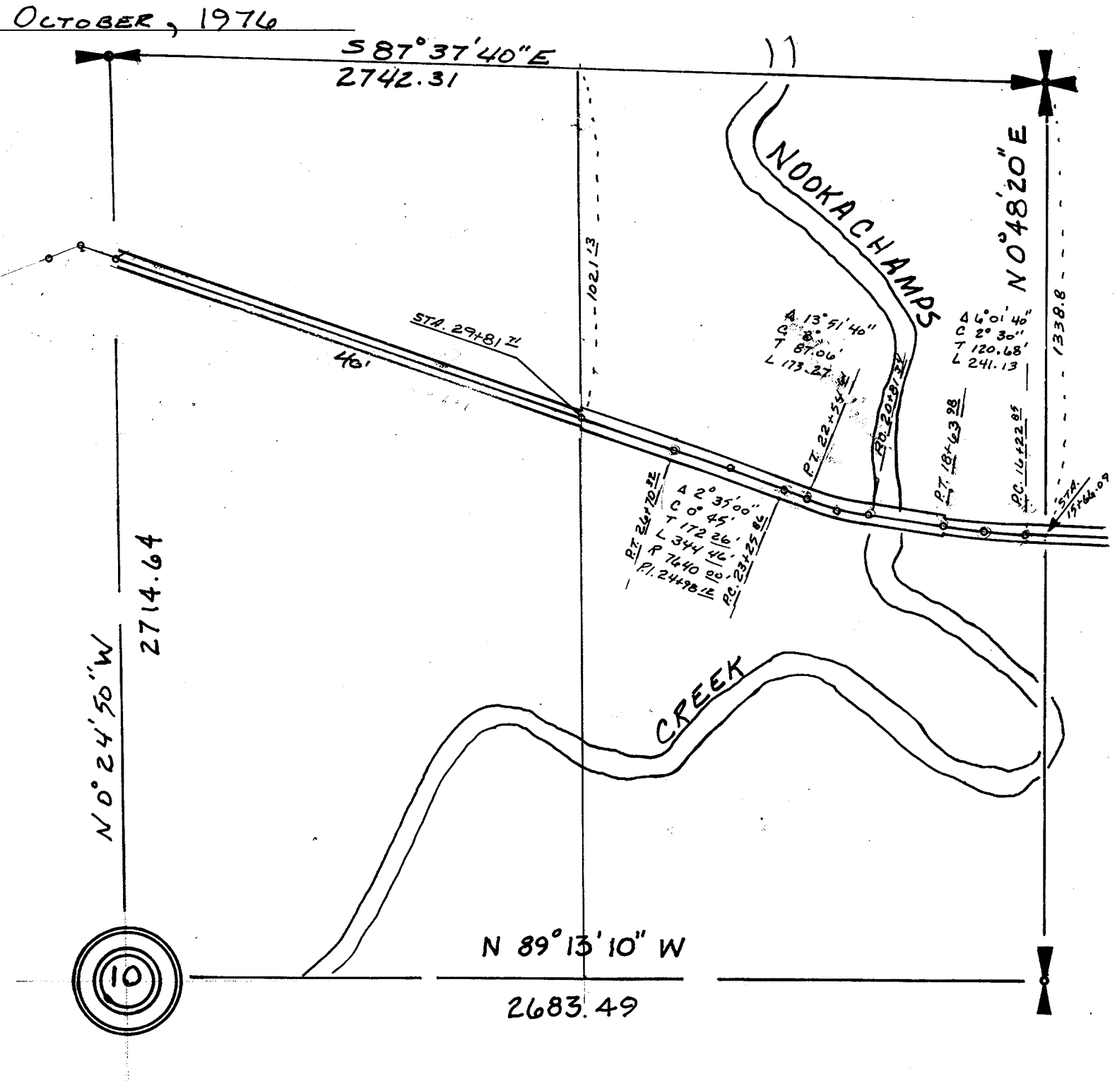


SECTION 11

TOWNSHIP 34 NORTH, RANGE 4 EAST, W. M.

SKAGIT COUNTY, WASH.

SCALE, 1 INCH--400 FEET

DATE September, 1959 Frank Gilkey COUNTY ENGINEER

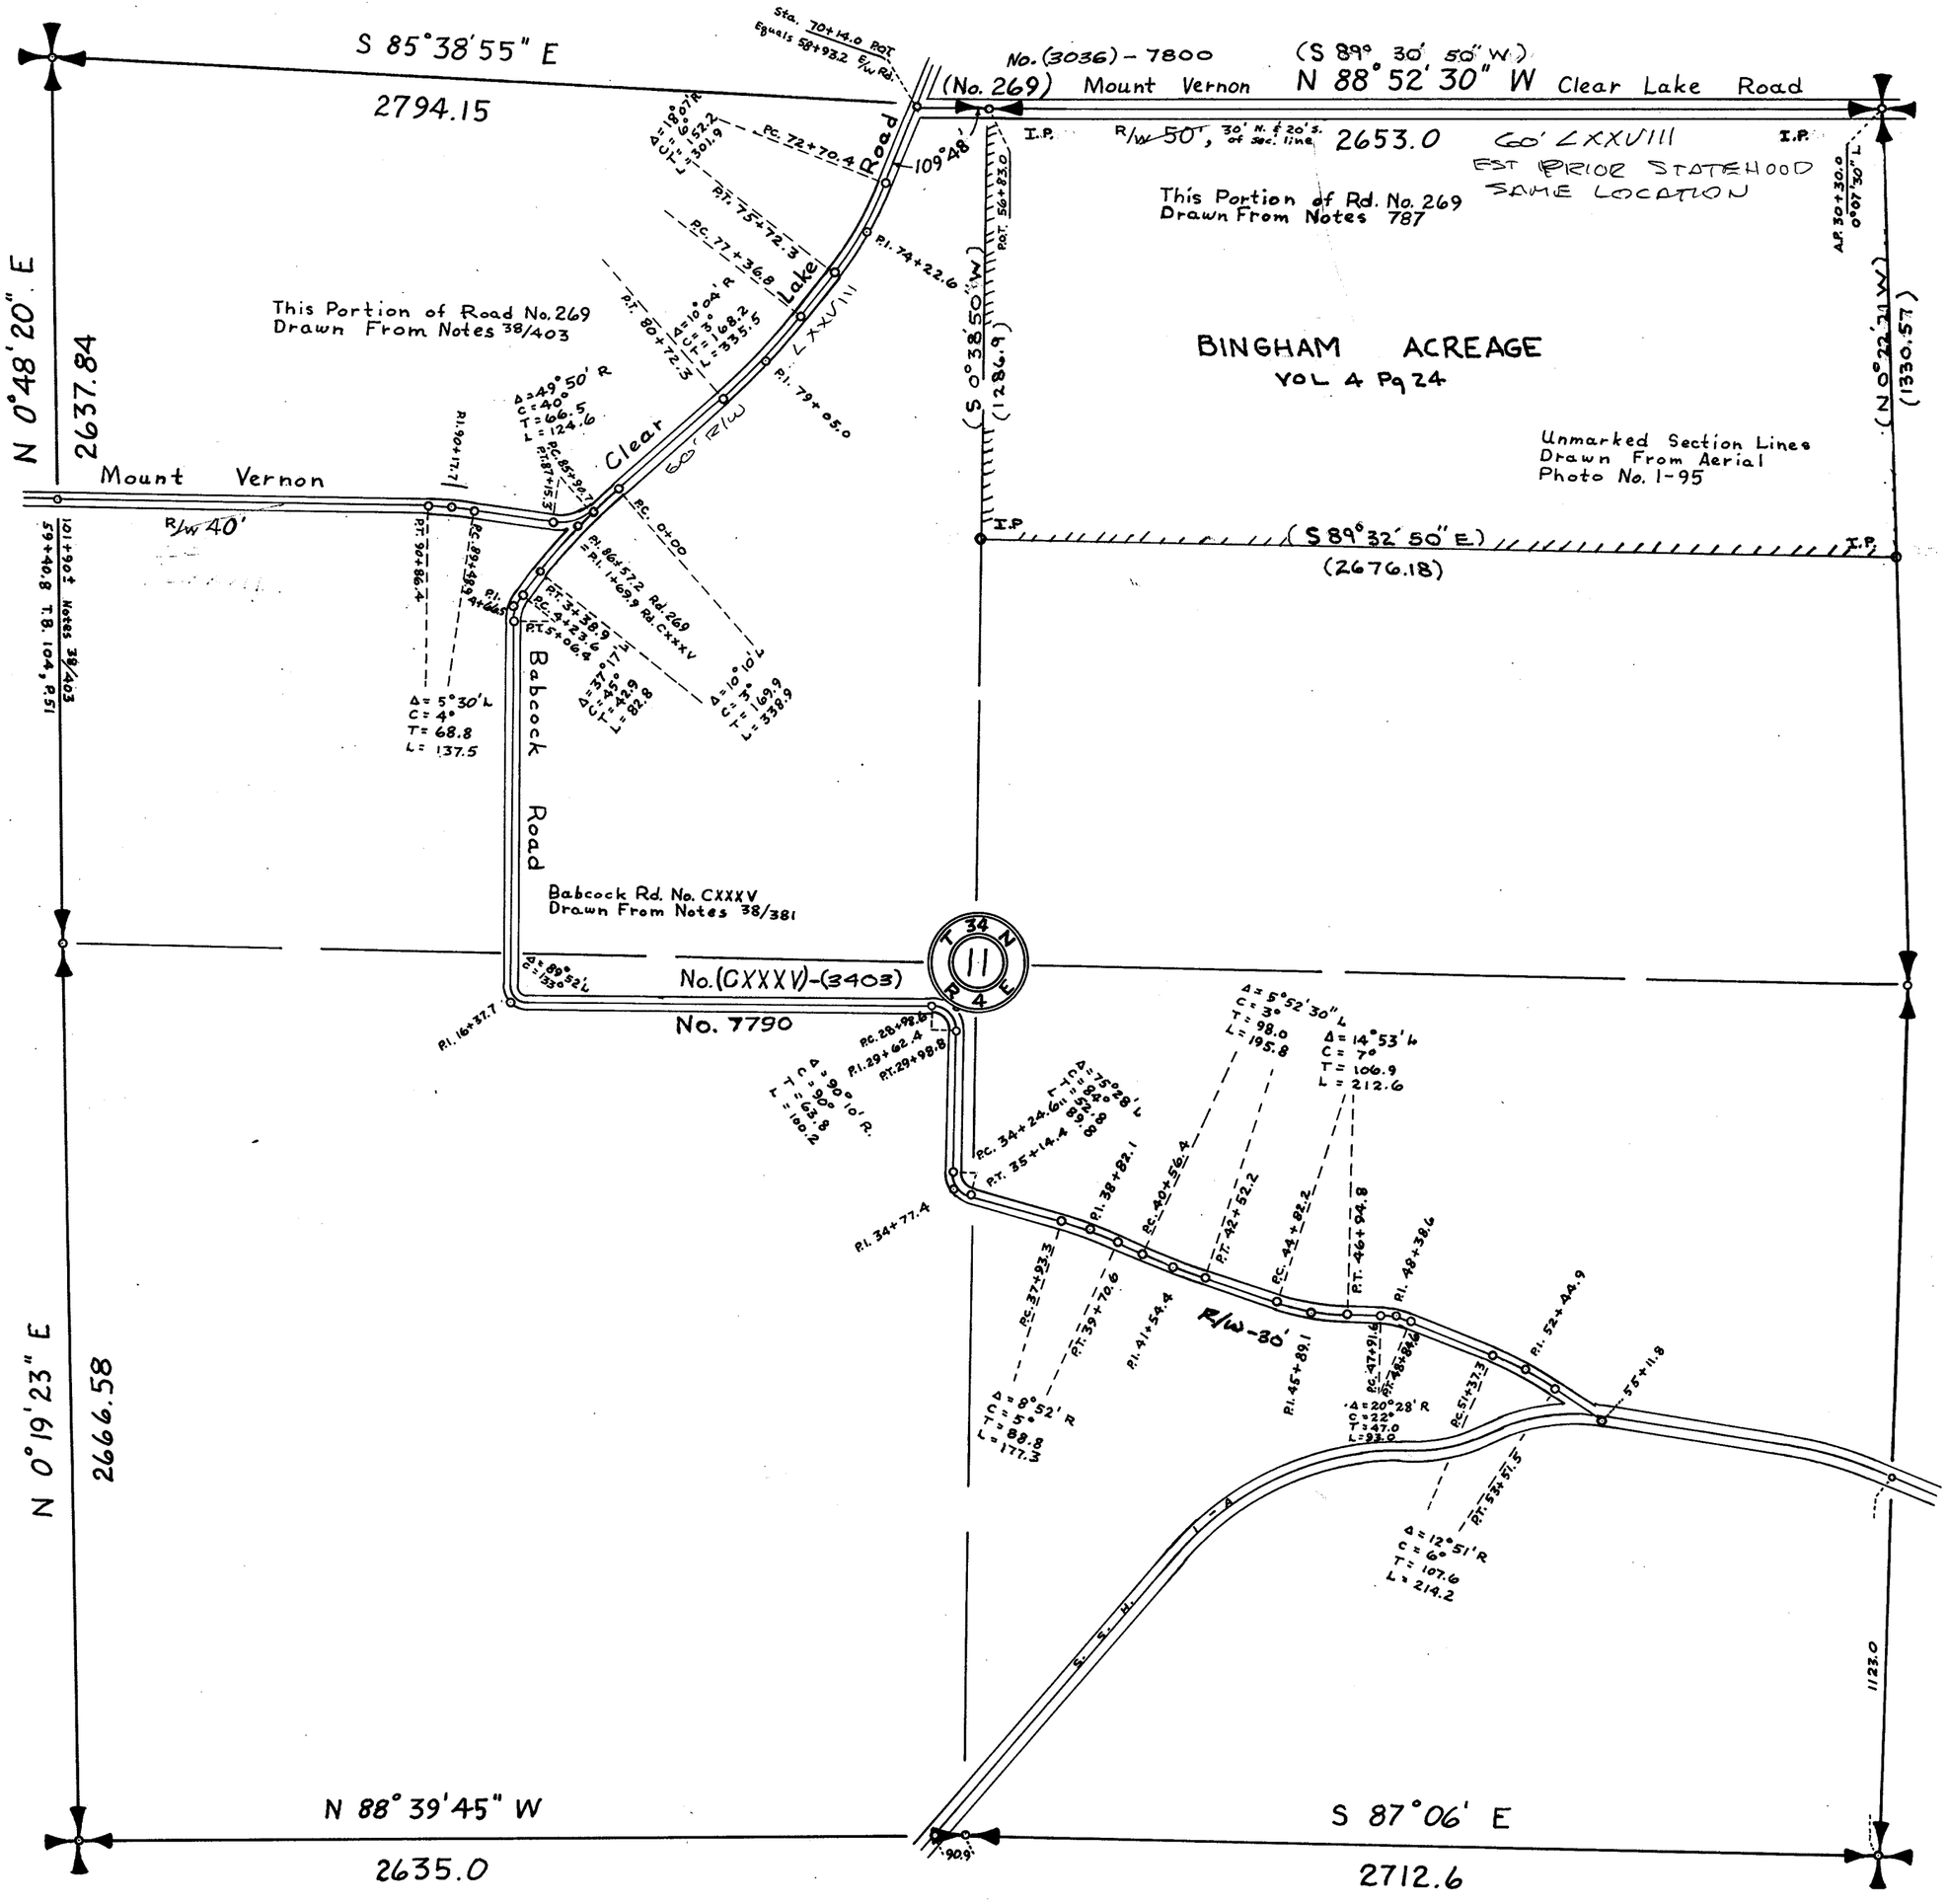


SECTION 12

TOWNSHIP 34 NORTH, RANGE 4 EAST, W. M.

SKAGIT COUNTY, WASH.

SCALE, 1 INCH--400 FEET

DATE September, 1959 Frank Gilkey COUNTY ENGINEER

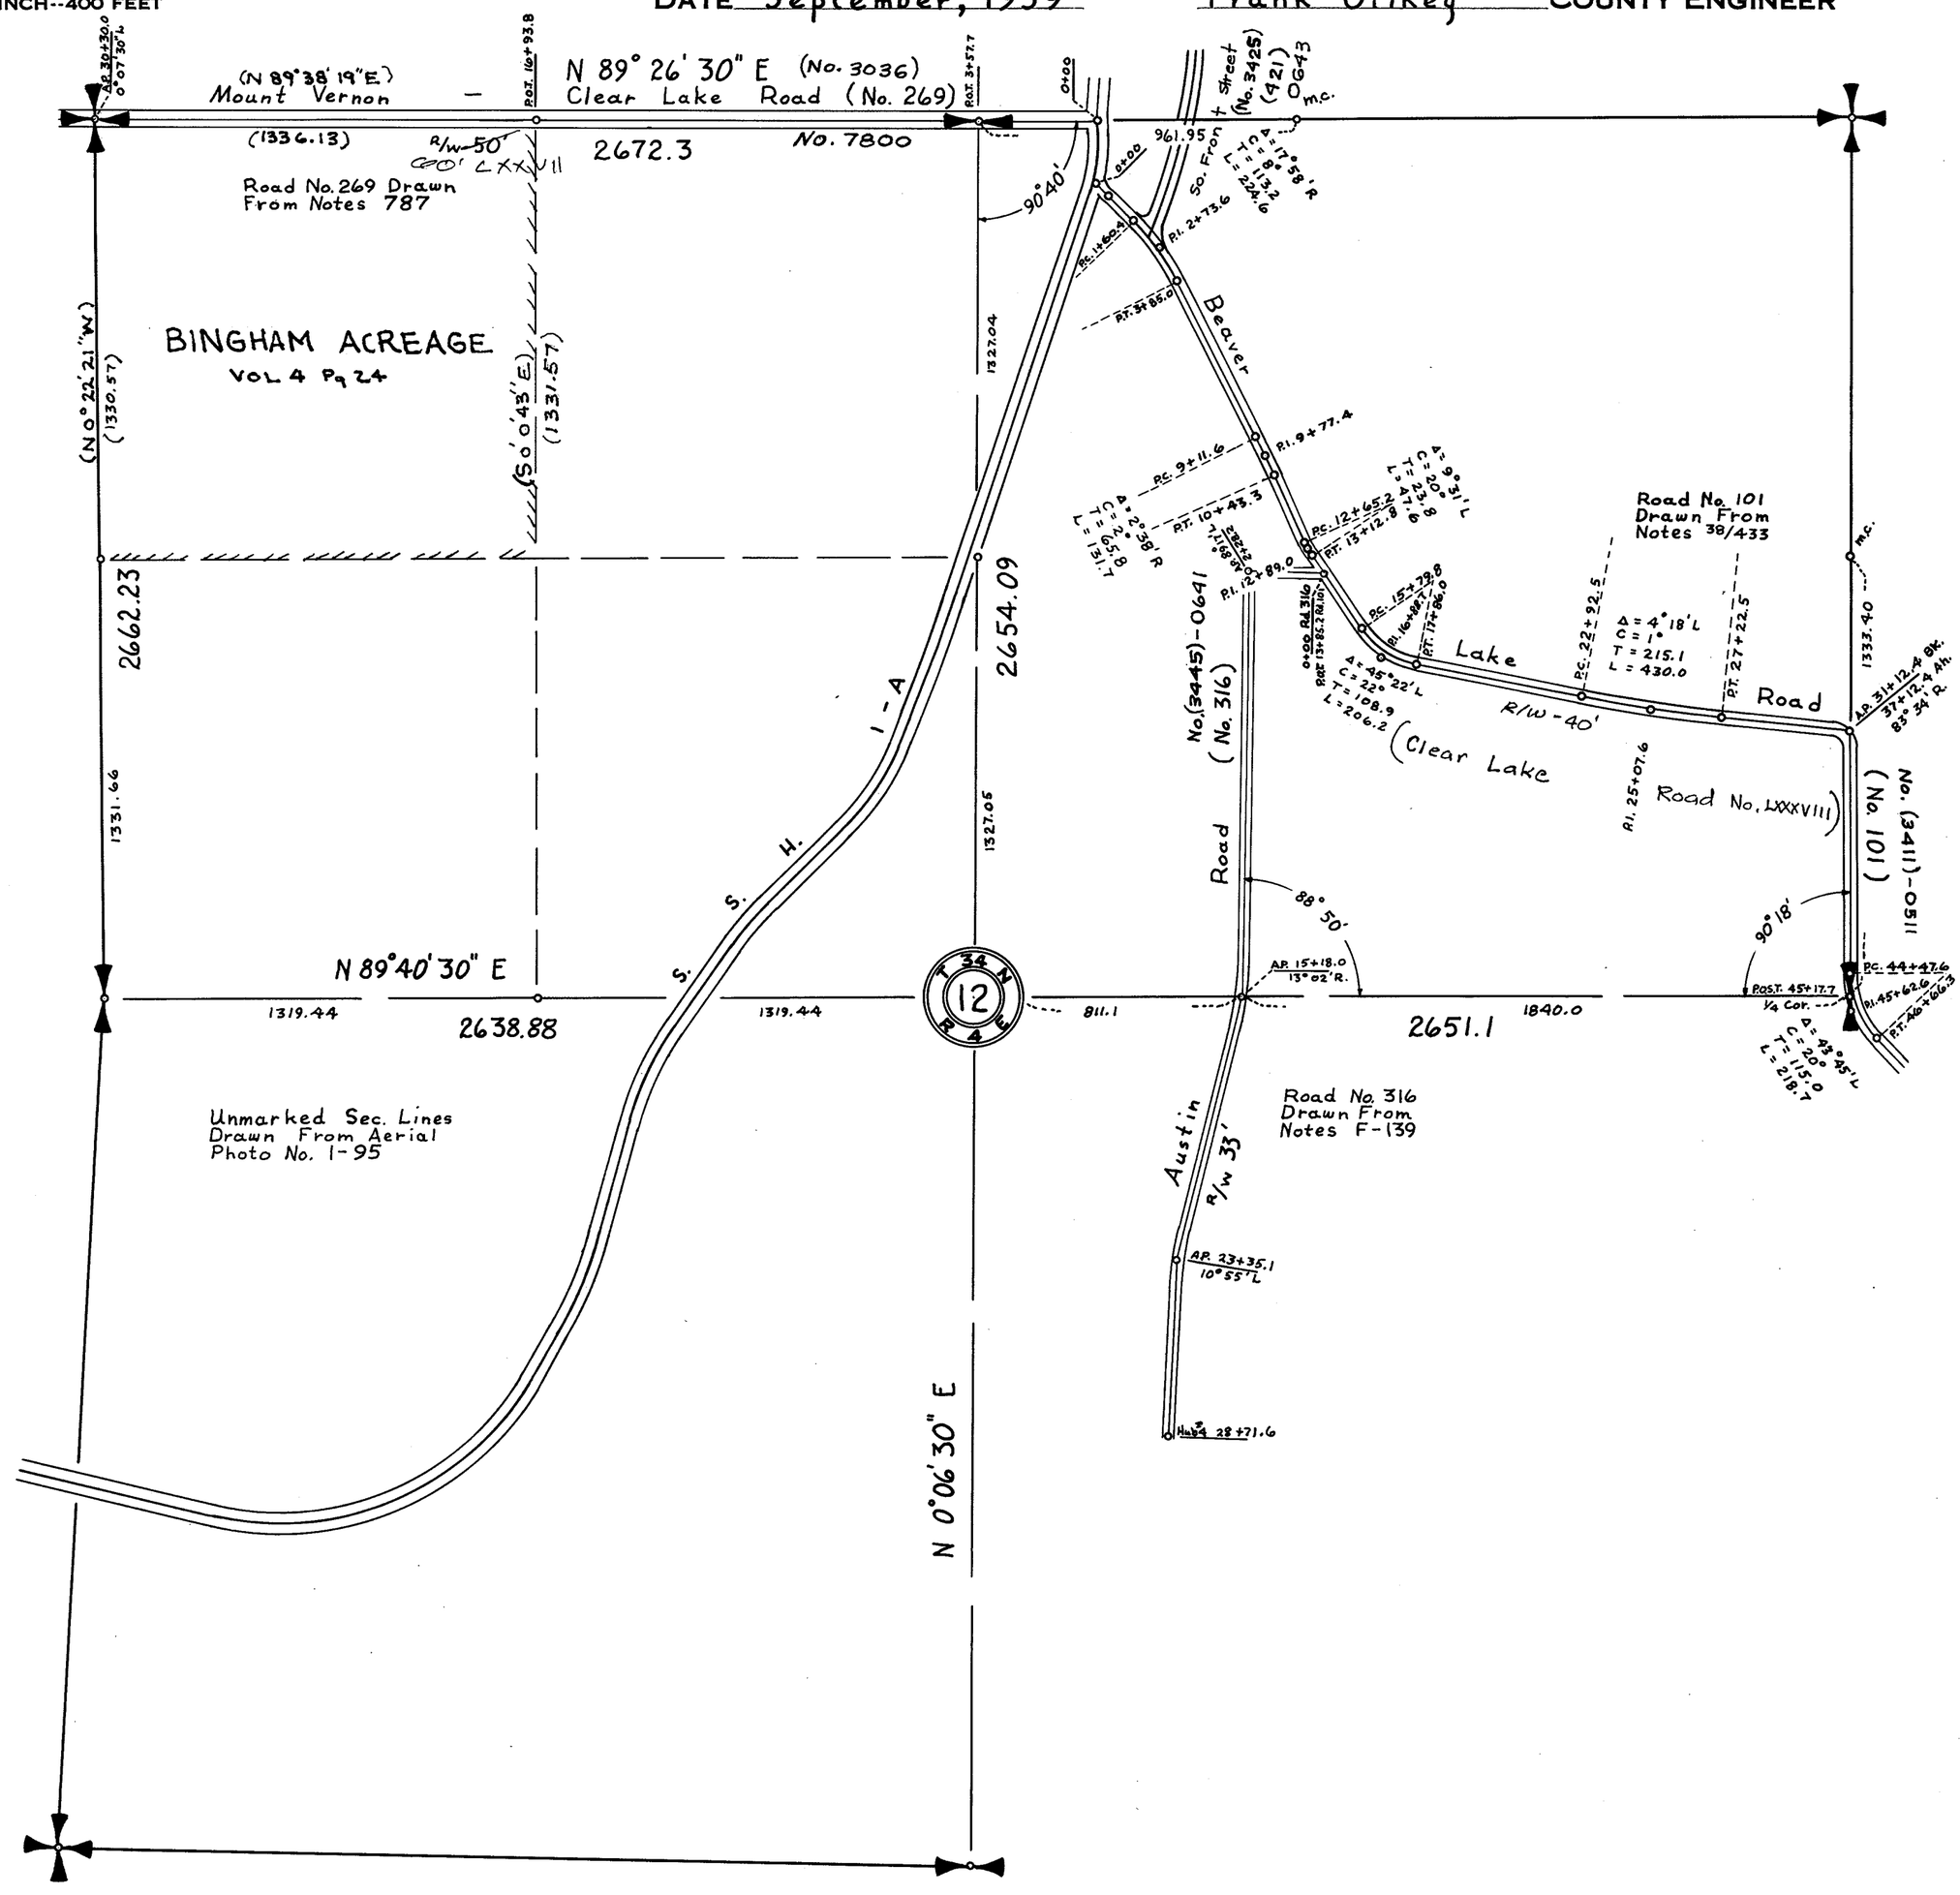


SECTION 12

TOWNSHIP 34 NORTH, RANGE 4 EAST, W. M.
SKAGIT COUNTY, WASH.

SCALE, 1 INCH--400 FEET

A.L. STRONG, COUNTY ENGINEER

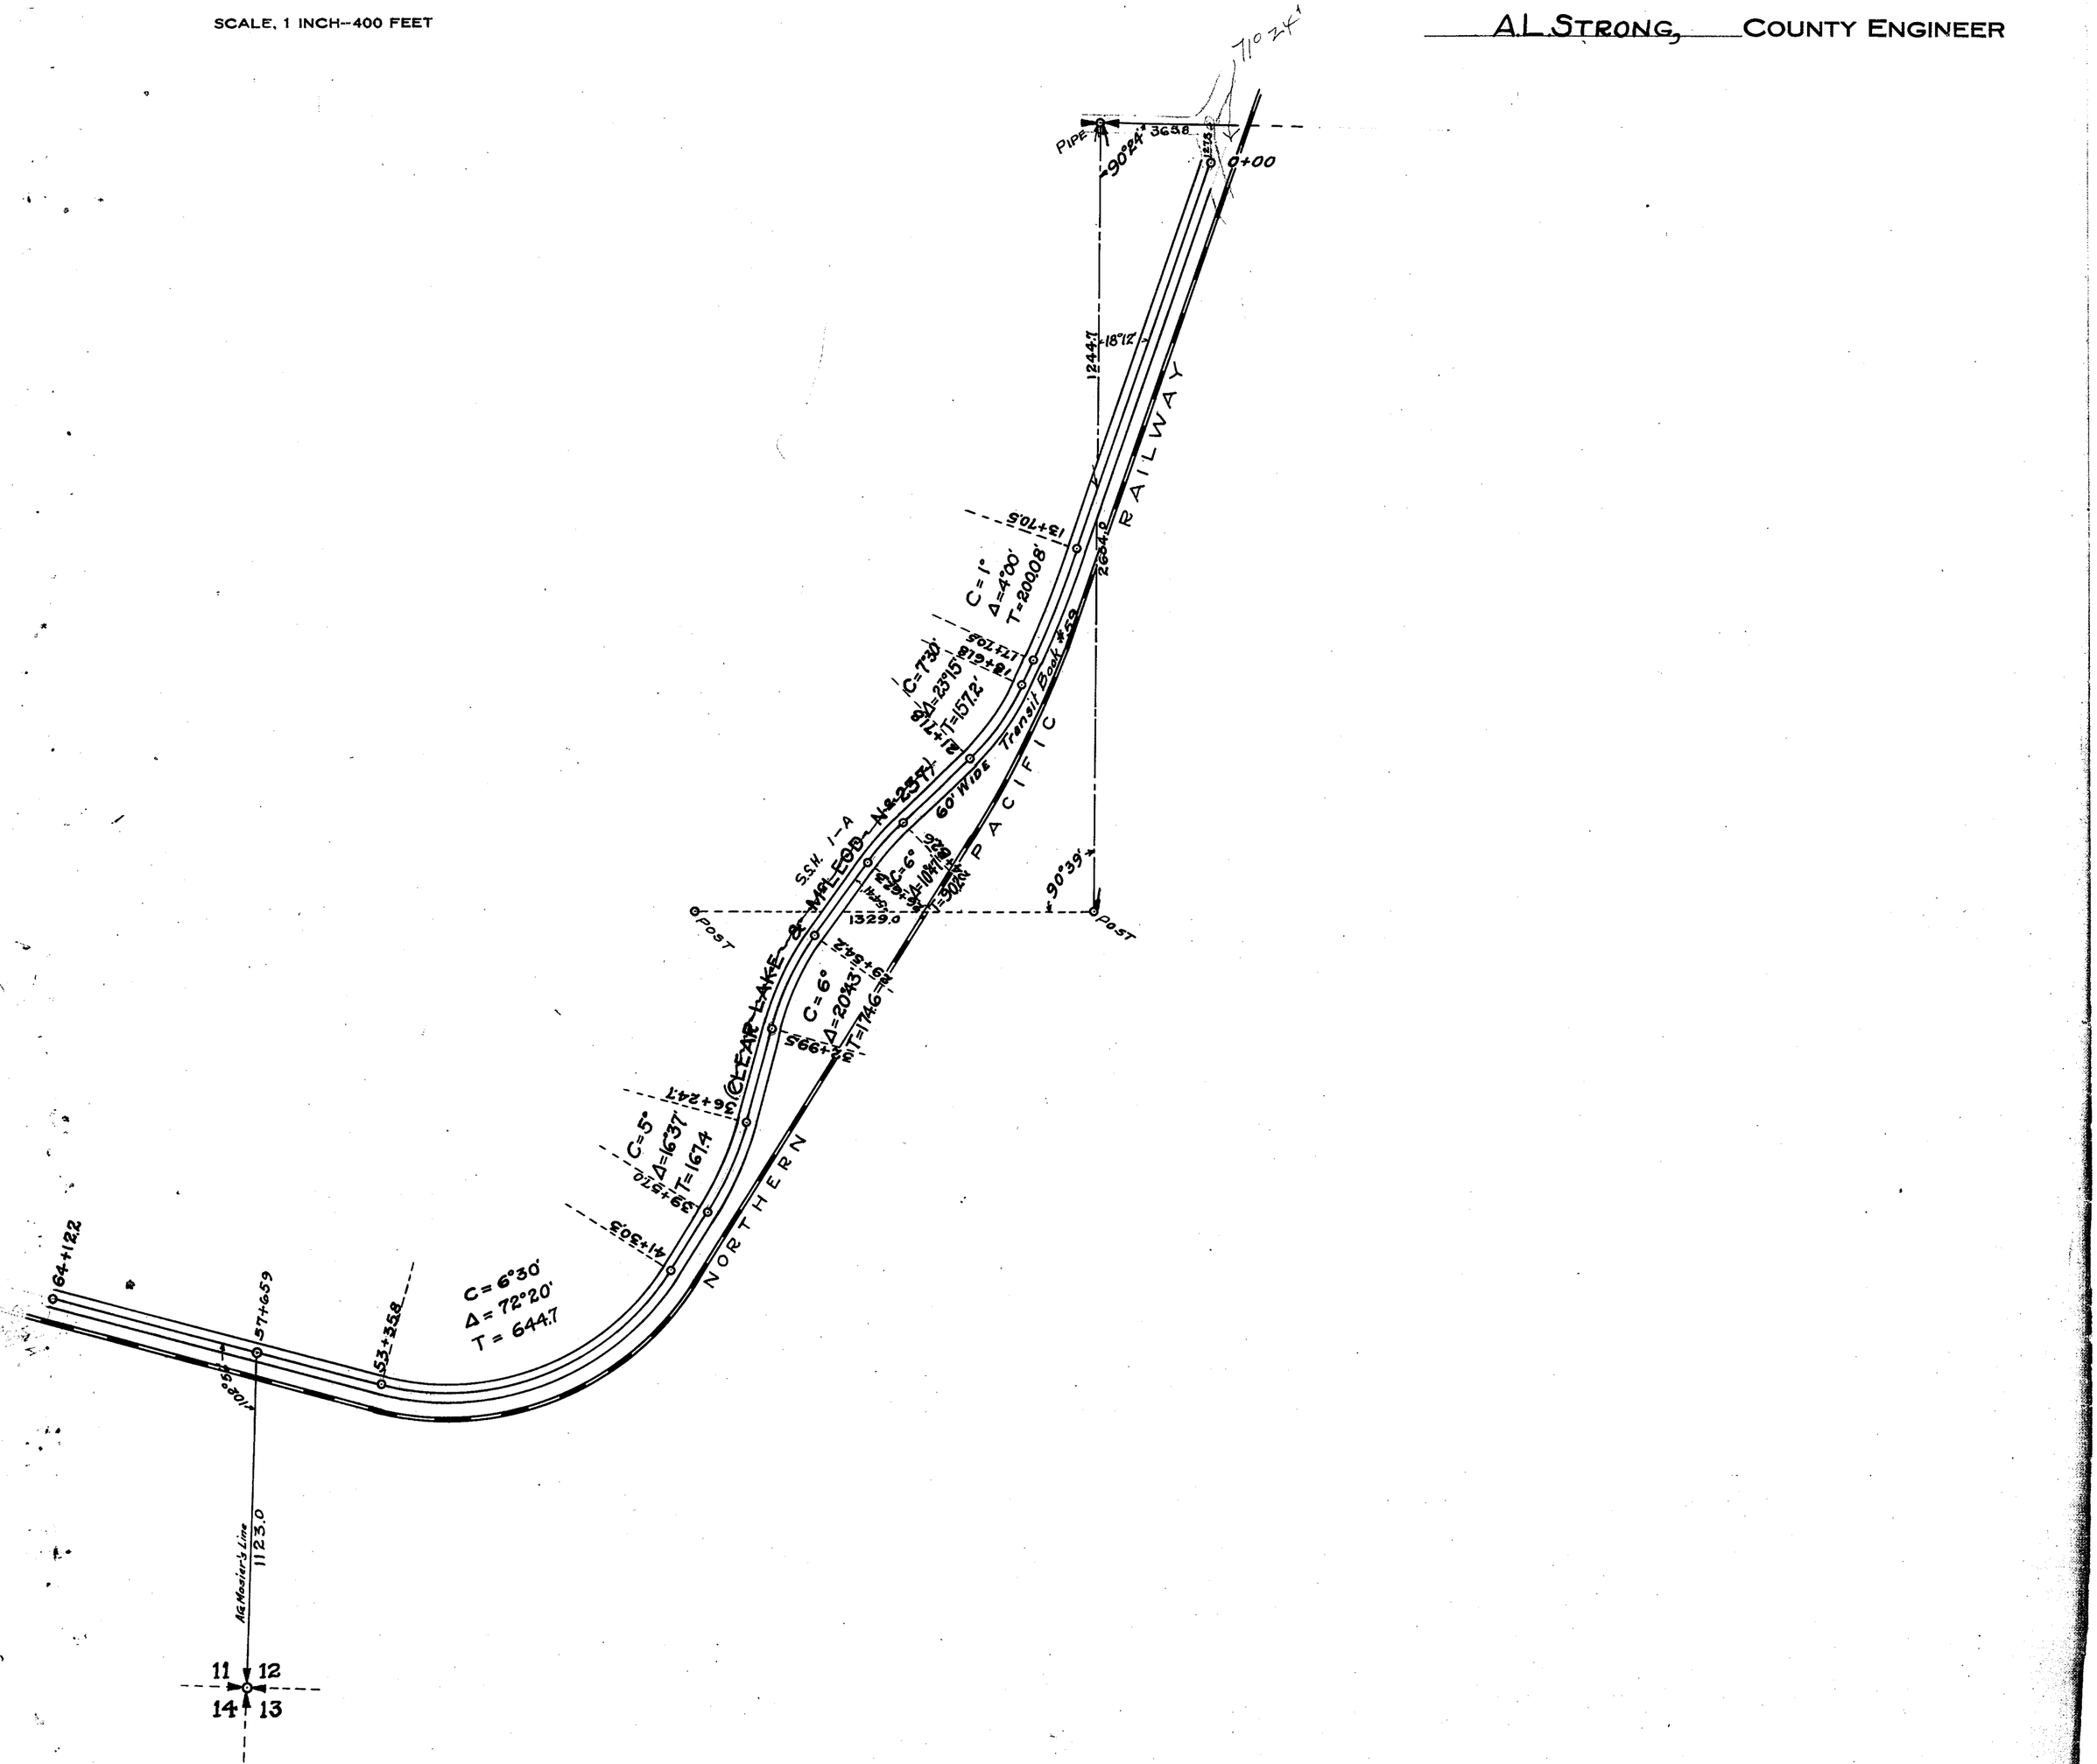


SECTION 12

TOWNSHIP 34 NORTH, RANGE 4 EAST, W. M.
SKAGIT COUNTY, WASH.

SCALE, 1 INCH–400 FEET
Notes. L.L.–F.139.
Austin Road.


_____ COUNTY ENGINEER

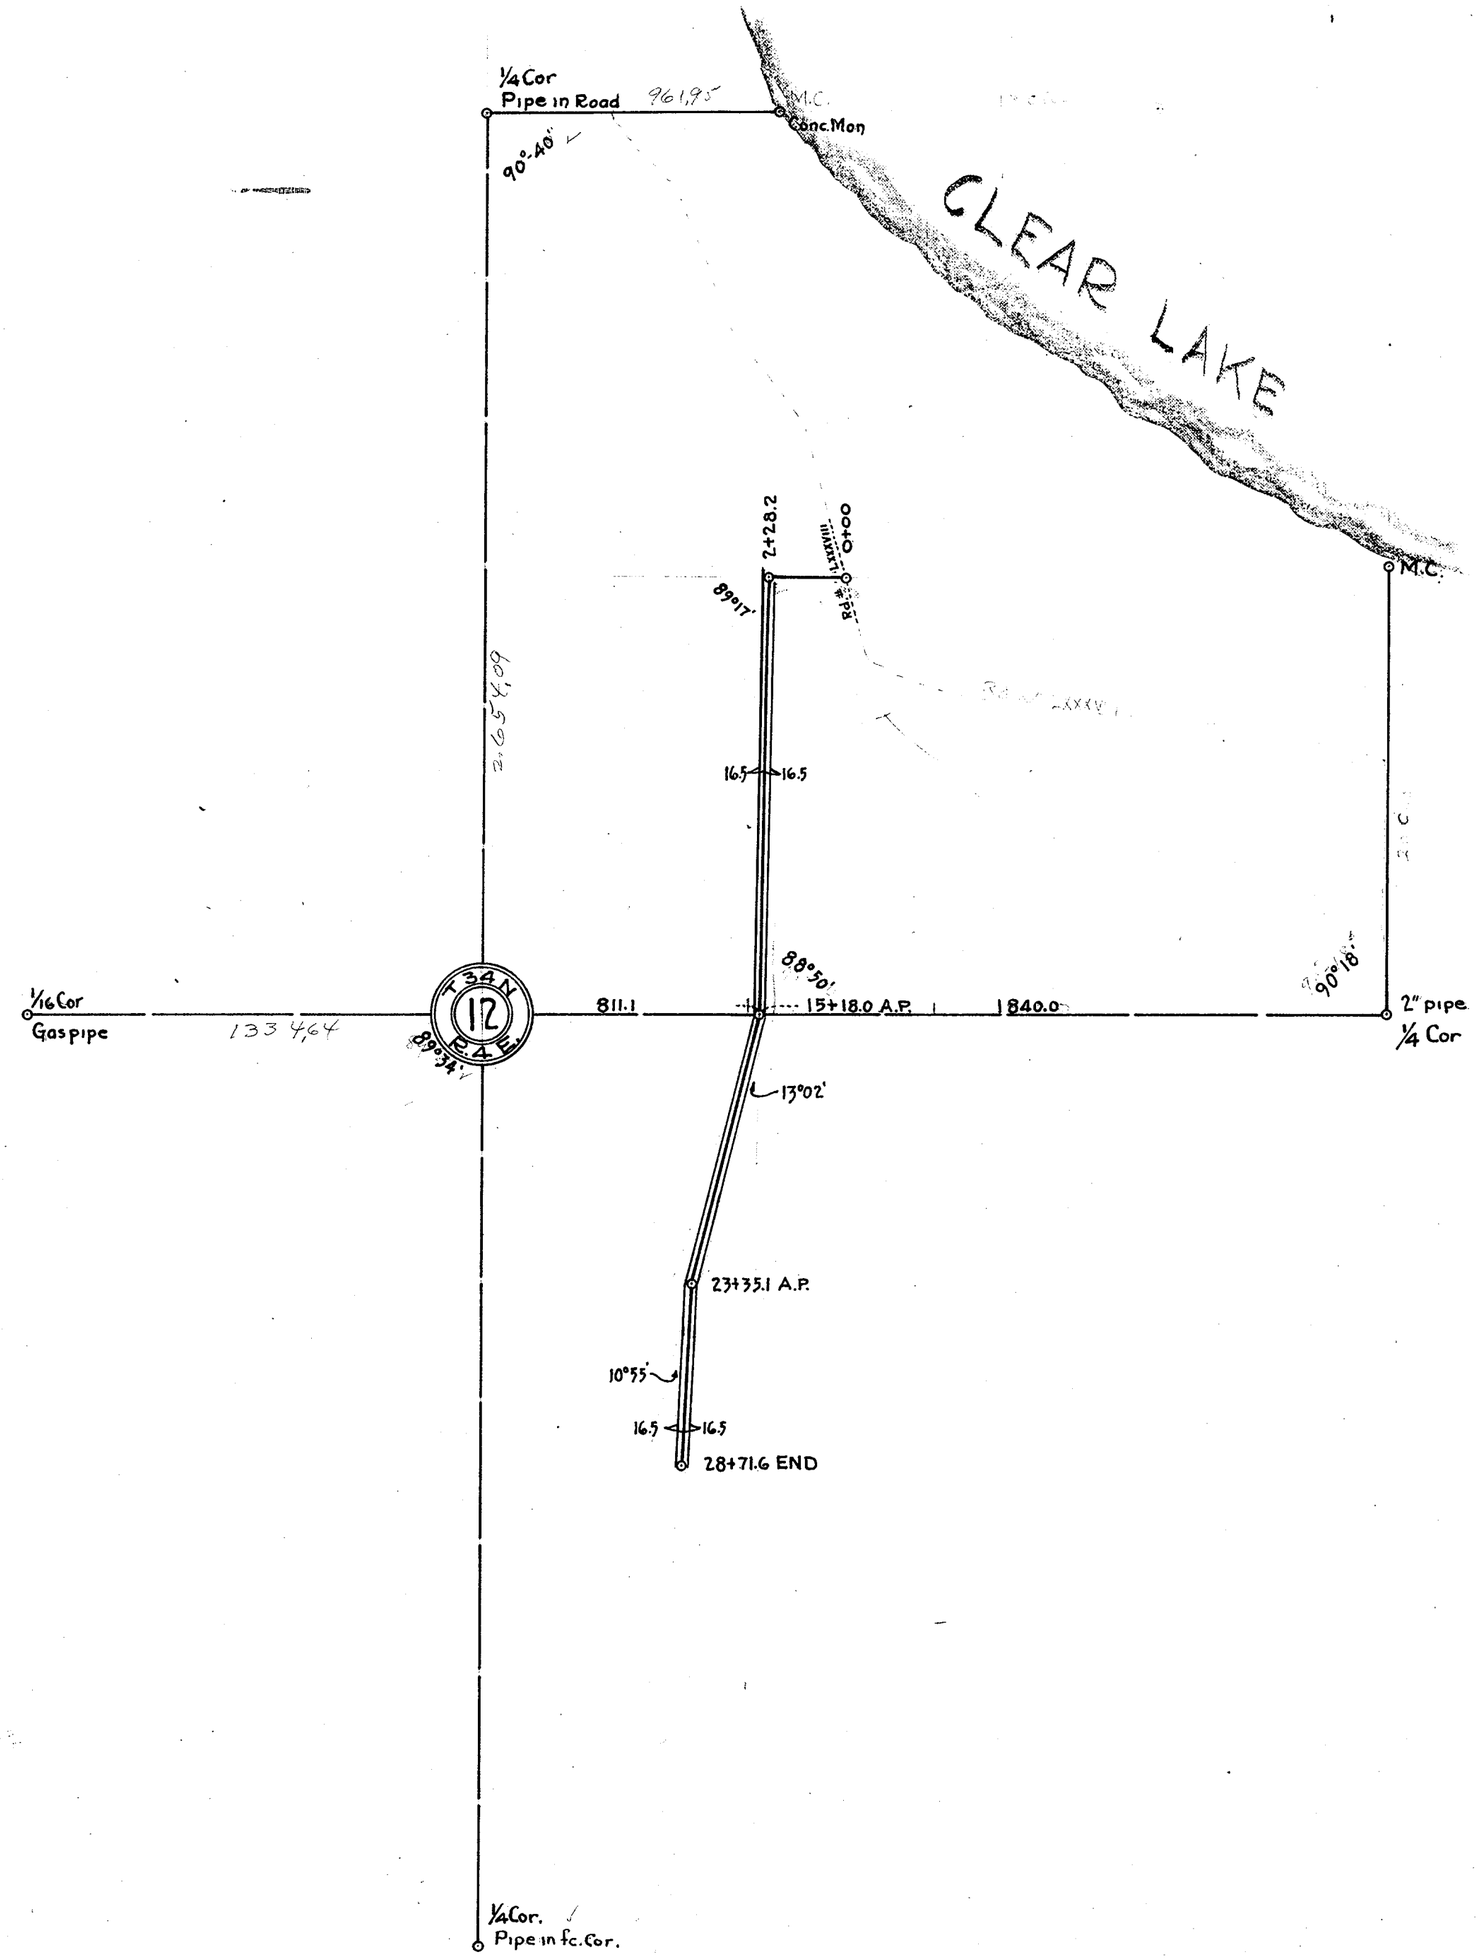

TOWNSHIP 34 NORTH, RANGE 4 EAST, W. M.
SKAGIT COUNTY, WASH.

SCALE, 1 INCH--400 FEET

DATE September, 1959 Frank Gilkey COUNTY ENGINEER

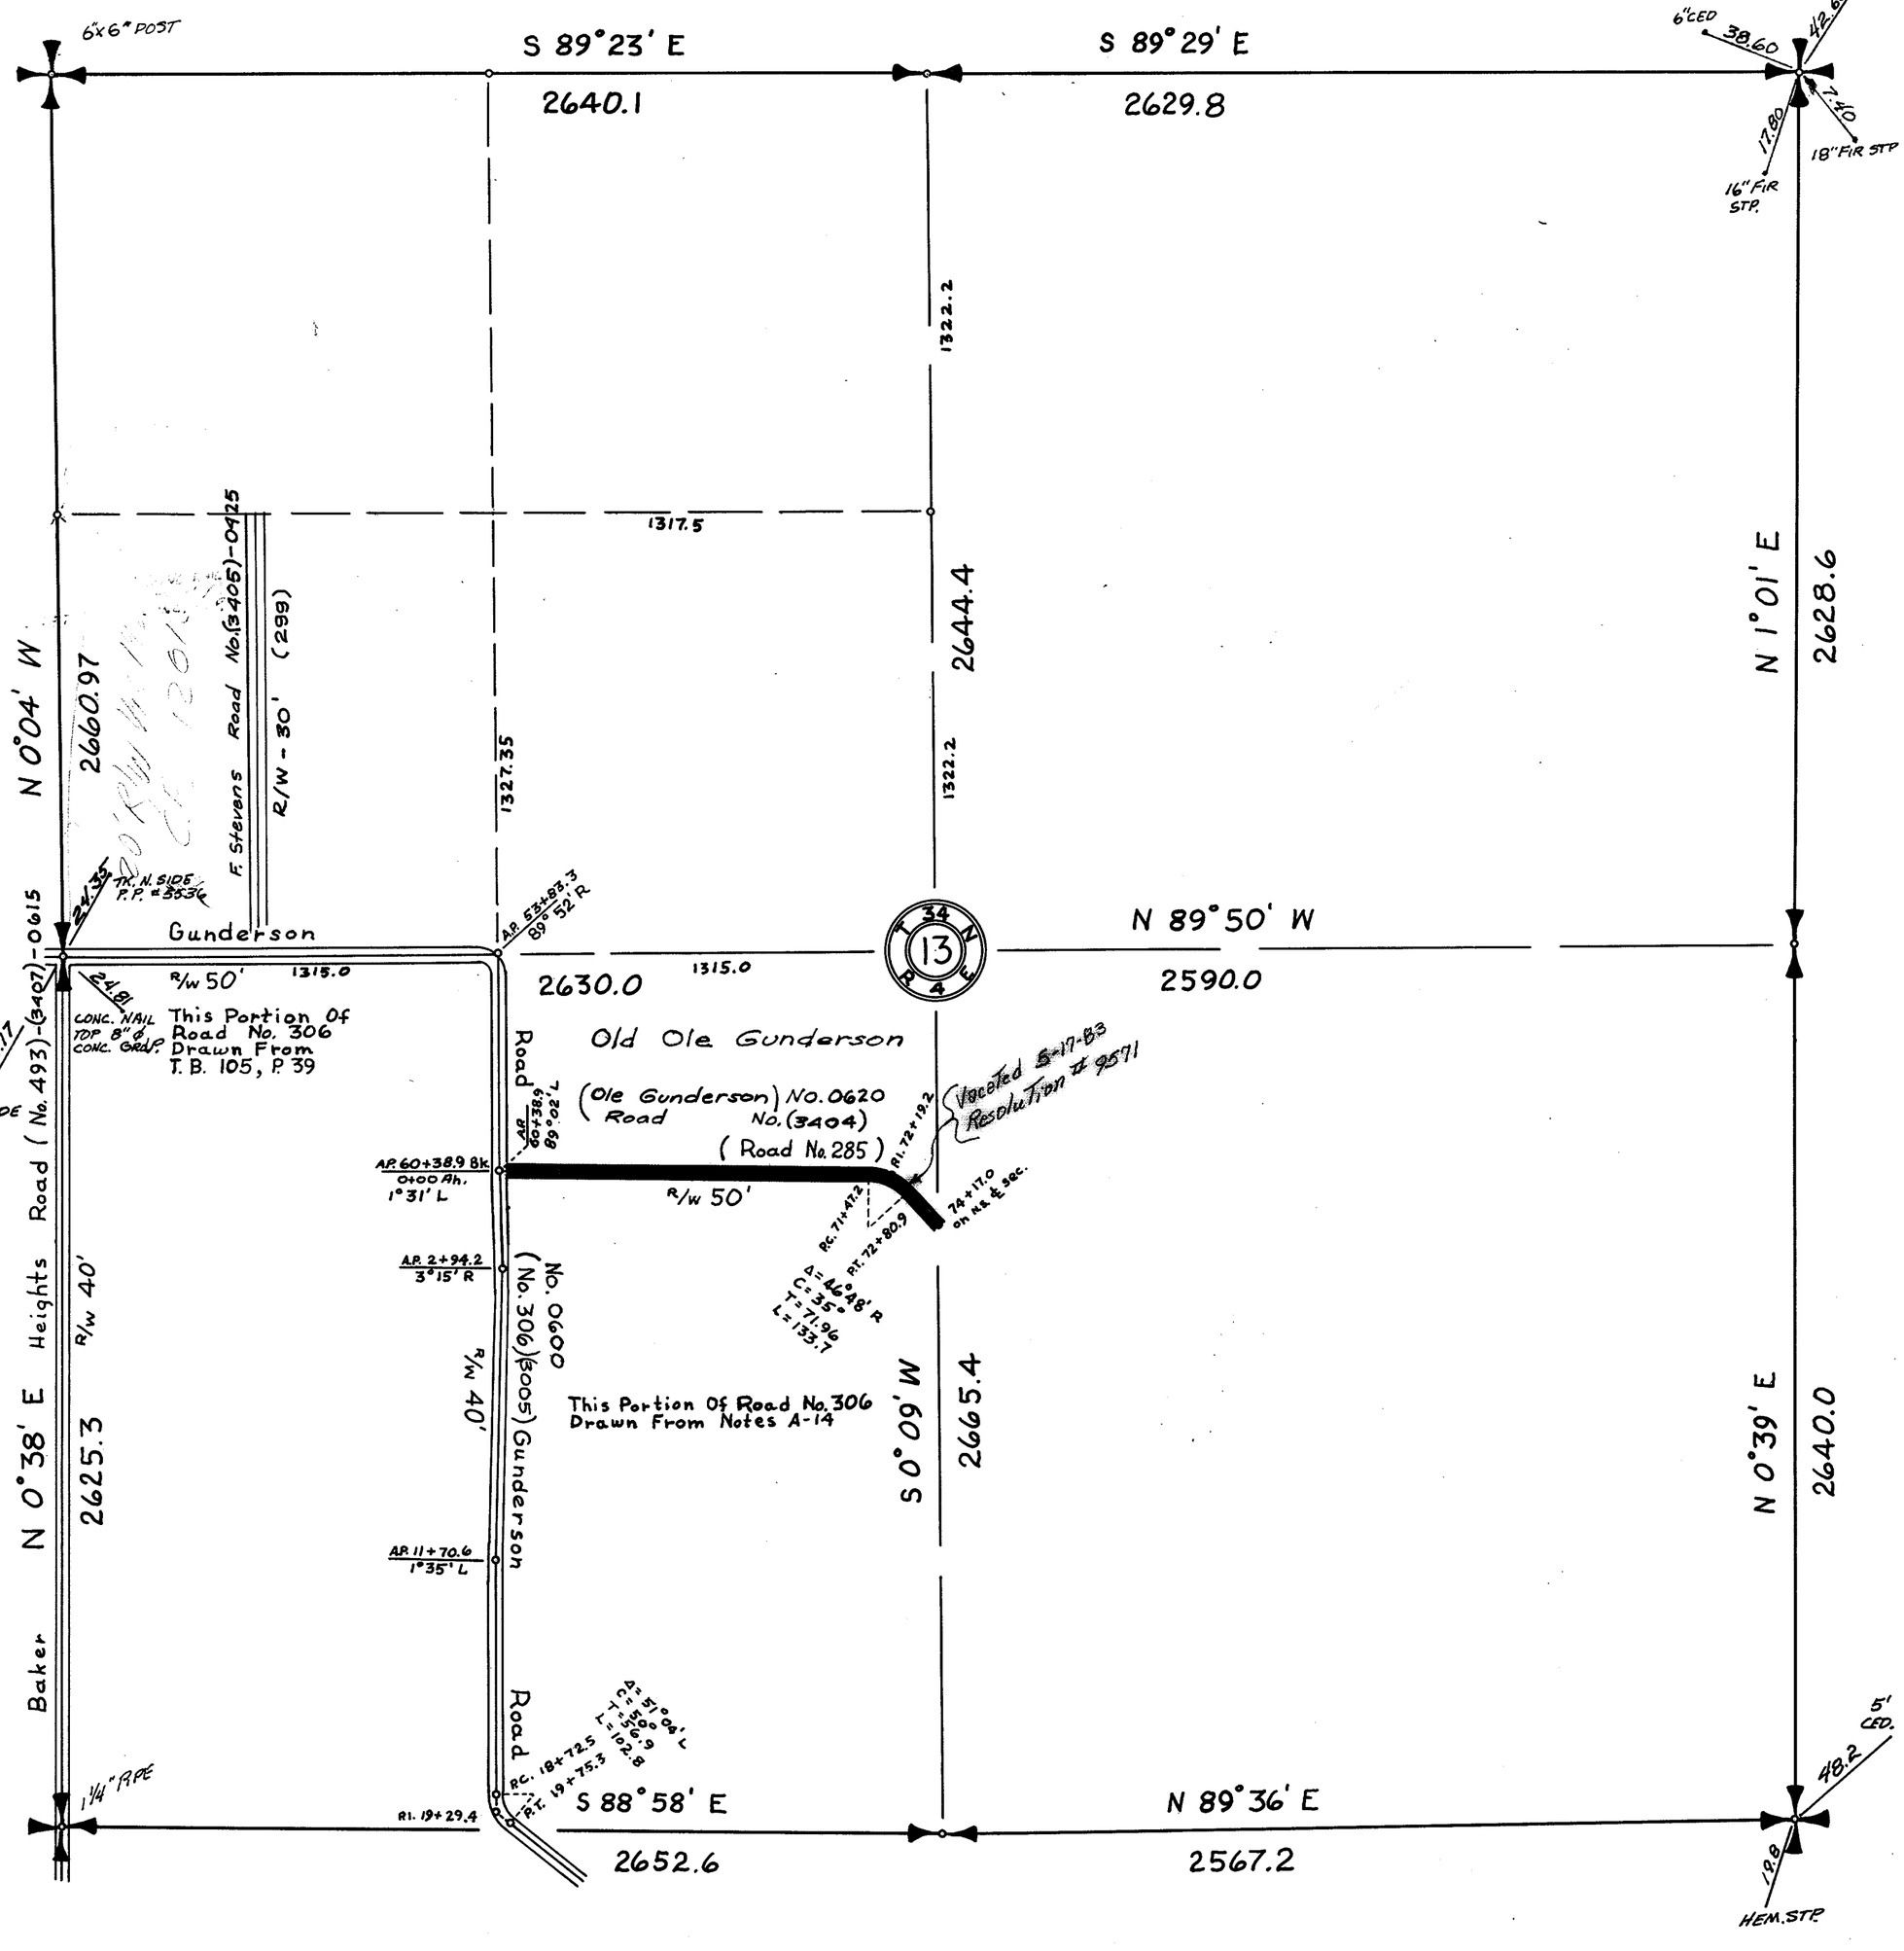


SECTION 13

TOWNSHIP 34 NORTH. RANGE 4 EAST. W. M.

SKAGIT COUNTY. WASH.

SCALE, 1 INCH–400 FEET

A.L. STRONG COUNTY ENGINEER

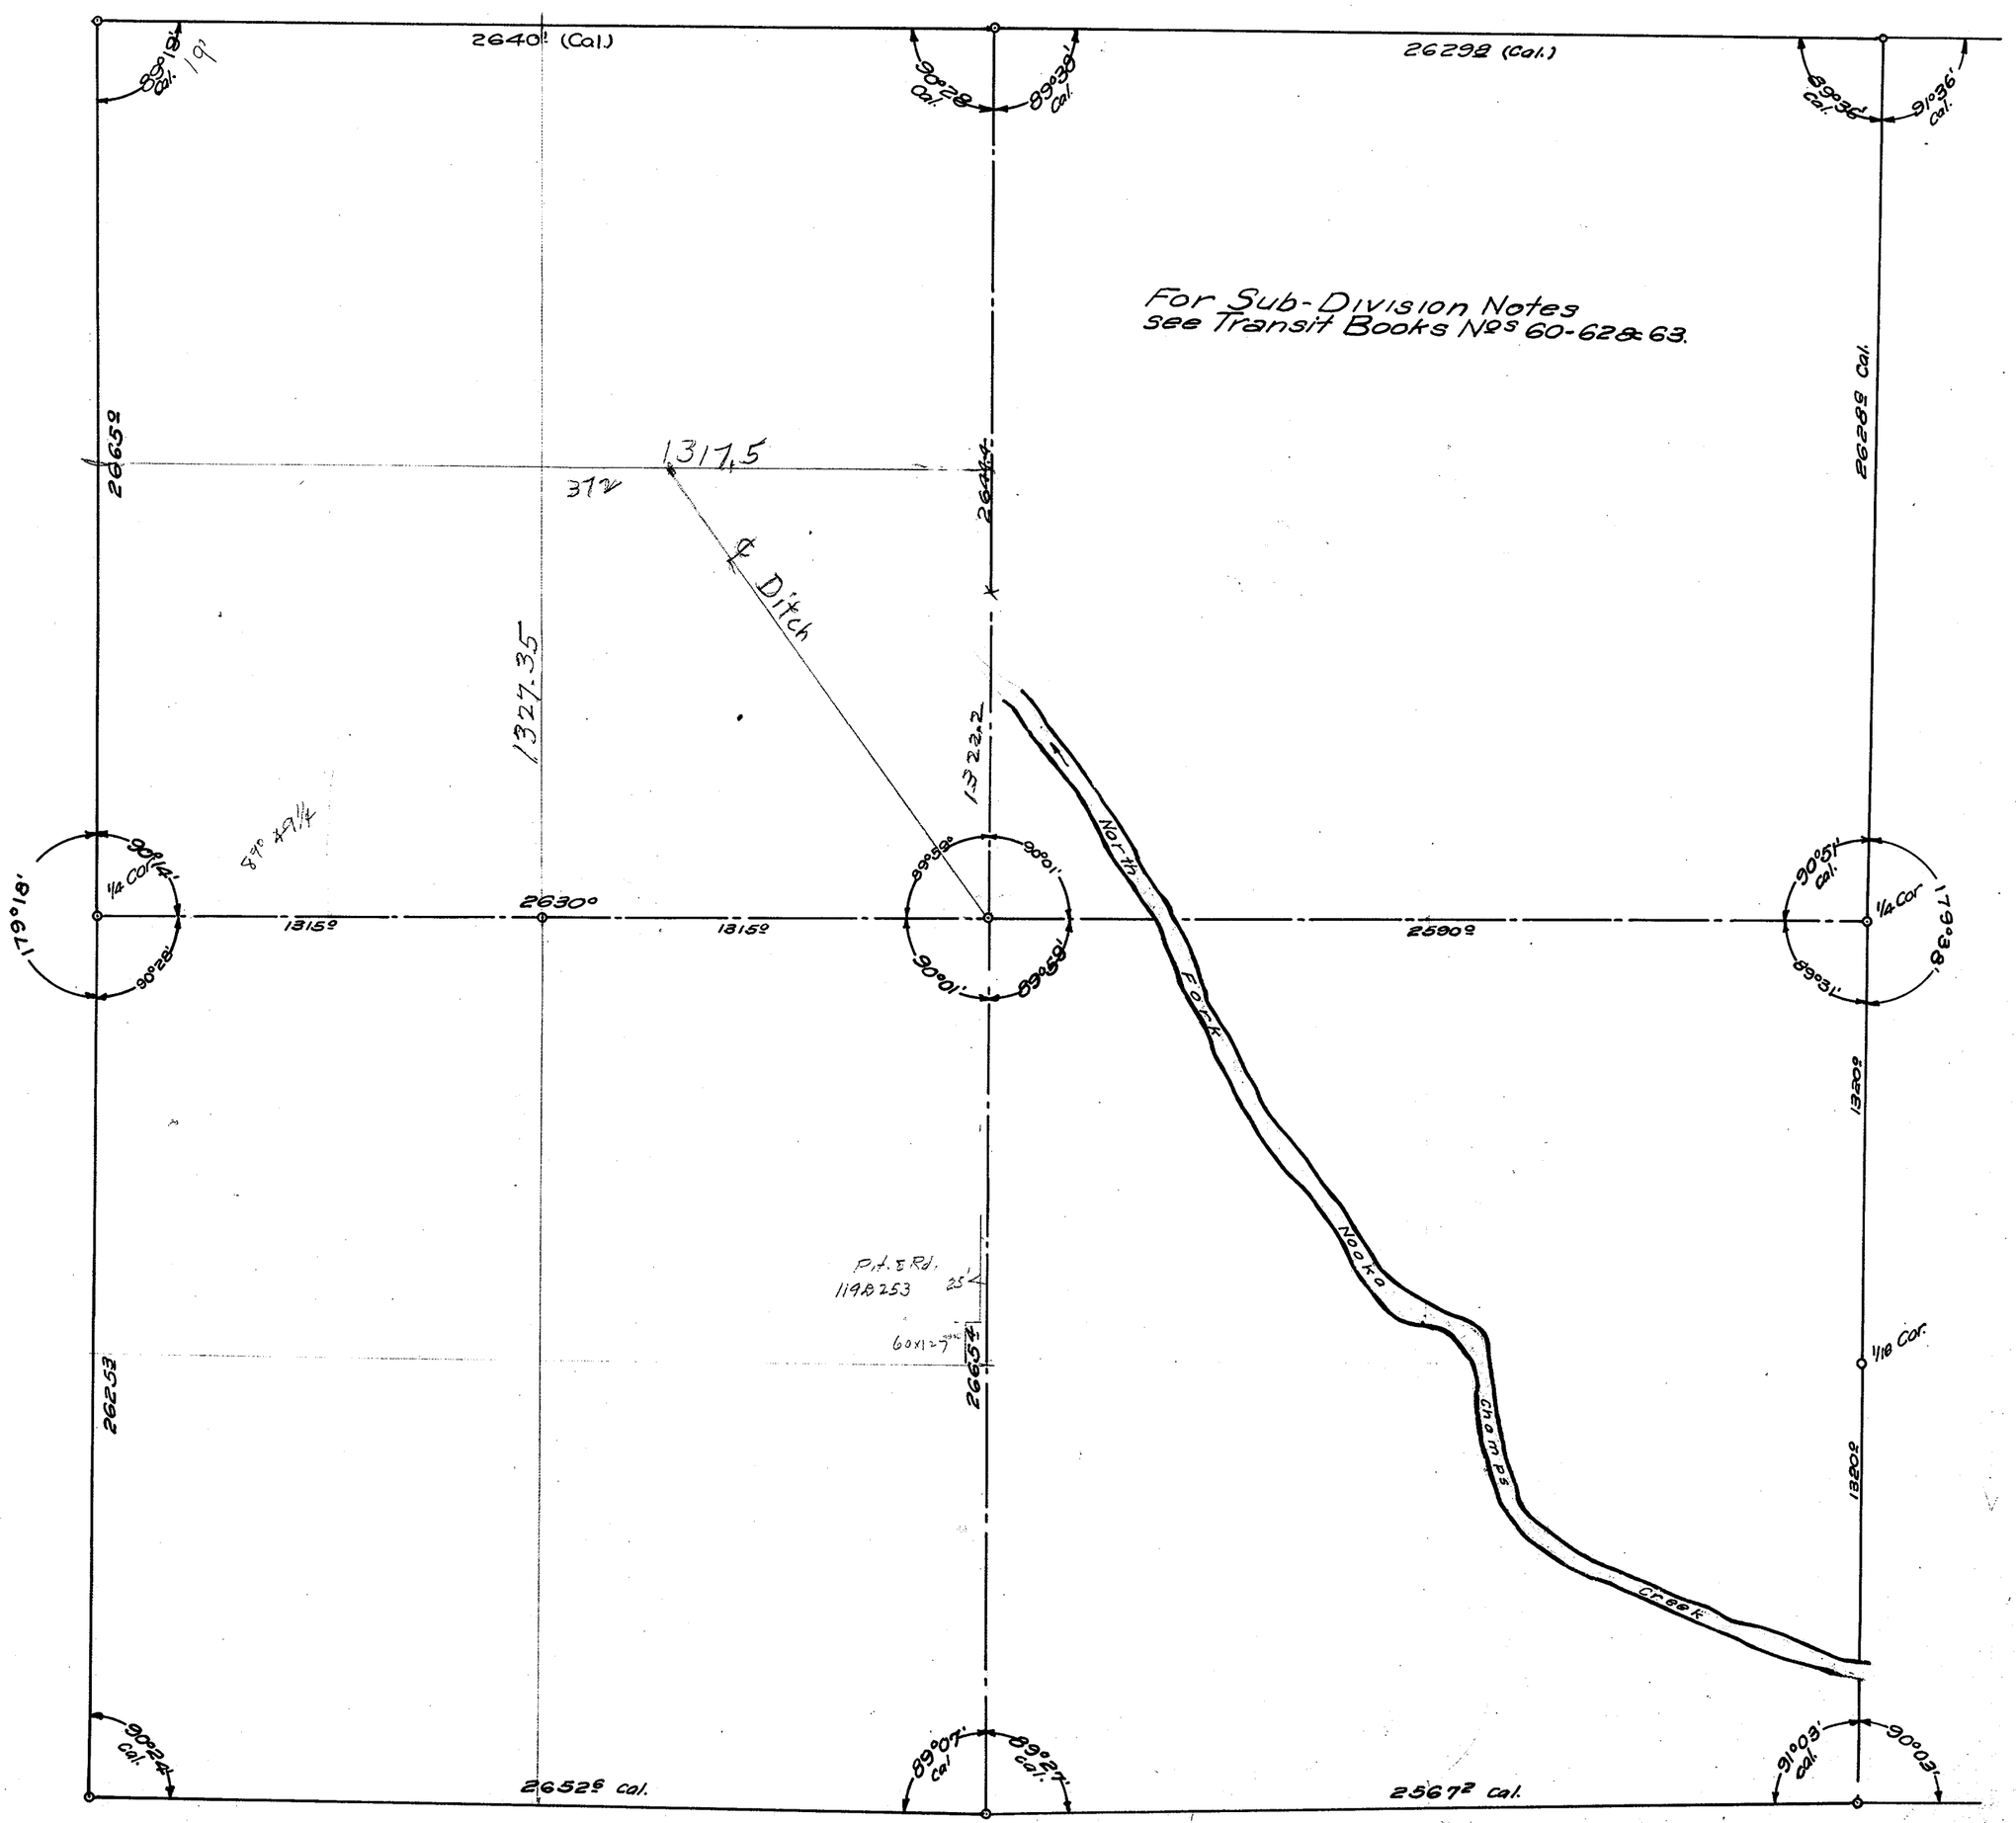


SECTION 13

TOWNSHIP 34 NORTH, RANGE 4 EAST, W. M.
SKAGIT COUNTY, WASH.

SCALE, 1 INCH–400 FEET


R.E.L. Knapp COUNTY ENGINEER

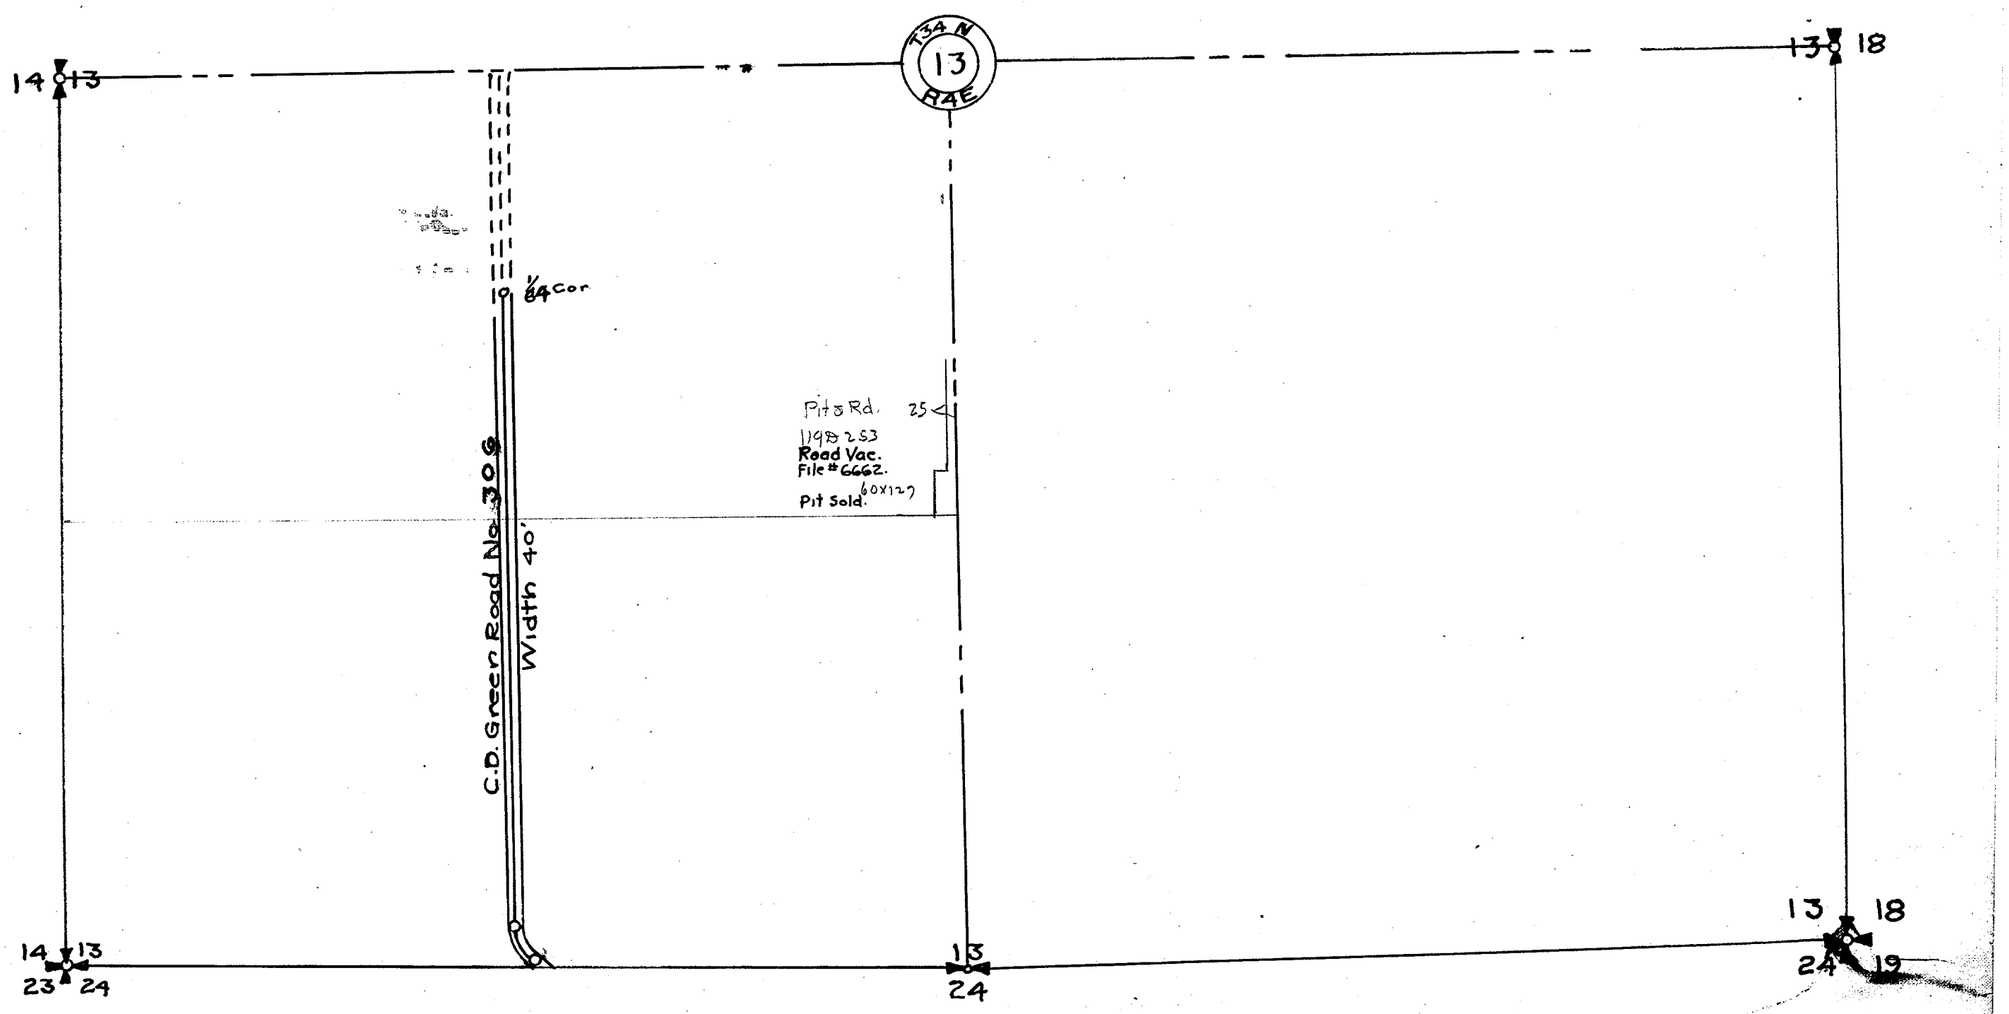

TOWNSHIP 34 NORTH, RANGE 4 EAST, W. M.
SKAGIT COUNTY, WASH.

SCALE, 1 INCH--400 FEET

DATE September, 1959 Frank Gilkey COUNTY ENGINEER

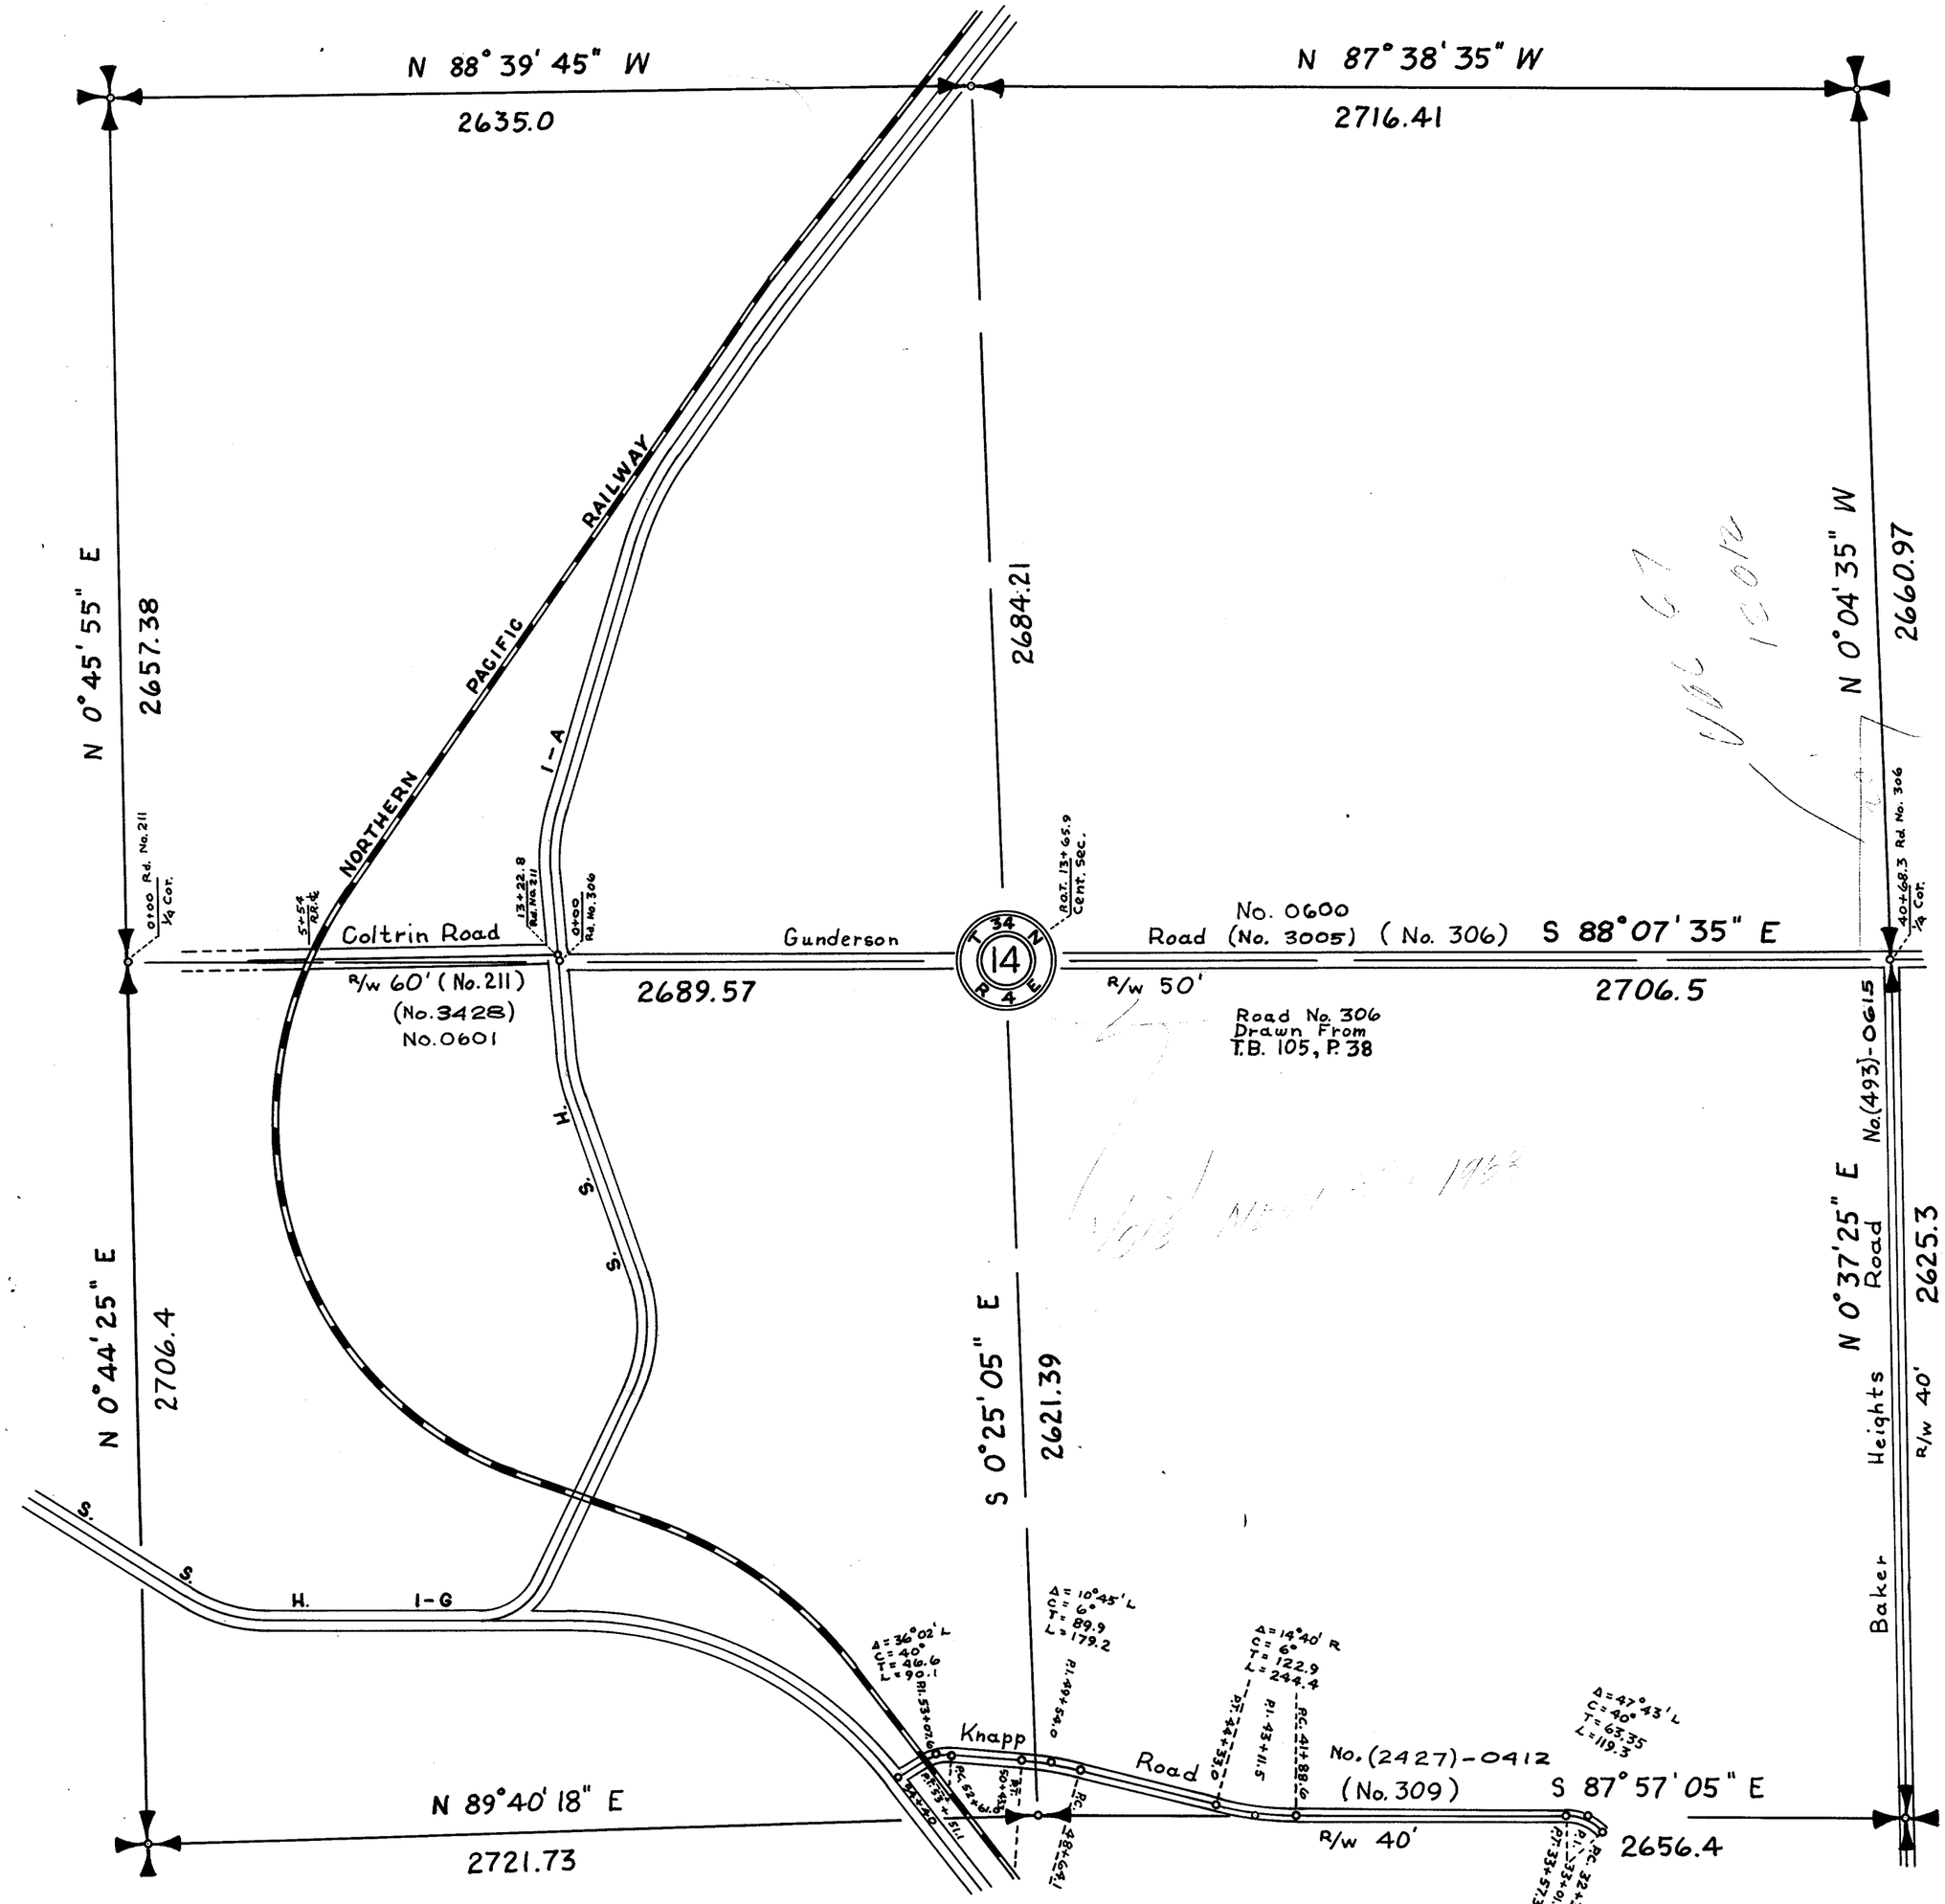

1332.3
666.2.


1300.4
672.2

SECTION 14

TOWNSHIP 34 NORTH, RANGE 4 EAST, W. M.
SKAGIT COUNTY, WASH.

SCALE, 1 INCH–400 FEET

AL STRONG COUNTY ENGINEER

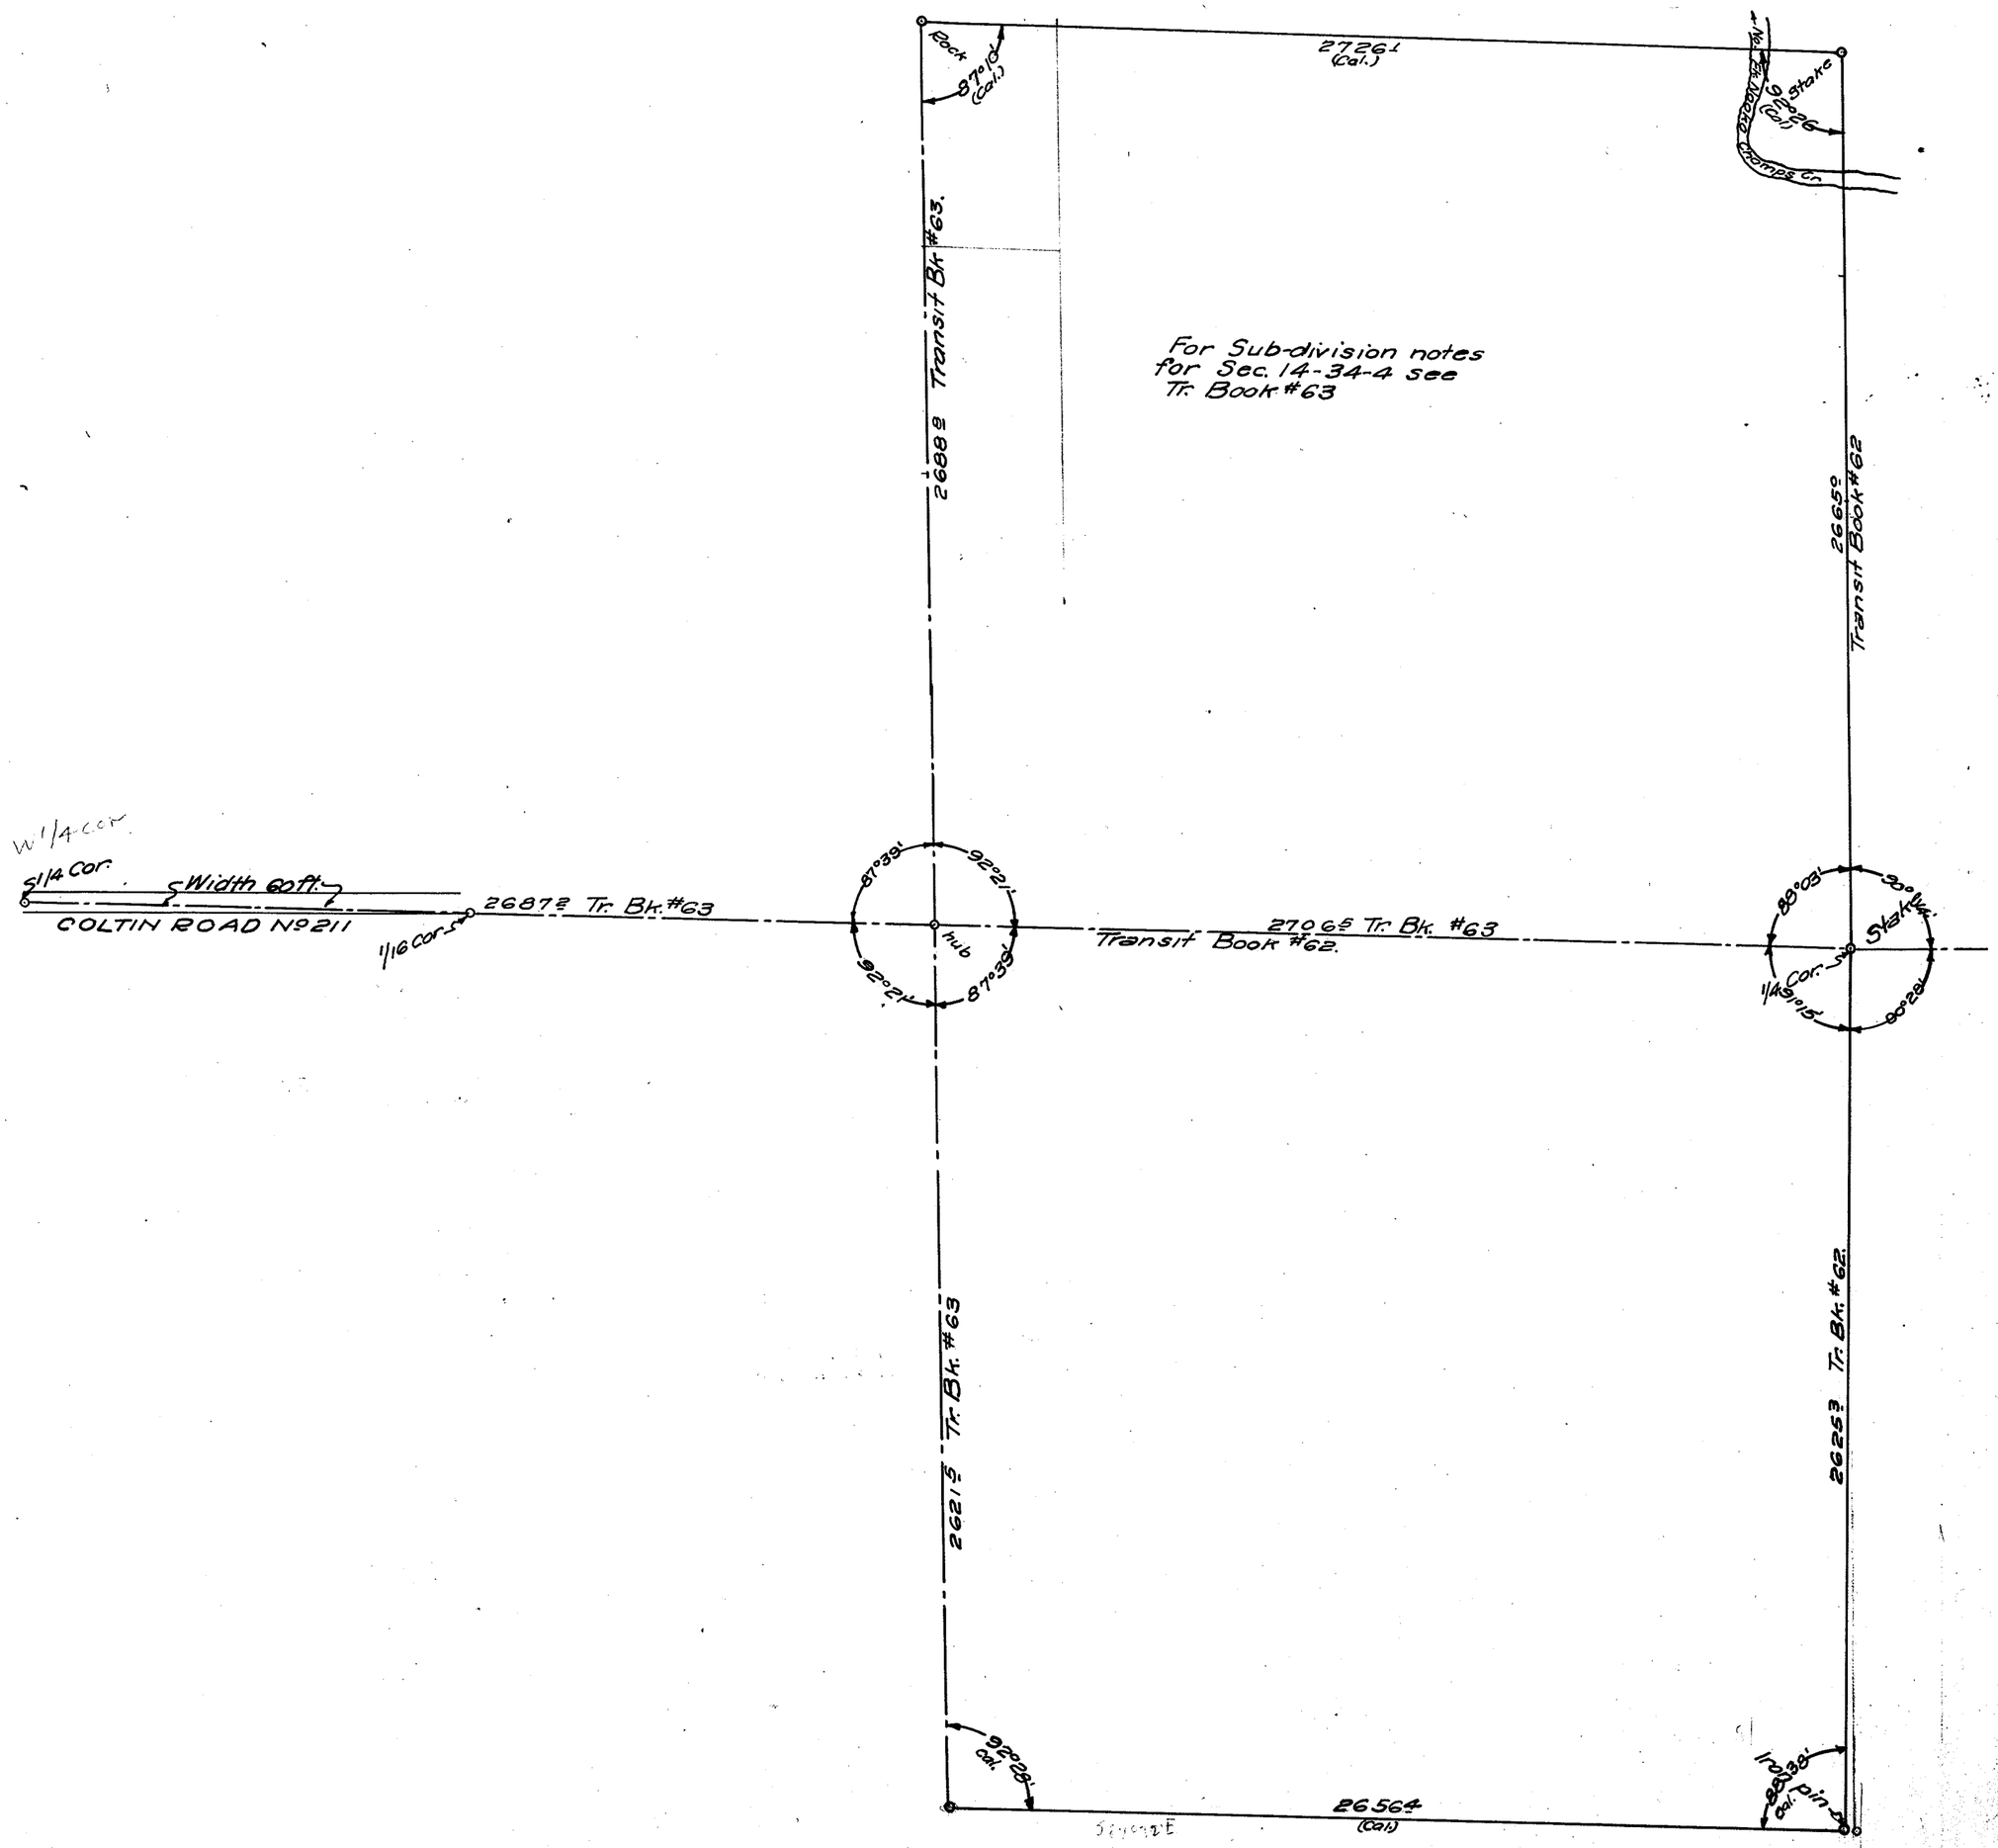

SECTION 14


TOWNSHIP 34 NORTH, RANGE 4 EAST, W. M.

SKAGIT COUNTY, WASH.

SCALE, 1 INCH -- 400 FEET

DATE FEB 25, 1972

FRANK GILKEY COUNTY ENGINEER

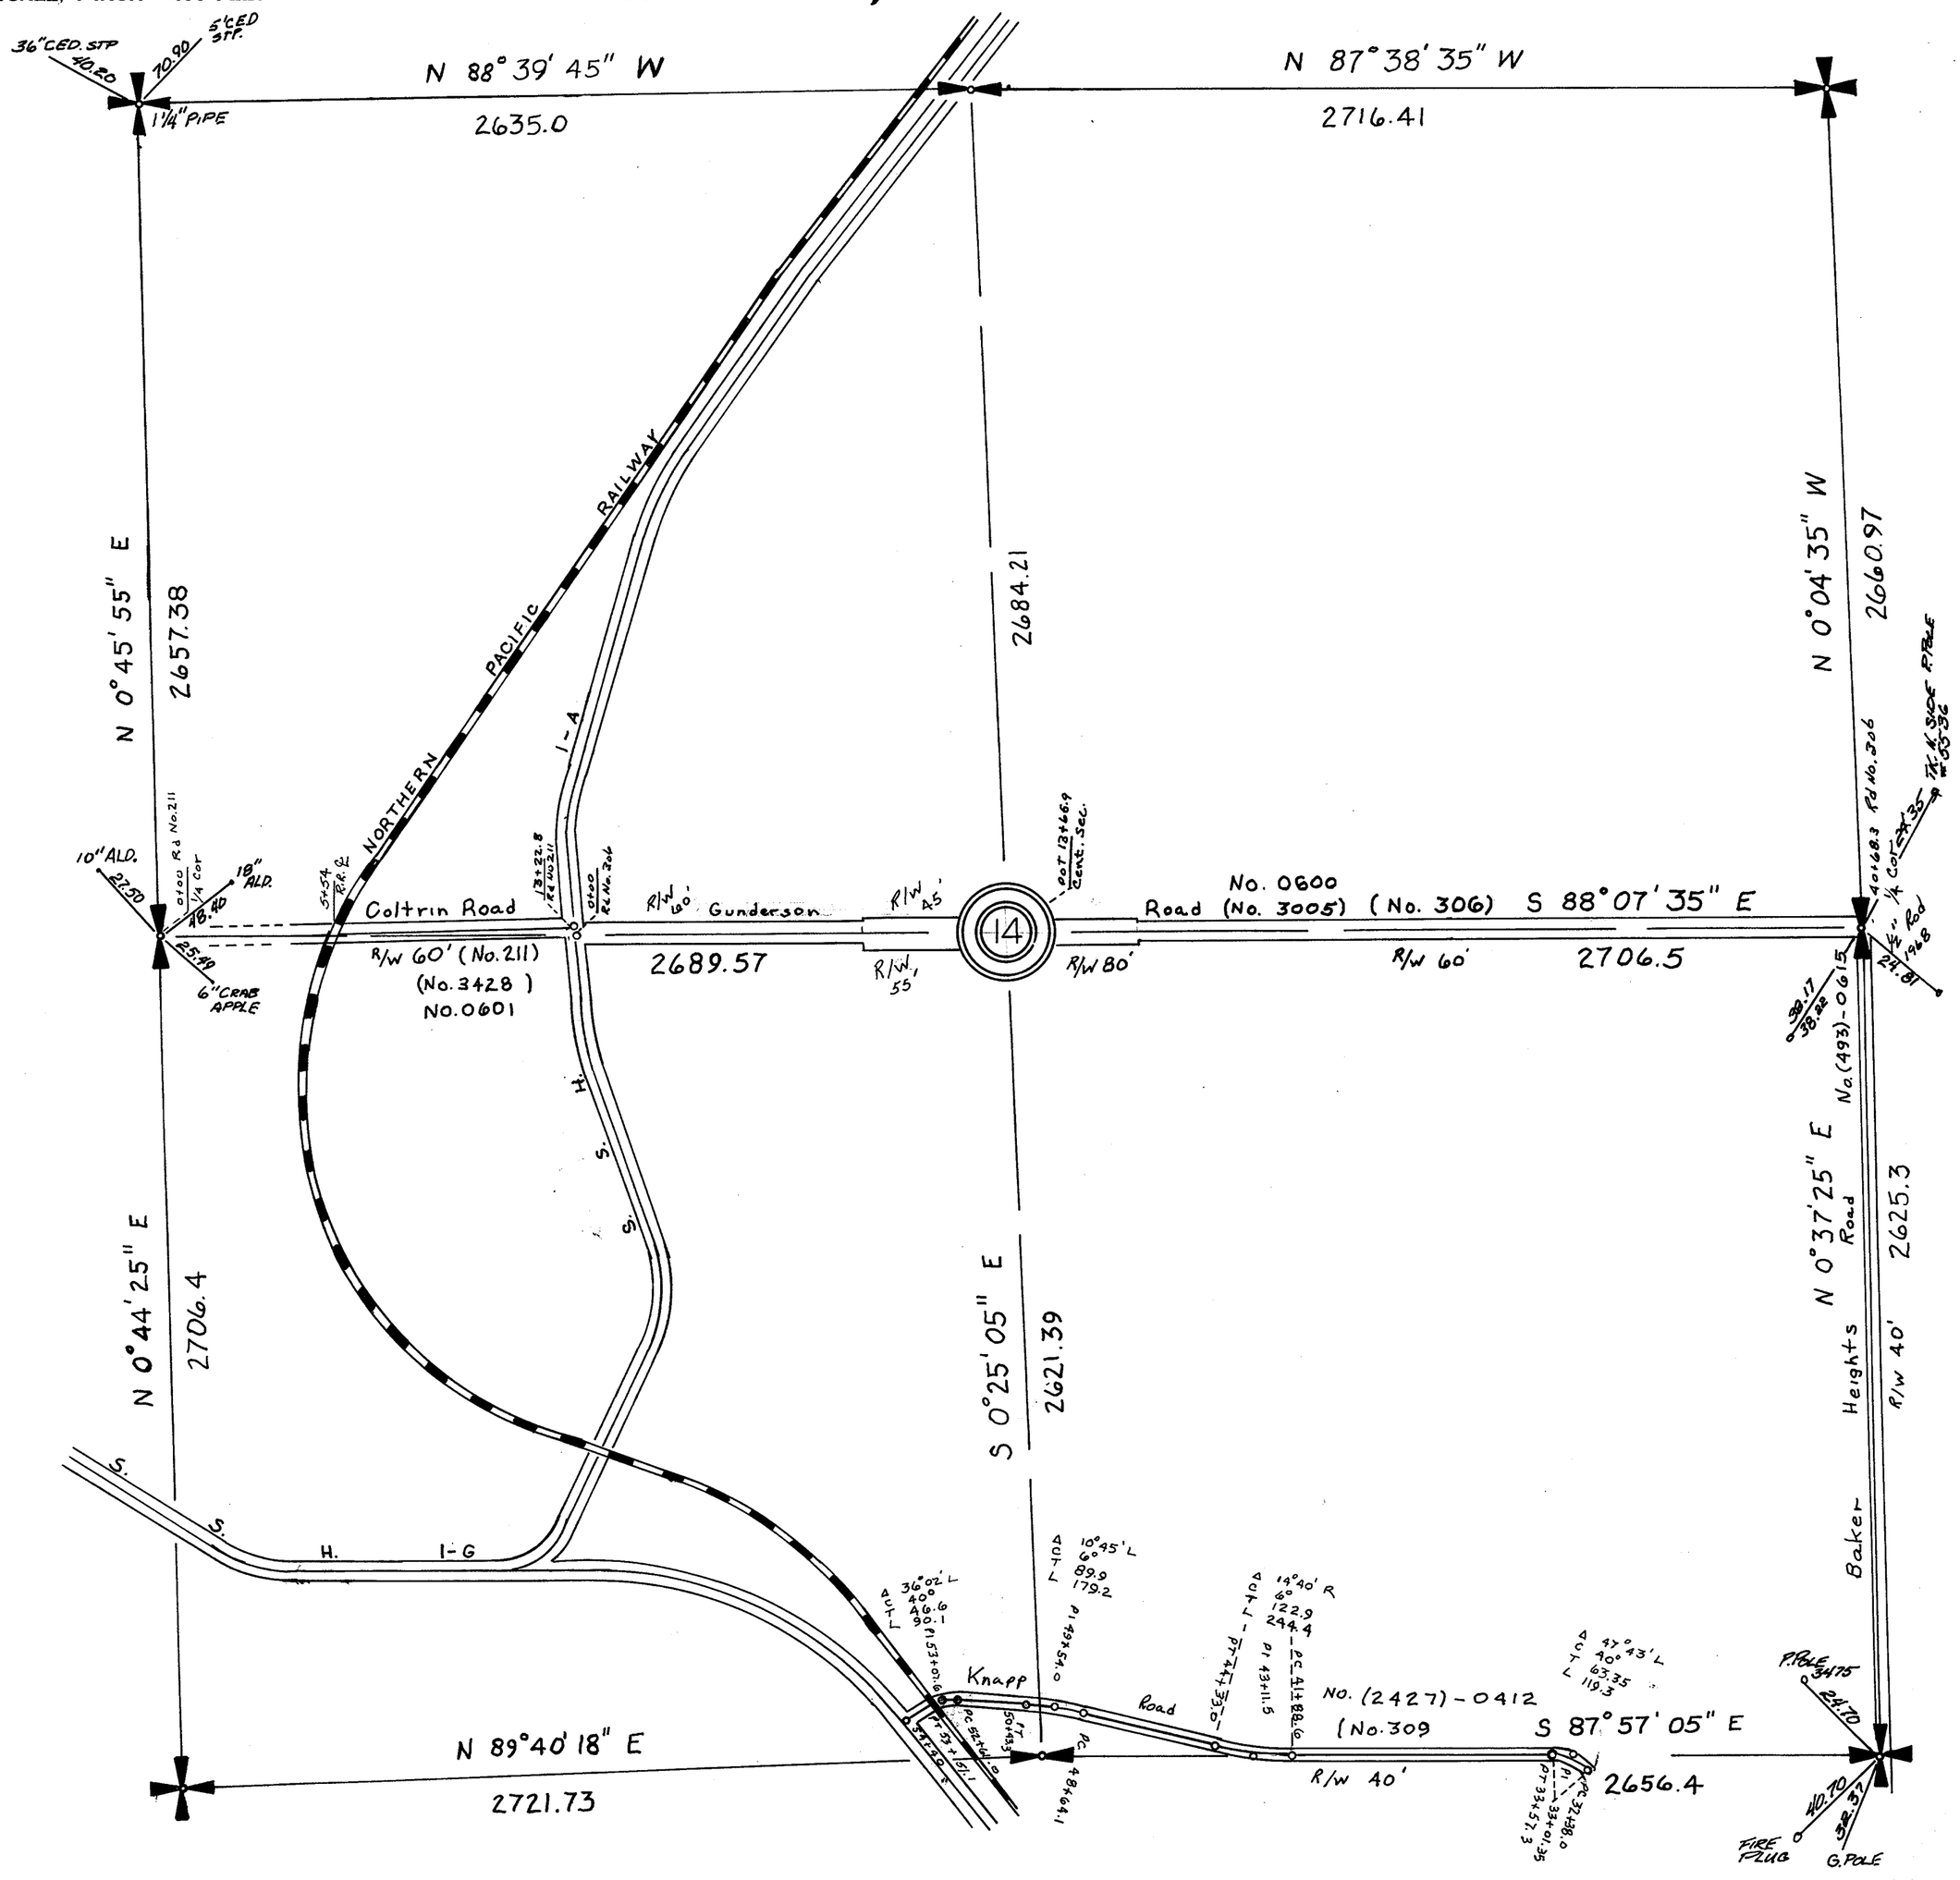

SECTION 15


TOWNSHIP 34 NORTH. RANGE 4 EAST. W. M.

SKAGIT COUNTY. WASH.

SCALE. 1 INCH—400 FEET

DATE Nov. 1 1973

Lloyd Johnson COUNTY ENGINEER

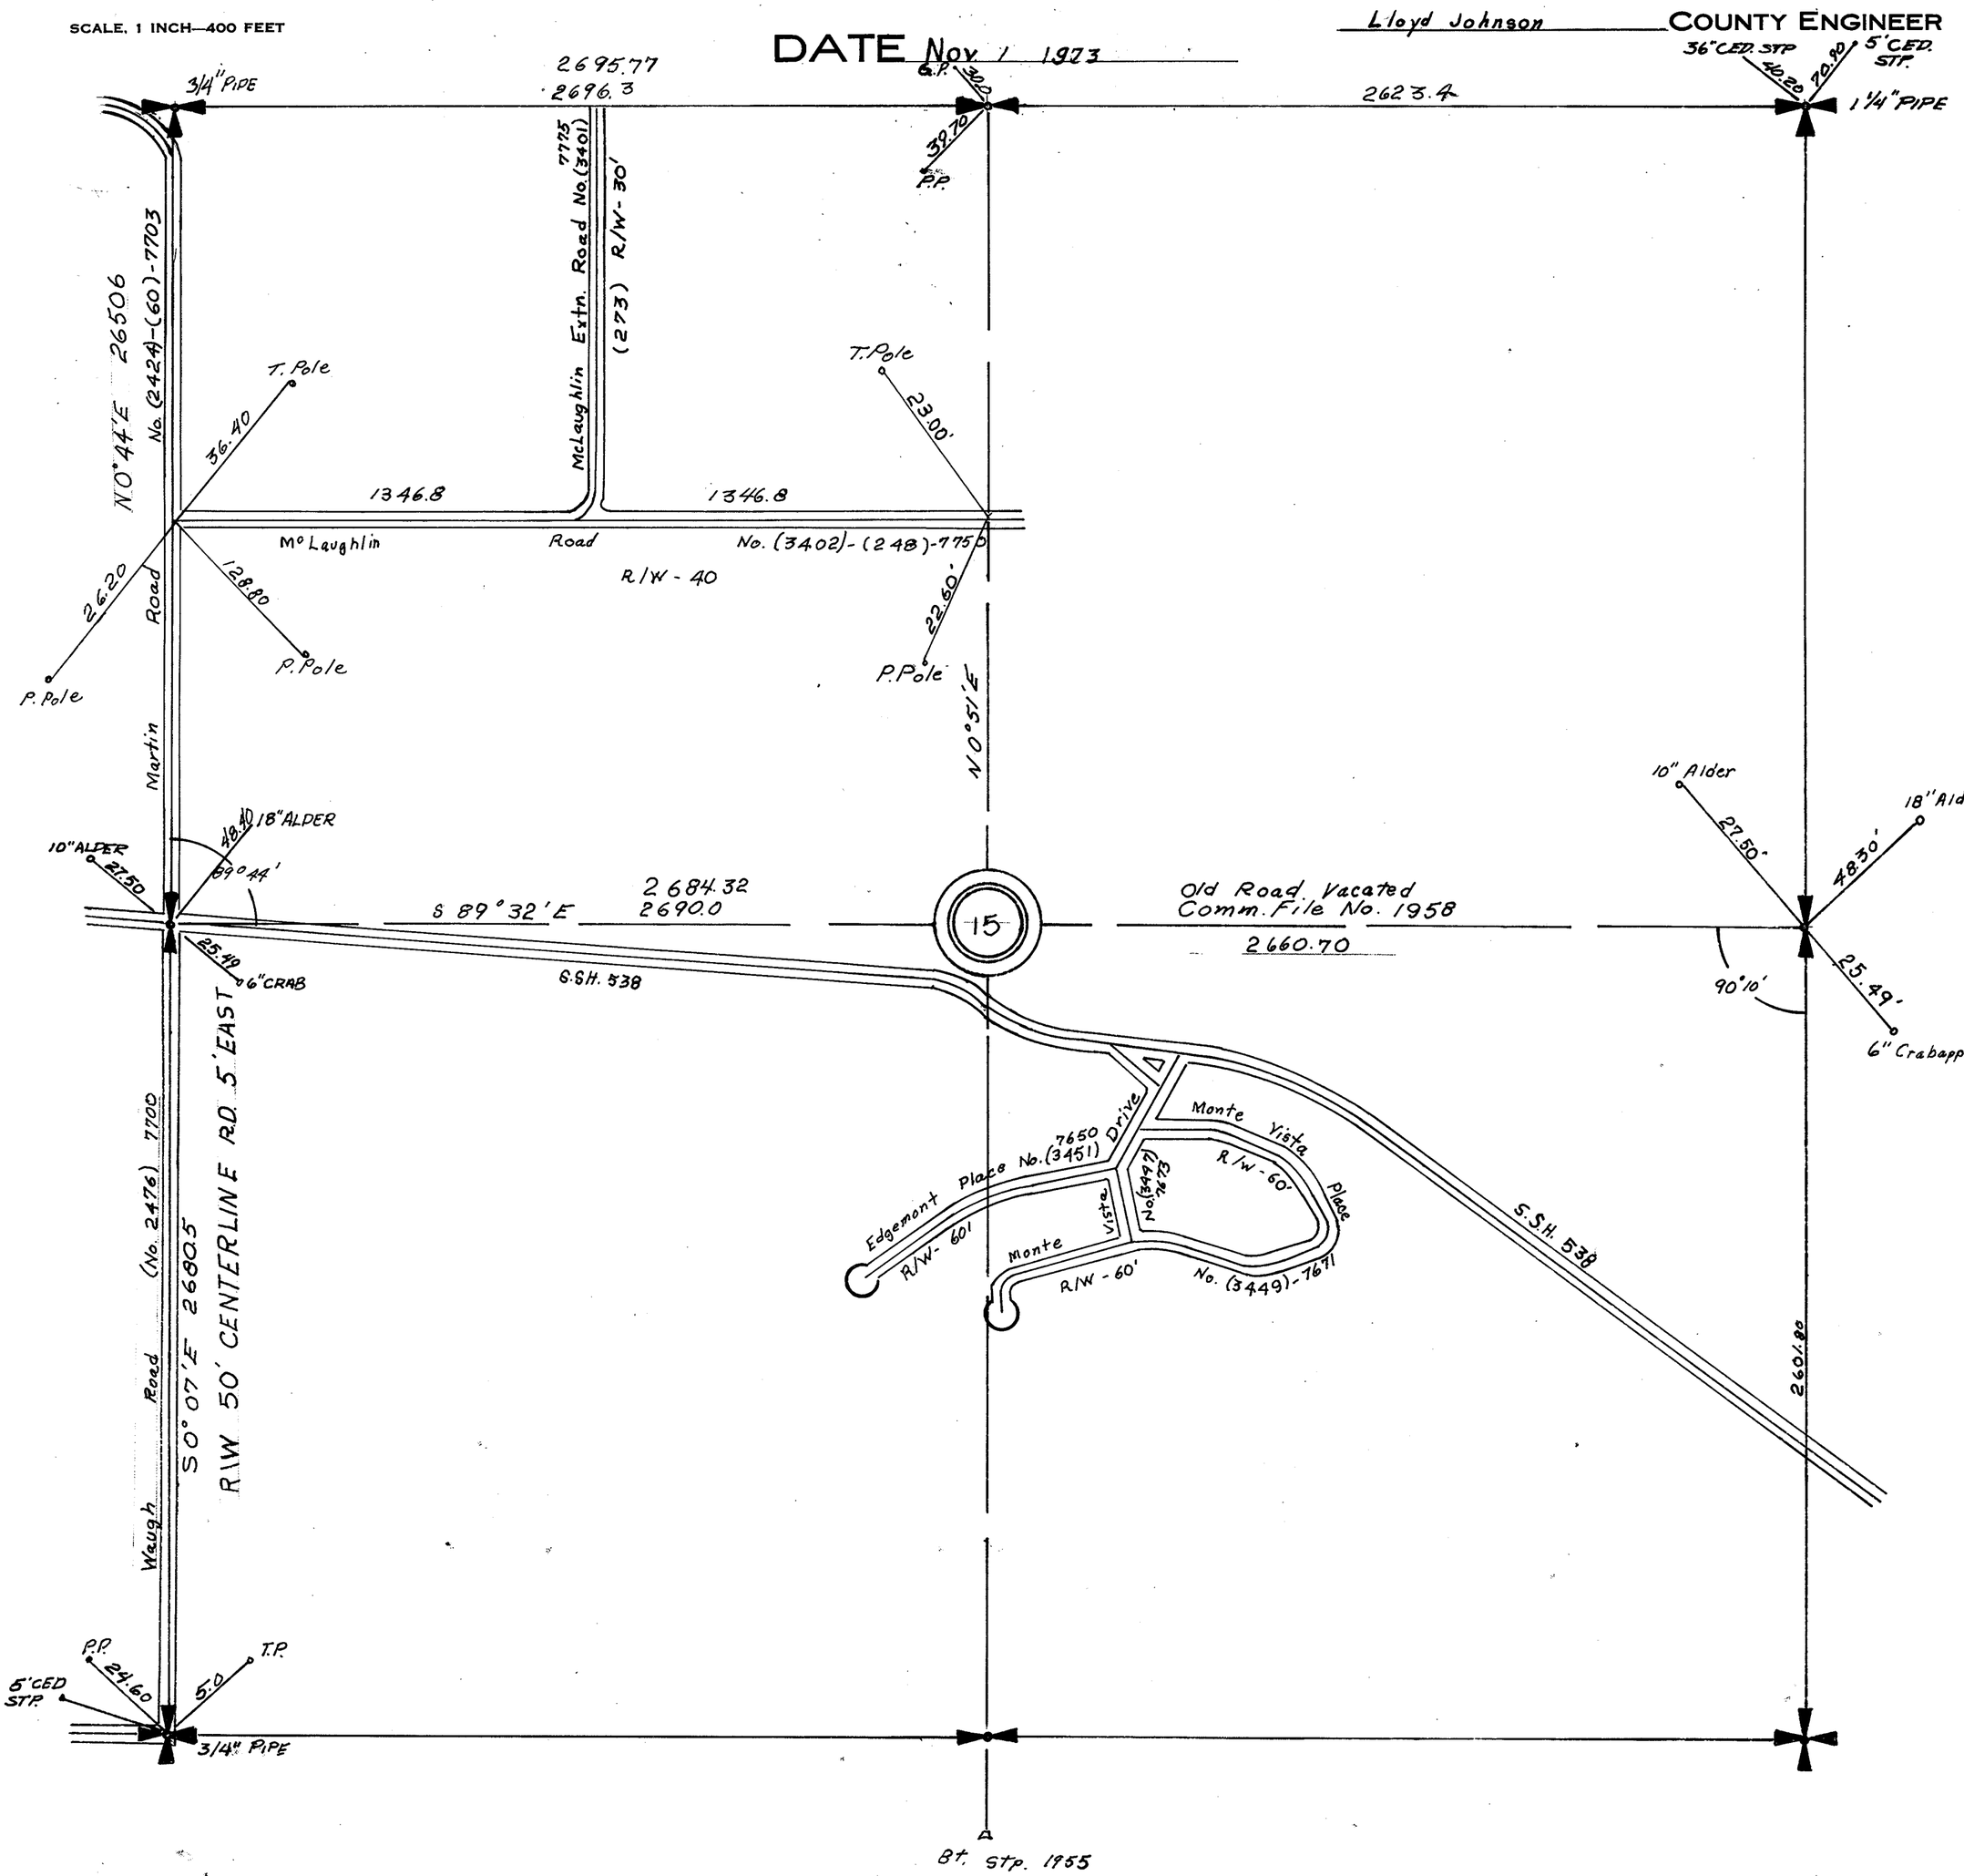


SECTION 15
TOWNSHIP 34 NORTH, RANGE 4 EAST, W. M.
SKAGIT COUNTY, WASH.

SCALE, 1 INCH--400 FEET

DATE July 14, 1966

Lloyd Johnson COUNTY ENGINEER

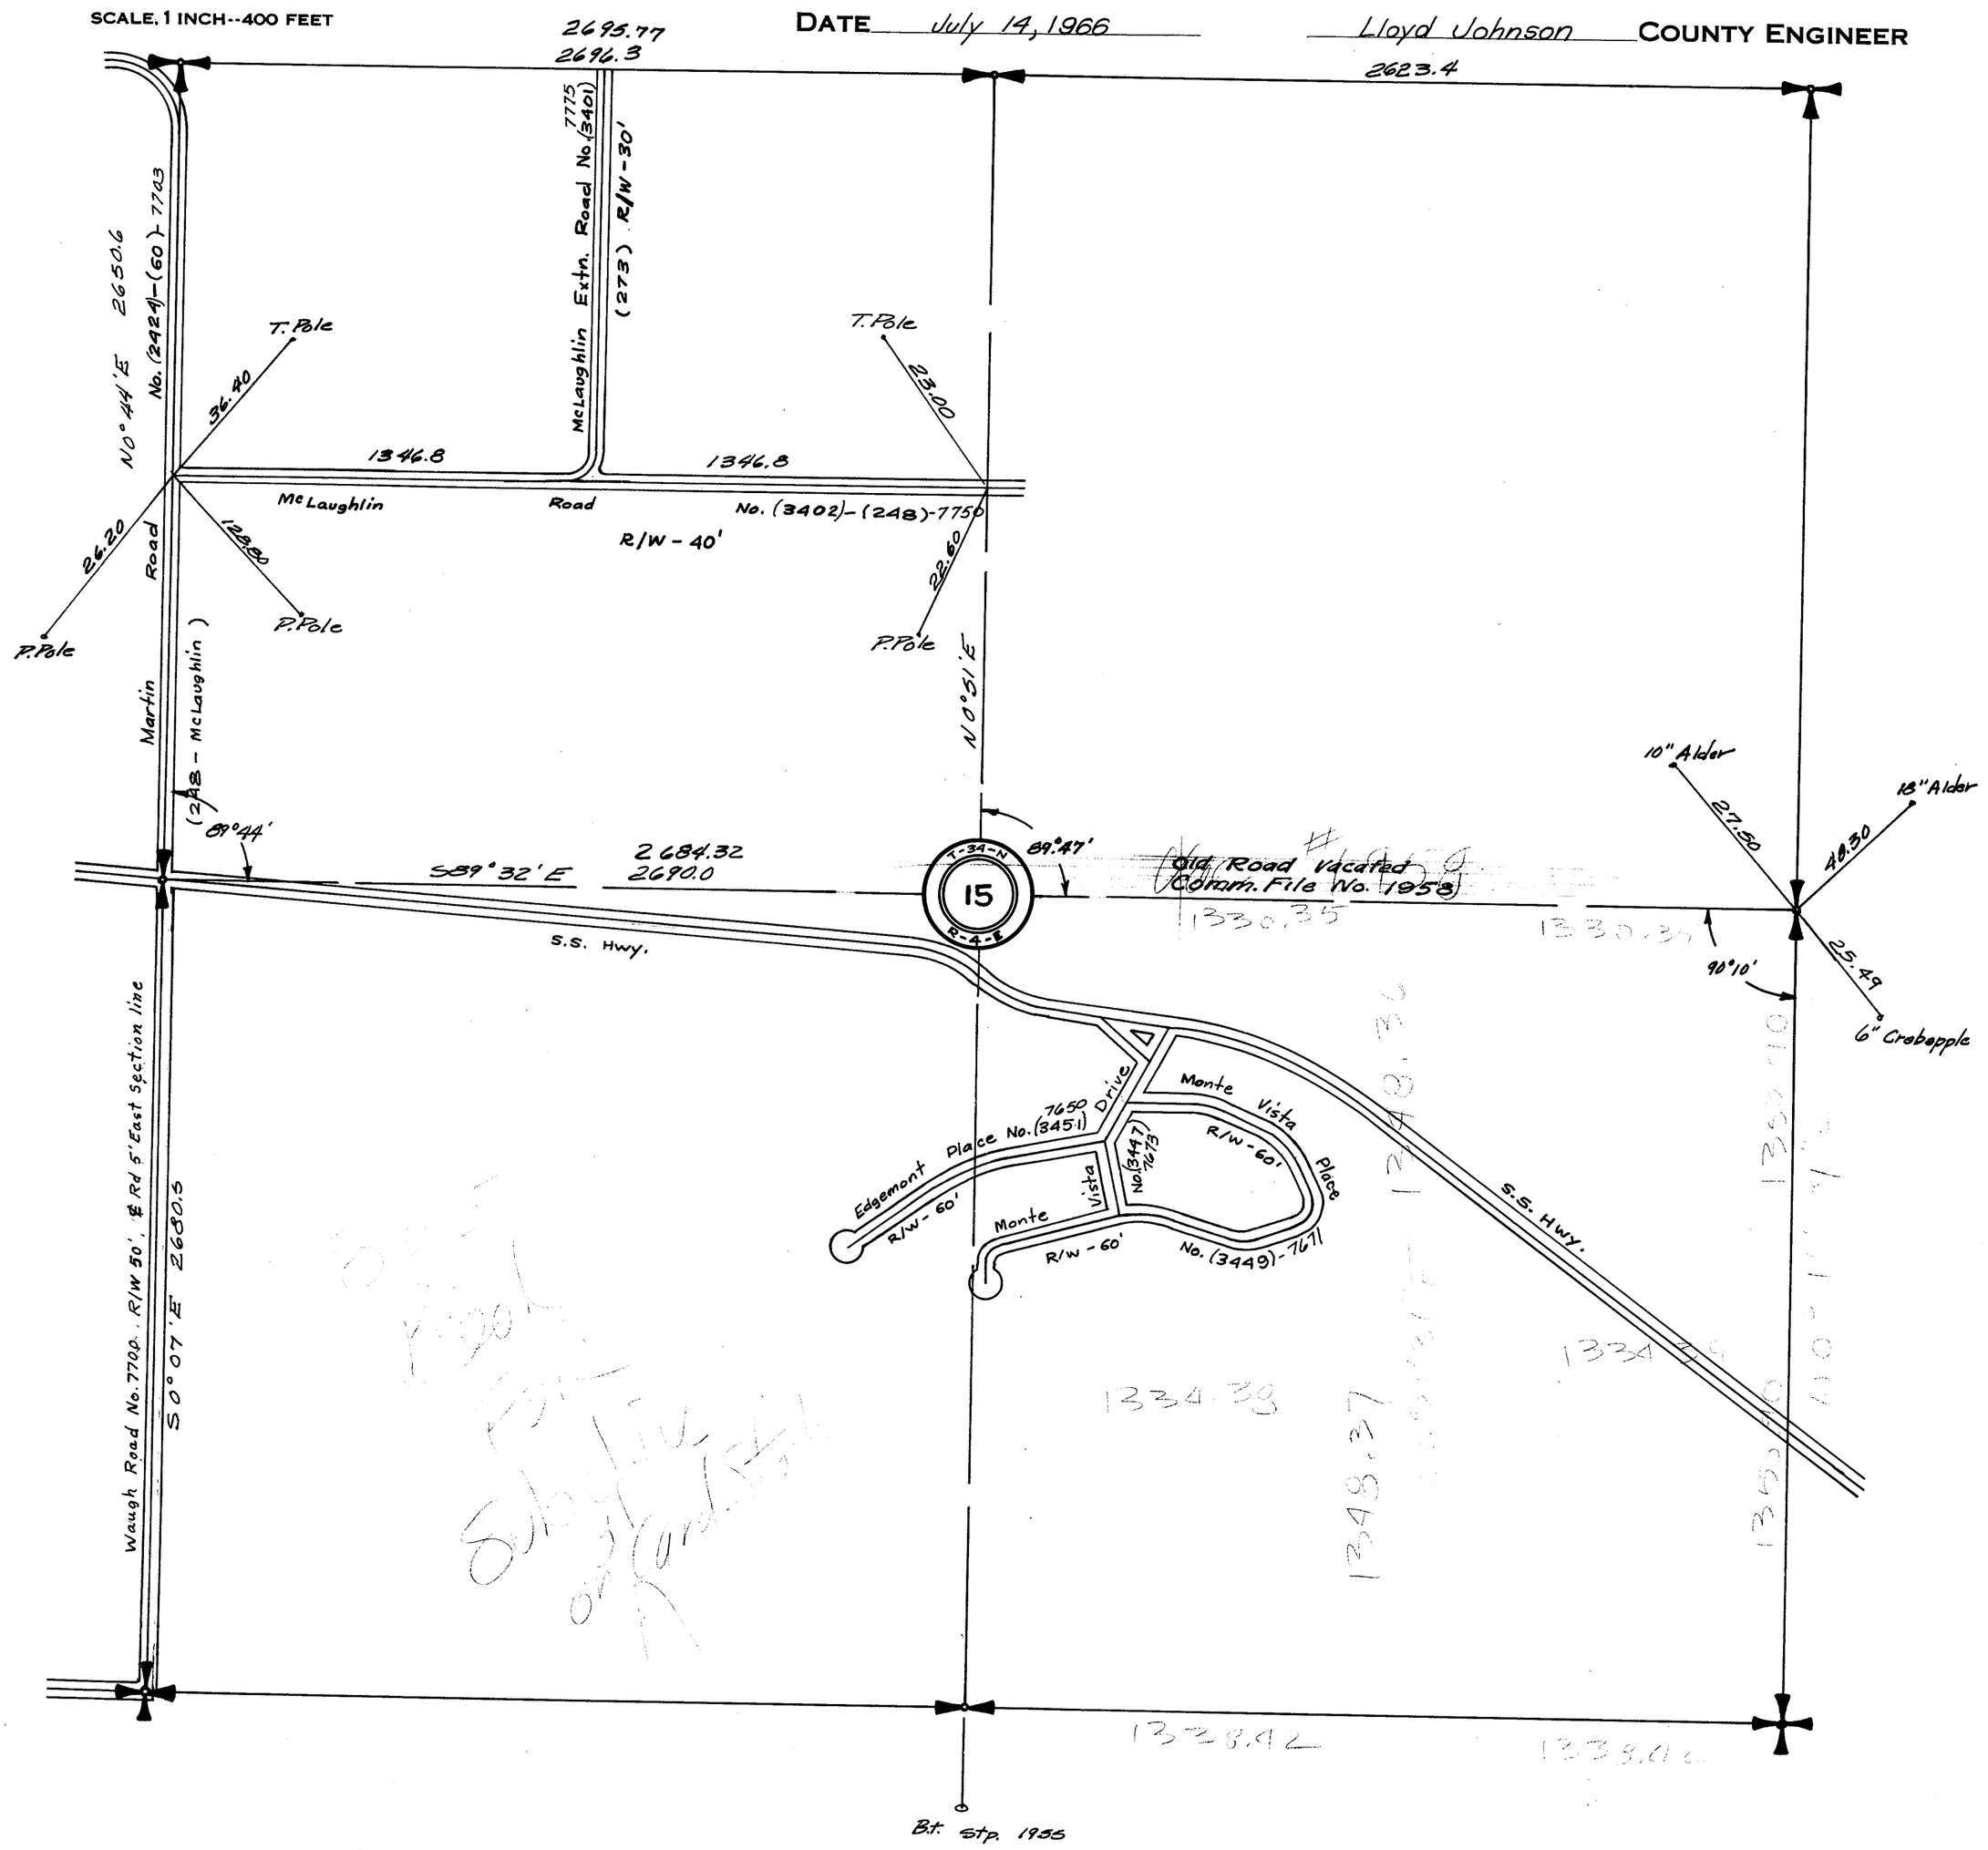


SECTION 15

TOWNSHIP 34 NORTH, RANGE 4 EAST, W. M.
SKAGIT COUNTY, WASH.

SCALE, 1 INCH–400 FEET

A. L. STRONG COUNTY ENGINEER

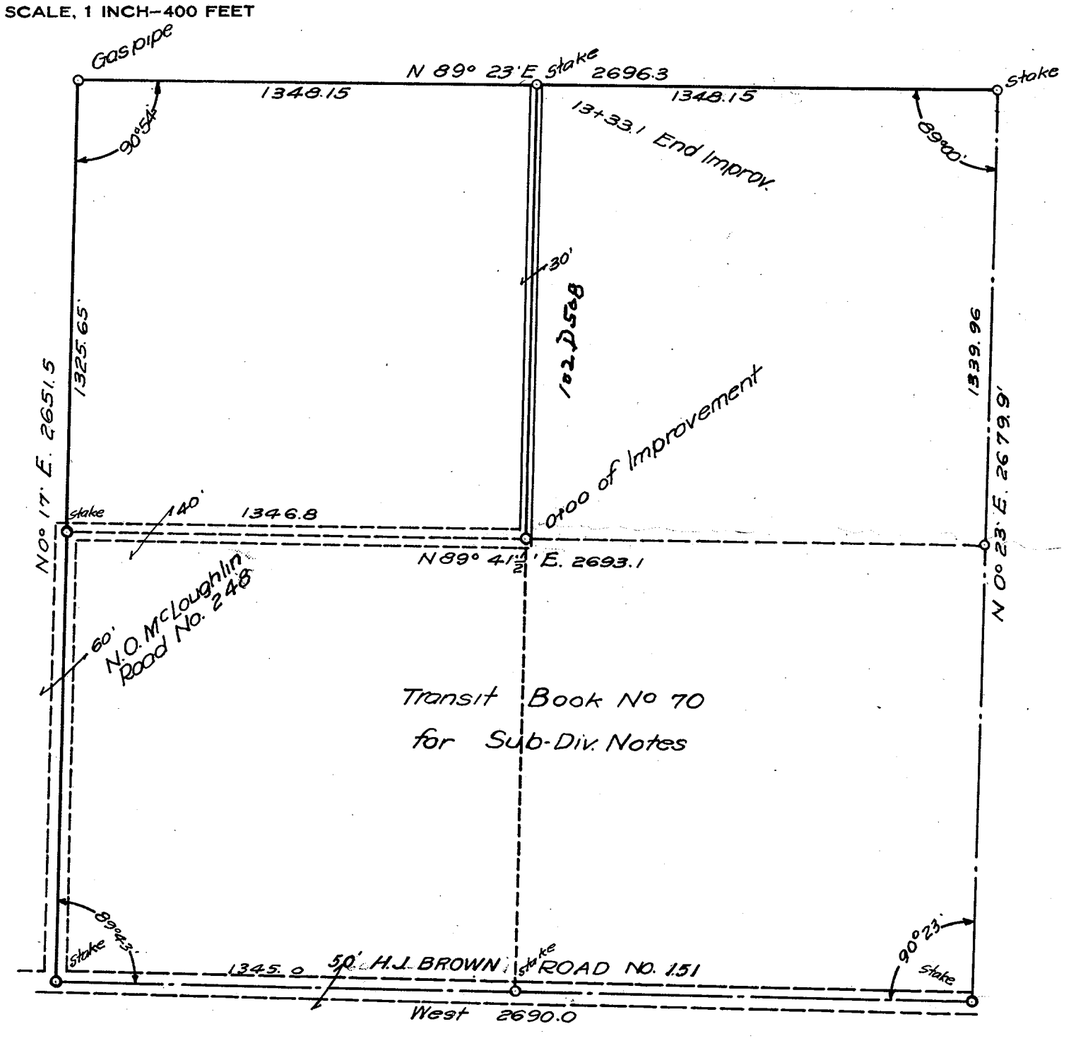

SECTION 16

TOWNSHIP 34 NORTH. RANGE 4 EAST. W. M.

SKAGIT COUNTY. WASH.

SCALE 1 INCH=400 FEET

COUNTY ENGINEER

T.P. 31.20 — 45.55 COR. P.

9 — 10

One Road Constructed on North side (AUGUST MARTIN ROAD NO 60) SURVEYED BY A.L. STRONG WIDTH 40'

F.P. 38.70

36+29.4

48+62.0

2629.4 Tr. Bk 59

2627.2 Tr. Bk 59

No. - 60 Martin Road No. (2424)-(60)-7703

R/W - 40'

3" FIR STP.

17 — 16 — 16 — 15

34.15 POLE — 28.00 P.P.

3/4" PIPE

Gaspipe

Mount Vernon

Martin Road No. (2424)-(60)-7703 (No. 248 McLaughlin Road) R/W - 40 & 60'

MON. HWY — S.S. Hwy. — S.S. Hwy. — MON. PAVT.

Waugh Road No. 7700 R/W 50' E Rd 5' East section line

N. 0°20'7" W. 2680.5

Mount Vernon

T.P. 68.70 — 34.00 P.P. — PIPE IN CASE

Hensley — 49.50 P.P. — 20.0 P.P.

Road

T.P. — 93.50 SW COR. Hs.

No. (2476)-(133)-7700

R/W - 60' — 1" ROD — 57.50 P.P.

P.P. — 2.0 — T.P. — 5.00

5' CED STP. 71.40

3/4" PIPE

63.22 Hs.

SECTION 17


TOWNSHIP 34 NORTH, RANGE 4 EAST, W. M.

SKAGIT COUNTY, WASH.

SCALE, 1 INCH—400 FEET

NOTES: 534
494

A. L. STRONG COUNTY ENGINEER

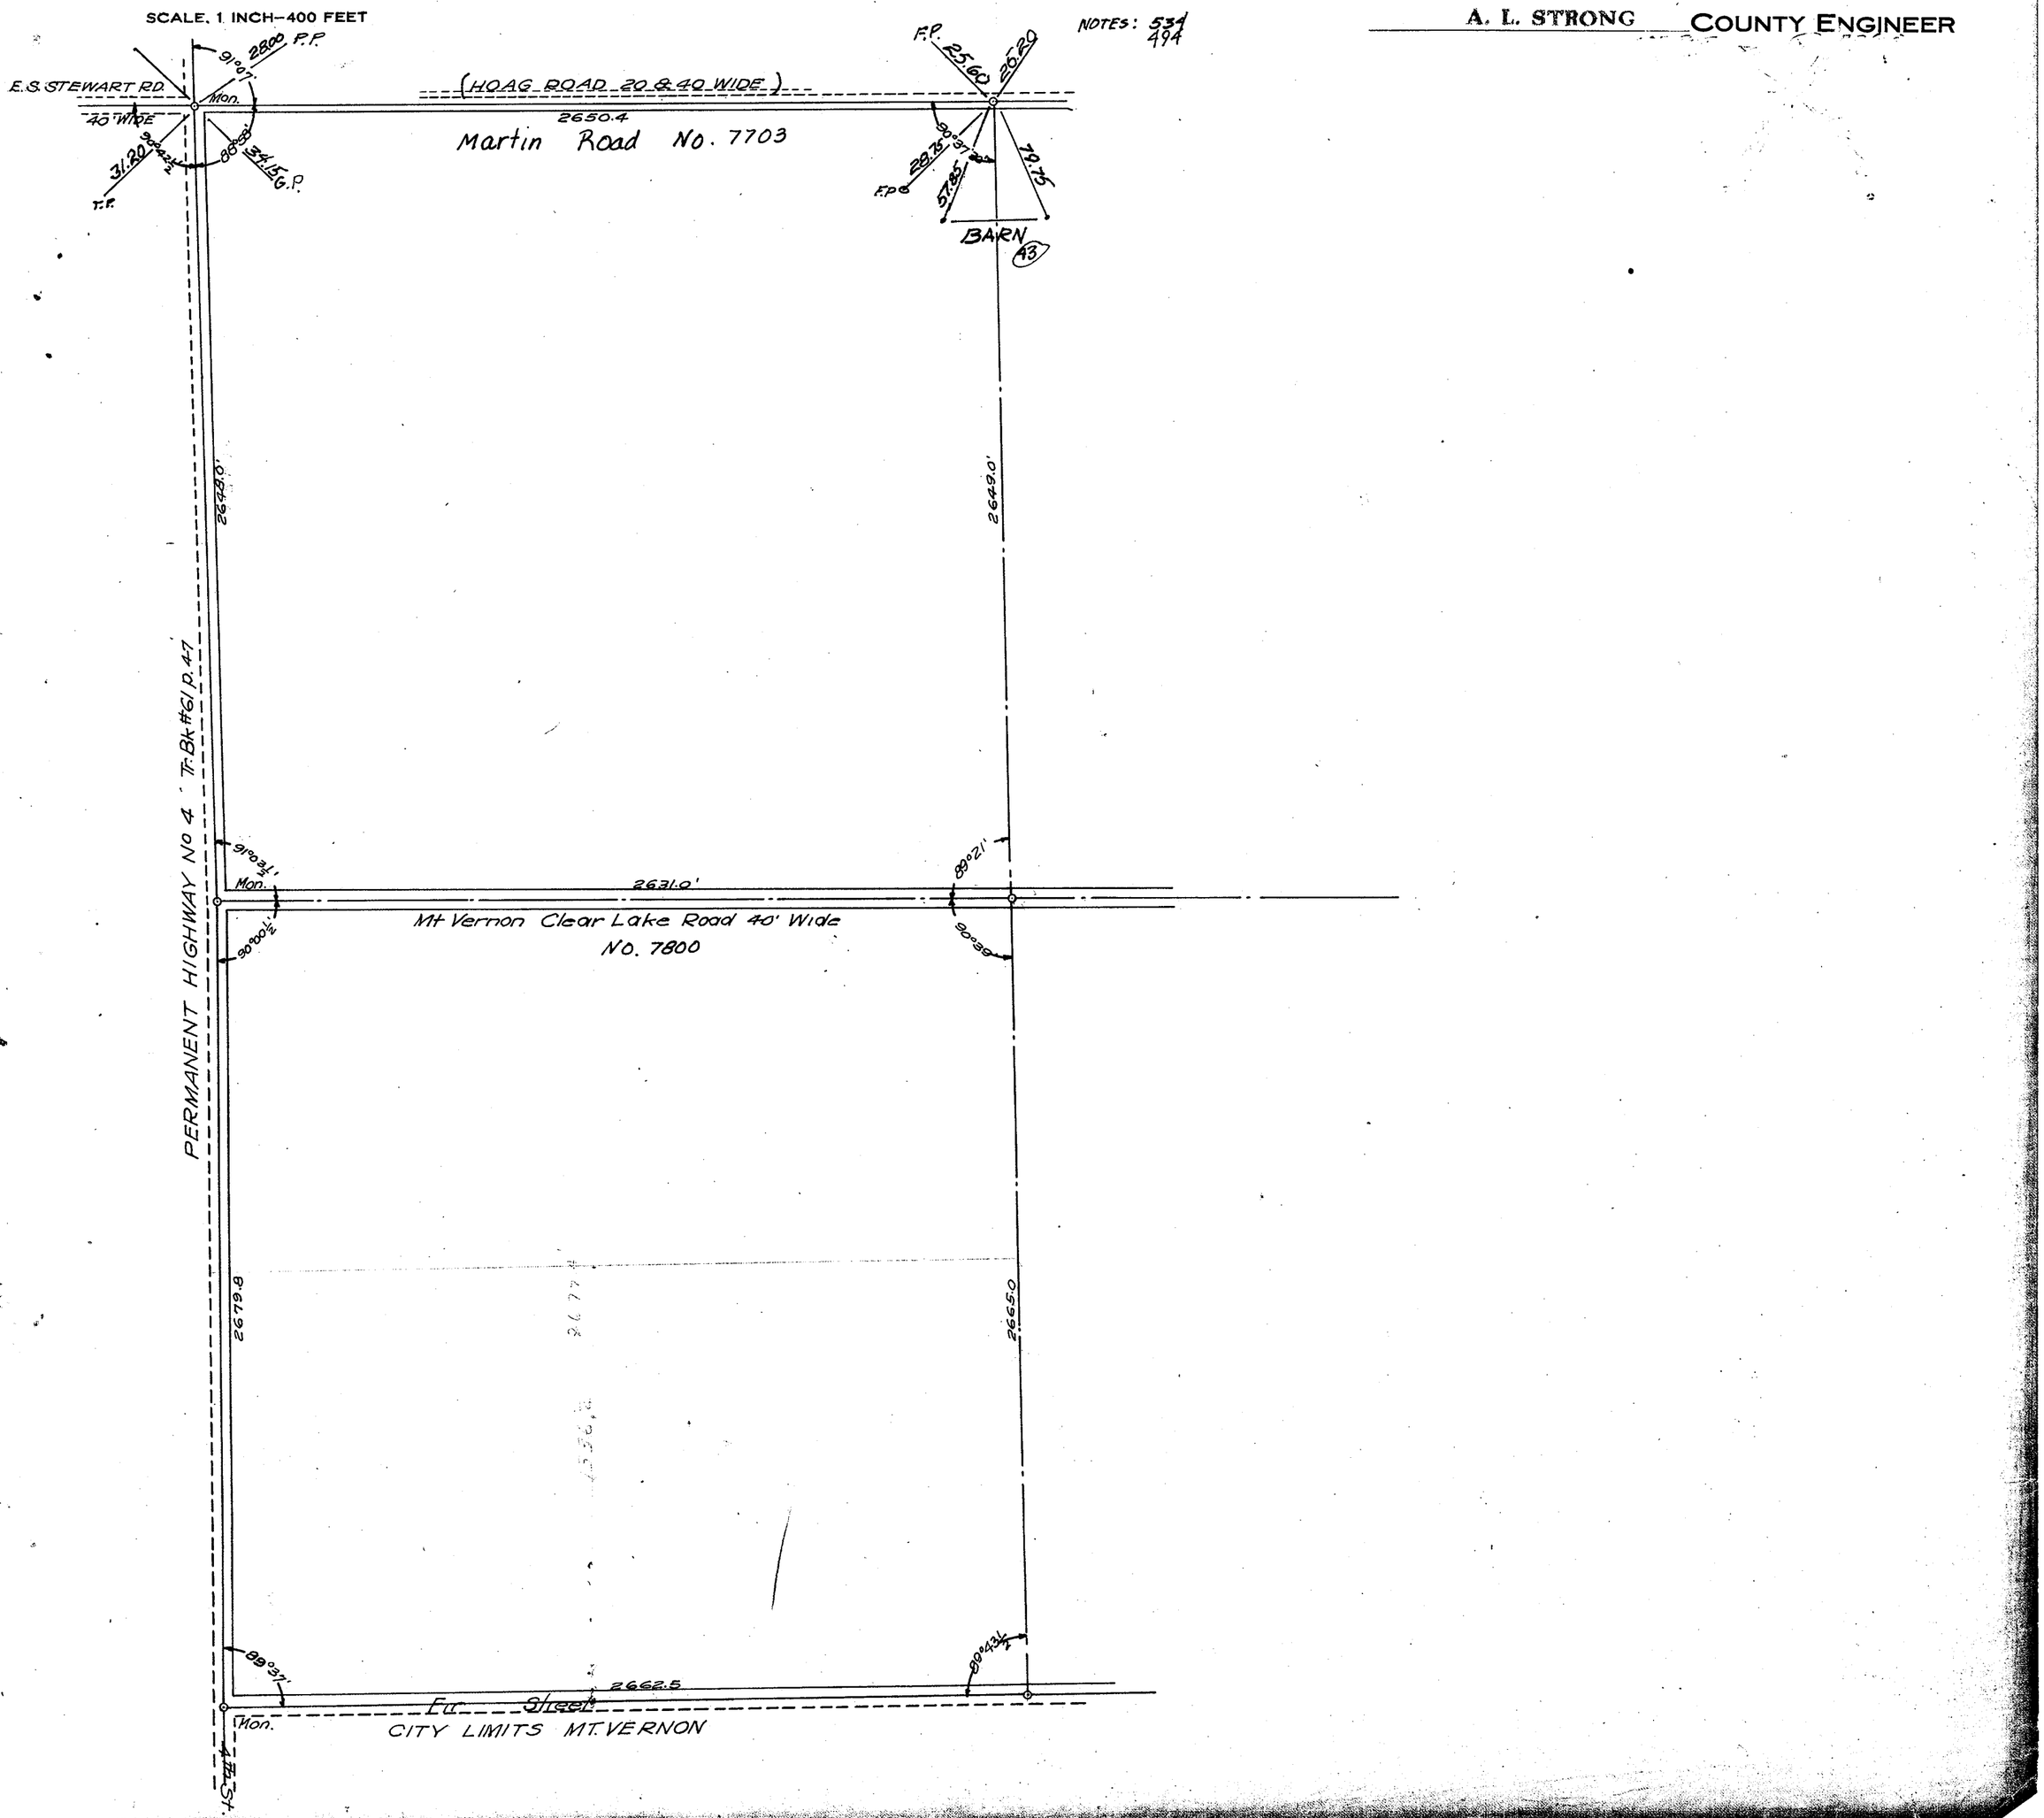

SECTION 18

TOWNSHIP 34 NORTH, RANGE 4 EAST, W. M.
SKAGIT COUNTY, WASH.

SCALE, 1 INCH–400 FEET

A. L. STRONG COUNTY ENGINEER



SECTION 18

TOWNSHIP 34 NORTH, RANGE 4 EAST, W. M.

SKAGIT COUNTY, WASH.

SCALE, 1 INCH--400 FEET

Subdiv. 35/285 except as noted

Assembled by WCW 7-3-50

H.O. WALBERG COUNTY ENGINEER

SRP No. 43. A1/2

F.P.

7.30

S 10° 46' 47" W 46.12.10

2" AXLE 1' BELOW OIL SURFACE

S89°23'40"E 2717.41

45.68

TACK IN N. SIDE P.P. BLM.P. 6/68

42.00

P.P.

13.83

52.00

F.P.

58.22

F.P.

8" APPLE TREE

P.P.

60.20

67.7.71 1390.04

S89° 11'30"E 2662.72

56.40.17 10052.49

MON. PAV'T.

63.00

P.P.

N 0° 11' 22" W 2671.1

N 30.35.54 E 4707.62

2664.08

3013.63 7383.67

N 0° 06' 30" E 2648.3

MON. IN PAVT. S 89°31'50"E 2671.14

3/4" PIPE

2663.86

2991.87 10047.44

MON. IN PAV'T,

89°21' msd. 2-3-50

G 185 G 186

N 0° 03' 02" W 2923.34

N 0° 08' 13" E 29[illegible].03

N 10660 E 7376.71

N 10° [illegible]' 10" E 26[illegible]

319.62 9997.33

MON. IN PAVT.

P.P. 29.10

43.19

117.20 47.10.20

6" WALNUT TREE

PIPE & PLUG

S 89° 52' 47" E 2665.48

from plat in Sec. 19

N 85° 21' 10" E 2629.26

F.G.


SECTION 18

TOWNSHIP 34 NORTH, RANGE 4 EAST, W.M.
SKAGIT COUNTY, WASH.

SCALE, 1 INCH = 400 FEET

MAY 9, 1972


LLOYD H. JOHNSON COUNTY ENGINEER

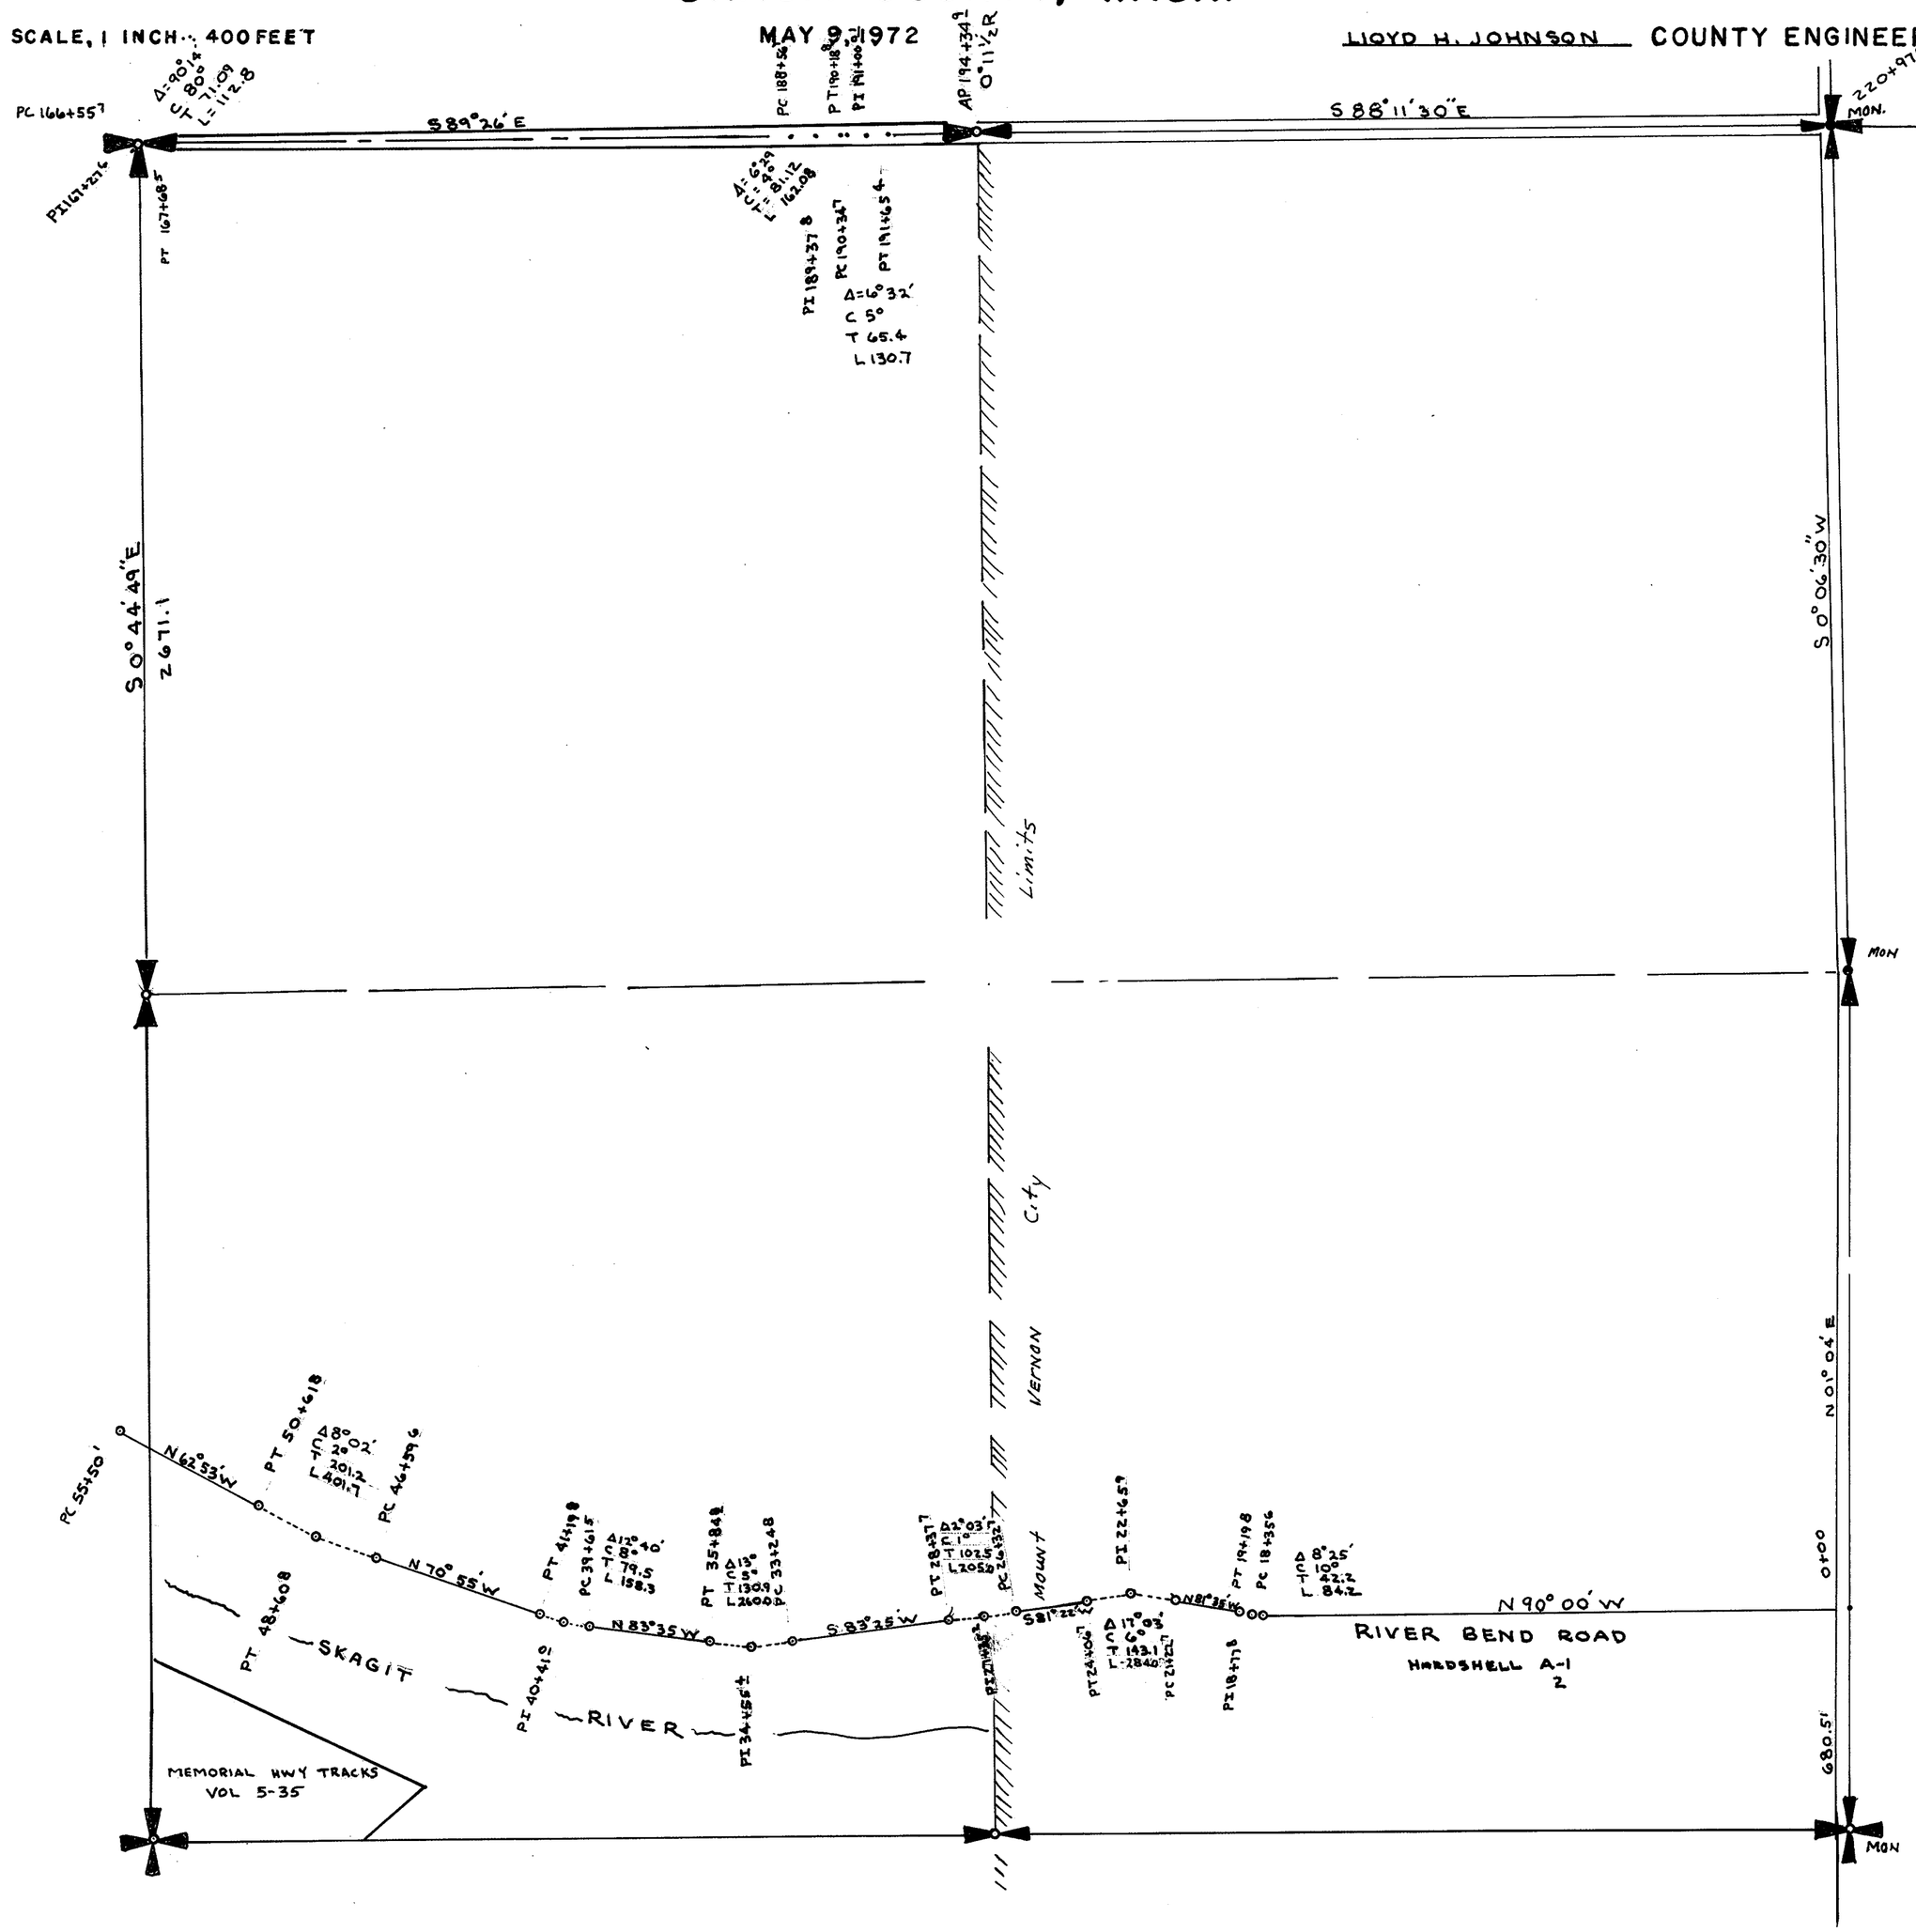

SKAGIT COUNTY

SCALE 1" = 400'

SEC. 19 TWP. 34 R. 4

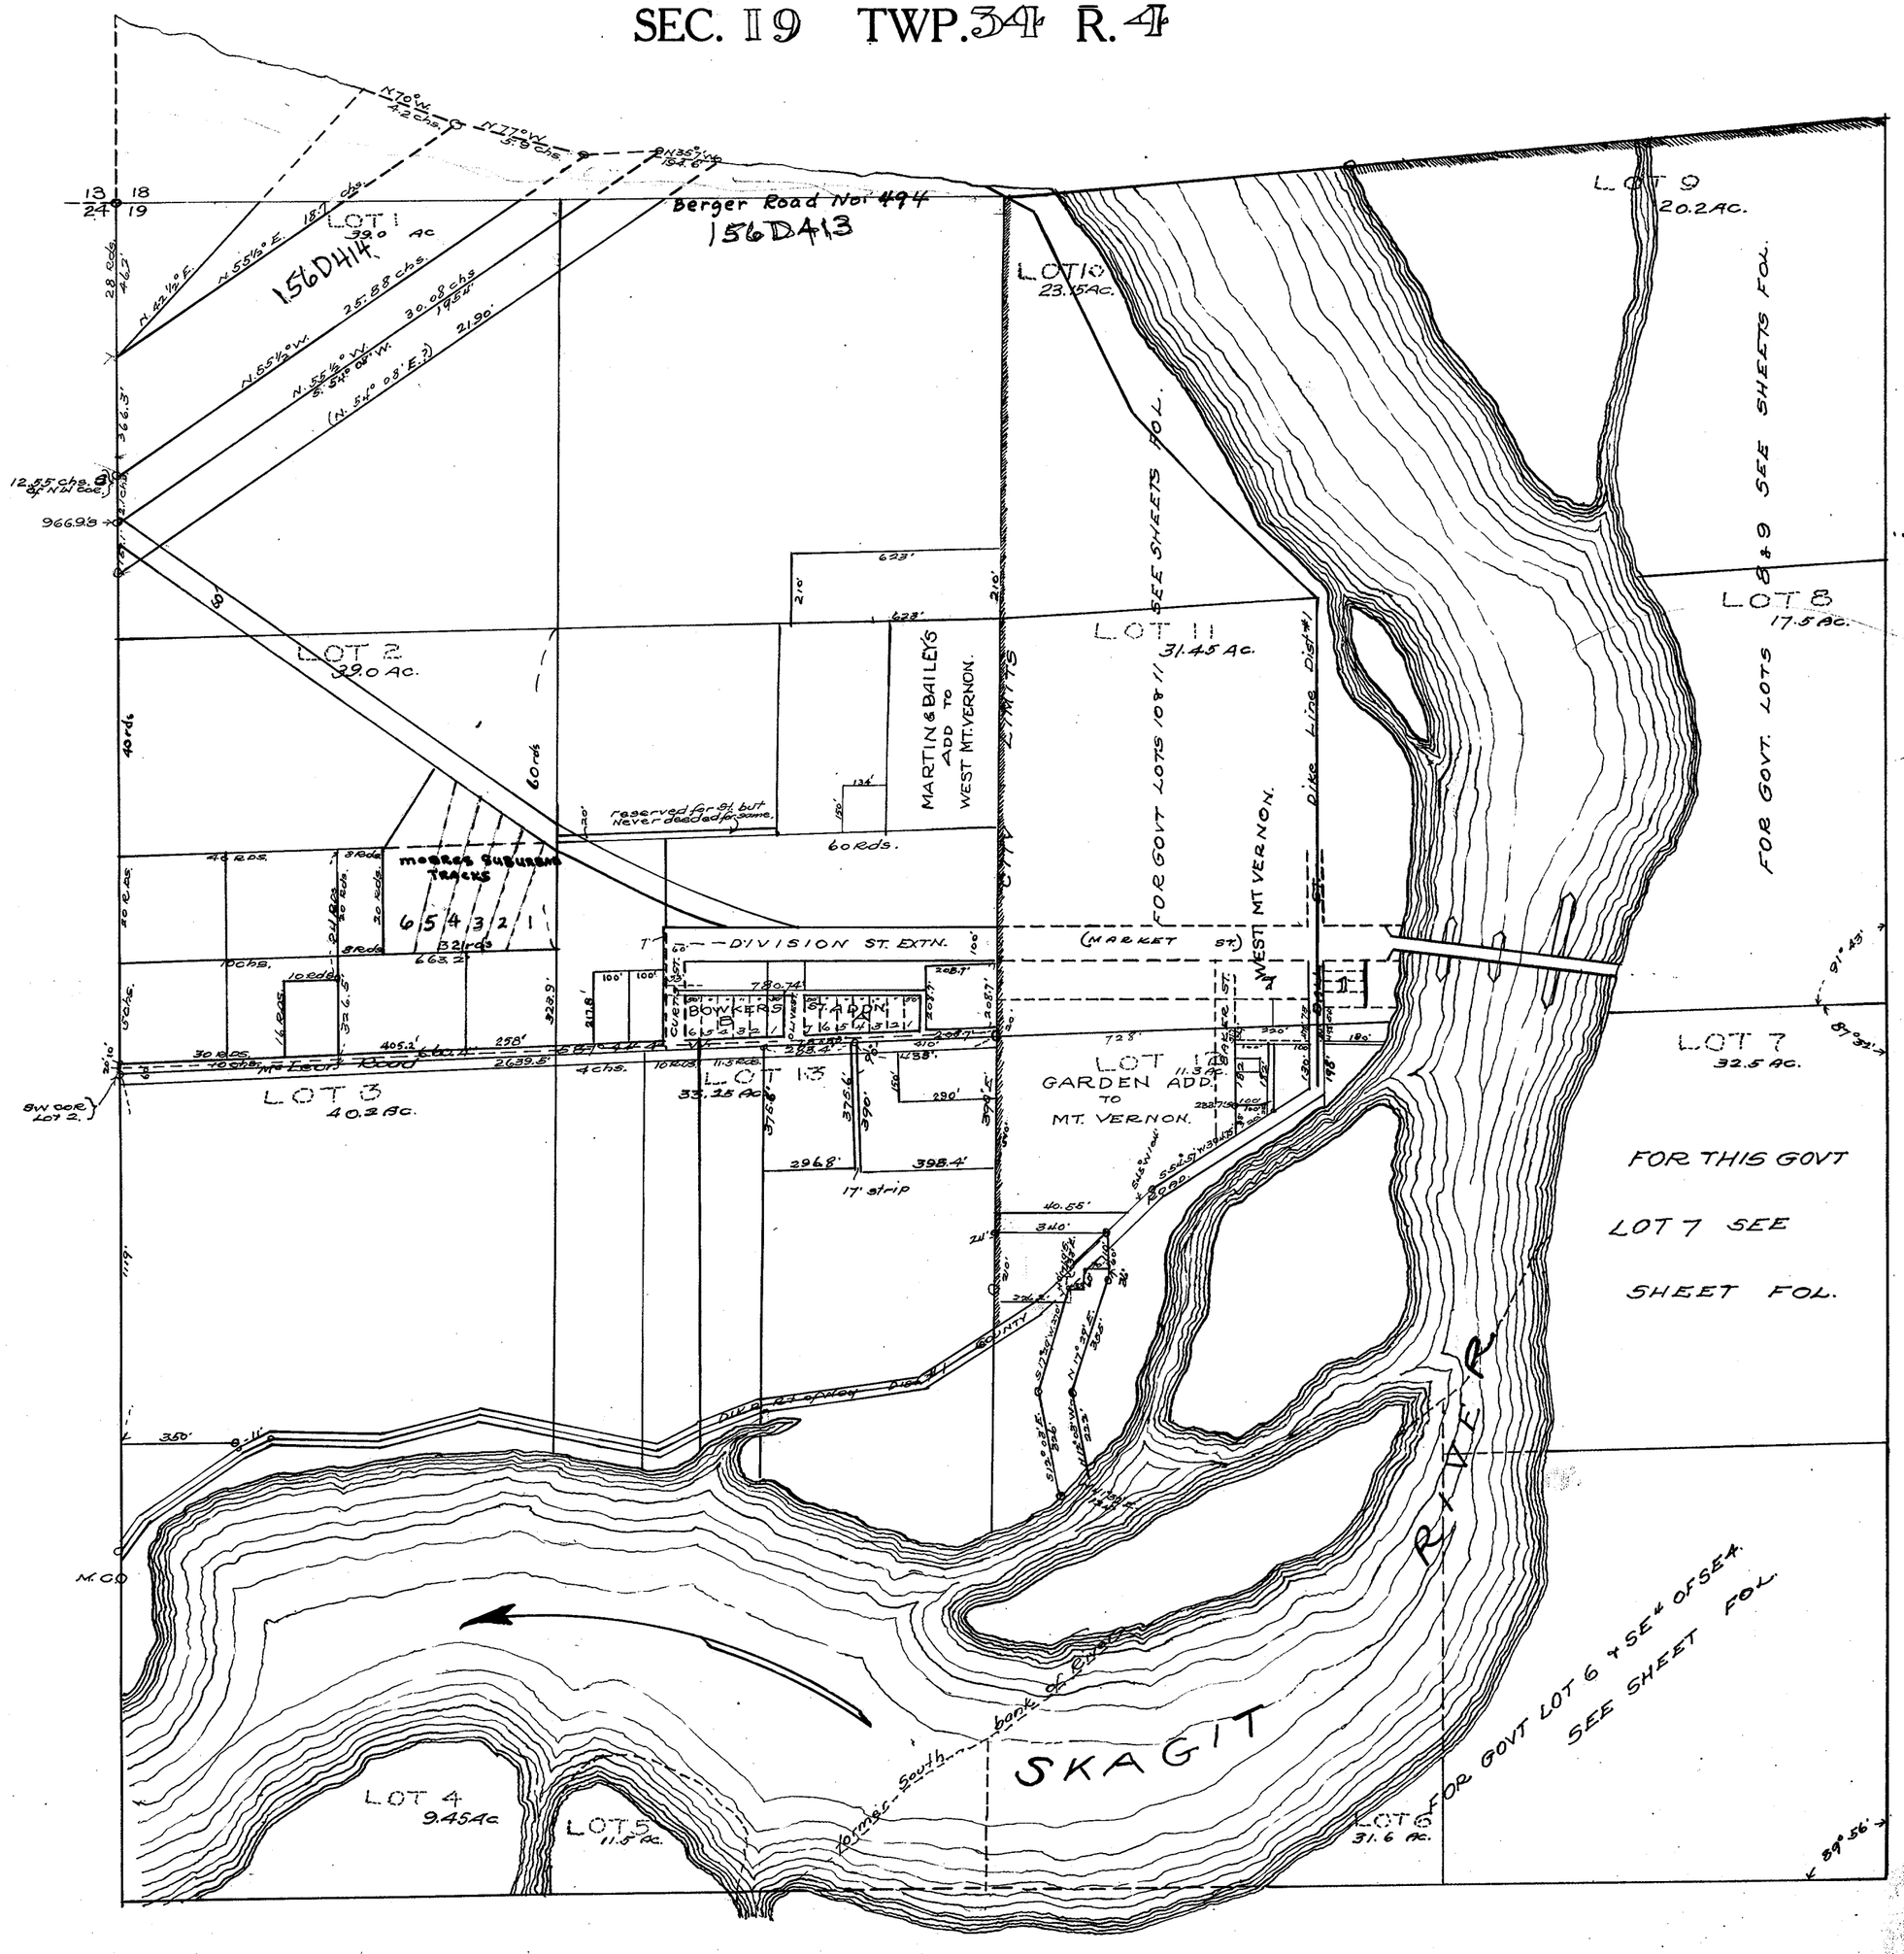

SECTION 19

TOWNSHIP 34 NORTH, RANGE 4 EAST, W. M.

SKAGIT COUNTY, WASH.

SCALE, 1 INCH = 400 FEET

DATE July 19, 1966

Lloyd Johnson COUNTY ENGINEER

P.P. 29.10 43.1 6" WALNUT

PIPE & PLUG

2664.13
2665.48

(No. 2434)-4520

174°22'40"

2629.26

90°25'30"

MEMORIAL HWY. TRACKS
VOL-5 Pg 35

Moore's Garden Road No.(2453)-(458)-4540

R/W - 60'

(Berger Road) No.(2434)
Dunbar Road
(494)

4520

95°53'25"

91°02'55"

R/W - 40'

86°07'44"

2549.66

VERNON CITY LIMITS

2631.0

P.S.H. -(1)-536

(VACATED 1947 File #7588)

NOT vacated

N88°02'30"E

2650.99

R/W - 40'
Cascade St.
Road No.(24120)
4504

Lincoln St.
Road No.(24118)
4502

MOUNT VERNON

RIVER

2686.39

N1°30'05"W

R/W - 60'
Lane Boulevard
No.(2483)-(642)-4621

Not Constructed
Norman Place No. 4622

(No. 2490)-(643)

Bonney
R/W-60'

87°47'

P.Pole

40.15

41.30 G. Pole

87°06'23"

N1°11'25"E

MON.

2639.4

2712.22

S88°21'W

90°51'10"

McLean Road No.(2012)-(365)-4400

87°09'33"

87°55'27"

87°32"

91°02'20"

25.00

40.50

T. Pole

G. Pole

2626.8

Behrens and Millett Road No.(4424)-(8)
NO. 4582

MOUNT VERNON CITY LIMITS

2538.1

2655.29

SKAGIT

86°56'

94°53'05"

88°48'15"

90°00'07"

2561.60
2562.12


2763.77
2726.70

SECTION 19

TOWNSHIP 34 NORTH, RANGE 4 EAST, W. M.
SKAGIT COUNTY, WASH.

SCALE, 1 INCH–400 FEET

A.L. STRONG. COUNTY ENGINEER

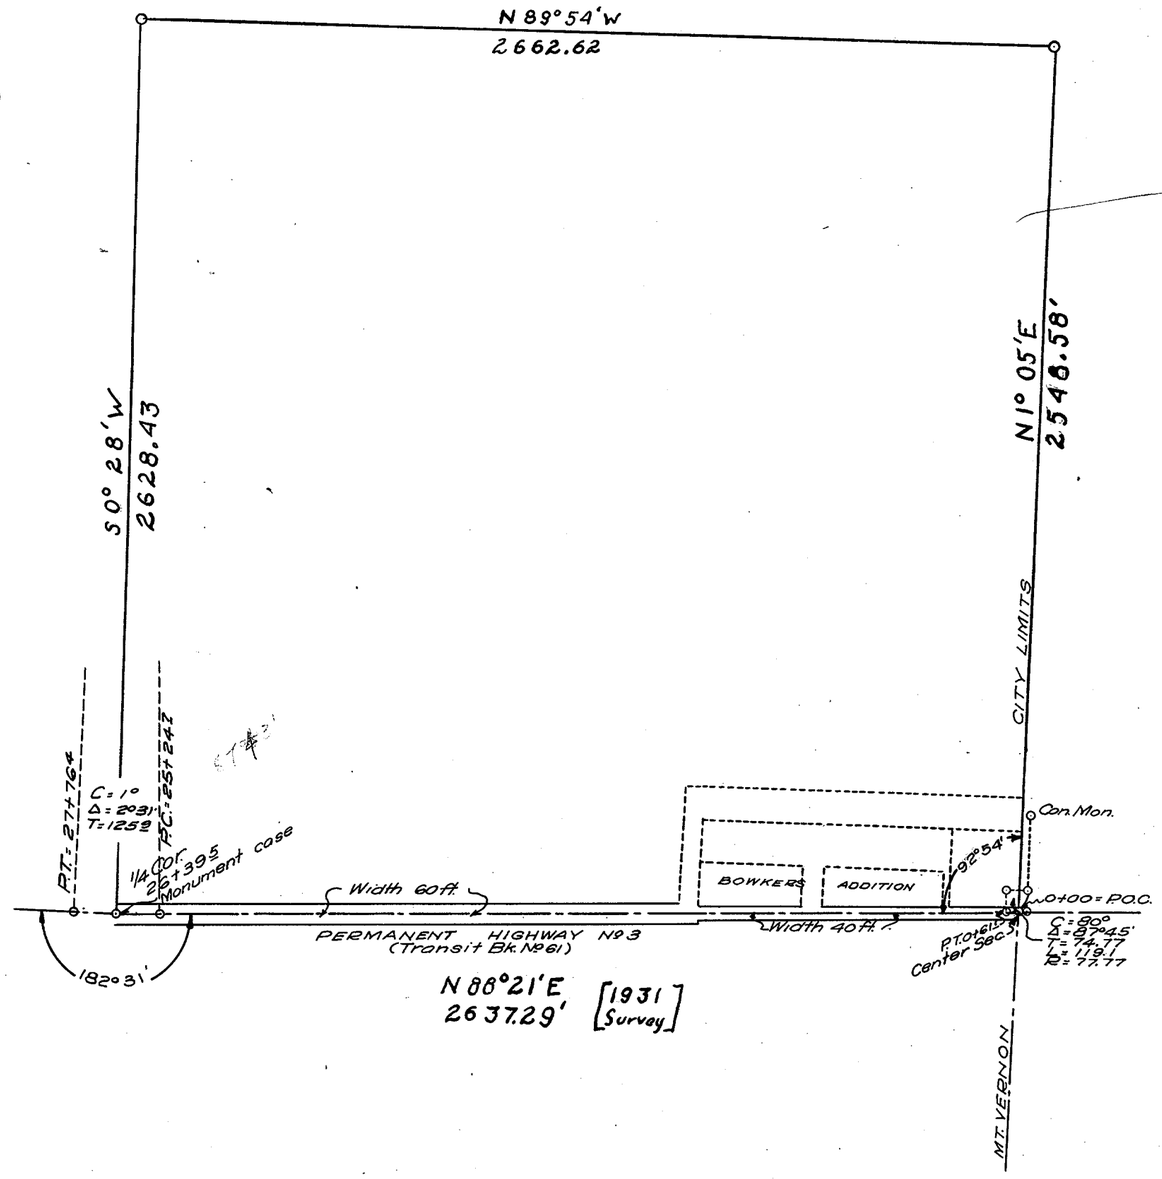

SECTION 20

TOWNSHIP 34 NORTH, RANGE 4 EAST, W. M.

SKAGIT COUNTY, WASH.

Assembled

SCALE, 1 INCH--400 FEET

NOTES : 505 853

H.O. Walberg COUNTY ENGINEER

NOTES! 41/505

T34N
20
R4E

S 89° 29' 30" E 1330.45' 2660.90

S89° 31' 55" E 2661.14'

F.P. T.P. 50.50 31.40 30.02 3/4" PIPE ON PROP. LINE 87.00 T.P. 28.35 P.P. 15288 180° 12' 180° 07'

T.P. 39.00 39.80 F.P. 40.20 F.P. 31.40 T.R.

N 0° 51' 40" W 2685.2'

N 0° 26' 30" W 2686.16'

N 0° 44' 25" W 2681.84'

S89° 37' 40" E 2642.50'

772.47'

S89° 37' 40" E 2675.11

88° 53' 15"

CONC. MON.

F.P. 34.55 34.55 T.P.

N 0° 23' 45" E 2651.64'

N 0° 0' 12" E 2654.5'

N 0° 26' 30" W 2652.16'

N 0° 19' 26" W 2671.83'

S89° 36' E 2679.90'

793.13'

S89° 09' E 2669.80'

F.P. 24.30 P.P. 10/15 65.60 CONC. MON. 55.70 T.P.

J.F.

SE 1/4 SECTION 20

TOWNSHIP 34 NORTH, RANGE 4 EAST, W. M.

SKAGIT COUNTY, WASH.

Subdiv. by R.H. Davis for Reynolds Add. Ck. by W.C.W. July 1941.

SCALE, 1 INCH--200 FEET

H.O. Walberg COUNTY ENGINEER

Angular Closure 00
Linear - N34°09'W 0.41

Pipe - Center Sec.

N89°35'E 2675.04

Hub

89°07'

2650.64

Pipe S52° E 2.55 From 1/6 Cor.

N89°47'30"E 1335.96

534.38

Pipe {N 0.10 W 0.12}

2675.95

N89°52'11"E 267.08

534.15

534.16

133.54

1333.15

N1°18'04"W

153.30

N89°03'05"E 266.98

148.48

330.12

330.08

N1°17'17"W

Home

Add

N1°15'33"W 832.01

832.31

N1°15'08"W

N1°13'53"W 833.22

346.78

351.24

533.78

New Hub

266.89

133.45

West 2668.90

N1°00'43"W

Axle

Hub

SECTION 21


TOWNSHIP 34 NORTH, RANGE 4 EAST, W. M.

SKAGIT COUNTY, WASH.

SCALE, 1 INCH--400 FEET

DATE June, 1959

Frank Gilkey COUNTY ENGINEER

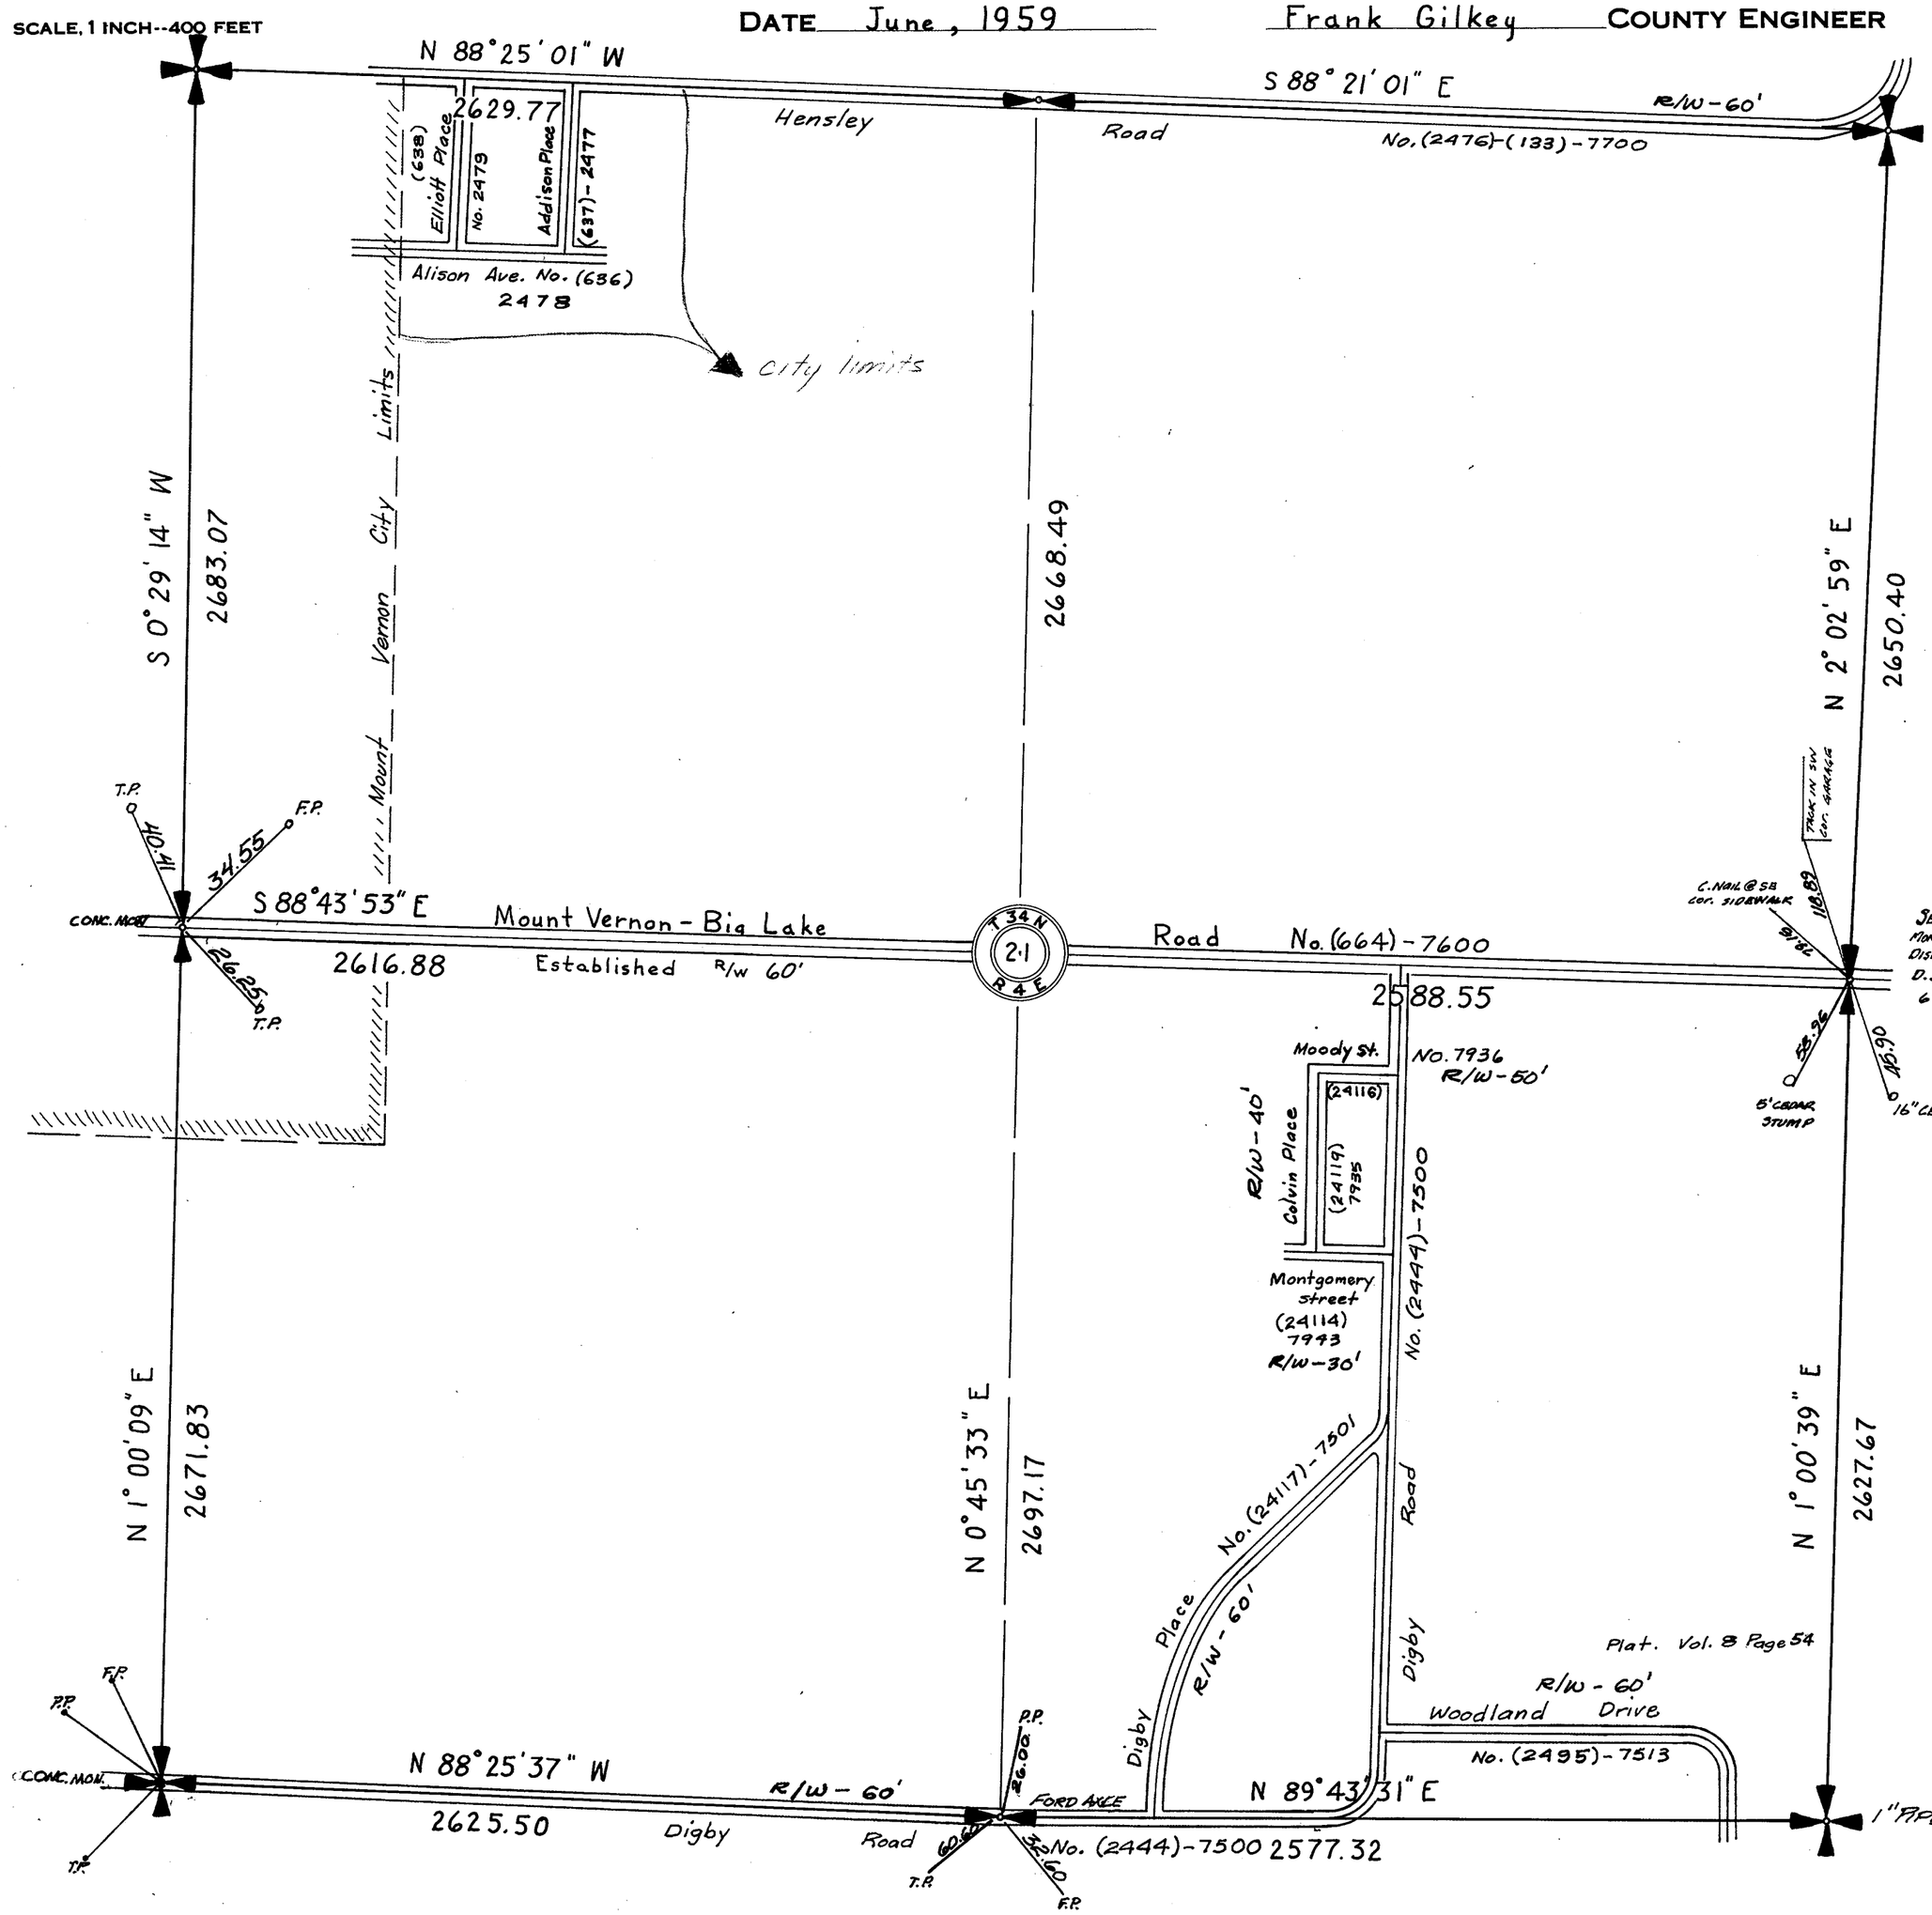


SECTION 22

TOWNSHIP 34 NORTH, RANGE 4 EAST, W. M.

SKAGIT COUNTY, WASH.

SCALE, 1 INCH--400 FEET

DATE June, 1959 Frank Gilkey COUNTY ENGINEER

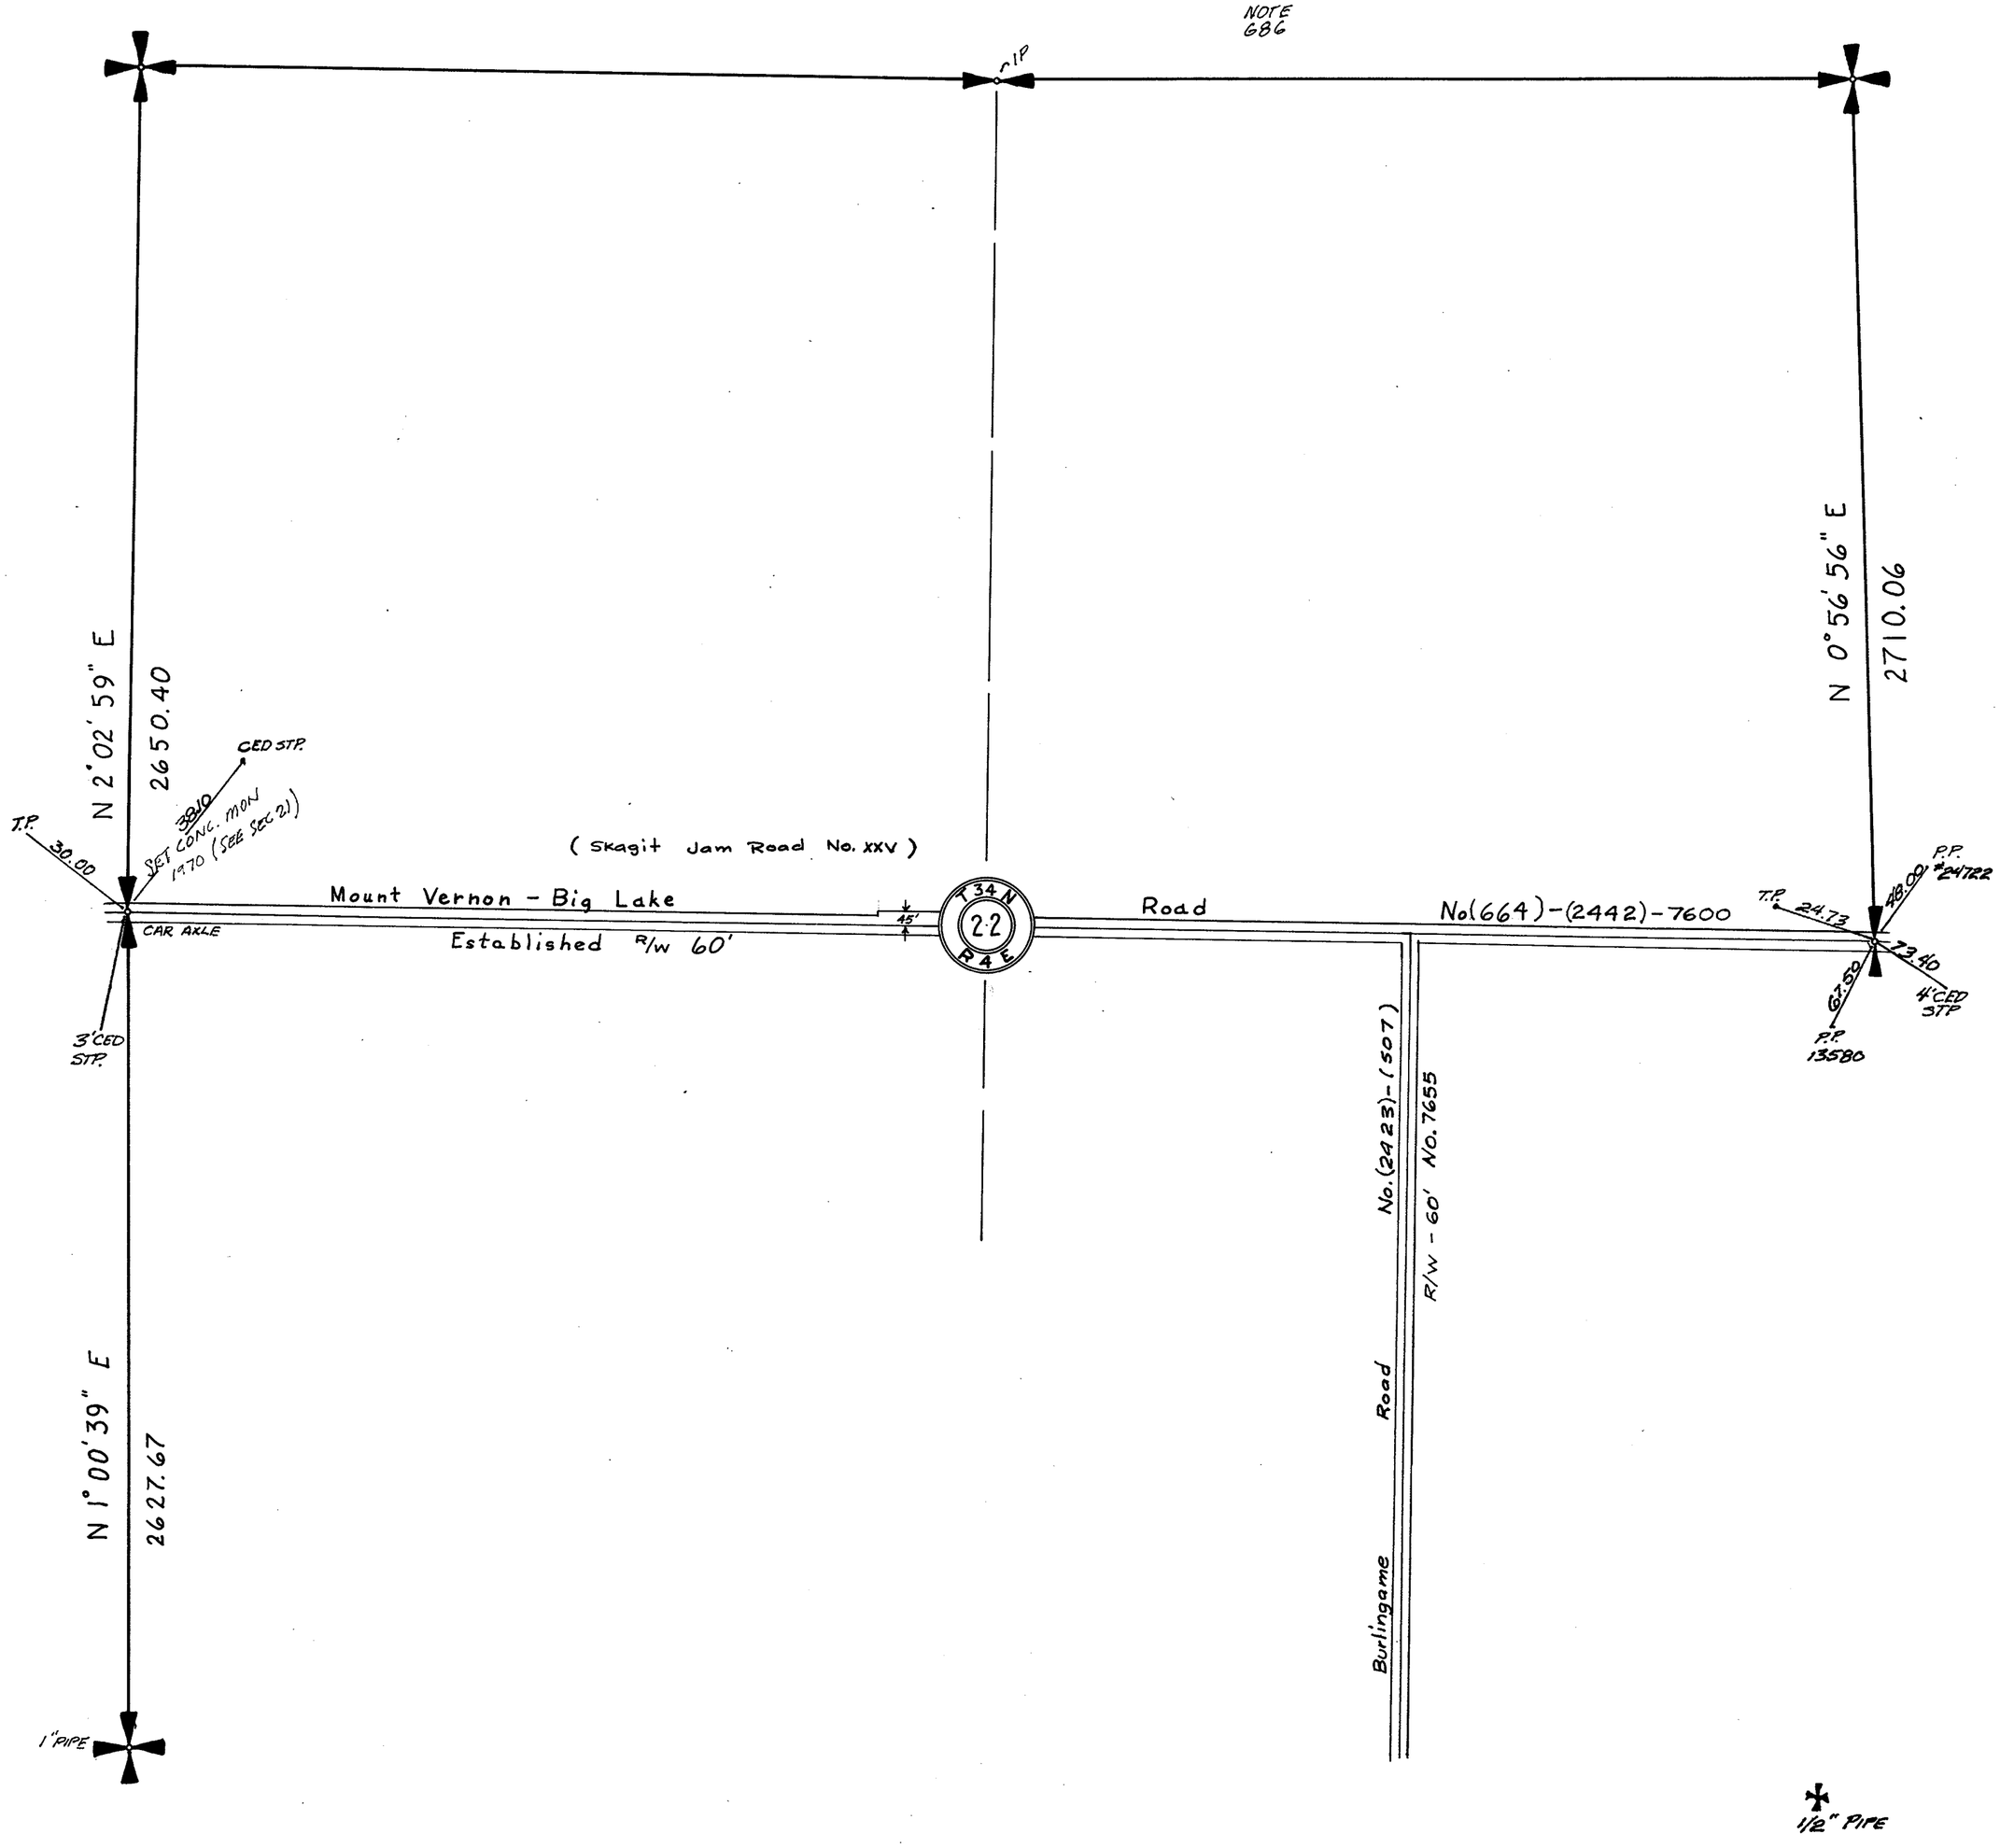



TOWNSHIP 34 NORTH, RANGE 4 EAST, W. M.
SKAGIT COUNTY, WASH.

SCALE, 1 INCH–400 FEET

A.L. STRONG
Lloyd H. Johnson
COUNTY ENGINEER
1975

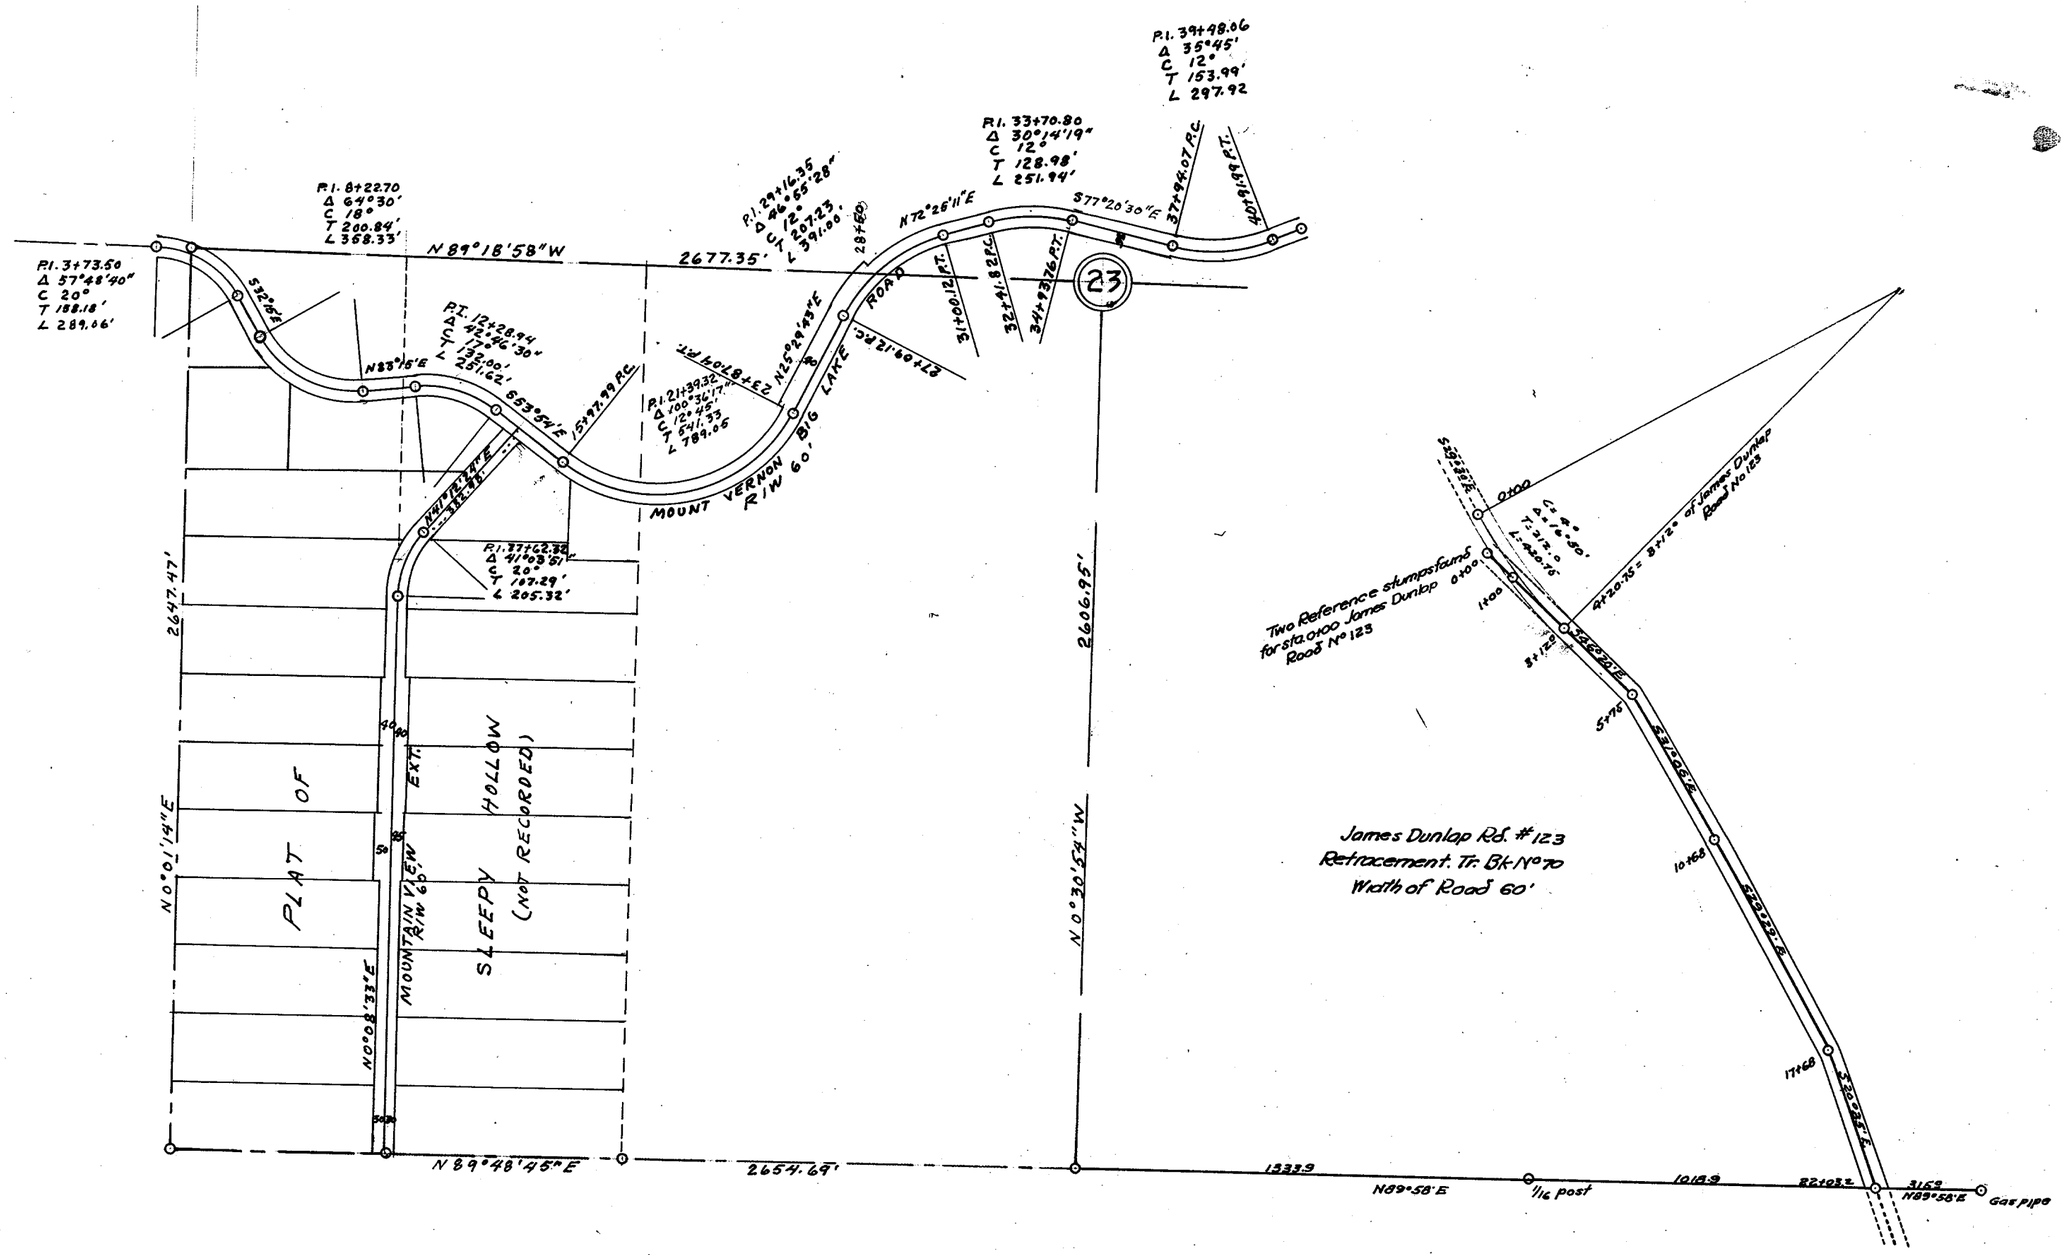

SECTION 23


TOWNSHIP 34 NORTH, RANGE 4 EAST, W. M.

SKAGIT COUNTY, WASH.

SCALE, 1 INCH--400 FEET

DATE MARCH 20, 1972

FRANK GILKEY COUNTY ENGINEER

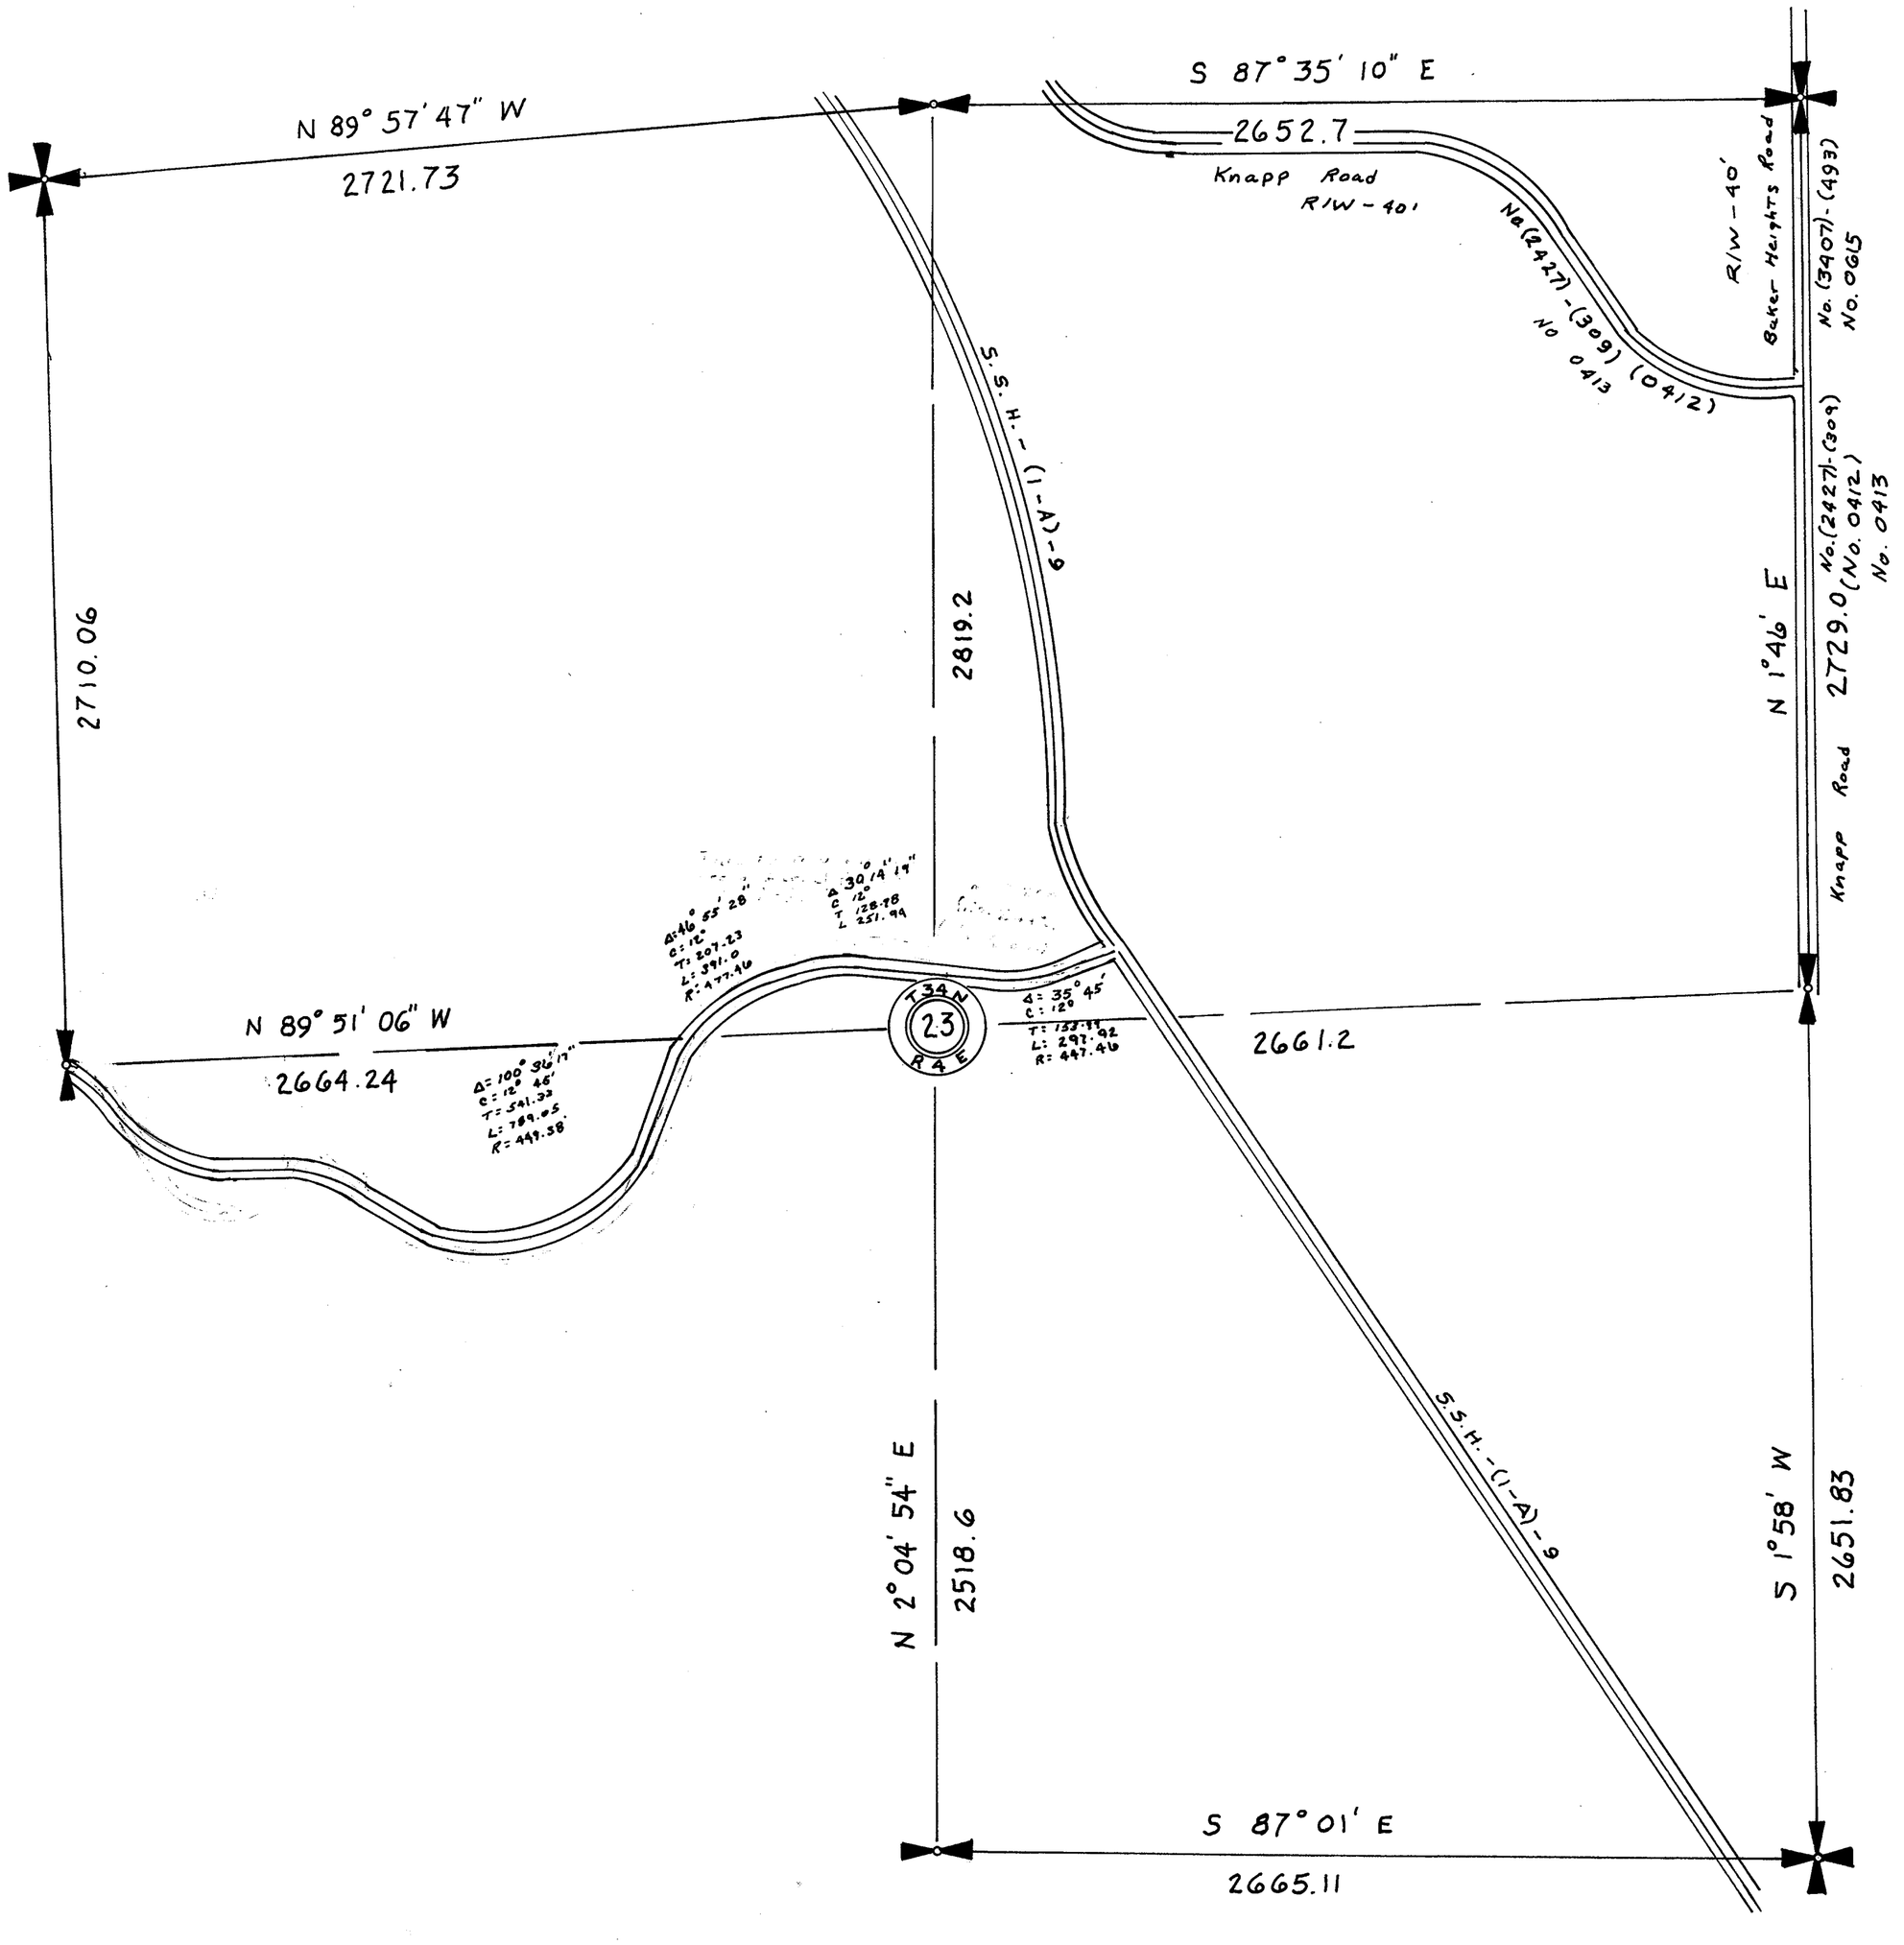


SECTION 23

TOWNSHIP 34 NORTH, RANGE 4 EAST, W. M.

SKAGIT COUNTY, WASH.

SCALE, 1 INCH--400 FEET

DATE June, 1959 Frank Gilkey COUNTY ENGINEER

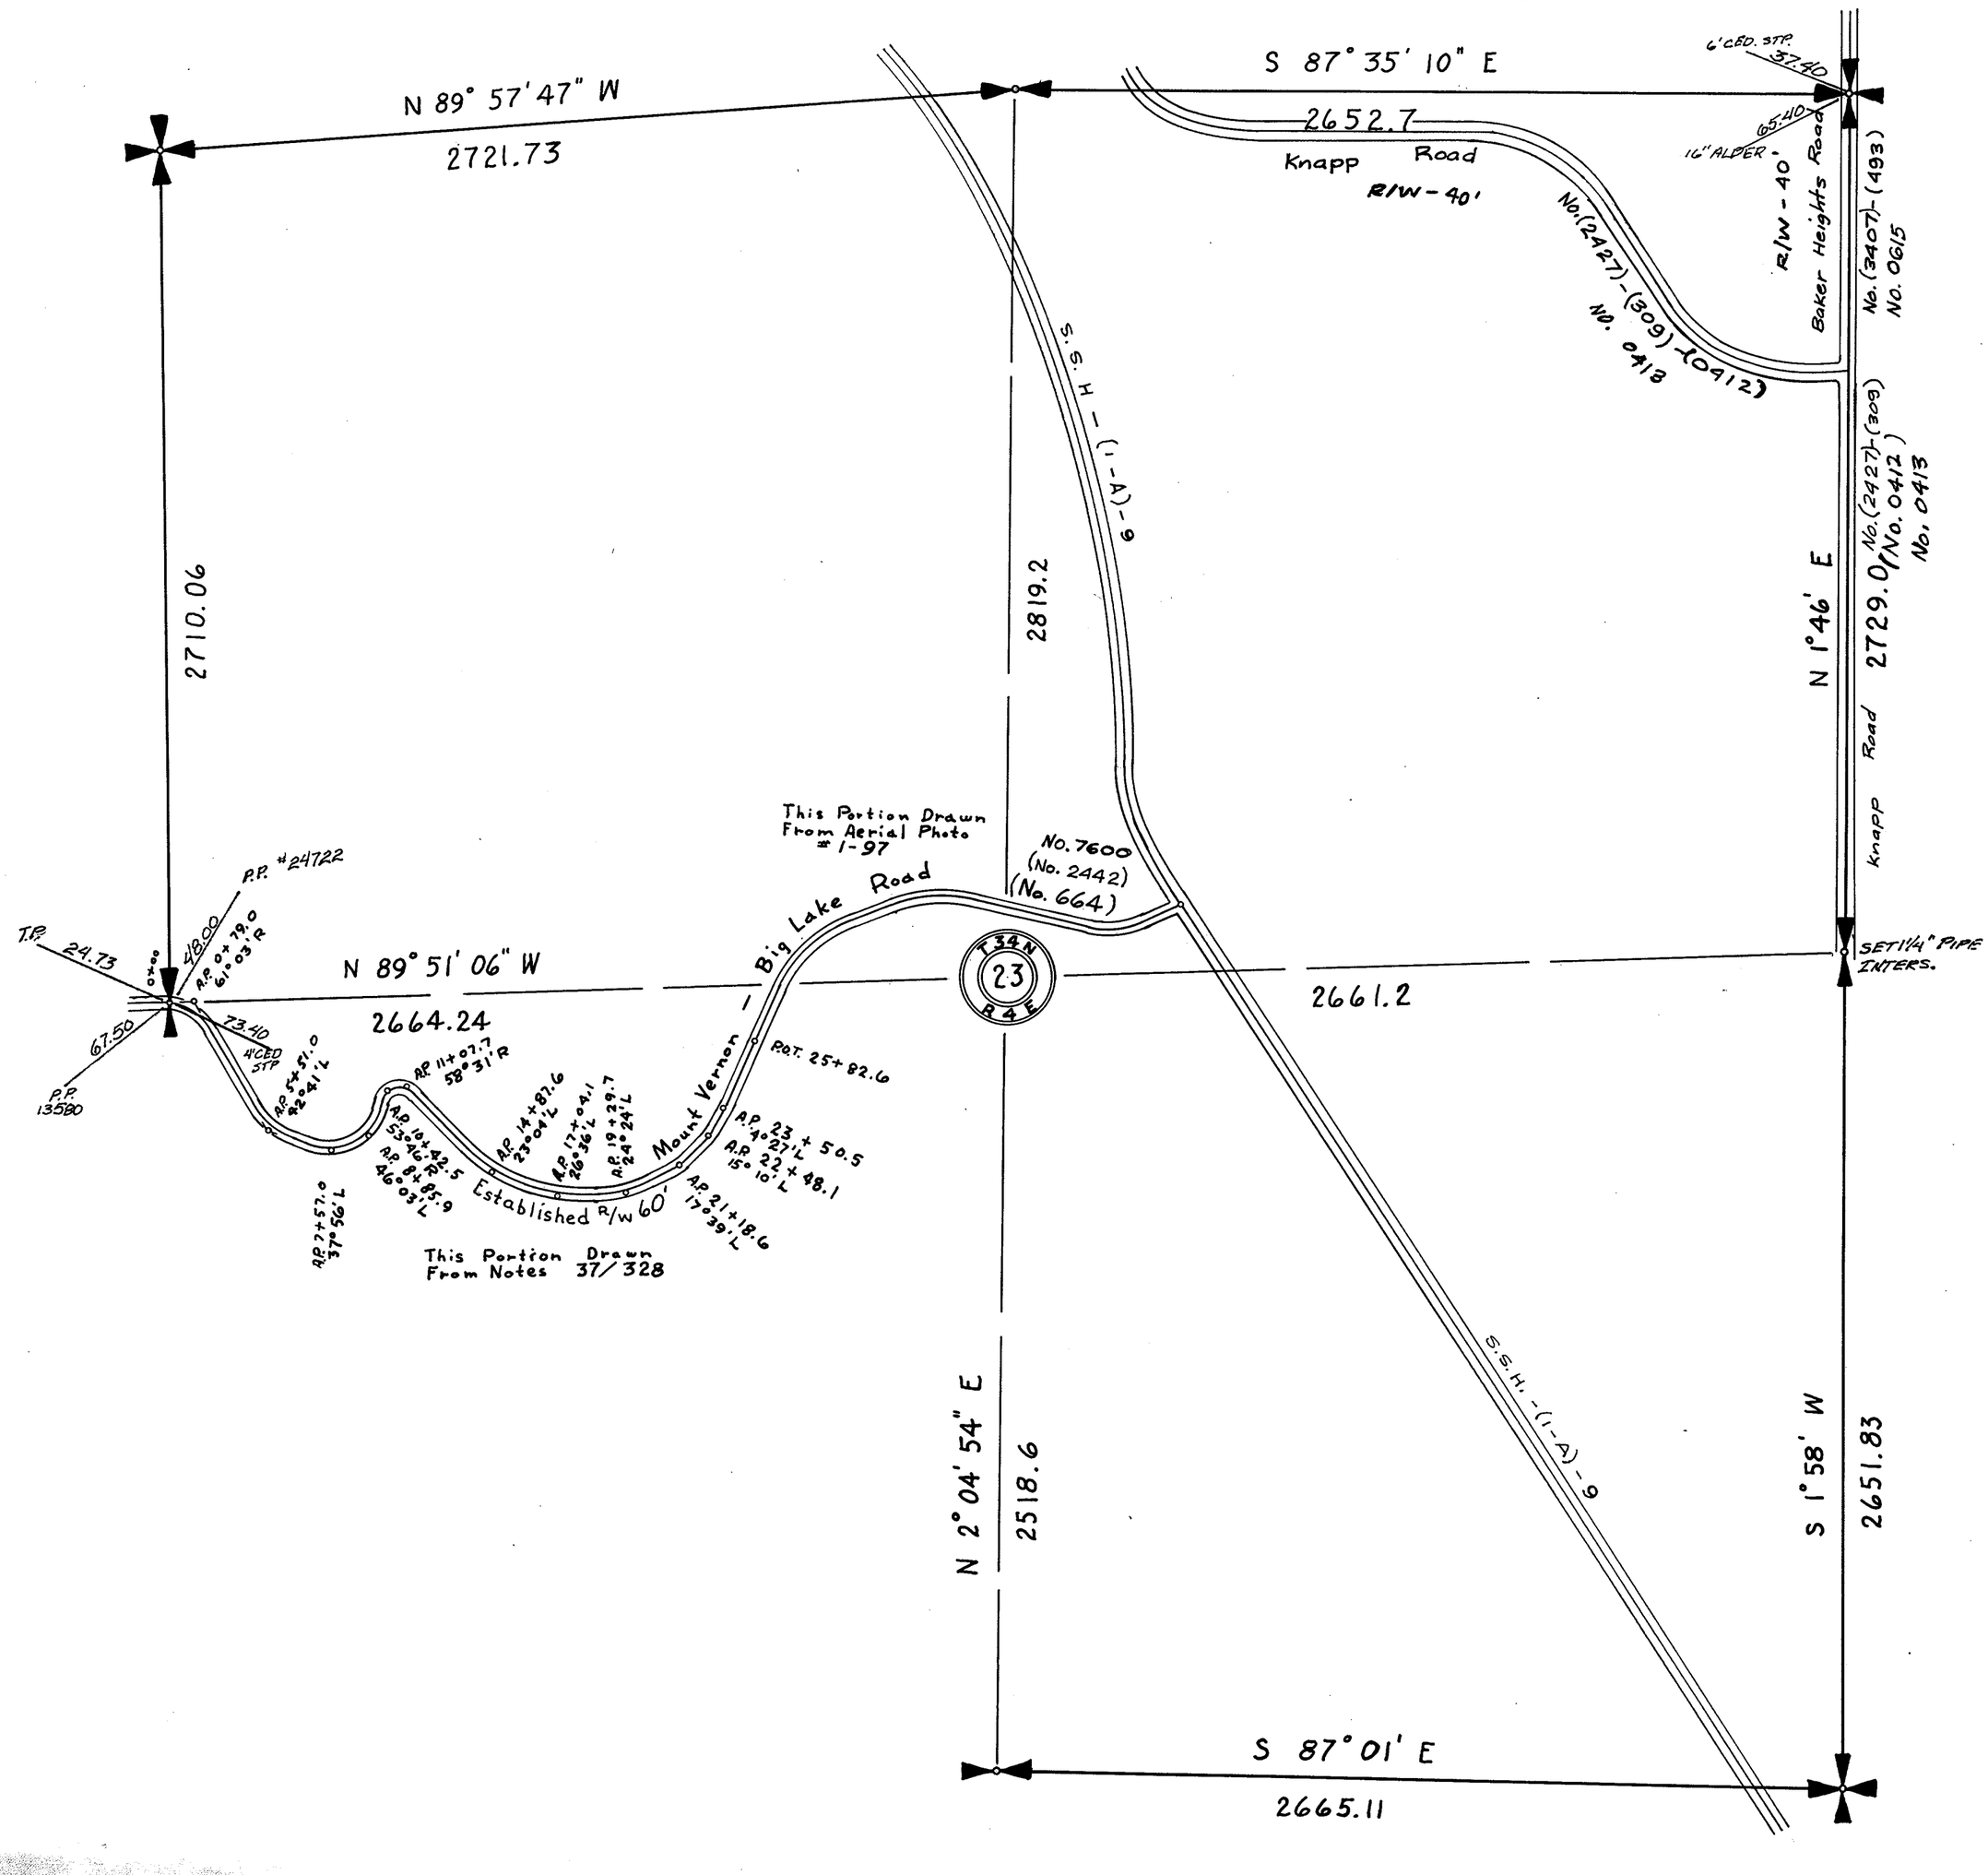

W.
10-10-47

SECTION 24


TOWNSHIP 34 NORTH, RANGE 4 EAST, W. M.

SKAGIT COUNTY, WASH.

Notes A14

SCALE, 1 INCH--400 FEET

H.O. Walberg COUNTY ENGINEER

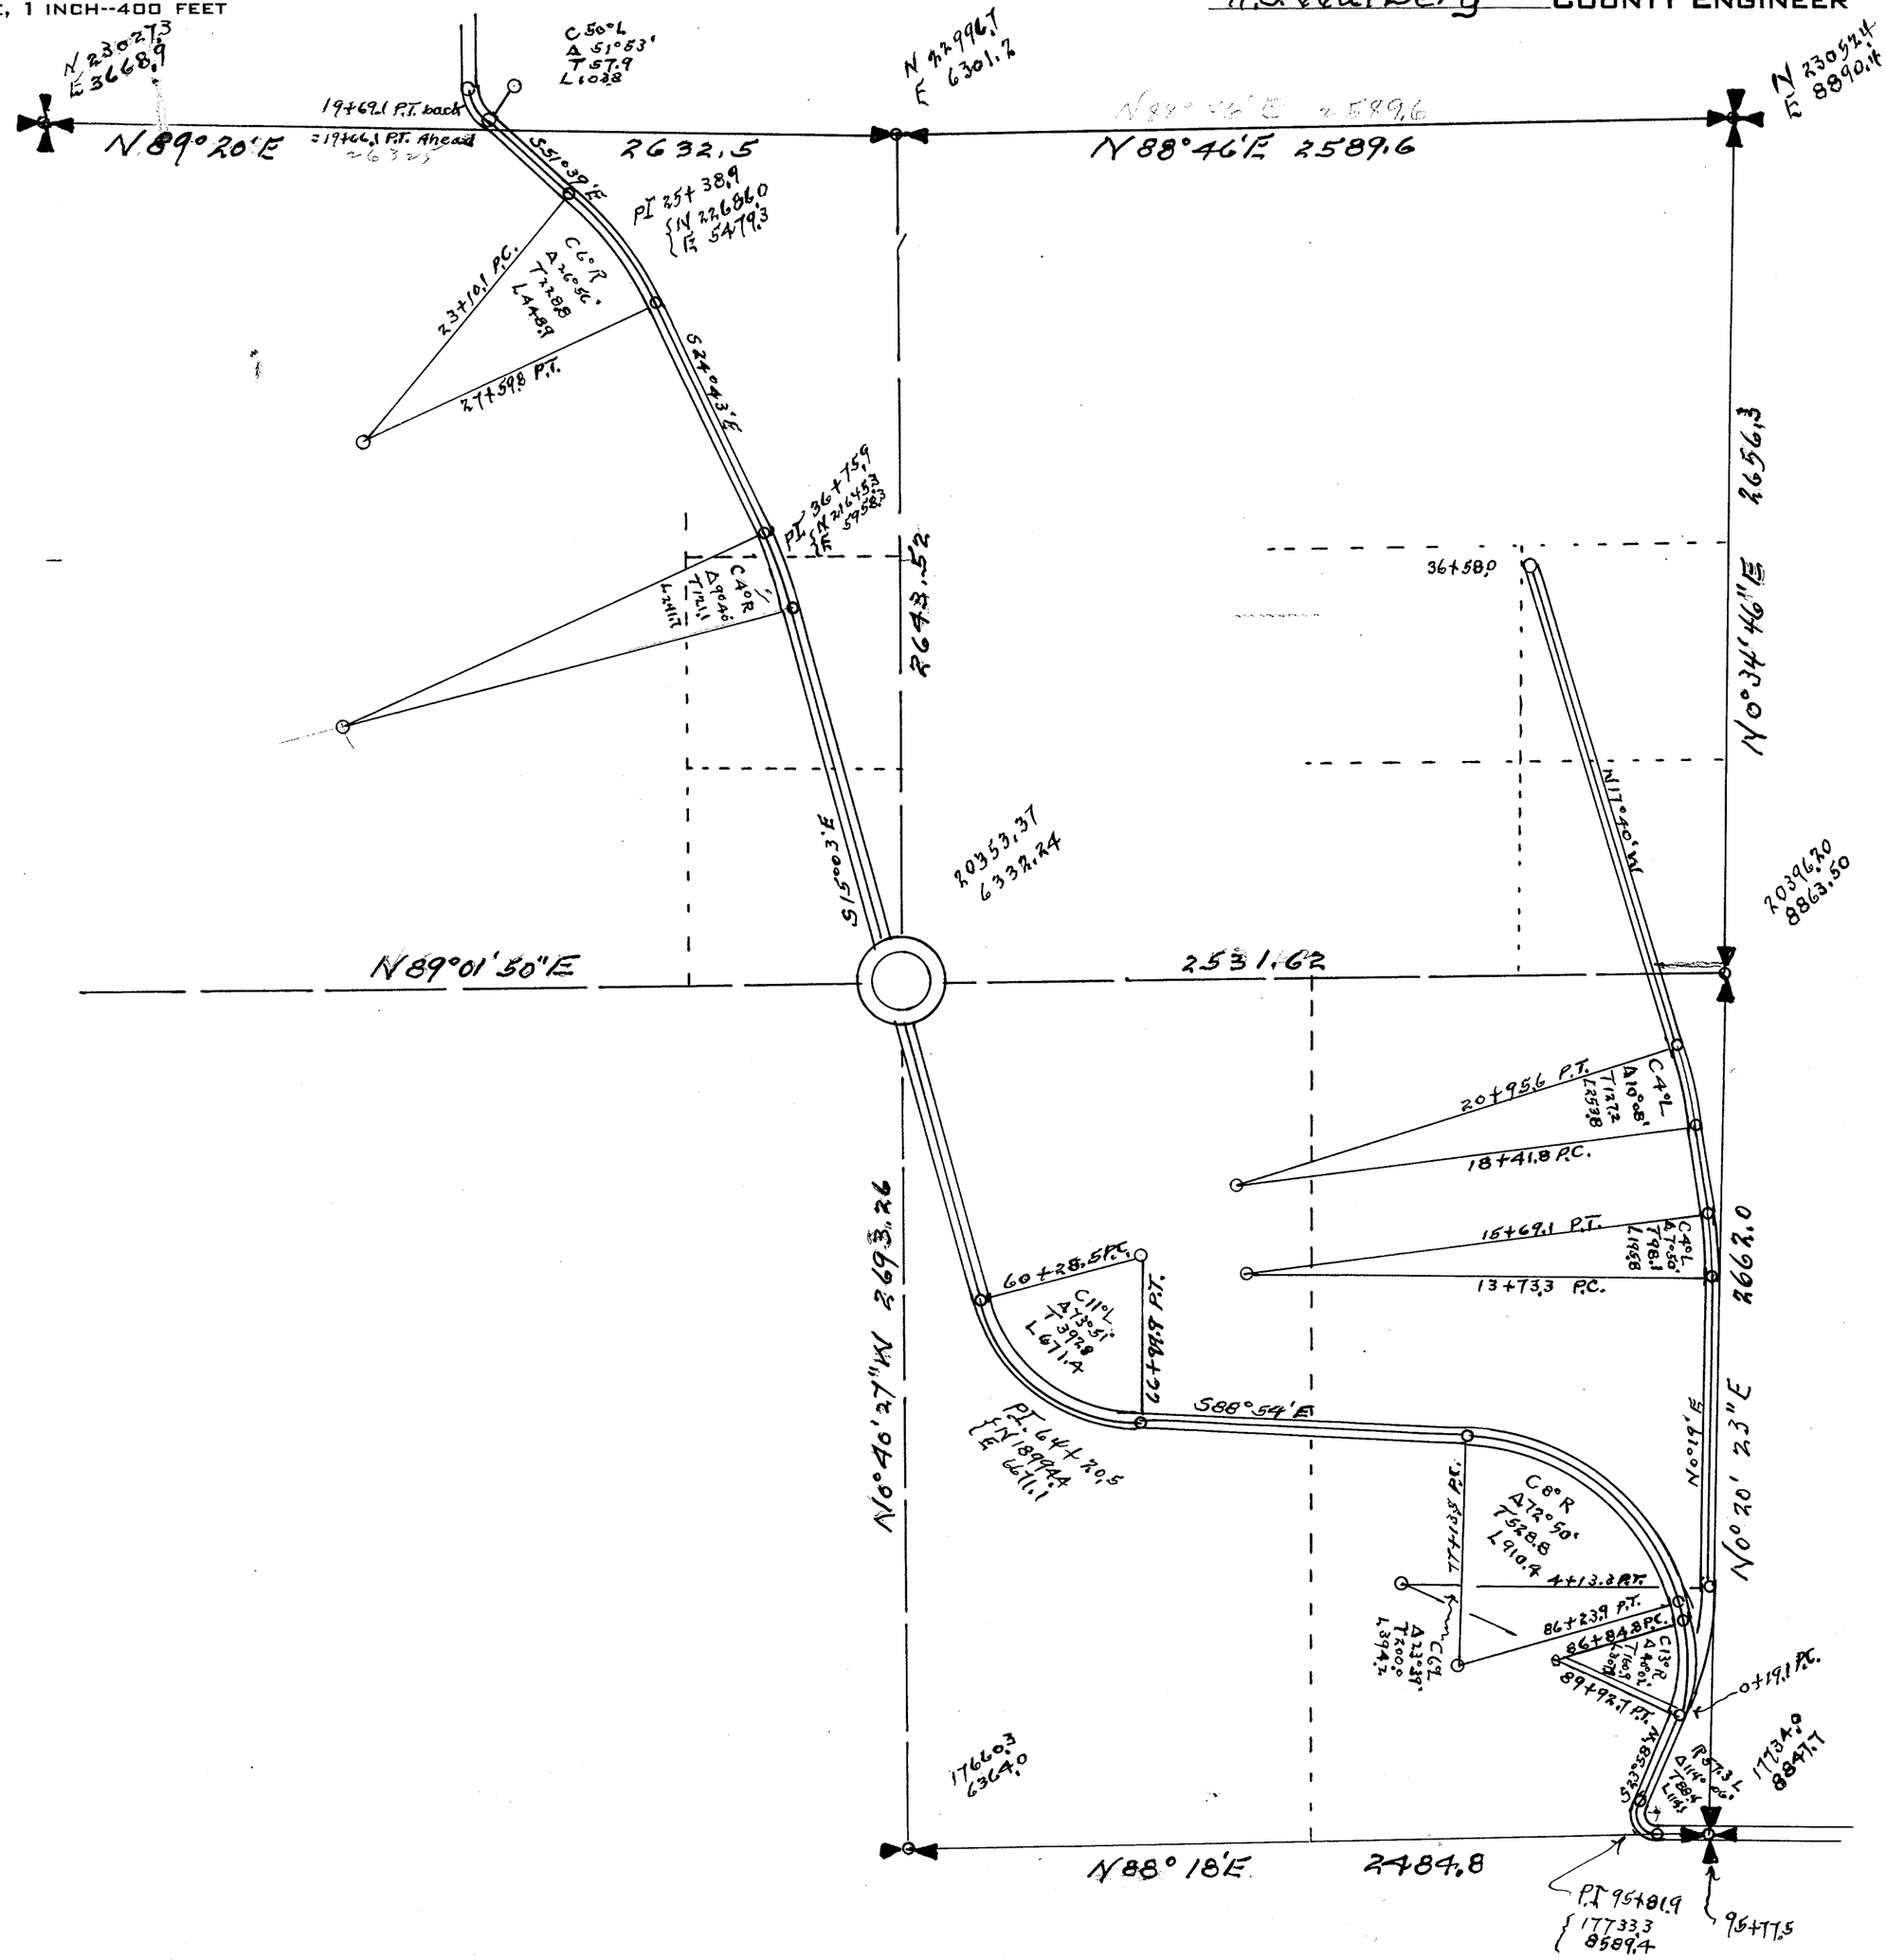


SECTION 24

TOWNSHIP 34 NORTH. RANGE 4 EAST. W. M.
SKAGIT COUNTY. WASH.

SCALE. 1 INCH–400 FEET

Robt. E. L. Knapp COUNTY ENGINEER

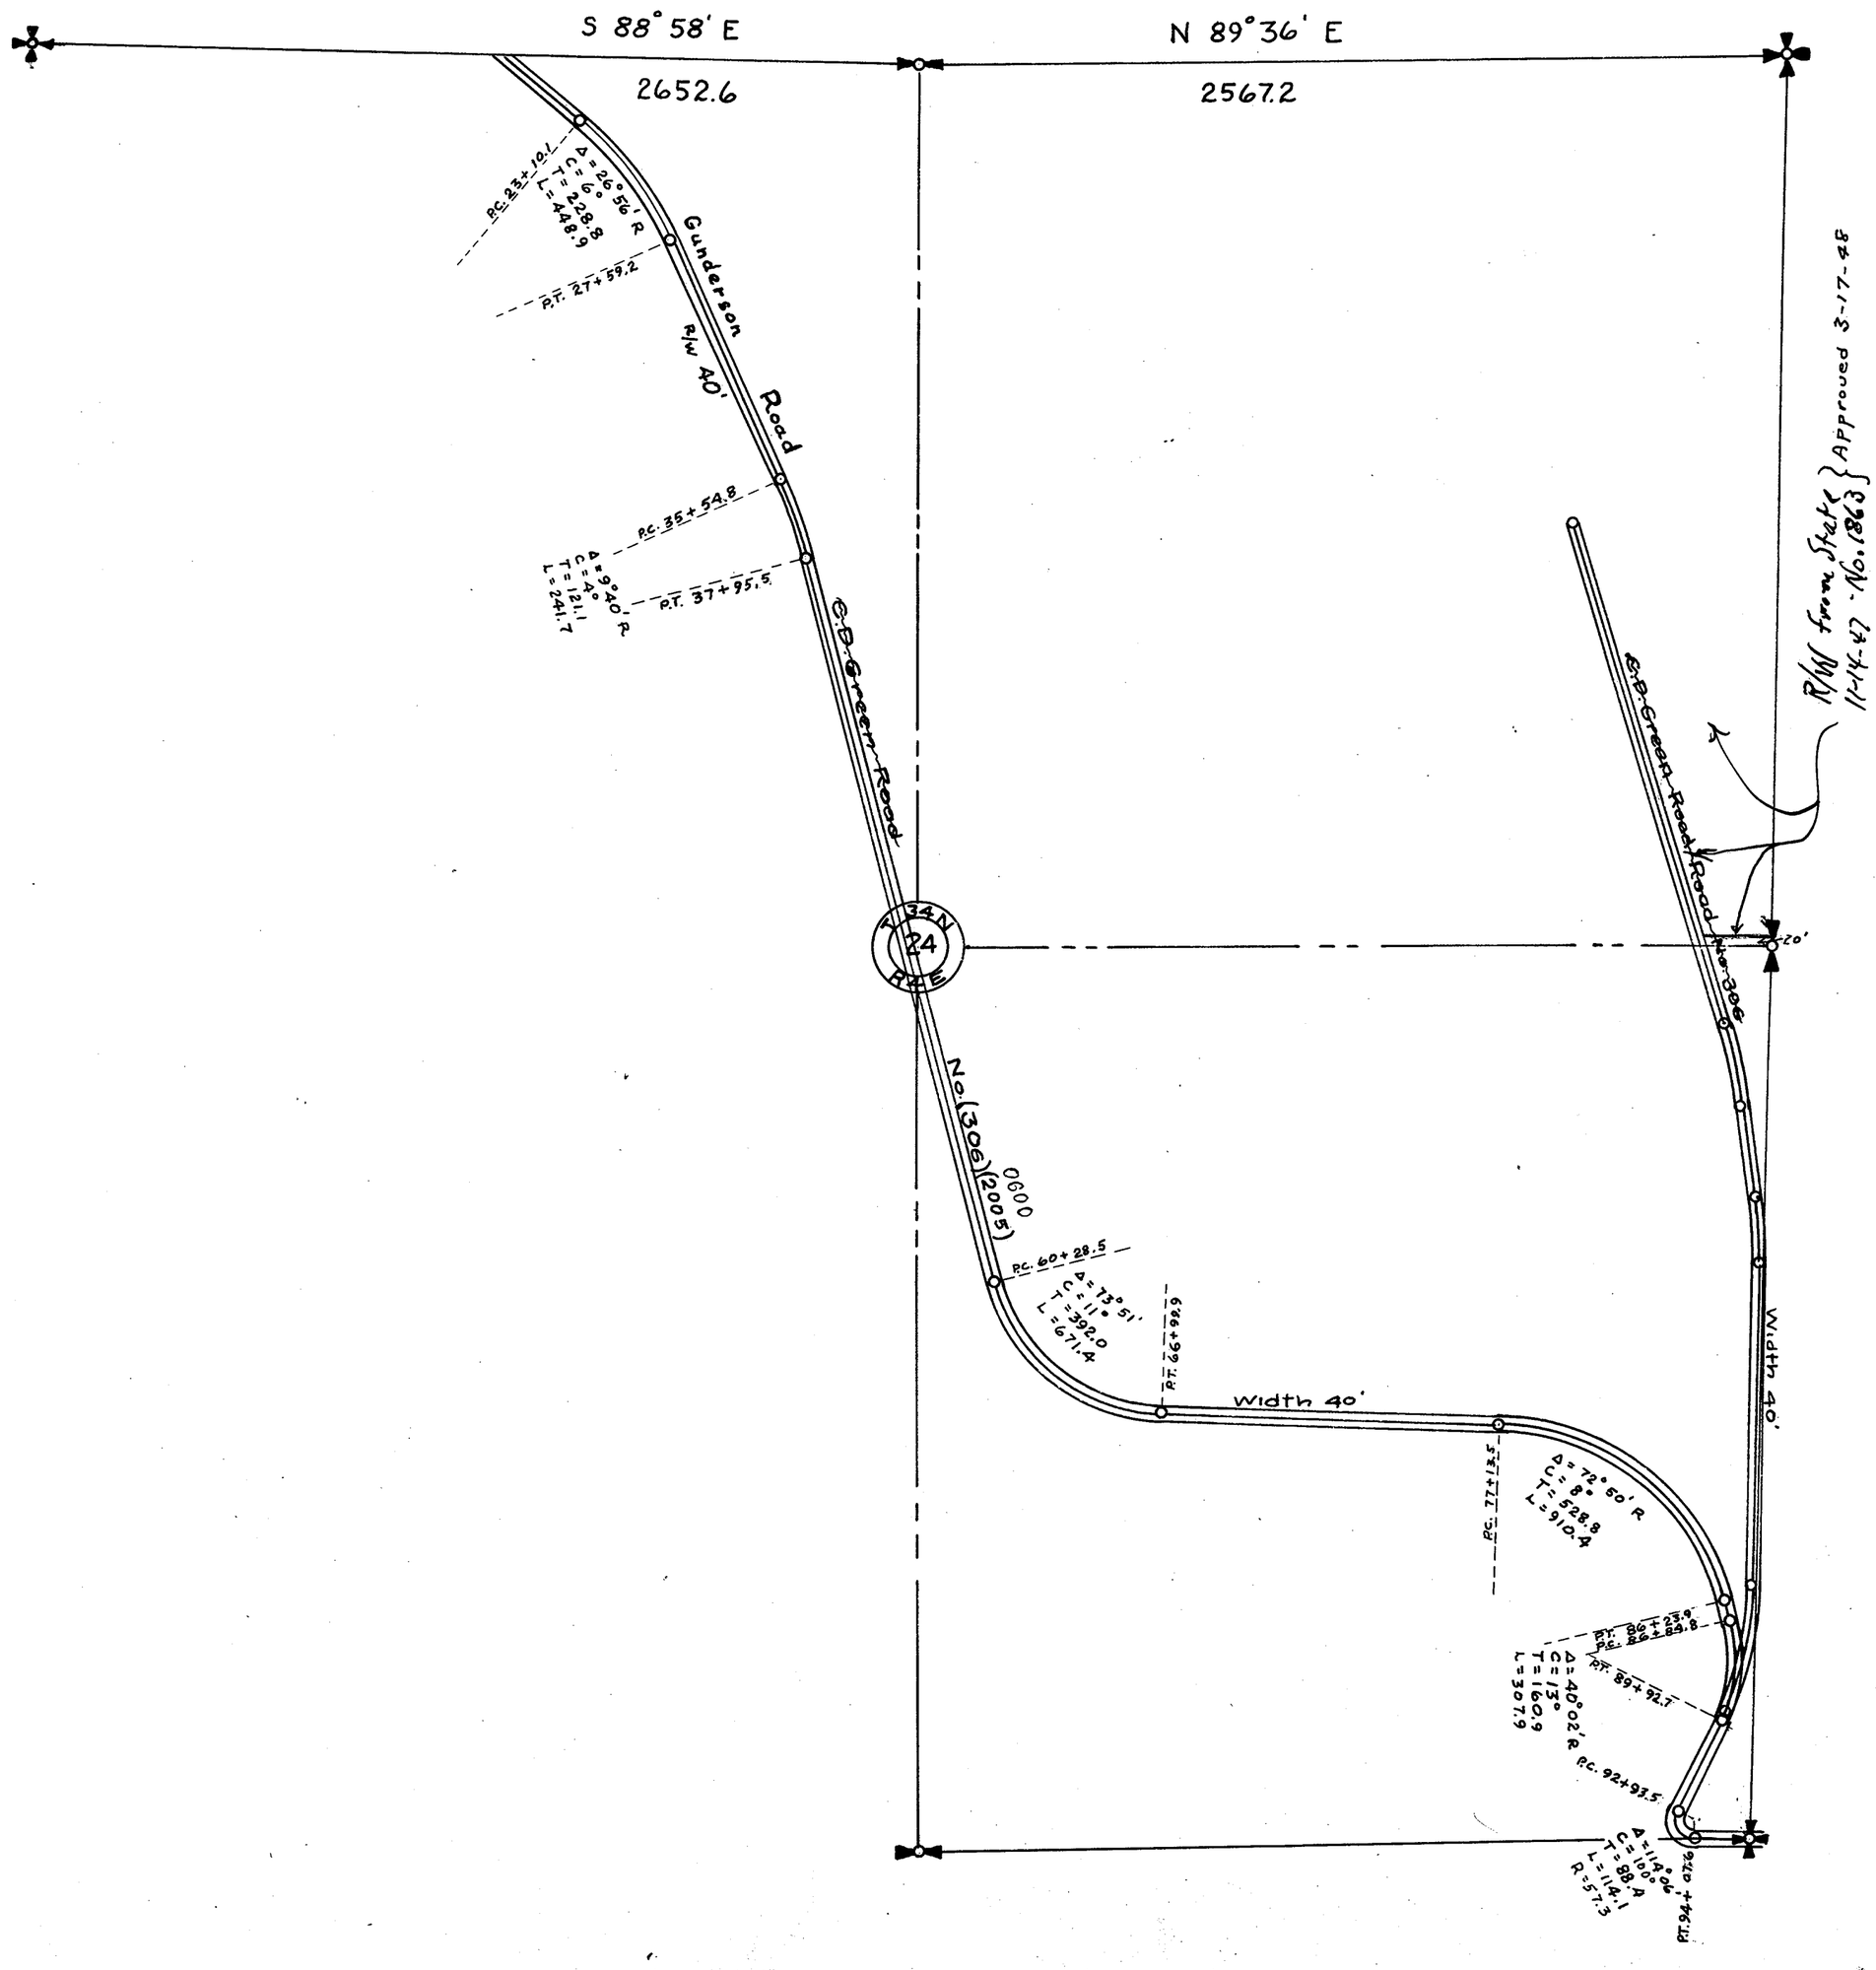


SECTION 25

TOWNSHIP 34 NORTH, RANGE 4 EAST, W. M.

SKAGIT COUNTY, WASH.

SCALE, 1 INCH--400 FEET

DATE July 22, 1966 — Lloyd Johnson — COUNTY ENGINEER

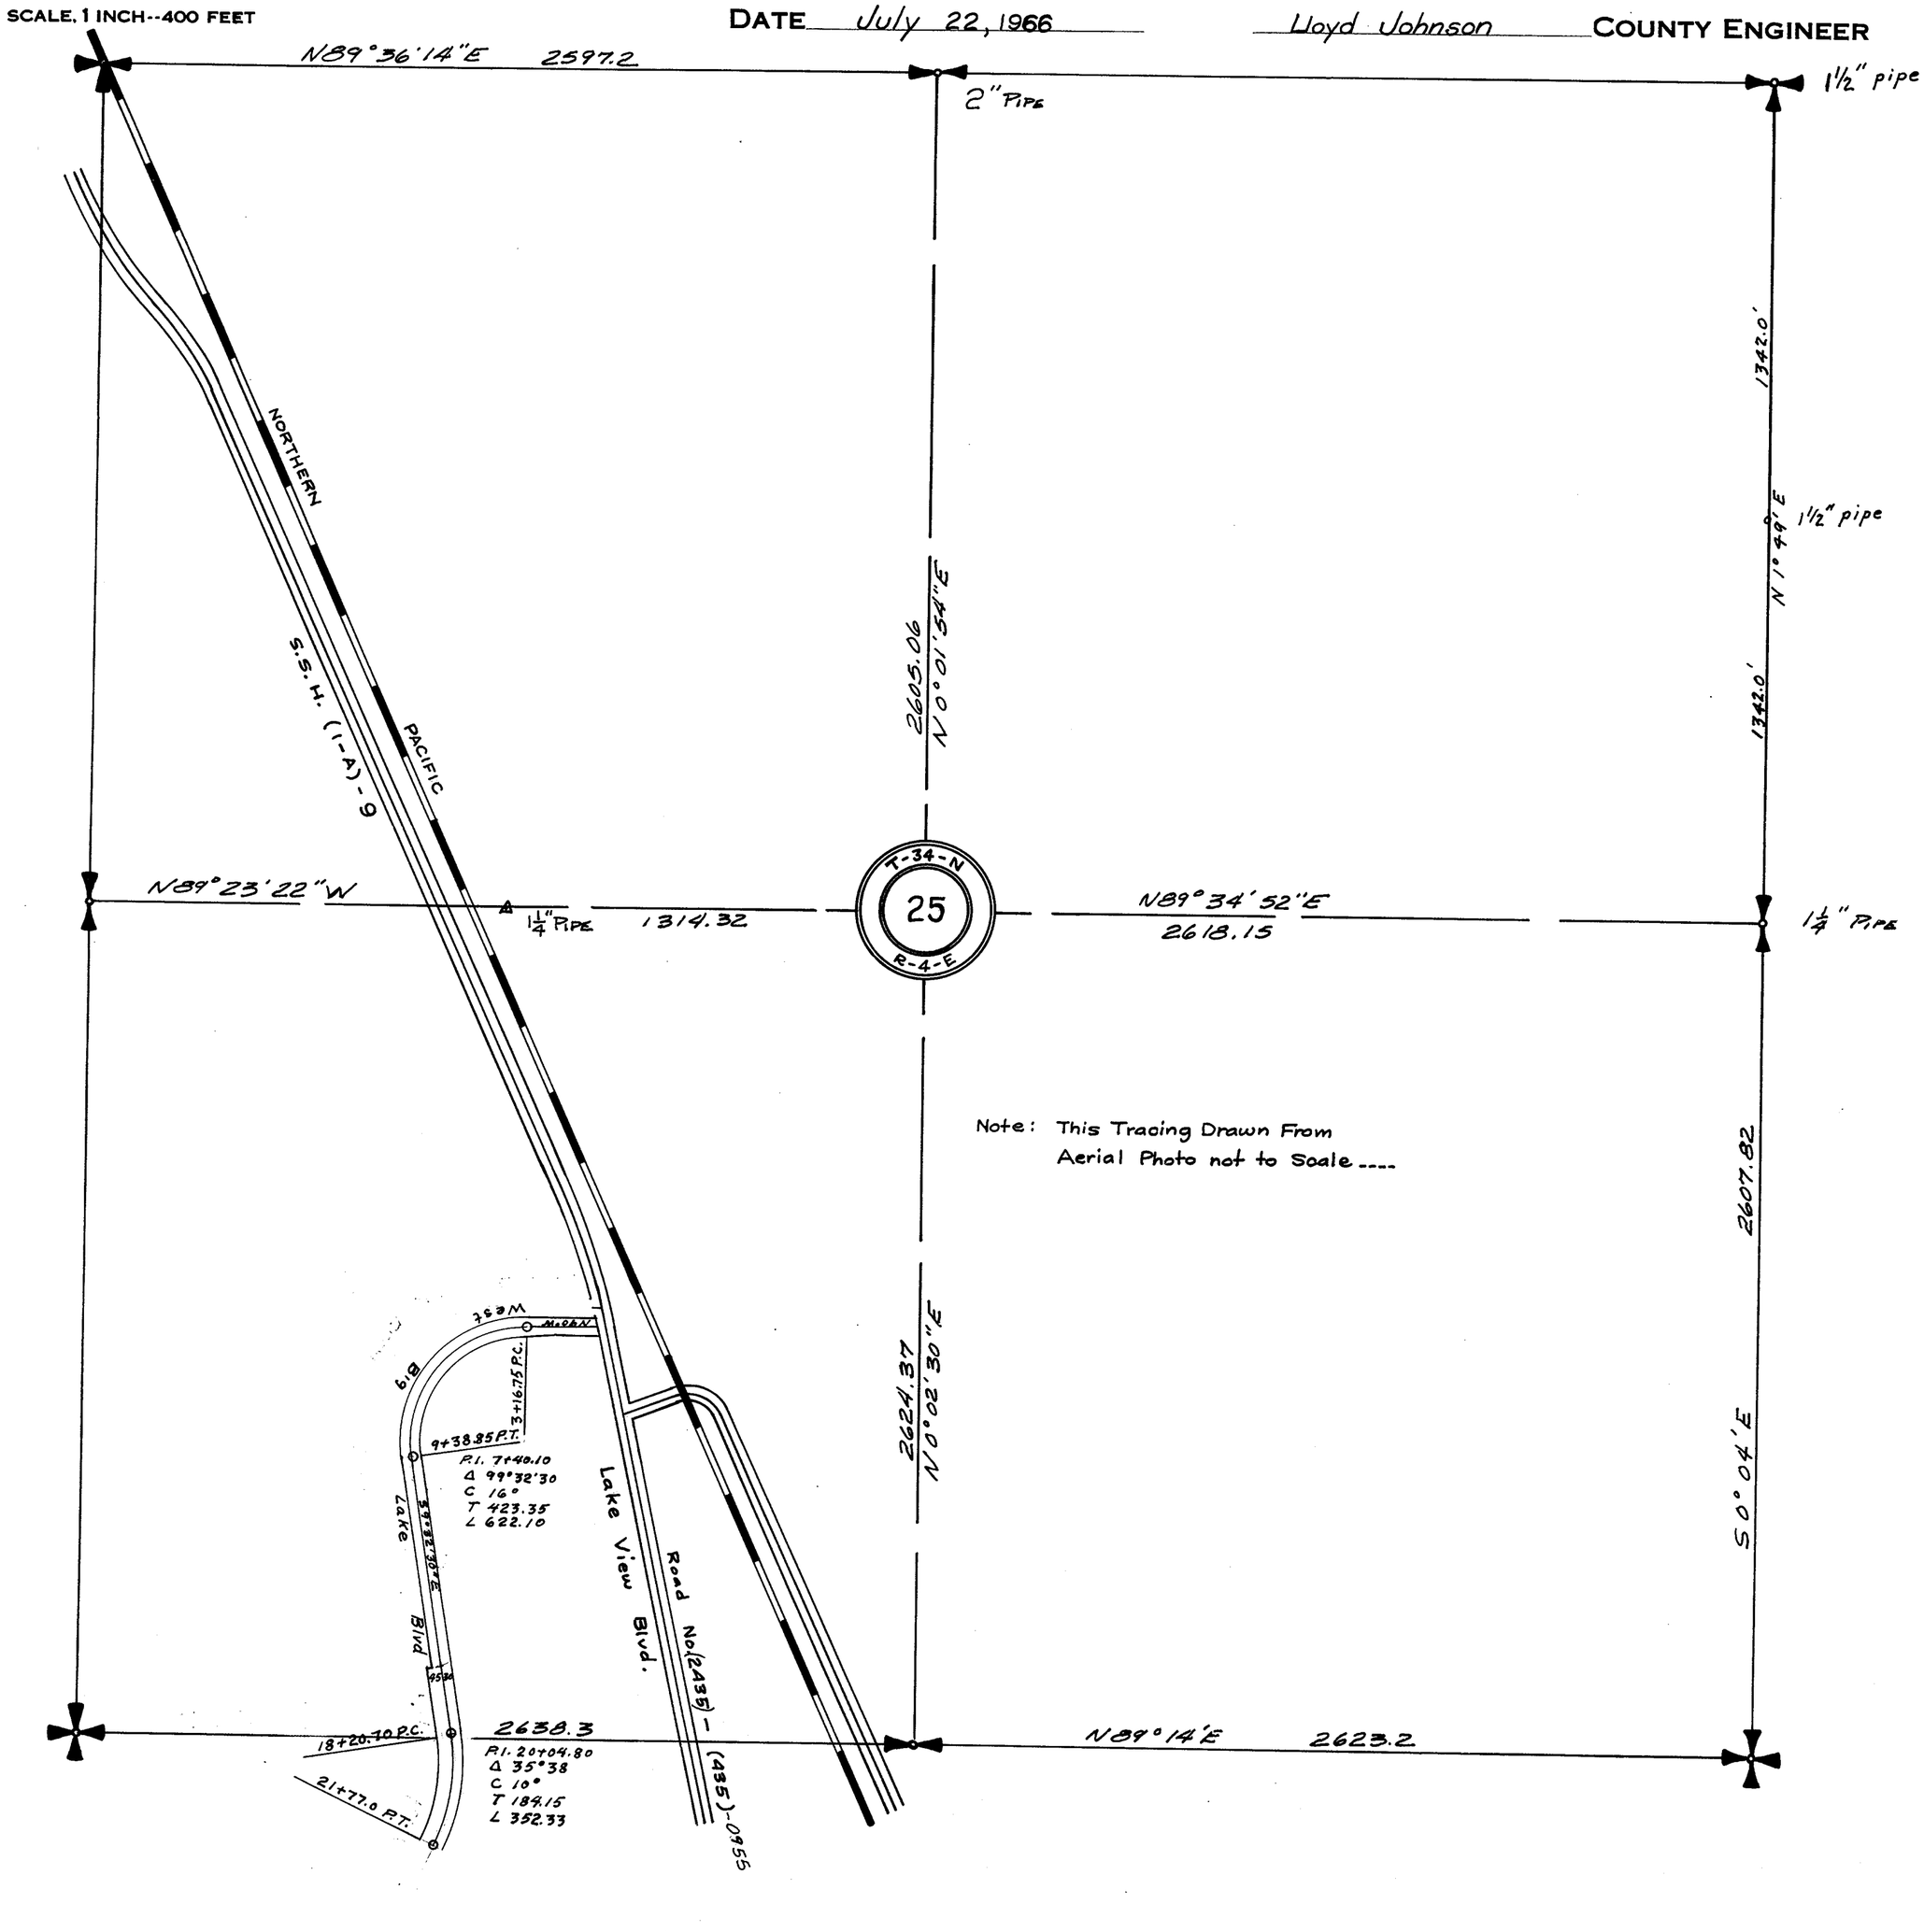

SECTION 26


TOWNSHIP 34 NORTH, RANGE 4 EAST, W. M.
SKAGIT COUNTY, WASH.

SCALE, 1 INCH--400 FEET

W.A. Costello COUNTY ENGINEER

Notes - H219-36/325

Note: Roads Drawn 7/22/66 From Aerial Photo - Not to Scale

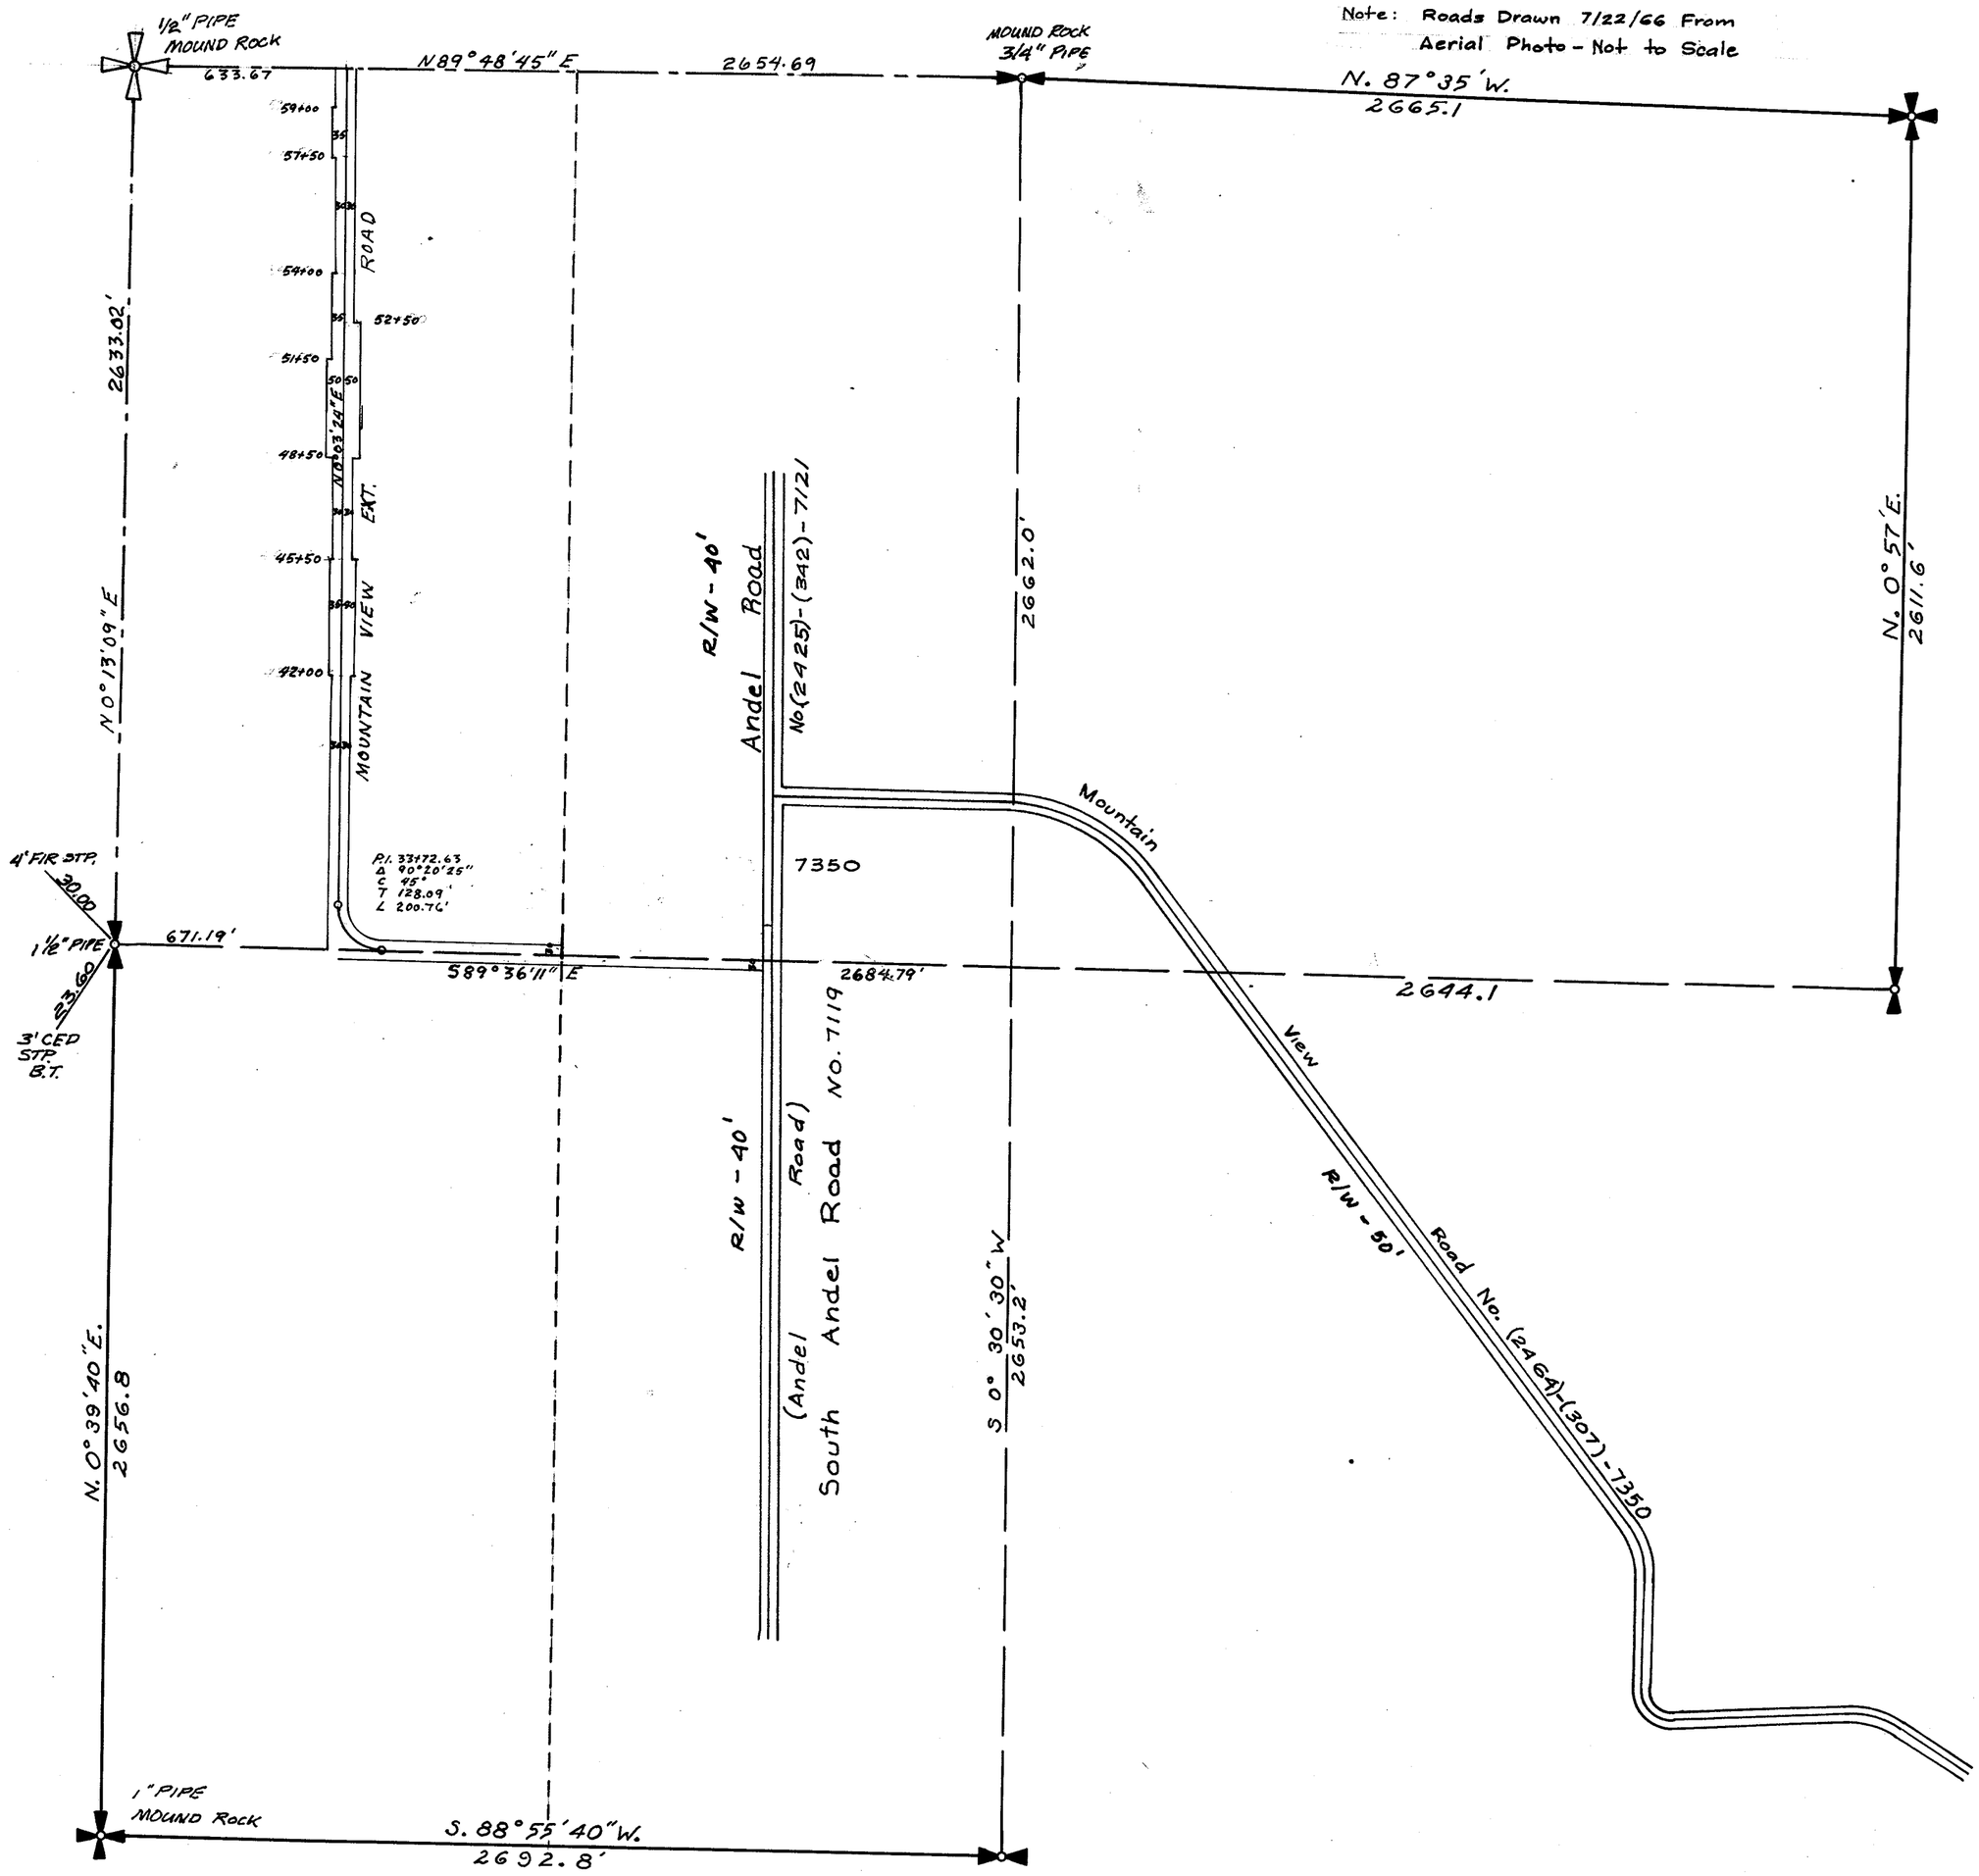

SECTION 28

TOWNSHIP 34 NORTH, RANGE 4 EAST, W. M.

SKAGIT COUNTY, WASH.

Notes 46/595

SCALE, 1 INCH--400 FEET

F 135

NOTES: 595
614

H.O. Walberg — COUNTY ENGINEER

3"x3" CED. P.
1" PIPE

P.P.
26.00

Digby Place

(No. 2411T)
No. 7501

N88° 34' E 2577.06

S89° 35' 10" E 2625.54

Digby Road

60.60 T.P.

32.60 T.P.

No.(2444)-(185)-7500

Woodland Place No.(2497)-7511

R/W-60'

R/W-60'

Woodland Drive No.(2495)
No. 7513

N 1° 11' 12" E 2657.02

N 1° 23' E 2597.8 (M.2599.8)

N 1° 08' 54" W 2620.53

5'FIR STR.

18"FIR

63.95

T. 34 N.
2 8
R. 4 E.

P.P.
25.63

Blackborn

R/W-60'

Road No. (2446)-7400

R/W-60'

N 89° 07' E 2617.5

0.00 ---660---→

FORD AXLE

RESET CENTER
11-1-46

N 89° 07' E 2692.5

1/2" PIPE

(~~Little~~ Mountain Road ~~No. 338~~)

47.60 ℄

11.00

19.20

4'CED STP.

4'CED STP.

Cedar Hill No. 7405 (24107) Drive

2+55.8

N1°23'E

Δ 25°50'
C 14°
T 94.2
L 184.5

4+40.3

4+47.0

Cedar Hills Road
(Drive)

Δ 47°50'
C 20°
T 169.9
L 318.9

(Road No(24107)
No.7407

7+65.9

7+99.0

Δ 22°00'
C 10°
T 111.5
L 220.2

Bk 10+19.2
Ah 9+97.5

N1°23'E

12+36.3

14+33.2

Δ 39°25'
C 20°
T 103.15
L 197.10

Little Mountain Rd.
R/W-40'

S 37° 02' E

23+69.7

N 1° 04' E 2644.70

N 1° 23' E 2664.9

N 0° 36' 17" E 2586.8

Little Mountain Road No. 338
Entered June, 1959

522.3

No. 7200
(No. 2448)
(No. 338)

N 89° 34' 13" E 2602.1

DROVE 2" PIPE
IN 24" CED. STP.


N 87° 30' 24" E 2731.8

SECTION 28

TOWNSHIP 34 NORTH, RANGE 4 EAST, W. M.
SKAGIT COUNTY, WASH.

SCALE, 1 INCH–400 FEET

_____ COUNTY ENGINEER

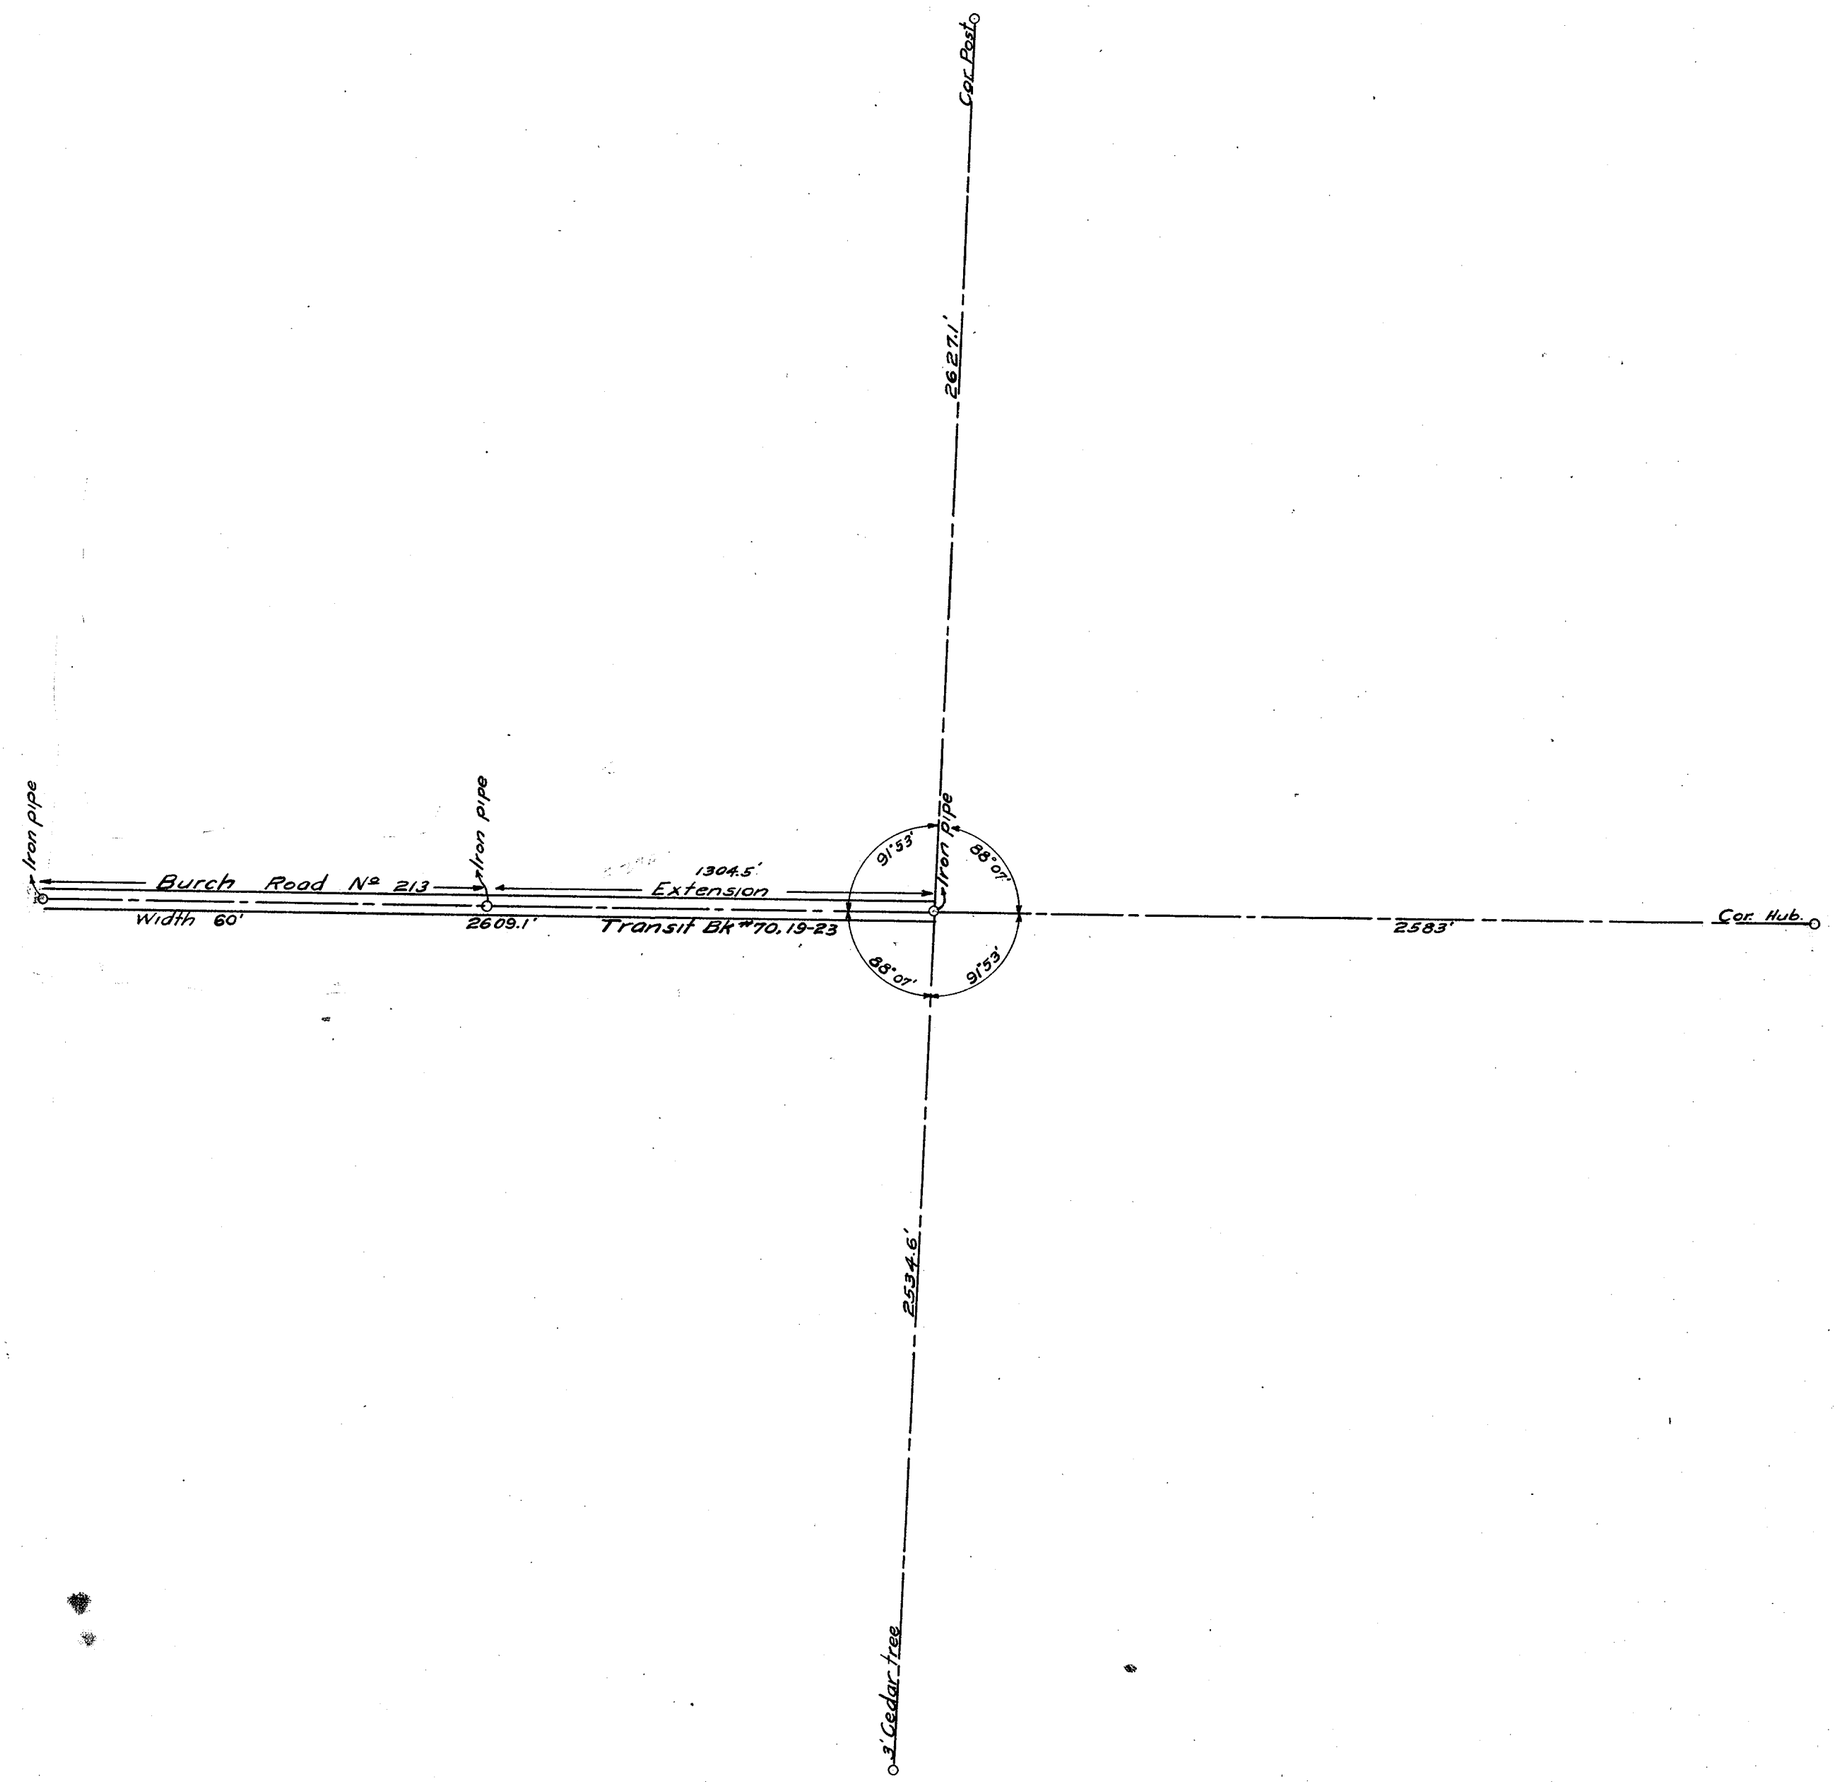


SECTION 28

TOWNSHIP 34 NORTH, RANGE 4 EAST, W. M.

SKAGIT COUNTY, WASH.

May - 1932
SCALE, 1 INCH = 400 FEET

R.E.L. Knapp. COUNTY ENGINEER
L.J. Wright. Asst.

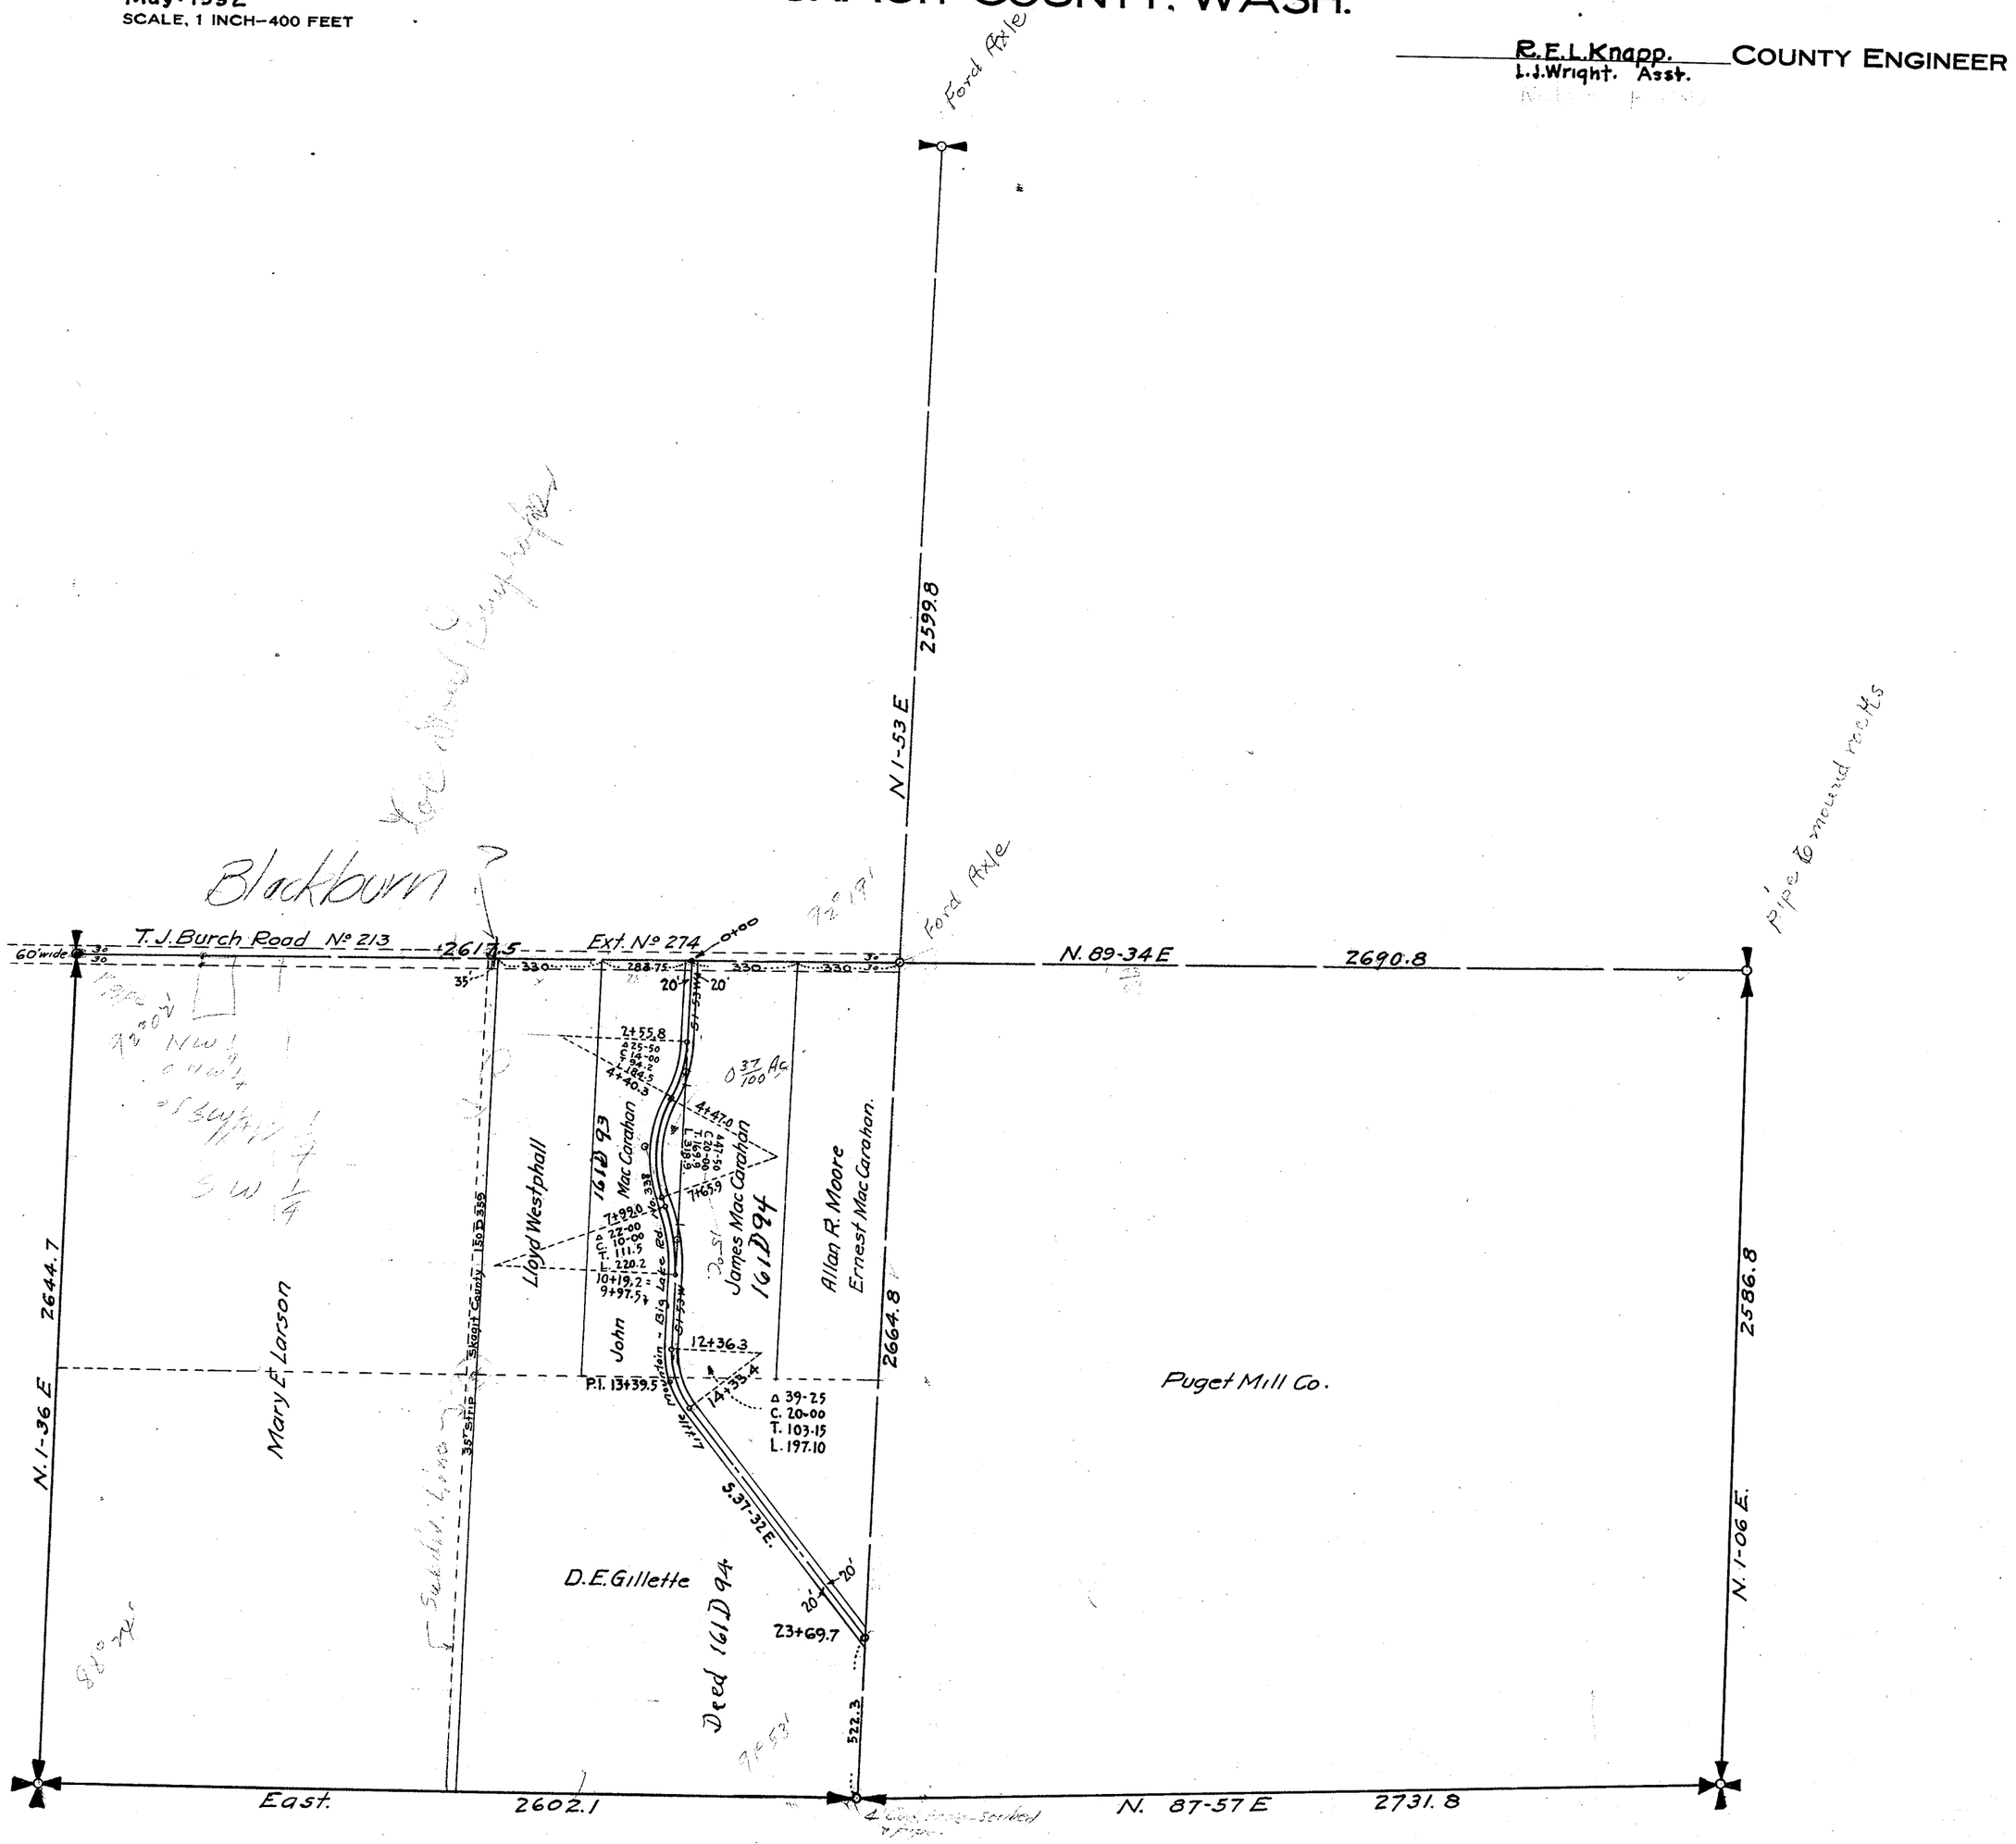

SECTION 28

TOWNSHIP 34 NORTH, RANGE 4 EAST, W. M.


SKAGIT COUNTY, WASH.

SCALE, 1 INCH - - 400 FEET

DATE January, 1971

Lloyd Johnson COUNTY ENGINEER

Note: Blackburn Road Drawn From Hard Copy A4/24

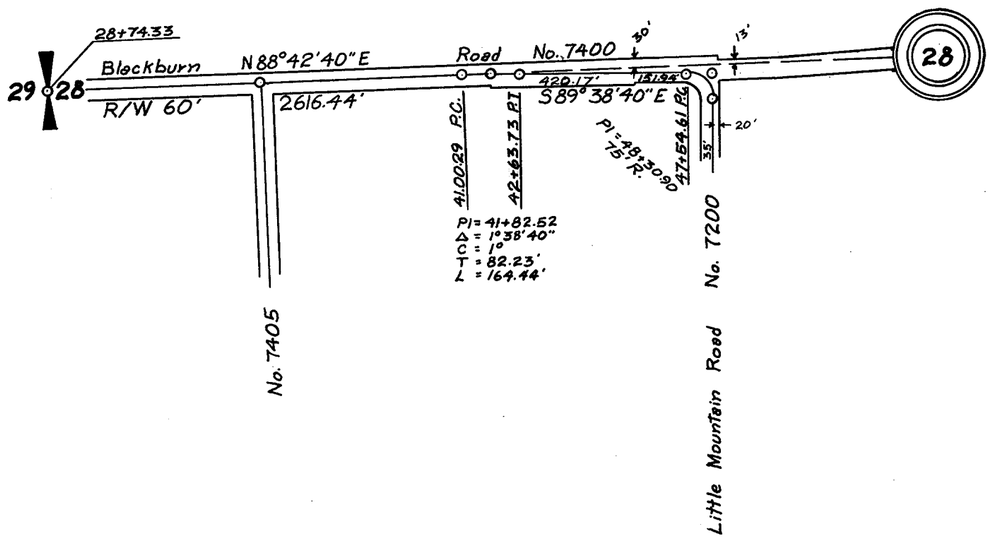

SECTION 29

TOWNSHIP 34 NORTH, RANGE 4 EAST, W. M.

SKAGIT COUNTY, WASH.


SCALE, 1 INCH -- 400 FEET

DATE January, 1971

Lloyd Johnson COUNTY ENGINEER

Note :

Blackburn Road Drawn From Hard Copy A4/24
Blodgett Road " " " " A2/15
18th St. Ext. " " " " A4/22

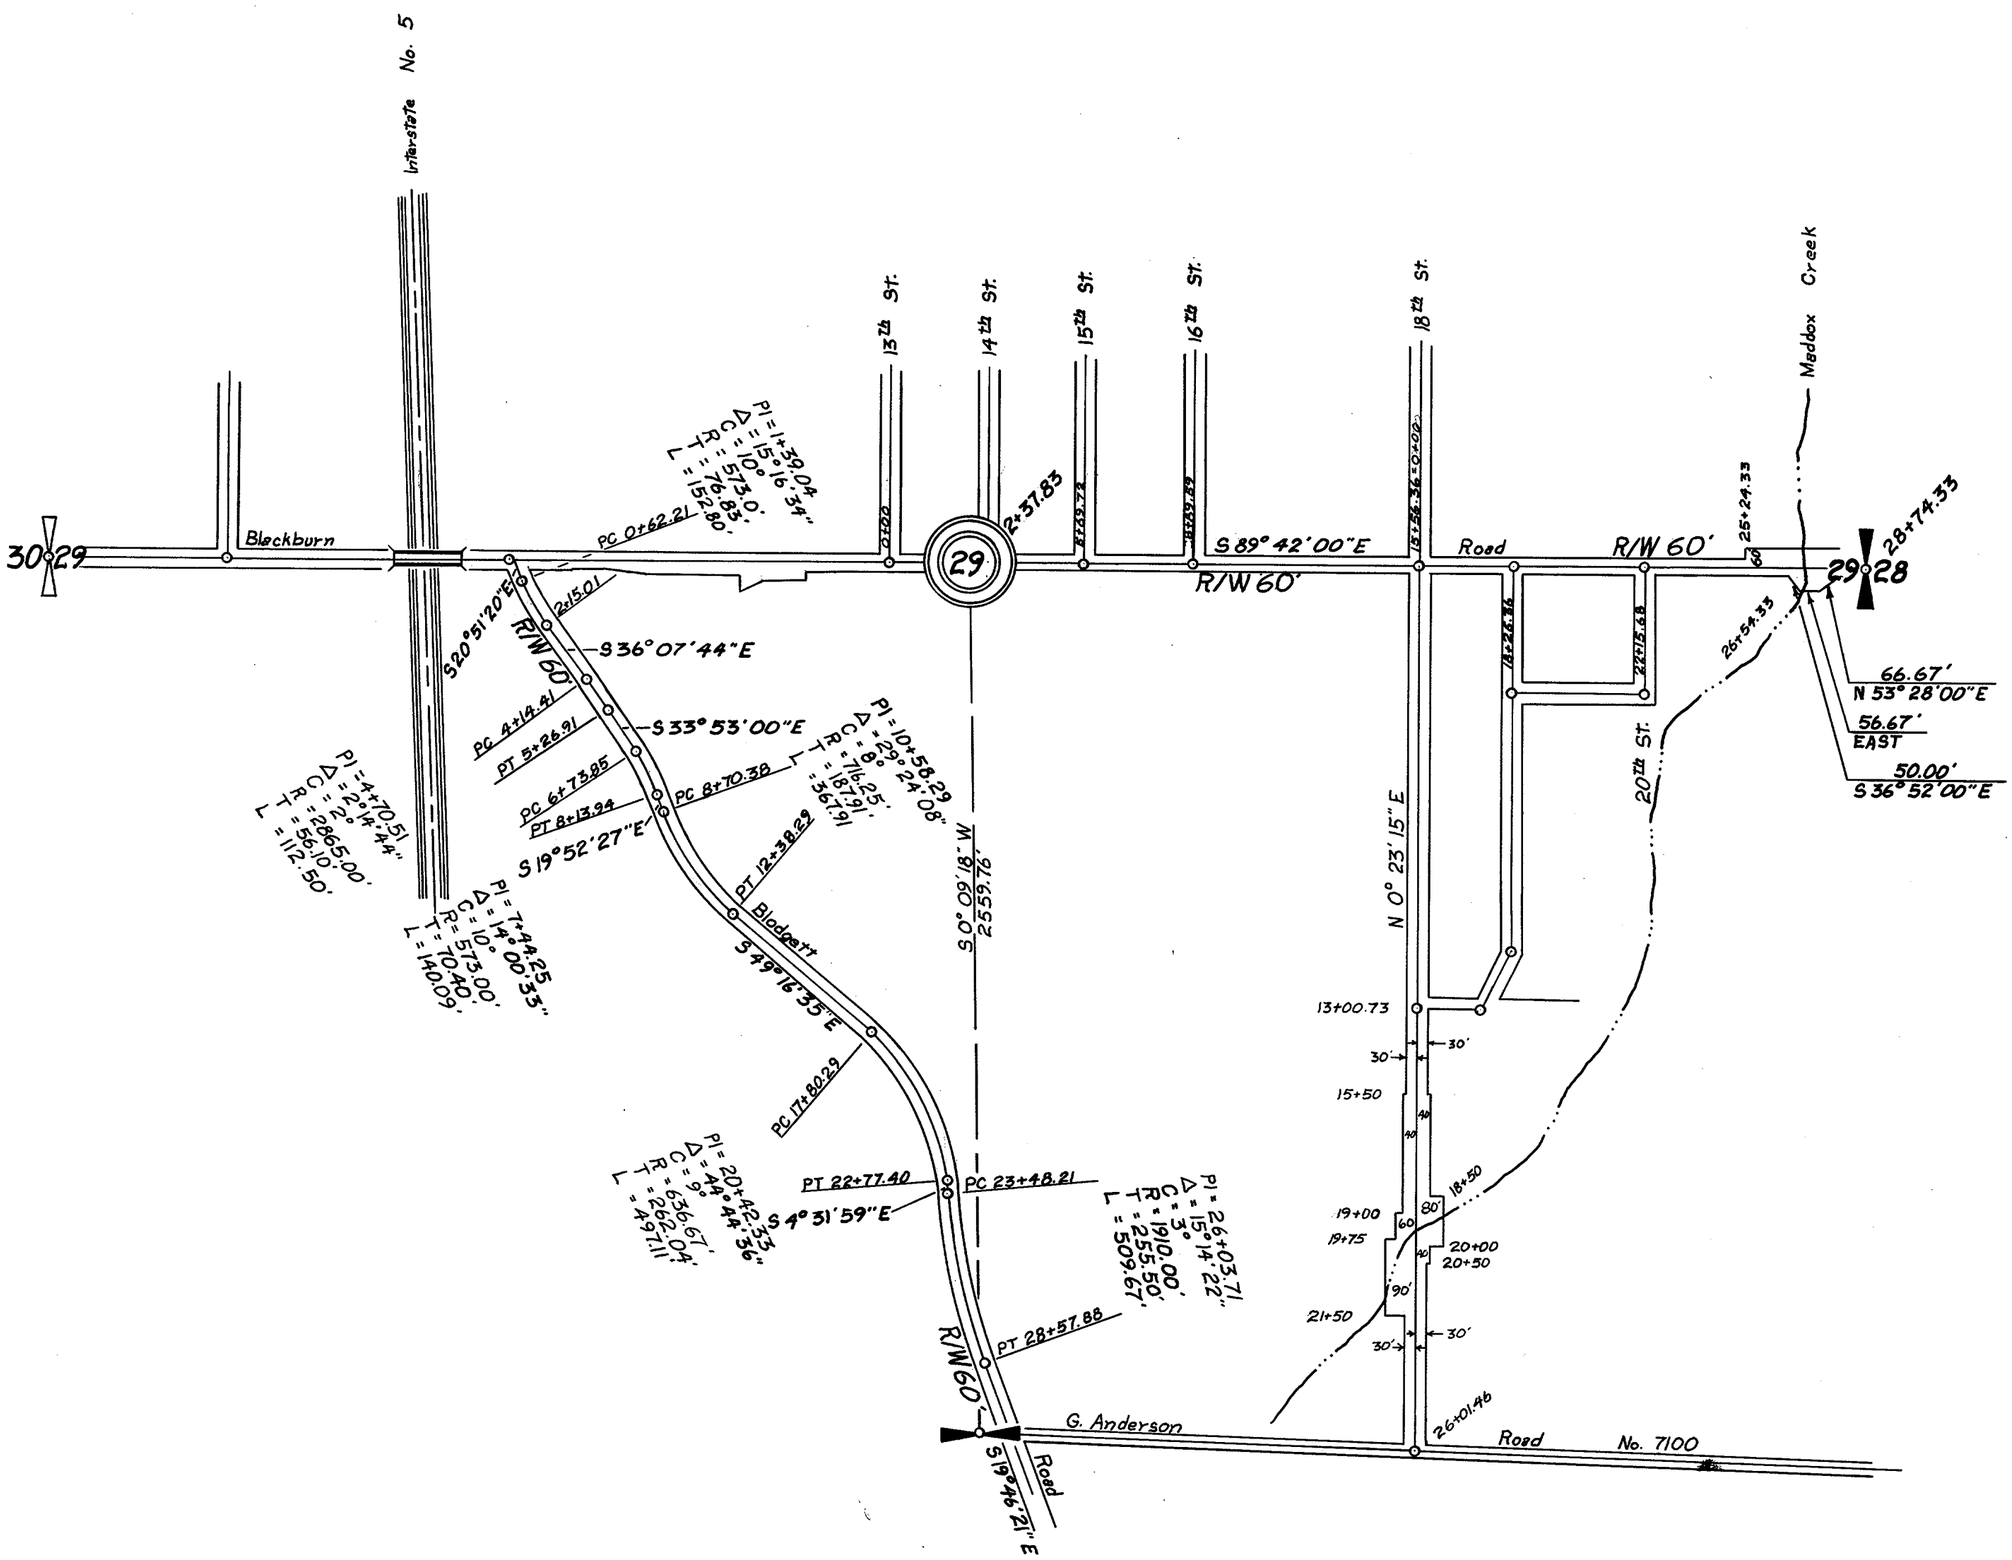


SECTION 29

TOWNSHIP 34 NORTH, RANGE 4 EAST, W. M.

SKAGIT COUNTY, WASH.

SCALE, 1 INCH--400 FEET

H.O. Wallberg COUNTY ENGINEER

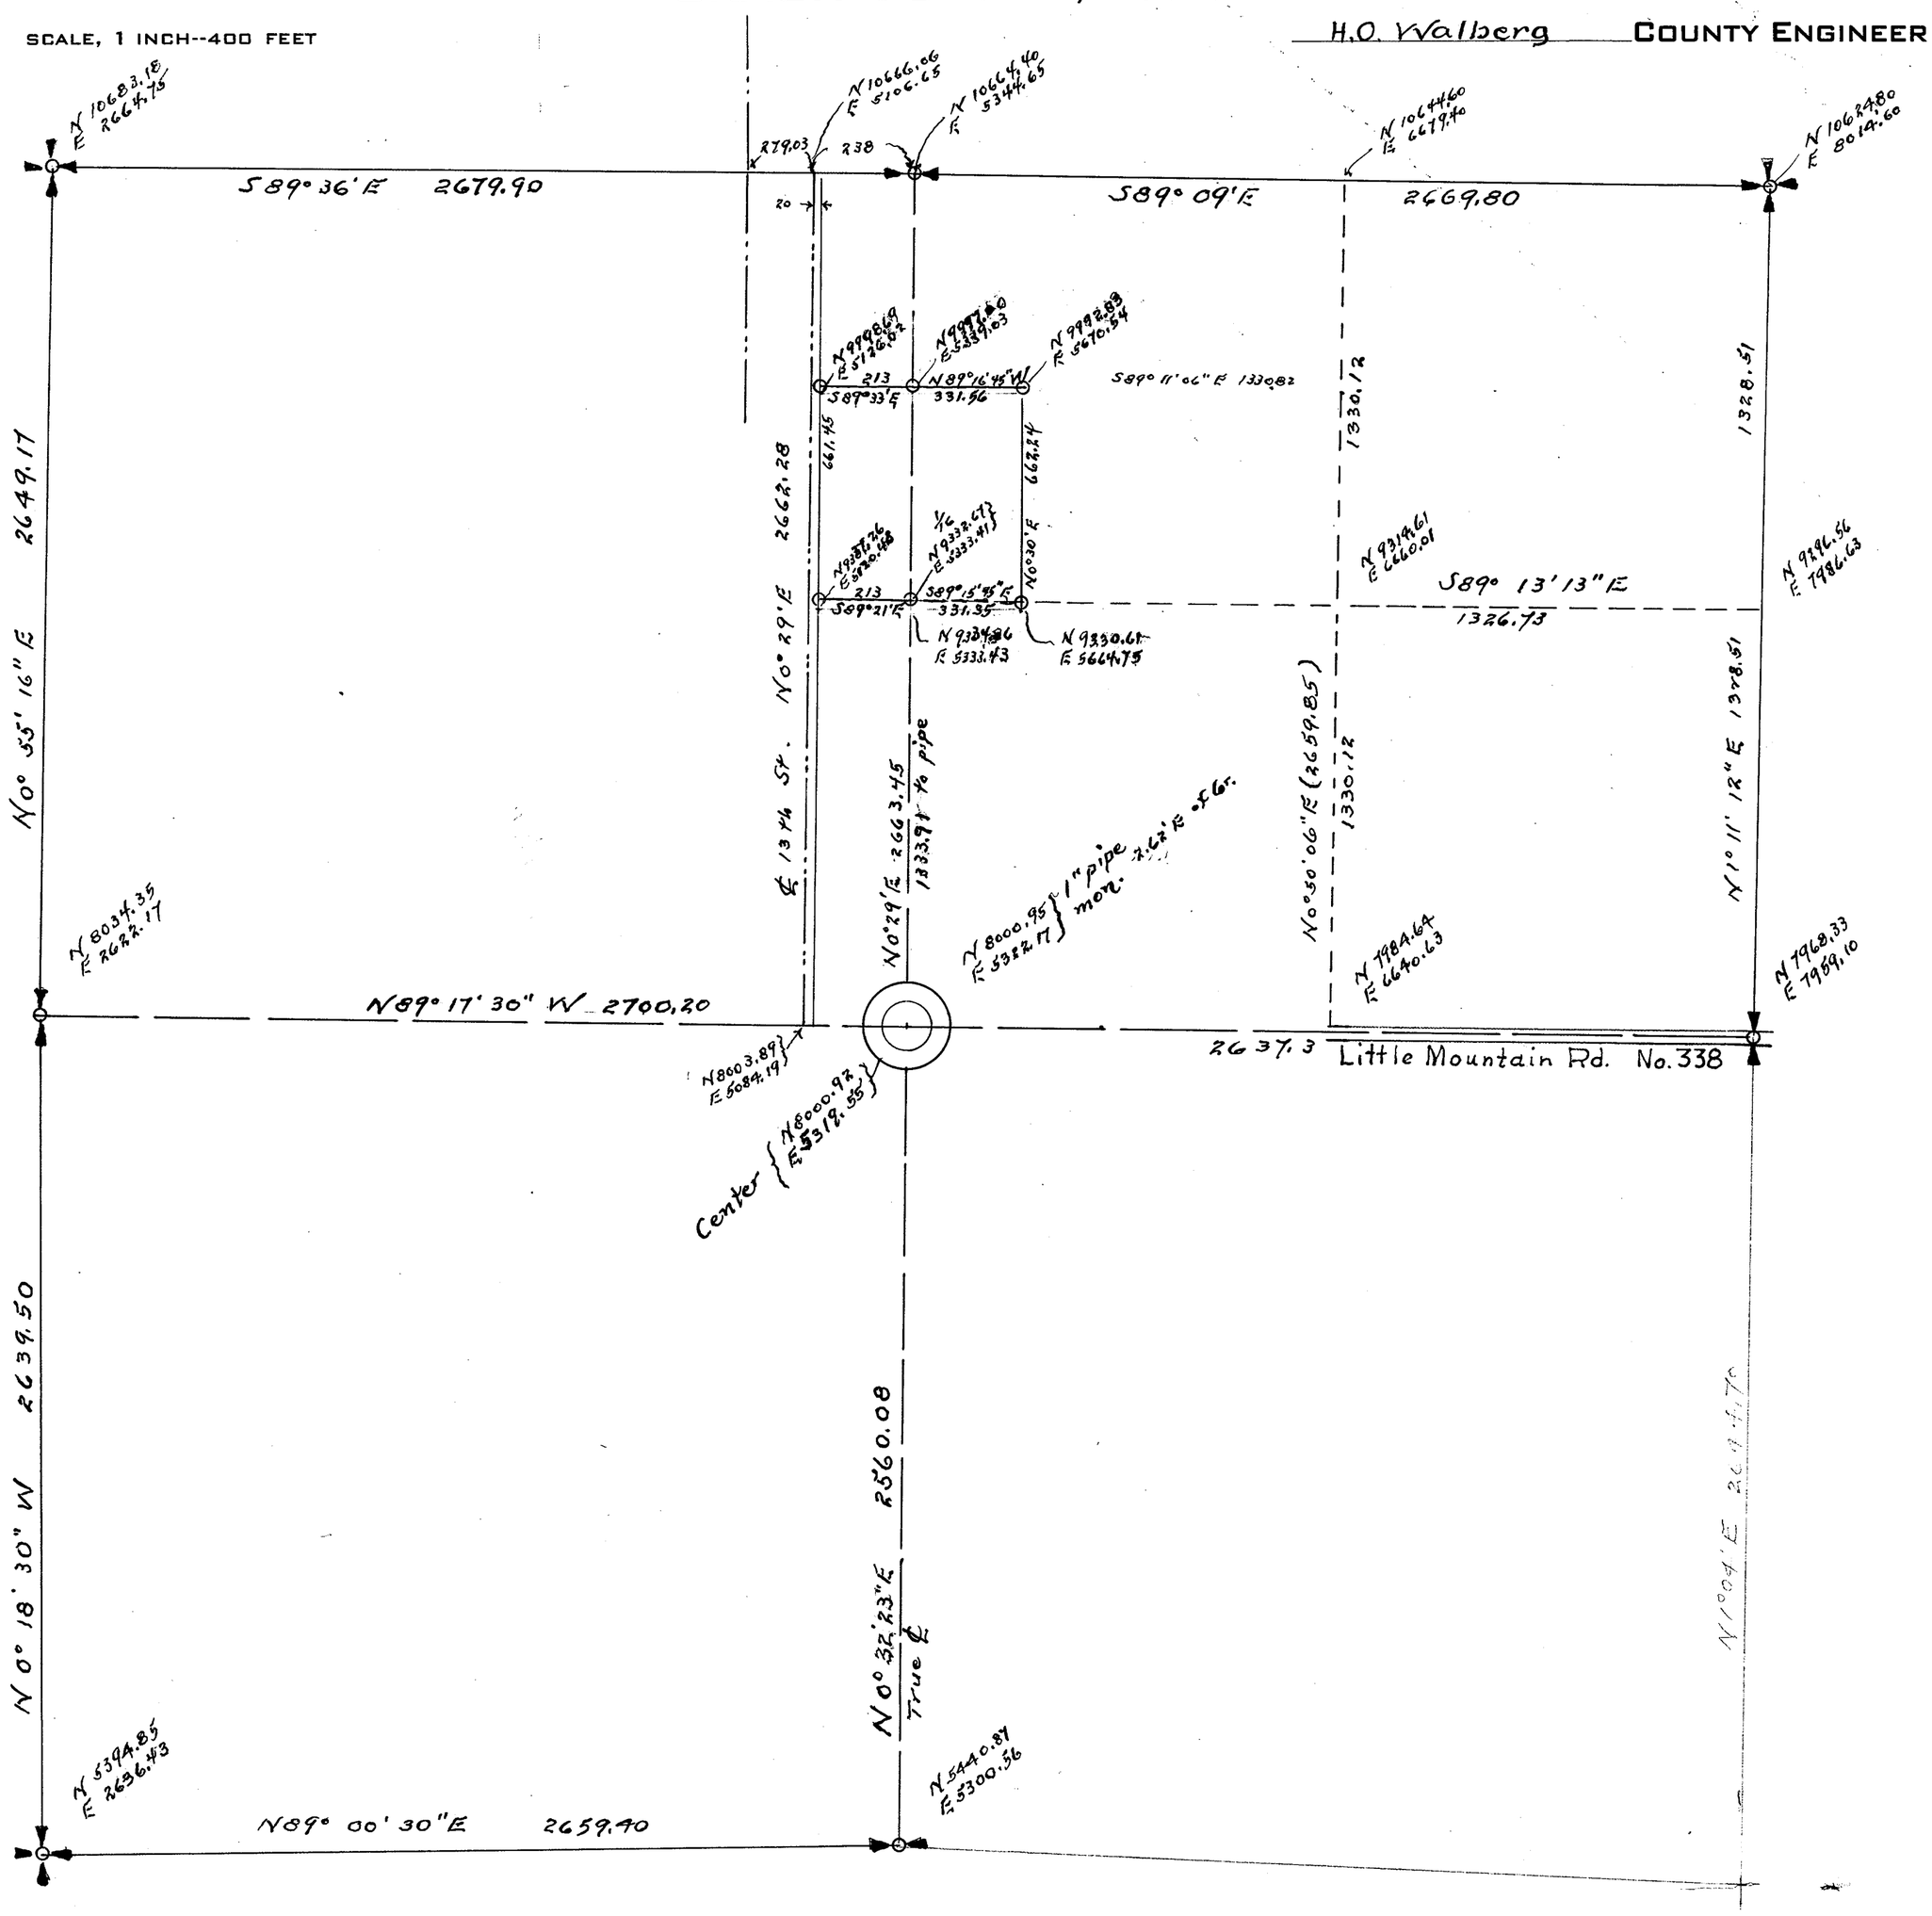

SECTION 29


TOWNSHIP 34 NORTH, RANGE 4 EAST, W. M.

SKAGIT COUNTY, WASH.

SCALE, 1 INCH–400 FEET

Robt. E. L. Knapp 1929 COUNTY ENGINEER

Note: Roads & City Limits added 7/19/66 – From Aerial Photo---

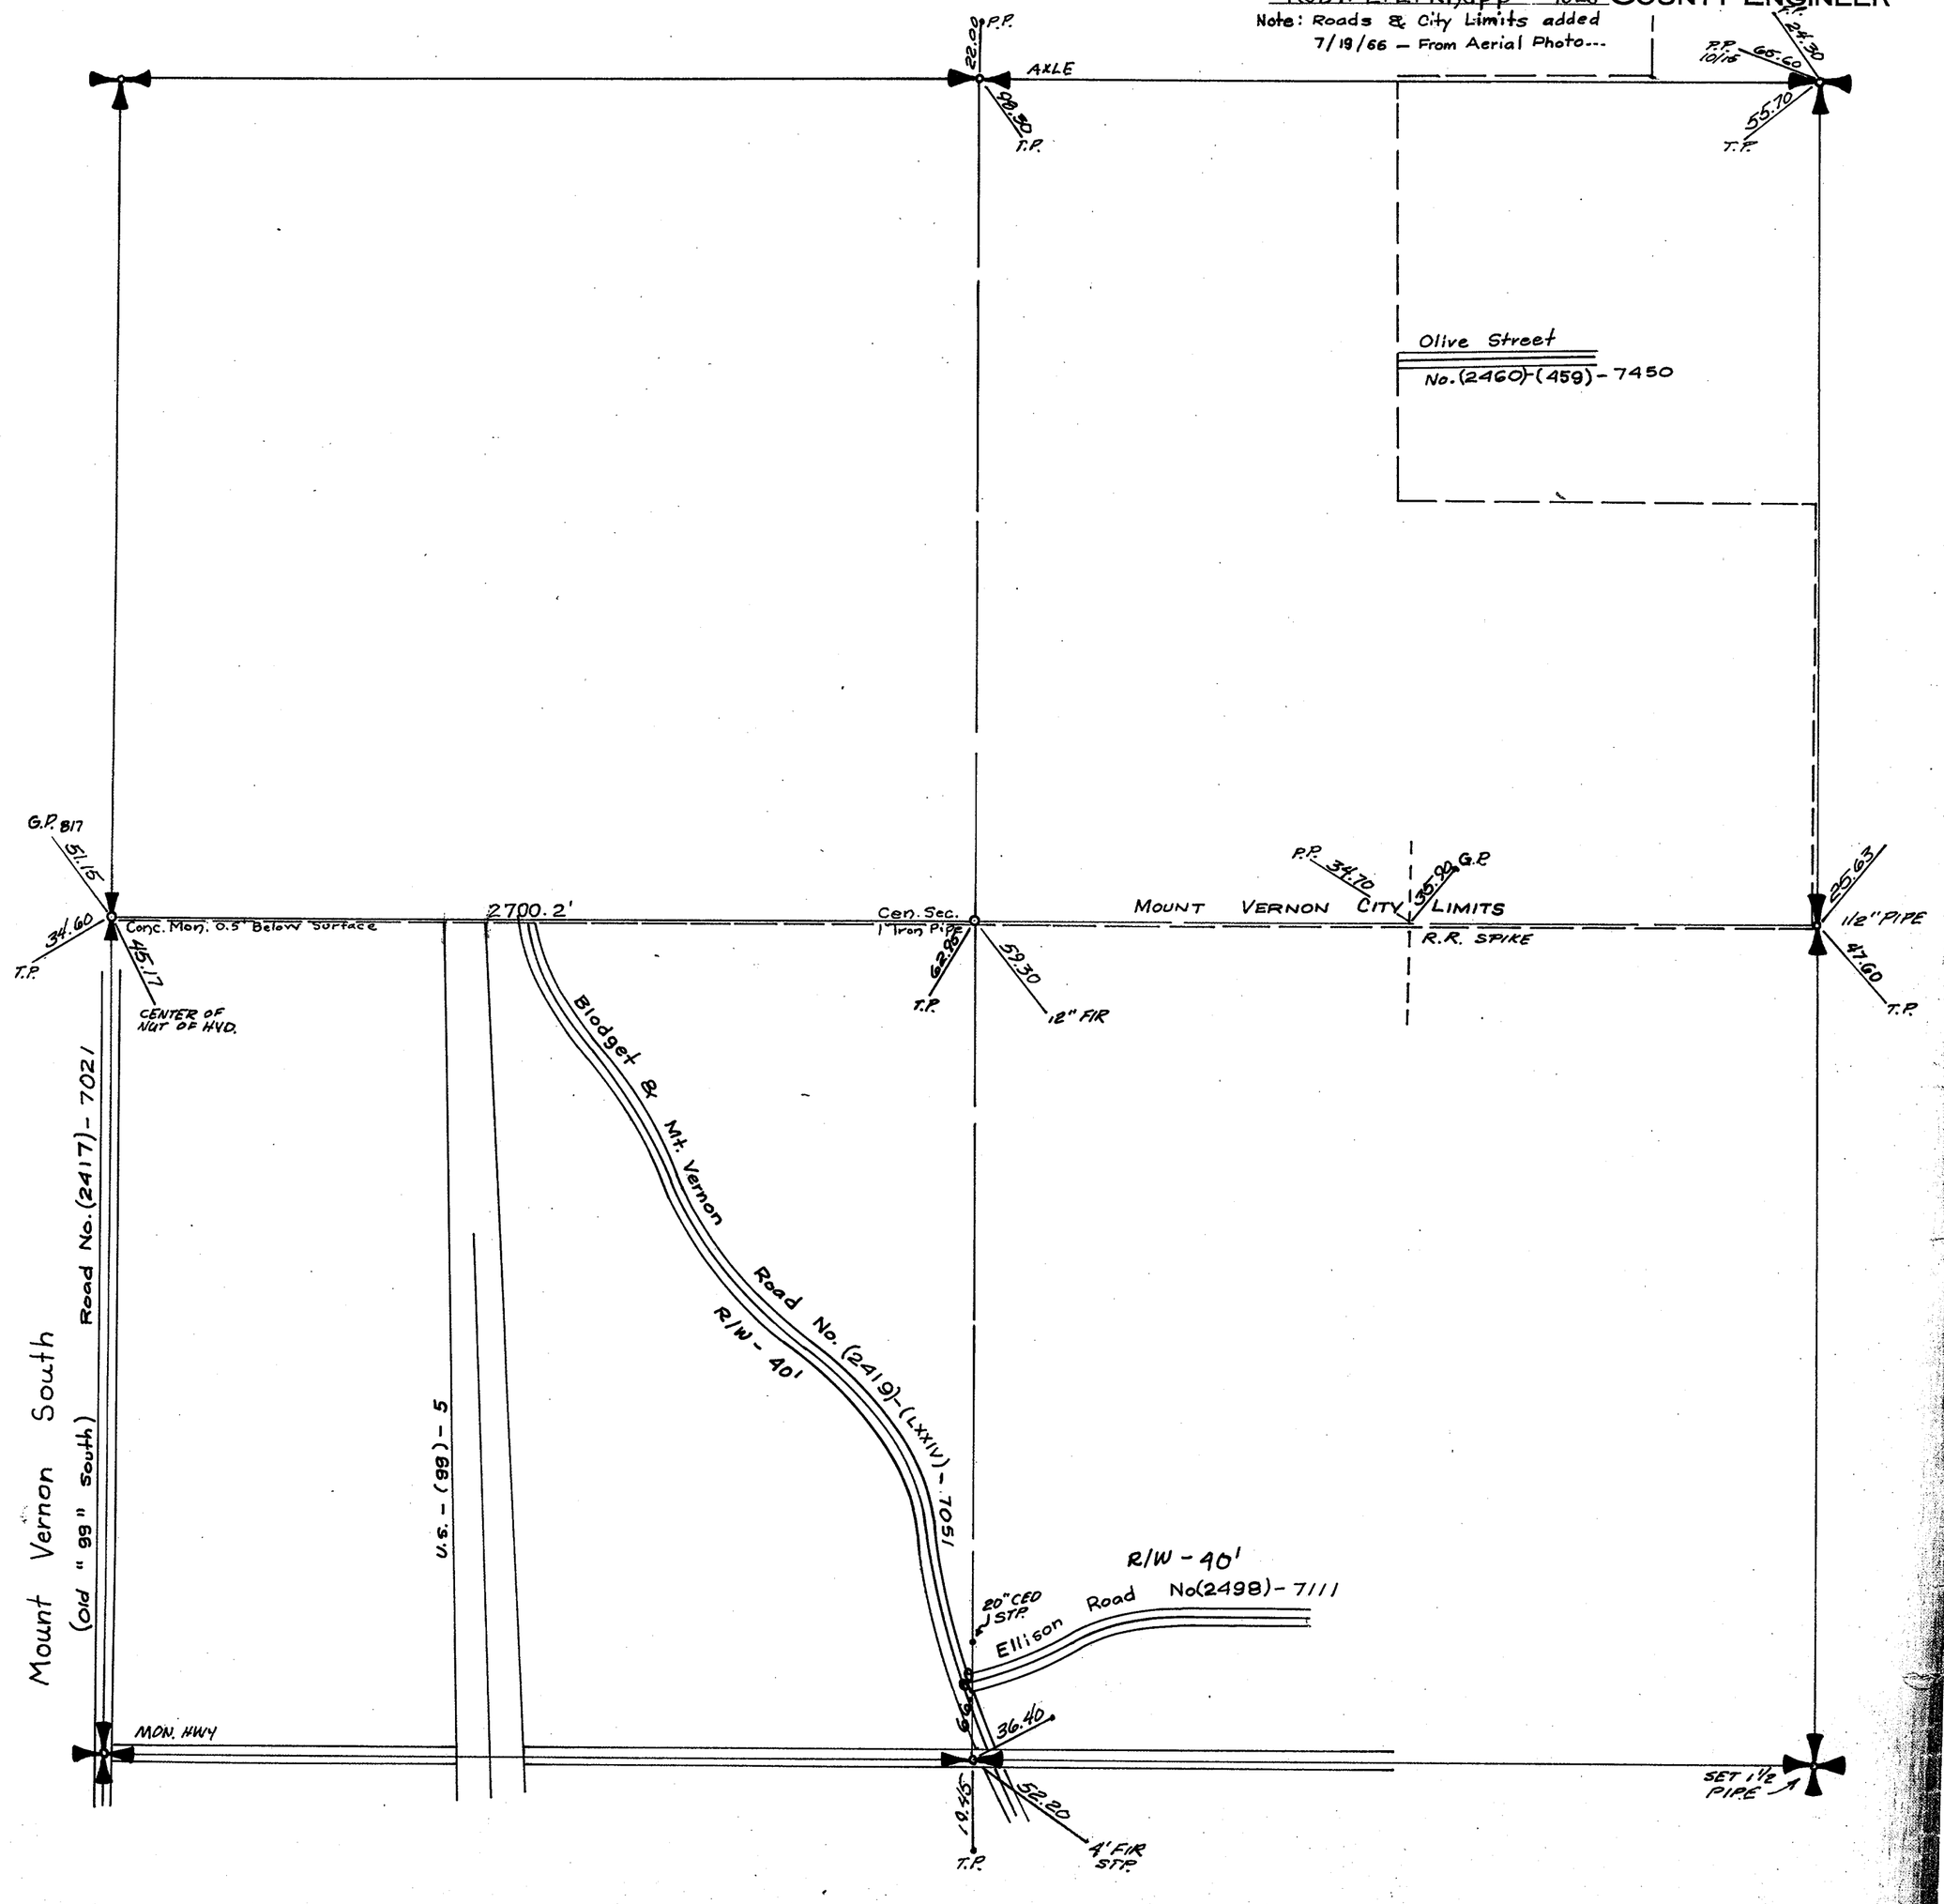


SECTION 30

TOWNSHIP 34 NORTH, RANGE 4 EAST, W. M.
SKAGIT COUNTY, WASH.

SCALE, 1 INCH—400 FEET

N-579


A. L. STRONG COUNTY ENGINEER

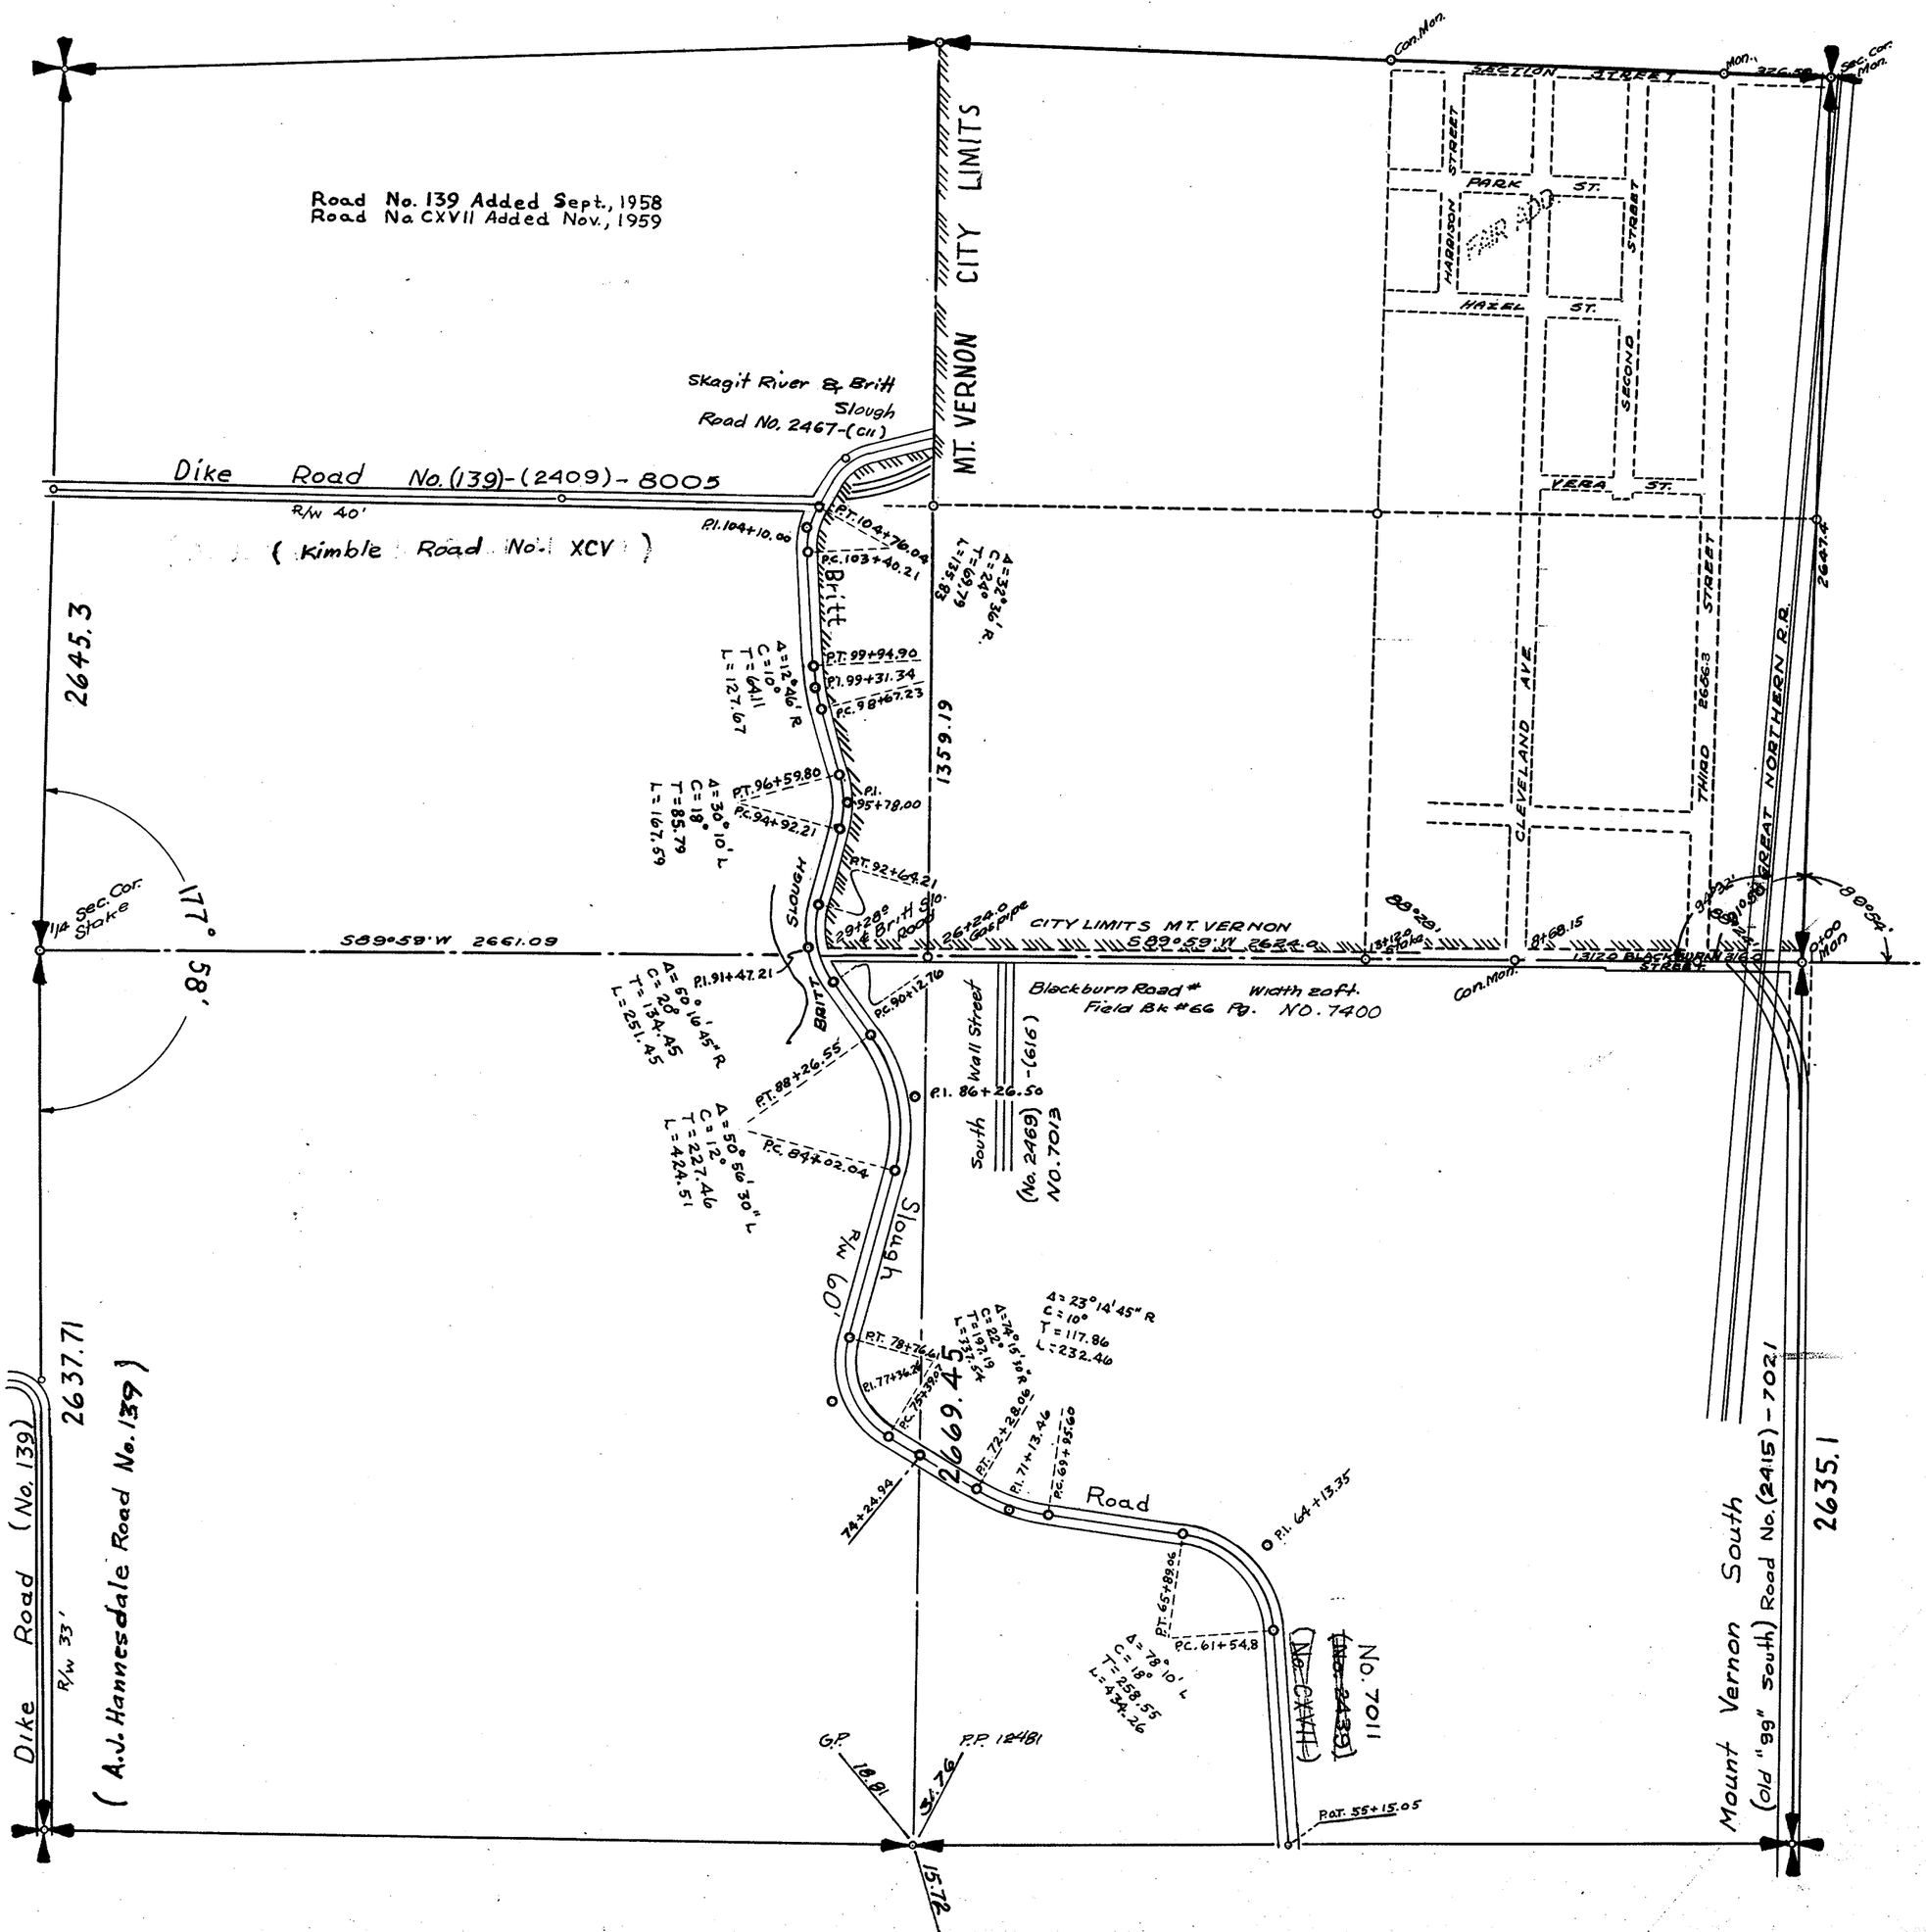

SECTION 31
TOWNSHIP 34 NORTH, RANGE 4 EAST, W. M.
SKAGIT COUNTY, WASH.

SCALE, 1 INCH--400 FEET

G. D. LeGro
Sept. 1958
COUNTY ENGINEER

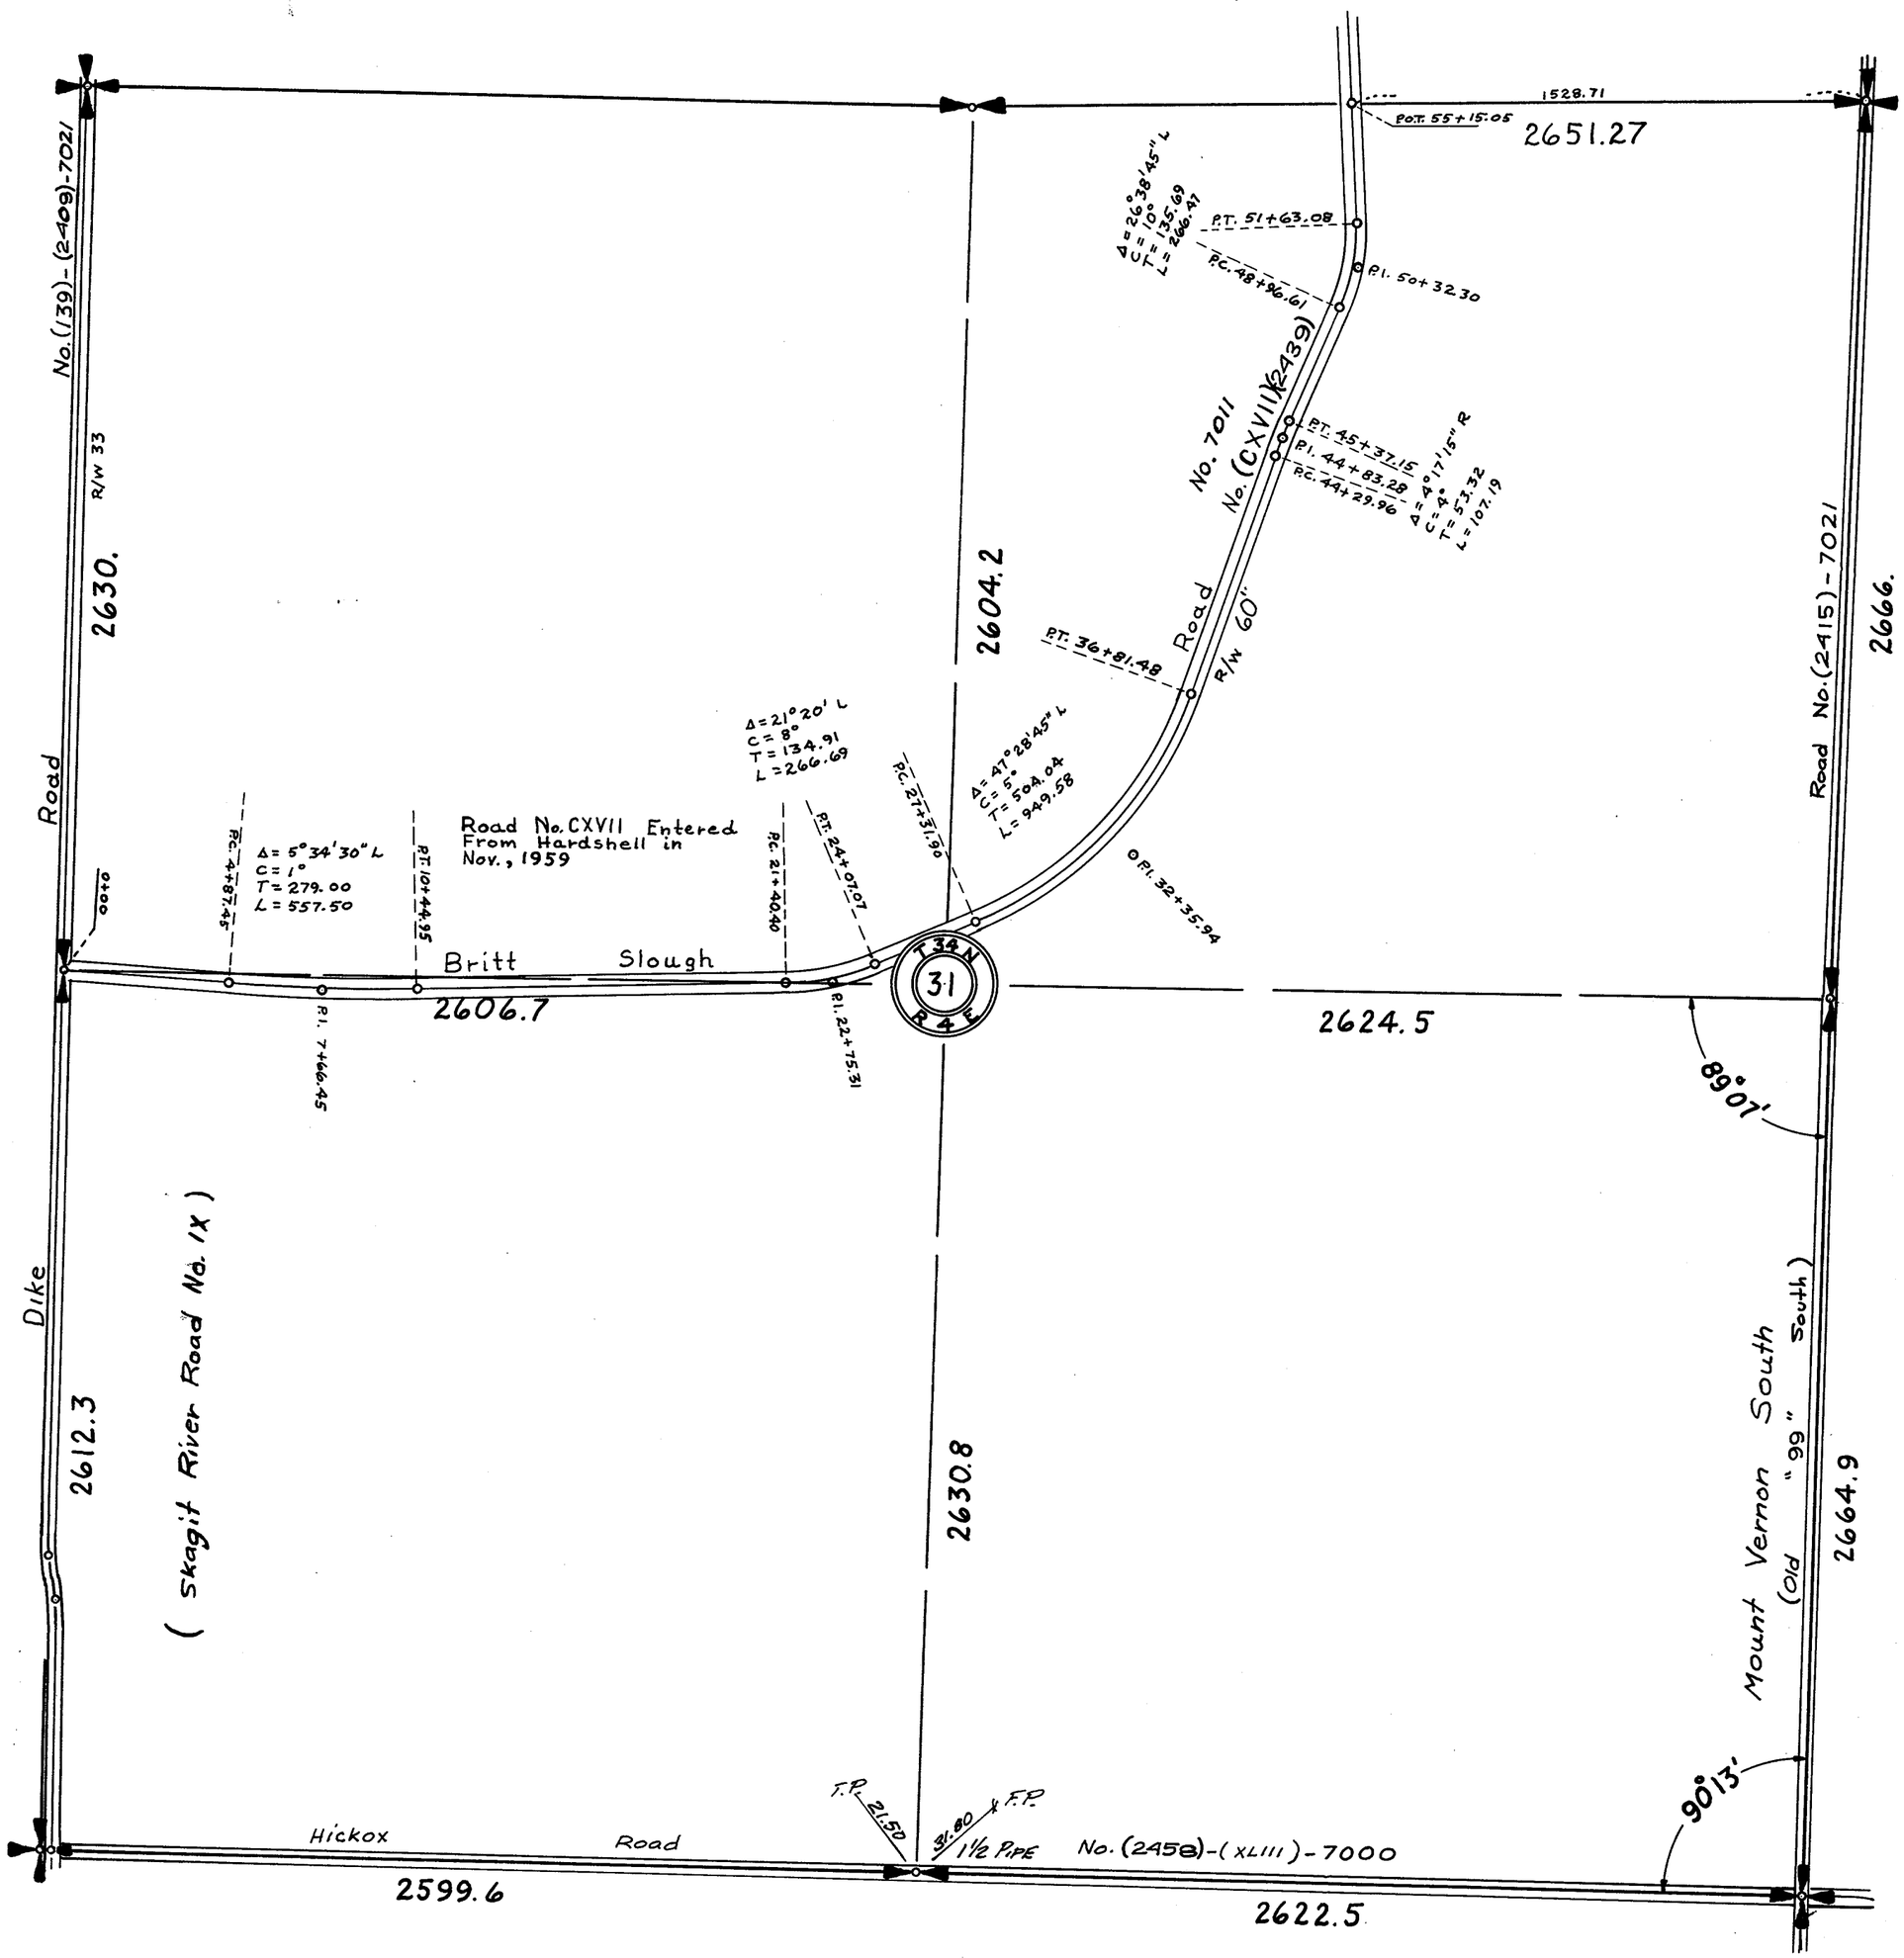

SECTION 31

TOWNSHIP 34 NORTH. RANGE 4 EAST. W. M.


SKAGIT COUNTY. WASH.

Sub. Div. THOMAS V. WILLIAMS, L.S.
Seattle, Wn.

SCALE. 1 INCH—400 FEET

LLOYD H. JOHNSON COUNTY ENGINEER

DATE NOV. 2, 1972

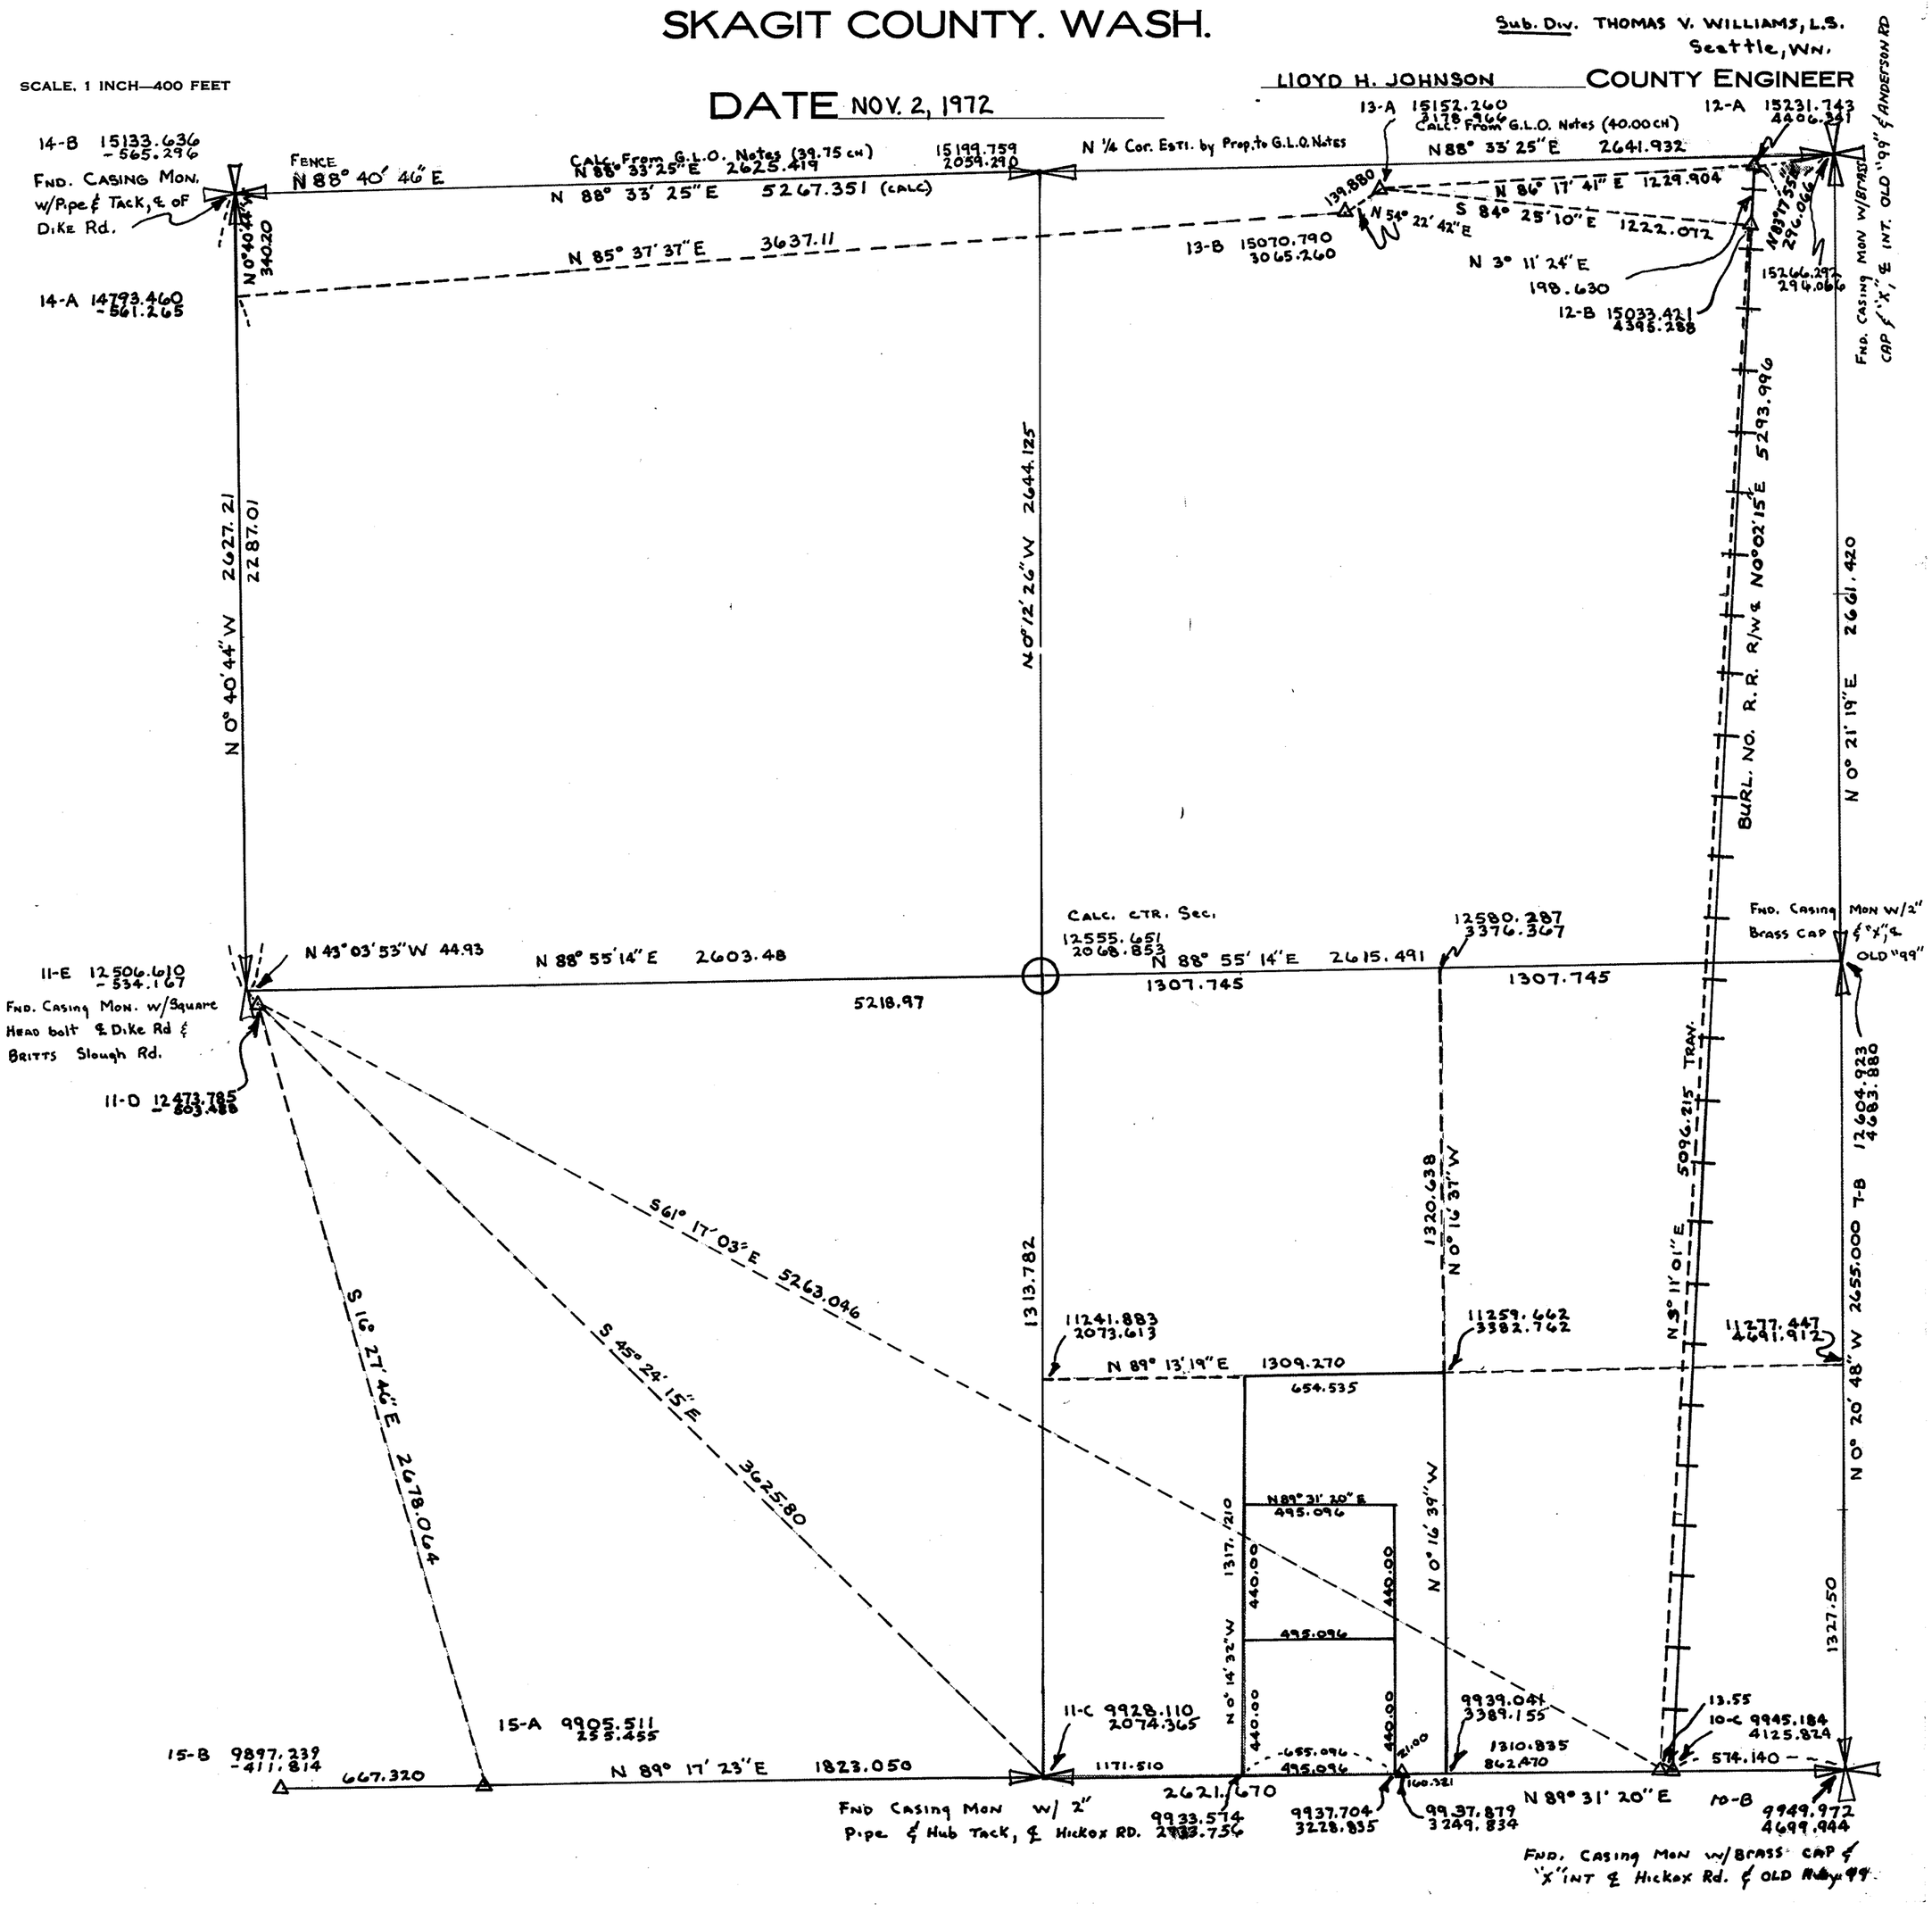

SECTION 32

TOWNSHIP 34 NORTH, RANGE 4 EAST, W. M.

SKAGIT COUNTY, WASH.

SCALE, 1 INCH—400 FEET

W.E. Castello COUNTY ENGINEER

G.P. 18.81 S. 7.4 W. P.P. 12481

CONC. MON. 2" DOWN

T.P. 15.72

G. Anderson

Road No. (2450)-(156)-7100
R/W - 40'

Hollydale Acres

Road No. (2417)(434)
NO. 7123
R/W - 30'

Blodget

Road No. (2415)-7021

Mount Vernon South
(Old "99" South)

R/W - 60'

STATE HWY (99)-5

Mount Vernon

N-599
338

MON.
16.50
24" COTTONWOOD
30.10
5' CED. STP.

Road No. (2419)-(LXXV)-7051

R/W - 40'

Sky Ridge Road No. (2472)-(659)-7212

Sky Ridge Road

Meadow Lane Road No. (2471)-(657) R/W-40
NO. 7211

Sound View Road No. (2473)-(658) R/W-40'
7213

Olympic Place Road No. (2476)-(660)-7215
R/W-40'

7215

P.P.
T.P.
12.70
42.80

Hickox Road No. (2458) - (XLIII) - 7000 R/W - 60'

43.20 T.P.

MON.
58.40
10" FIR
33.50 P.P.

2654.8' S 89° 49' E.

Gas Pipe

32 33

Stone (X).

5 4

SECTION 32


TOWNSHIP 34 NORTH, RANGE 4 EAST, W.M.

SKAGIT COUNTY, WASH.

SCALE 1 INCH 400 FEET

DATE June 15, 1972

Lloyd H. Johnson COUNTY ENGINEER

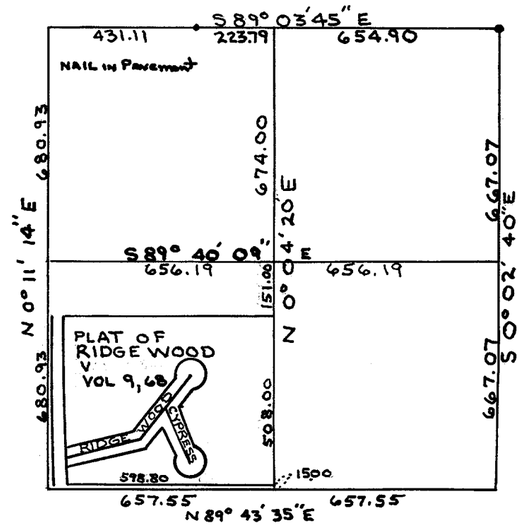

SECTION 33


TOWNSHIP 34 NORTH, RANGE 4 EAST, W. M.

SKAGIT COUNTY, WASH.

SCALE, 1 INCH--400 FEET

DATE June, 1959

Frank Gilkey COUNTY ENGINEER

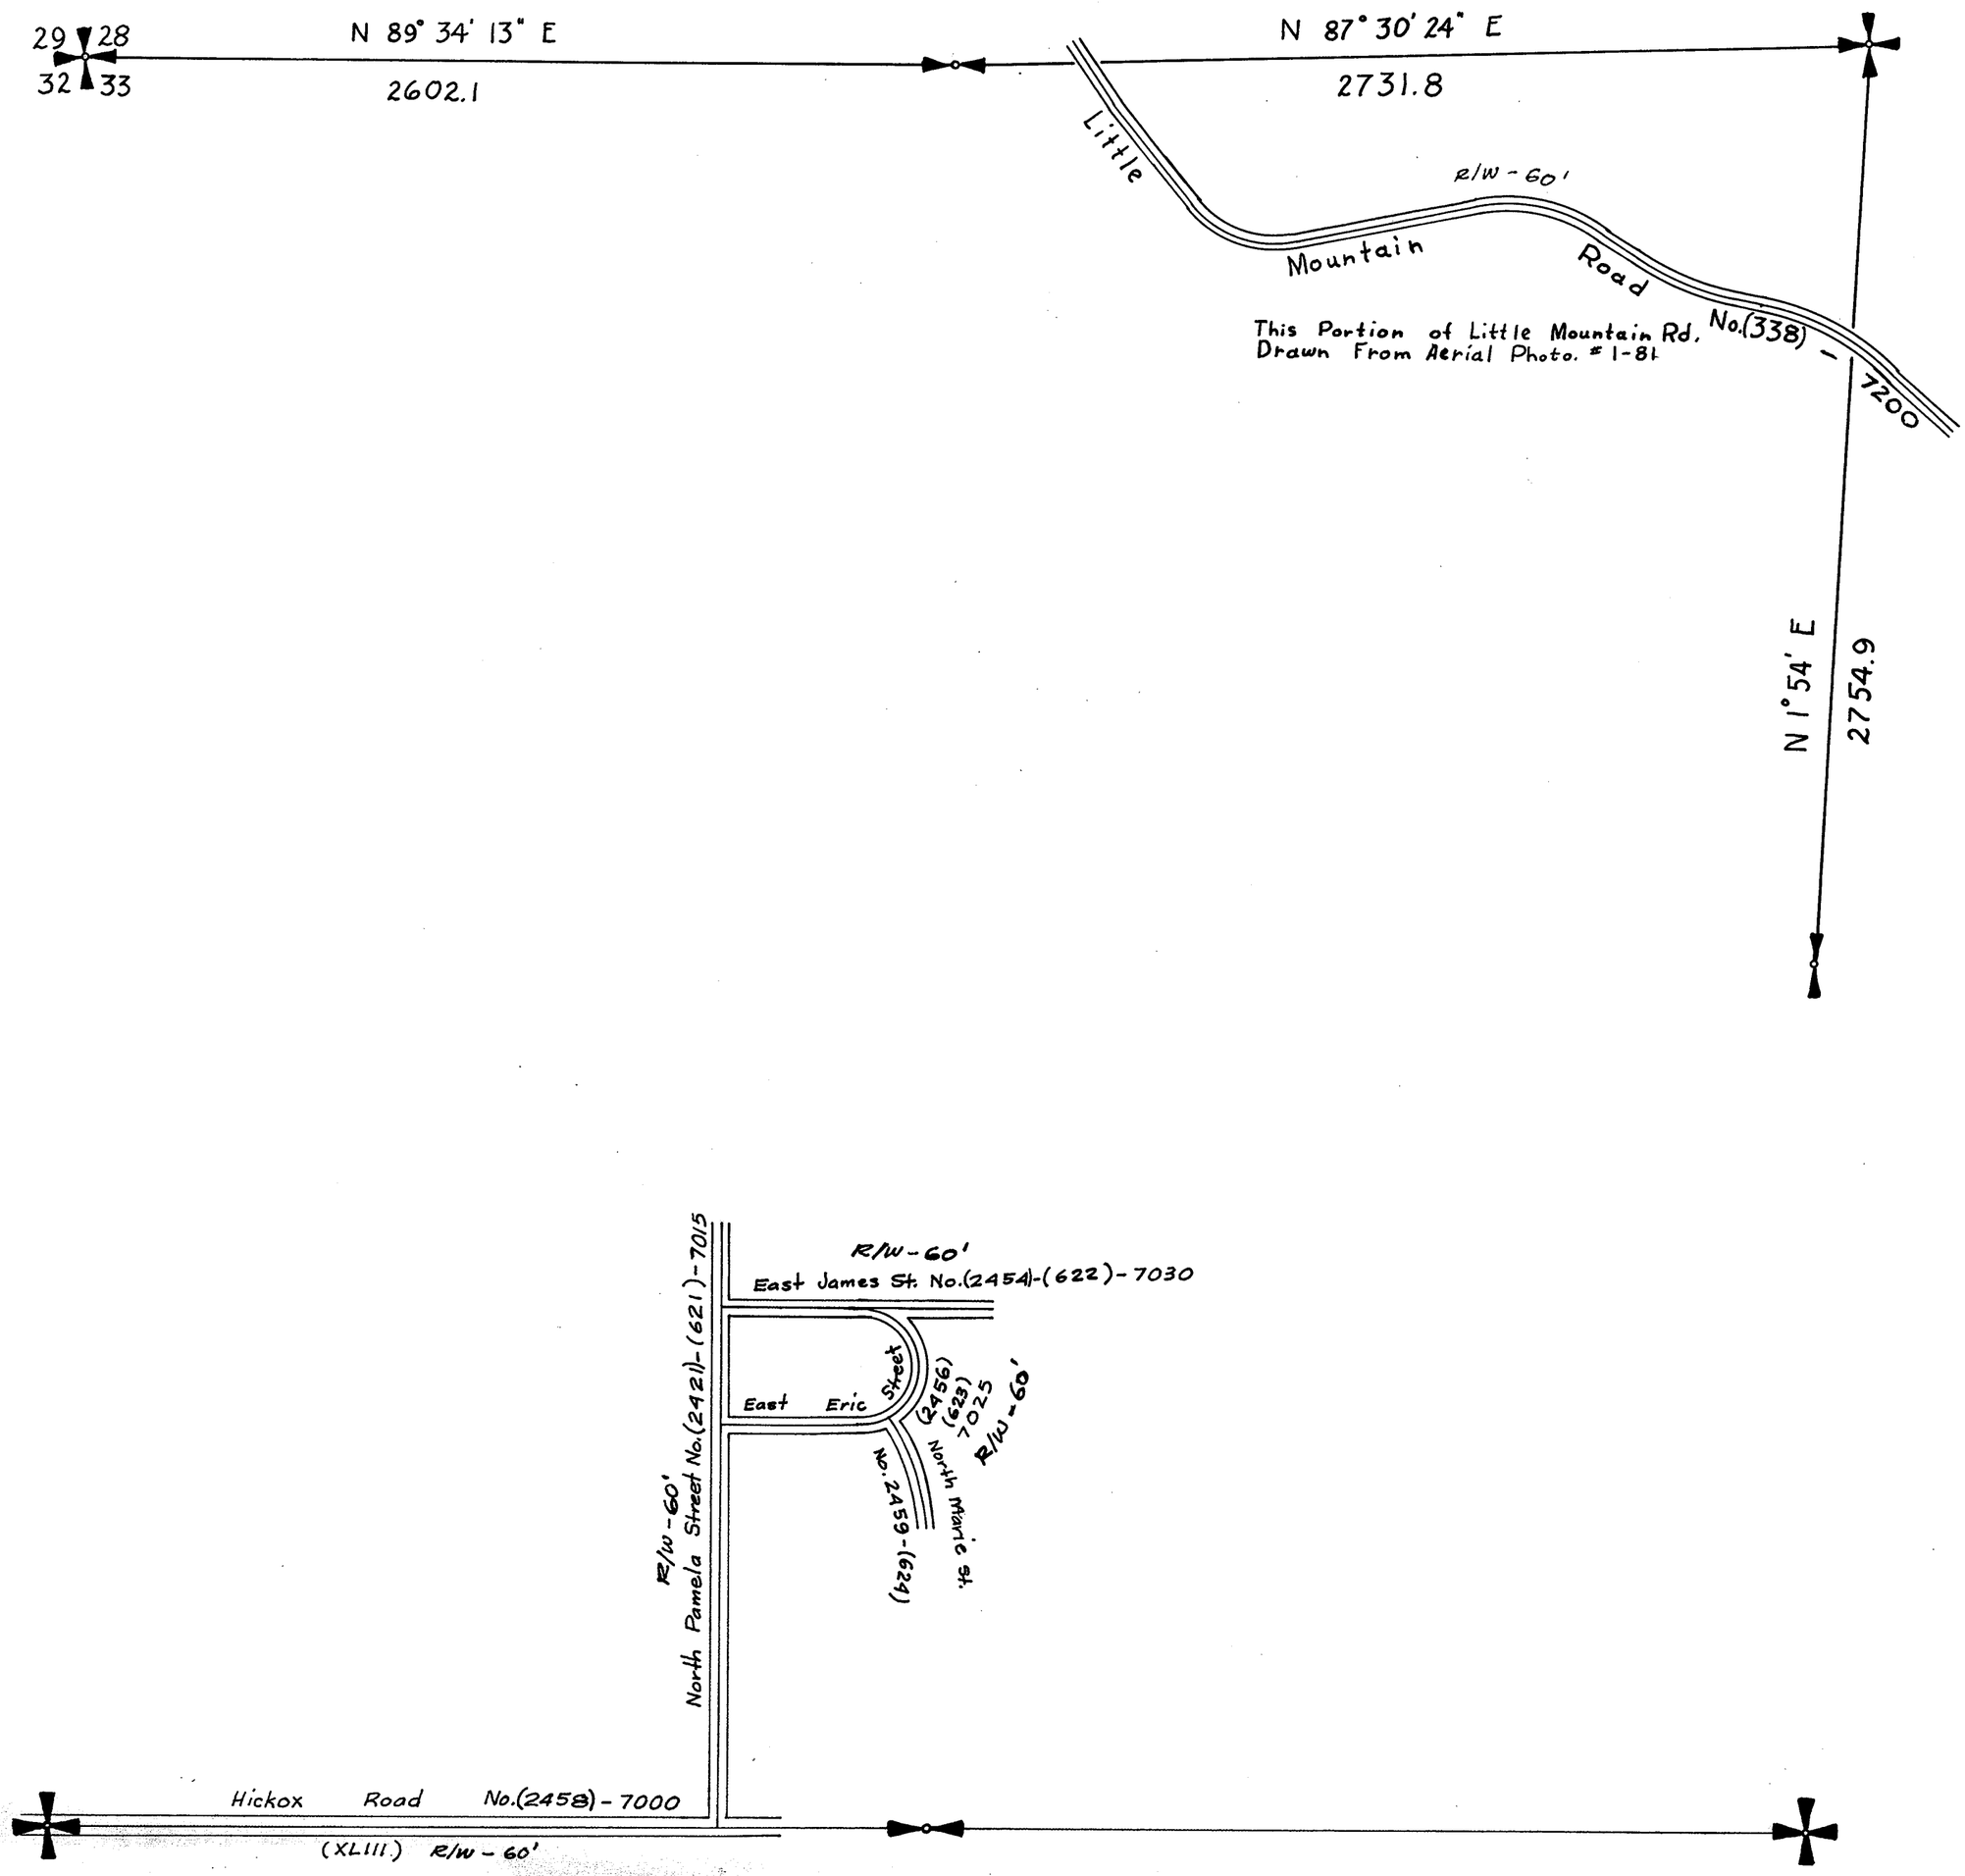


SECTION 34

TOWNSHIP 34 NORTH, RANGE 4 EAST, W. M.

SKAGIT COUNTY, WASH.

SCALE, 1 INCH--400 FEET

DATE June, 1959 Frank Gilkey COUNTY ENGINEER

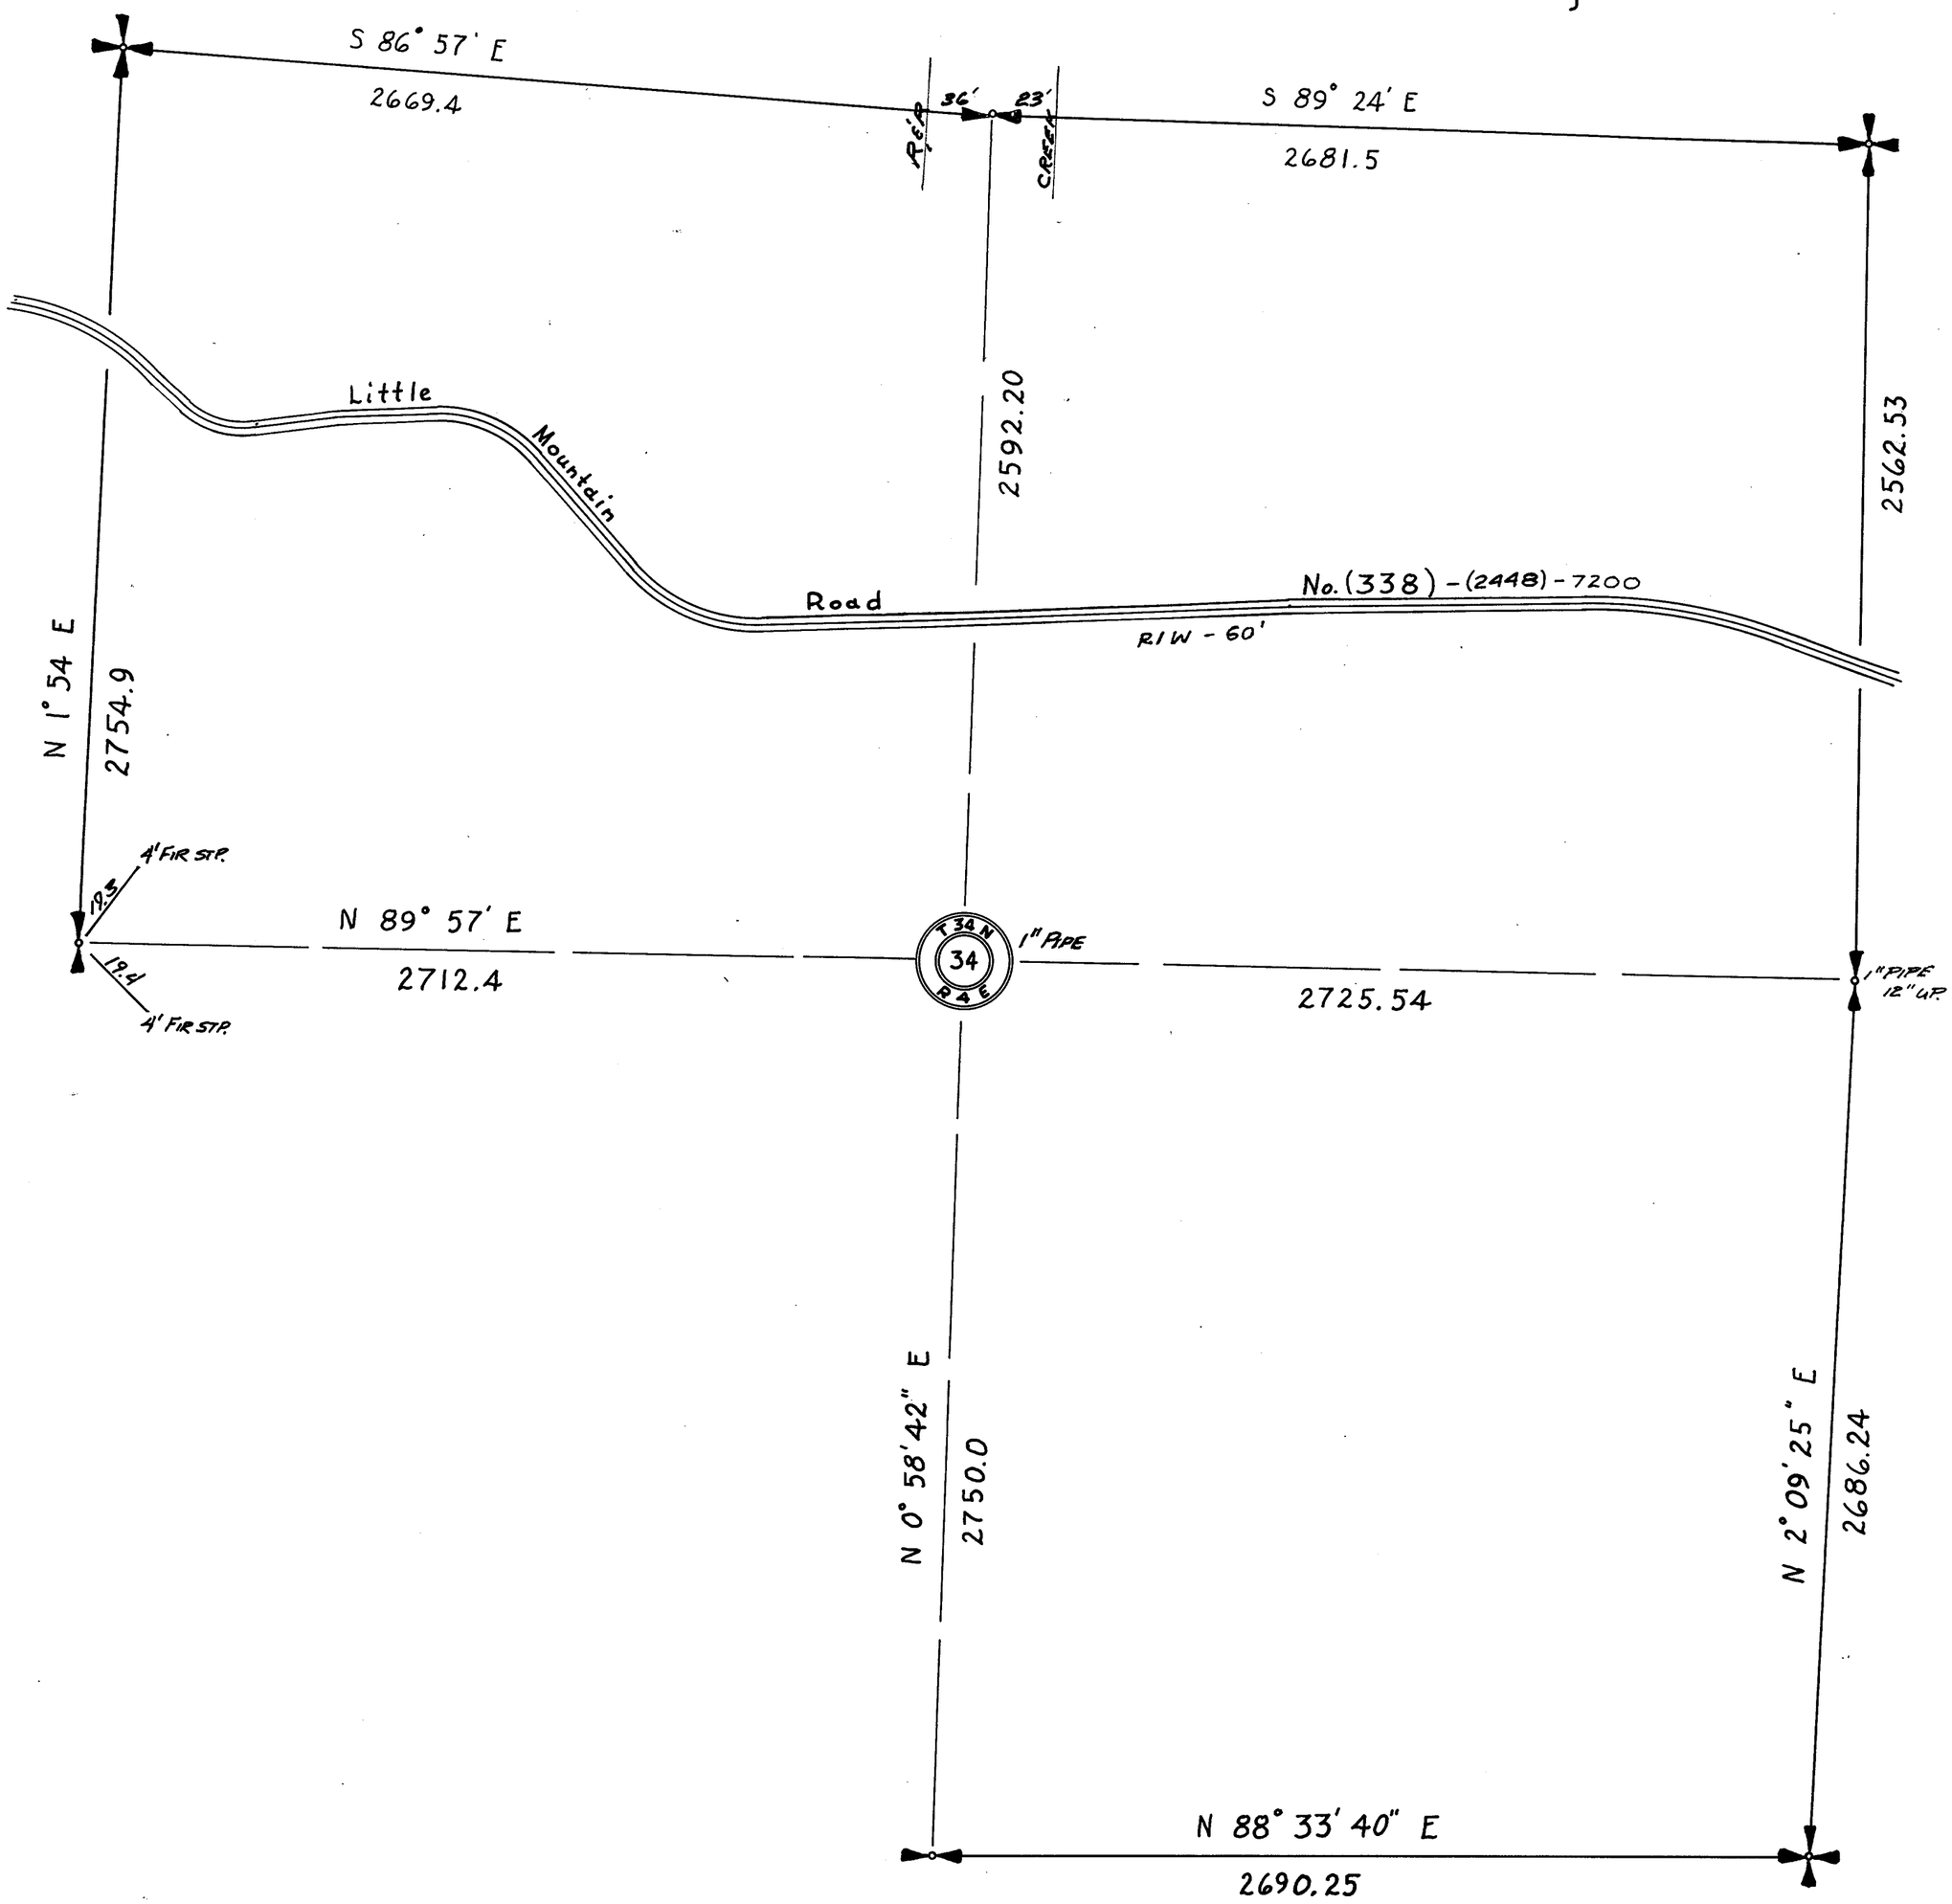


SECTION 35
TOWNSHIP 34 NORTH, RANGE 4 EAST, W. M.
SKAGIT COUNTY, WASH.

SCALE, 1 INCH--400 FEET

DATE June, 1959

Frank Gilkey COUNTY ENGINEER

N-230

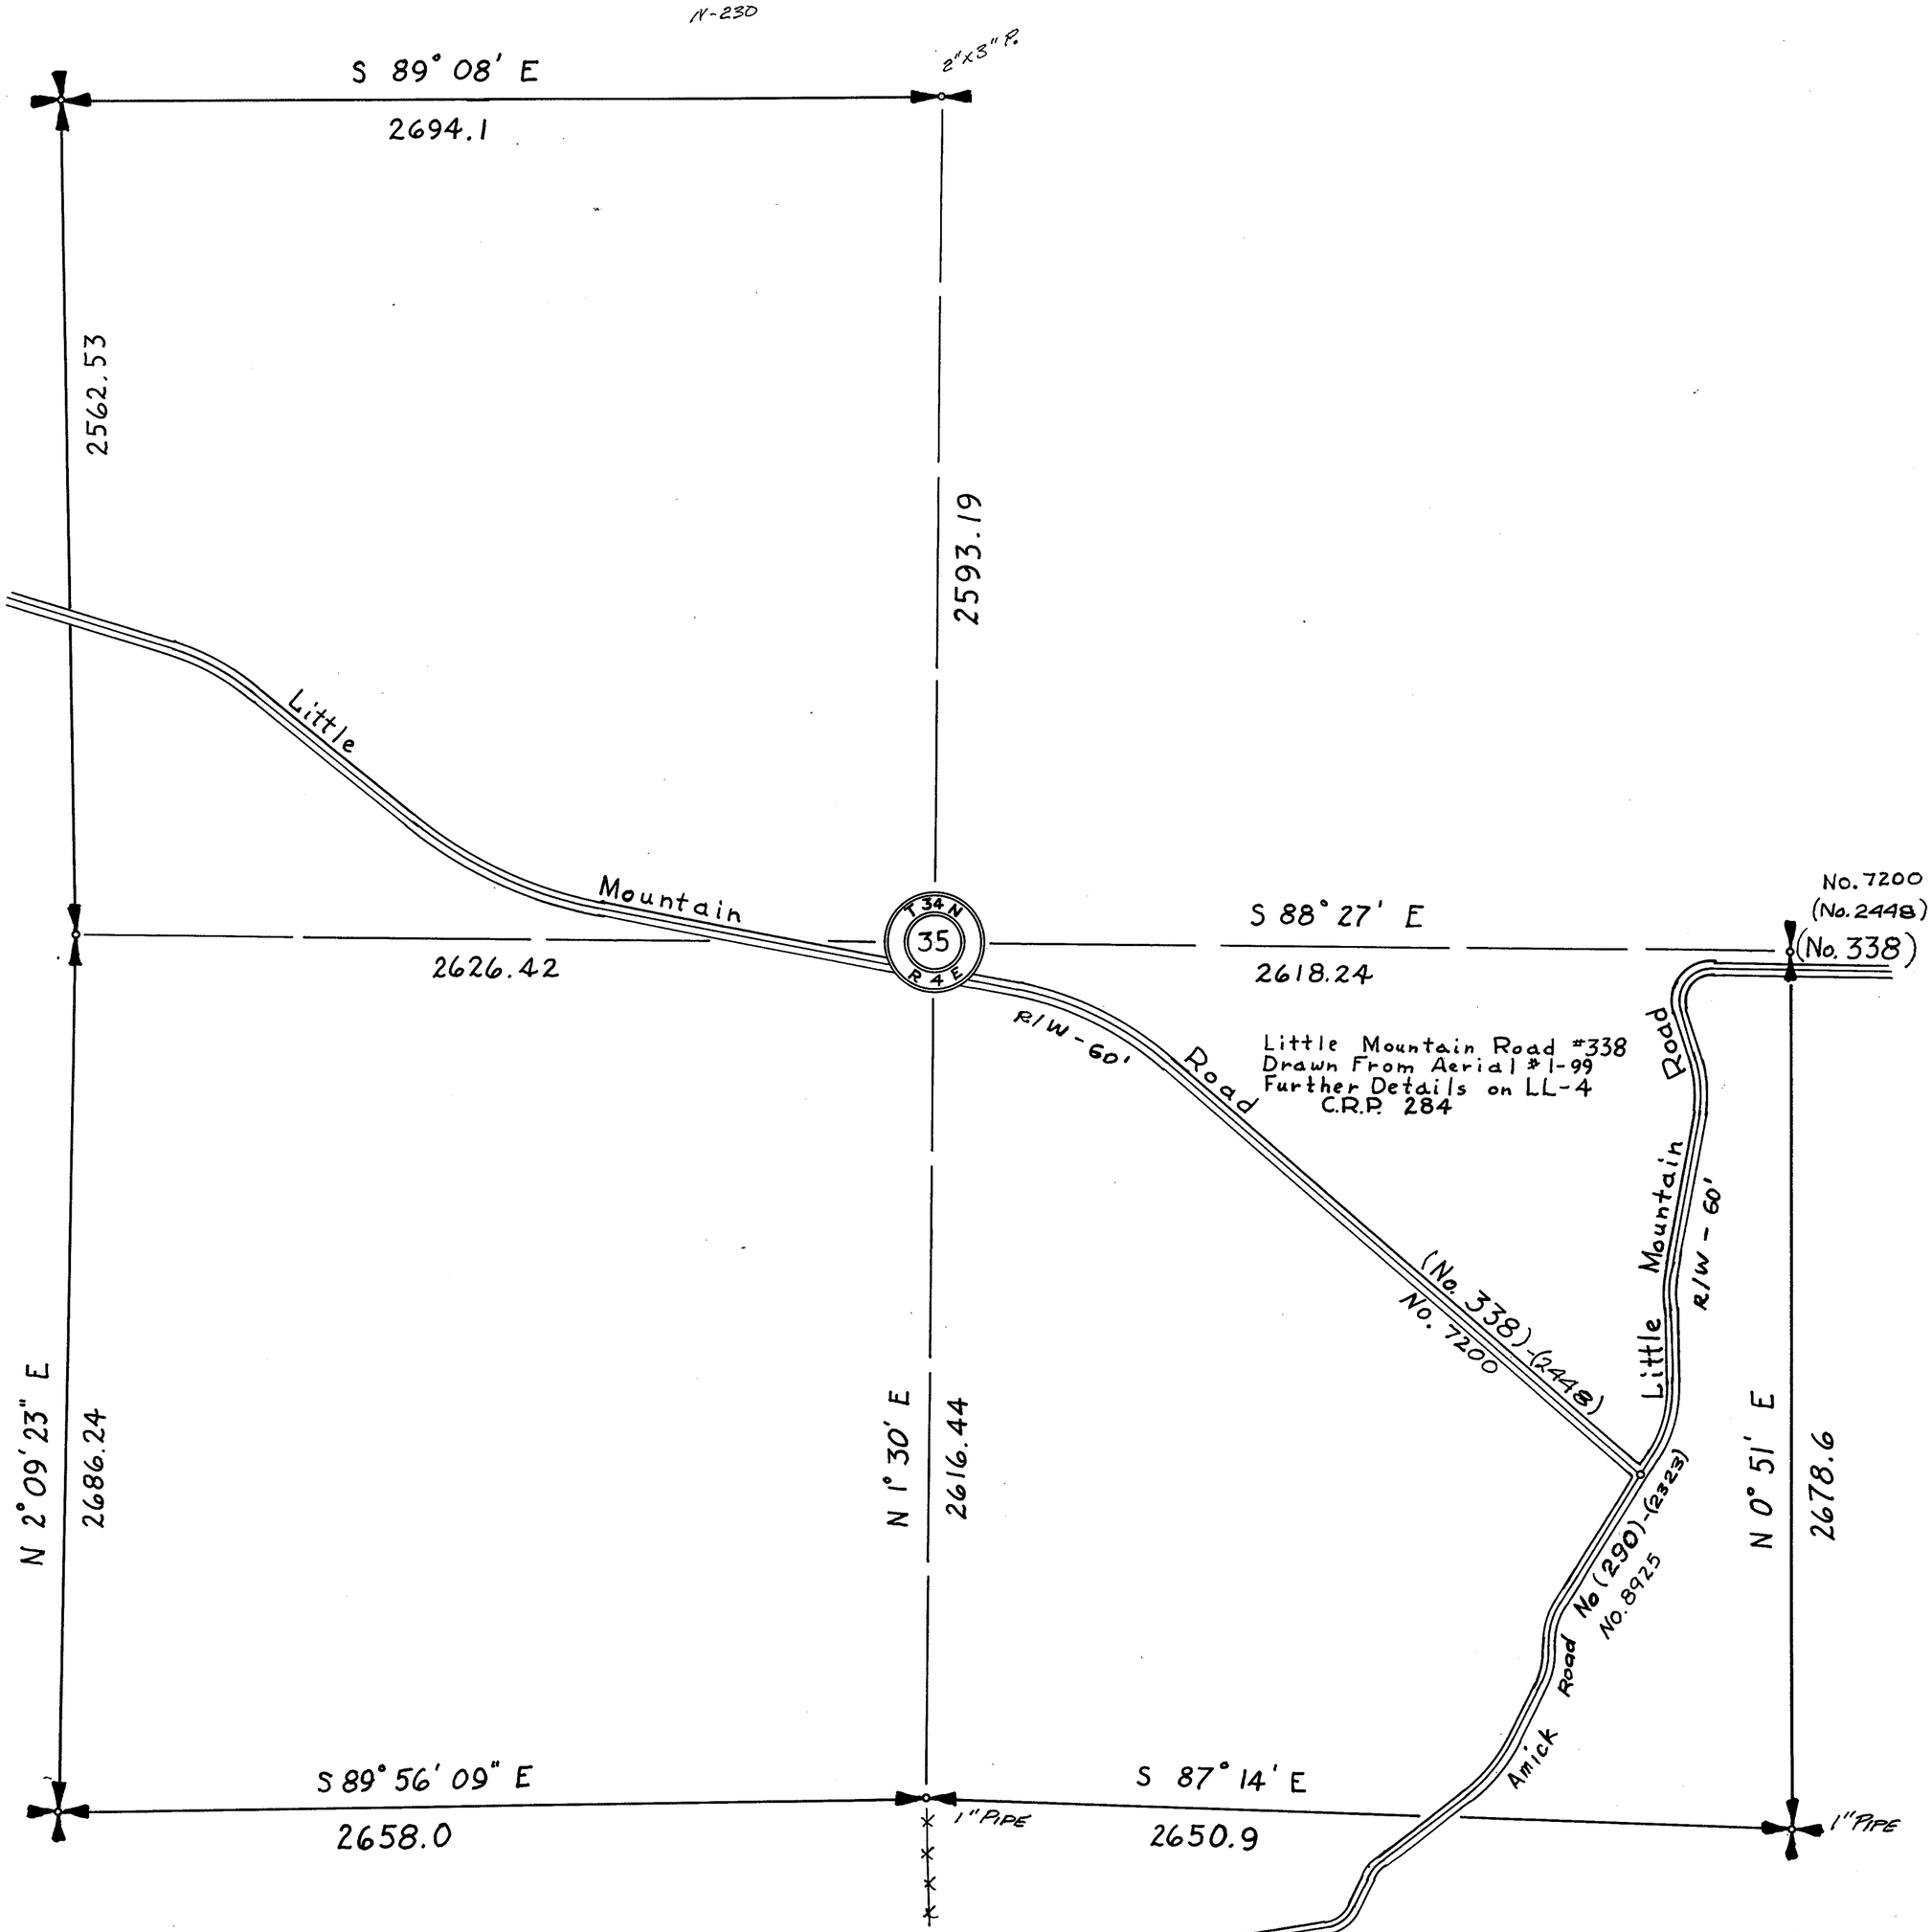

SECTION 36


TOWNSHIP 34 NORTH, RANGE 4 EAST, W. M.

SKAGIT COUNTY, WASH.

SCALE, 1 INCH--400 FEET

DATE June, 1959

Frank Gilkey COUNTY ENGINEER

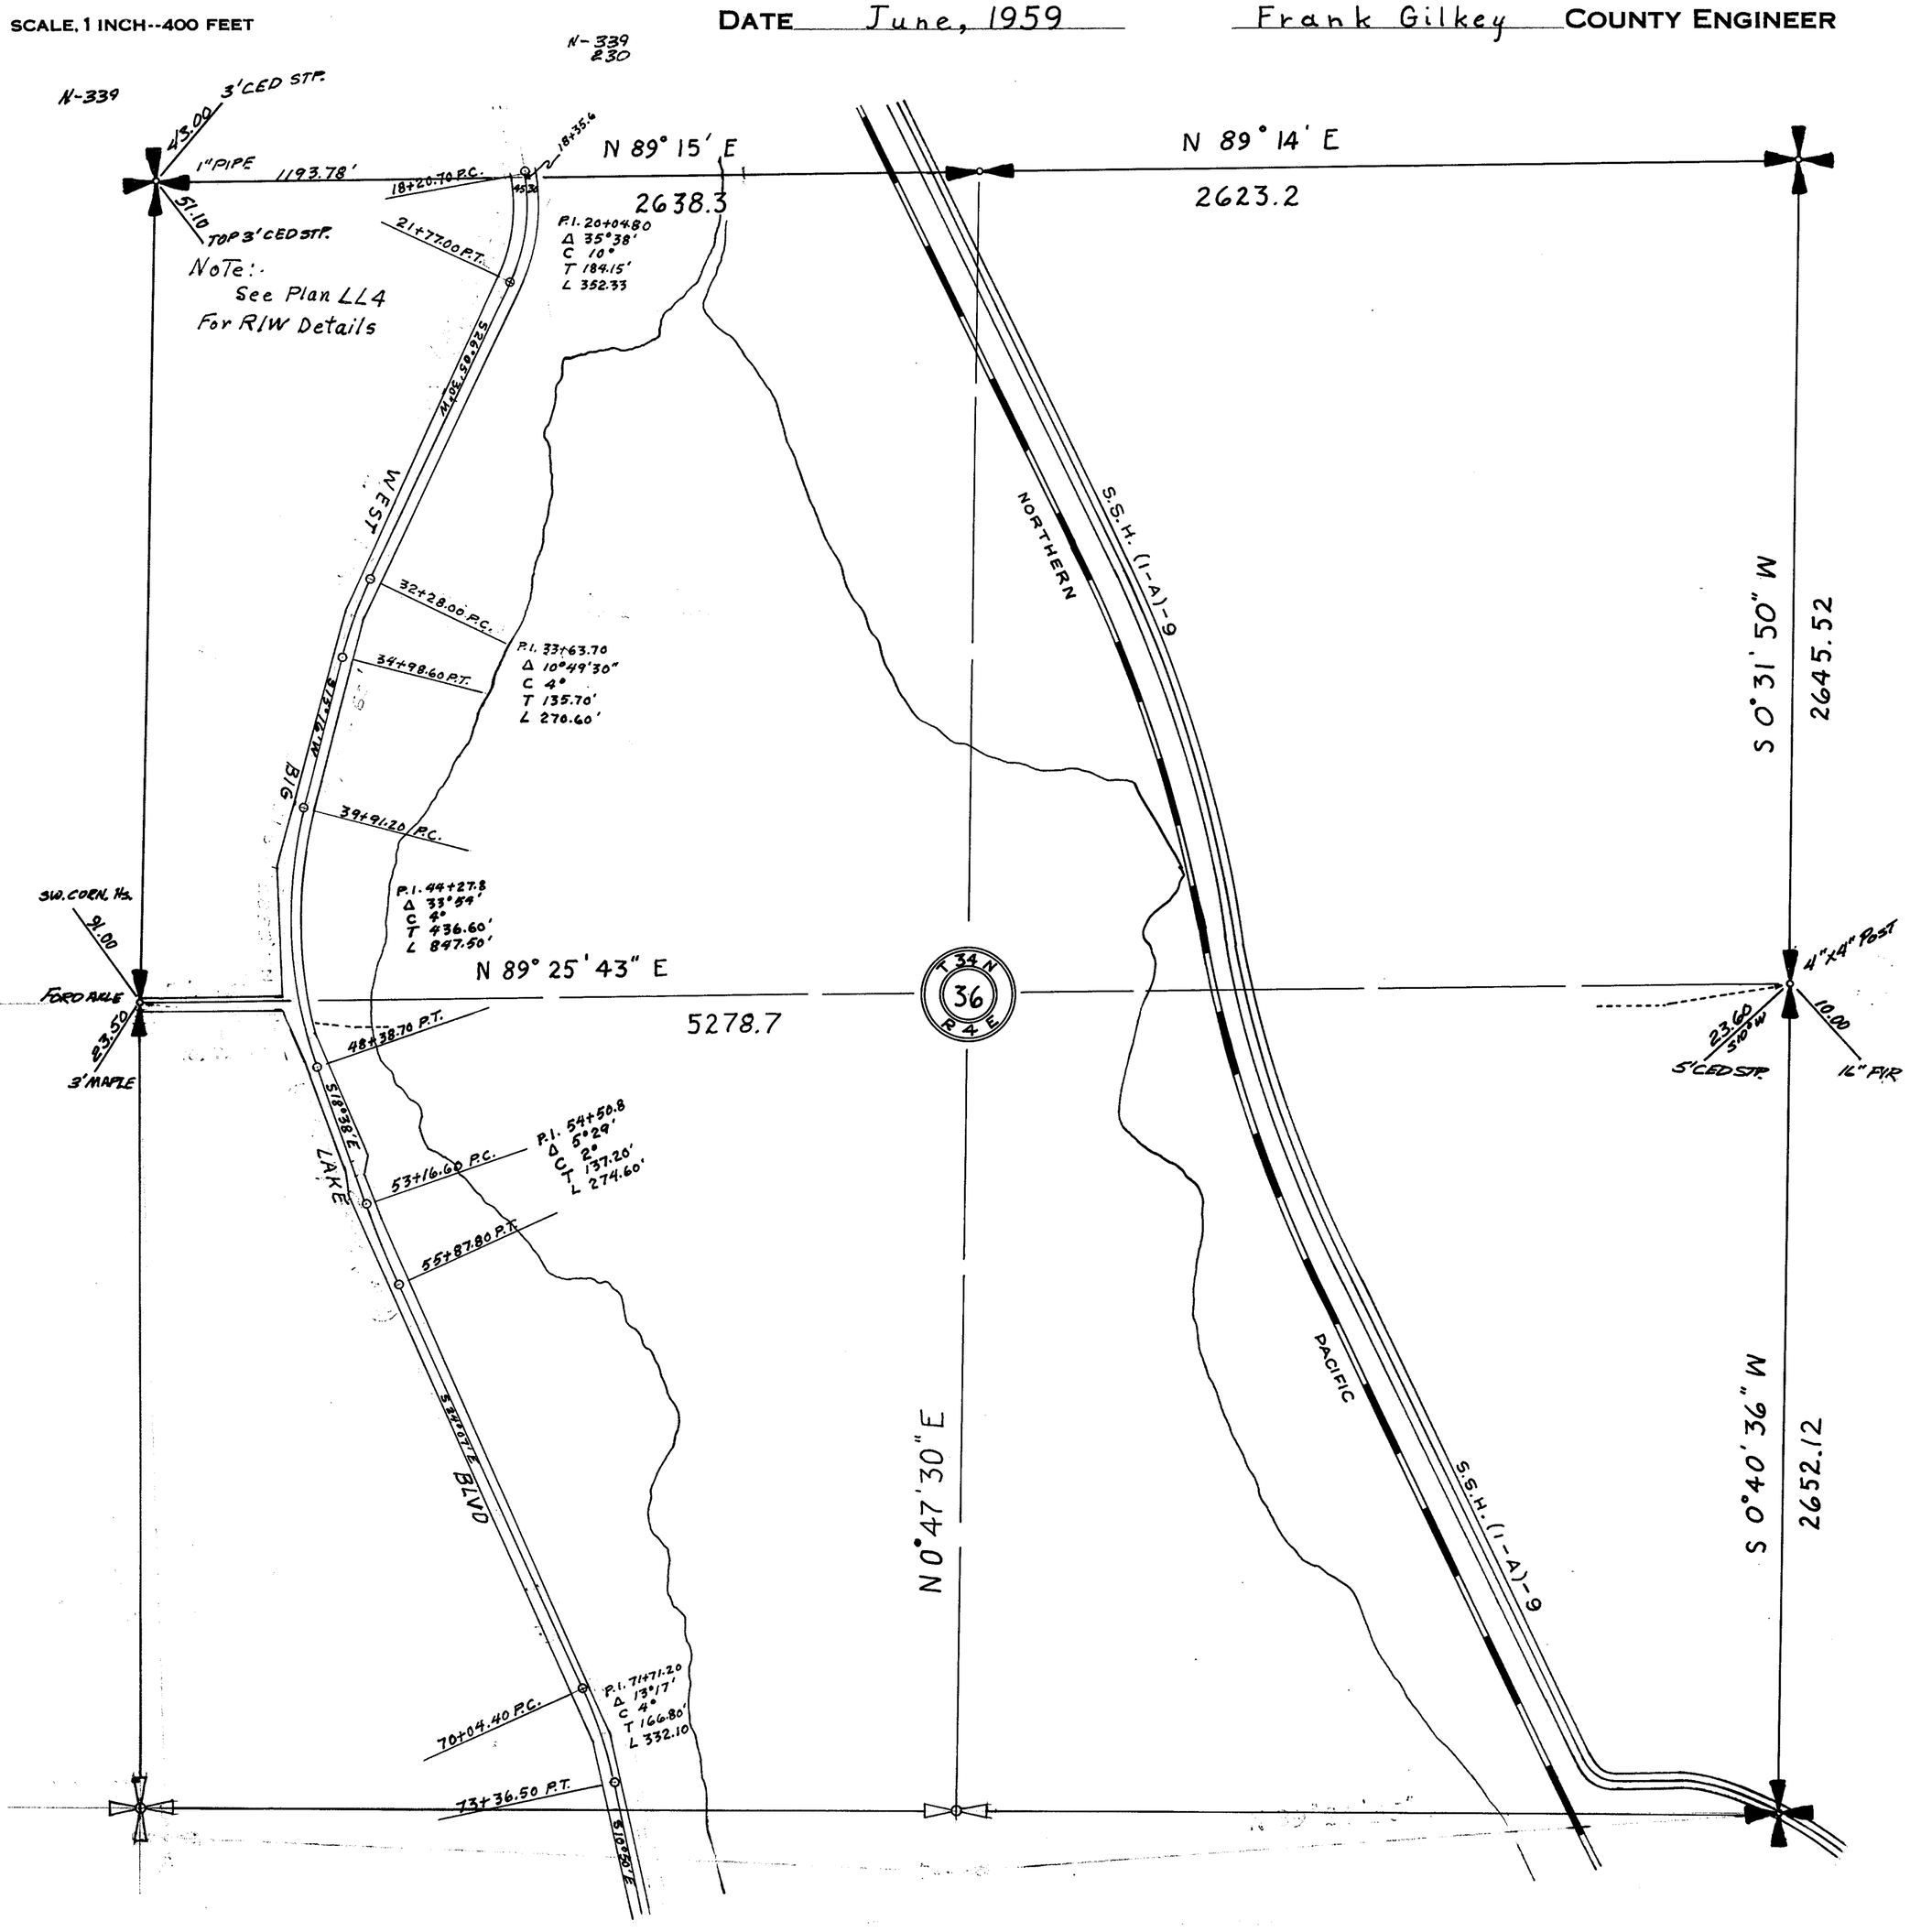

SECTION 4


TOWNSHIP 34 NORTH, RANGE 5 EAST, W. M.

SKAGIT COUNTY, WASH.

SCALE, 1 INCH–400 FEET

Ref. 18" D.Fir N15°E 9.0'
20" D.Fir N84½°E 13.0'


W.E. Castello COUNTY ENGINEER

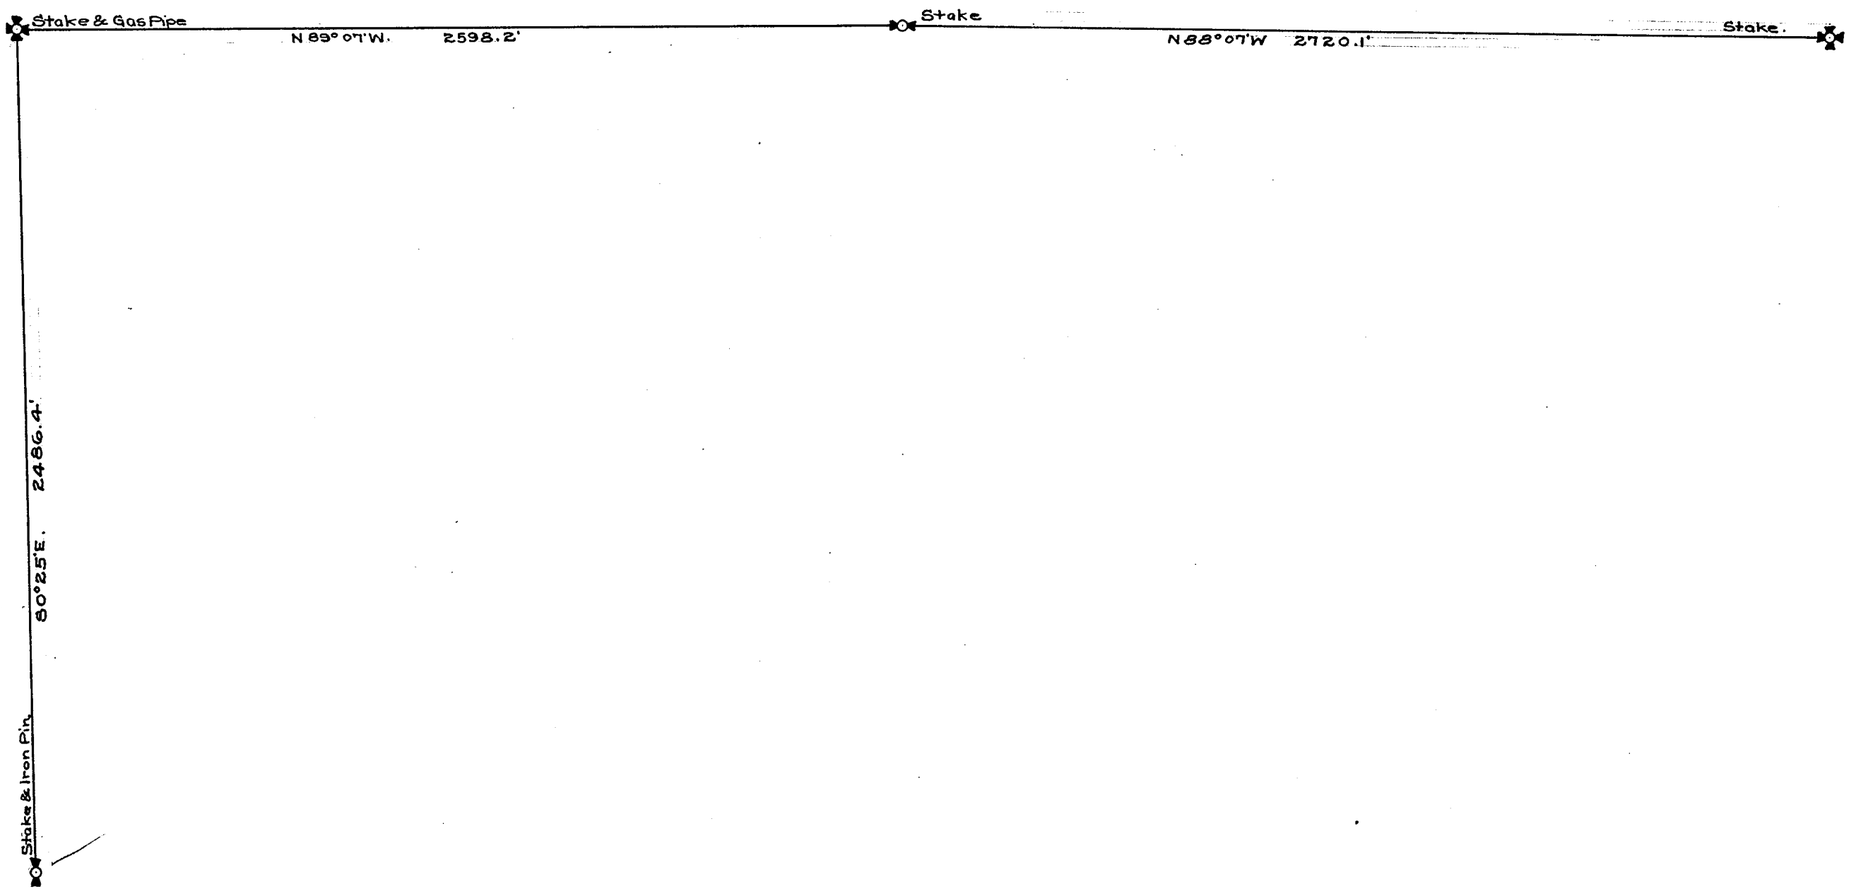

SECTION 4

TOWNSHIP 34 NORTH, RANGE 5 EAST, W. M.


SKAGIT COUNTY, WASH.

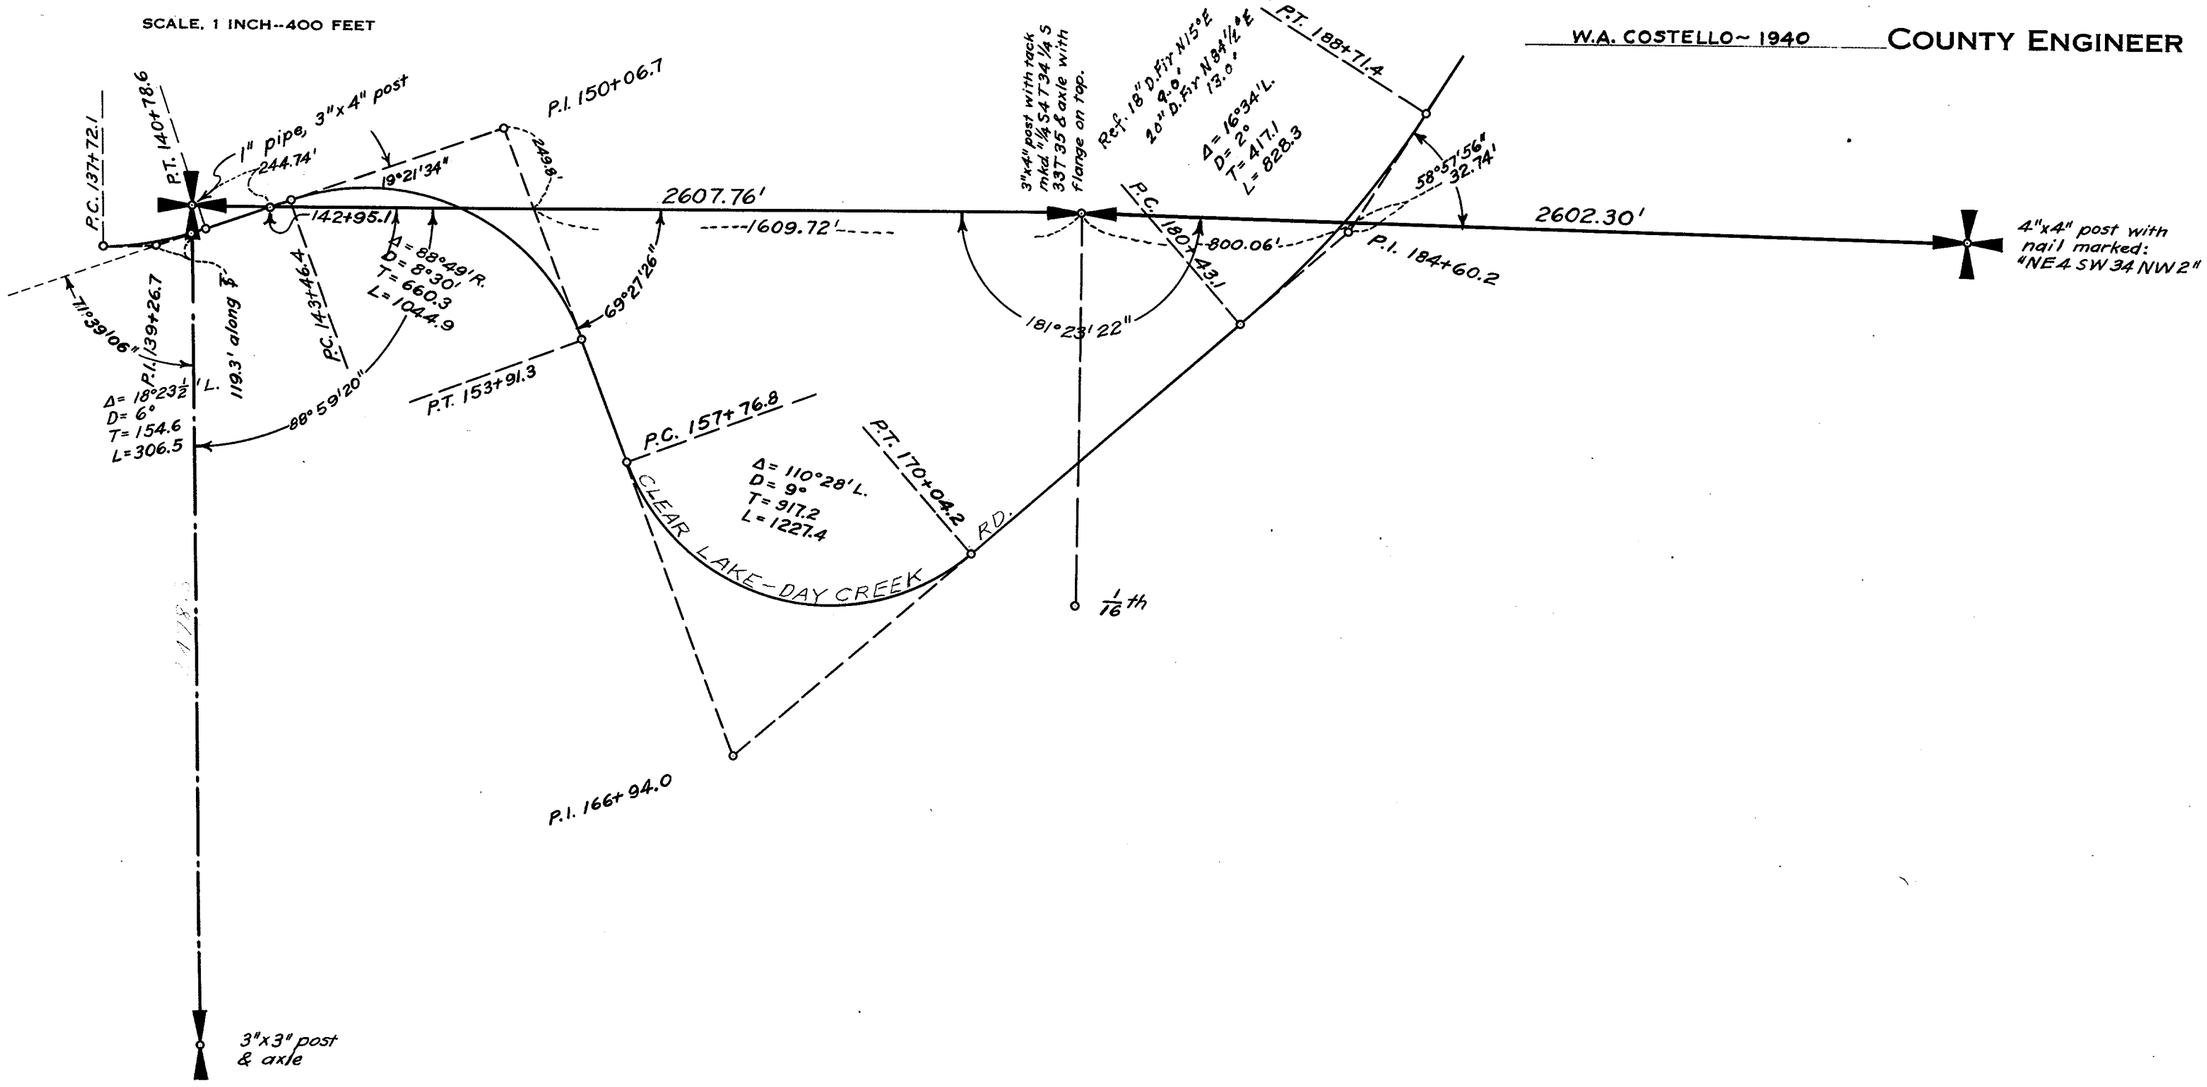

SECTION 5

TOWNSHIP 34 NORTH, RANGE 5 EAST, W. M.

SKAGIT COUNTY, WASH.

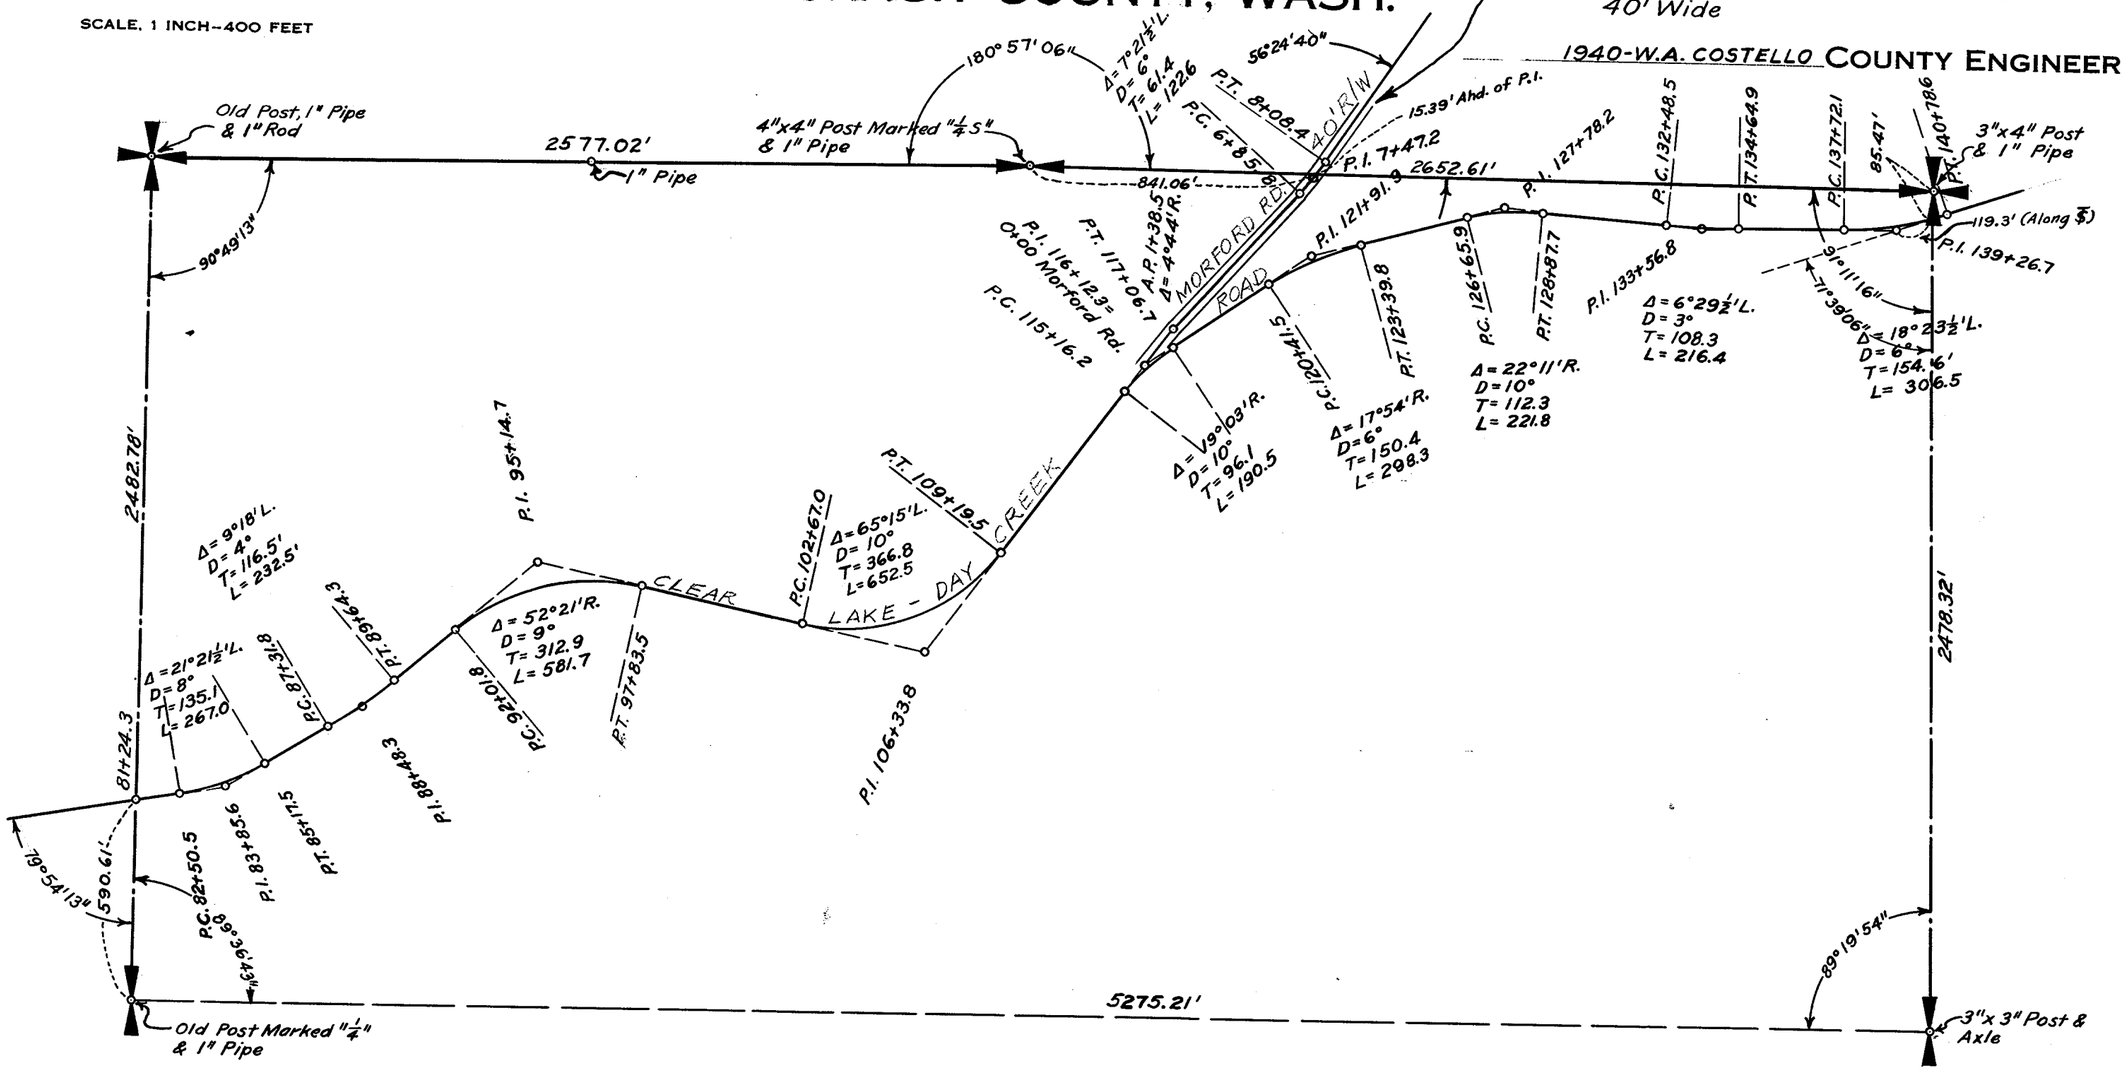


SECTION 5

TOWNSHIP 34 NORTH, RANGE 5 EAST, W. M.
SKAGIT COUNTY, WASH.

SCALE, 1 INCH–400 FEET

W.E. Costello COUNTY ENGINEER

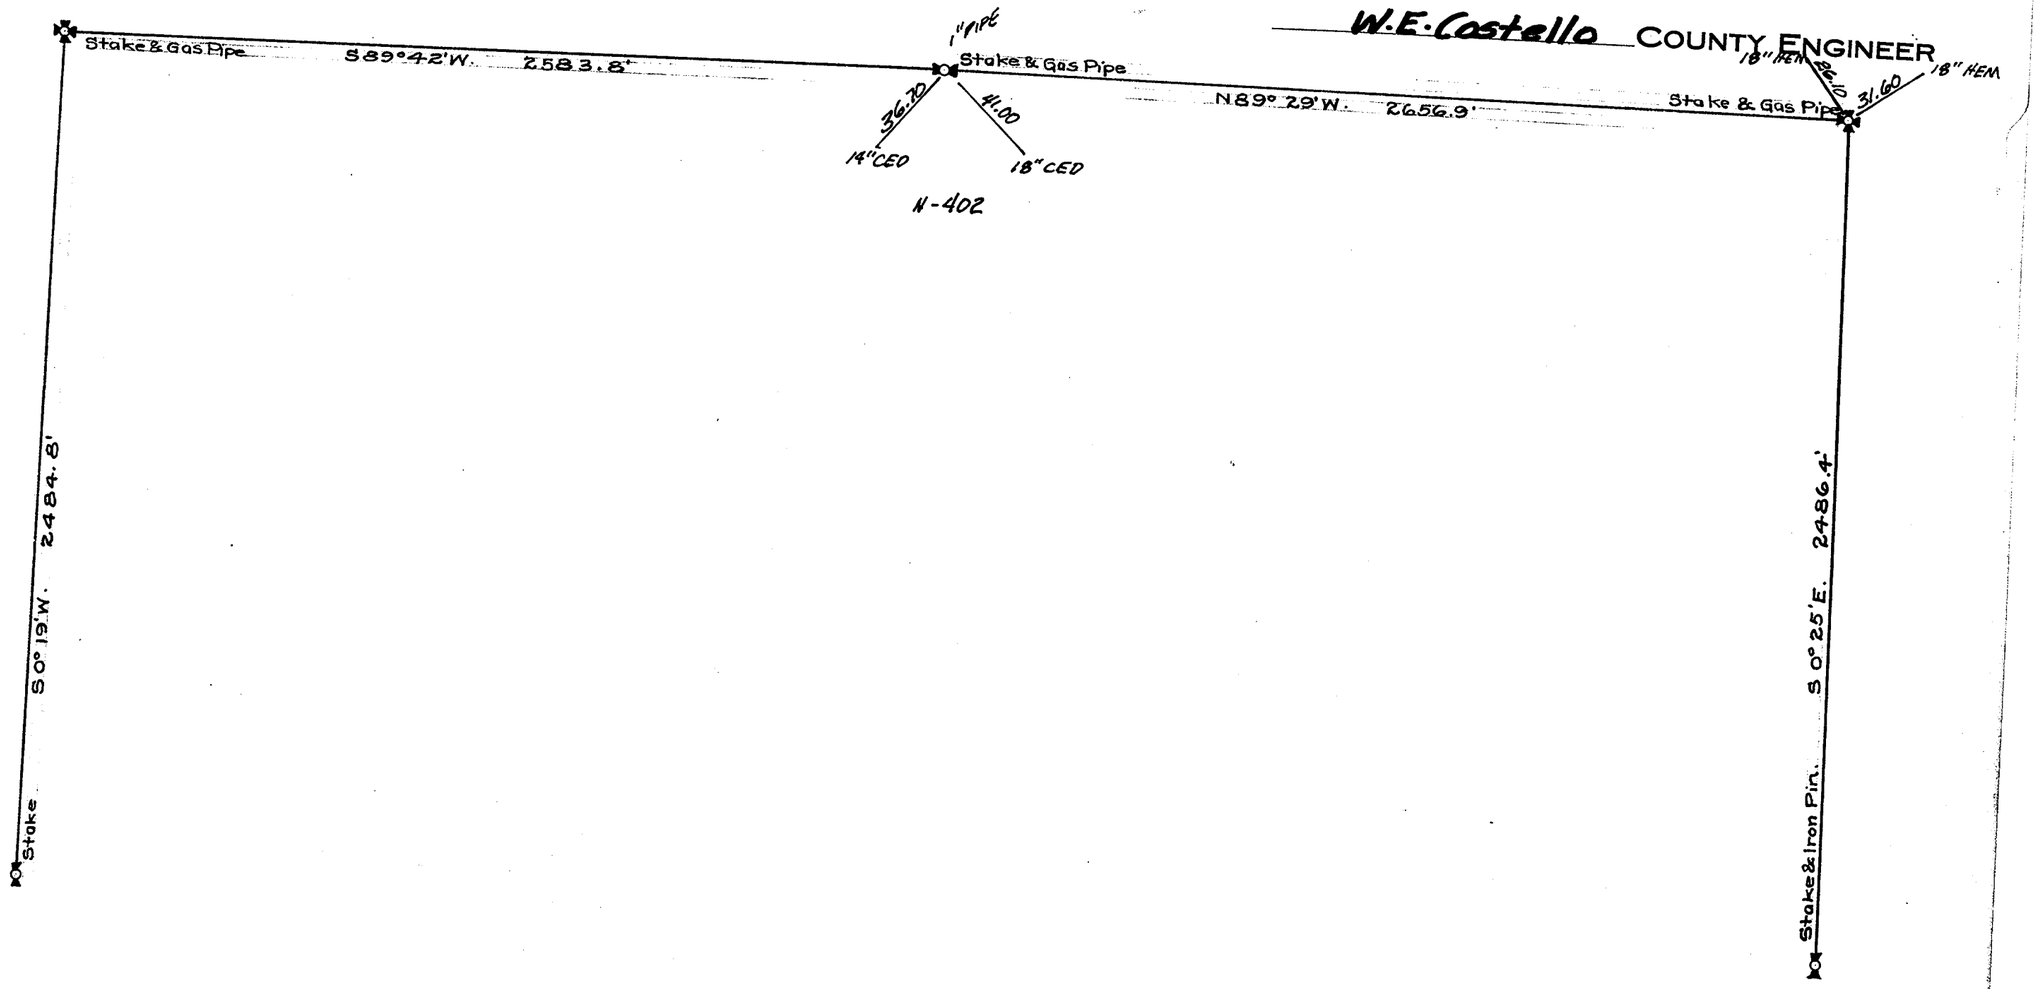

SECTION 5

TOWNSHIP 34 NORTH, RANGE 5 EAST, W. M.

SKAGIT COUNTY, WASH.

SCALE, 1 INCH--400 FEET

DATE July 26, 1966 Lloyd Johnson COUNTY ENGINEER



Note : This Tracing Drawn From
Aerial Photo – Not to Scale ....


SECTION 6

TOWNSHIP 34 NORTH, RANGE 5 EAST, W. M.
SKAGIT COUNTY, WASH.

SCALE, 1 INCH--400 FEET

W. A. COSTELLO
1940
COUNTY ENGINEER

Clear Lake-Day Cr. Notes - 33/402

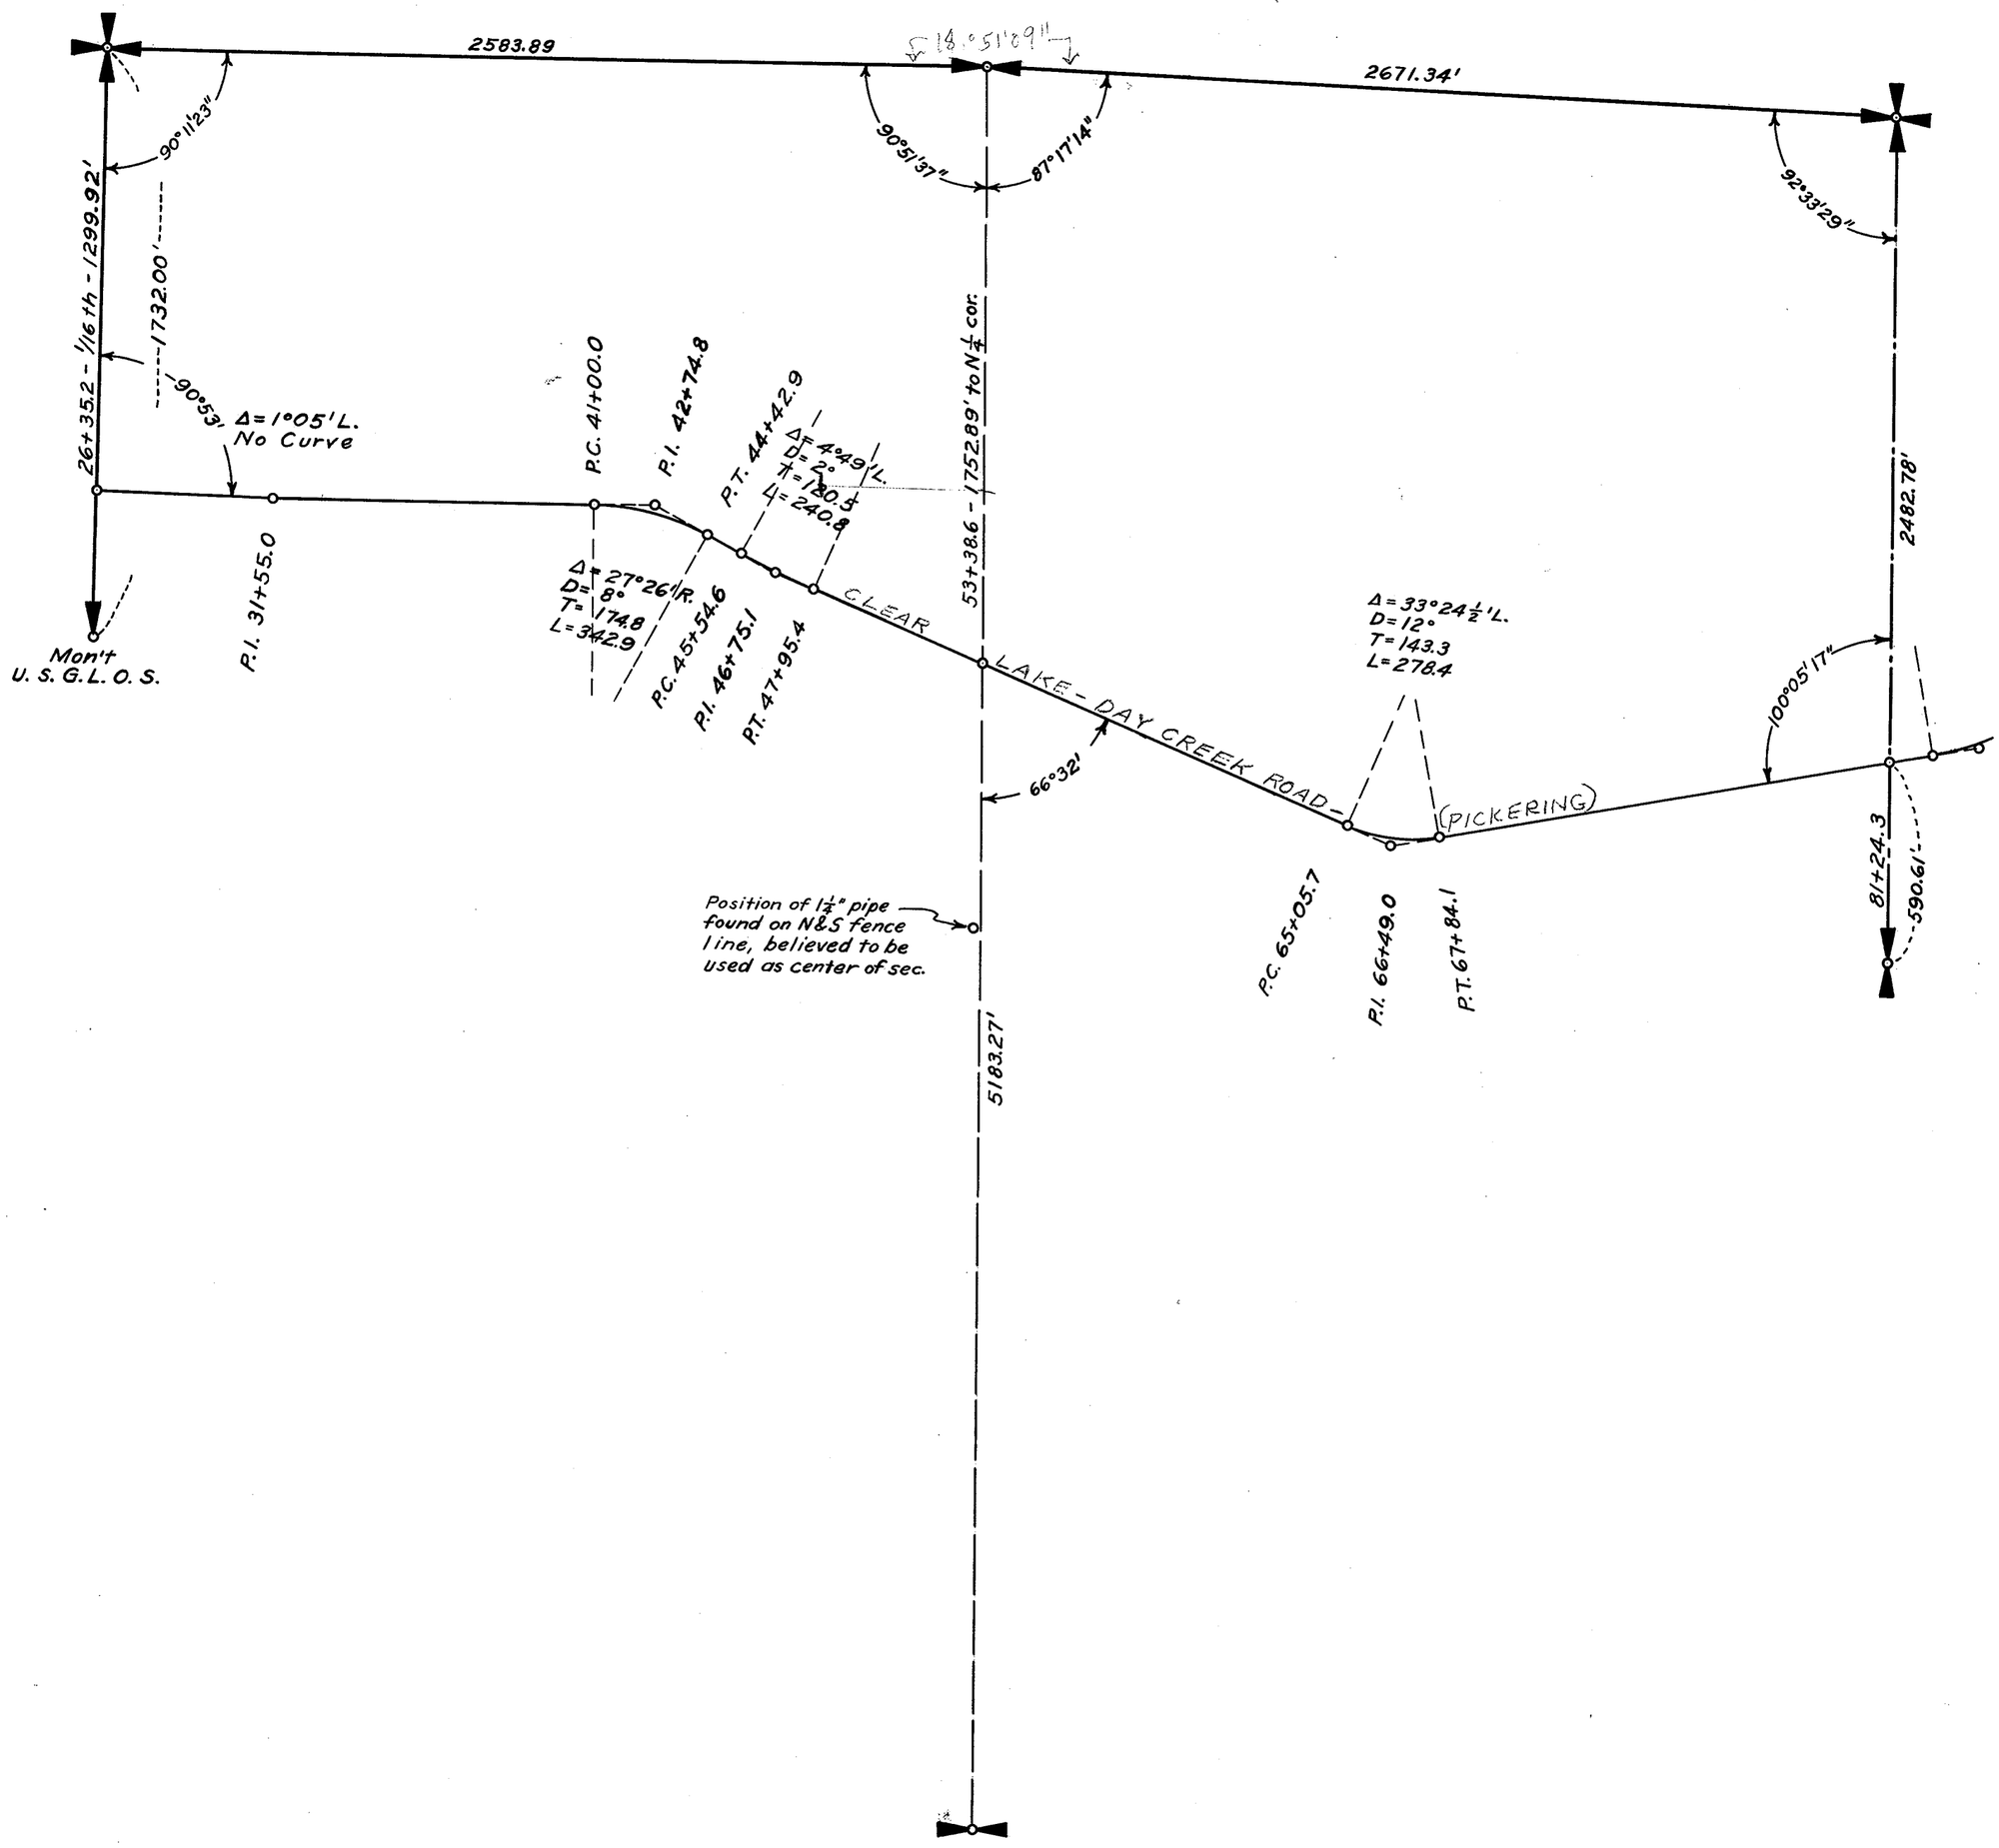


SECTION 6

TOWNSHIP 34 NORTH, RANGE 5 EAST, W. M.
SKAGIT COUNTY, WASH.

SCALE, 1 INCH--400 FEET

Traced from Co. Asses. Record.
Aug. 1940
Corrected to June 1949

_____ COUNTY ENGINEER

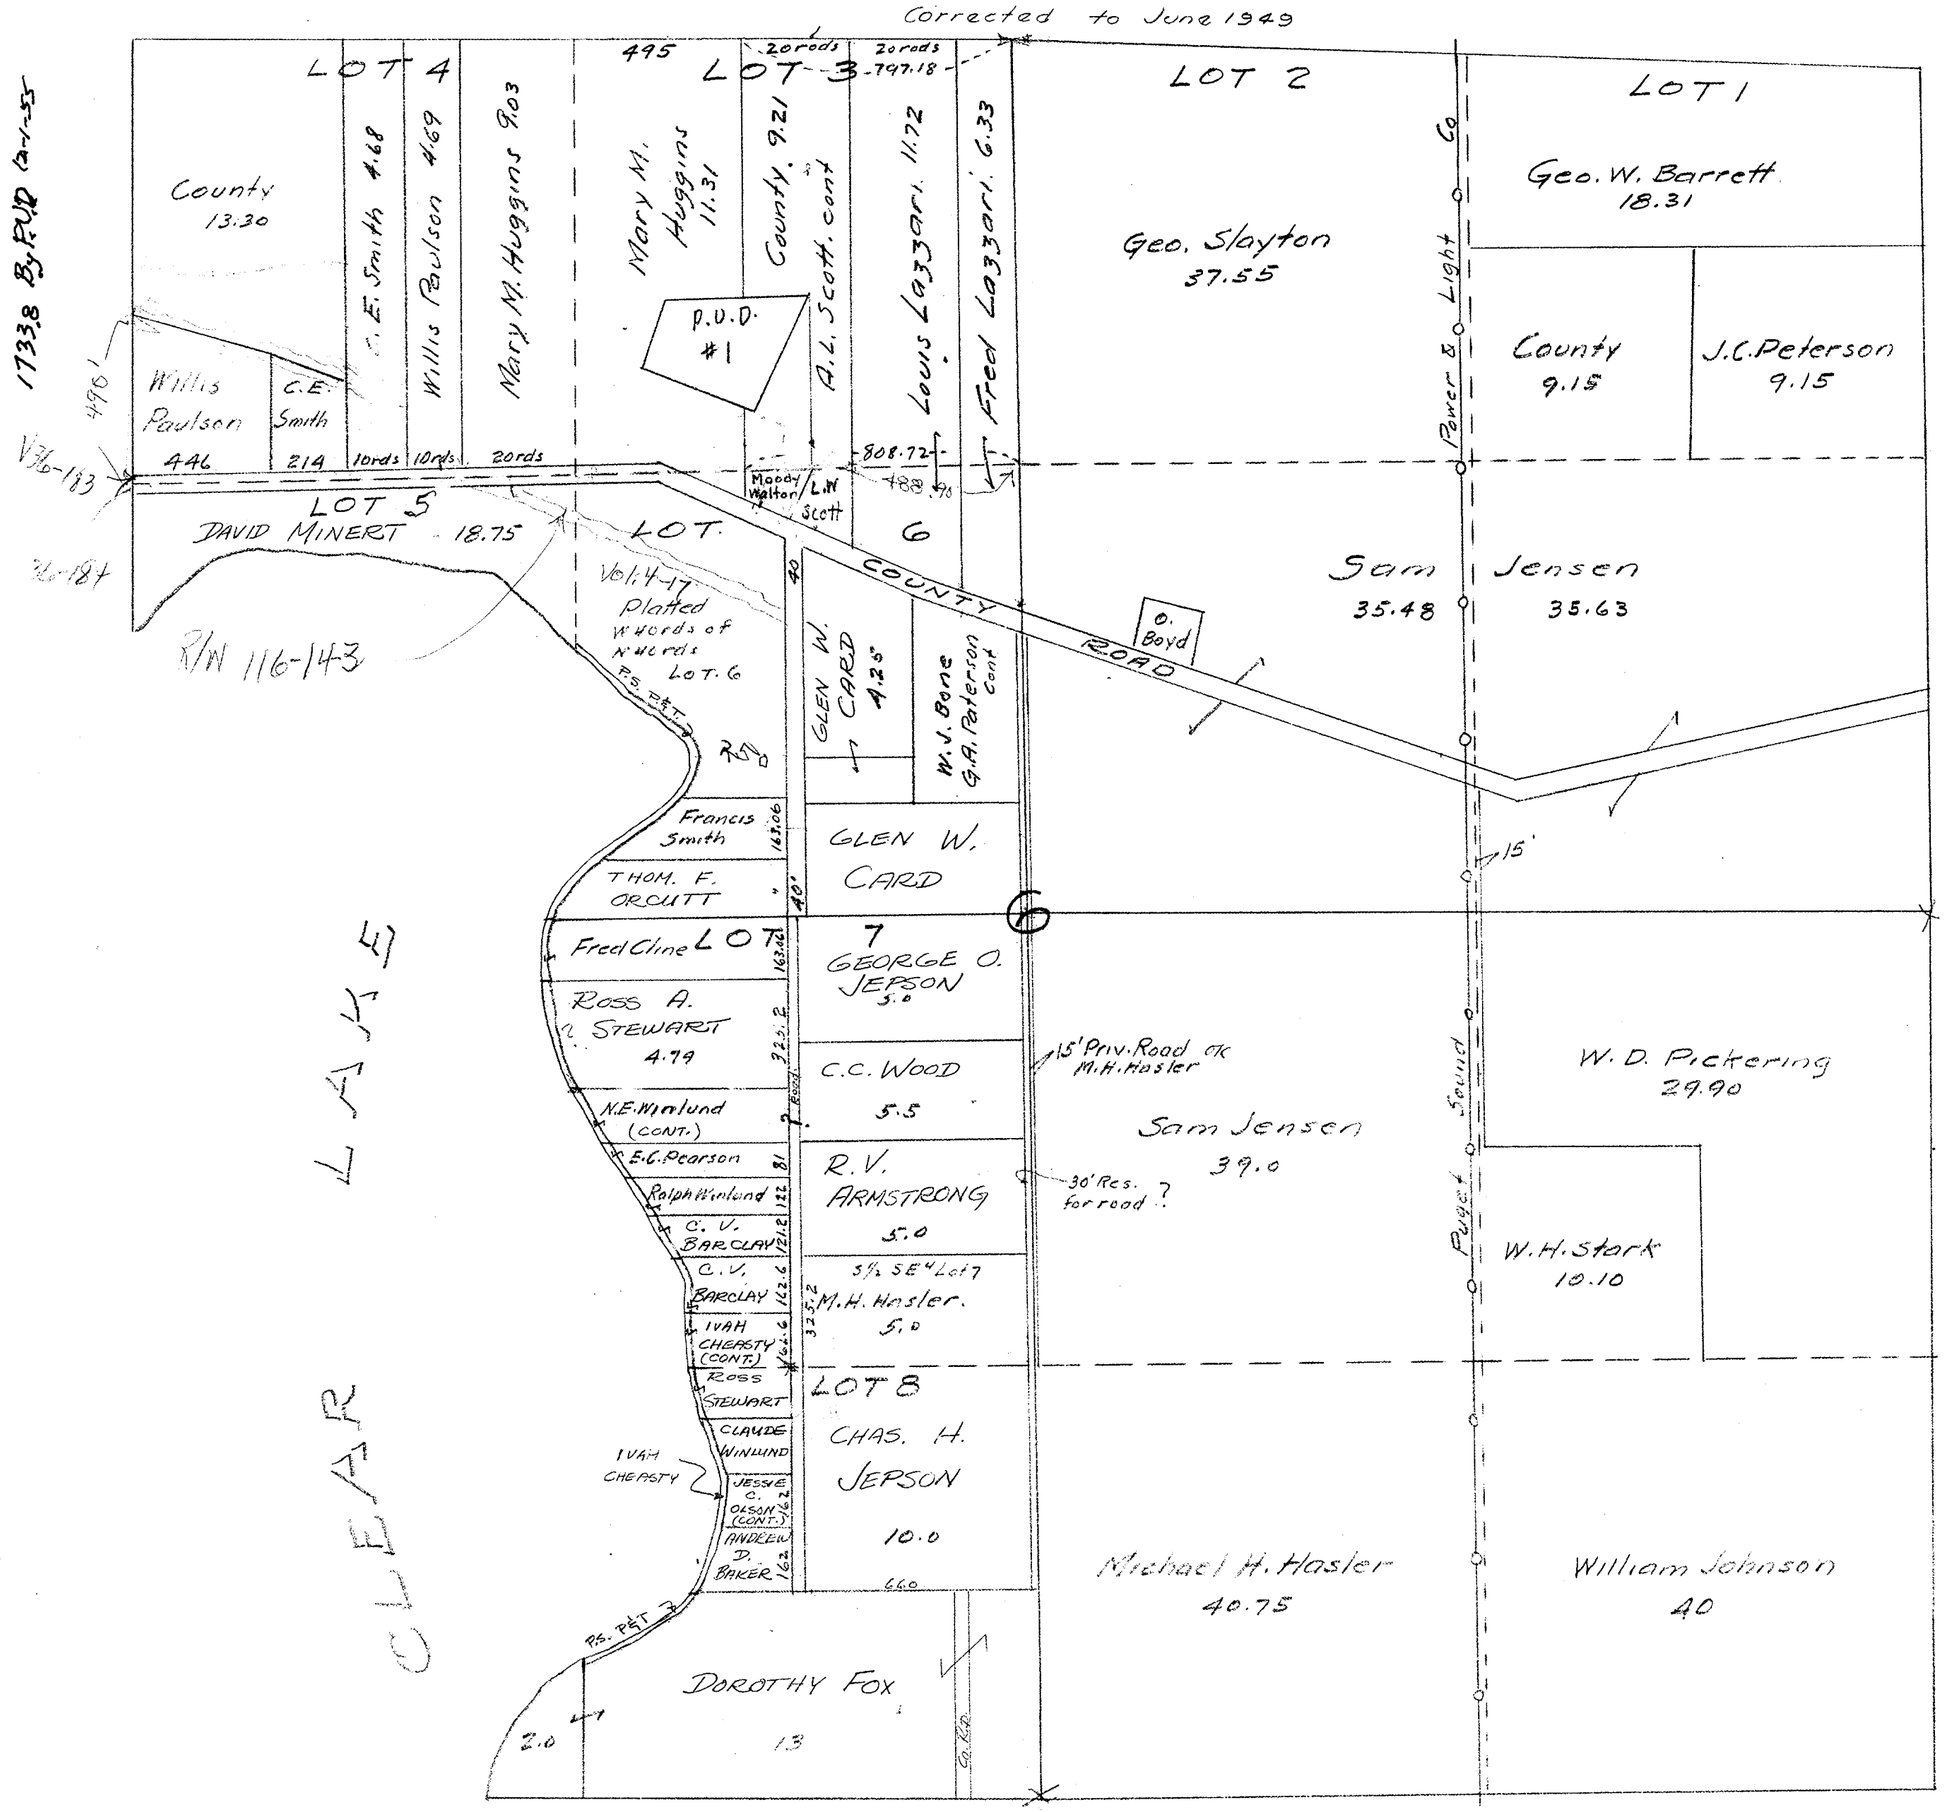


SECTION 6

TOWNSHIP 34 NORTH, RANGE 5 EAST, W. M.

SKAGIT COUNTY, WASH.

SCALE, 1 INCH--400 FEET

DATE July 26, 1966 Lloyd Johnson COUNTY ENGINEER

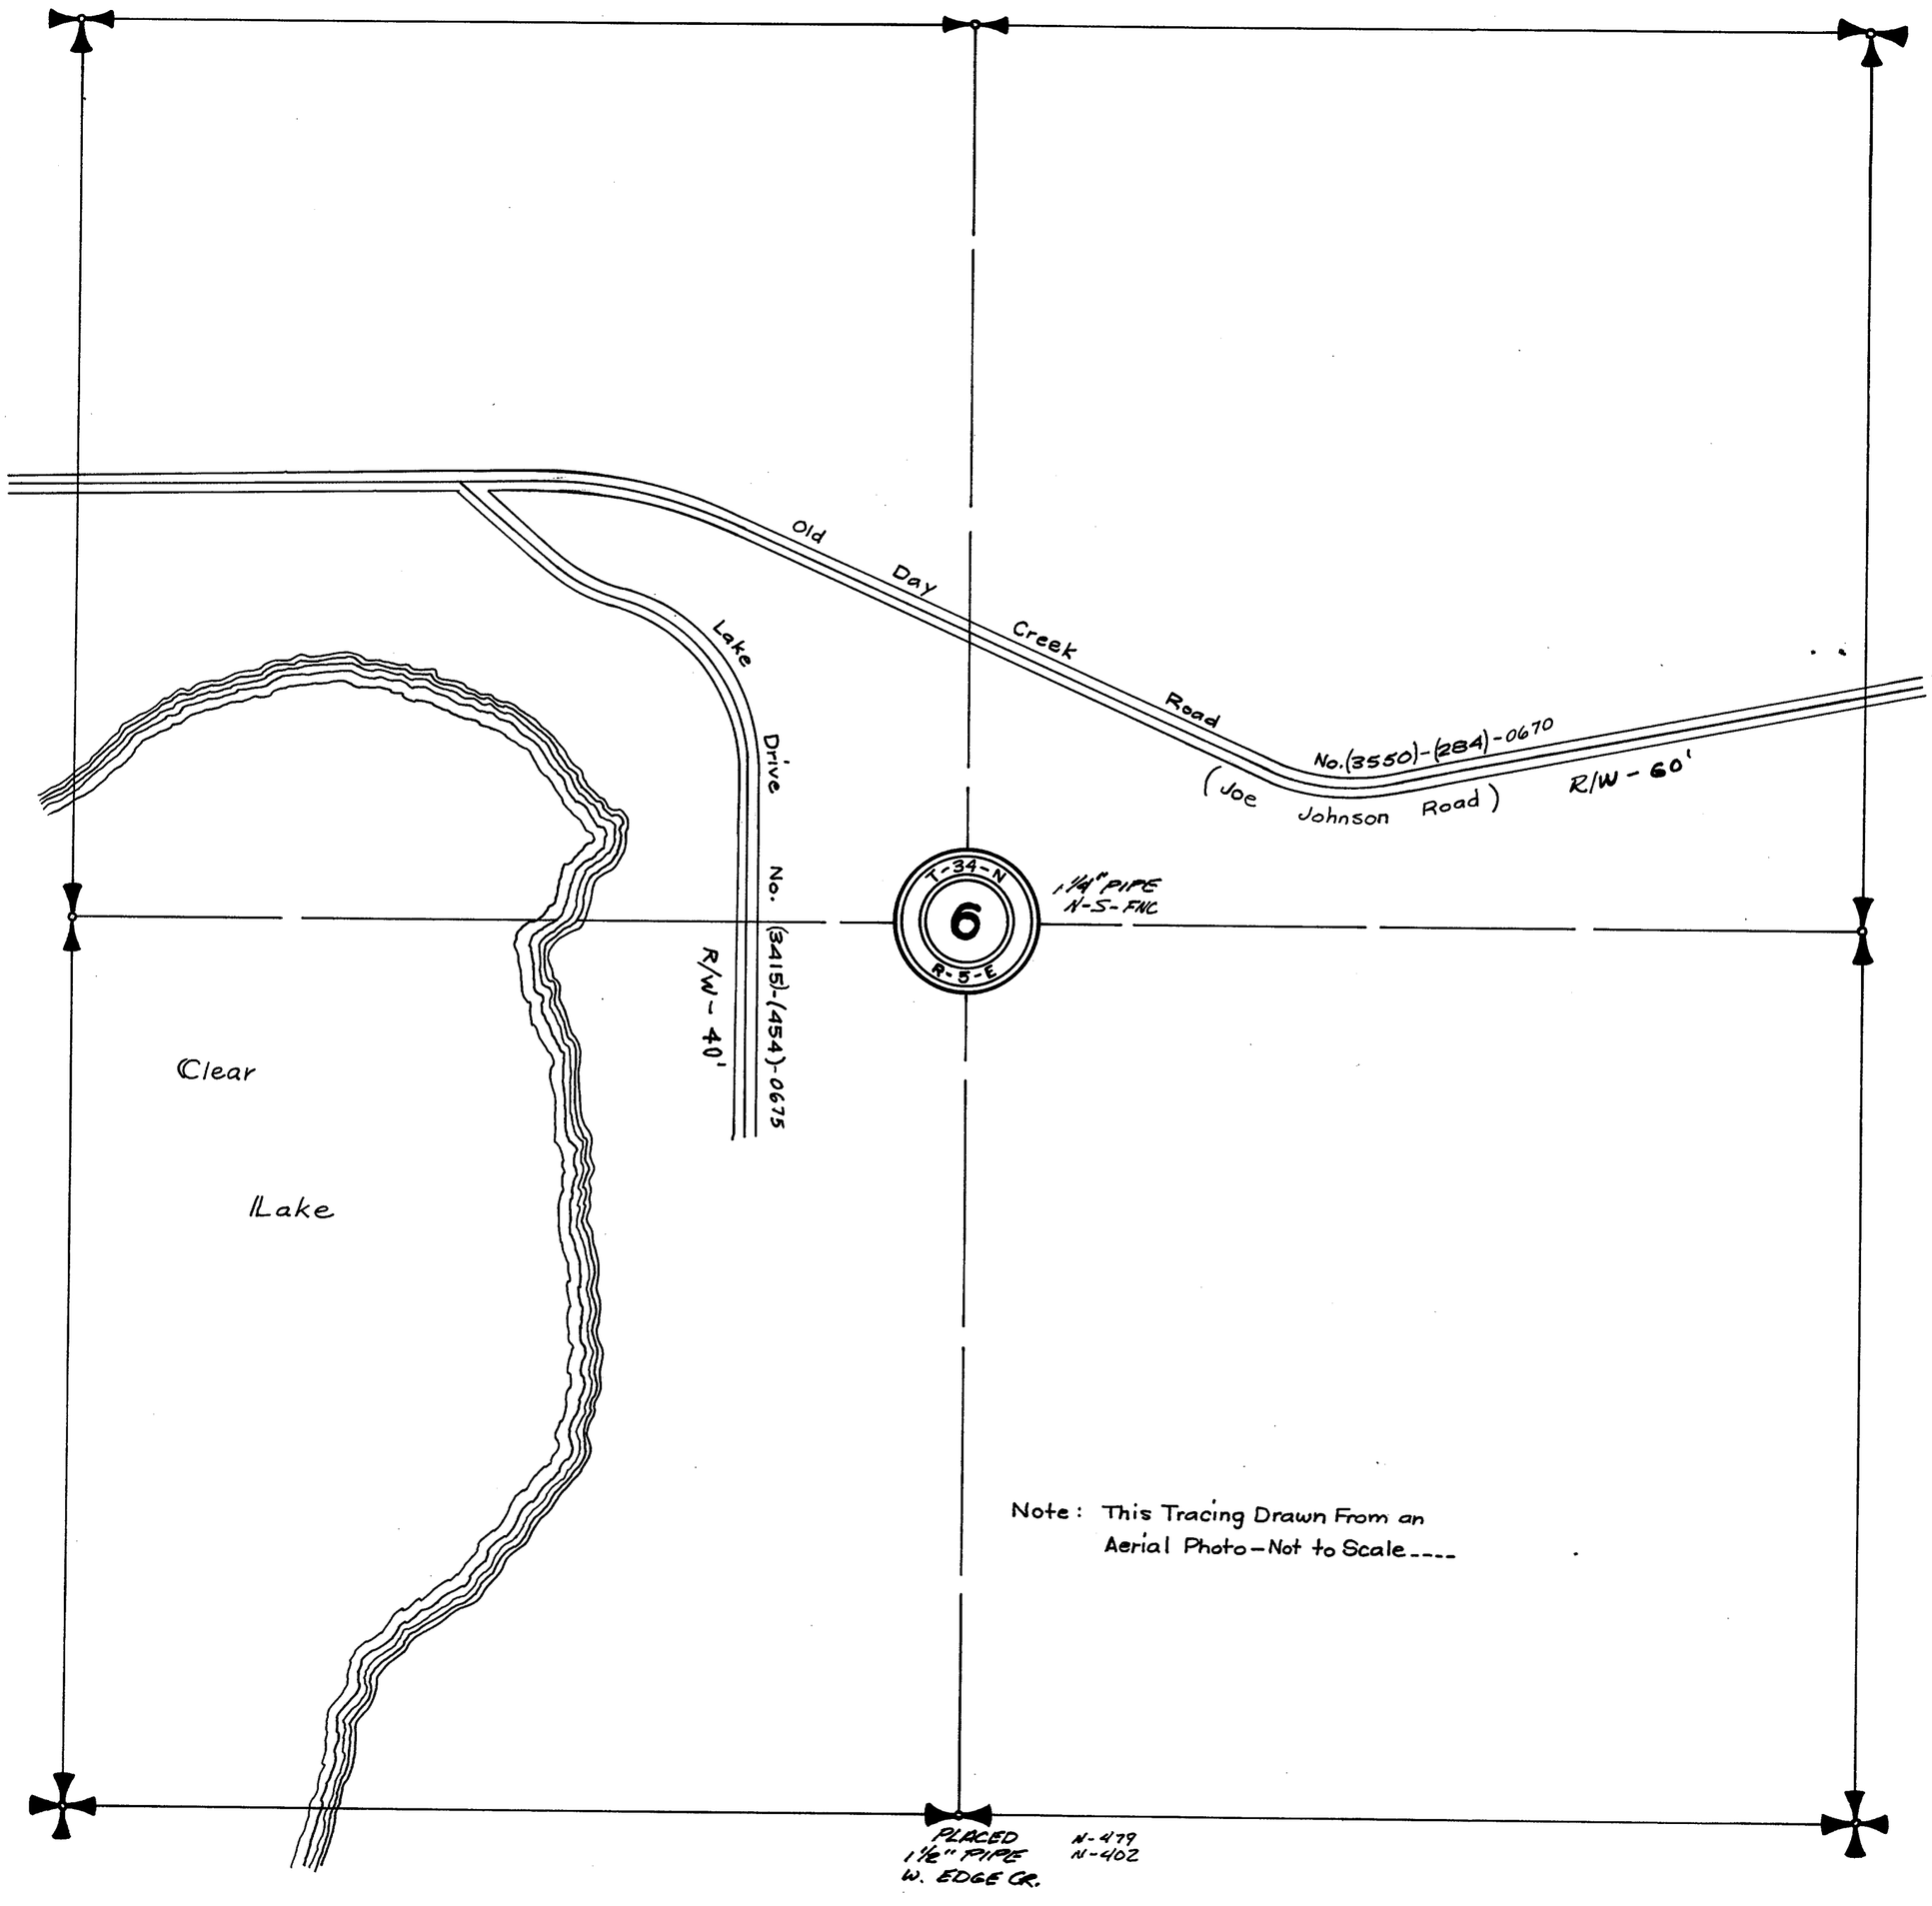

SECTION 7


TOWNSHIP 34 NORTH, RANGE 5 EAST, W. M.

SKAGIT COUNTY, WASH.

SCALE, 1 INCH--400 FEET

DATE September, 1959

Frank Gilkey COUNTY ENGINEER

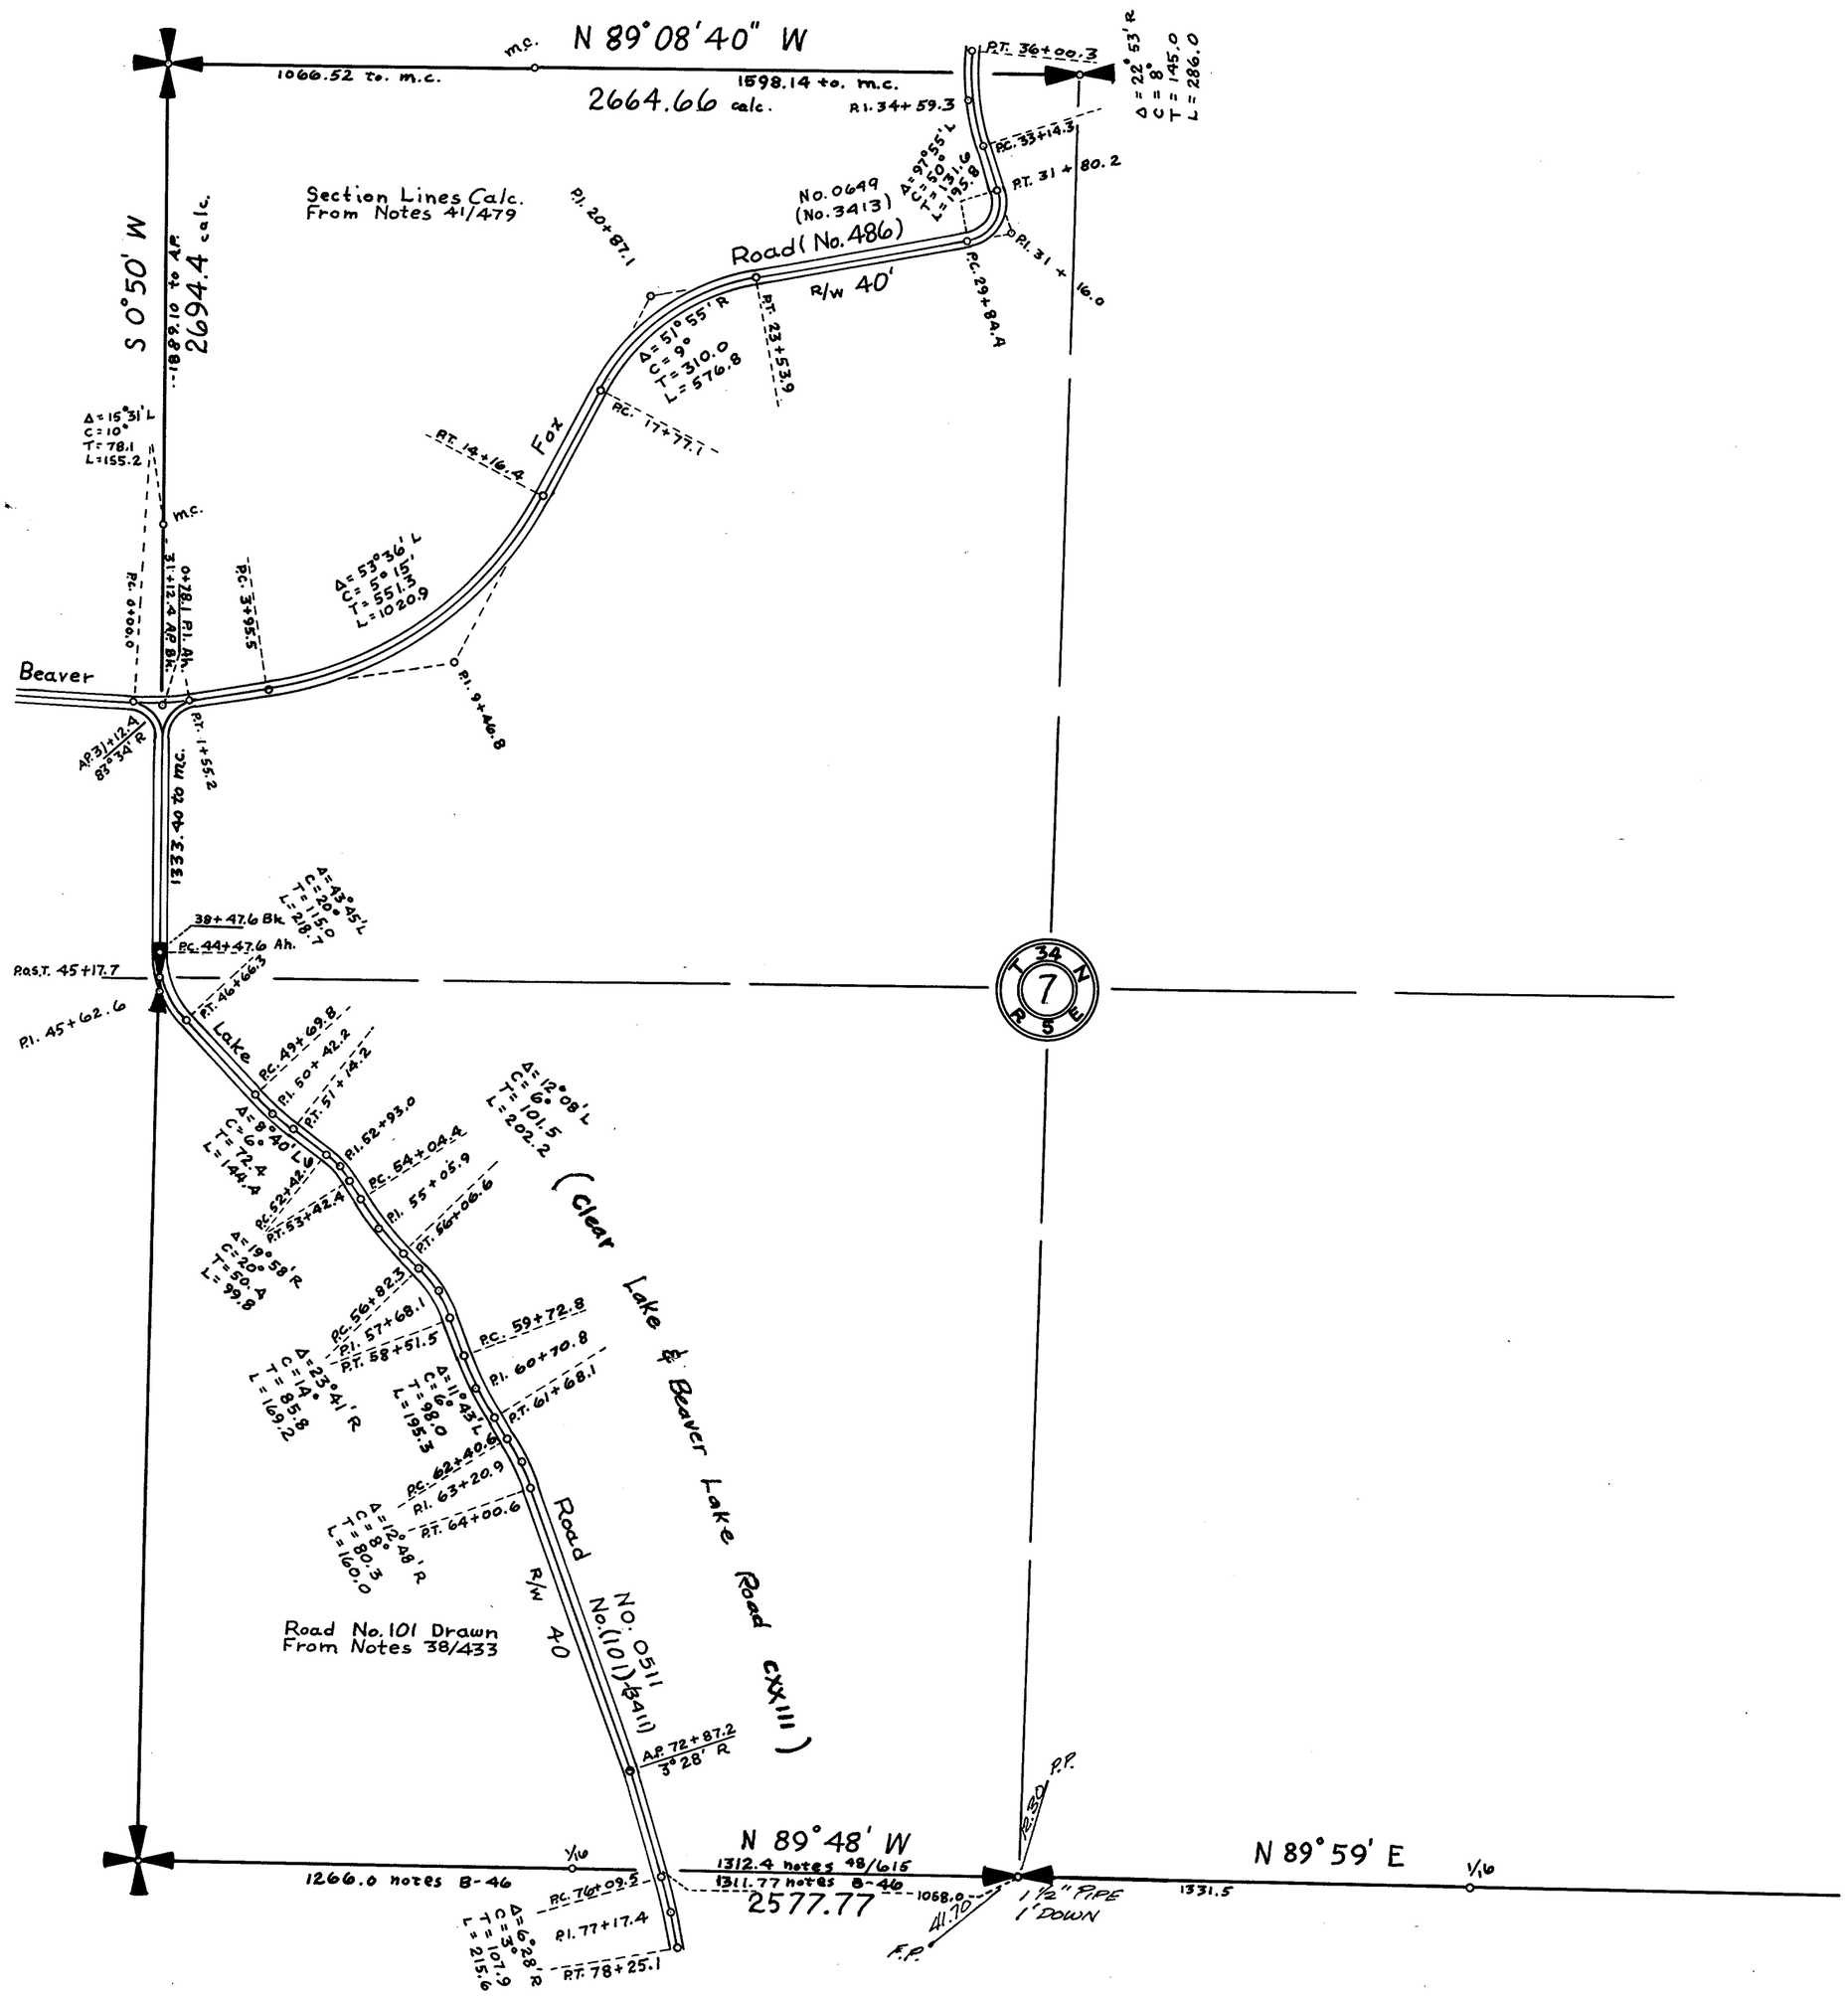



TOWNSHIP 34 NORTH, RANGE 5 EAST, W. M.

SKAGIT COUNTY, WASH.

SCALE, 1 INCH--400 FEET

DATE September, 1959 Frank Gilkey COUNTY ENGINEER

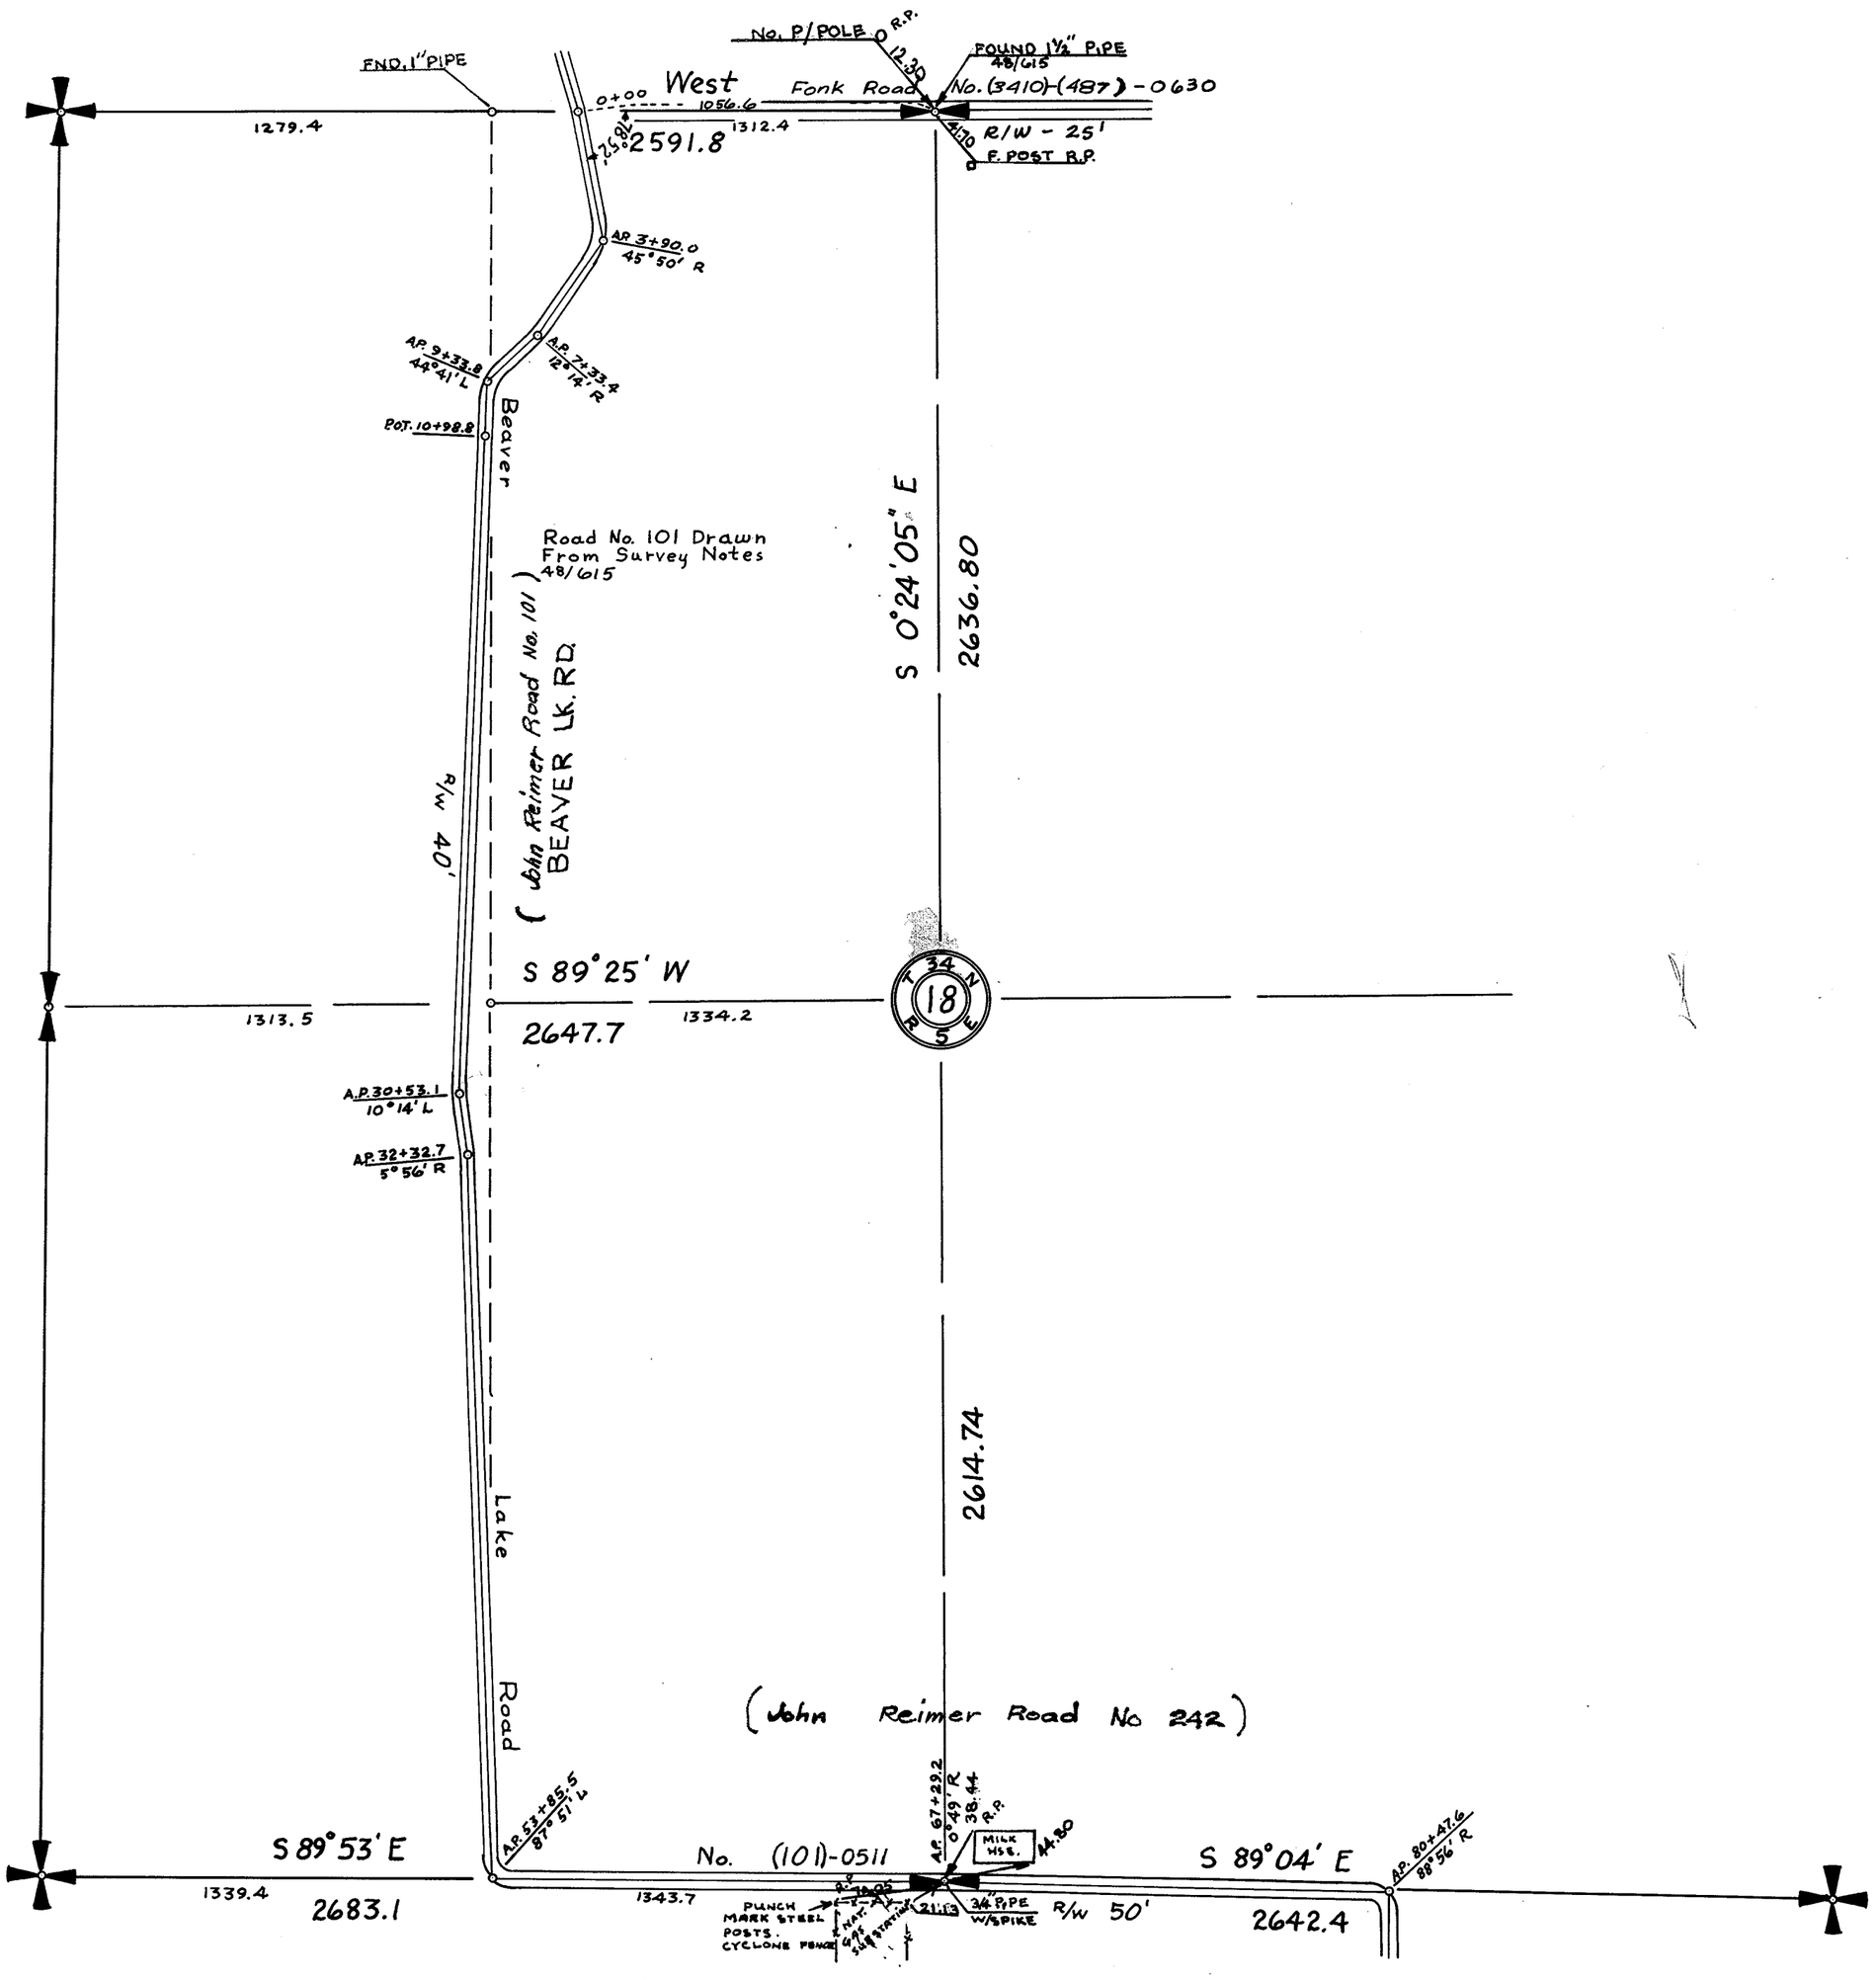

Notes-48/615

SECTION 18

TOWNSHIP 34 NORTH, RANGE 5 EAST, W. M.

SKAGIT COUNTY, WASH.

SCALE, 1 INCH–400 FEET

A.L. STRONG COUNTY ENGINEER

N 10 880
E 868760

N 10080
E 10000

Stake.

Gas pipe

Gas pipe 1/2" R

12792

13124

89°30'

91°36' Cal.

89°08'

90°52'

89°37' Cal.

26286 Cal.

26626

26626.38

26396 Cal.

No. 101

Notes for Sub-Div.
see Field Book
No 60, and County
Road No 101

S 89°41'17" W

S 0°24'05" E

N 7363.20
E 10018.51

90°05' Cal.

88°36' Cal.

90°40'

89°20'

90°11' Cal.

89°49' Cal.

89°49' Cal.

90°11' Cal.

13135

13342

Cal. 91°02'

S 89°25' W

N 7349.16
E 8684.73

Beaver Lake Road

(DENMAN ROAD No 242)

Beaver Lake Road #101

3598.30

2640±

N 0°15'19" E

S 0°11'38" E

26396 Cal.

26144.74

N 7448.60
E 10036.80

A14
S 89° 12' 03" E 26.39.5

A14
N 89° 48' 54" E

91°03'

90°03'

99°09'

181°16'

90°07'

89°00' Cal.

26647

S 89°53' E
1343.1

13394

13470

Beaver Lake Road No. 101

2644.4


N 4751.34
E 4693.10 Not Yet Surveyed

(DENMAN ROAD No 242) WIDTH 50ft.
Transit Bk. #60

SECTION 19
TOWNSHIP 34 NORTH, RANGE 5 EAST, W. M.
SKAGIT COUNTY, WASH.

SCALE, 1 INCH--400 FEET

DATE September, 1959 Frank Gilkey COUNTY ENGINEER

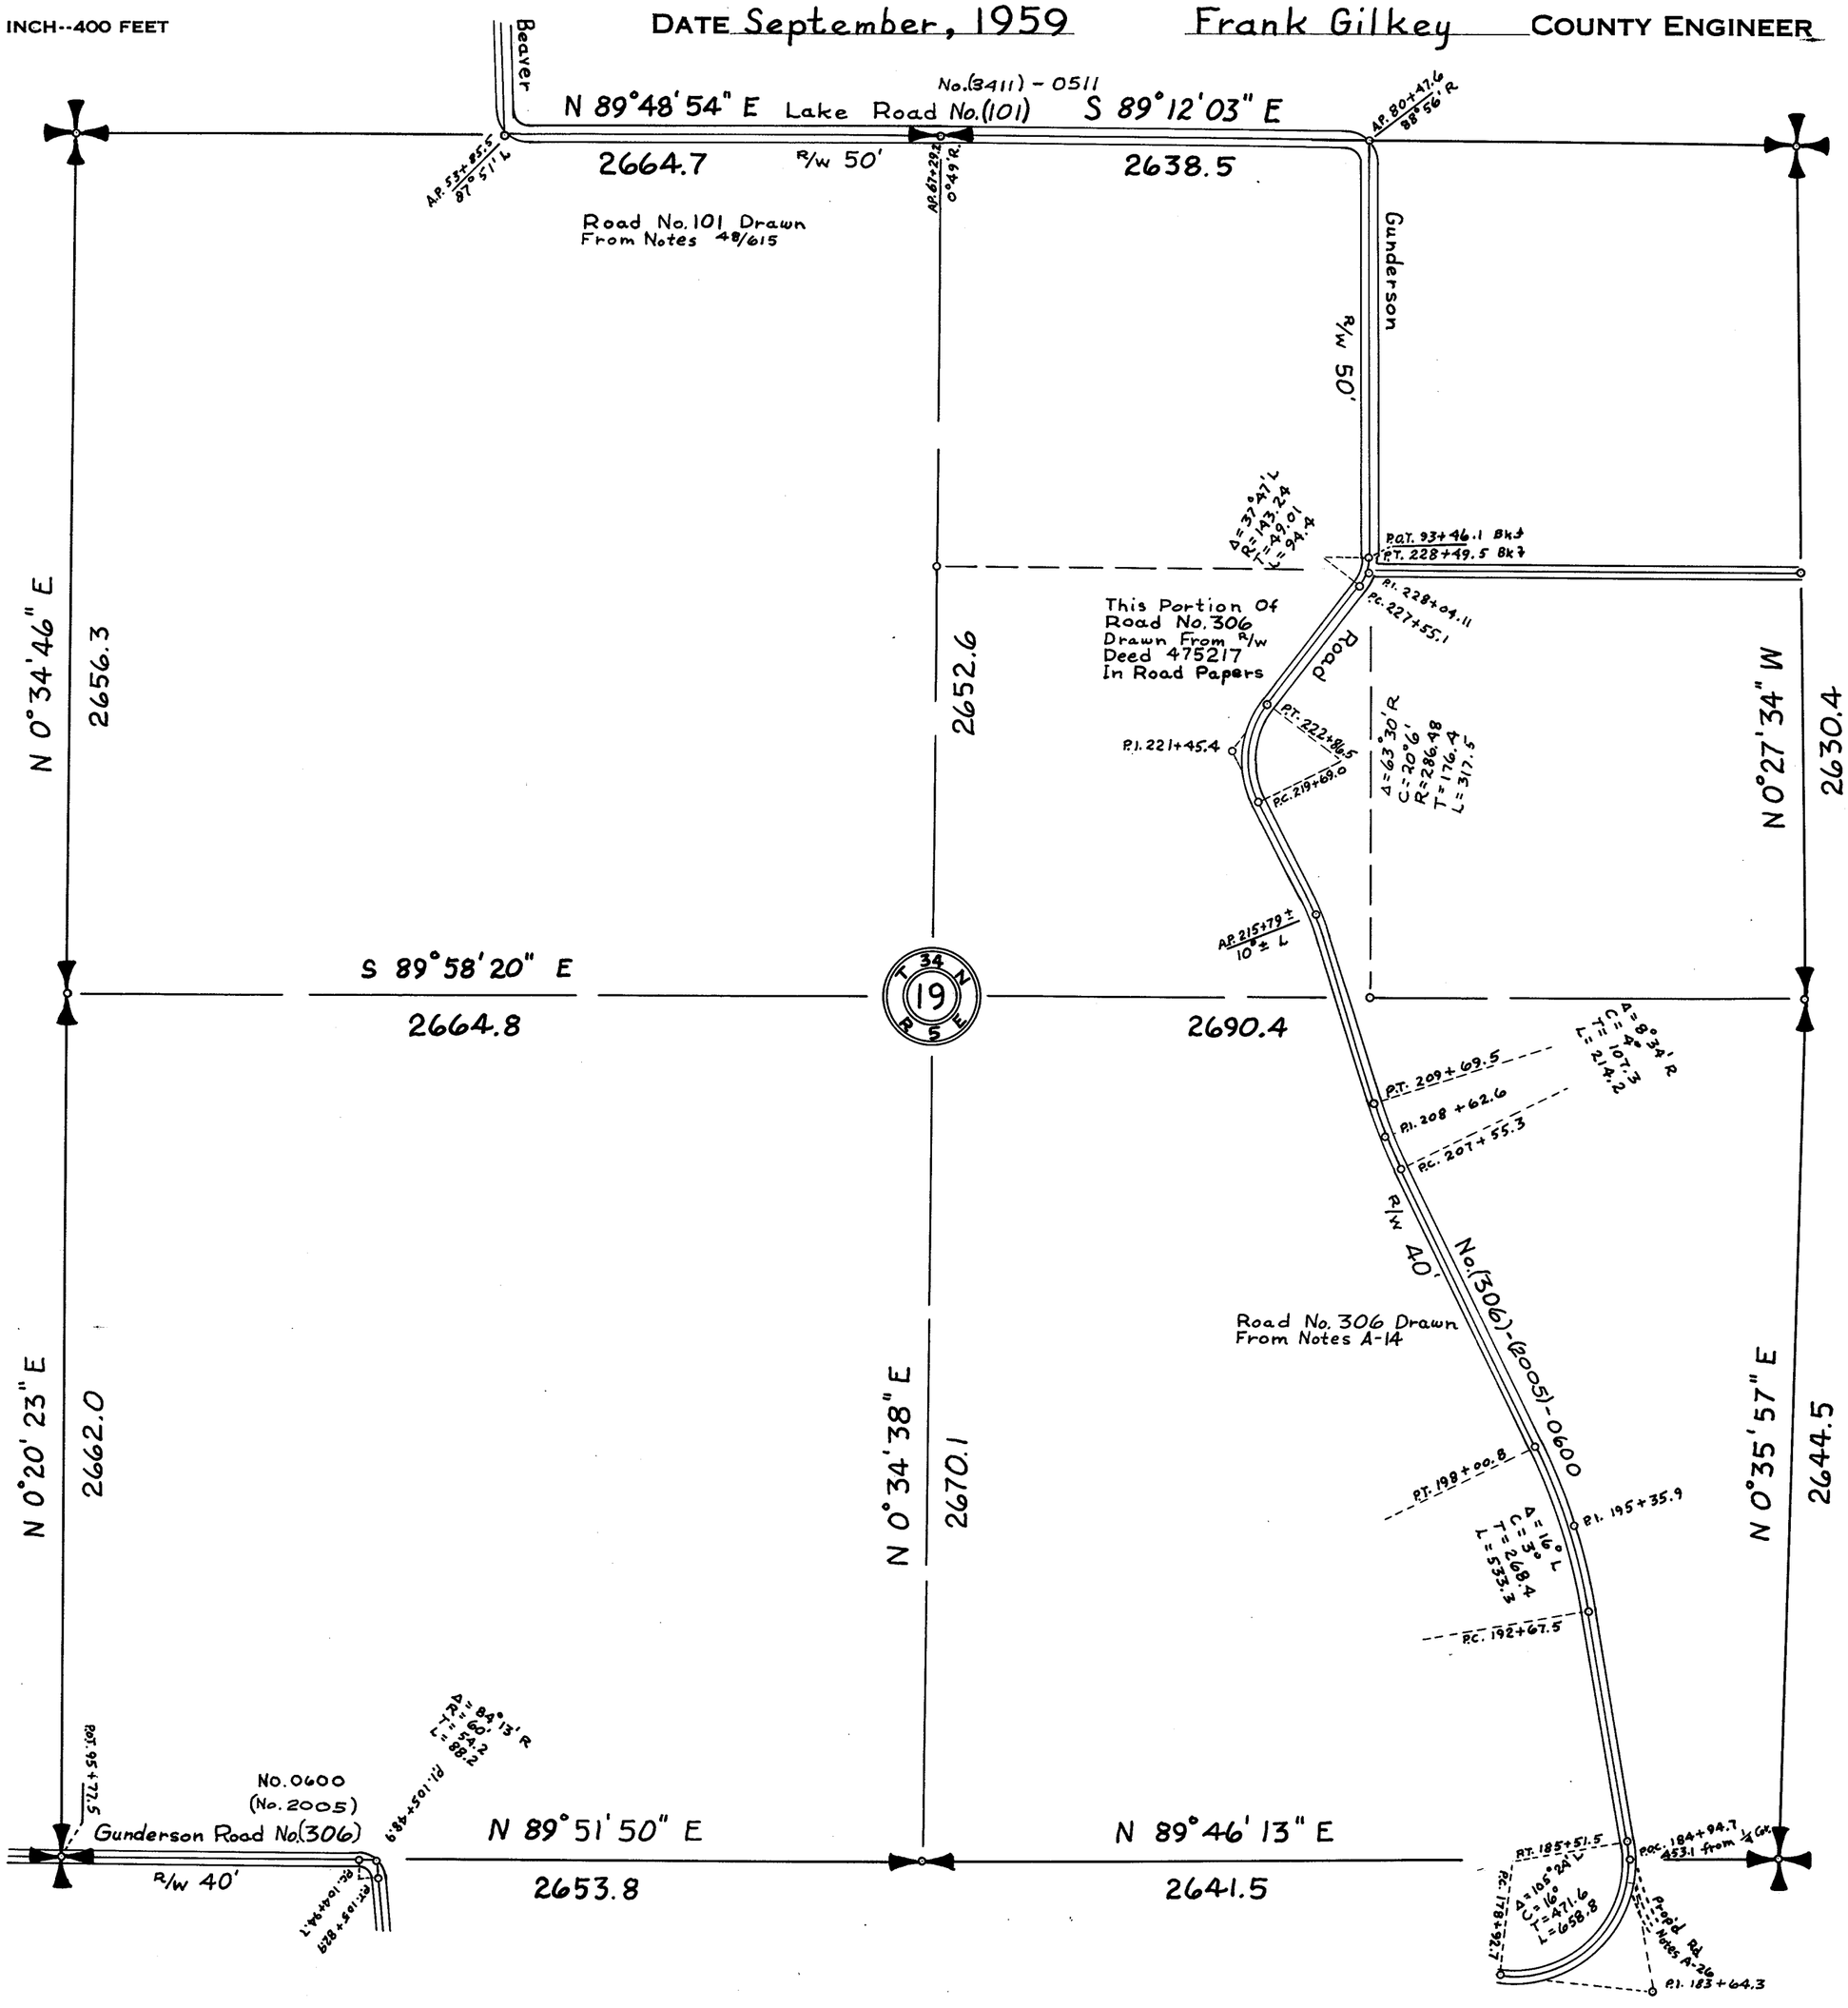

SECTION 19


TOWNSHIP 34 NORTH, RANGE 5 EAST, W. M.

SKAGIT COUNTY, WASH.

SCALE, 1 INCH—400 FEET

R.F.L. Knapp COUNTY ENGINEER

A14

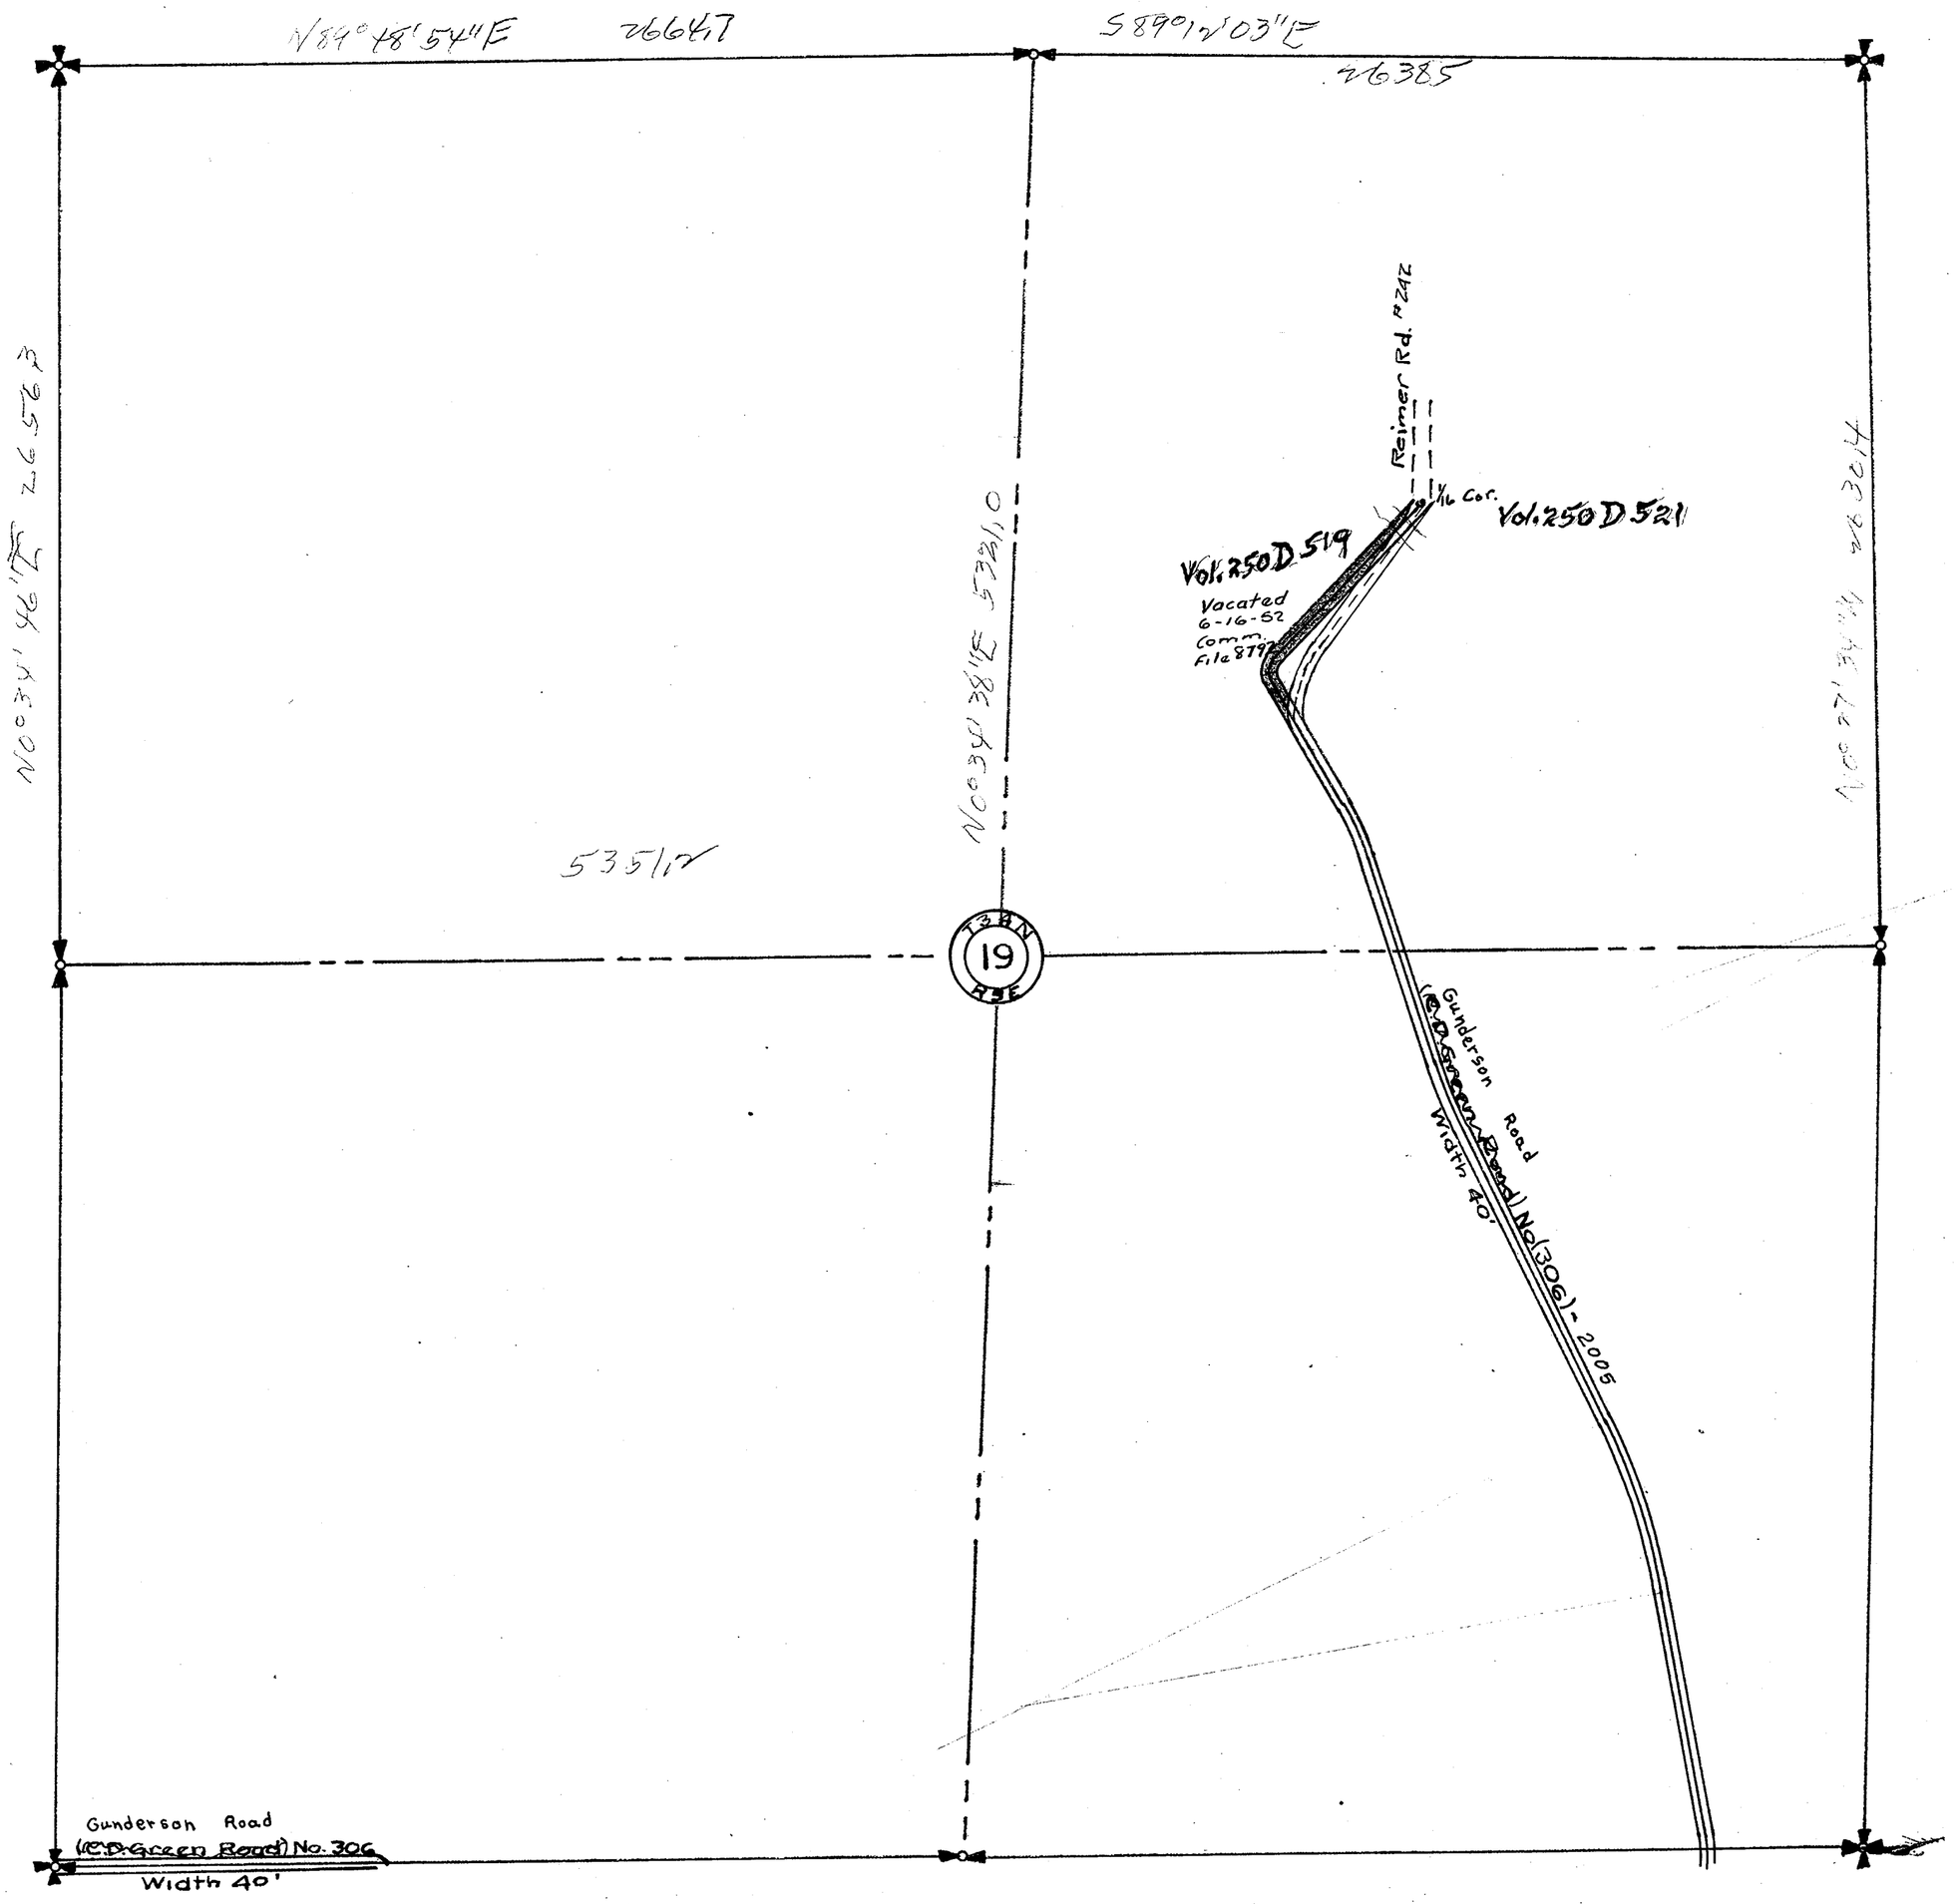


SECTION 19

TOWNSHIP 34 NORTH, RANGE 5 EAST, W. M.

SKAGIT COUNTY, WASH.

SCALE, 1 INCH = 400 FEET

A. L. STRONG COUNTY ENGINEER

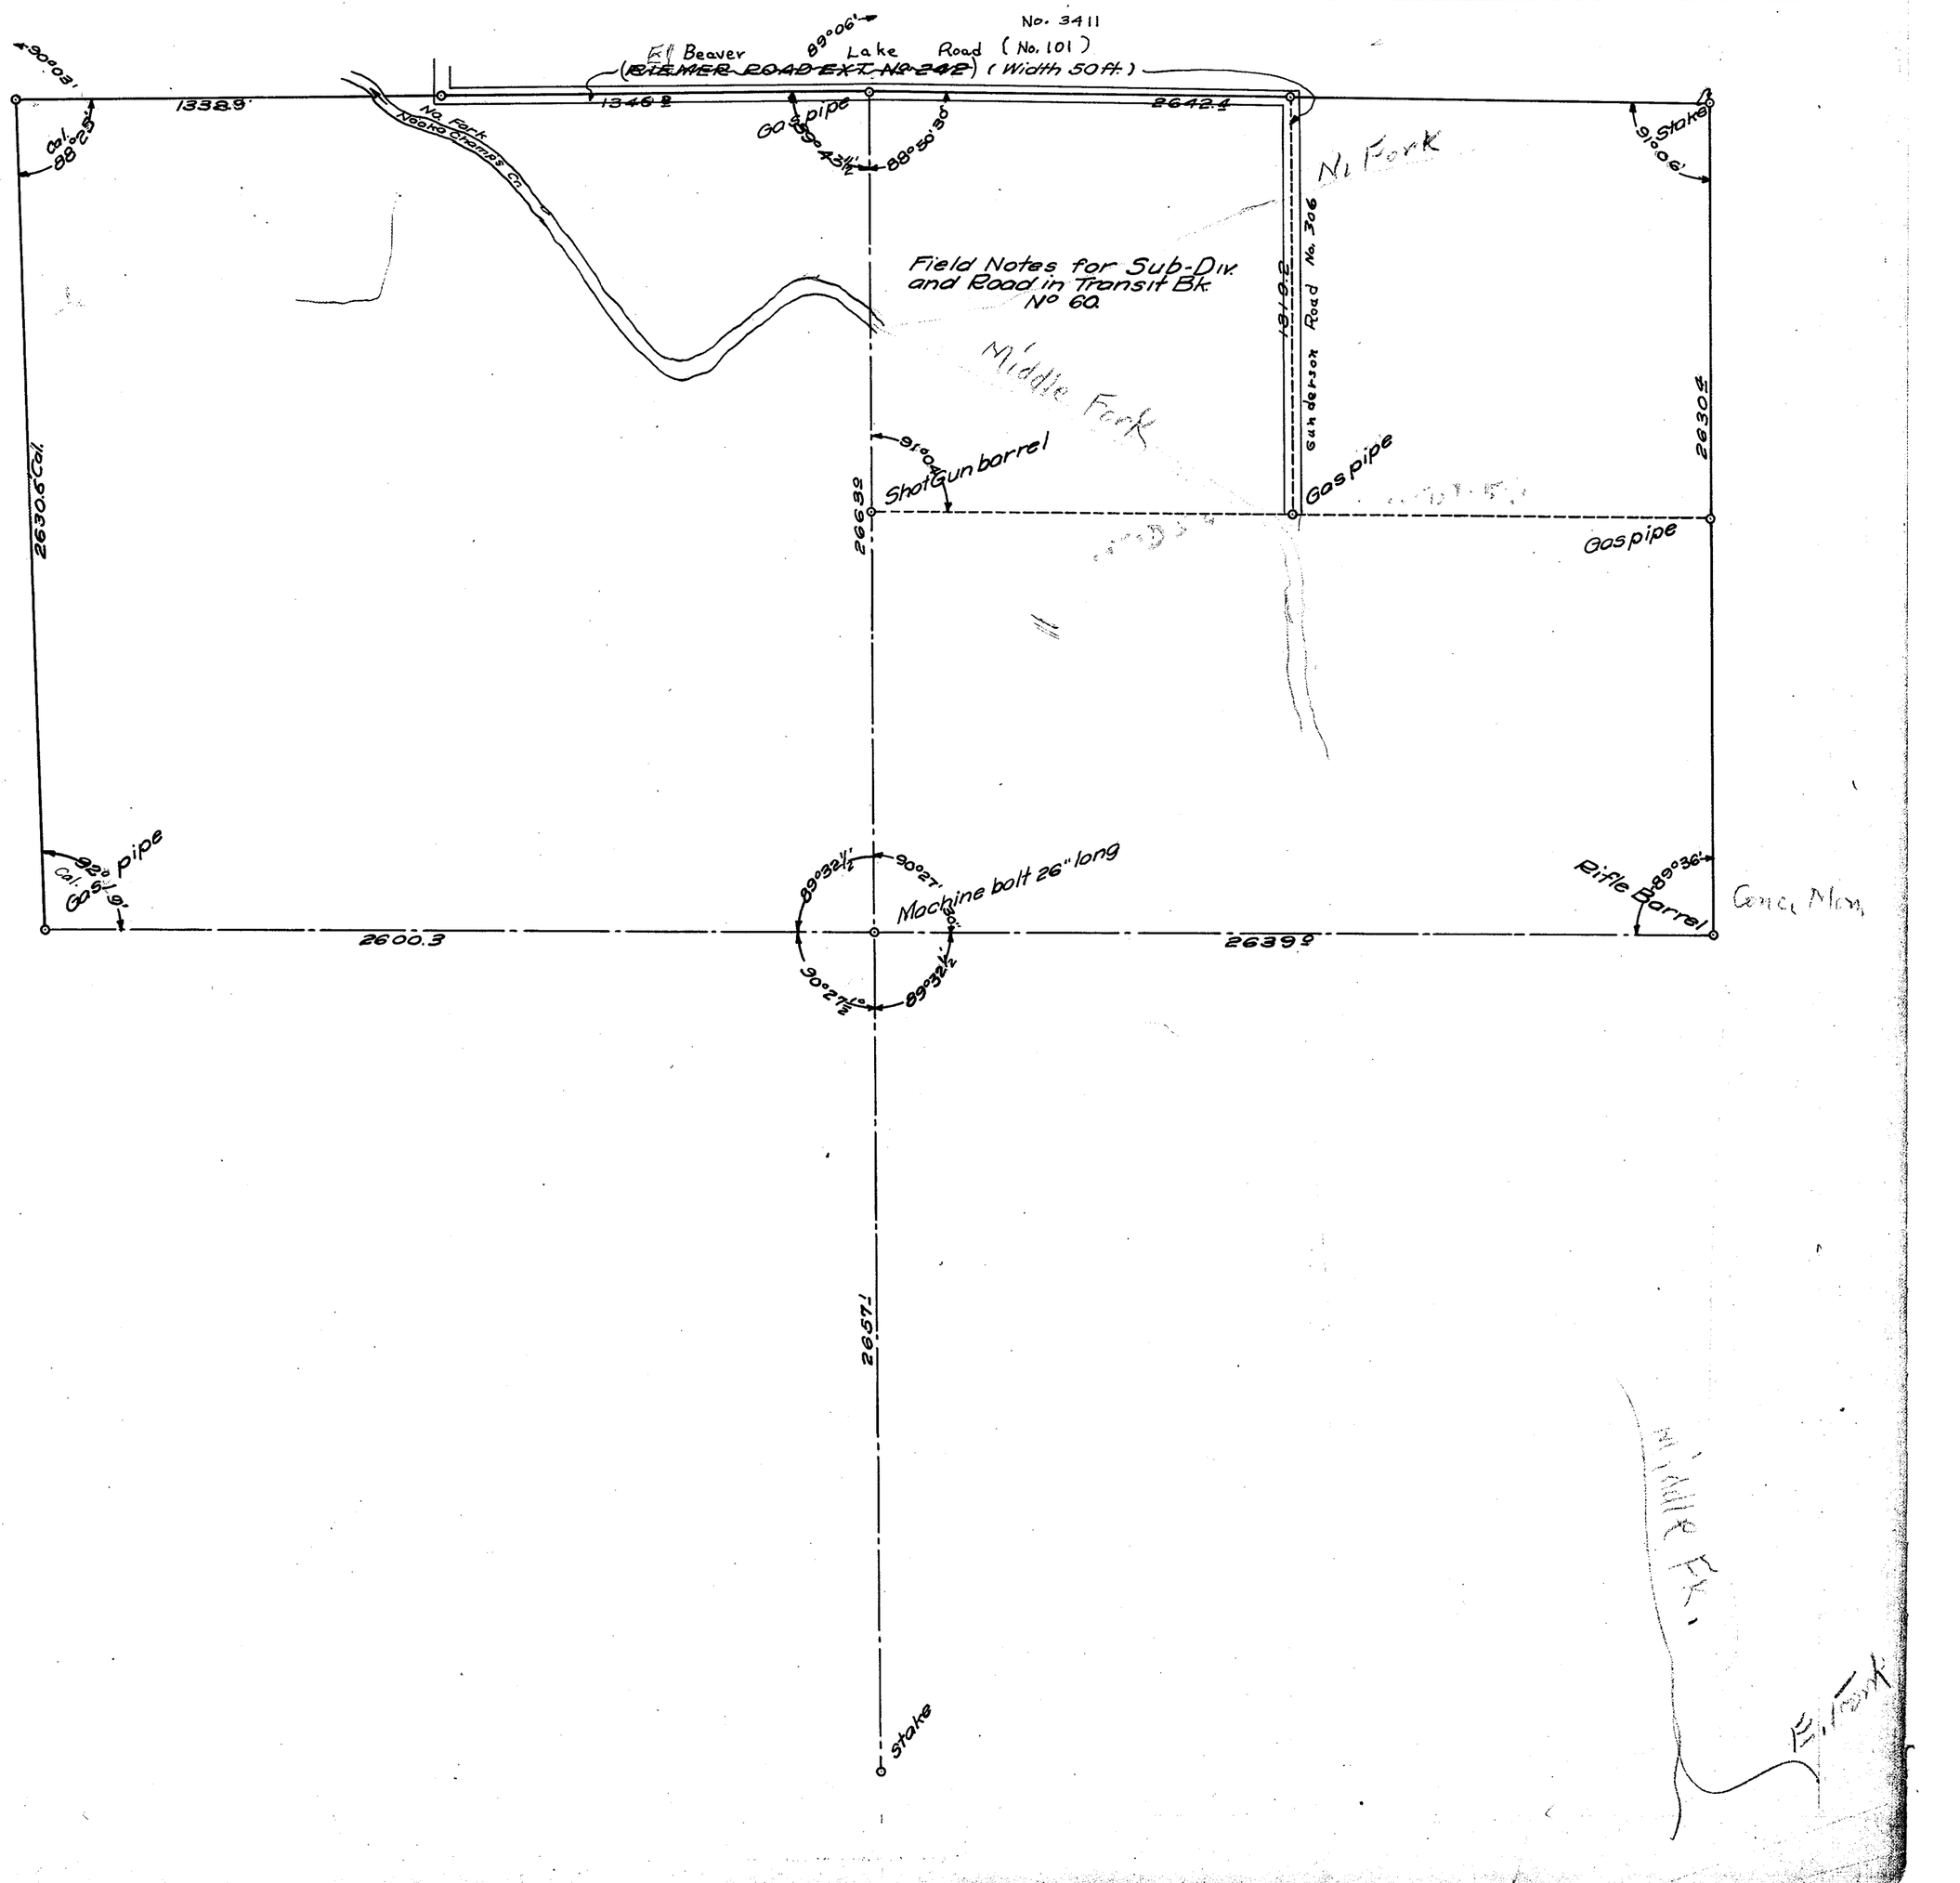

SECTION 30

TOWNSHIP 34 NORTH, RANGE 5 EAST, W. M.

SKAGIT COUNTY, WASH.

SCALE, 1 INCH--400 FEET


DATE September, 1959 Frank Gilkey COUNTY ENGINEER

SECTION 30

TOWNSHIP 34 NORTH, RANGE 5 EAST, W. M.
SKAGIT COUNTY, WASH.

SCALE, 1 INCH–400 FEET

R.E.L. Knapp COUNTY ENGINEER

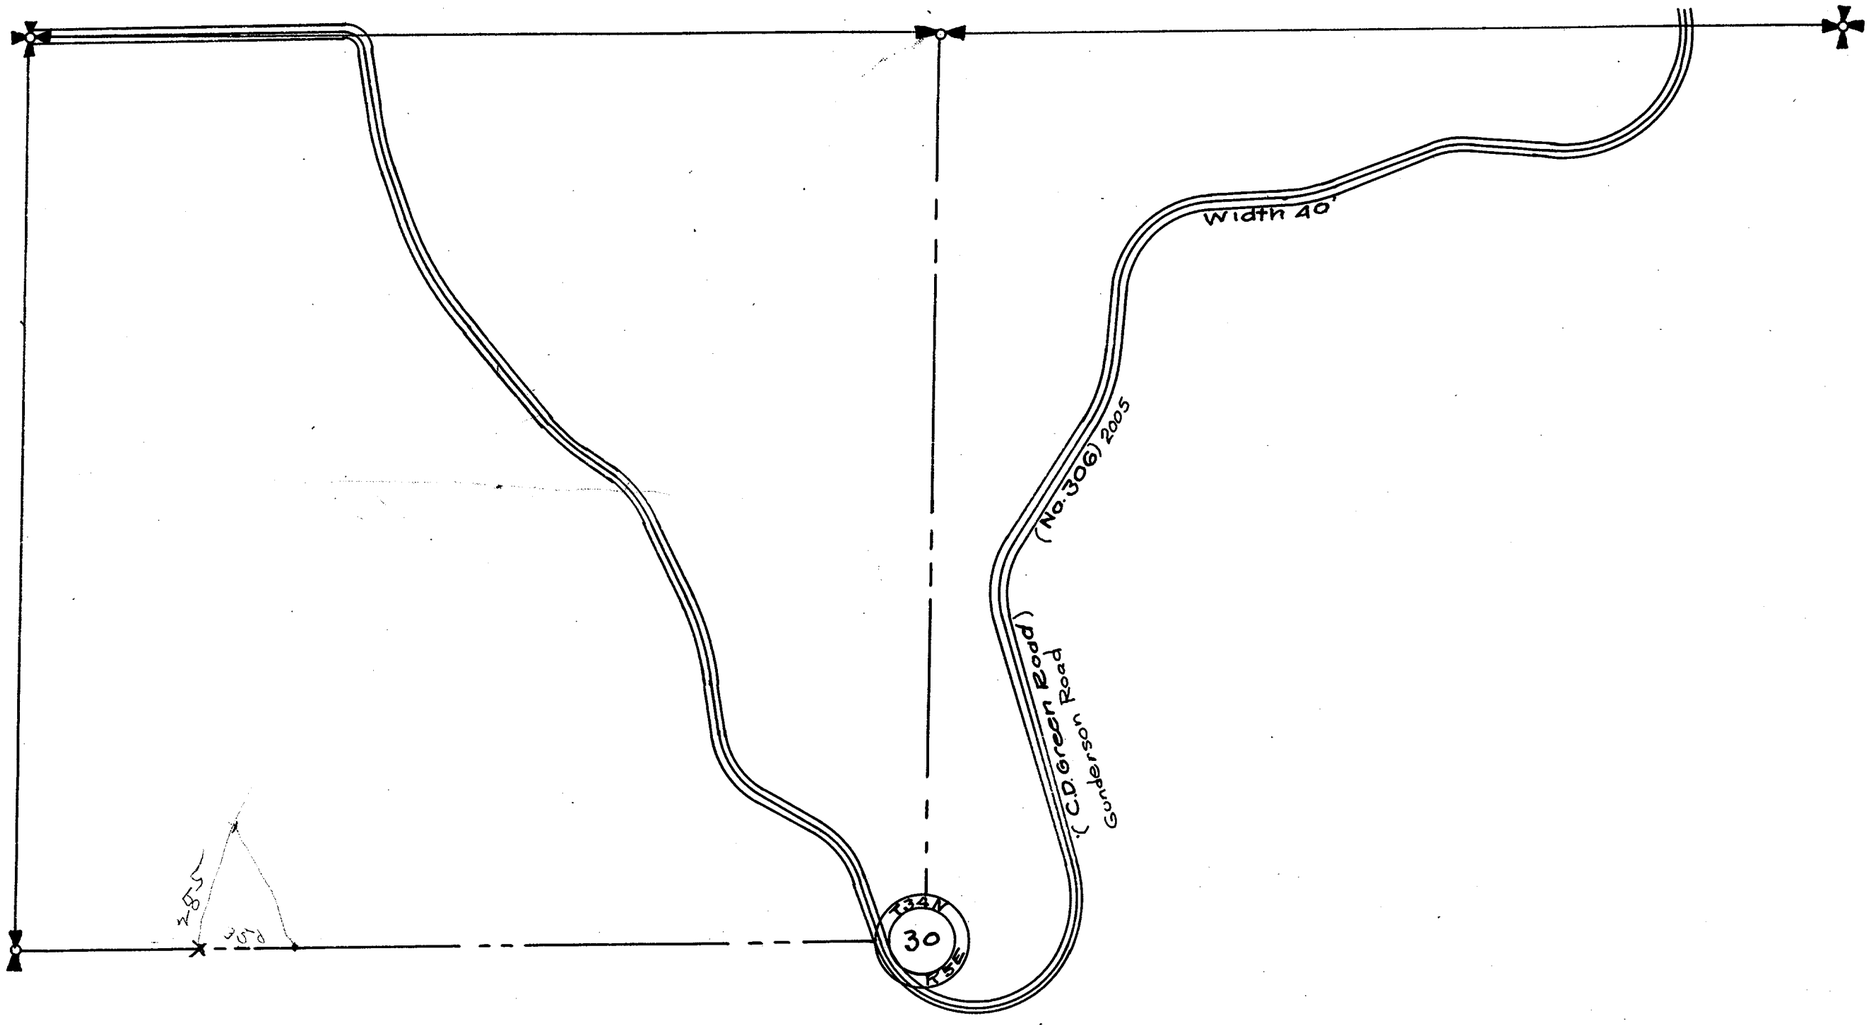

SECTION 31


TOWNSHIP 34 NORTH, RANGE 5 EAST, W. M.

SKAGIT COUNTY, WASH.

SCALE, 1 INCH--400 FEET

DATE July 25, 1966 Lloyd Johnson COUNTY ENGINEER

Note : This Tracing Drawn From an Aerial Photo — Not to Scale

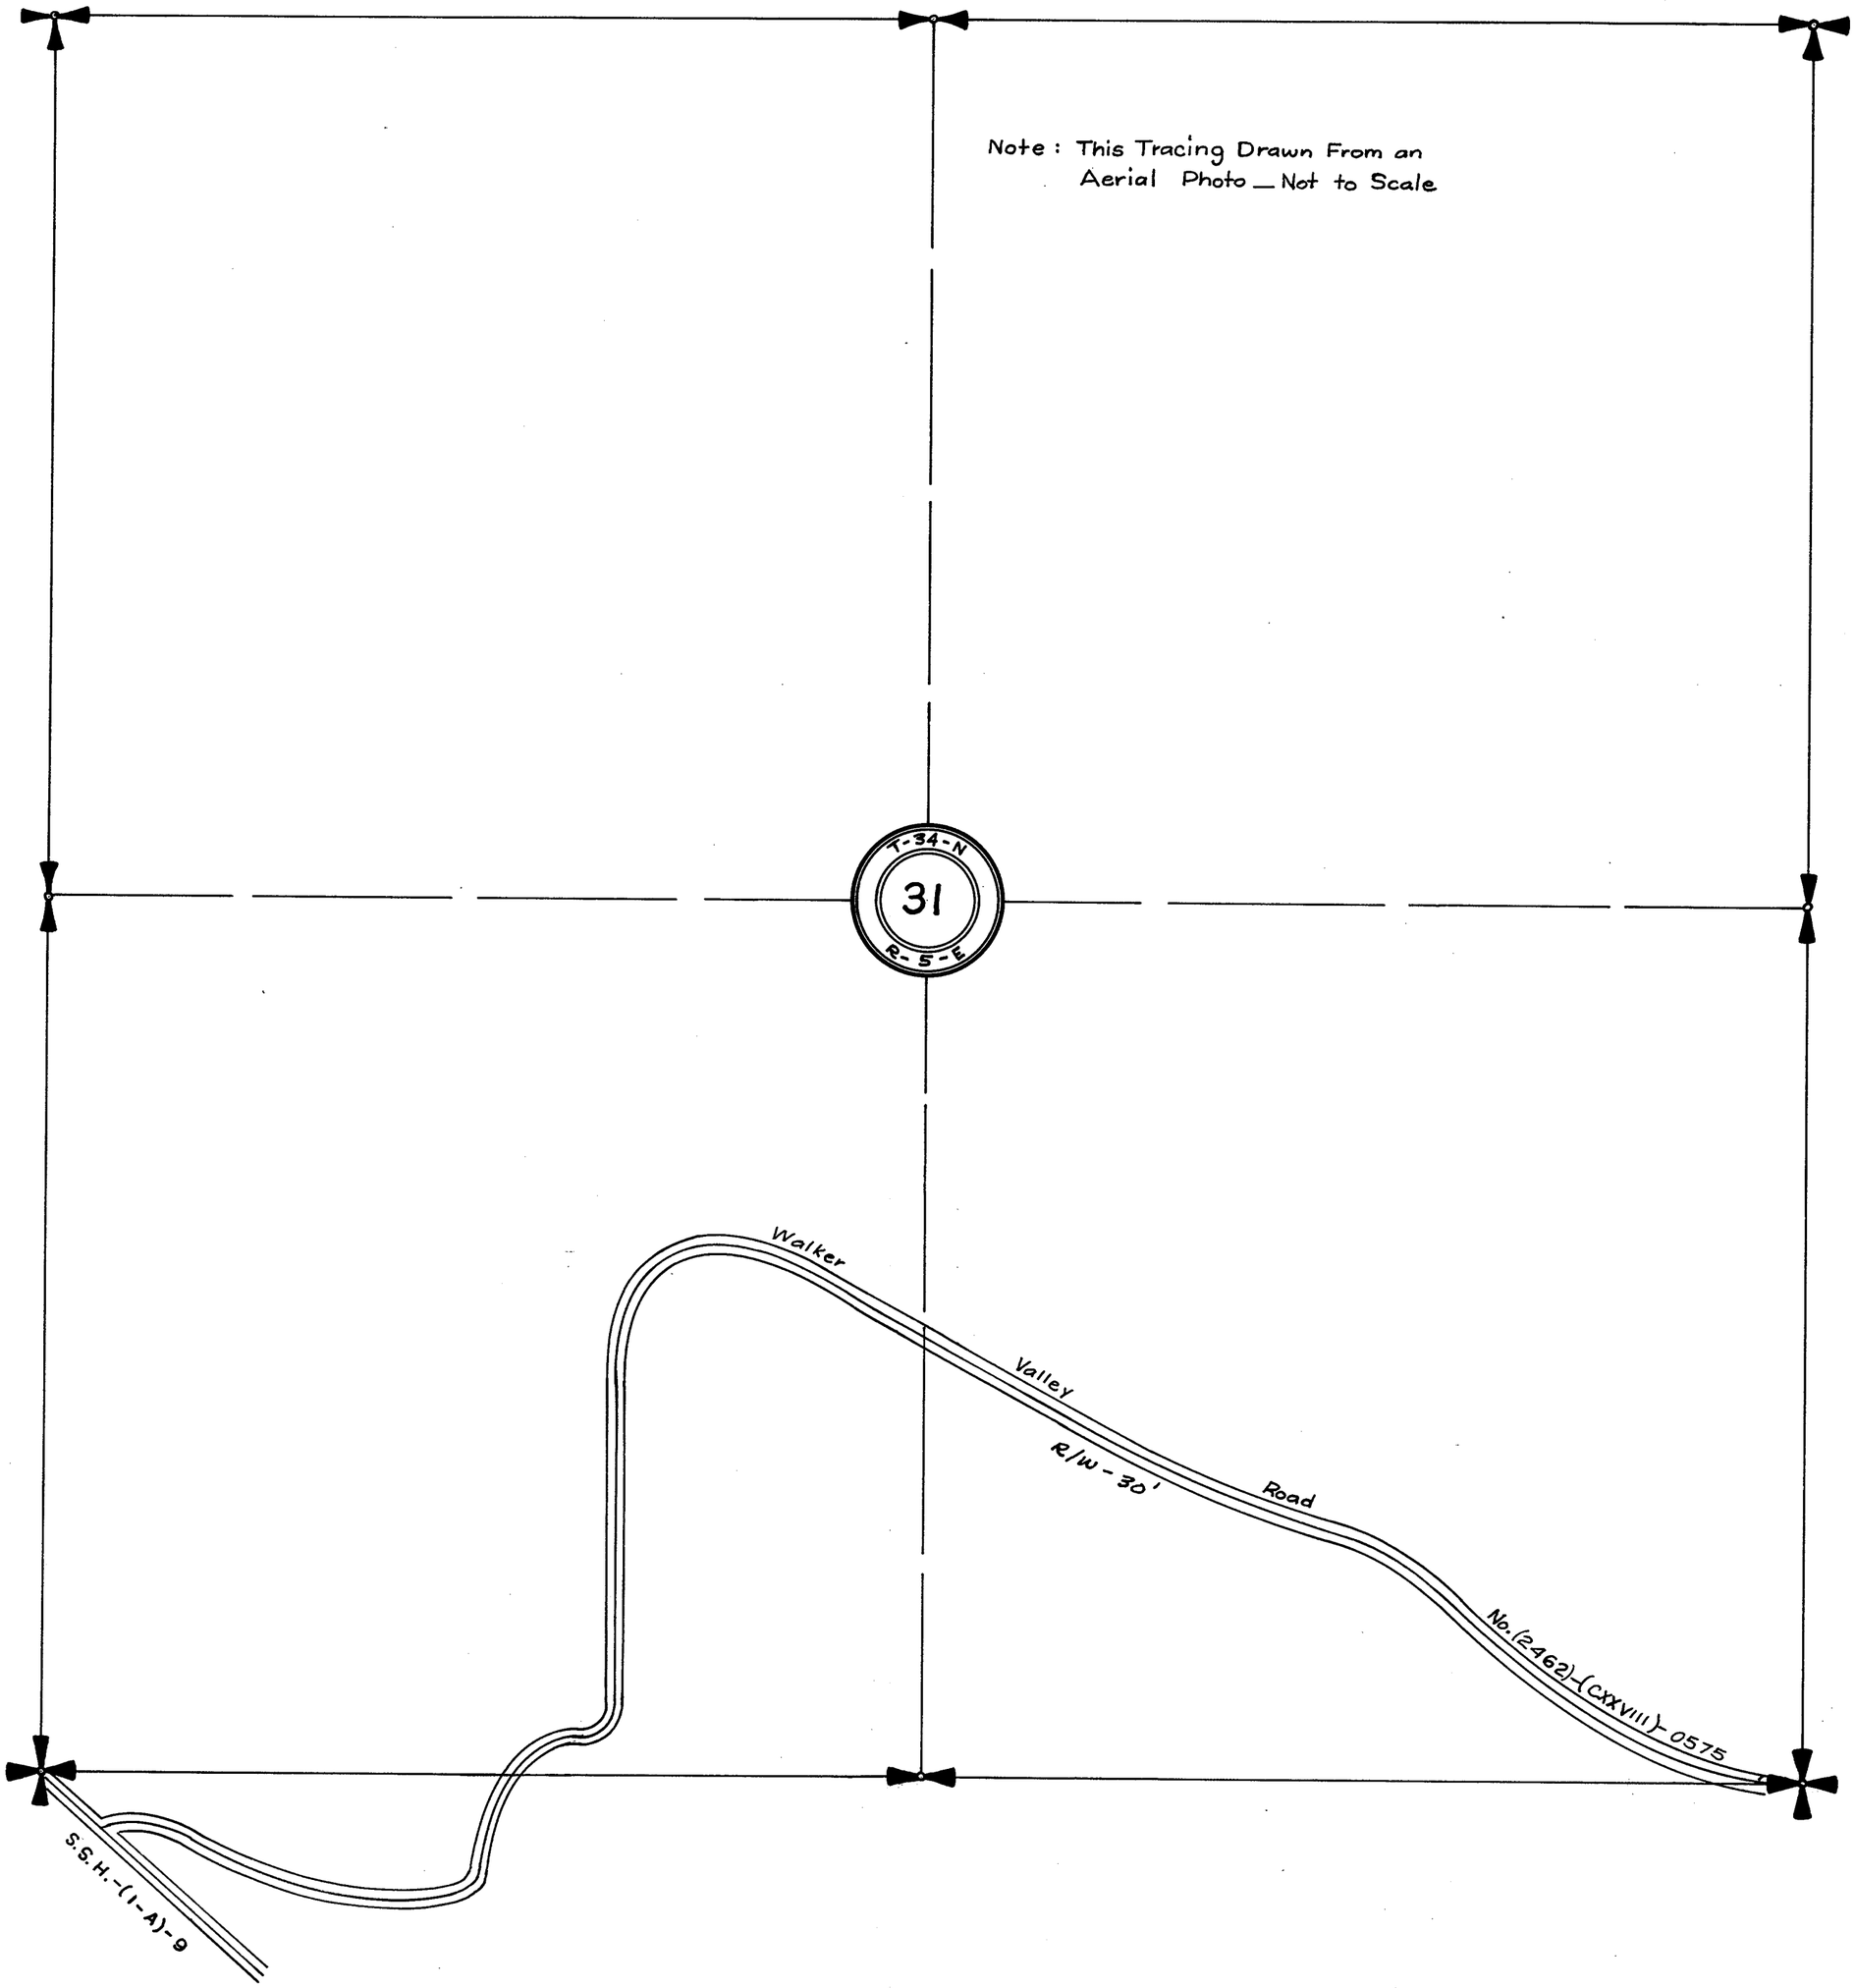


SECTION 32

TOWNSHIP 34 NORTH, RANGE 5 EAST, W. M.

SKAGIT COUNTY, WASH.

SCALE, 1 INCH--400 FEET

DATE July 25, 1966 Lloyd Johnson COUNTY ENGINEER

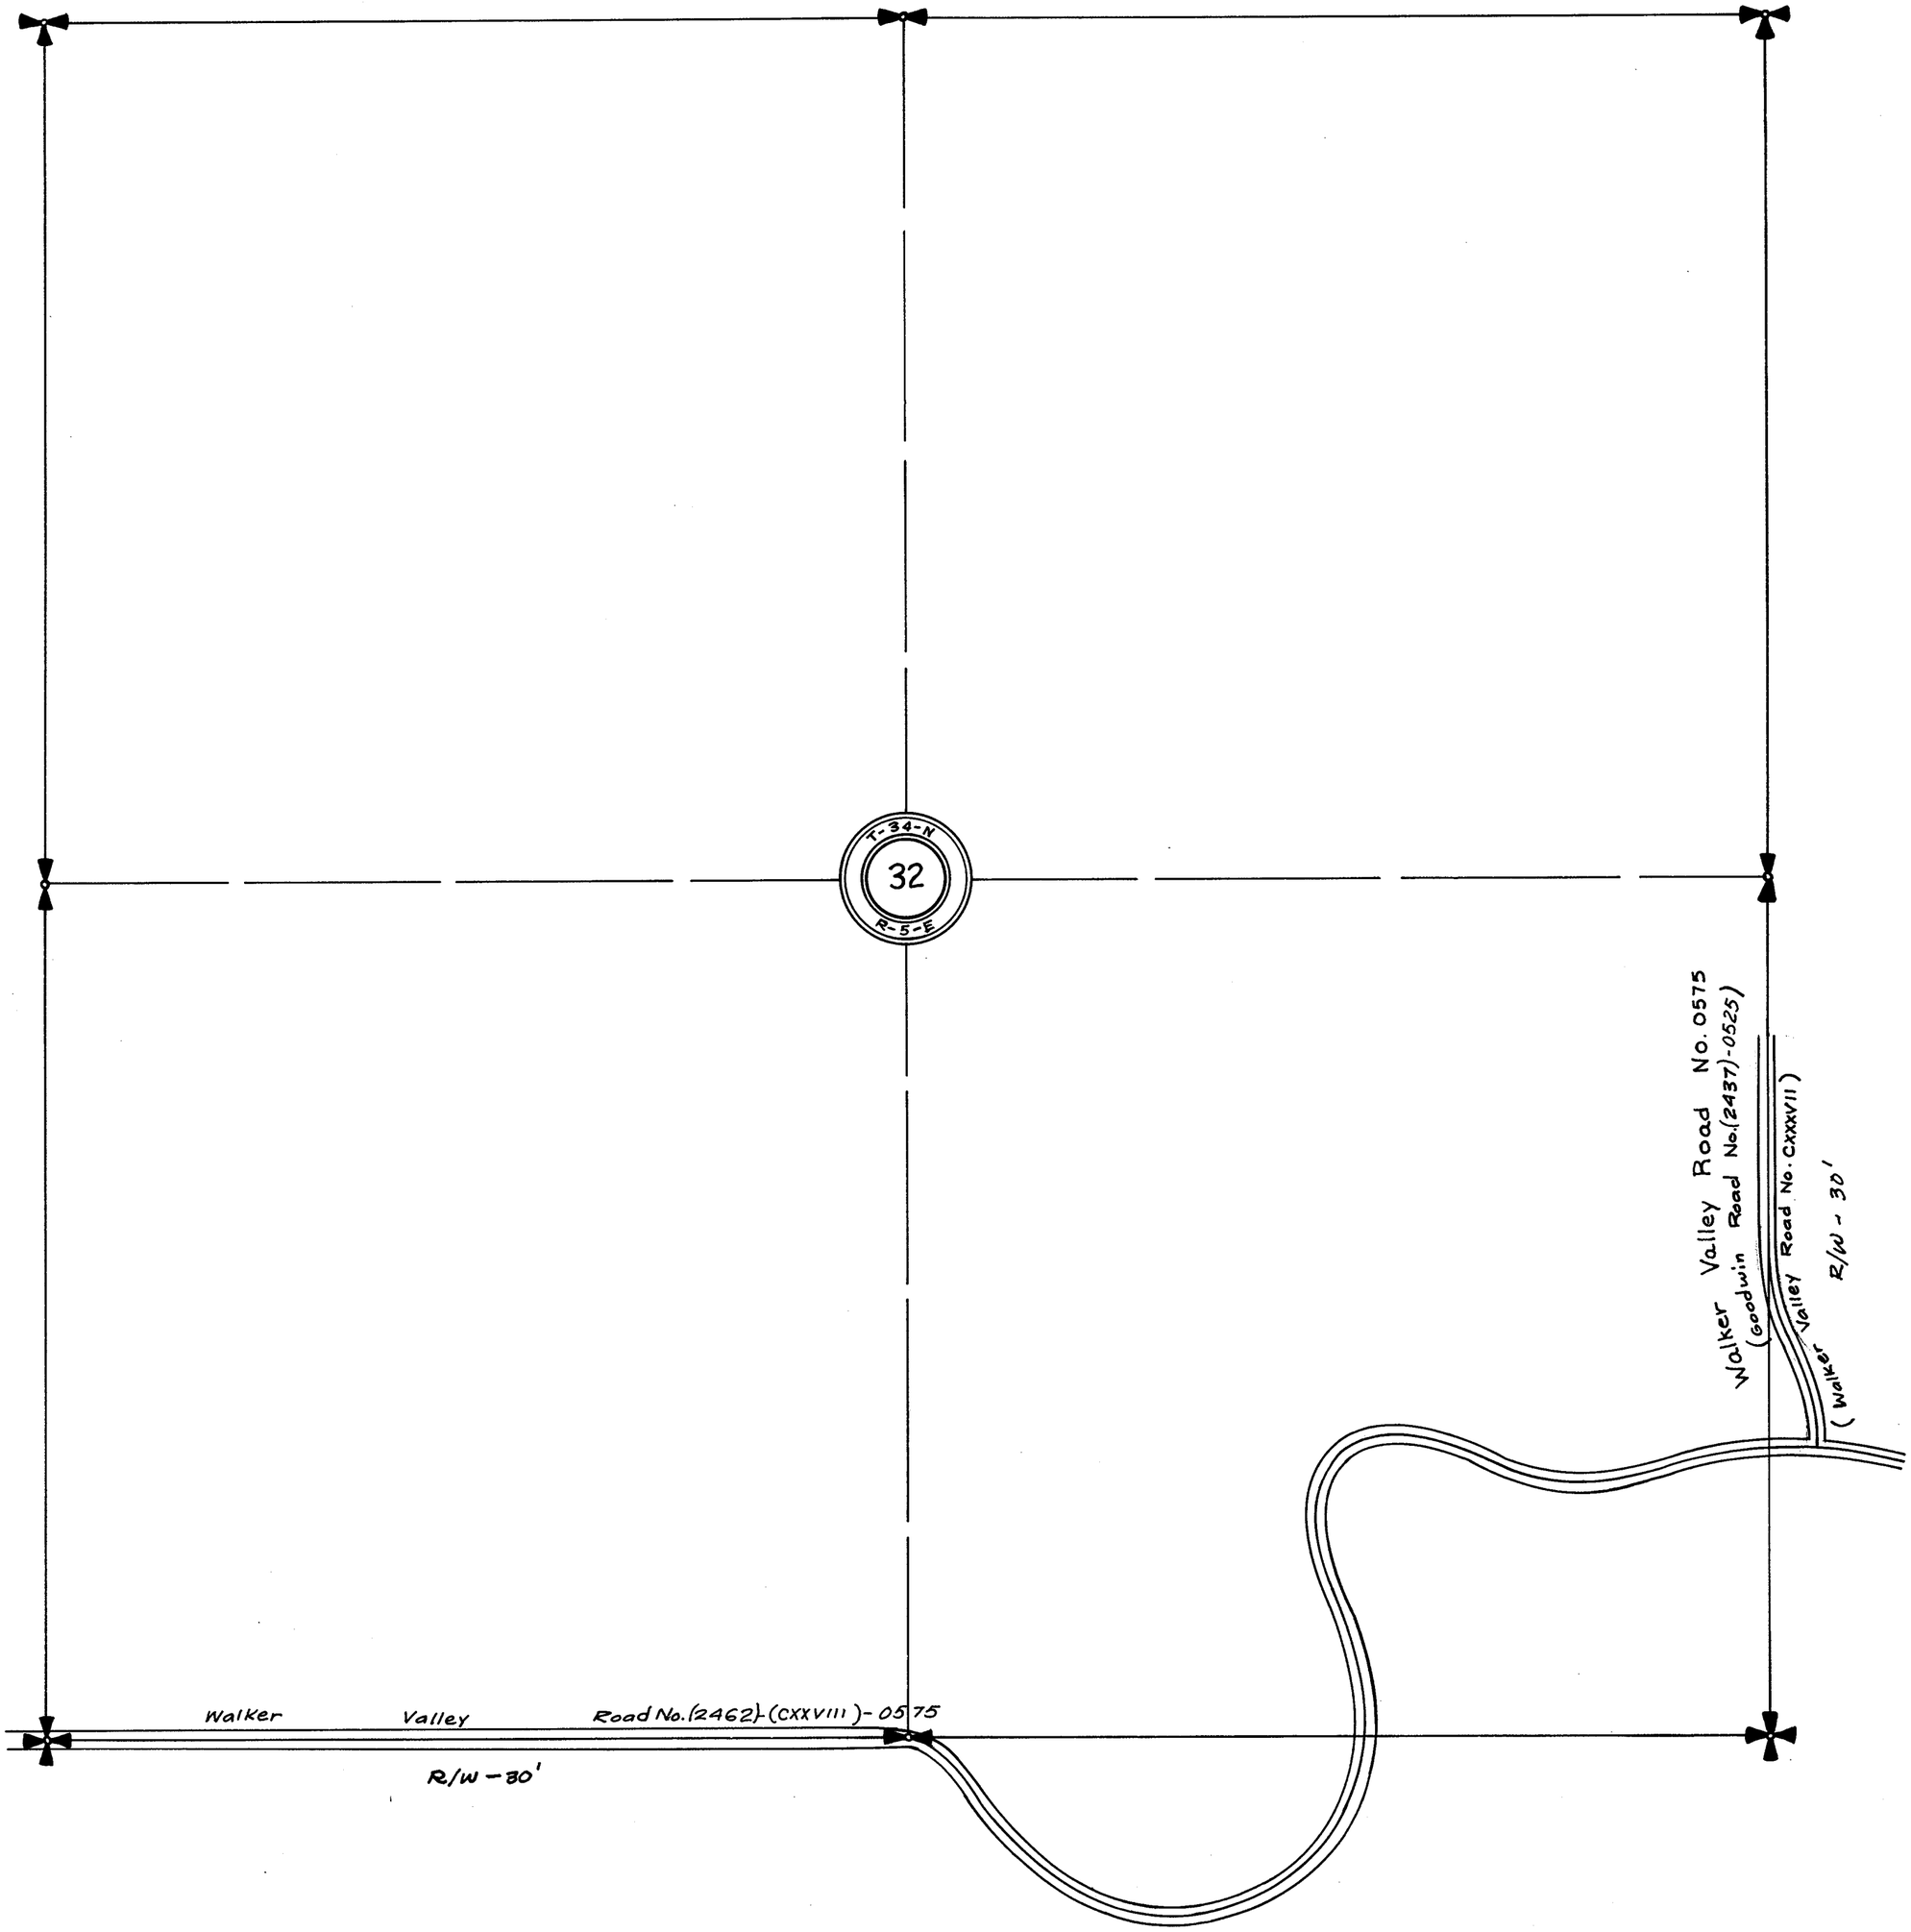

SECTION 1


TOWNSHIP 34 NORTH, RANGE 9 EAST, W. M.

SKAGIT COUNTY, WASH.

SCALE, 1 INCH -- 400 FEET

DATE Aug. 26, 1966


Lloyd Johnson COUNTY ENGINEER

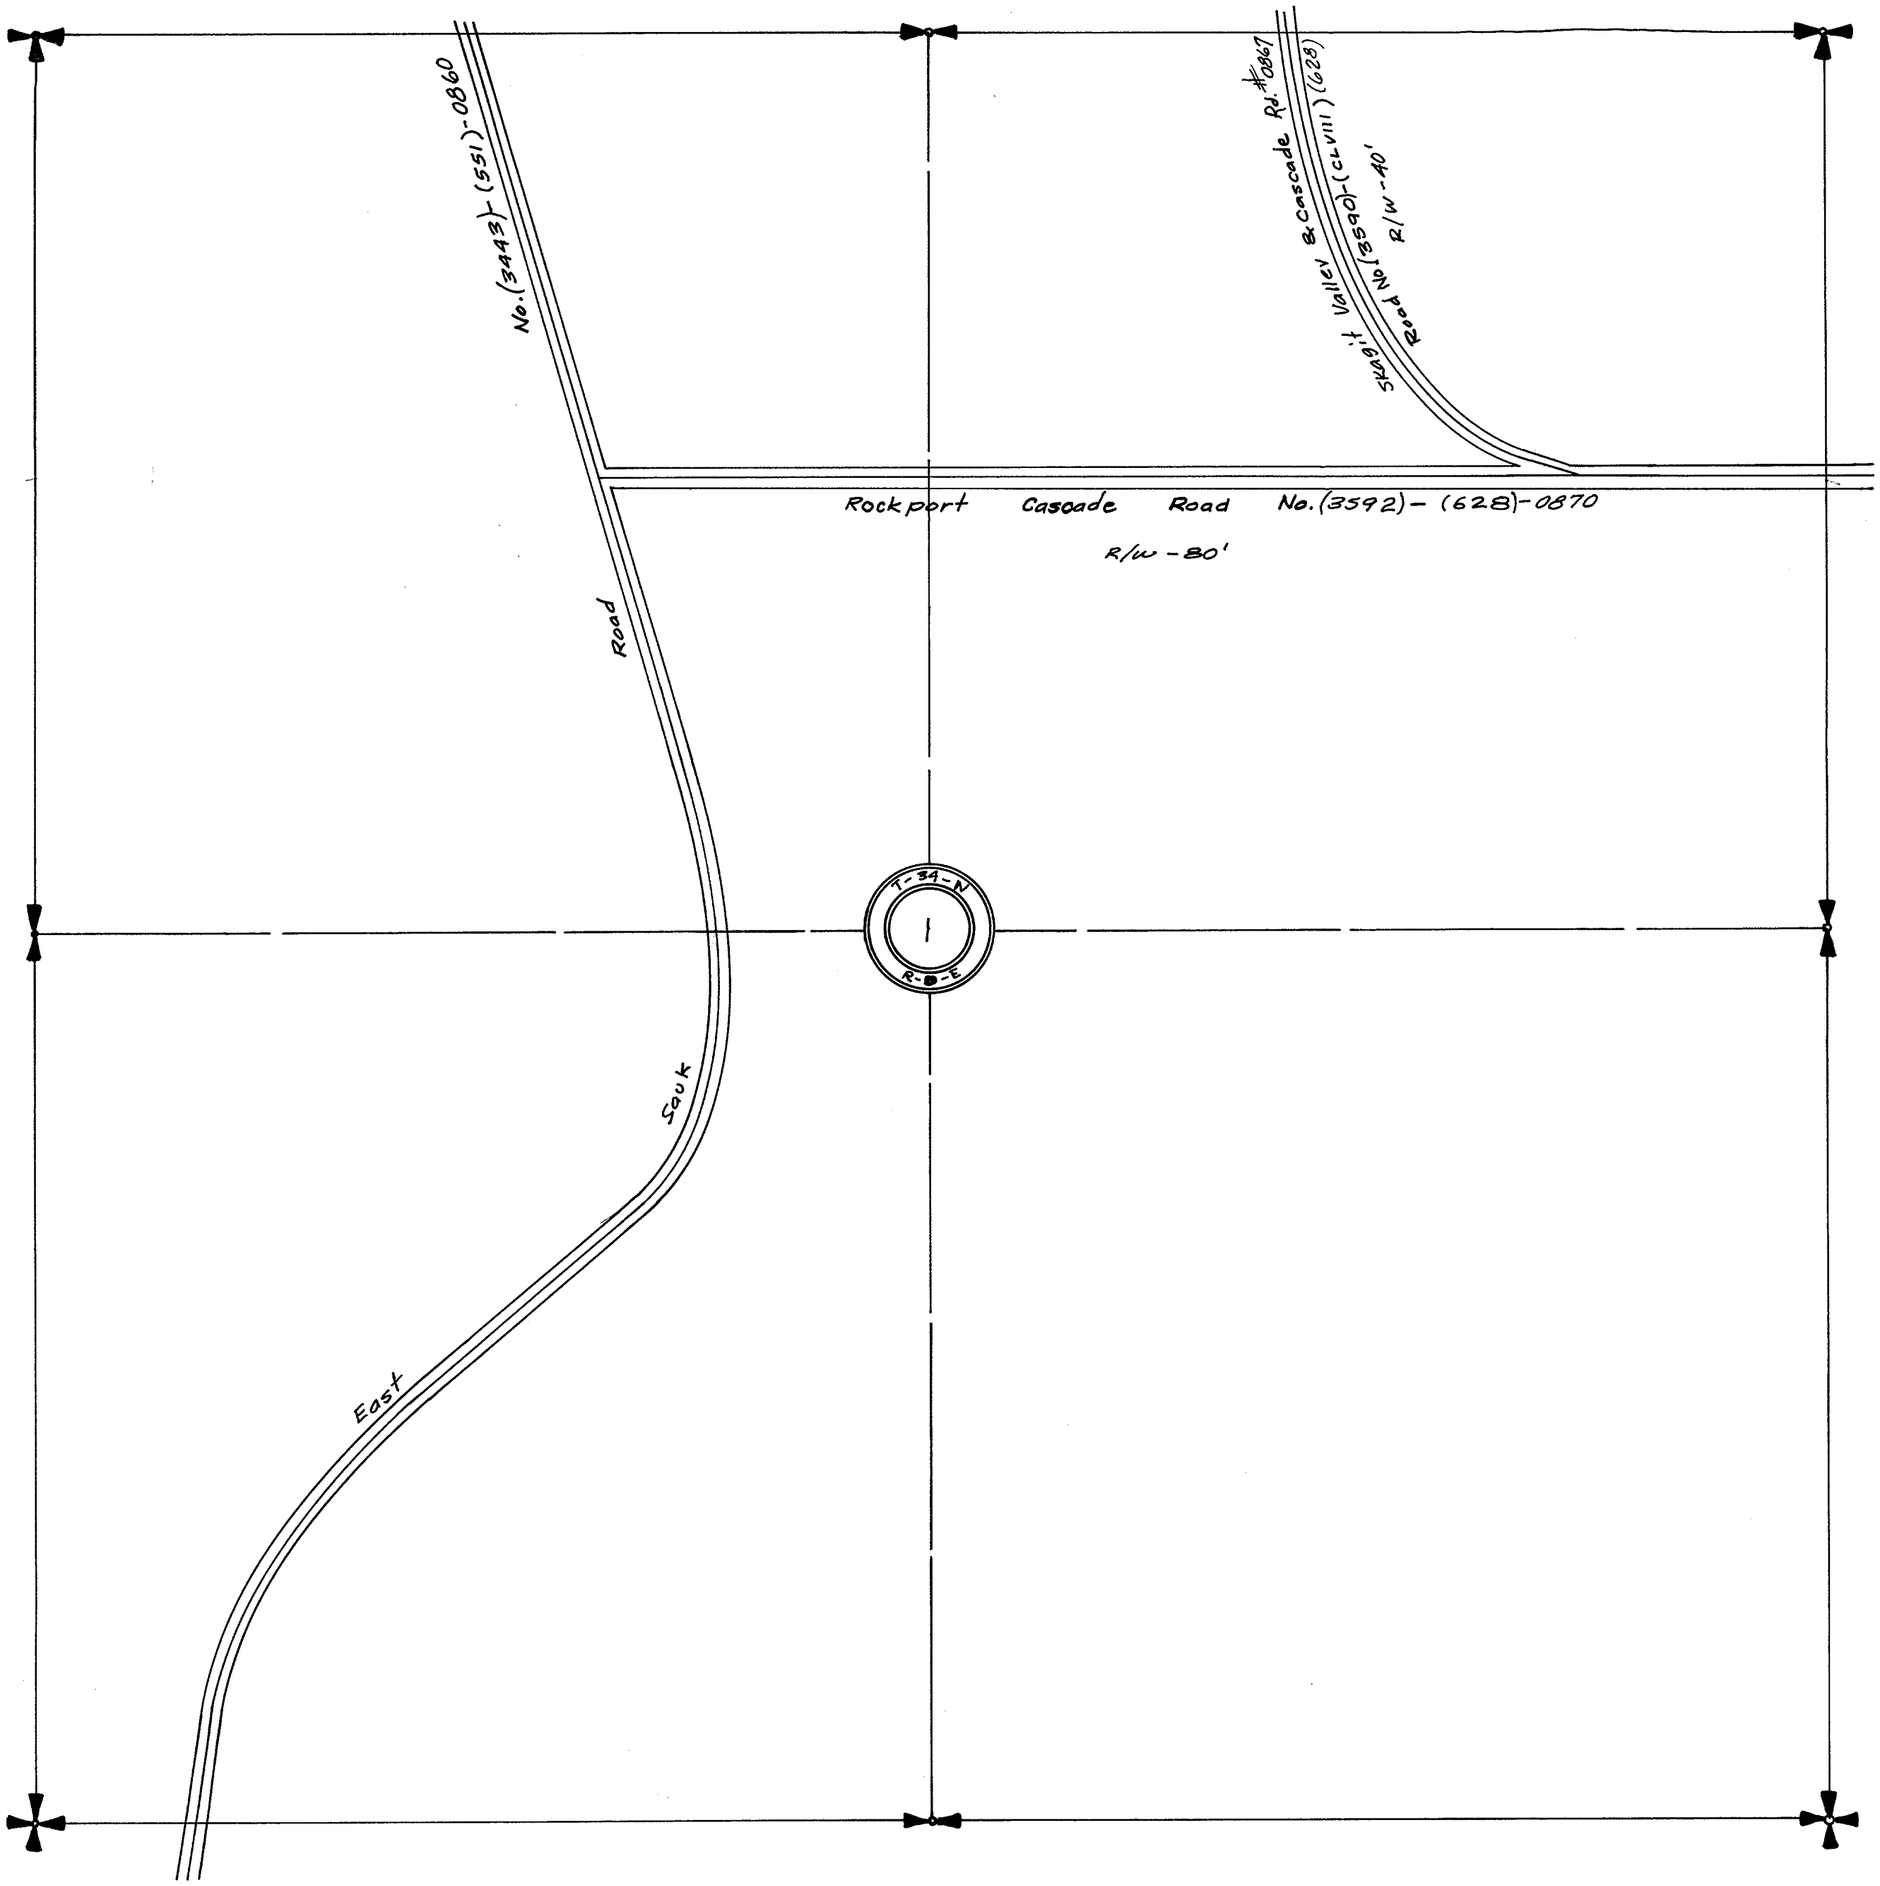

SECTION 1
TOWNSHIP 34 NORTH, RANGE 9 EAST, W. M.
SKAGIT COUNTY, WASH.

SCALE, 1 INCH--400 FEET

H.O. WALBERG COUNTY ENGINEER

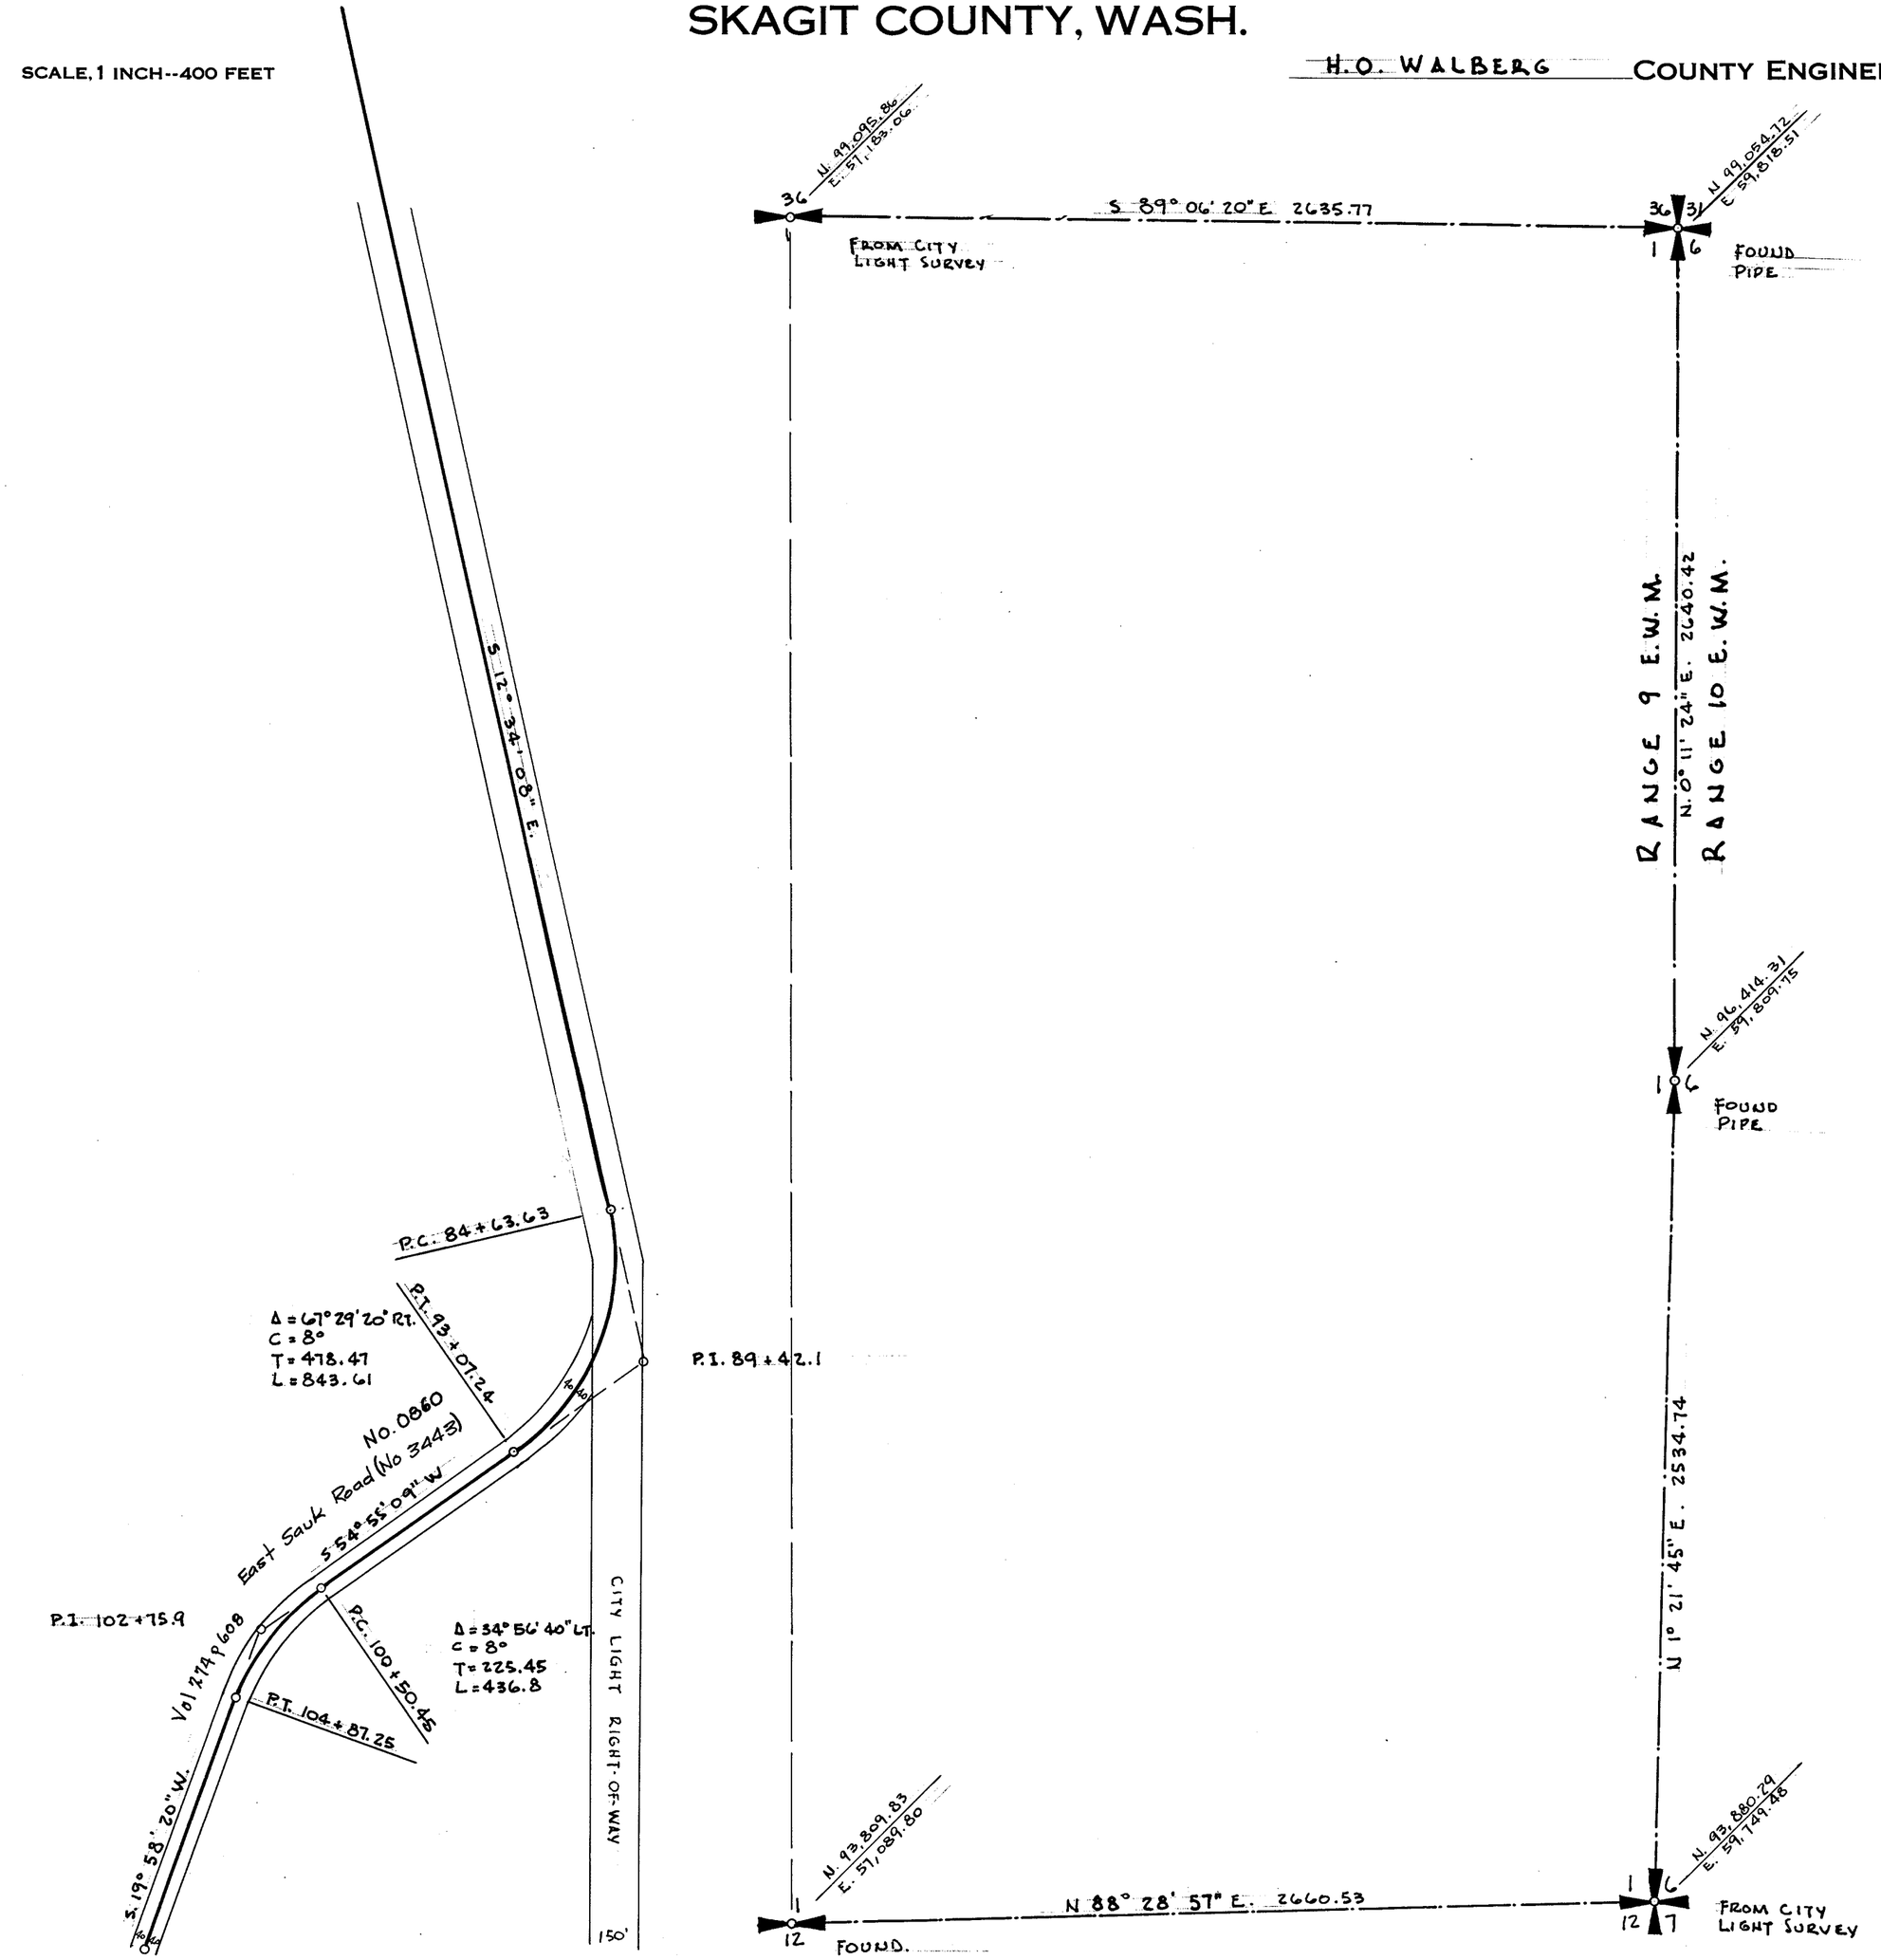

SECTION 2


TOWNSHIP 34 NORTH, RANGE 9 EAST, W. M.

SKAGIT COUNTY, WASH.

SCALE, 1 INCH--400 FEET

DATE Aug. 12, 1963

COUNTY ENGINEER

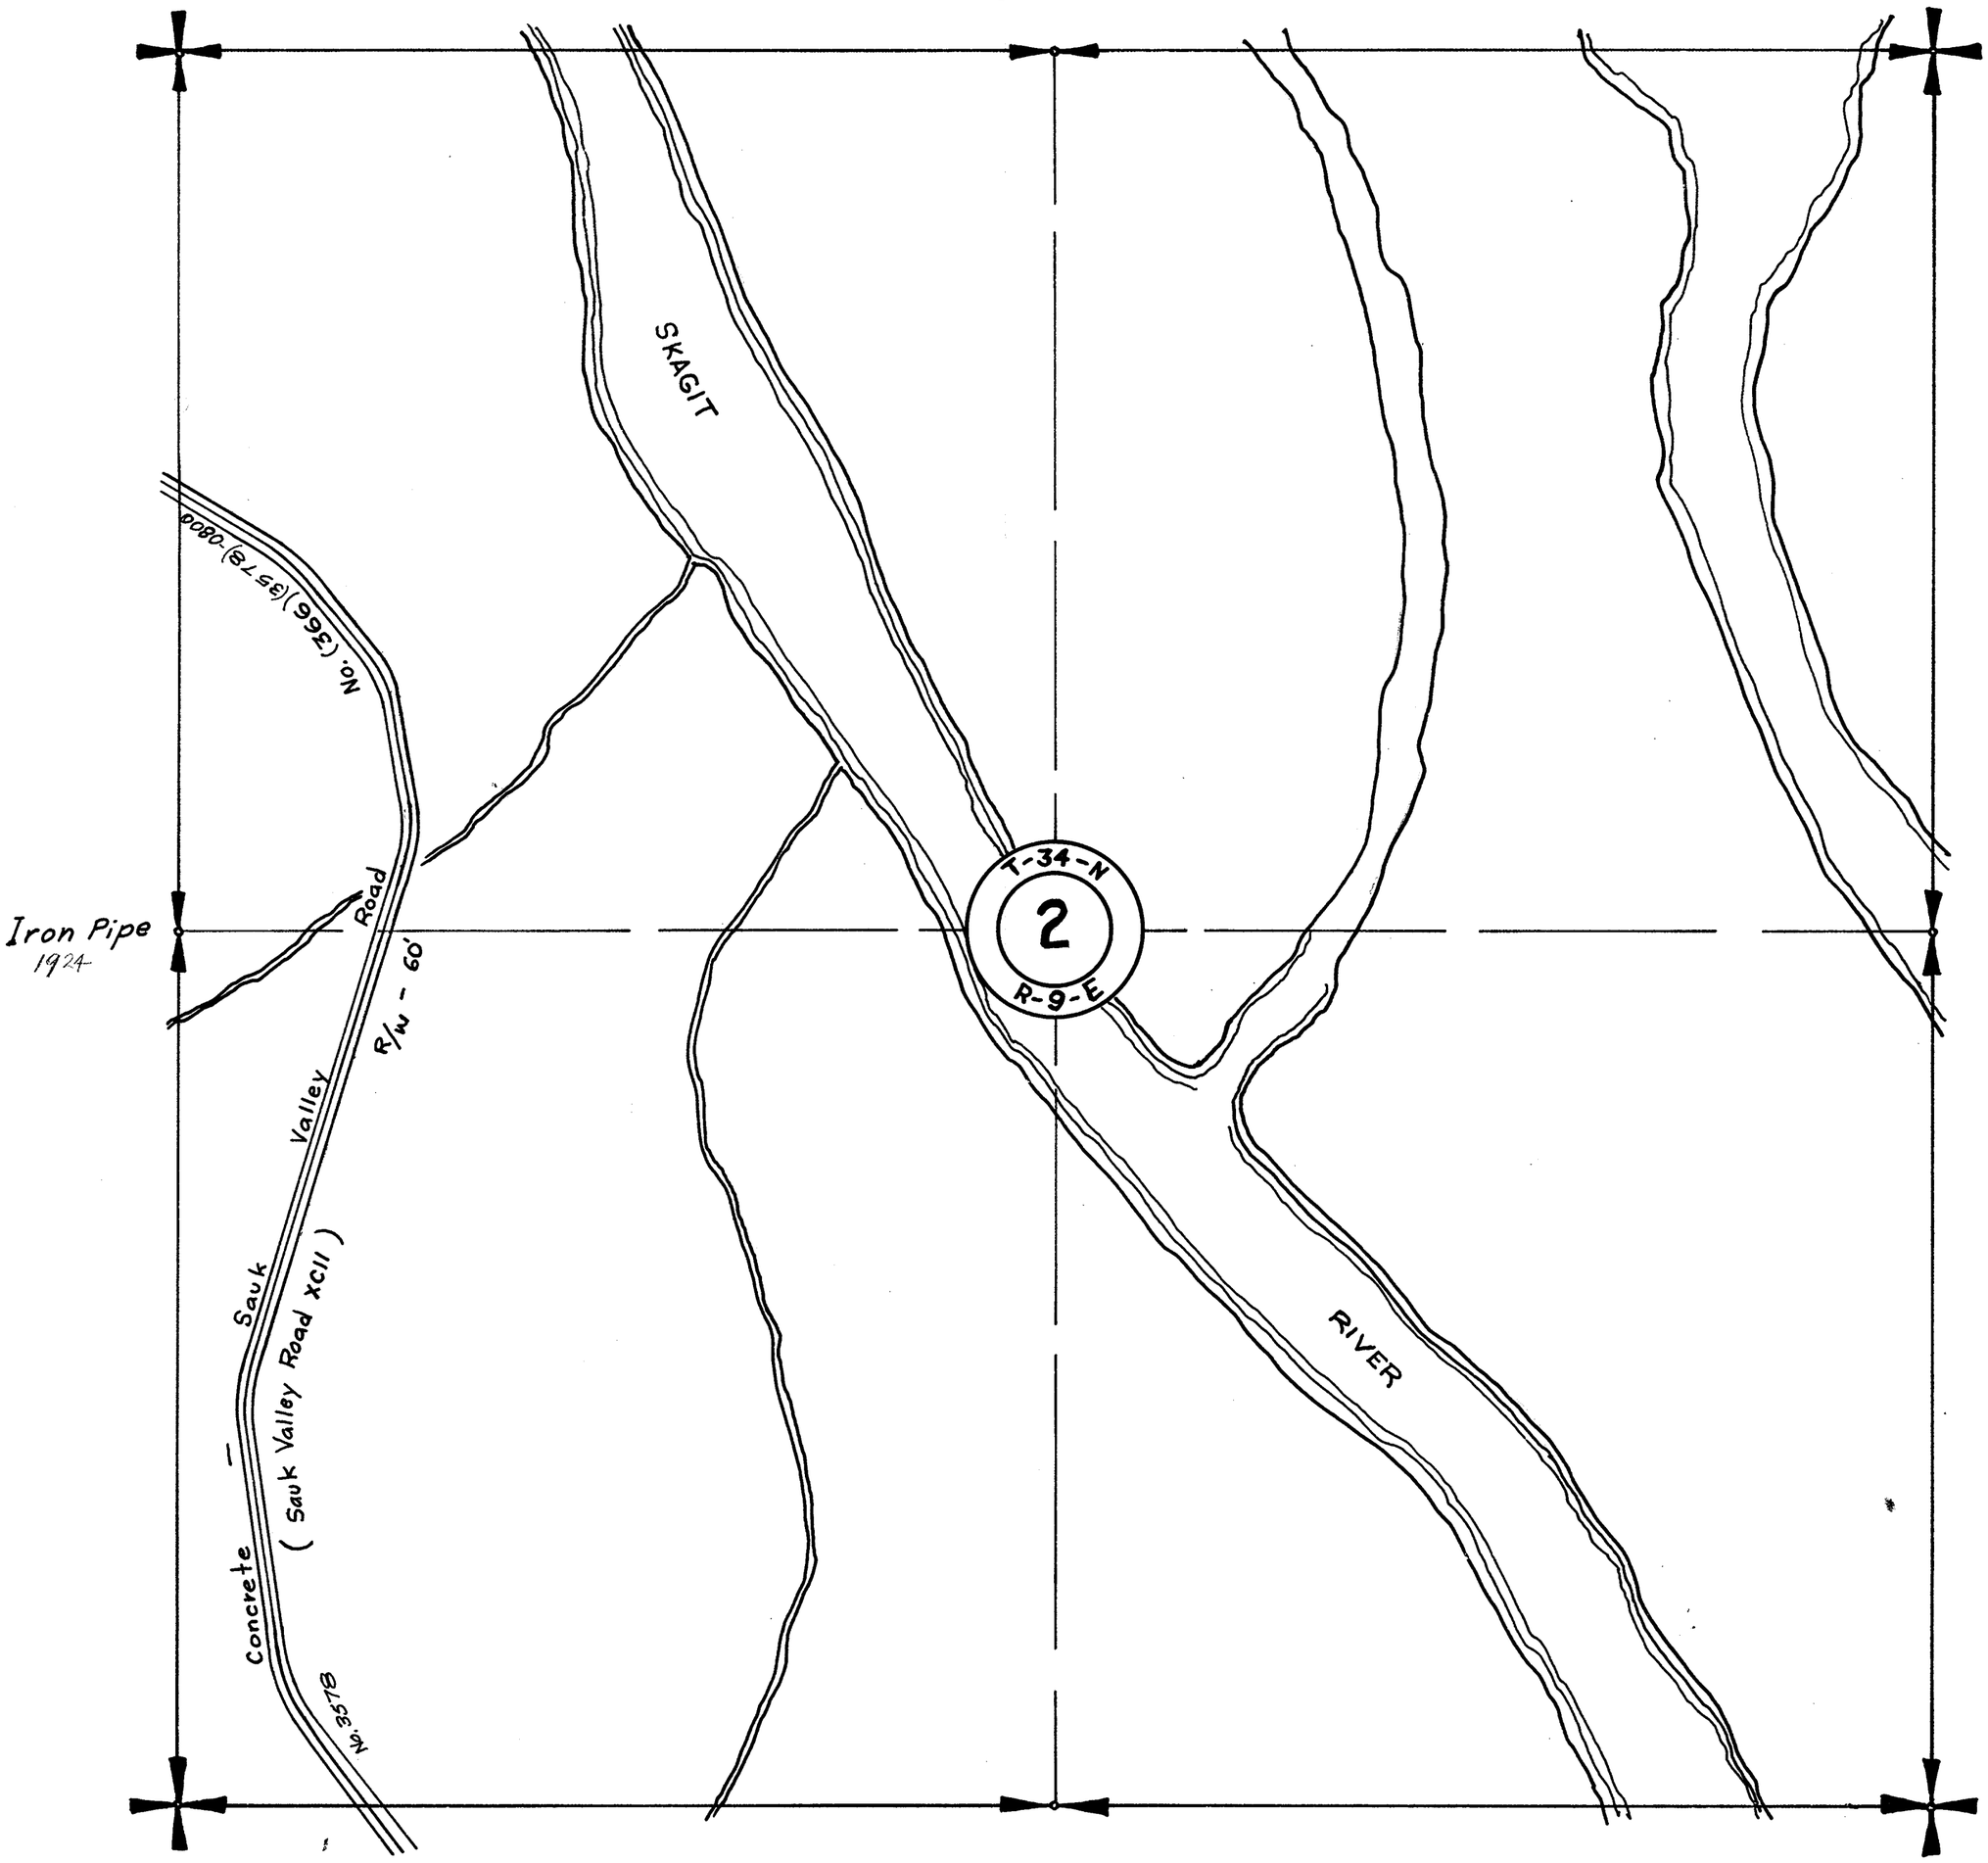

SECTION 11


TOWNSHIP 34 NORTH, RANGE 9 EAST, W. M.

SKAGIT COUNTY, WASH.

SCALE, 1 INCH--400 FEET

DATE Aug. 27, 1963

COUNTY ENGINEER

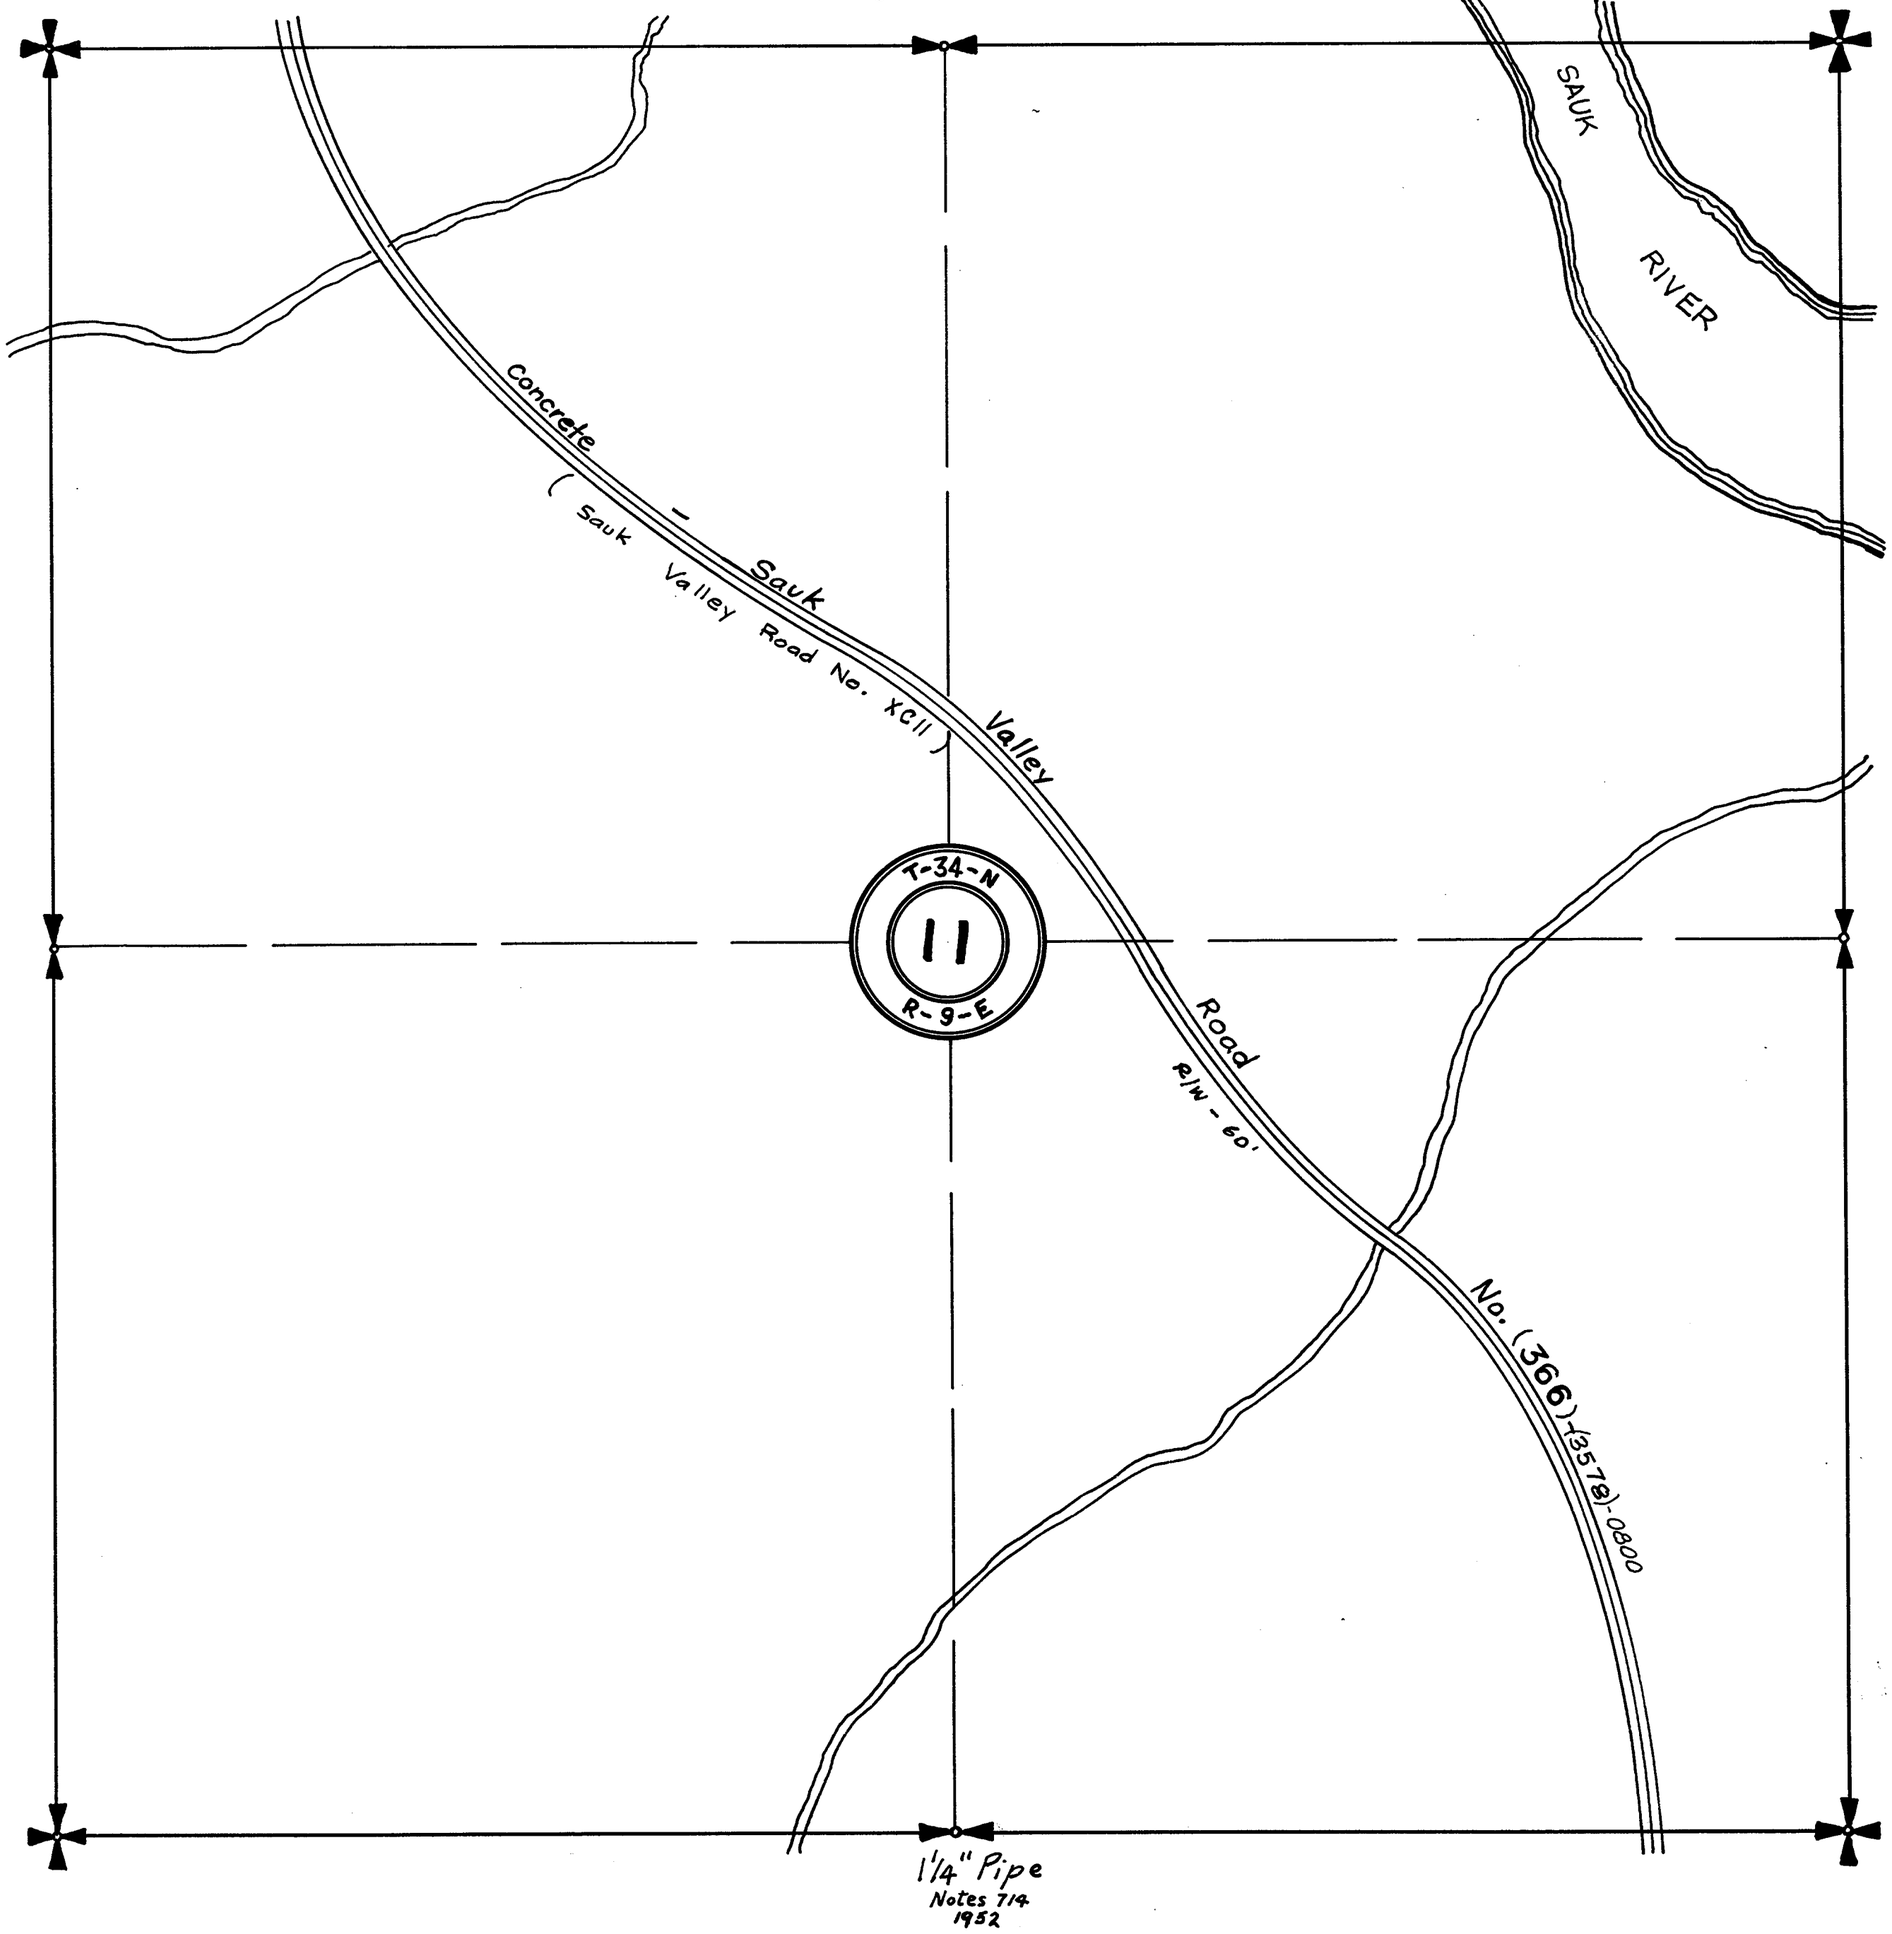


SECTION 12

TOWNSHIP 34 NORTH, RANGE 9 EAST, W. M.

SKAGIT COUNTY, WASH.

SCALE, 1 INCH--400 FEET

H.O. WALBERG COUNTY ENGINEER

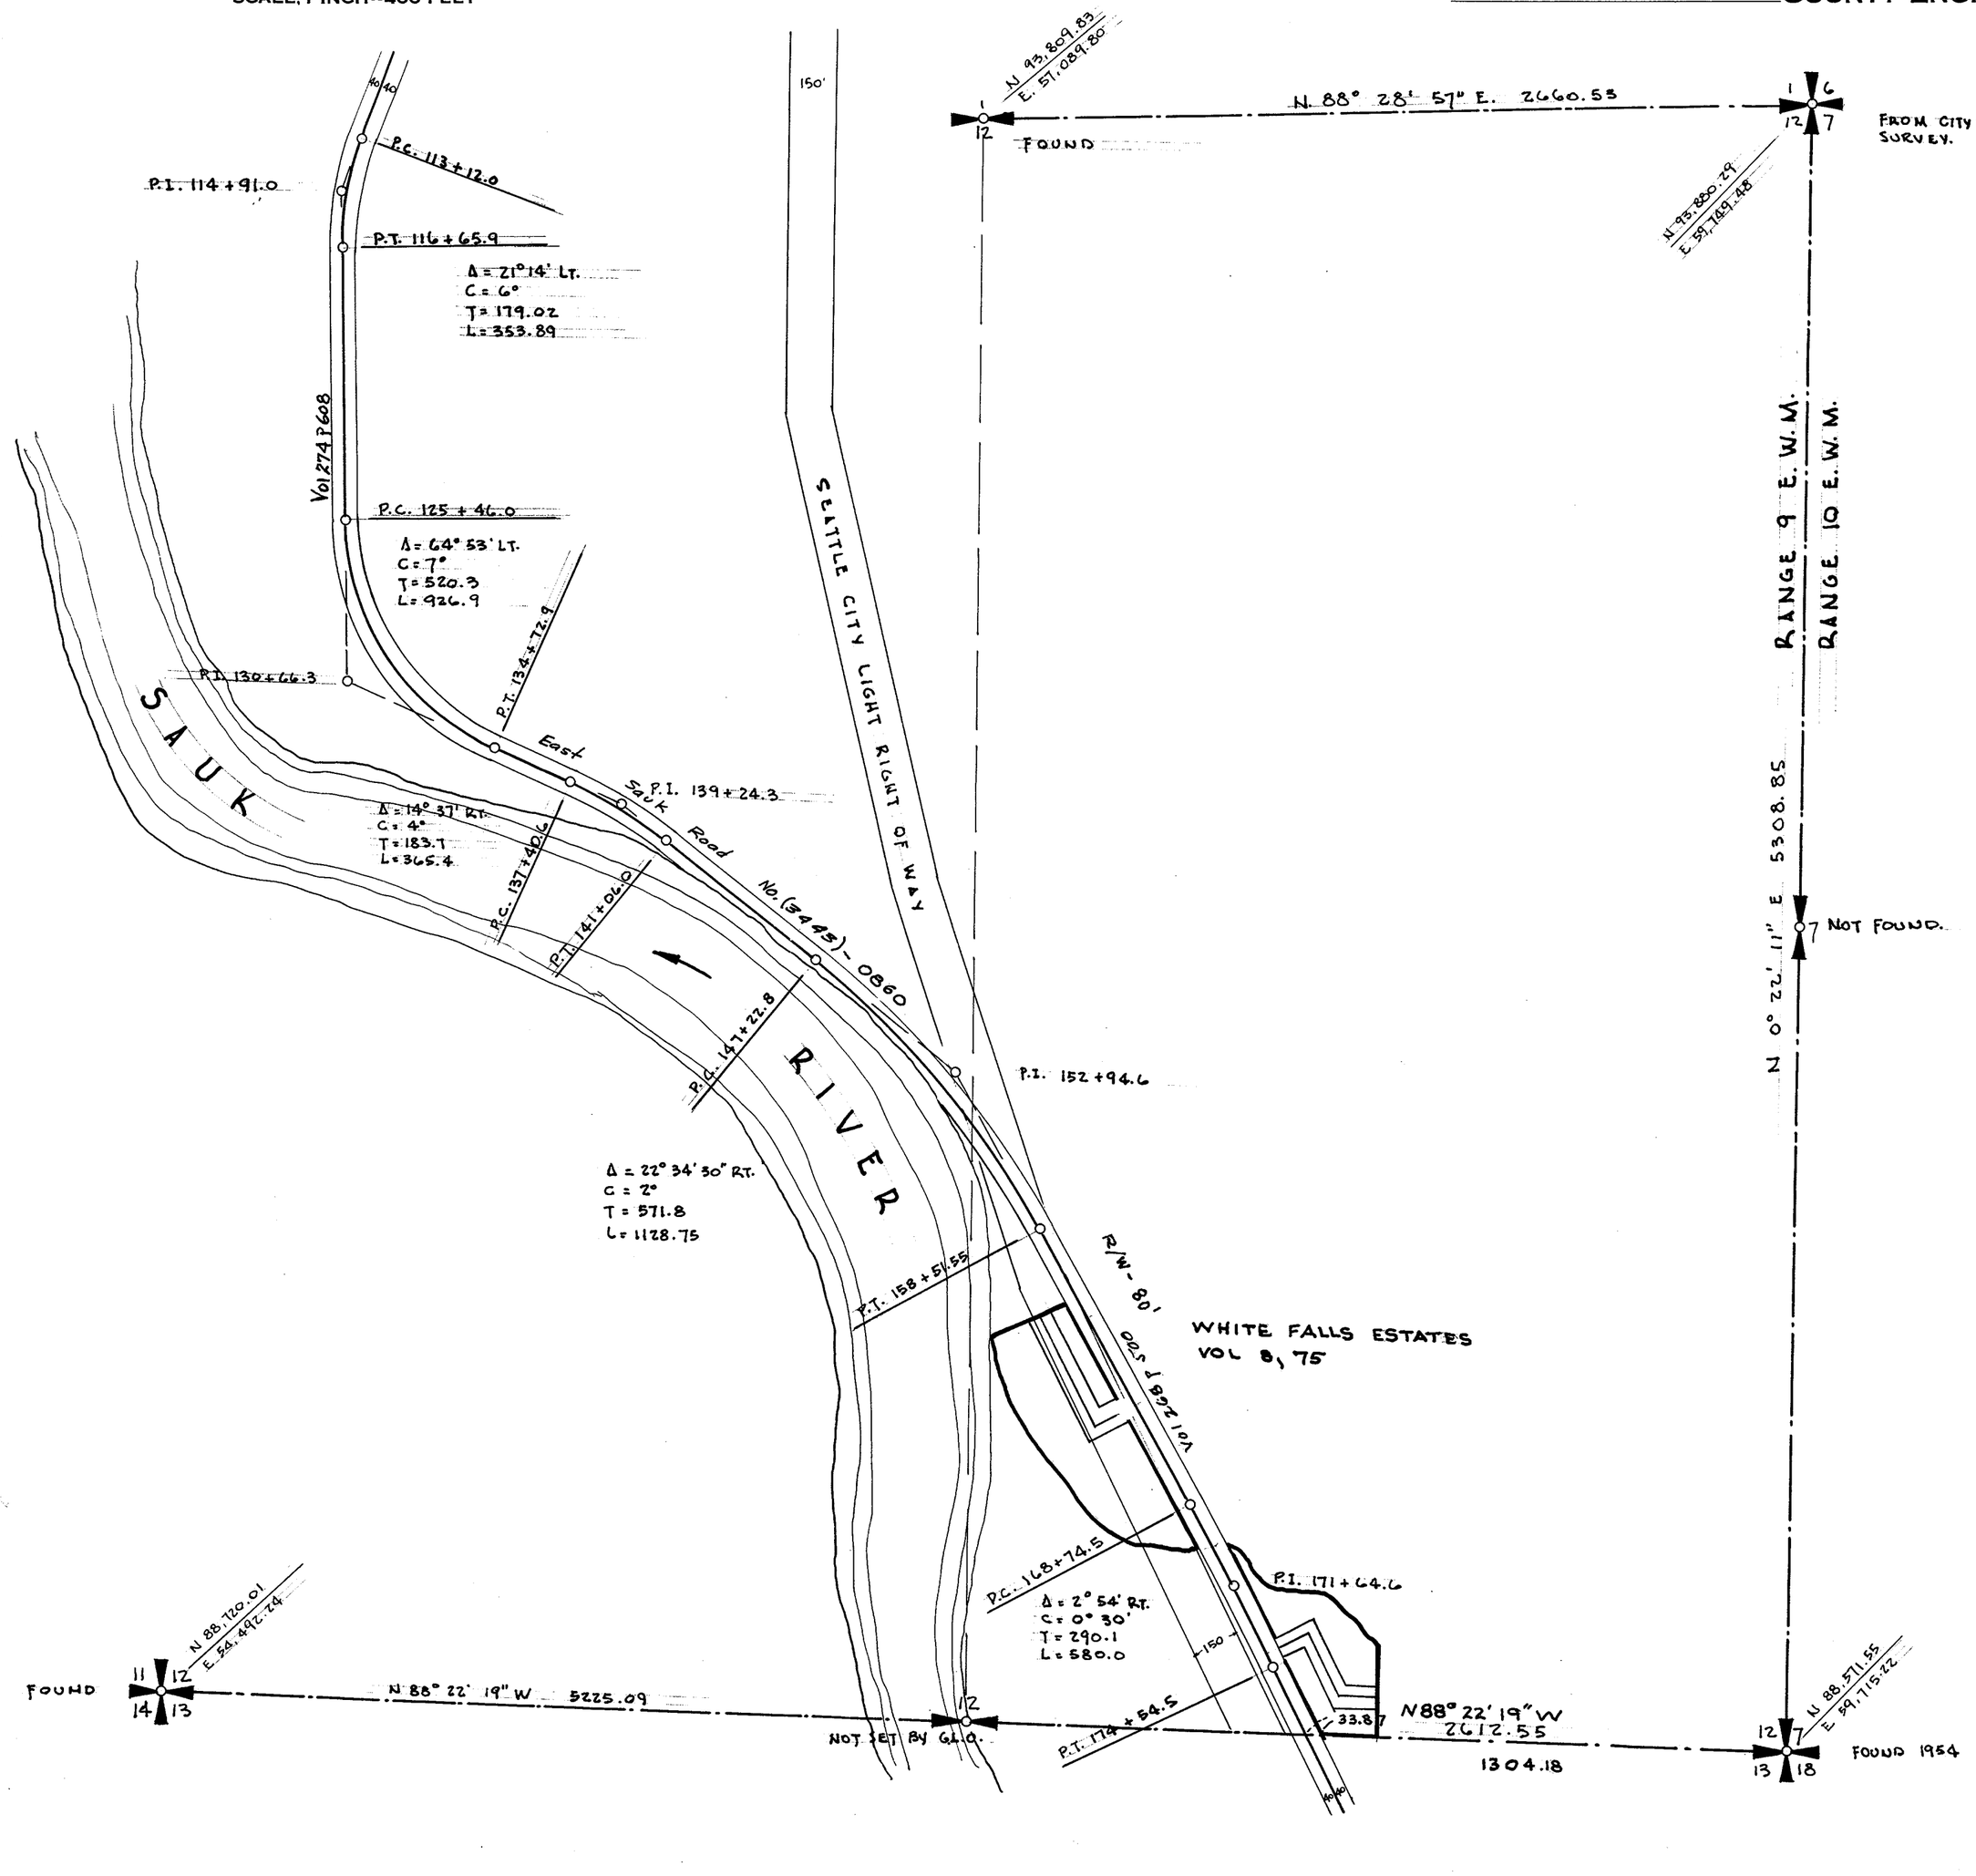


SECTION 13

TOWNSHIP 34 NORTH, RANGE 9 EAST, W. M.

SKAGIT COUNTY, WASH.

SCALE, 1 INCH--400 FEET


H. O. WALBERG COUNTY ENGINEER

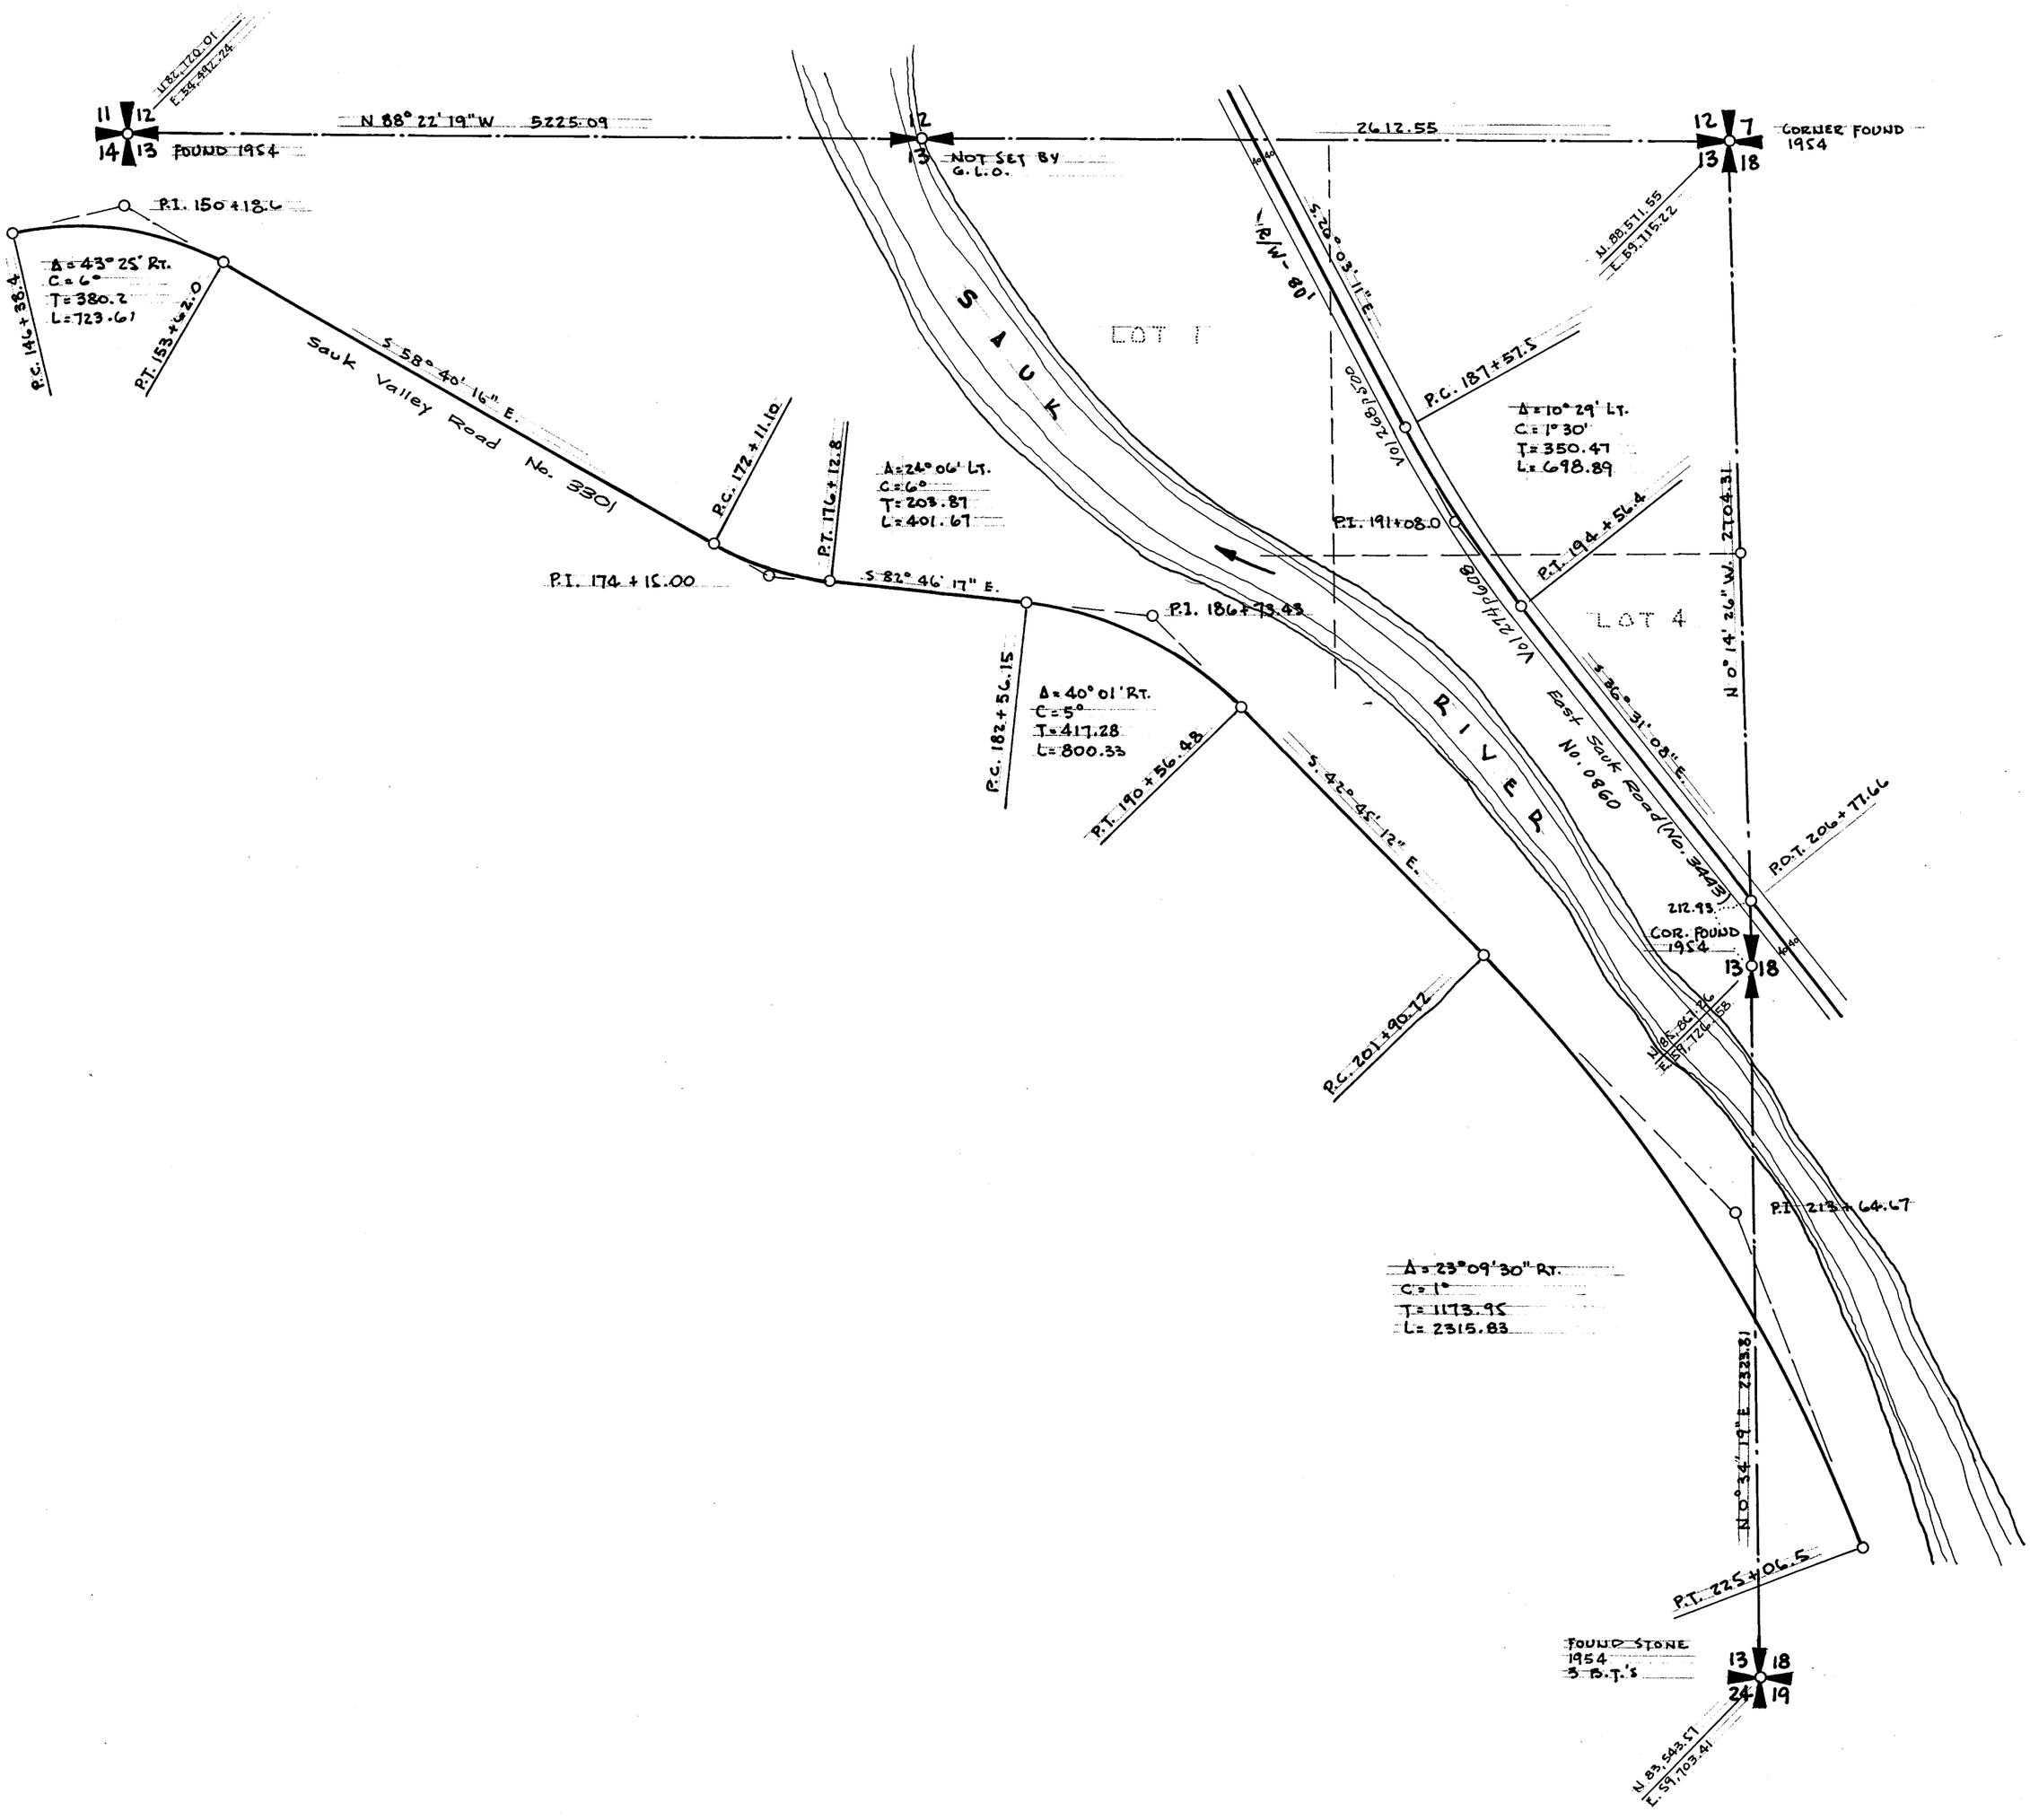

SECTION 13
TOWNSHIP 34 NORTH, RANGE 9 EAST, W. M.
SKAGIT COUNTY, WASH.

SCALE, 1 INCH--400 FEET

DATE _____ _____ COUNTY ENGINEER

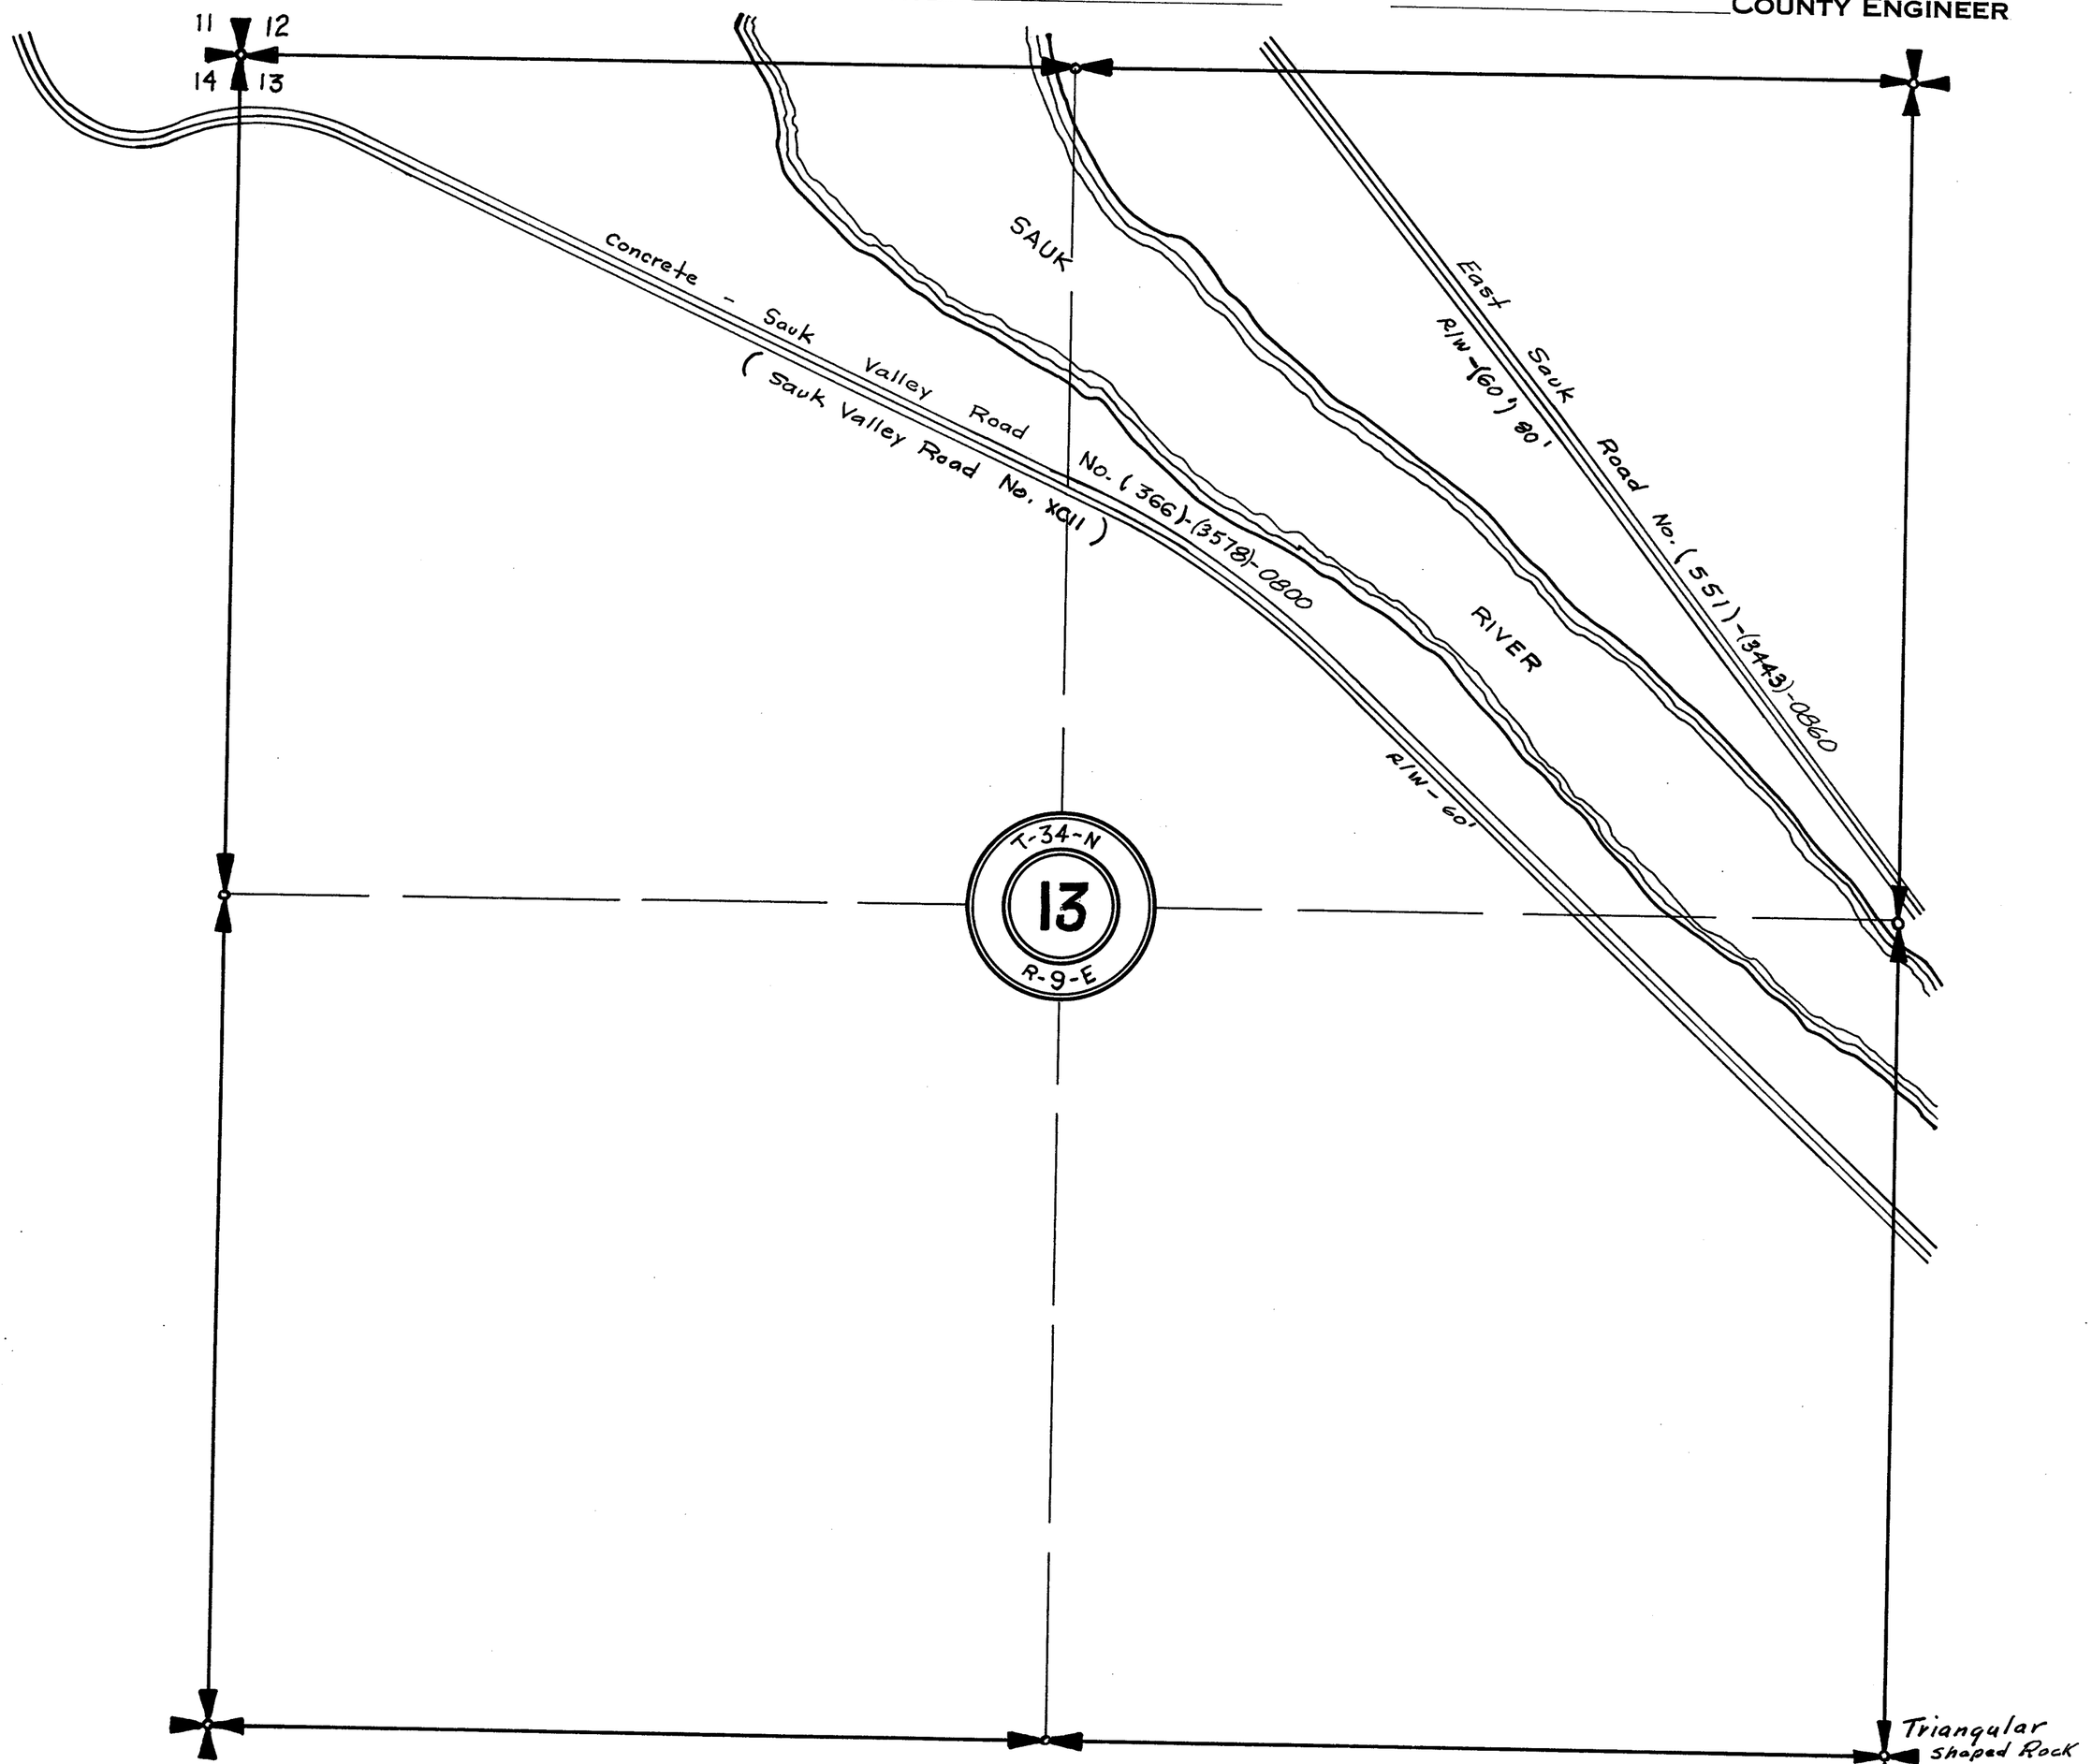

Triangular Shaped Rock Inscribed M-6 W-5
Also 1 1/2" Pipe
Notes 880


SECTION 4

TOWNSHIP 34 NORTH, RANGE 10 EAST, W. M.

SKAGIT COUNTY, WASH.

SCALE, 1 INCH--400 FEET

COUNTY ENGINEER

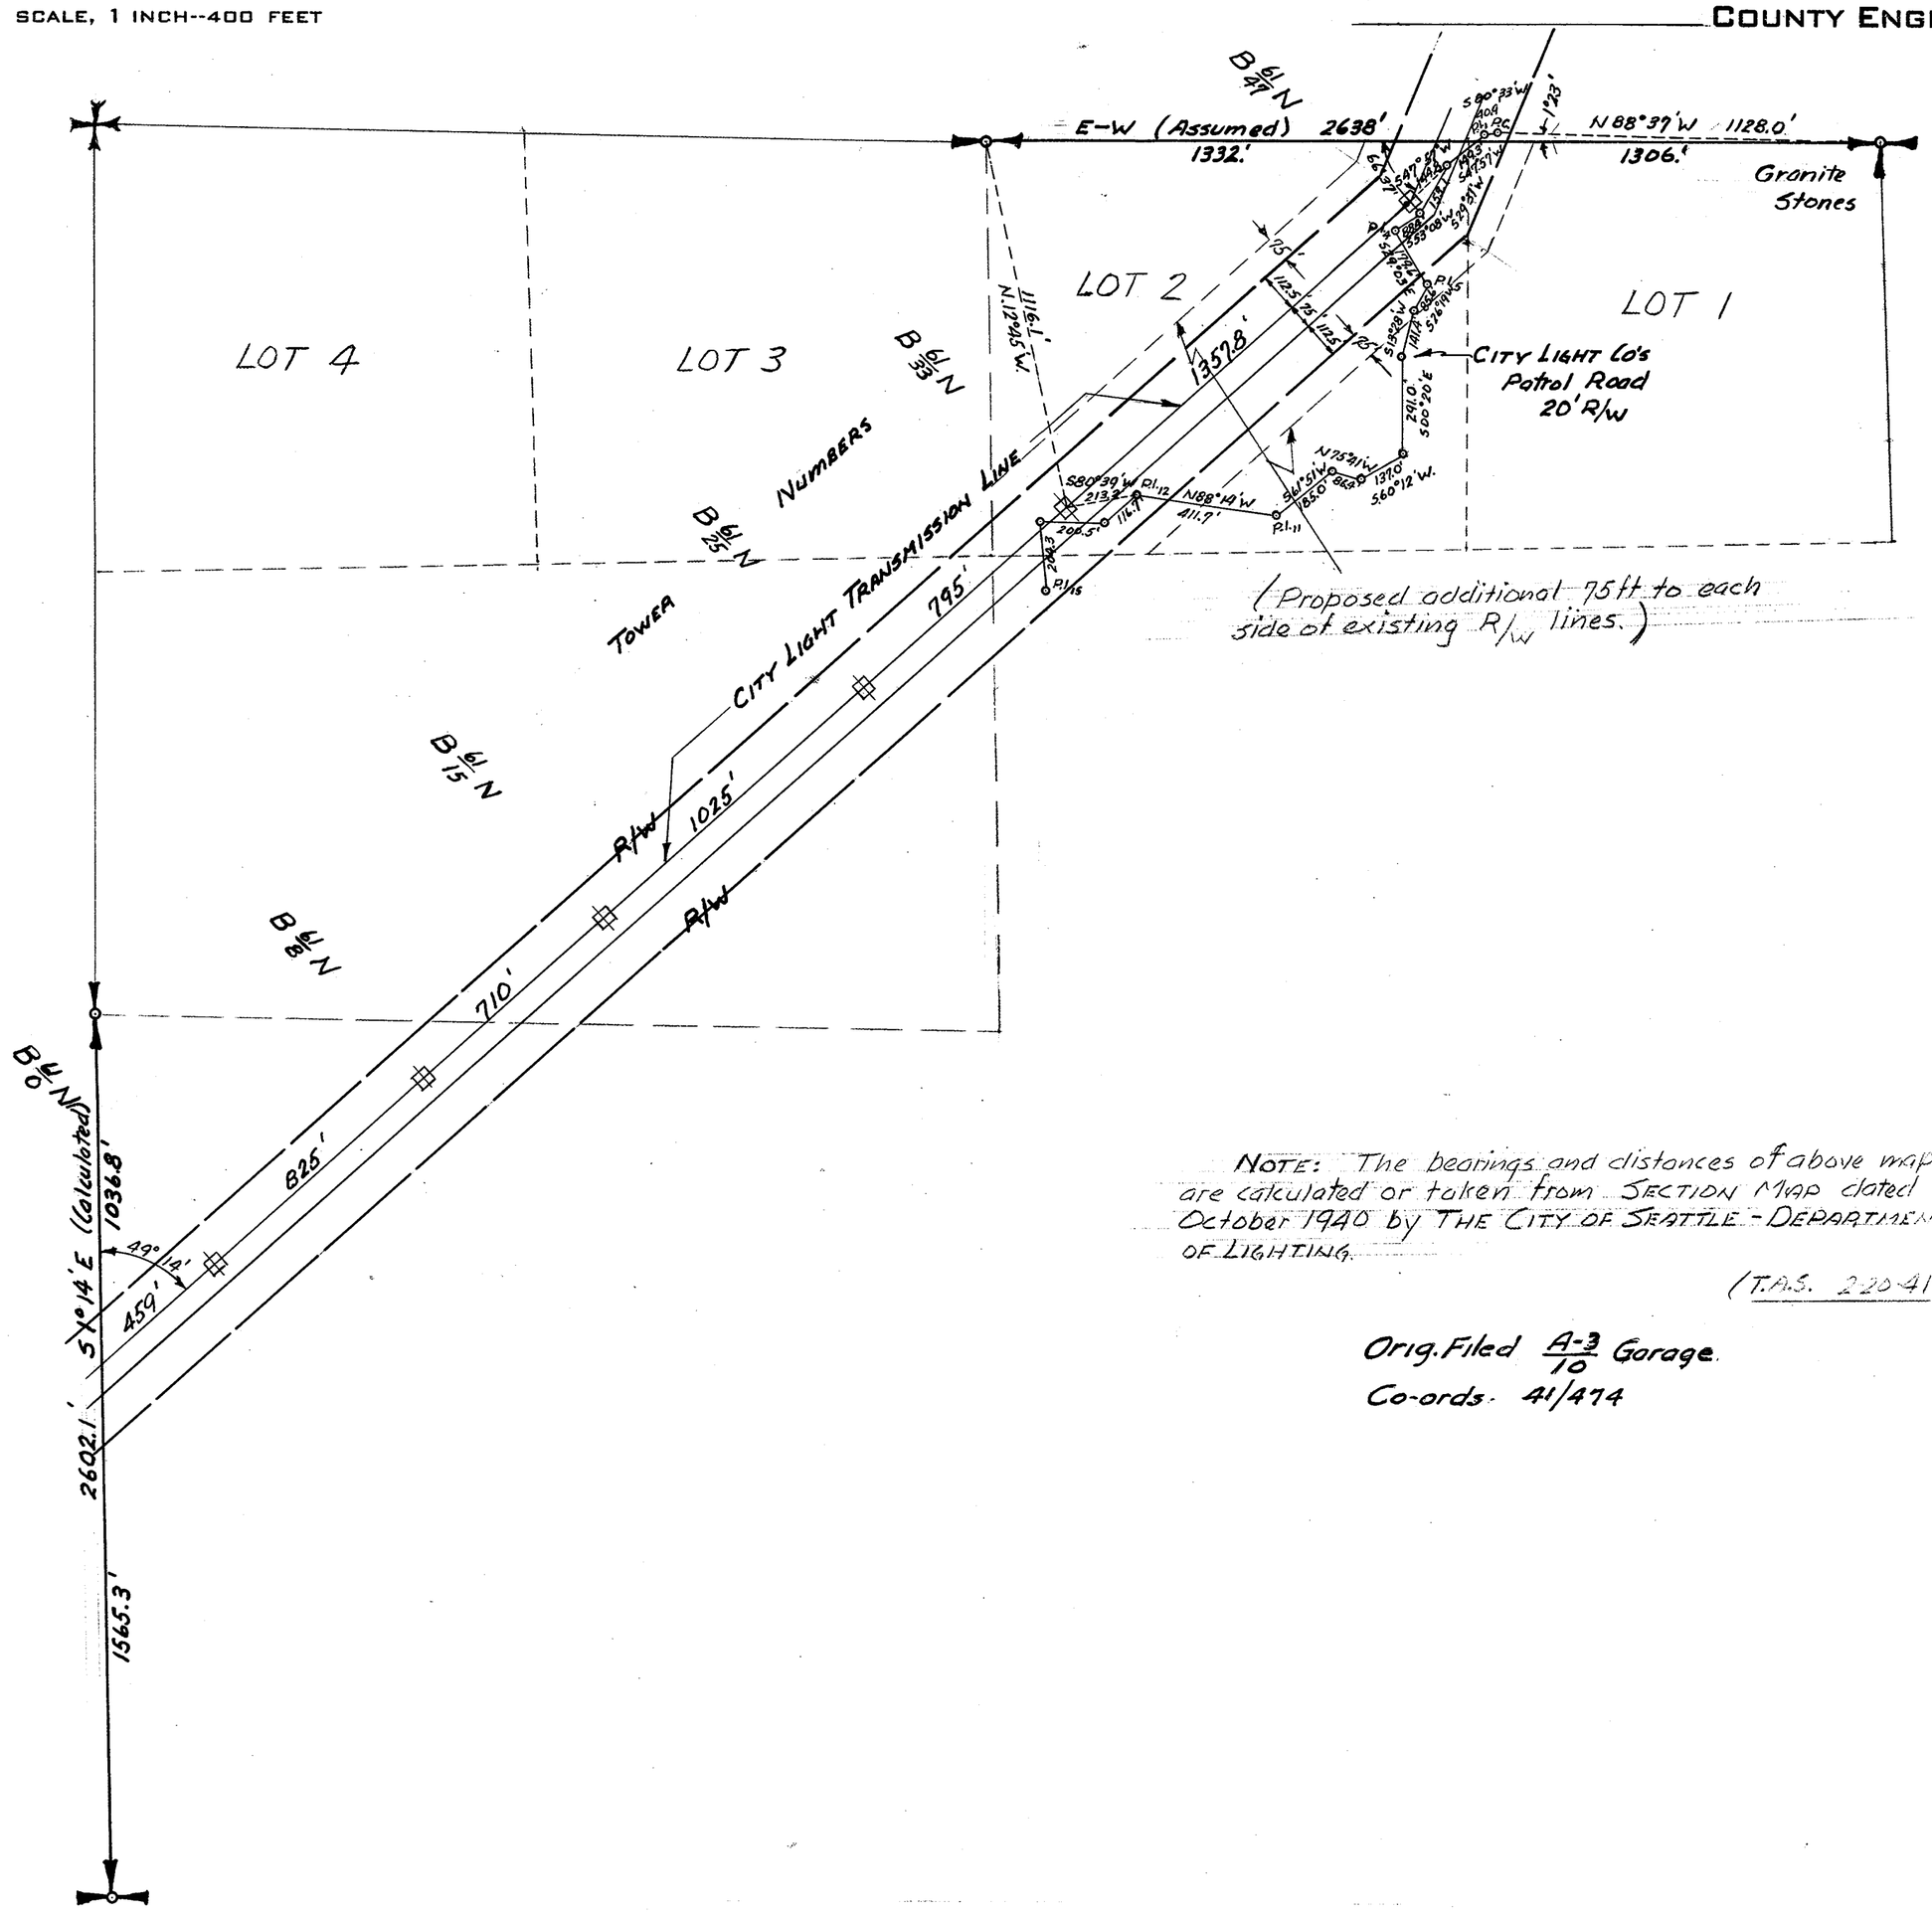

NOTE: The bearings and distances of above map are calculated or taken from SECTION MAP dated October 1940 by THE CITY OF SEATTLE - DEPARTMENT OF LIGHTING.

(T.A.S. 220-41)

Orig. Filed A-3/10 Garage.

Co-ords. 41/474

SECTION 6


TOWNSHIP 34 NORTH, RANGE 10 EAST, W. M.

SKAGIT COUNTY, WASH.

SCALE, 1 INCH--400 FEET

DATE Aug. 26, 1966

Lloyd Johnson COUNTY ENGINEER

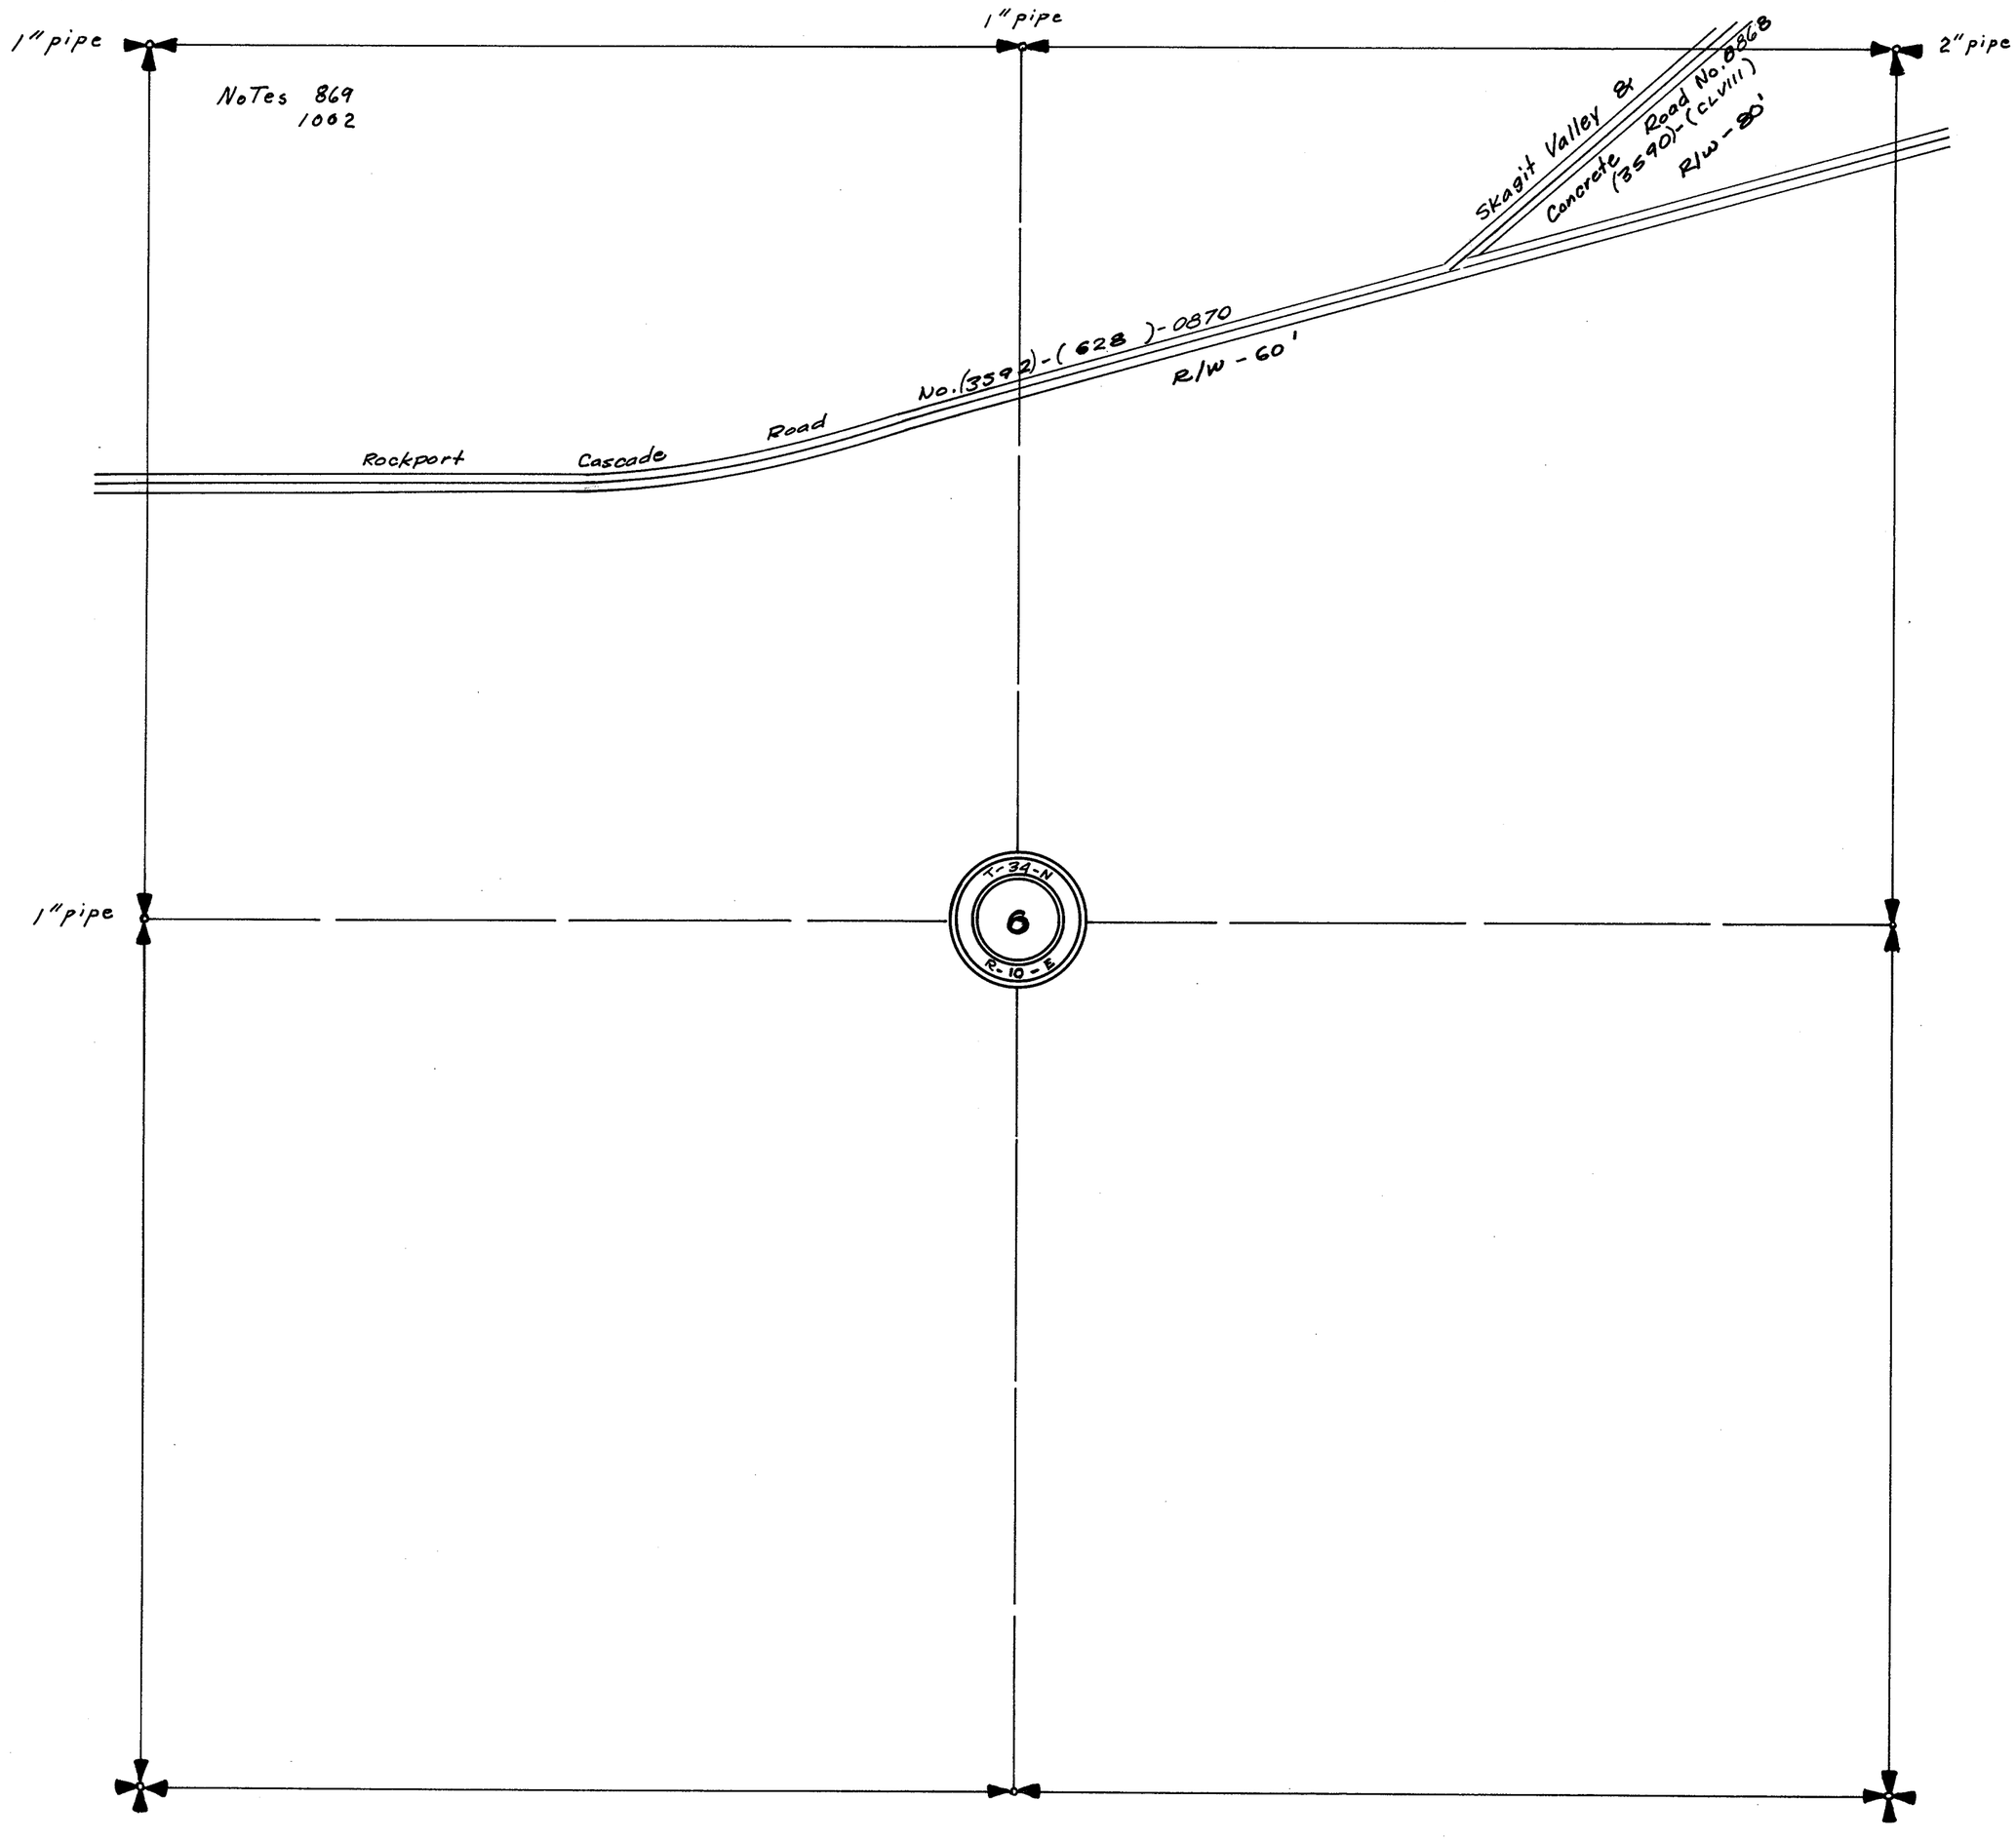


SECTION 18

TOWNSHIP 34 NORTH, RANGE 10 EAST, W. M.

SKAGIT COUNTY, WASH.

SCALE, 1 INCH--400 FEET

H.O. WALBERG COUNTY ENGINEER

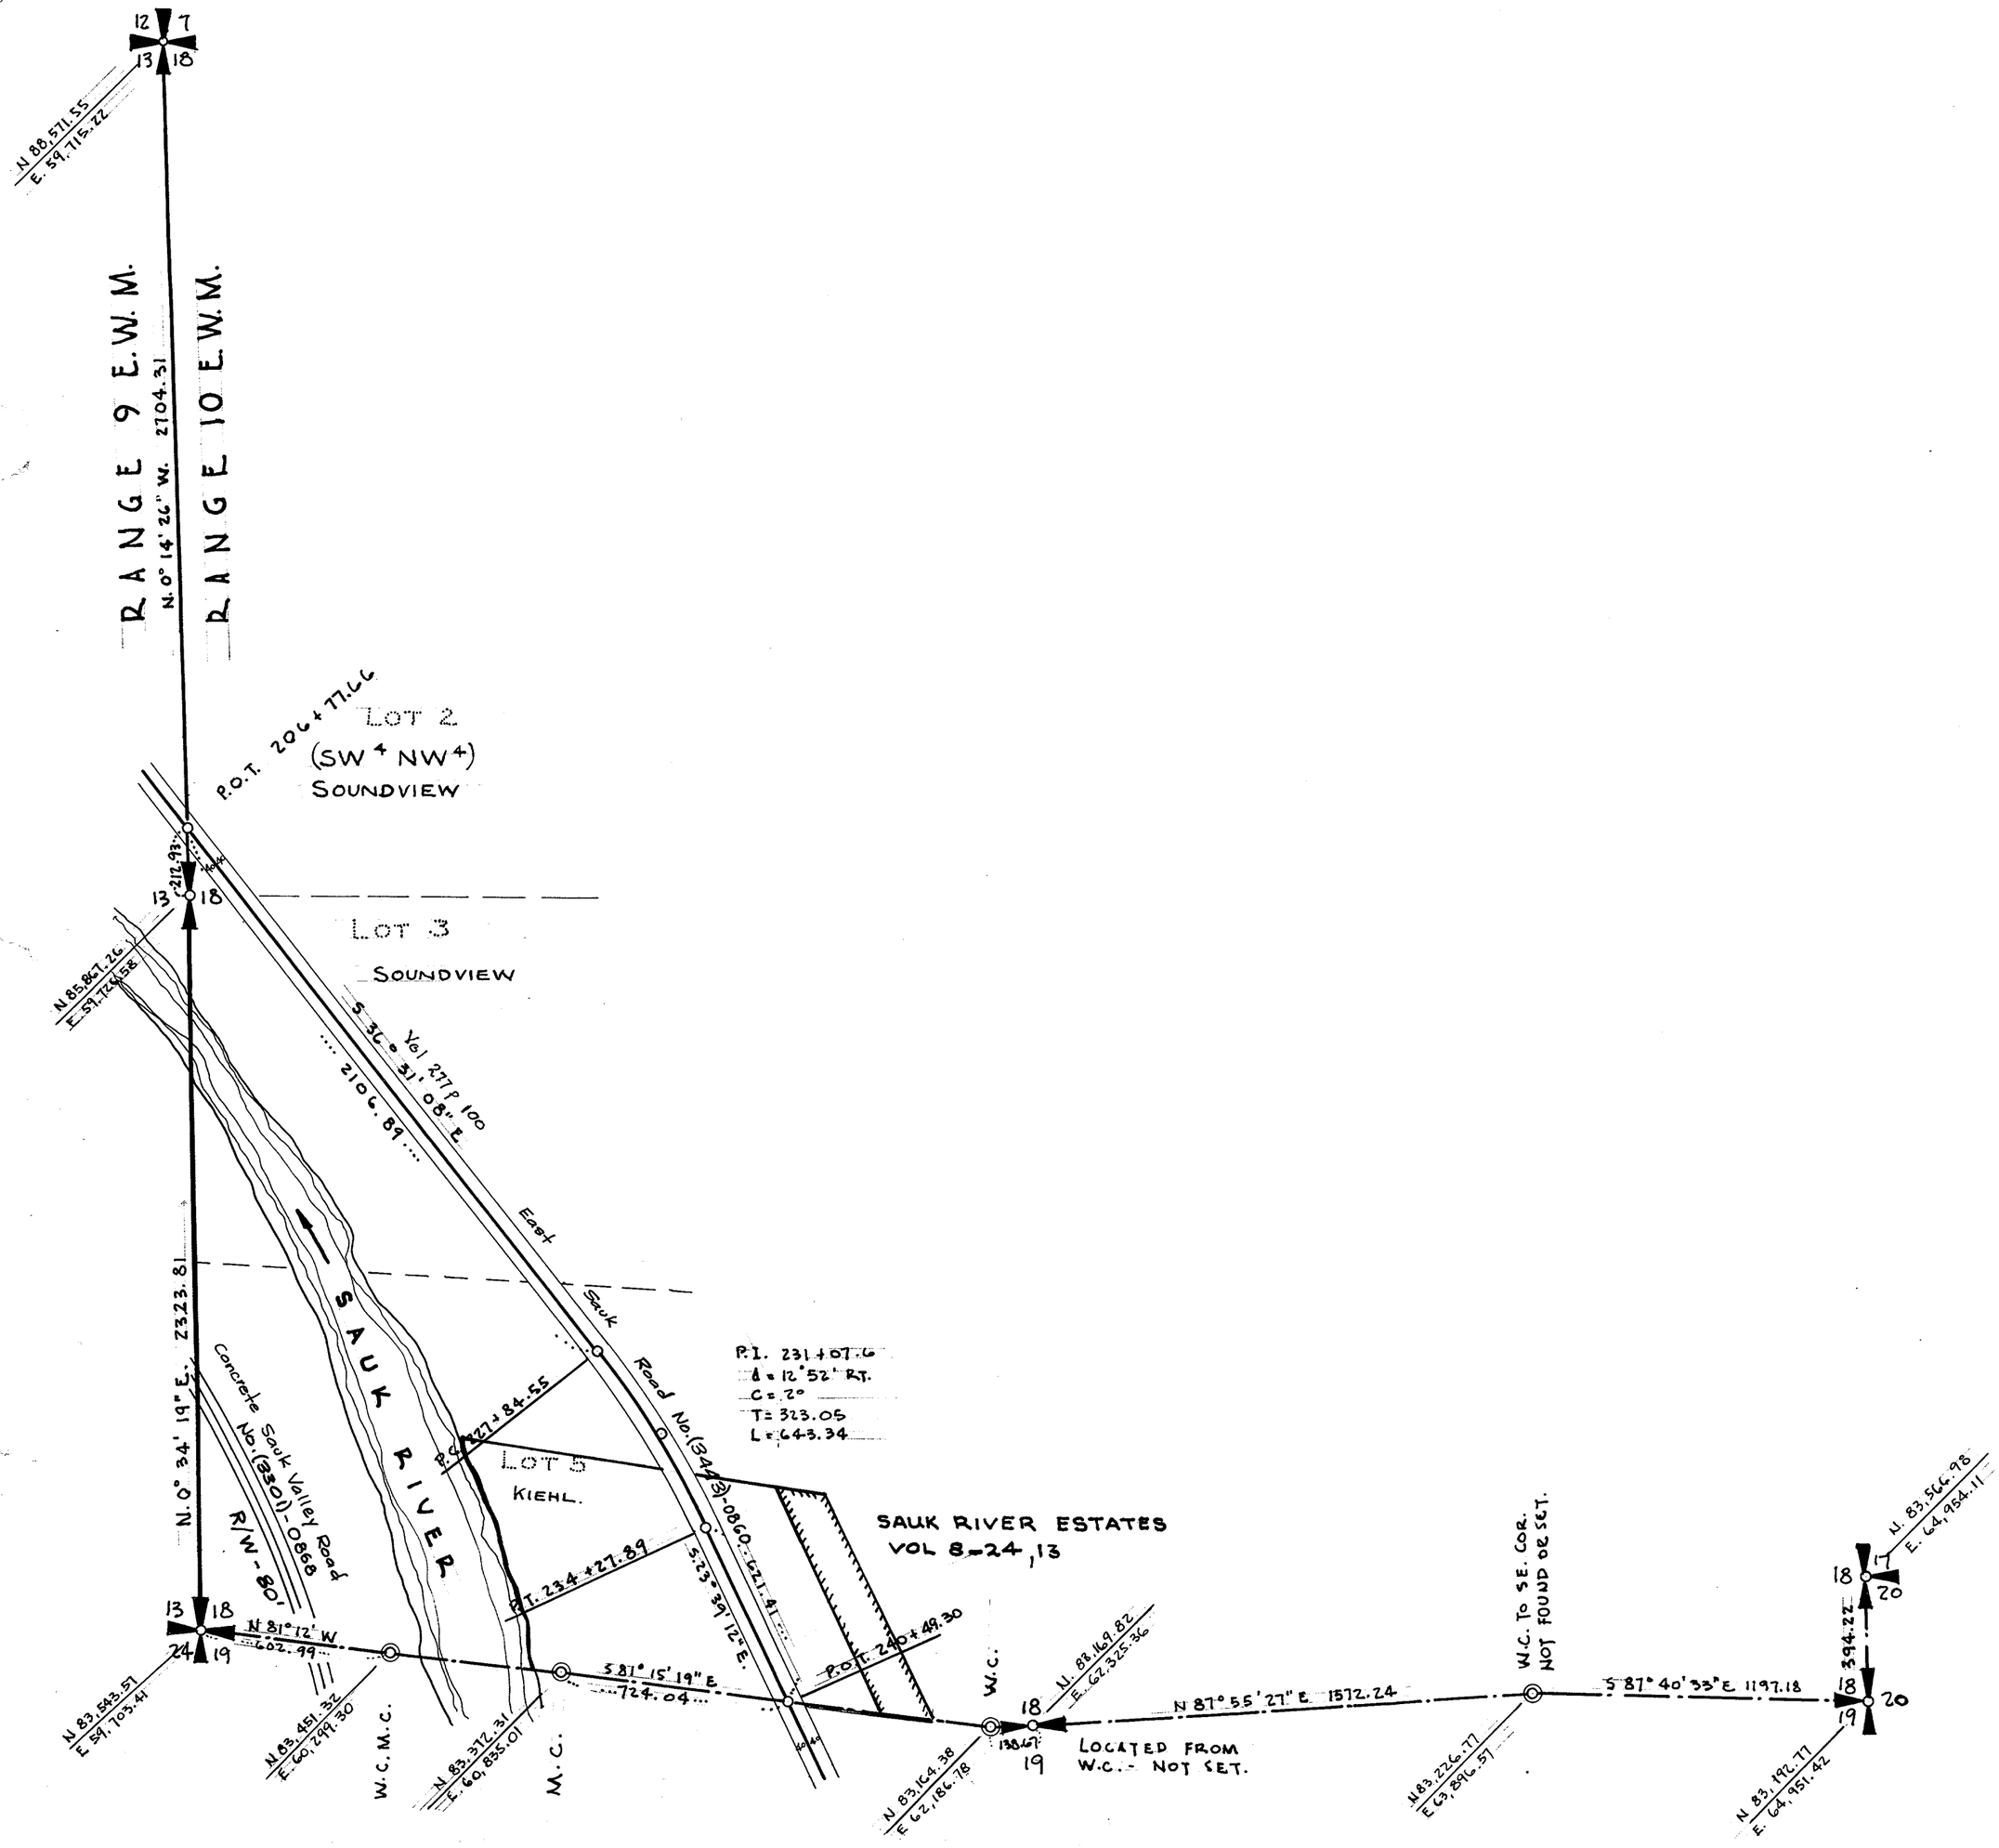


RIGHT OF WAY PLAT

SEC. 19 T. 34N R. 10E. W.M.

SKAGIT COUNTY WASH.

SCALE: 1" = 400'

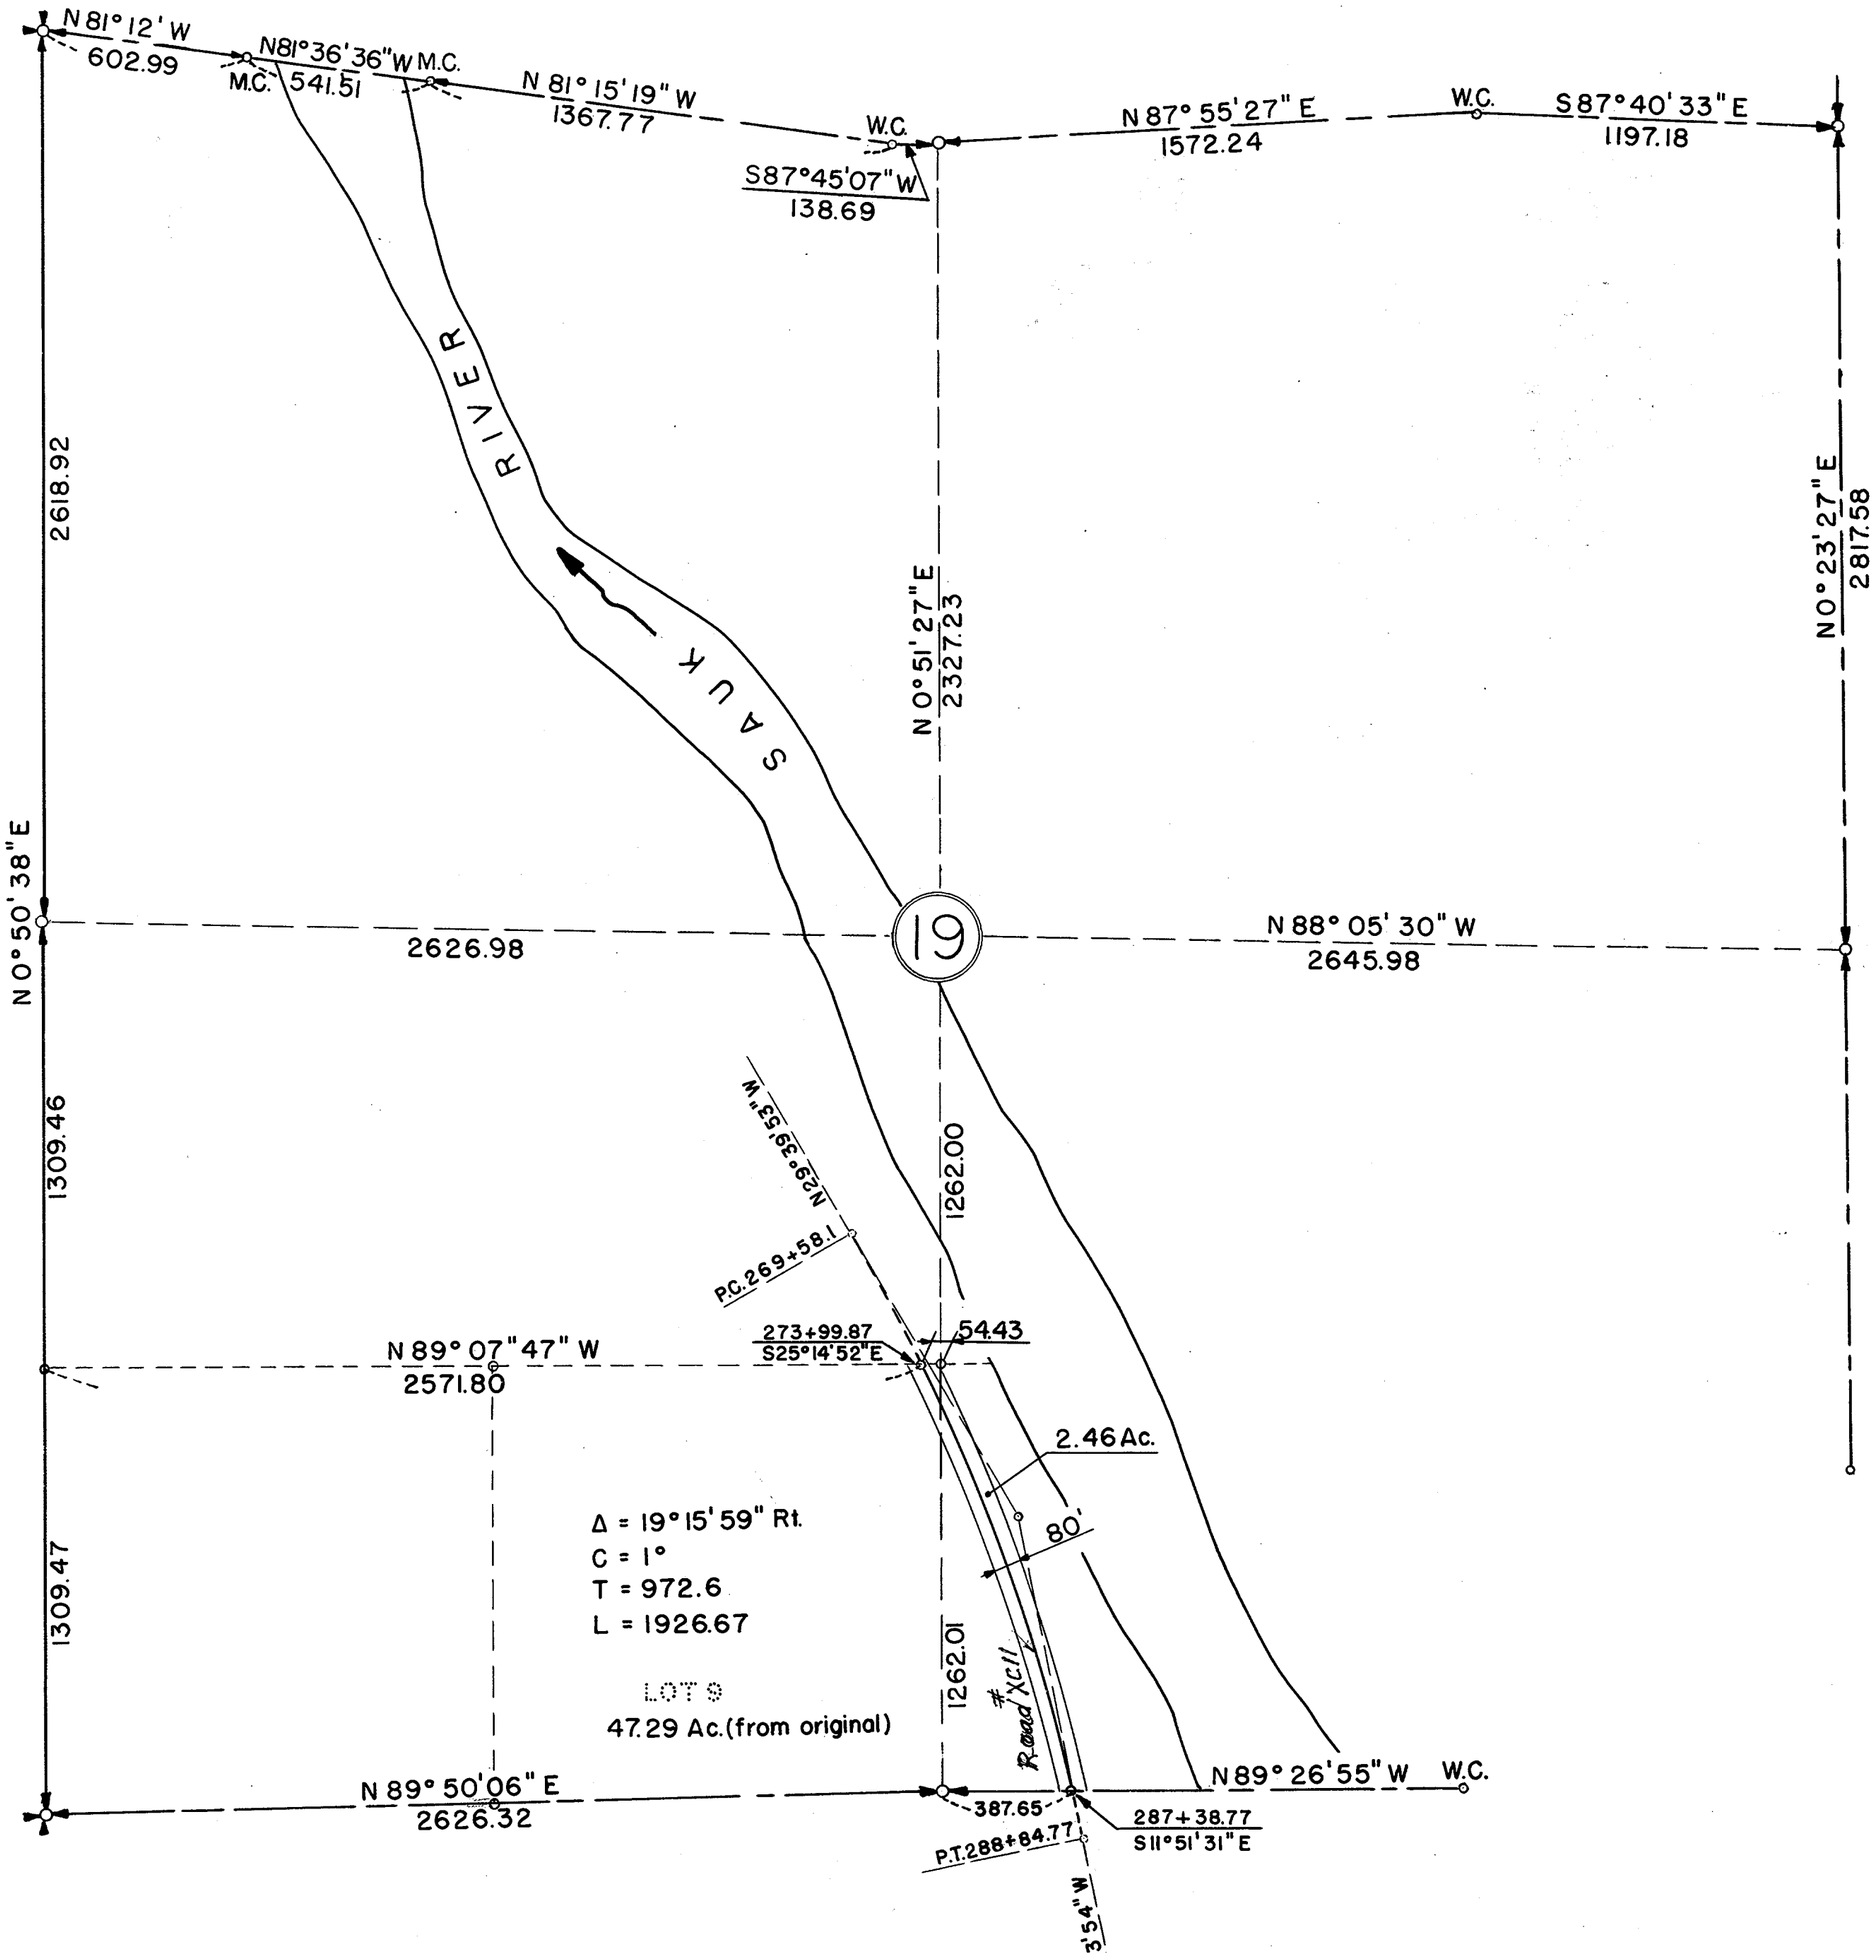

SECTION 19

TOWNSHIP 34 NORTH, RANGE 10 EAST, W. M.

SKAGIT COUNTY, WASH.

SCALE, 1 INCH--400 FEET

H. O. WALBERG COUNTY ENGINEER

STONE FOUND 1954 3 B.T.'s

N 89,543.51 E. 59,703.41

N 82,234.32 E. 59,684.18

N 80,925.06 E. 59,664.85

N 78,306.54 E. 59,626.28

N 89,401.32 E. 60,591.30

N 89,372.31 E. 60,835.01

N 89,164.35 E 62,186.78

N 89,167.82 E. 62,325.36

N 83,226.77 E. 63,896.57

N 83,546.98 E. 64,959.11

N 83,172.77 E 64,951.42

N 80,749.46 E. 64,934.89

N 79,218.72 E 64,928.35

N 78,299.47 E 63,772.51

N 78,048.25 E. 64,899.50

N 78,314.10 E 62,252.60

N 80,887.51 E 62,290.38

P.C. 229+16.1

P.I. 231+71.8
A = 7°39' Lt.
C = 1°30'
T = 255.4
L = 510.0

P.T. 234+26.1

P.O.T. 240+49.30

S 81° 15' 19" E
724.04

N 81° 12' 00" W
602.99

W.C.M.C.

M.C.

SAUK RIVER ESTATES
VOL 8-24

W.C. 1/4 COR.

N 87° 55' 27" E
1572.24

S 87° 40' 33" E.
1197.18

W.C. TO N.E. COR. NOT FOUND OR SET.

394.22

1386.7

1163.74

452.02

P.O.T. 259+19.62

N 0° 23' 27" E.
2423.51

N 0° 00' 58" E. 5237.85

RANGE 9 E.W.M.

RANGE 10 E.W.M.

P.C. 243+30.0

P.I. 245+20.4

A = 5°42' 30" Rt.
C = 1° 30'
T = 190.43
L = 380.55

P.T. 247+10.50

P.C. 249+61.53

P.I. 251+91.0
A = 8°07' 30" Lt.
C = 2°
T = 203.47
L = 406.25

P.T. 253+93.78

N 0°51' 27" E
2327.23

East Sauk Road No. (3443)-0860
S. 23° 39' 12" E.

Vol 274 Pg 14

2626.98

S 88° 05' 30" E
2645.98

Concrete Sauk Valley Road No. (3301)-0800

S 29° 39' 01" E.

P.C. 269+58.1

2618.93

SAUK RIVER

P.I. 279+30.7

Δ = 19° 10' Rt.
C = 1°
T = 972.6
L = 1926.67

P.C. 292+46.0

P.I. 294+48.0
Δ = 16° 03' Rt.
C = 4°
T = 201.95
L = 401.25

P.T. 296+47.3

P.T. 288+84.77

W.C. TO S.E. COR.



LOT 1

LOT 2

LOT 3

LOT 4














SECTION 30
TOWNSHIP 34 NORTH, RANGE 10 EAST, W. M.
SKAGIT COUNTY, WASH.

SCALE, 1 INCH--400 FEET

H.O. WALBERG COUNTY ENGINEER

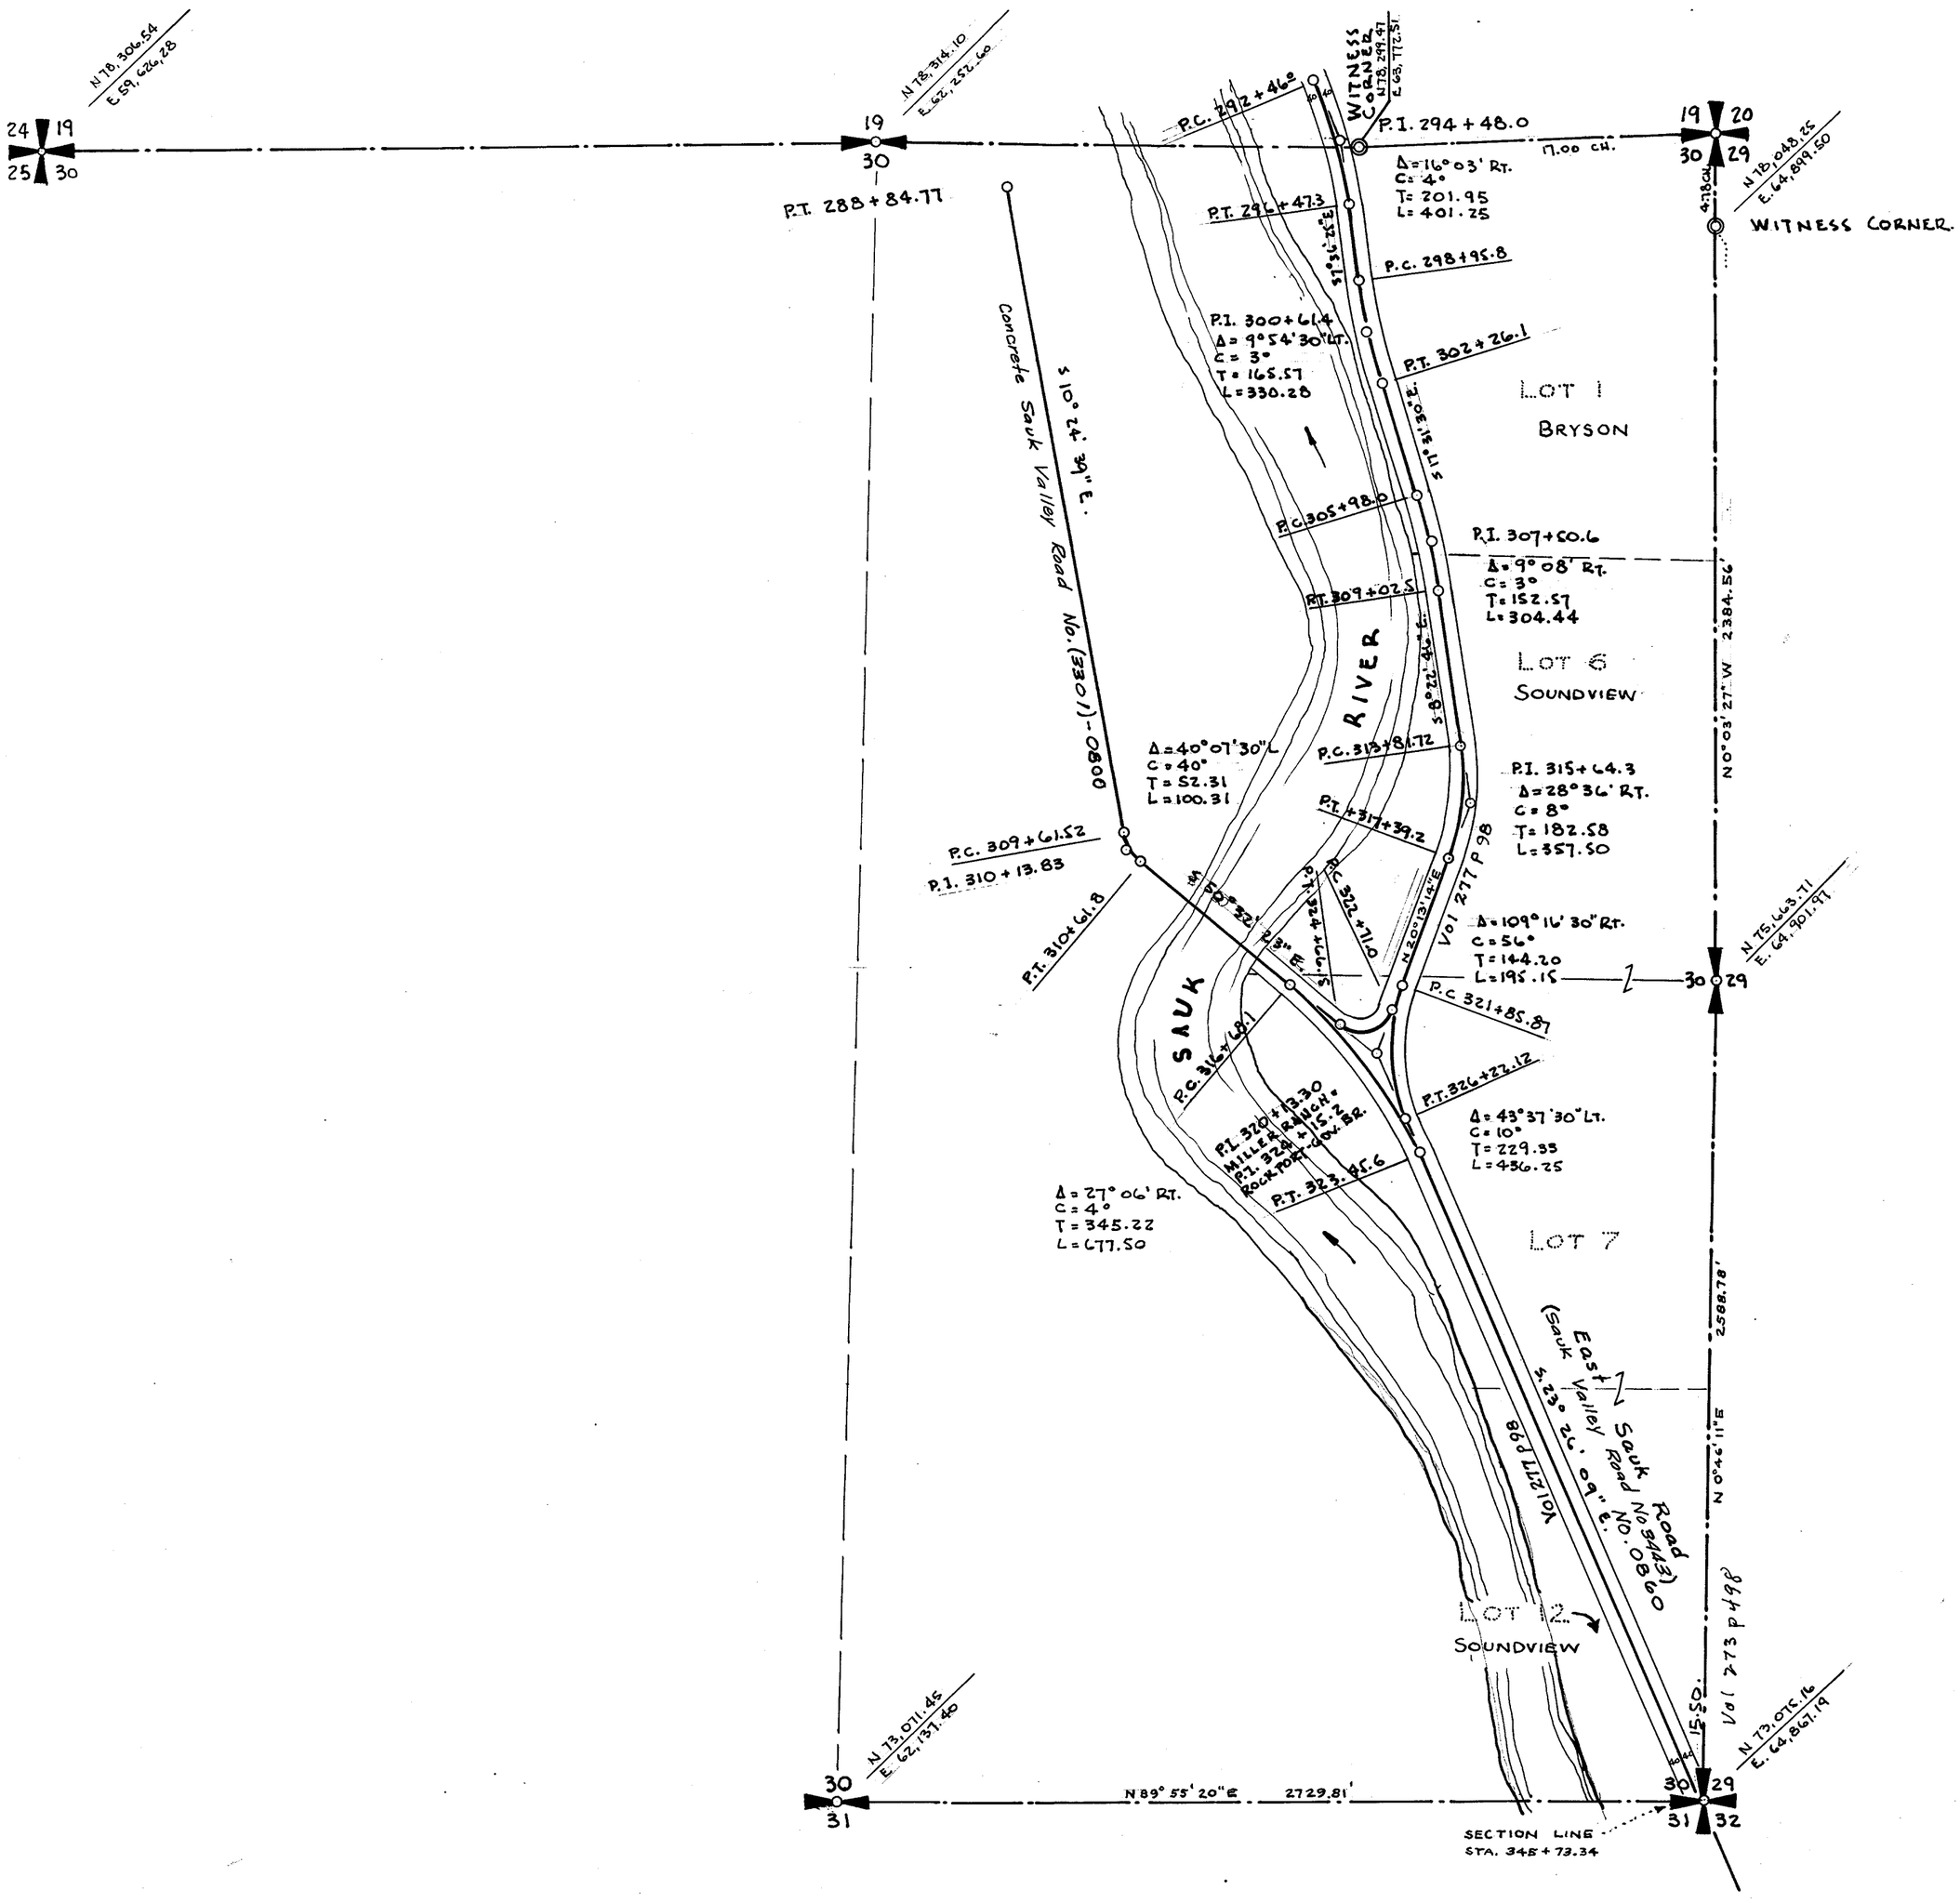

SECTION 31
TOWNSHIP 34 NORTH, RANGE 10 EAST, W. M.
SKAGIT COUNTY, WASH.

SCALE, 1 INCH--400 FEET

H. O. WALBERG COUNTY ENGINEER

N 73,011.45
E 62,137.40

30
31

N 89° 55' 20" E 2729.81'

N 73,075.16
E 64,867.19

29
32

345+73.34

37.49

LOT 1

LOT 1
SOUNDVIEW

S 23° 22' 09" E

Δ = 16° 57' 20" RT.
C = 5°
T = 170.85
L = 339.17

P.C. 351+81.85

P.I. 353+58.7

P.T. 355+27.021

2674.58'

S 6° 28' 53" E

LOT 2

Δ = 6° 52' RT.
C = 3°
T = 114.57
L = 228.89.

P.C. 364+04.33

P.I 365+18.9

P.T. 366+33.22

East Sauk Road No. 0860
(Sauk Valley Road No. 3443)

IN RIVER. WAS NEVER SET.

31 32

N 47° 22' 05" W

Δ = 40° 13' RT.
C = 6°
T = 349.63
L = 670.28

P.C. 371+99.4

LOT 3

P.T. 384+69.7

P.I. 381+49.0

Note: This Road Drawn From An Aerial Photo - Not to Scale....

SAUK RIVER

P.C.T. 388+68.89

LOT 6

LOT 12

SOUNDVIEW

SOUNDVIEW

S 40° 35' 27" W

N 0° 59' 00" E 3349.16

1273.69'

Δ = 60° 43' 40" LT.
C = 5°
T = 671.38
L = 1214.55

N 67,801.80
E 59,426.78

36 31
1 6

N 89° 40' 33" W 2616.54

N 67,793.85
E 62,043.31

31
6

N 88° 35' 38" W 2732.89'

N 67,726.79
E 64,779.38

P.C. 401+06.7

973.38

31 32
6 5

P.I. 407+78.08

P.C. 404+51.34


SECTION 1

TOWNSHIP 35 NORTH, RANGE 1 EAST, W. M.

SKAGIT COUNTY, WASH.

SCALE, 1 INCH--400 FEET

G. D. LeGro
July 1958
COUNTY ENGINEER

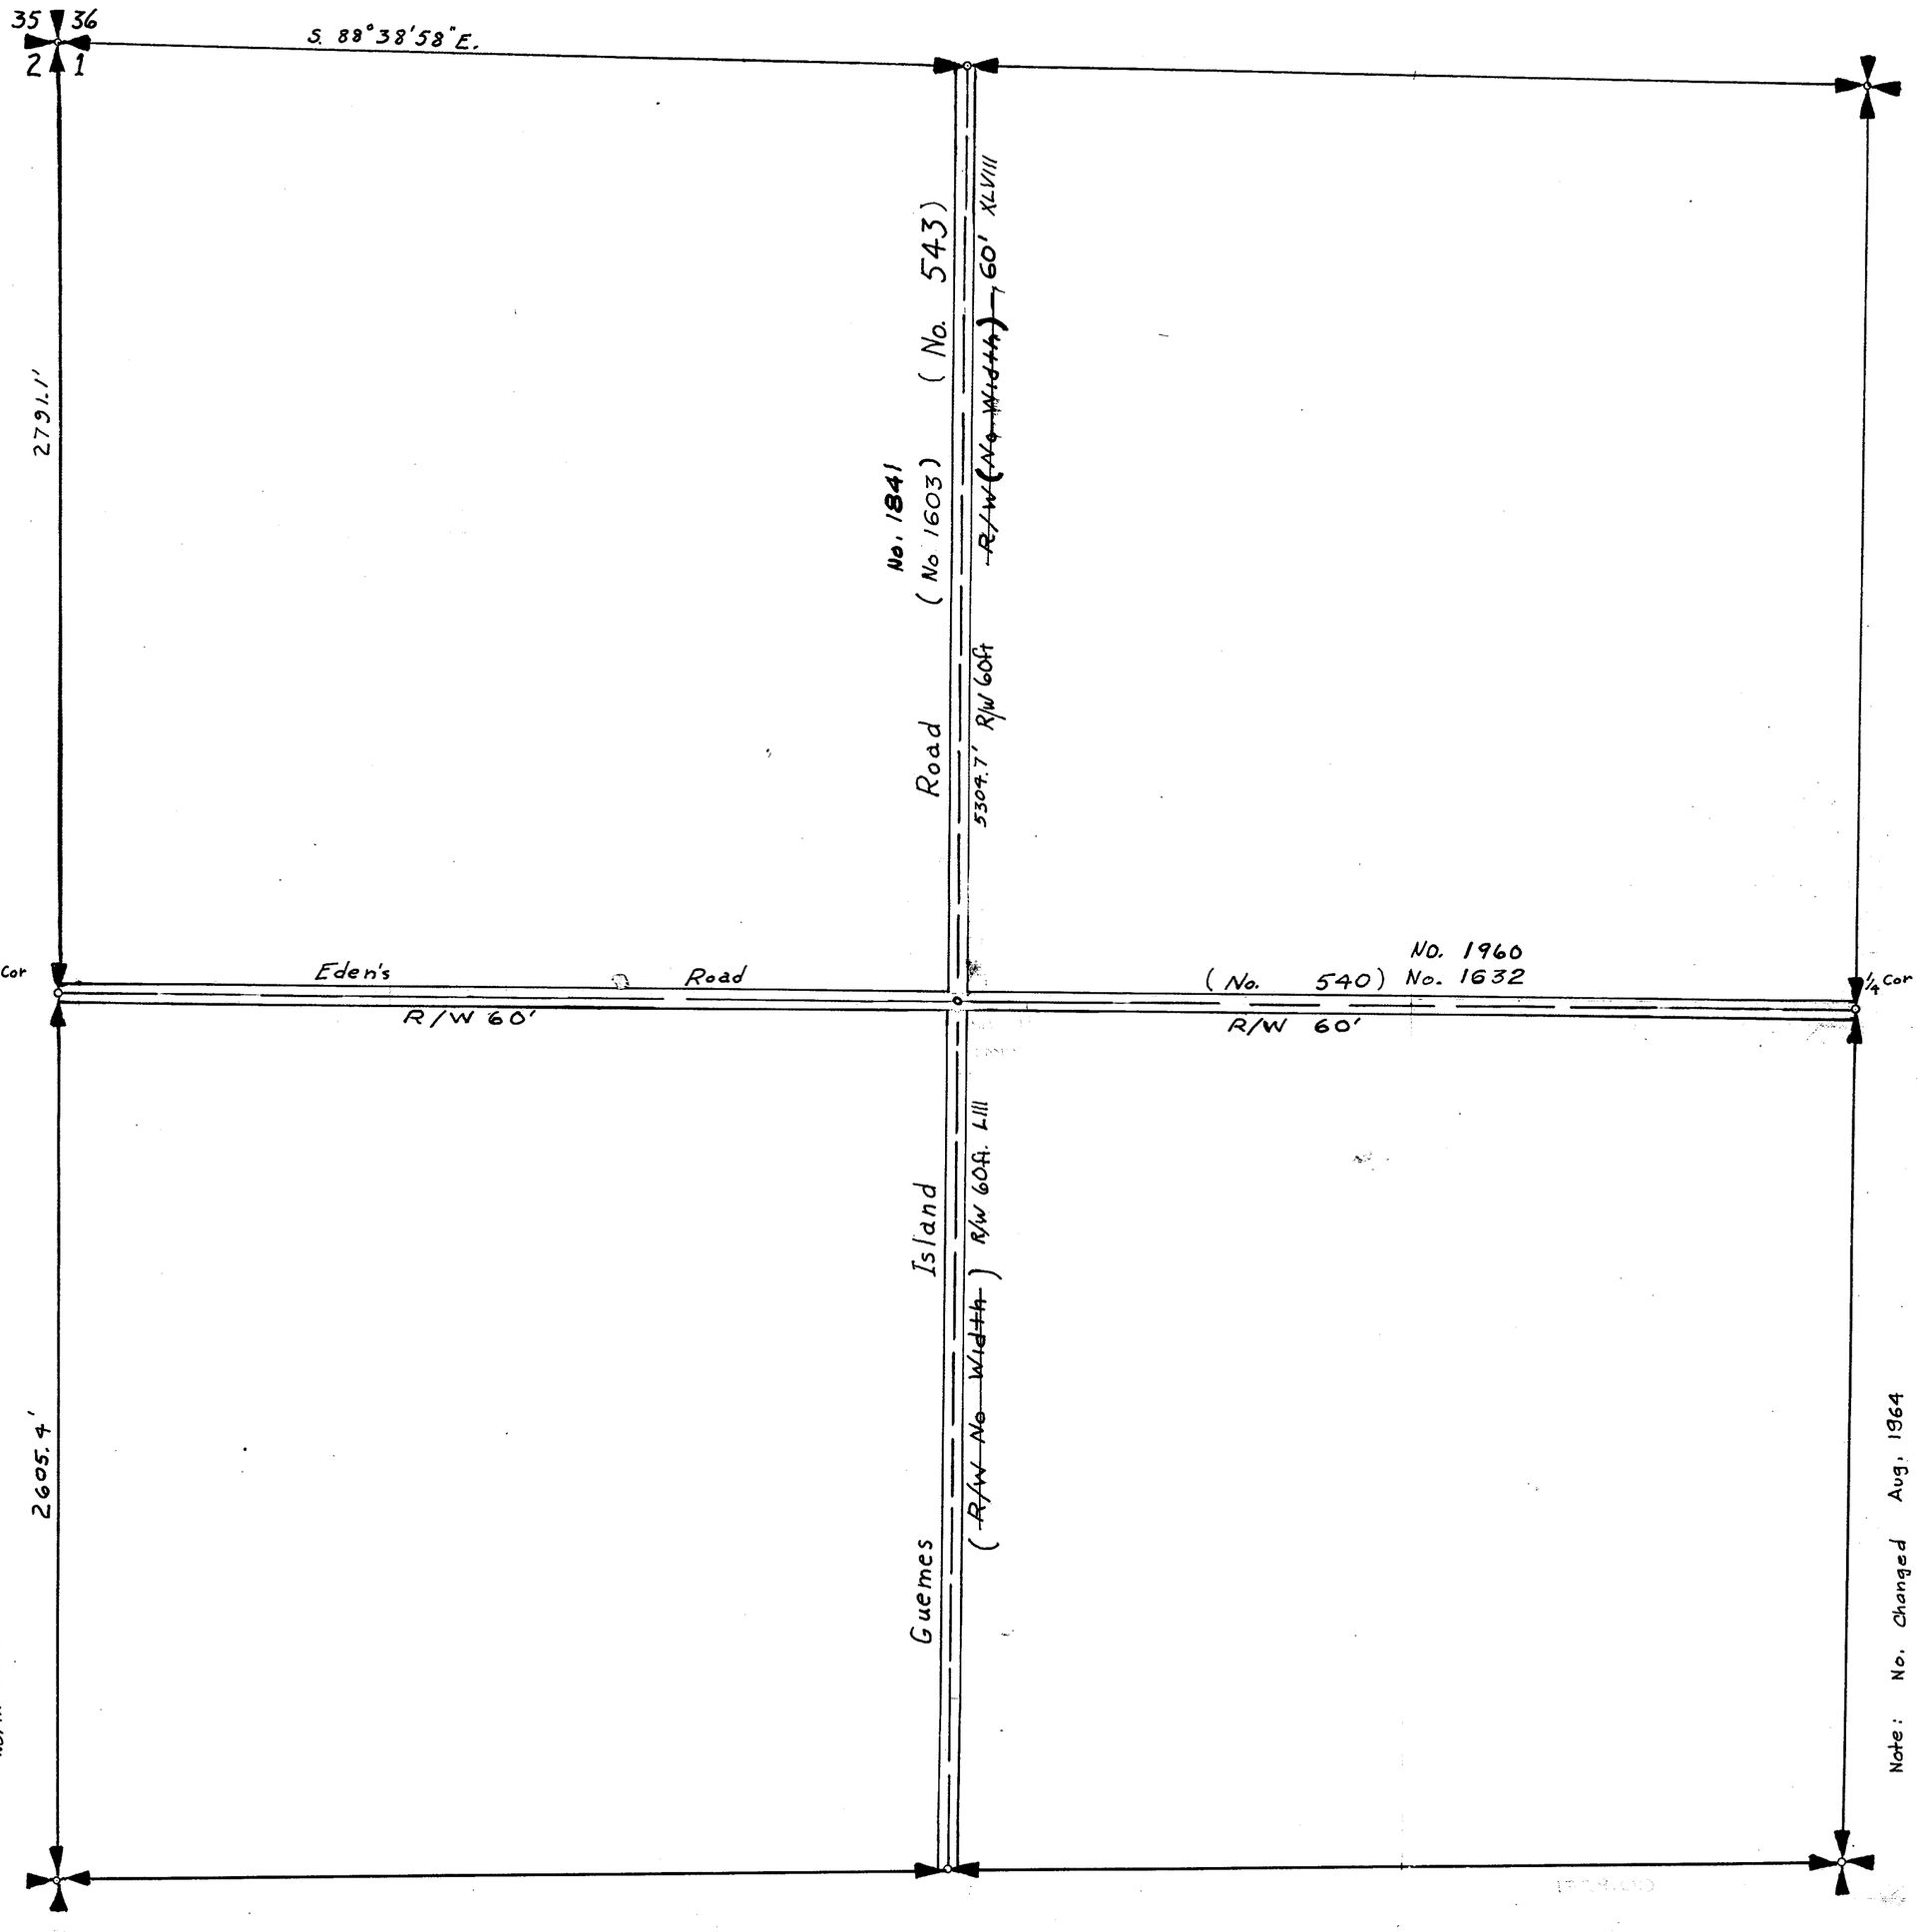

Field Notes:

SECTION 1

TOWNSHIP 35 NORTH, RANGE 1 EAST, W. M.

SKAGIT COUNTY, WASH.

SCALE, 1 INCH--400 FEET

DATE Aug. 1965

COUNTY ENGINEER

Set 1½" Pipe (38)
Set Axle with Gear on top (52)

10" Cedar (52) 40.30

10" Alder (38)(41) 25.30

S. 88° 38' 58" E.

16.00

15" Alder (38)(41)

4"x4" Cedar Post replaced with 1½" Pipe with Car Axle inside 1938

32.00

30" Fir Stp. (38)

52.30

18" Fir (52)

Plats - Vol. 4 Page 45

Notes: 750
618
480
415

No. (1603) - (543) 1841

2658.0 N1°13'E

(XLVIII)

Road

Section Ave. Road No. (1607) 1871

(No. 456)

R/W (?) - (?)

Vol. 176 - 104

Vol. 176 - 105

Vol. 176 - 105

R/w 25'± 40'

2791.1'

10" Alder (38) 45.80

8" Alder (38) 16.80

89° 34'

2"x2" Stake
Brass Tack (38)

Eden's Road

T-35-N
1
R-1-E

N89°46'30"E 2634.7

No. (540) - (1632) - (XCVII) 1960 R/W - 60'

(Guemes Is. Road # LIII)

Set Spike (52)

28.10

24.40

P. Pole (38)(41)(52)

G. Pole (38)(41)(52)

Eng. Note File - 41/509
38/415
38/349
41/480
750 - Date - 1952

#38/349
#38/415
#41/480
#41/509
750

Field Notes: Gray Road - Guemes Island
Guemes Island - School House - West
" " " to N. Beach
Eden's Road (XCVIII) - Rev. of Portion
Gray Road - (1952)

2605.4'

N0°31'30"W

Guemes Island (LIII) R/W - 60'

26.00 F. Post (38)

N89°59'30"E

66.80 T. Pole (38)

17.80 6" Fir (48)

55.30 30" Fir Stp. (48)

24.70 18" Cedar (48)

Conc. Mon. (38)

GENERAL NOTATION: THIS TRACING DRAWN FROM AN AERIAL PHOTO

Corrected: 1/28/39 by AI
Notes & File Eden's Rd. Extn.
Notes: 37/327

SECTION 2


TOWNSHIP 35 NORTH, RANGE 1 EAST, W. M.

SKAGIT COUNTY, WASH.

SCALE, 1 INCH--400 FEET

DATE Aug. 1965

COUNTY ENGINEER

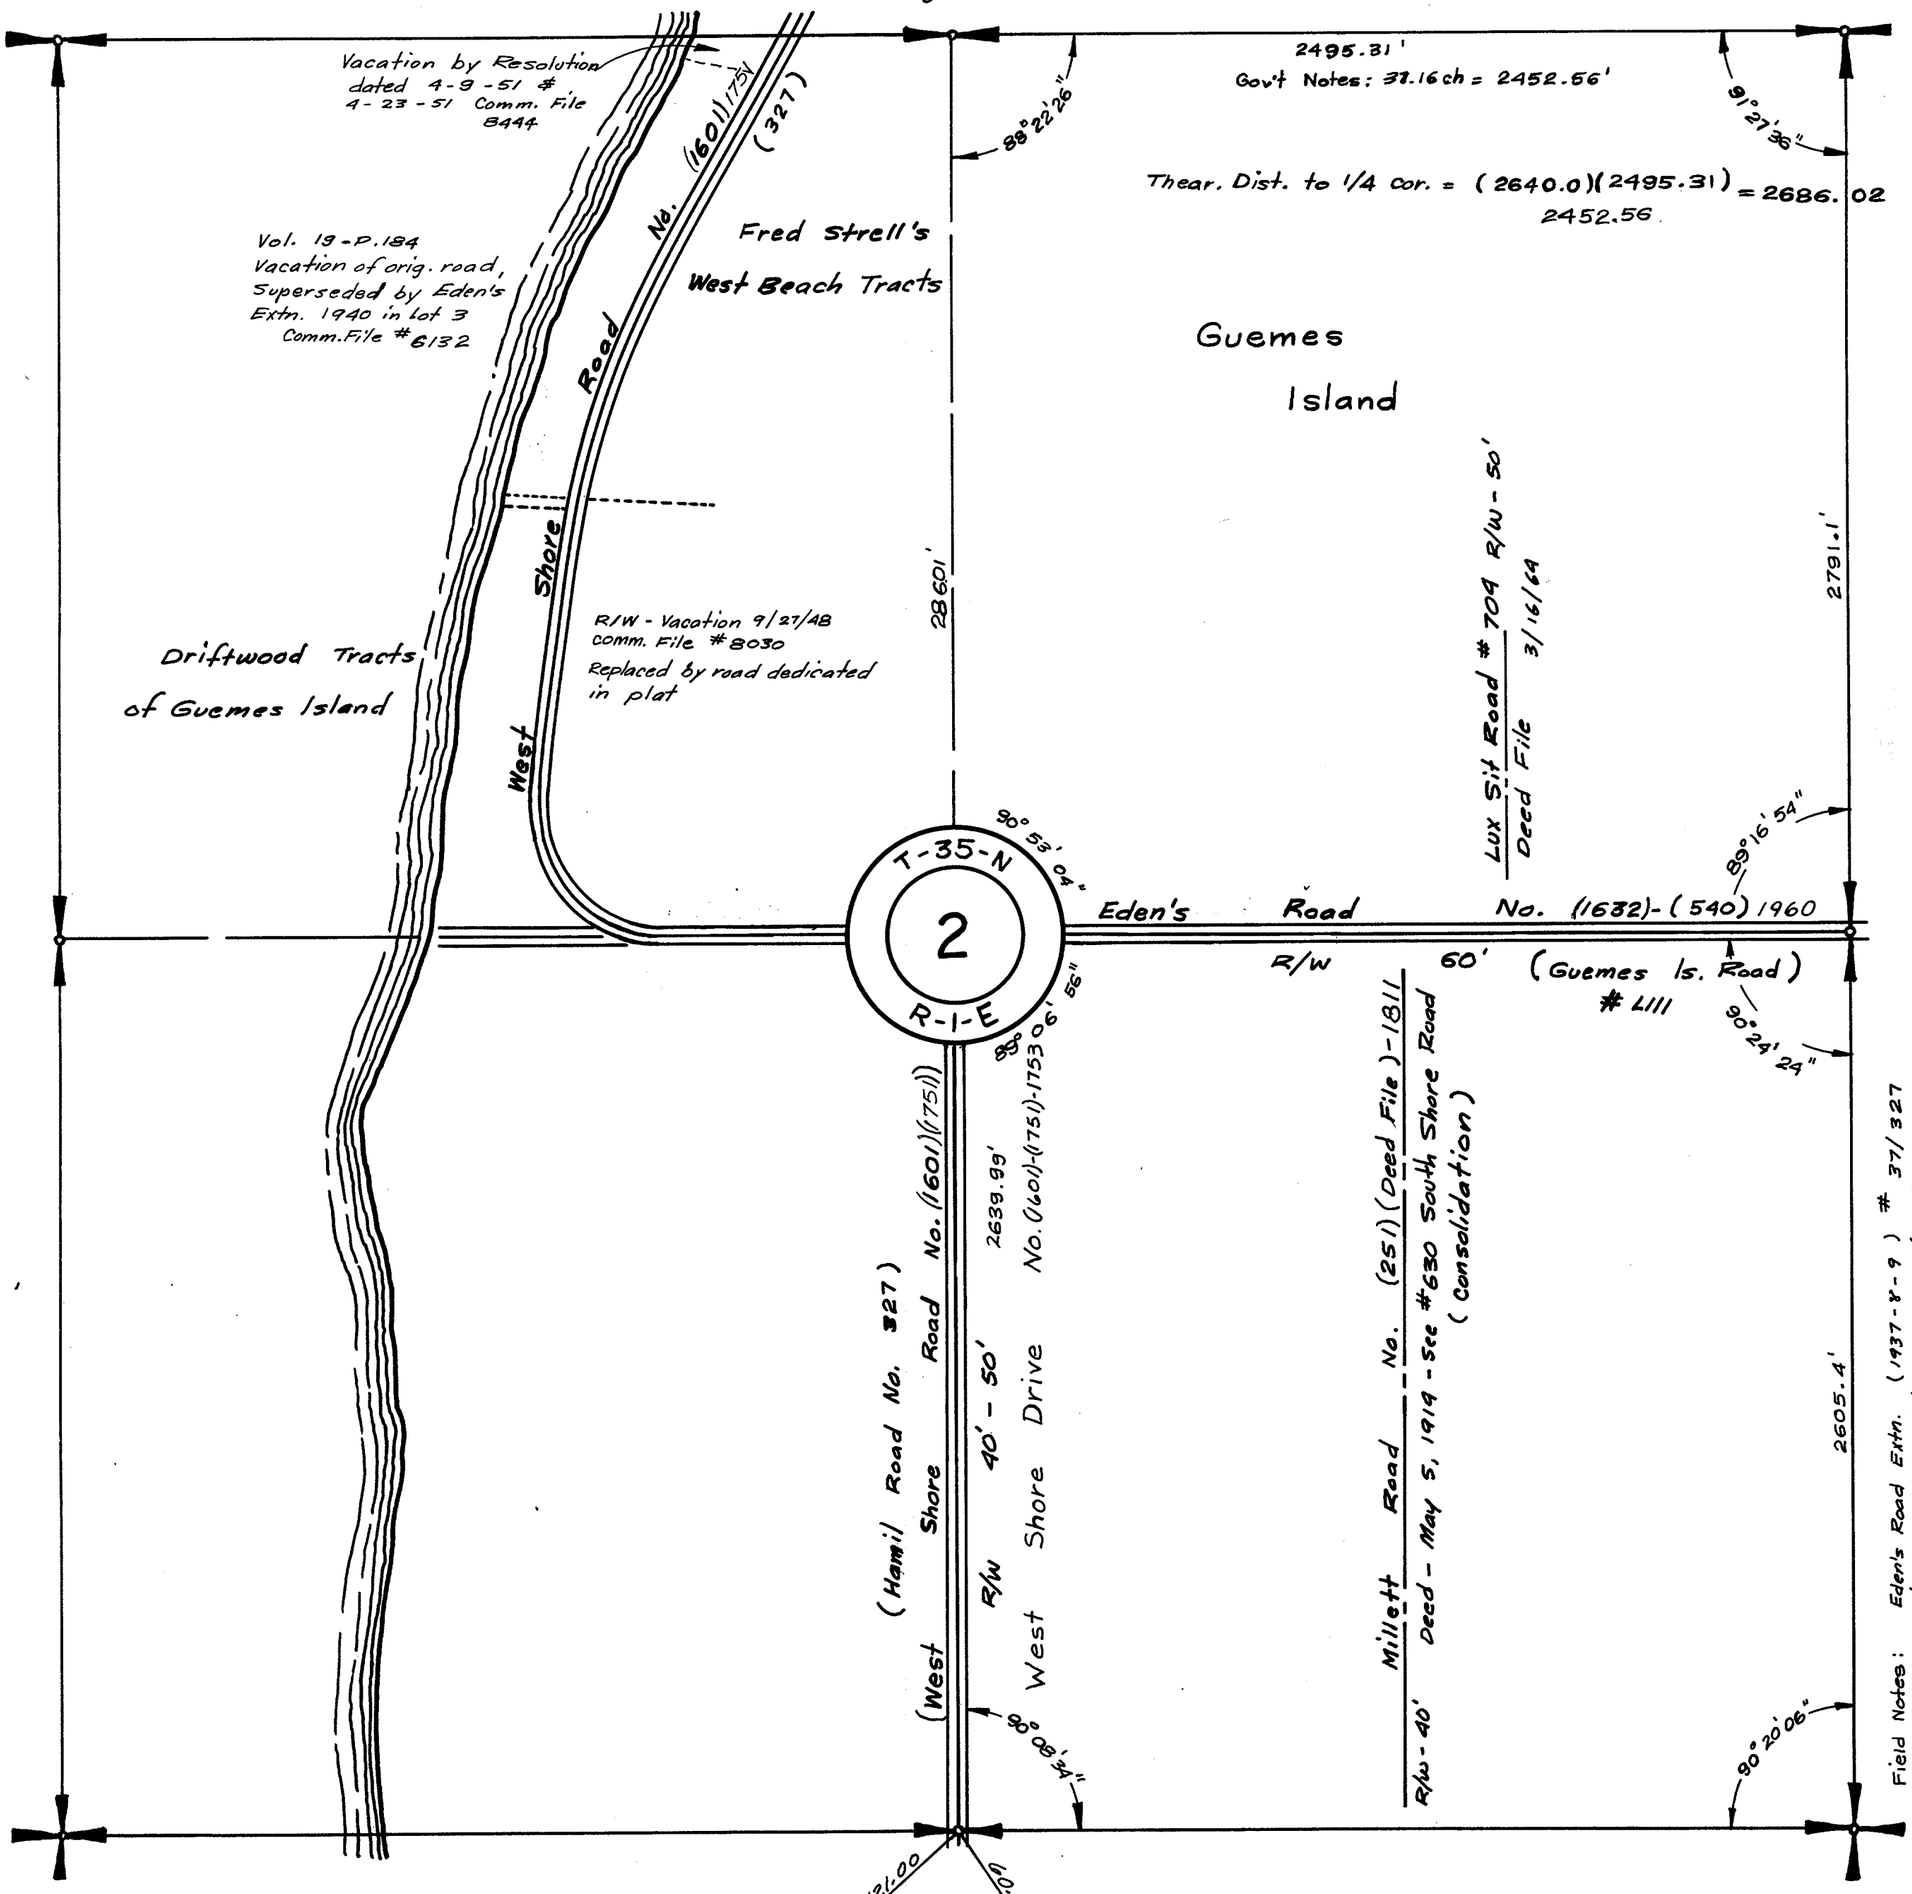

Field Notes: Eden's Road Extn. (1937-8-9) # 37/327
Ditch on Guemes Island - See Tie's # 35/290

GENERAL NOTATION: THIS TRACING DRAWN FROM FORMER TRACINGS, DRAWINGS, & AERIAL PHOTO

24" Fir (31) Drove 1" Pipe 2' long 3" below Subgrade 1933 Notes: 194


8" Cedar (31)

SECTION 2

TOWNSHIP 35 NORTH. RANGE 1 EAST. W. M.
SKAGIT COUNTY. WASH.

SCALE. 1 INCH–400 FEET

Robt. E. L. Knapp COUNTY ENGINEER
July 1931

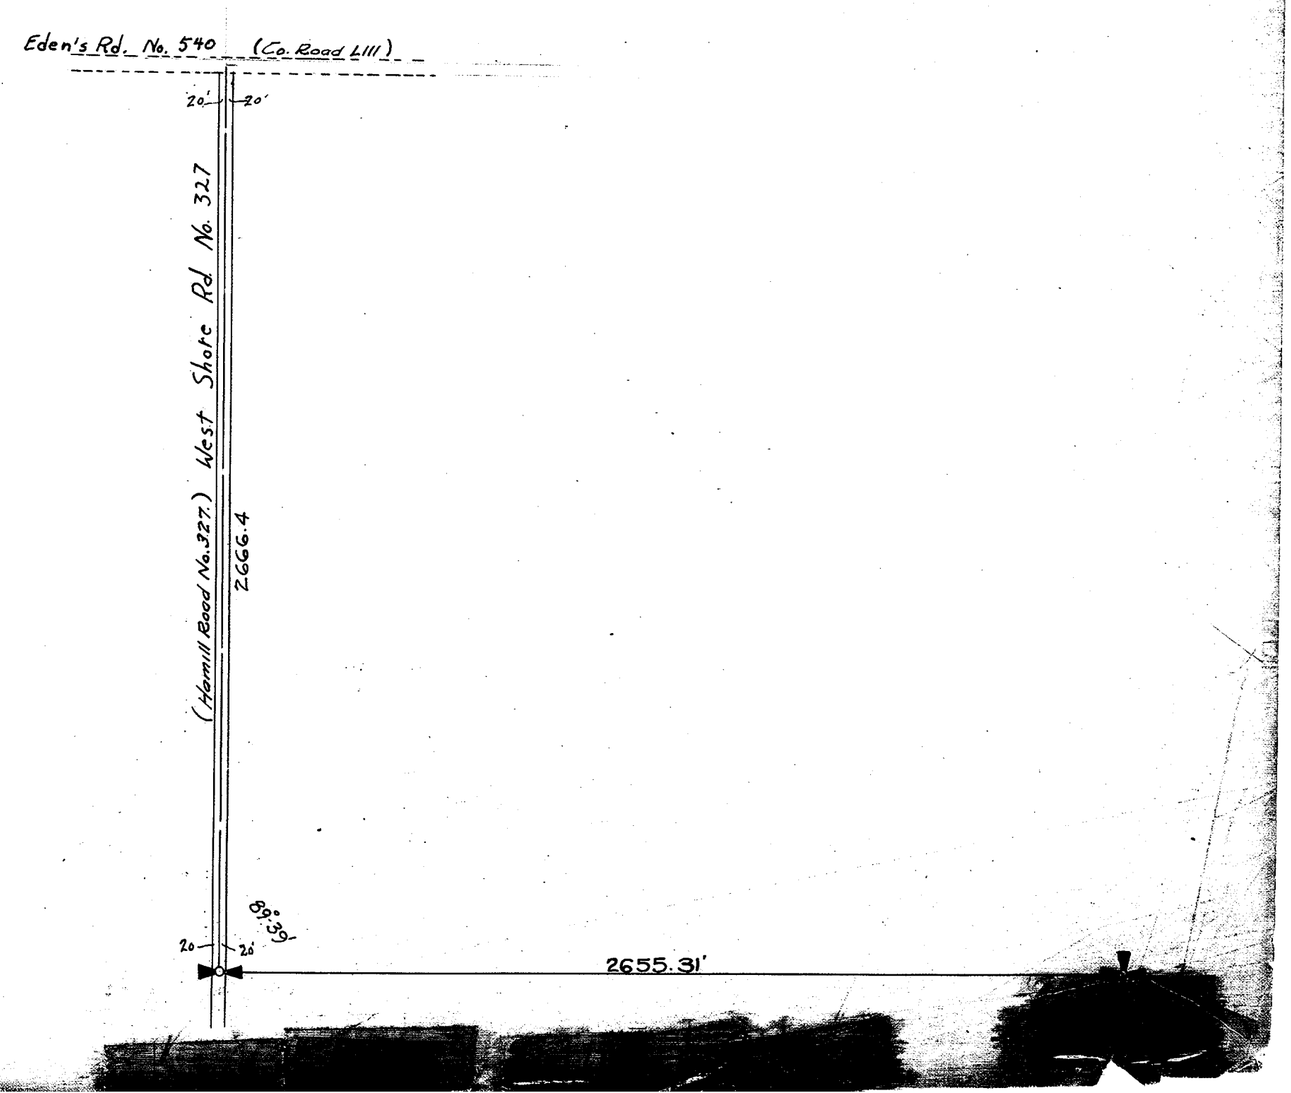


SECTION 2

TOWNSHIP 35 NORTH, RANGE 1 EAST, W. M.
SKAGIT COUNTY, WASH.

Corrected: 1/28/39 by AH
Notes & File Eden's Rd. Exten.
Notes: 37/327

SCALE, 1 INCH--400 FEET

R.E.L. Knopp COUNTY ENGINEER
Notes: 35-290

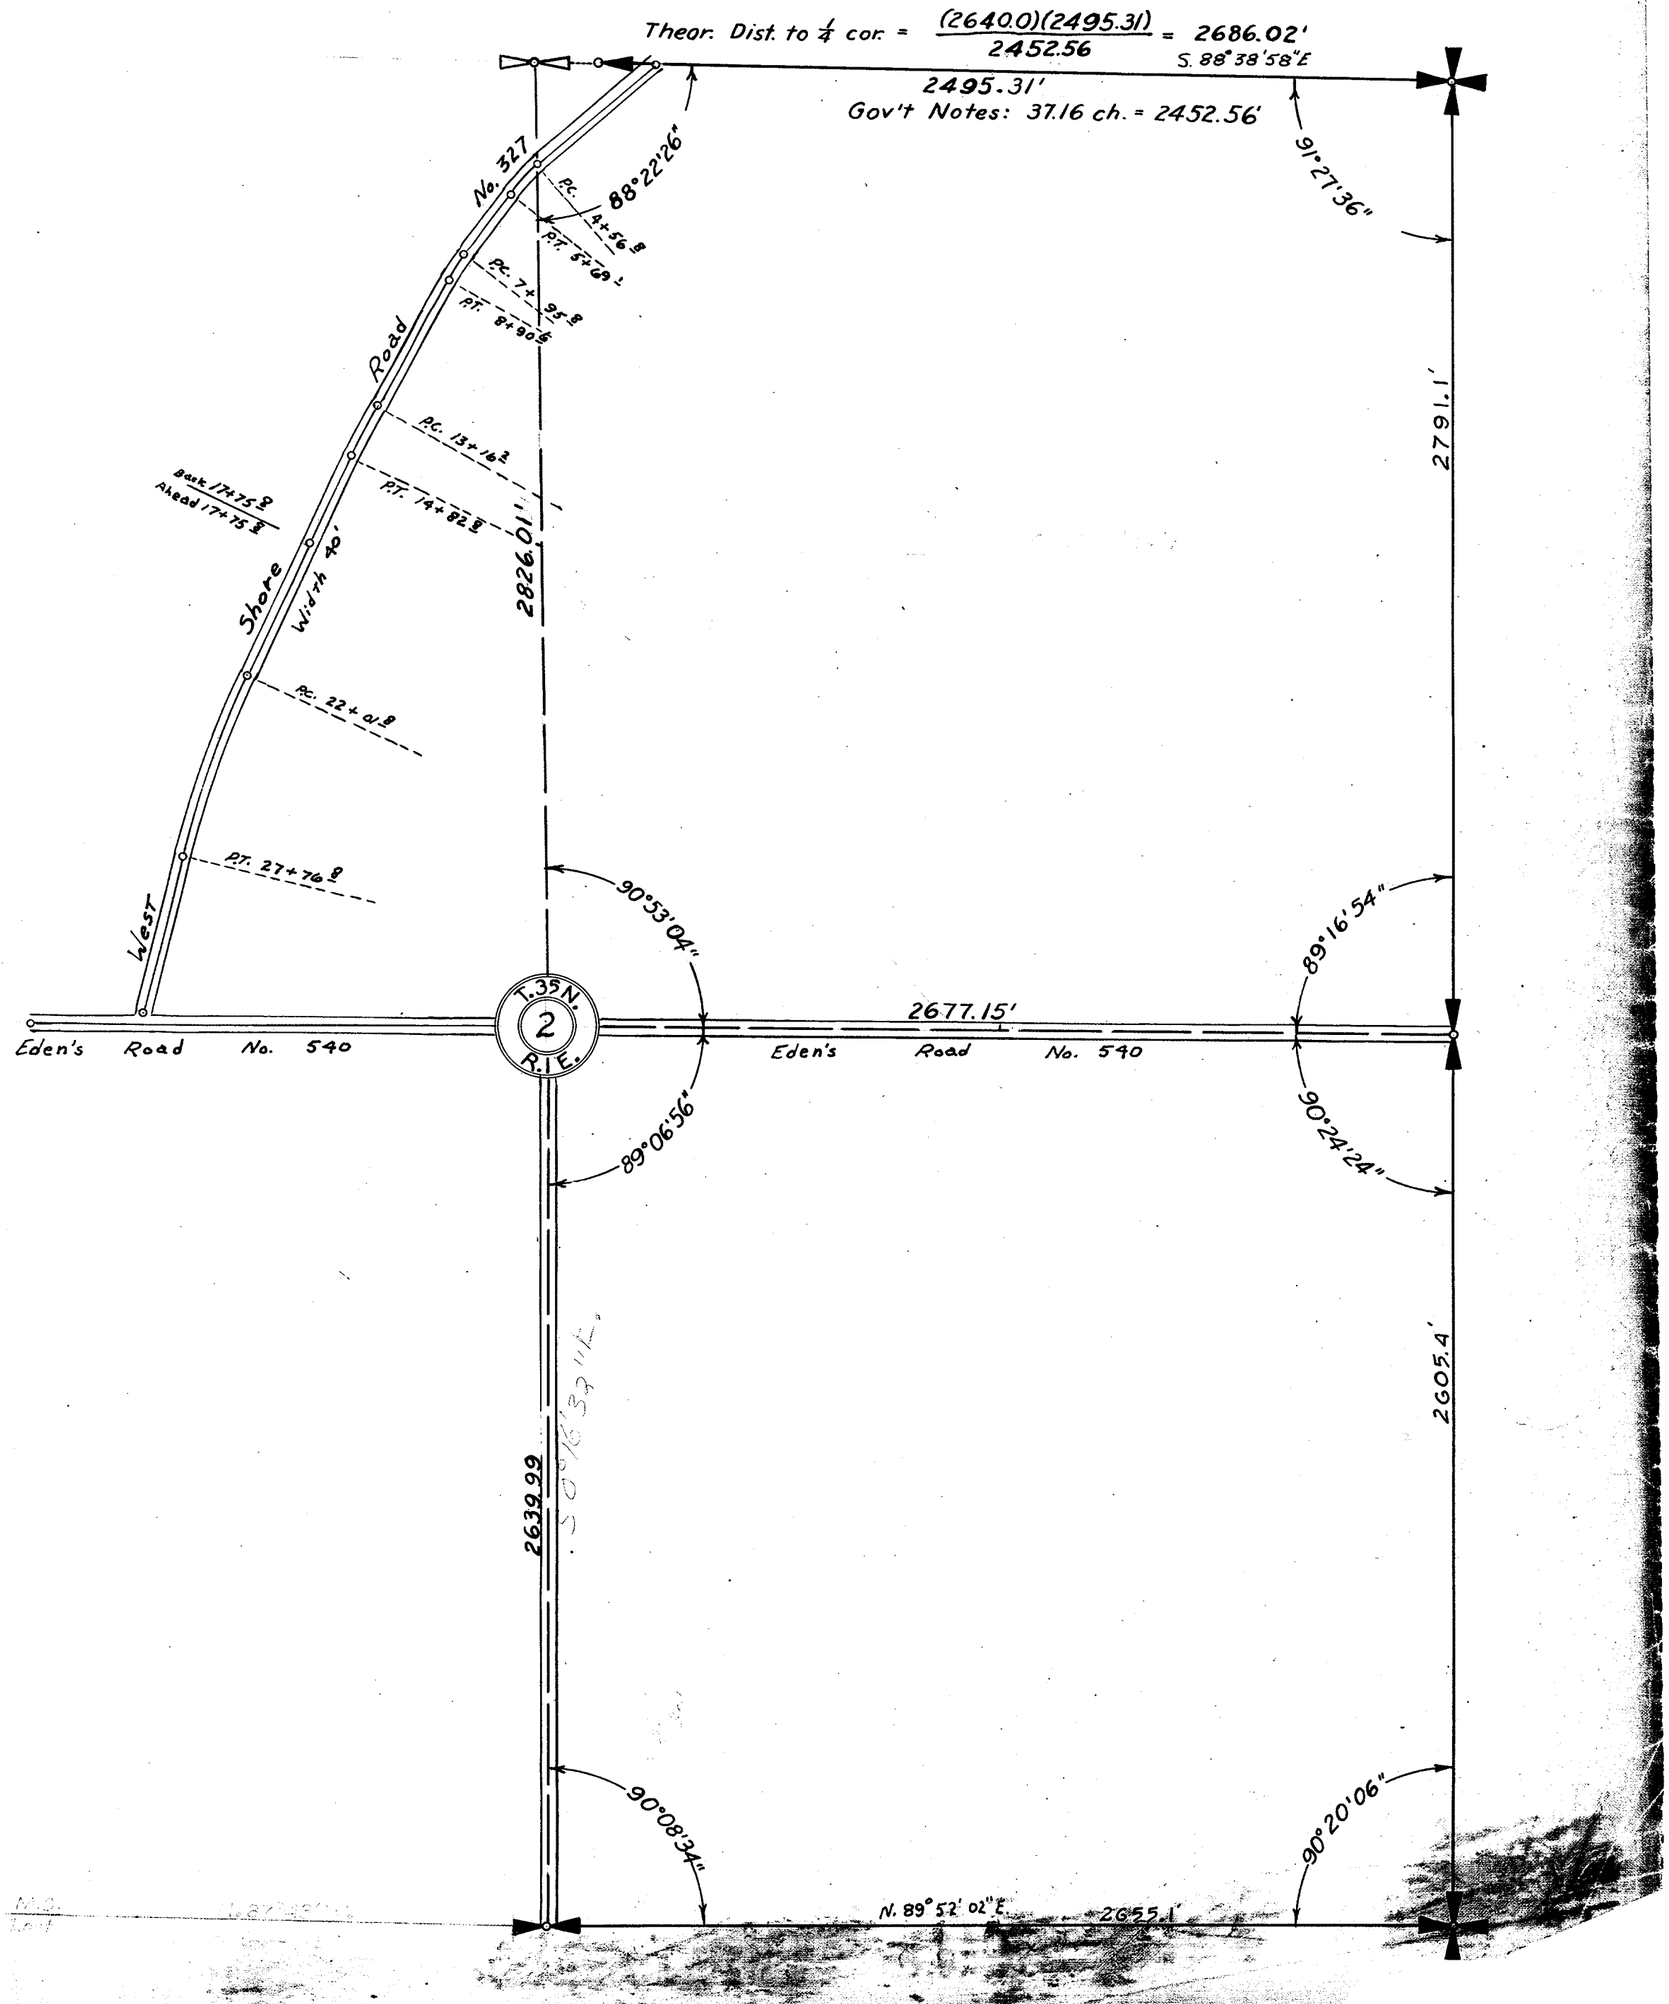



TOWNSHIP 35 NORTH. RANGE 1 EAST. W. M.

SKAGIT COUNTY. WASH.

SCALE, 1 INCH—400 FEET

LLOYD H. JOHNSON COUNTY ENGINEER

DATE June 19, 1972

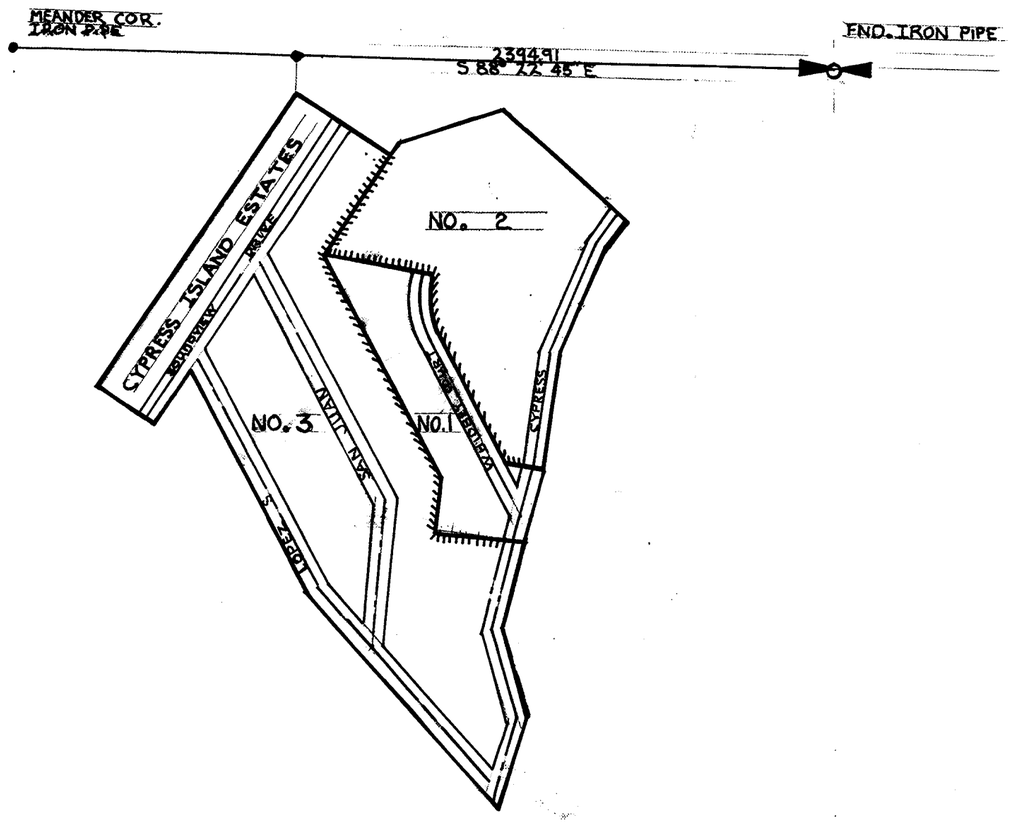


SECTION 11

TOWNSHIP 35 NORTH, RANGE 1 EAST, W. M.
SKAGIT COUNTY, WASH.

SCALE, 1 INCH–400 FEET

Robt. E. L. Knapp COUNTY ENGINEER
July 1931

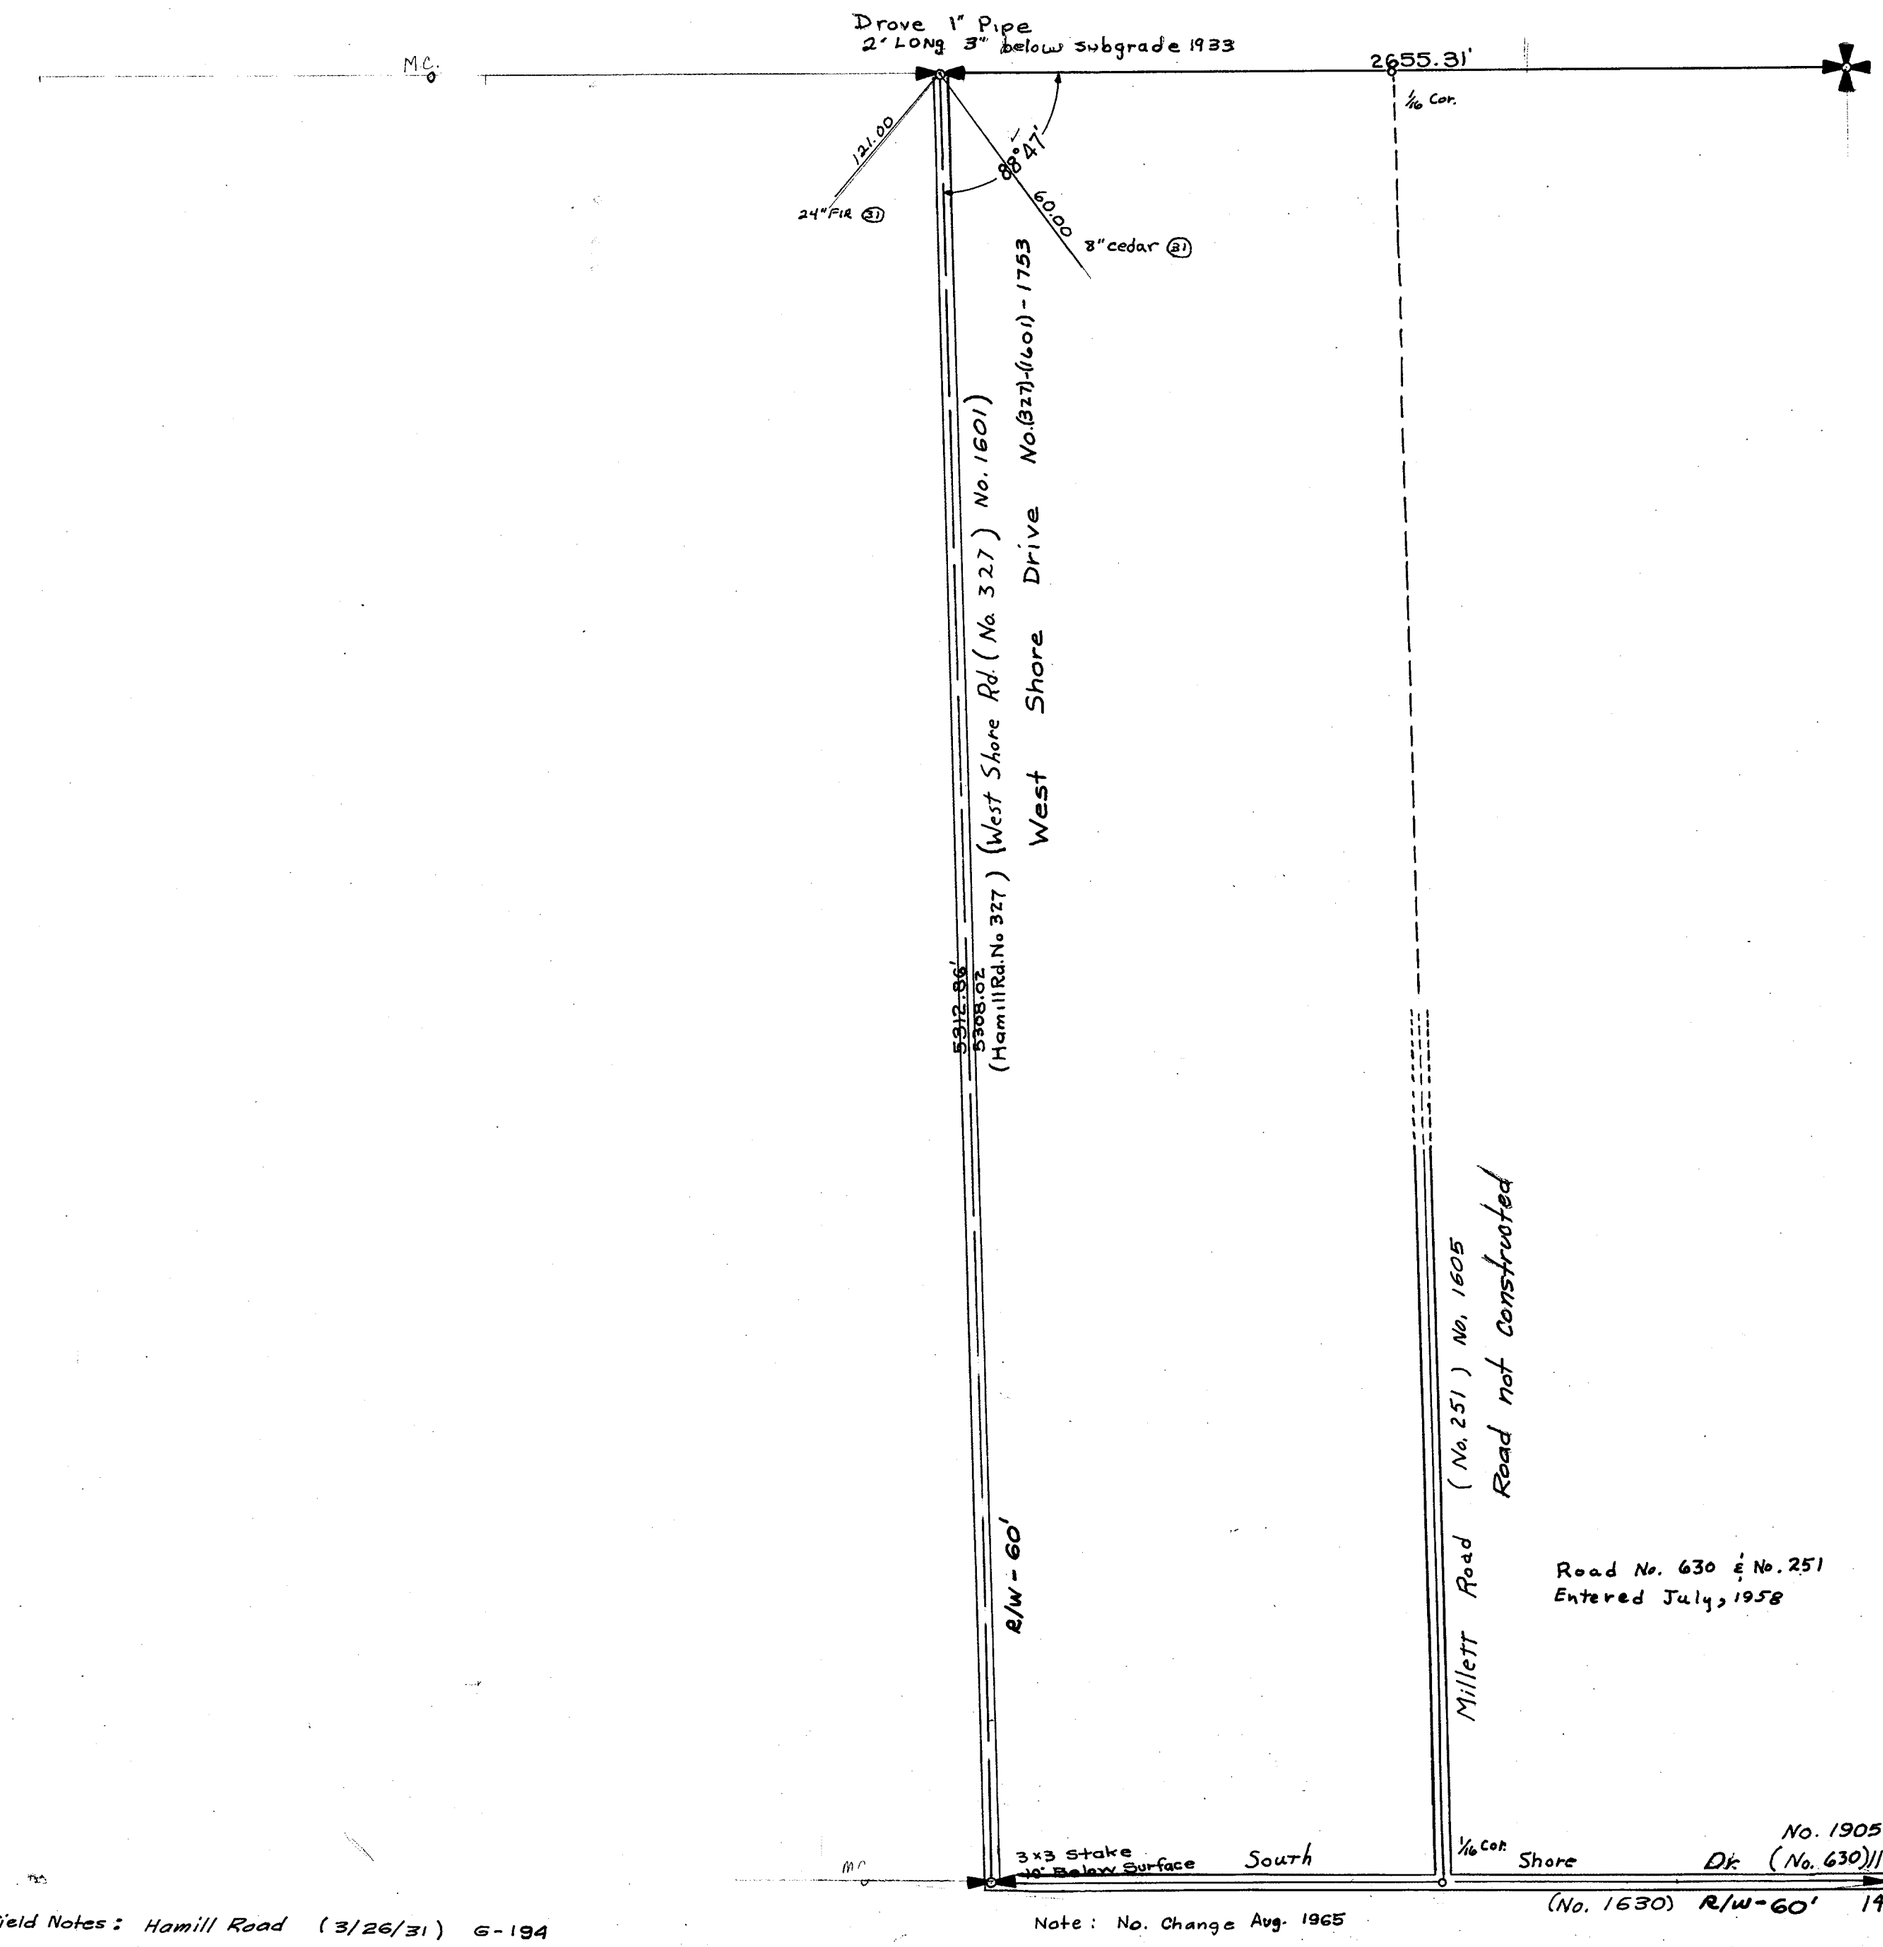


Field Notes: Hamill Road (3/26/31) G-194

Note: No. Change Aug. 1965

SKAGIT COUNTY

SEC. 12 TWP. 35 R. 1

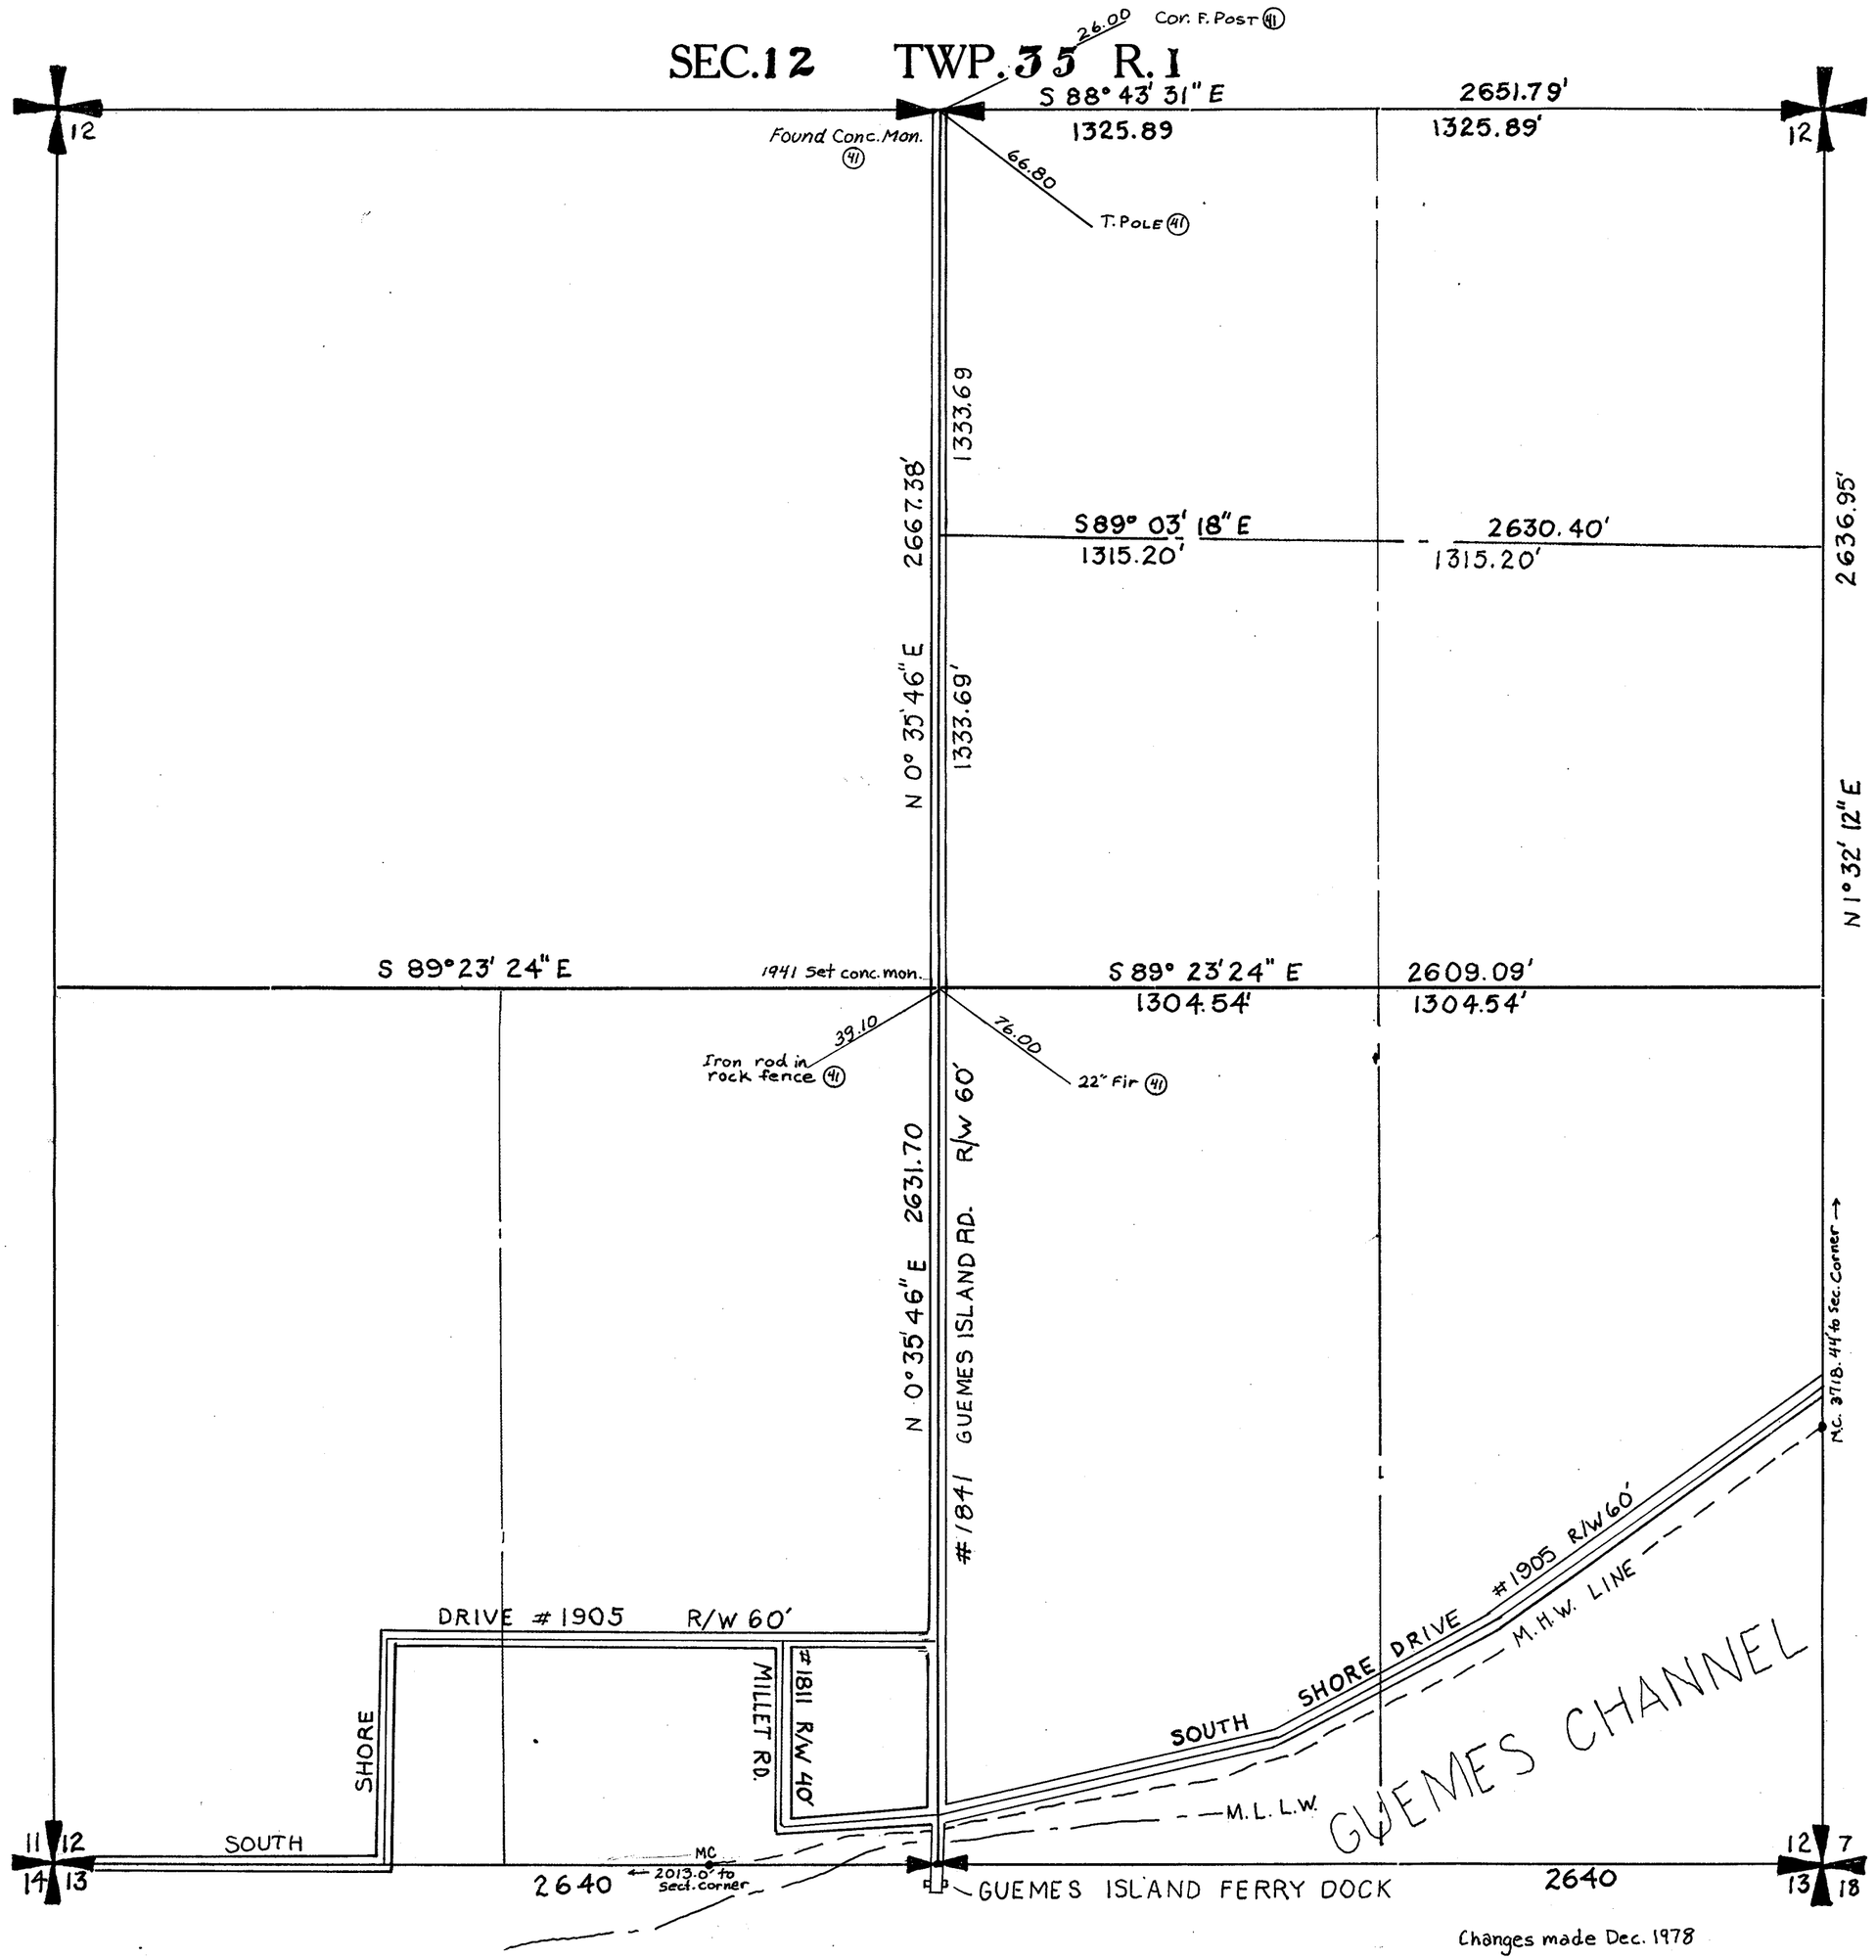

Changes made Dec. 1978


SECTION 12

TOWNSHIP 35 NORTH, RANGE 1 EAST, W. M.

SKAGIT COUNTY, WASH.

SCALE, 1 INCH–400 FEET


W.E. Costello COUNTY ENGINEER

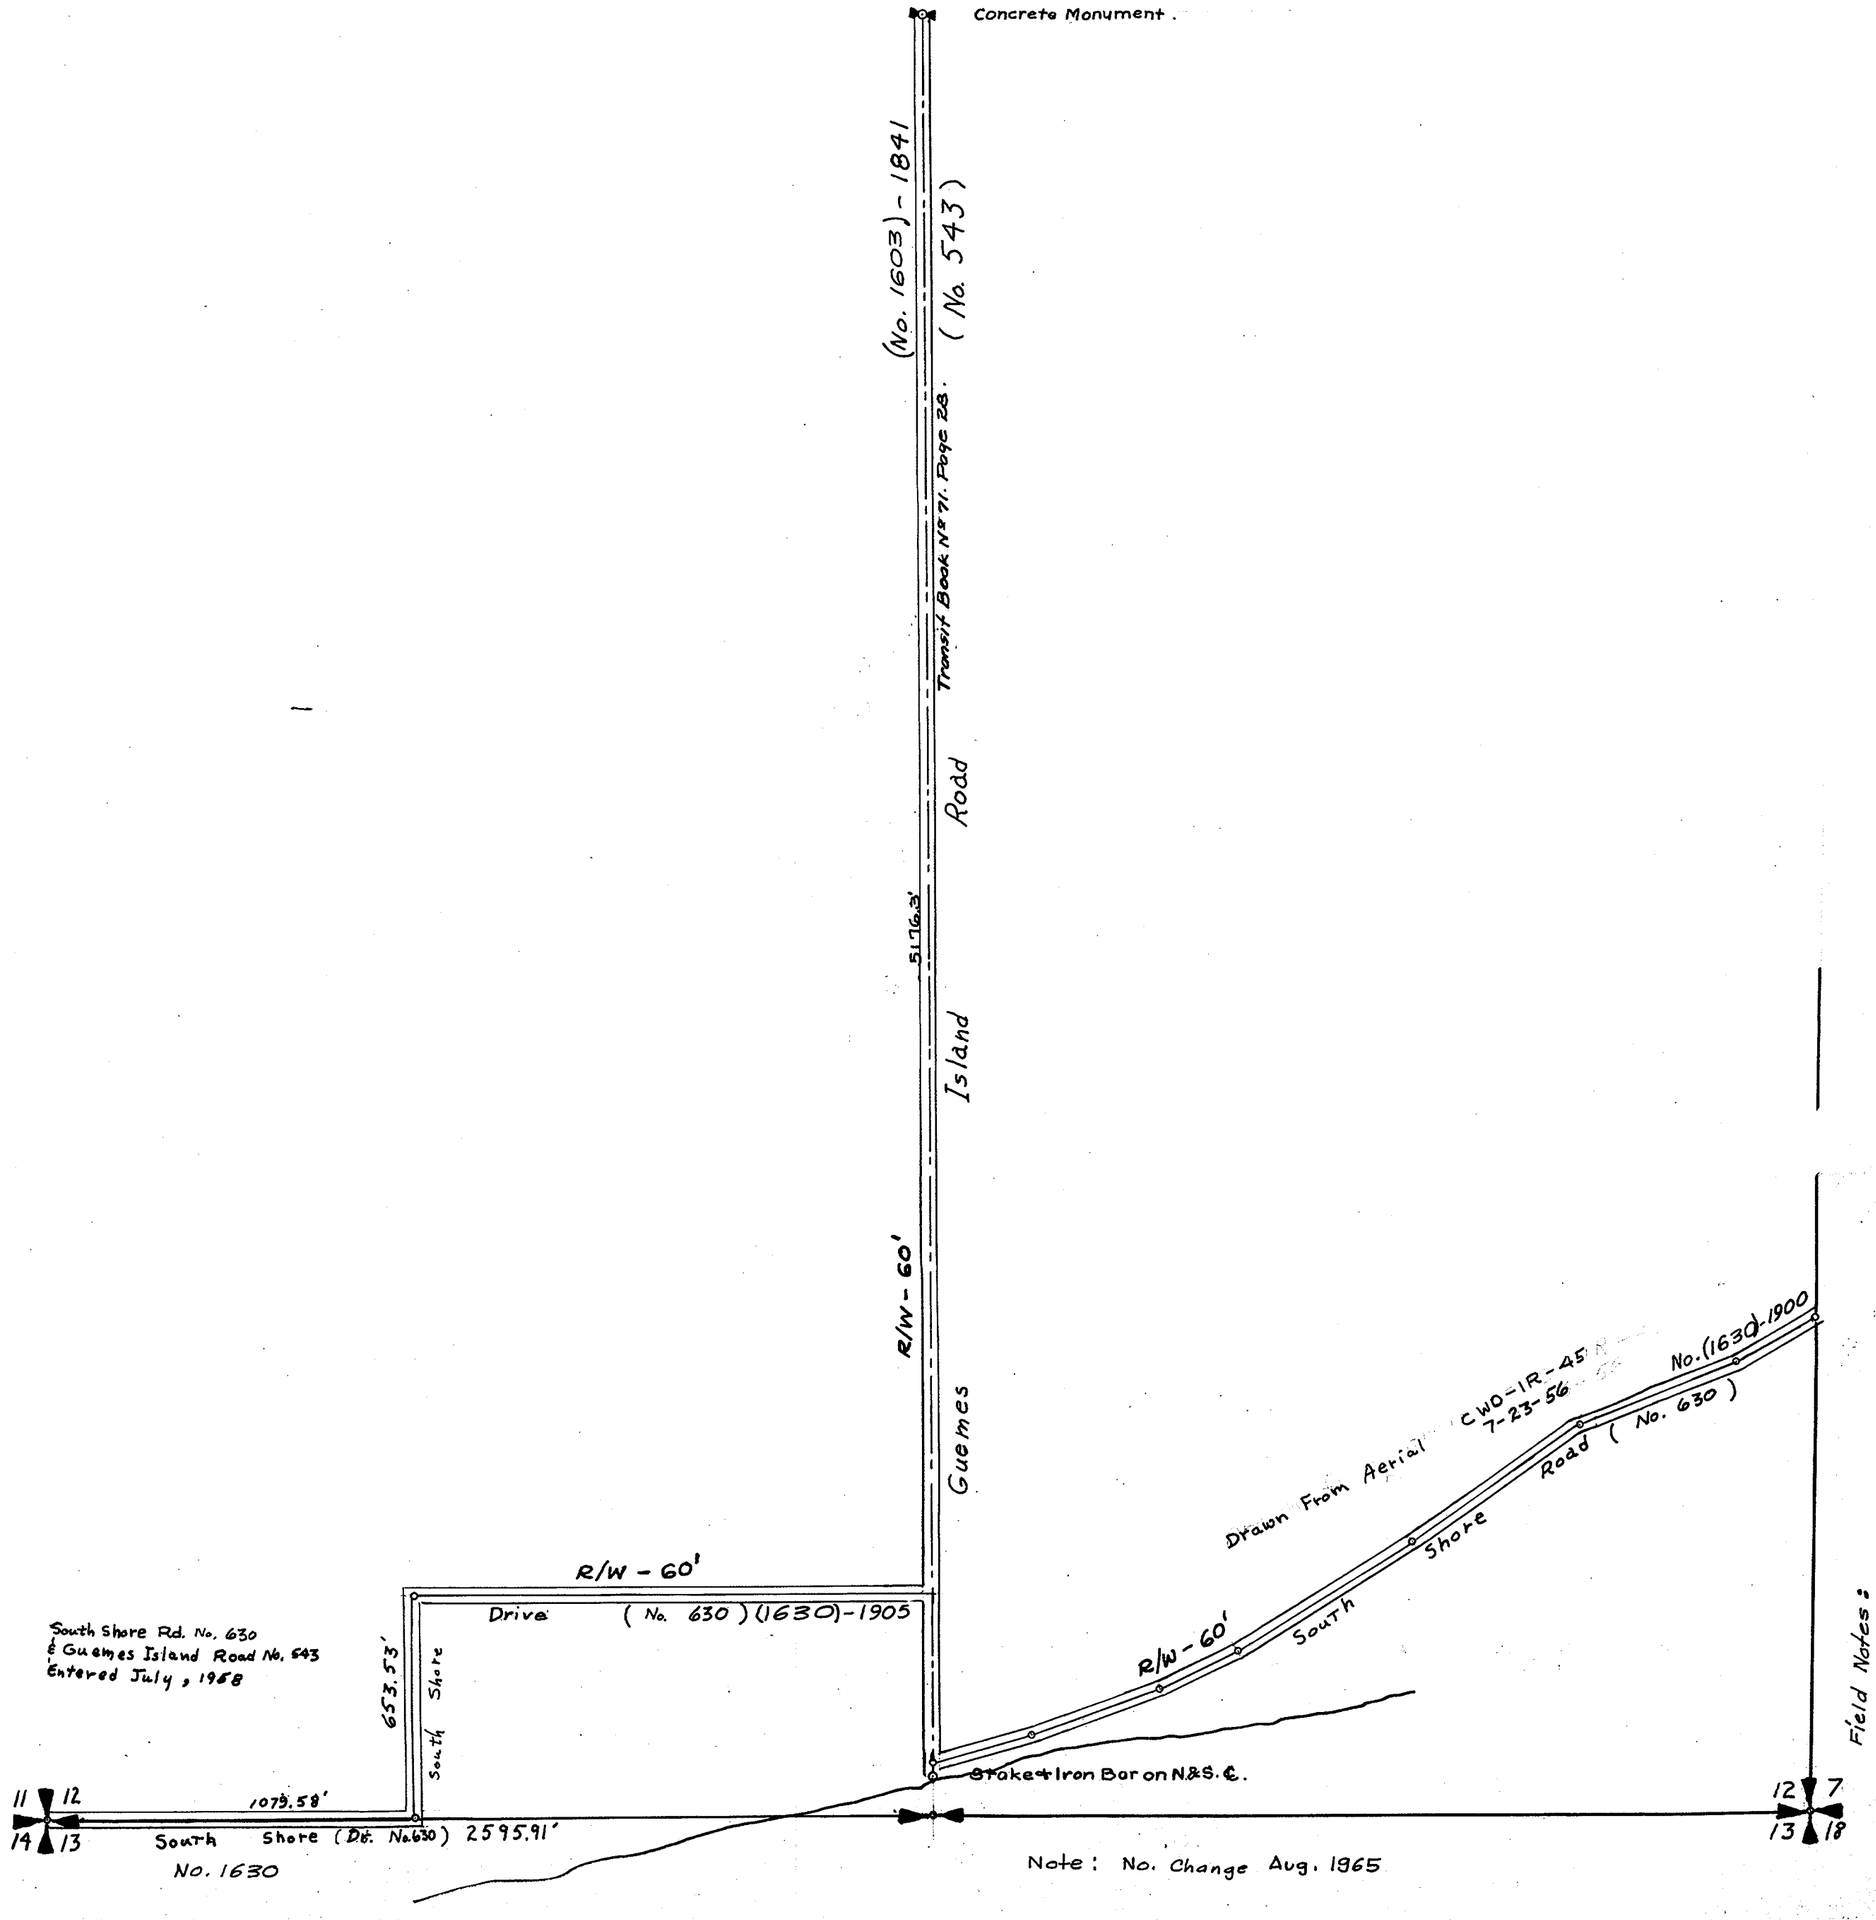

SECTION 34
TOWNSHIP 35 NORTH, RANGE 1 EAST, W. M.
SKAGIT COUNTY, WASH.

SCALE, 1 INCH--400 FEET

G.D. LeGro
Sept. 1958
COUNTY ENGINEER

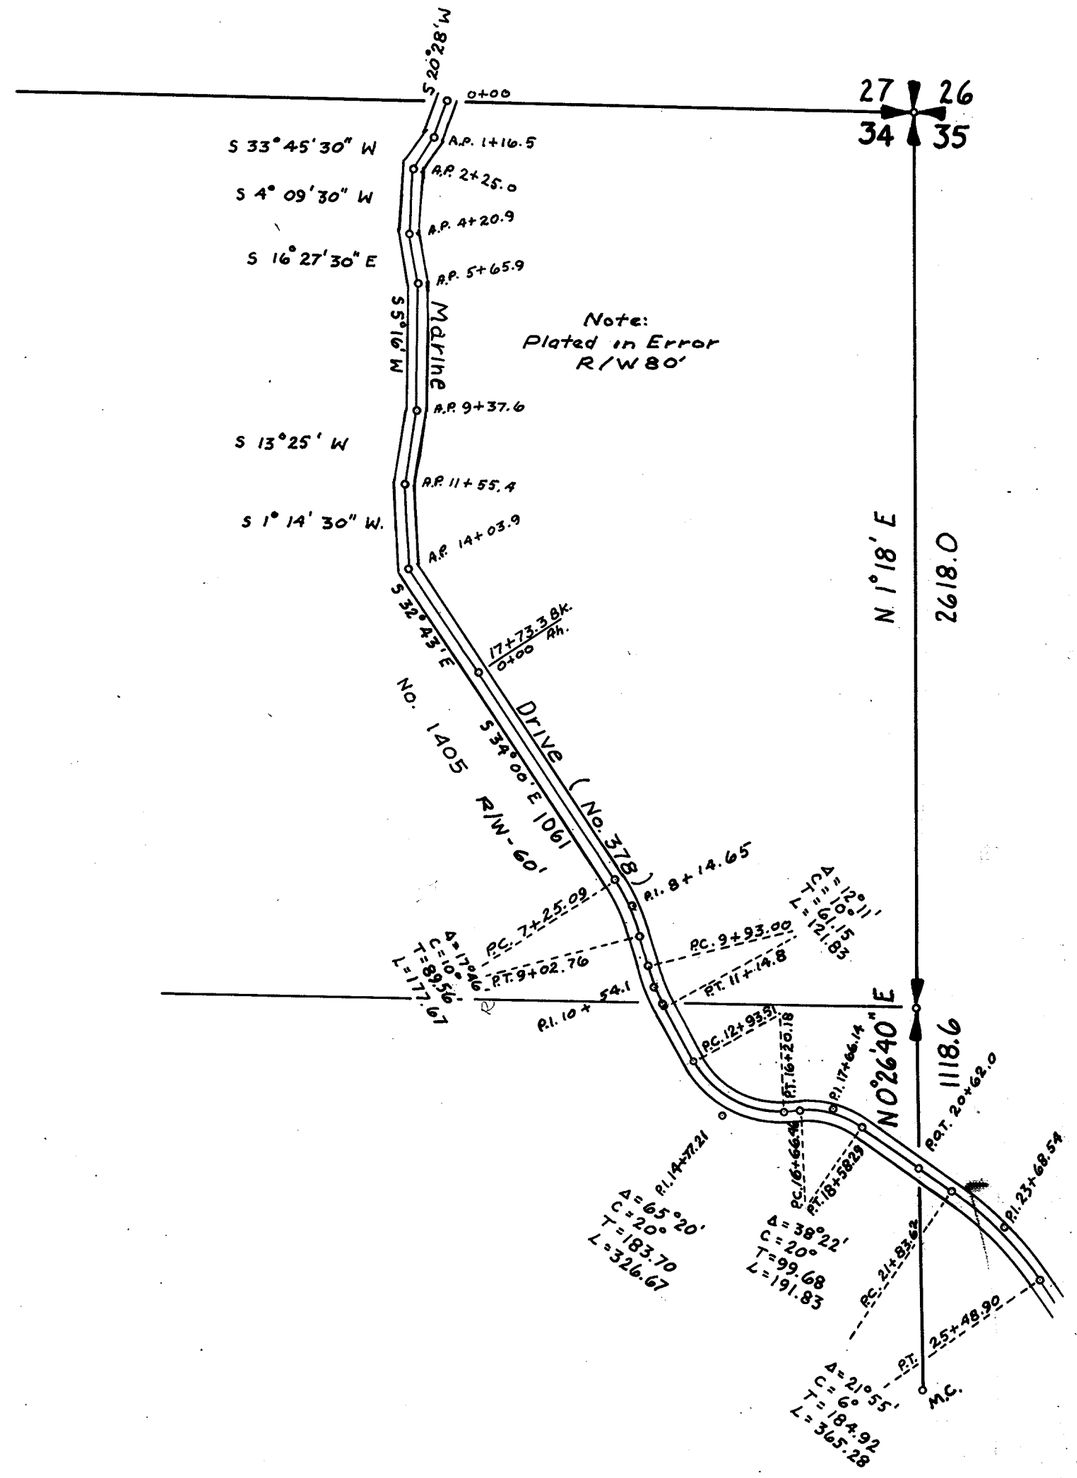

Field Notes: Marine Drive – L-4 & L-7 Line (1963-1959) # 985

GEN. NOTE: No. Change Aug. 1964

TB. 101.

SECTION 35


TOWNSHIP 35 NORTH, RANGE 1 EAST, W. M.

SKAGIT COUNTY, WASH.

SCALE, 1 INCH--400 FEET

Subdivision by Frank Gilkey -1949.

G.D. LeGro COUNTY ENGINEER
Sept 1958, Consolidation No. 378

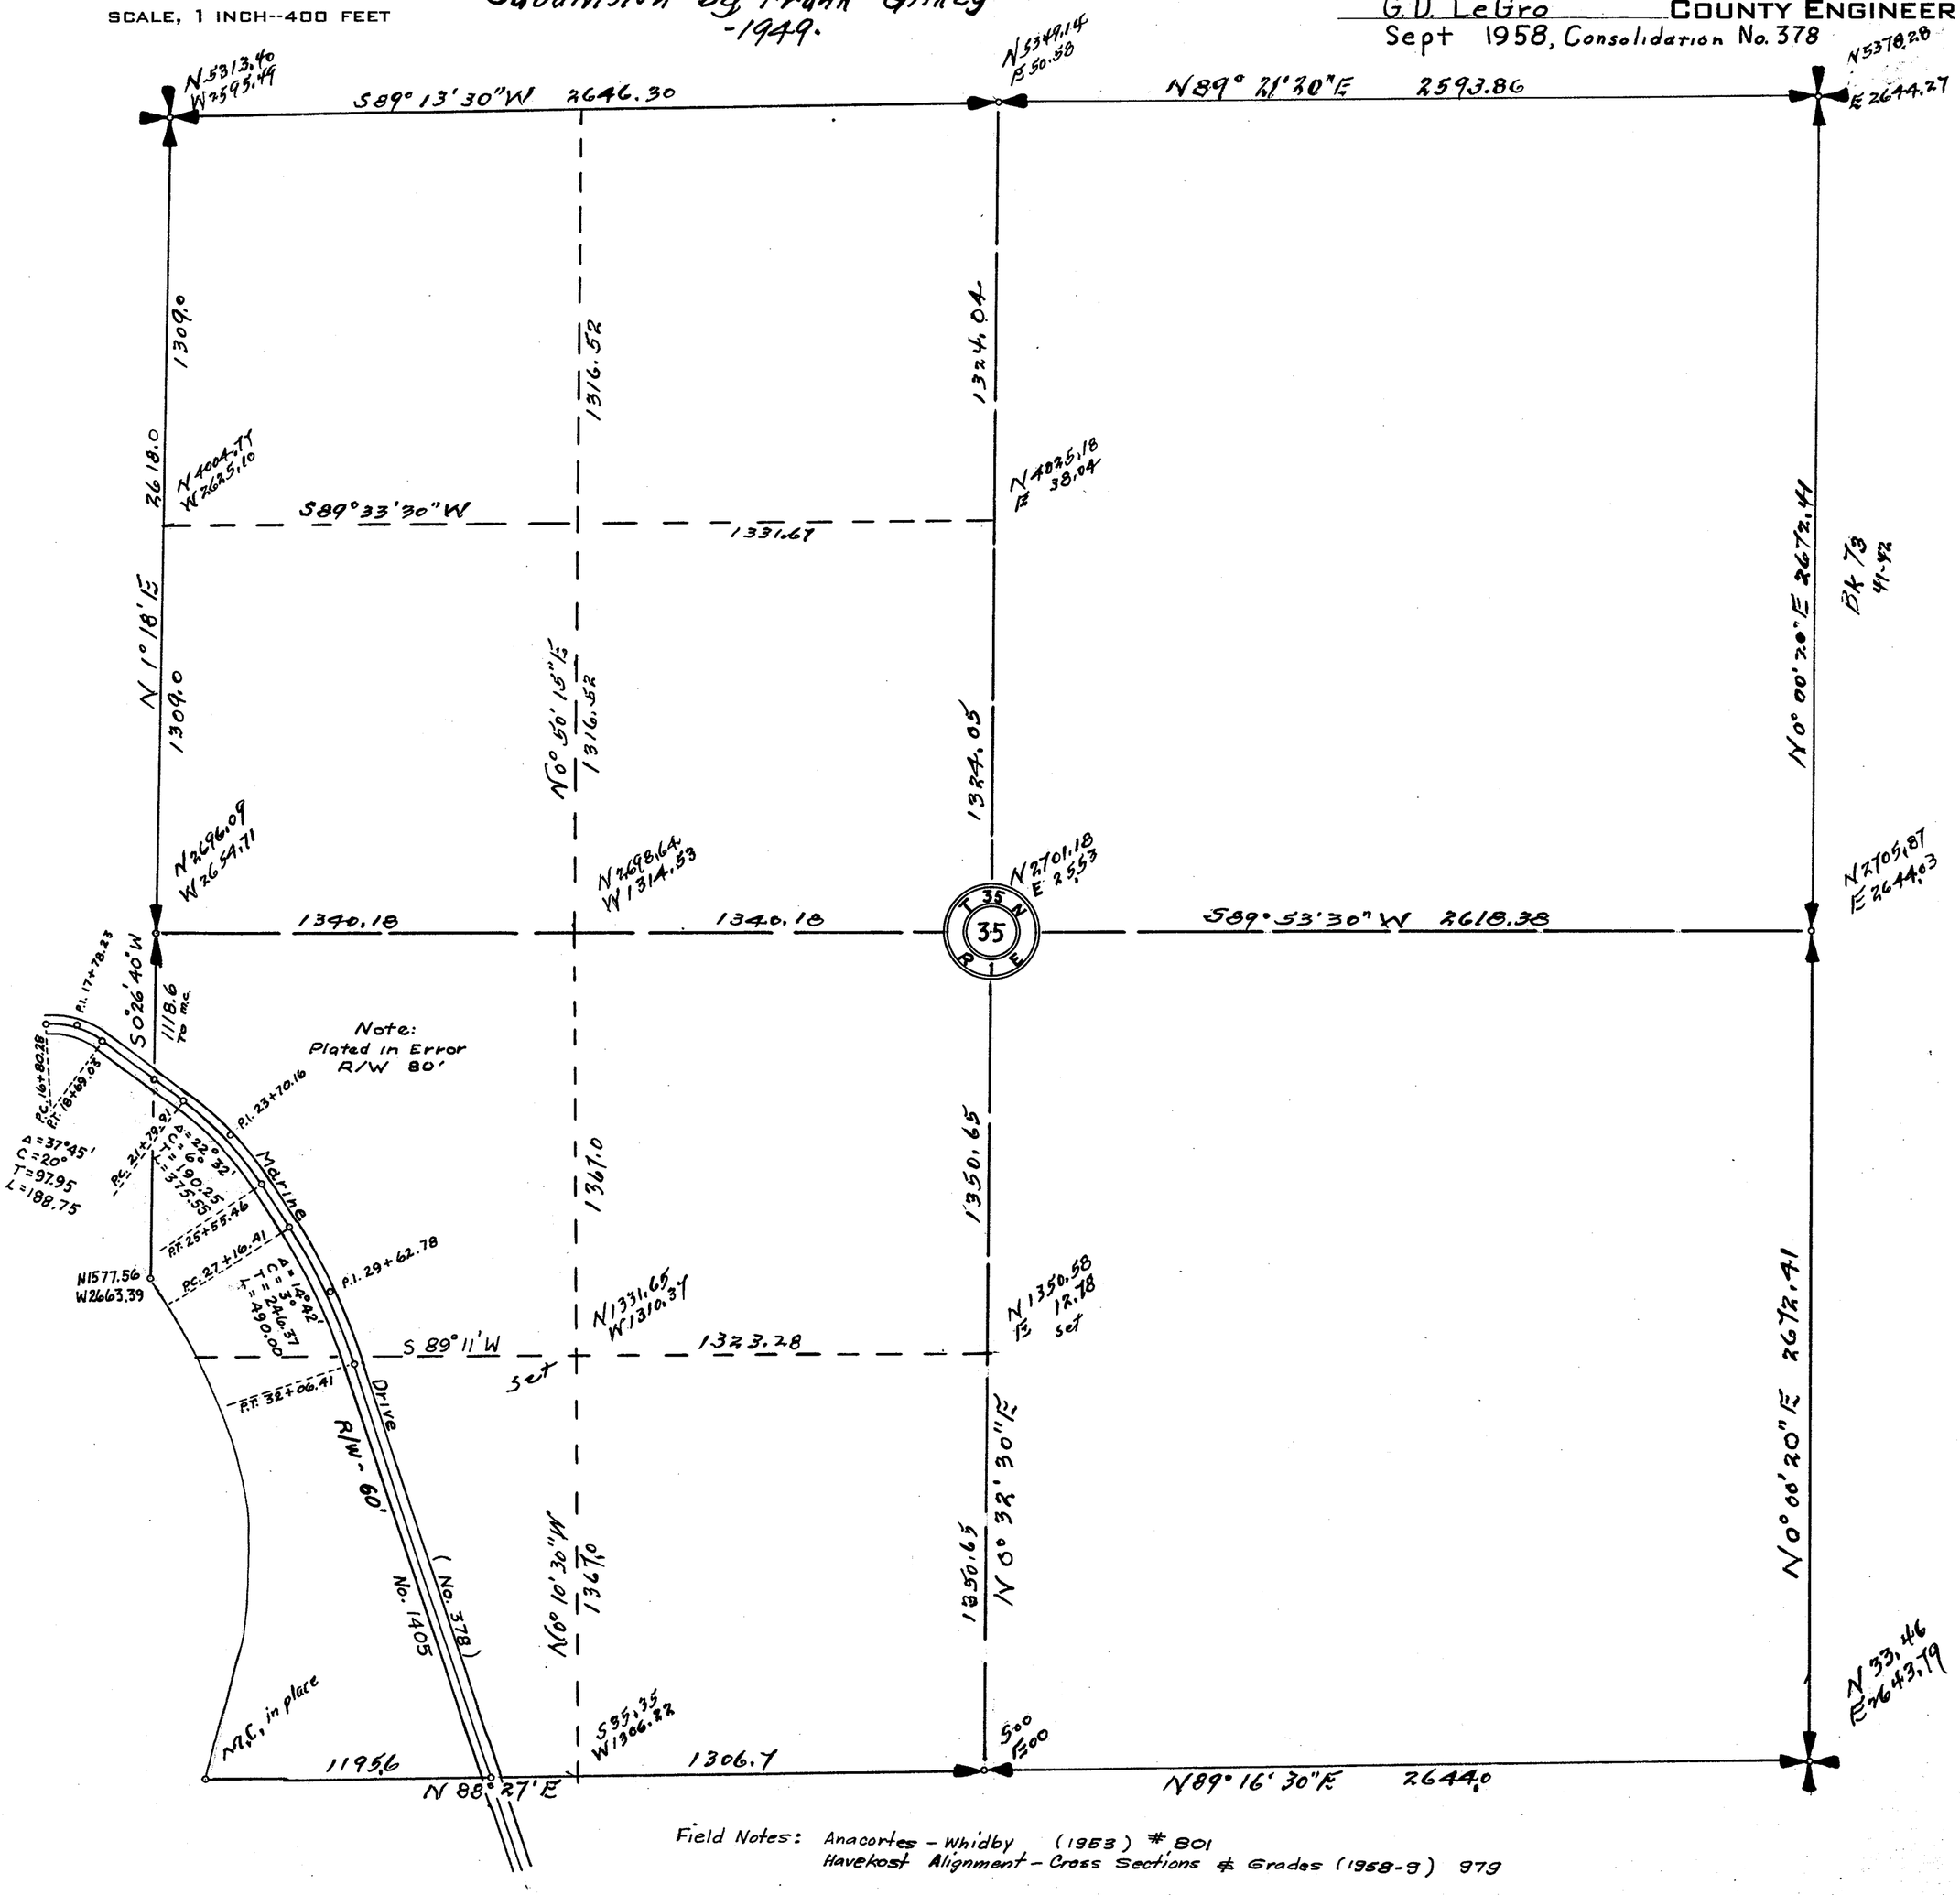

Field Notes: Anacortes - Whidby (1953) # 801
Havekost Alignment - Cross Sections & Grades (1958-9) 979

SECTION 36
TOWNSHIP 35 NORTH, RANGE 1 EAST, W. M.
SKAGIT COUNTY, WASH.

SCALE, 1 INCH--400 FEET

G D LeGro
July 1958
COUNTY ENGINEER

N9002.54
E2715.53
Stone Mon.
F. Post (48)
P. Pole (48)
28.00
29.90
31.50
12" FIR STP. (48)
N.89°20'30"E.
2677.91'
N9033.20
E5393.26
3/4 Bolt
1/4 Cor
S.88°51'40"E.
2661.68'
Stone Mon.
Copper wire (48)
N8980.31
E8054.41
Stone Mon.
26.00
F. POST (48)
P. Pole (48)
N.0°00'20"E.
2660.24'
30" Cedar
28.20
N.1°03'10"E.
2647.67'
18" cedar (48)
20.60
30" Cedar Stp. (48)
13.10
1" Pipe
2285.66'
S.89°54'E.
2659.57'
2630.55
(48) 6x6 Post
1" Pipe
23.00
12" Hemlock (48)
Heart Lake Road 1121
(C.R. Donnel Road)
N1°05'E
P.T. 36+83.90
Δ 3°13' Rt
C 1°
T 160.90
L 321.70
P.I. 35+23.10
P.C. 33+62.20
Δ 24°04' Lt
C 12°
T 101.80'
L 200.60'
P.T 26+89.0
P.C. 24+88.4
25+90.20 P.I.
Equation
23+46.8 Ahead
23+40 Back
N25°09'E
2695.71'
P.T. 22+22.0
P.I. 20+90.9
P.C. 19+58.10
Δ 15°50' R
C 6°
T 132.8'
L 263.9'
N 9°19'E
Heart Lake Road # 1121 R/W 60'
Heart Lake
(C.R. Donnel Road)
Heart Lake
Δ 39°10' Rt
C 14°
T 145.60'
L 279.80'
P.T. 9+141.90
P.C. 6+35.10
N15°51'W
2683.48
N 0°22'50"E
Δ 51°02' Lt
C 20°
T 136.80
L 255.20
P.T. 4+62.50
P.C. 2+07.30
N12°19'E
Δ 41°05' Lt
C 20°
T 107.3
L 205.4
P.C. 3+92.30
0+00
P.T. 5+00
P.T. 5+98.10
N15°54'W
Δ 60°00 Rt
C 20°
T 137.8'
L 250.0'
R 238.73
P.C. 8+29.30
P.T. 10+79.3
N.0°07'E.
2670.50'
N 40° 06' E
Heart Lake
Found 1" pipe old hub 1948
1" Iron Pipe
N3671.80
E2710.33
35
36
N.89°37'02"W.
2647.24'
919.11' to P.O.C.
36
1
2"x 2" Post
N3654.13
E5357.51
2
1
17.80
58.30
24.70
6' Fir (48)
18" Cedar (48)
30" Fir stp. (48)
30'
20'
P.T.
P.T. 19+35.3
S. 56°43'47"E.
40°30'
P.T. 22+34.9
Δ=17°58'30"
D=6°
T=151.0'
L=299.6
S.22°07'30"W.

GEN. NOTE: ROAD NO. CHANGES AUG. 1964
Monuments added Jan. 1978 from Hrd.shell A1/4
Road changes noted Jan 1978 from Hardshell A1/4 1960

Field Notes: Donnel Rd. #2 (1938) #38/335
Heart Lake Rev. (3/11/38) #38/335
Donnel Rd. #2 - Heart Lake - South (1948) # 48/618 (LL-5)

SECTION 35


TOWNSHIP 35 NORTH, RANGE 1 EAST, W. M.

SKAGIT COUNTY, WASH.

SCALE, 1 INCH--400 FEET

DATE (12) AUG. 1965

COUNTY ENGINEER

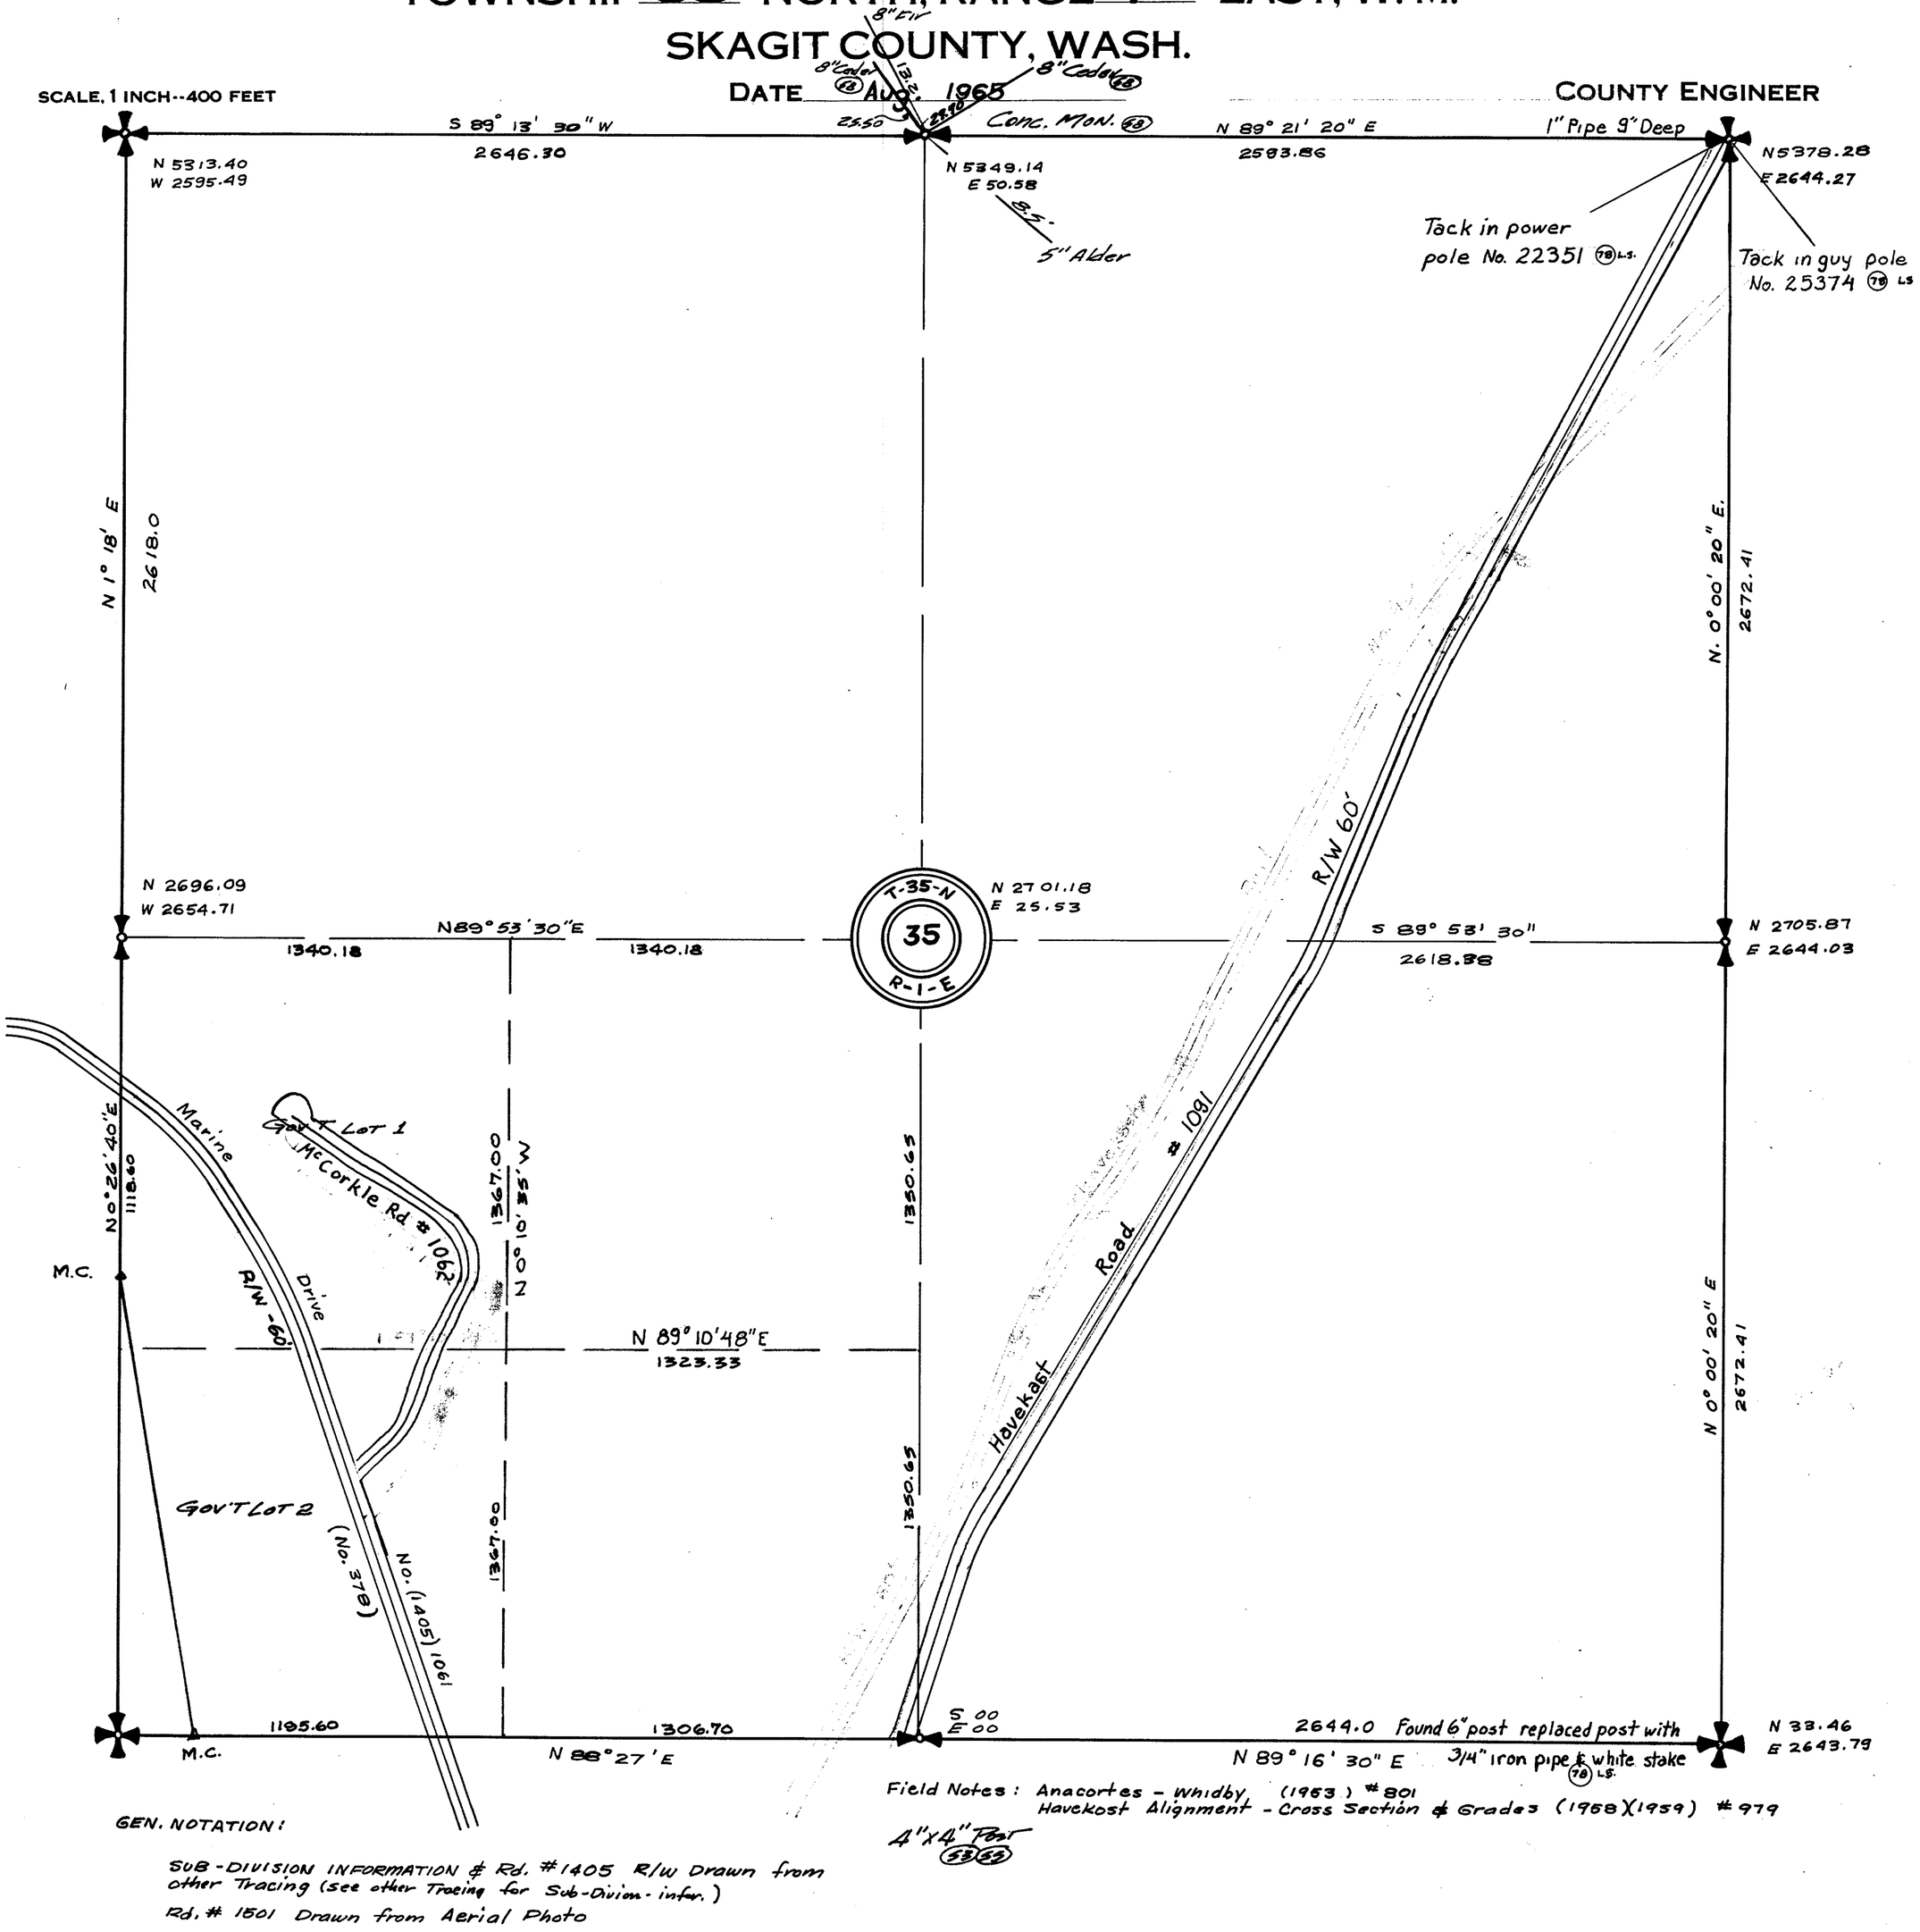

Field Notes: Anacortes - Whidby (1953) #801
Havekost Alignment - Cross Section & Grades (1958 X 1959) #979

4"x4" Post (53) (52)

GEN. NOTATION:

SUB-DIVISION INFORMATION & Rd. #1405 R/W Drawn from other Tracing (see other Tracing for Sub-Divion. infor.)

Rd. # 1501 Drawn from Aerial Photo


SECTION 6

TOWNSHIP 35 NORTH, RANGE 2 EAST, W. M.

SKAGIT COUNTY, WASH.

SCALE, 1 INCH--400 FEET

G. D. LeGro COUNTY ENGINEER
July 1958
Monuments added Dec. 1978

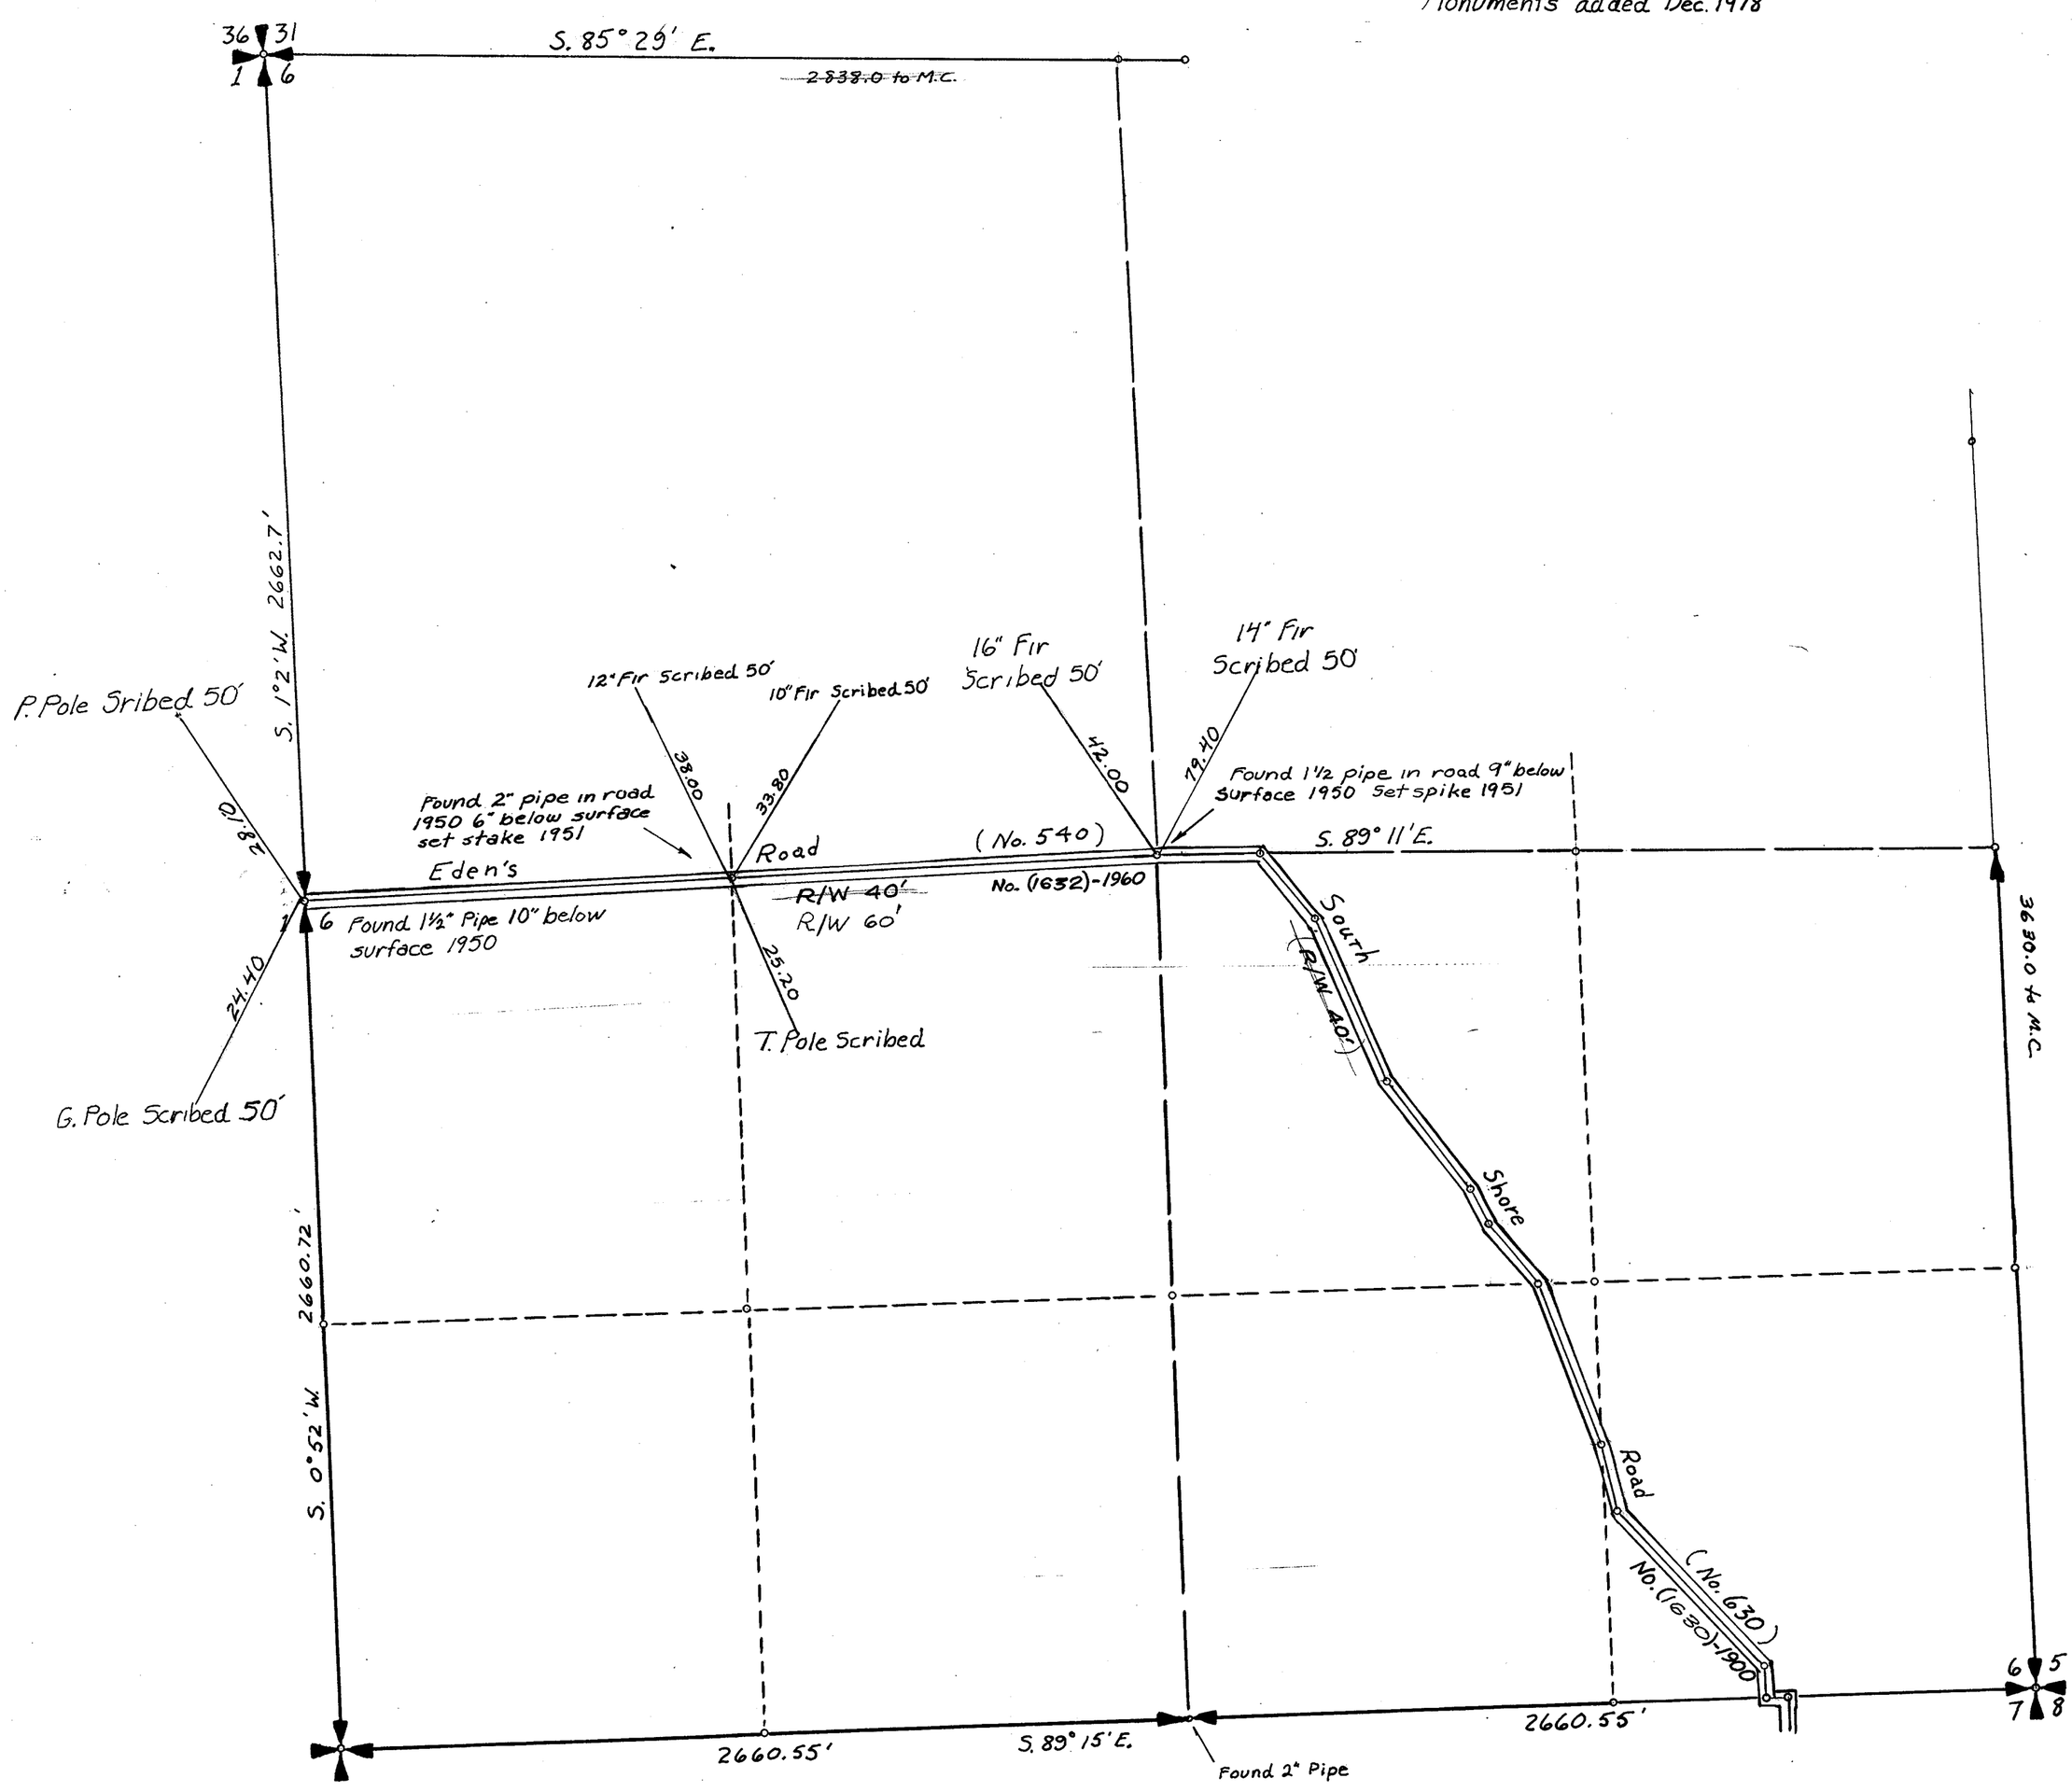

Map of Subdivision Survey of S.½ and N.W.¼ of Sec. 6. T. 35. N. R. 2. E. W. M.
Guemes I'd. Skagit Co. Wash.

Subdivided according to instructions by U.S. Surveyor General by rules established by U.S. Land Office.

Scale 400' = 1" *Feb.-Mar. 1915.*

W. Edward Newbert C.E.

Corners found and established, Cedar Posts Mkd. except as shown.

Corner found and checked from B.T.s. S. 85° 29½" E. 1343'

Corner Established proportionally. 2686' 1343'

Corner Established from B.T.s. 1/4 Cor. M.C. 201.45

Approx. Meander Line by Gov. Approx. High Tide Line Notes Feb. 1915

In Error

N. Var. 24° 15'

N½ Lot 2. 20.6 A.

Lot 3. 41.1 A.

S½ Lot 2, W. W. Boynton. 20.6 A.

Lot 1. 29.4 A.

4"x4" Cedar Post. 1¼" gal. pipe. 2½" Pipe. 1¼" Rod.

S. 89° 25' E. 1341.88'

N. 89° 20¼ W. 1340.76'

670.38' 670.38' 1308.51

S. 1° 2' W. 2662.7'

W½ Lot 4. R. W. Spencer. 20.5 A.

N.E.¼ Lot 4. Rolph. 10.26 A.

S.E.¼ Lot 4. Harry Causland. 10.26 A.

S.E.¼ N.W.¼. Frank Causland. 41.1 A.

40.4 A.

Lot 7. 38.5 A.

S. 89° 15½' E. 669.82'

S. 1° 5' W. 666.58

N. 1° 43' E. 667.485'

S. 1° 13½' W. 1338.59' 2677.18'

1342.21'

1333.16' 666.38' 1334.97' 667.485' 1338.52'

1/4 Cor. 1½" Pipe. 669.26' 669.26' 1338.52'

2" C.I. Pipe. 2½" Pipe. 1½" Pipe. S. 89° 11' E. 5308.57' 1315.765'

1½"x26" Bolt. 325.765' 2½" Pipe. 1315.765' 990' 6 5 4 Cor.

Corner preserved by Frank Causland.

Lot 5. Frank Causland. 40.8 A.

40.8A. 40.2 A 10.05A. 30.18A.

1330.36' 1329.665' 1328.97' 1328.26' N. 0° 54½' E. 1328.08' N. 0° 36' E. 1328.08' 1327.55'

S. 1° 23½' W. 2657.94'

4"x4" Cedar Post. 4"x5" Cedar Post. 2½" Pipe. 4"x4" 2655.1' Cedar Post.

1334.397' 1334.397' S. 89° 13' E. 5314.83' 1323.02' 333.02' 990' 1323.02'

Corner found and checked from B.T.s. S. 0° 52' W. 2660.72'

Corner found and N. 0° 36' E. checked from B.T.s.

Nick Bessner

Lot 6. 40.7A. 40.7A. 40.4A. 40.4A.

1330.275' 1330.275' 1330.275' 1330.275'

2½" Pipe. 4 Cor. 5321.1' S. 89° 15' E. 665.14' 665.14'

12 7 8 2" Pipe.

Oak St. Ash St. Elm St. Ave. Ave. Ave. Vashon

Anacortes

Wheldon Griffith Kanagke. F. Magill.


SECTION 7

TOWNSHIP 35 NORTH, RANGE 2 EAST, W. M.

SKAGIT COUNTY, WASH.

SCALE, 1 INCH--400 FEET

G. D. Le Gro
July 1958
COUNTY ENGINEER

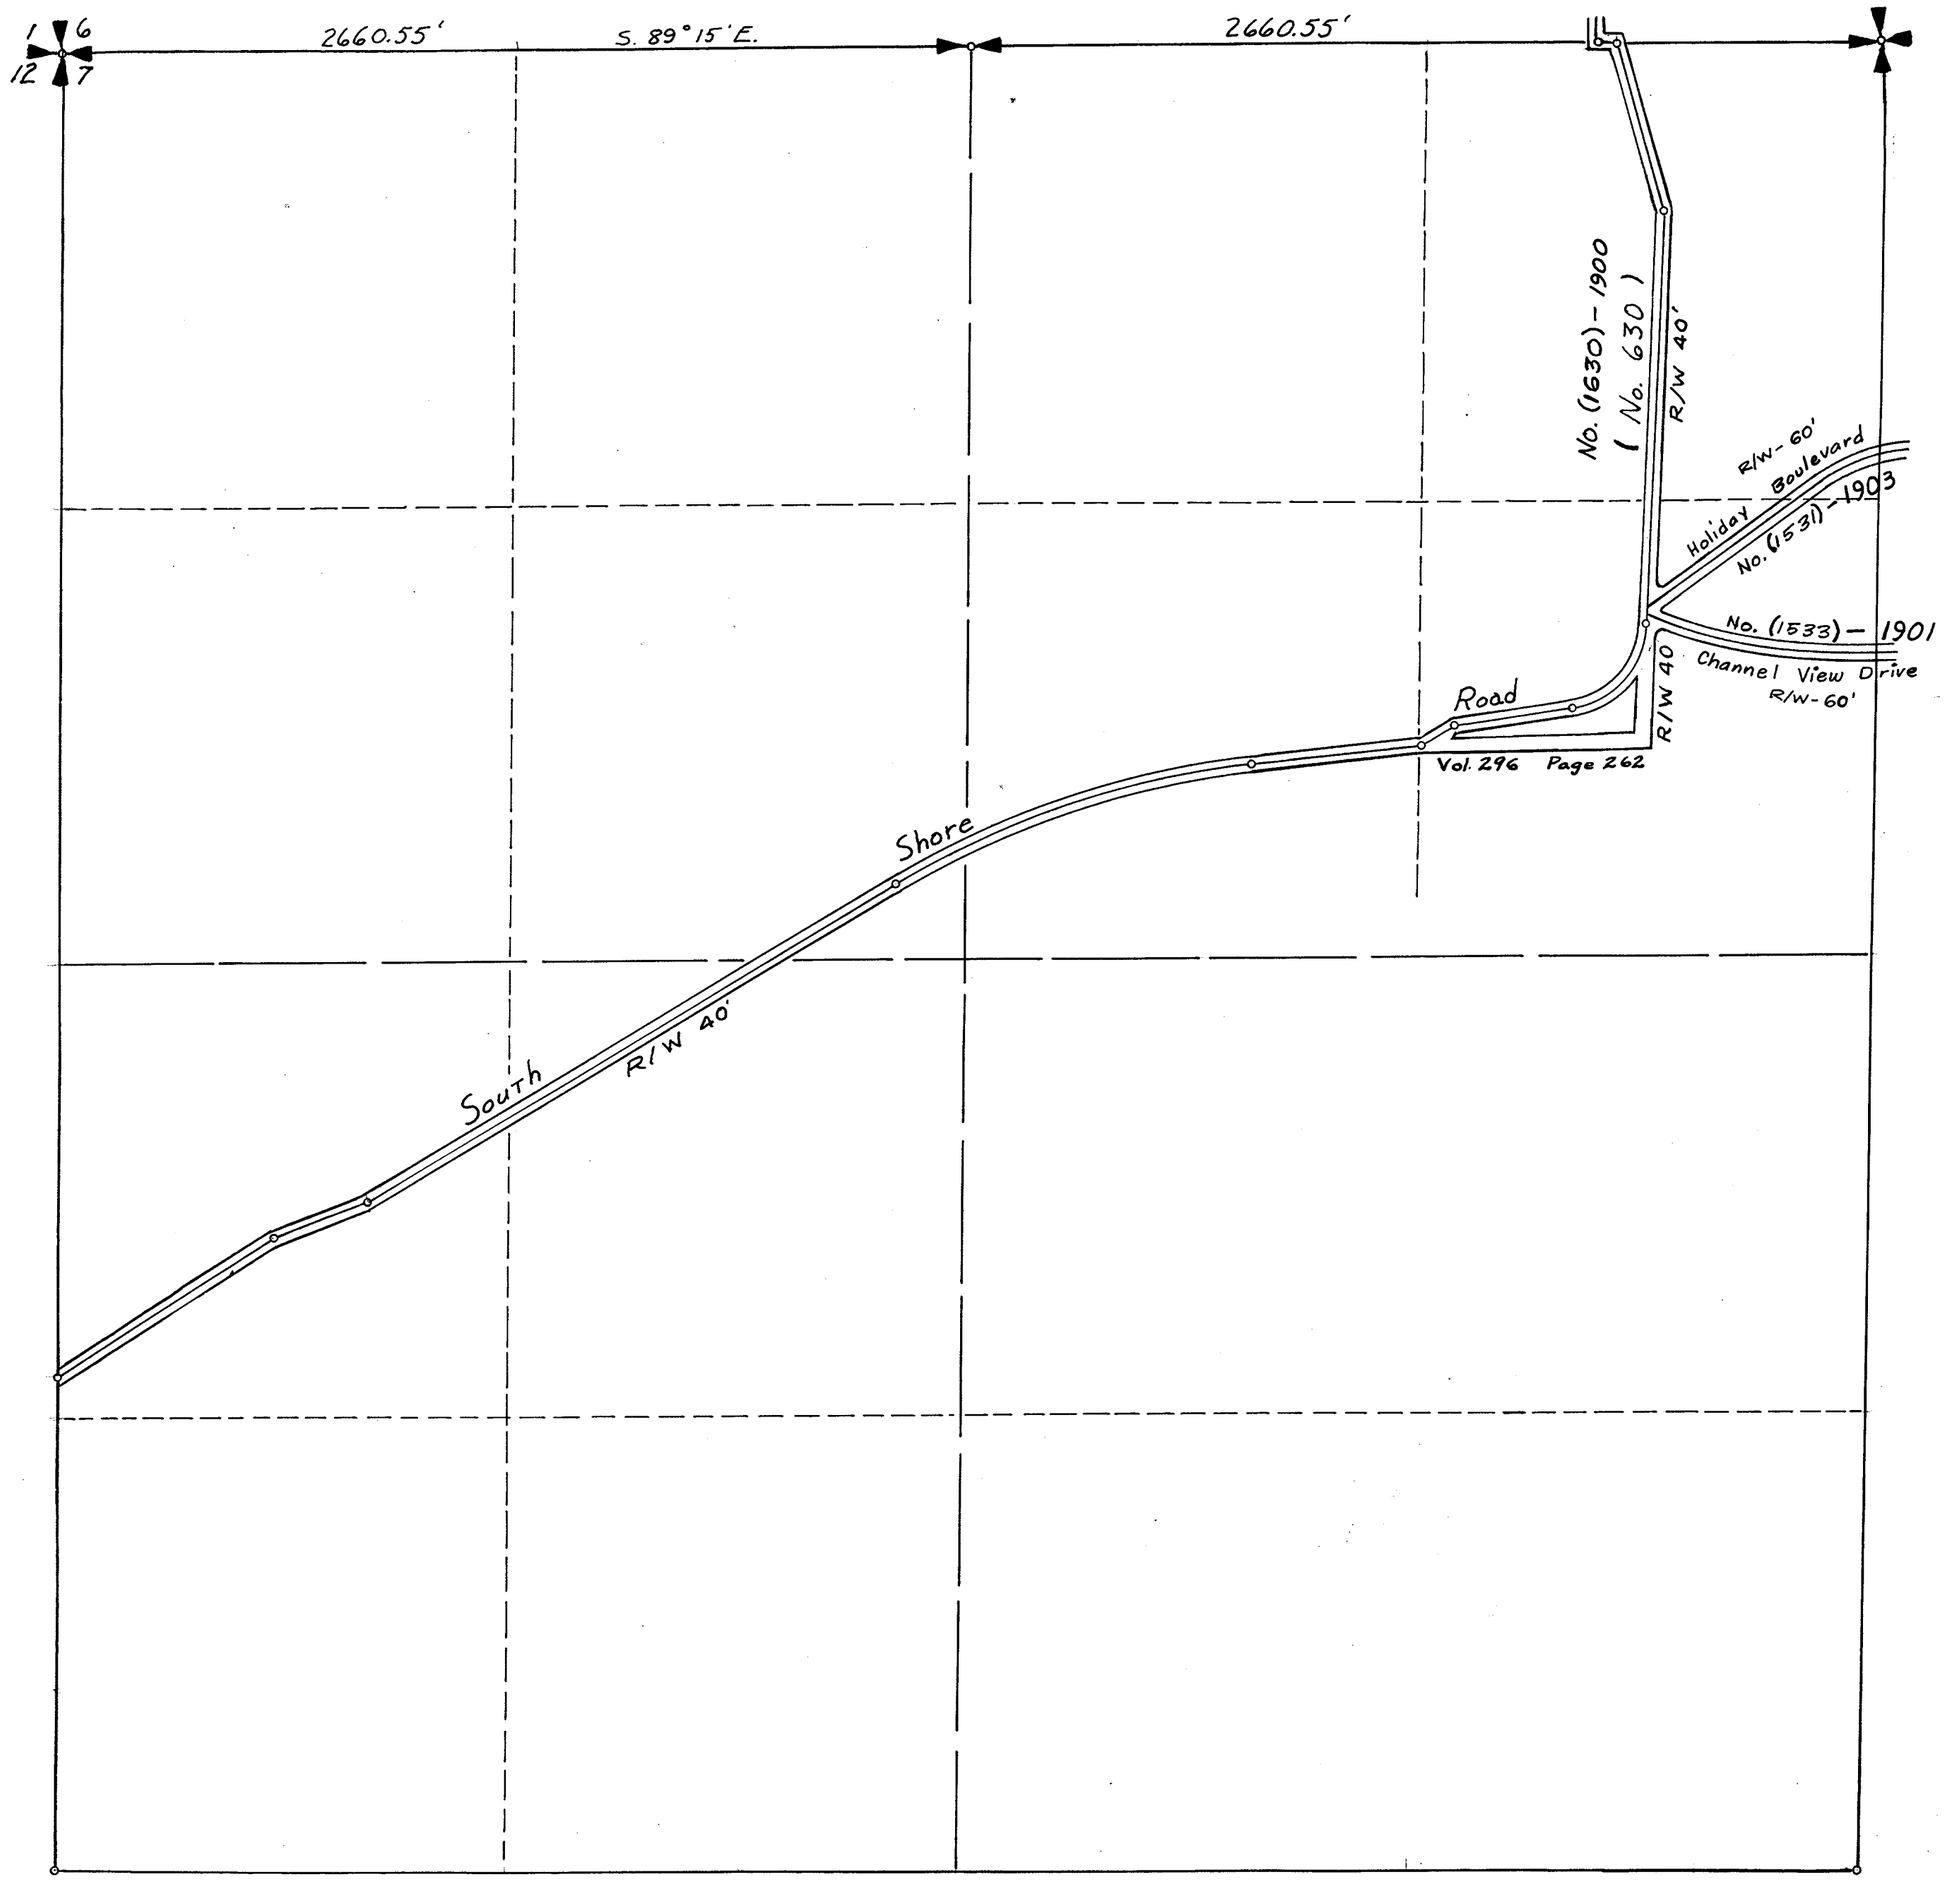

SECTION 8


TOWNSHIP 35 NORTH. RANGE 2 EAST. W. M.

SKAGIT COUNTY. WASH.

SCALE, 1 INCH—400 FEET

LLOYD H. JOHNSON COUNTY ENGINEER

DATE JUNE 20, 1972

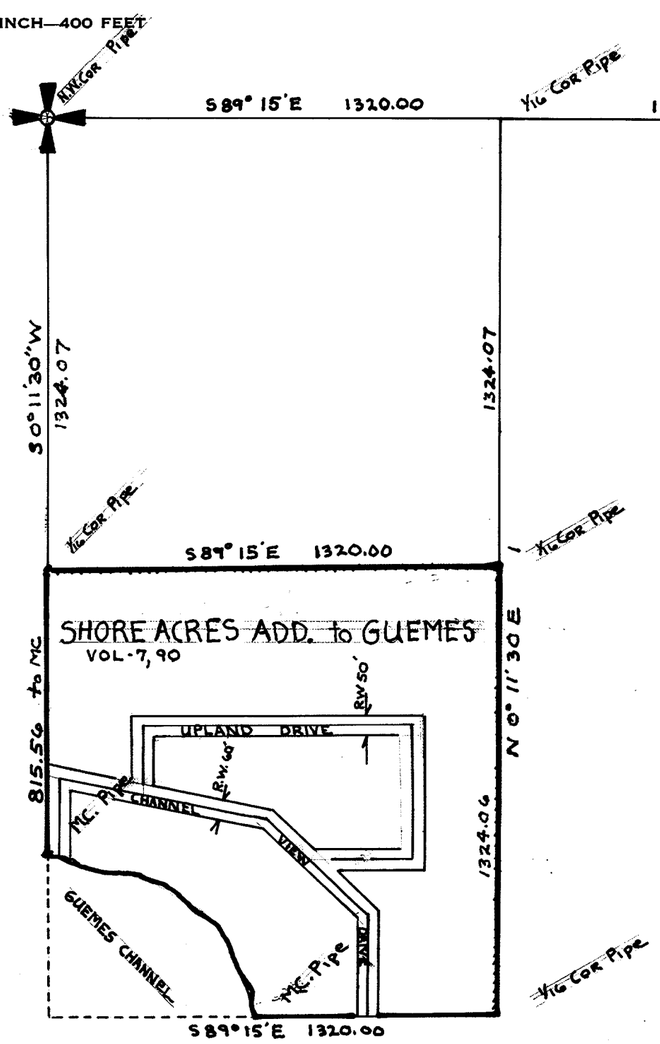

SECTION 8


TOWNSHIP 35 NORTH, RANGE 2 EAST, W. M.

SKAGIT COUNTY, WASH.

SCALE, 1 INCH--400 FEET

DATE Aug. 1965

COUNTY ENGINEER

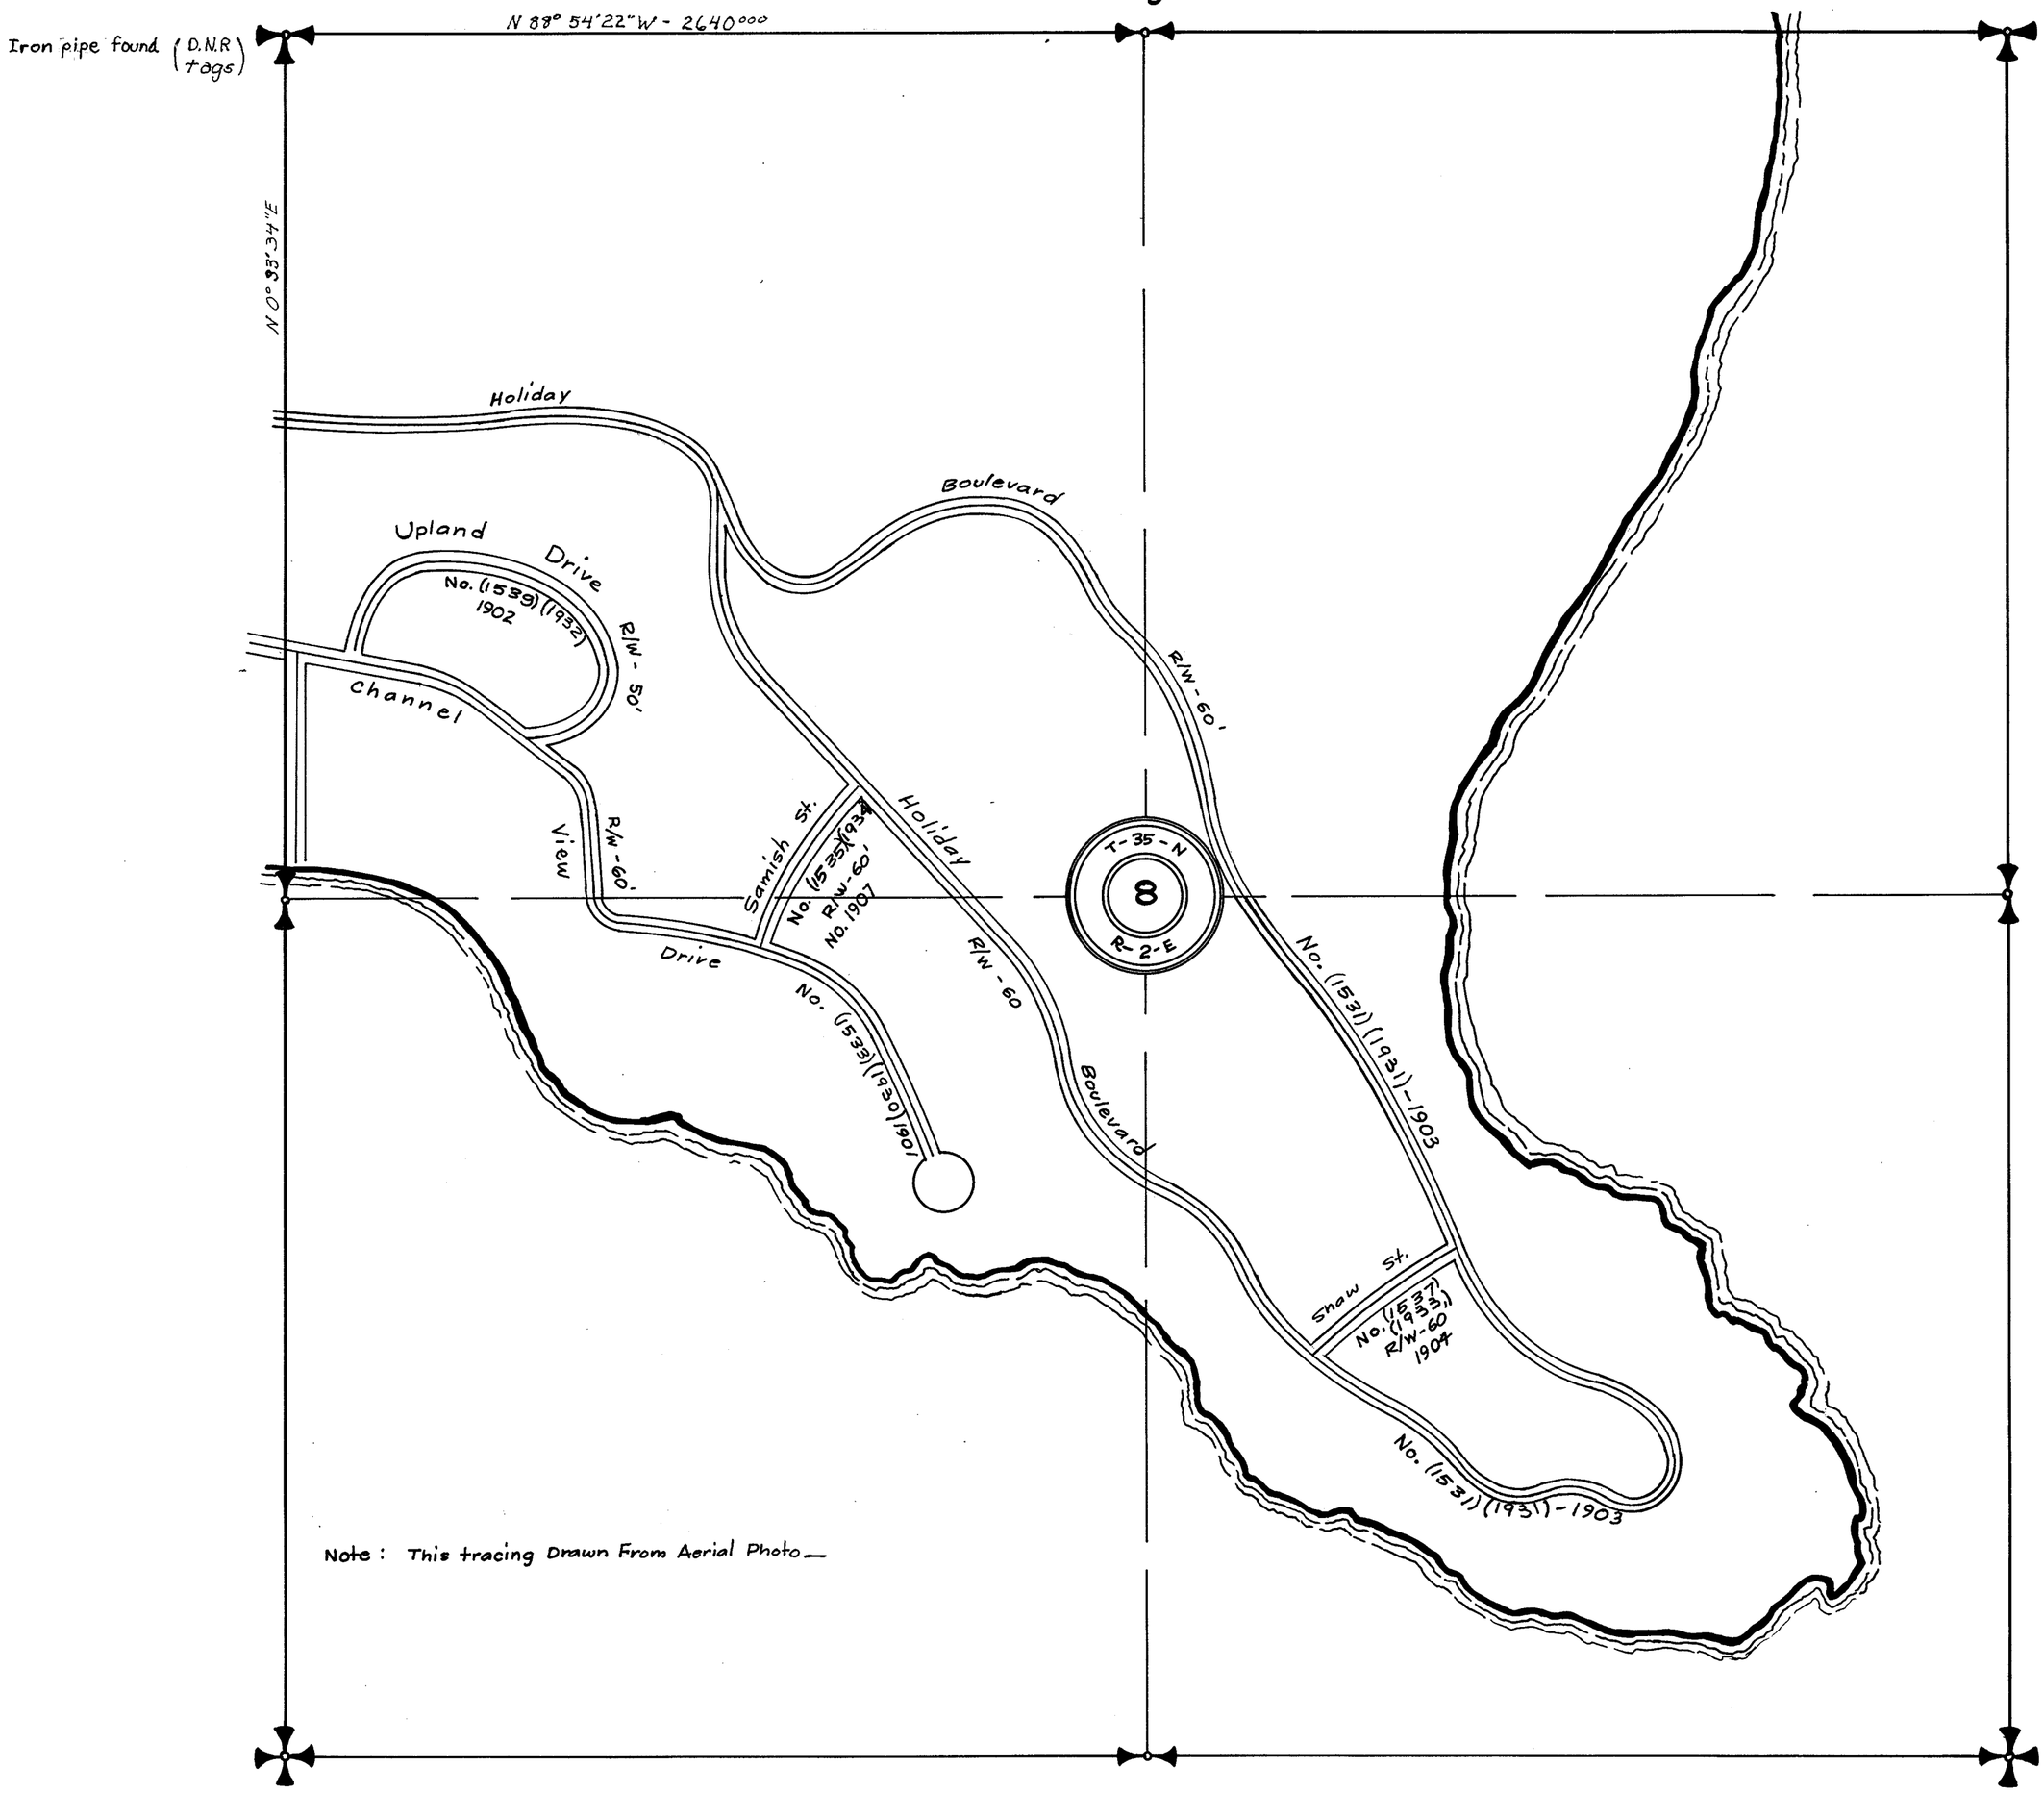

Note : This tracing Drawn From Aerial Photo—


SECTION 21

TOWNSHIP 35 NORTH, RANGE 2 EAST, W. M.

SKAGIT COUNTY, WASH.

SCALE, 1 INCH--400 FEET

G. D. LeGro
July 1958
COUNTY ENGINEER

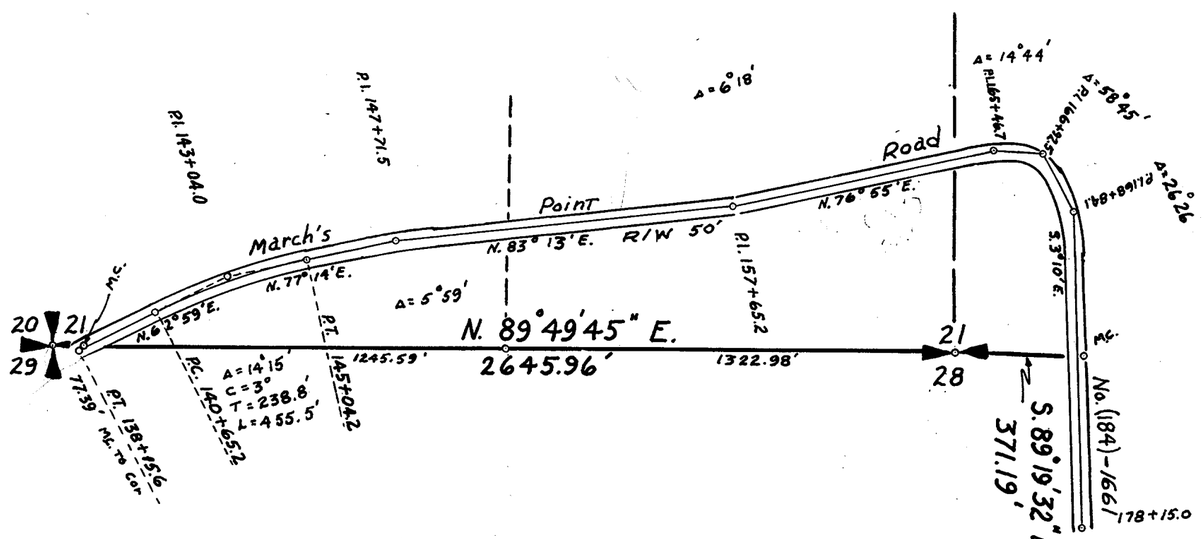

SECTION 21


TOWNSHIP 35 NORTH. RANGE 2 EAST. W. M.

SKAGIT COUNTY. WASH.

SCALE. 1 INCH—400 FEET

Lloyd H. Johnson COUNTY ENGINEER

DATE June 19, 1972

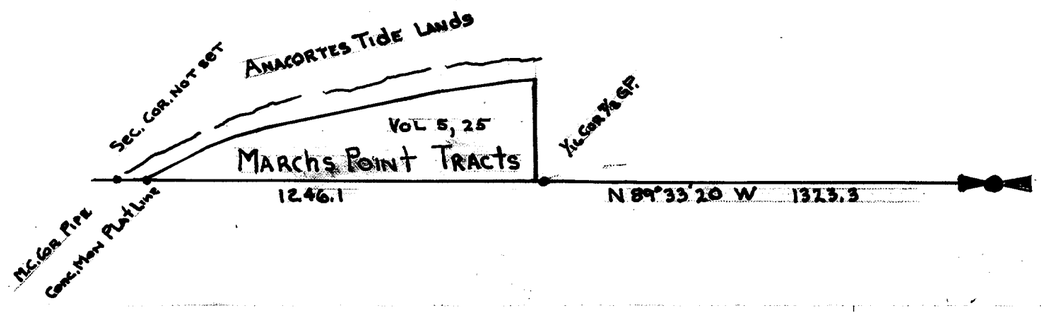


SECTION 28

TOWNSHIP 35 NORTH. RANGE 2 EAST. W. M.
SKAGIT COUNTY. WASH.

SCALE. 1 INCH—400 FEET

DATE June 20, 1972

Lloyd H. Johnson COUNTY ENGINEER

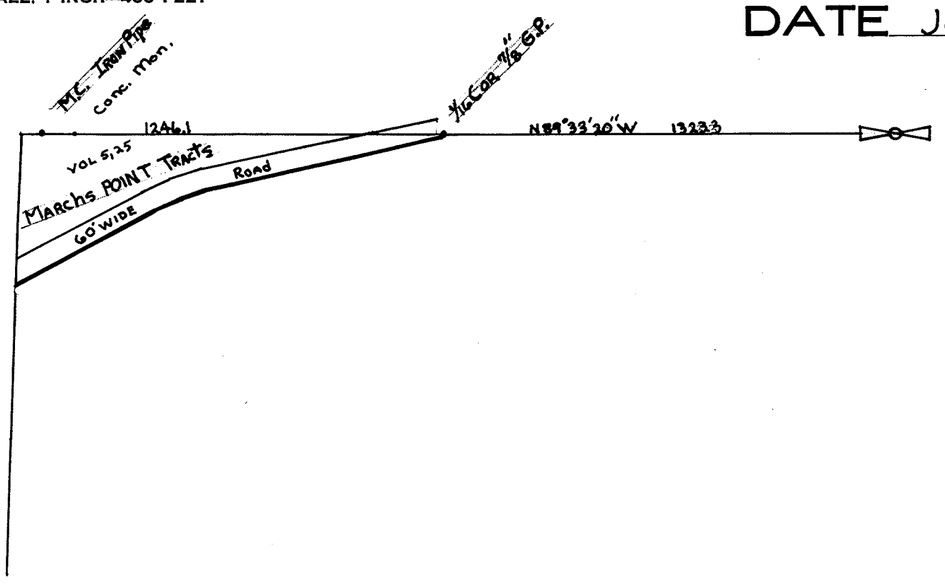

SECTION 28


TOWNSHIP 35 NORTH, RANGE 2 EAST, W. M.

SKAGIT COUNTY, WASH.

SCALE, 1 INCH--400 FEET

H.O. Walberg COUNTY ENGINEER
July 1947 by LeGro

Assembled Subdivision from
Field Notes: H - 208
Transit Books: No. 66
No. 67
Plat: March's Point Tracts
July 1945

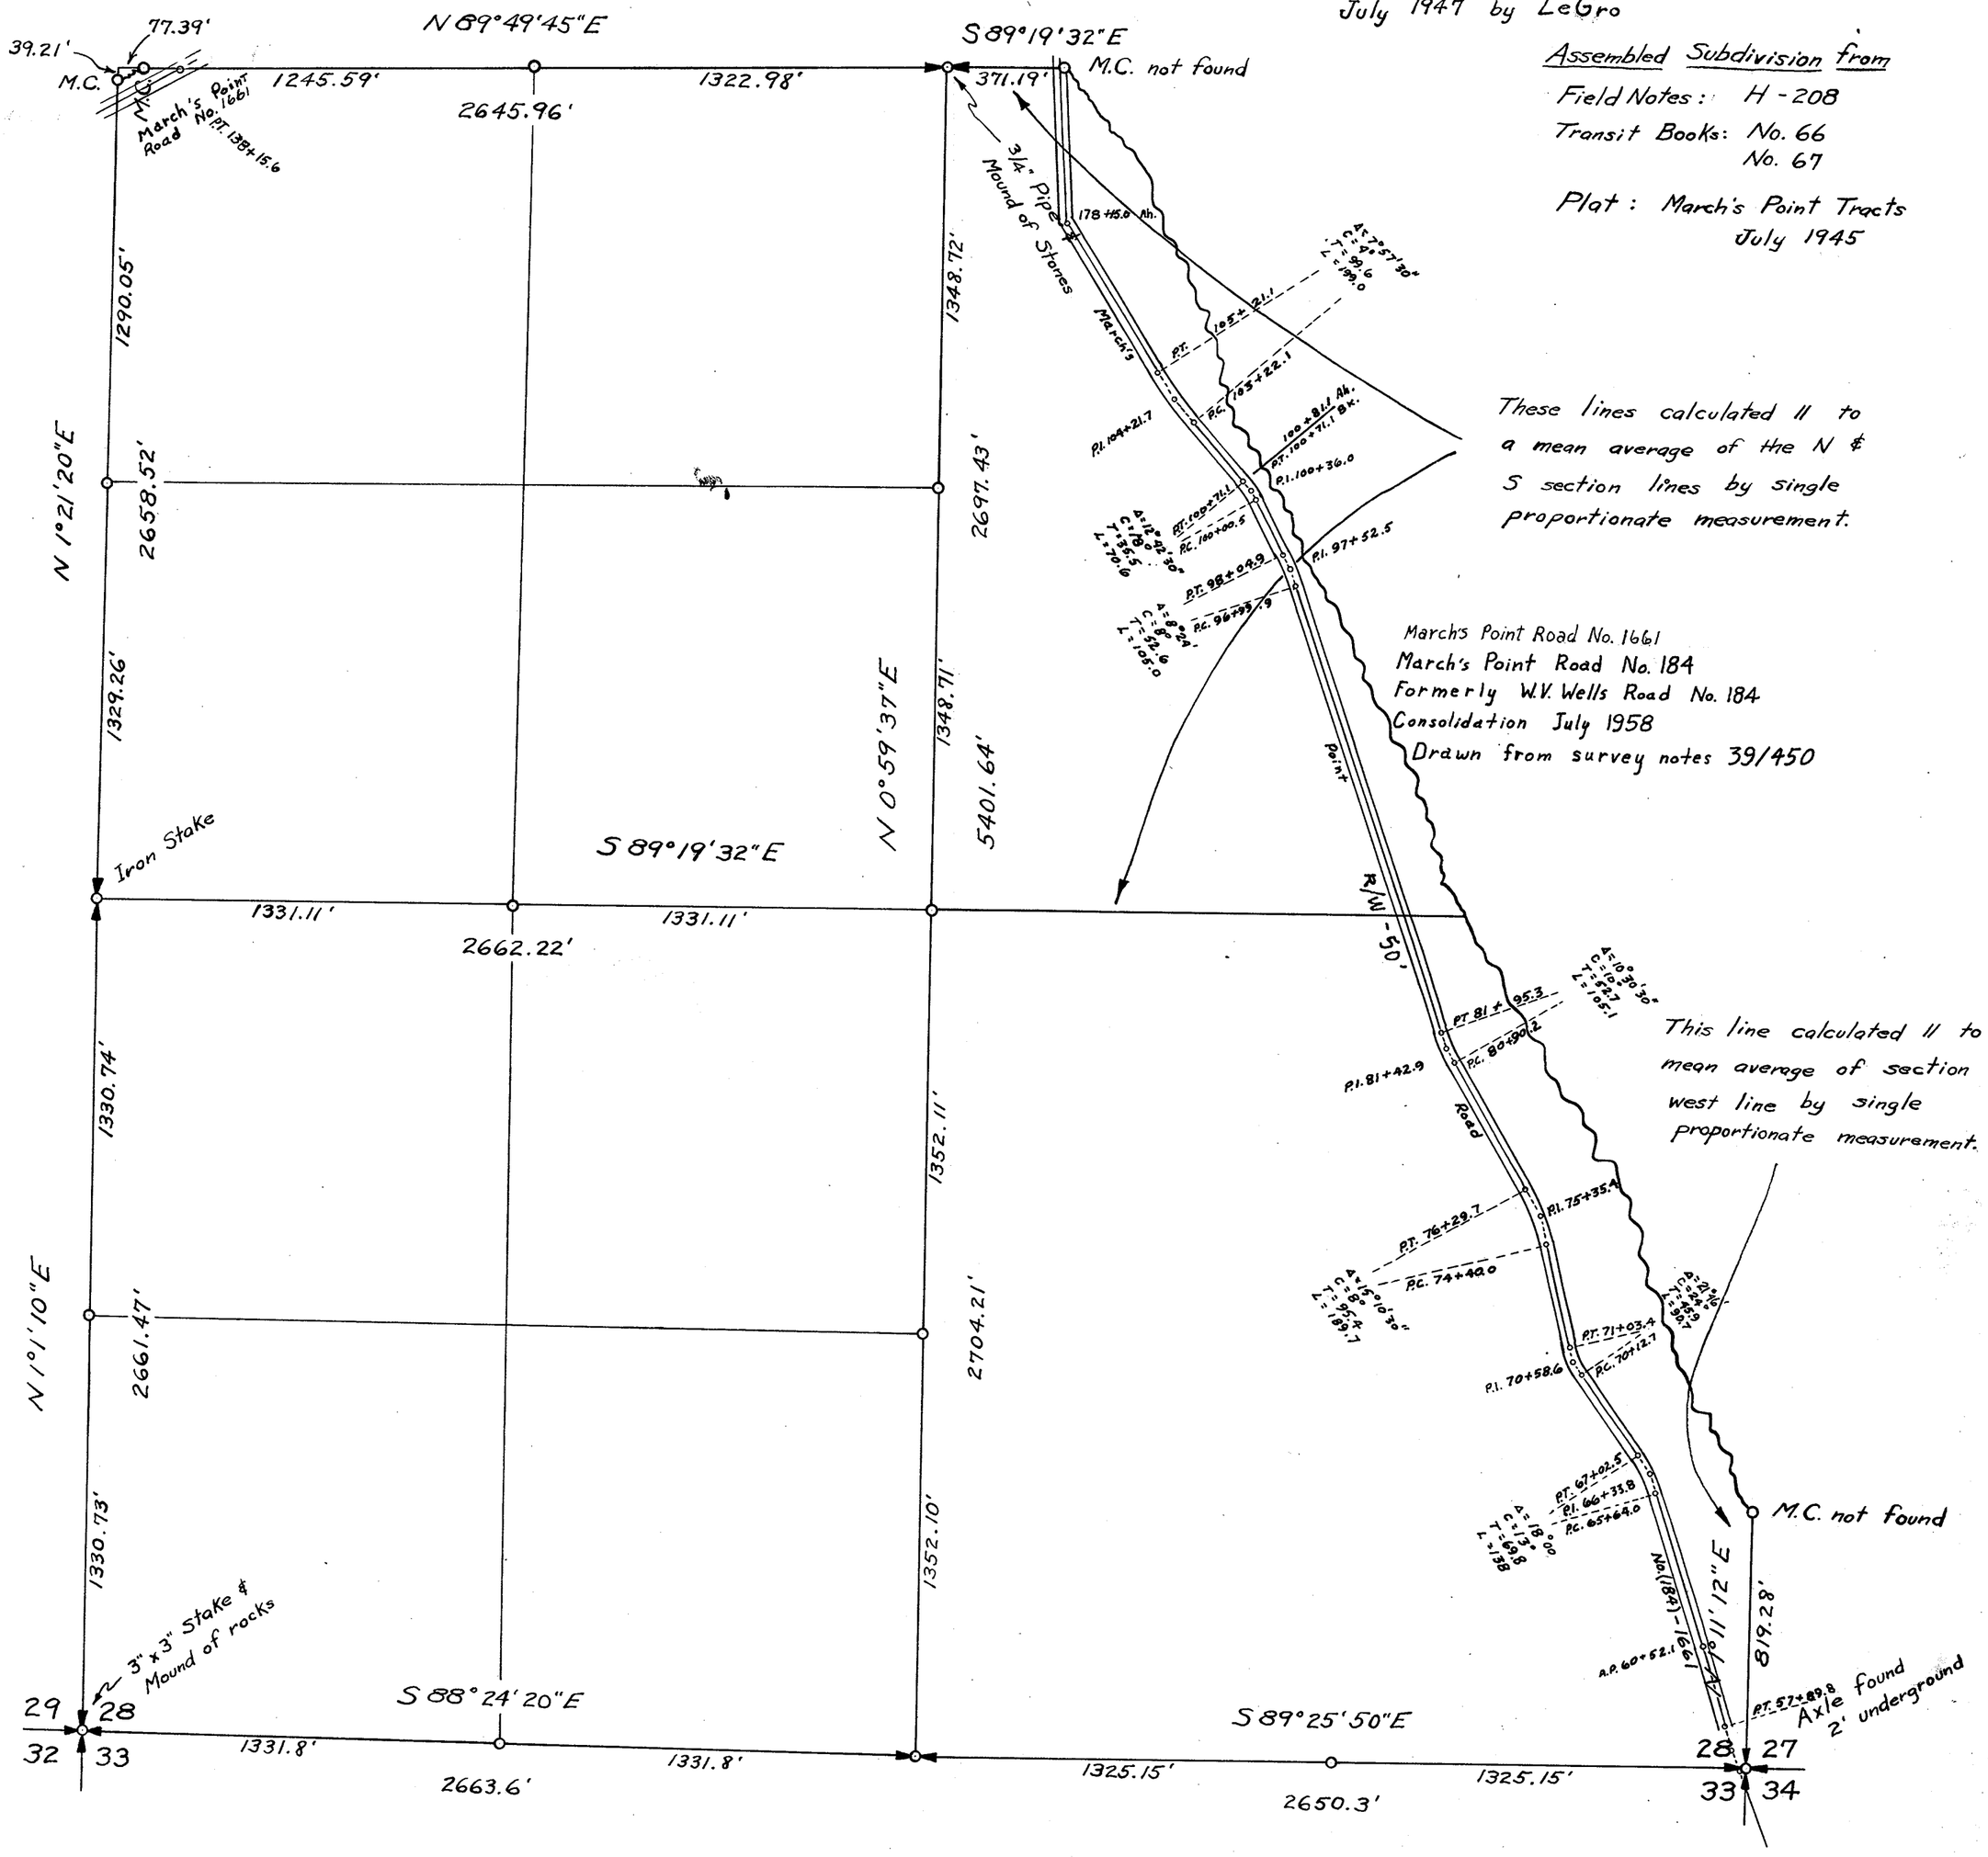


SECTION 29

TOWNSHIP 35 NORTH. RANGE 2 EAST. W. M.
SKAGIT COUNTY. WASH.

SCALE. 1 INCH—400 FEET

LLOYD H. JOHNSON COUNTY ENGINEER


DATE June 20, 1972

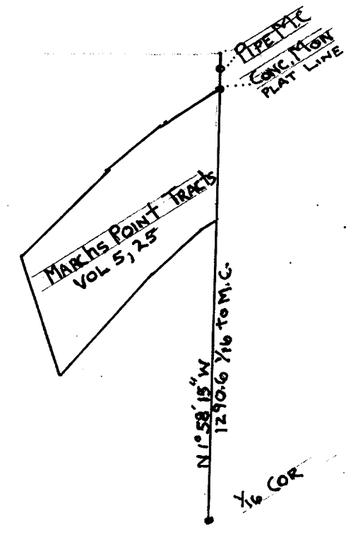

SECTION 29
TOWNSHIP 35 NORTH, RANGE 2 EAST, W. M.
SKAGIT COUNTY, WASH.

SCALE, 1 INCH--400 FEET

G.D. LeGro
July 1958
COUNTY ENGINEER

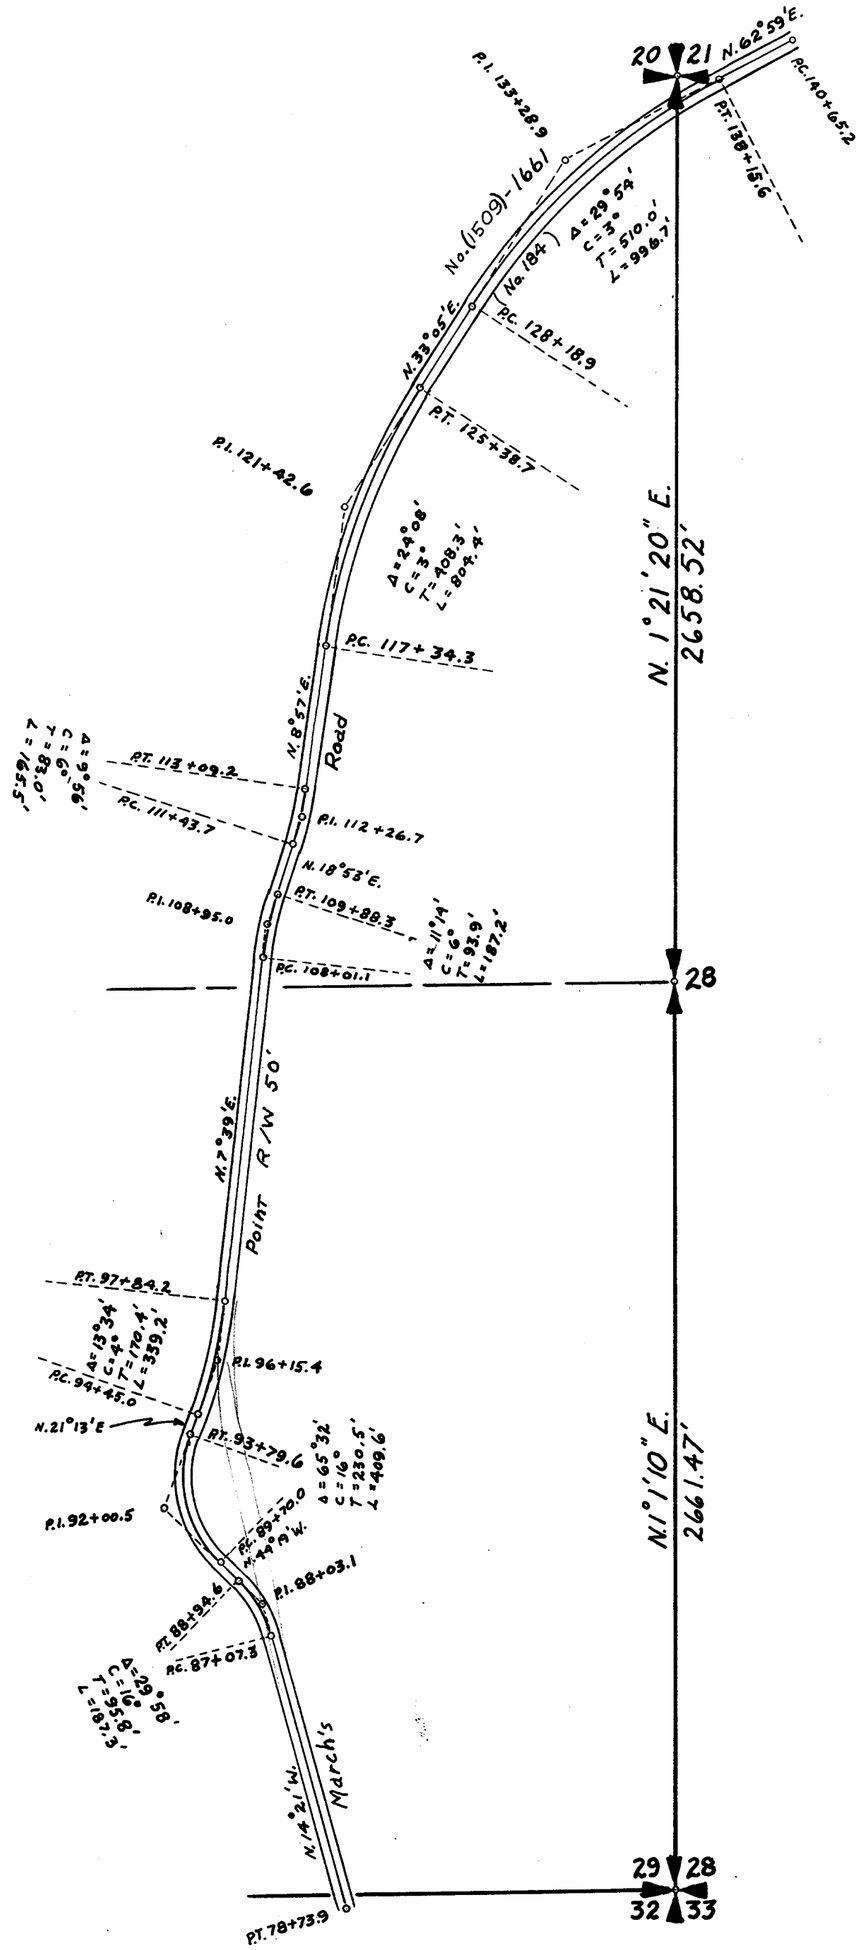

SECTION 31


TOWNSHIP 35 NORTH, RANGE 2 EAST, W. M.

SKAGIT COUNTY, WASH.

SCALE, 1 INCH--400 FEET

DATE Aug. 1965

COUNTY ENGINEER

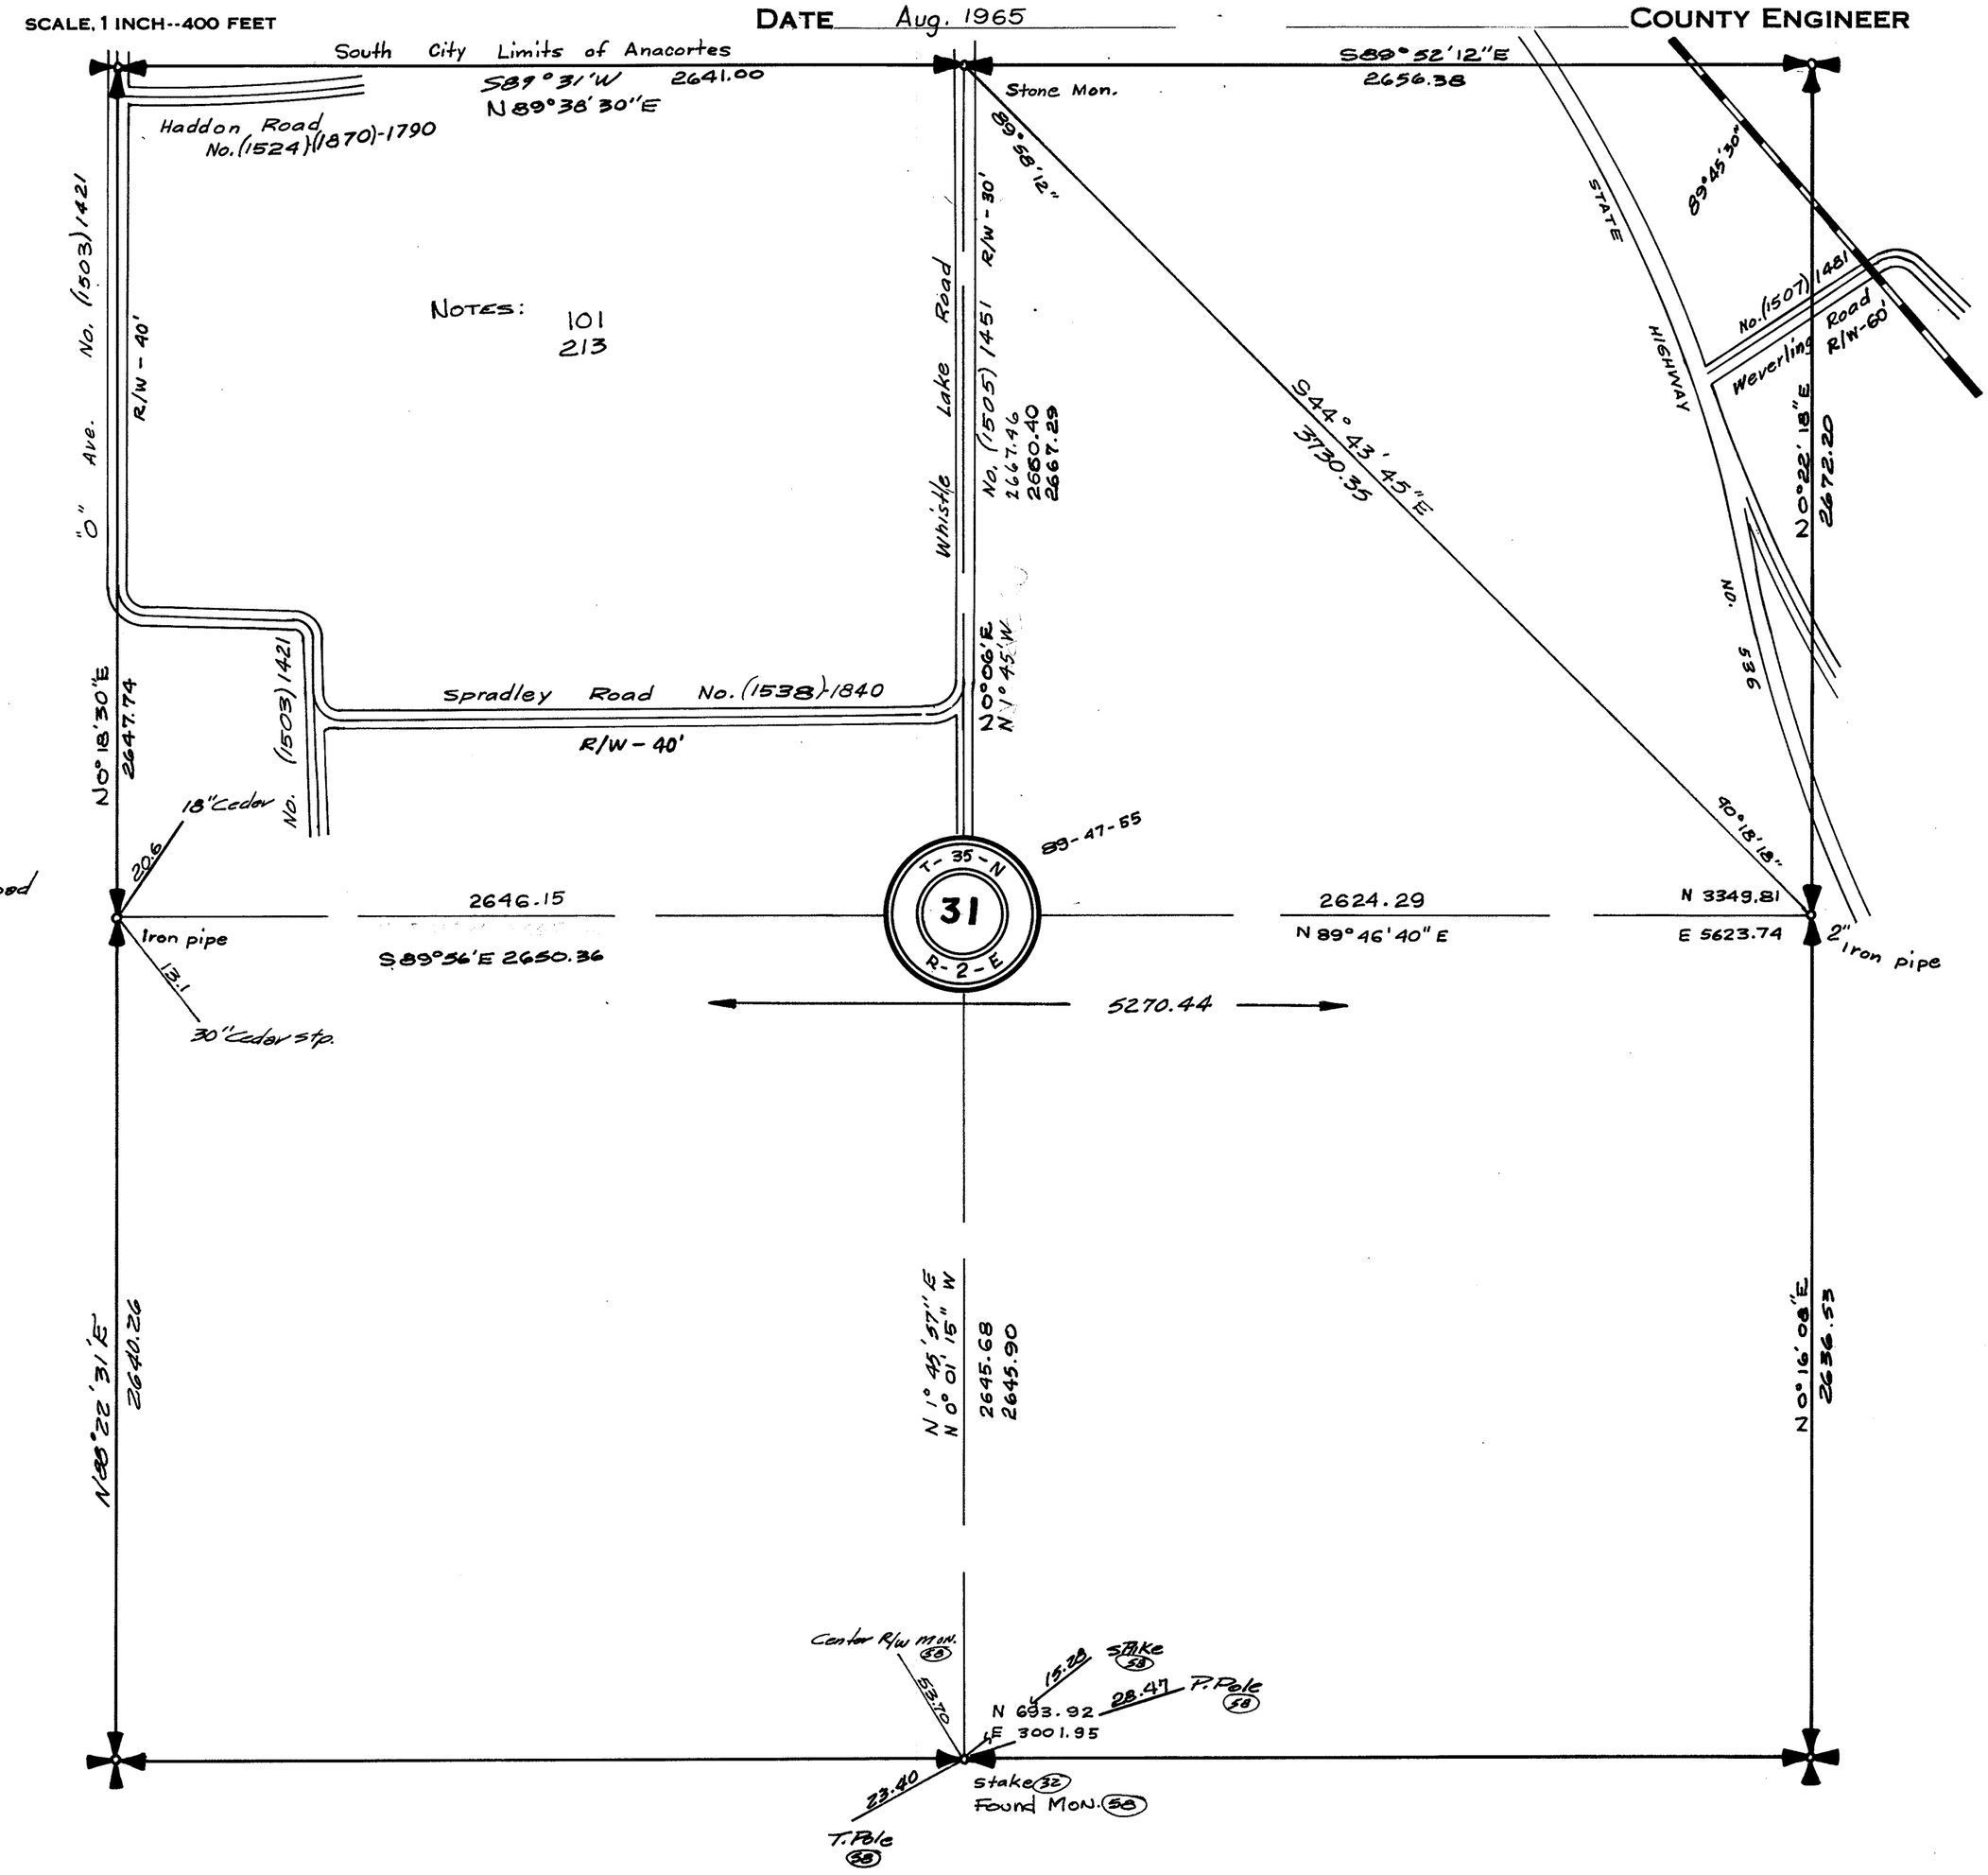

NOTES: 101
213

H.213
E 101


SECTION 31.

TOWNSHIP 35. NORTH. RANGE 2. EAST. W. M.
SKAGIT COUNTY. WASH.

SCALE. 1 INCH–400 FEET

Transit Book. 70.

A. L. STRONG COUNTY ENGINEER

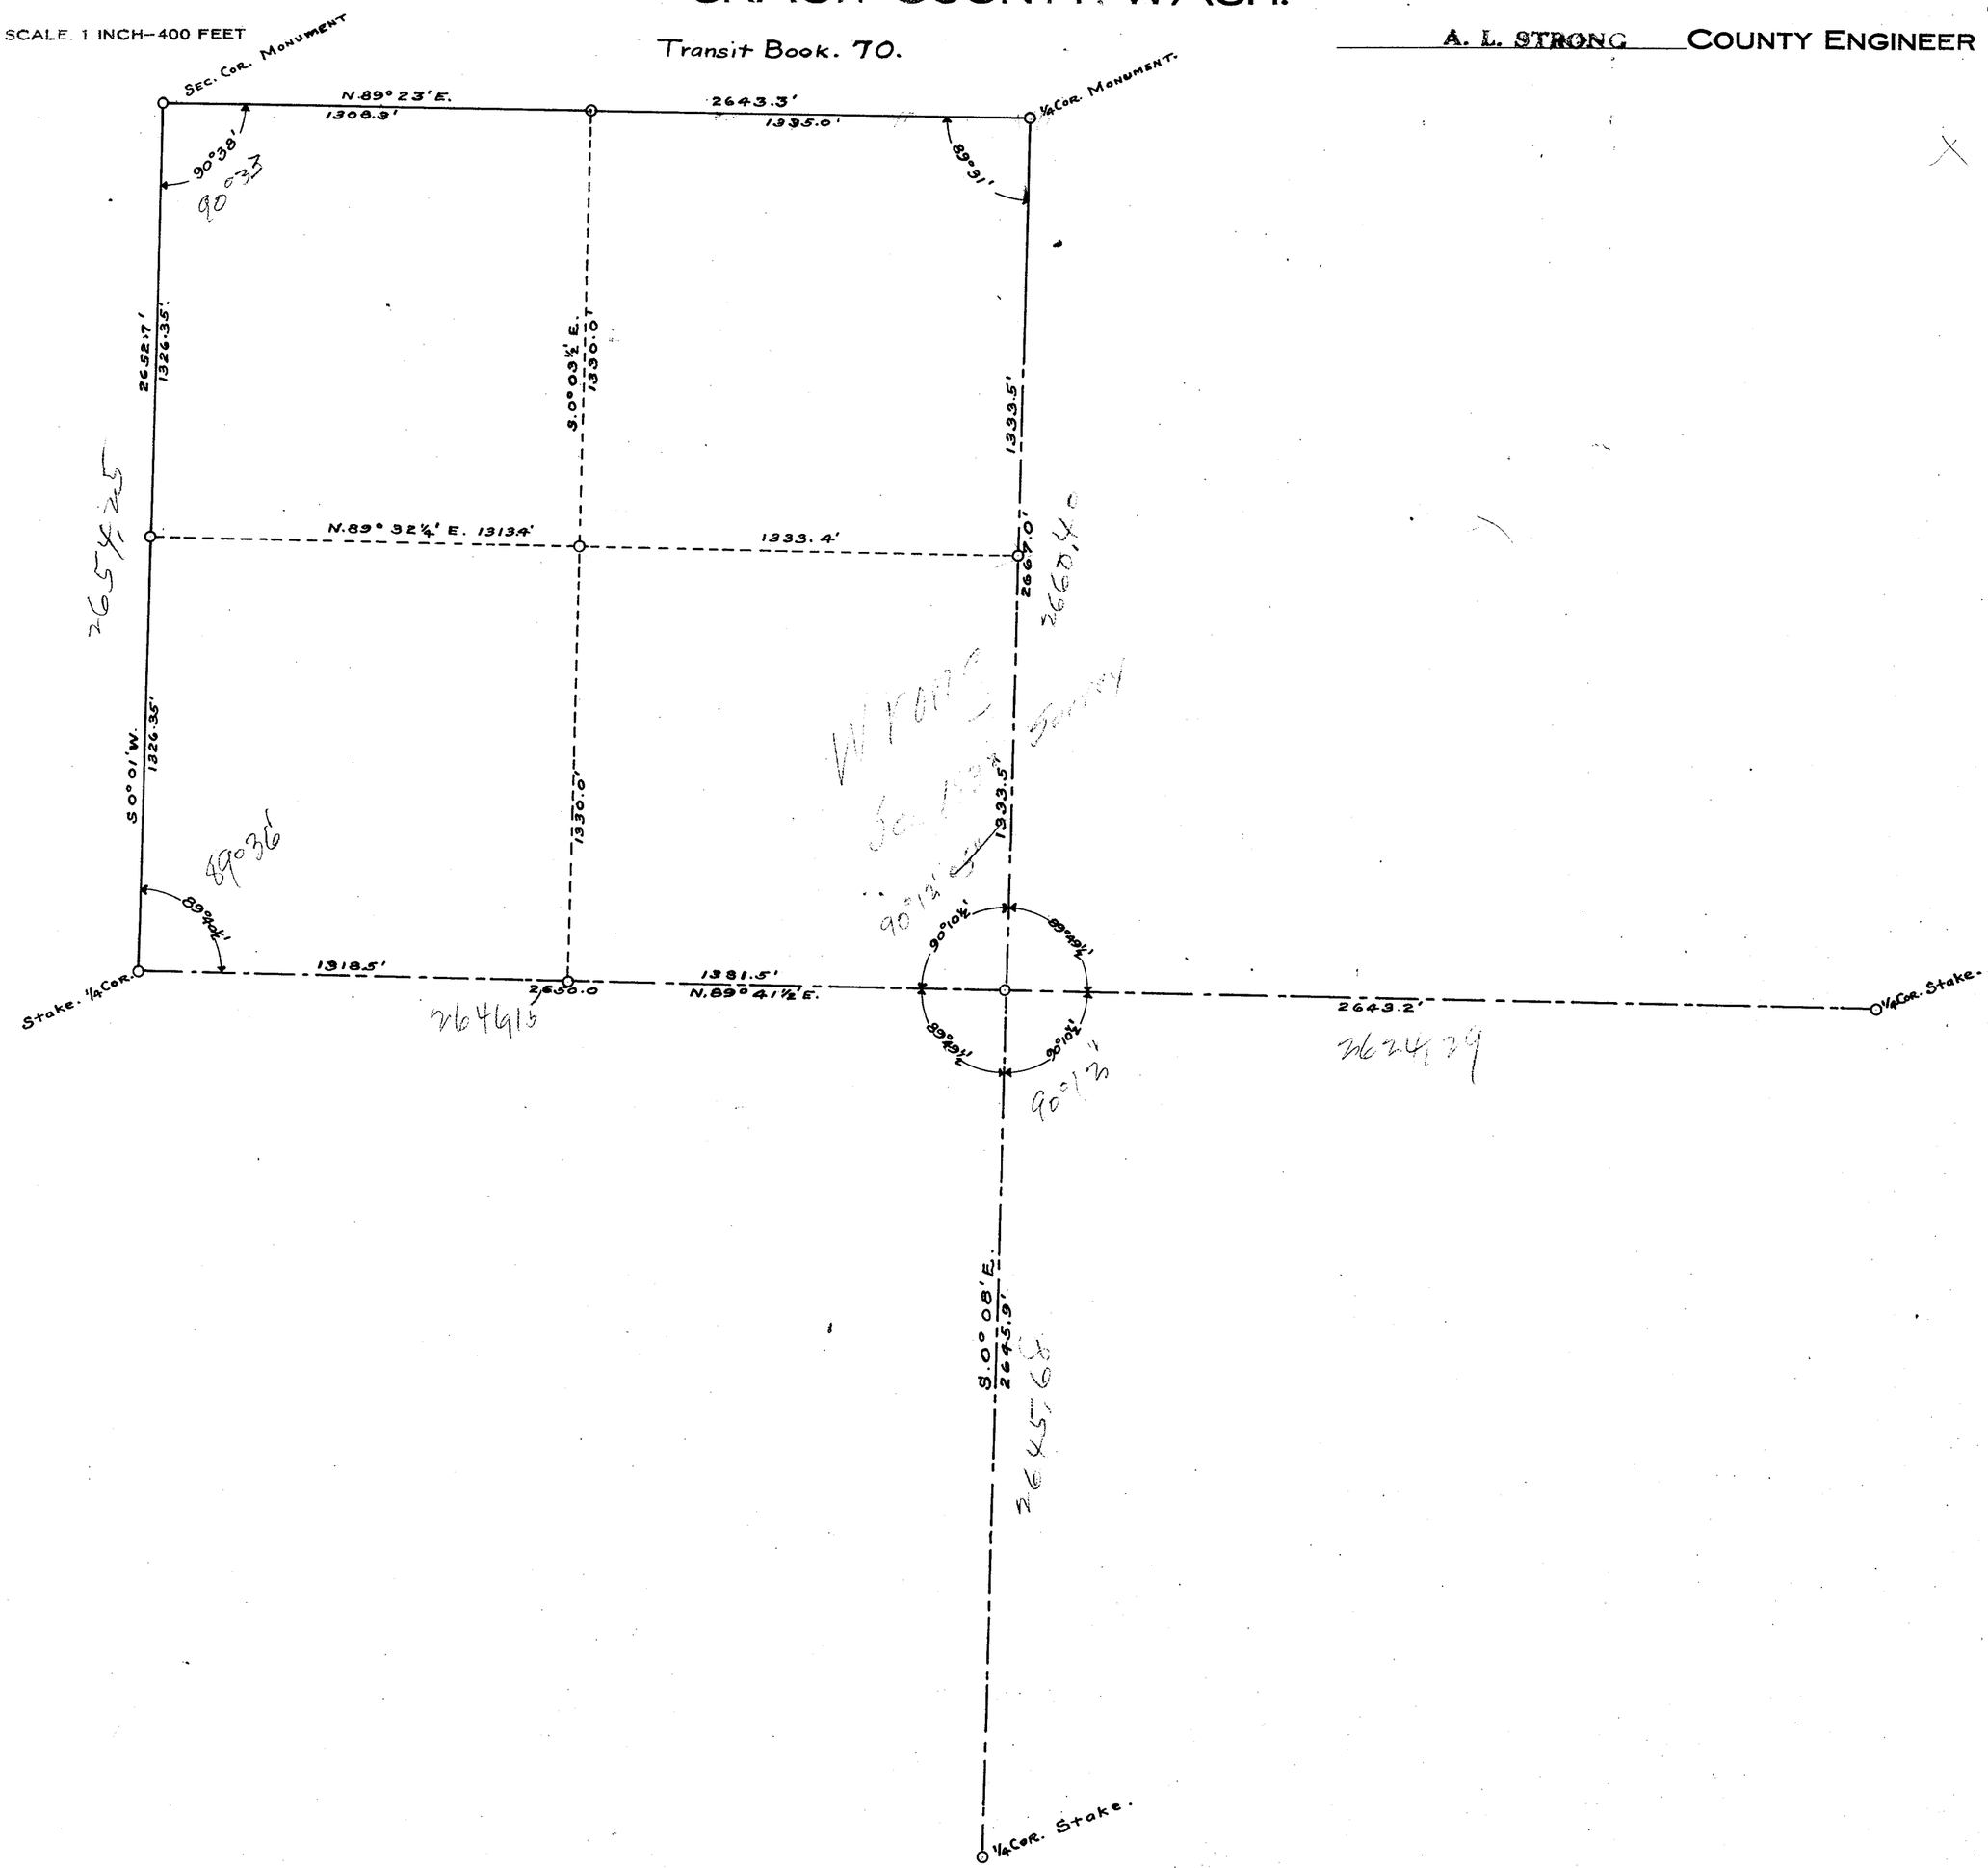


SECTION 31

TOWNSHIP 35 NORTH. RANGE 2 EAST. W. M.
SKAGIT COUNTY. WASH.

SCALE, 1 INCH—400 FEET

R.E.L. KNAPP. COUNTY ENGINEER
1931. Notes H-213

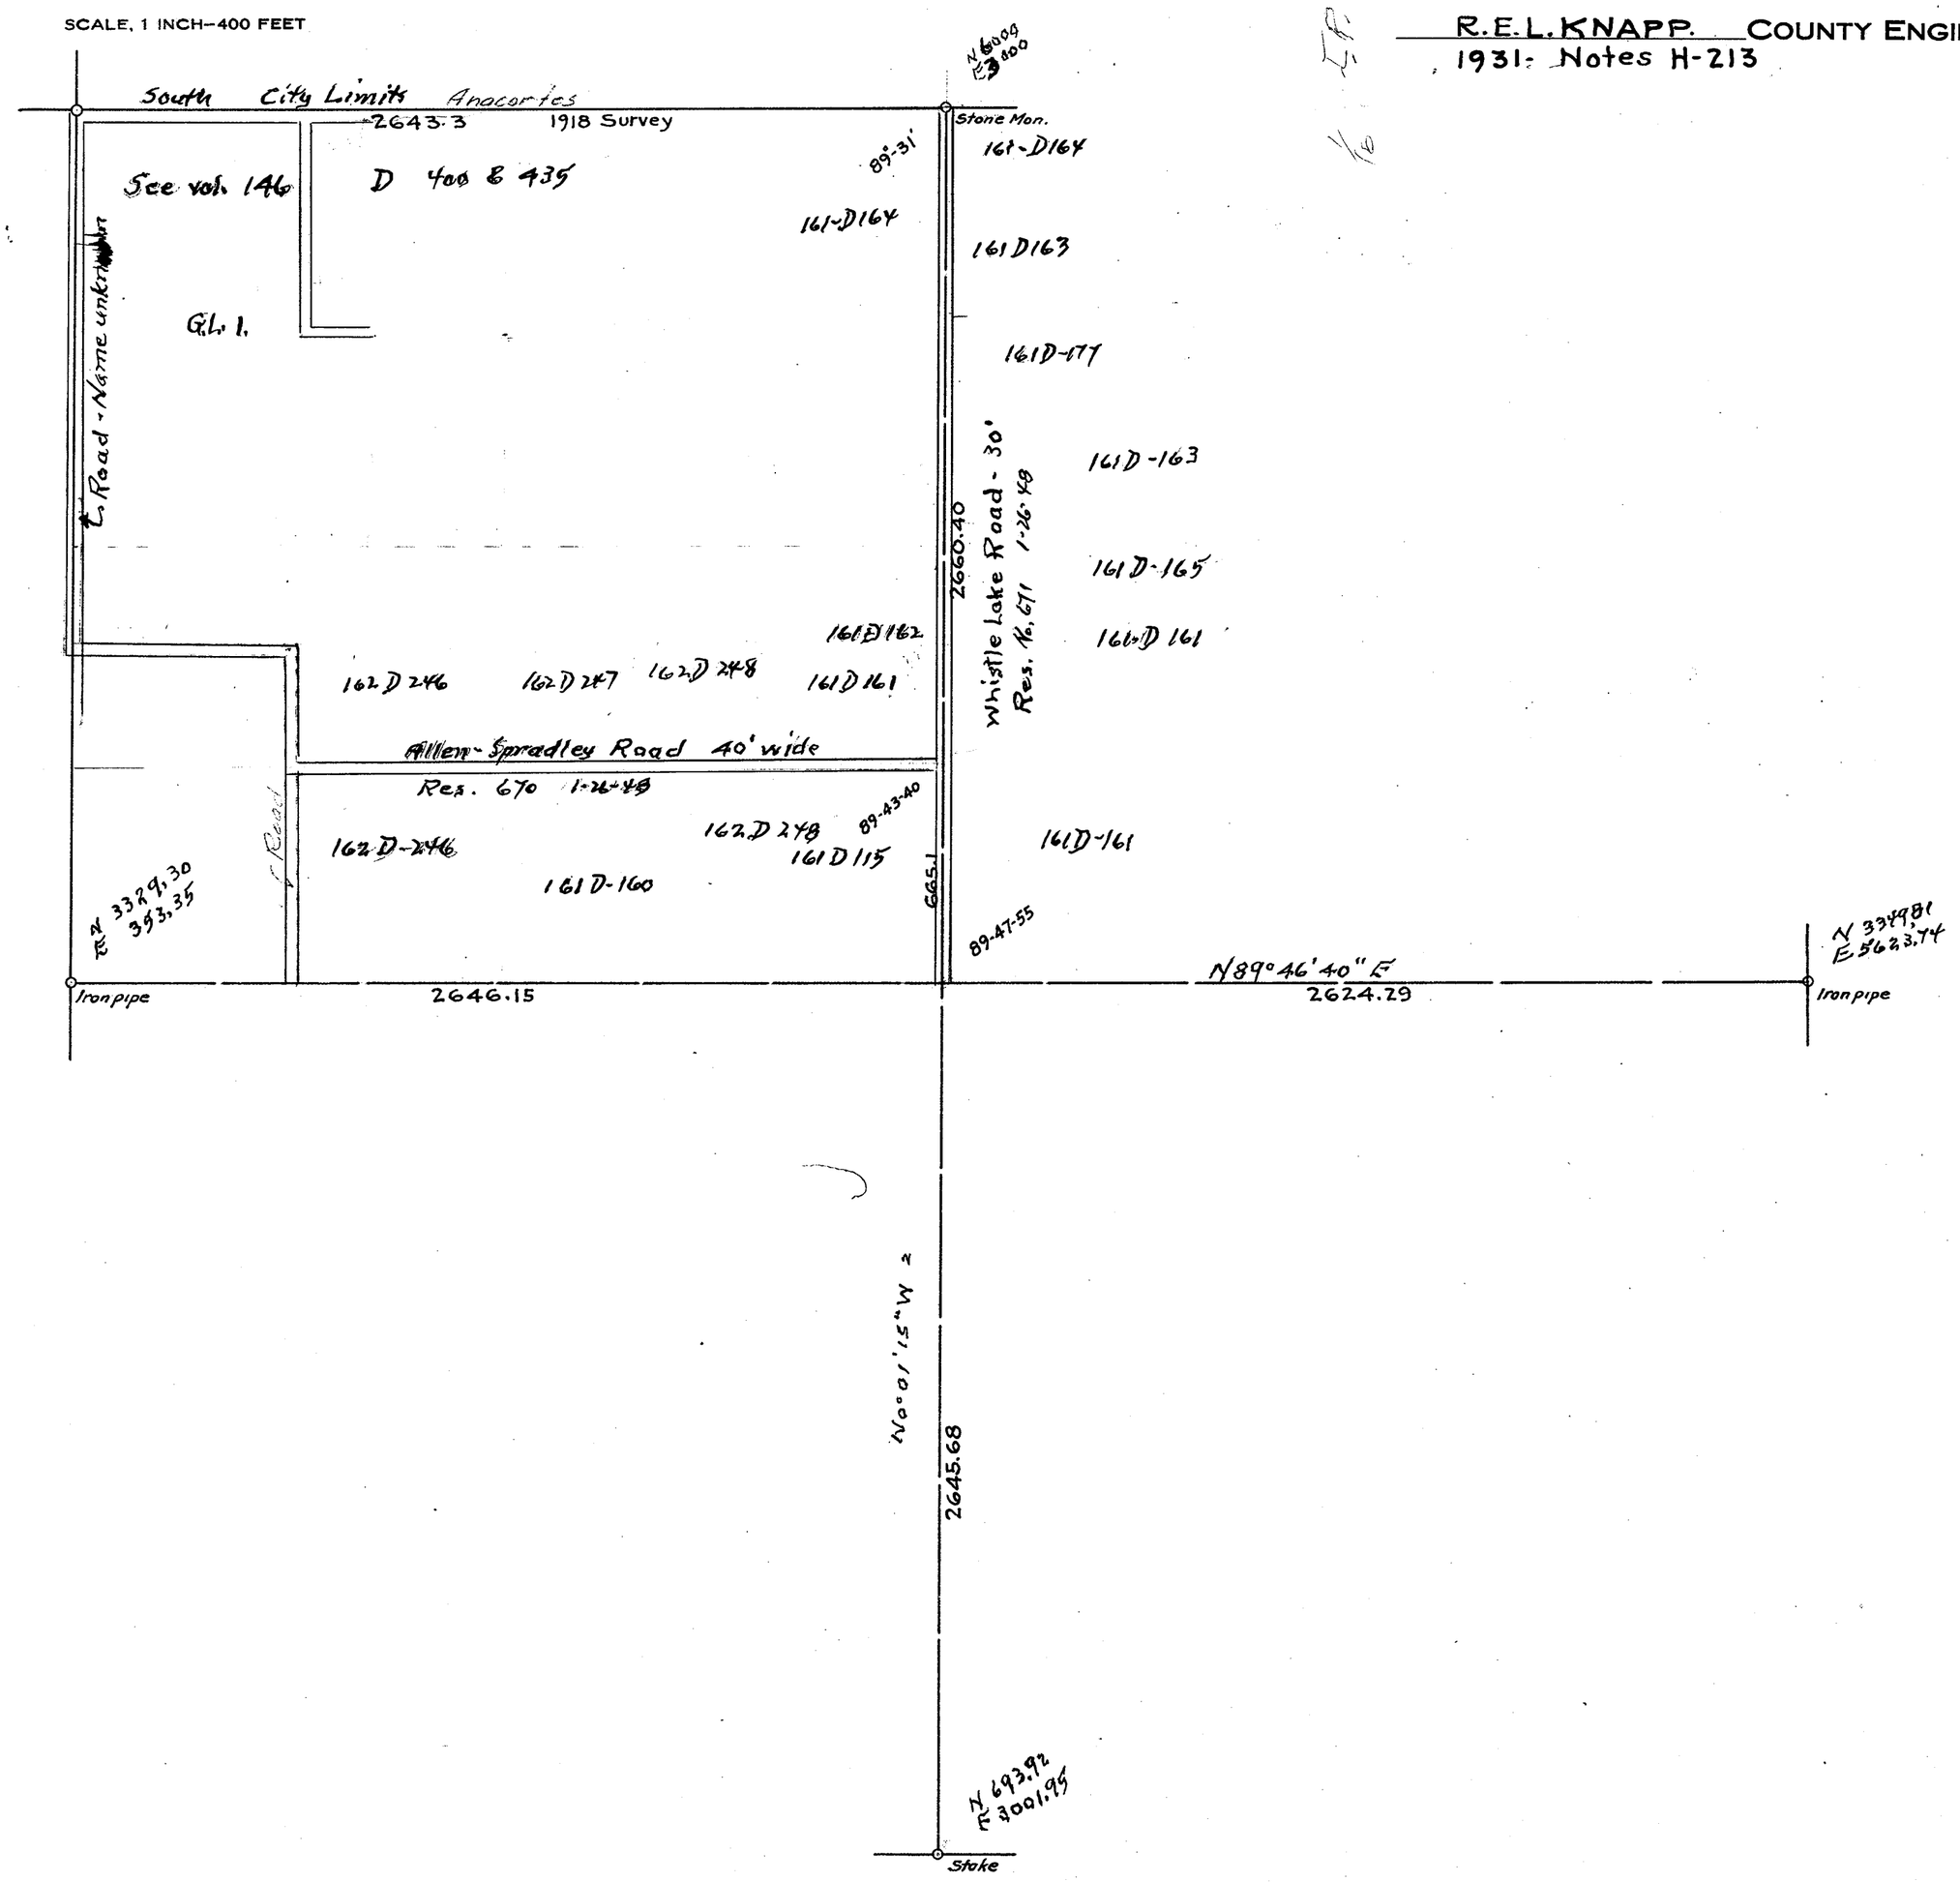


SECTION 32 & 33

TOWNSHIP 35 NORTH, RANGE 2 EAST, W. M.

SKAGIT COUNTY, WASH.

SCALE, 1 INCH--400 FEET

G. D. LeGro COUNTY ENGINEER
July 1958
Monuments noted Jan. 1979

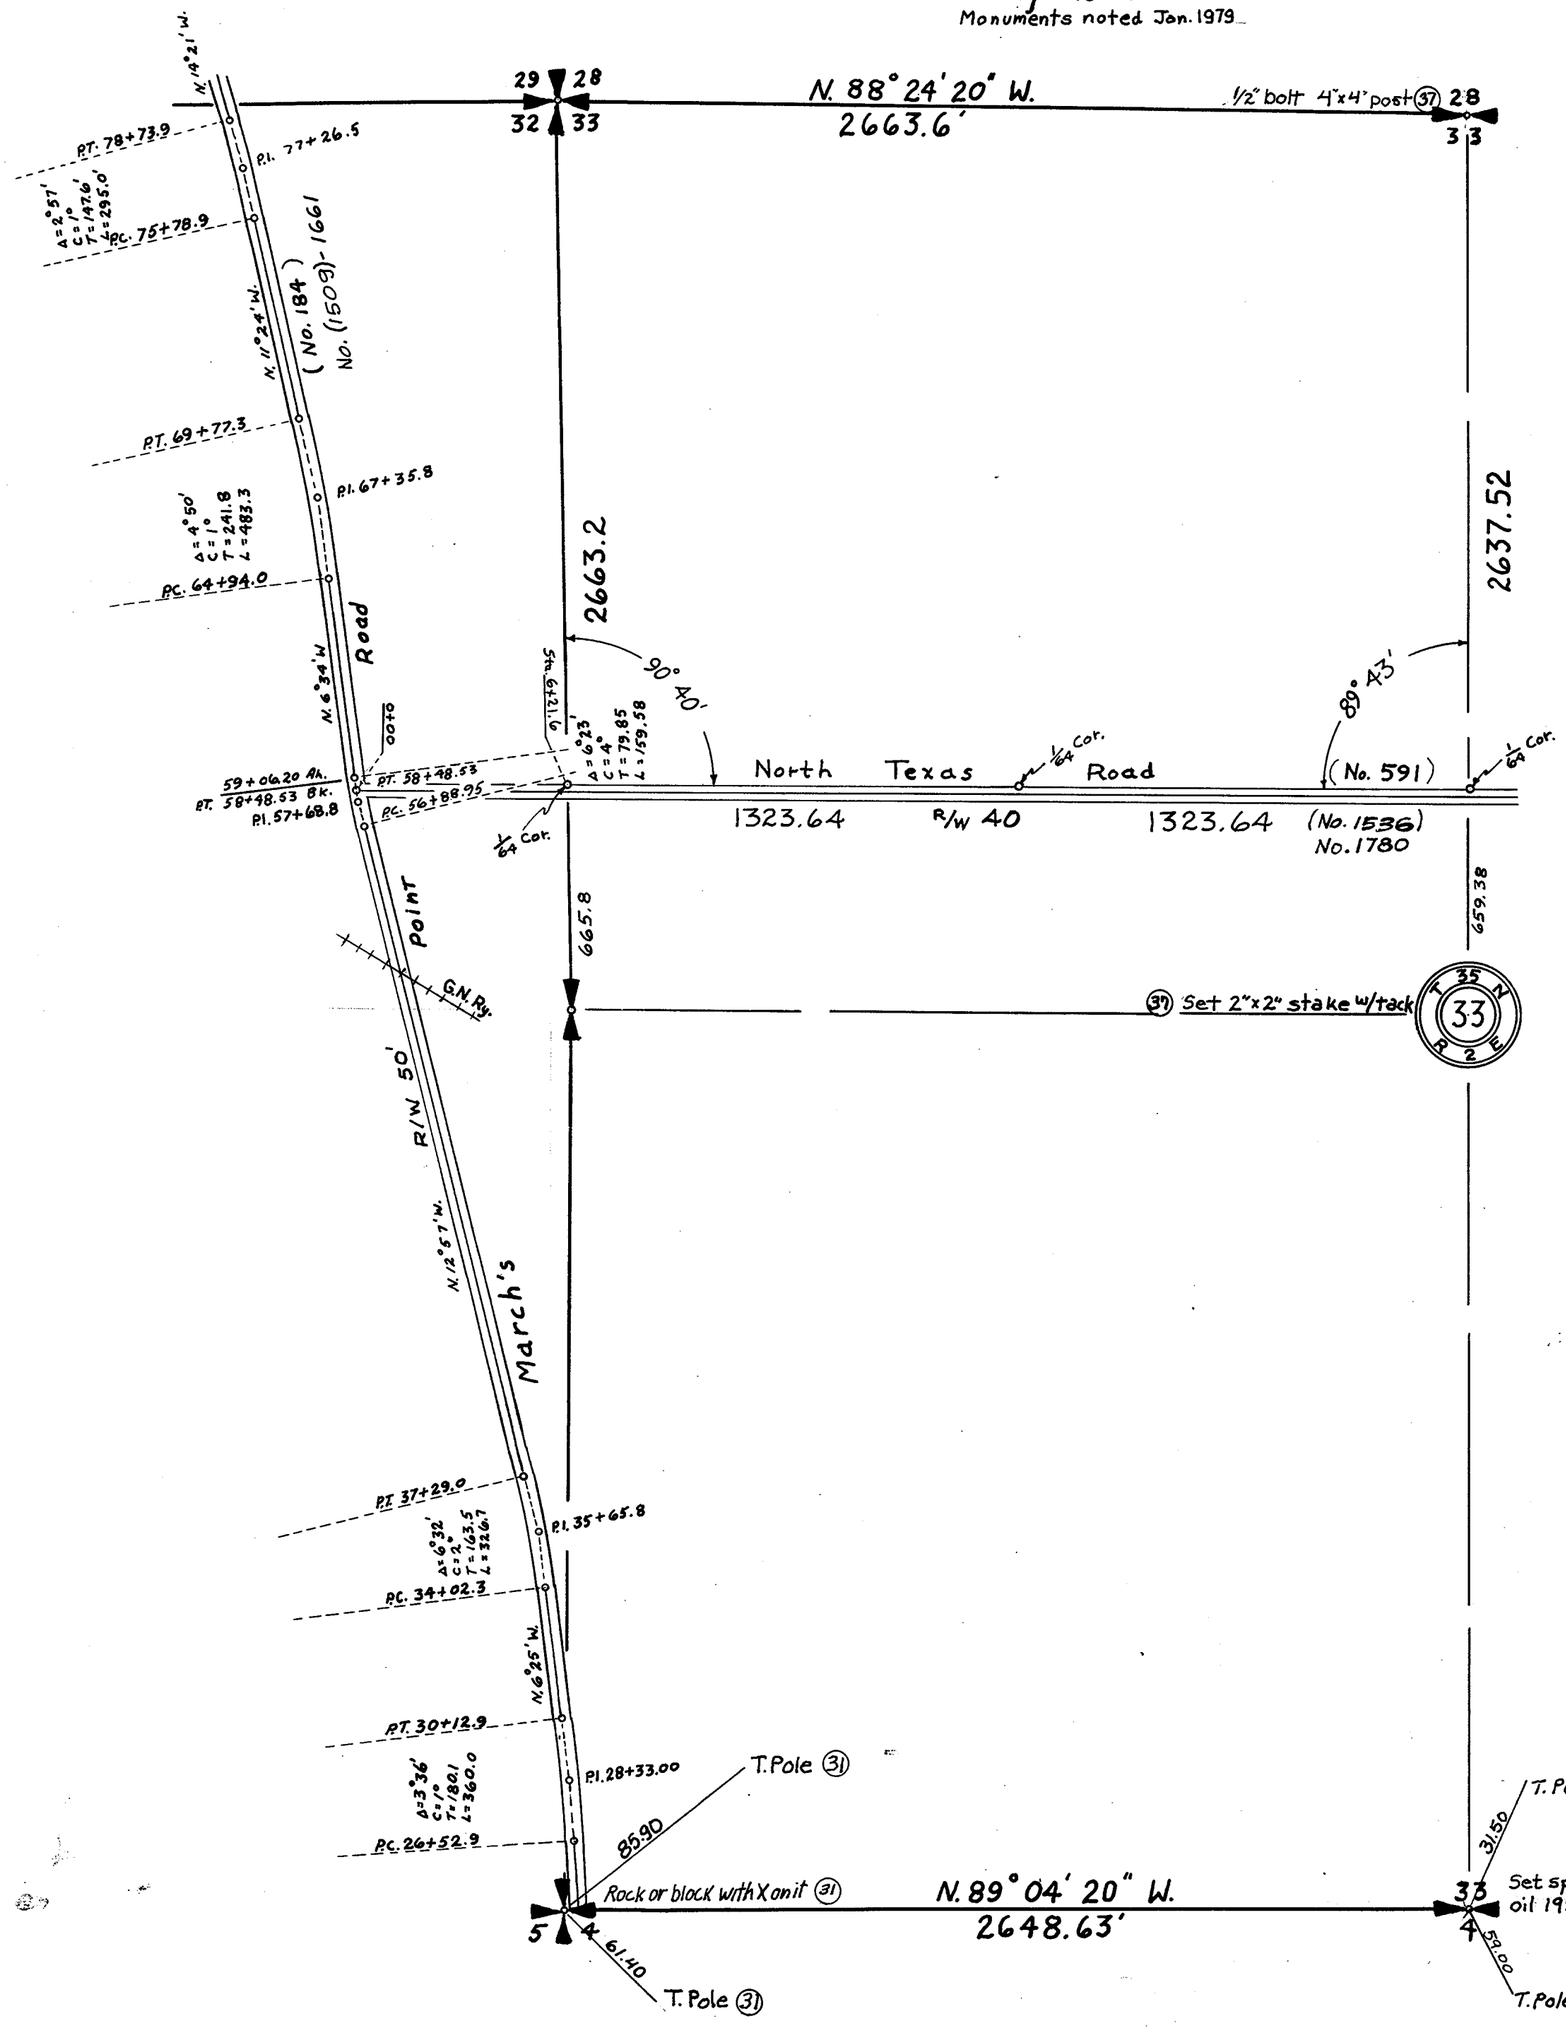


SECTION 33 & 34
TOWNSHIP 35 NORTH, RANGE 2 EAST, W. M.
SKAGIT COUNTY, WASH.

SCALE, 1 INCH--400 FEET

G. D. LeGro COUNTY ENGINEER
July 1958
Monuments noted Jan. 1979

March's Point Road No. 184 #1661
Formerly W.V. Wells Road No. 184
Drawn from Survey Notes 39/450

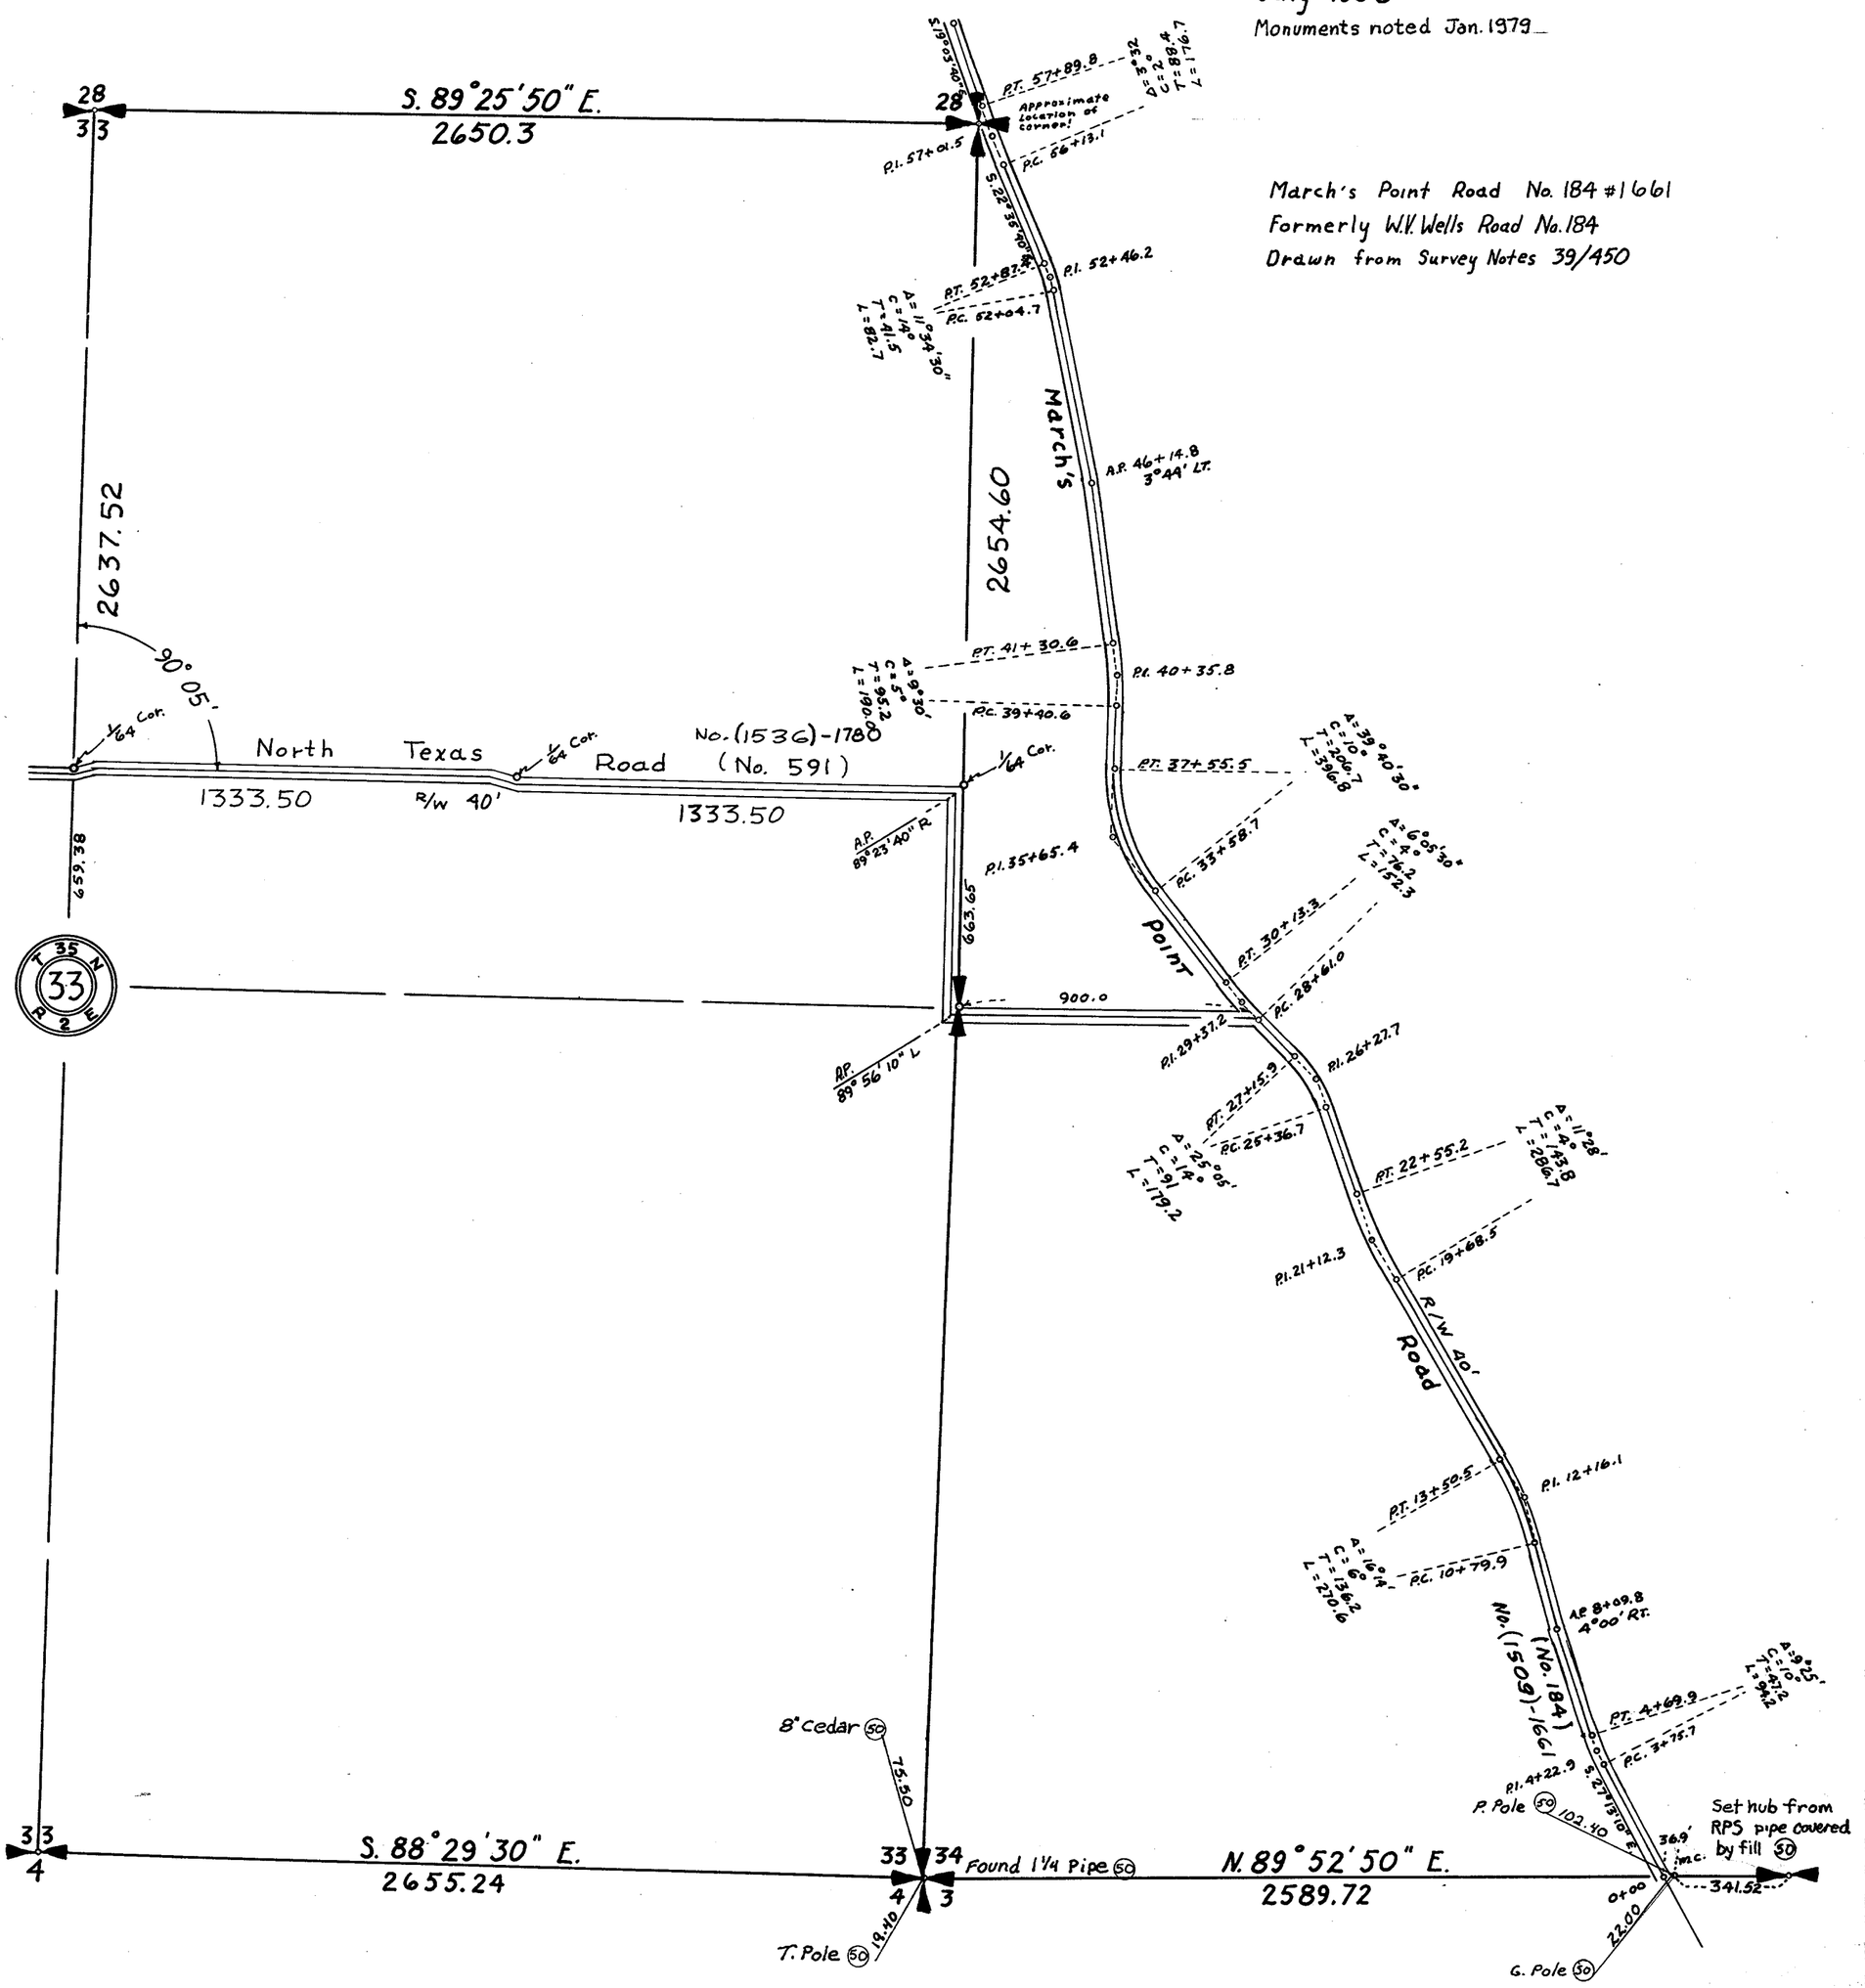

SECTION 1


TOWNSHIP 35 NORTH, RANGE 3 EAST, W. M.

SKAGIT COUNTY, WASH.

SCALE, 1 INCH--400 FEET

DATE Aug. 1965

COUNTY ENGINEER

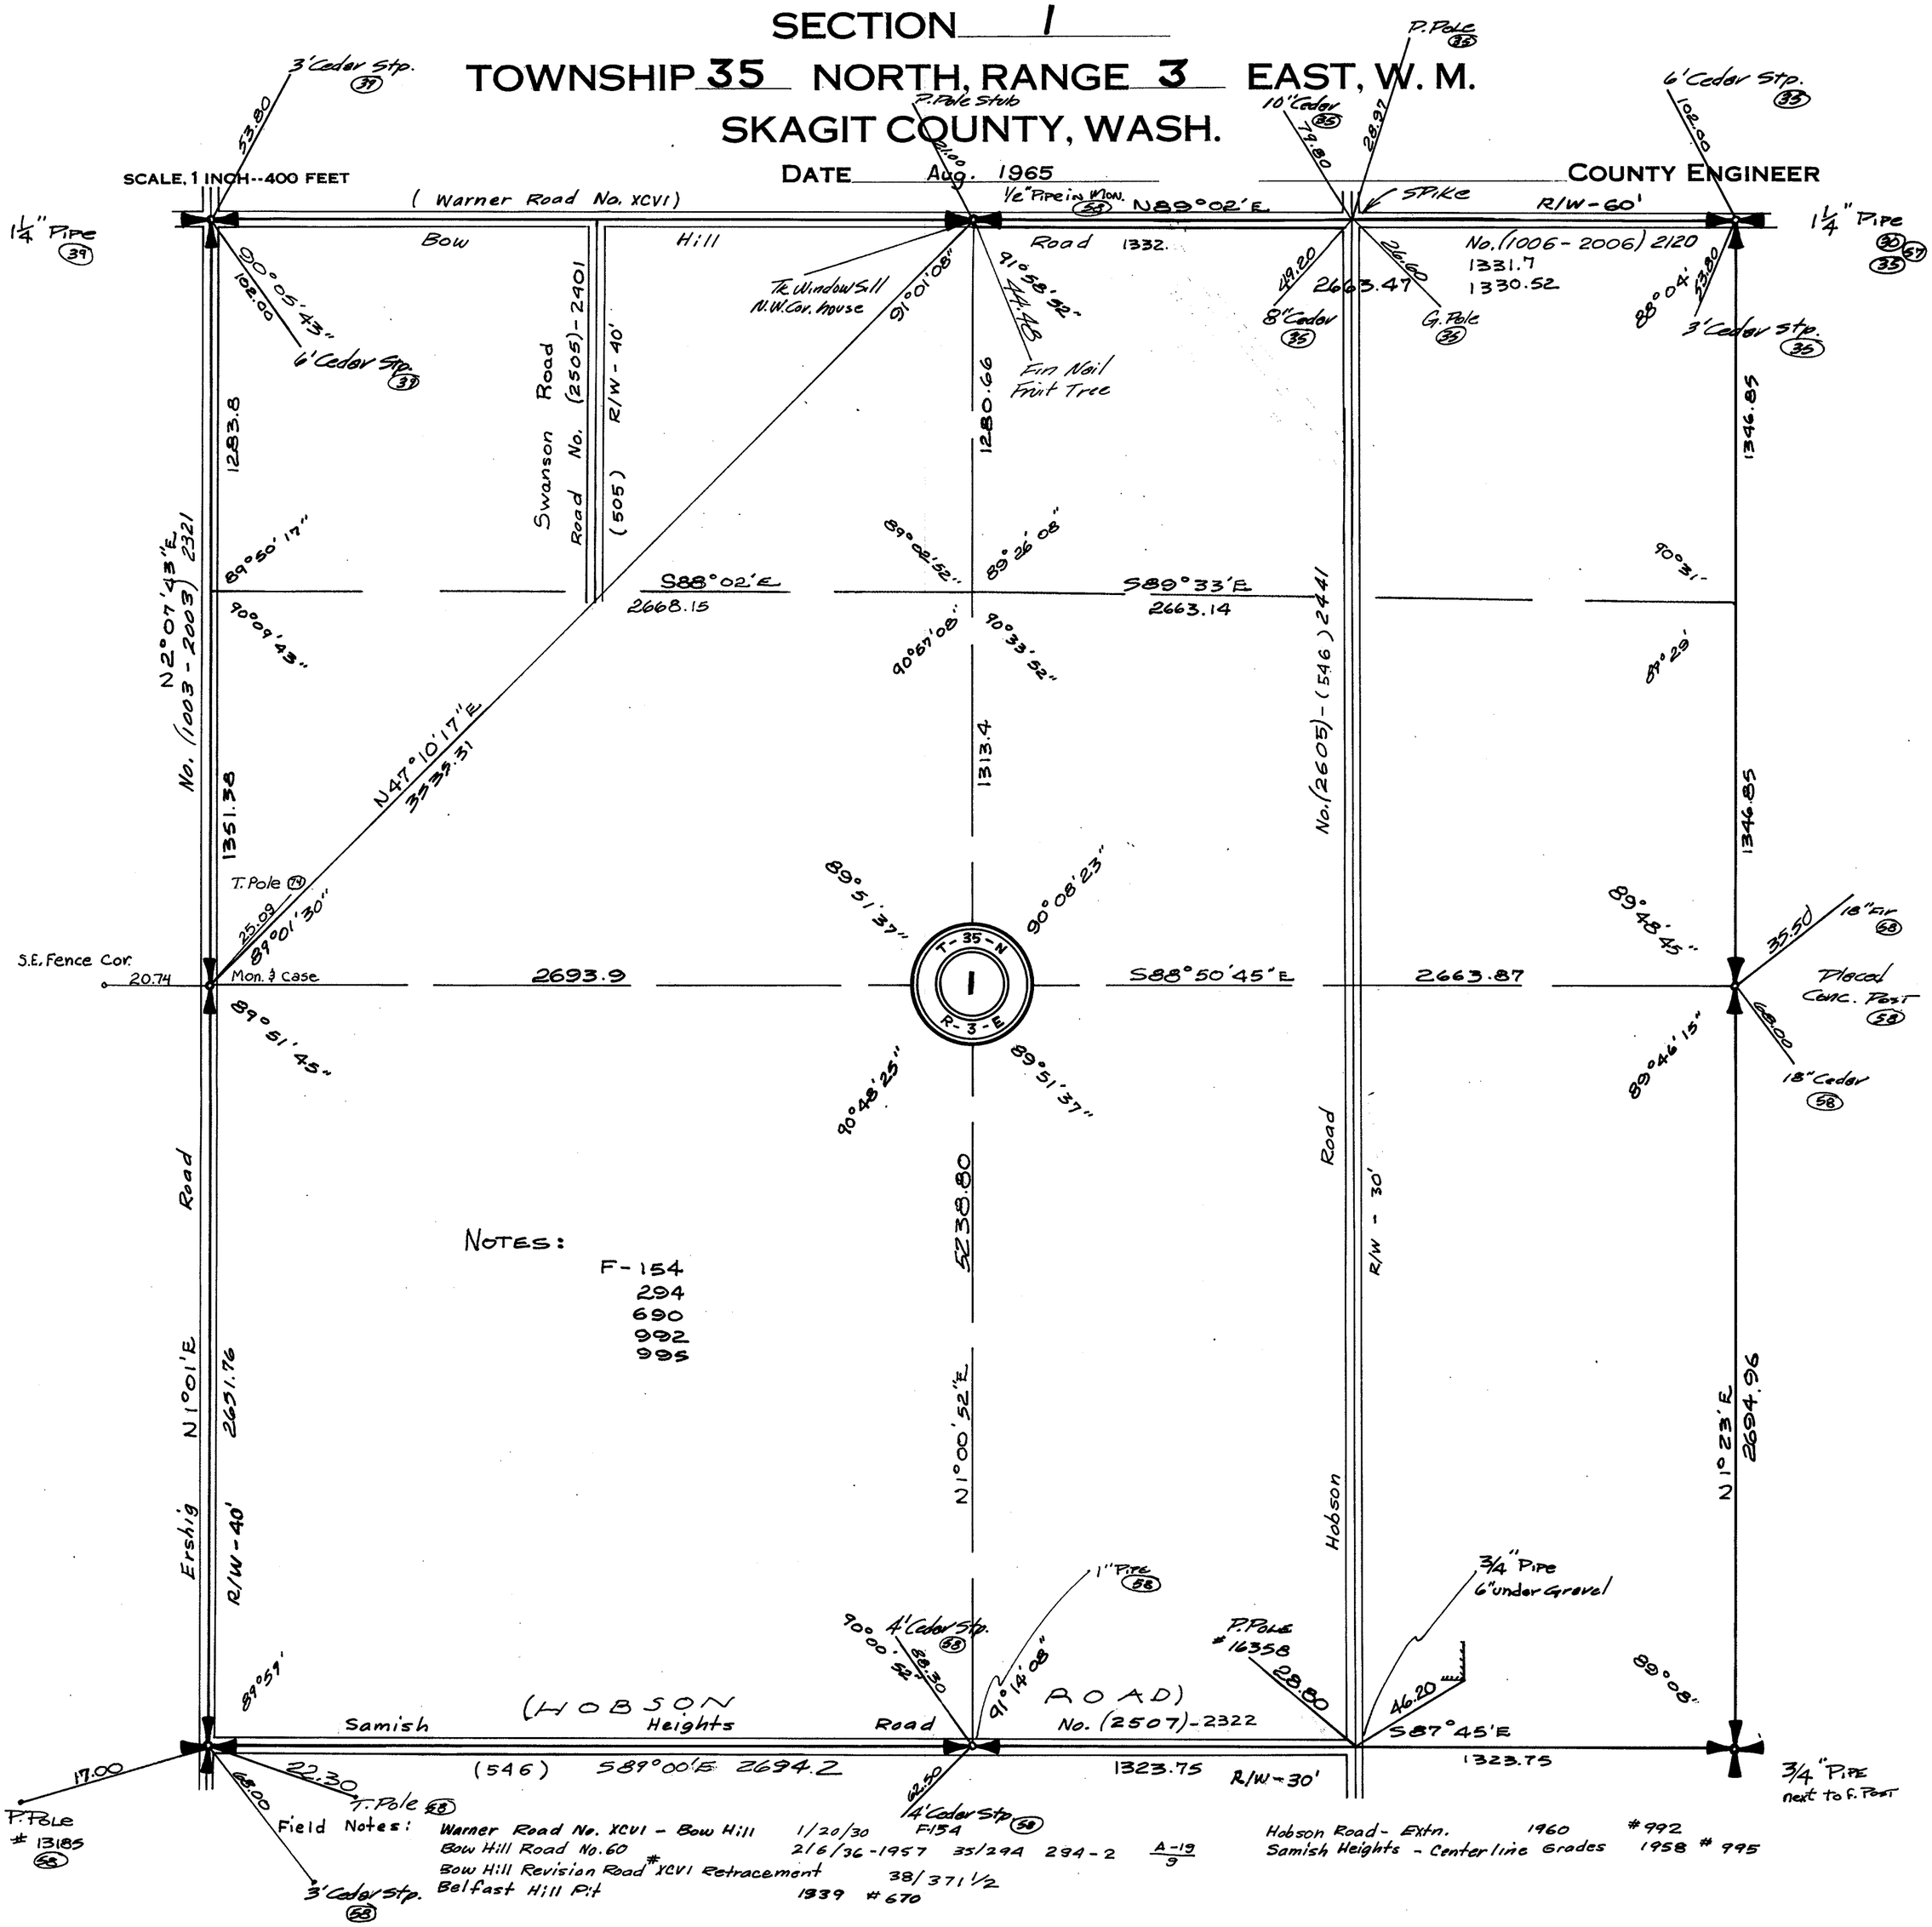

NOTES:

F-154
294
690
992
995

Field Notes:

Warner Road No. XCVI - Bow Hill 1/20/30 F-154
Bow Hill Road No. 60 2/6/36-1957 35/294 294-2 A-19/9
Bow Hill Revision Road # XCVI Retracement 38/371 1/2
Belfast Hill Pit 1939 # 670

Hobson Road - Extn. 1960 # 992
Samish Heights - Centerline Grades 1958 # 995

2643.23
2663.47
53[illegible]6.70


SECTION 1

TOWNSHIP 35 NORTH, RANGE 3 EAST, W. M.
SKAGIT COUNTY, WASH.

SCALE, 1 INCH–400 FEET

Robt. E.L. Knapp 1930 COUNTY ENGINEER

Notes: 35/294

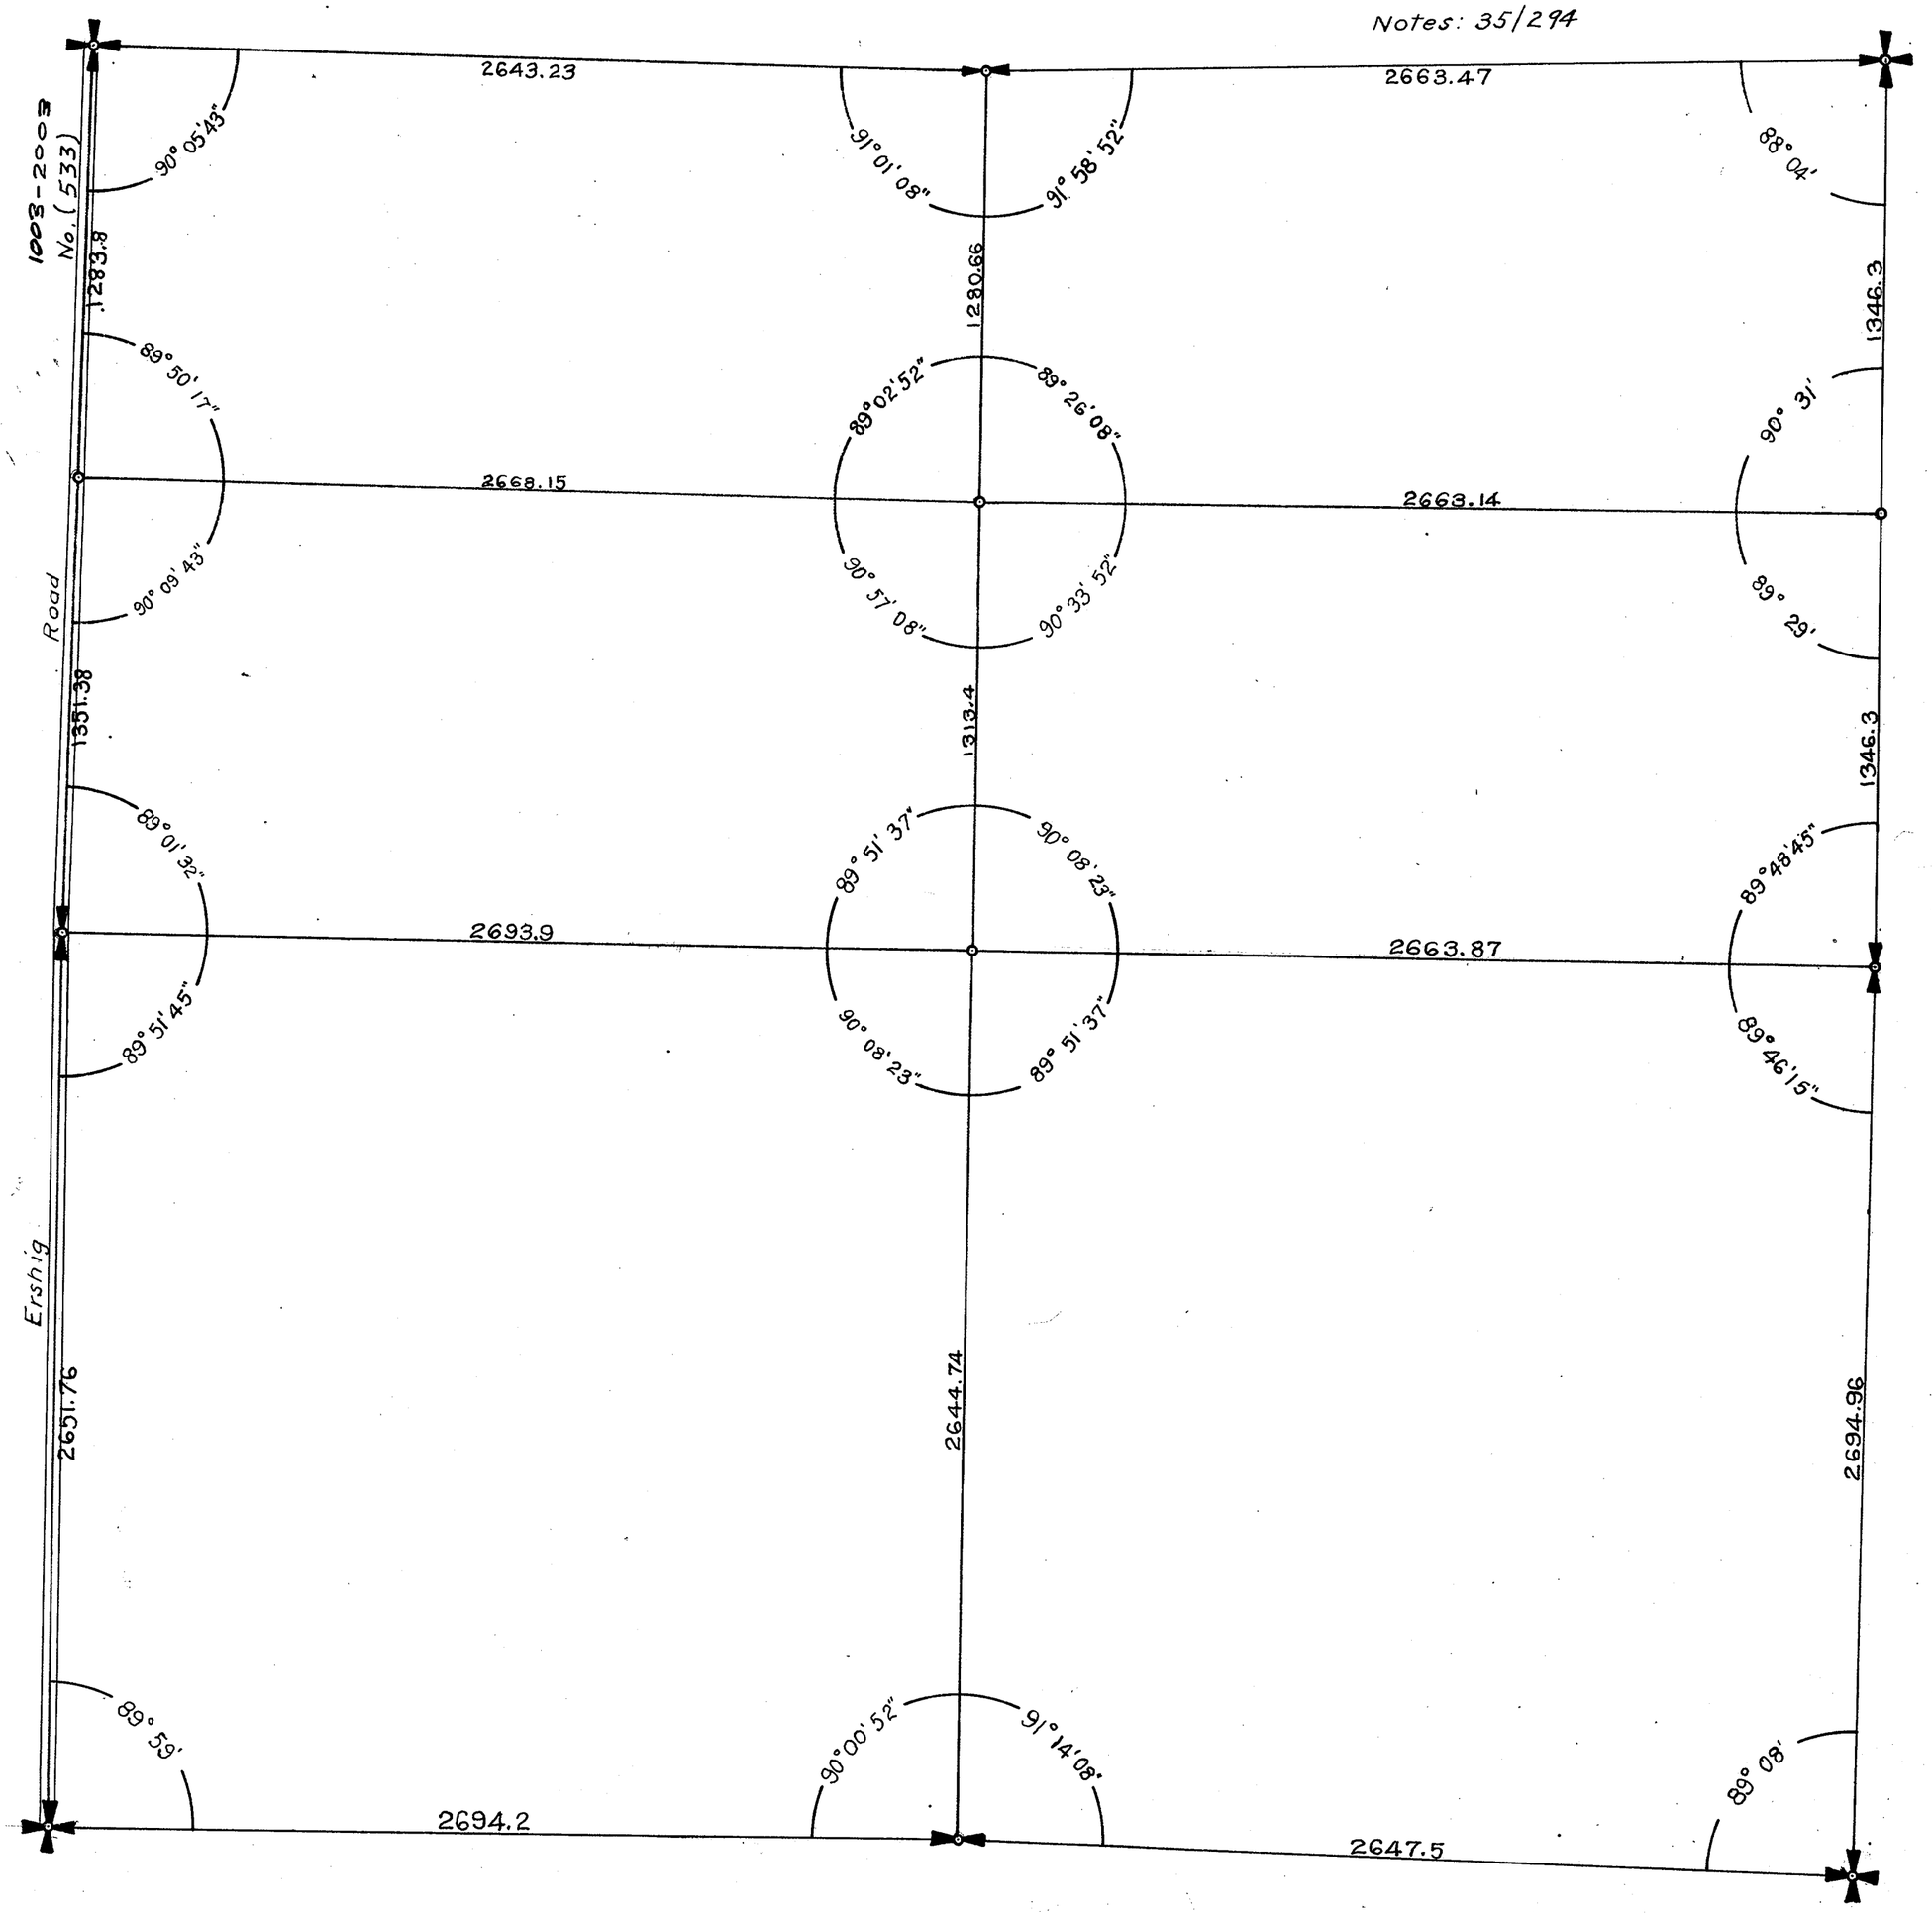

SECTION 2


TOWNSHIP 35 NORTH, RANGE 3 EAST, W. M.

SKAGIT COUNTY, WASH.

SCALE, 1 INCH--400 FEET

DATE July, 1959

Frank Gilkey COUNTY ENGINEER

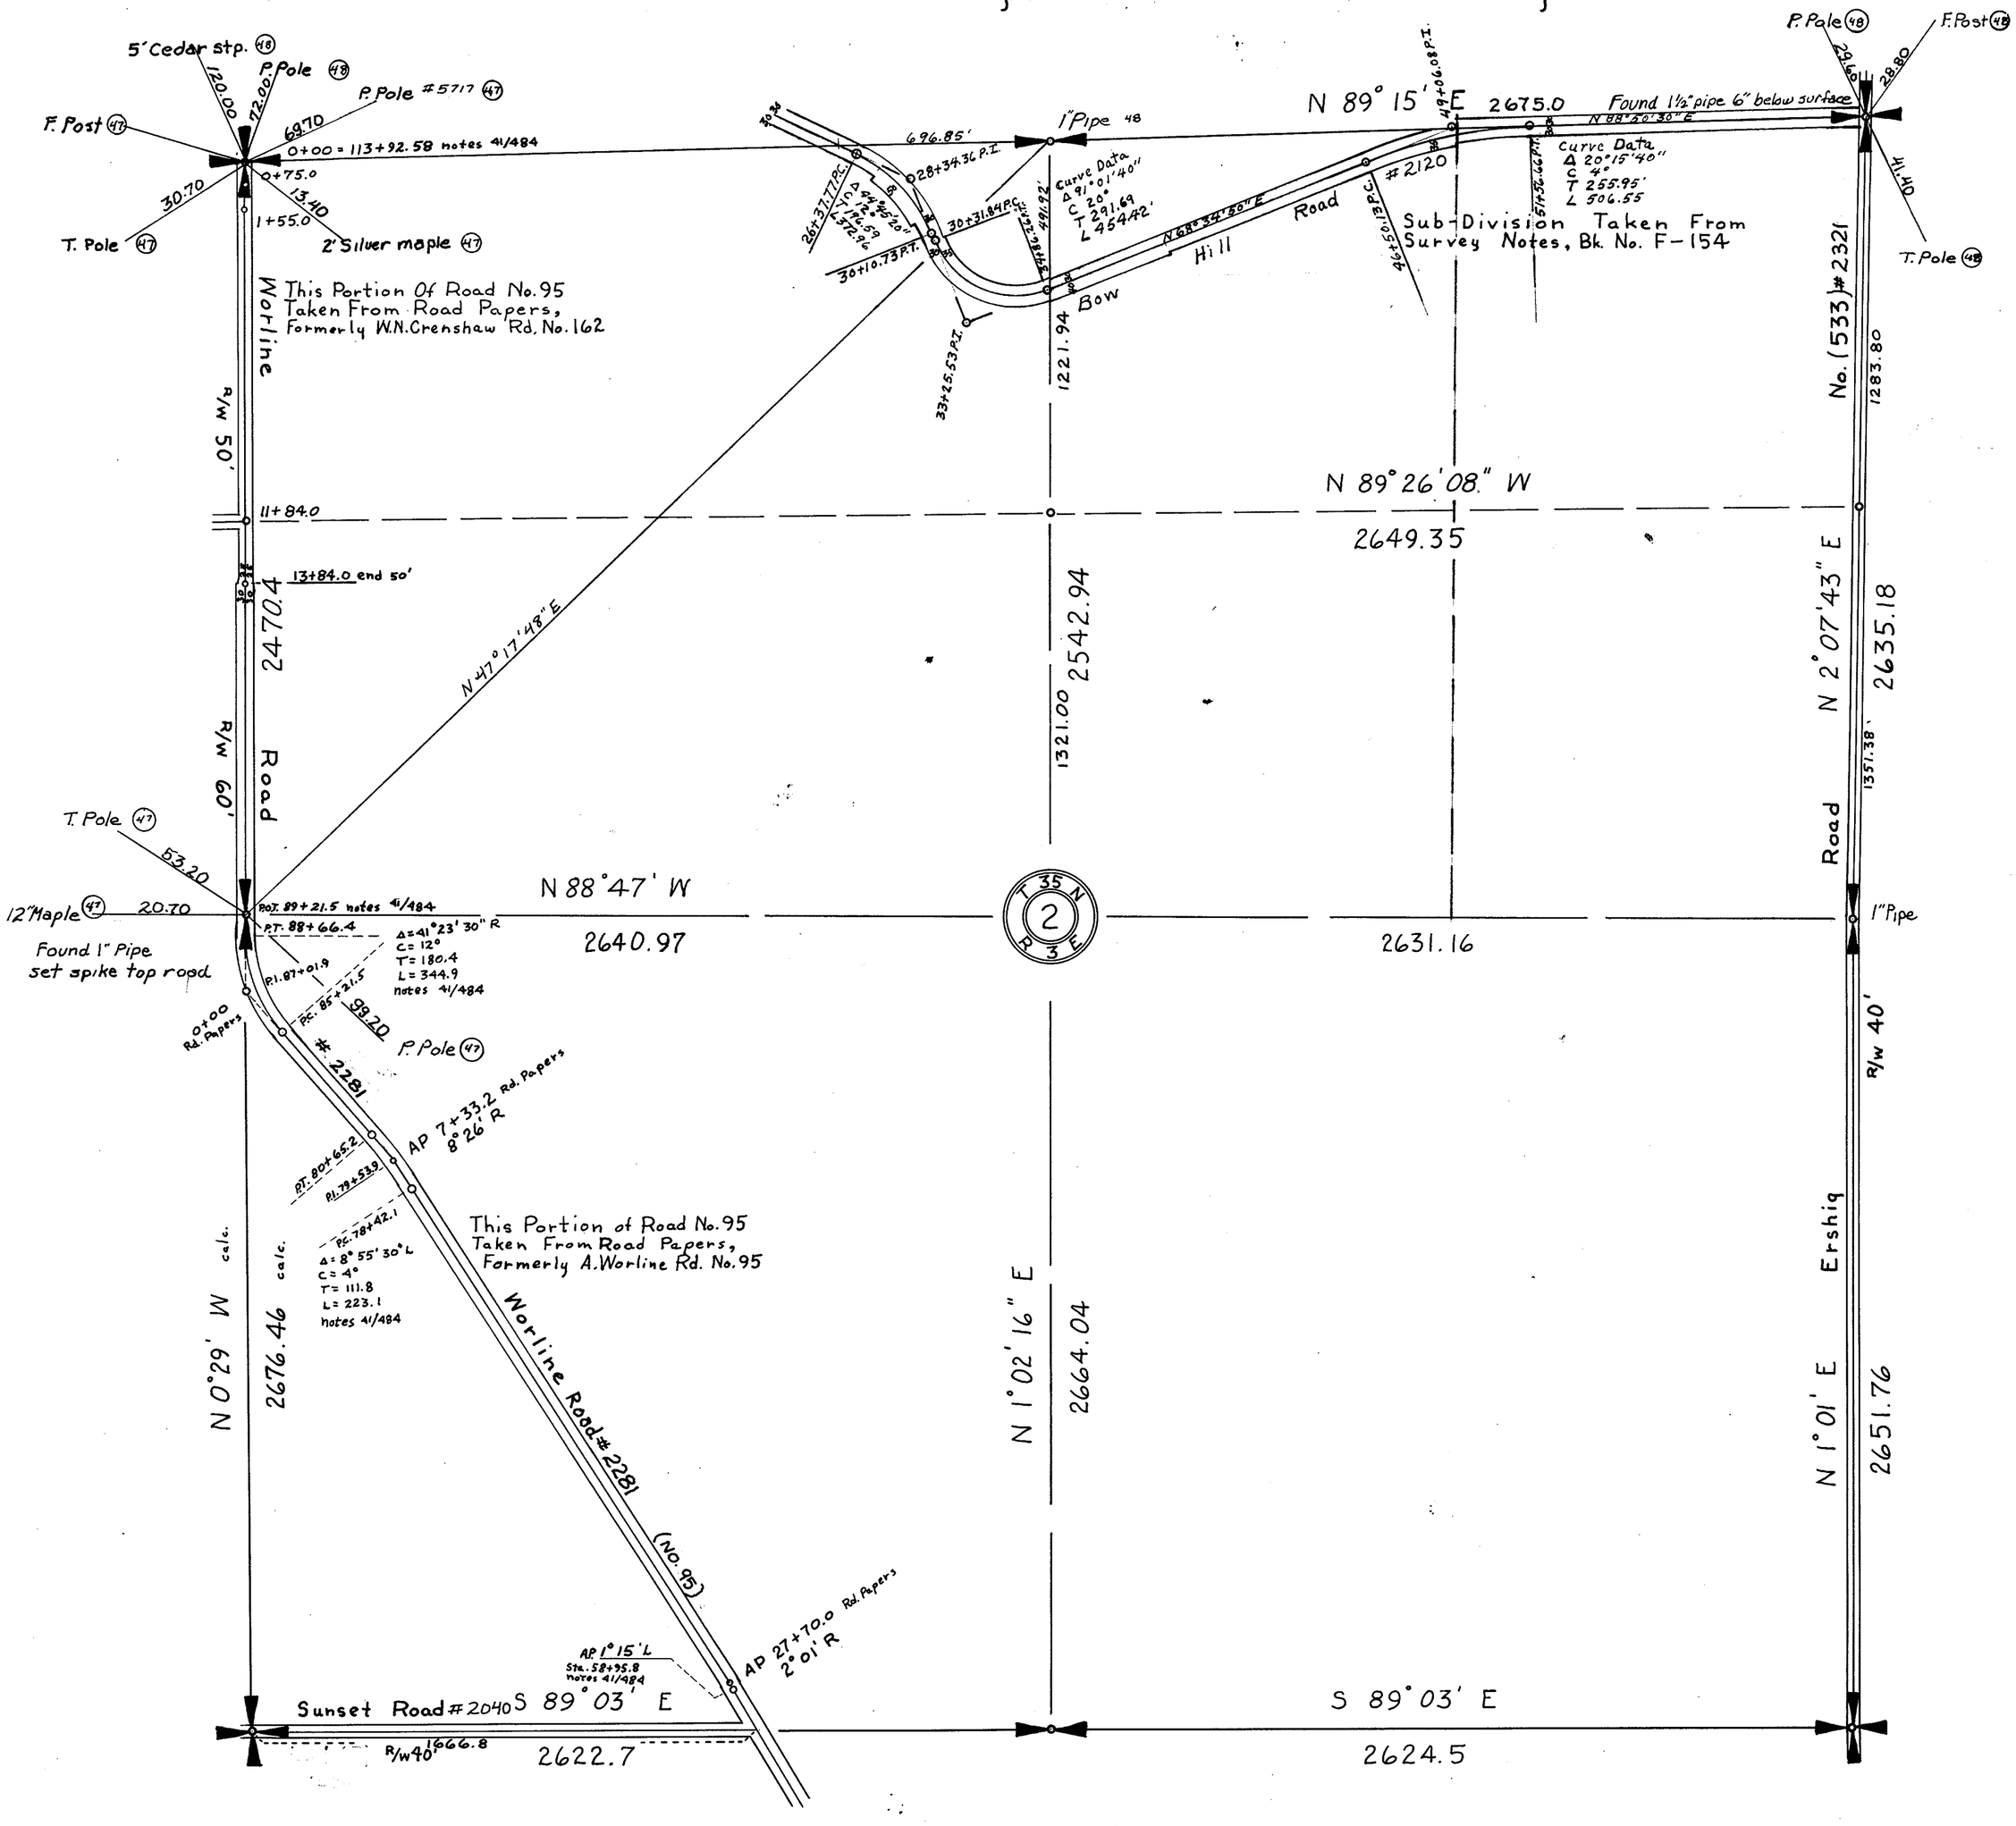


SECTION 2
TOWNSHIP 35 NORTH, RANGE 3 EAST, W. M.
SKAGIT COUNTY, WASH.

SCALE 1 INCH--400 FEET

DATE July 19, 1963

COUNTY ENGINEER

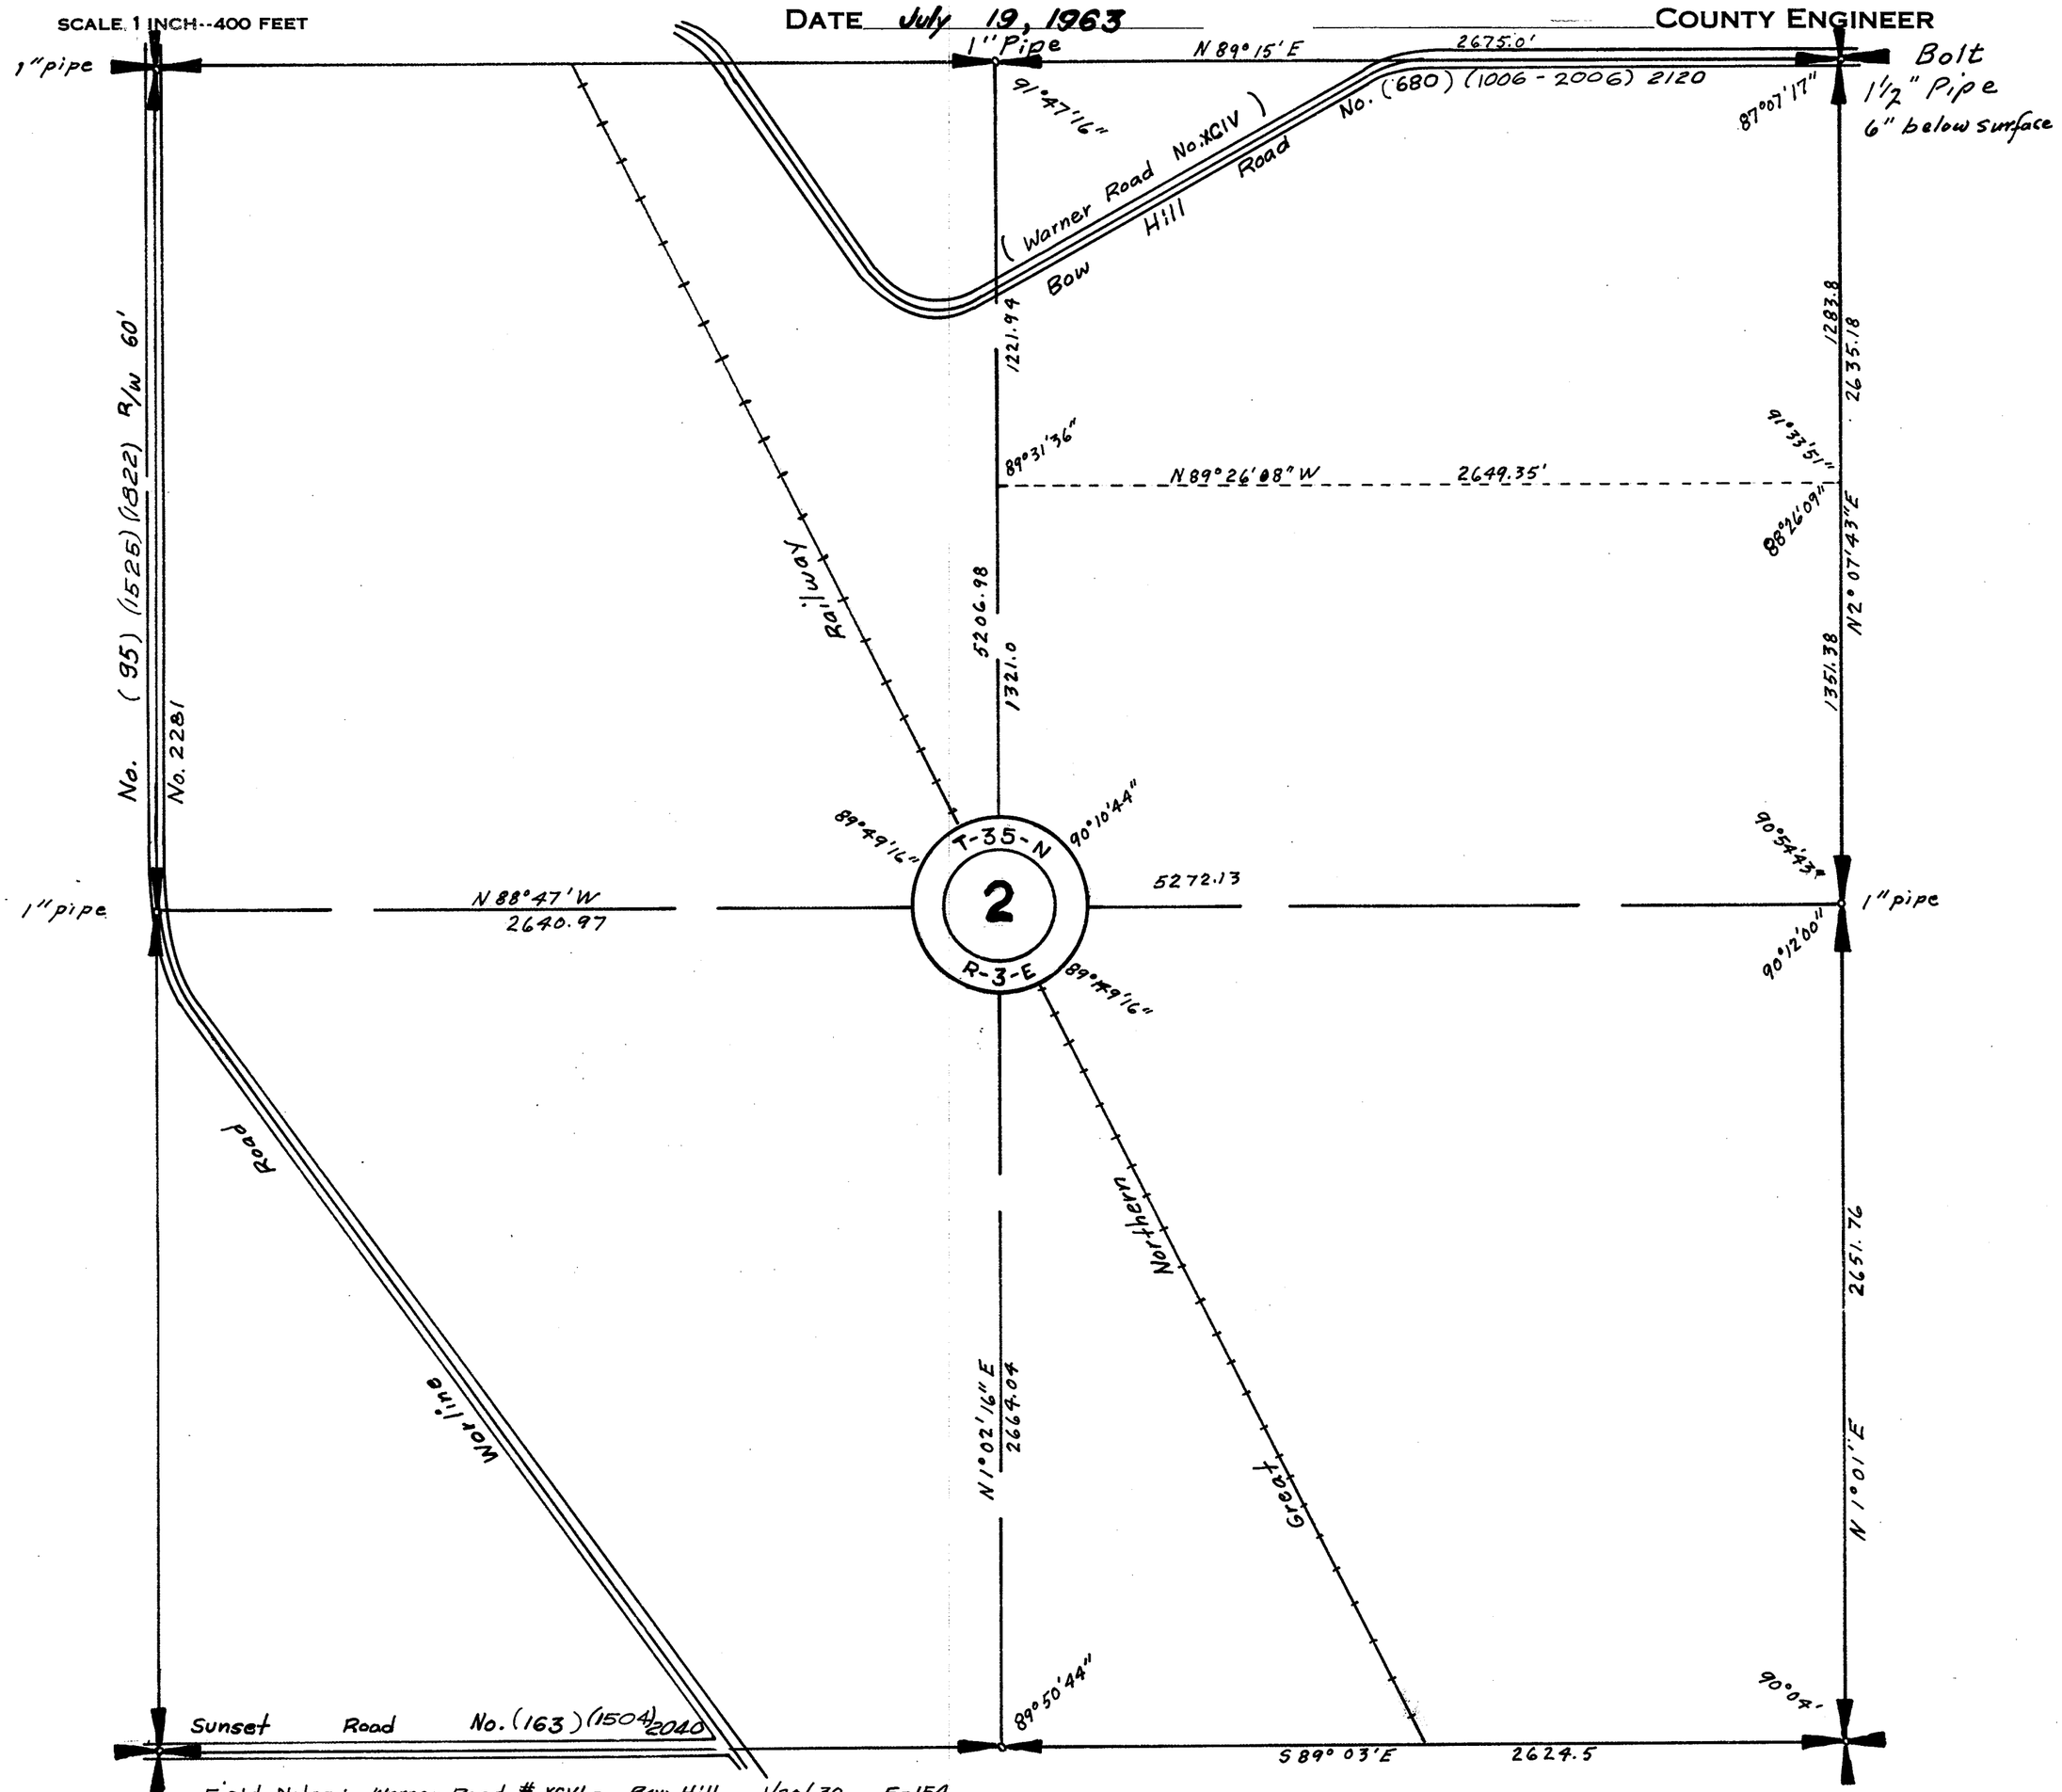

Field Notes: Warner Road # XCVI - Bow Hill 1/20/30 F-154
Bow Hill Road #60 2/6/36 35/294
1957 294-2

A-19
9

Bow Hill Rev. Road # XCVI 38/371½

SECTION 2


TOWNSHIP 35 NORTH. RANGE 3 EAST. W. M.
SKAGIT COUNTY. WASH.

SCALE, 1 INCH—400 FEET

A. L. STRONG COUNTY ENGINEER

Robt. E.L. Knapp 1930.

F154

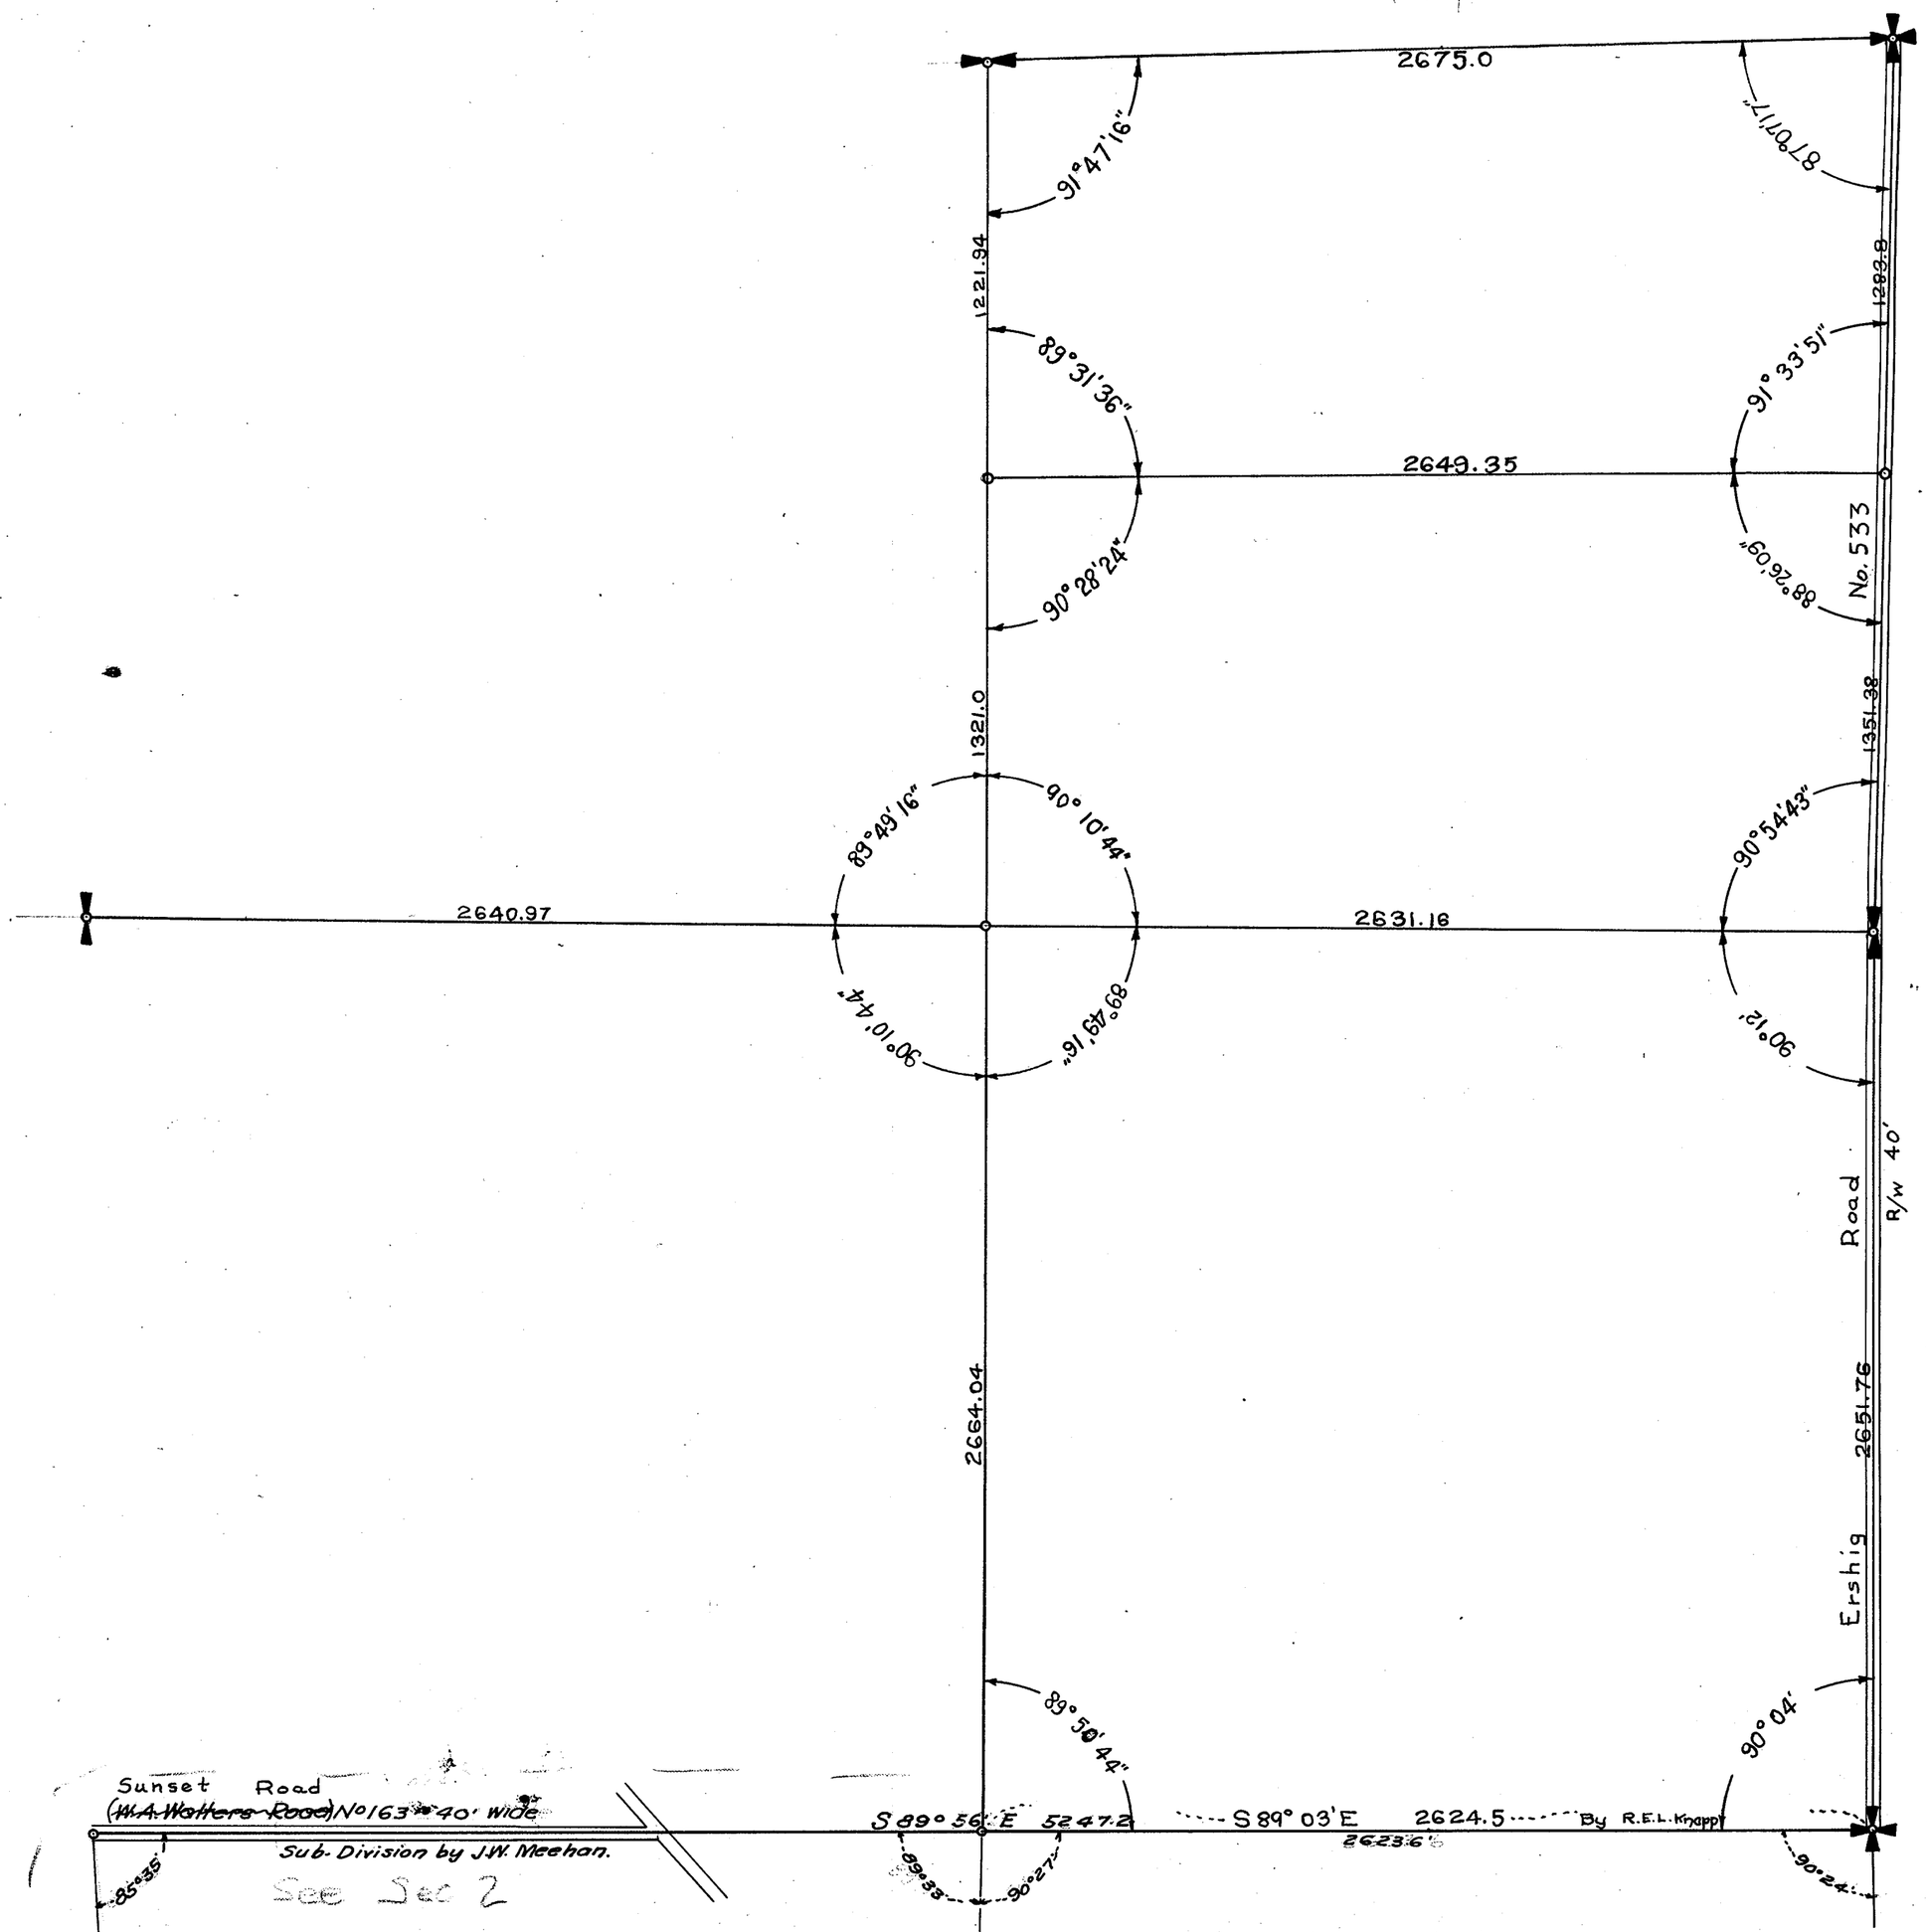

SECTION 3


TOWNSHIP 35 NORTH, RANGE 7 EAST, W. M.

SKAGIT COUNTY, WASH.

SCALE, 1 INCH--400 FEET

DATE 4-21-66

_____ COUNTY ENGINEER

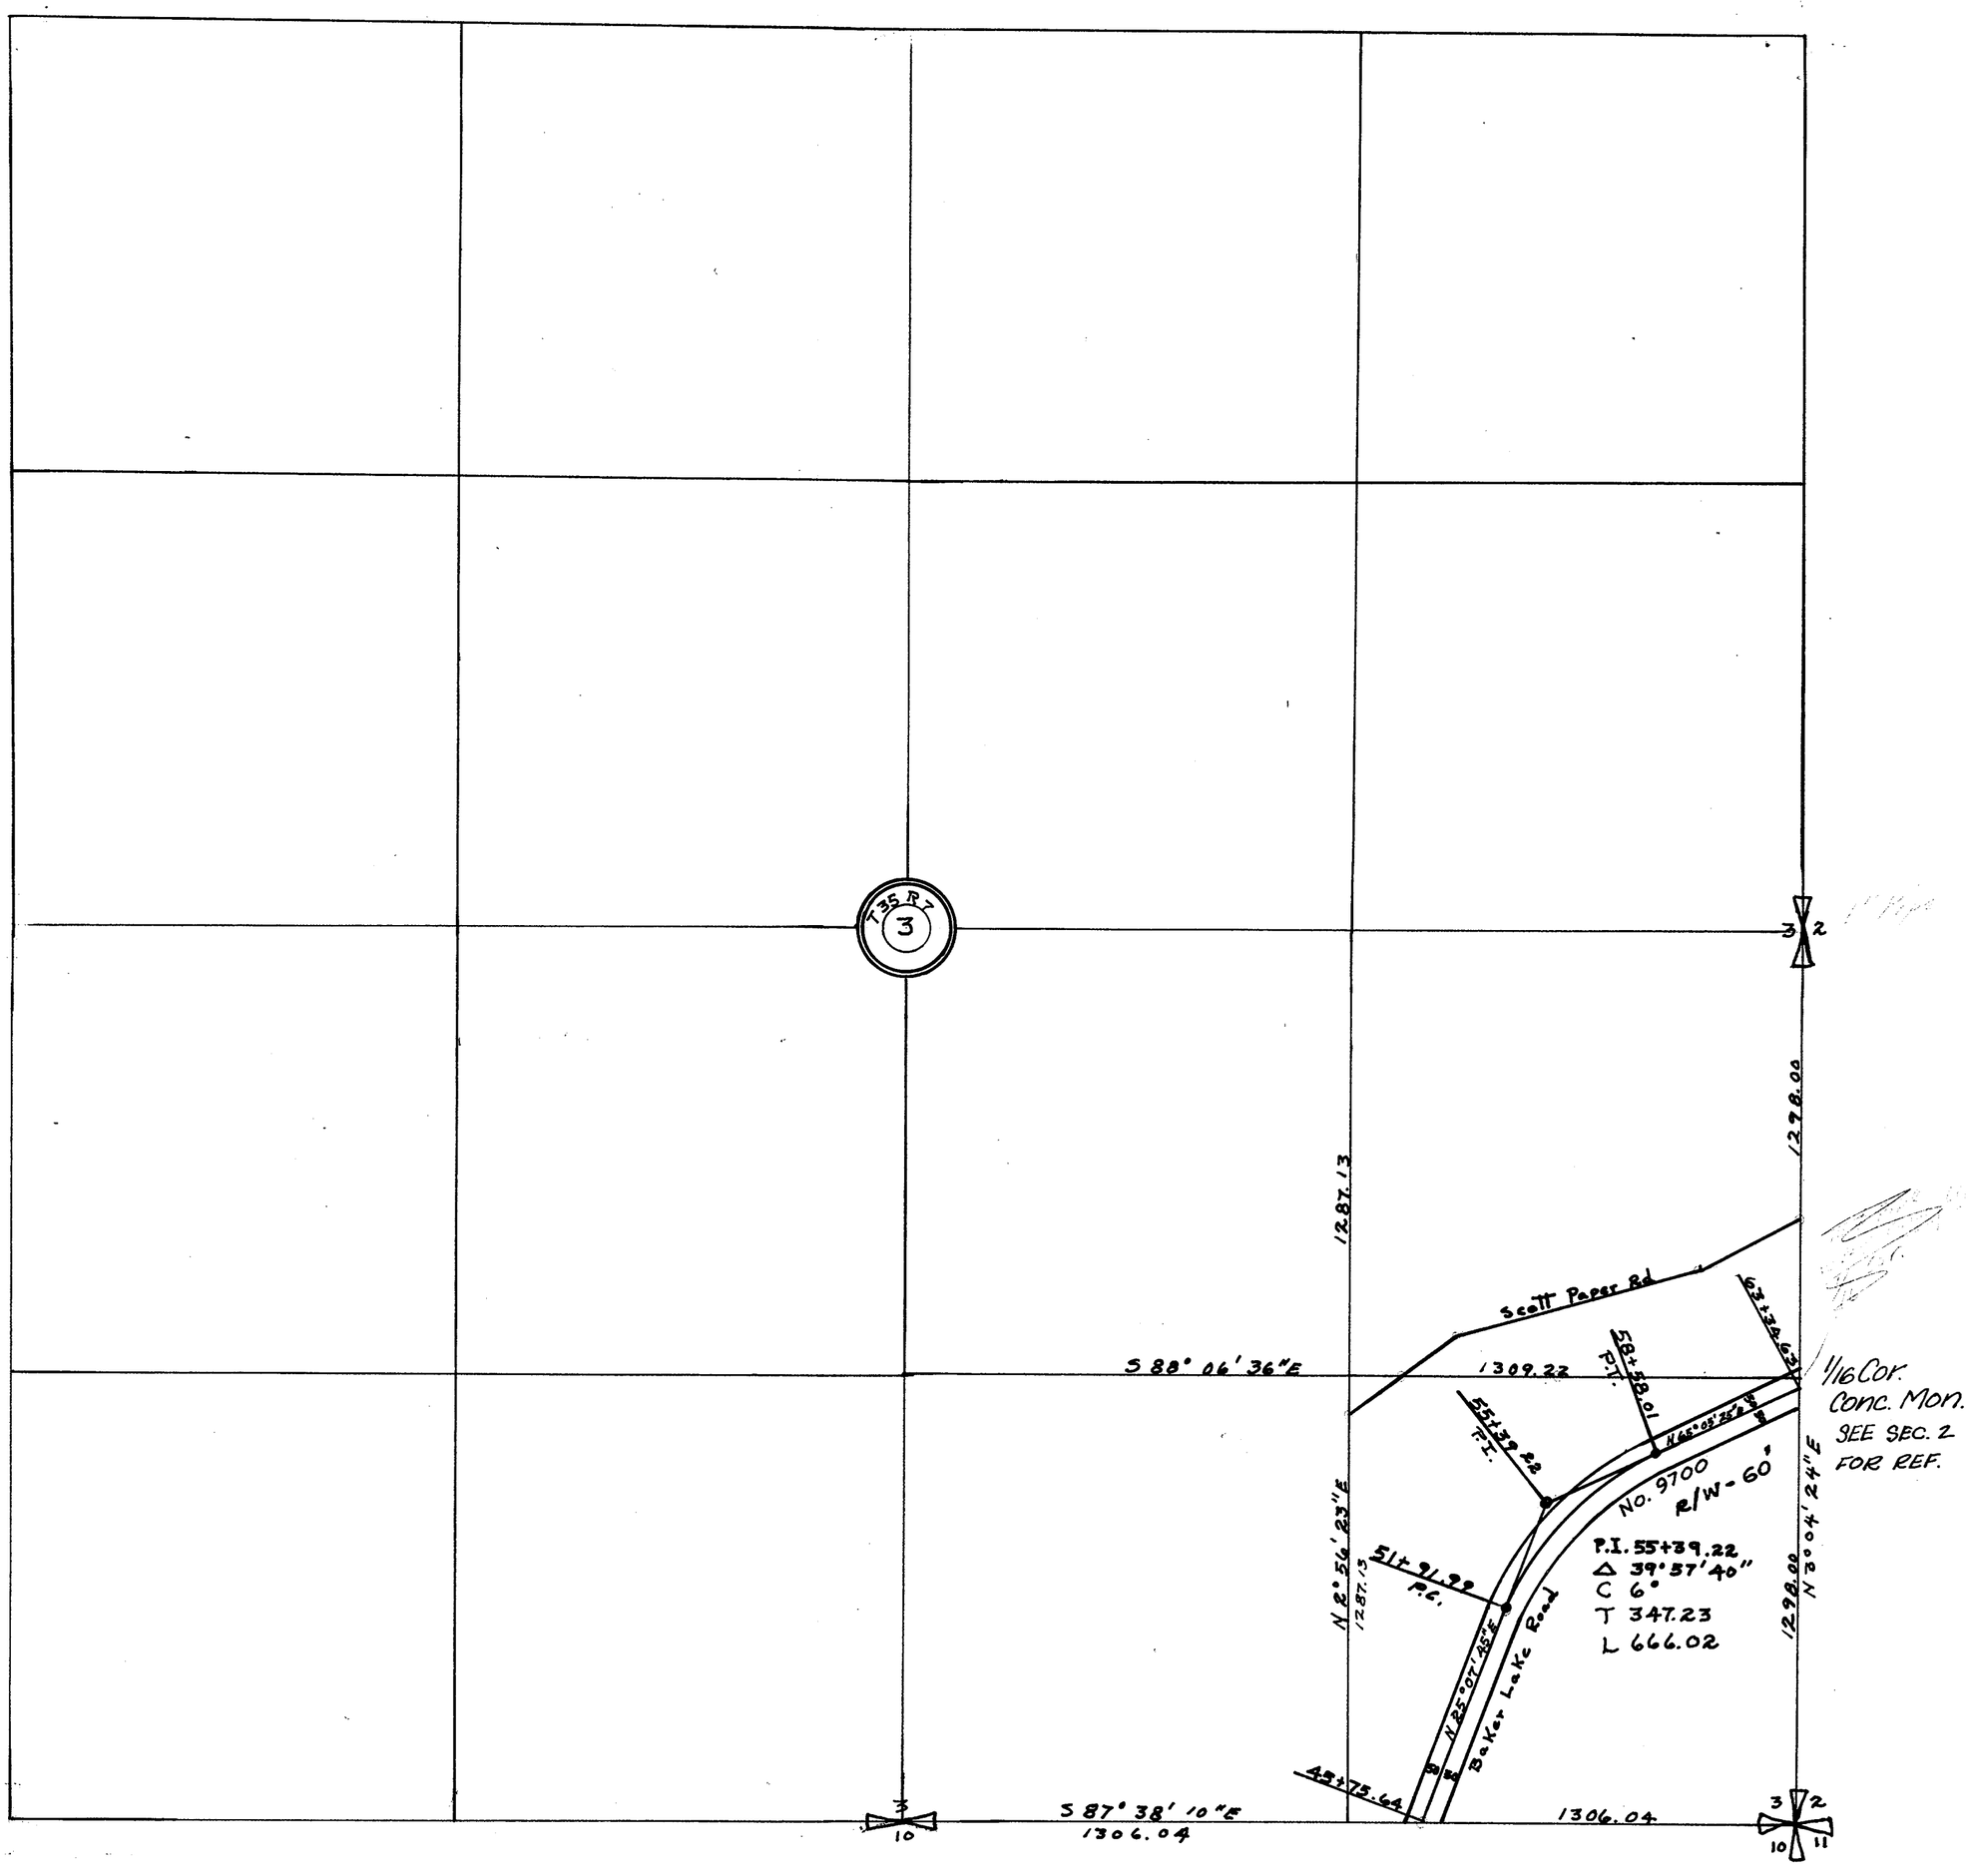

SECTION 3

TOWNSHIP 35 NORTH, RANGE 3 EAST, W. M.

SKAGIT COUNTY, WASH.

SCALE, 1 INCH--400 FEET

DATE July, 1959 Frank Gilkey COUNTY ENGINEER



SECTION 3


TOWNSHIP 35 NORTH. RANGE 3 EAST. W. M.

SKAGIT COUNTY. WASH.

Notes: E 104

R. E. L. Knapp 6-1928 COUNTY ENGINEER

SCALE, 1 INCH—400 FEET

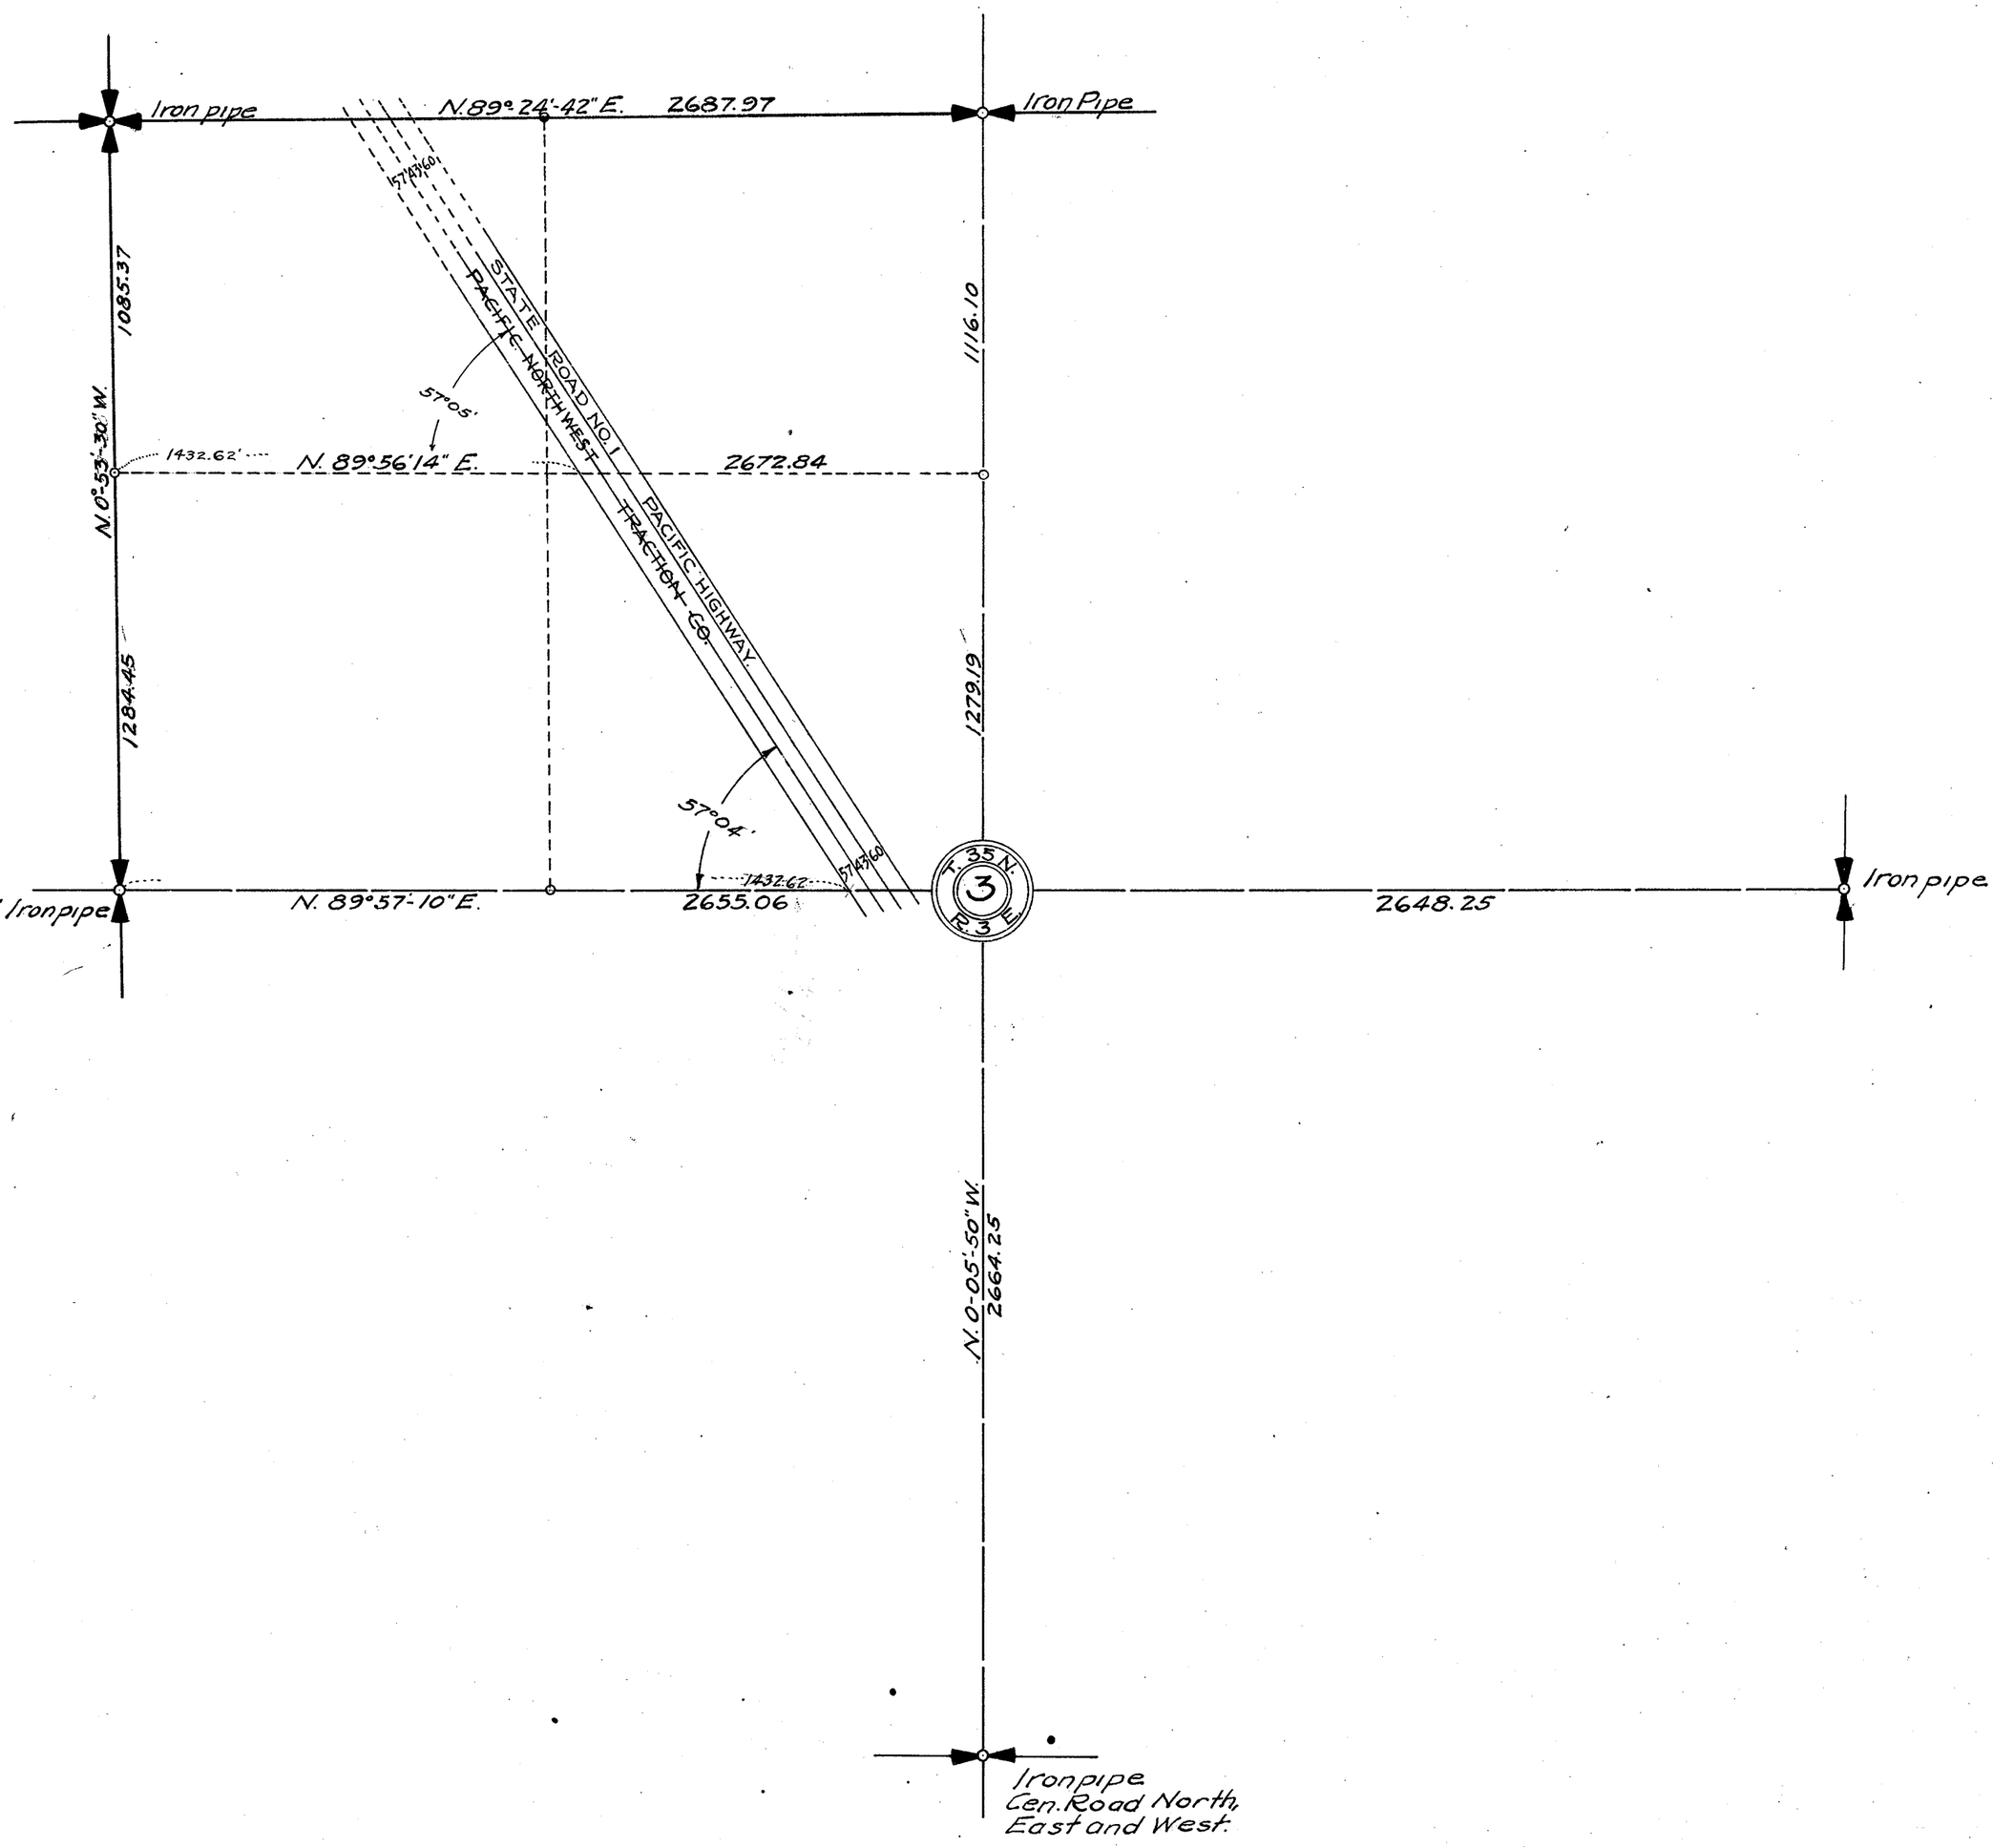


SECTION 3

TOWNSHIP 35 NORTH, RANGE 3 EAST, W. M.
SKAGIT COUNTY, WASH.

Surveyed by L.E. Smith.
Nov. 1919. Transit Book # 82
R.W. McKinstry, County Engineer.

SCALE: 1 INCH = 400 FEET

A. L. STRONG COUNTY ENGINEER

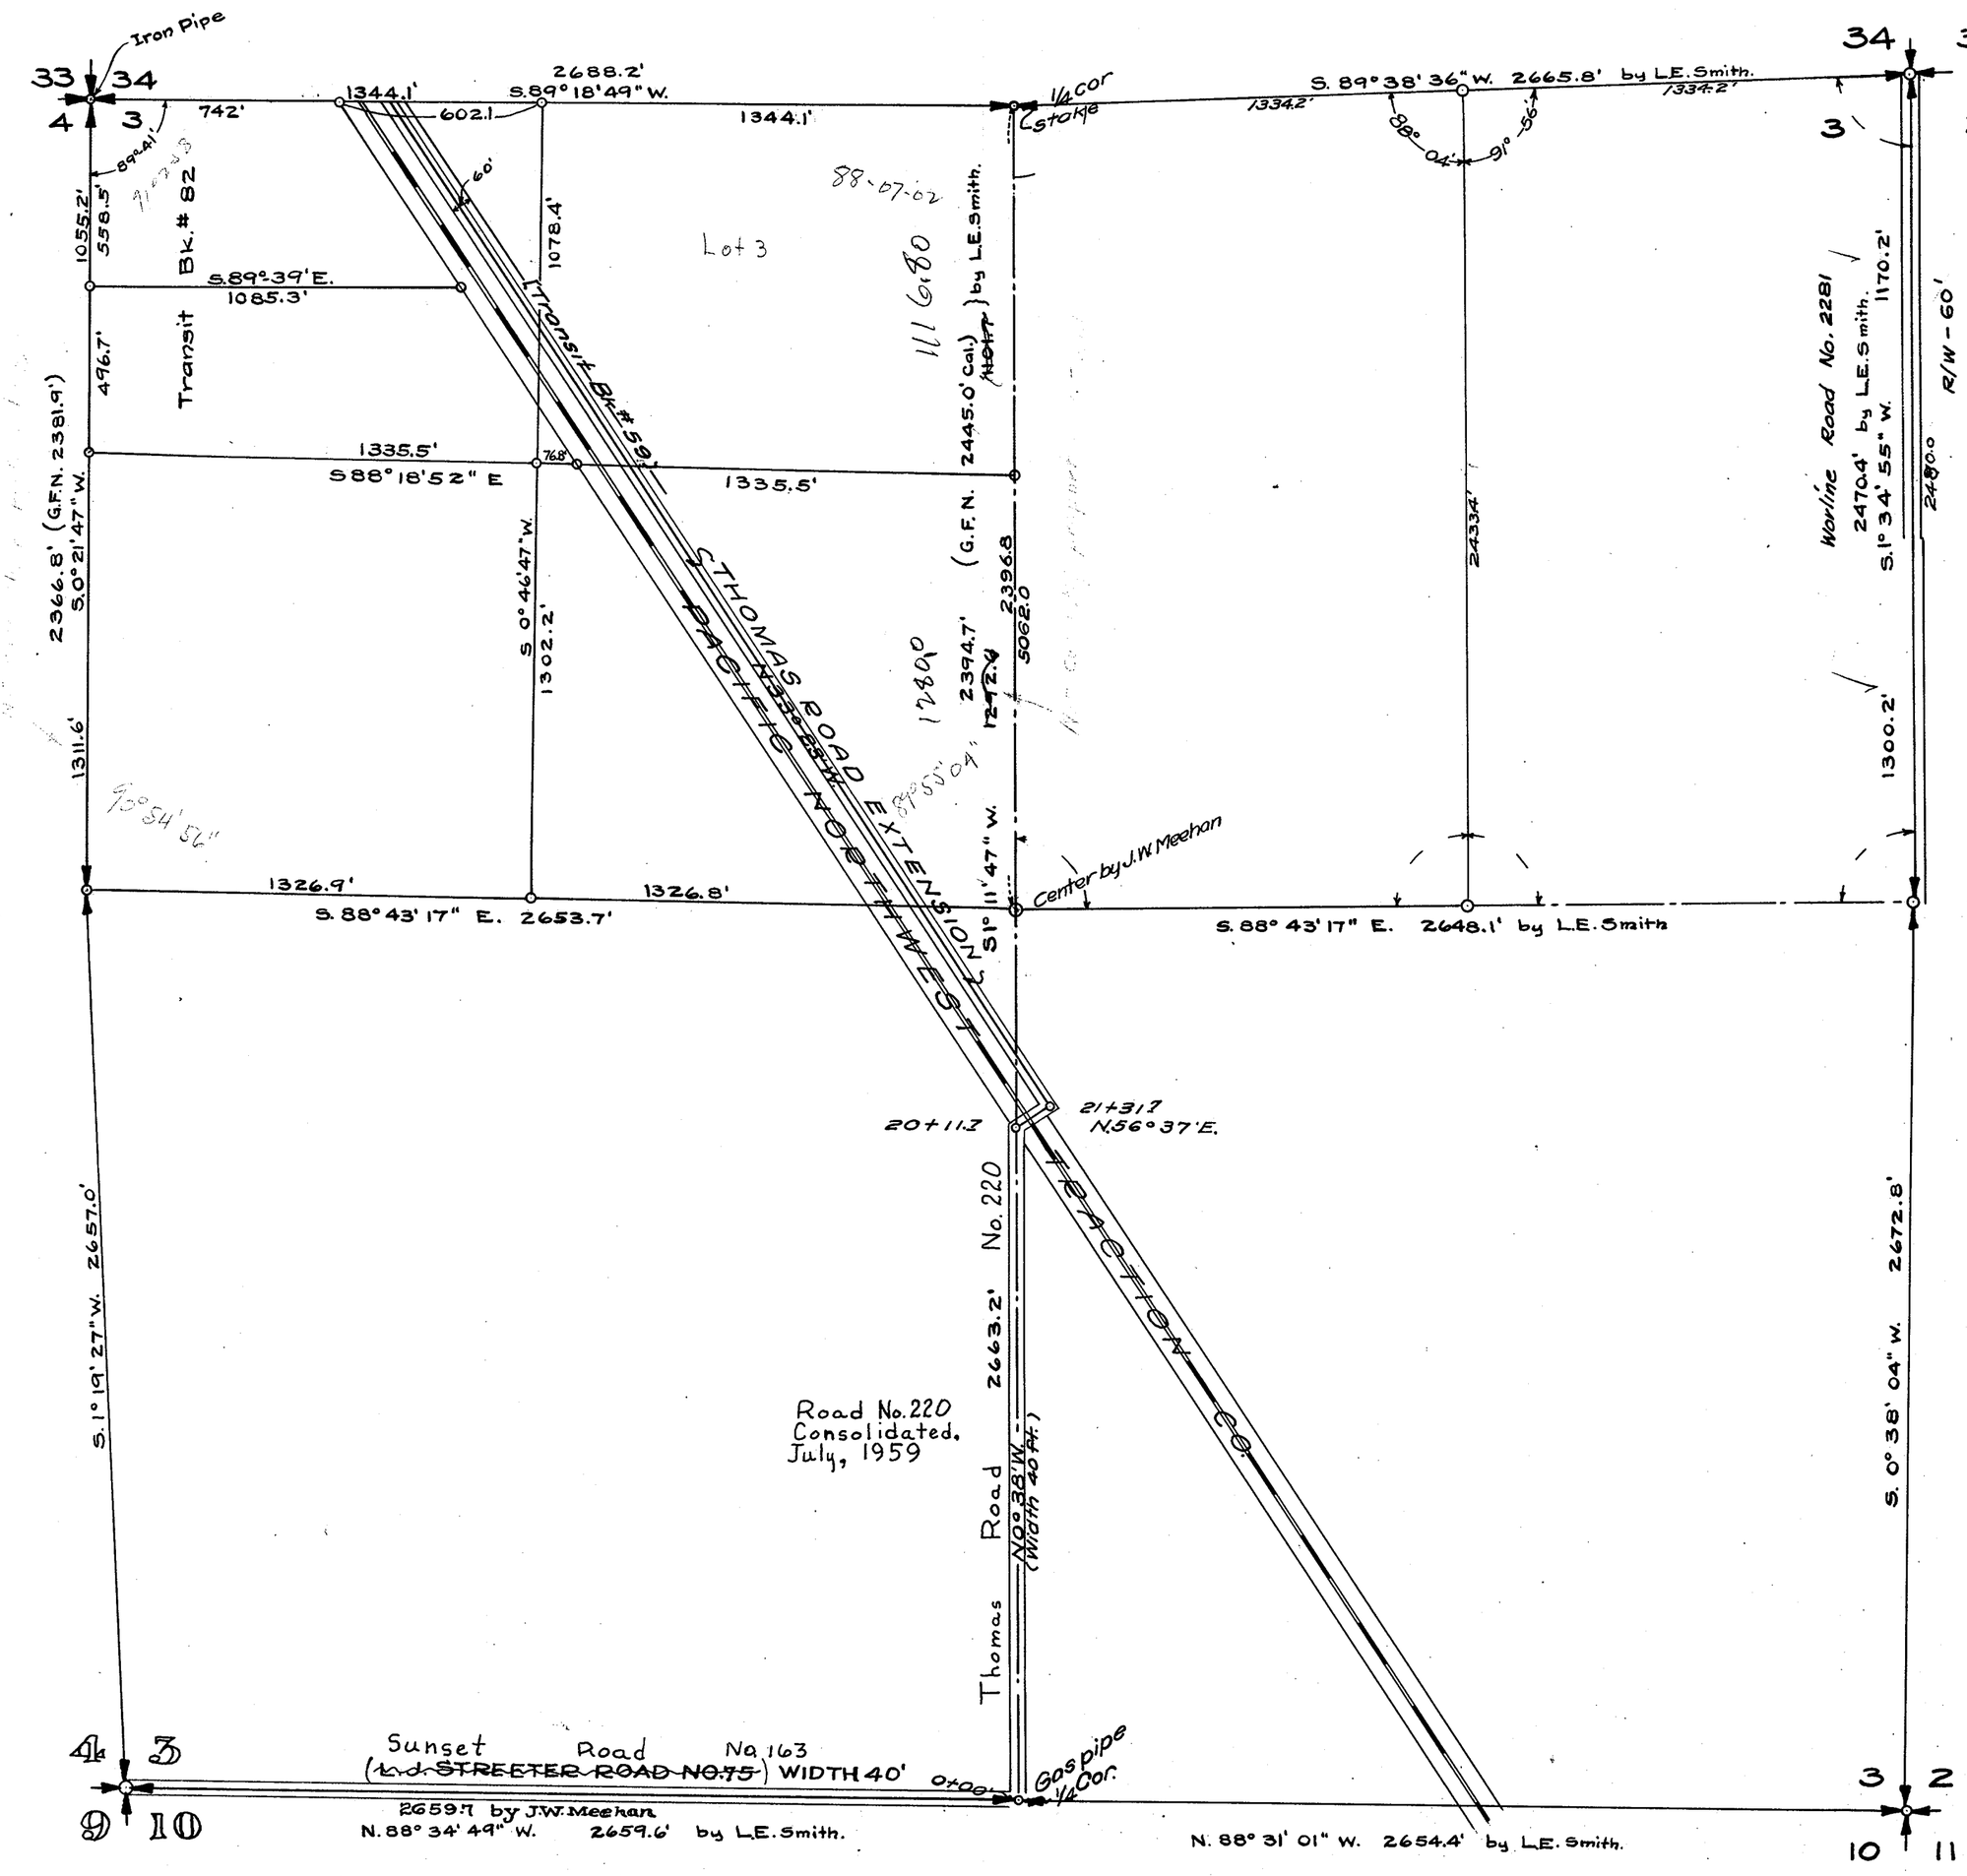


SECTION 4

TOWNSHIP 35 NORTH, RANGE 3 EAST, W. M.

SKAGIT COUNTY, WASH.

Notes: E-104
June 1928

SCALE, 1 INCH=400 FEET

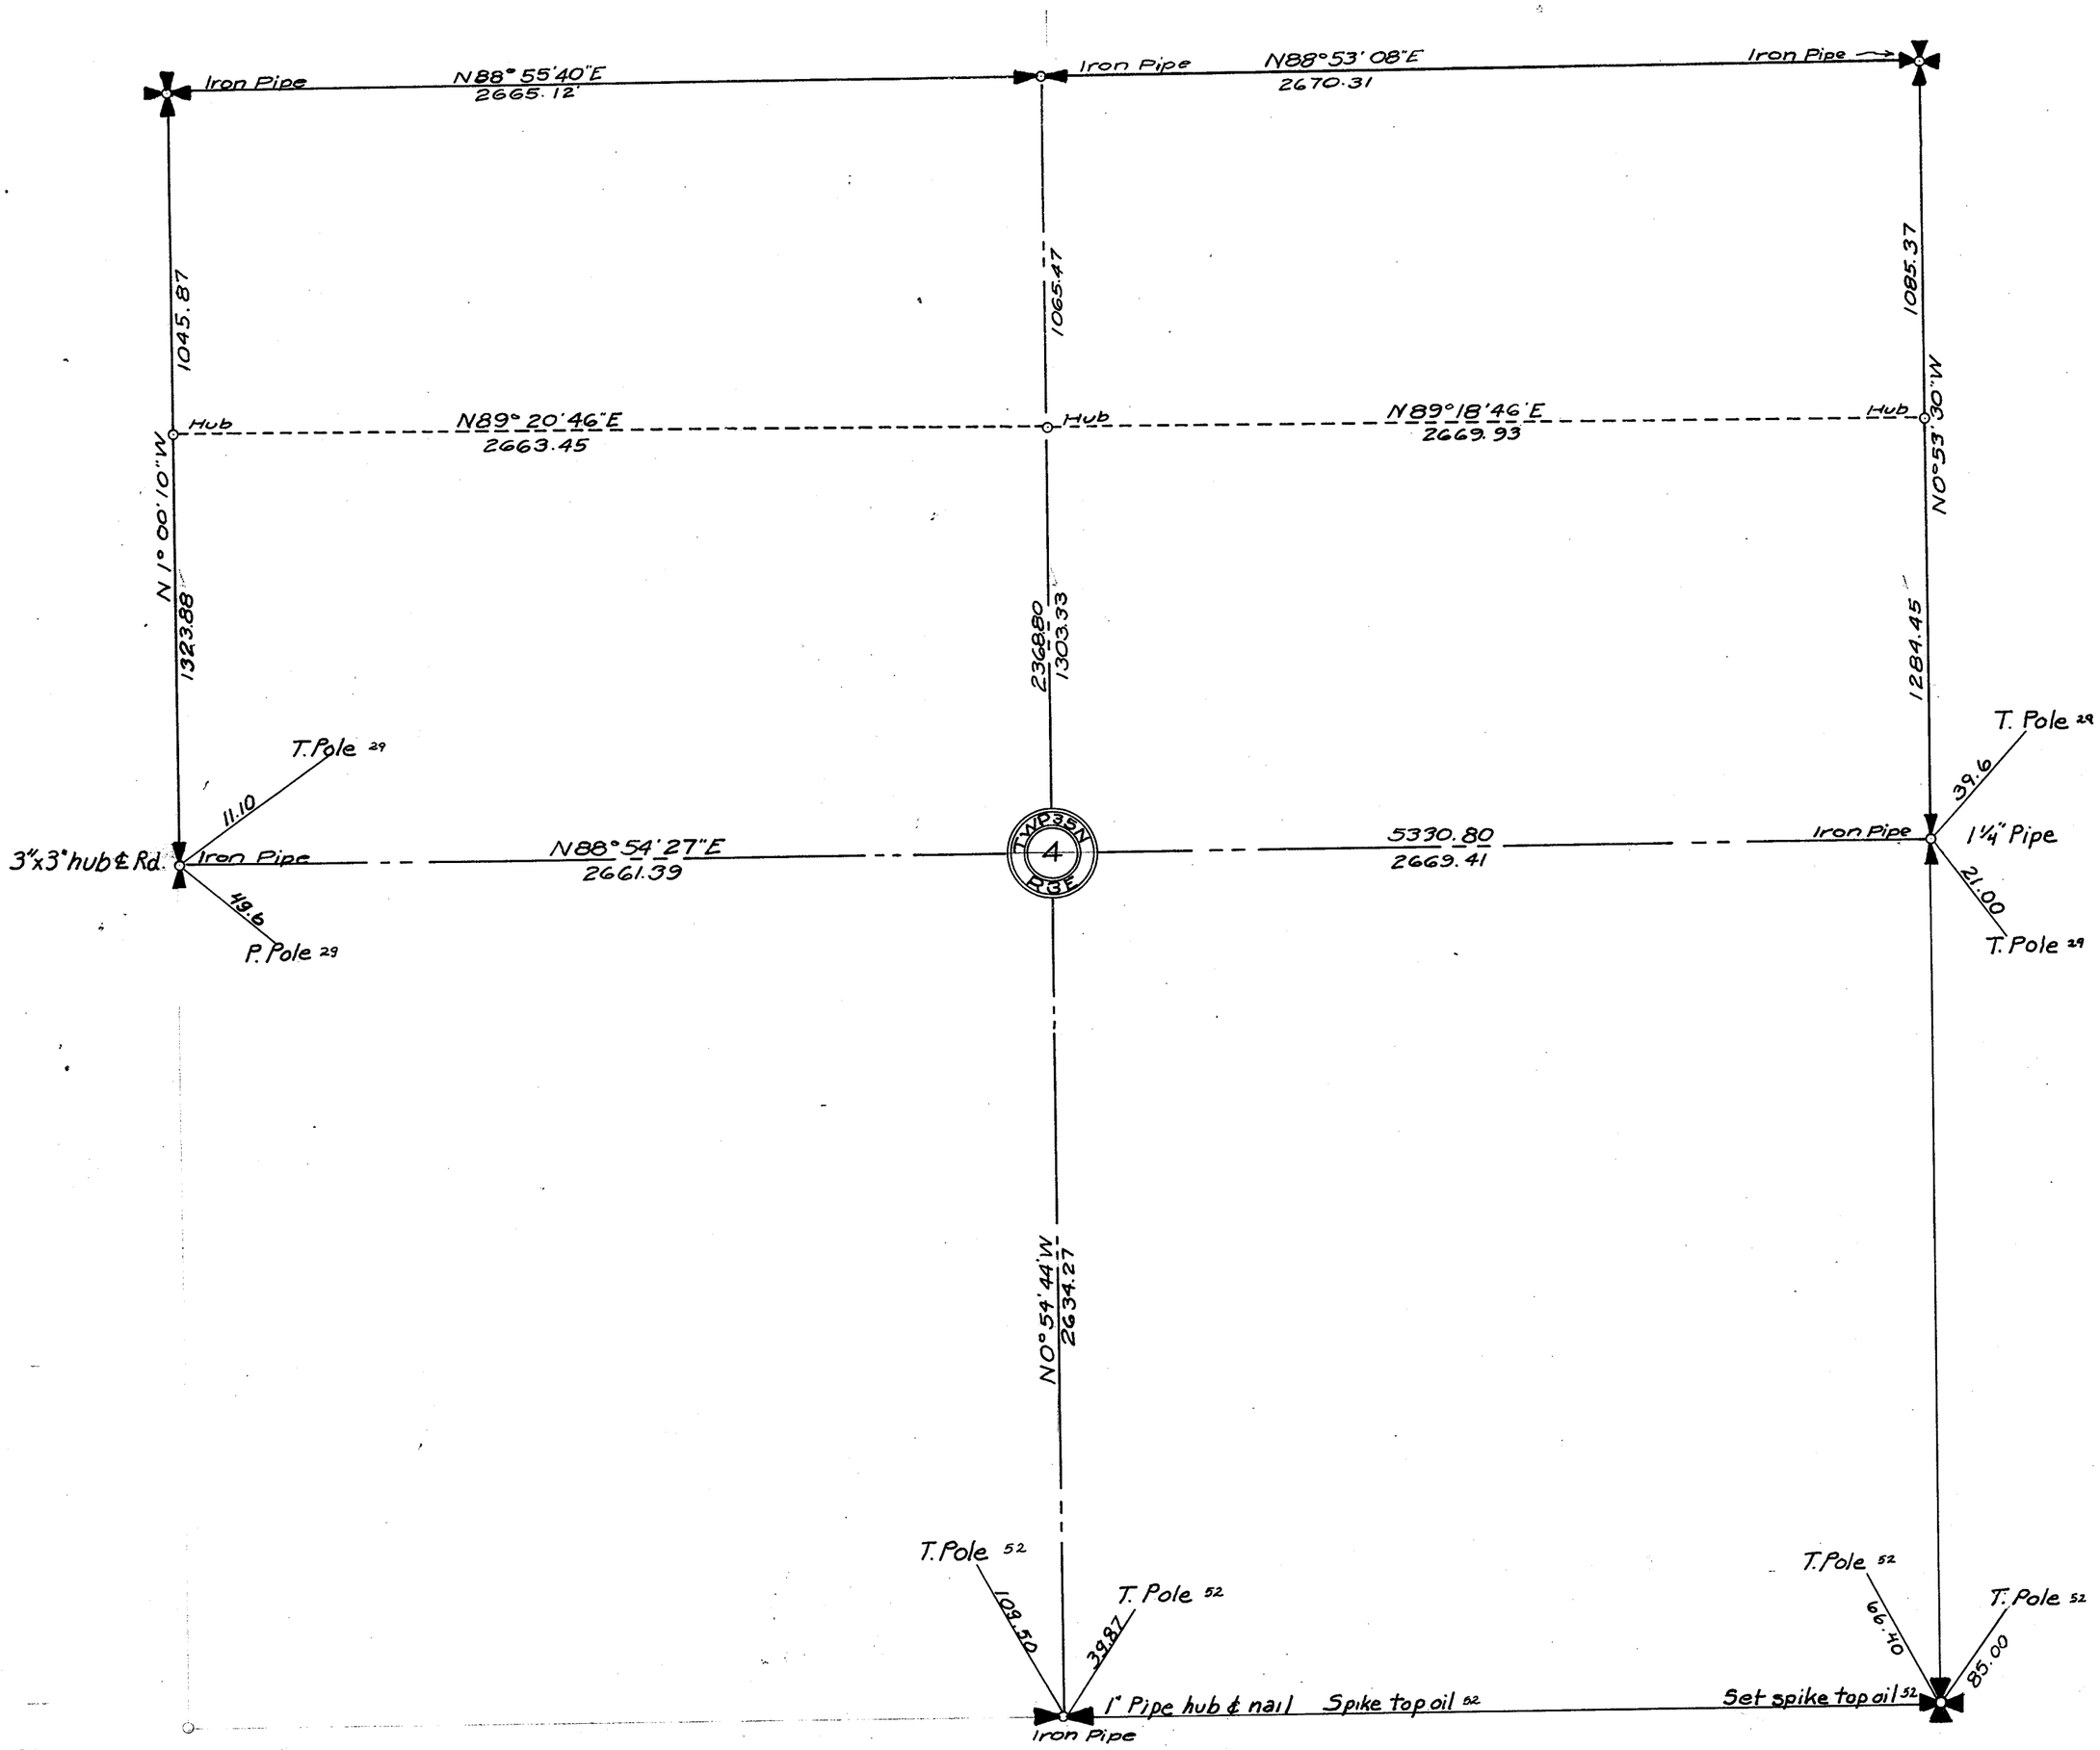


SECTION 4

TOWNSHIP 35 NORTH. RANGE 3 EAST. W. M.
SKAGIT COUNTY. WASH.

Surveyed by L.E. Smith
Nov. 1919. Transit Book # 82

SCALE, 1 INCH--400 FEET

R.W. McKinstry COUNTY ENGINEER

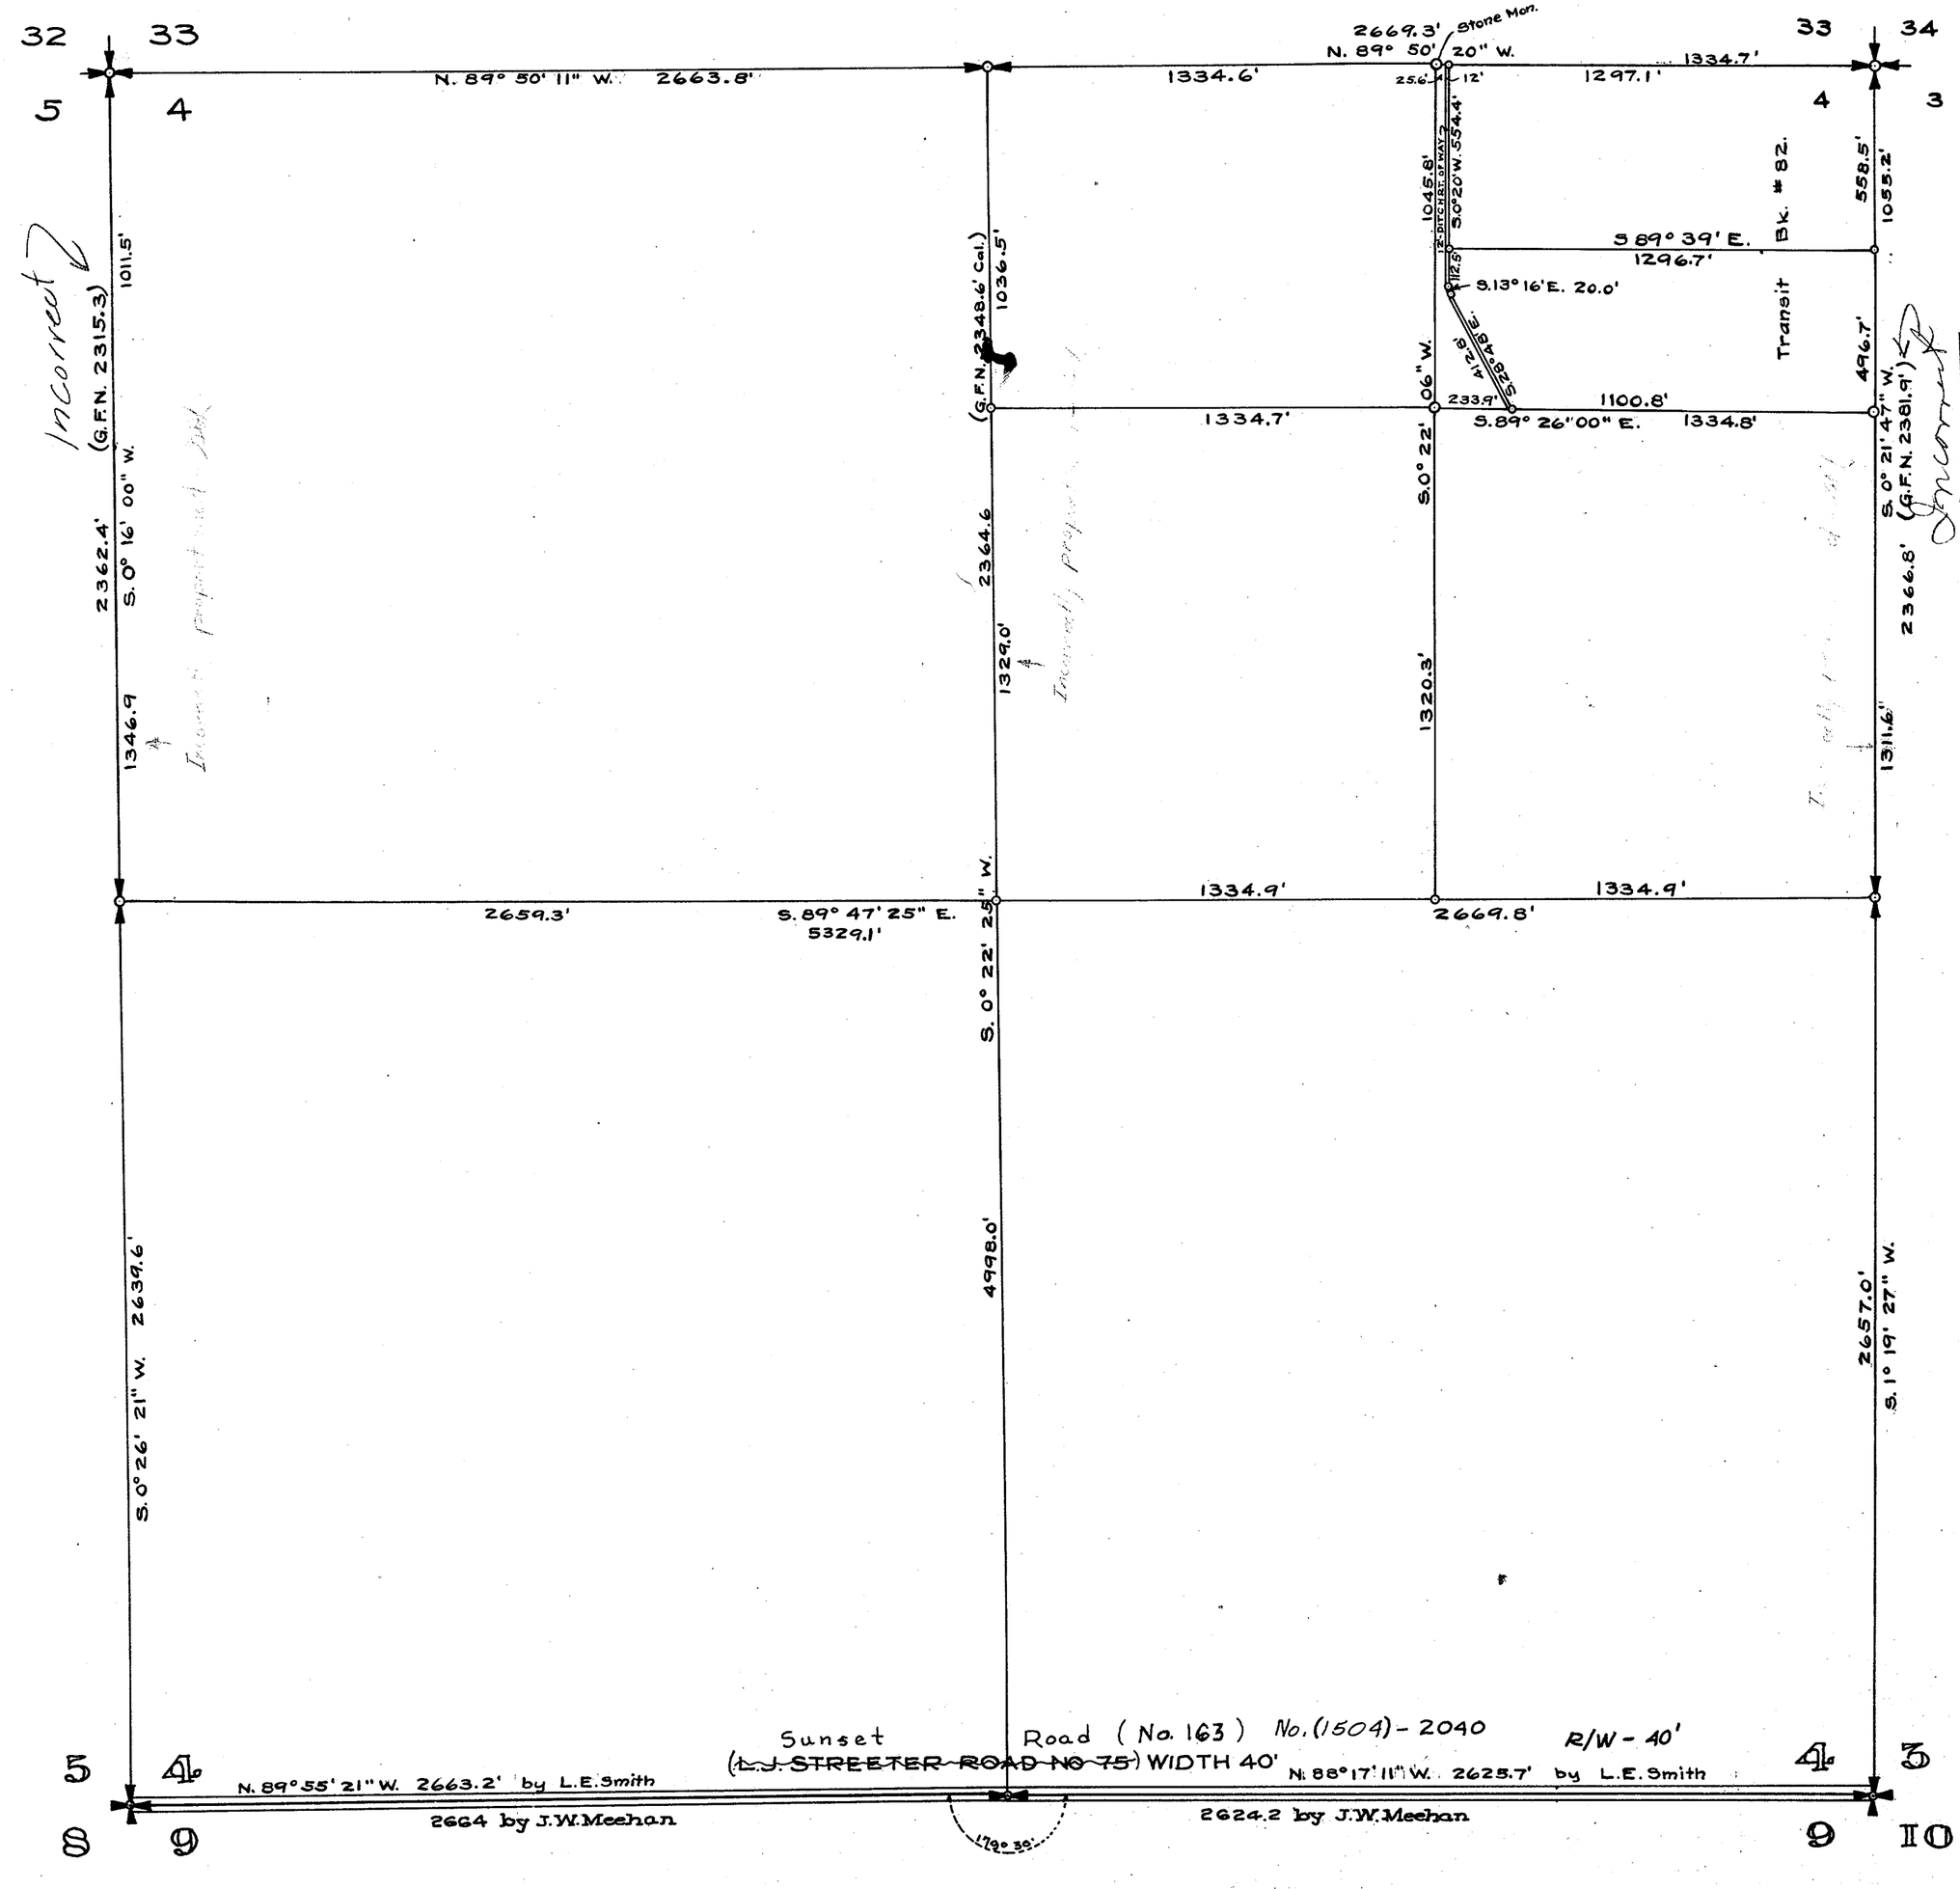

SECTION 5

TOWNSHIP 35 NORTH, RANGE 3 EAST, W. M.


SKAGIT COUNTY, WASH.

SCALE, 1 INCH--400 FEET

Notes as shown
Subdiv. F146

H.O. WALBERG COUNTY ENGINEER

Compiled by W.C.W from notes Aug. 1944

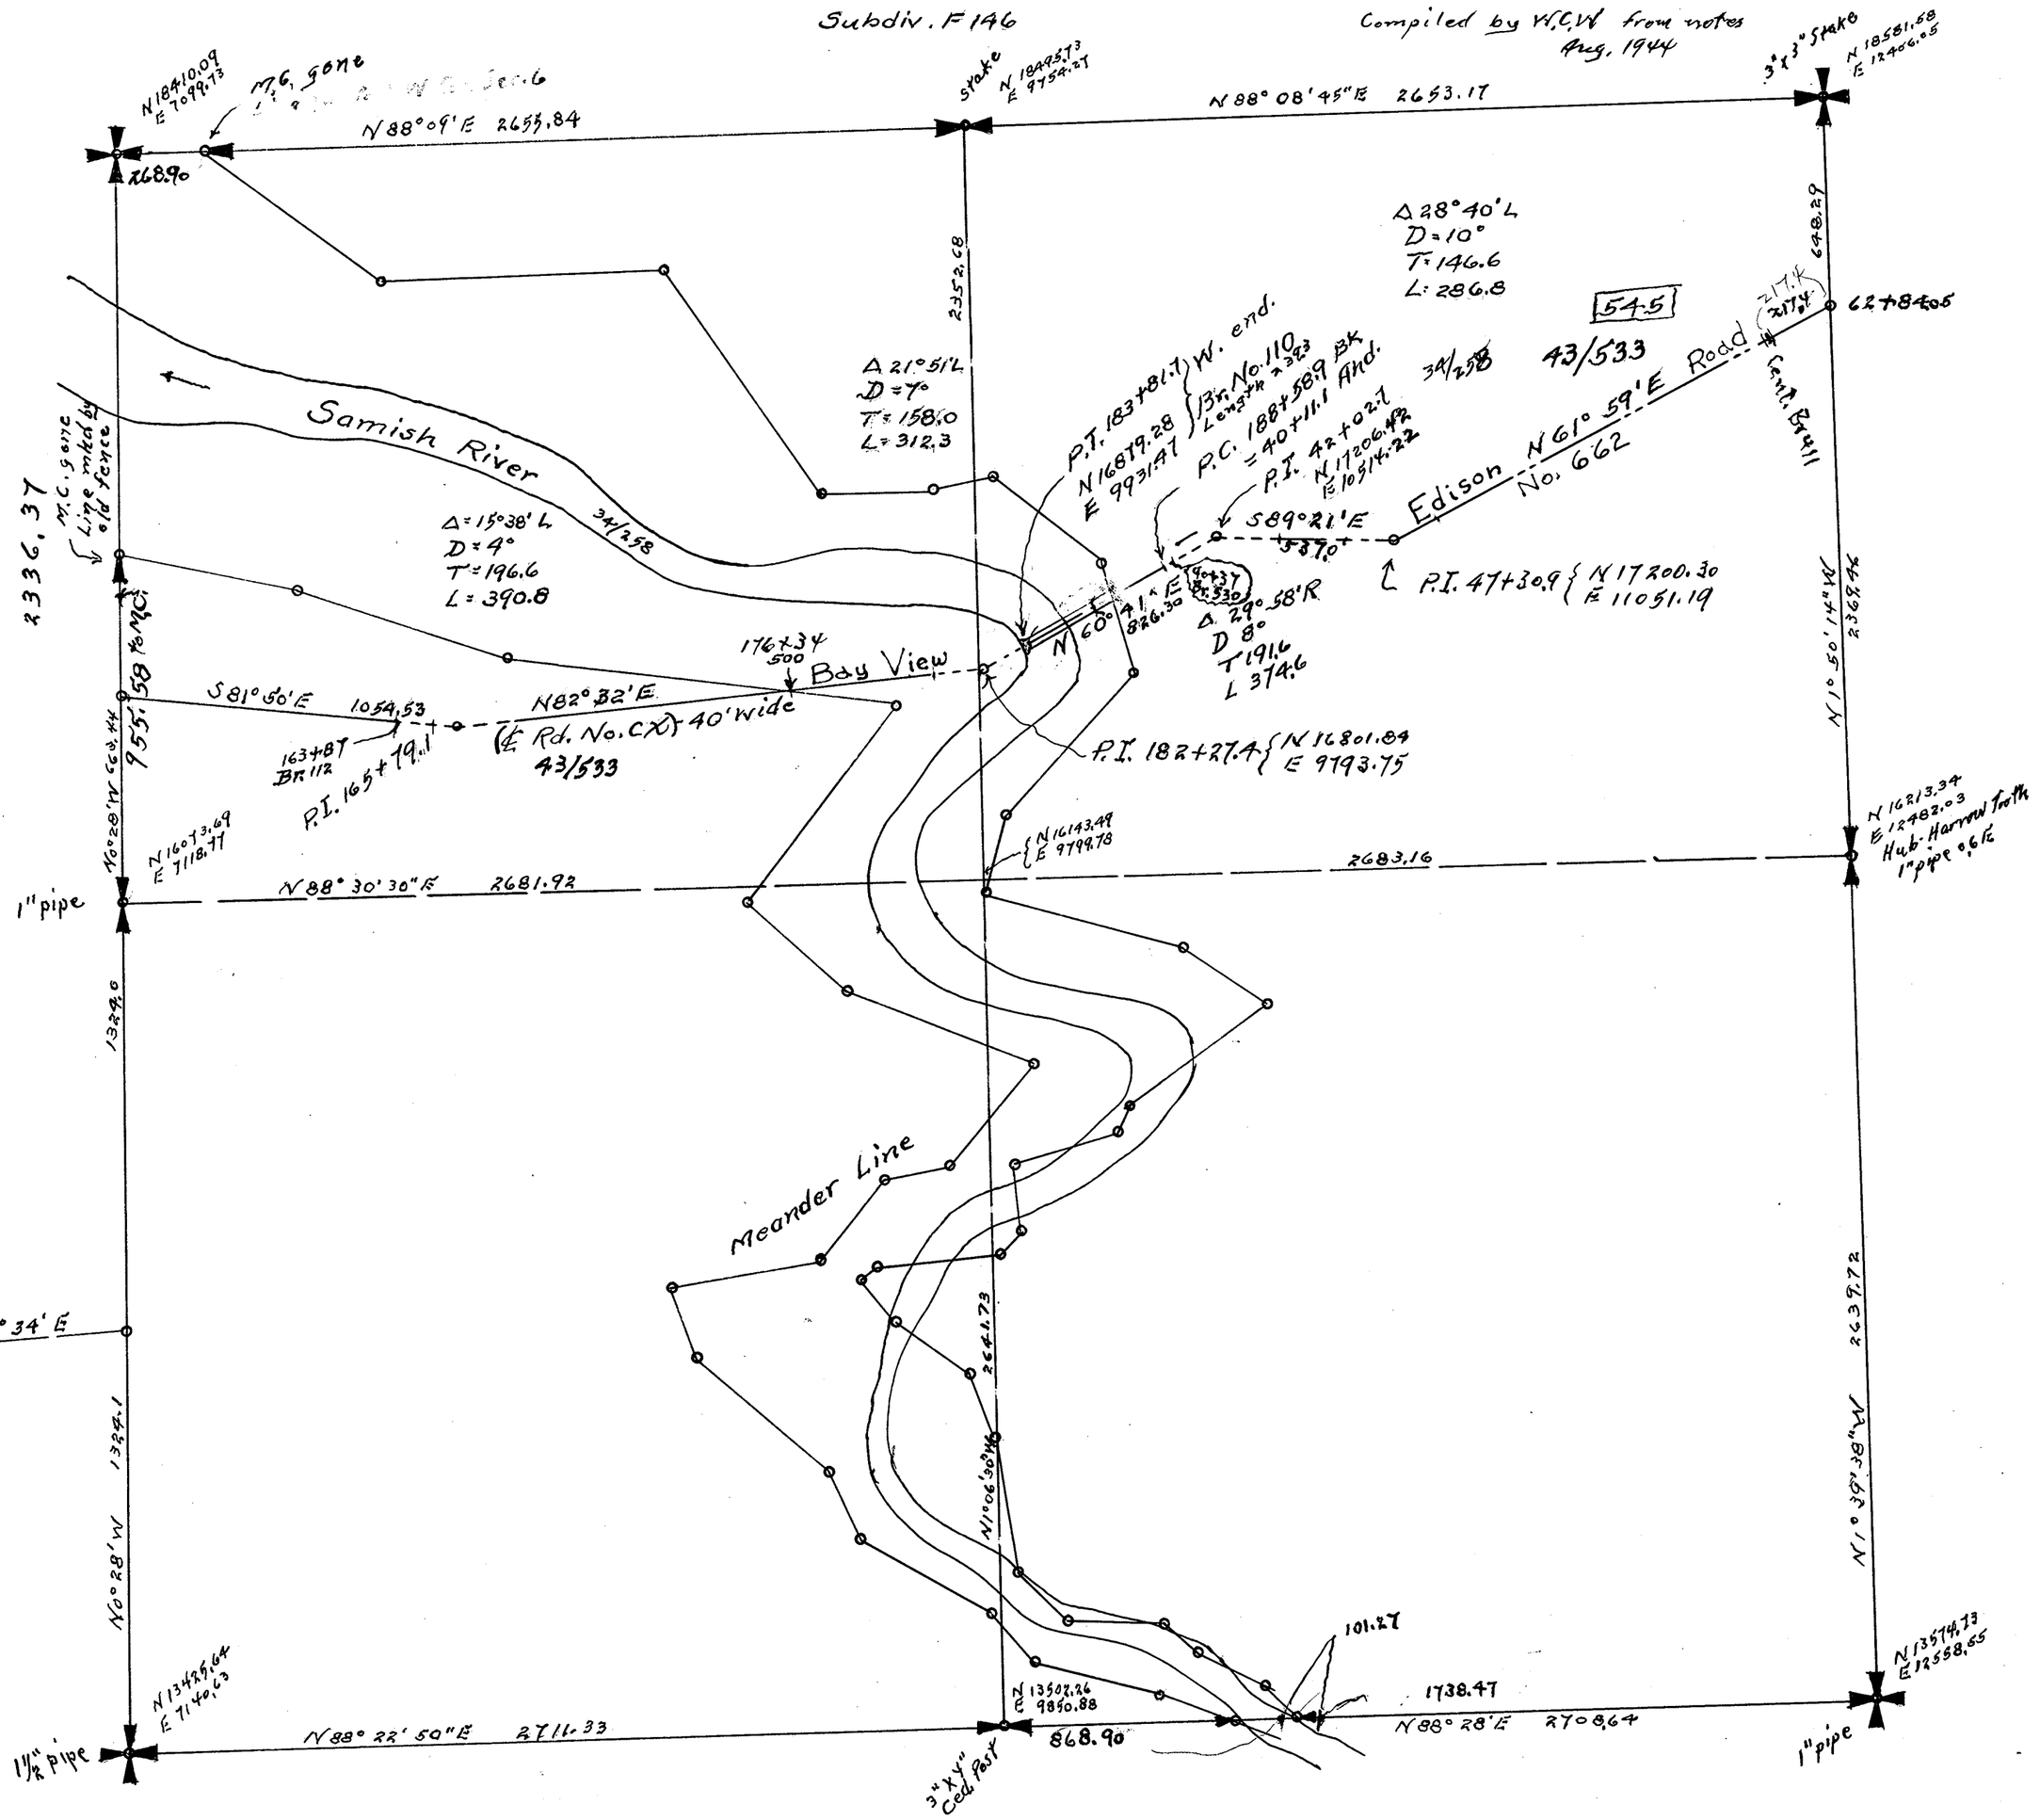

SKAGIT COUNTY

SEC. 5 TWP. 35 R. 3

36" Cedar stp.
102.90
20.20
18 Cedar stp.
P. Pole
42.40
91.70
24 Maple
S 89° 04' W
2651.75
1 1/2 Pipe
F. Post 46
39.60
3"x3" stake
Nail in road 33
Found 3/4 pipe
1 below surf. 46
33.60
F. Post 46
22.40
F. Post 46
48° 31' 30"
N 48° 20' 15" E
3577.17
2351.24
N 0° 55' W
2367.8
2369.0
5362.04
41° 05' 25"
T. Pole 29
Found stake
Set 1" pipe 29
N89° 25' 40" E
2680.25
1" Pipe 33
T. Pole 29

From notes: F-146
544-3
371

S 0° 27' W
2646.40
N 89° 22' E
2695.51
4991.22
N 0° 11' 15" W
N 89° 24' E
2994.08
N 0° 44' 30" W
2638.05

Found stake
Set 1/2" Rod 27
N89° 18' E
2709.90
N89° 23' E
3/4 Cedar Post 1929
2693.06

SECTION 5


TOWNSHIP 35 NORTH, RANGE 3 EAST, W. M.

SKAGIT COUNTY, WASH.

SCALE, 1 INCH--400 FEET
Road No. 662 From Notes 45/545, (3 of 3)

DATE June, 1959 Frank Gilkey COUNTY ENGINEER


Changes noted Jan. 1979

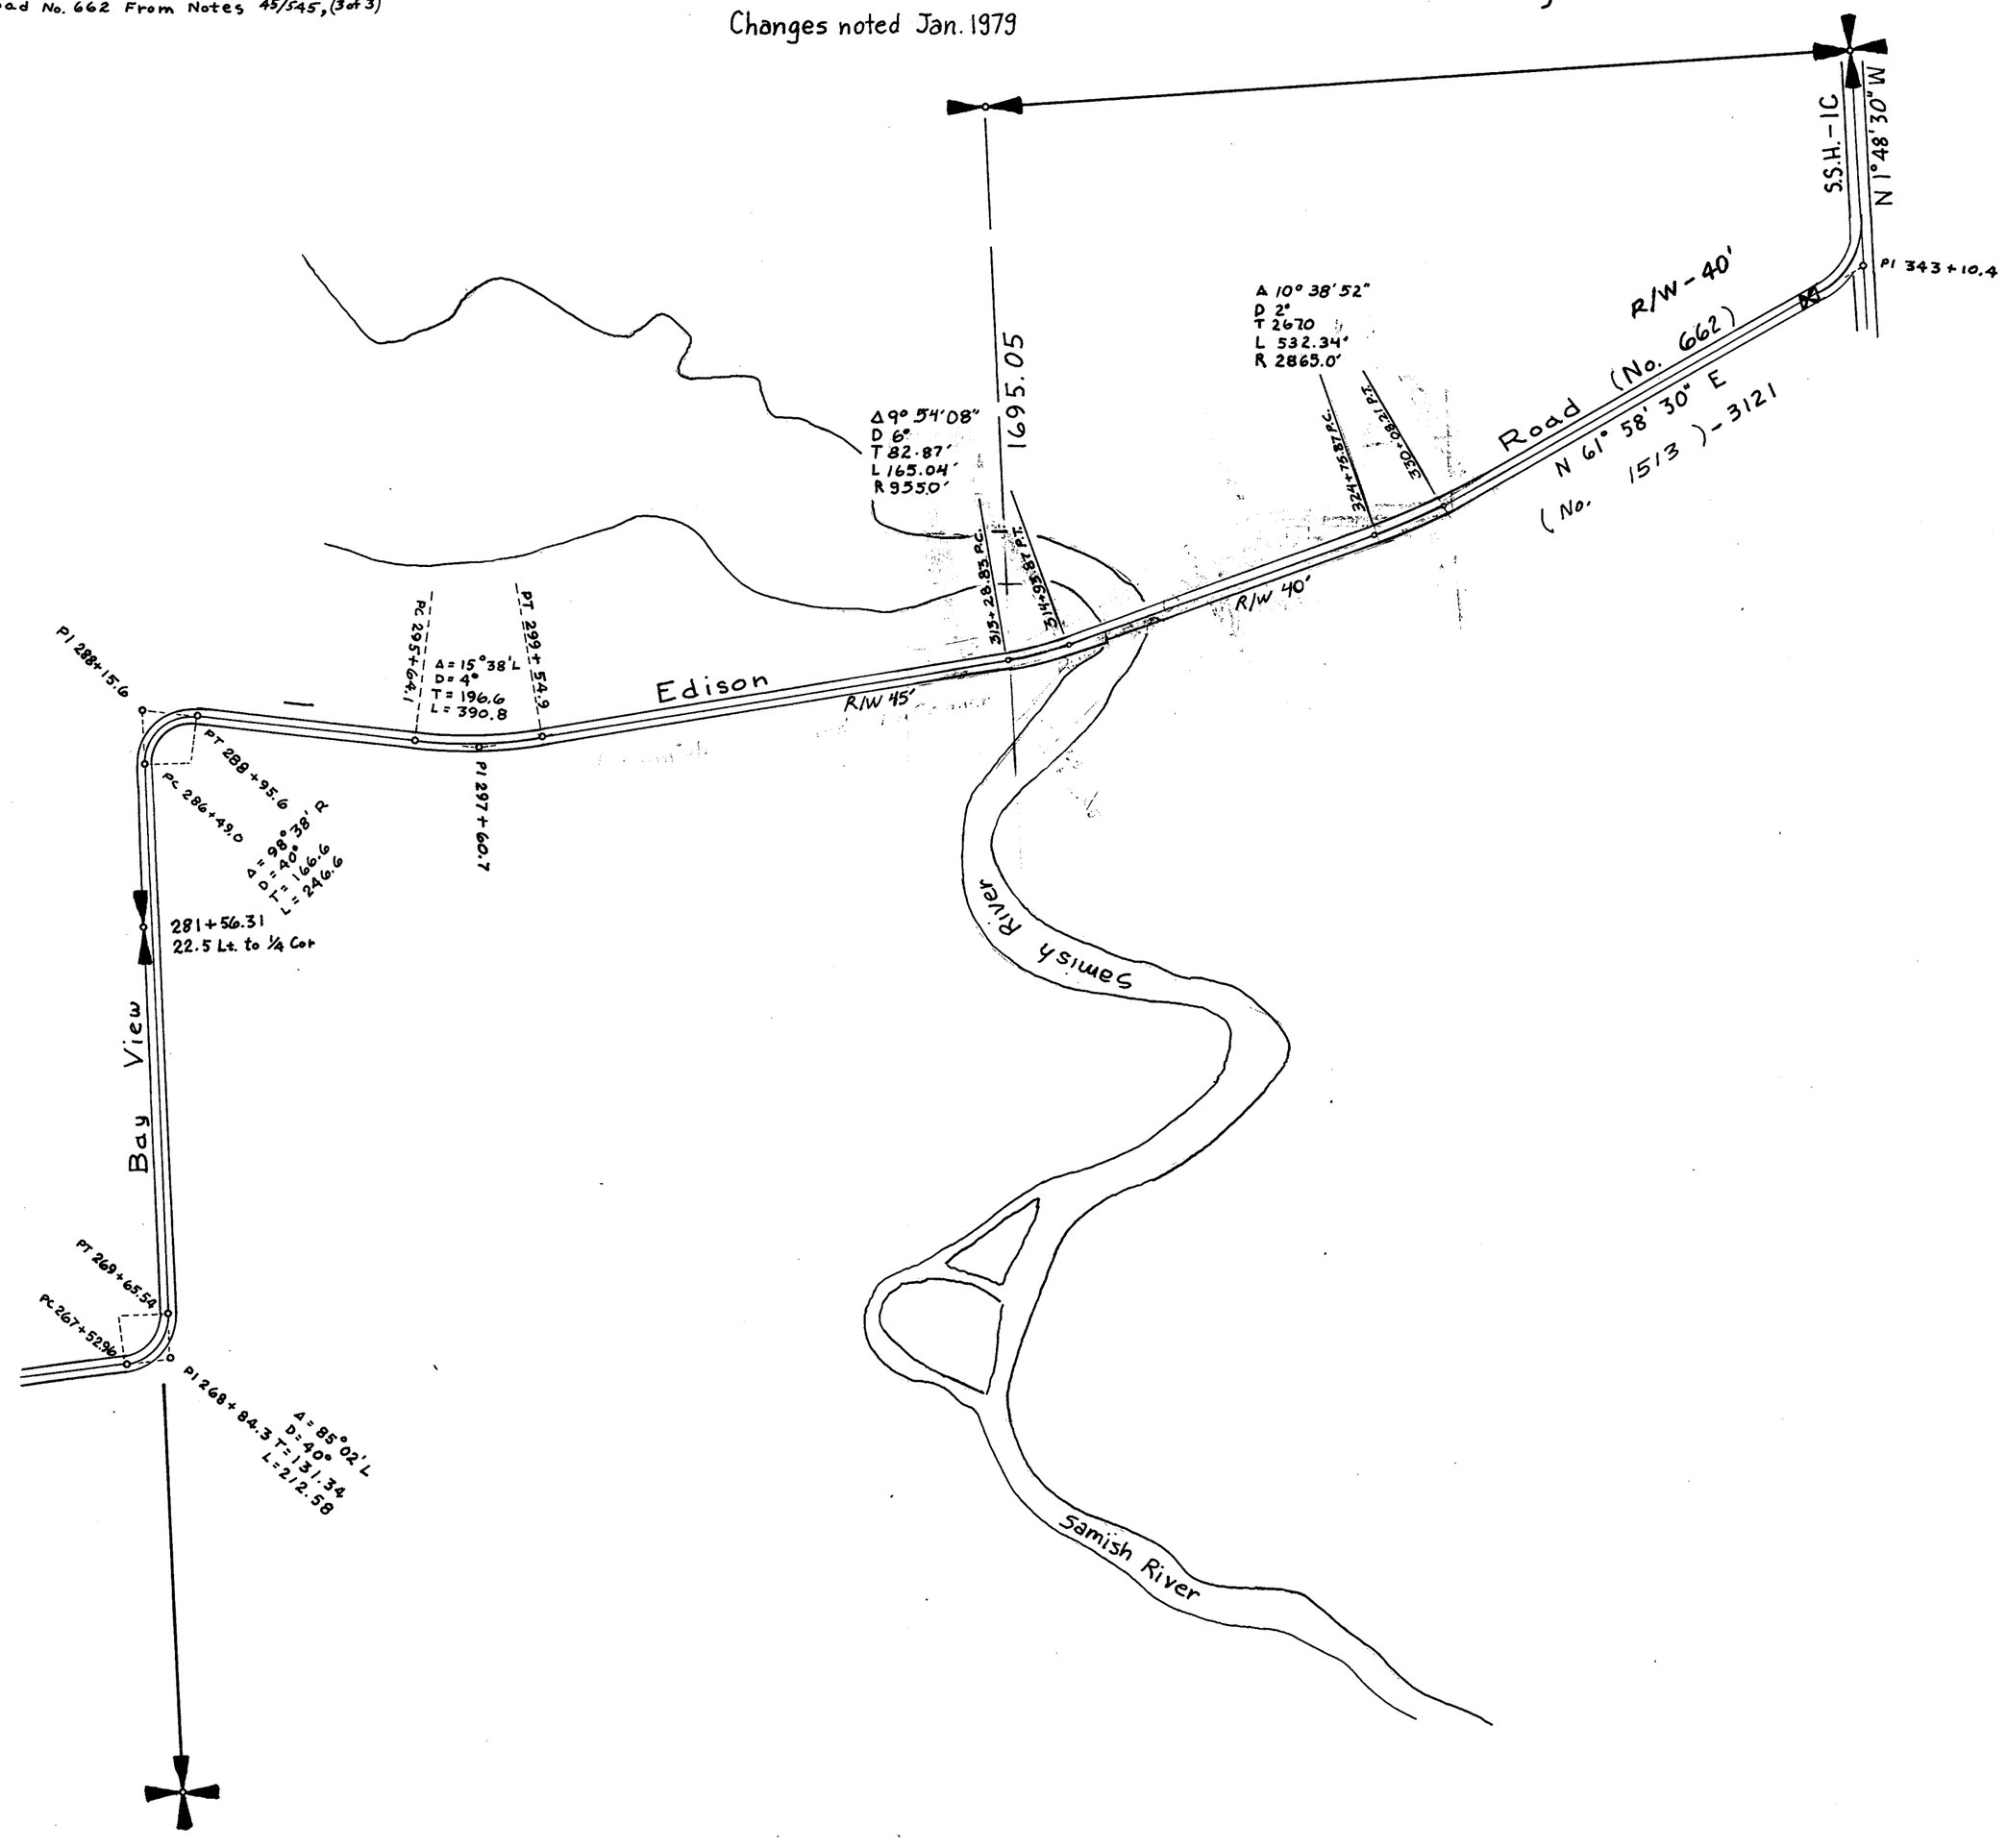

SECTION 6
TOWNSHIP 35 NORTH, RANGE 3 EAST, W. M.
SKAGIT COUNTY, WASH.

SCALE, 1 INCH--400 FEET
Road No. 662 From Notes 45/545, (3 of 3)

DATE June, 1959 Frank Gilkey COUNTY ENGINEER

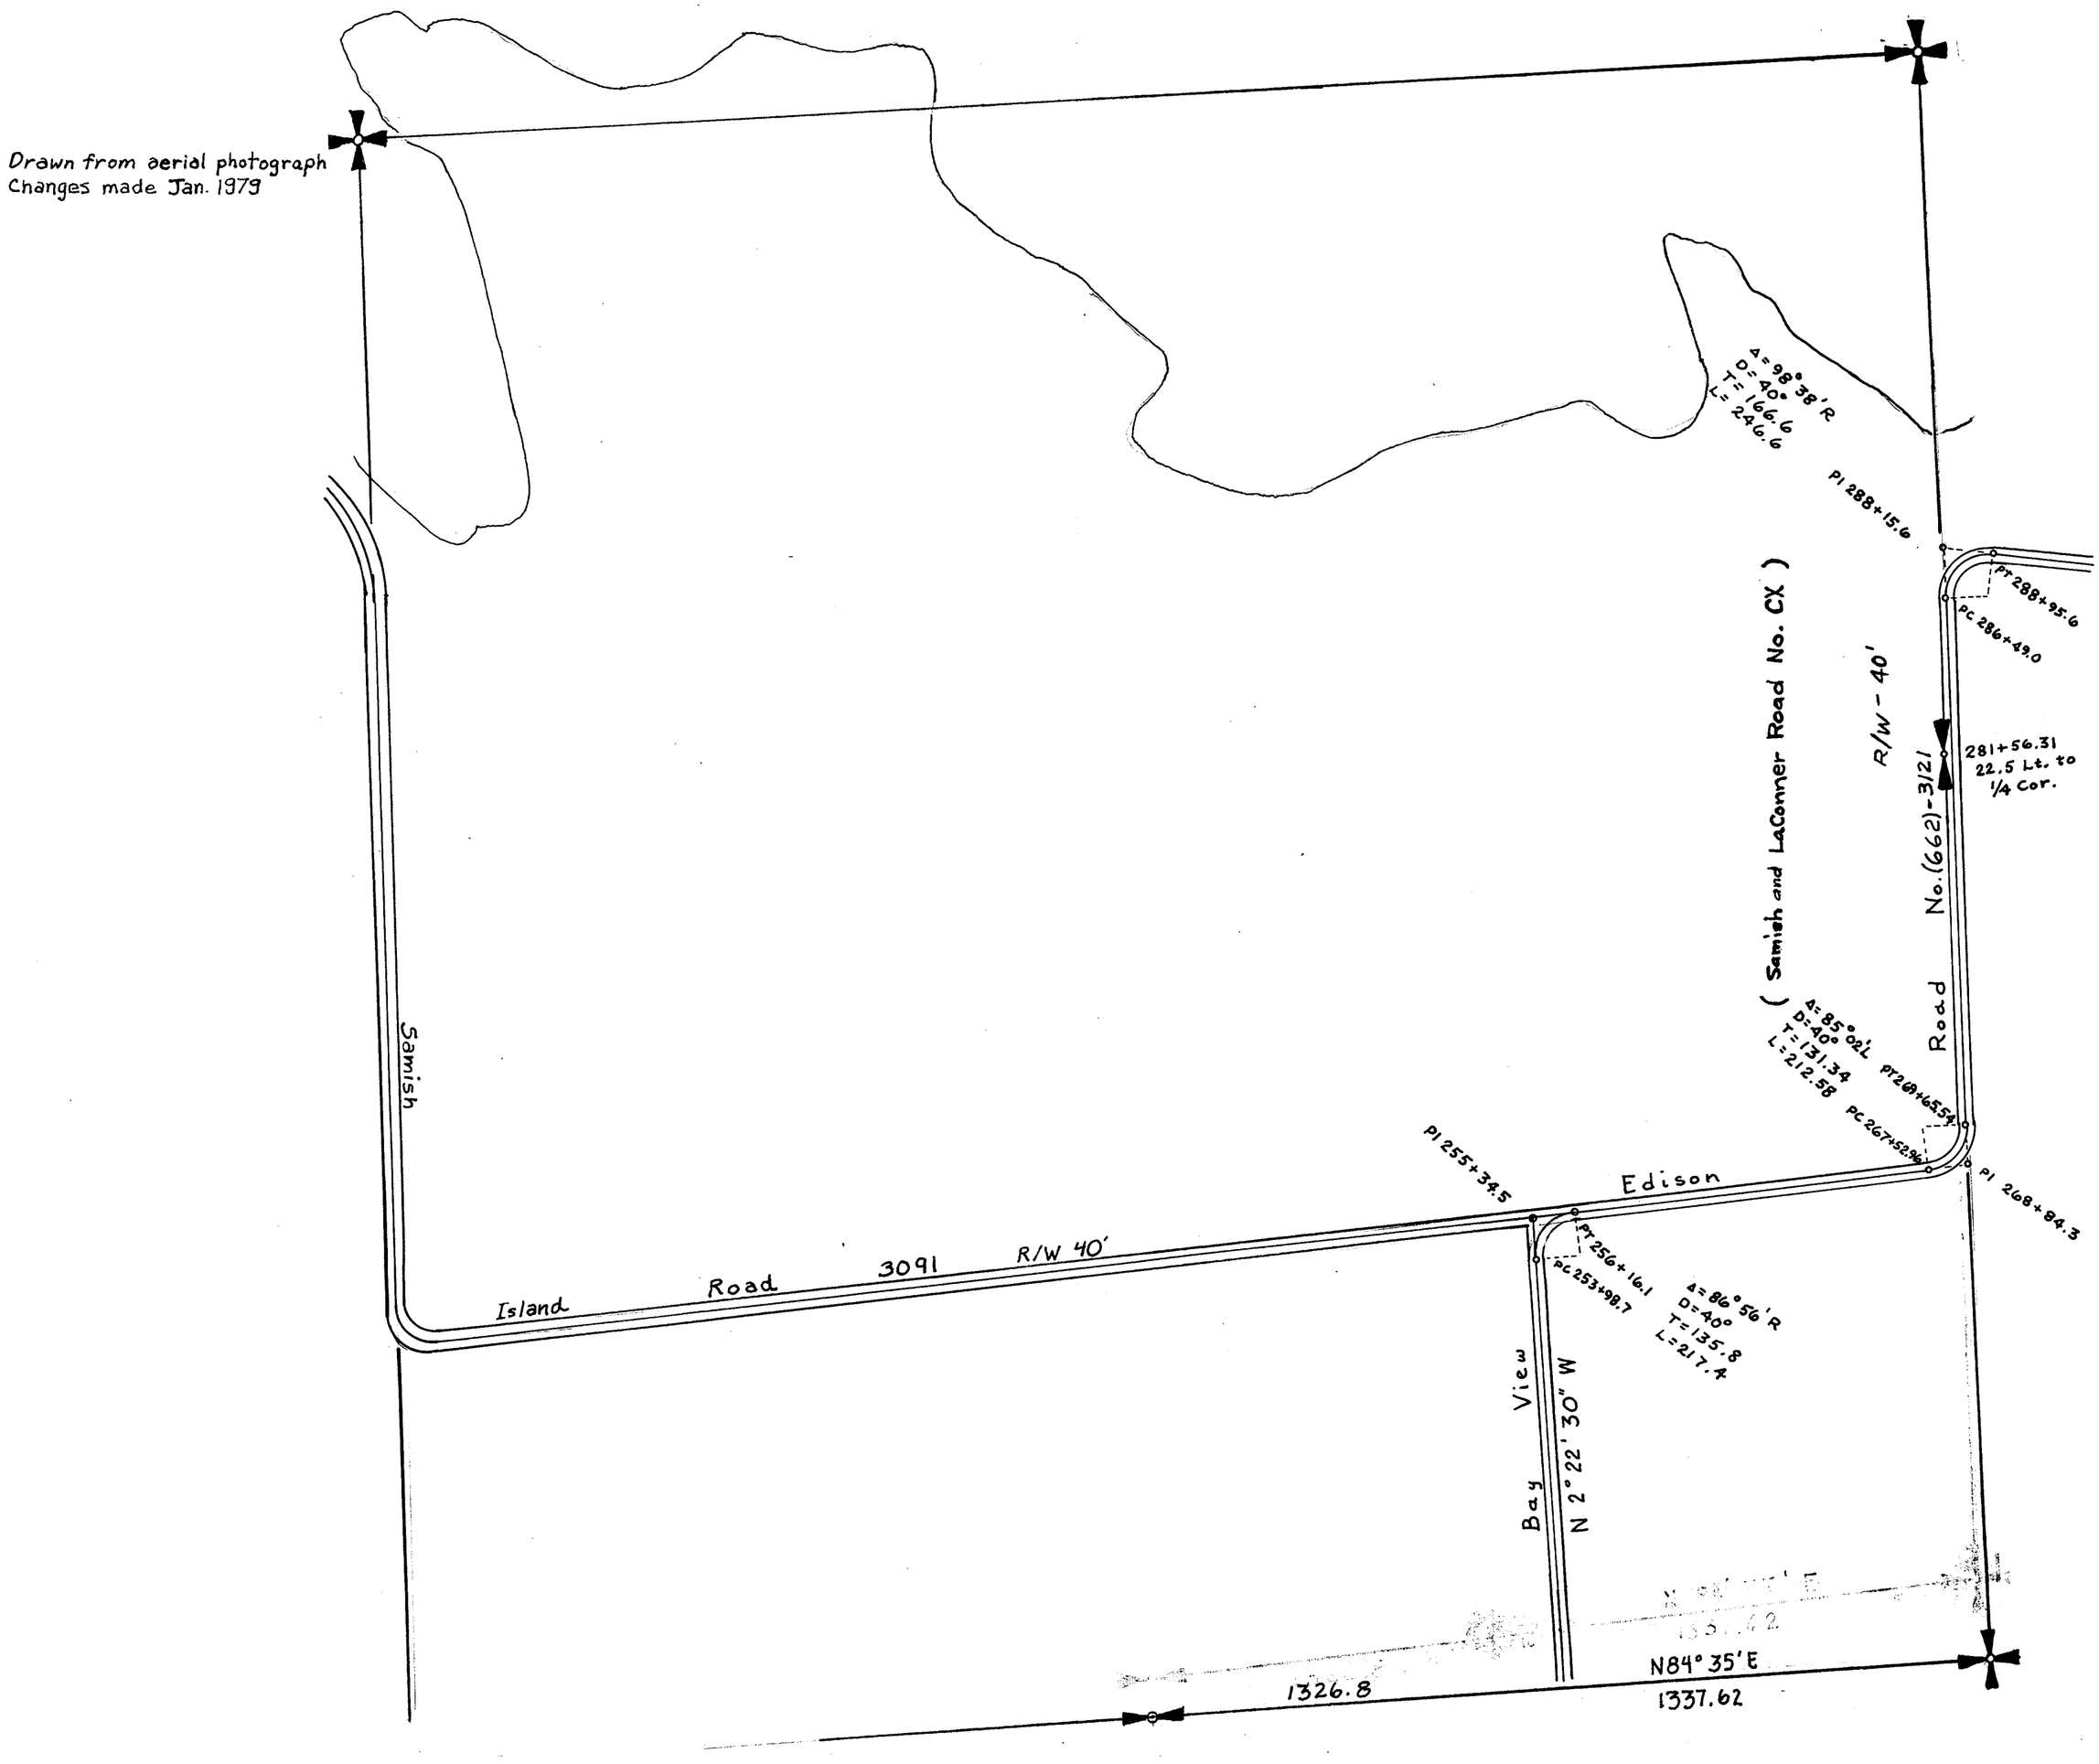

SECTION 7


TOWNSHIP 35 NORTH, RANGE 3 EAST, W. M.

SKAGIT COUNTY, WASH.

SCALE, 1 INCH--400 FEET
Road No. 662 From Notes 45/545 (30f3)

Changes made from aerial photograph Jan. 1979

DATE June, 1959 Frank Gilkey COUNTY ENGINEER

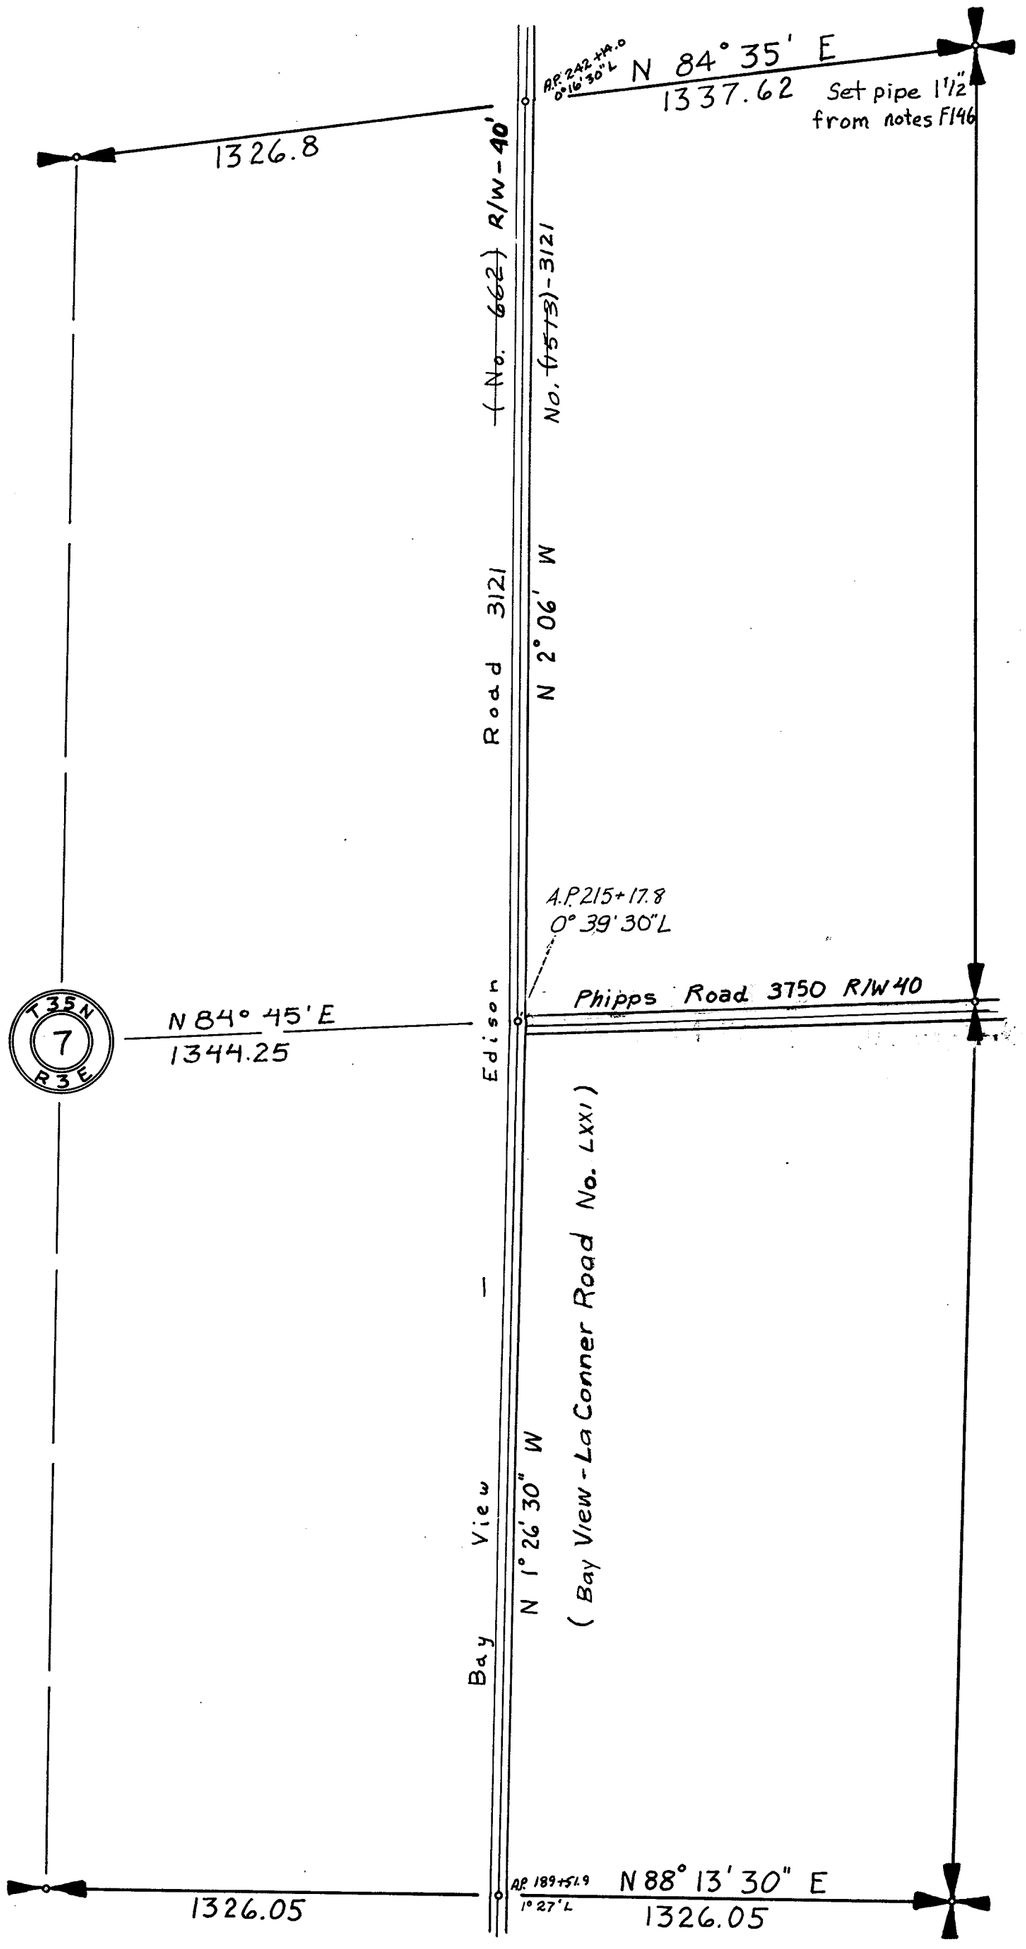


SECTION 8

TOWNSHIP 35 NORTH, RANGE 3 EAST, W. M.
SKAGIT COUNTY, WASH.

SCALE, 1 INCH–400 FEET

Robt. E.L. Knapp 1930 COUNTY ENGINEER

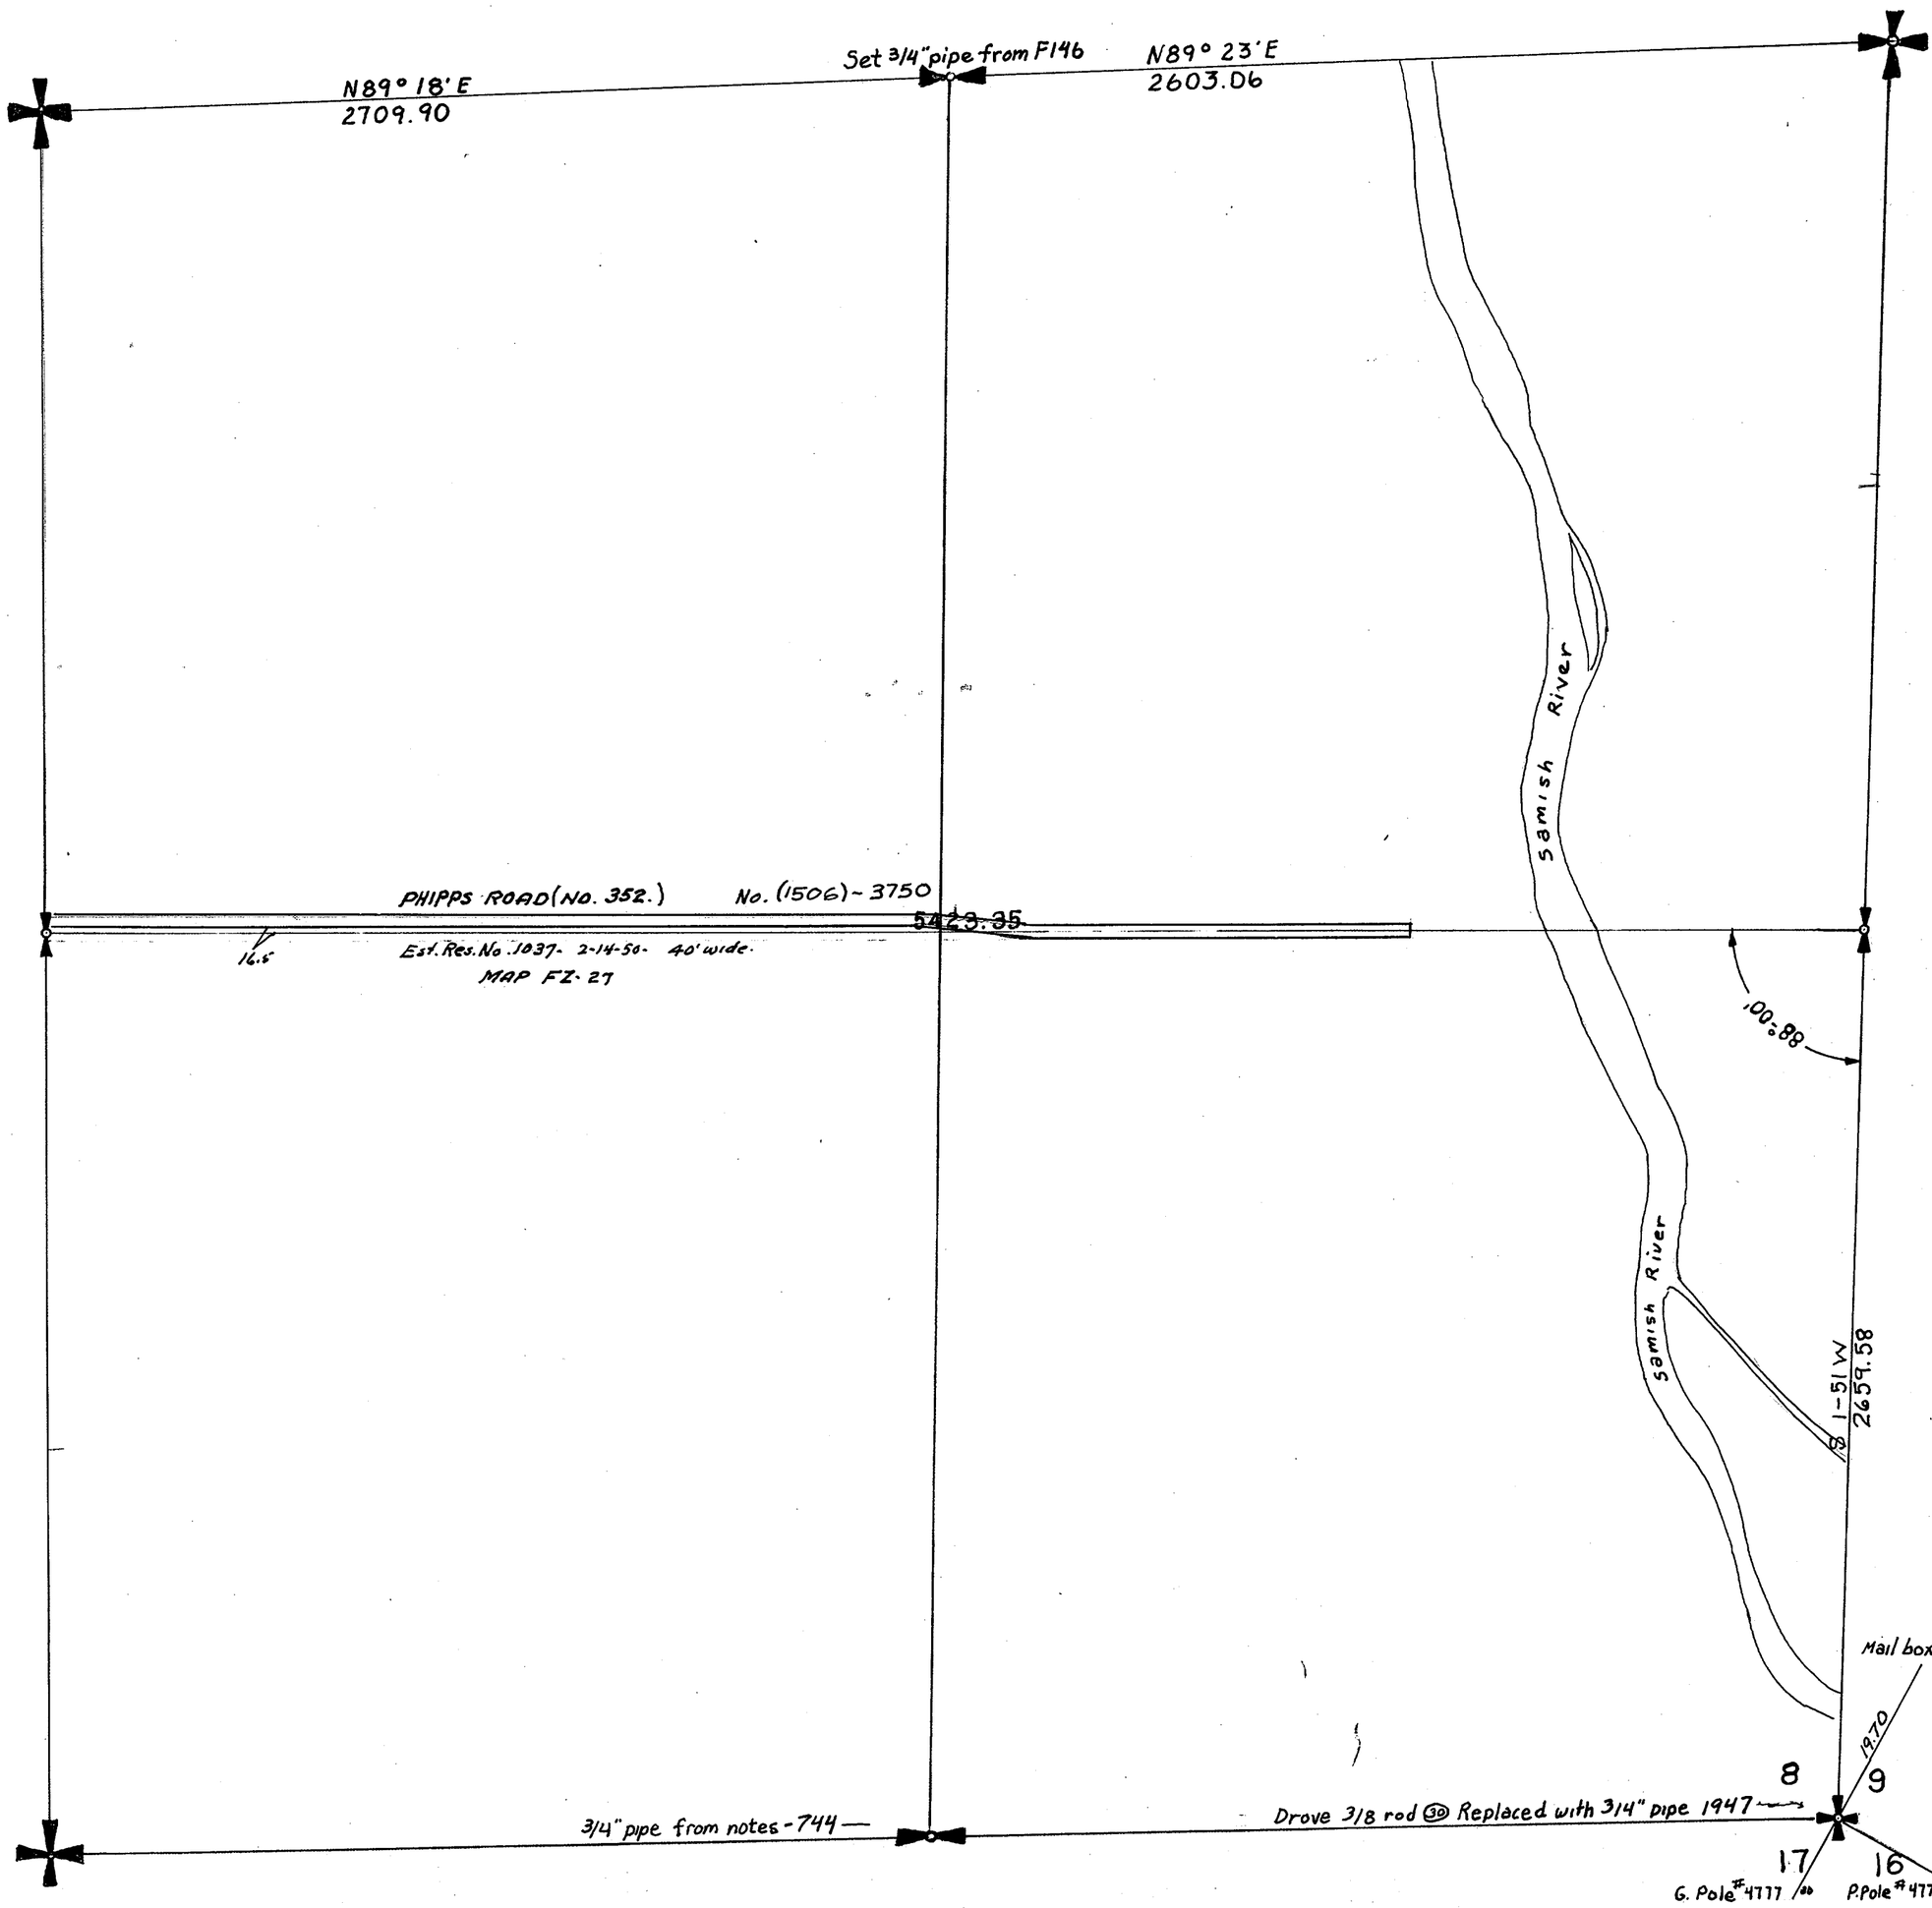

SECTION 9


TOWNSHIP 35 NORTH, RANGE 3 EAST, W. M.

SKAGIT COUNTY, WASH.

SCALE, 1 INCH--400 FEET

DATE Aug. 16, 1963

COUNTY ENGINEER

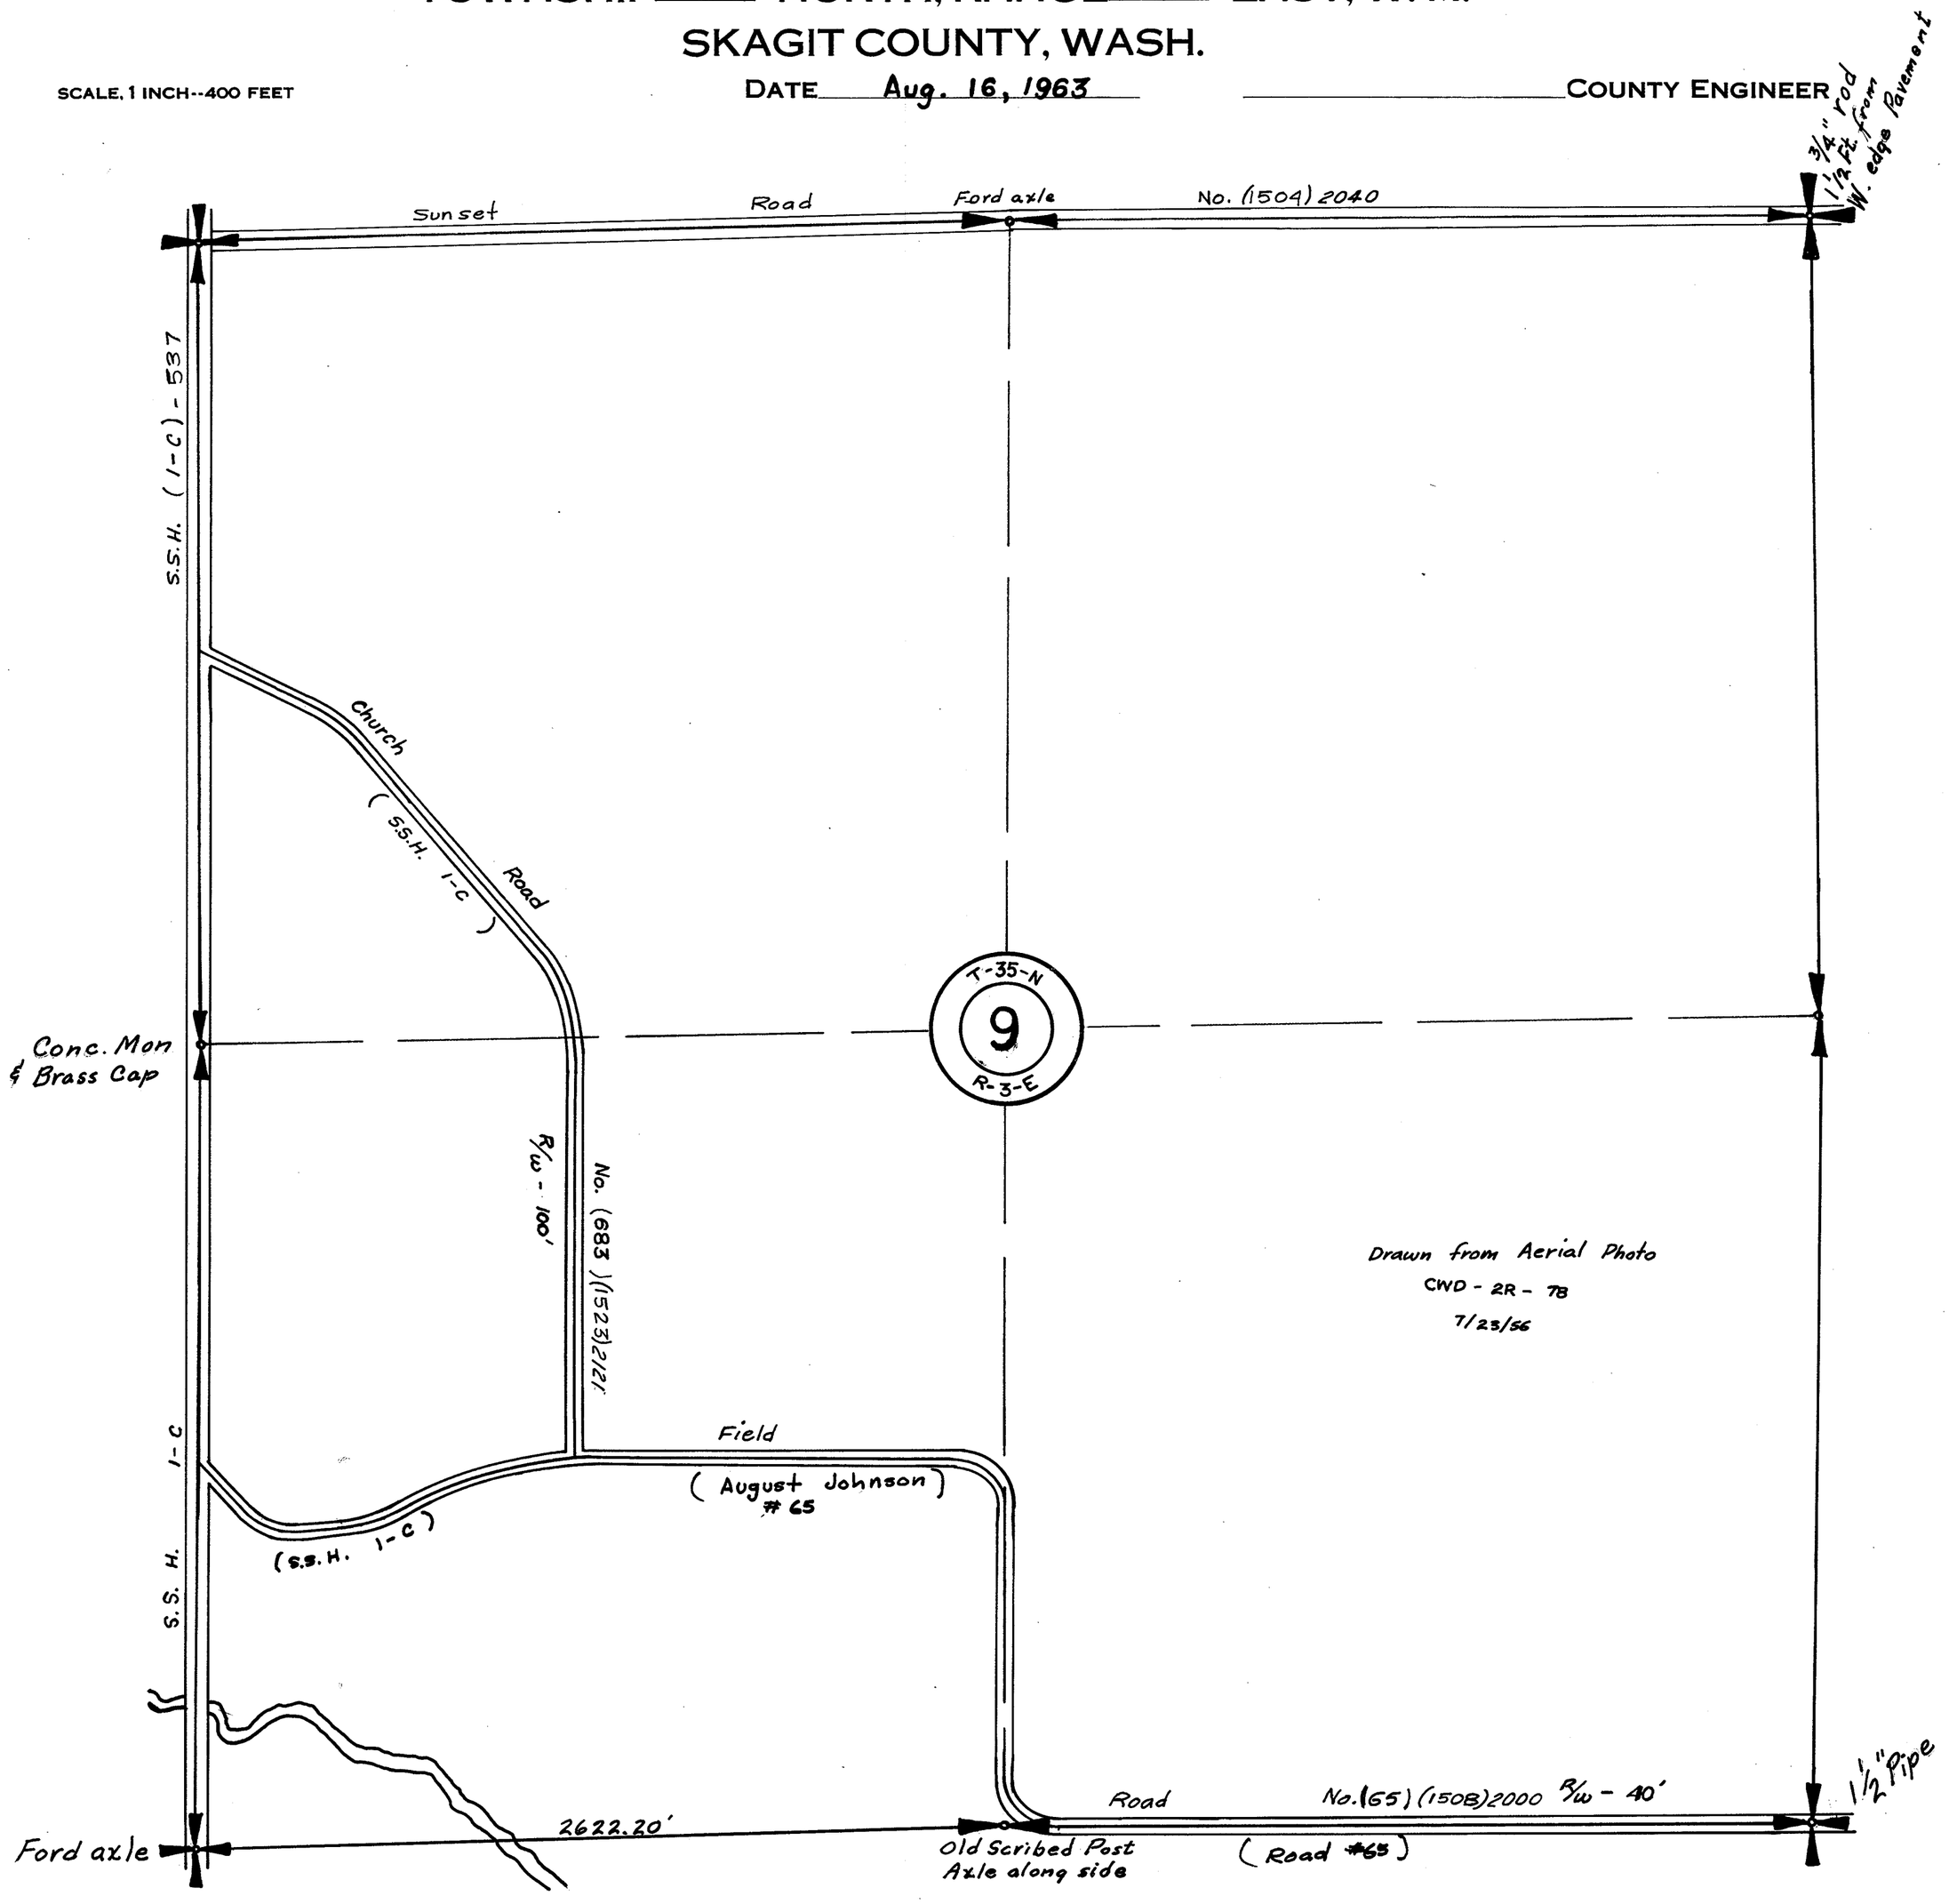

SECTION 9


TOWNSHIP 35 NORTH, RANGE 3 EAST, W. M.

SKAGIT COUNTY, WASH.

SCALE, 1 INCH--400 FEET


Frank Gilkey COUNTY ENGINEER

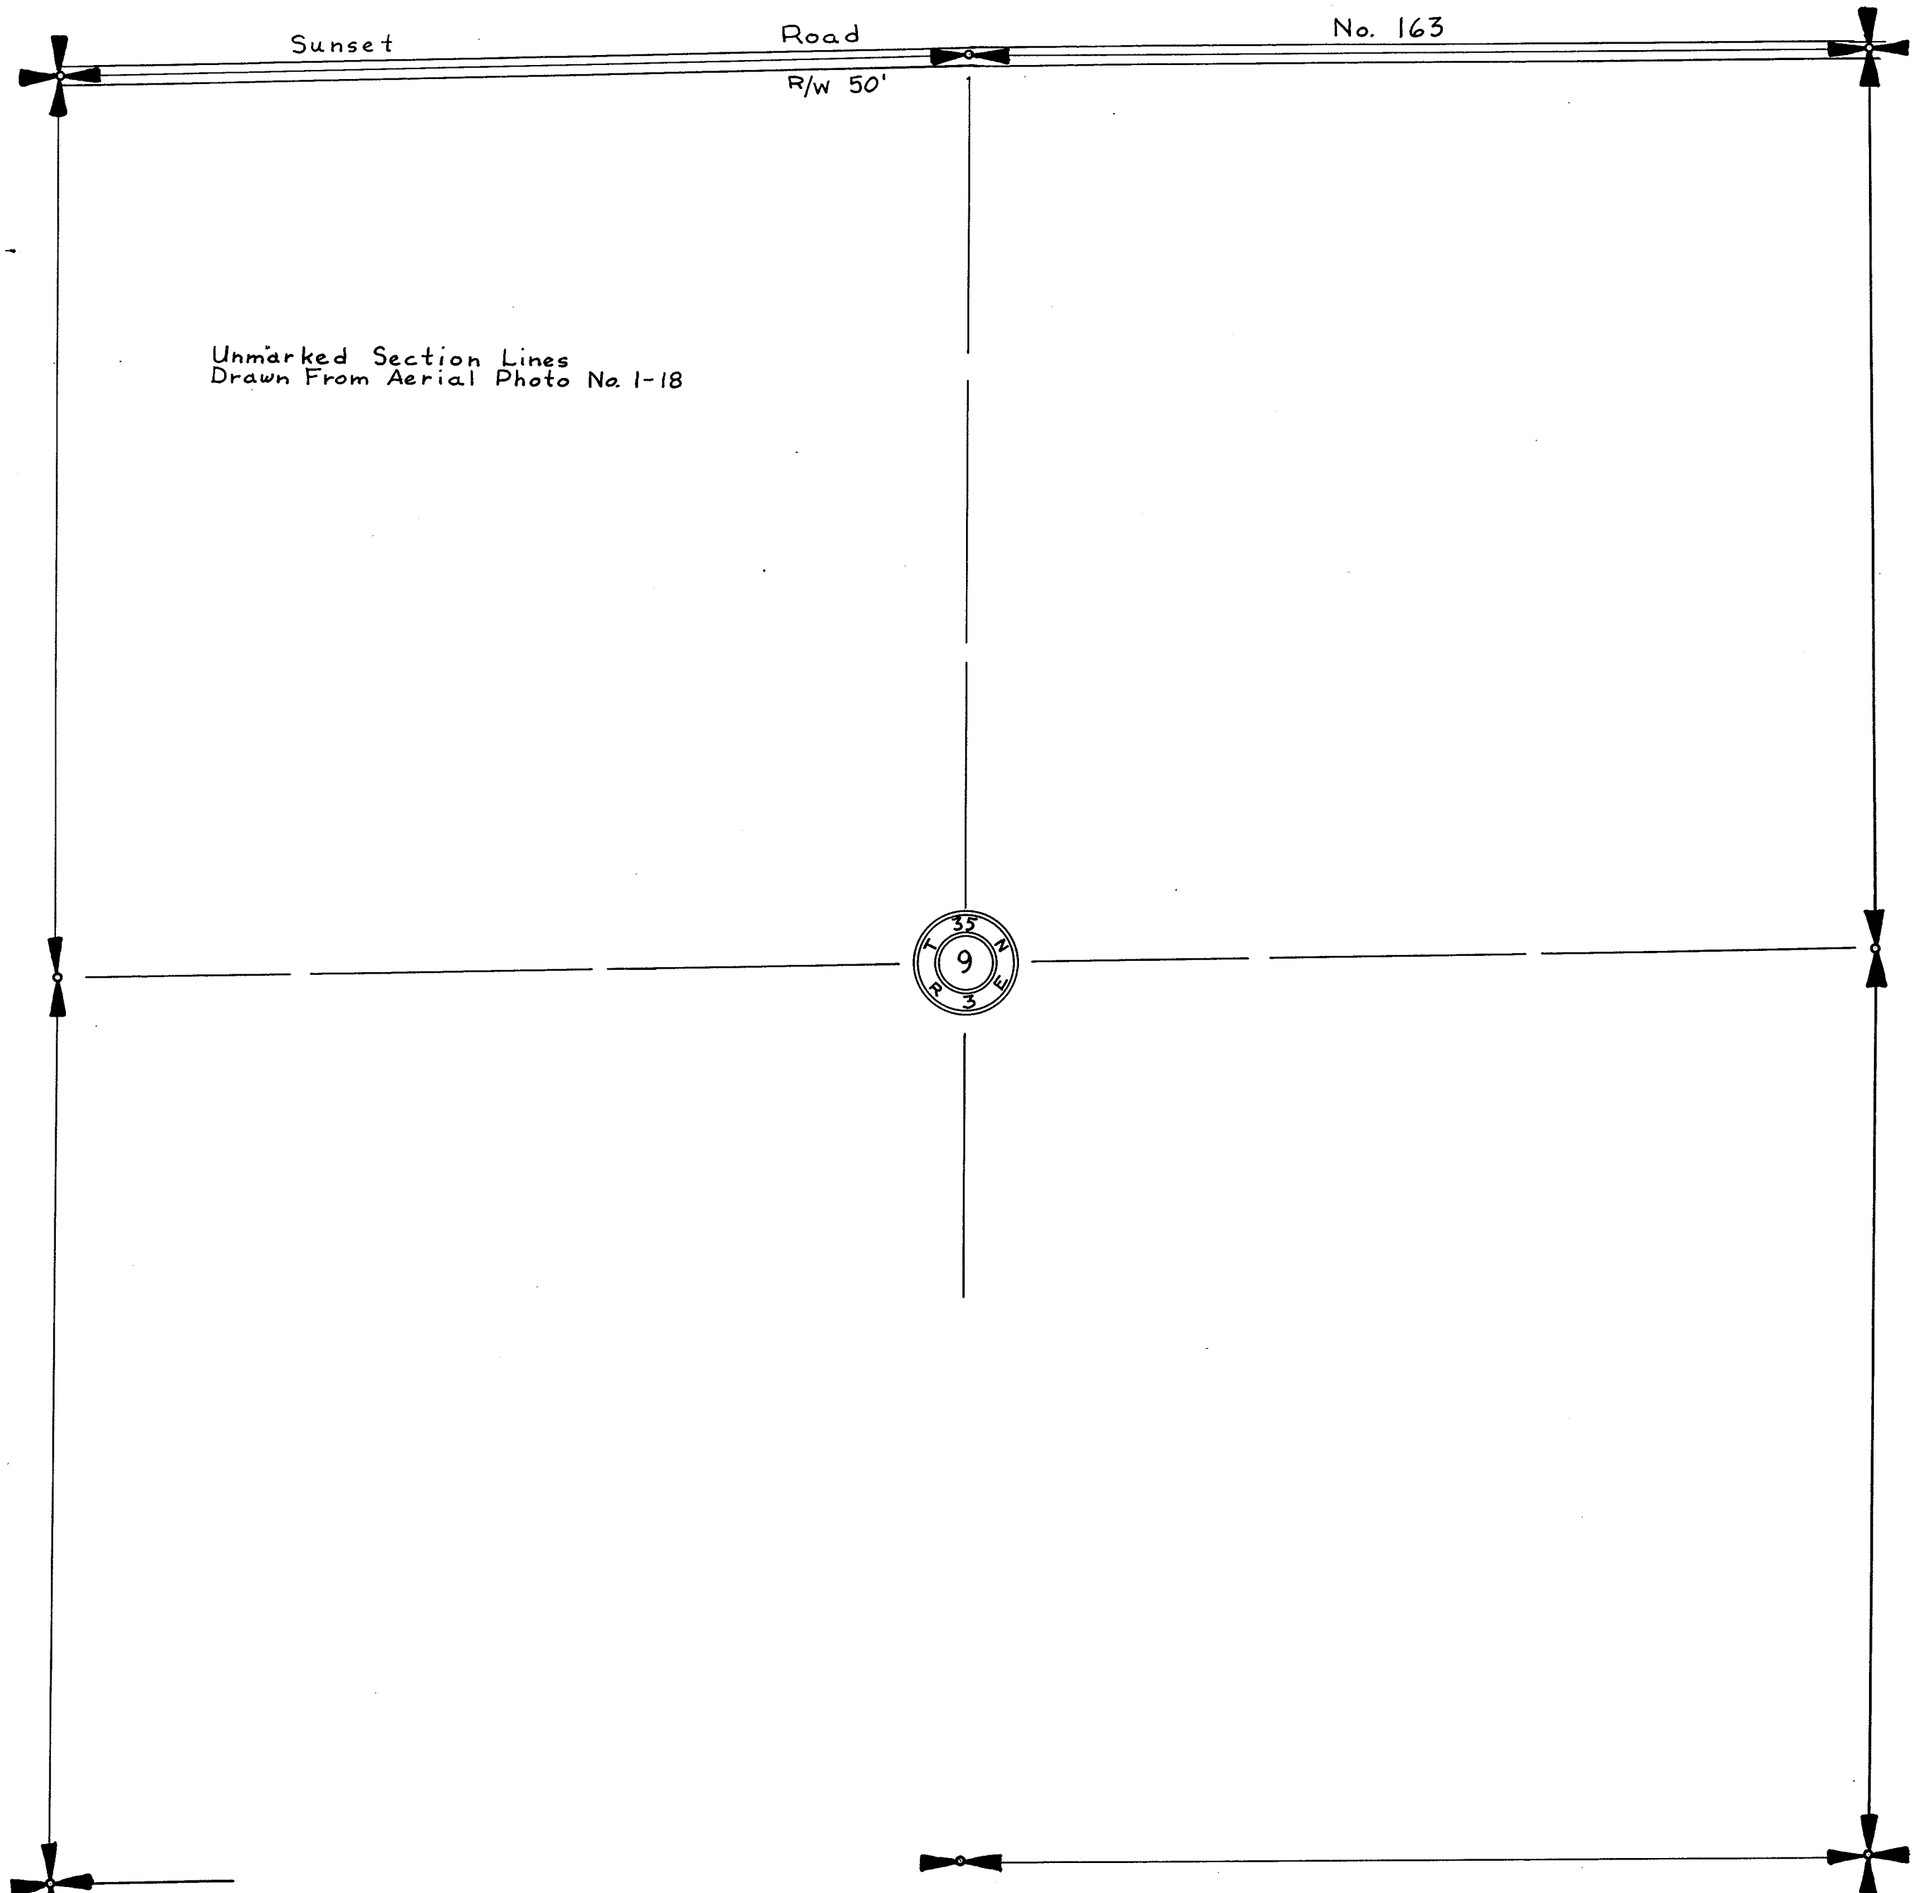


SECTION 10

TOWNSHIP 35 NORTH, RANGE 3 EAST, W. M.
SKAGIT COUNTY, WASH.

SCALE, 1 INCH–400 FEET

A. L. STRONG COUNTY ENGINEER

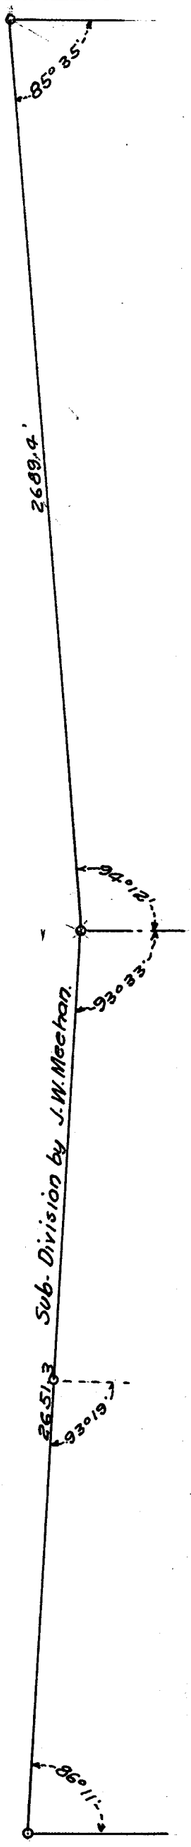


SECTION 10
TOWNSHIP 35 NORTH, RANGE 3 EAST, W. M.
SKAGIT COUNTY, WASH.

SCALE, 1 INCH--400 FEET

DATE July, 1959


Frank Gilkey COUNTY ENGINEER

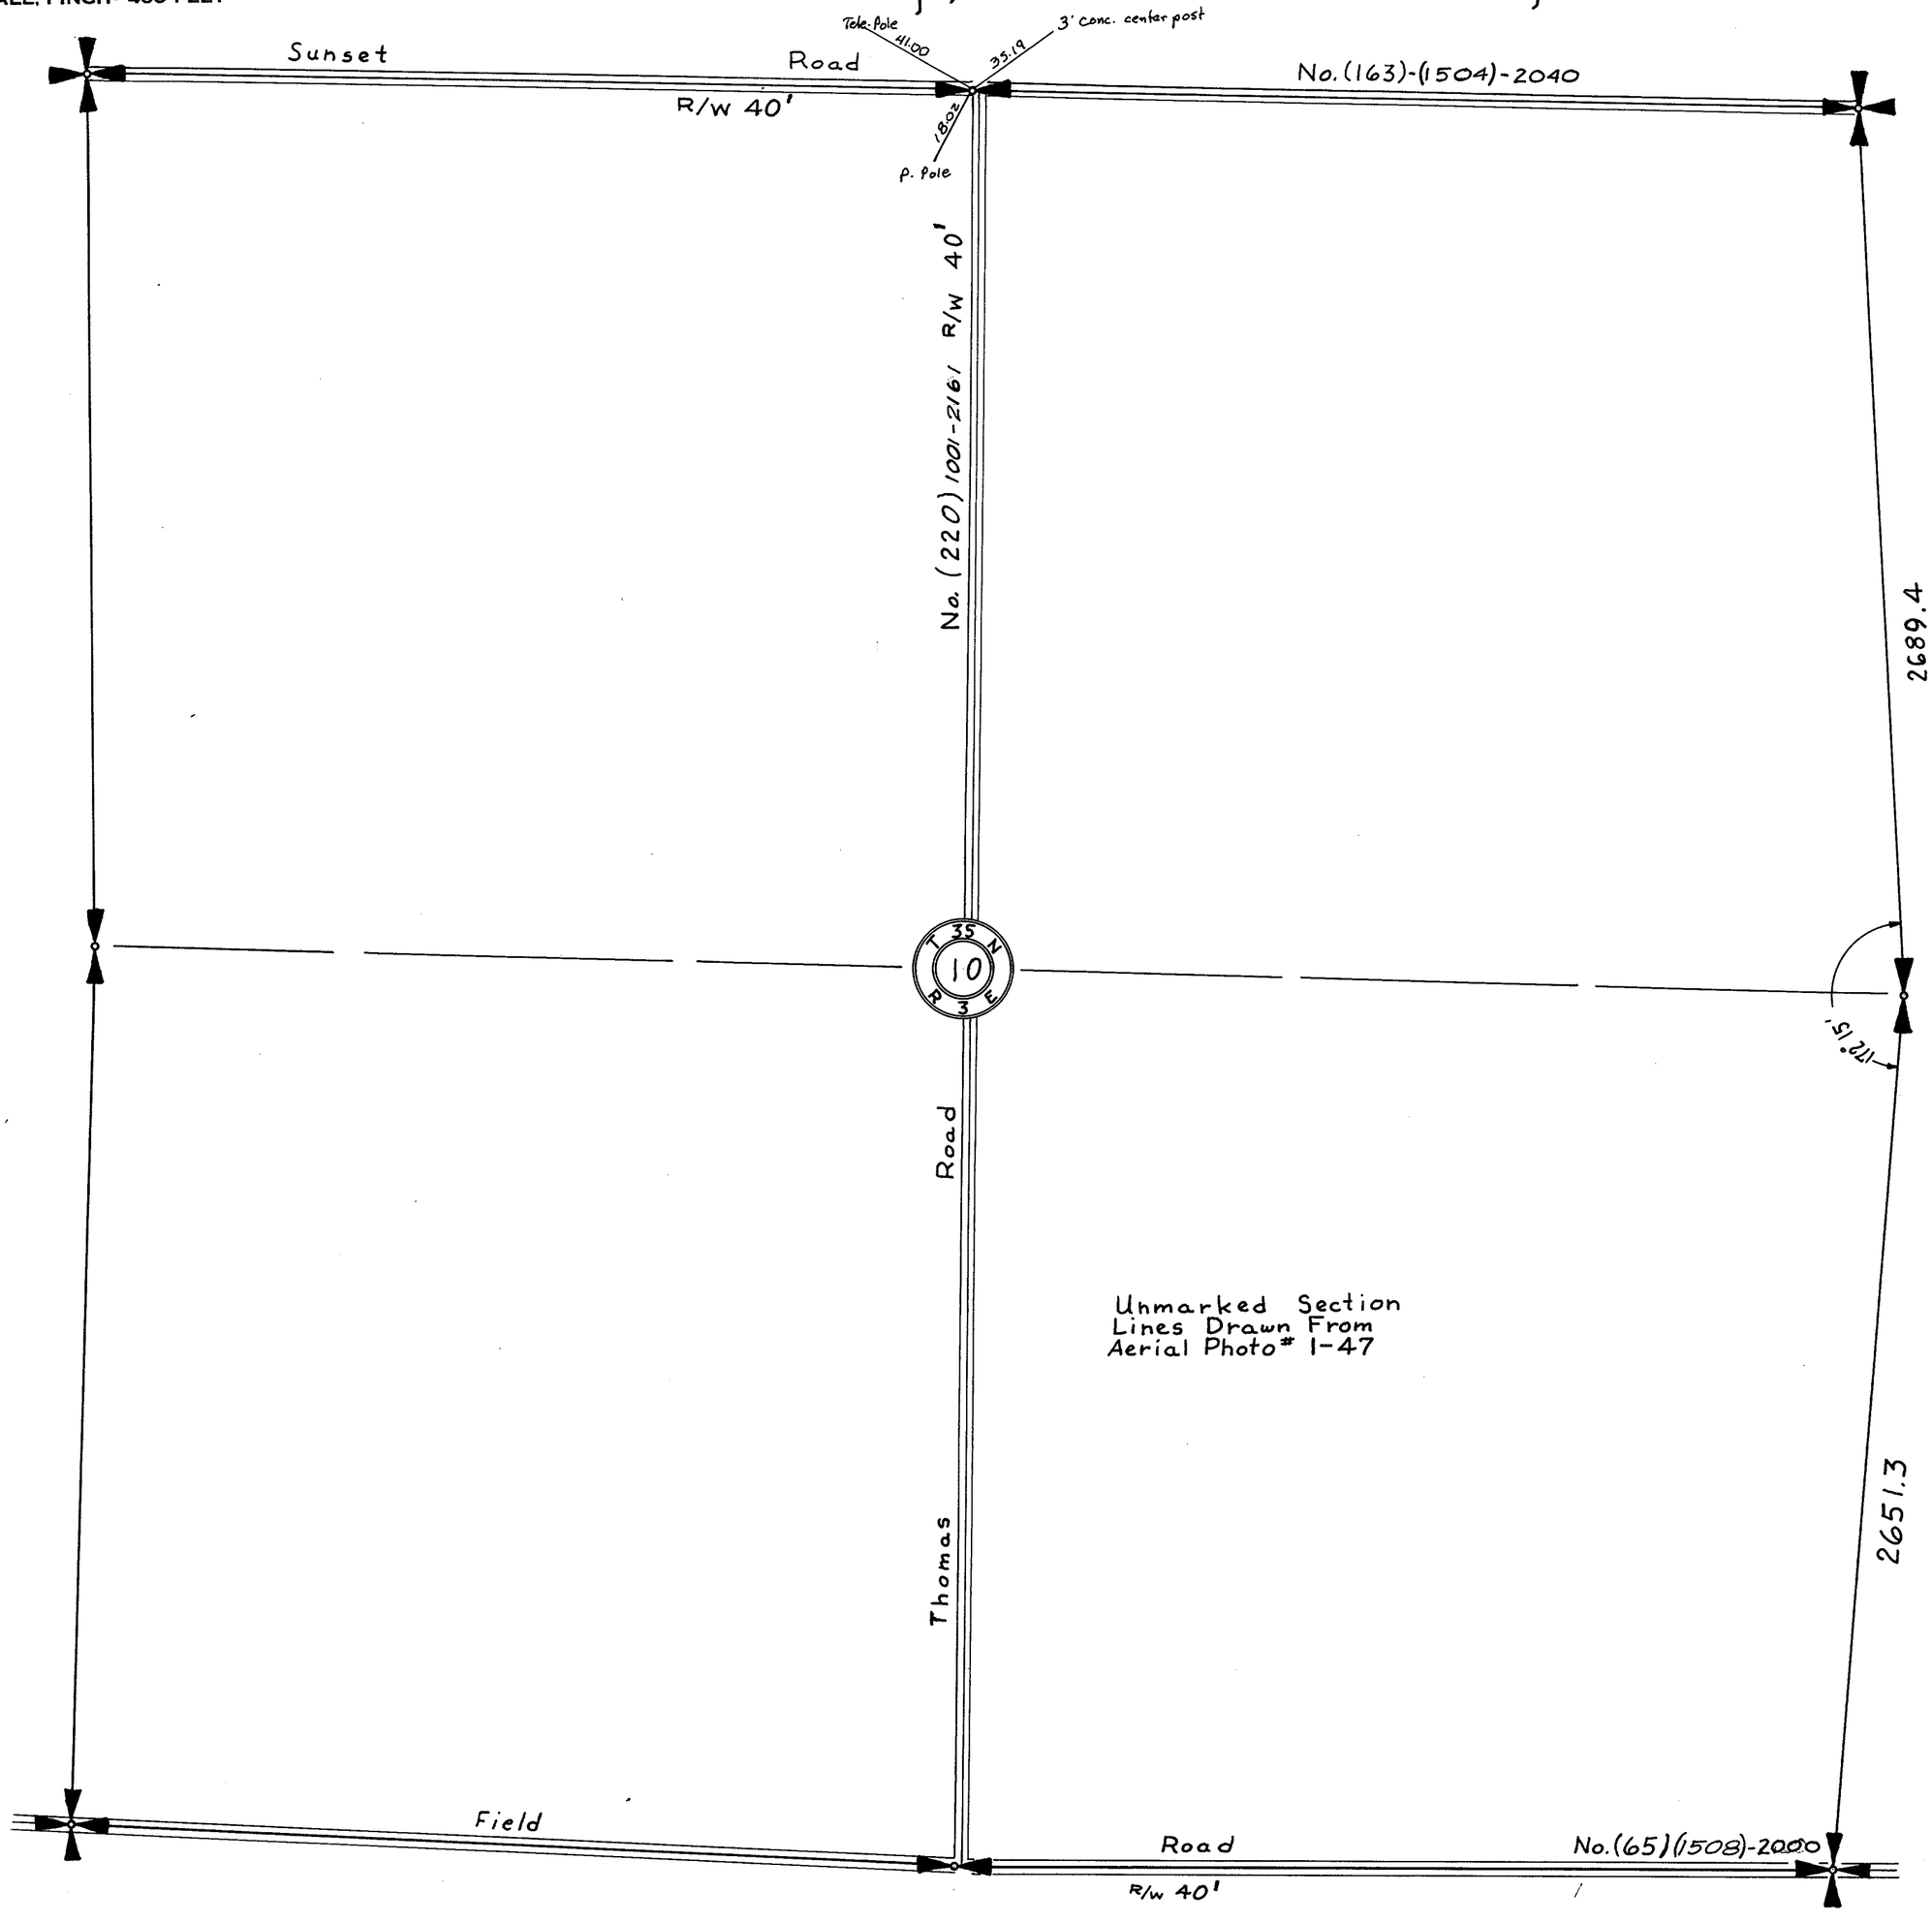

SECTION 11
TOWNSHIP 35 NORTH, RANGE 3 EAST, W. M.
SKAGIT COUNTY, WASH.

DATE July, 1959 — Frank Gilkey COUNTY ENGINEER

SCALE, 1 INCH--400 FEET
Road No. 95 From Notes 41/484
Road No. 533 From Notes 35/294
Subdivision By Meehan

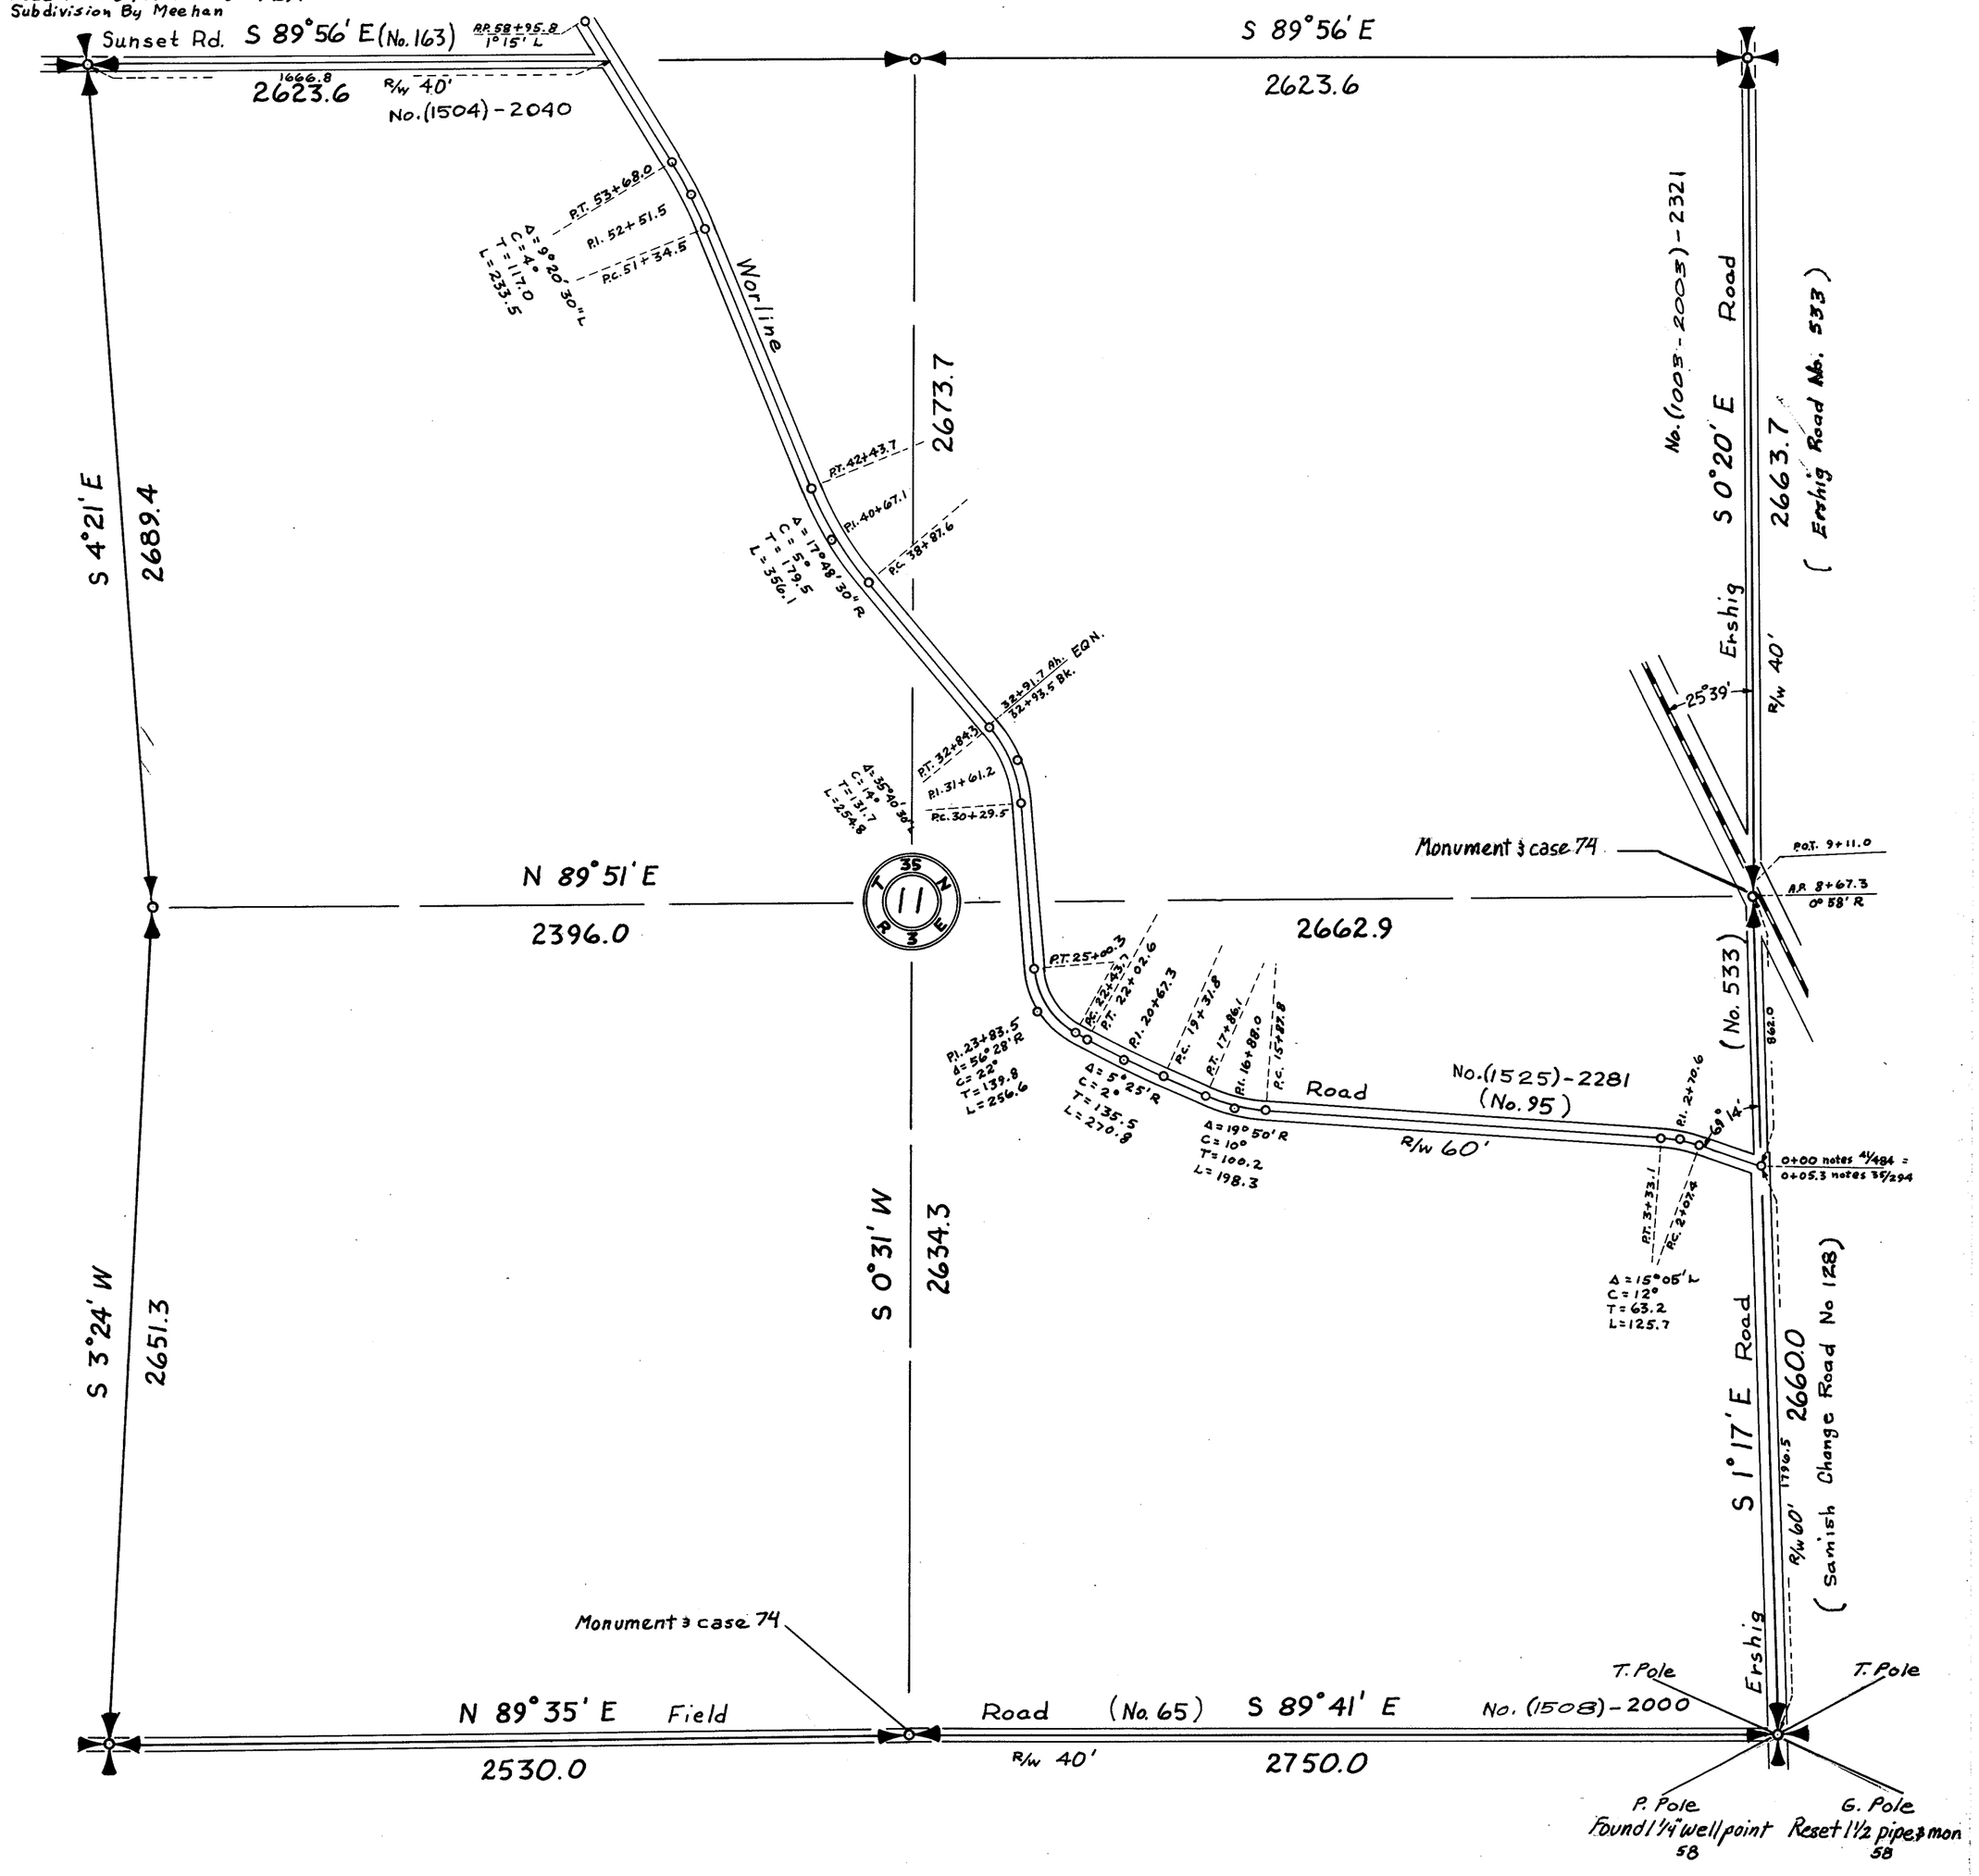


SECTION 11

TOWNSHIP 35 NORTH, RANGE 3 EAST, W. M.
SKAGIT COUNTY, WASH.

SCALE, 1 INCH=400 FEET

A.L. STRONG COUNTY ENGINEER

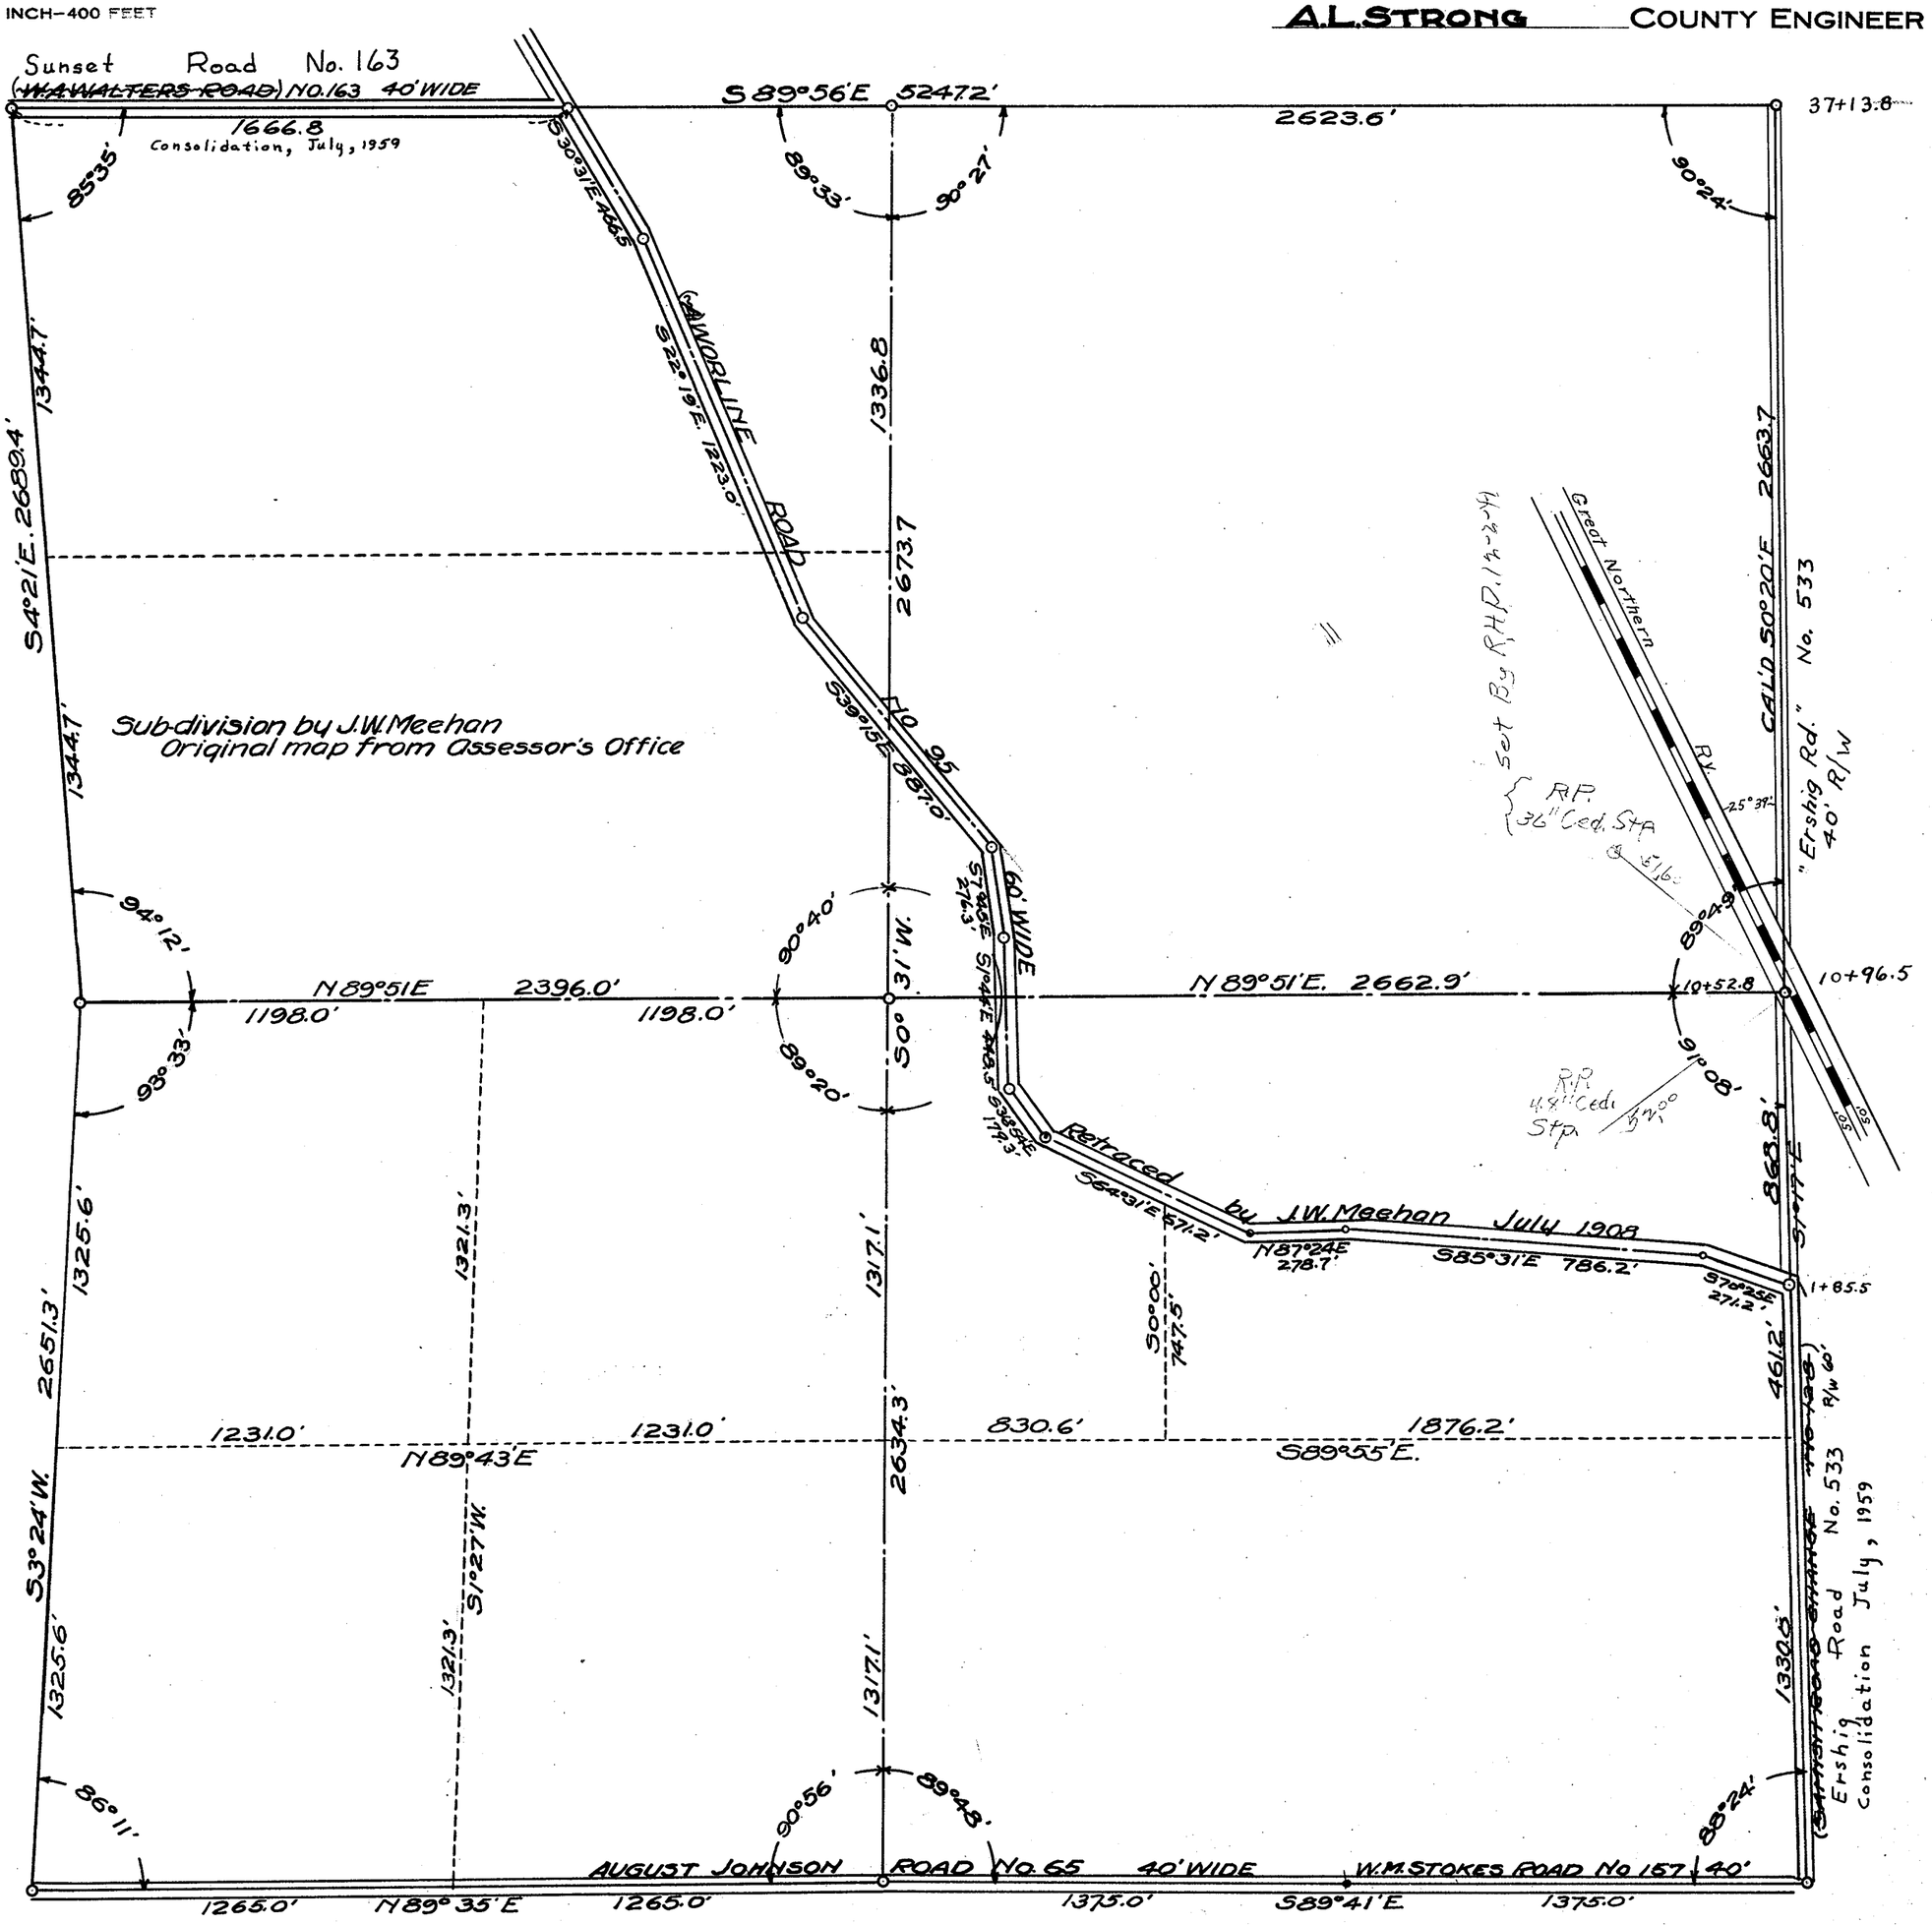

SKAGIT COUNTY

Monuments noted Jan. 1979

SEC. 12 TWP. 35 R. 3

P.Pole #13185 — 16.70 — Mon$ Case '74 — S88° 20'34" E — 2694.85 — S87° 05'34" E — 2647.50 — 3/4" Pipe

1347.42 — 1347.43 — Mon$ Case '74 — 1323.75 — 1323.75

42.82 — T.Pole #8 72/26 — N 43° 52'34" W — 1909.23

N46° 39'09" E — 1850.40

2659.60 — 1329.80 — 2667.87 — 1333.75 — 1337.50 — 2653.44 — 1326.72 — 2632.28

S88° 12' 01" E — 2698.02 — S87° 34'51" E — 2679.48

1348.98 — 1349.04 — 2675.0' — 1339.69 — 1339.79

N 1° 07' E — 1329.80 — N 1° 04'36" E — 1334.12 — 1337.50 — N 0° 18'28" E — 1326.72 — N 0° 24'21" W

3' Cedar Stp. 41 — 53.60 — 5' Cedar Stp. 41 — 53.00

T. Pole 41 74 — 40.15

R.R. Tie gate post — 29.72 — Mon. $ case 74 — 32.31 — Punch mark on R.R. crossing post 2' up post

S88° 03' 27" E — 2701.20 — 1½" Pipe 61 — 2711.46 — 1½ Pipe 61

1355.73 — Placed 1" pipe 61 — 1355.73

55.72 — 20" Cedar 61 — 10.50 — 4' Cedar Stp. 61

17.88 — 6' Cedar Snag 61 — 14.45 — 7' Cedar Stp 61

Notes: 294
484
995
Hardshell: A19/8

N 1° 00'37" E — 2685.70

10" Cedar 66 — 24.05

T. Pole — T. Pole

Found 1¼" well point 58 1½ pipe and monument

G. Pole — P. Pole


15.04 — 16" Alder 66 — 17.60 — 24" Fir 66

SECTION 12

TOWNSHIP 35 NORTH. RANGE 3 EAST. W. M.
SKAGIT COUNTY. WASH.

SCALE, 1 INCH—400 FEET

A. L. STRONG COUNTY ENGINEER

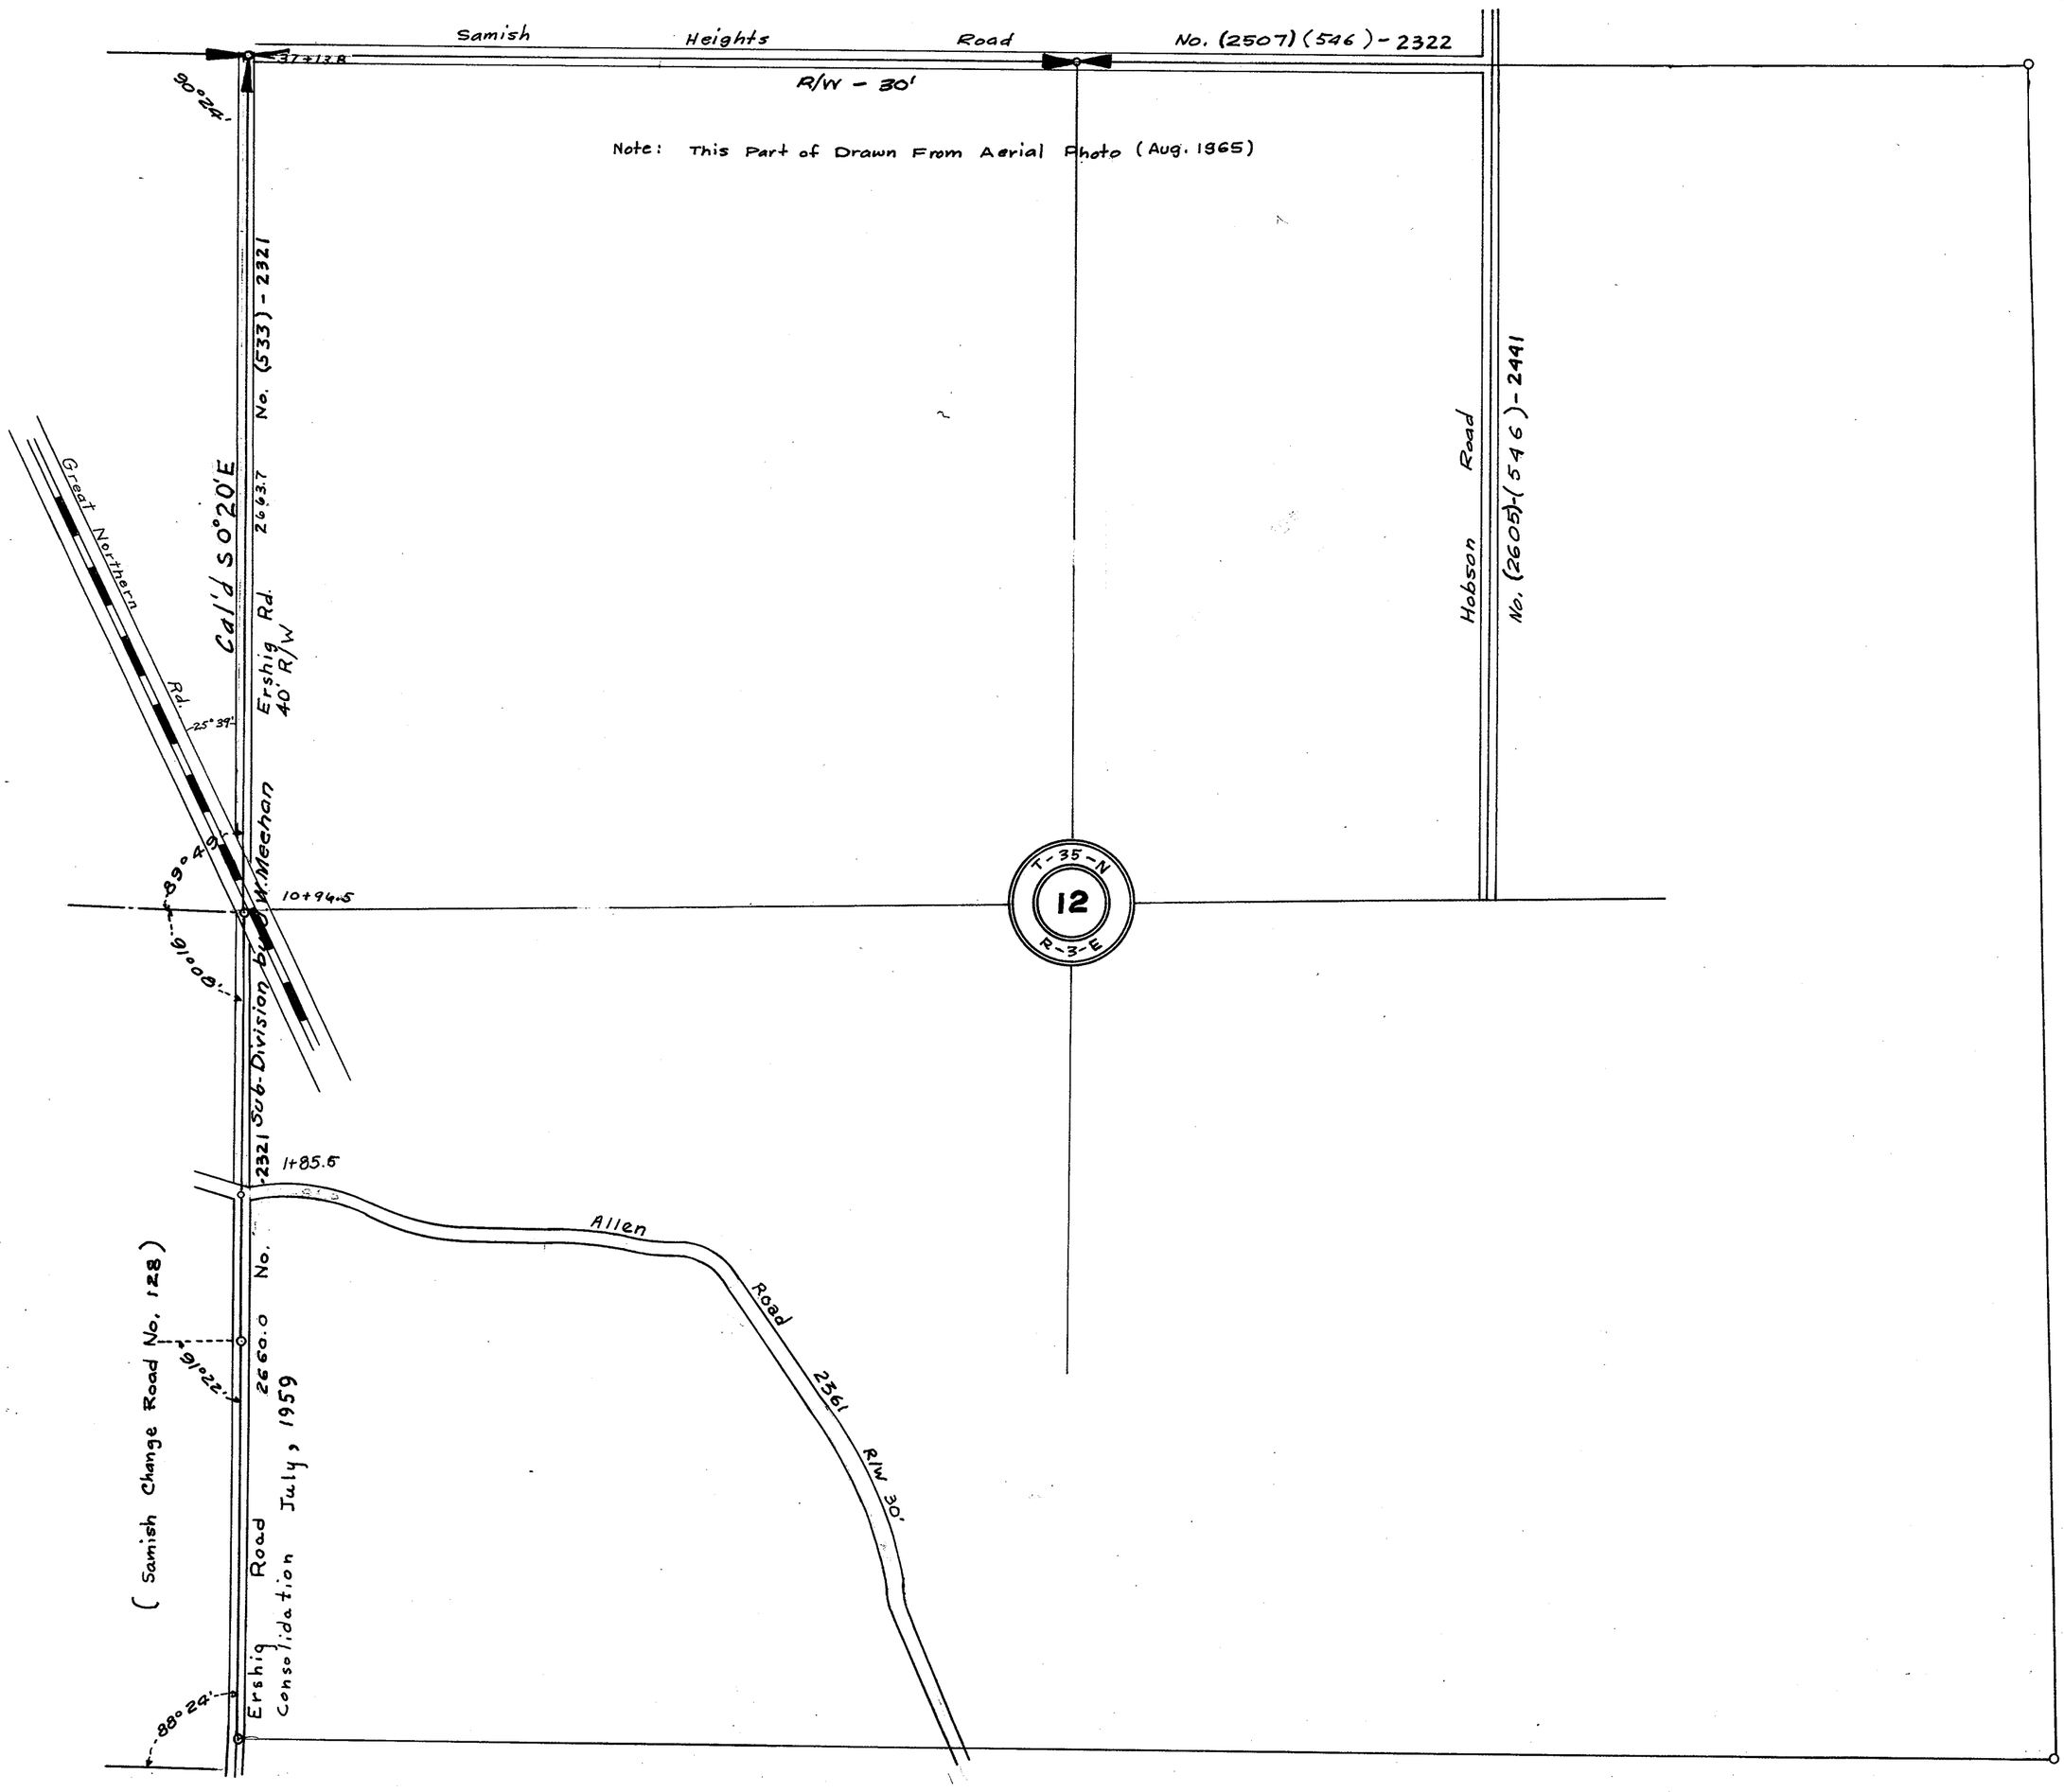

SECTION 13

TOWNSHIP 35 NORTH, RANGE 3 EAST, W. M.

SKAGIT COUNTY, WASH.

SCALE, 1 INCH = 400 FEET

COUNTY ENGINEER

T. Pole SB

T. Pole SB 57.30 28.97 Reset 1½ pipe & mon. 1¼" Well point found

25.10 19.20 G. Pole

P. Pole

Allen Road

Allen Road drawn from Aerial Photograph

2361 R/W 40'

R/W - 60'

Ersh'g Road No. (533) - 2321

(Worline Road No. 106)

P. Pole 48

79.50 T. Pole 48

41 P Pole 79.23 18.20

Reset 1'1/2" pipe & mon. 58 16.20 T. Pole 41

19.33 F. Post 41

T. Pole 37 42 42.80

10" Cedar 66

T. Pole 48 16.59 42.90

12" Fir 66 14.01

added 6/21/63

Found nail and shiner in road surface 78

14 13

(THOS. CAIN ROAD NO. 74) WIDTH 40 FT.

Bell Road No. (74) - 3600

13 18

Found old hub set mon 48

2612.0 by J.W. Meehan

2689.2 by J.W. Meehan

1'1/2" Pipe

23 24

24 19

35.00 40.40

T. Pole 23 42

Bldg. Skinner's tavern 23 42

7.49 91°05' 35.00 14.80 97.10

16" Fir 66

P. Pole 48

F. Post 42 F. Post 42

Found old stake Drove 3/4" pipe 1933 Found Hub in mon.


F. Post

P. Pole 24 42

SECTION 14
TOWNSHIP 35 NORTH, RANGE 3 EAST, W. M.
SKAGIT COUNTY, WASH.

SCALE, 1 INCH--400 FEET

DATE July, 1959 Frank Gilkey COUNTY ENGINEER

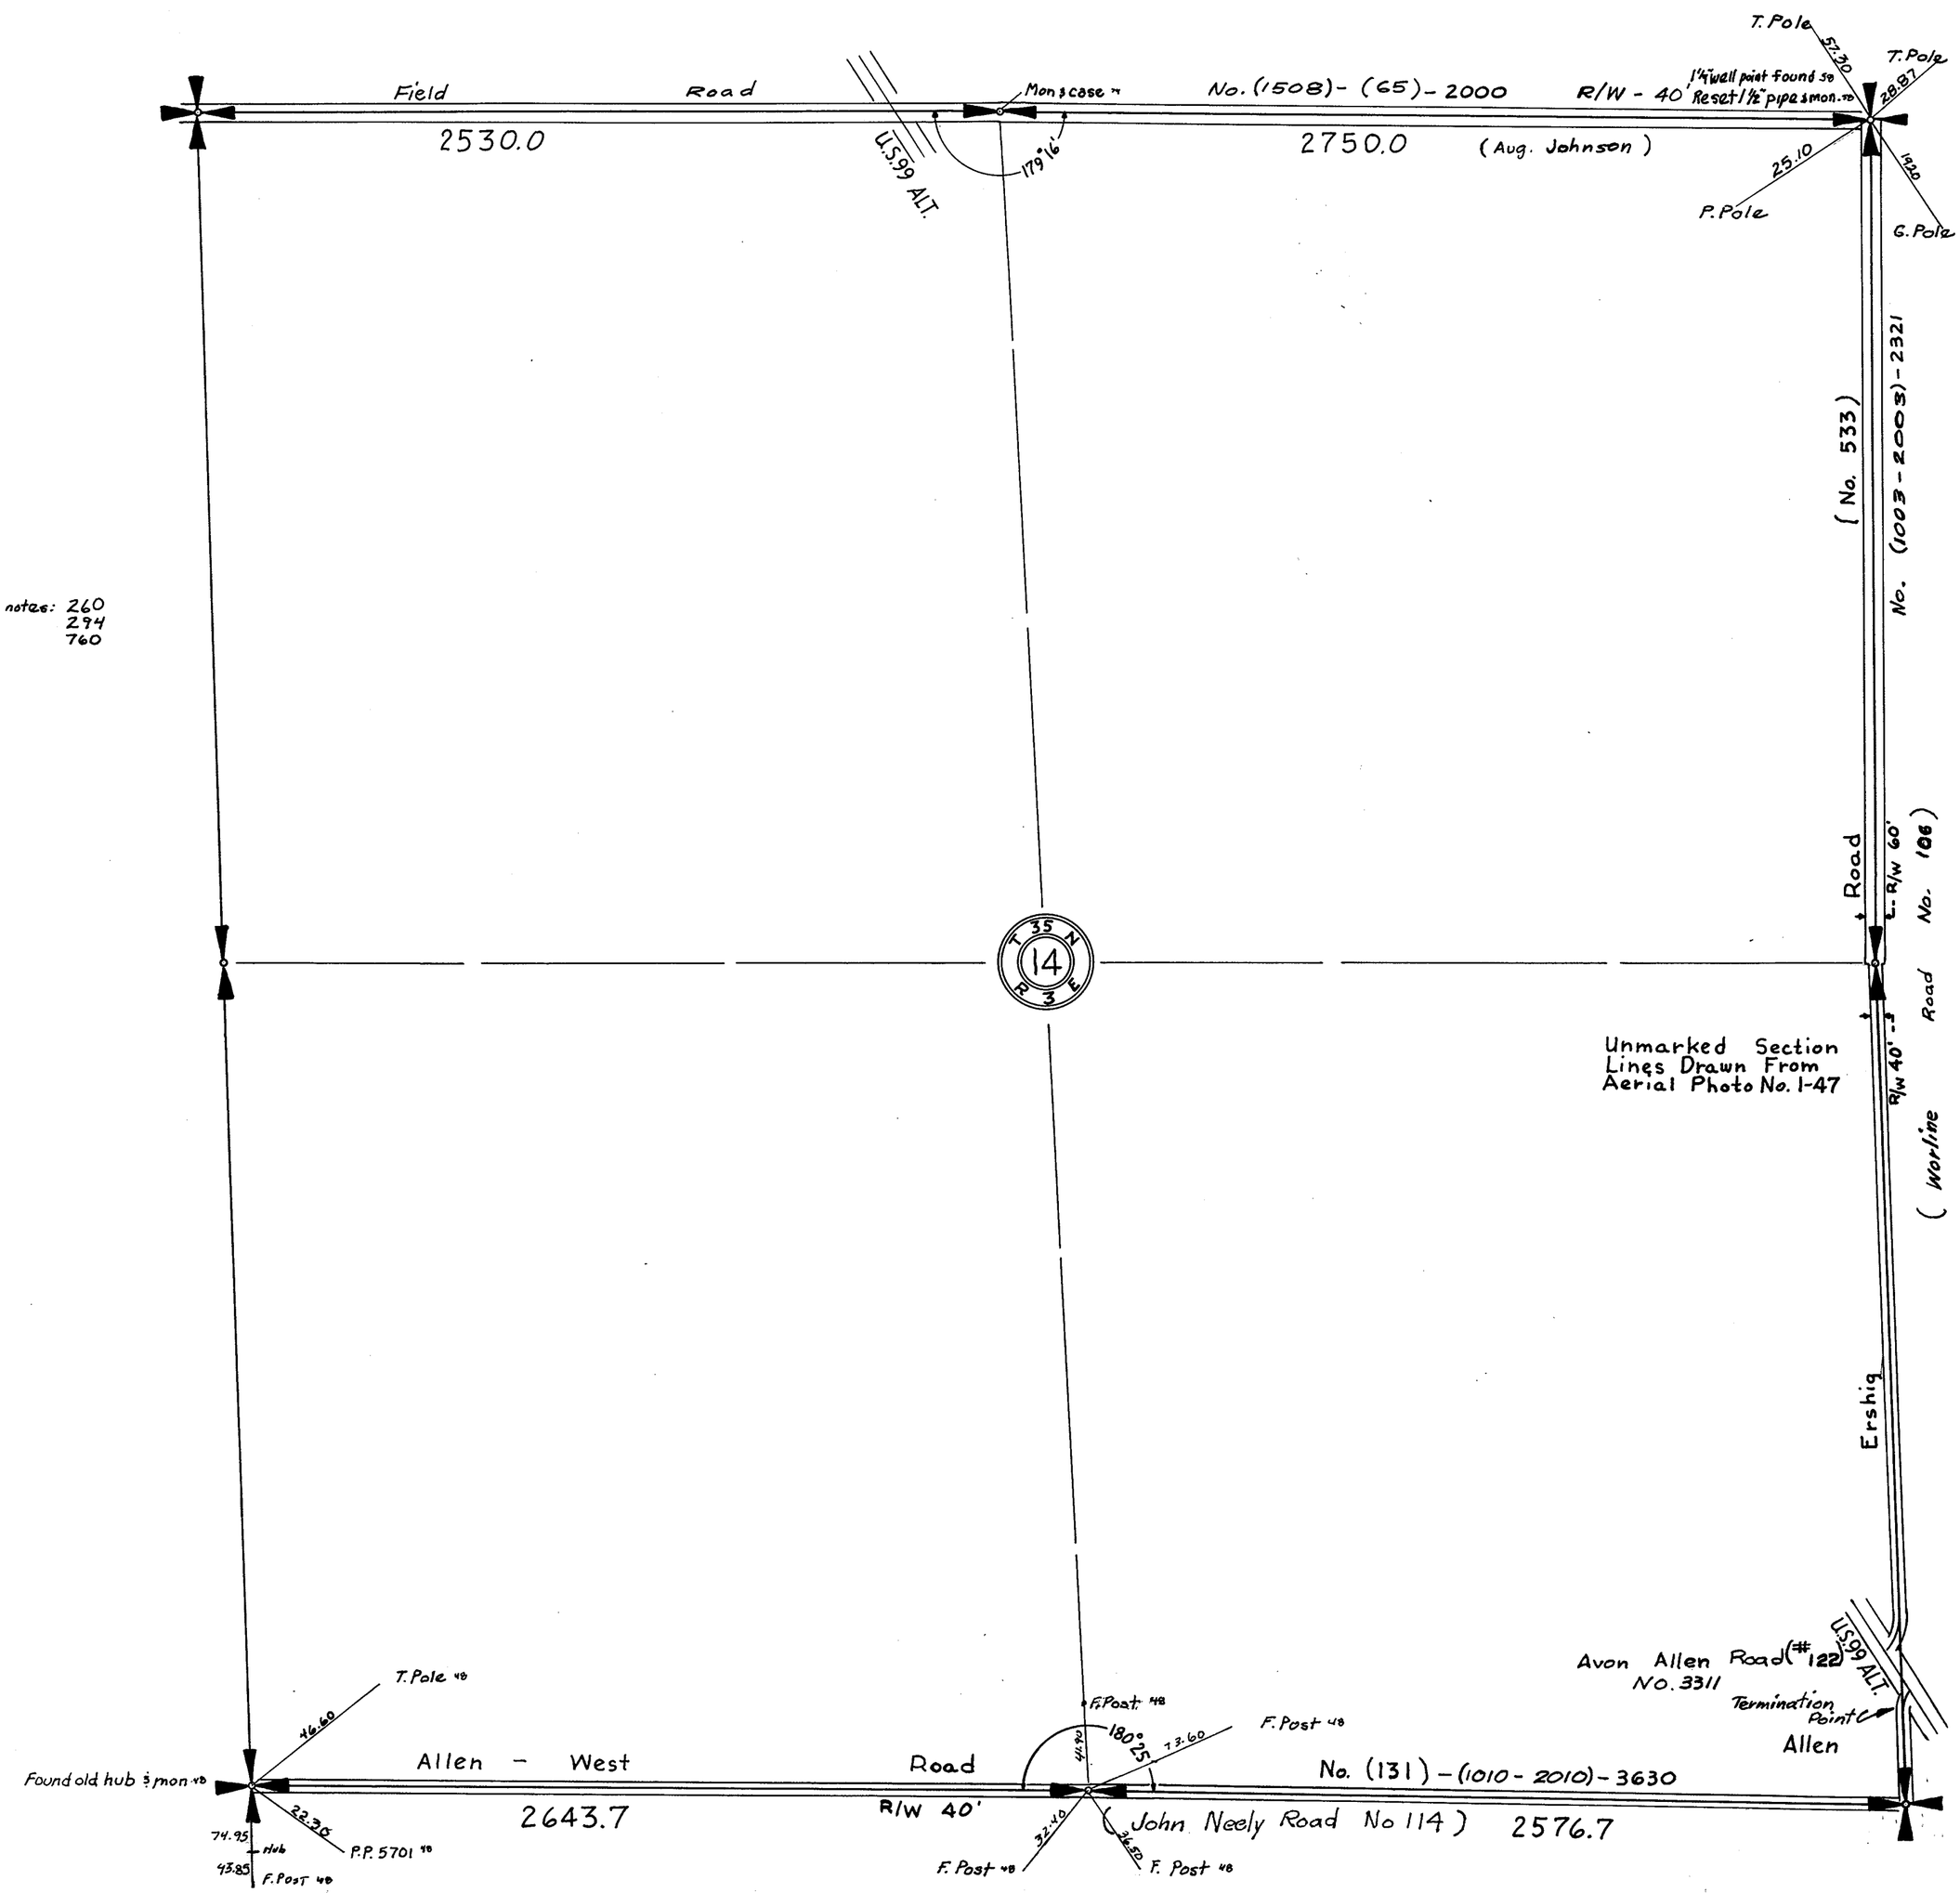

Monuments from notes: 260
294
760


SECTION 14

TOWNSHIP 35 NORTH. RANGE 3 EAST. W. M.

SKAGIT COUNTY. WASH.

SCALE. 1 INCH–400 FEET

A. L. STRONG COUNTY ENGINEER

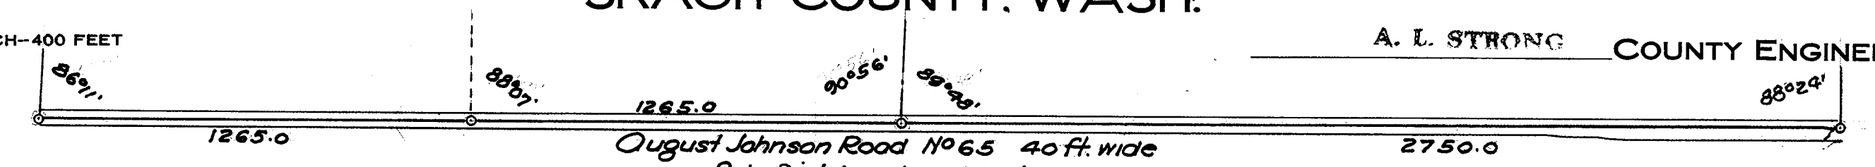

August Johnson Road No 65 40 ft. wide
Sub-Division by J.W. Meehan.

SECTION 15


TOWNSHIP 35 NORTH, RANGE 3 EAST, W. M.

SKAGIT COUNTY, WASH.

SCALE, 1 INCH--400 FEET

DATE July, 1959

Frank Gilkey COUNTY ENGINEER

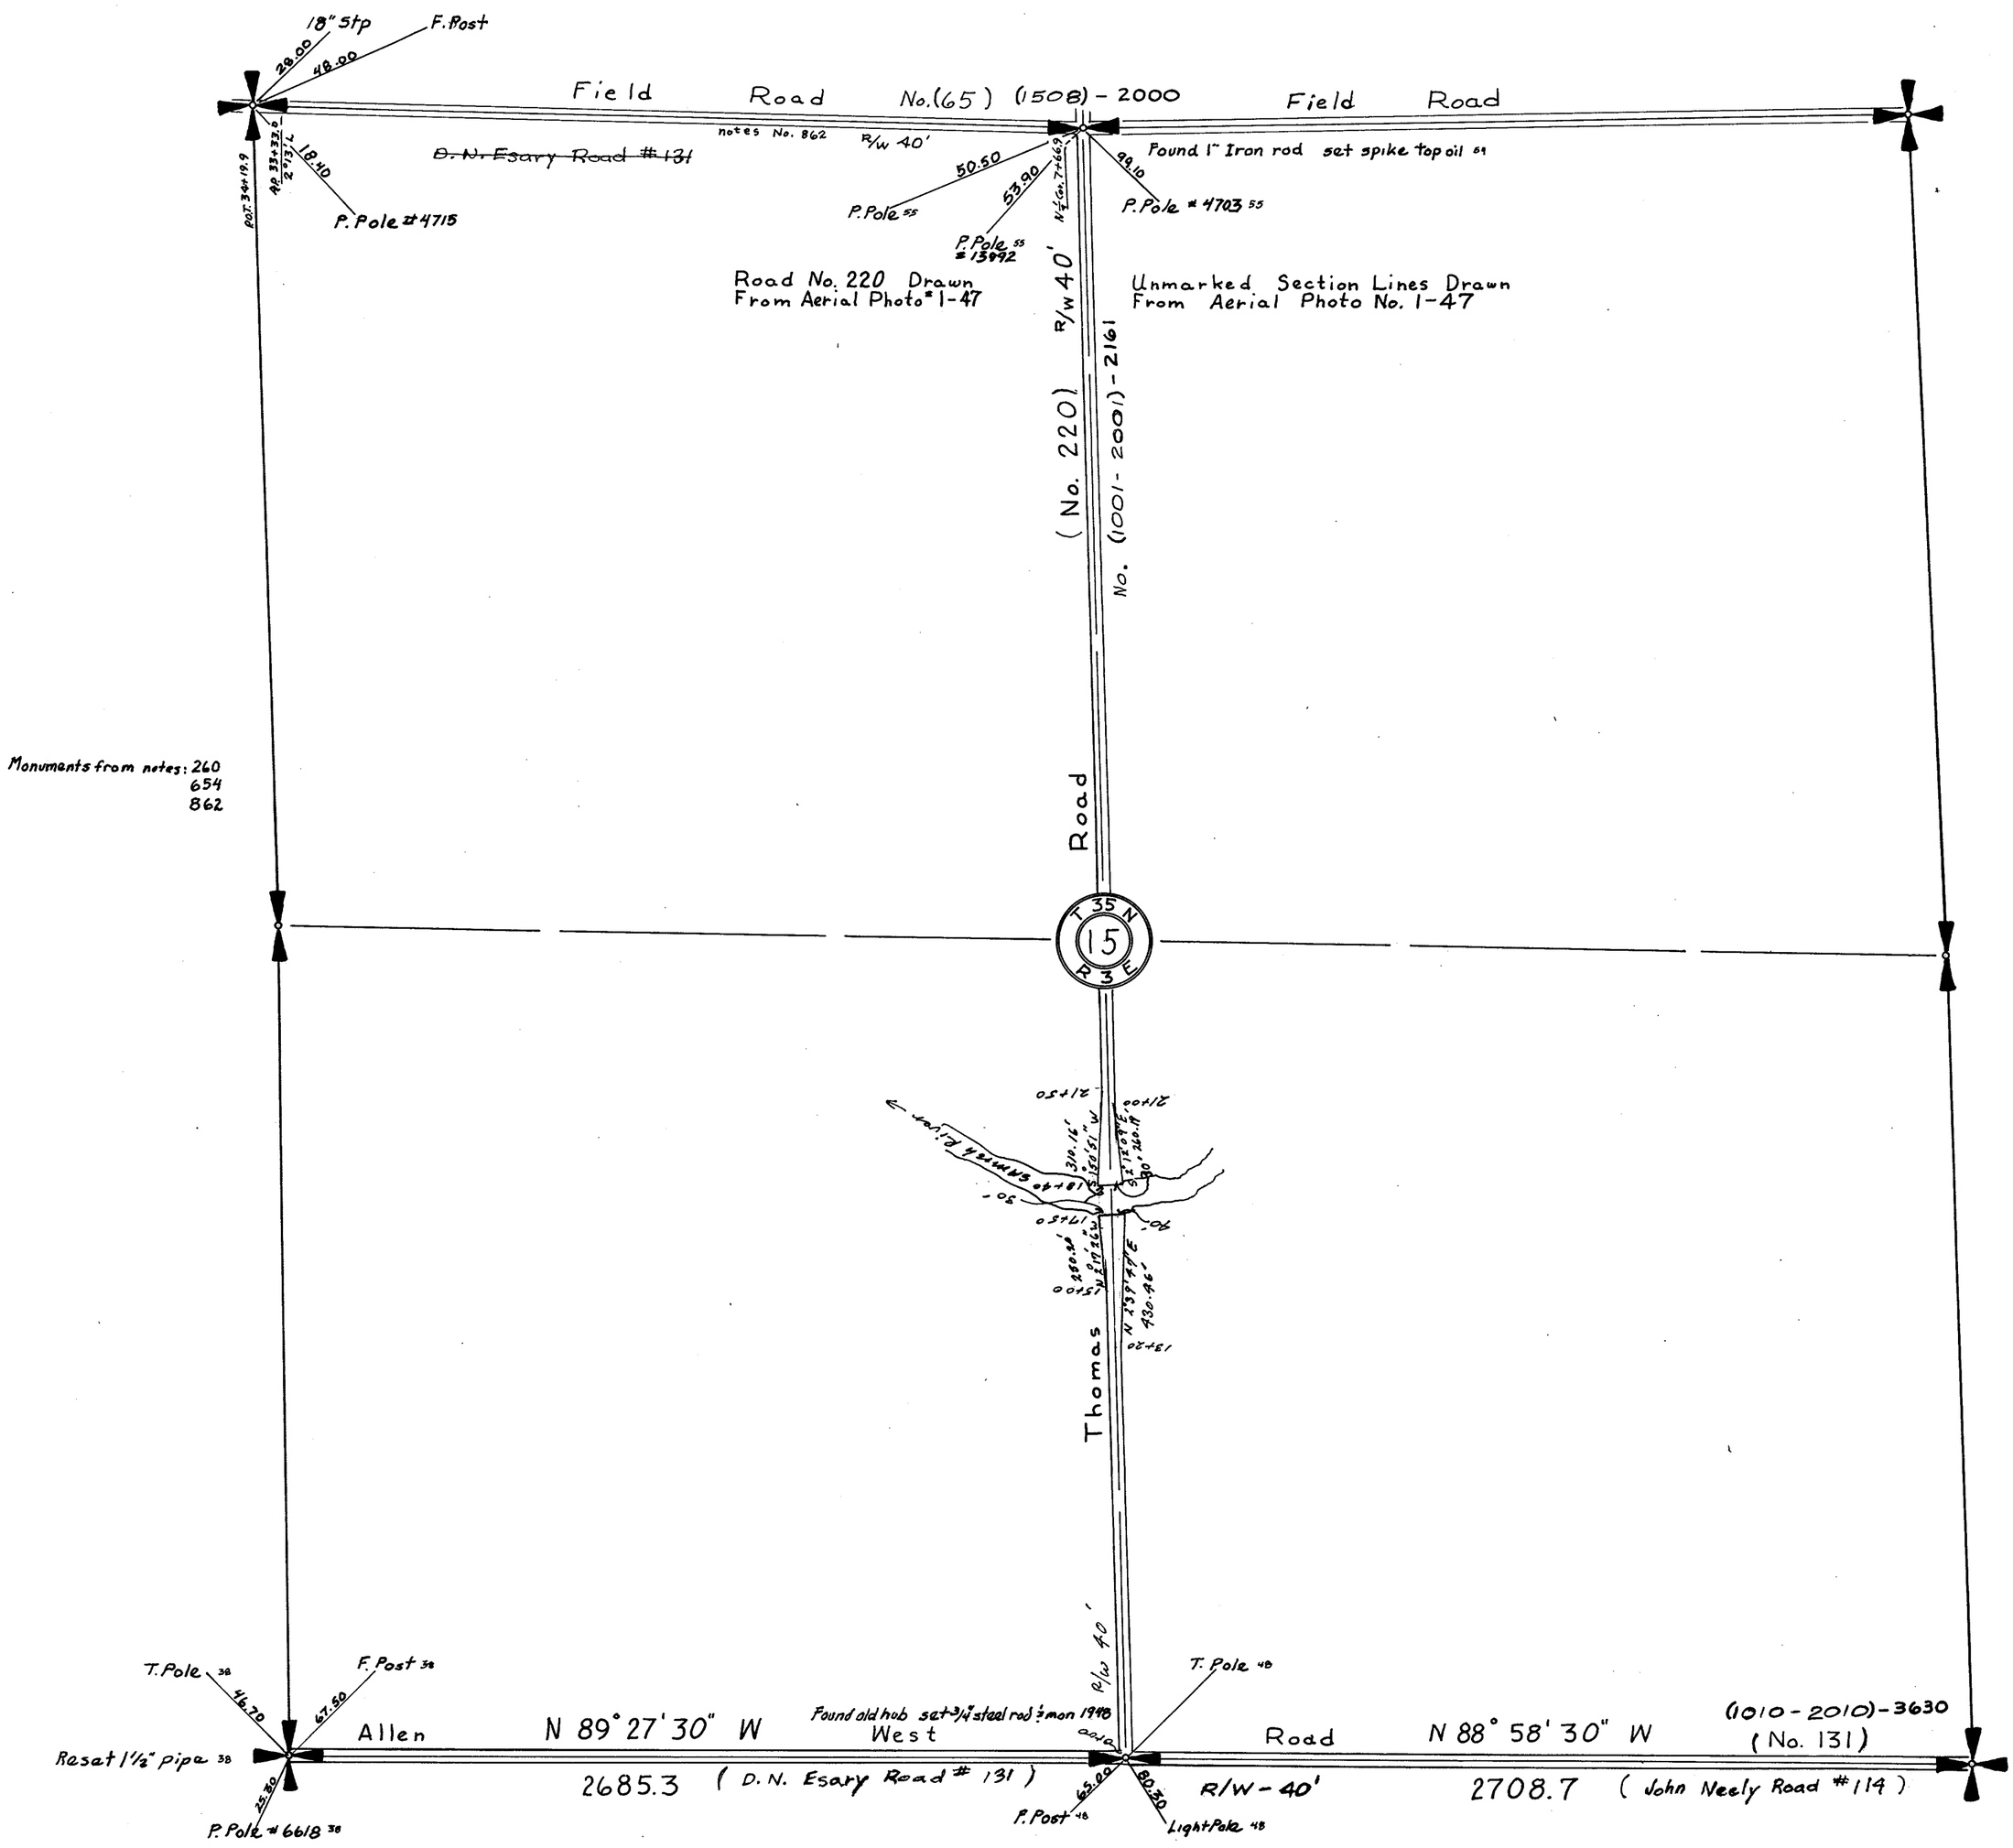


Monuments from notes: 260
654
862

SECTION 16
TOWNSHIP 35 NORTH, RANGE 3 EAST, W. M.
SKAGIT COUNTY, WASH.

SCALE, 1 INCH--400 FEET

DATE June 20, 1963

COUNTY ENGINEER

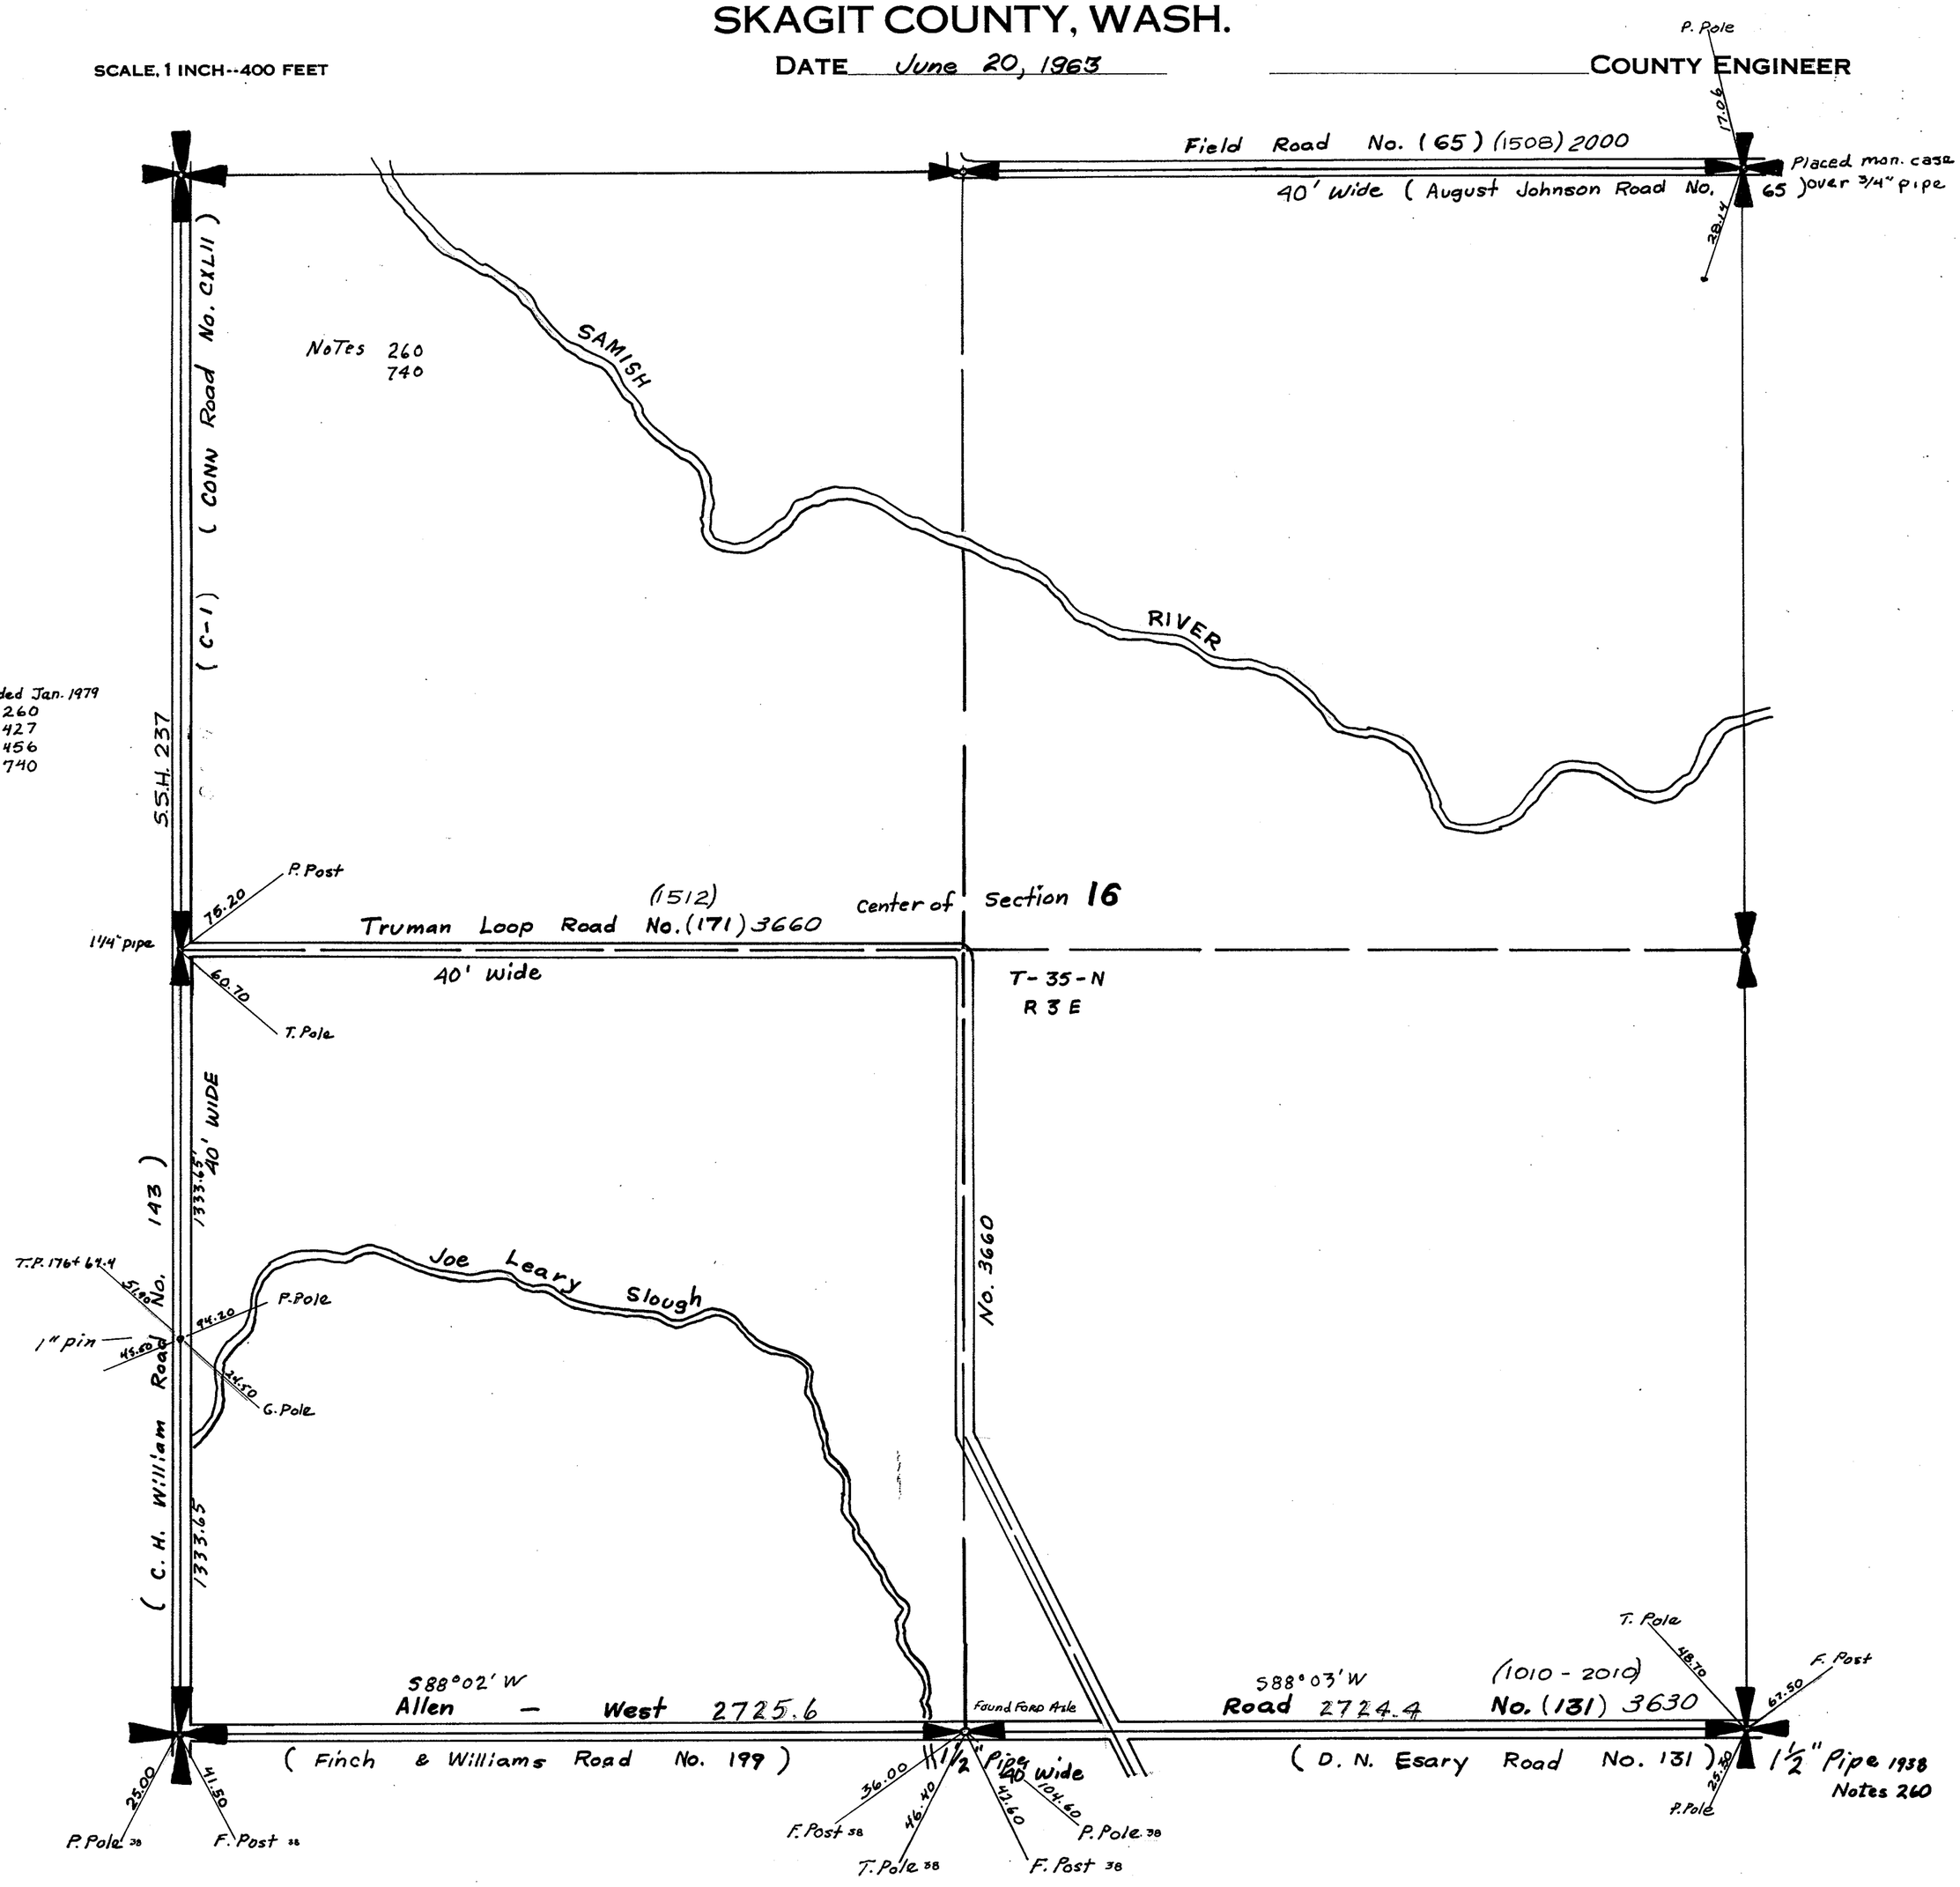

Monuments added Jan. 1979
from notes: 260
427
456
740


SECTION 17

TOWNSHIP 35 NORTH, RANGE 3 EAST, W. M.
SKAGIT COUNTY, WASH.

SCALE, 1 INCH--400 FEET

W. A. COSTELLO COUNTY ENGINEER

Jan. 1940 - AH Notes: 40/456

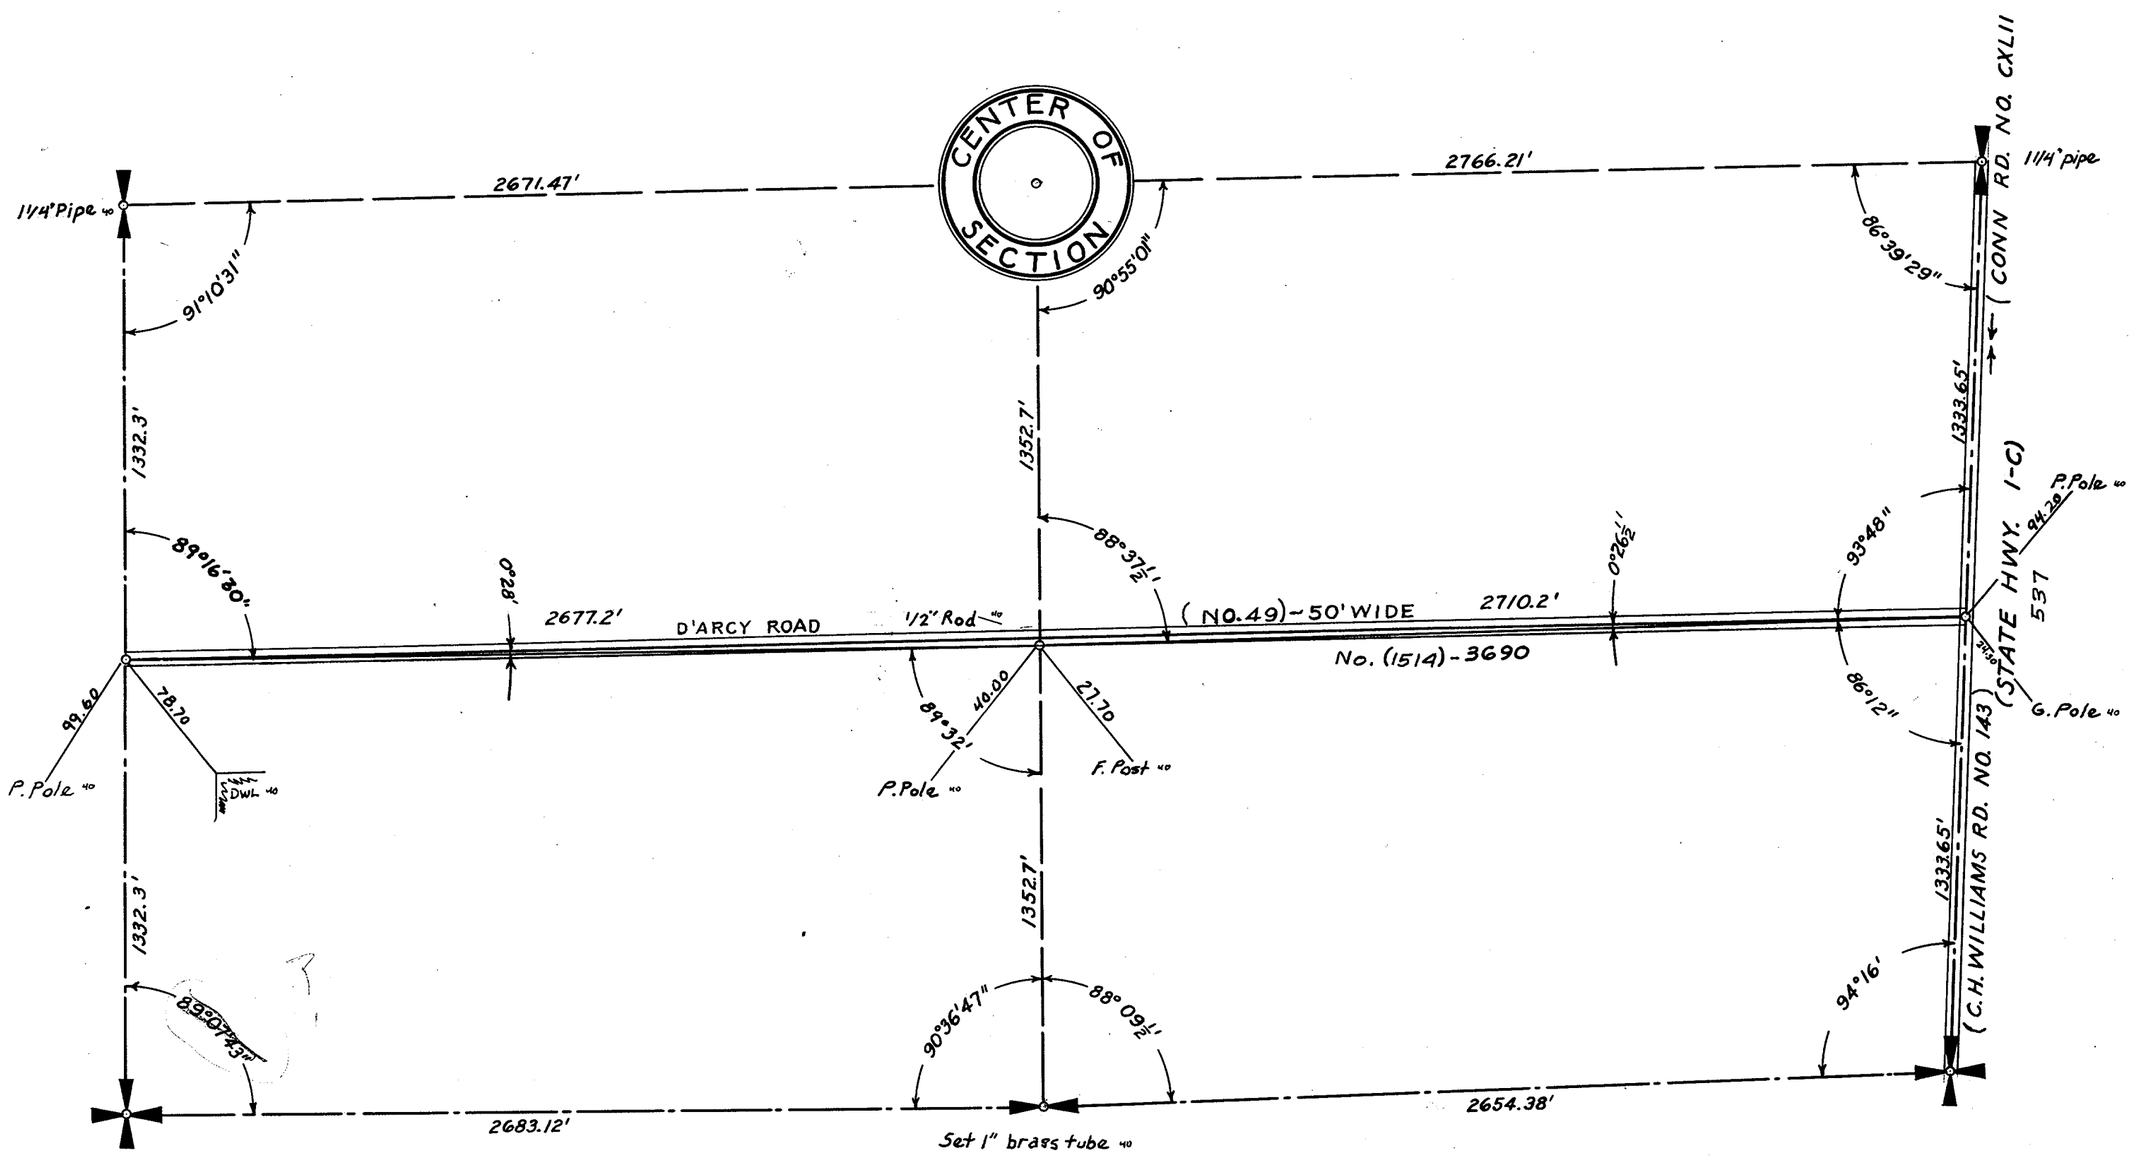


SECTION 18
TOWNSHIP 35 NORTH, RANGE 3 EAST, W. M.
SKAGIT COUNTY, WASH.

SCALE, 1 INCH--400 FEET
Road No. 662 From Notes 45/545 (3 of 3)

DATE June, 1959 — Frank Gilkey COUNTY ENGINEER

Shoreline, slough & unmarked section lines drawn from aerial photograph January 1979

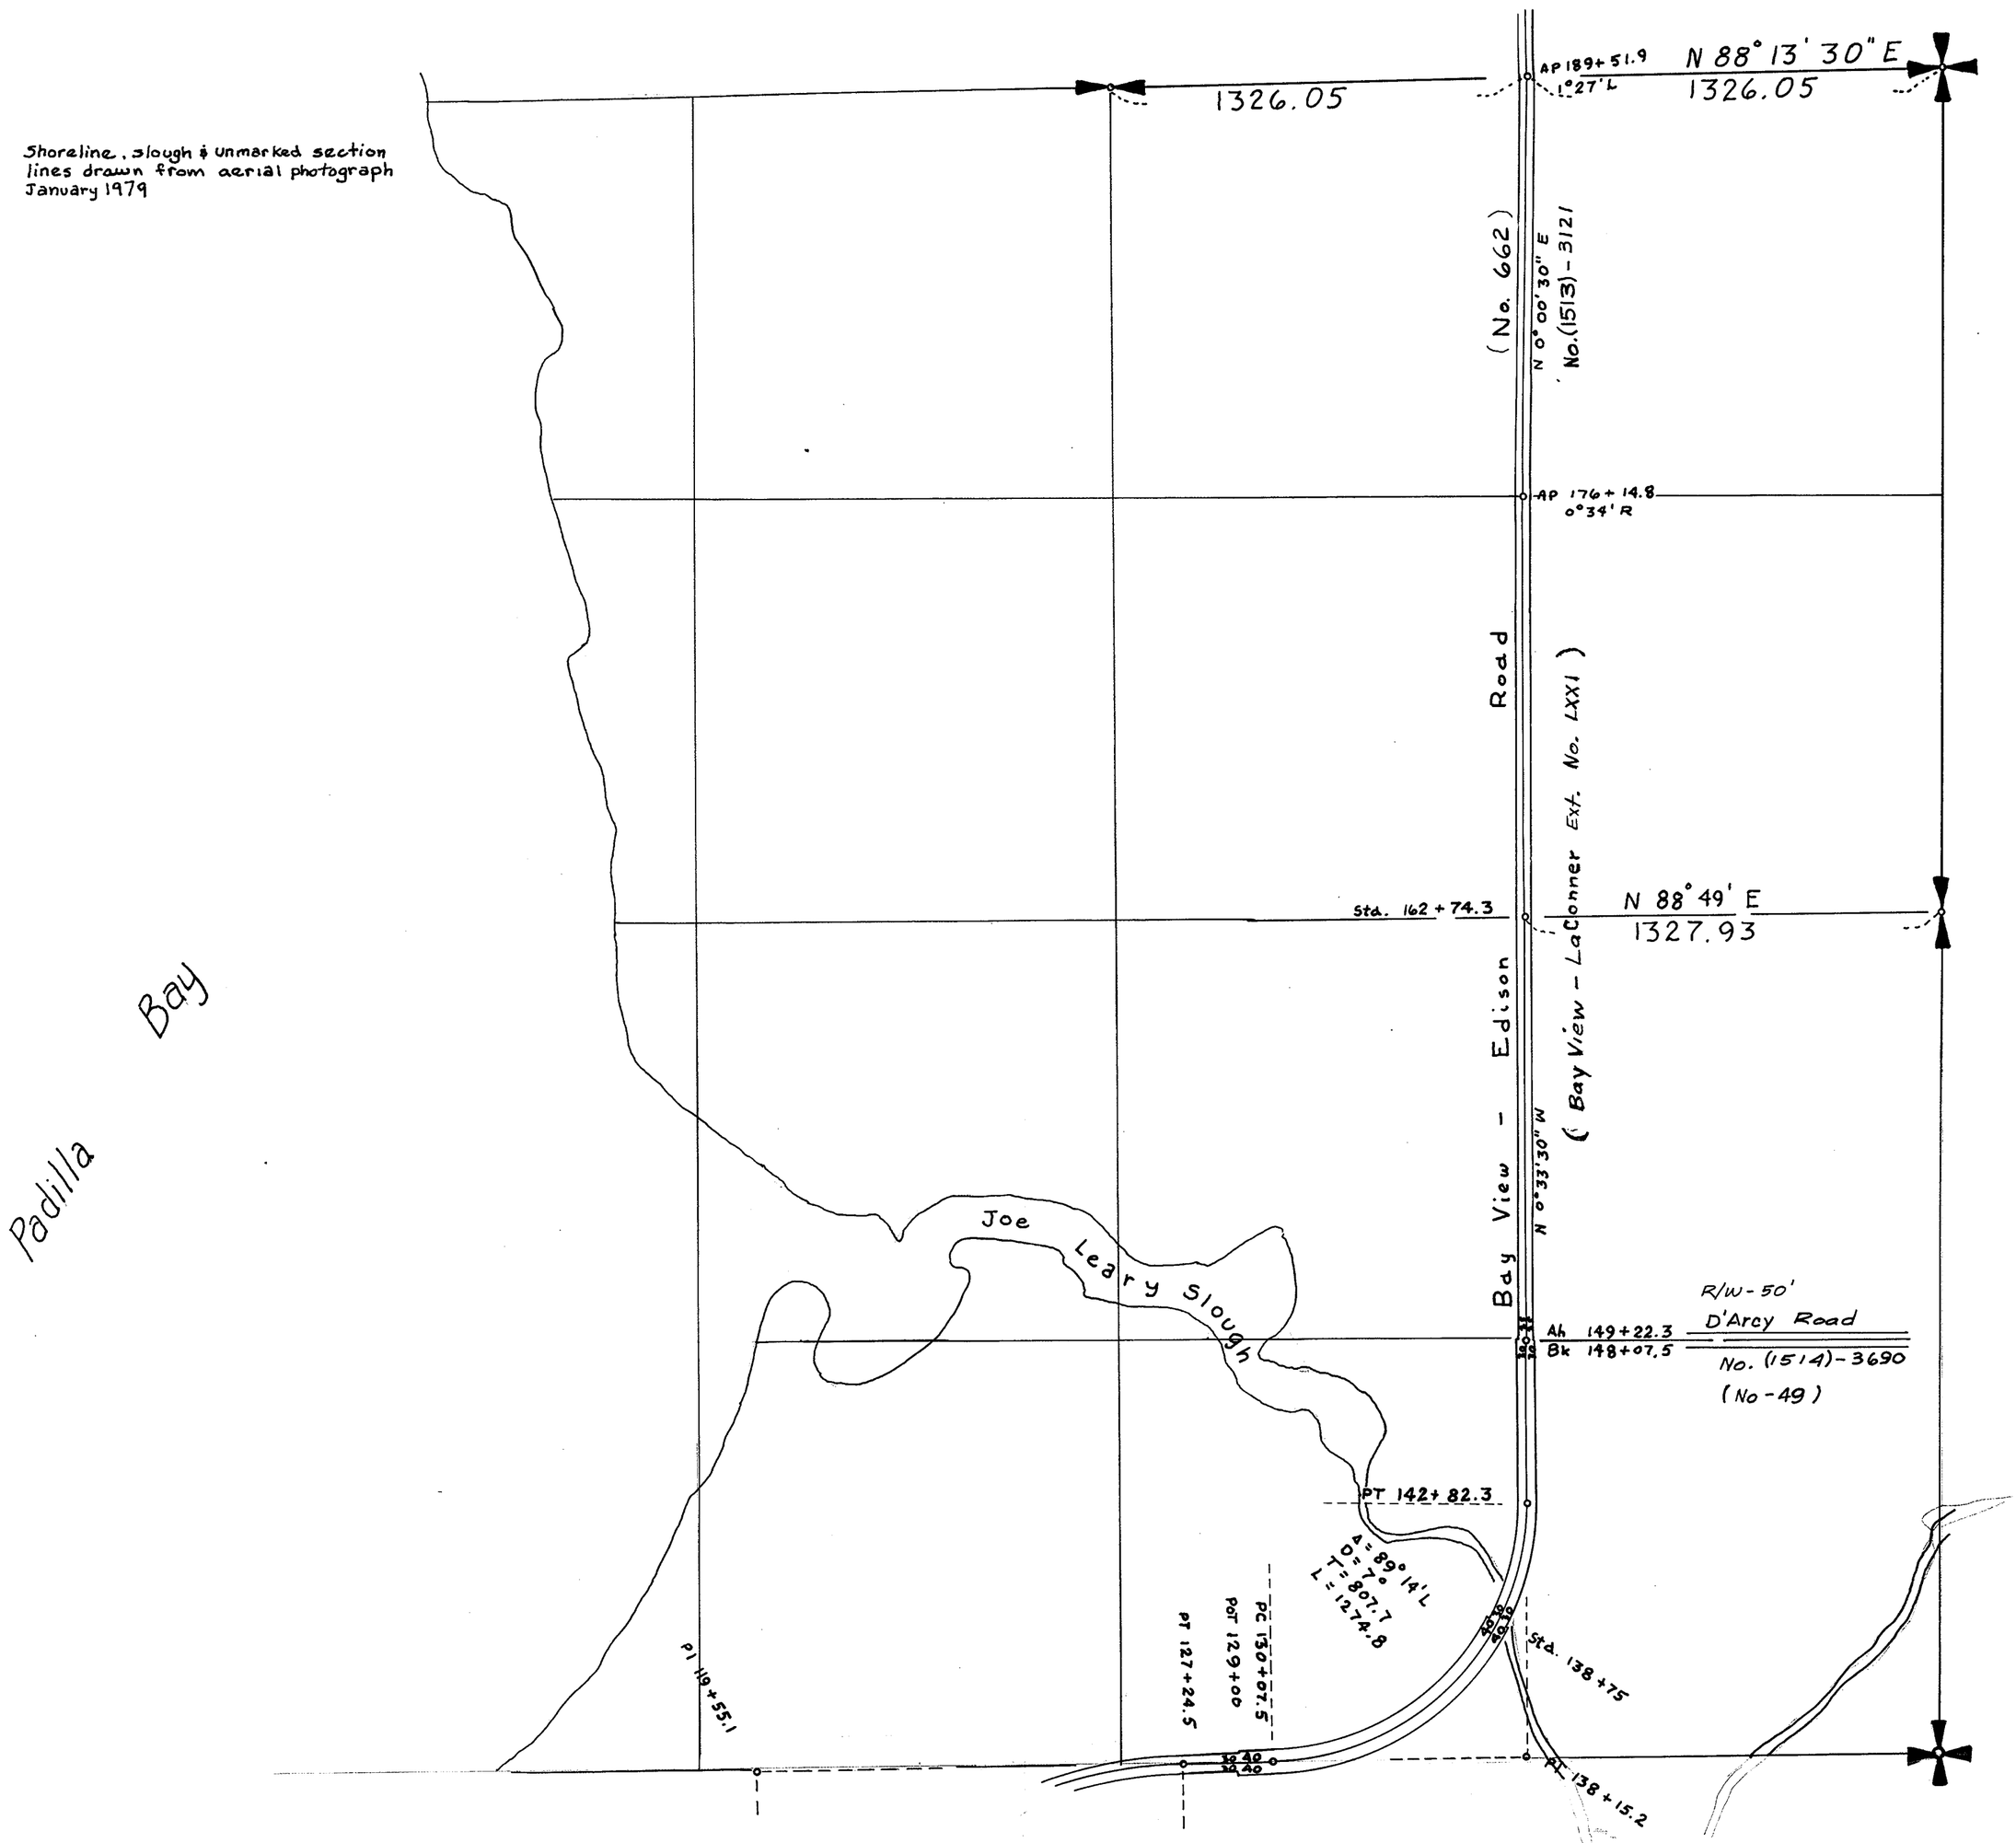


SECTION 18

TOWNSHIP 35 NORTH, RANGE 3 EAST, W. M.
SKAGIT COUNTY, WASH.

SCALE, 1 INCH--400 FEET

W.A. COSTELLO COUNTY ENGINEER

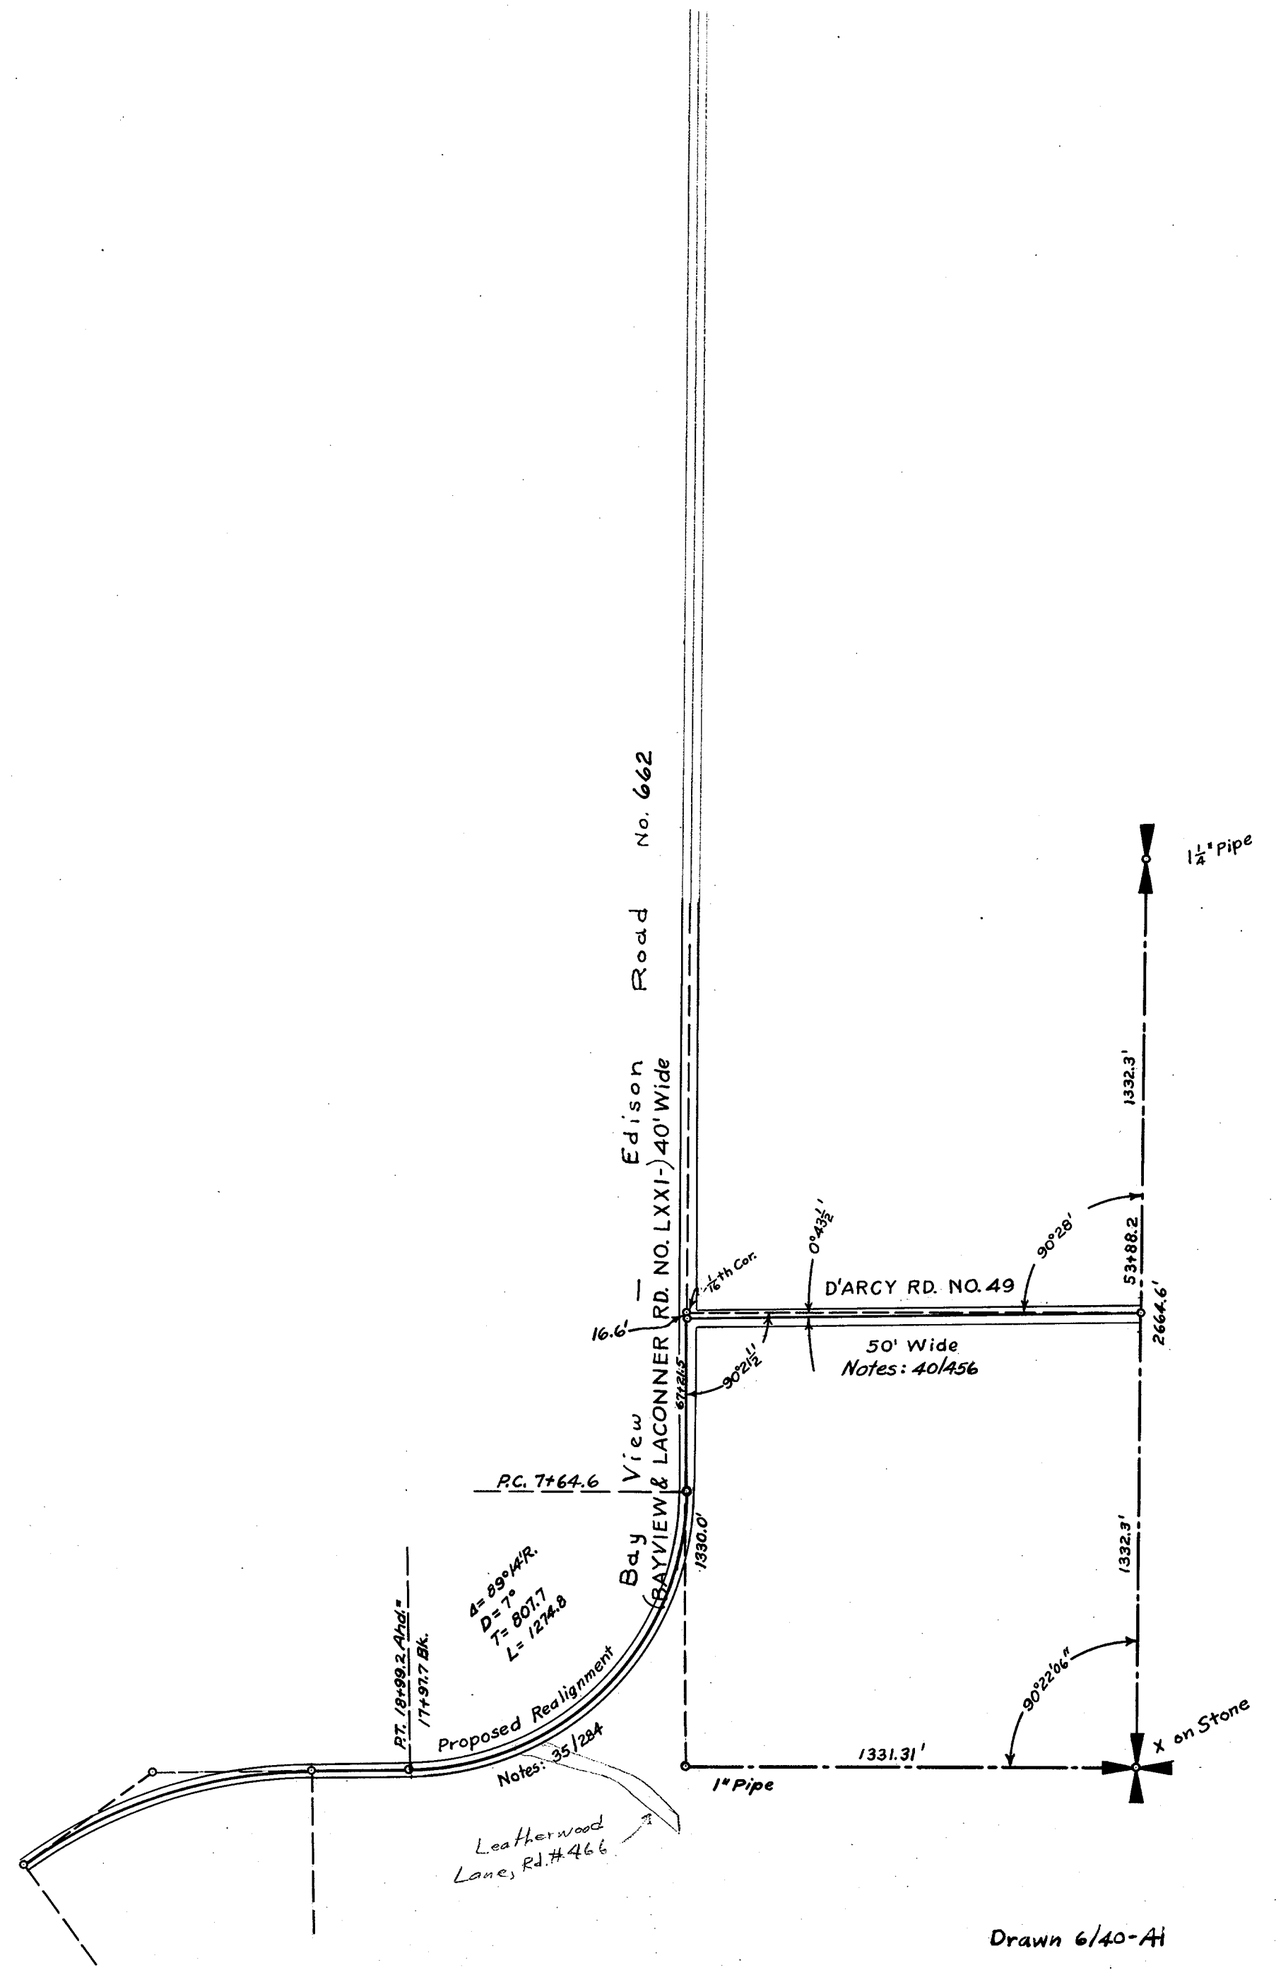

Drawn 6/40-Ai


SECTION 19

TOWNSHIP 35 NORTH, RANGE 3 EAST, W. M.

SKAGIT COUNTY, WASH.

SCALE, 1 INCH–400 FEET

A. L. STRONG COUNTY ENGINEER

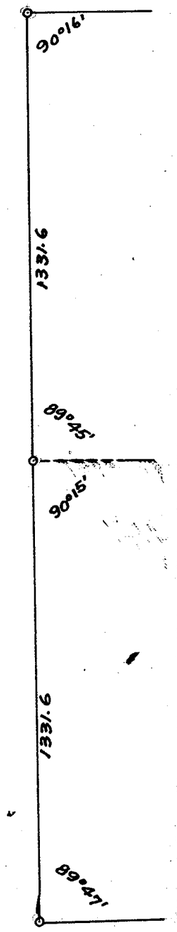

SECTION 19


TOWNSHIP 35 NORTH, RANGE 3 EAST, W. M.

SKAGIT COUNTY, WASH.

SCALE, 1 INCH--400 FEET
Road No. 662 From Notes 45/545 (3 of 3)

DATE June, 1959 Frank Gilkey COUNTY ENGINEER

Shoreline, slough & unmarked section lines from aerial photograph January 1979

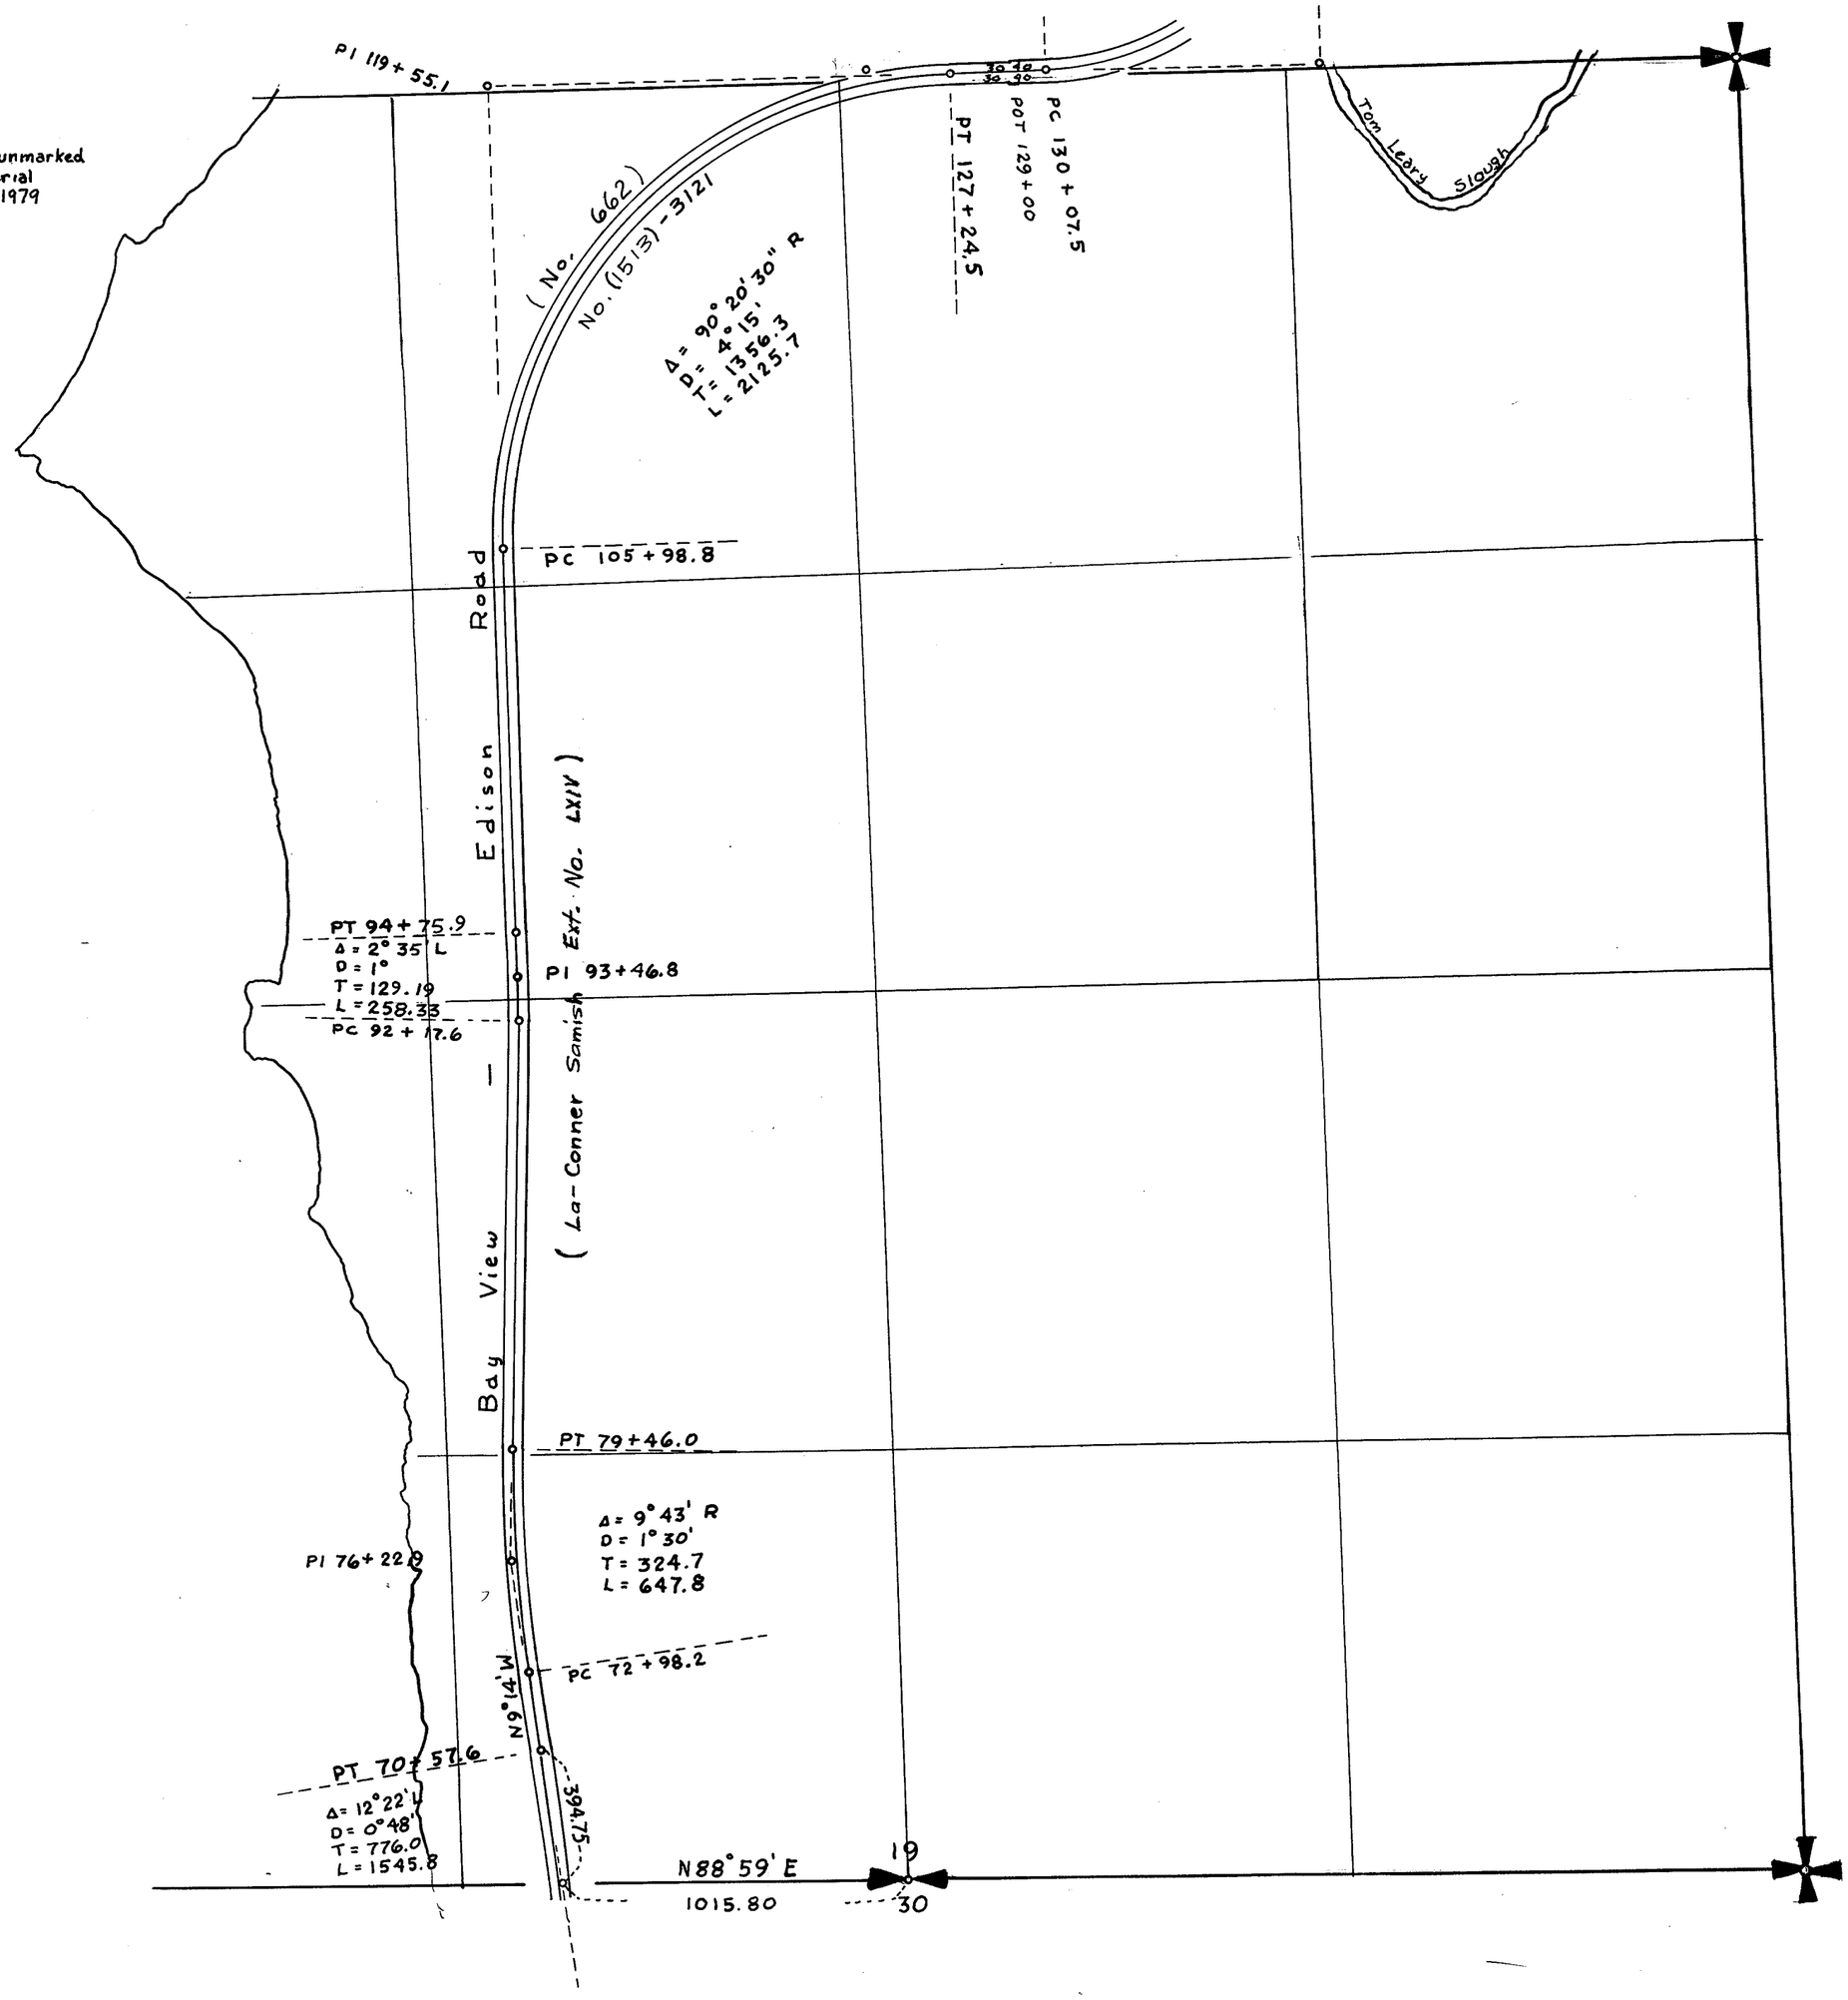


SECTION 20

TOWNSHIP 35 NORTH, RANGE 3 EAST, W. M.

SKAGIT COUNTY, WASH.

SCALE, 1 INCH–400 FEET

A. L. STRONG COUNTY ENGINEER

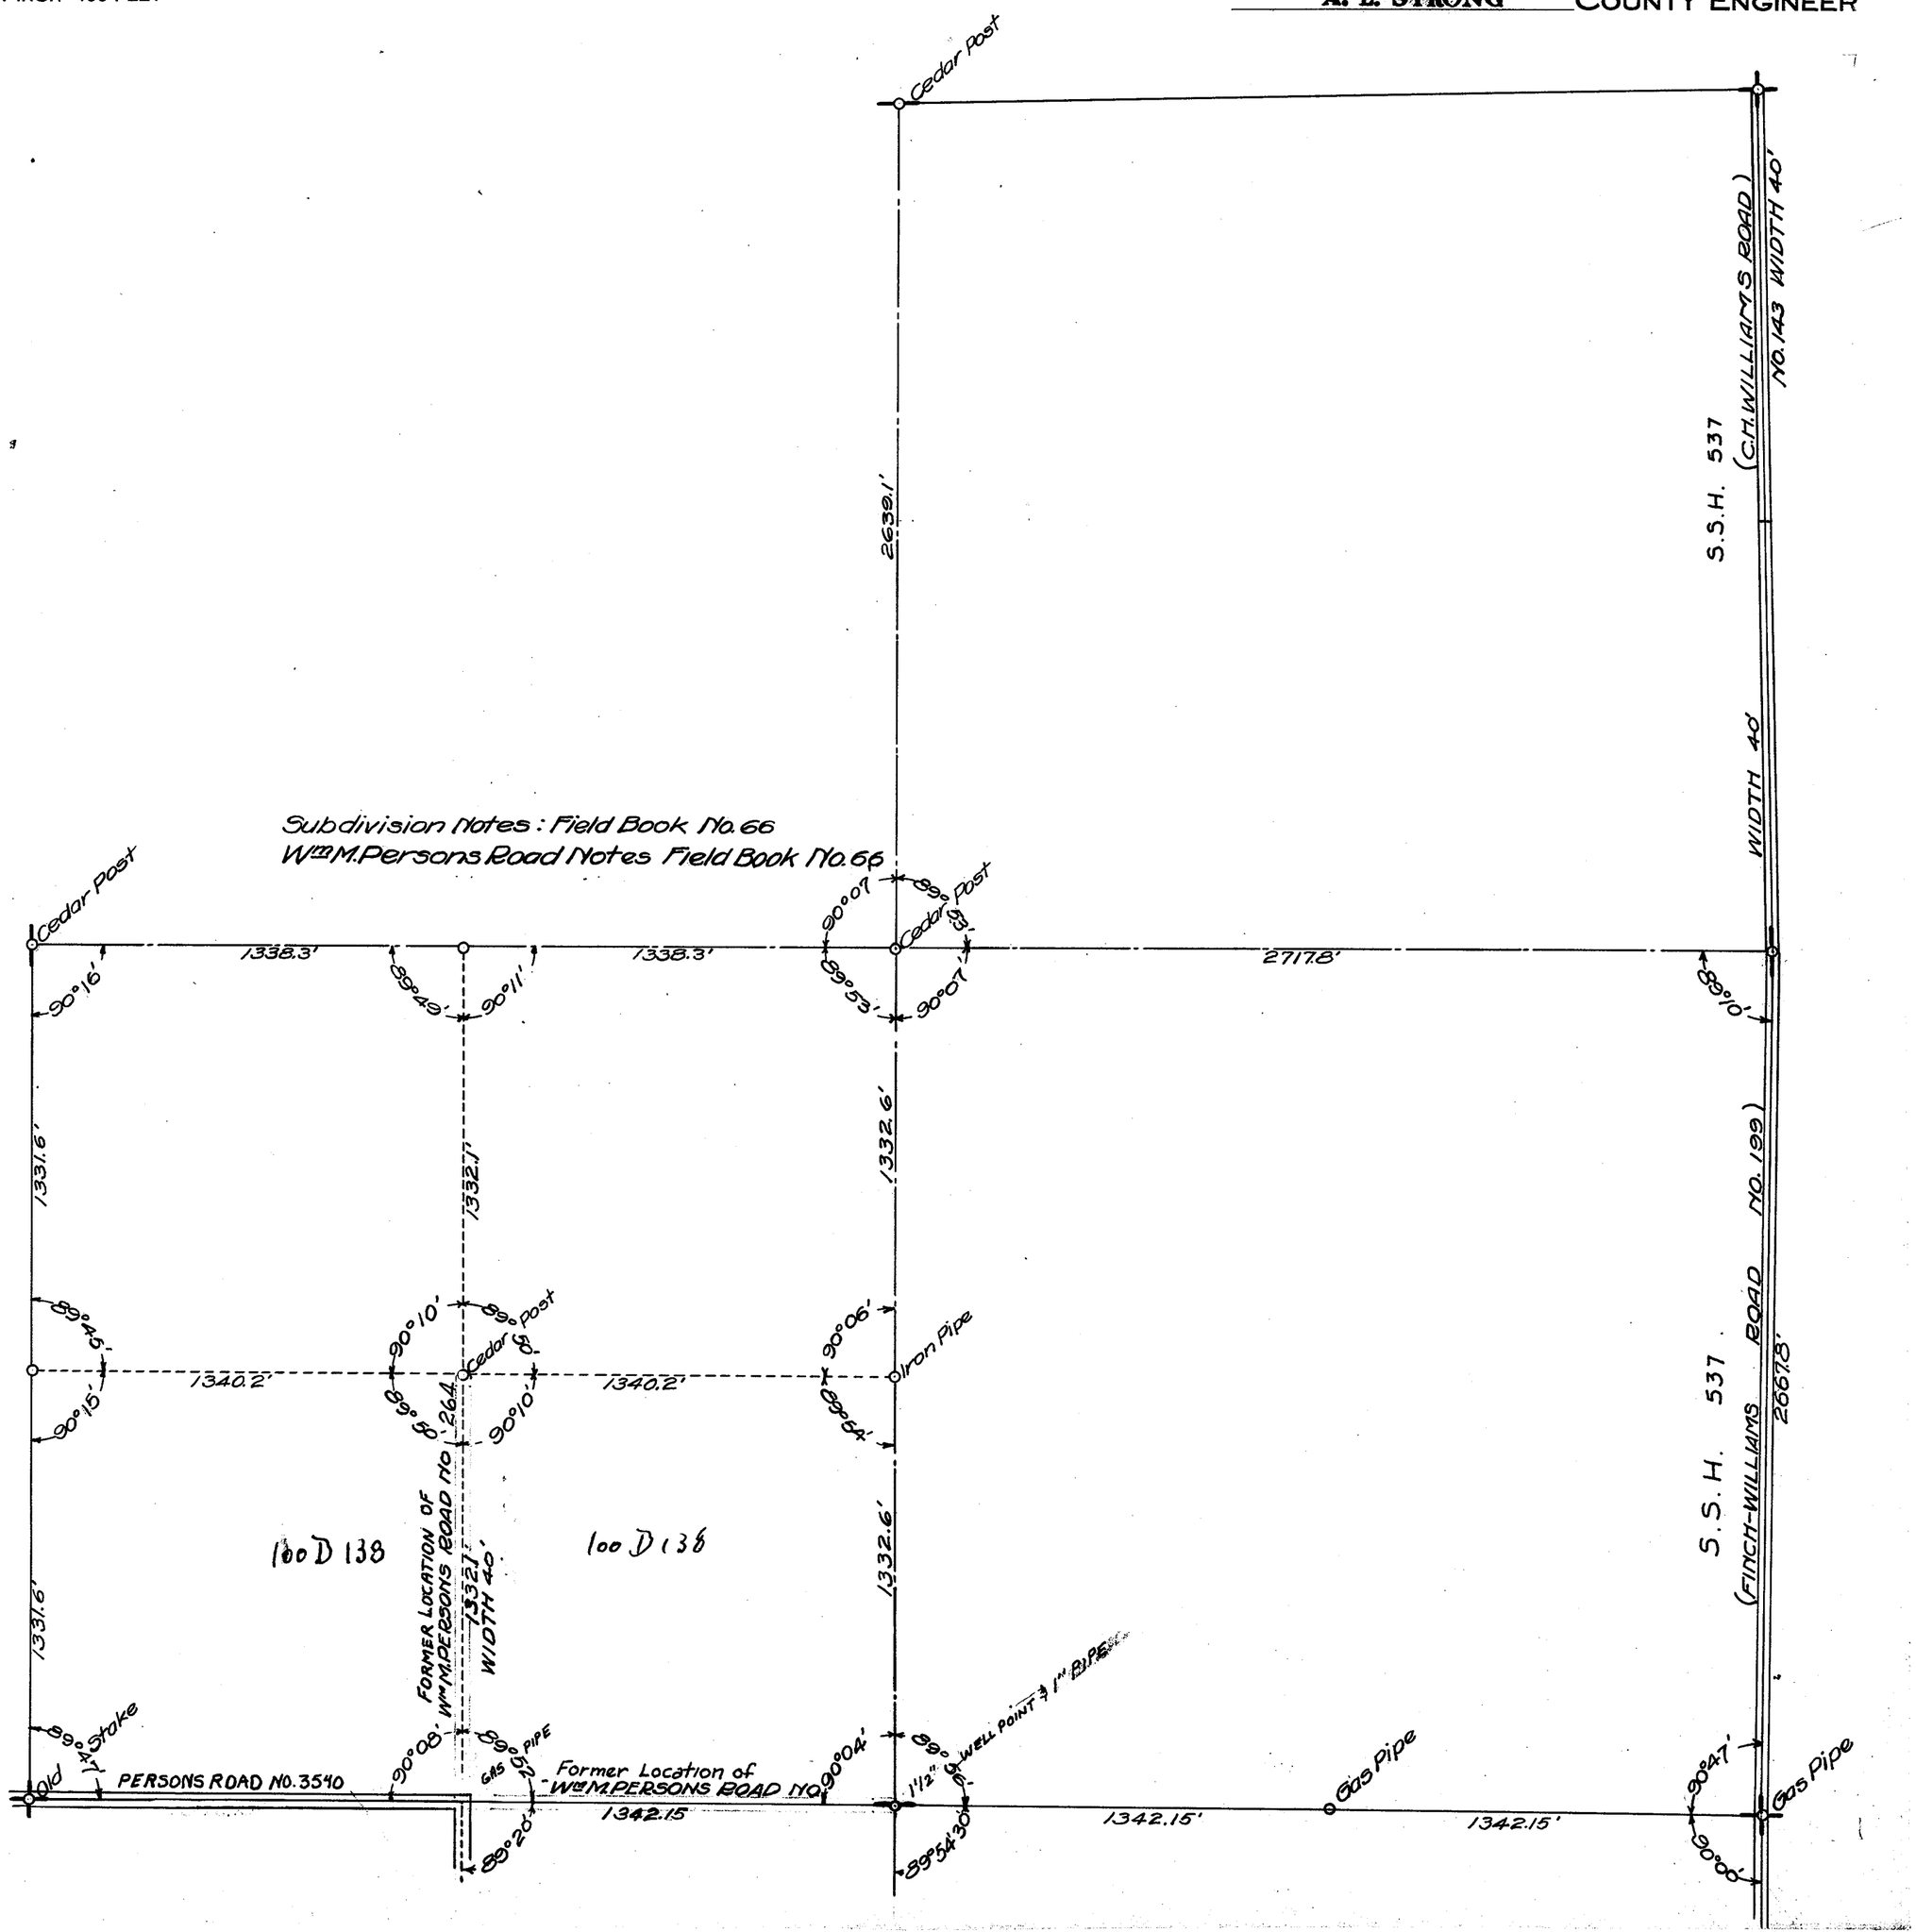


SECTION 21

TOWNSHIP 35 NORTH, RANGE 3 EAST, W. M.

SKAGIT COUNTY, WASH.

DATE July, 1959 — Frank Gilkey COUNTY ENGINEER

SCALE, 1 INCH--400 FEET

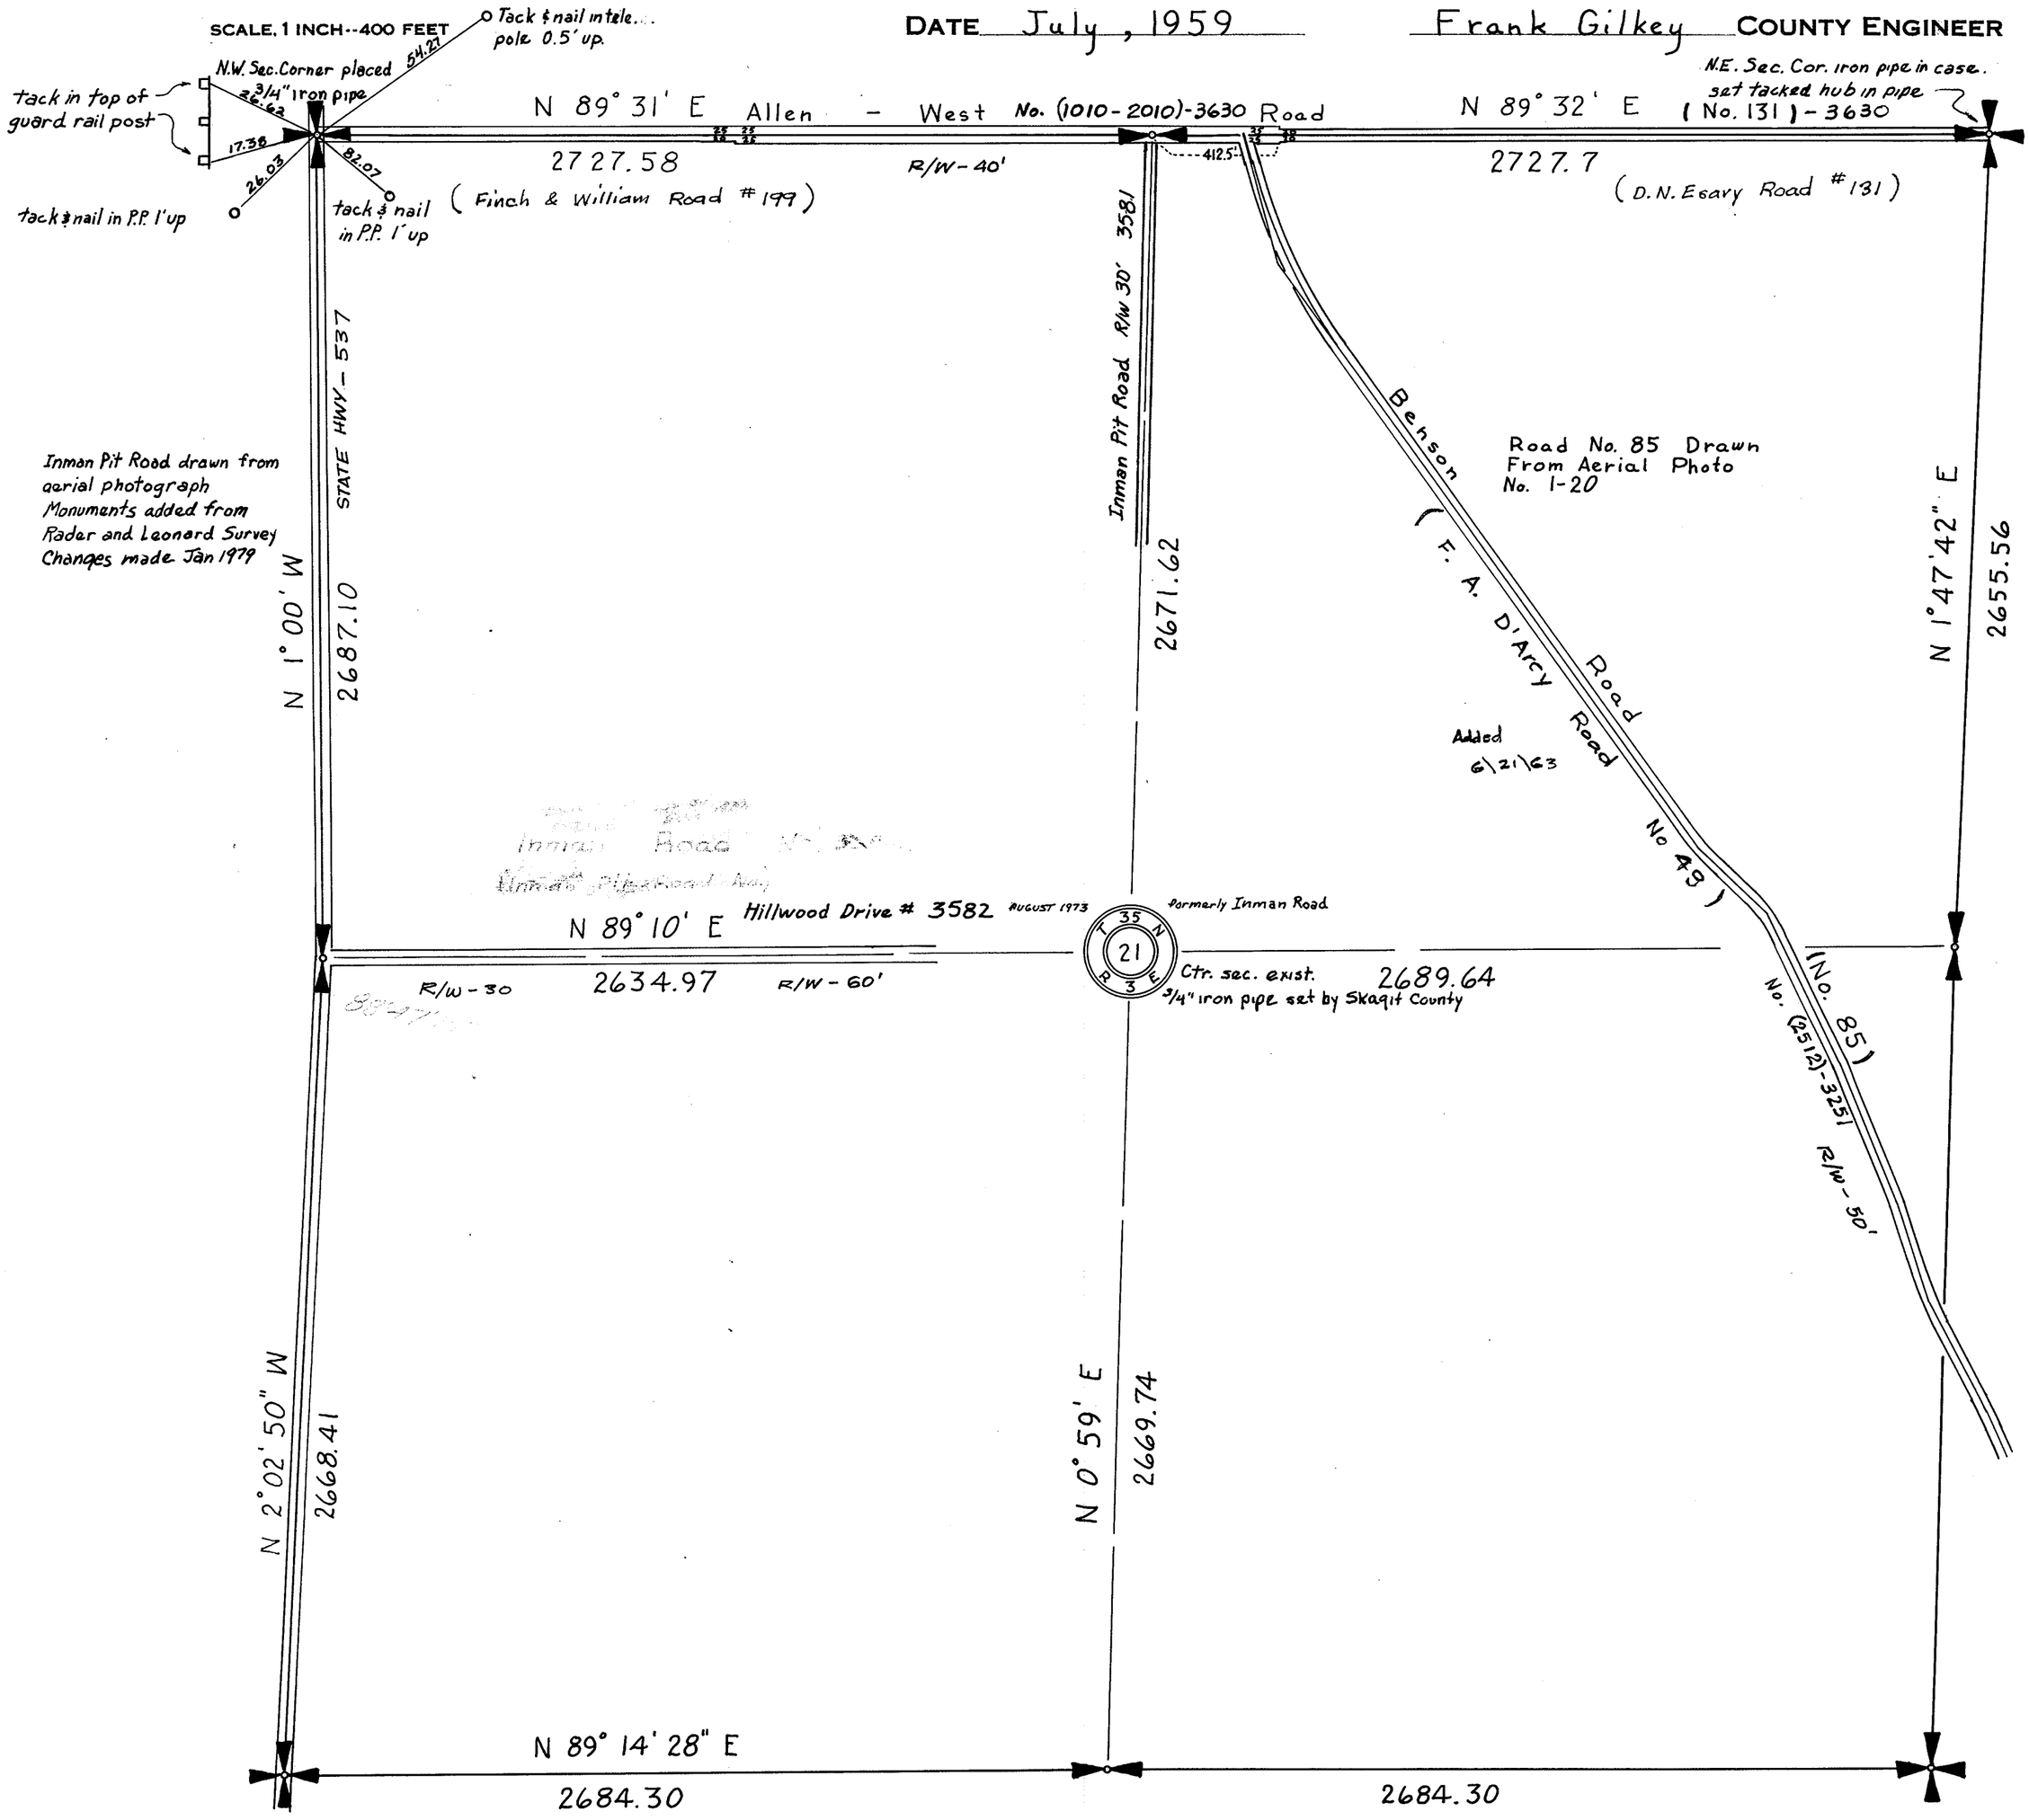

SECTION 22

TOWNSHIP 35 NORTH, RANGE 3 EAST, W. M.

SKAGIT COUNTY, WASH.

SCALE, 1 INCH--400 FEET

H.O. Walberg COUNTY ENGINEER




SECTION 23

TOWNSHIP 35 NORTH, RANGE 3 EAST, W. M.

SKAGIT COUNTY, WASH.

SCALE, 1 INCH--400 FEET

H.O. Walberg COUNTY ENGINEER

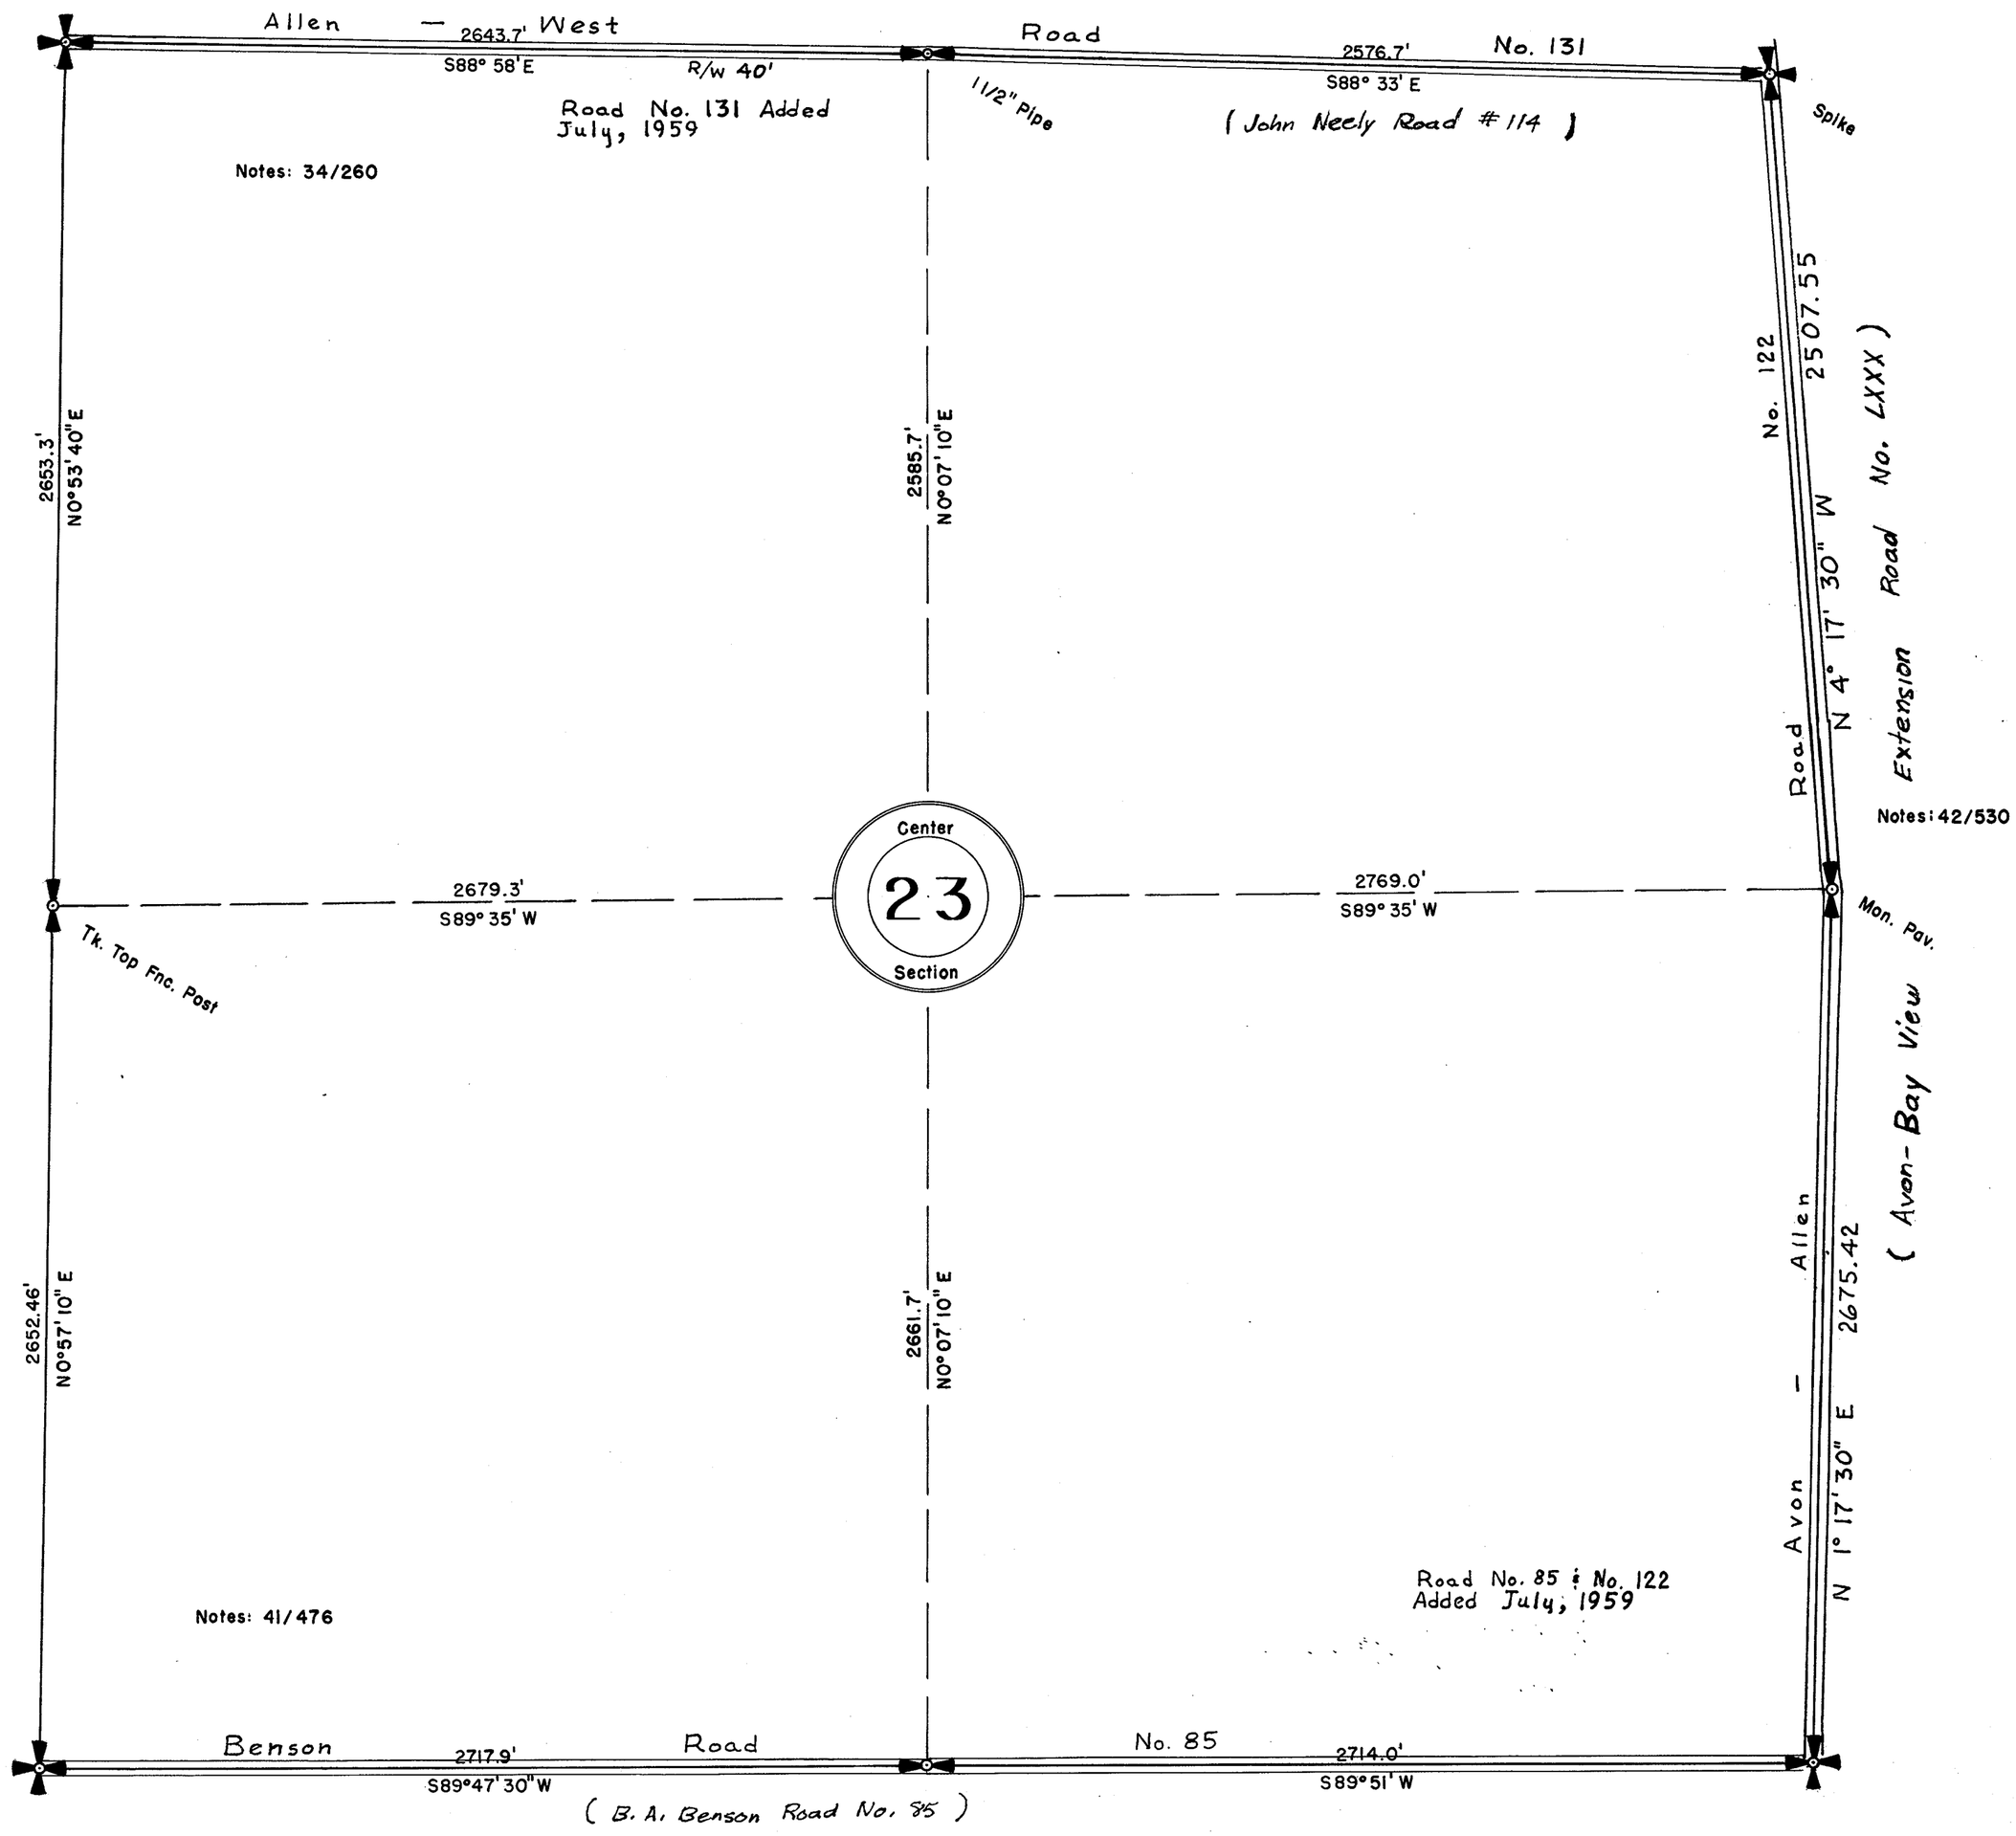


SECTION 23

TOWNSHIP 35 NORTH, RANGE 3 EAST, W. M.

SKAGIT COUNTY, WASH.

SCALE, 1 INCH--400 FEET

COUNTY ENGINEER

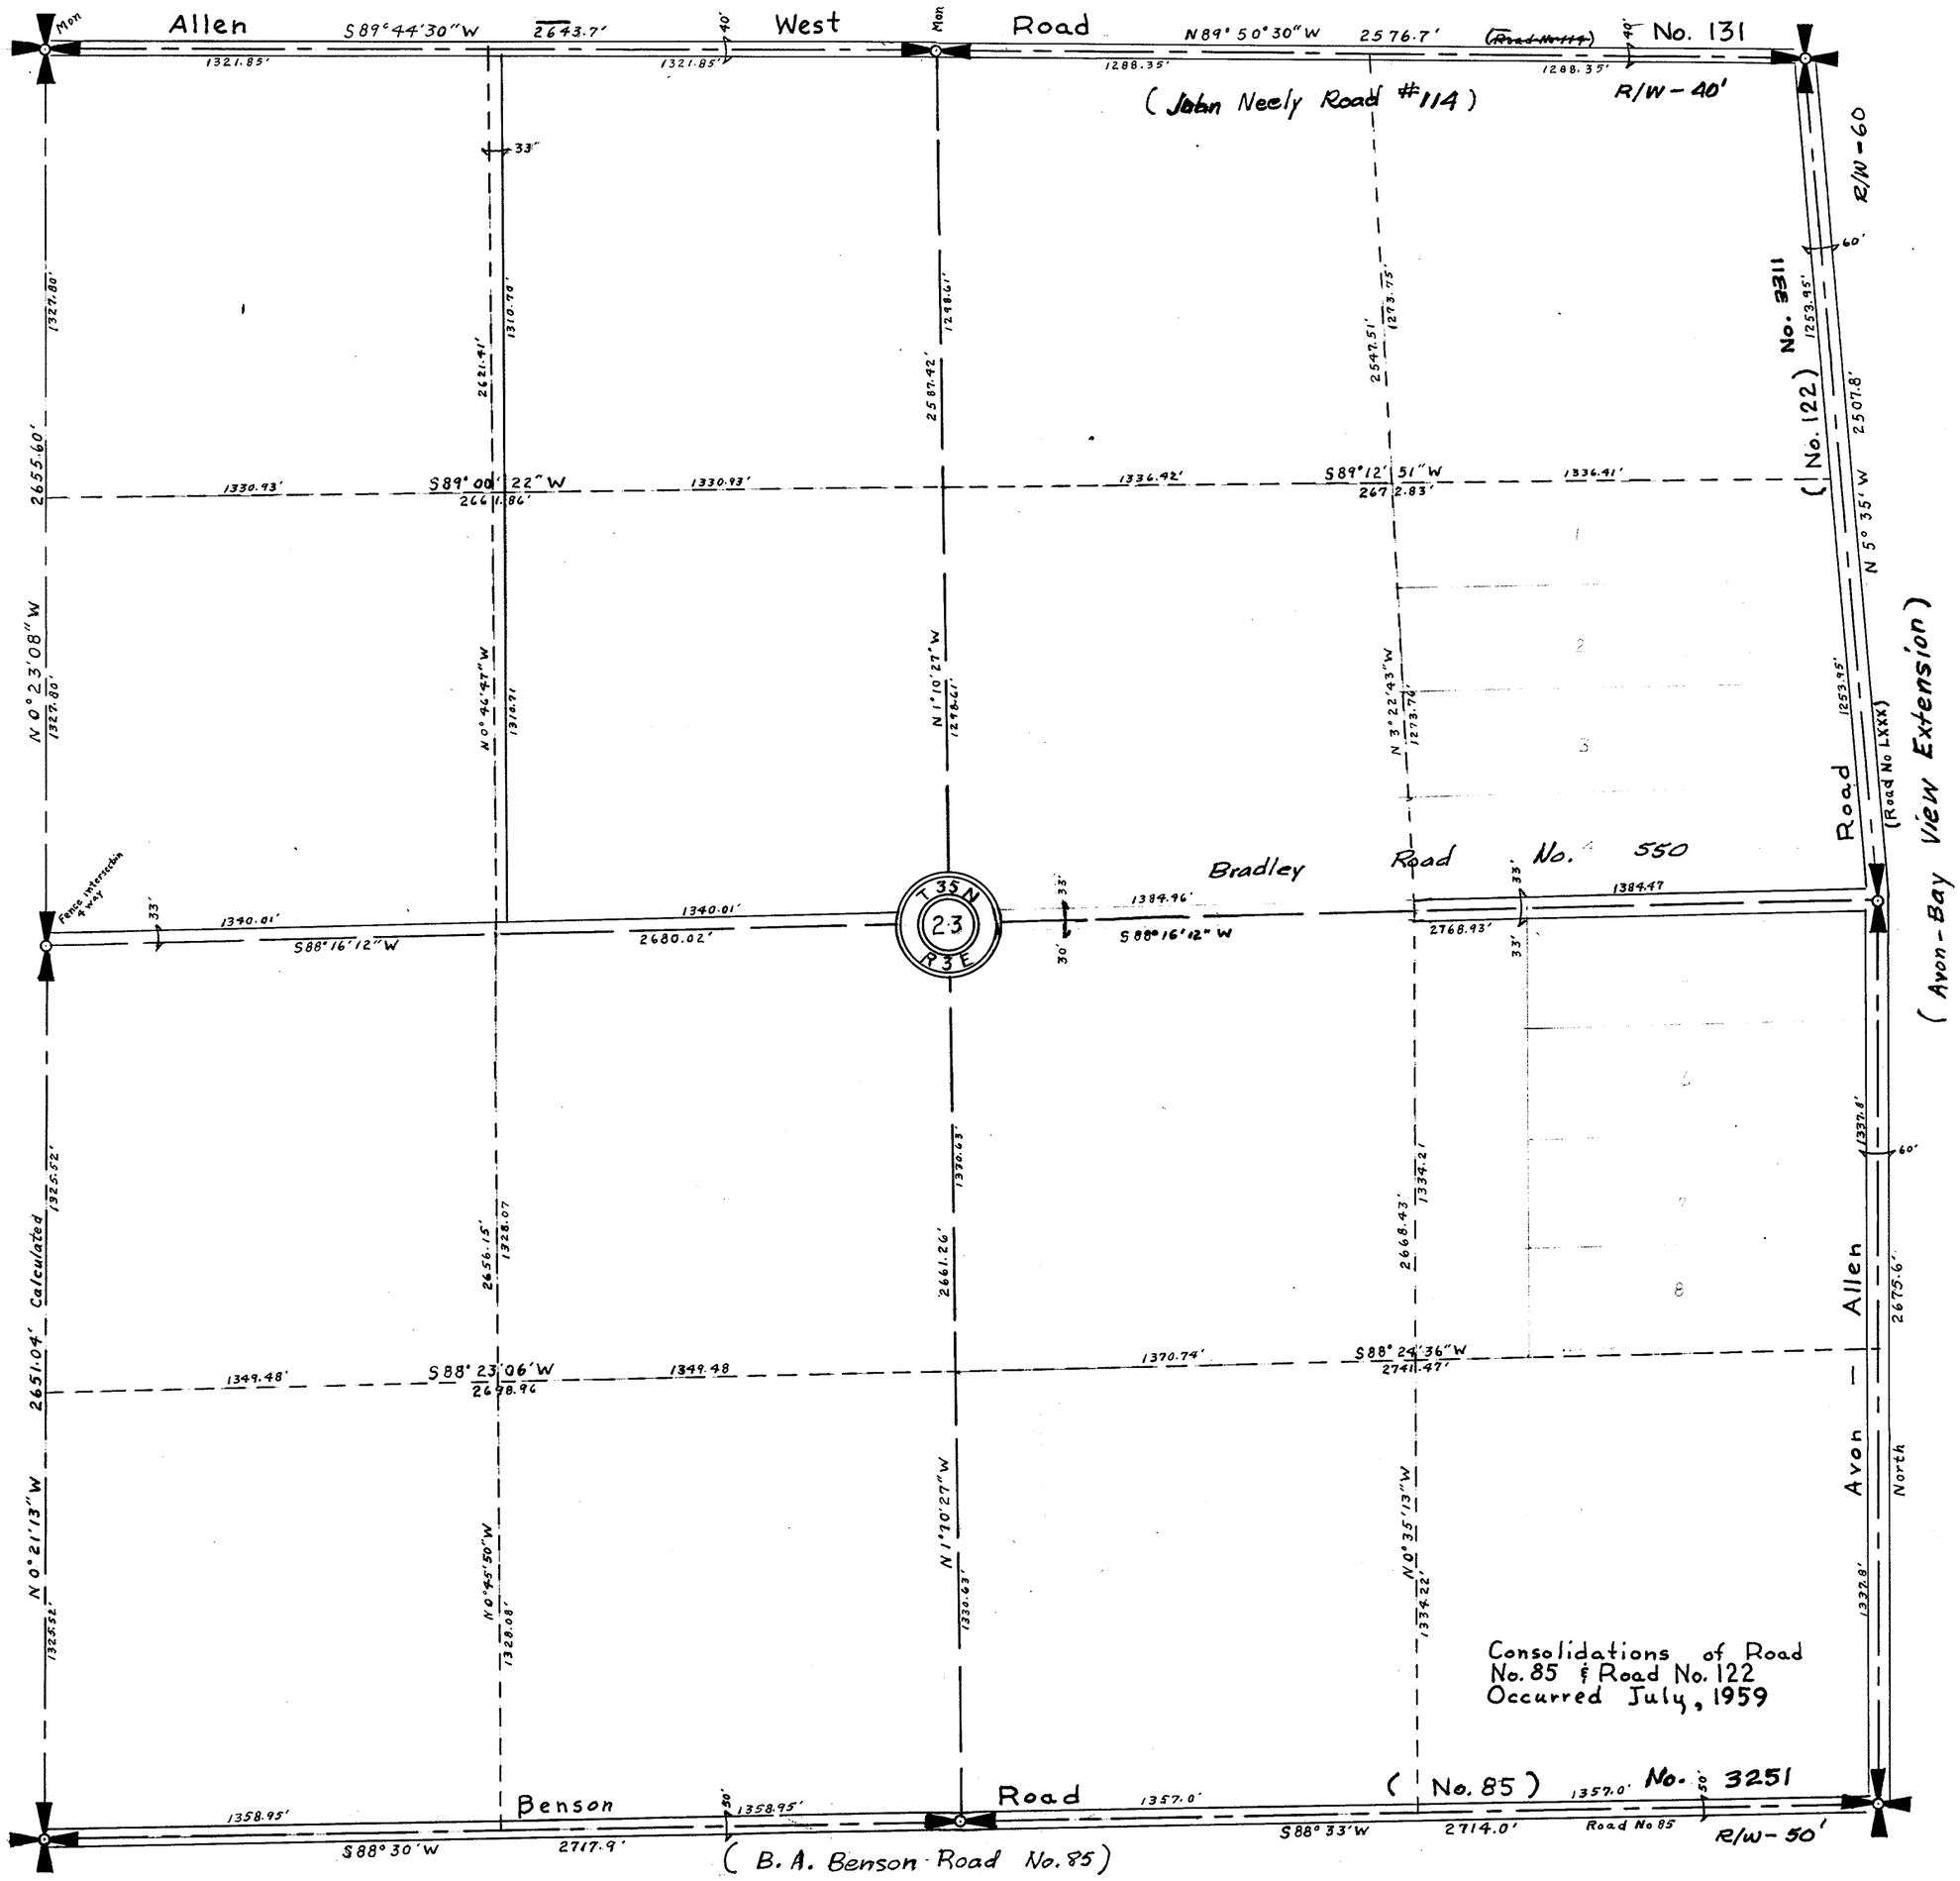

SECTION 23


TOWNSHIP 35 NORTH, RANGE 3 EAST, W. M.

SKAGIT COUNTY, WASH.

SCALE, 1 INCH--400 FEET

DATE Aug. 1965

COUNTY ENGINEER

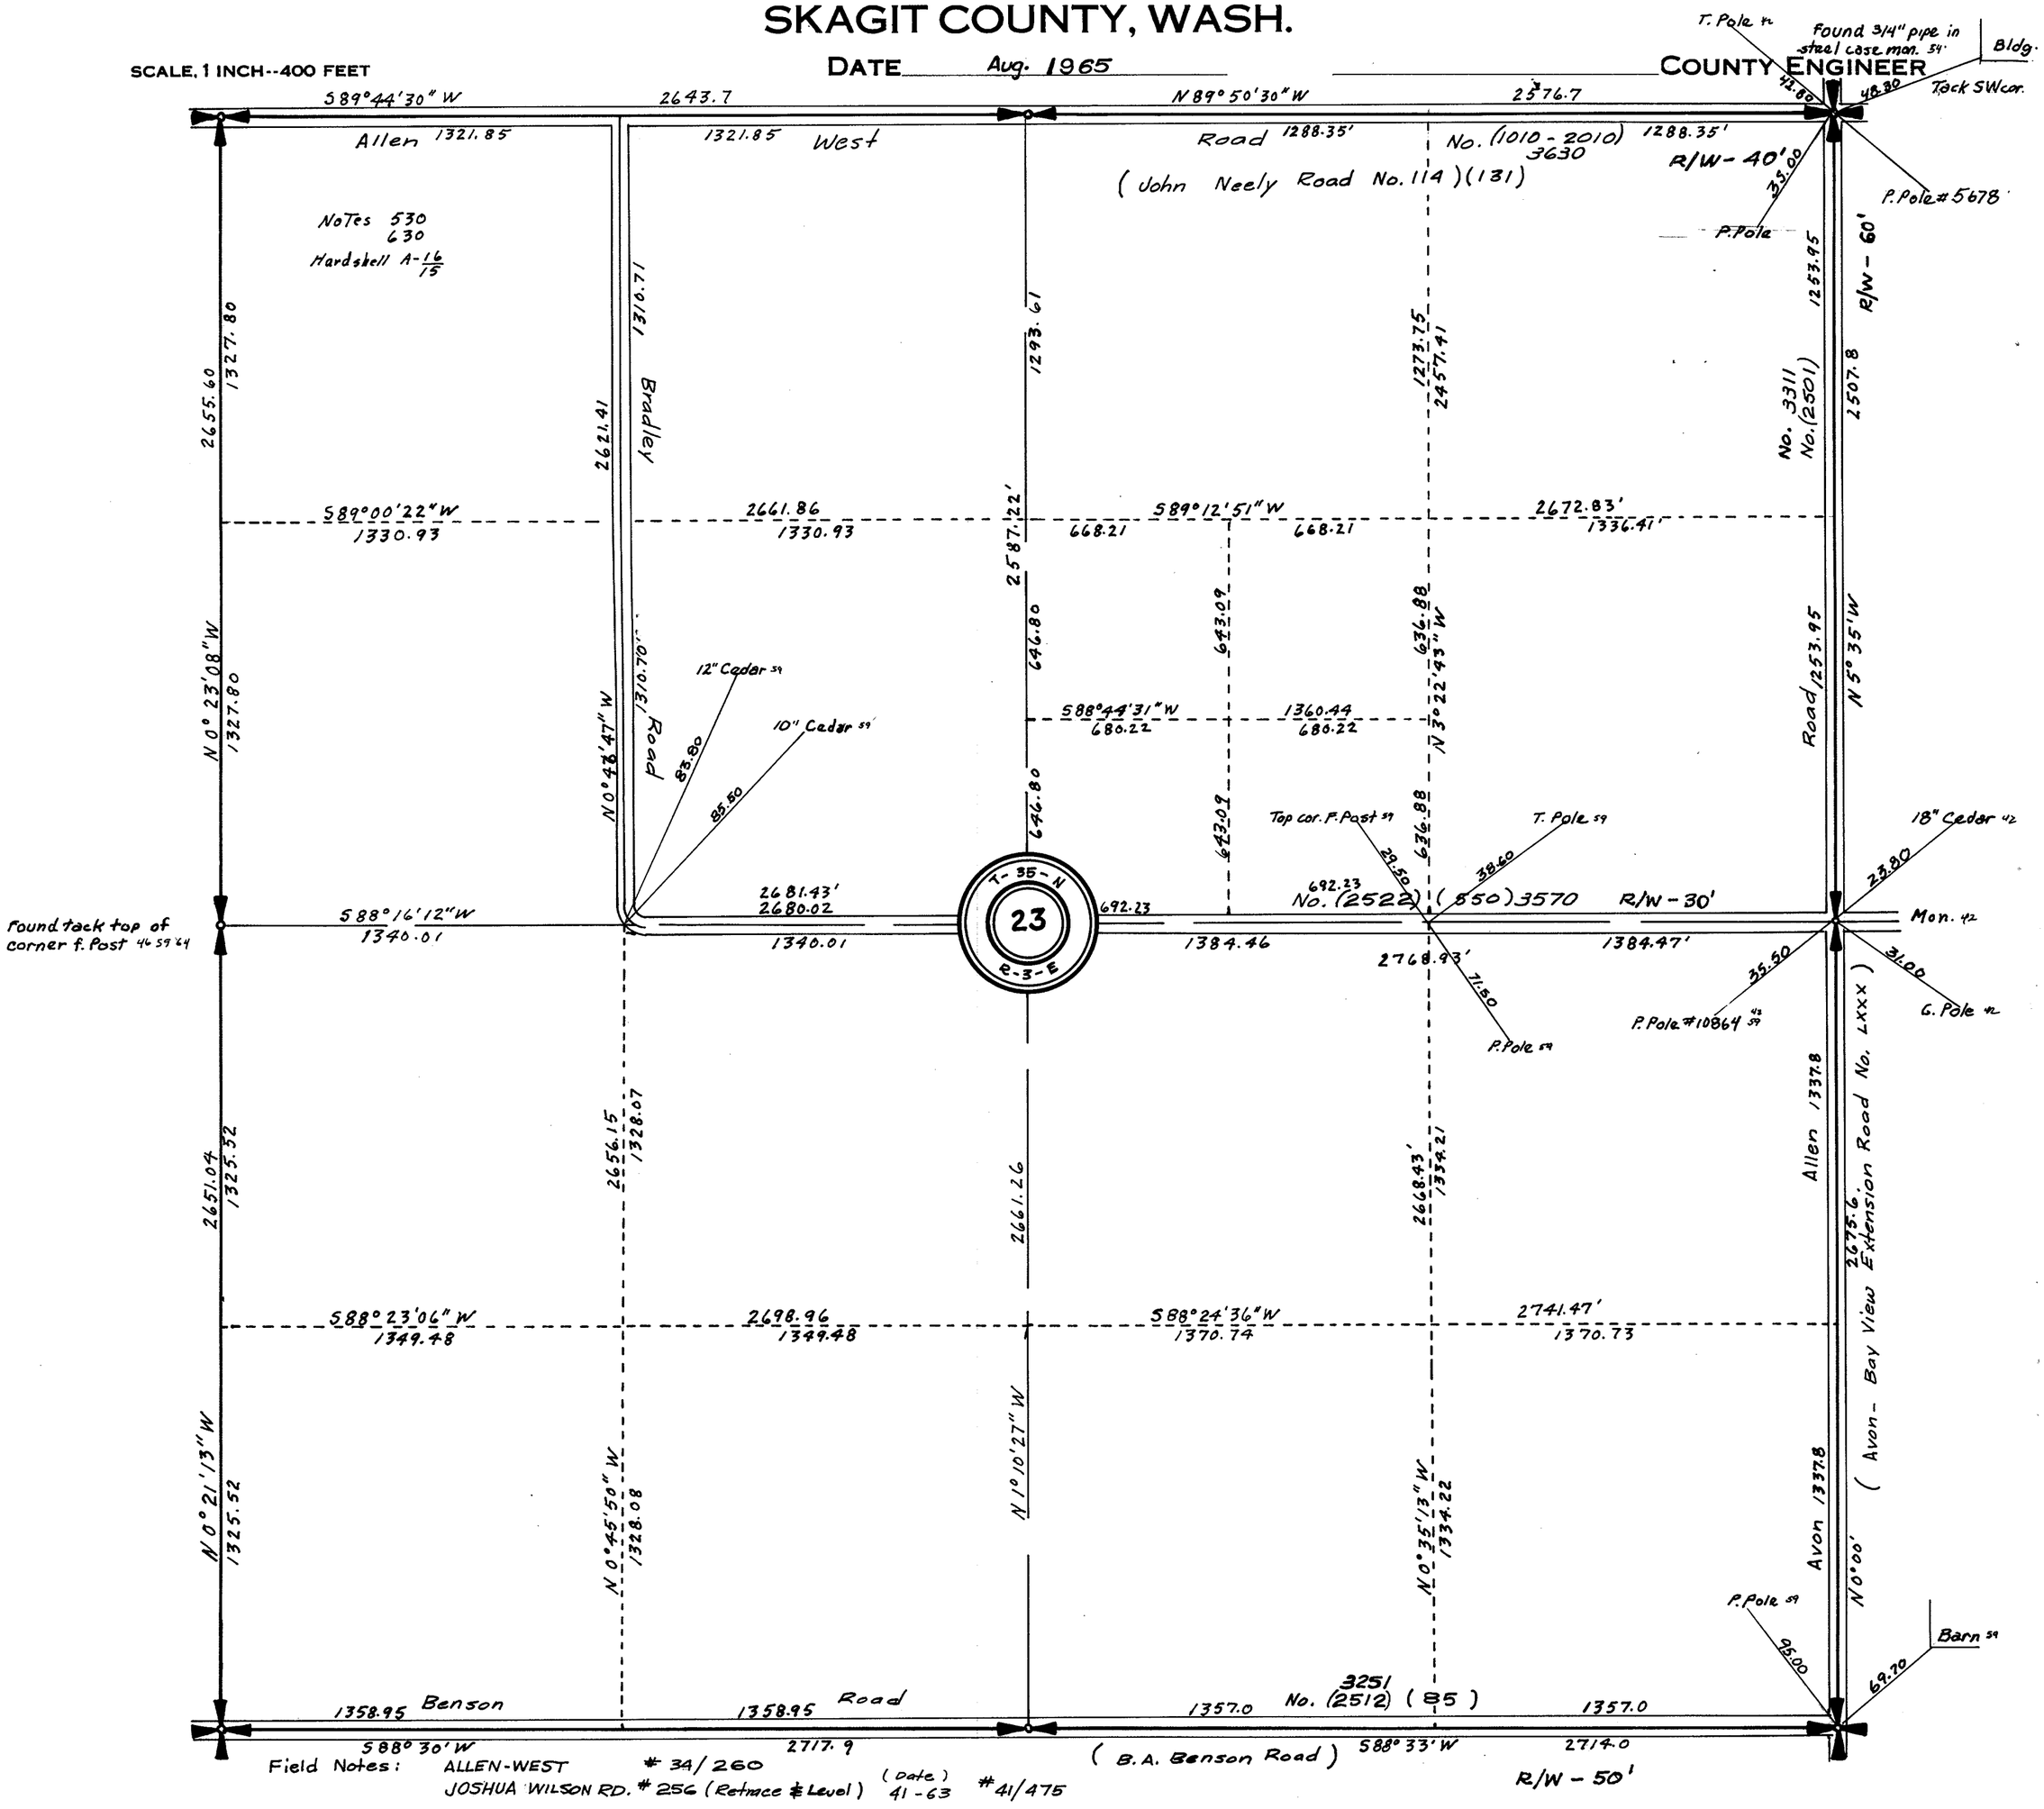

Field Notes: ALLEN-WEST # 34/260


JOSHUA WILSON RD. # 256 (Retrace & Level) (date) 41-63 #41/475

SECTION 24

TOWNSHIP 35 NORTH, RANGE 3 EAST, W. M.
SKAGIT COUNTY, WASH.

SCALE, 1 INCH--400 FEET

Robt. E. L. Knapp 1930 COUNTY ENGINEER

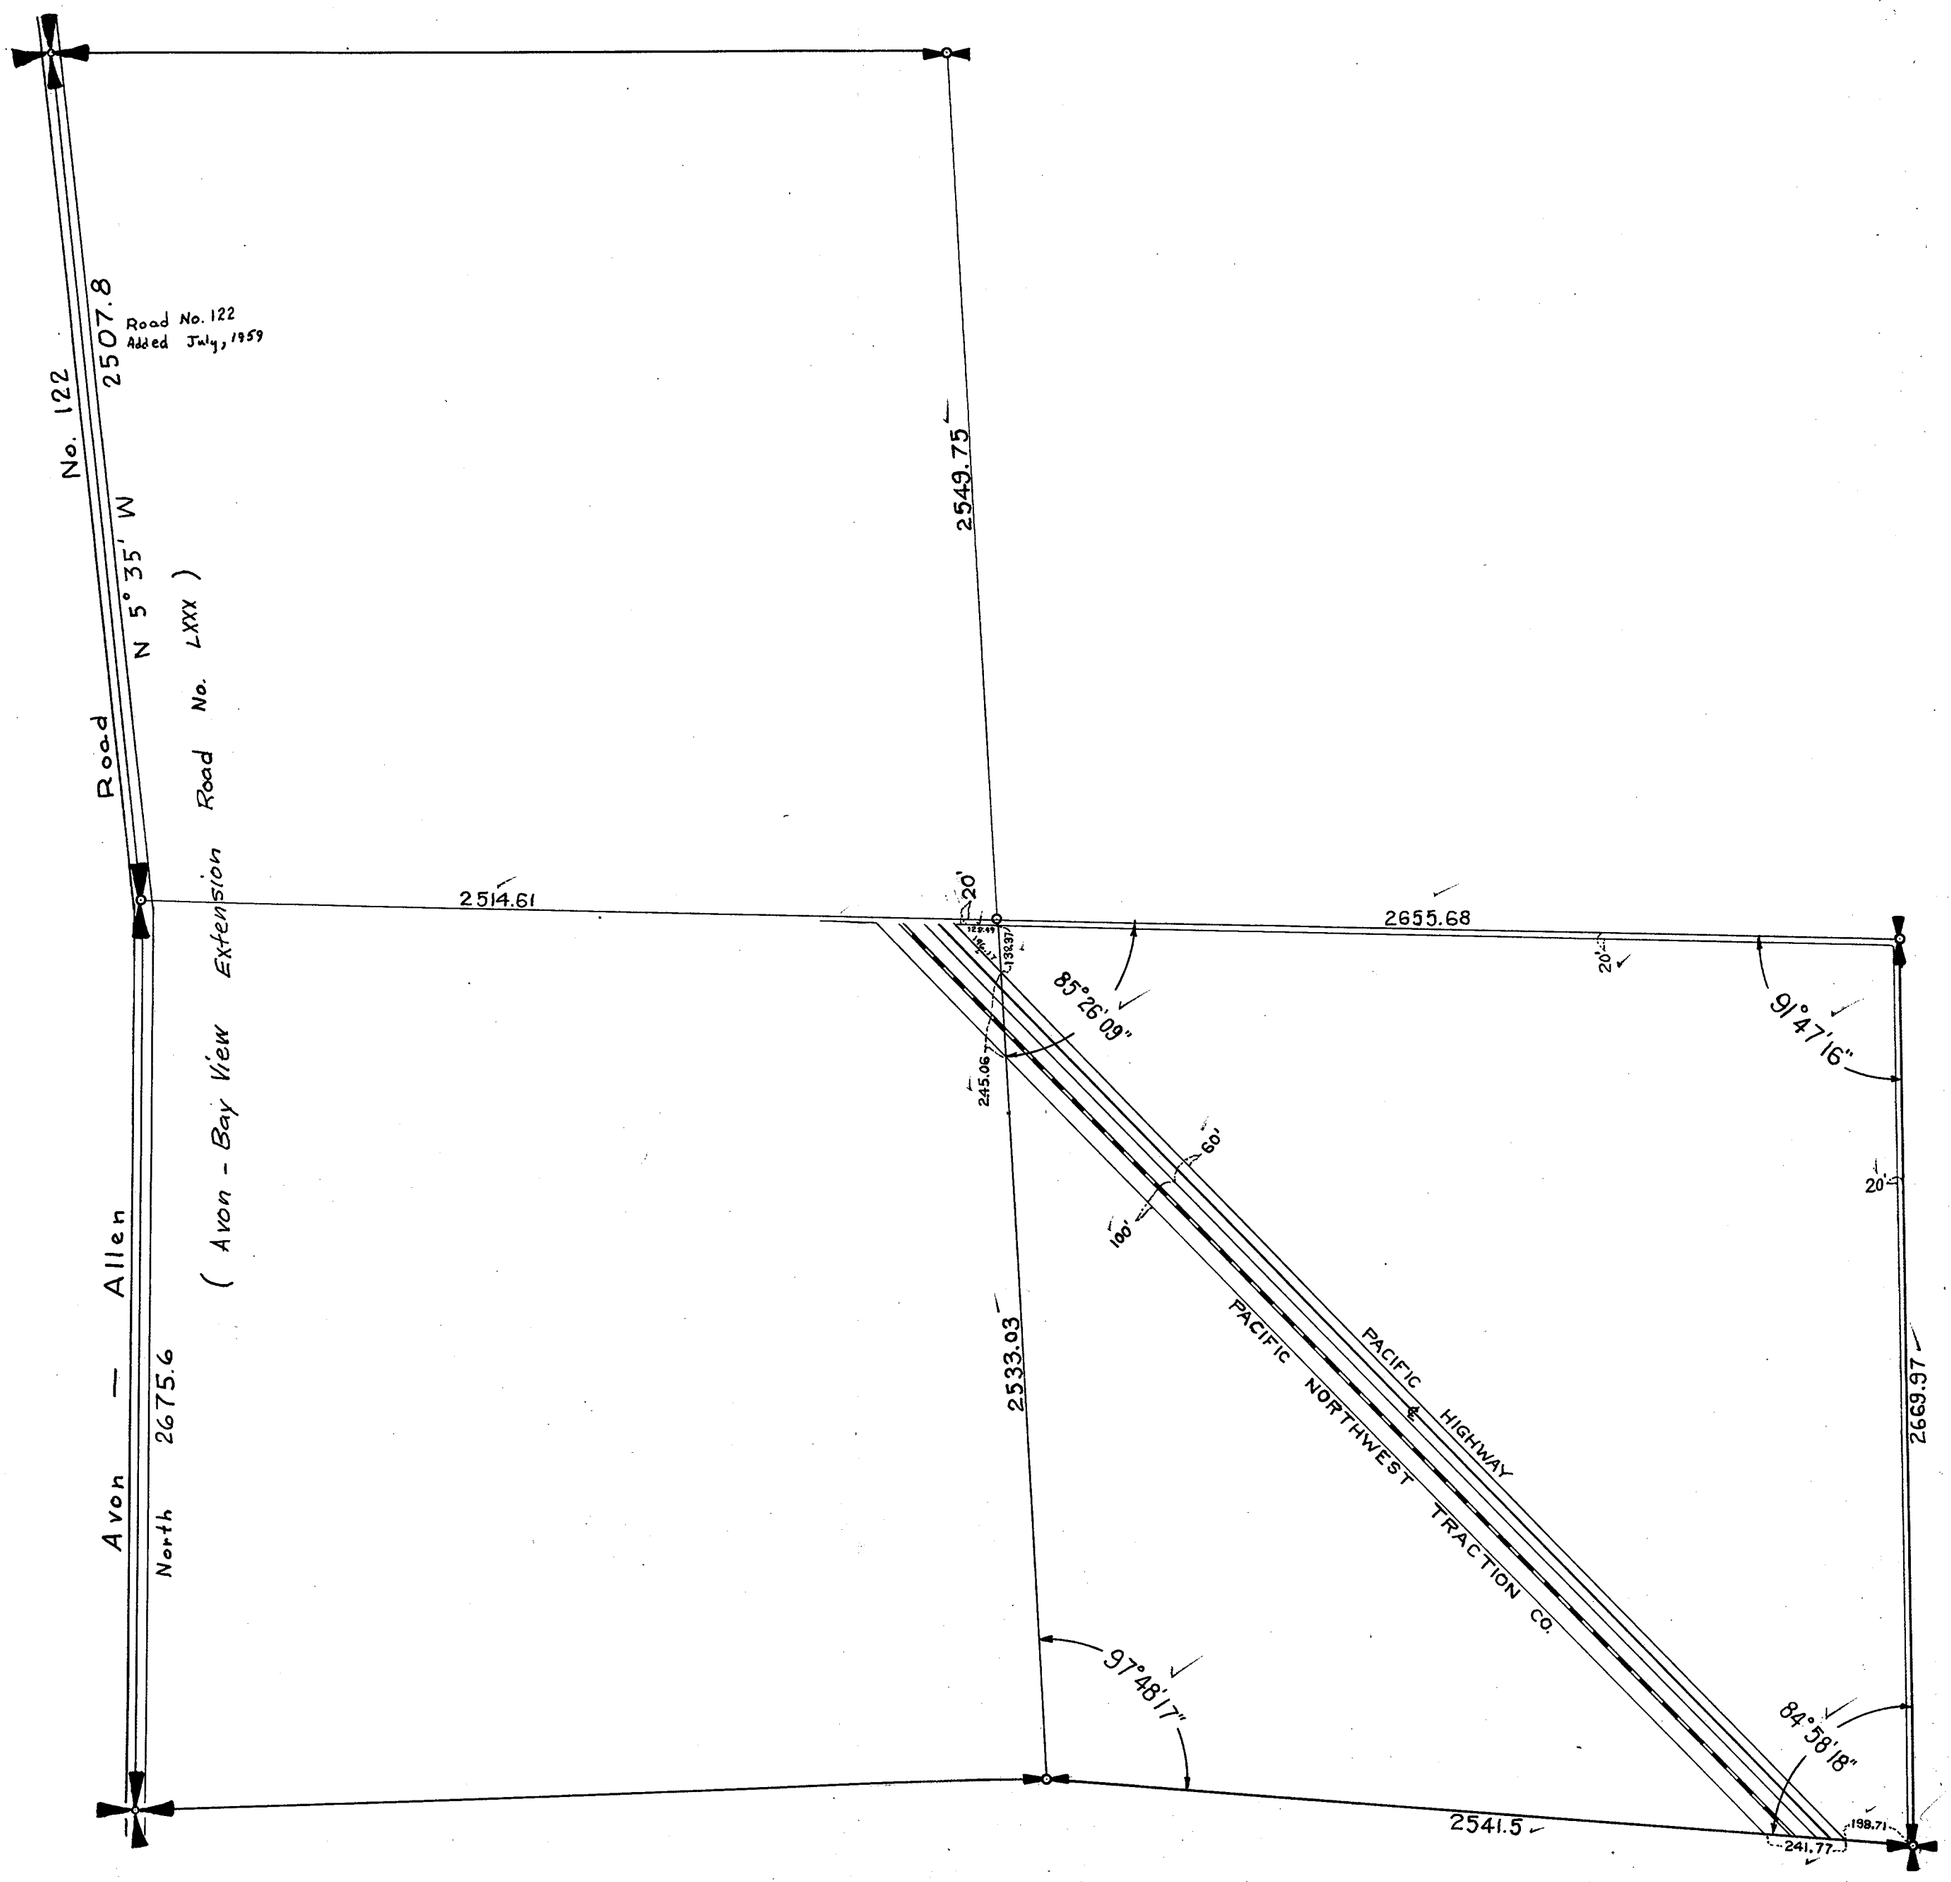



SECTION 24

TOWNSHIP 35 NORTH, RANGE 3 EAST, W. M.
SKAGIT COUNTY, WASH.

SCALE, 1 INCH–400 FEET

W.E. Castello COUNTY ENGINEER

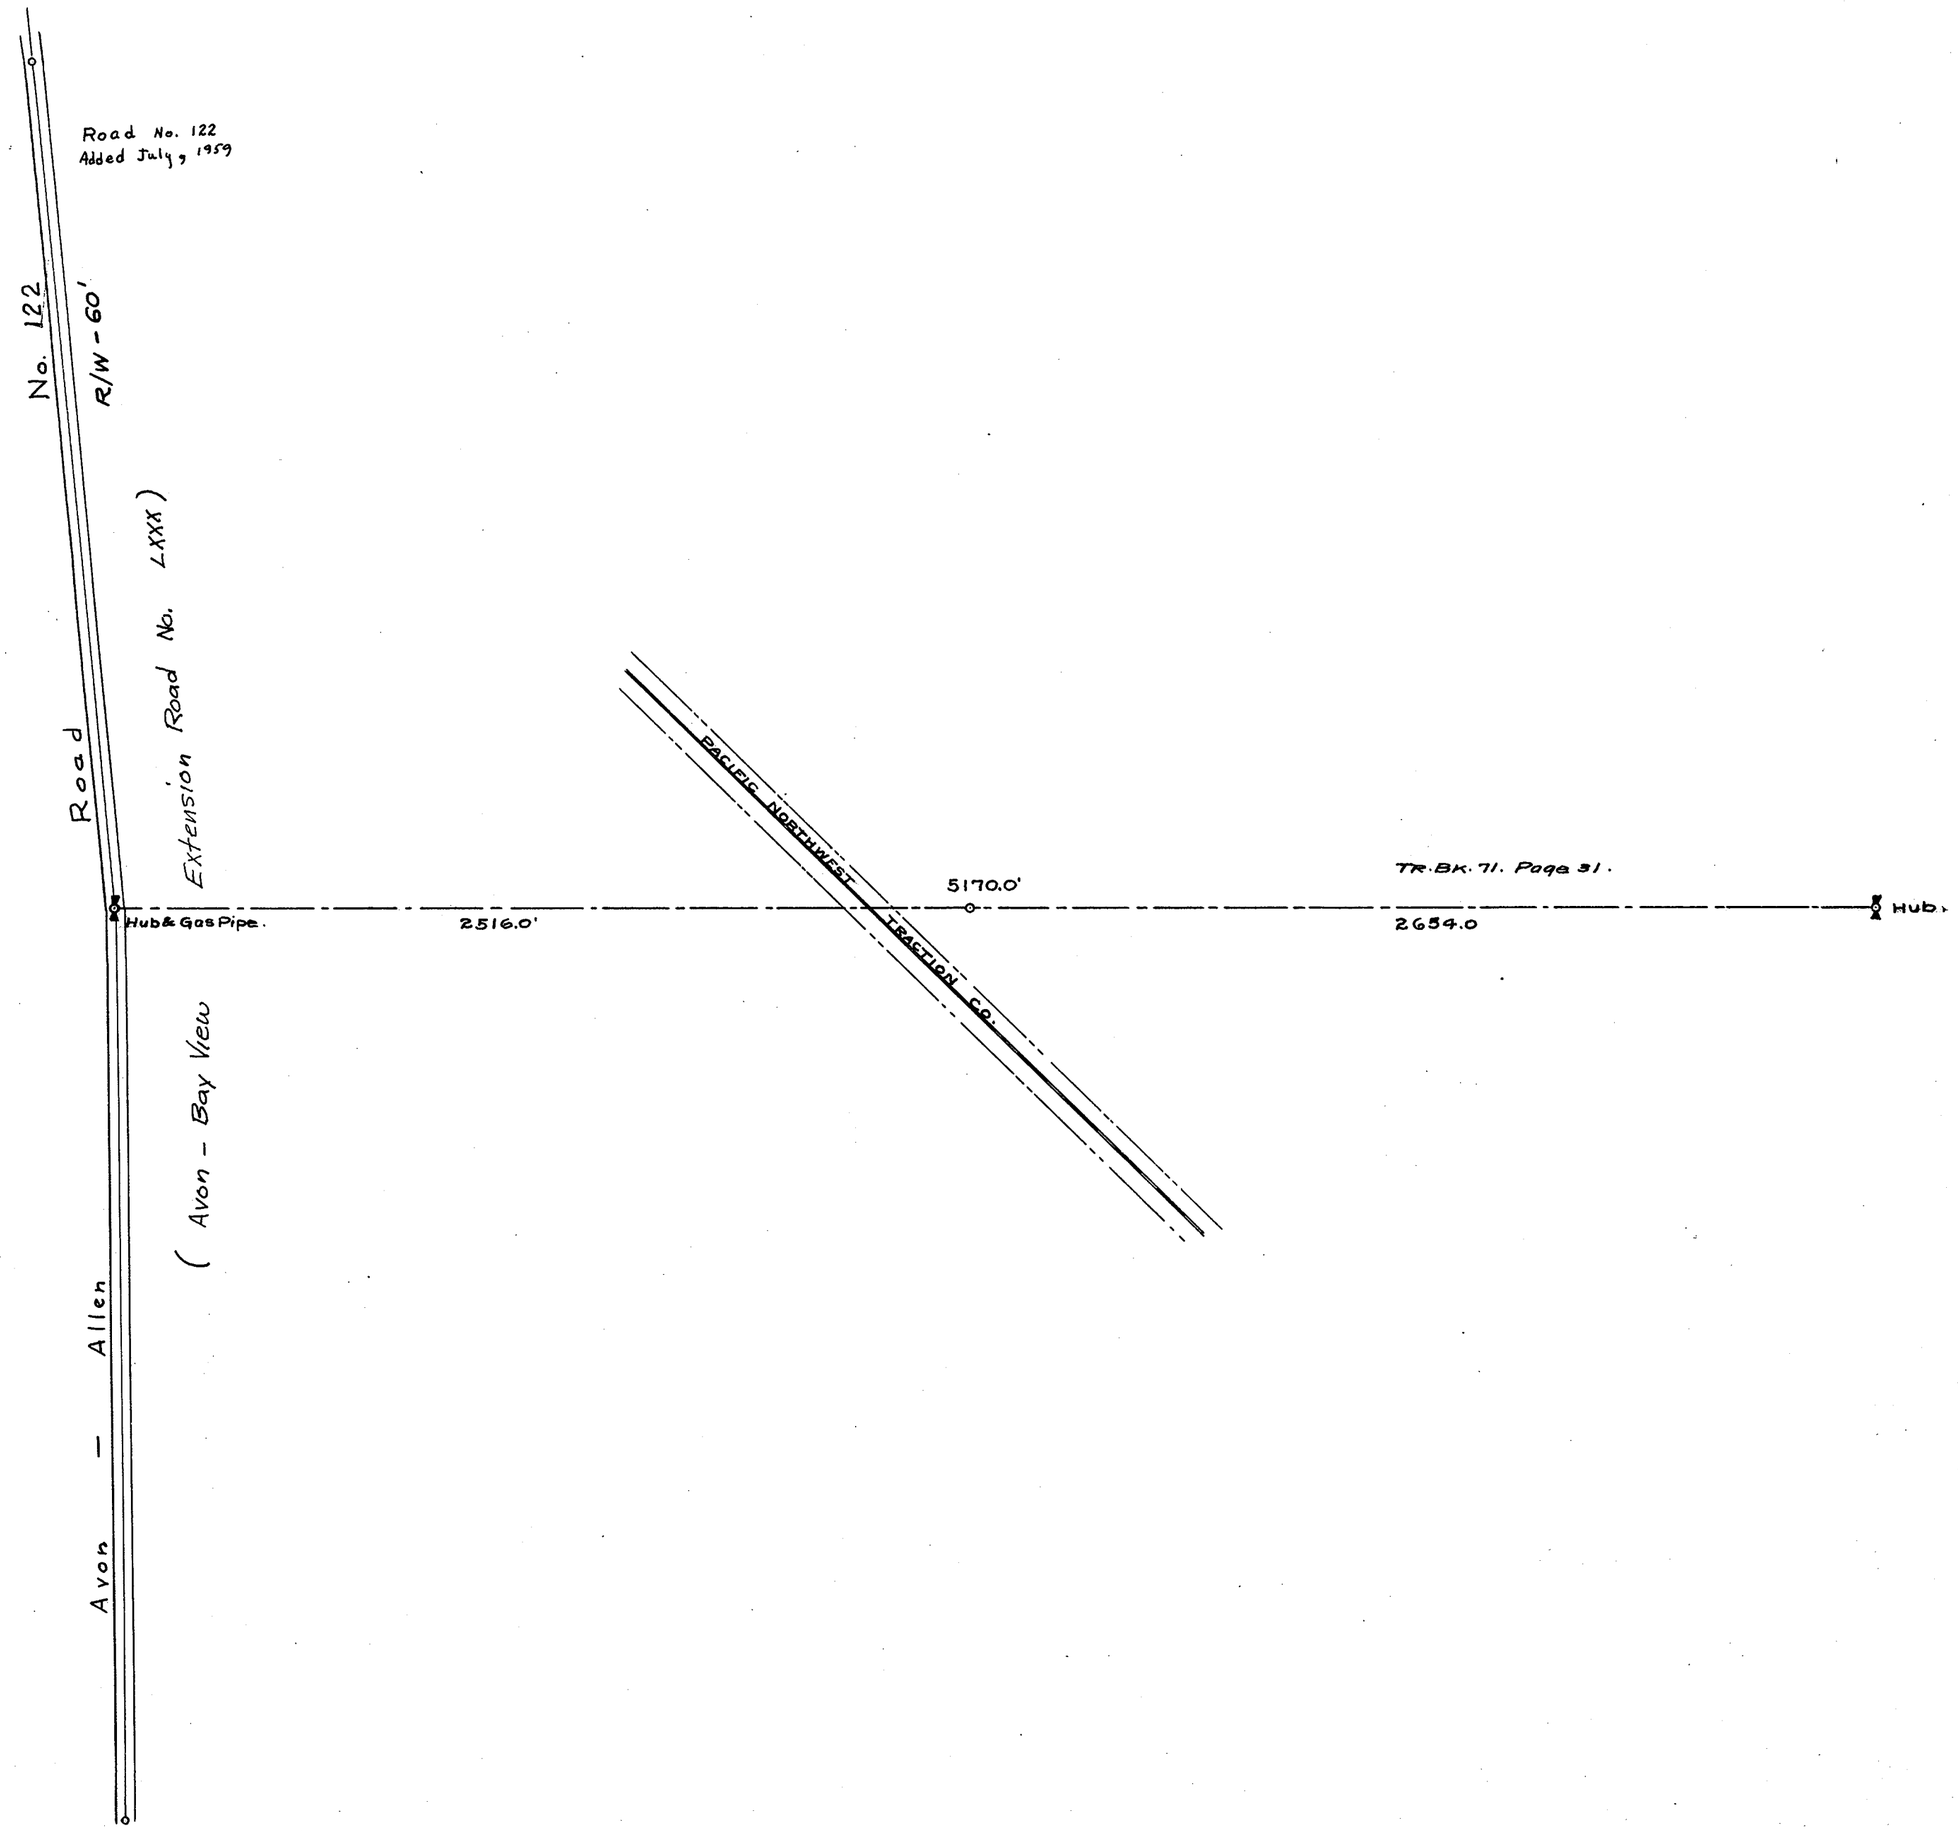

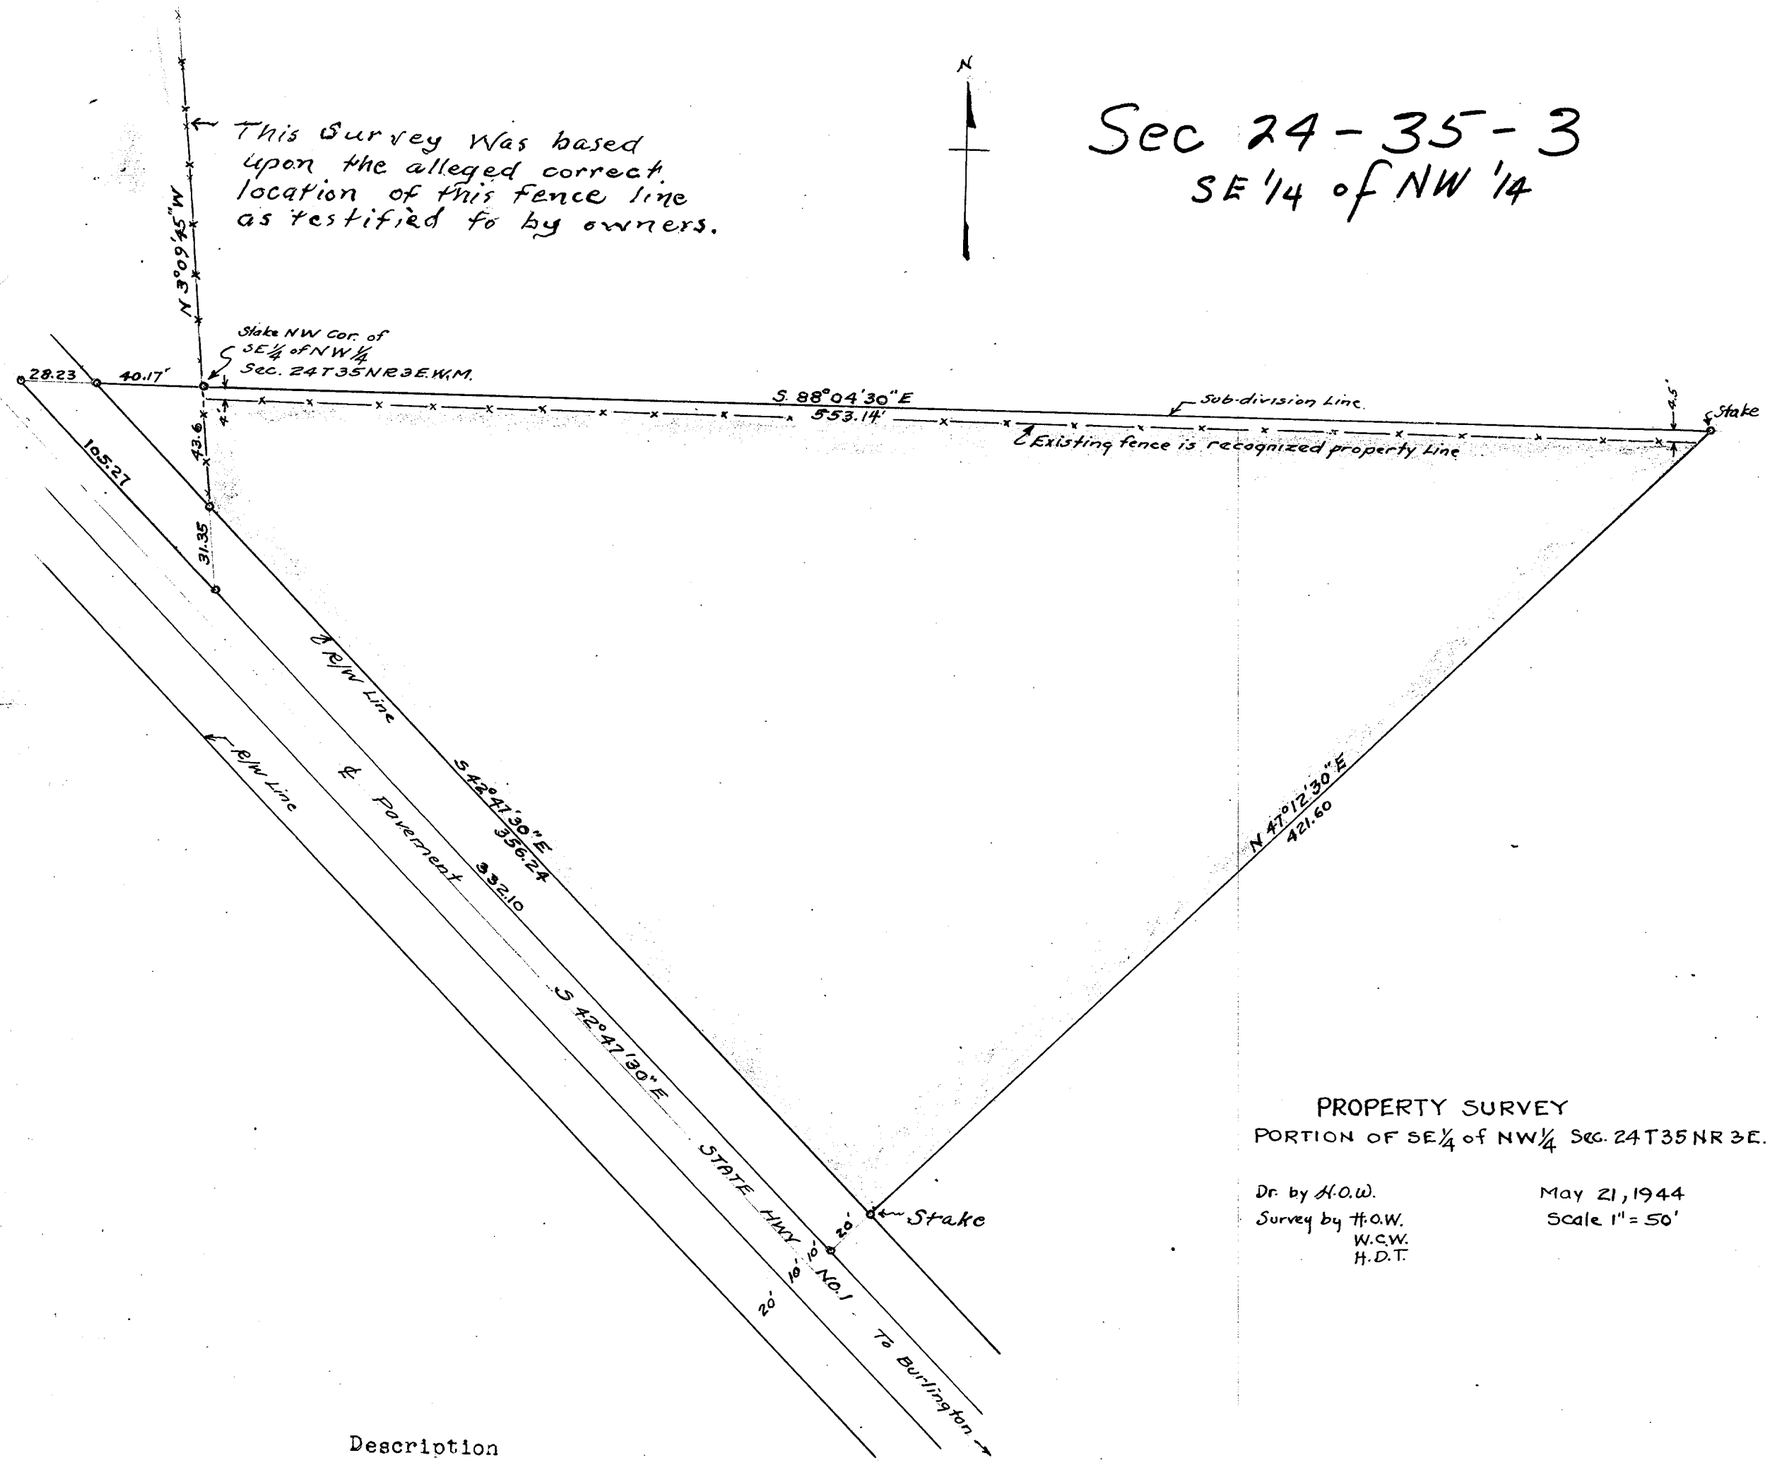

PROPERTY SURVEY

PORTION OF SE¼ of NW¼ Sec. 24 T35 NR 3E.

Dr. by H.O.W. — May 21, 1944

Survey by H.O.W., W.C.W., H.D.T. — Scale 1" = 50'

Description

Beginning at the NW Cor. of SE¼ of NW¼ of Sec 24 T35NR3E., thence S88° 04' 30" E, 553.14 ft., thence s 47° 12' 30" E, 421.60 ft to the State Rd. No. 1 R/W line., thence N42° 47' 30" W 356.24 ft. along aforesaid R/W line,, thence N 3° 09' 45" W, 43.6 ft to the point of beginning. This is the true sub-division description. However, the north boundary of this property is the existing fence which is the recognized property line by local owners. The property line diverges south from the subdivision line on the east end 4.5ft and on the west side by 4 ft. Total area inside of property lines is 1.95 acres.

H.O. Walberg Reg. No. 1677 E 318
Lic. Prof. Engineer

W. C. Whitnall Reg. No. 1477 E 61


SECTION 24

TOWNSHIP 35 NORTH, RANGE 3 EAST, W. M.

SKAGIT COUNTY, WASH.

SCALE, 1 INCH--400 FEET

DATE July, 1959 Frank Gilkey COUNTY ENGINEER

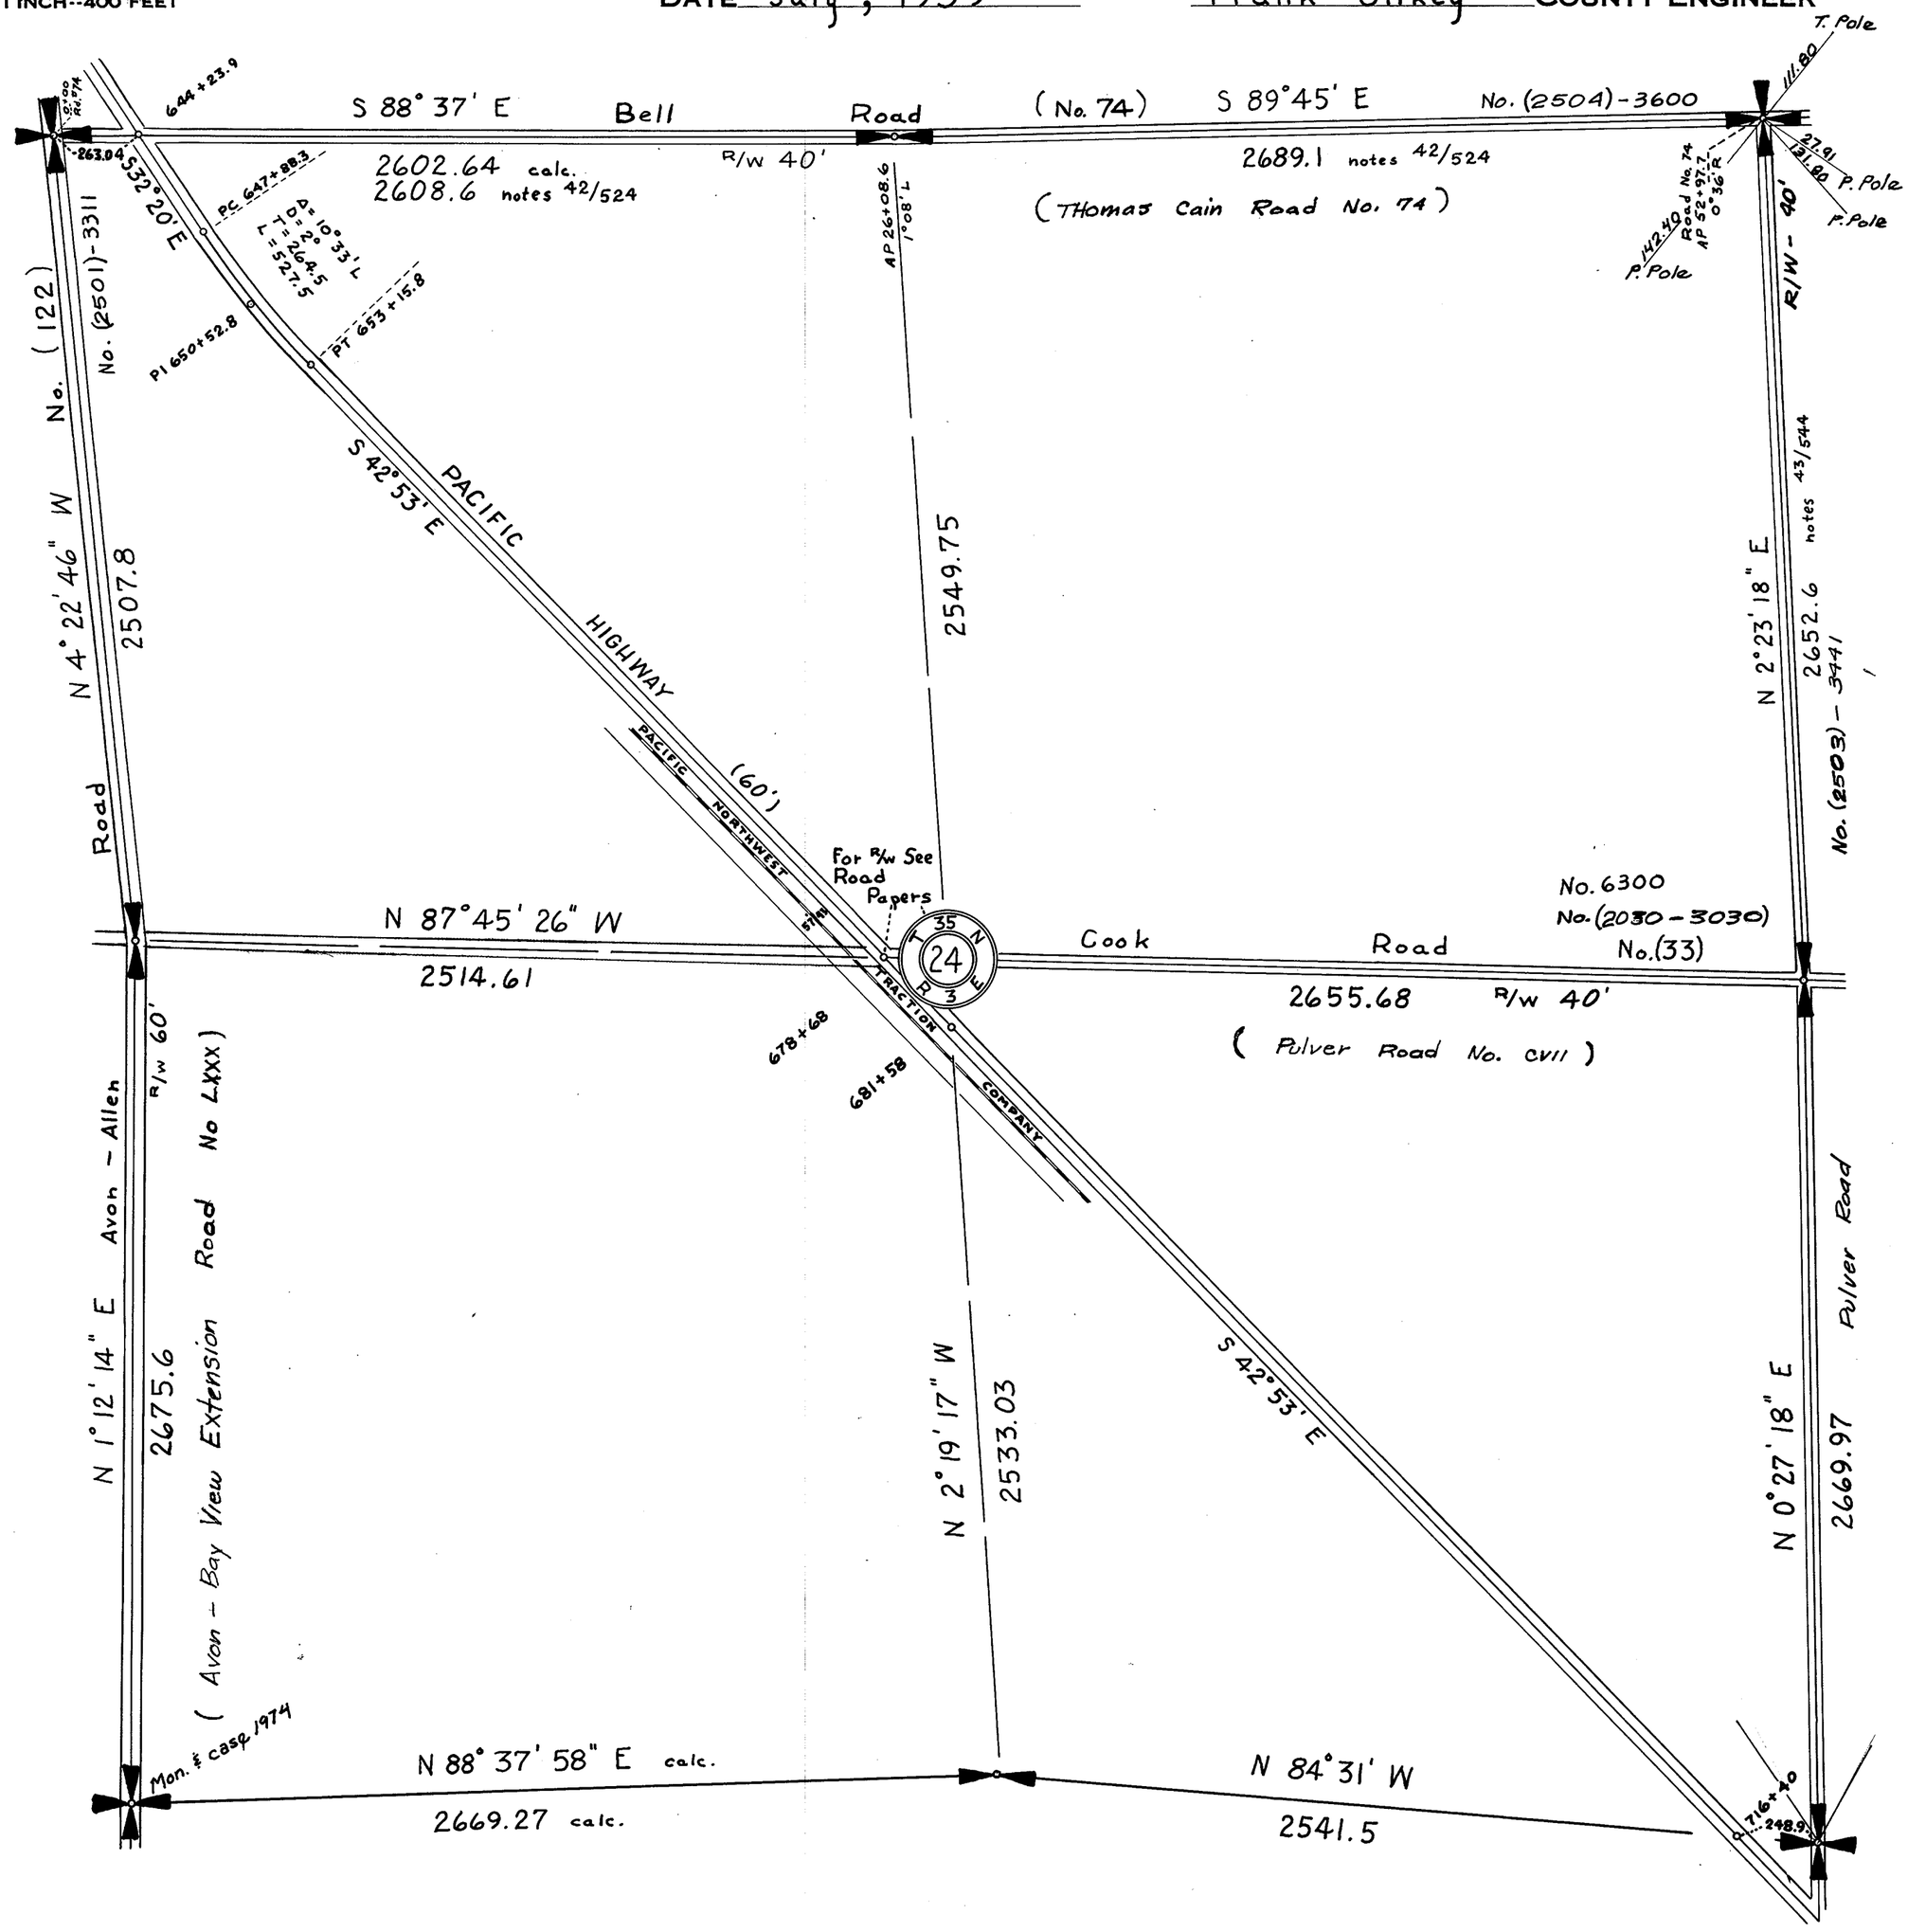


SECTION 25

TOWNSHIP 35 NORTH, RANGE 3 EAST, W. M.
SKAGIT COUNTY, WASH.

SCALE, 1 INCH–400 FEET

Frank Gilkey COUNTY ENGINEER
June, 1959

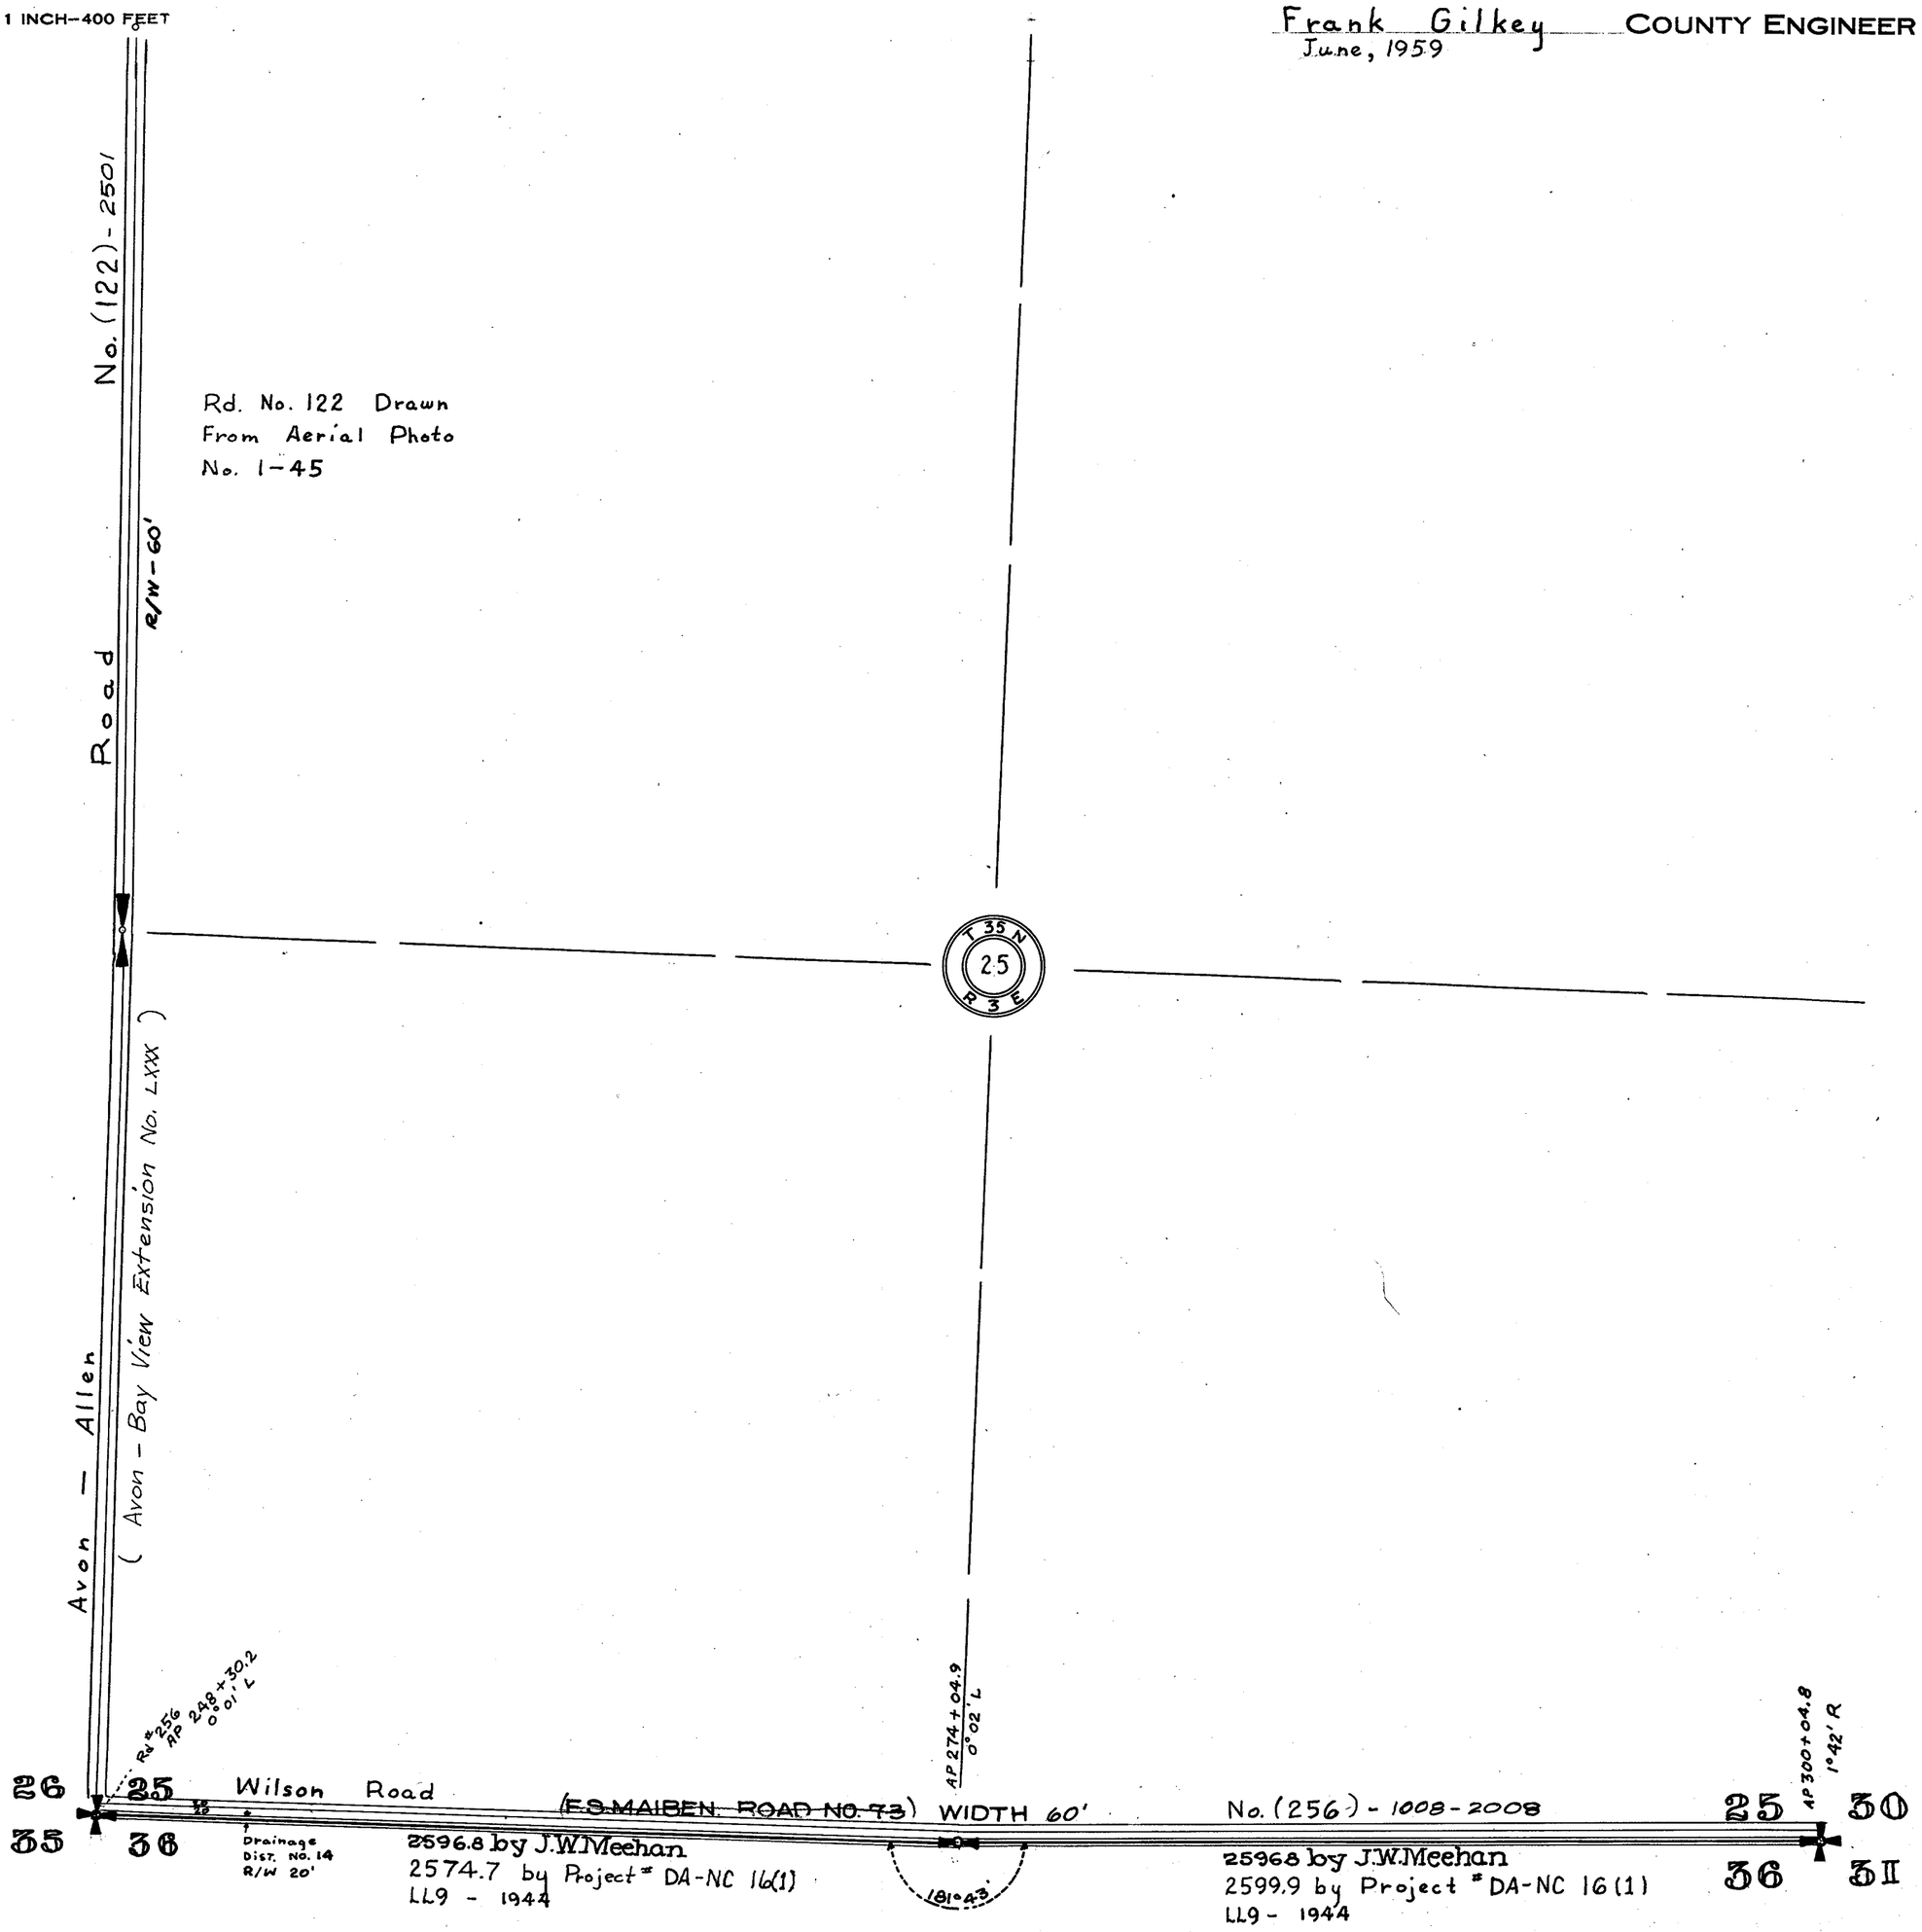

SECTION 25

TOWNSHIP 35 NORTH, RANGE 3 EAST, W. M.

SKAGIT COUNTY, WASH.

SCALE, 1 INCH--400 FEET

DATE Aug. 1965

COUNTY ENGINEER

N 89°16'10" E 2661.15 N 84°16'50" W 2541.5

Mon. & case 1974

Notes 530
672
Hardshell A-11/6

U.S. HWY. 11

2701.90

No. 3311 (# 2501)

R/W - 60'

Mon. from notes: 1044

Road N 0°32' E

No. (2503)-(CLI)-3441 R/W - 40'

2422.2'

N 1°10'30" E

Boat Spike

C.E. Maiben Road

No. (2510) (121) 3330 R/W - 30'

S 88°04'30" E

T-35-N
25
R-4-E

Allen 2728.0

(Avon & Bay View Extn. No. LXXX)

N 1°04'50" E Avon

Road

2655.0

River

N 0° 53' E

P. Pole

54.77

G. Pole

18.90

P. Pole 50.47

Wilson Road

No. (1008 - 2008) (No - 73) 3300

N 88°52' W 2575.0 R/W - 30'-45'-60' (F.S. Maiben Road) N 88°54' W 2601.7

34.61

G. Pole

27.14

P. Pole

Field Notes: Bridge #85 1949 #672
Naval Airfield Access 1944 LL-9
Bridge #274 - Road #CLI 1954 #824

GEN. NOTE: THIS TRACING DRAWN FROM AERIAL PHOTO

SECTION 26


TOWNSHIP 35 NORTH, RANGE 3 EAST, W. M.

SKAGIT COUNTY, WASH.

SCALE, 1 INCH--400 FEET

DATE June 21, 1963

COUNTY ENGINEER

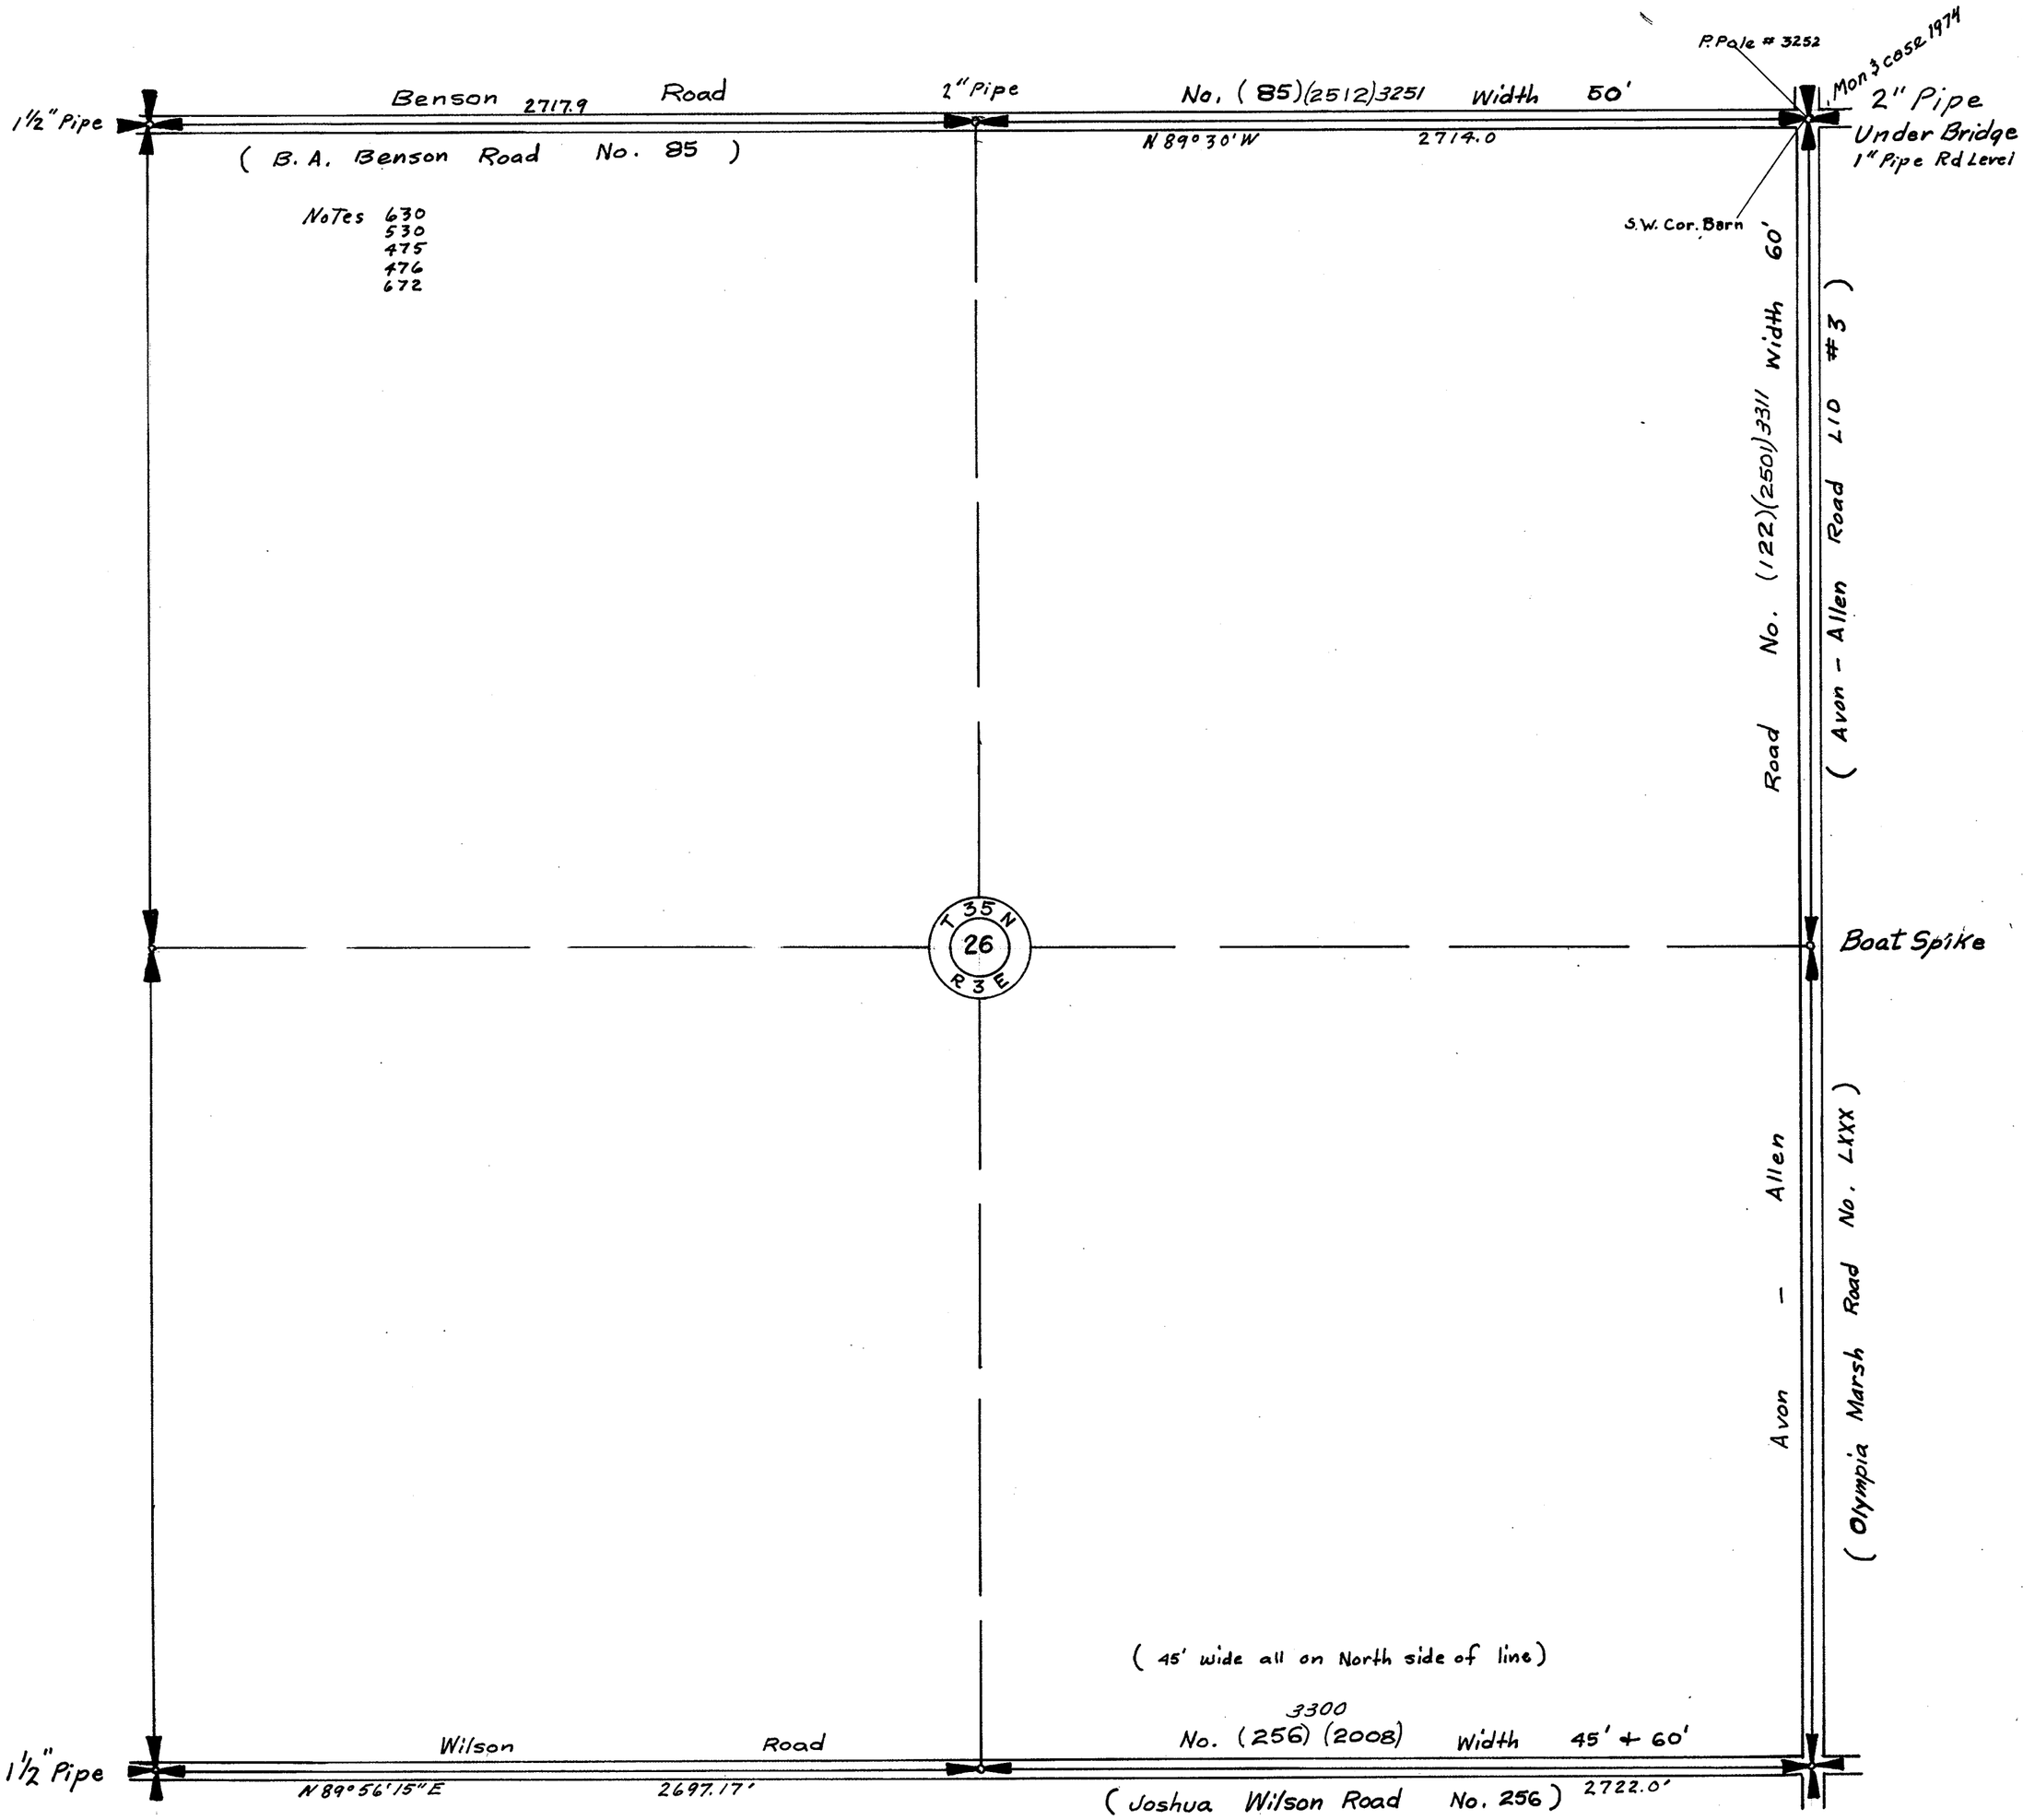


SECTION 27

TOWNSHIP 35 NORTH. RANGE 3 EAST. W. M.
SKAGIT COUNTY. WASH.

SCALE, 1 INCH--400 FEET

A. L. STRONG COUNTY ENGINEER

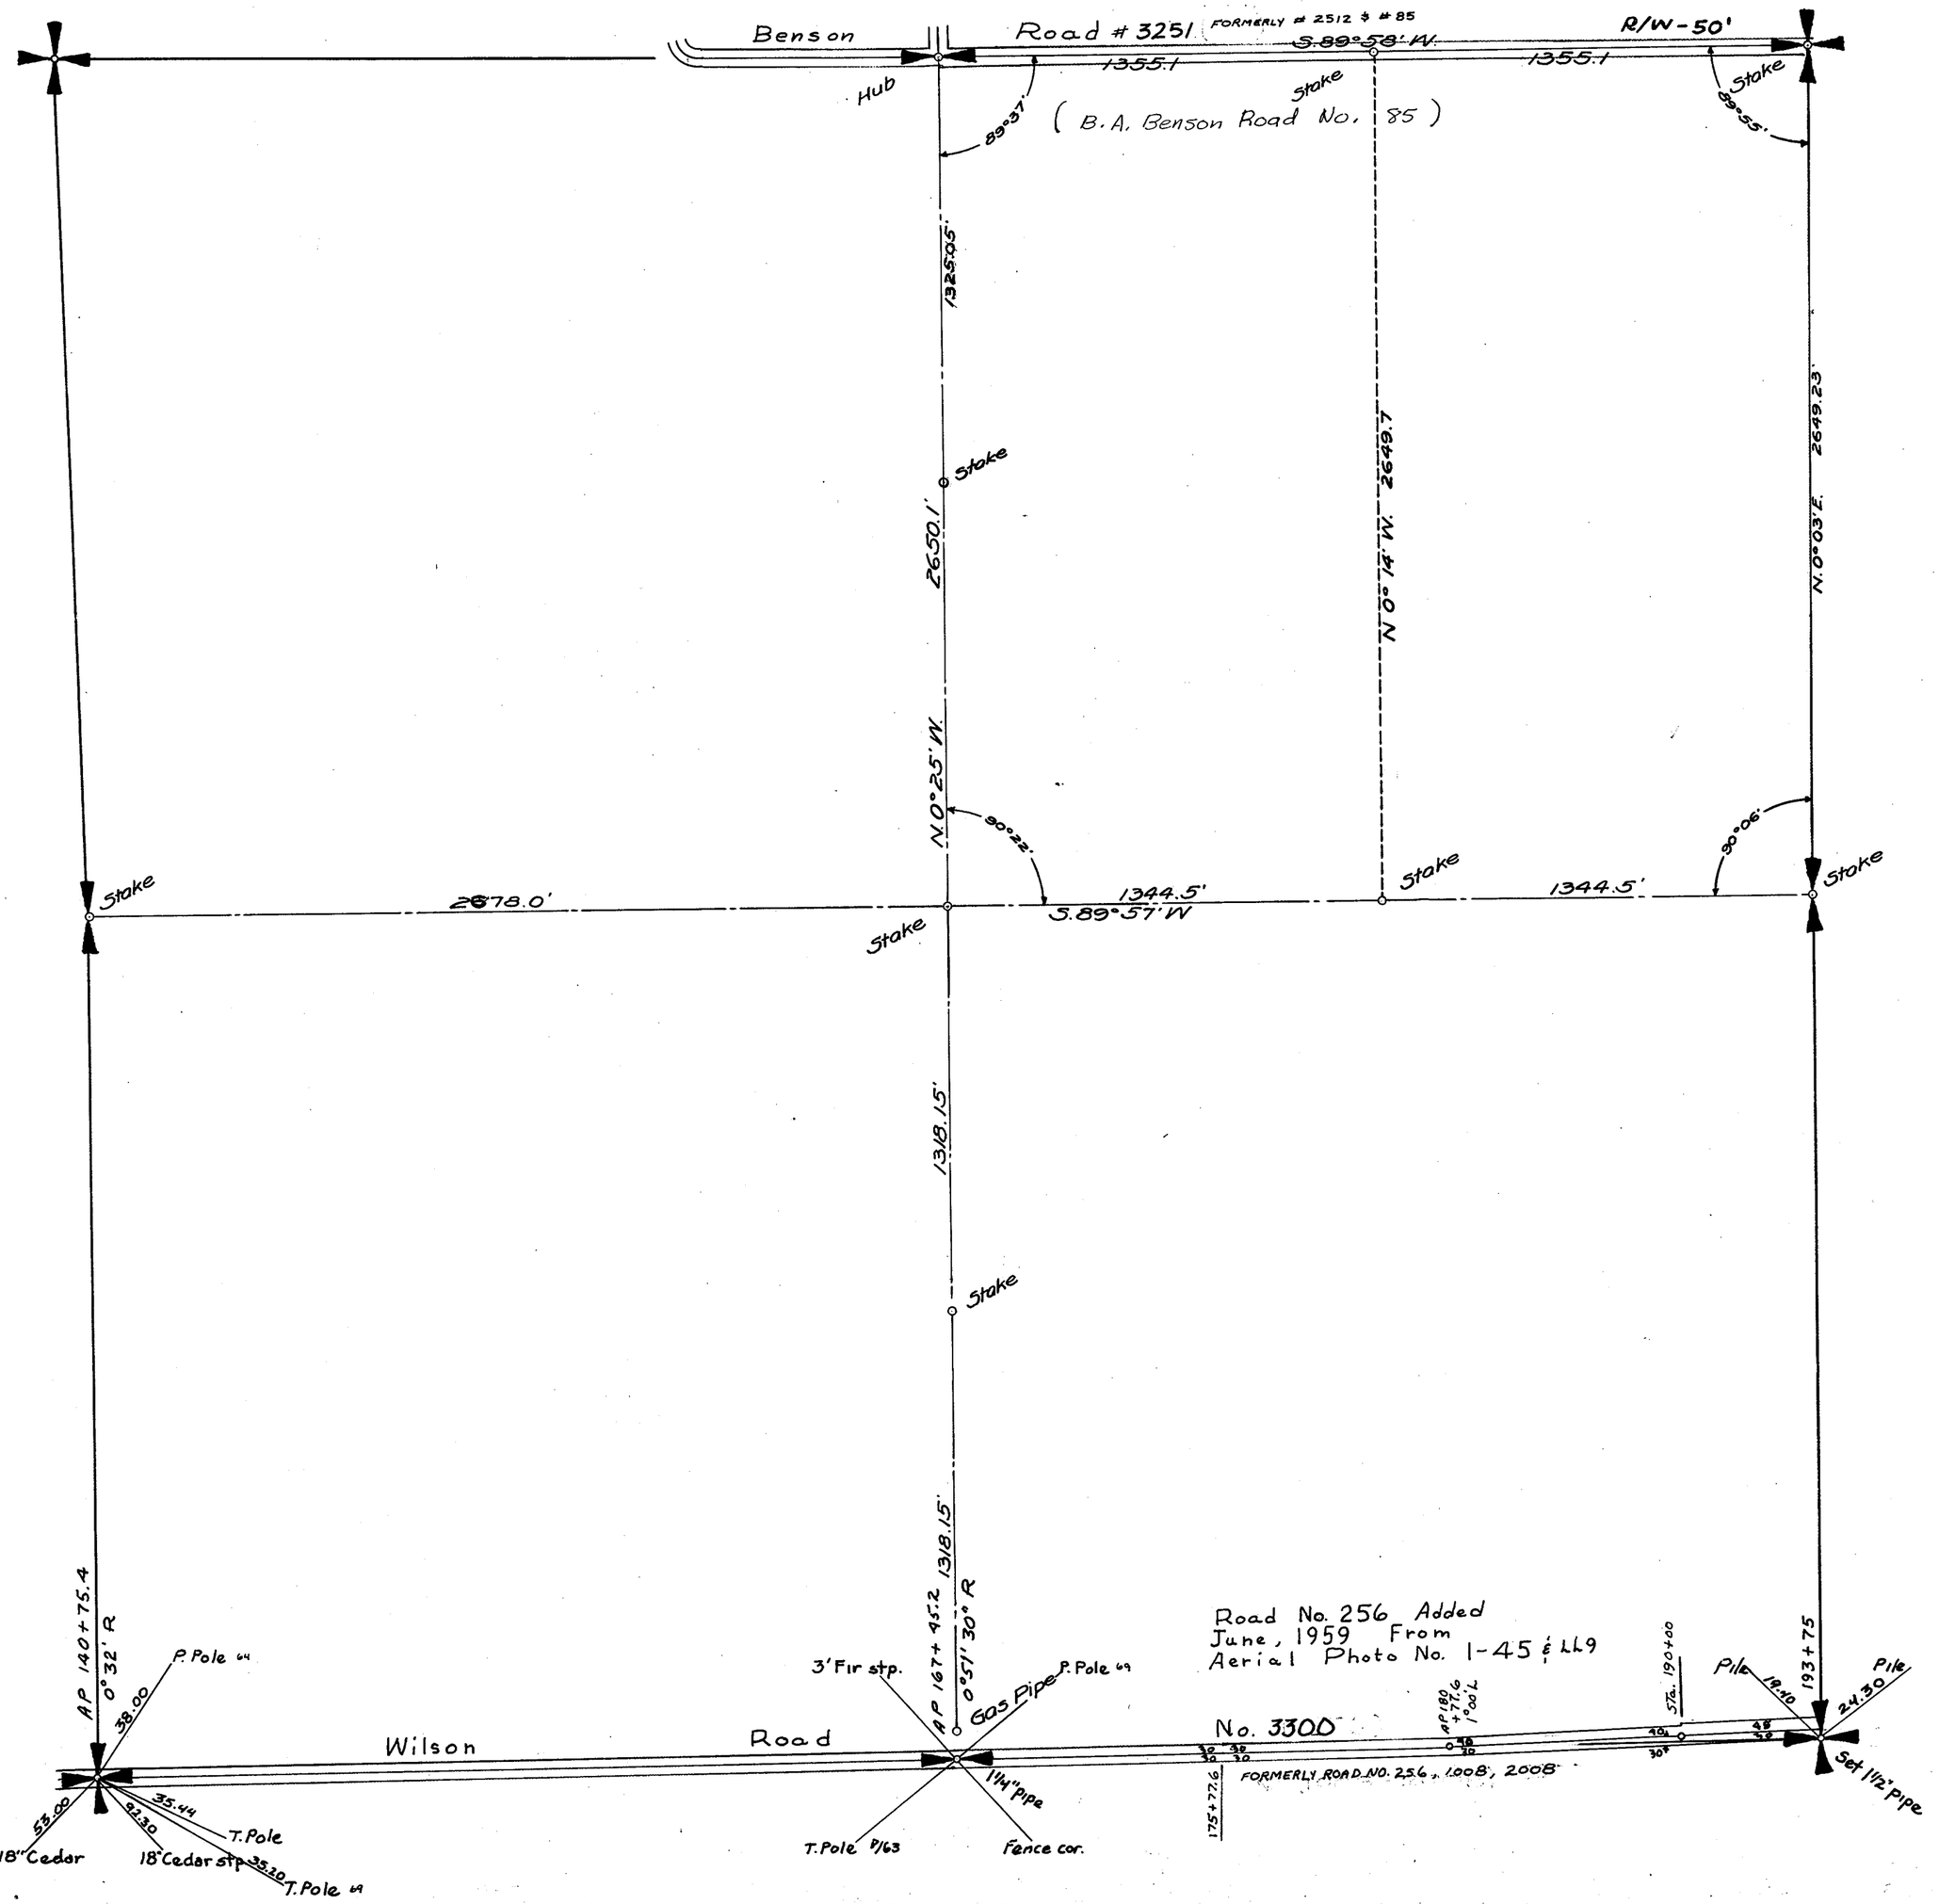

Notes: 475


SECTION 28

TOWNSHIP 35 NORTH, RANGE 3 EAST, W. M.

SKAGIT COUNTY, WASH.

SCALE, 1 INCH–400 FEET

Arthur L. Strong COUNTY ENGINEER

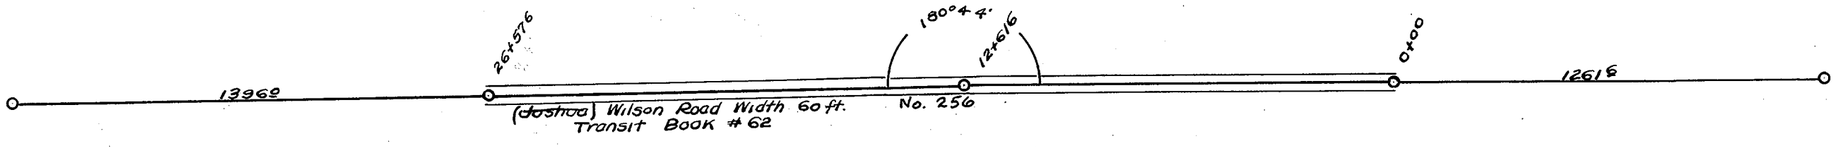


SECTION 28

TOWNSHIP 35 NORTH, RANGE 3 EAST, W. M.
SKAGIT COUNTY, WASH.

SCALE, 1 INCH–400 FEET

A. L. STRONG COUNTY ENGINEER

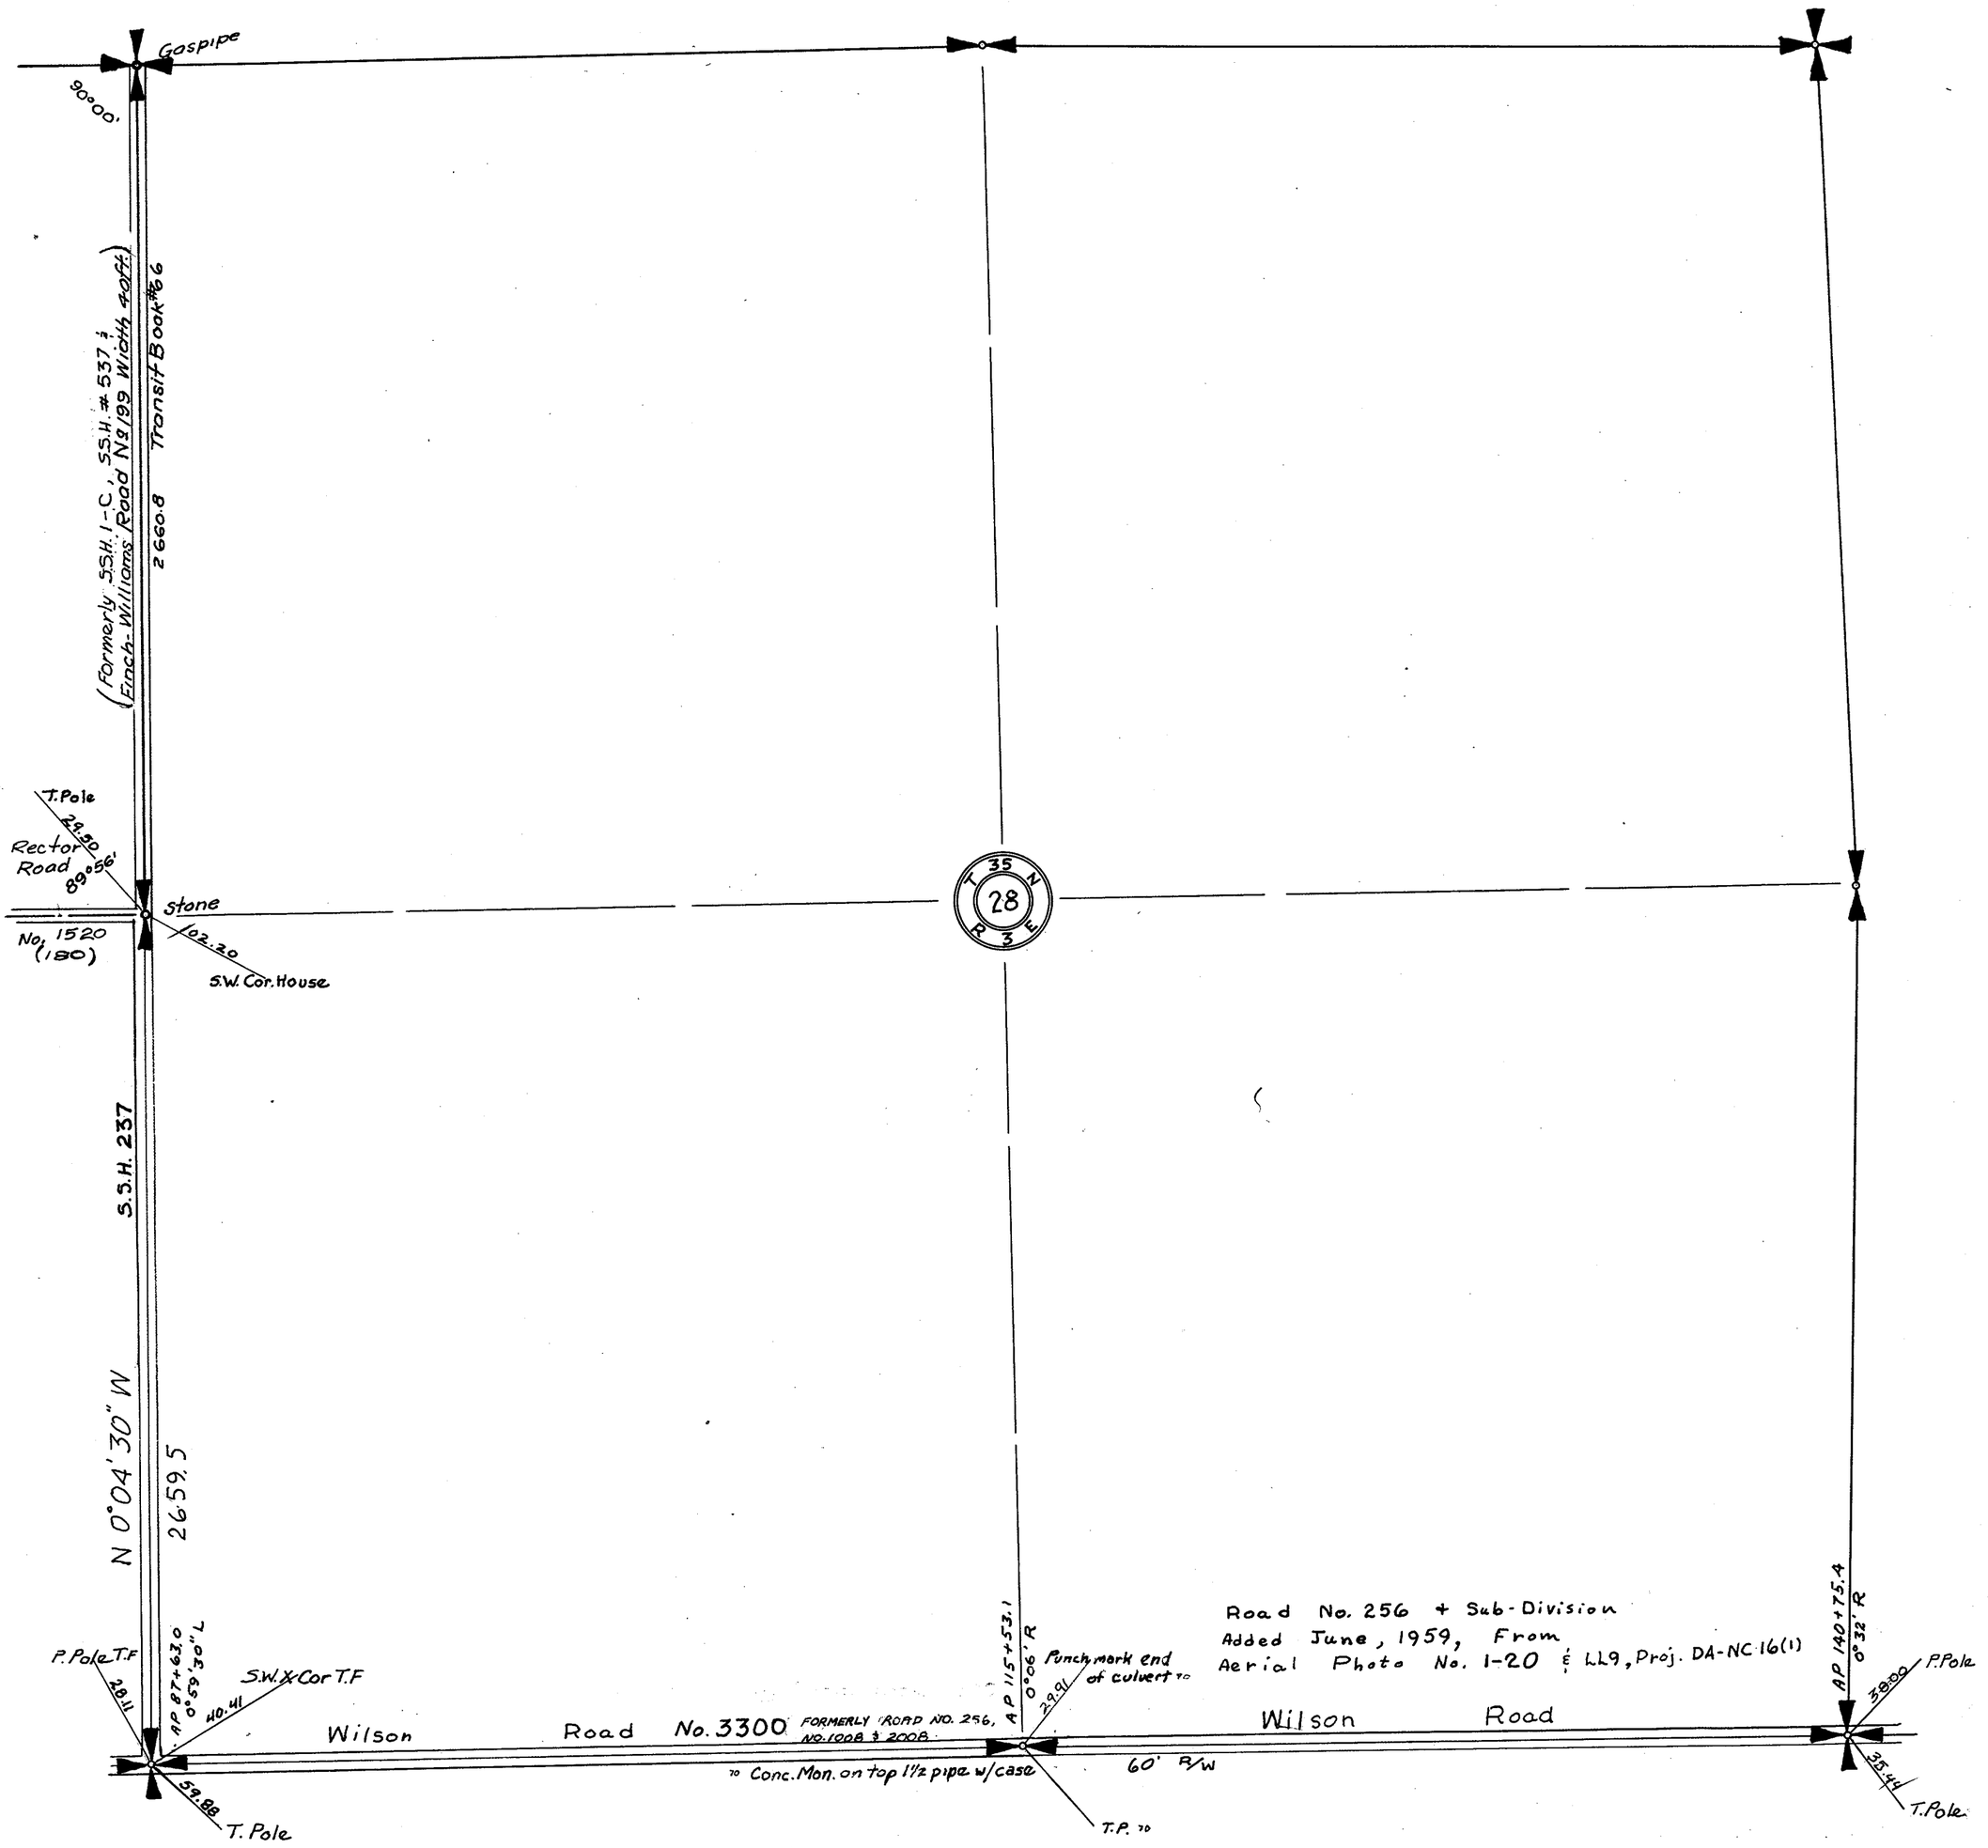


SECTION 29

TOWNSHIP 35 NORTH, RANGE 3 EAST, W. M.

SKAGIT COUNTY, WASH.

SCALE, 1 INCH–400 FEET

COUNTY ENGINEER

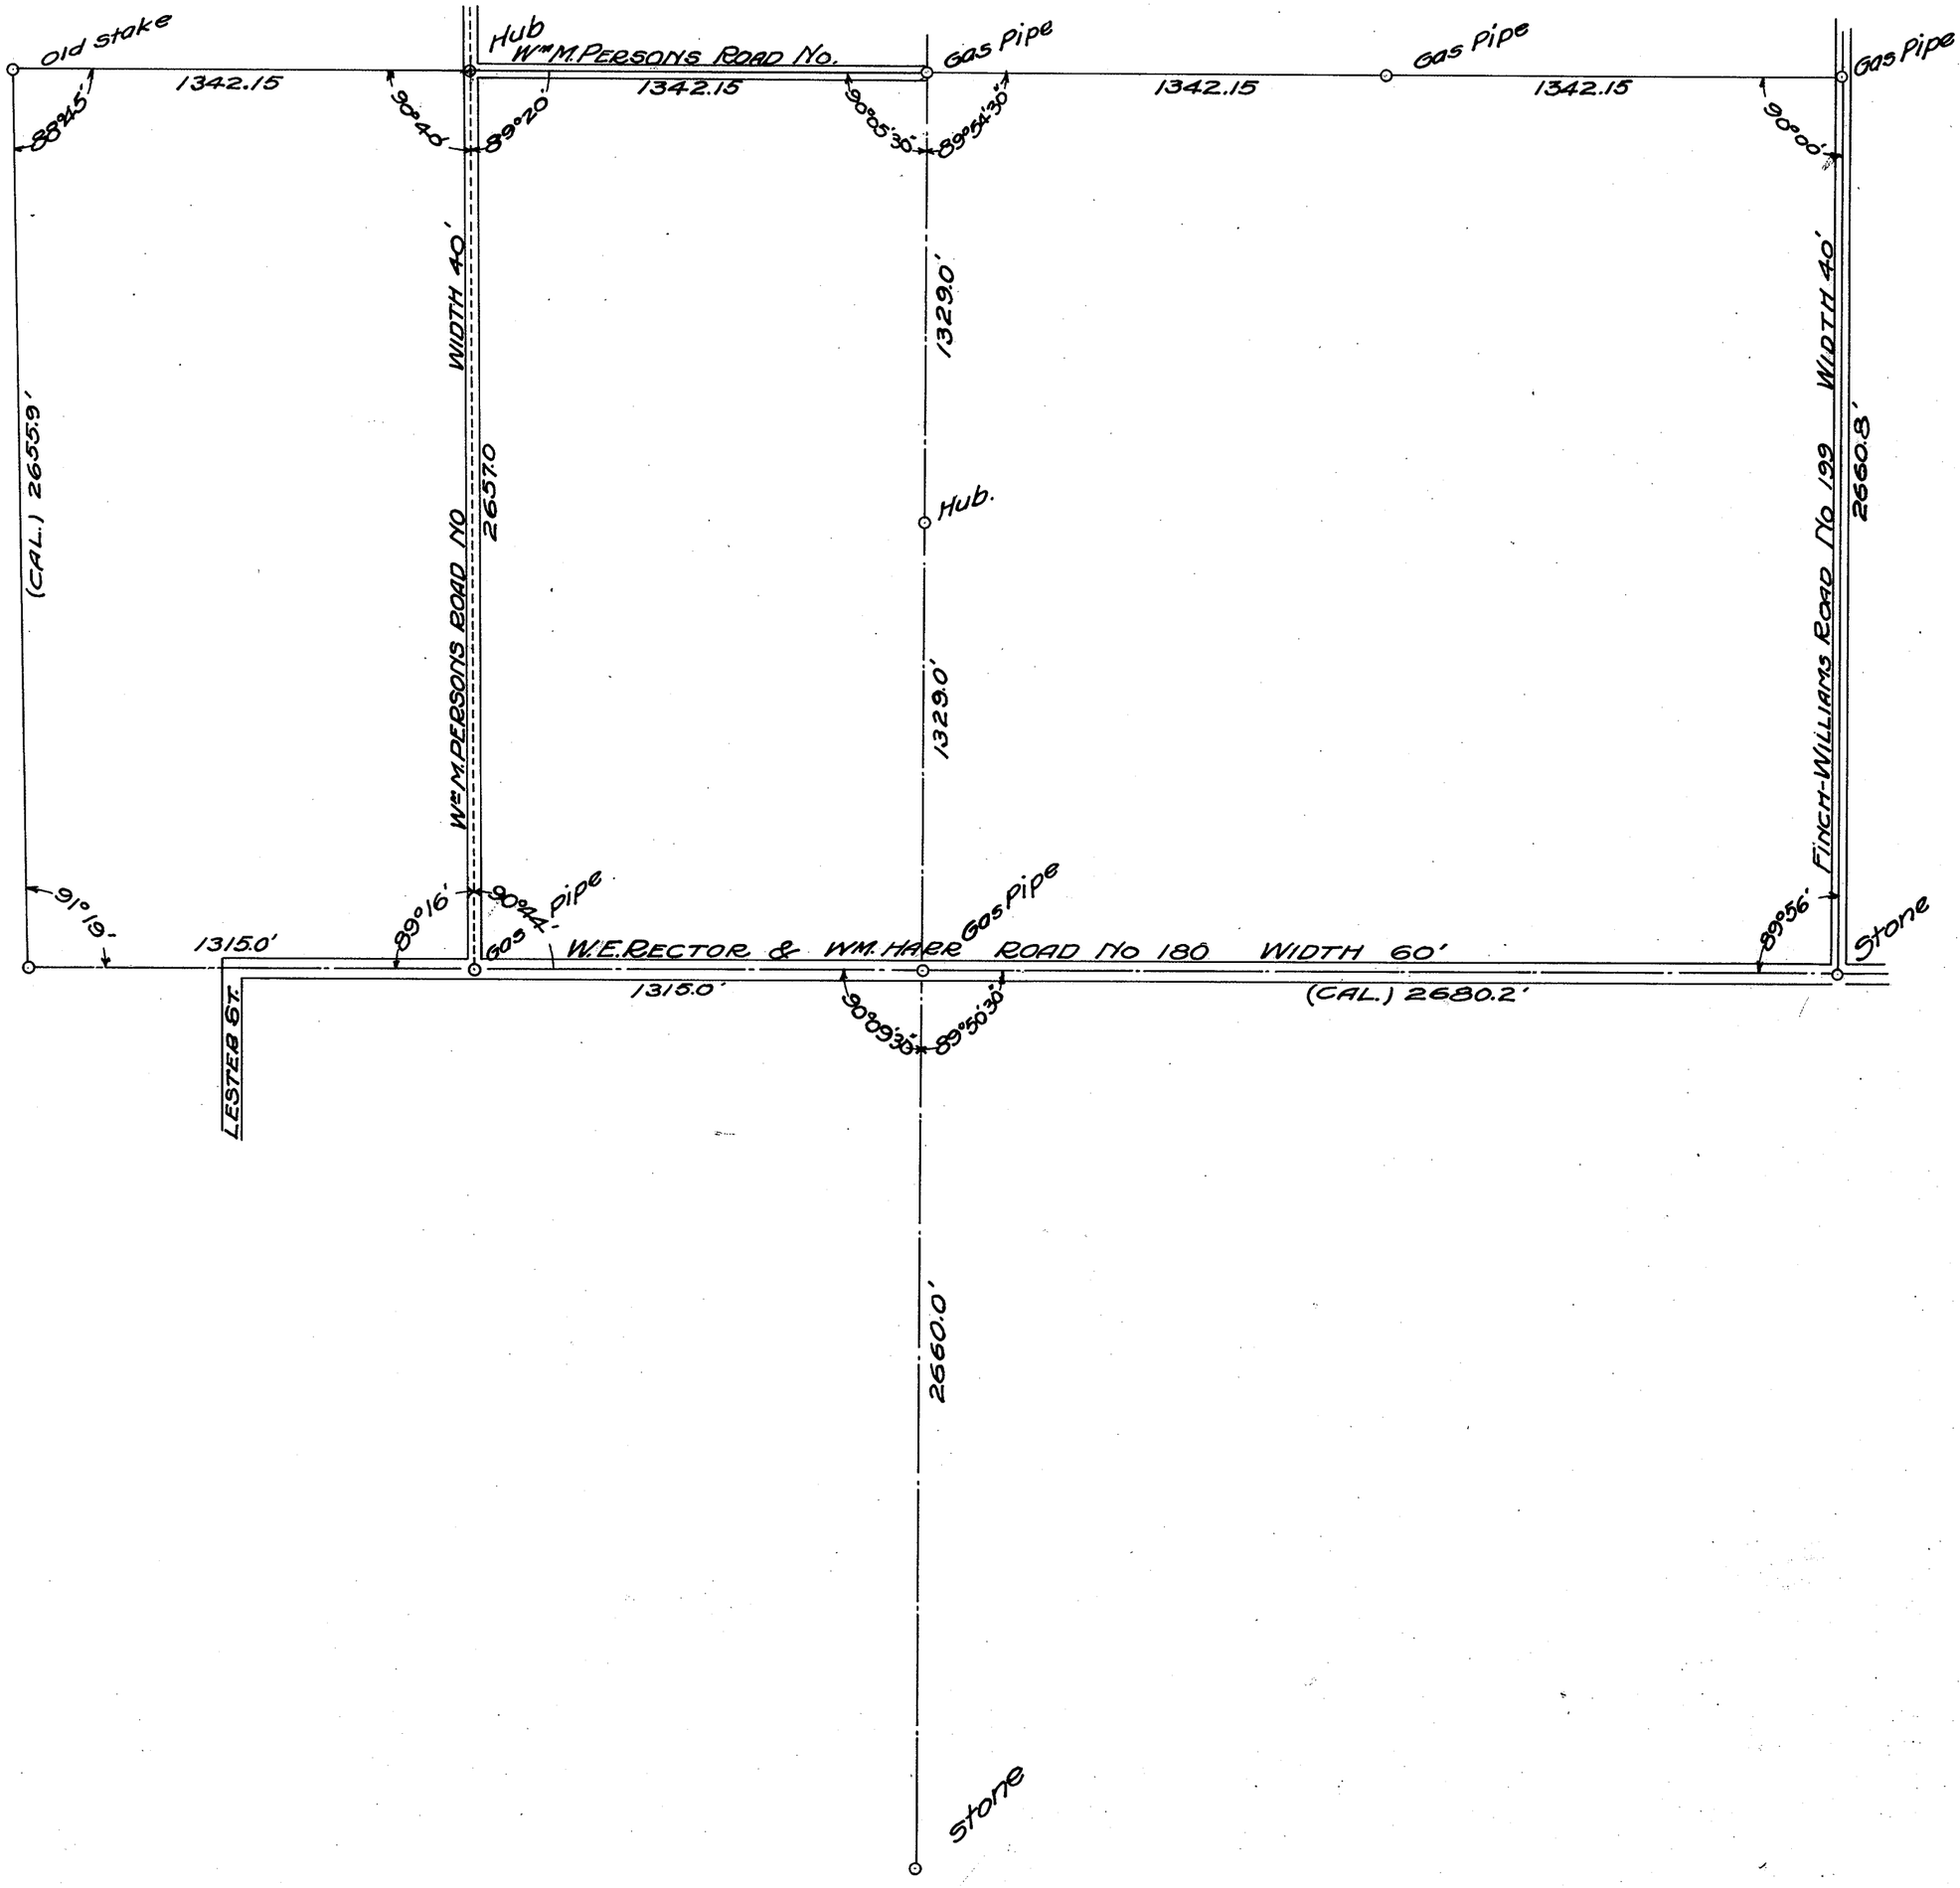

SECTION 29


TOWNSHIP 35 NORTH, RANGE 3 EAST, W. M.

SKAGIT COUNTY, WASH.

SCALE, 1 INCH--400 FEET

DATE June, 1959

Frank Gilkey - COUNTY ENGINEER

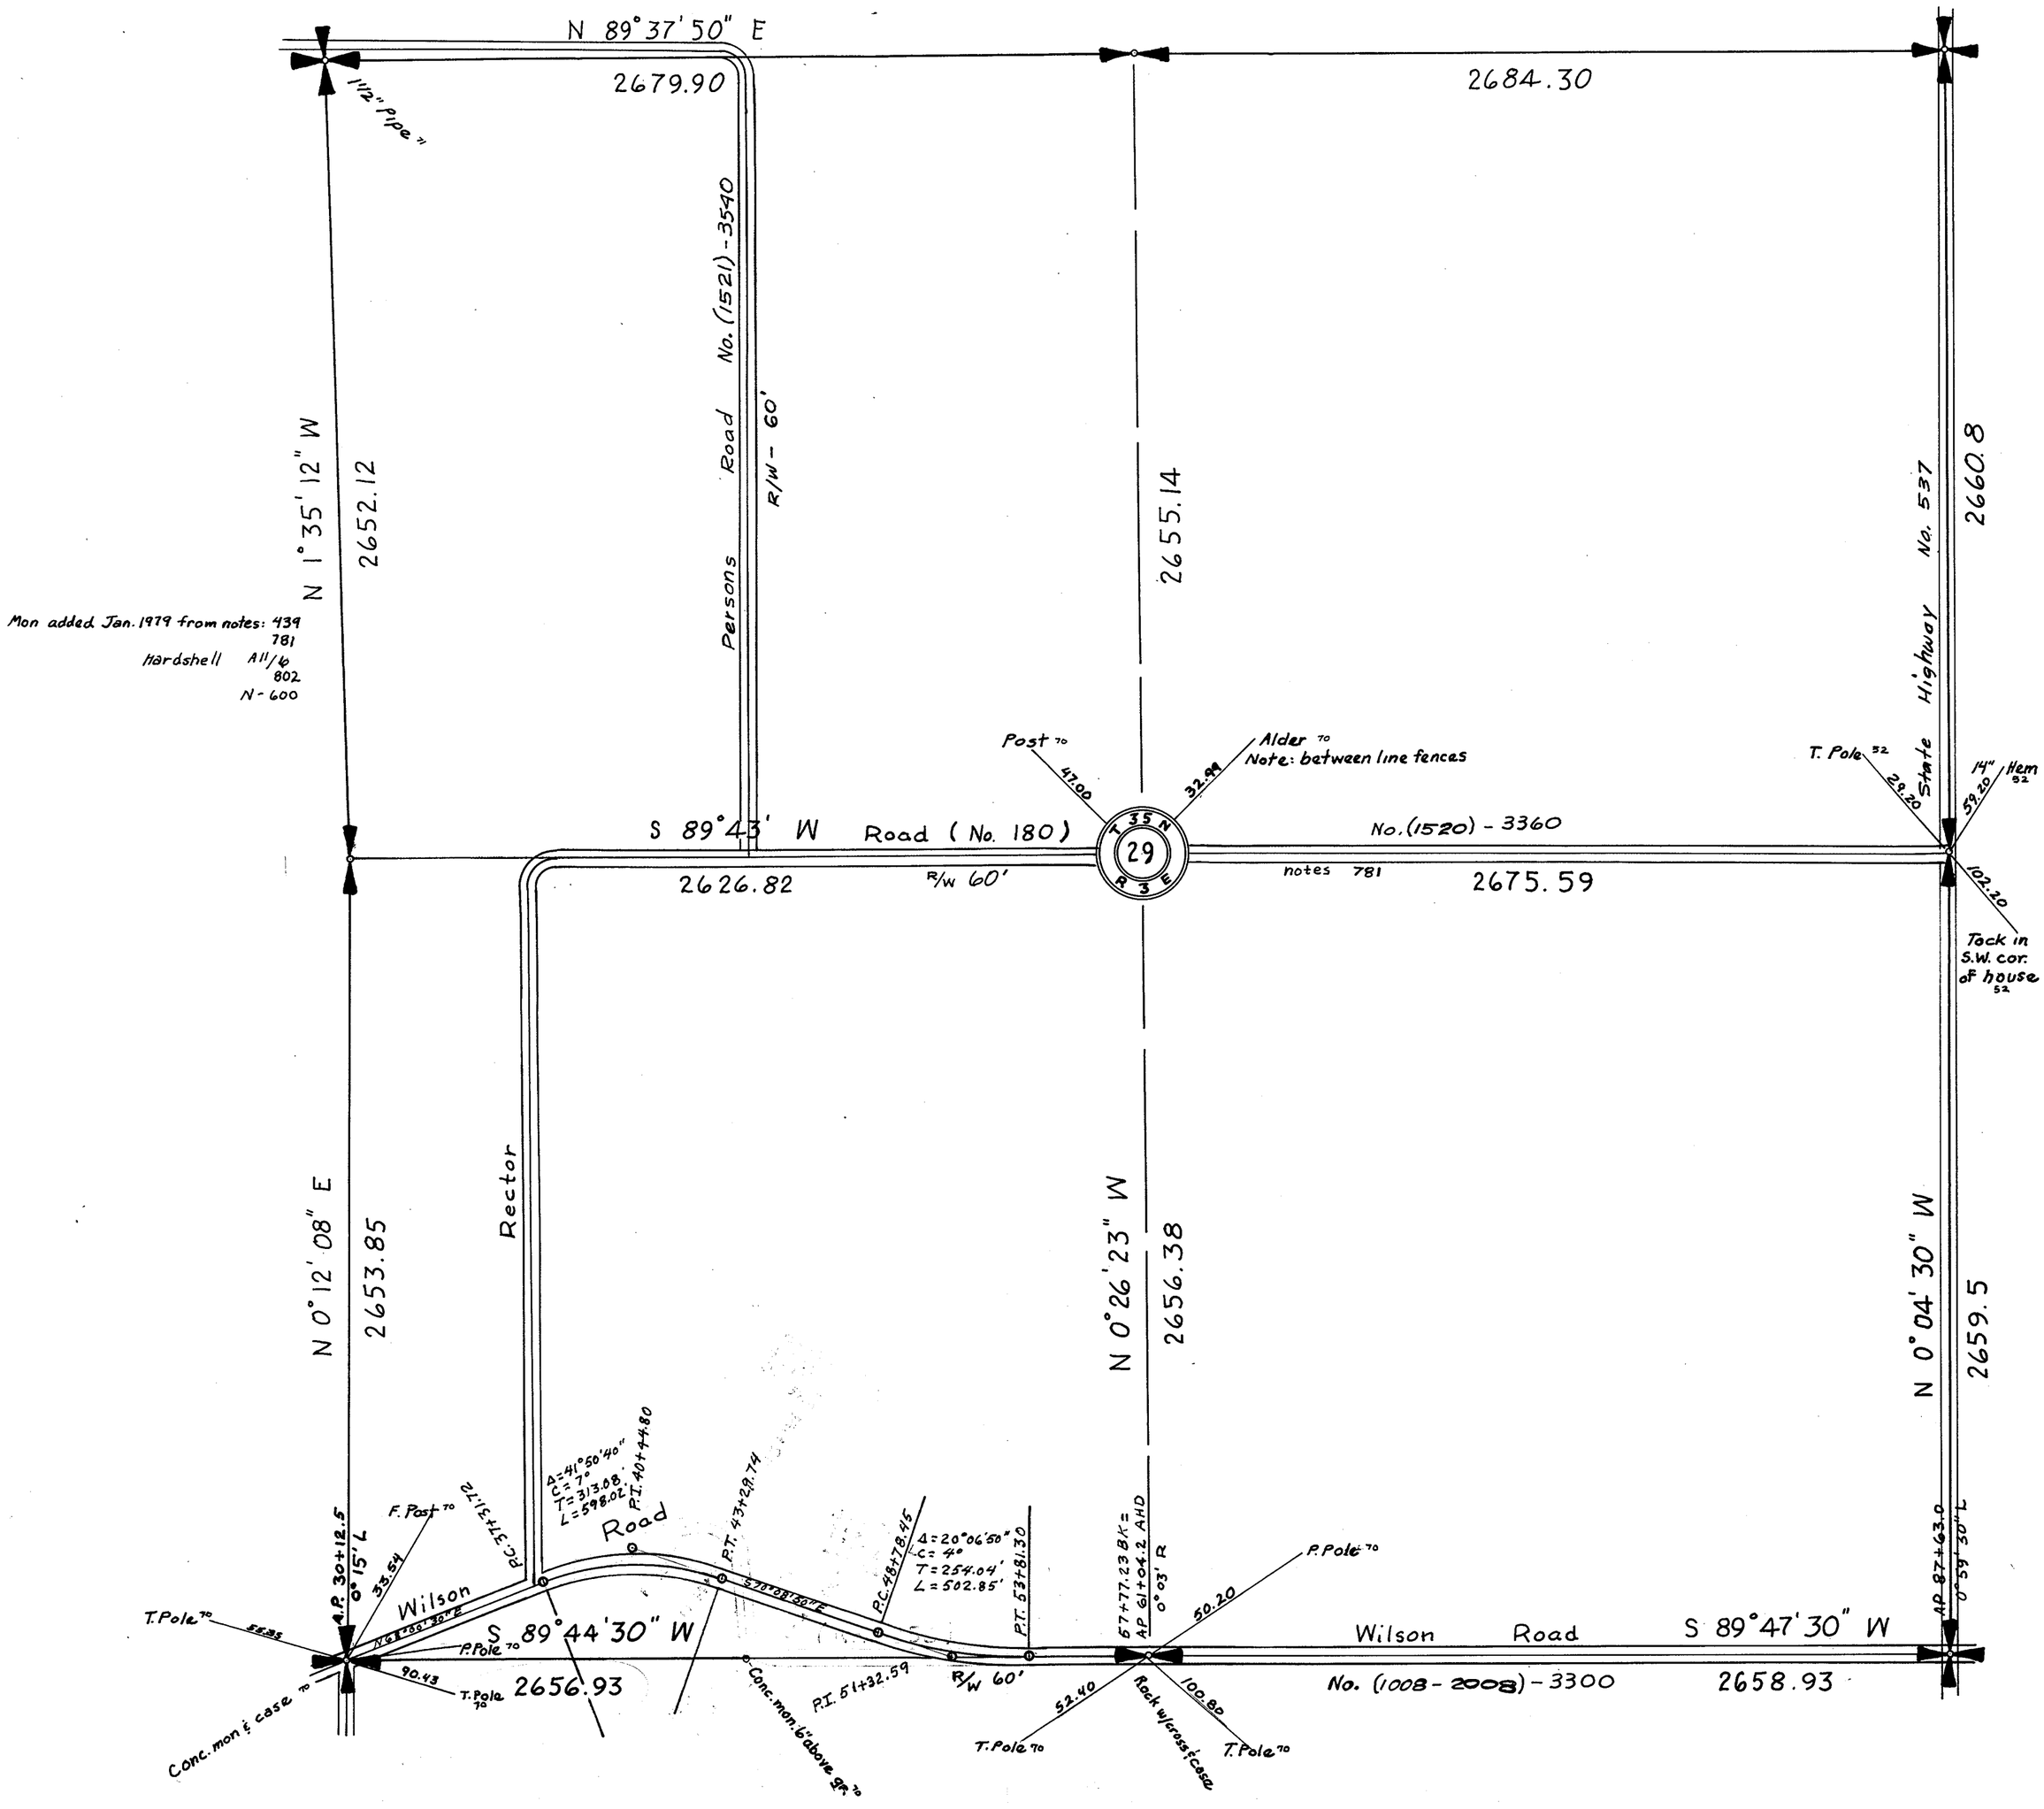


SECTION 30

TOWNSHIP 35 NORTH, RANGE 3 EAST, W. M.

SKAGIT COUNTY, WASH.

SCALE, 1 INCH--400 FEET
Road No. 662 From Notes 45/545

DATE June, 1959 — Frank Gilkey COUNTY ENGINEER

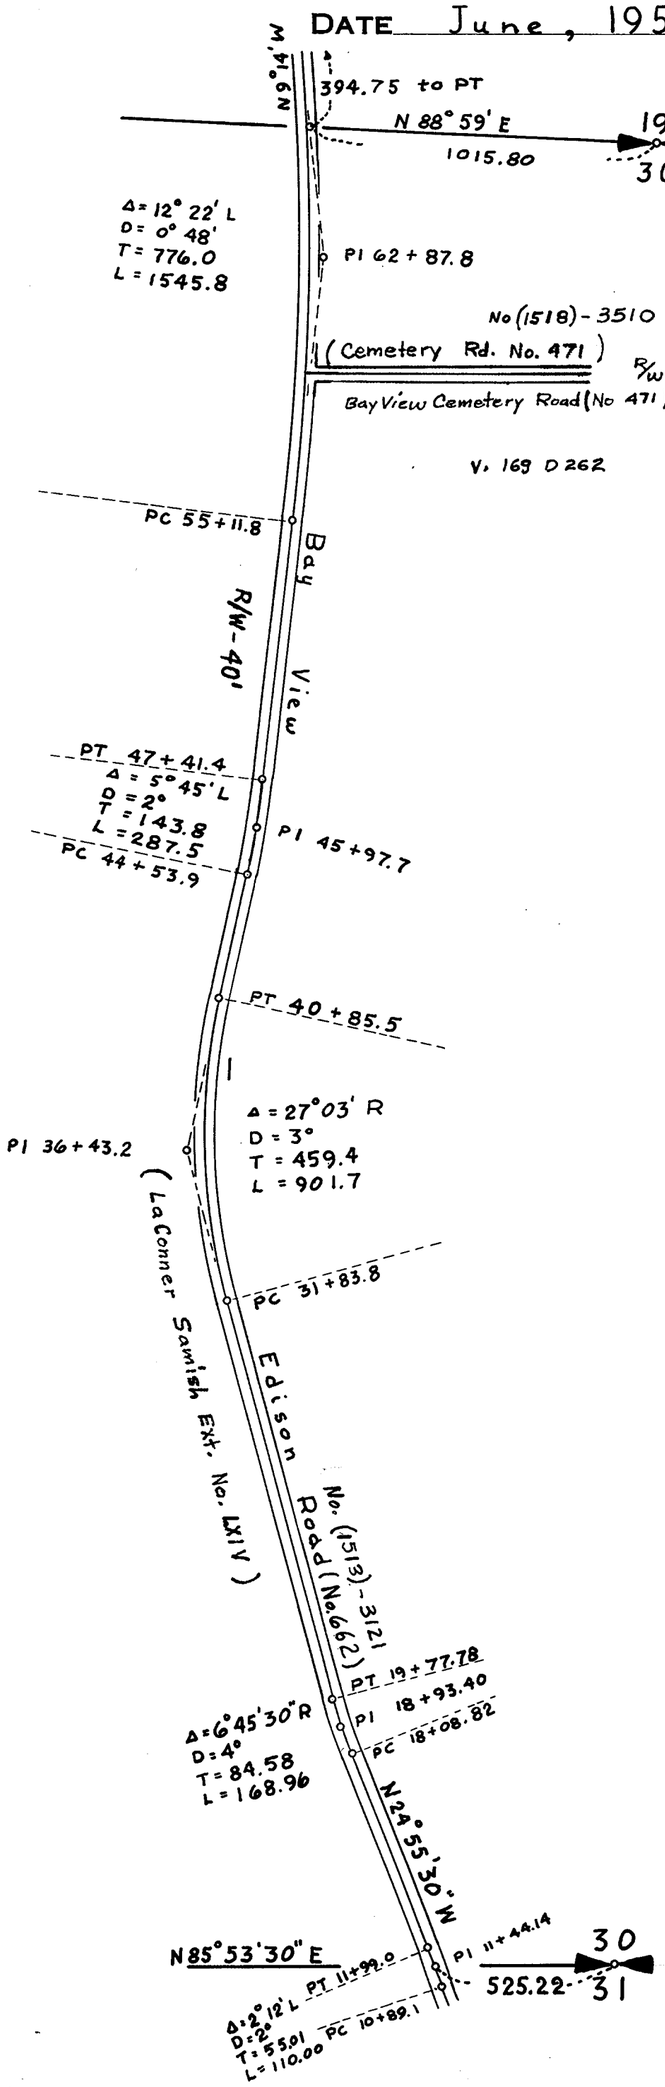

SECTION 30

TOWNSHIP 35 NORTH, RANGE 3 EAST, W. M.
SKAGIT COUNTY, WASH.

SCALE, 1 INCH–400 FEET

A. L. STRONG COUNTY ENGINEER



SECTION 31

TOWNSHIP 35 NORTH, RANGE 3 EAST, W. M.

SKAGIT COUNTY, WASH.

SCALE, 1 INCH--400 FEET

H. O. Walberg COUNTY ENGINEER

7-15-41 ✓ 10-9-41 Notes 515 - First St.

Compiled and adjusted by W.C.W. July 1941
from 38/434 39/439 40/470
Traverse closed
from S 32° 50' E 1.14

See Surv. 13/Ks. 21-22 Mck-GE.
Add to Bayview 1941

Orig. Position of M.C.
Reproduced from Plats. Set 1½" Iron Bolt 4-29-42 (N 5356.39 E 1453.20)

old stone mon. N 5381.50 E 1458.72

N 5369.31 E 2038.48

1½" pipe

N 88° 47' 50" W 2665.23

1½" pipe

N 5313.27 E 4703.12

S 88° 44' 45" W 524.04

30

31

N 5357.88 E 1514.57

Earth Mound

300

60.3

A

B

C

D

N 11° 08' 11" W 1040.

310

N 69° 44' 50" E 300.12

N 69° 52' E 2687.42

Surv. 39/439

St

Wilson Road No. 256

(40/470)

N 0° 39' E 2644.36

N 4388.23 E 2179.89

N 4289.34 E 1898.32

Notes 515

N 76° 06' 30" E 2000

N 13° 53' 30" W 2000

N 16° 09' 04" W 1401.7

N 3816.66 E 2380.70

N 70° 09' 30" E 296.04

N 3716.19 E 2102.27

N 19° 49' 10" W 1431.10

654.96

N 19° 38' 10" W

363.84

N 3303.27 E 2251.06

S 73° 25' E 894.2

Survey 38/434

S 66° 26' E 402.2

S 70° 01' E 638.7

East 596.4

1½" pipe N 2669.08 E 4673.18

S 89° 04' E

Bay View - Edison Road No. 662

℄ S 89° 15' E 2679.89

℄ N 0° 58' E 2665.53

The meander course here should have been N W — by Haley

S 1° 17' W 2651.8

N 17.84 E 4613.78

N 89° 18' W 812.4

1" Bar

SECTION 31


TOWNSHIP 35 NORTH, RANGE 3 EAST, W. M.

SKAGIT COUNTY, WASH.

SCALE, 1 INCH--400 FEET

DATE June, 1959

Frank Gilkey COUNTY ENGINEER

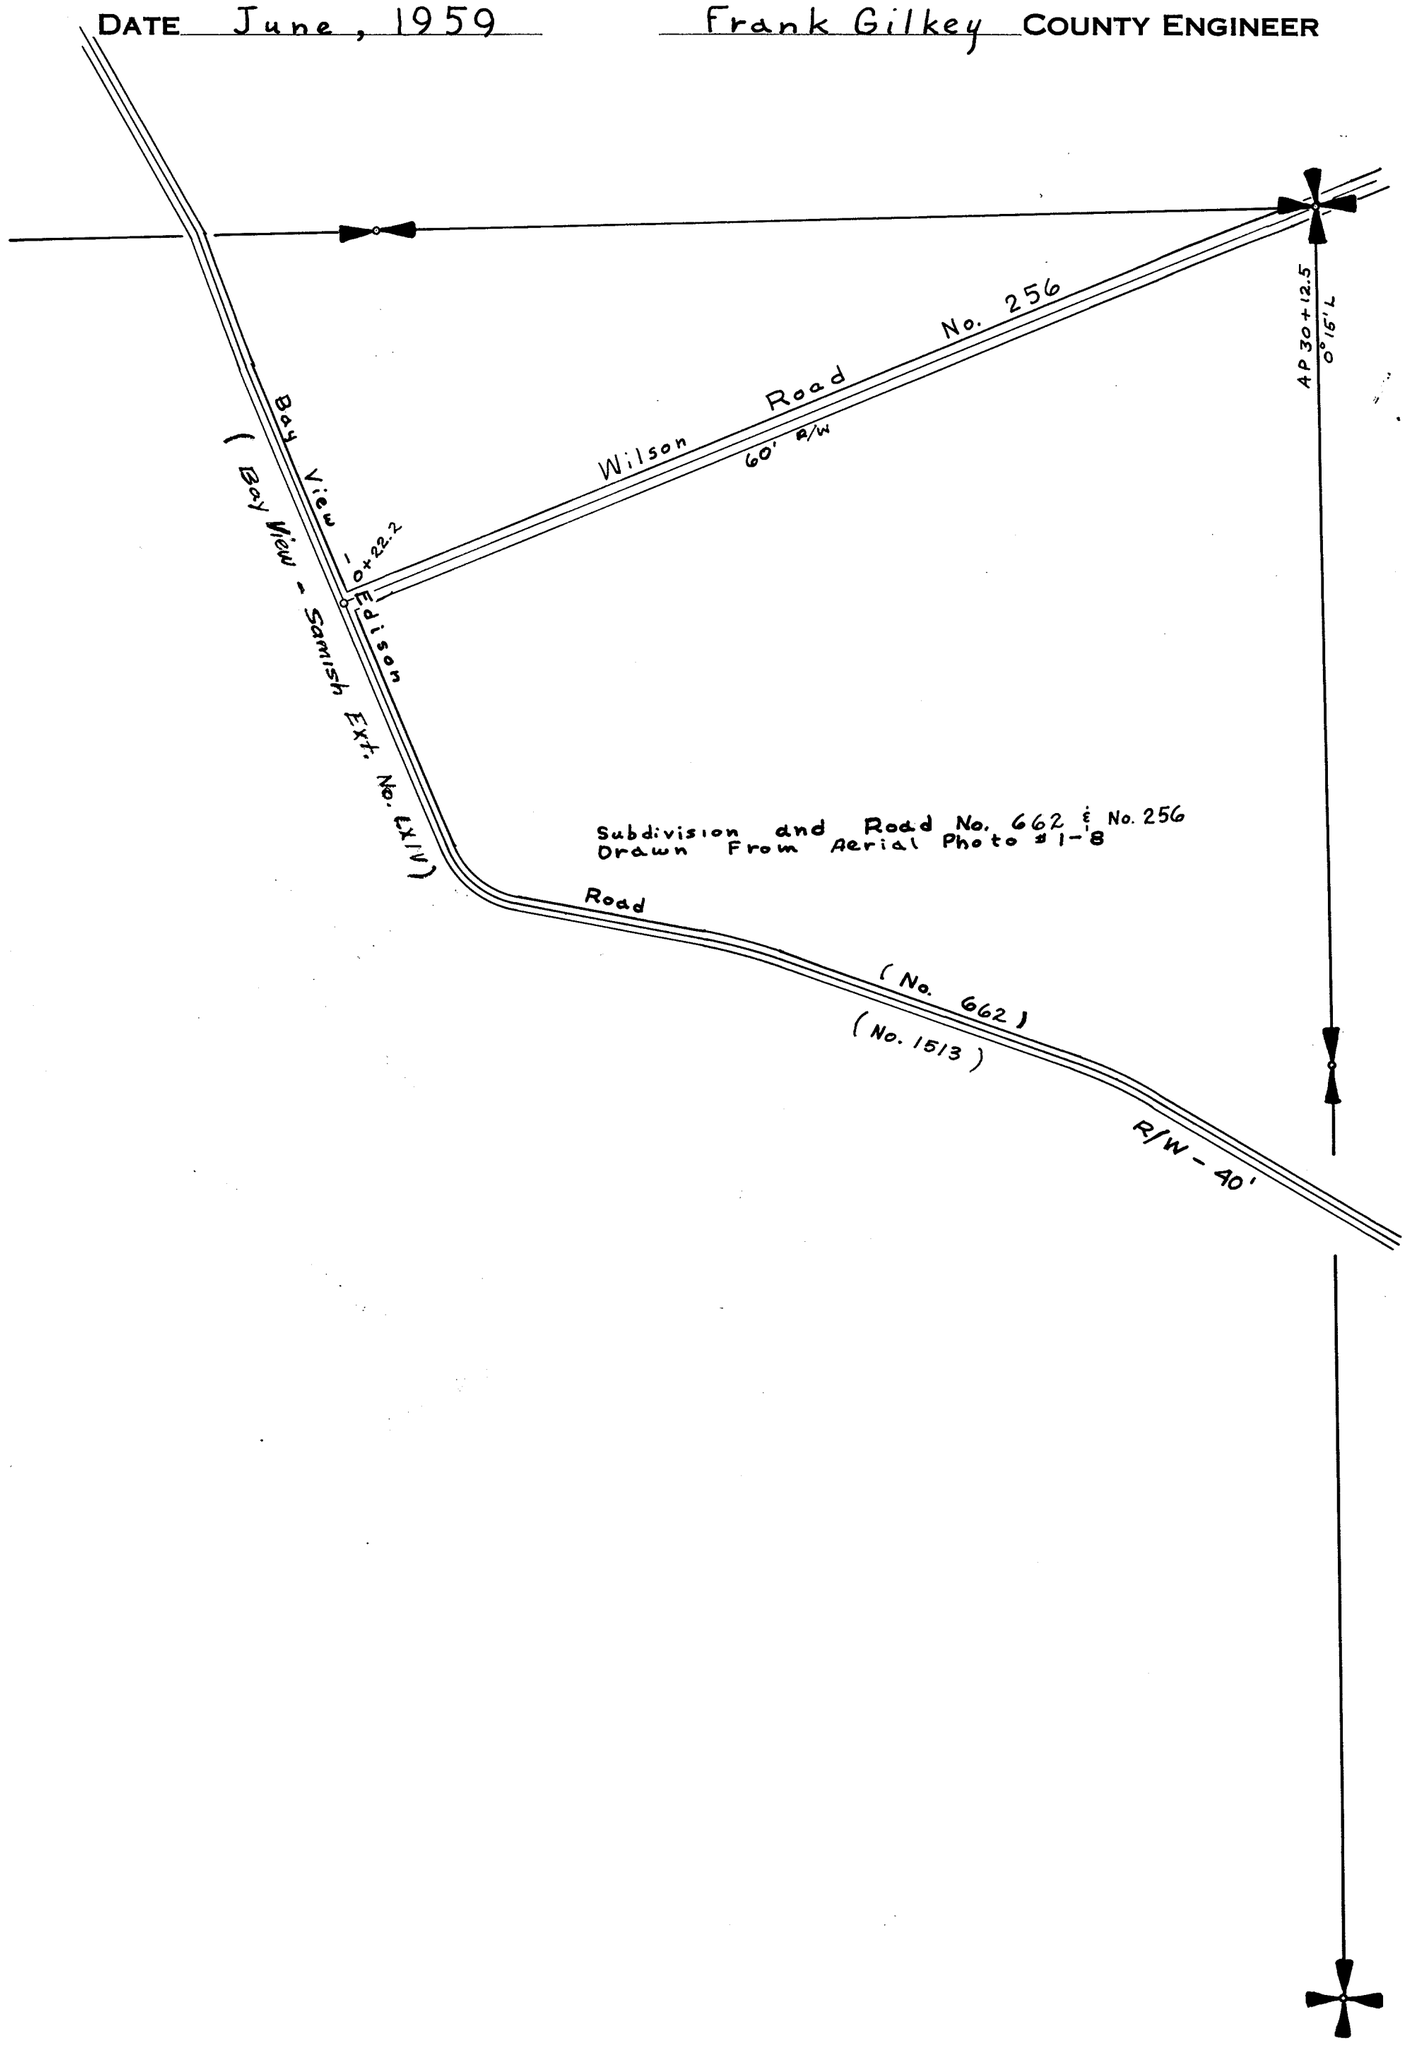

SECTION 31


TOWNSHIP 35 NORTH, RANGE 3 EAST, W. M.

SKAGIT COUNTY, WASH.

SCALE, 1 INCH--400 FEET

DATE Aug. 1965

COUNTY ENGINEER

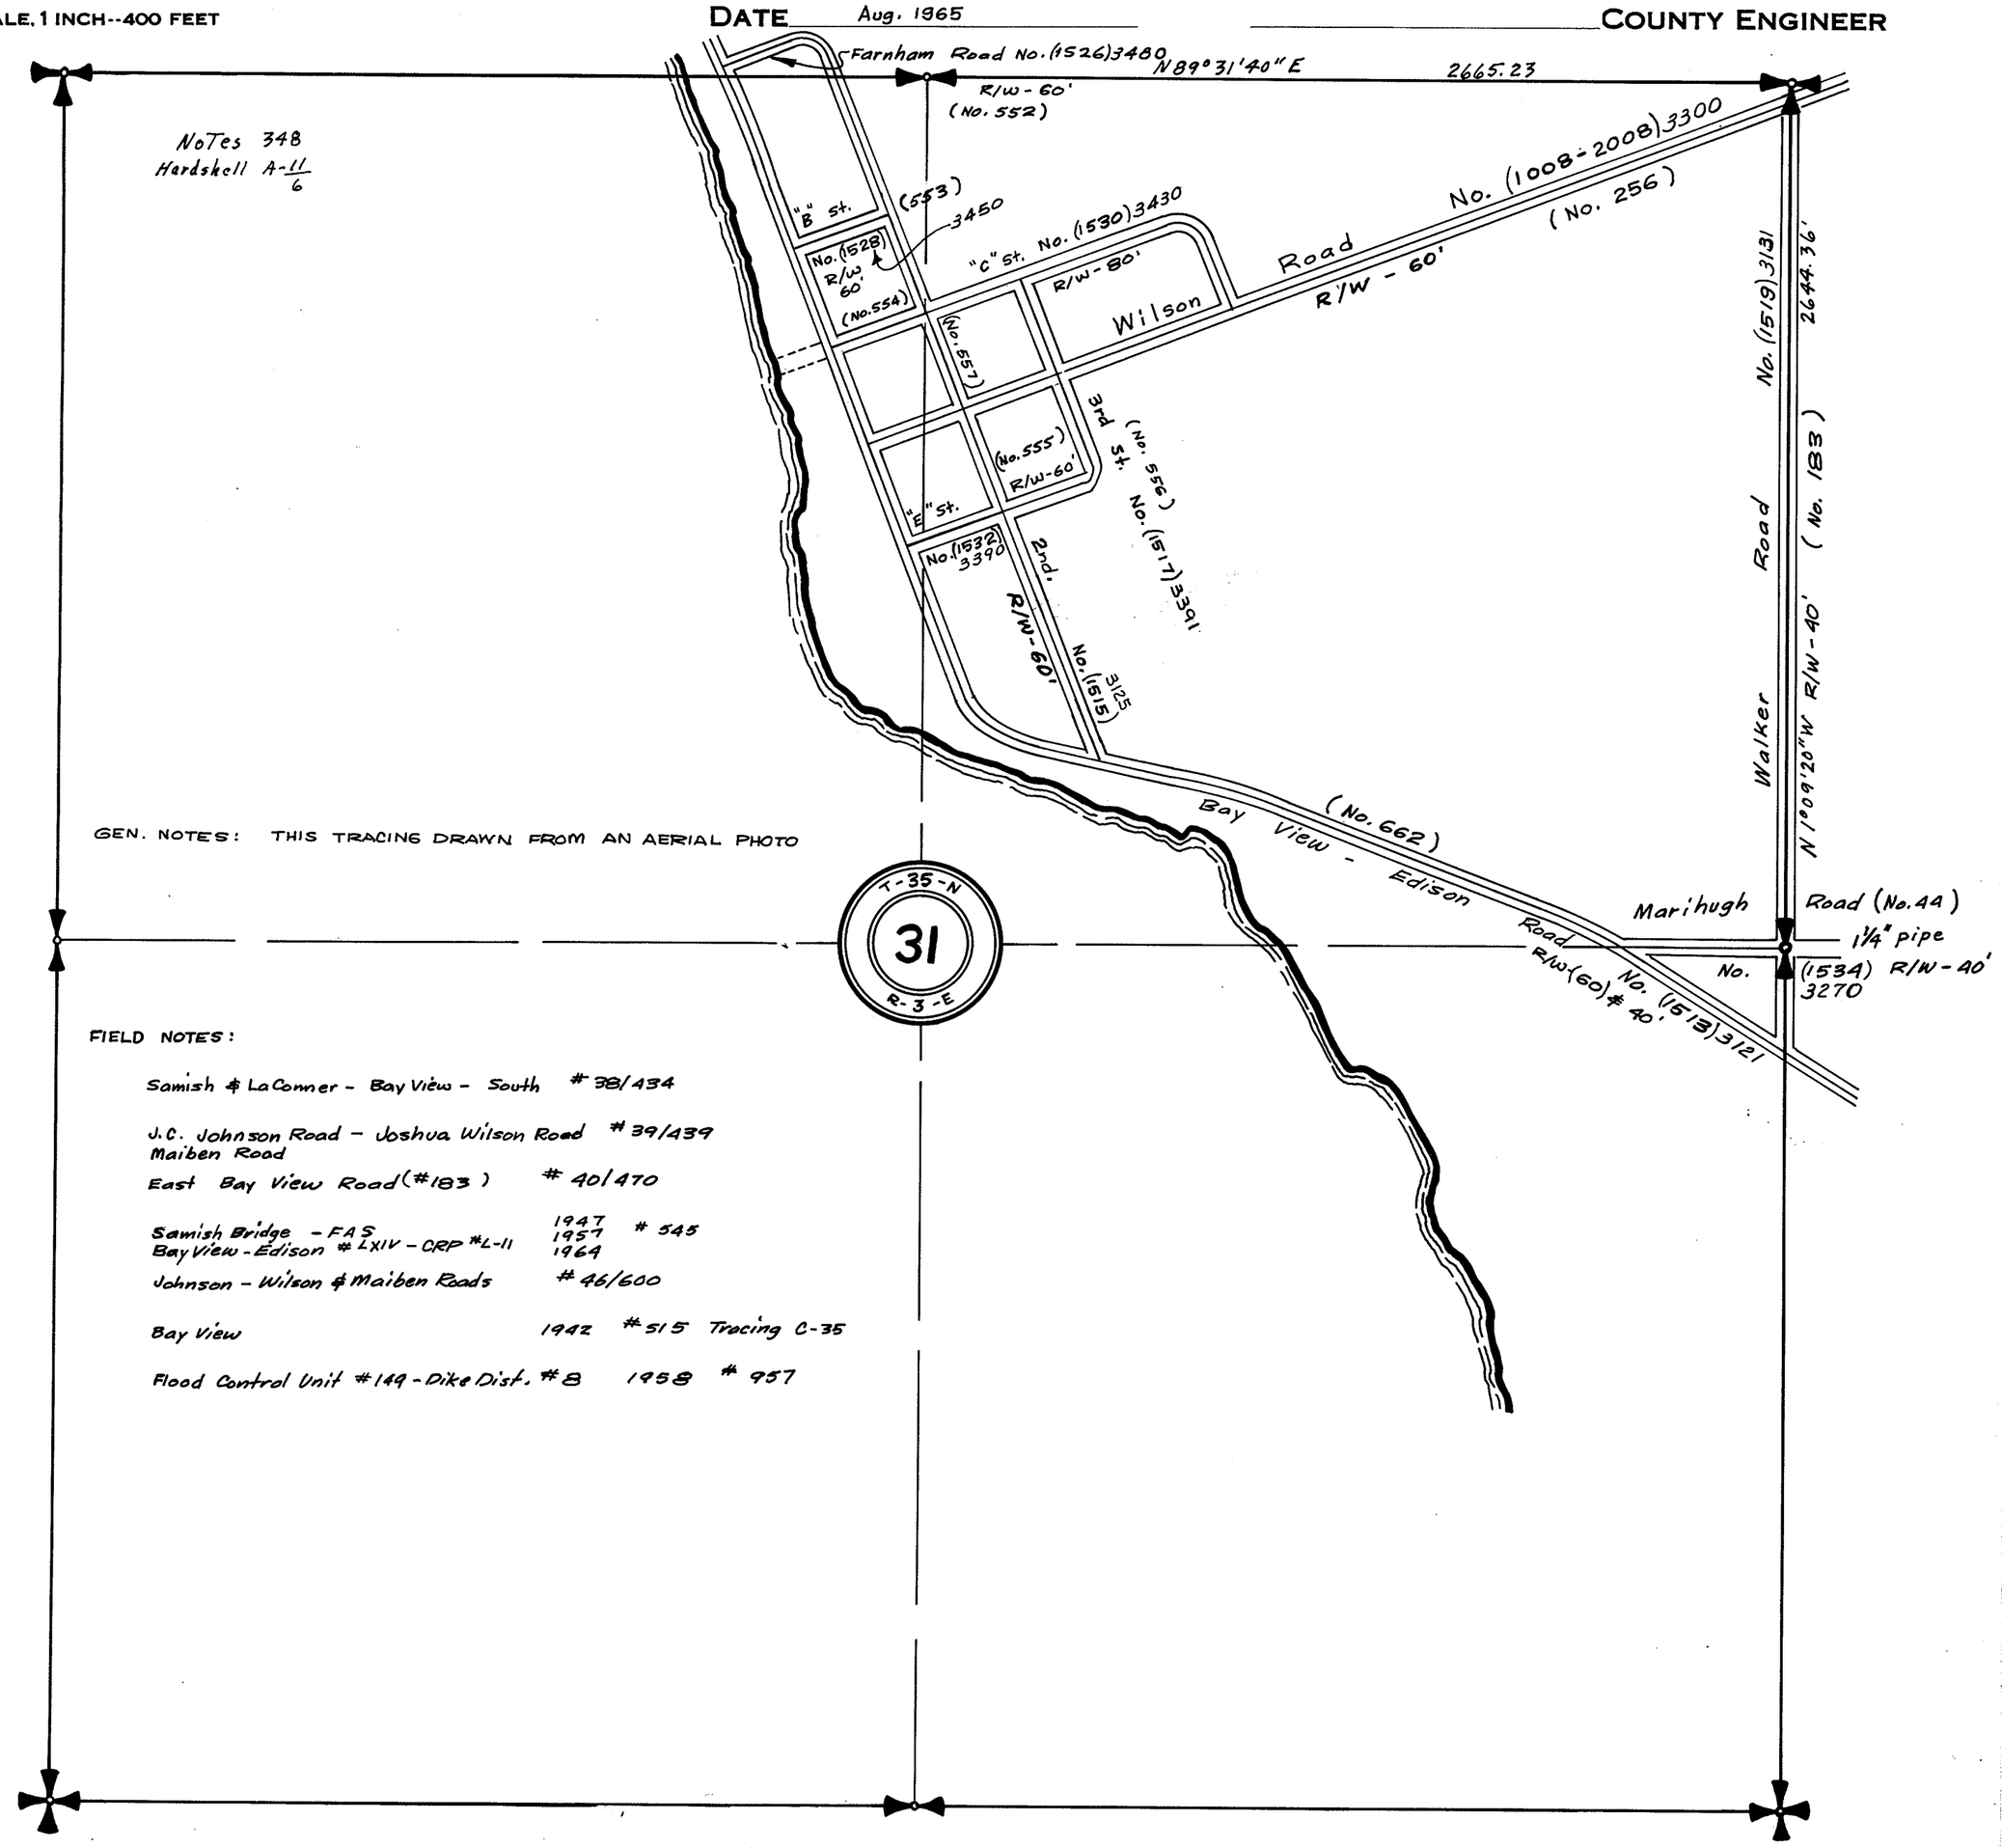

GEN. NOTES: THIS TRACING DRAWN FROM AN AERIAL PHOTO

FIELD NOTES:

Samish & LaConner - Bay View - South # 38/434

J.C. Johnson Road - Joshua Wilson Road # 39/439
Maiben Road

East Bay View Road (#183) # 40/470

Samish Bridge - FAS 1947 # 545
Bay View - Edison # LXIV - CRP #L-11 1957 1964

Johnson - Wilson & Maiben Roads # 46/600

Bay View 1942 # 515 Tracing C-35

Flood Control Unit #149 - Dike Dist. #8 1958 # 957

SECTION 32


TOWNSHIP 35 NORTH, RANGE 3 EAST, W. M.

SKAGIT COUNTY, WASH.

SCALE, 1 INCH--400 FEET

DATE June, 1959

Frank Gilkey COUNTY ENGINEER

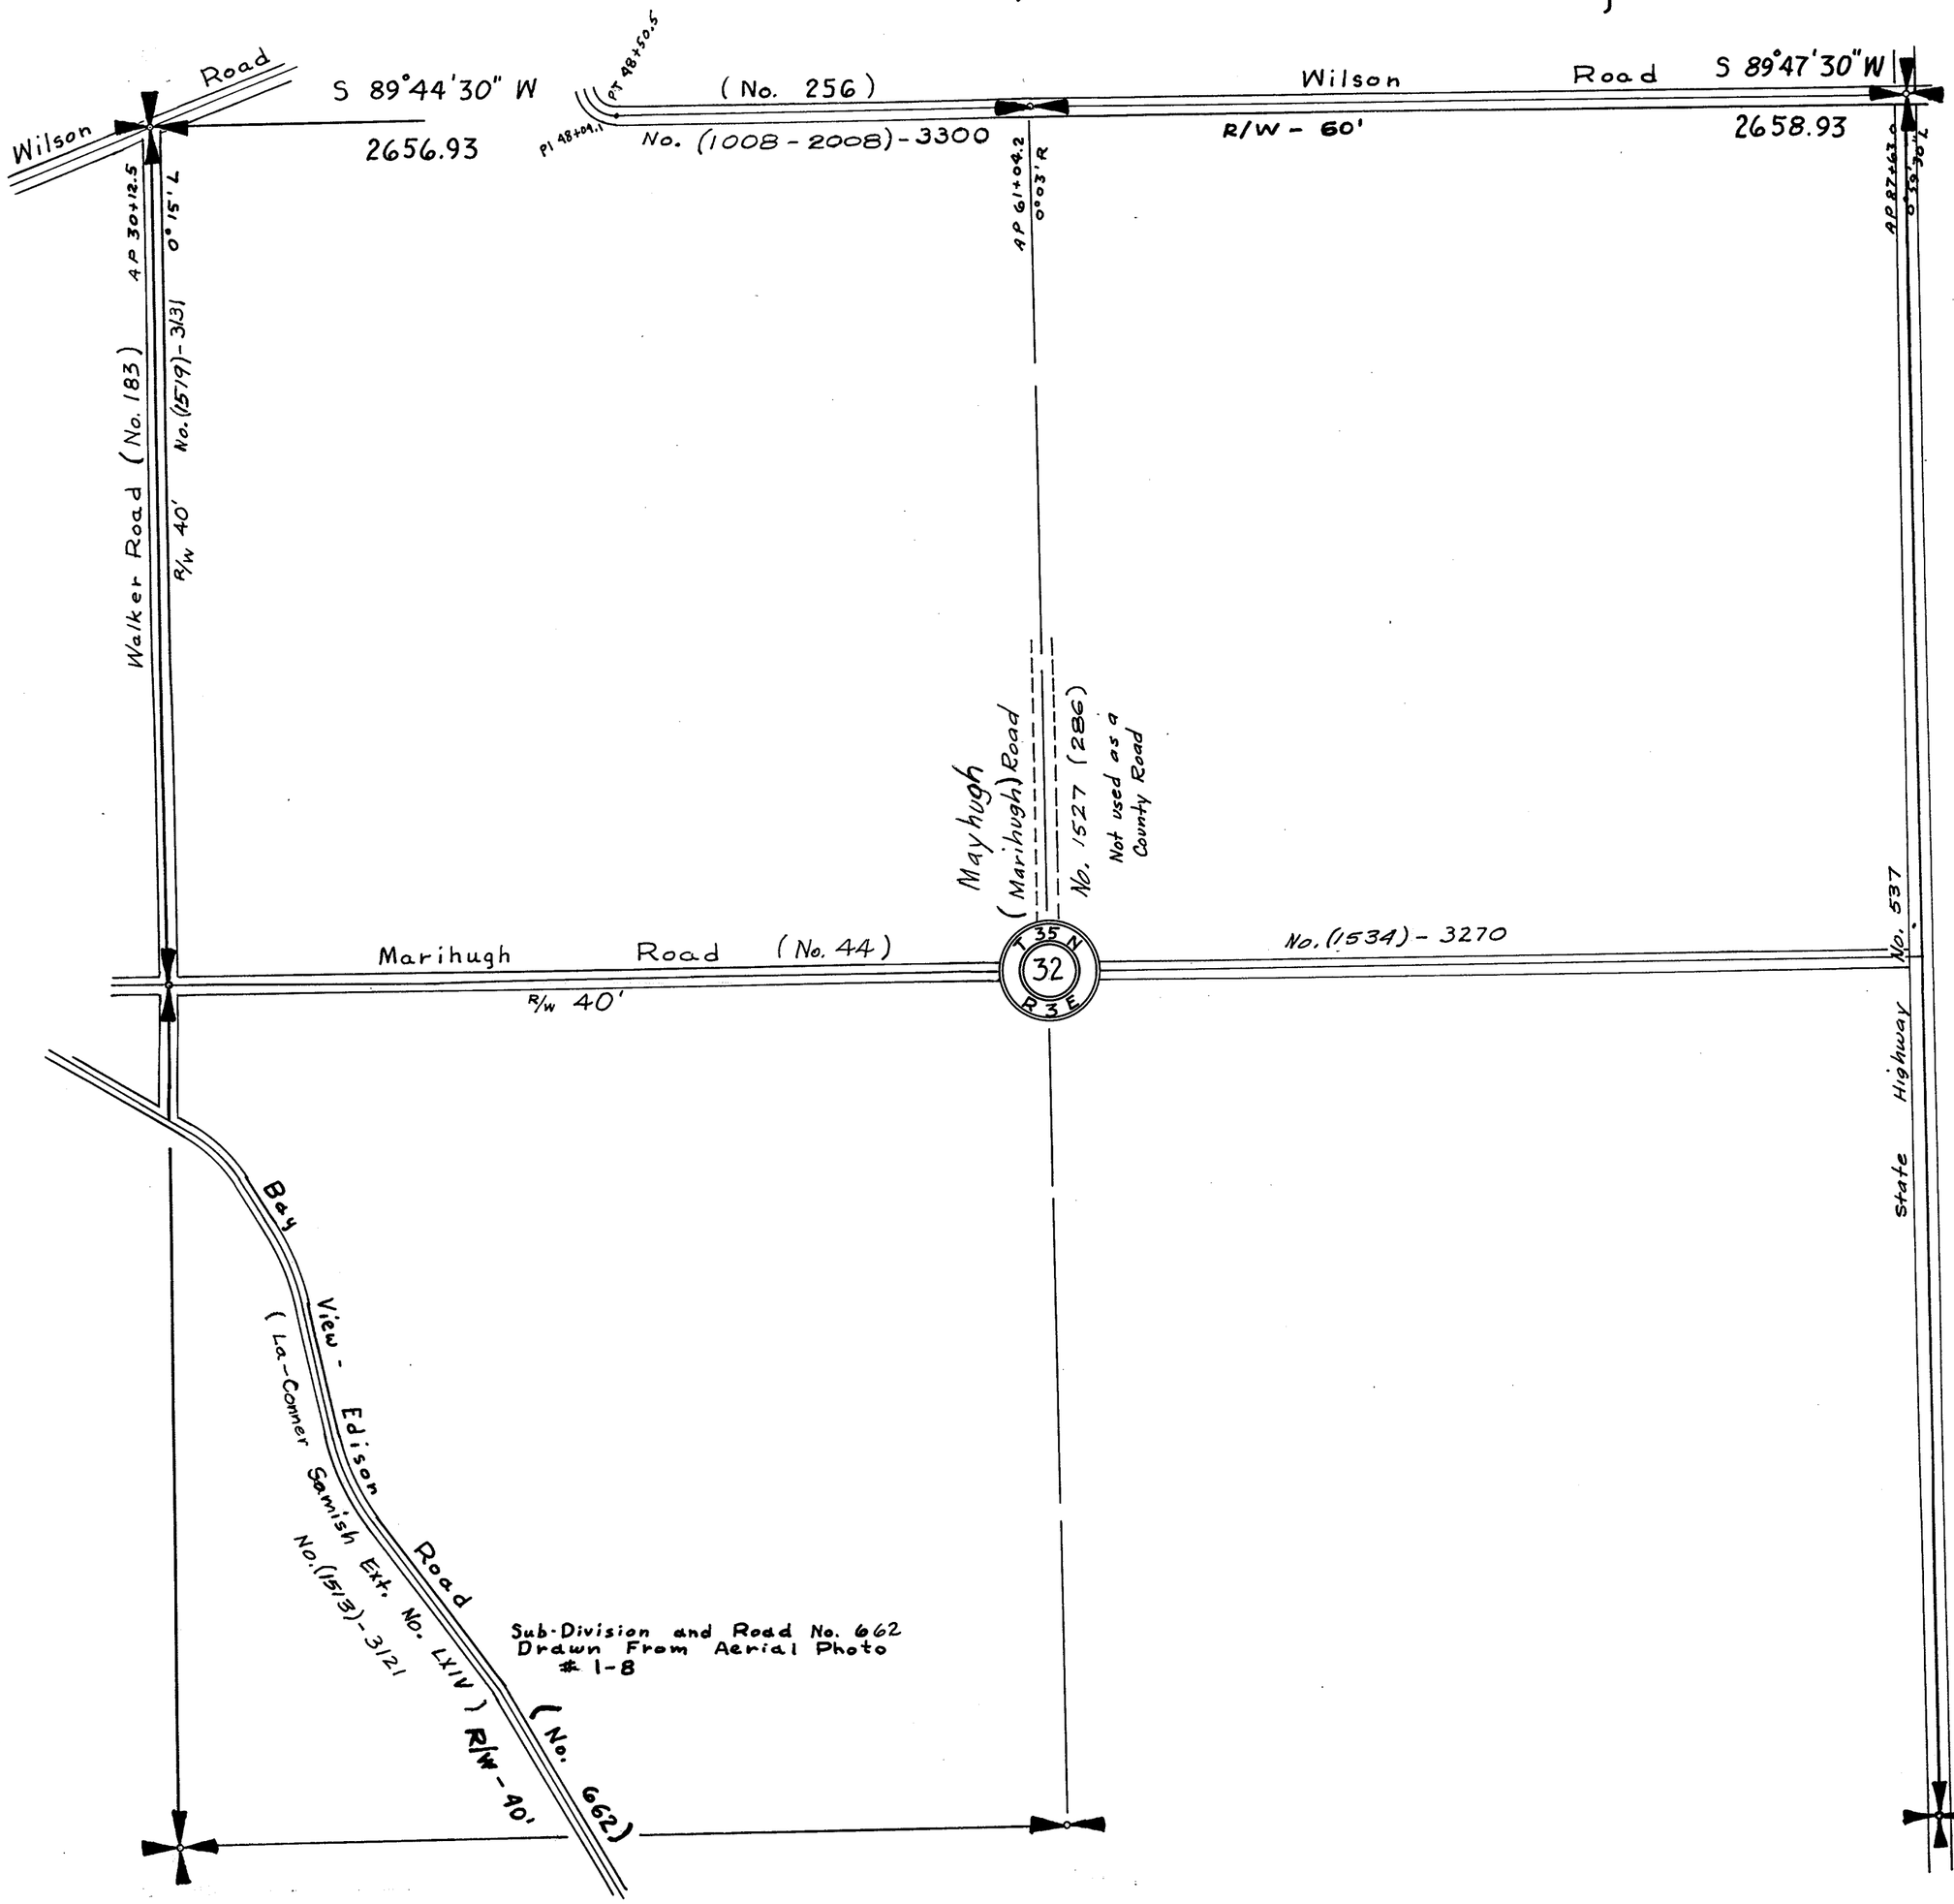


SECTION 32

TOWNSHIP 35 NORTH, RANGE 3 EAST, W. M.
SKAGIT COUNTY, WASH.

SCALE, 1 INCH–400 FEET

A.L. STRONG. COUNTY ENGINEER

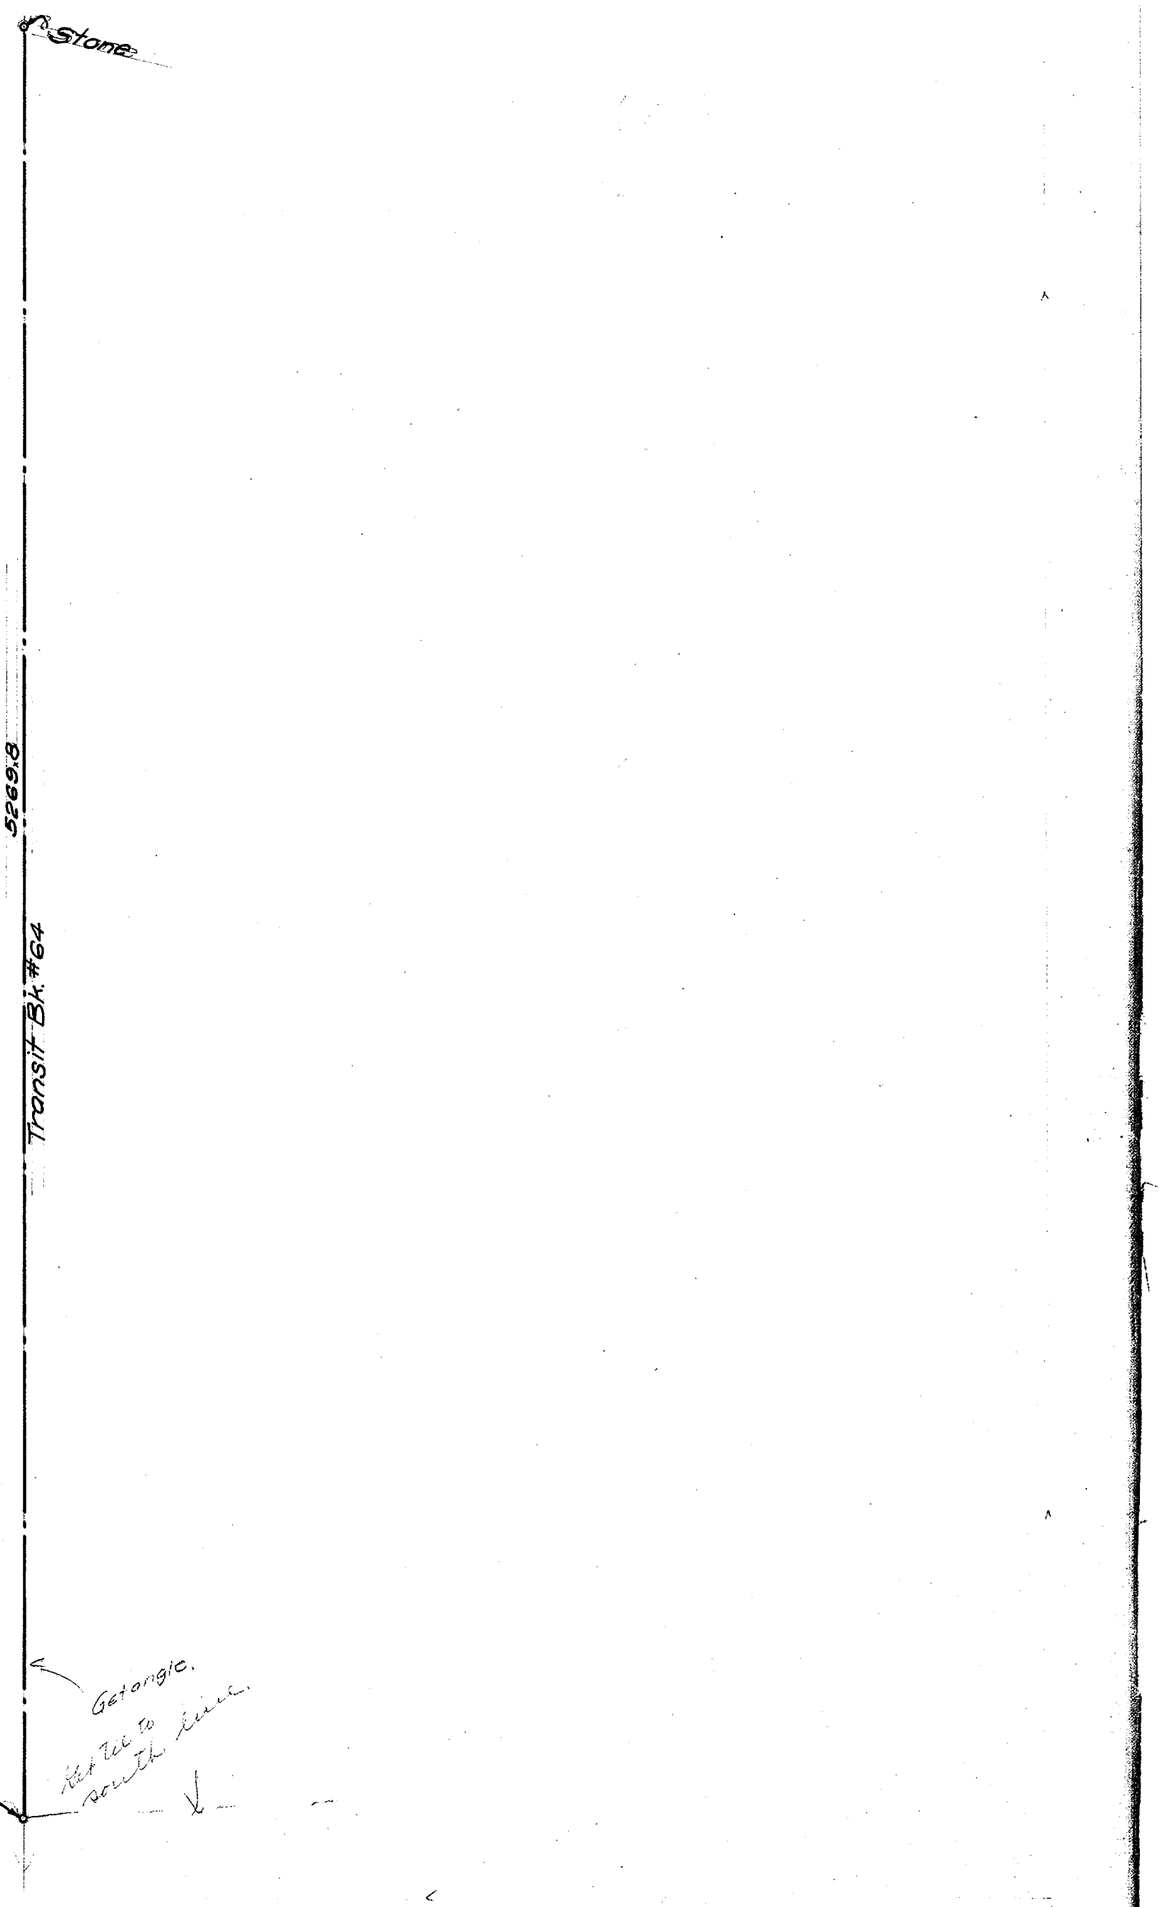


SECTION 33

TOWNSHIP 35 NORTH, RANGE 3 EAST, W. M.
SKAGIT COUNTY, WASH.

SCALE, 1 INCH–400 FEET

Arthur L Strong COUNTY ENGINEER

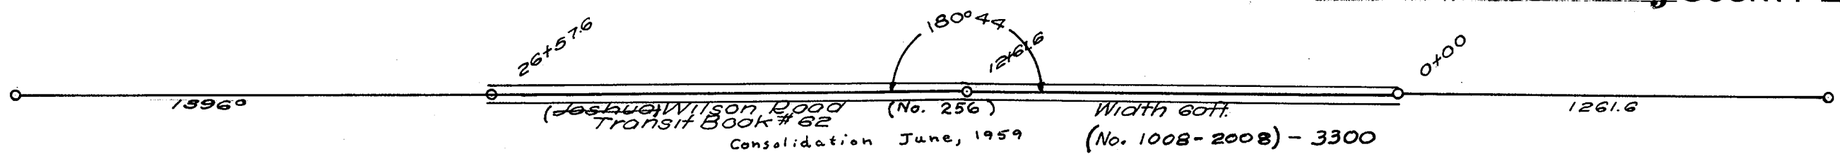

SECTION 35


TOWNSHIP 35 NORTH, RANGE 3 EAST, W. M.

SKAGIT COUNTY, WASH.

SCALE, 1 INCH--400 FEET

DATE June, 1959

Frank Gilkey COUNTY ENGINEER

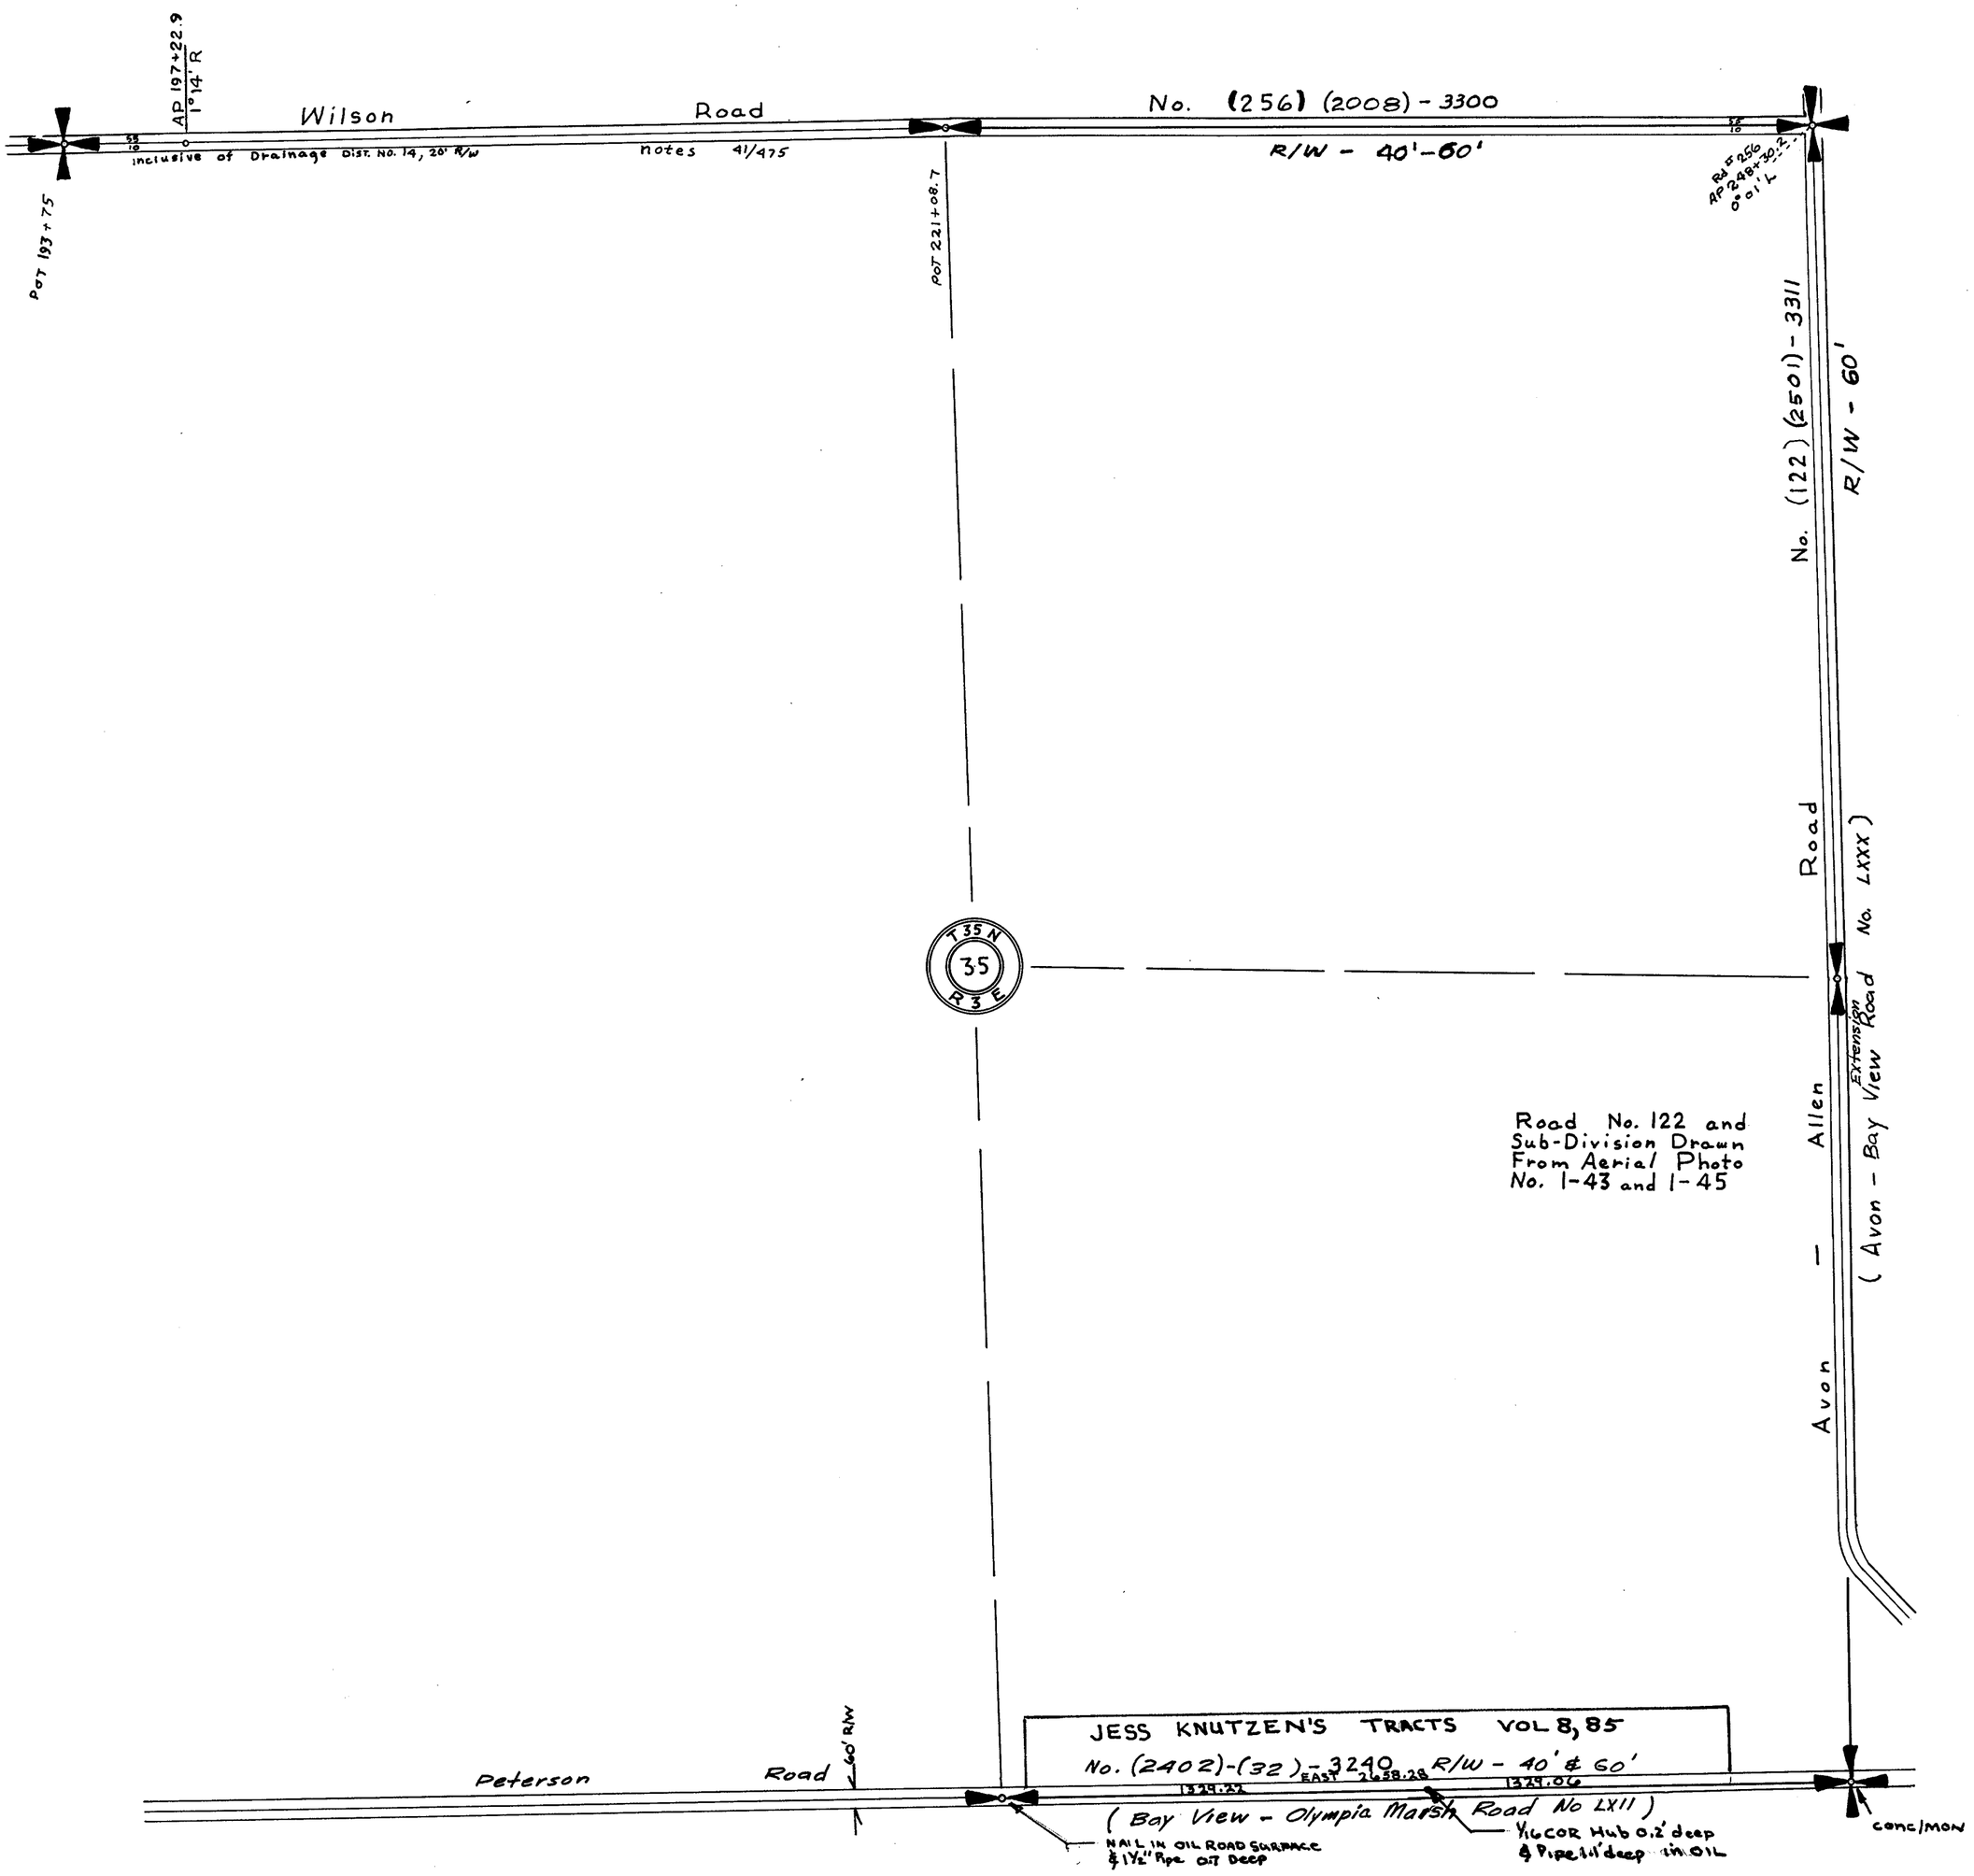

SECTION 36


TOWNSHIP 35 NORTH, RANGE 3 EAST, W. M.

SKAGIT COUNTY, WASH.

SCALE, 1 INCH--400 FEET

DATE June 20, 1963

LLOYD H. JOHNSON COUNTY ENGINEER

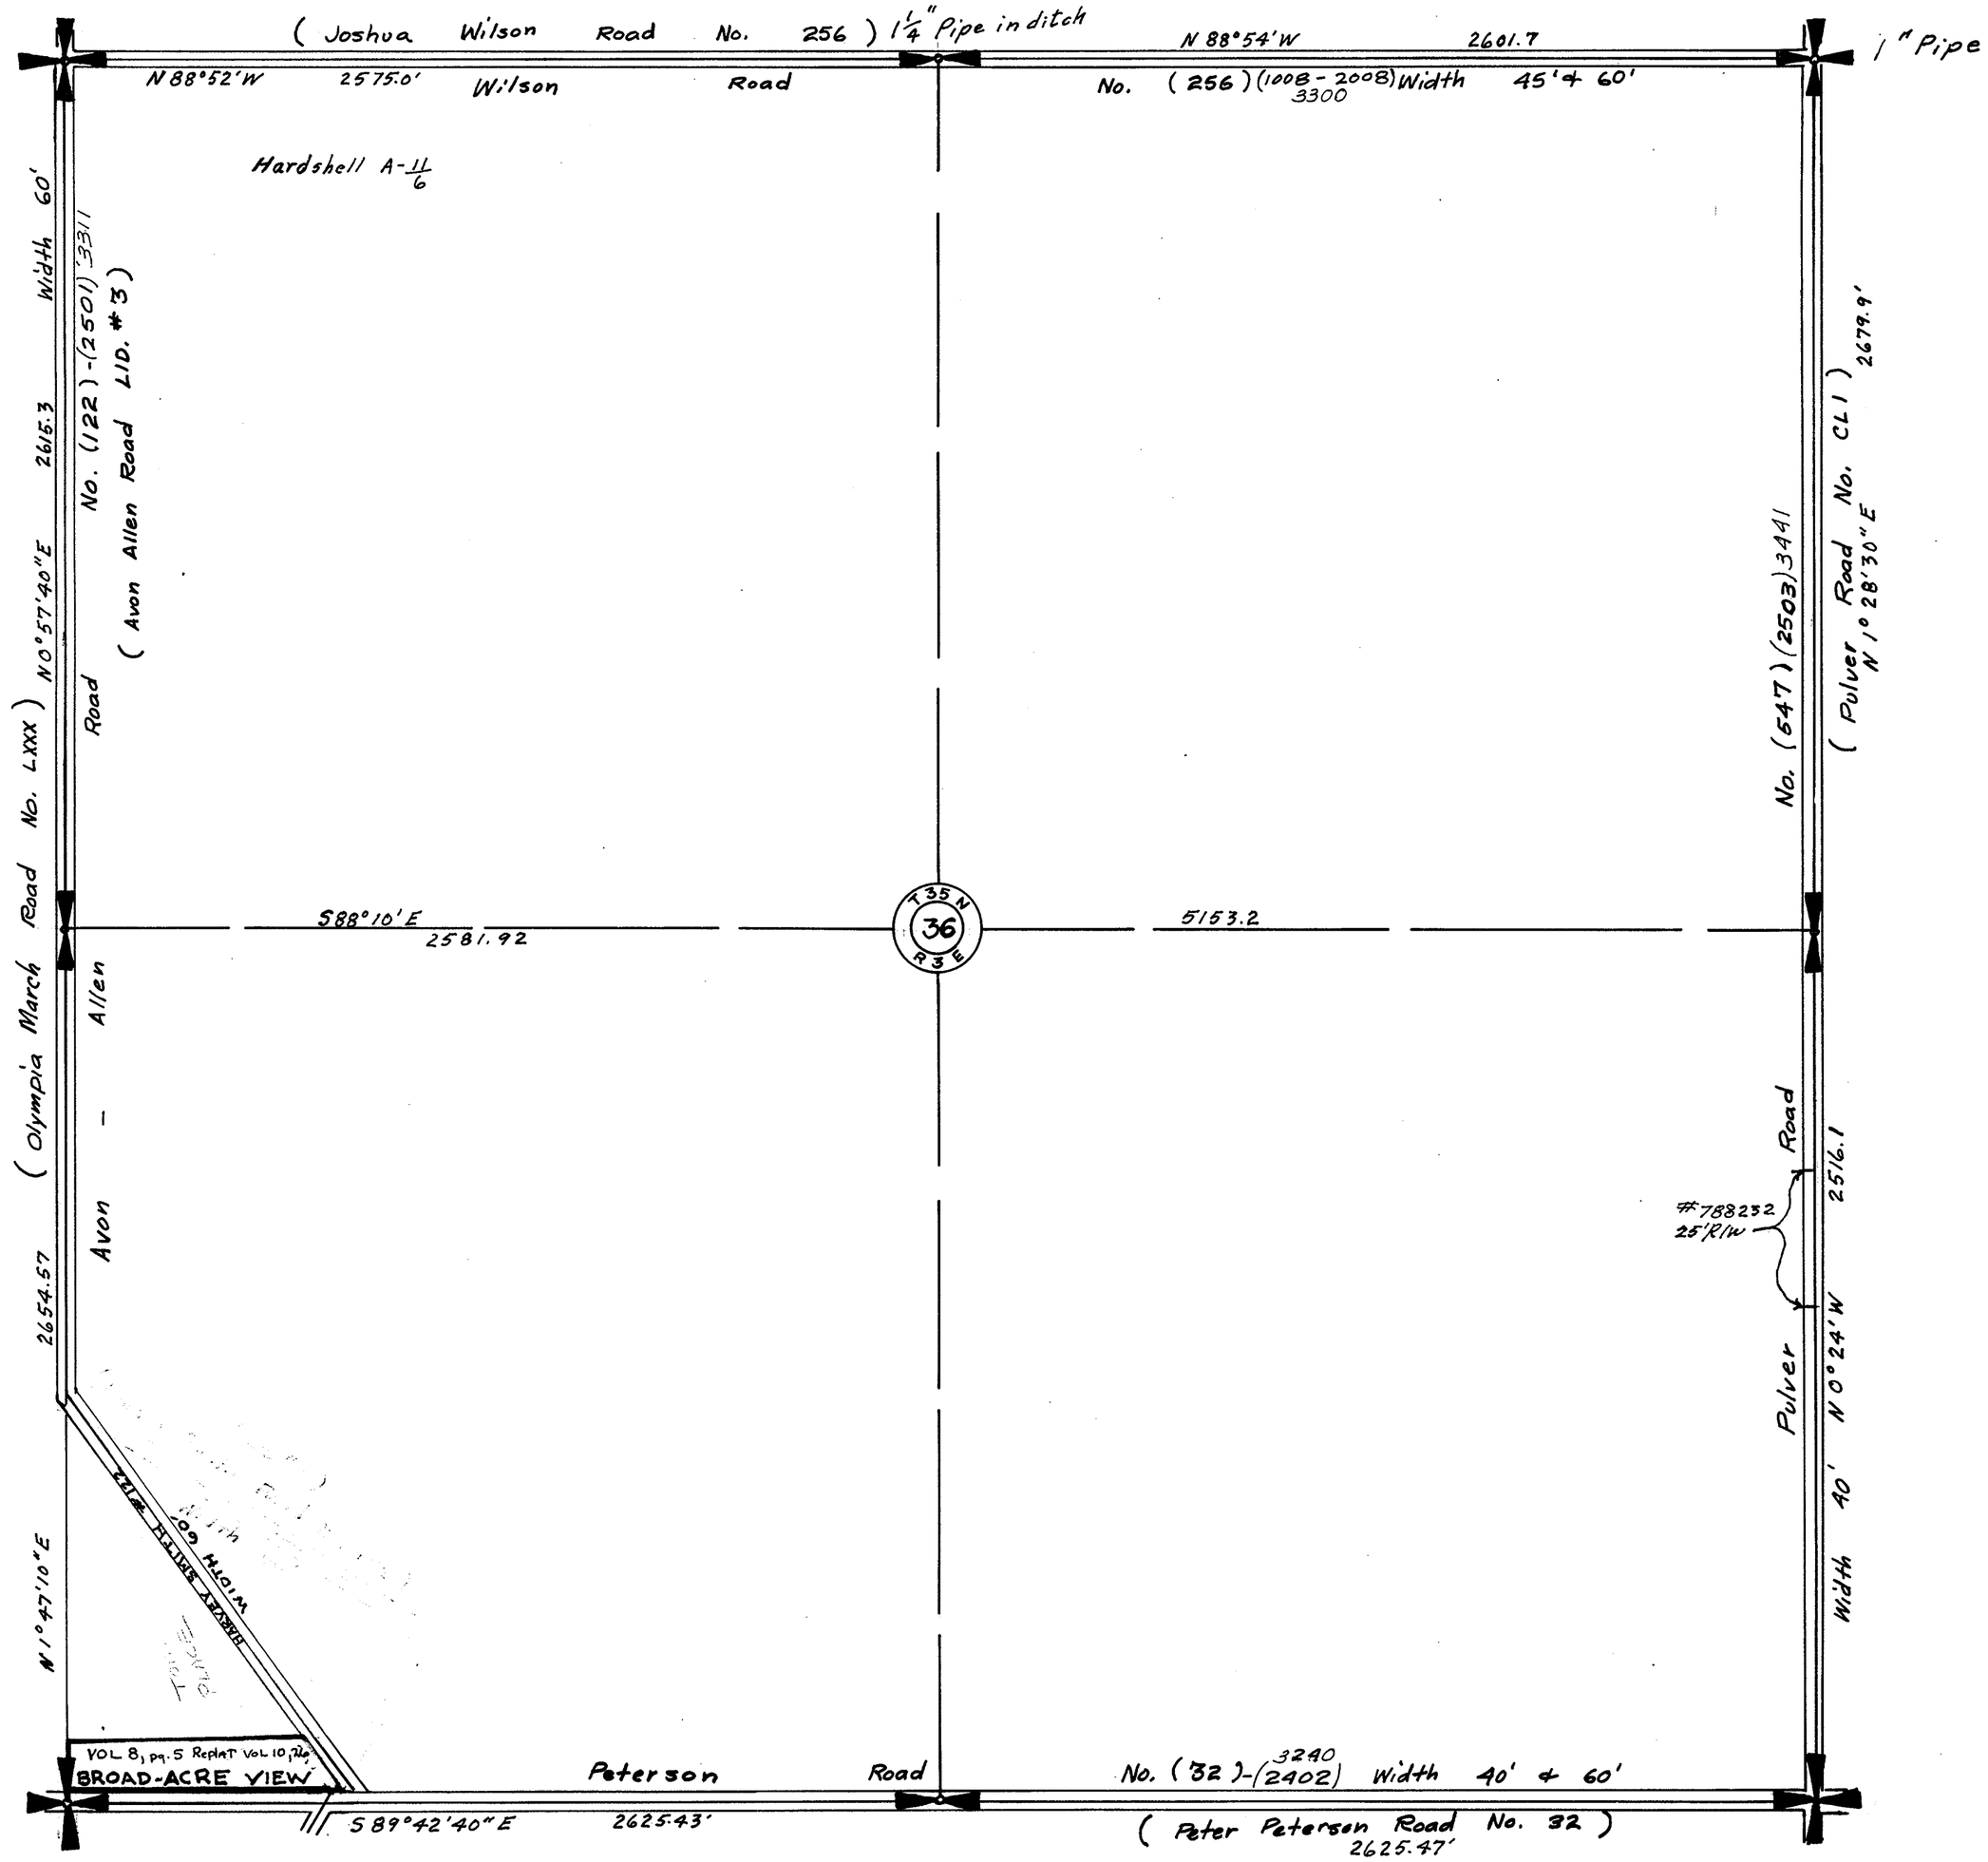

SECTION 1


TOWNSHIP 35 NORTH, RANGE 4 EAST, W. M.

SKAGIT COUNTY, WASH.

SCALE, 1 INCH--400 FEET

DATE Aug. 1965

COUNTY ENGINEER

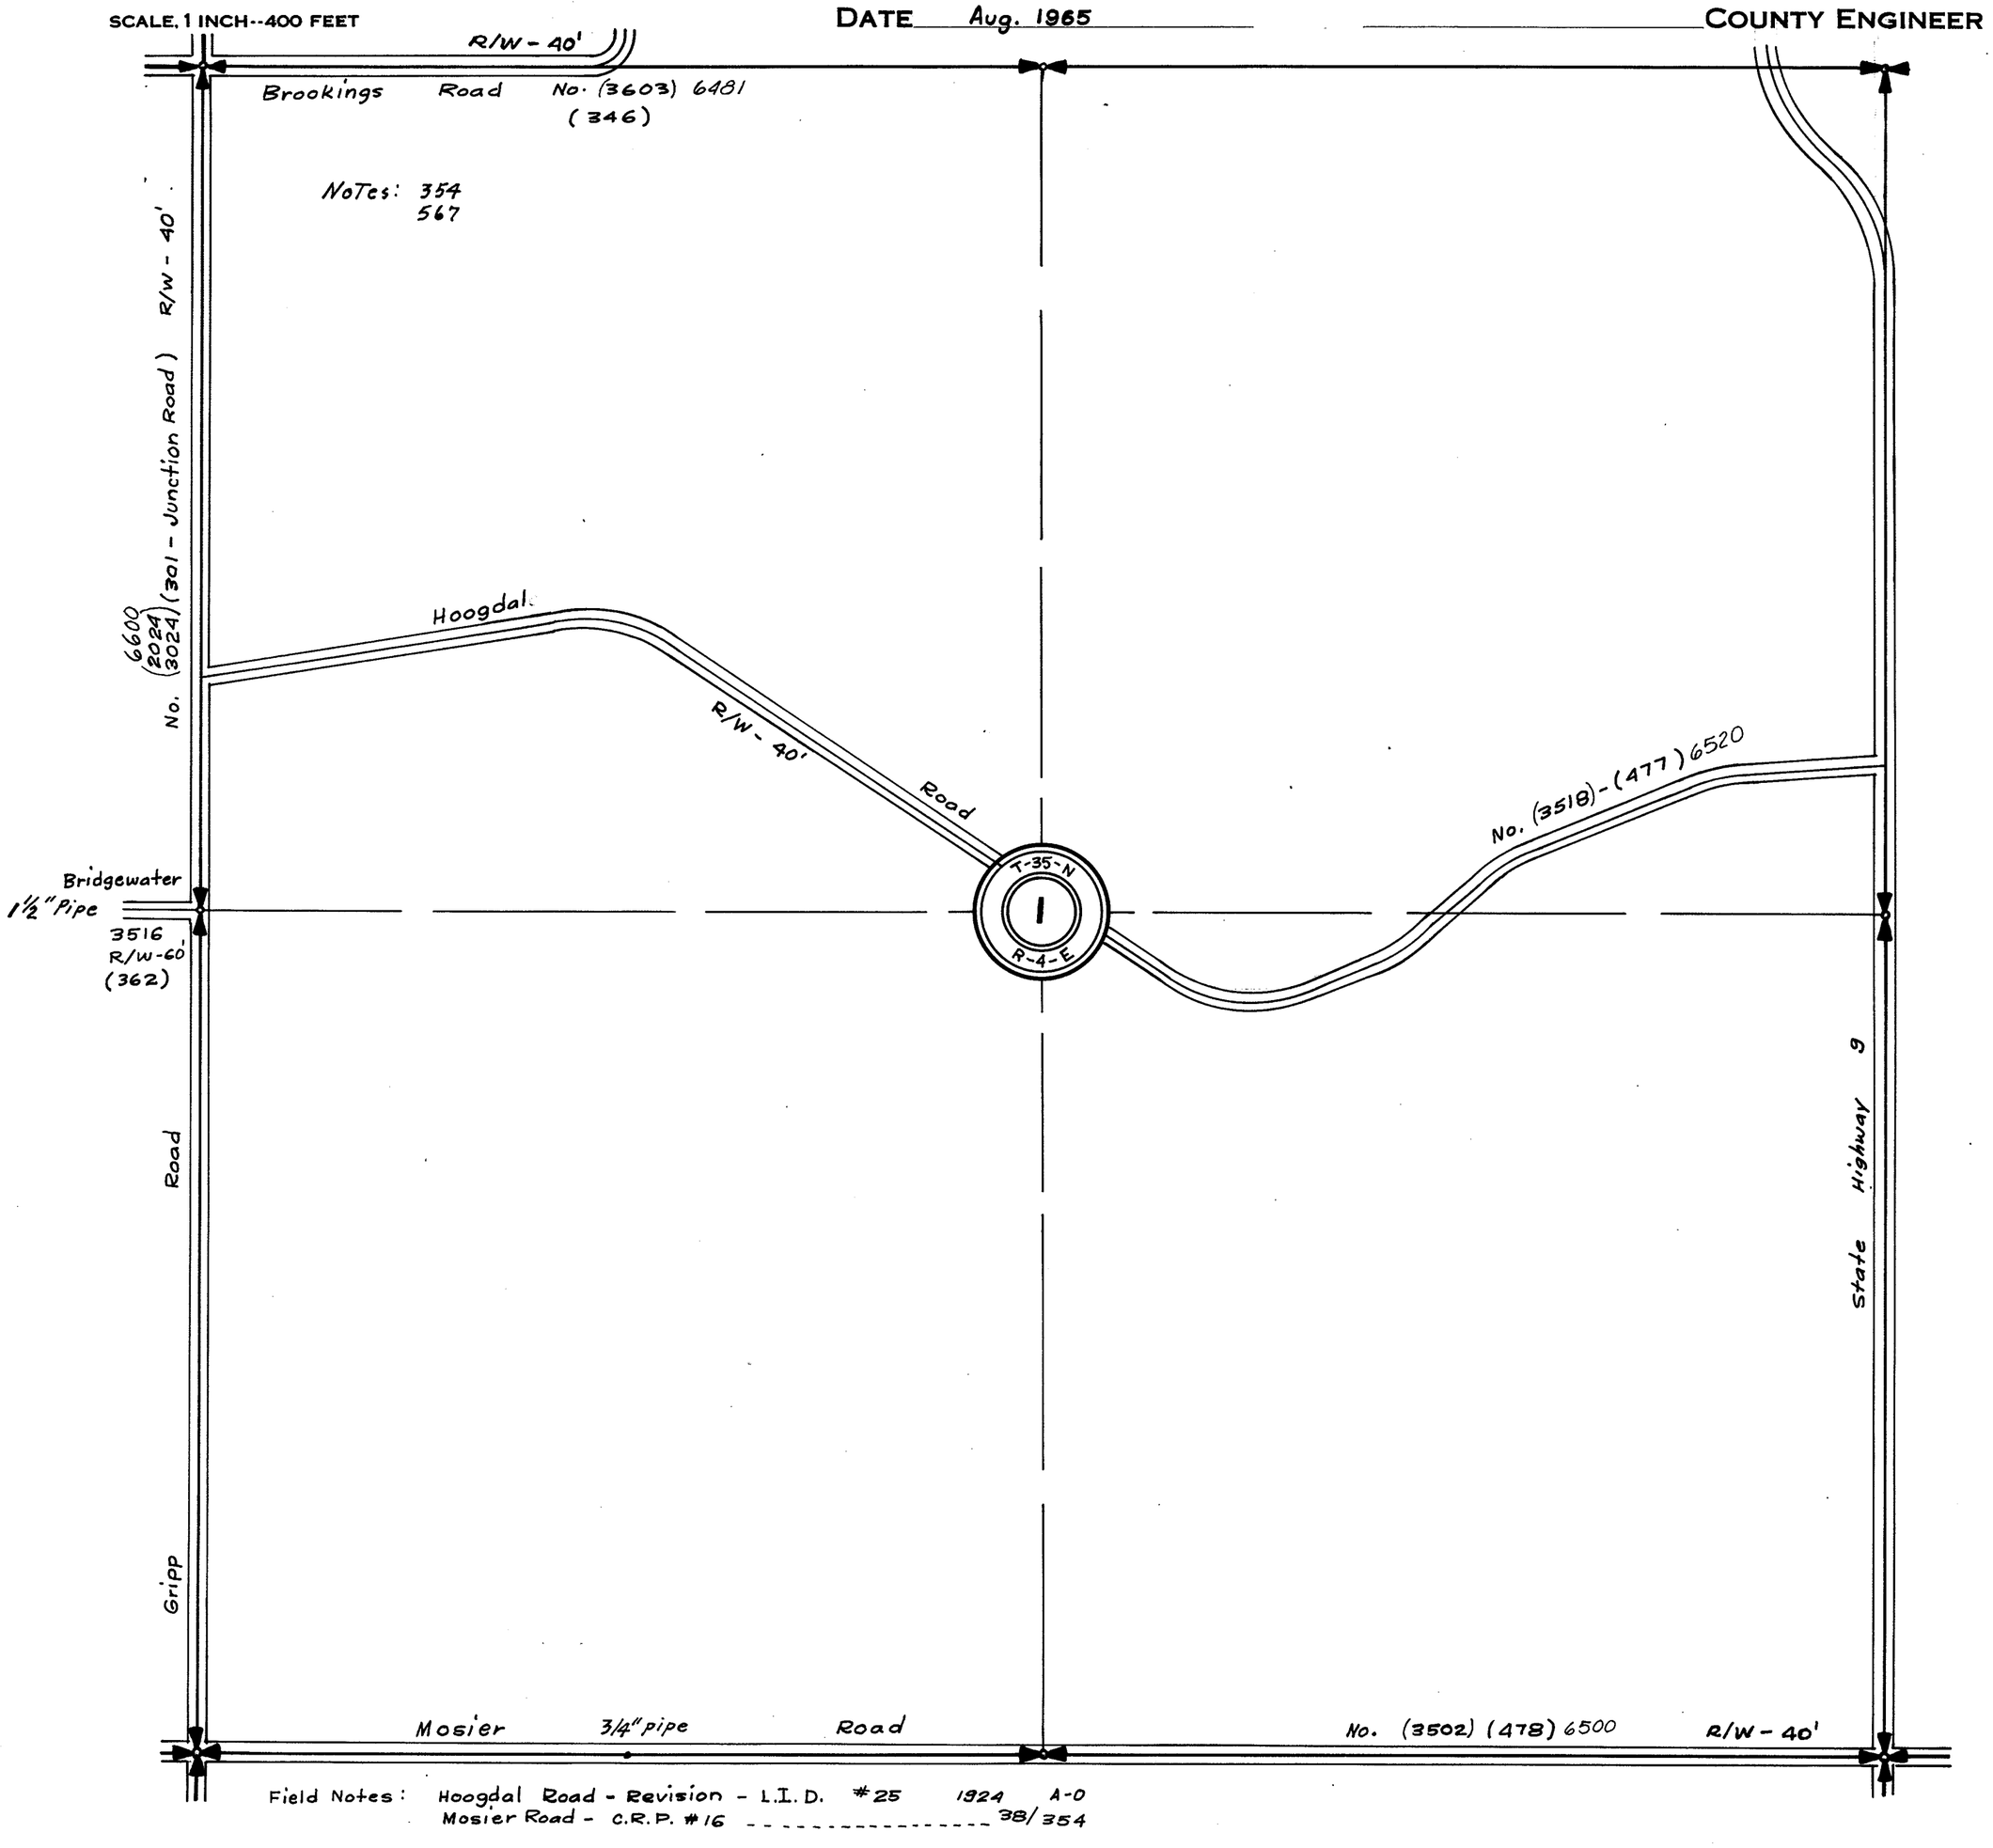

Field Notes: Hoogdal Road - Revision - L.I.D. #25 1924 A-0
Mosier Road - C.R.P. #16 ---------- 38/354

SECTION 1


TOWNSHIP 35 NORTH, RANGE 4 EAST, W. M.

SKAGIT COUNTY, WASH.

H.O. WALBERG COUNTY ENGINEER

FROM 1923 SURVEY

SCALE, 1 INCH--400 FEET

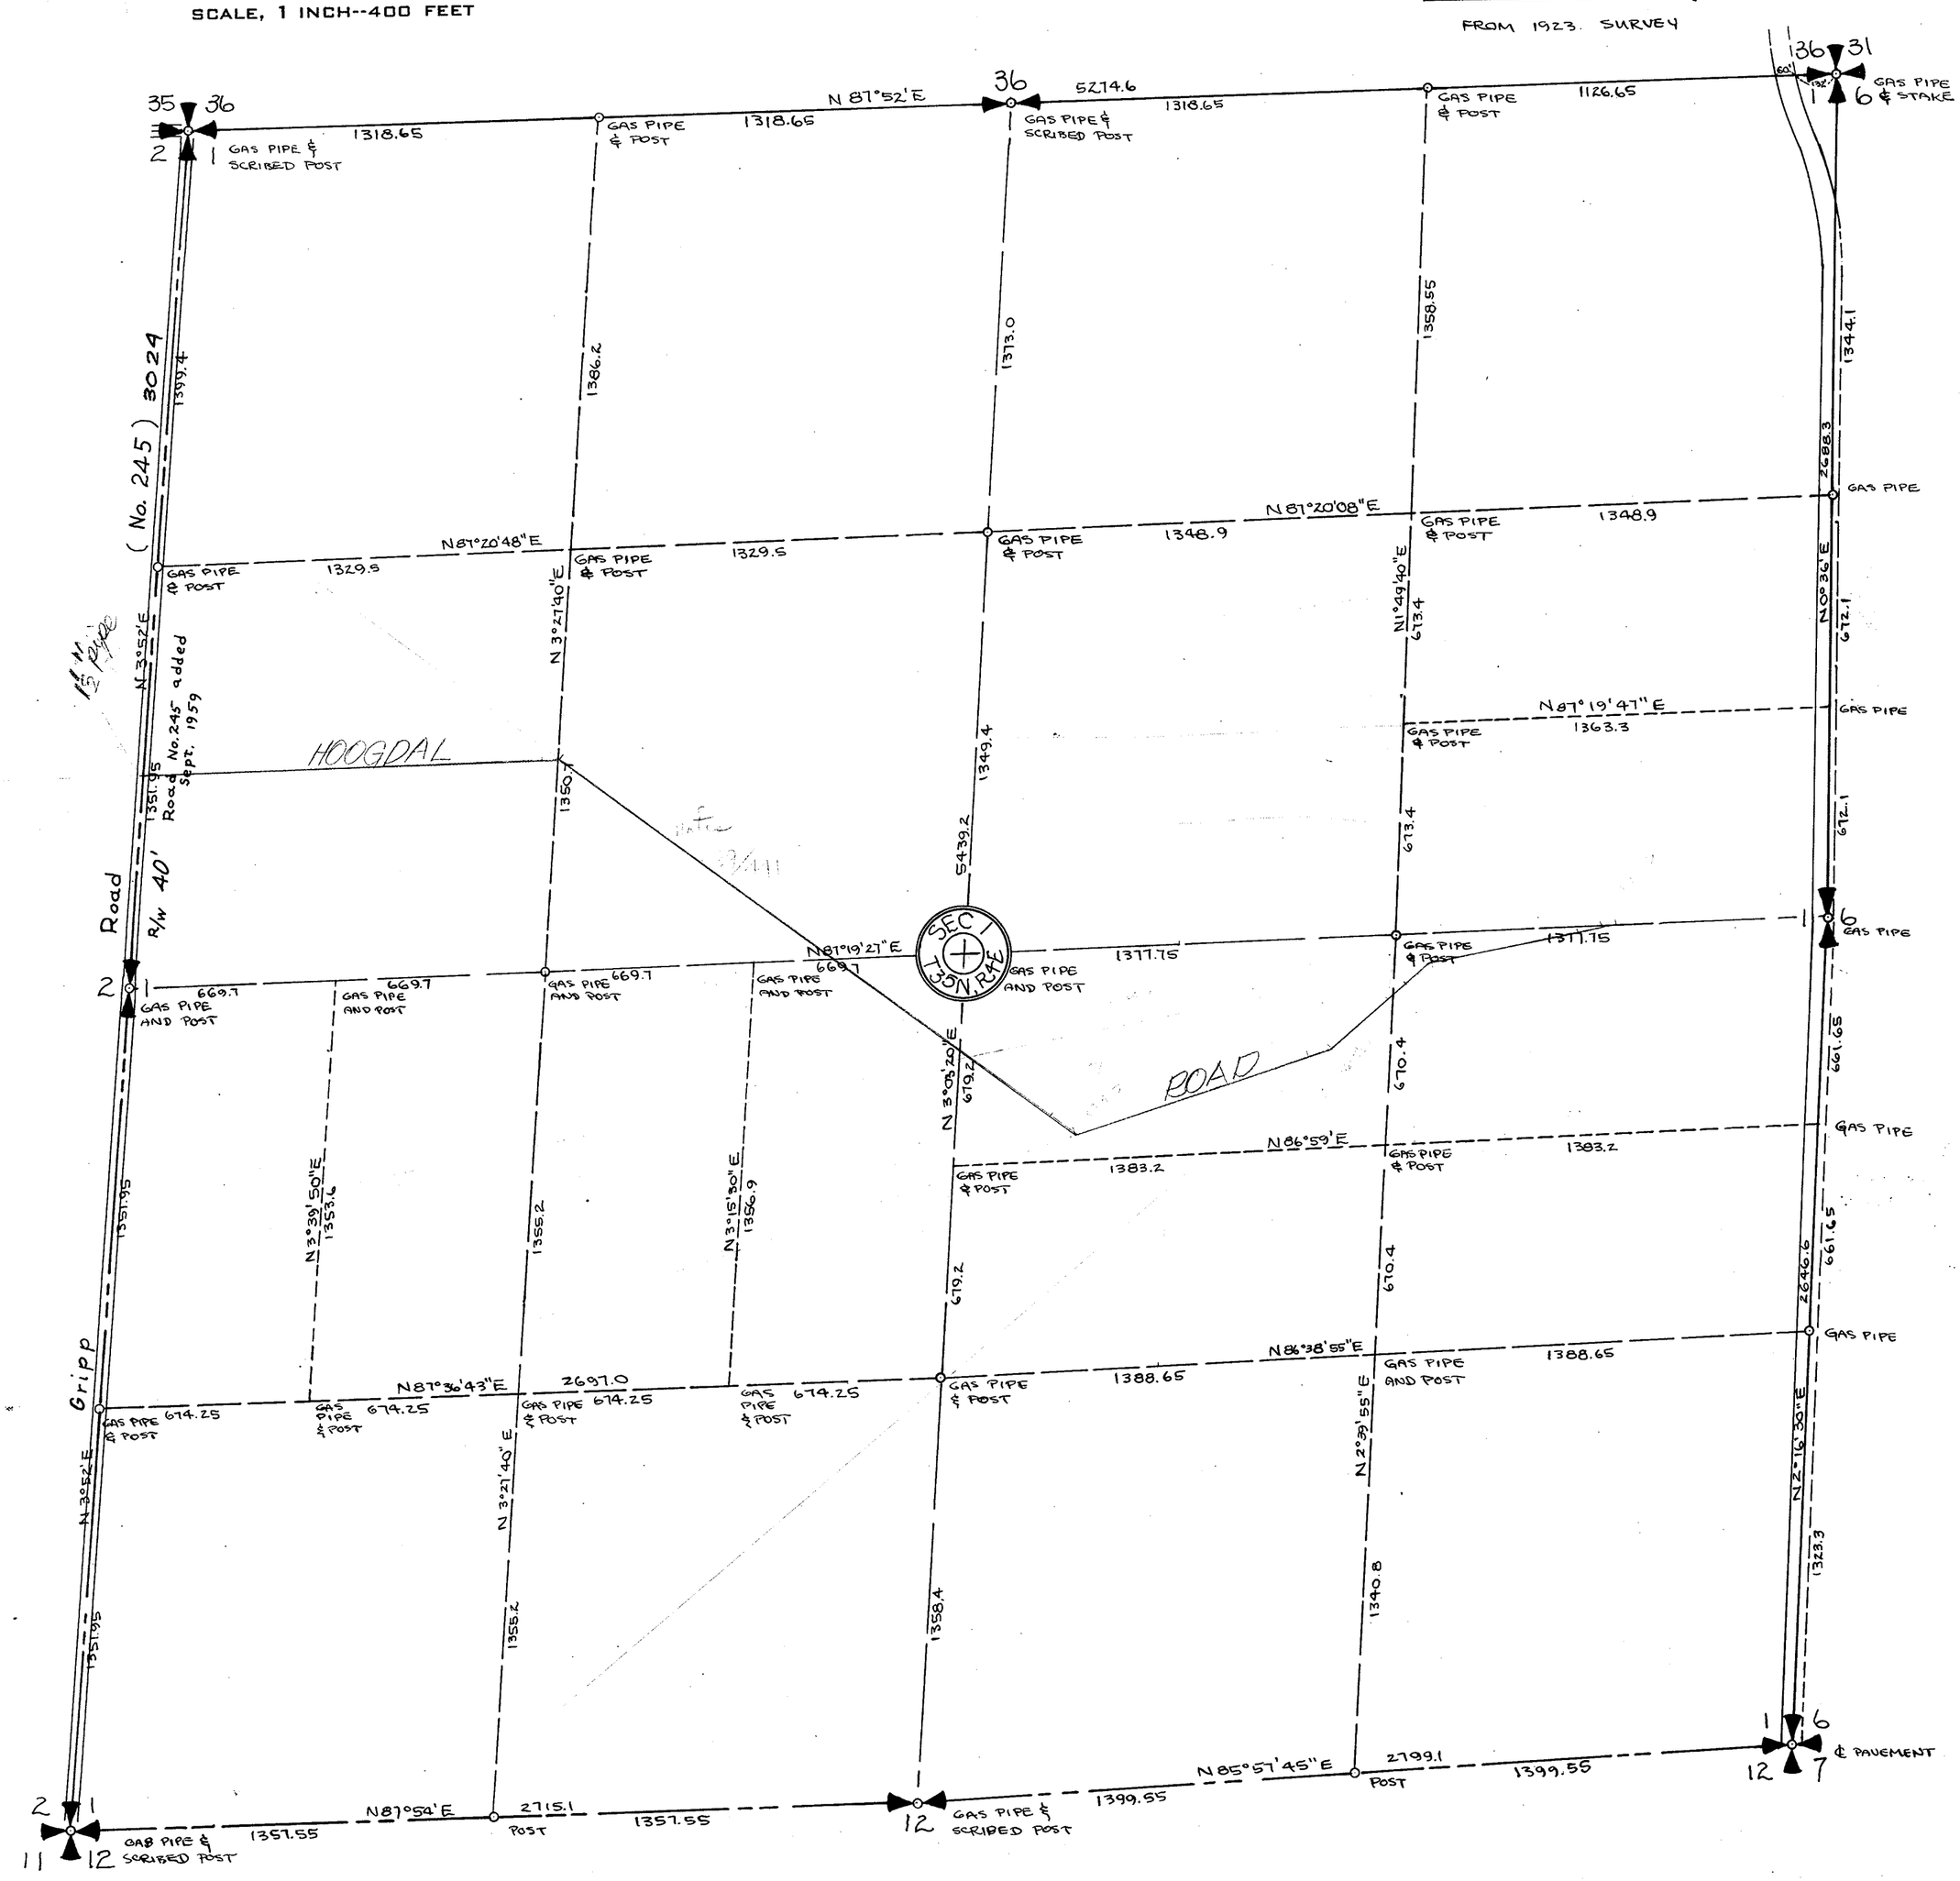


SECTION 1

TOWNSHIP 35 NORTH, RANGE 4 EAST, W. M.
SKAGIT COUNTY, WASH.

SCALE, 1 INCH–400 FEET

Arthur L. Strong, COUNTY ENGINEER

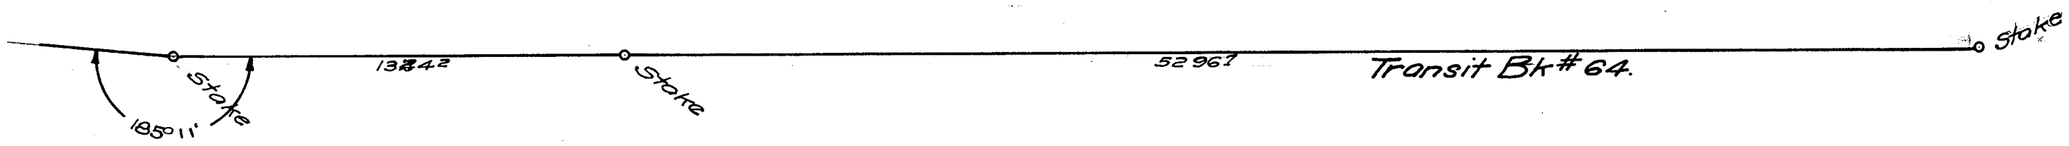

SECTION 2


TOWNSHIP 35 NORTH, RANGE 4 EAST, W. M.

SKAGIT COUNTY, WASH.

SCALE, 1 INCH--400 FEET

H.O. WALBERG COUNTY ENGINEER

1923 Survey

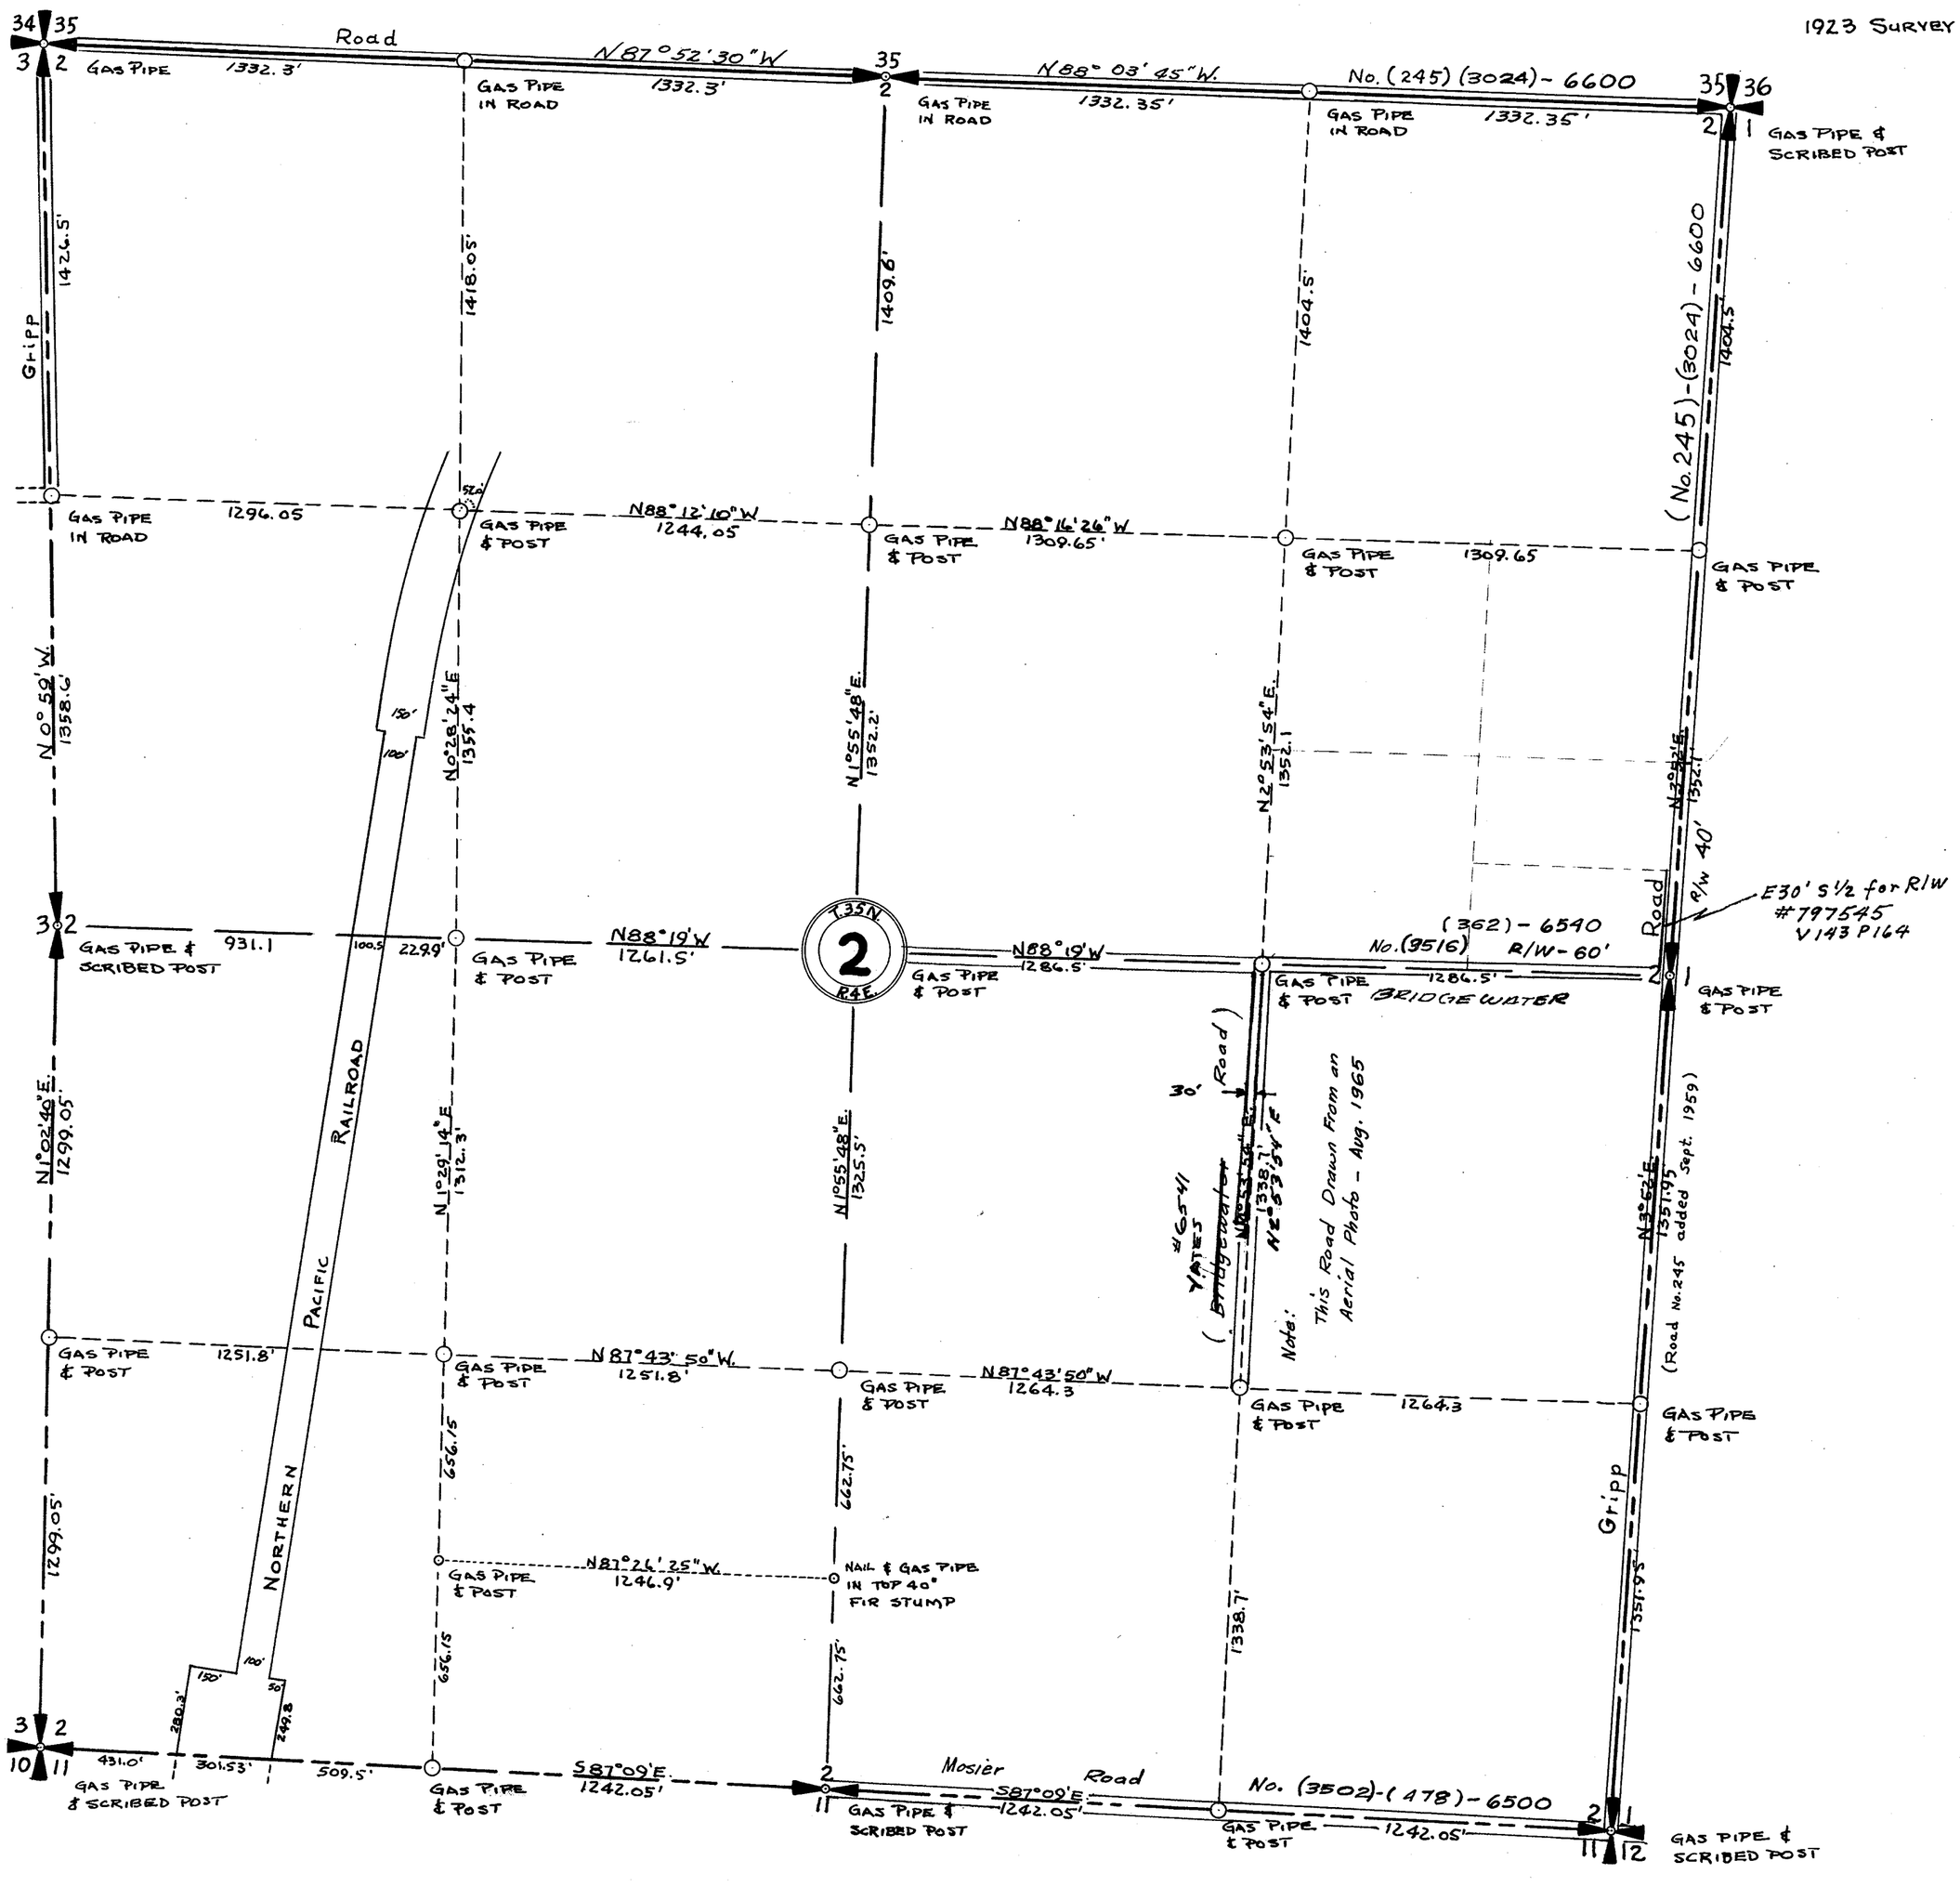


SECTION 2

TOWNSHIP 35 NORTH, RANGE 4 EAST, W. M.
SKAGIT COUNTY, WASH.

SCALE, 1 INCH–400 FEET

Arthur L. Strong. COUNTY ENGINEER

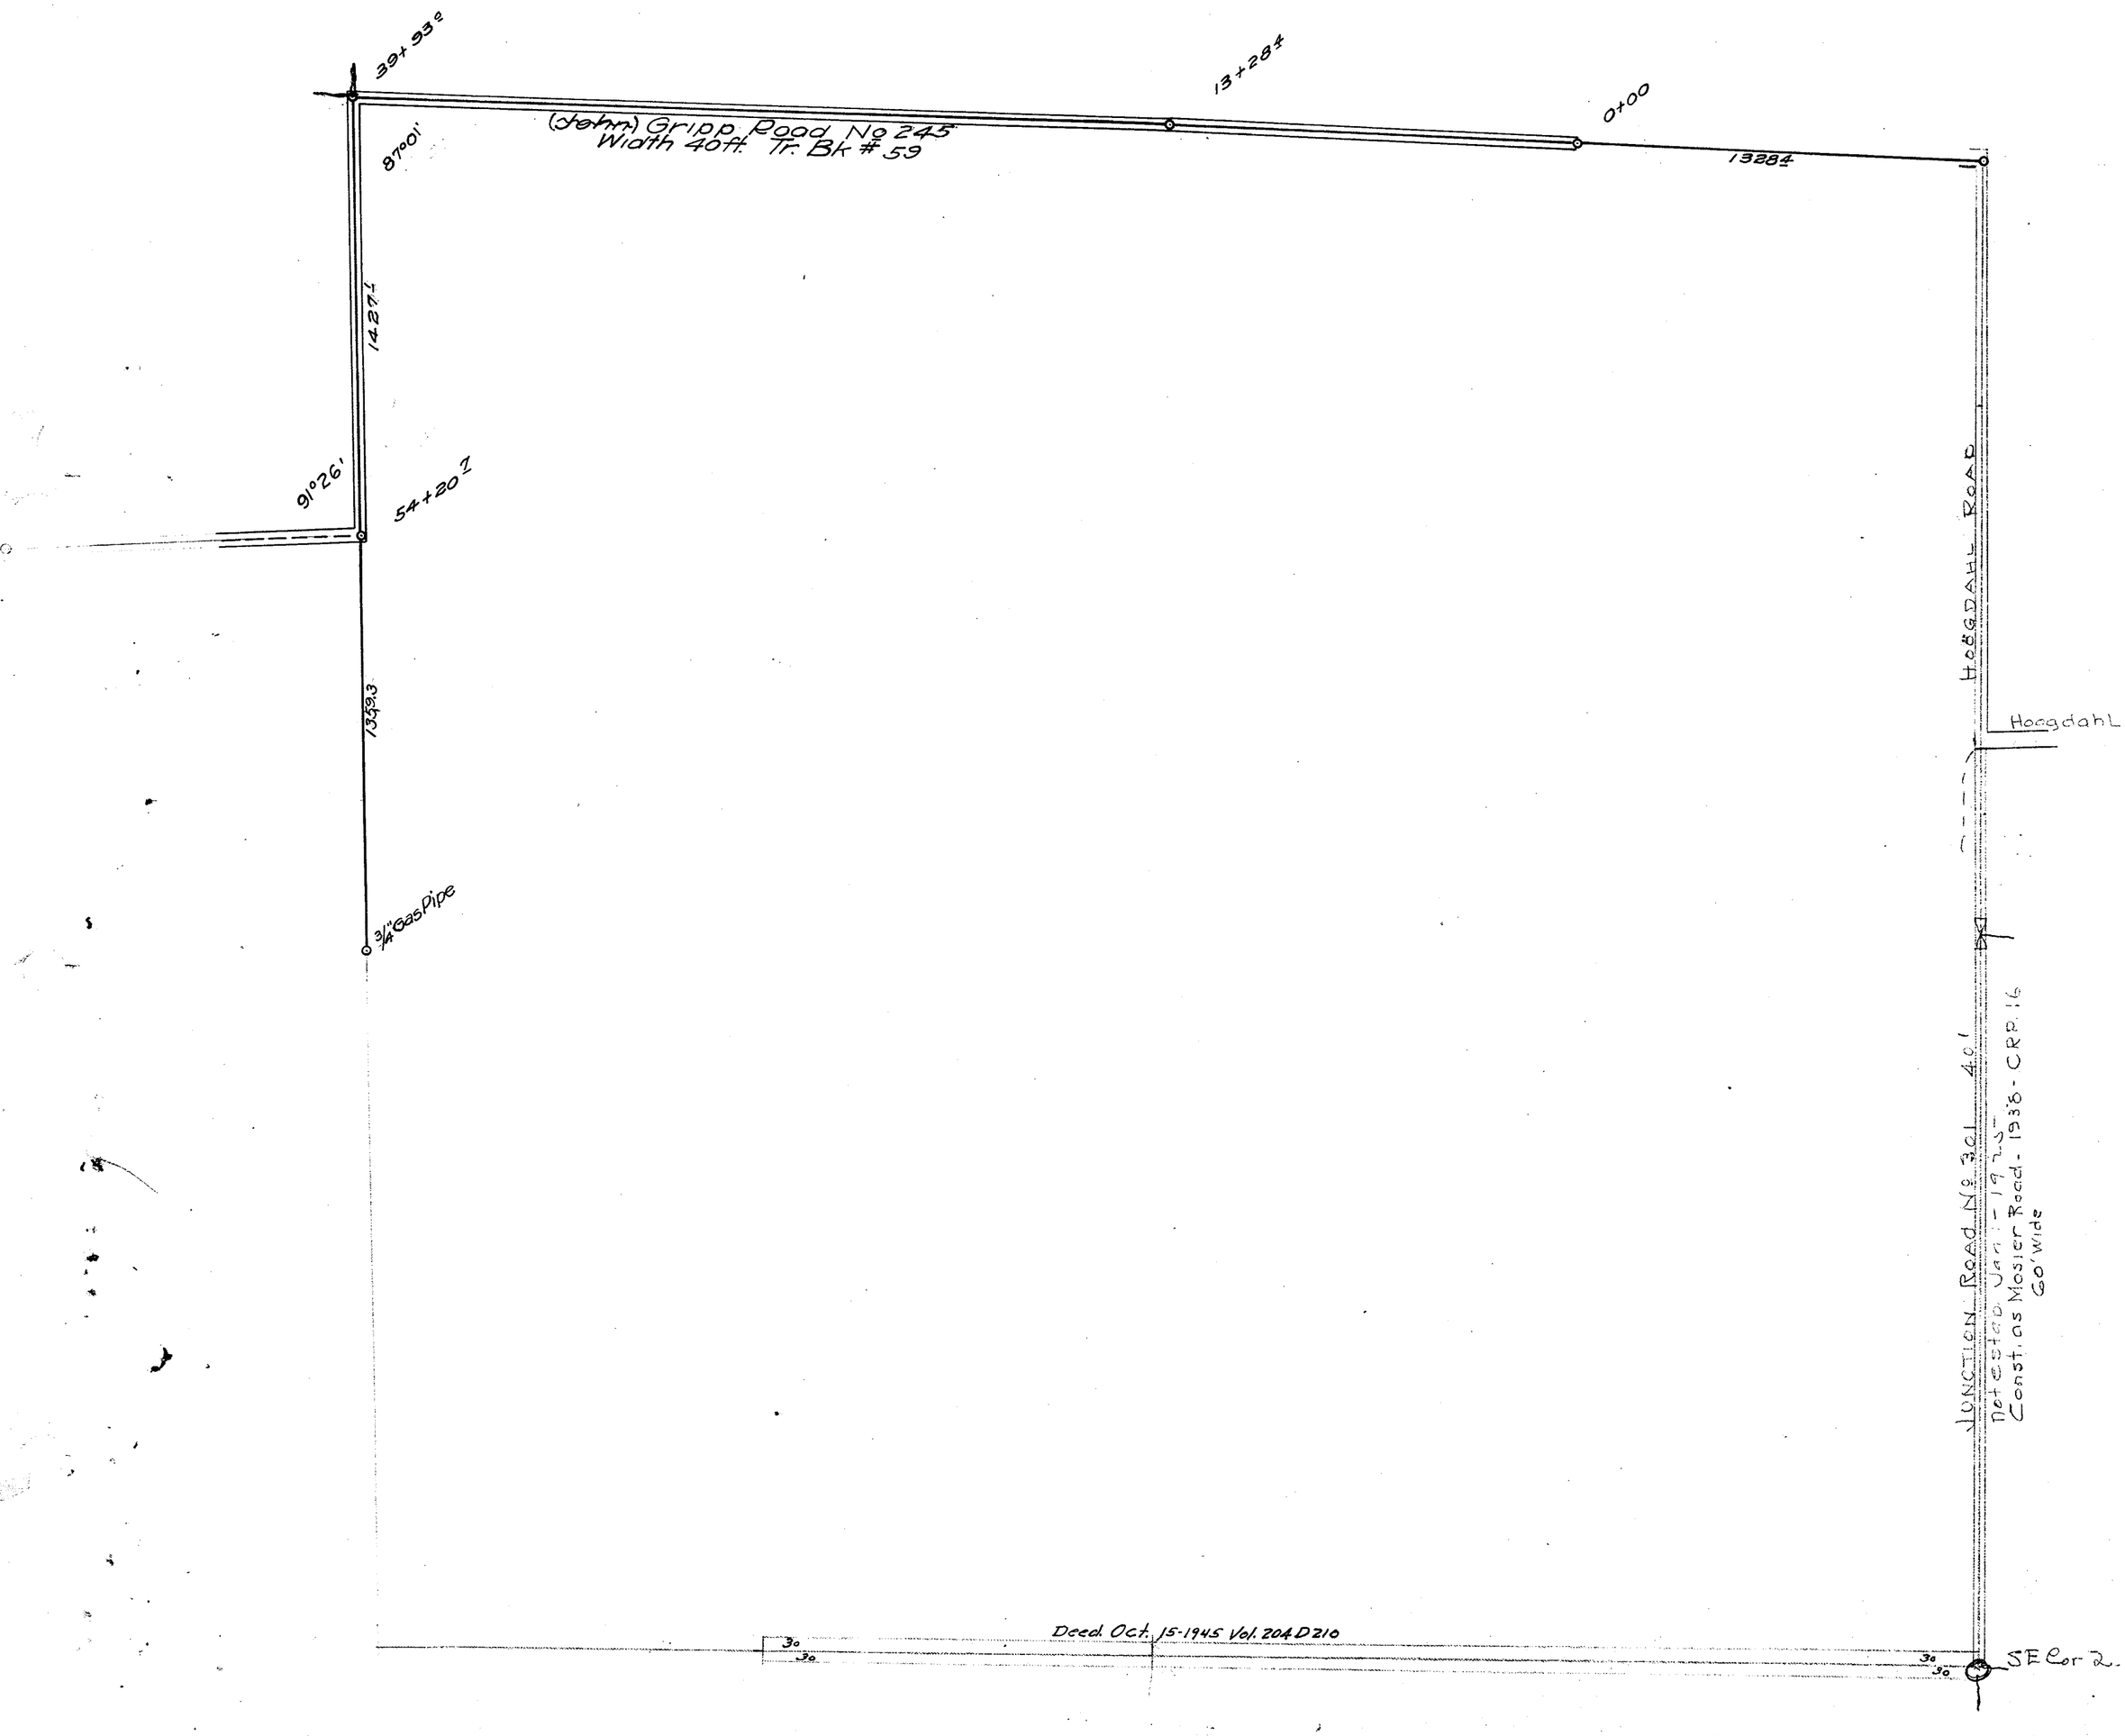


SECTION 3

TOWNSHIP 35 NORTH, RANGE 4 EAST, W. M.
SKAGIT COUNTY, WASH.

SCALE, 1 INCH–400 FEET

A.L.STRONG. COUNTY ENGINEER

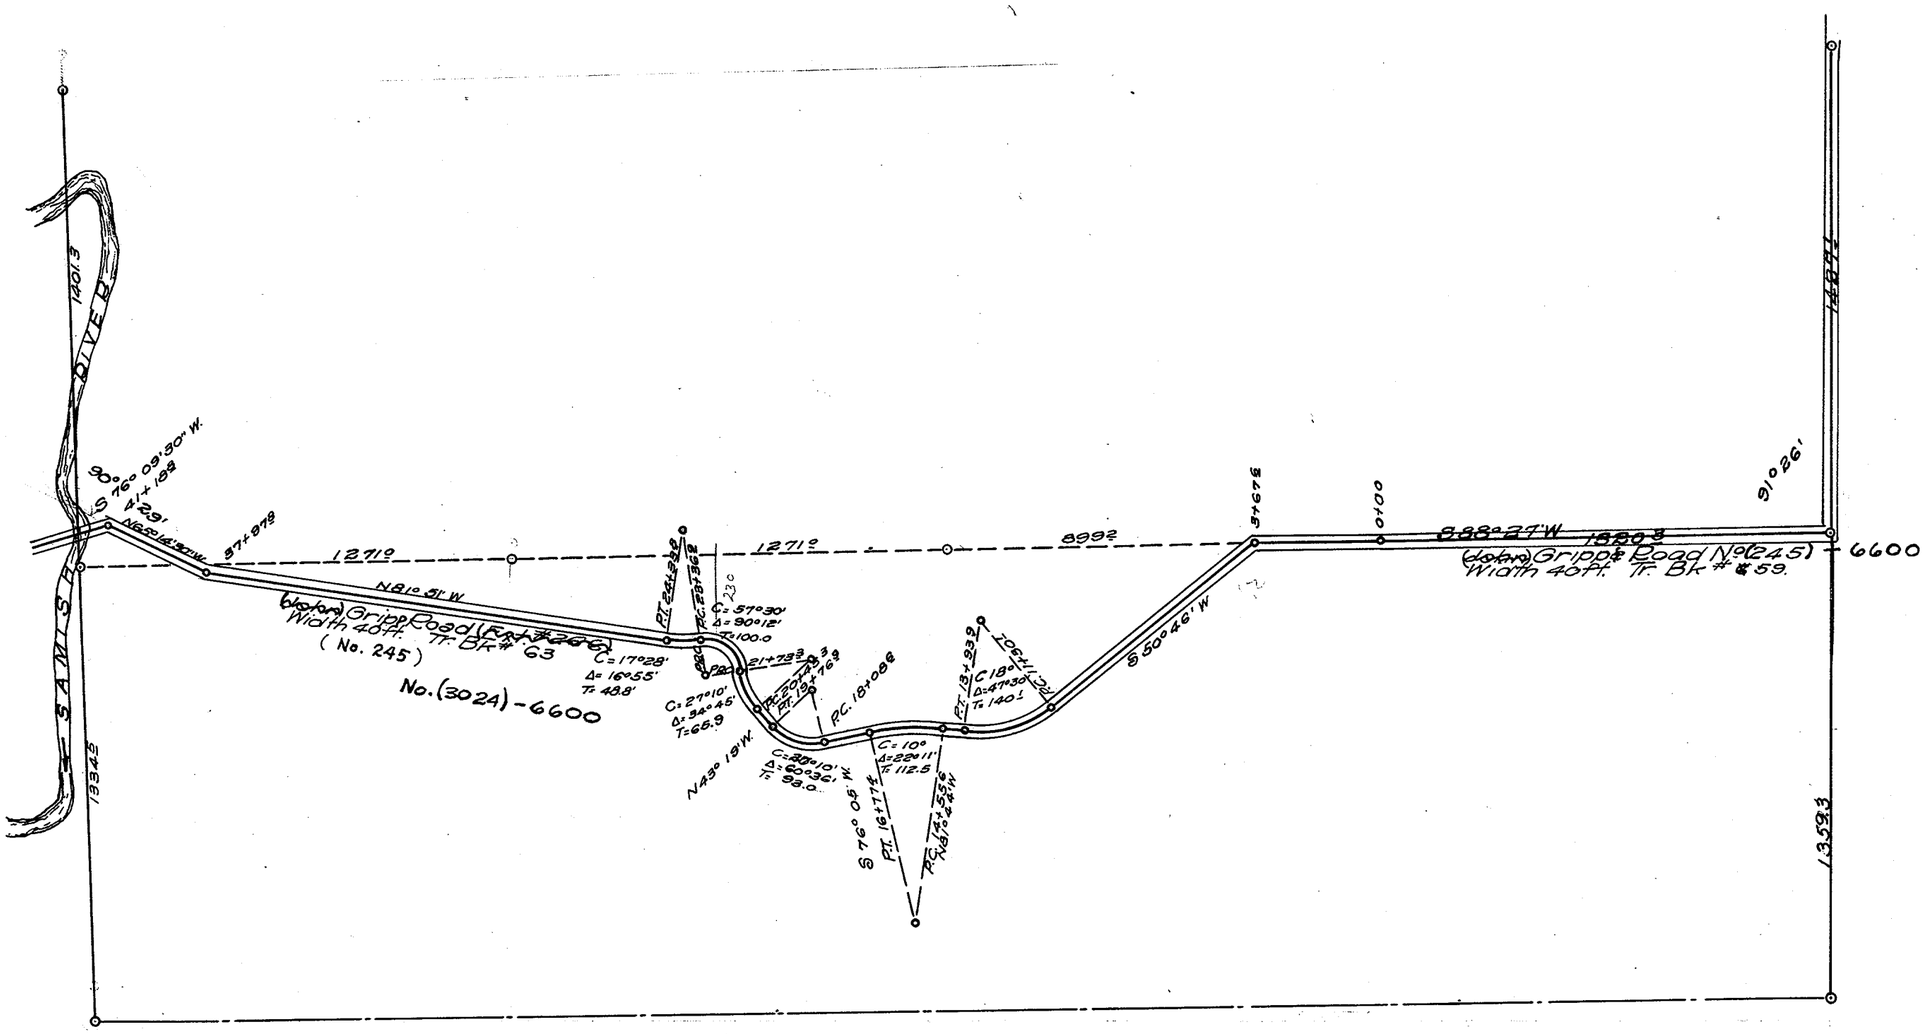

Platted Aug. 1939 by AI
Notes: 38/371


SECTION 4

TOWNSHIP 35 NORTH, RANGE 4 EAST, W. M.

SKAGIT COUNTY, WASH.

SCALE. 1 INCH--400 FEET

W.A. COSTELLO COUNTY ENGINEER

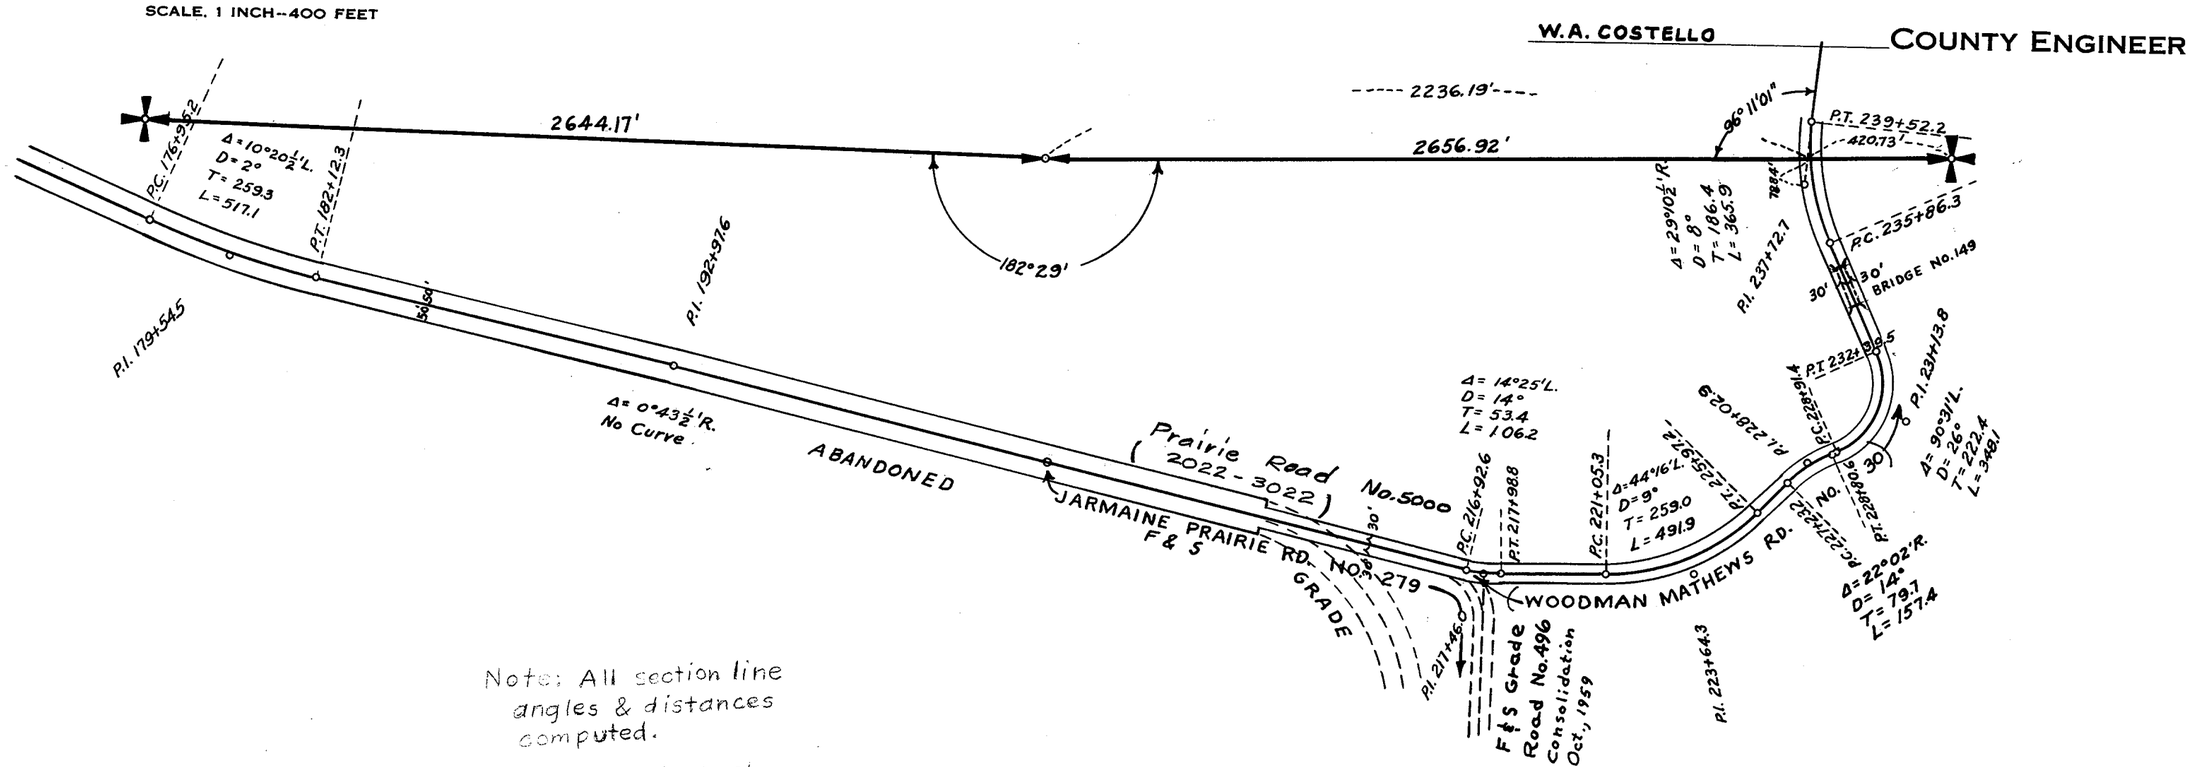


Note: All section line angles & distances computed.

See also next sheet

SECTION 4
TOWNSHIP 35 NORTH, RANGE 4 EAST, W. M.
SKAGIT COUNTY, WASH.

SCALE, 1 INCH--400 FEET

DATE _____ _____ COUNTY ENGINEER

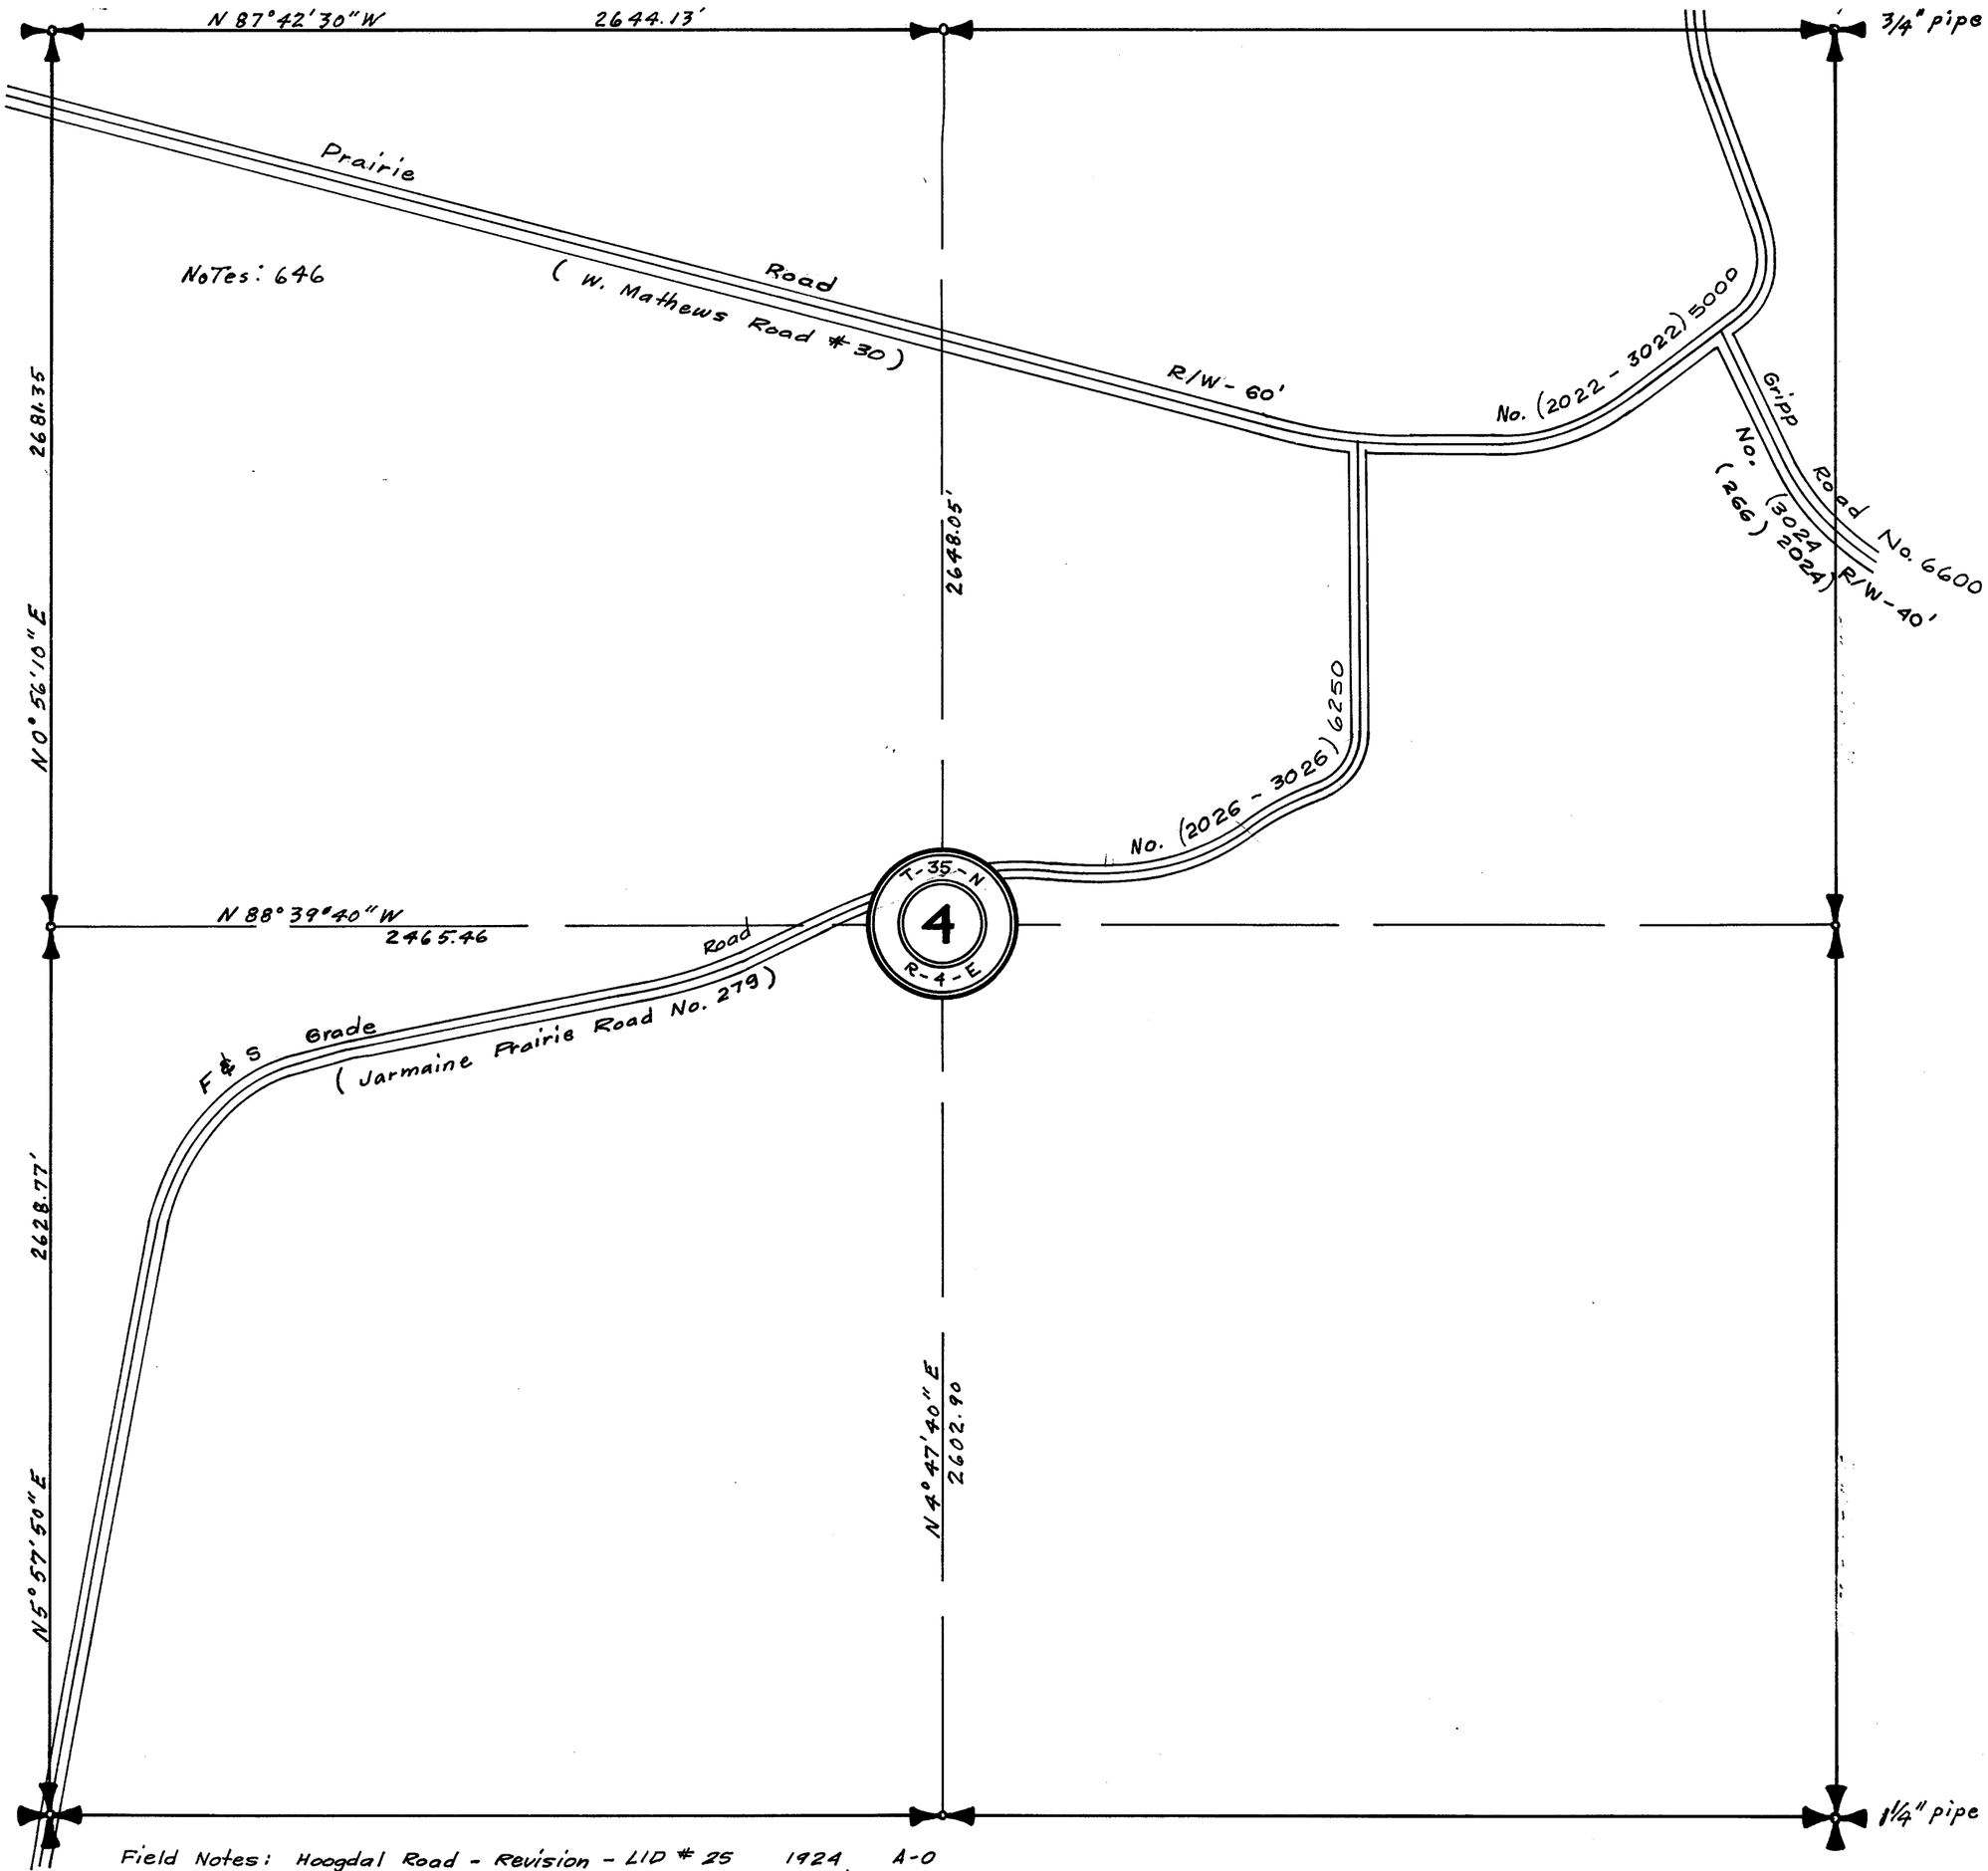


Field Notes:
Hoogdal Road - Revision - LID # 25 1924 A-0
Woodman - Matthews Road #30 - Retracement 38/371 1/2
Bridge #355 - Traverse for Relocation (Cross Section) 42/519
F&S Grade - 1/4 Mile West of Baker (River Railroad) 46/580
Bridge #149 - Woodman Matthews Road #30 49/641
Bridge #355 1949, 1960, 1953 646

SECTION 4

TOWNSHIP 35 NORTH, RANGE 4 EAST, W. M.
SKAGIT COUNTY, WASH.

SCALE, 1 INCH–400 FEET

Arthur L. Strong COUNTY ENGINEER

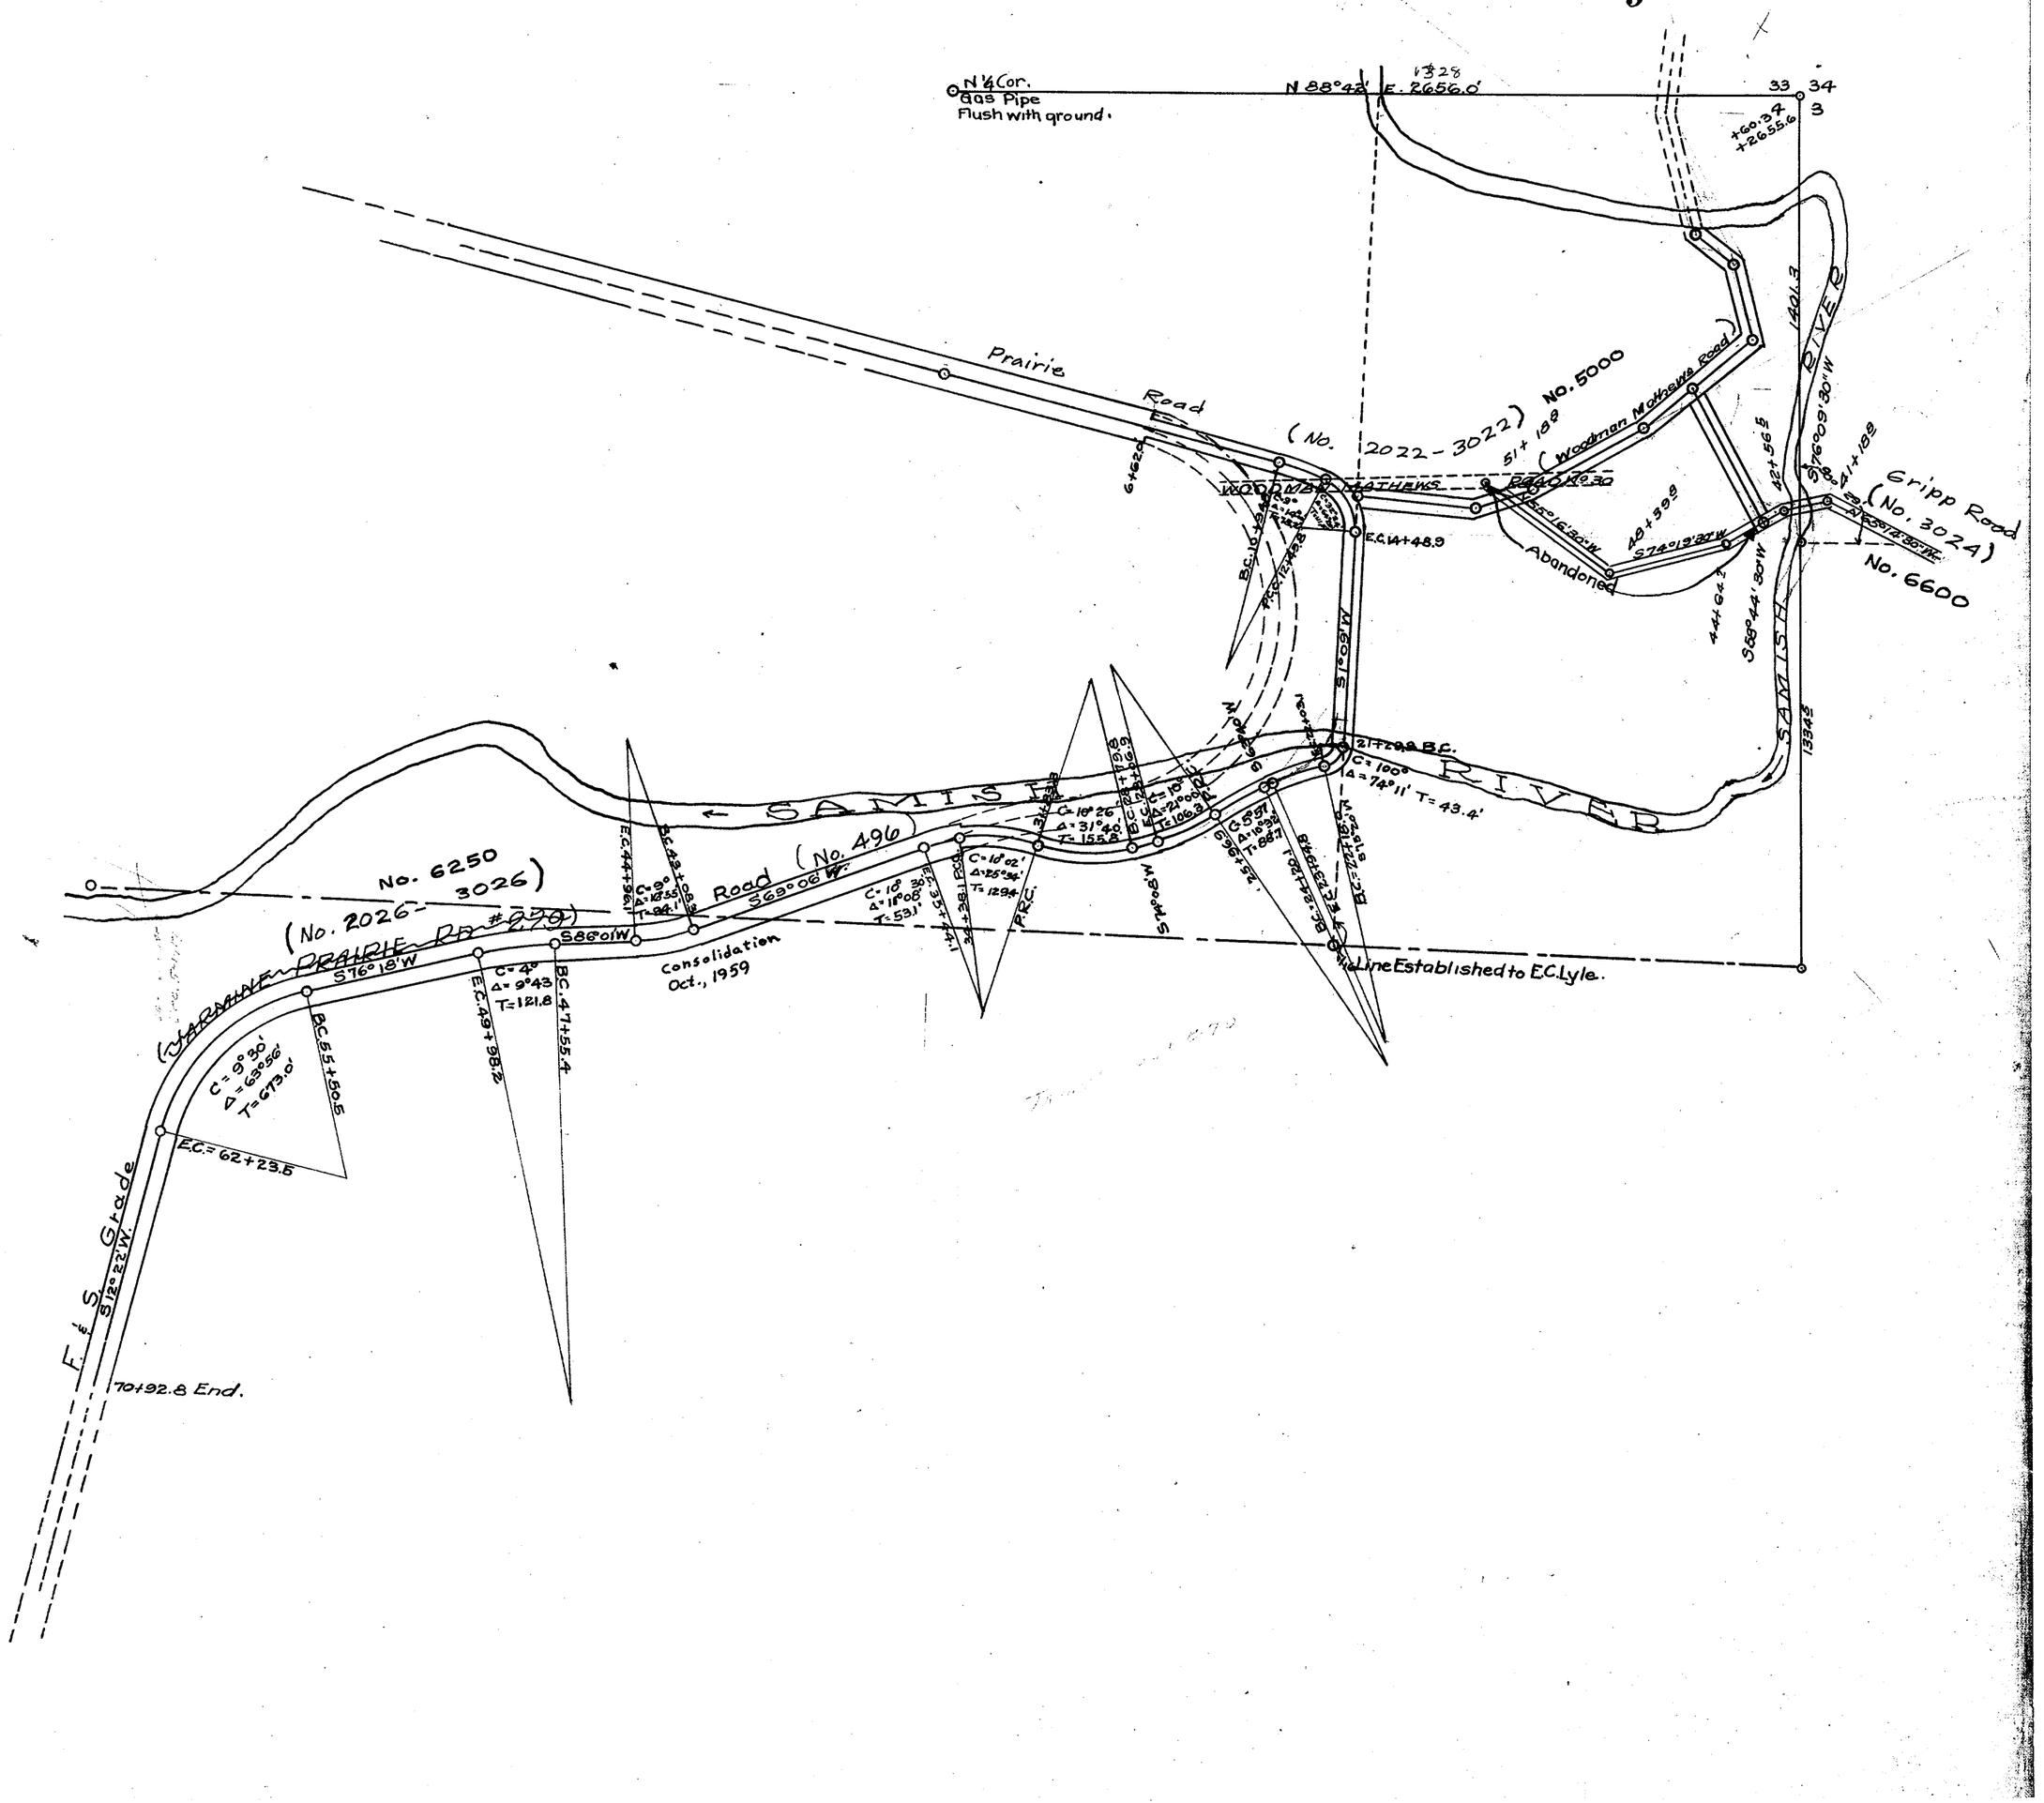


SECTION 4

TOWNSHIP 35 NORTH, RANGE 4 EAST, W. M.

SKAGIT COUNTY, WASH.

SCALE, 1 INCH--400 FEET

H.O. WALBERG COUNTY ENGINEER
1949 NOTES 36/314

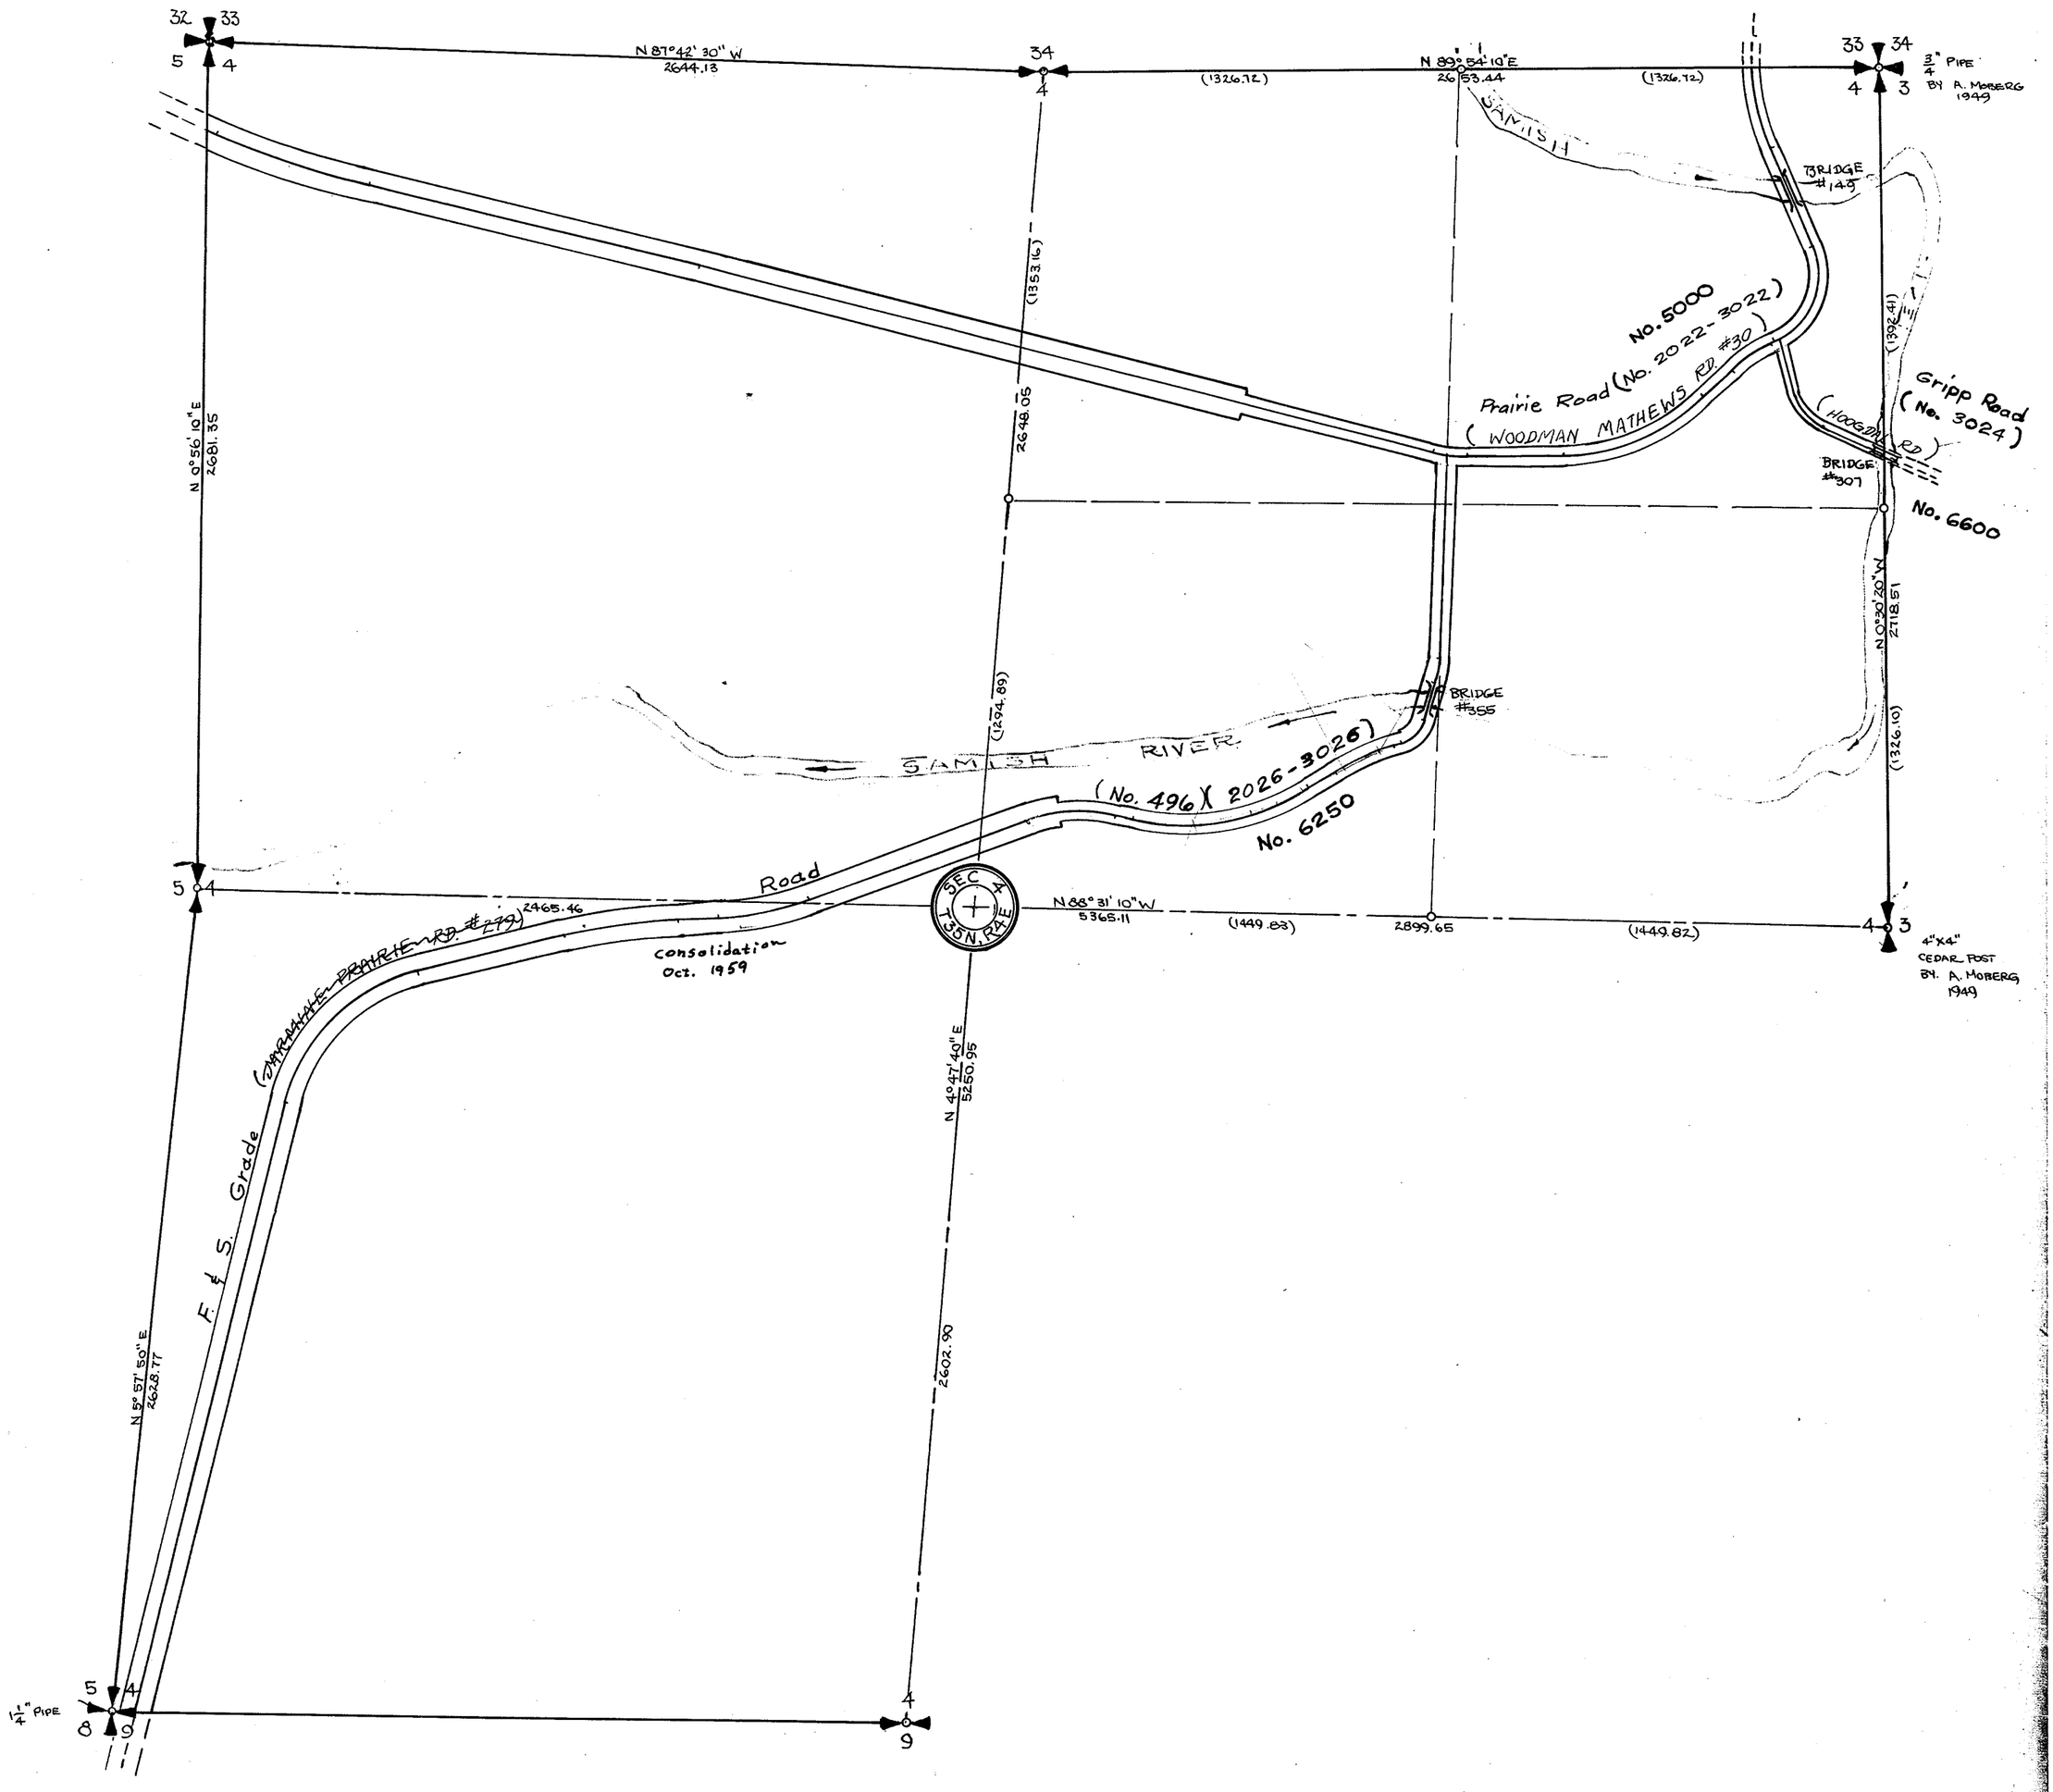

Drawn 1939 by AH
Notes: 38/371

SECTION 5

TOWNSHIP 35 NORTH, RANGE 4 EAST, W. M.

SKAGIT COUNTY, WASH.

W. A. COSTELLO — COUNTY ENGINEER

SCALE, 1 INCH--400 FEET

U.S. 99 - SAMISH BR.

WARNER

13°24'37"

P.I. 113+04.0

Δ=14°-7½'
No Cv.
R=16015'L.
No Cv.

250.52'

P.I. 117+67.9

RD. NO. ? Width Not Given

P.I. 123+57.3

Friday Cr. BRIDGE NO. 11

XCY

R/W - 60'

P.T. 129+01.7

2684.77'

2684.35'

ABANDONED

22'±

686.76'

169+26.89

F. & S.

50'

50'

GRADE

Δ=10°-20½'L.
D=2°
T=259.3
L=517.1

F & S 1027.61'
Grade Road
(No. 496)
Consolidation Oct., 1959
(2026 - 3026)-6250

P.I. 179+94.5

180°-5'-23"

R/C. 111+65.2

Δ=29°-46½'
D=1°
T=138.8
L=277.5

P.T. 114+42.7

Sec. Line Sta. 115+54.86

P.I. 115+72.7

P.I. 116+82.8

P.C. 117+20.5

D=14°-57'R.
D=16°
T=47.0
L=93.4

P.T. 118+14.3

P.C. 122+92.6

Δ=9°-32'R.
D=8°
T=59.7
L=119.2

P.T. 124+16.8

P.C. 128+37.1

P.I. 128+82.1

Δ=103°-22'L.
D=160°
T=453
L=646

Prairie Road No. (2022-3022) - 5000

Butler Hill Road No. (126) - (2529)

(C. W. Green Road No. 126)
North Green Road No. 5031 R/W-60'

T-35-N
5
R-3-E

SECTION 6


TOWNSHIP 35 NORTH, RANGE 4 EAST, W. M.

SKAGIT COUNTY, WASH.

SCALE, 1 INCH--400 FEET

DATE June 26, 1963

COUNTY ENGINEER

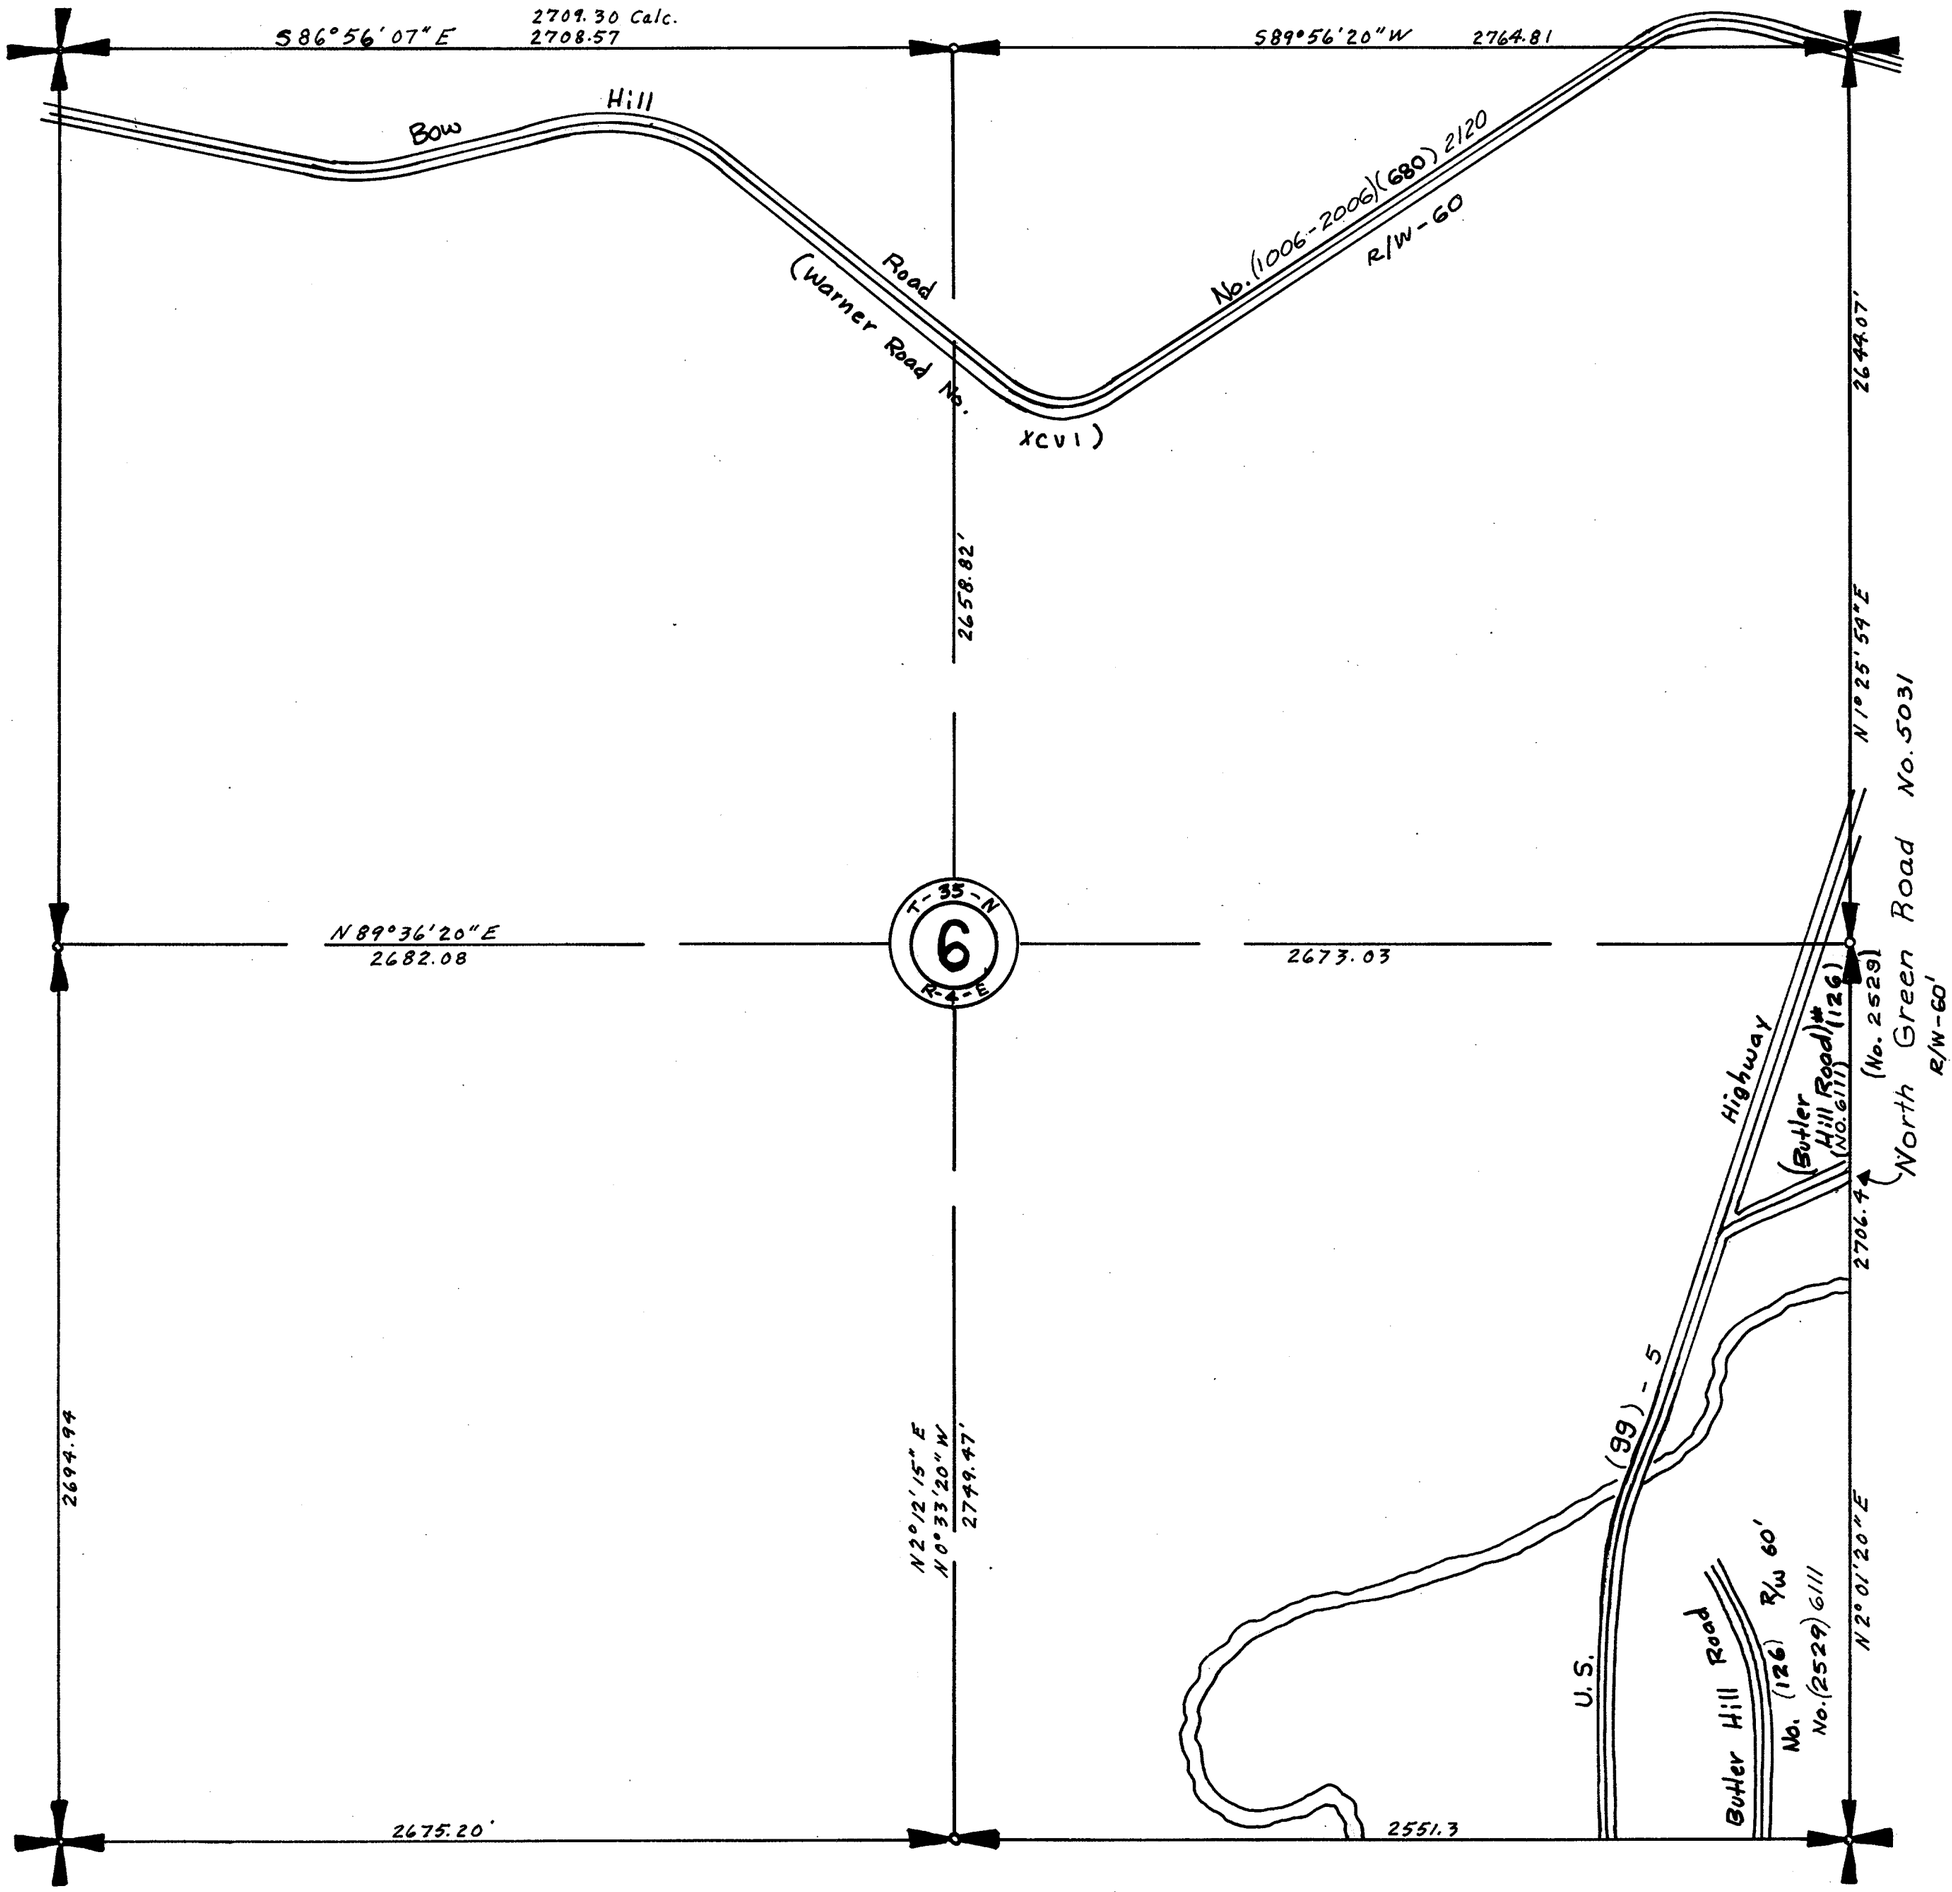


SECTION 6

TOWNSHIP 35 NORTH, RANGE 4 EAST, W. M.
SKAGIT COUNTY, WASH.

SCALE, 1 INCH--400 FEET

W.A. COSTELLO COUNTY ENGINEER

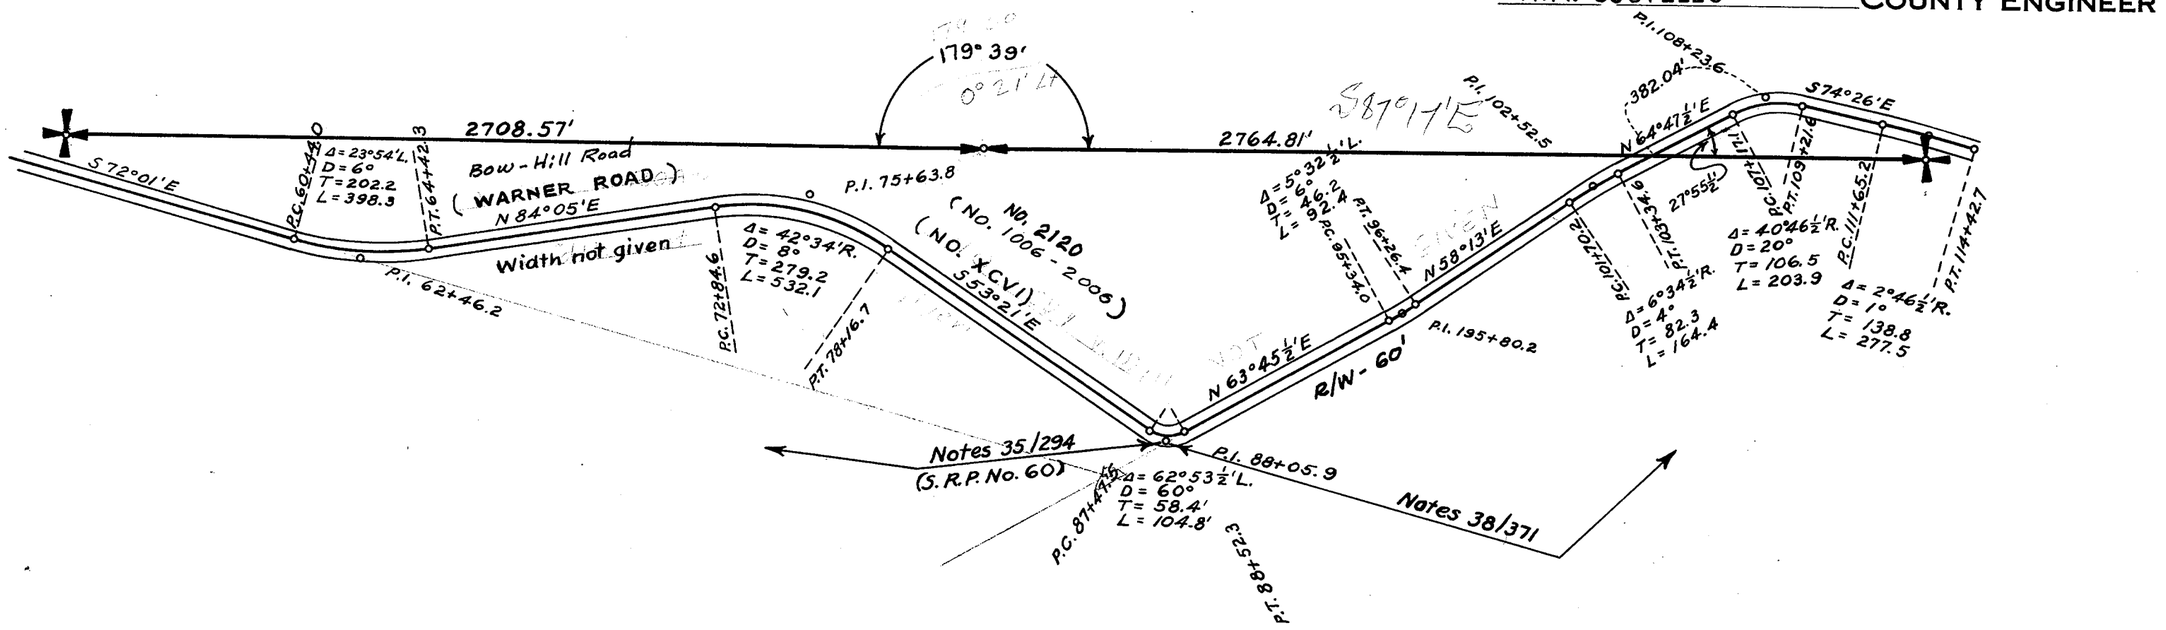

Road Consolidation : 1963 - Resolution 3458
No. Changes 1964


SECTION 6

TOWNSHIP 35 NORTH, RANGE 4 EAST, W. M.

SKAGIT COUNTY, WASH.

SCALE, 1 INCH–400 FEET

Robt. E. L. Knapp 1930 COUNTY ENGINEER

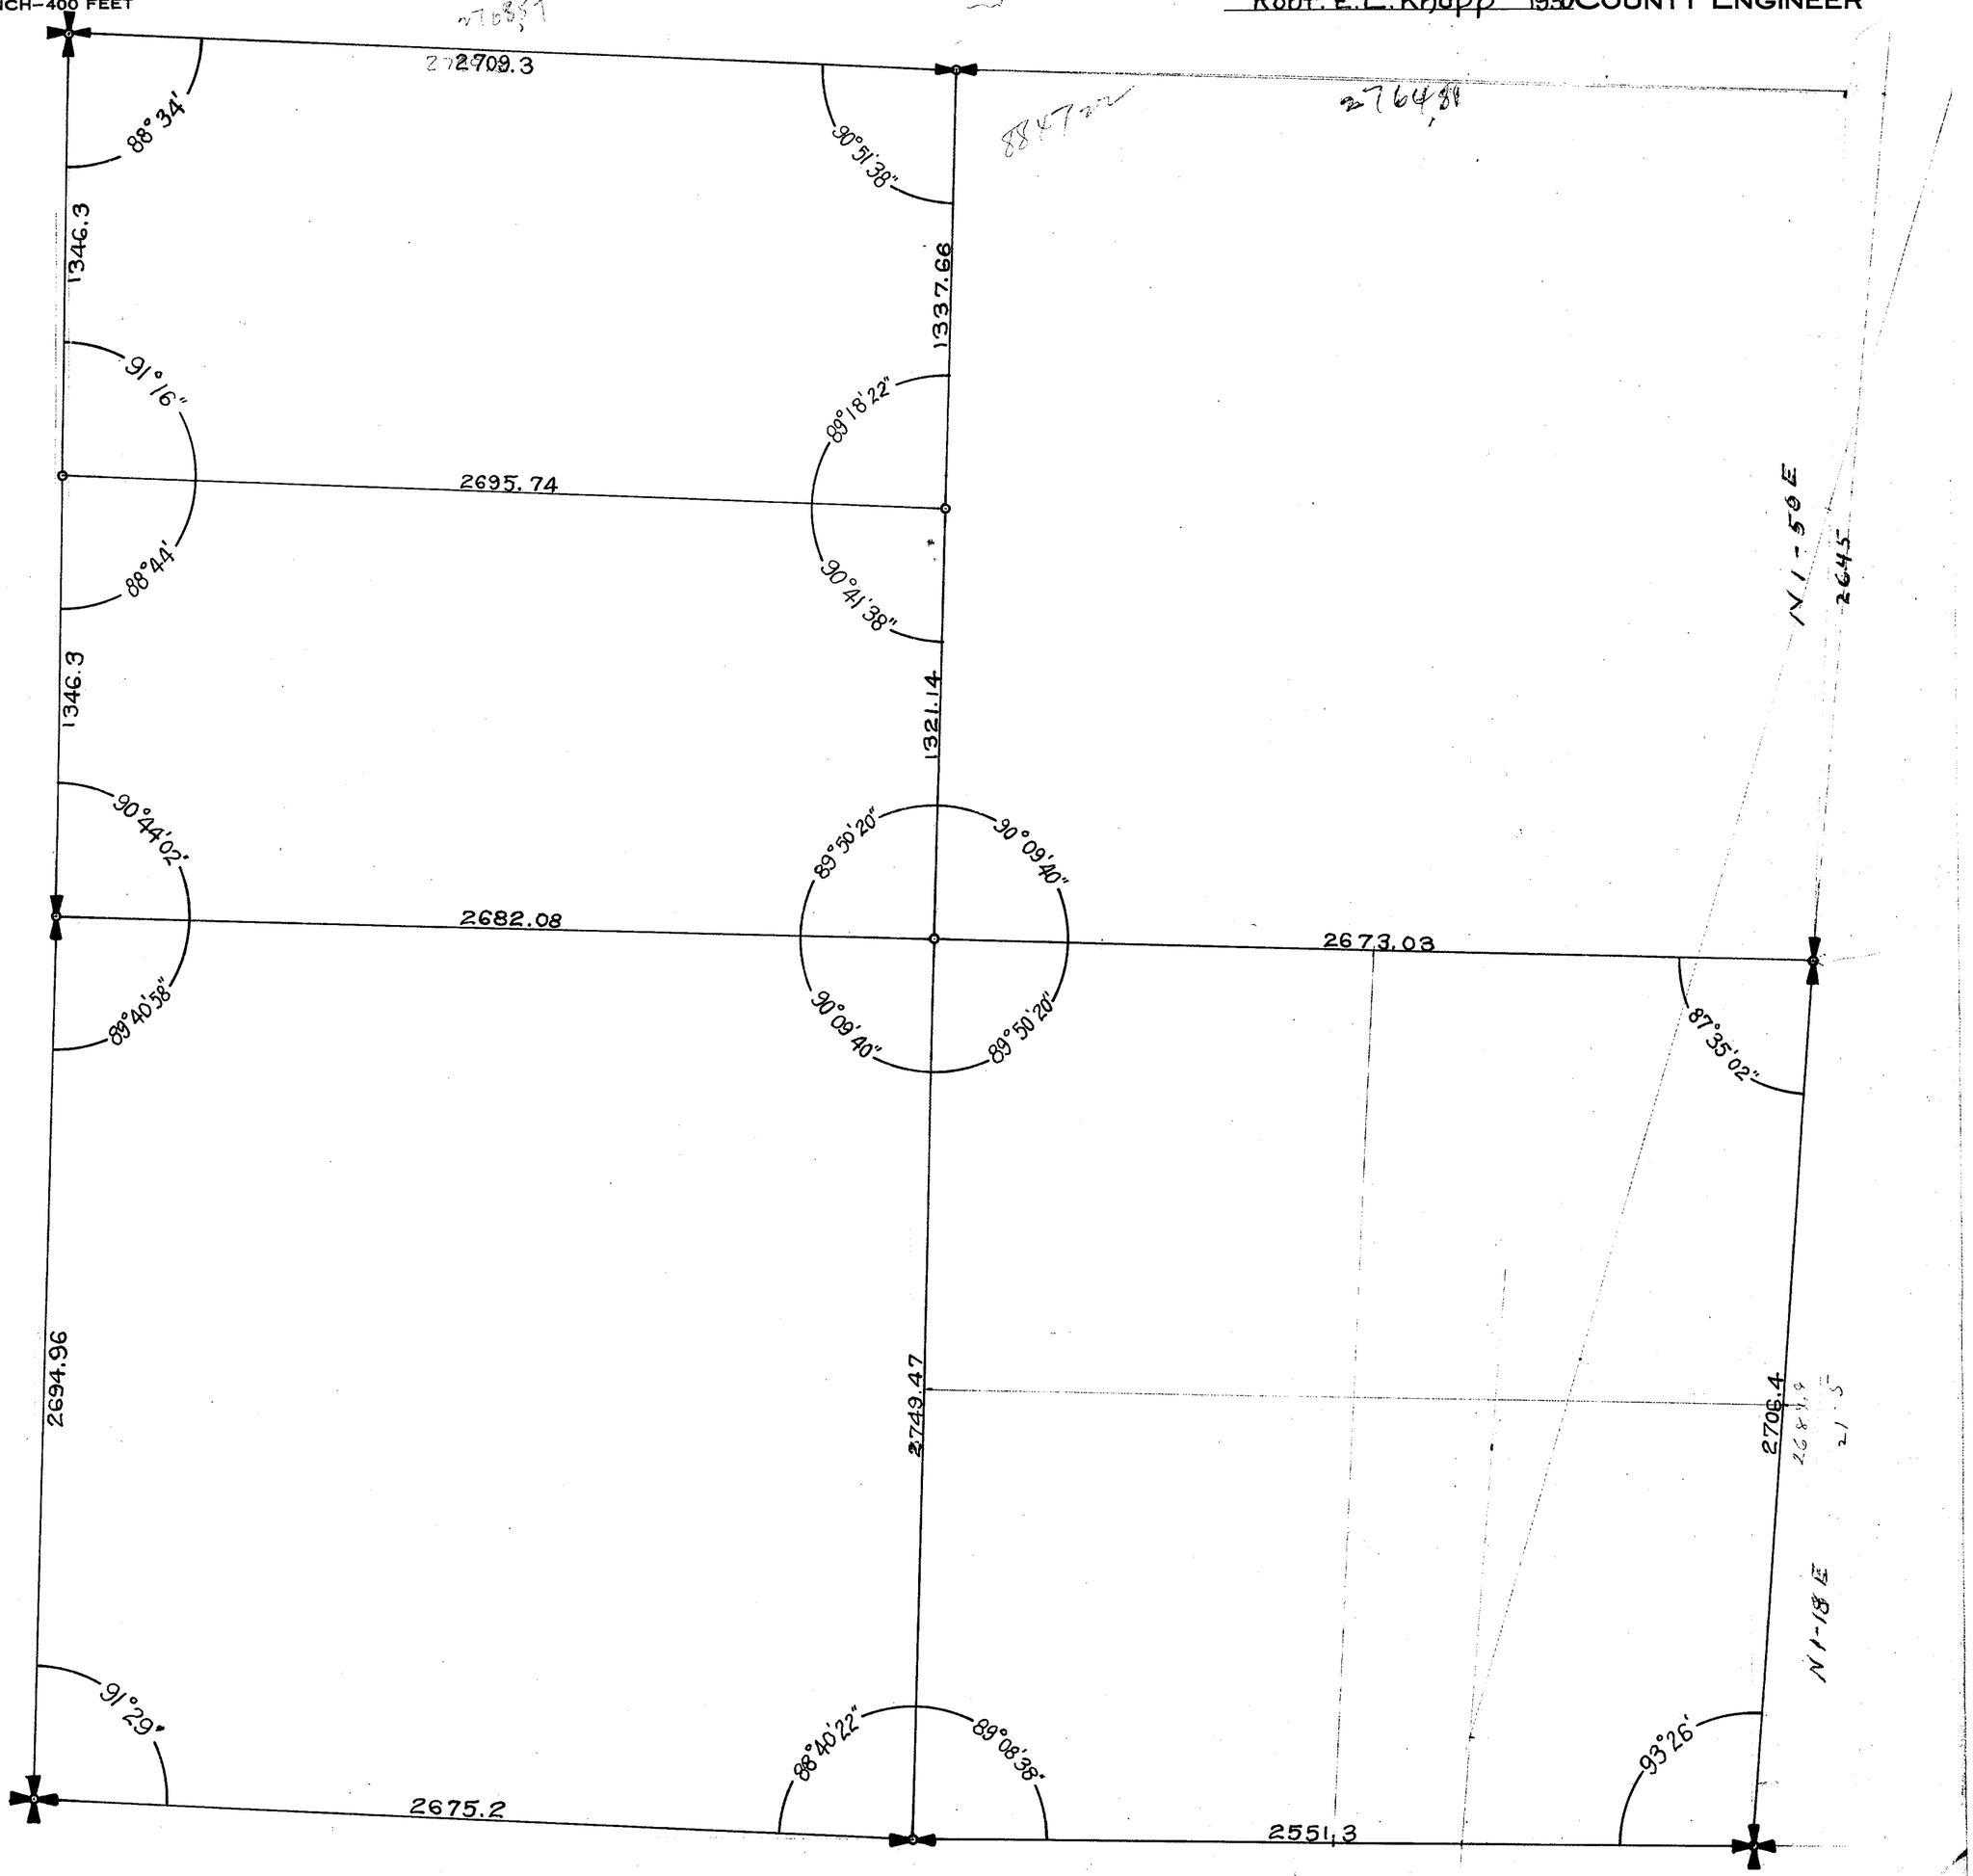

SECTION 7


TOWNSHIP 35 NORTH, RANGE 4 EAST, W. M.

SKAGIT COUNTY, WASH.

SCALE, 1 INCH--400 FEET

DATE June 27, 1963

LLOYD H. JOHNSON COUNTY ENGINEER

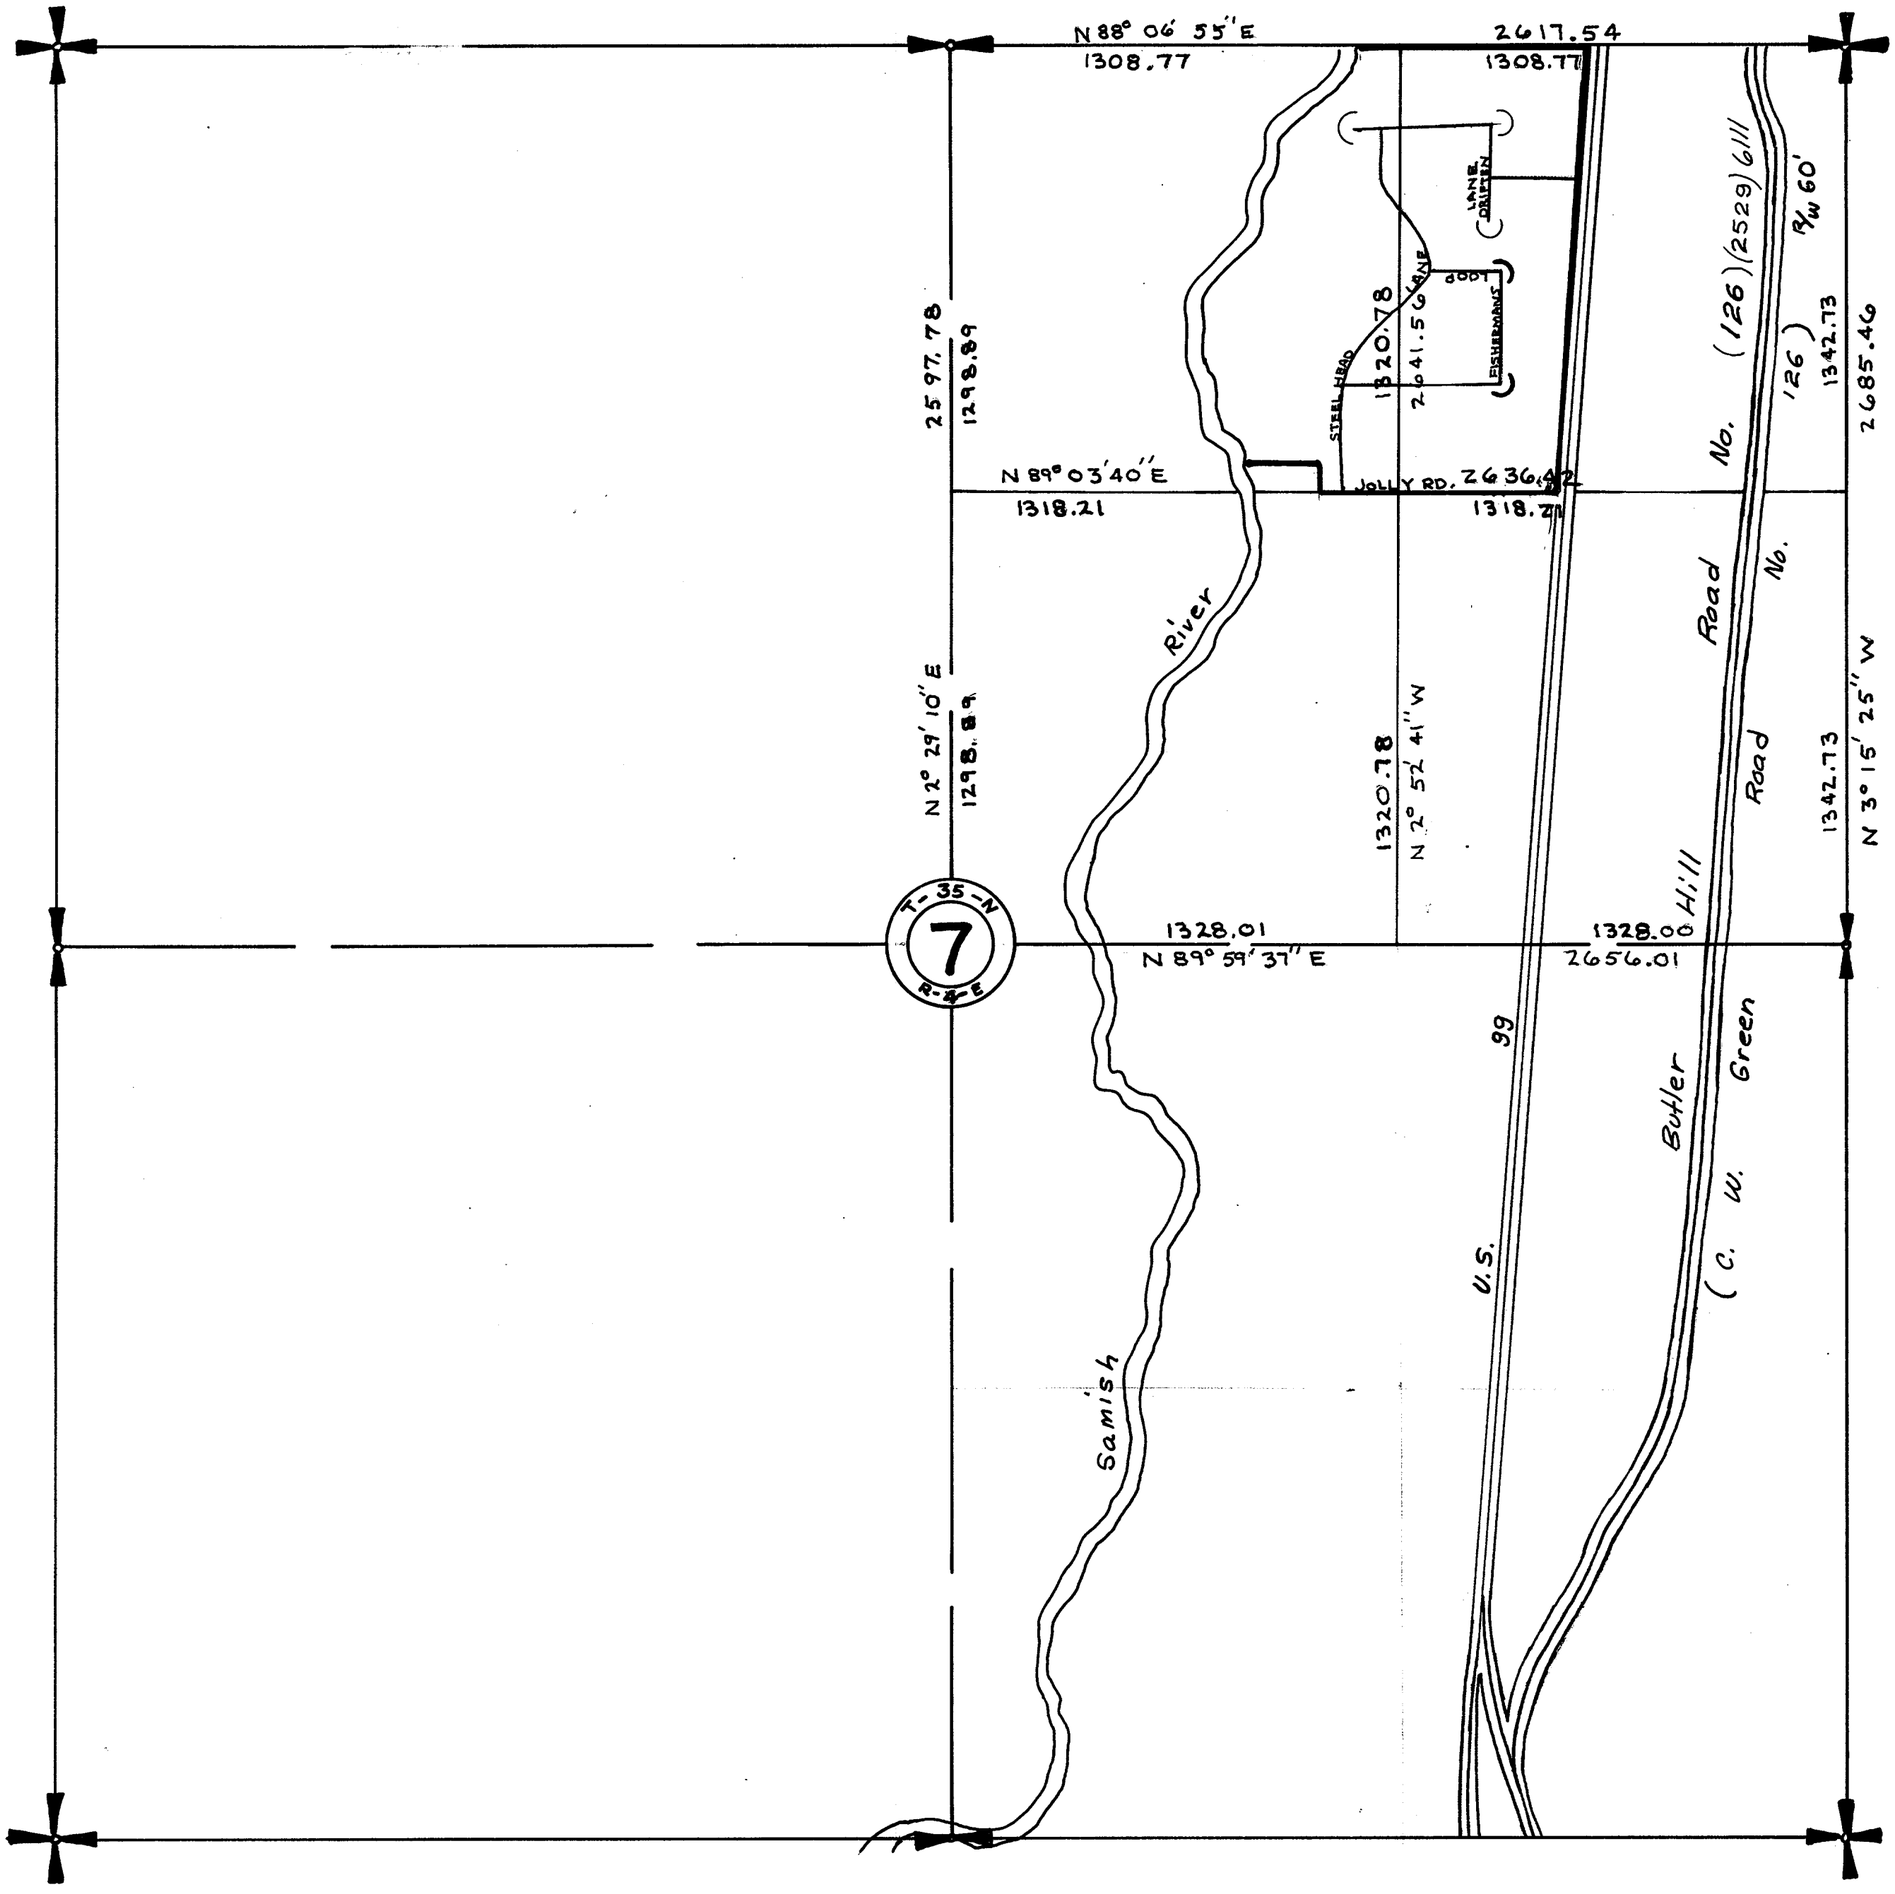

Notes: 36/314
Surveyed: 9/38 by H.D.T.
Computed: 11/38 by AH
Platted : 11/38 by AH
✓ : 11/38 by L.J.W.


SECTION 9

TOWNSHIP 35 NORTH, RANGE 4 EAST, W. M.

SKAGIT COUNTY, WASH.

W. A. COSTELLO COUNTY ENGINEER

SCALE, 1 INCH--400 FEET

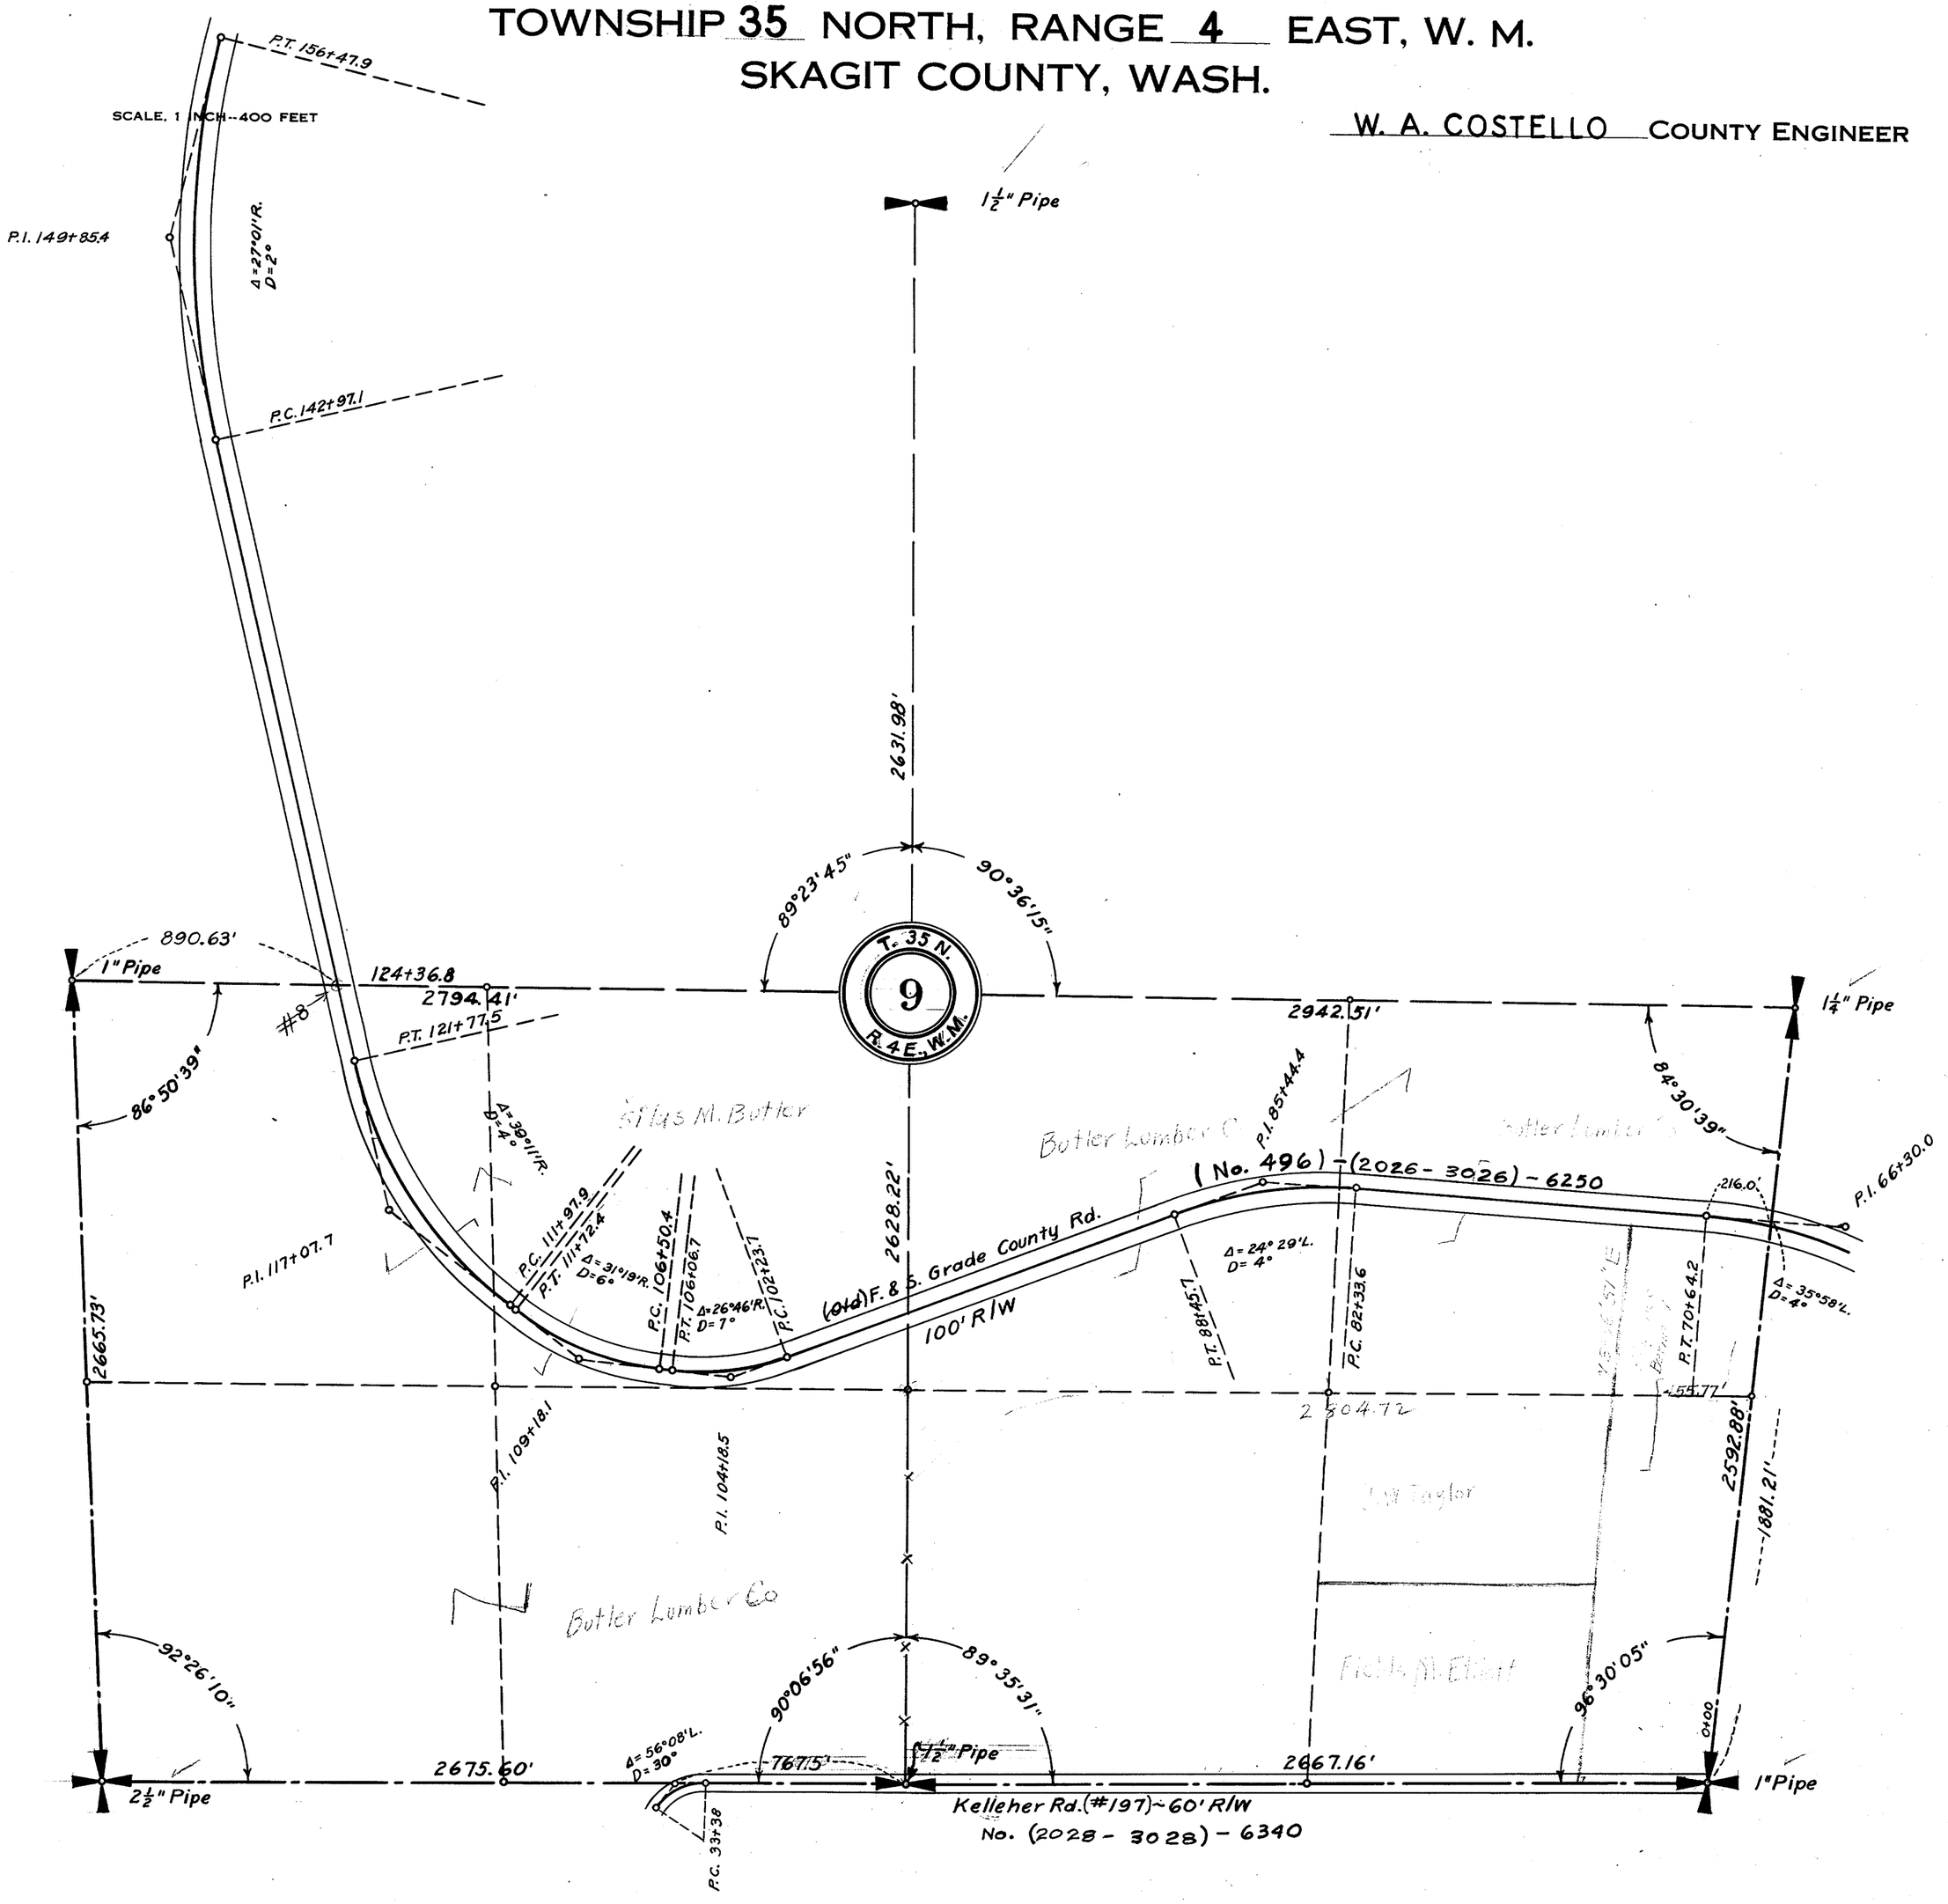


SECTION 9

TOWNSHIP 35 NORTH, RANGE 4 EAST, W. M.

SKAGIT COUNTY, WASH.

SCALE, 1 INCH–400 FEET

A. L. STRONG COUNTY ENGINEER

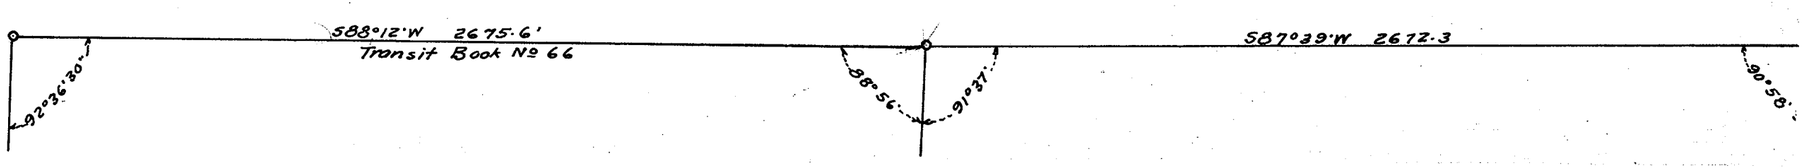

SECTION 10


TOWNSHIP 35 NORTH, RANGE 4 EAST, W. M.

SKAGIT COUNTY, WASH.

SCALE, 1 INCH--400 FEET

H.O. WALBERG COUNTY ENGINEER


1923 SURVEY

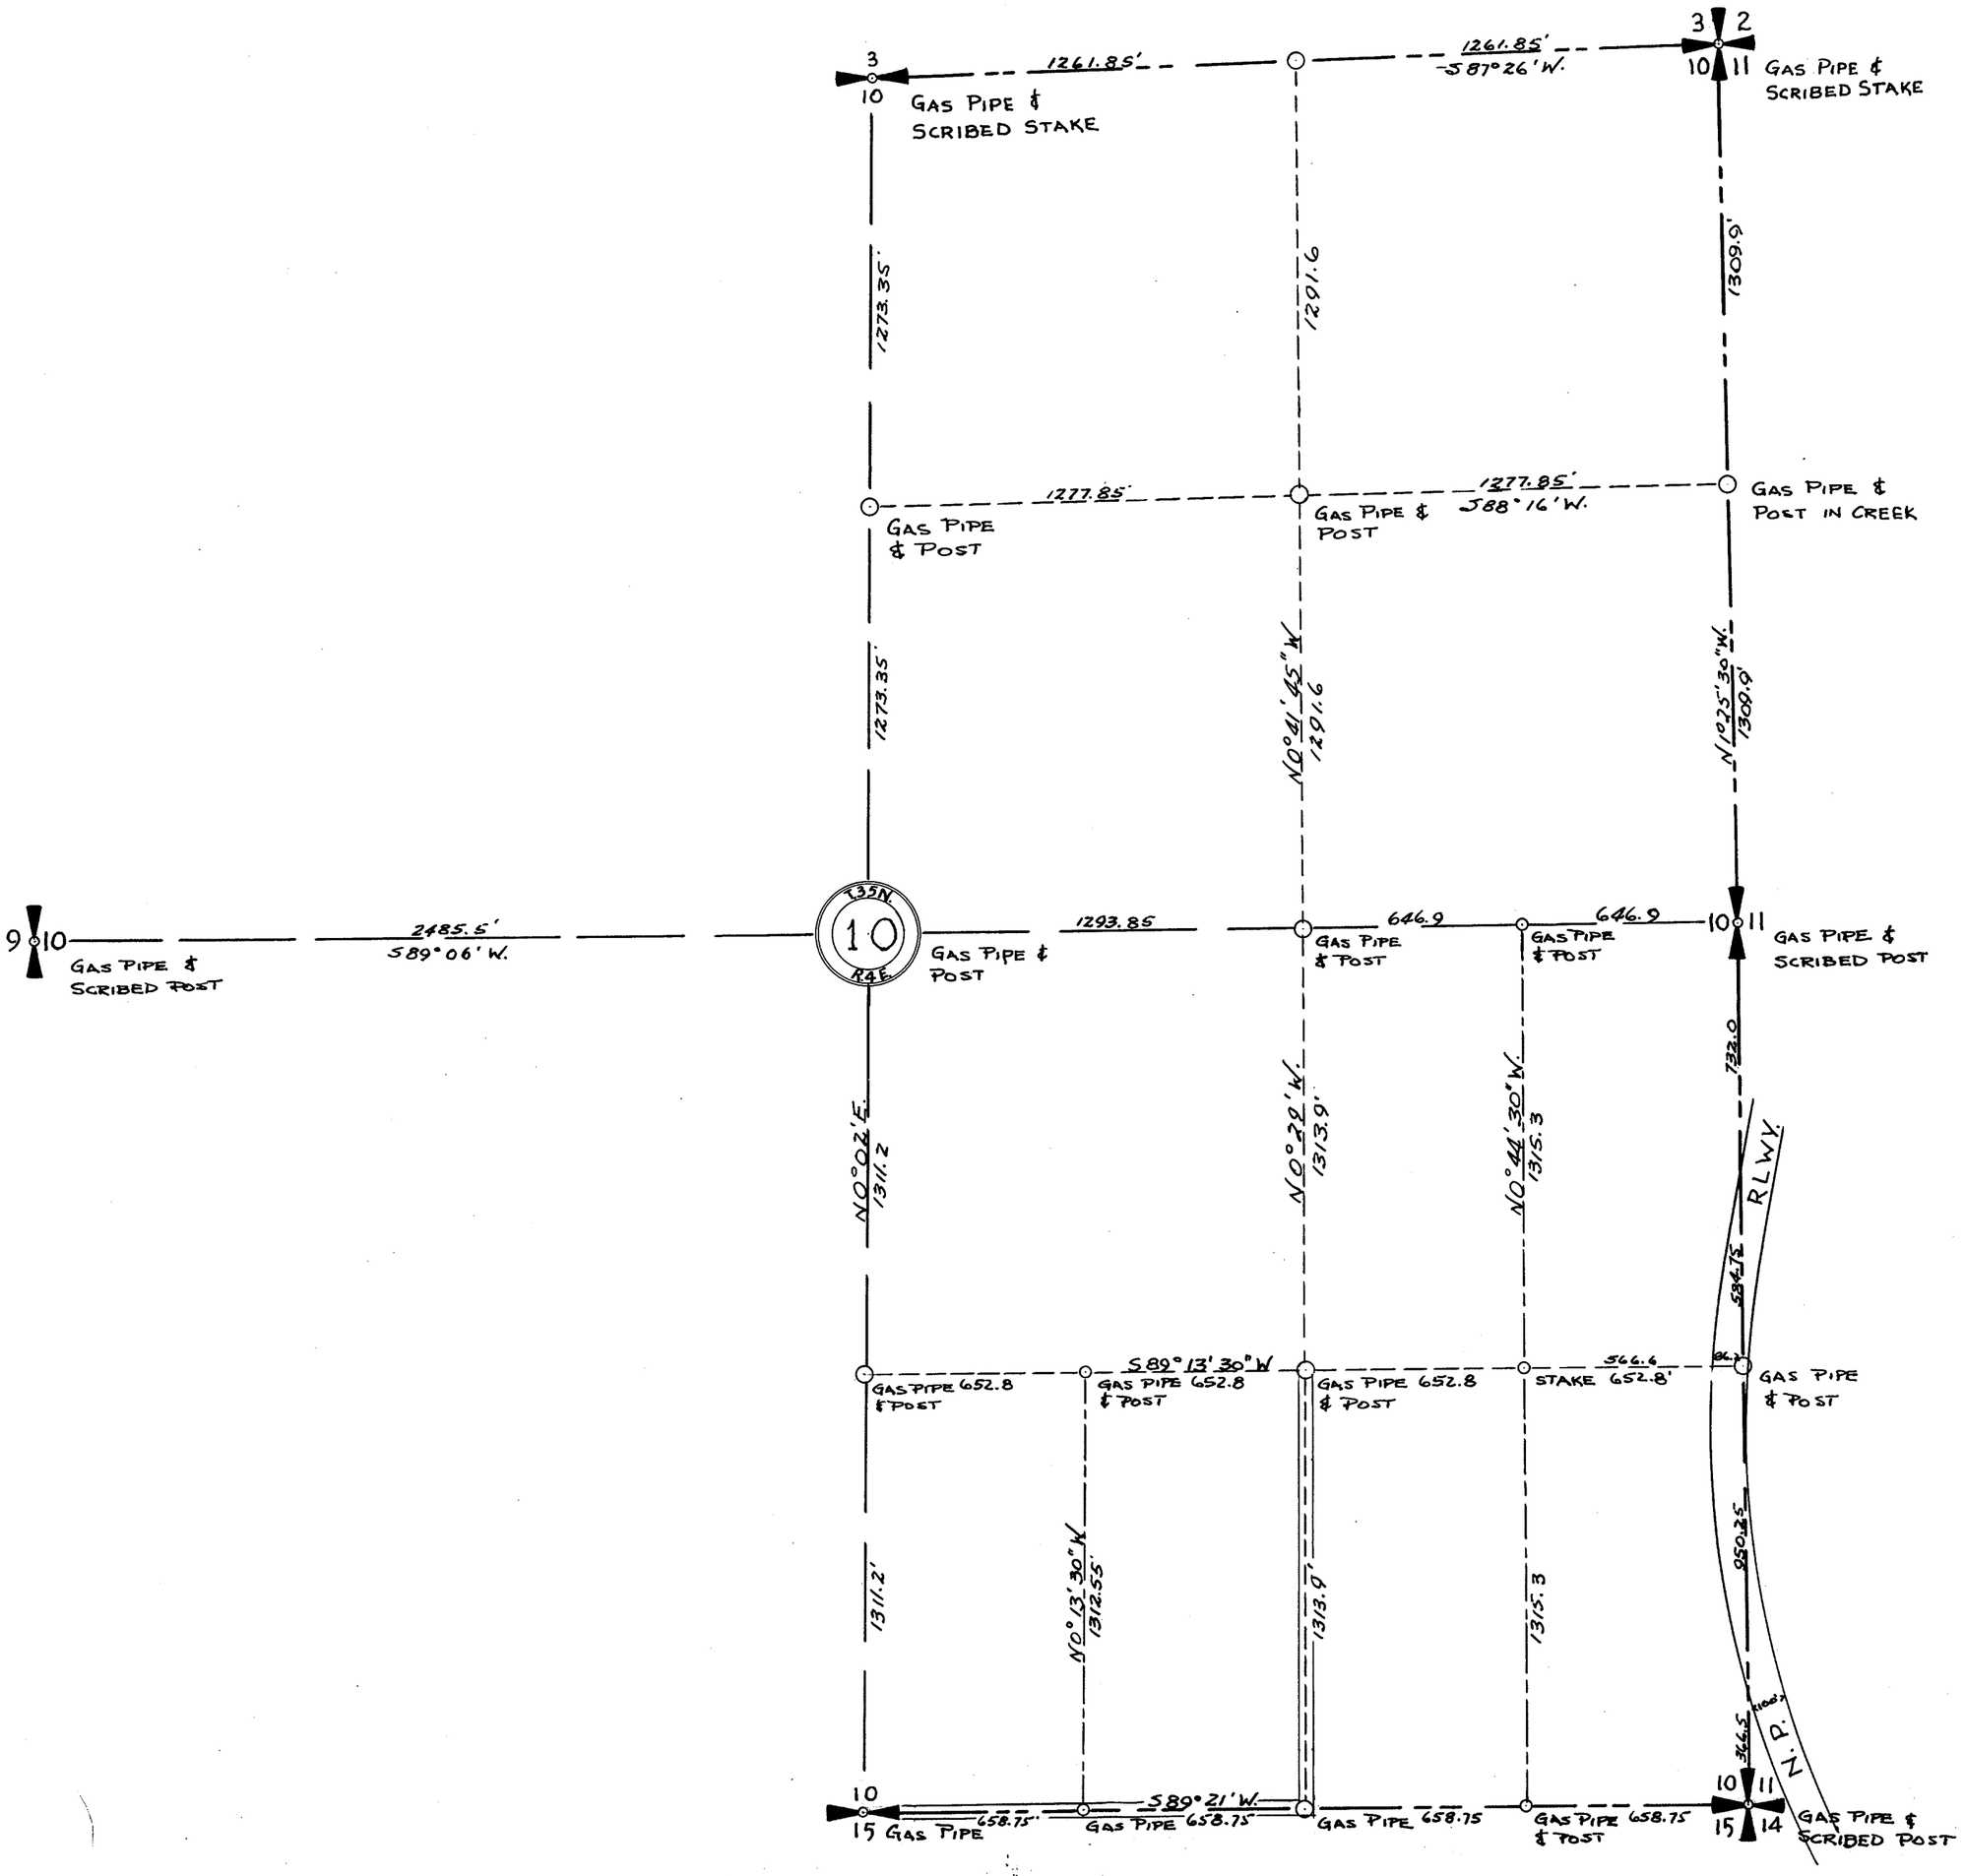

SECTION 10
TOWNSHIP 35 NORTH, RANGE 4 EAST, W. M.
SKAGIT COUNTY, WASH.

SCALE, 1 INCH--400 FEET

DATE October , 1959 Frank Gilkey COUNTY ENGINEER

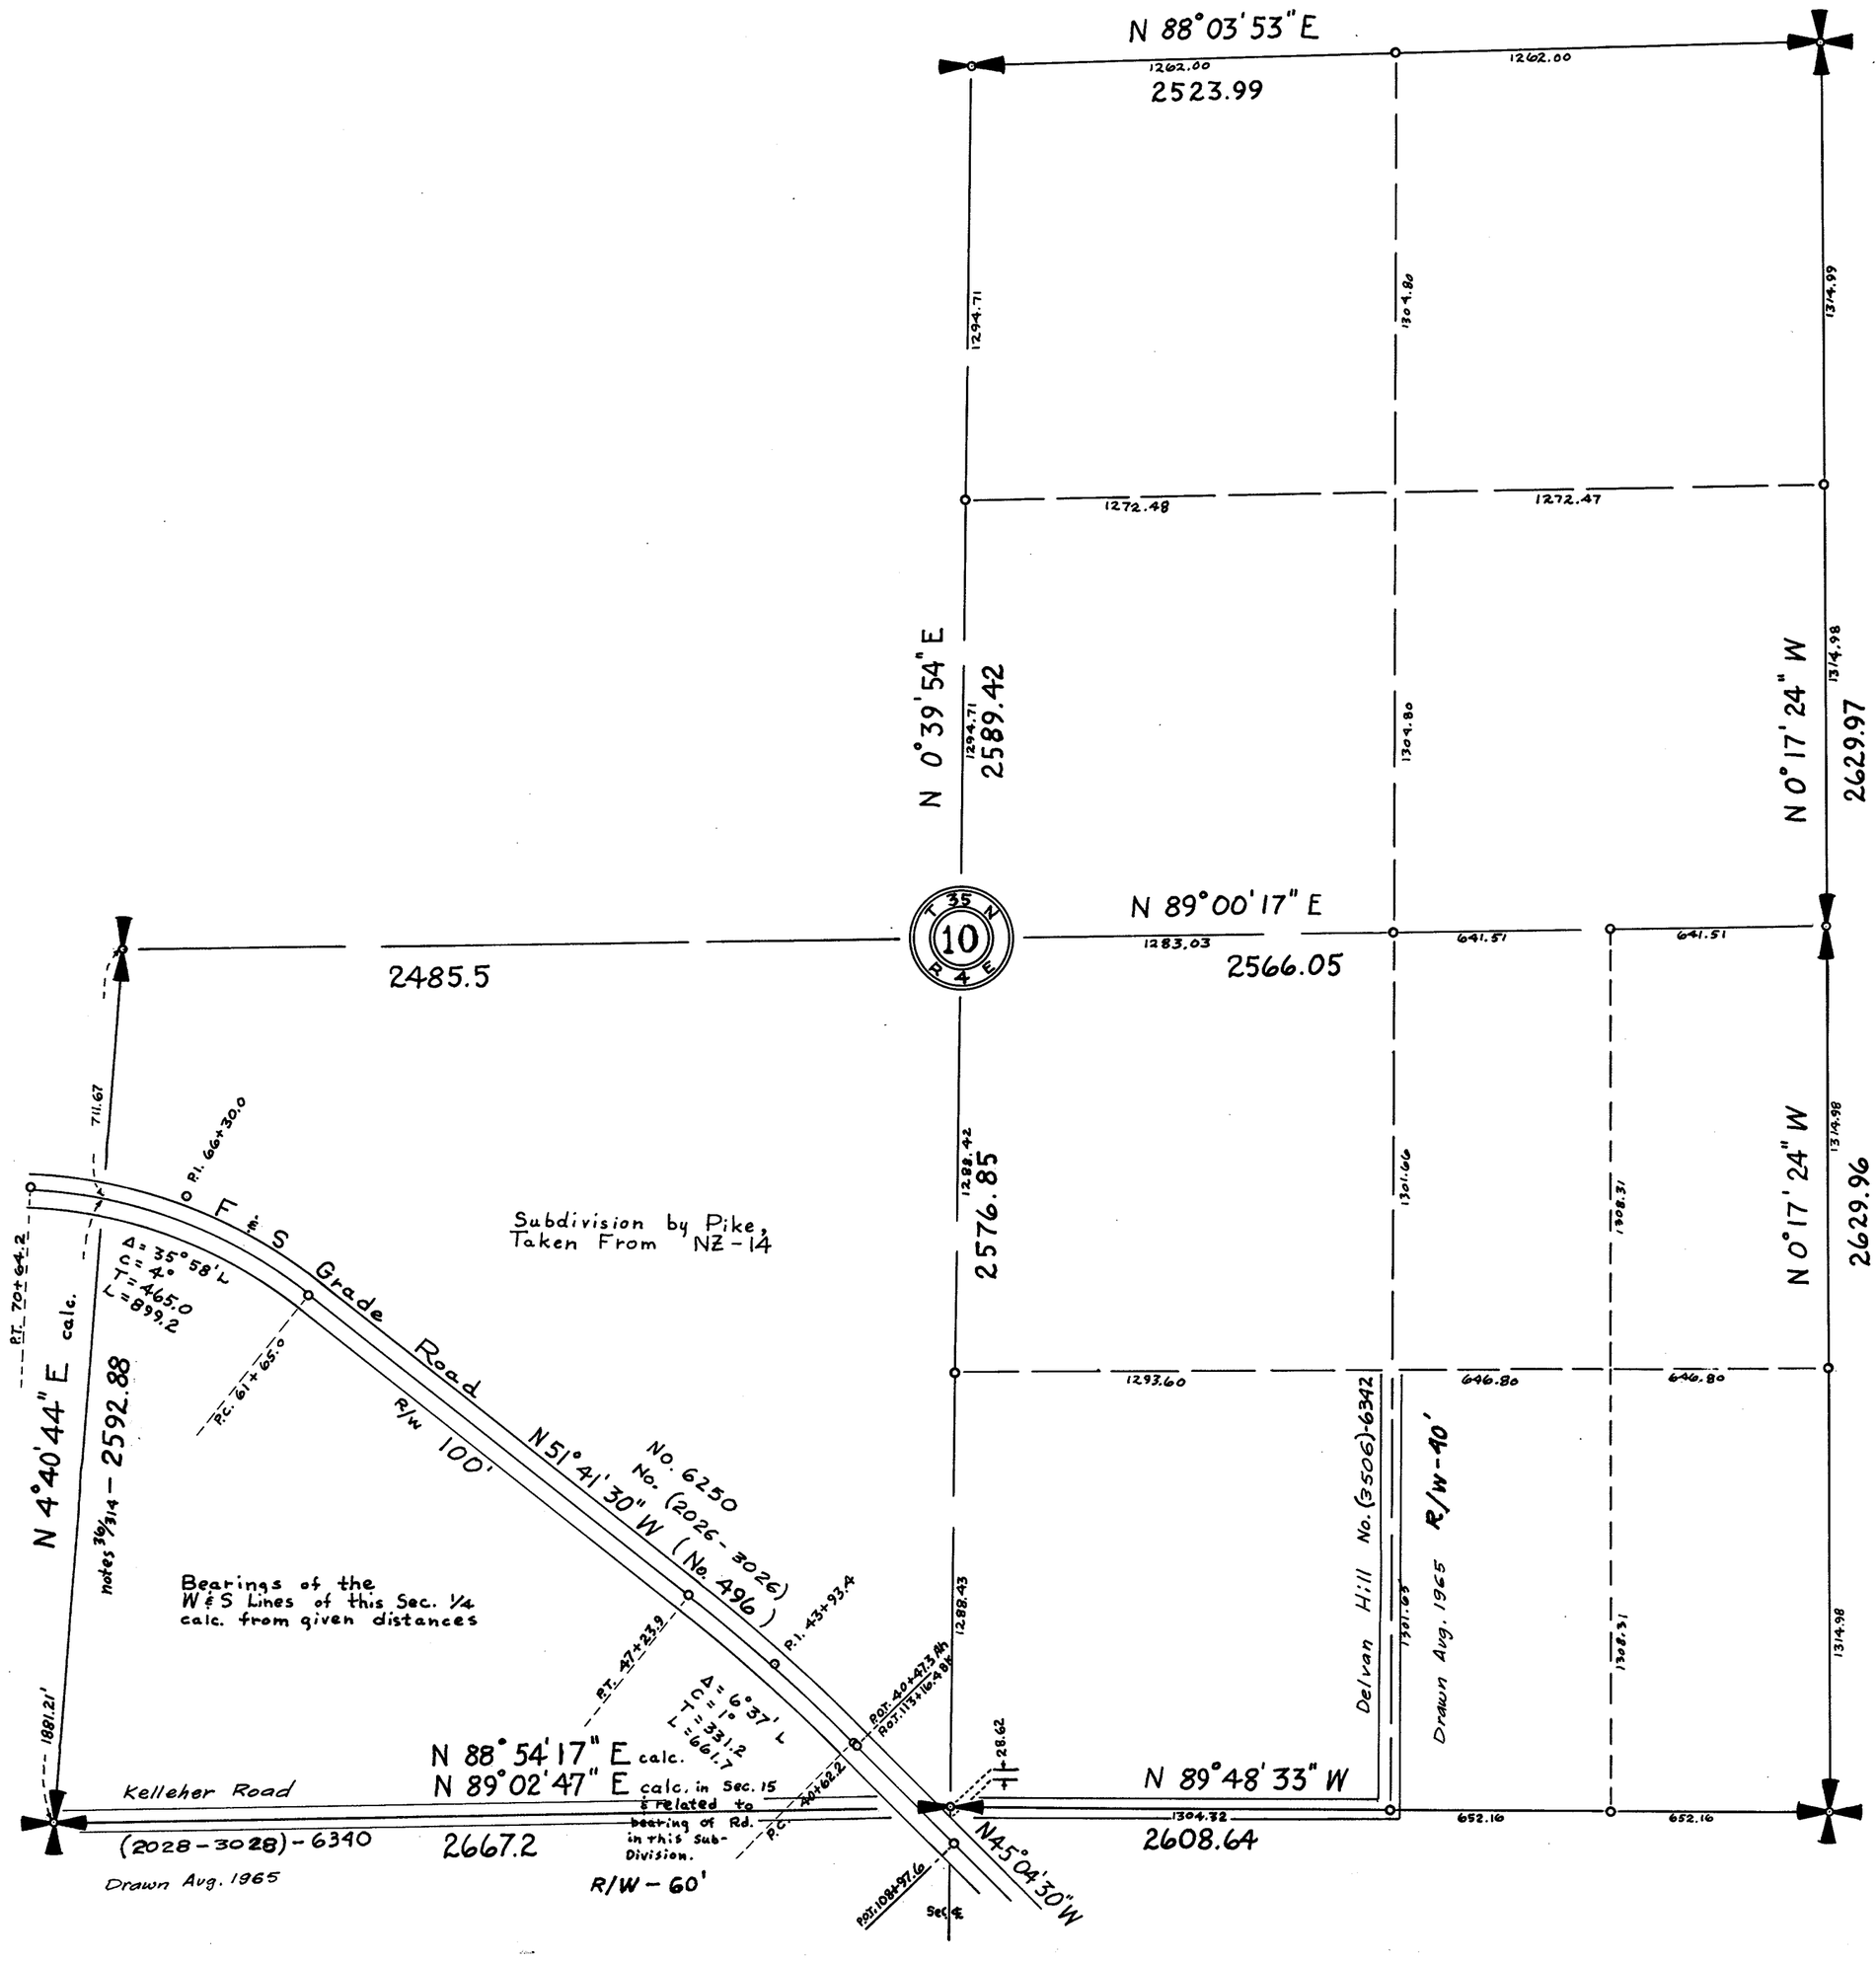

SECTION 11


TOWNSHIP 35 NORTH, RANGE 4 EAST, W. M.

SKAGIT COUNTY, WASH.

SCALE, 1 INCH--400 FEET

H.O. WALBERG COUNTY ENGINEER

1923 SURVEY

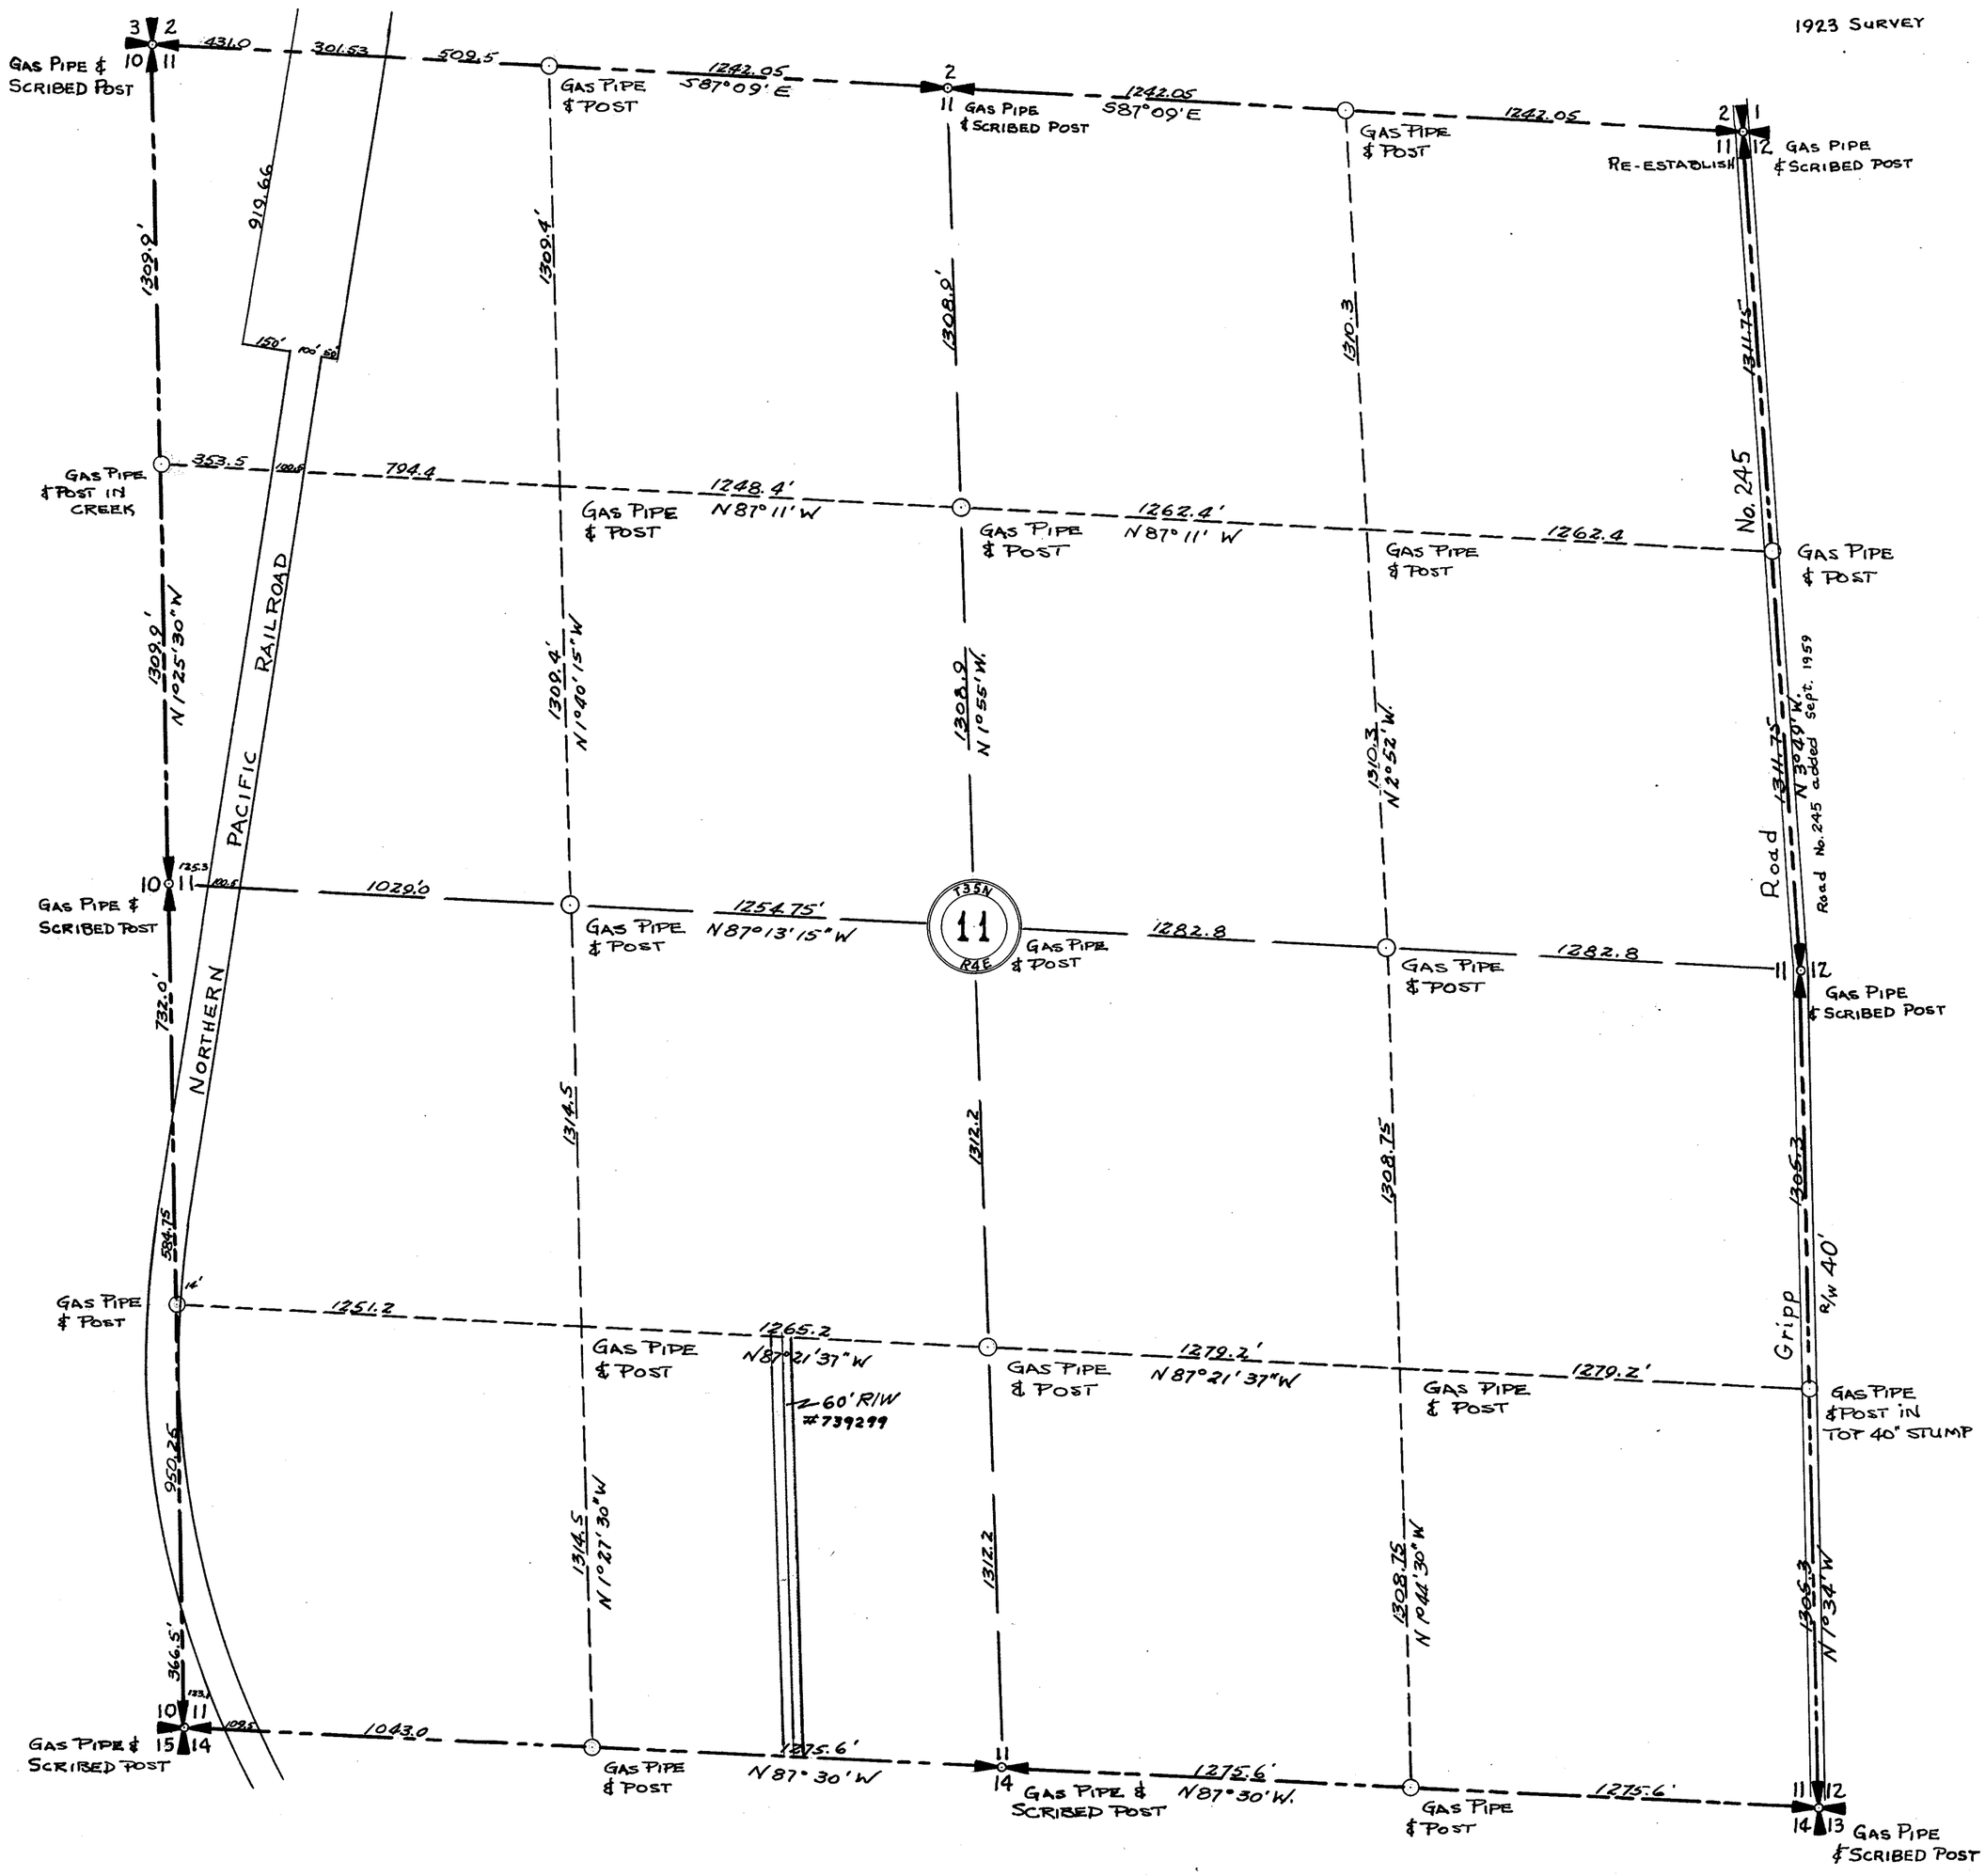

SECTION 11


TOWNSHIP 35 NORTH, RANGE 4 EAST, W. M.

SKAGIT COUNTY, WASH.

SCALE, 1 INCH--400 FEET

DATE Aug. 1965

COUNTY ENGINEER

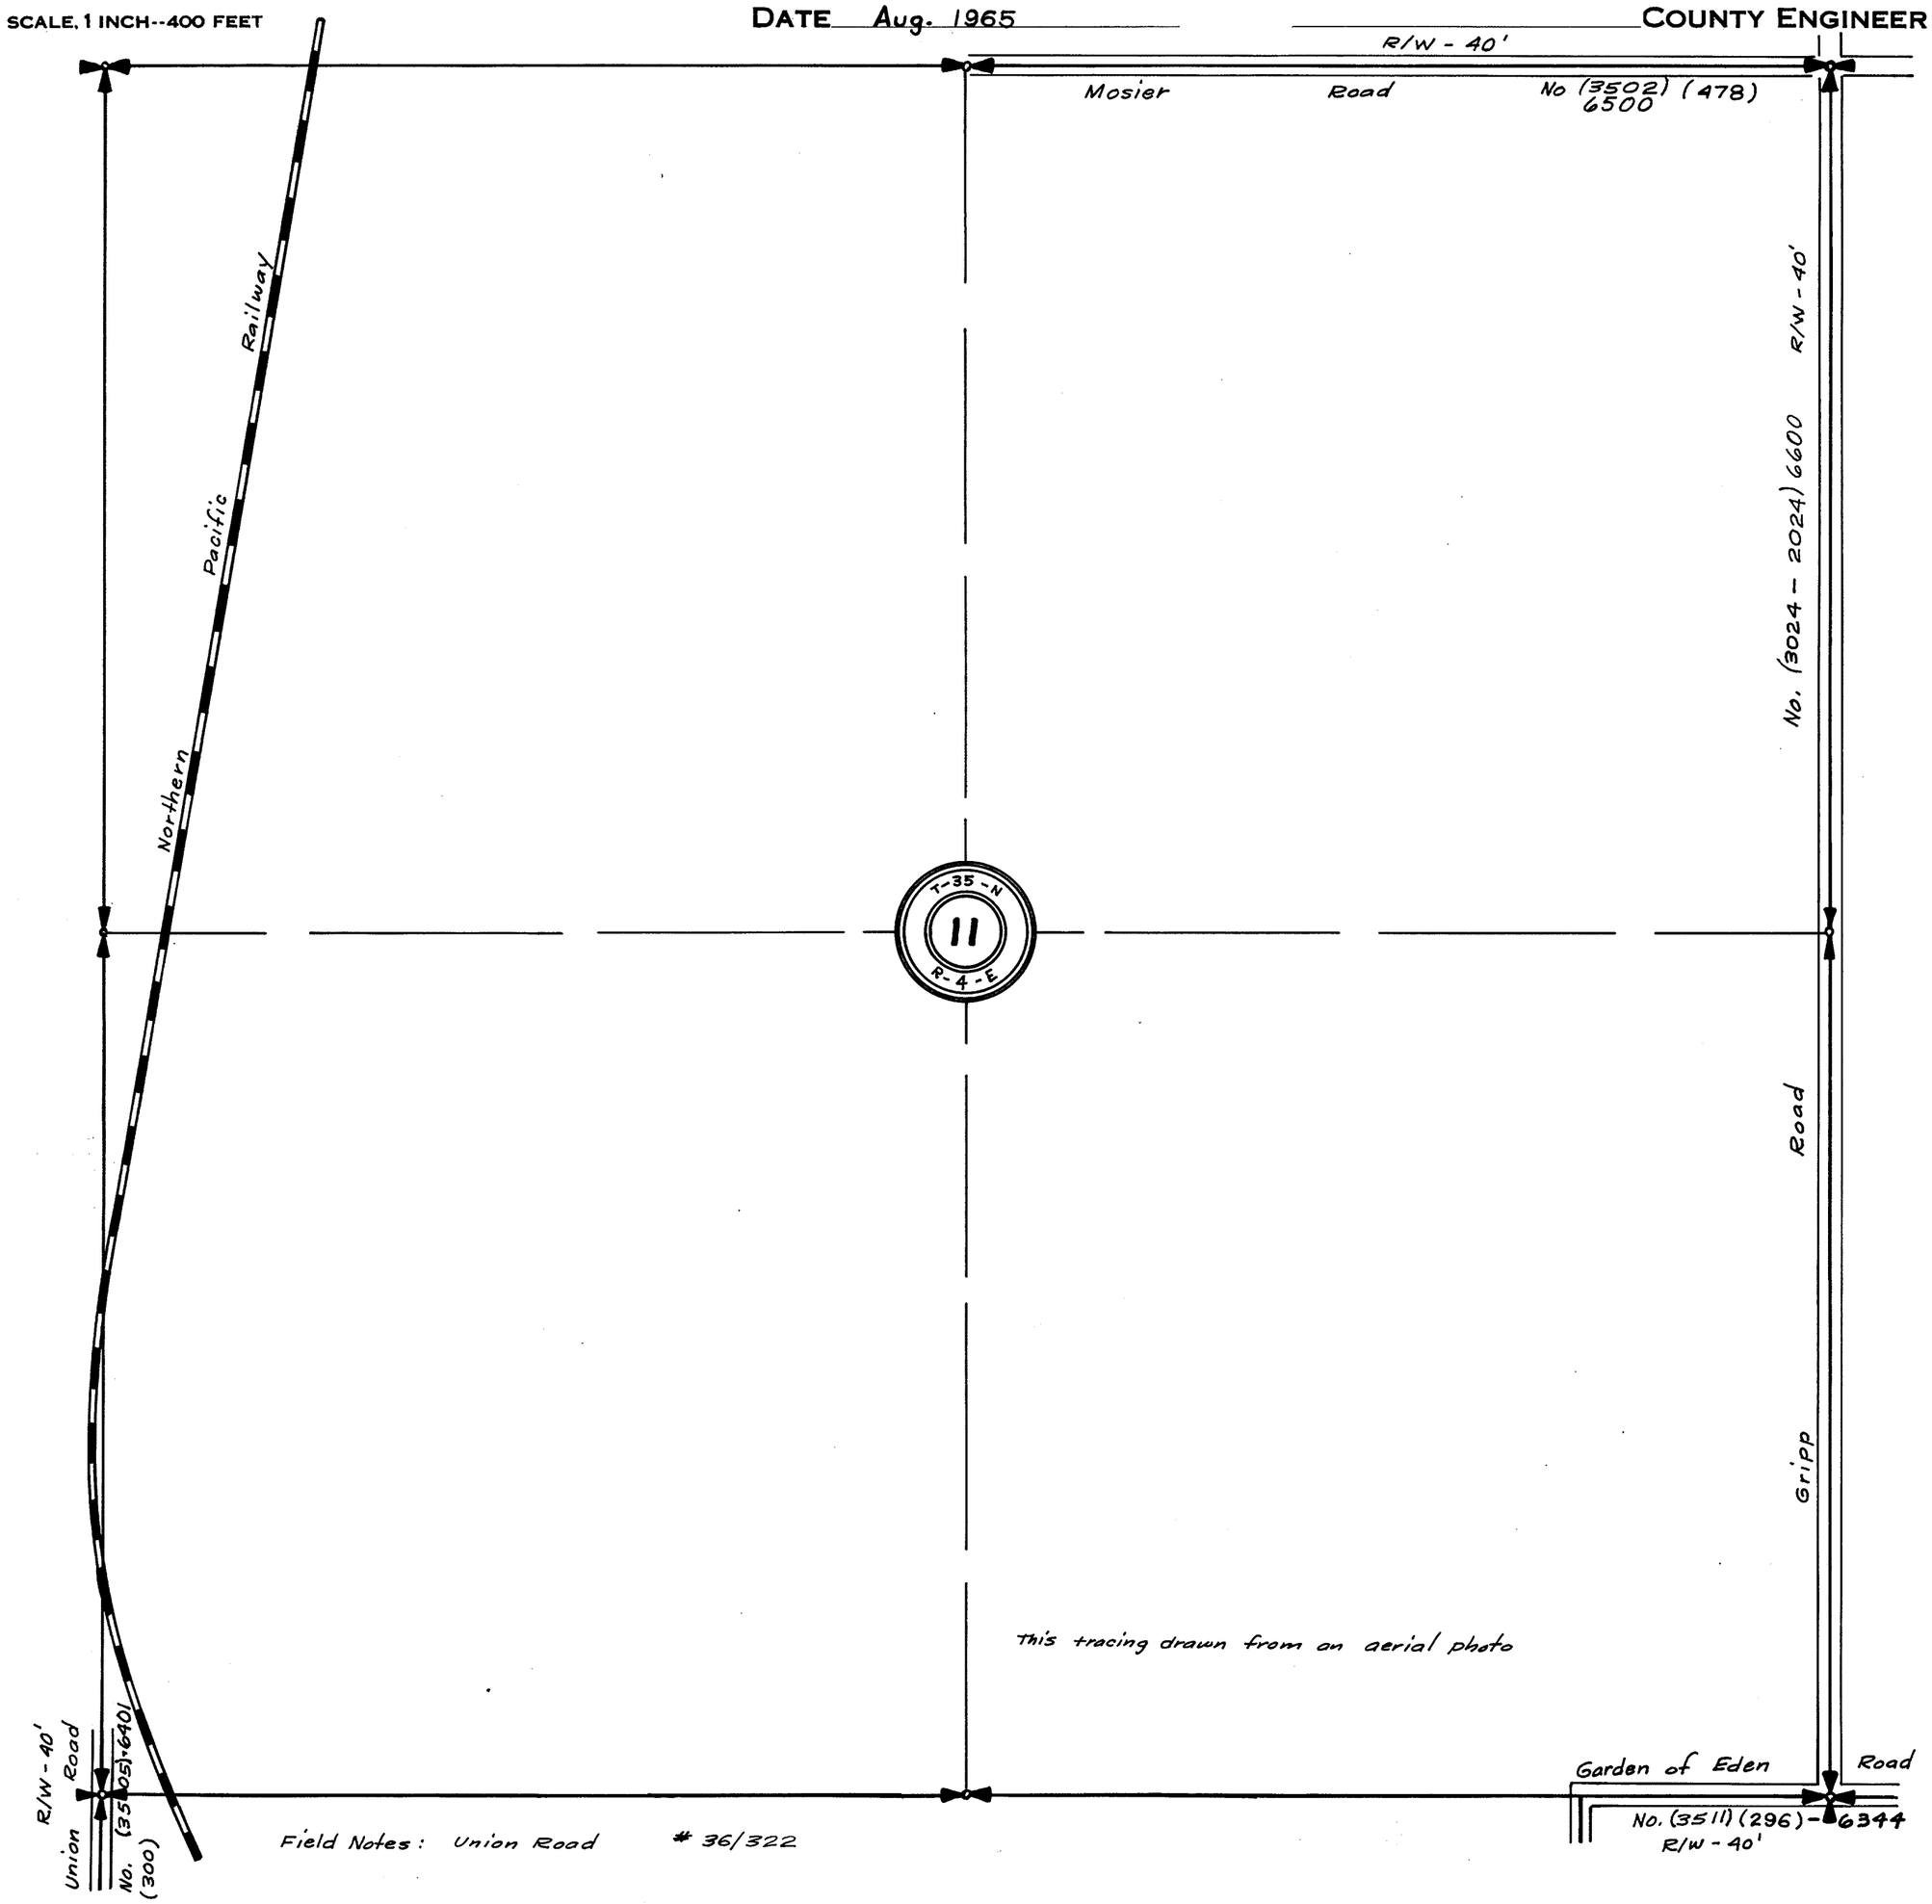

Field Notes: Union Road # 36/322

SECTION 12


TOWNSHIP 35 NORTH, RANGE 4 EAST, W. M.

SKAGIT COUNTY, WASH.

SCALE, 1 INCH--400 FEET

H.O. WALBERG COUNTY ENGINEER

FROM 1923 SURVEY

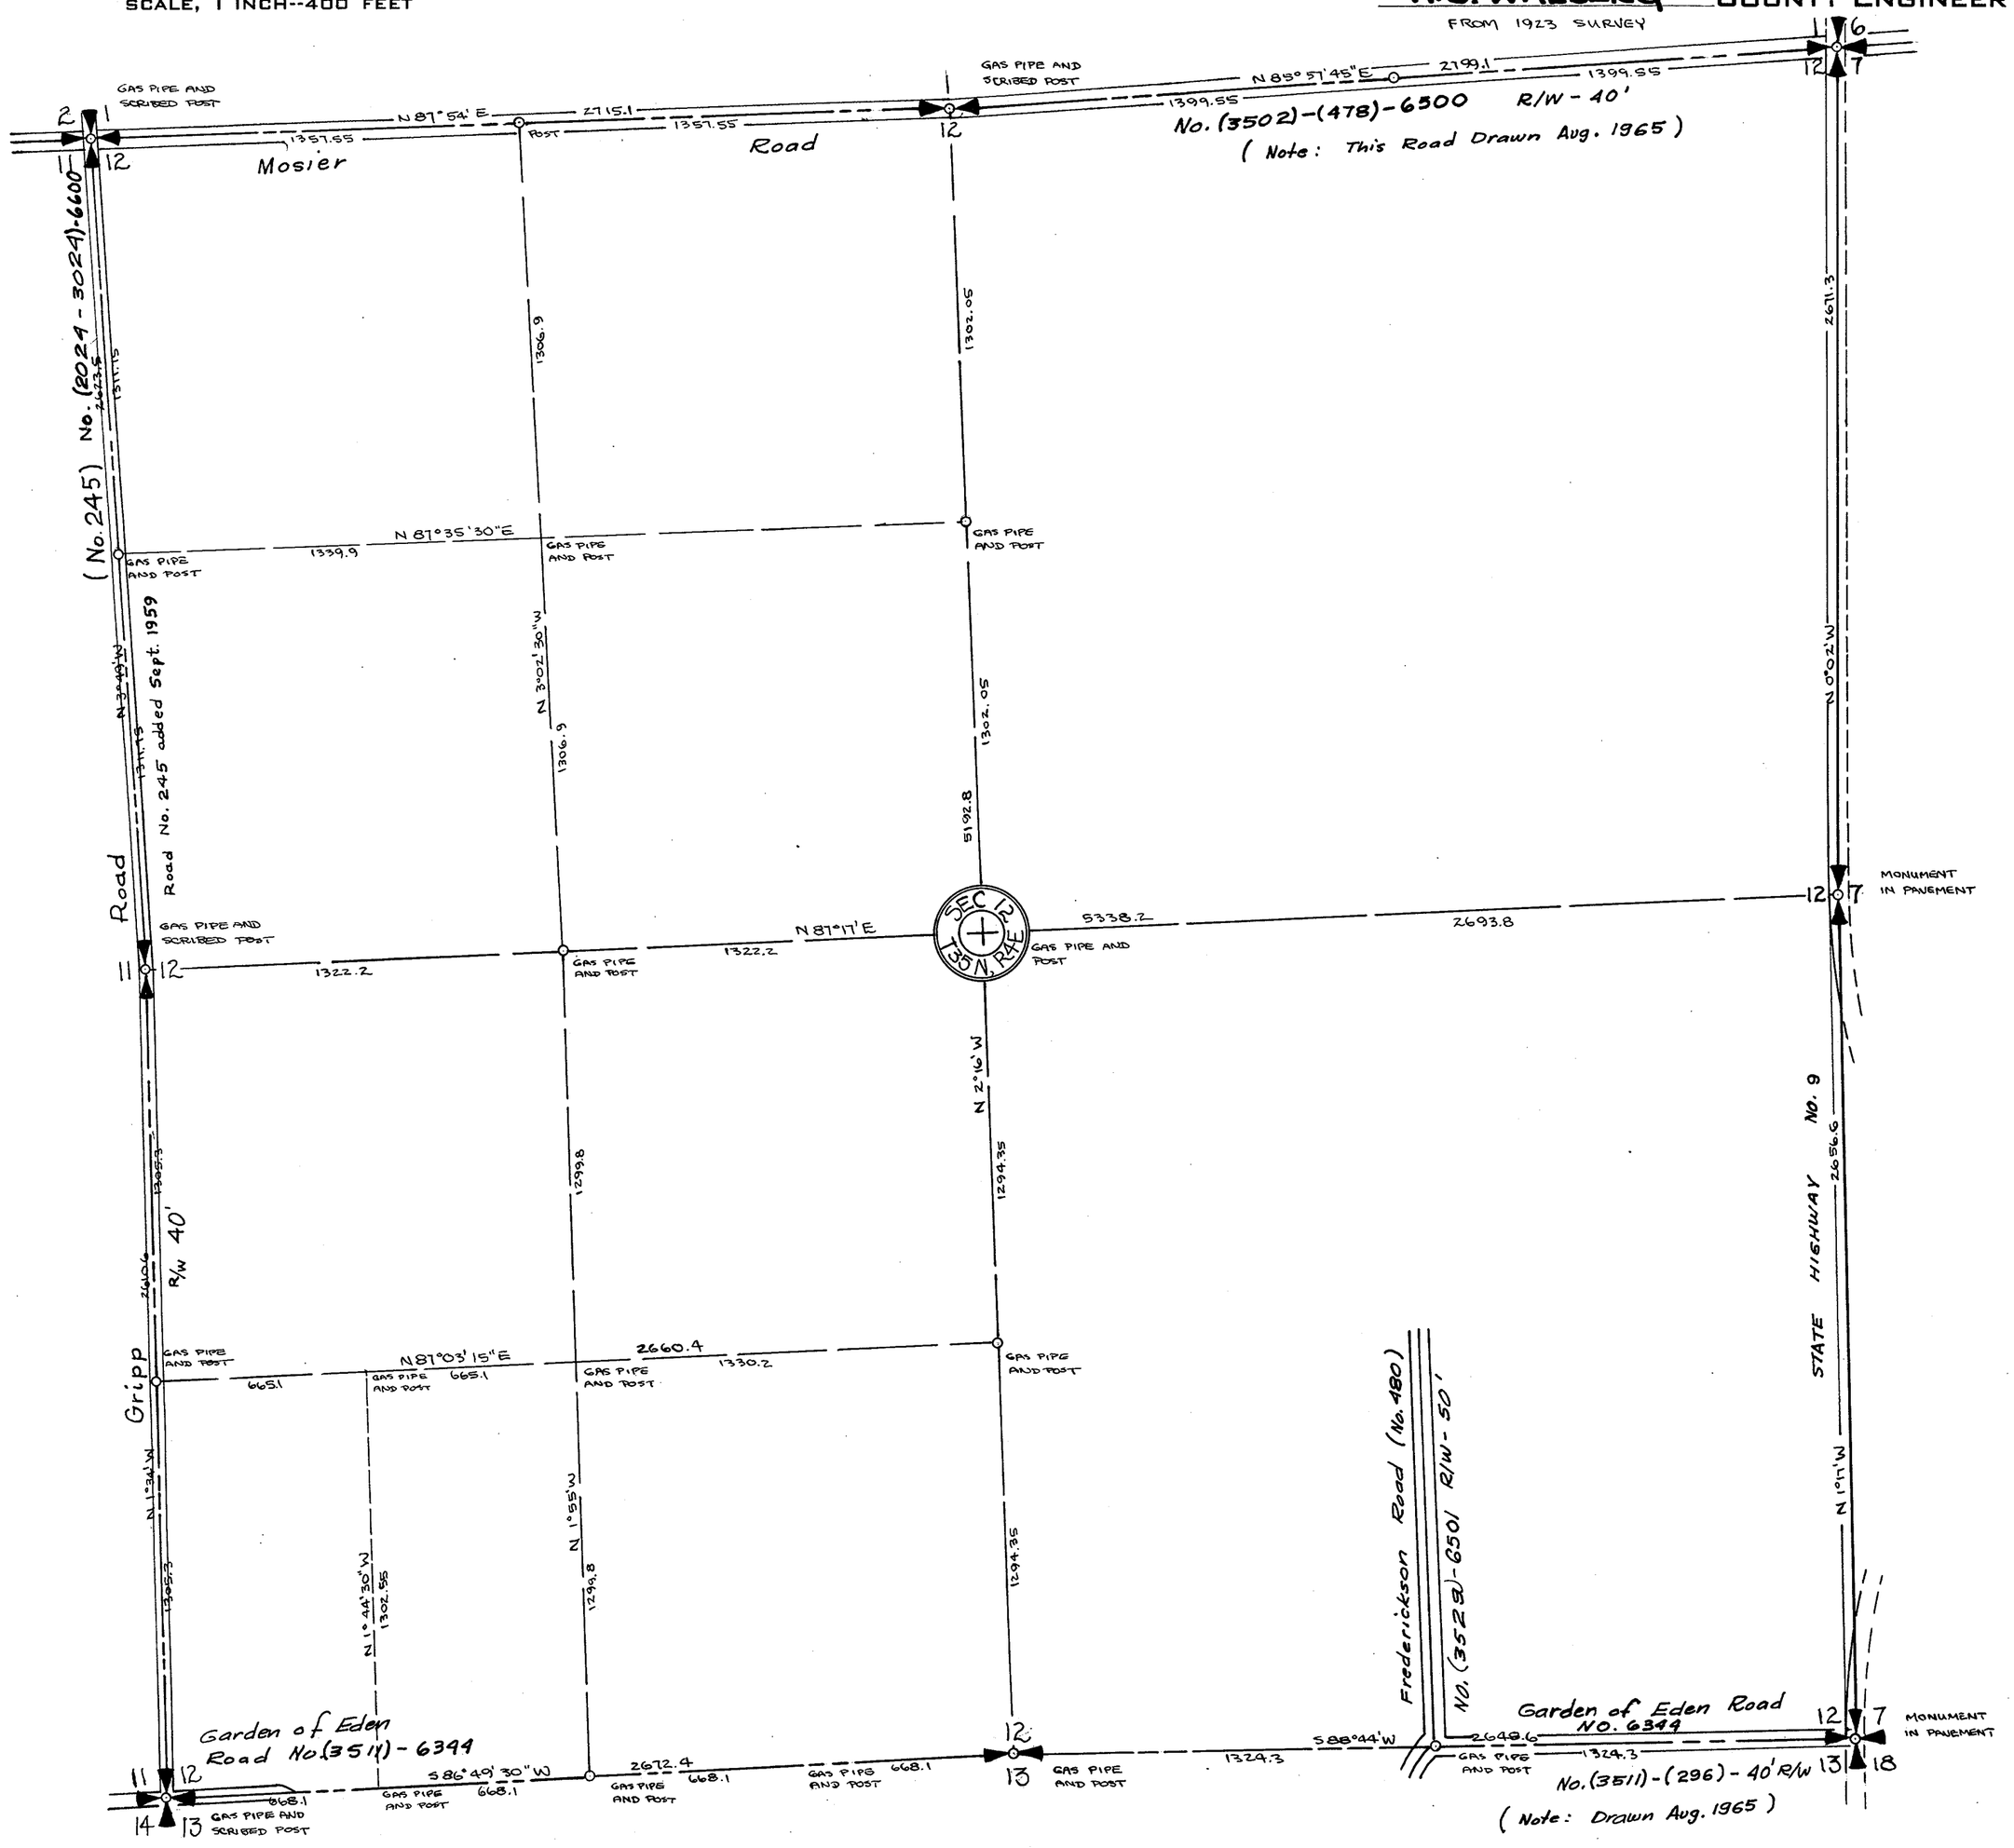

SECTION 13
TOWNSHIP 35 NORTH, RANGE 4 EAST, W. M.
SKAGIT COUNTY, WASH.

SCALE, 1 INCH--400 FEET

DATE September, 1959 Frank Gilkey COUNTY ENGINEER



SECTION 13

TOWNSHIP 35 NORTH, RANGE 4 EAST, W. M.

SKAGIT COUNTY, WASH.

SCALE, 1 INCH--400 FEET

DATE Aug. 1965

COUNTY ENGINEER

NoTes: 422

(Garden of Eden Road) (3511) (479) (6344) R/W - 40'

Bassett Road No. 6345

T-35-N
13
R-4-E

McLean Dr. Road No. 6507 (35112) (453)

No. (35147) 6075

Road R/W - 30' & 40' (Sam Sapp Road No. 320)

DUKES HILL EST. VOL 10, 22

SAPP (John Kiens Road No. 146)

Reed Ave. Extn. No. (3523)-(399) 6419

3/4" Pipe

East Jones Road No. (3512)-(55) 6312

R/W - 30'

J. Liner Road No. (3525) 6423

(400)

SECTION 13


TOWNSHIP 35 NORTH, RANGE 4 EAST, W. M.

SKAGIT COUNTY, WASH.

SCALE, 1 INCH--400 FEET

H.O. WALBERG COUNTY ENGINEER


FROM 1923 SURVEY

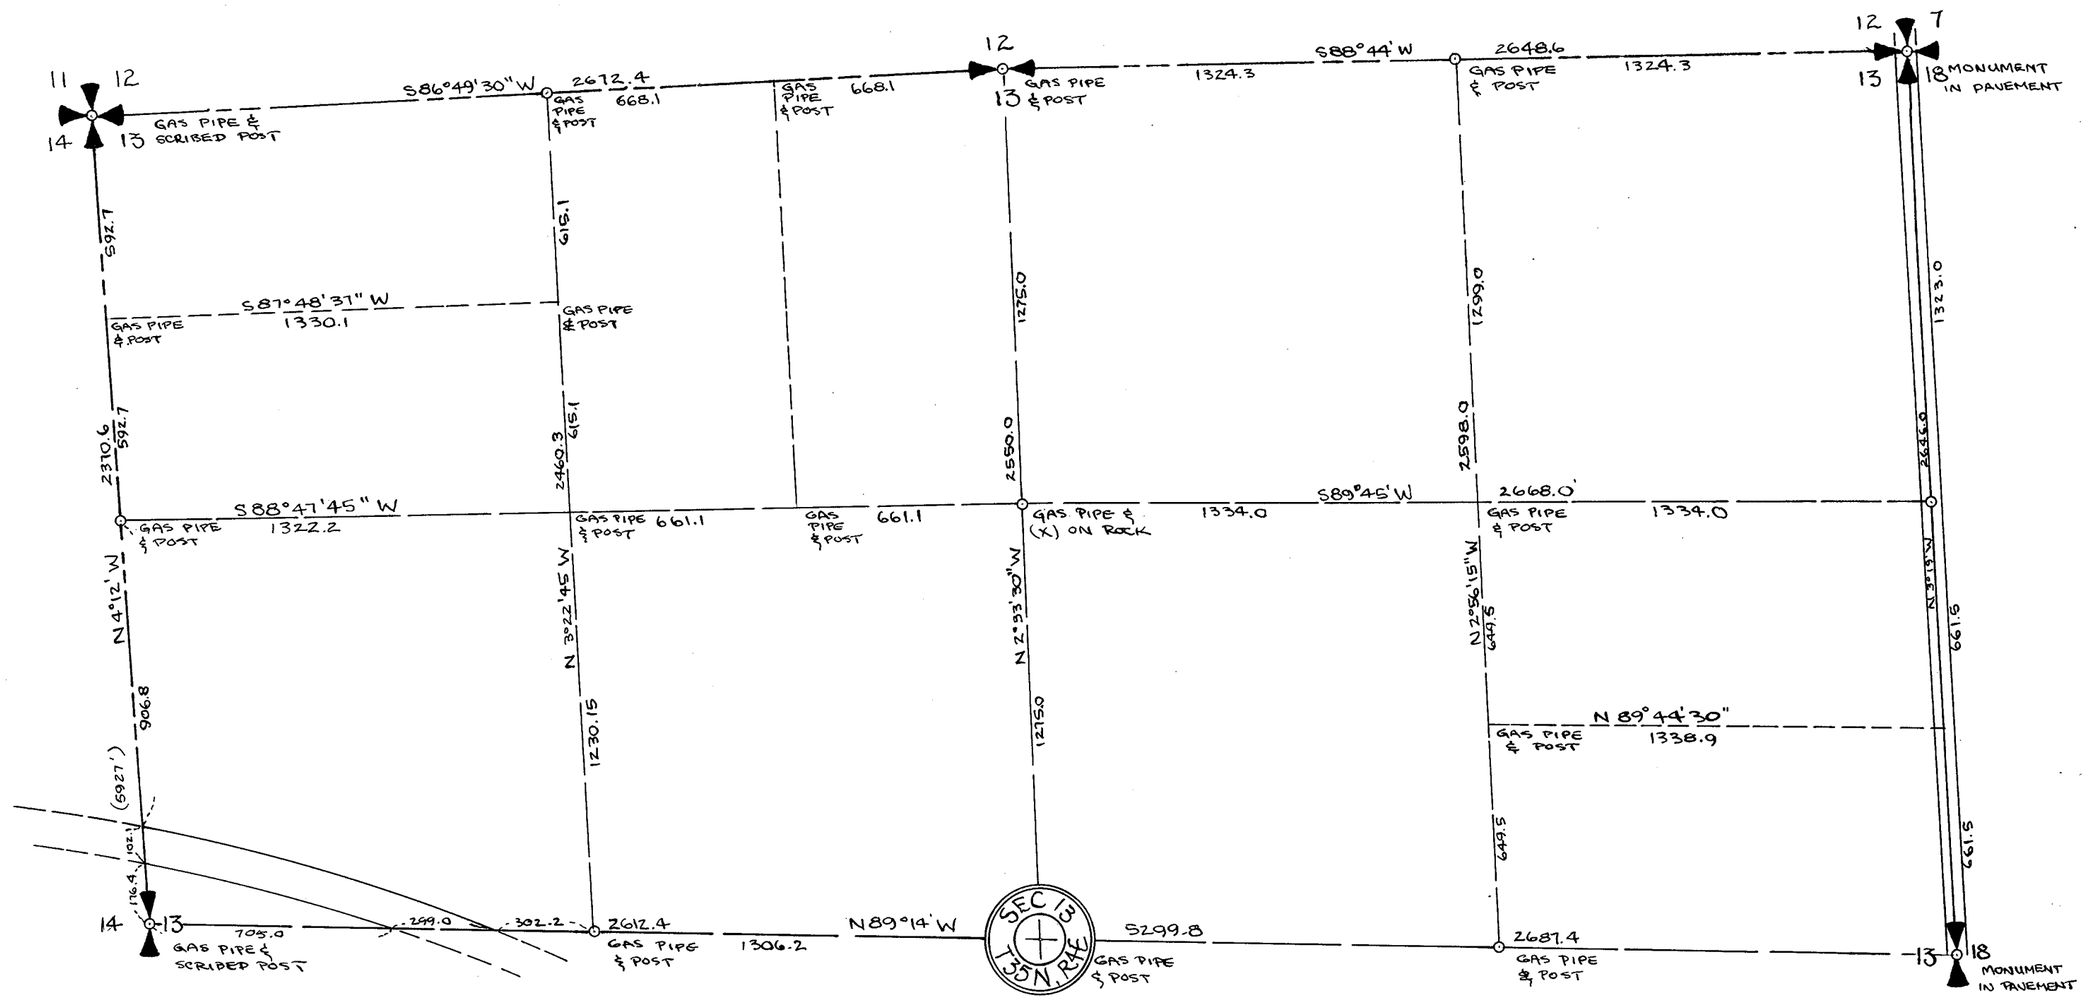

SECTION 14
TOWNSHIP 35 NORTH, RANGE 4 EAST, W. M.
SKAGIT COUNTY, WASH.

SCALE, 1 INCH--400 FEET

DATE October, 1959 Frank Gilkey COUNTY ENGINEER

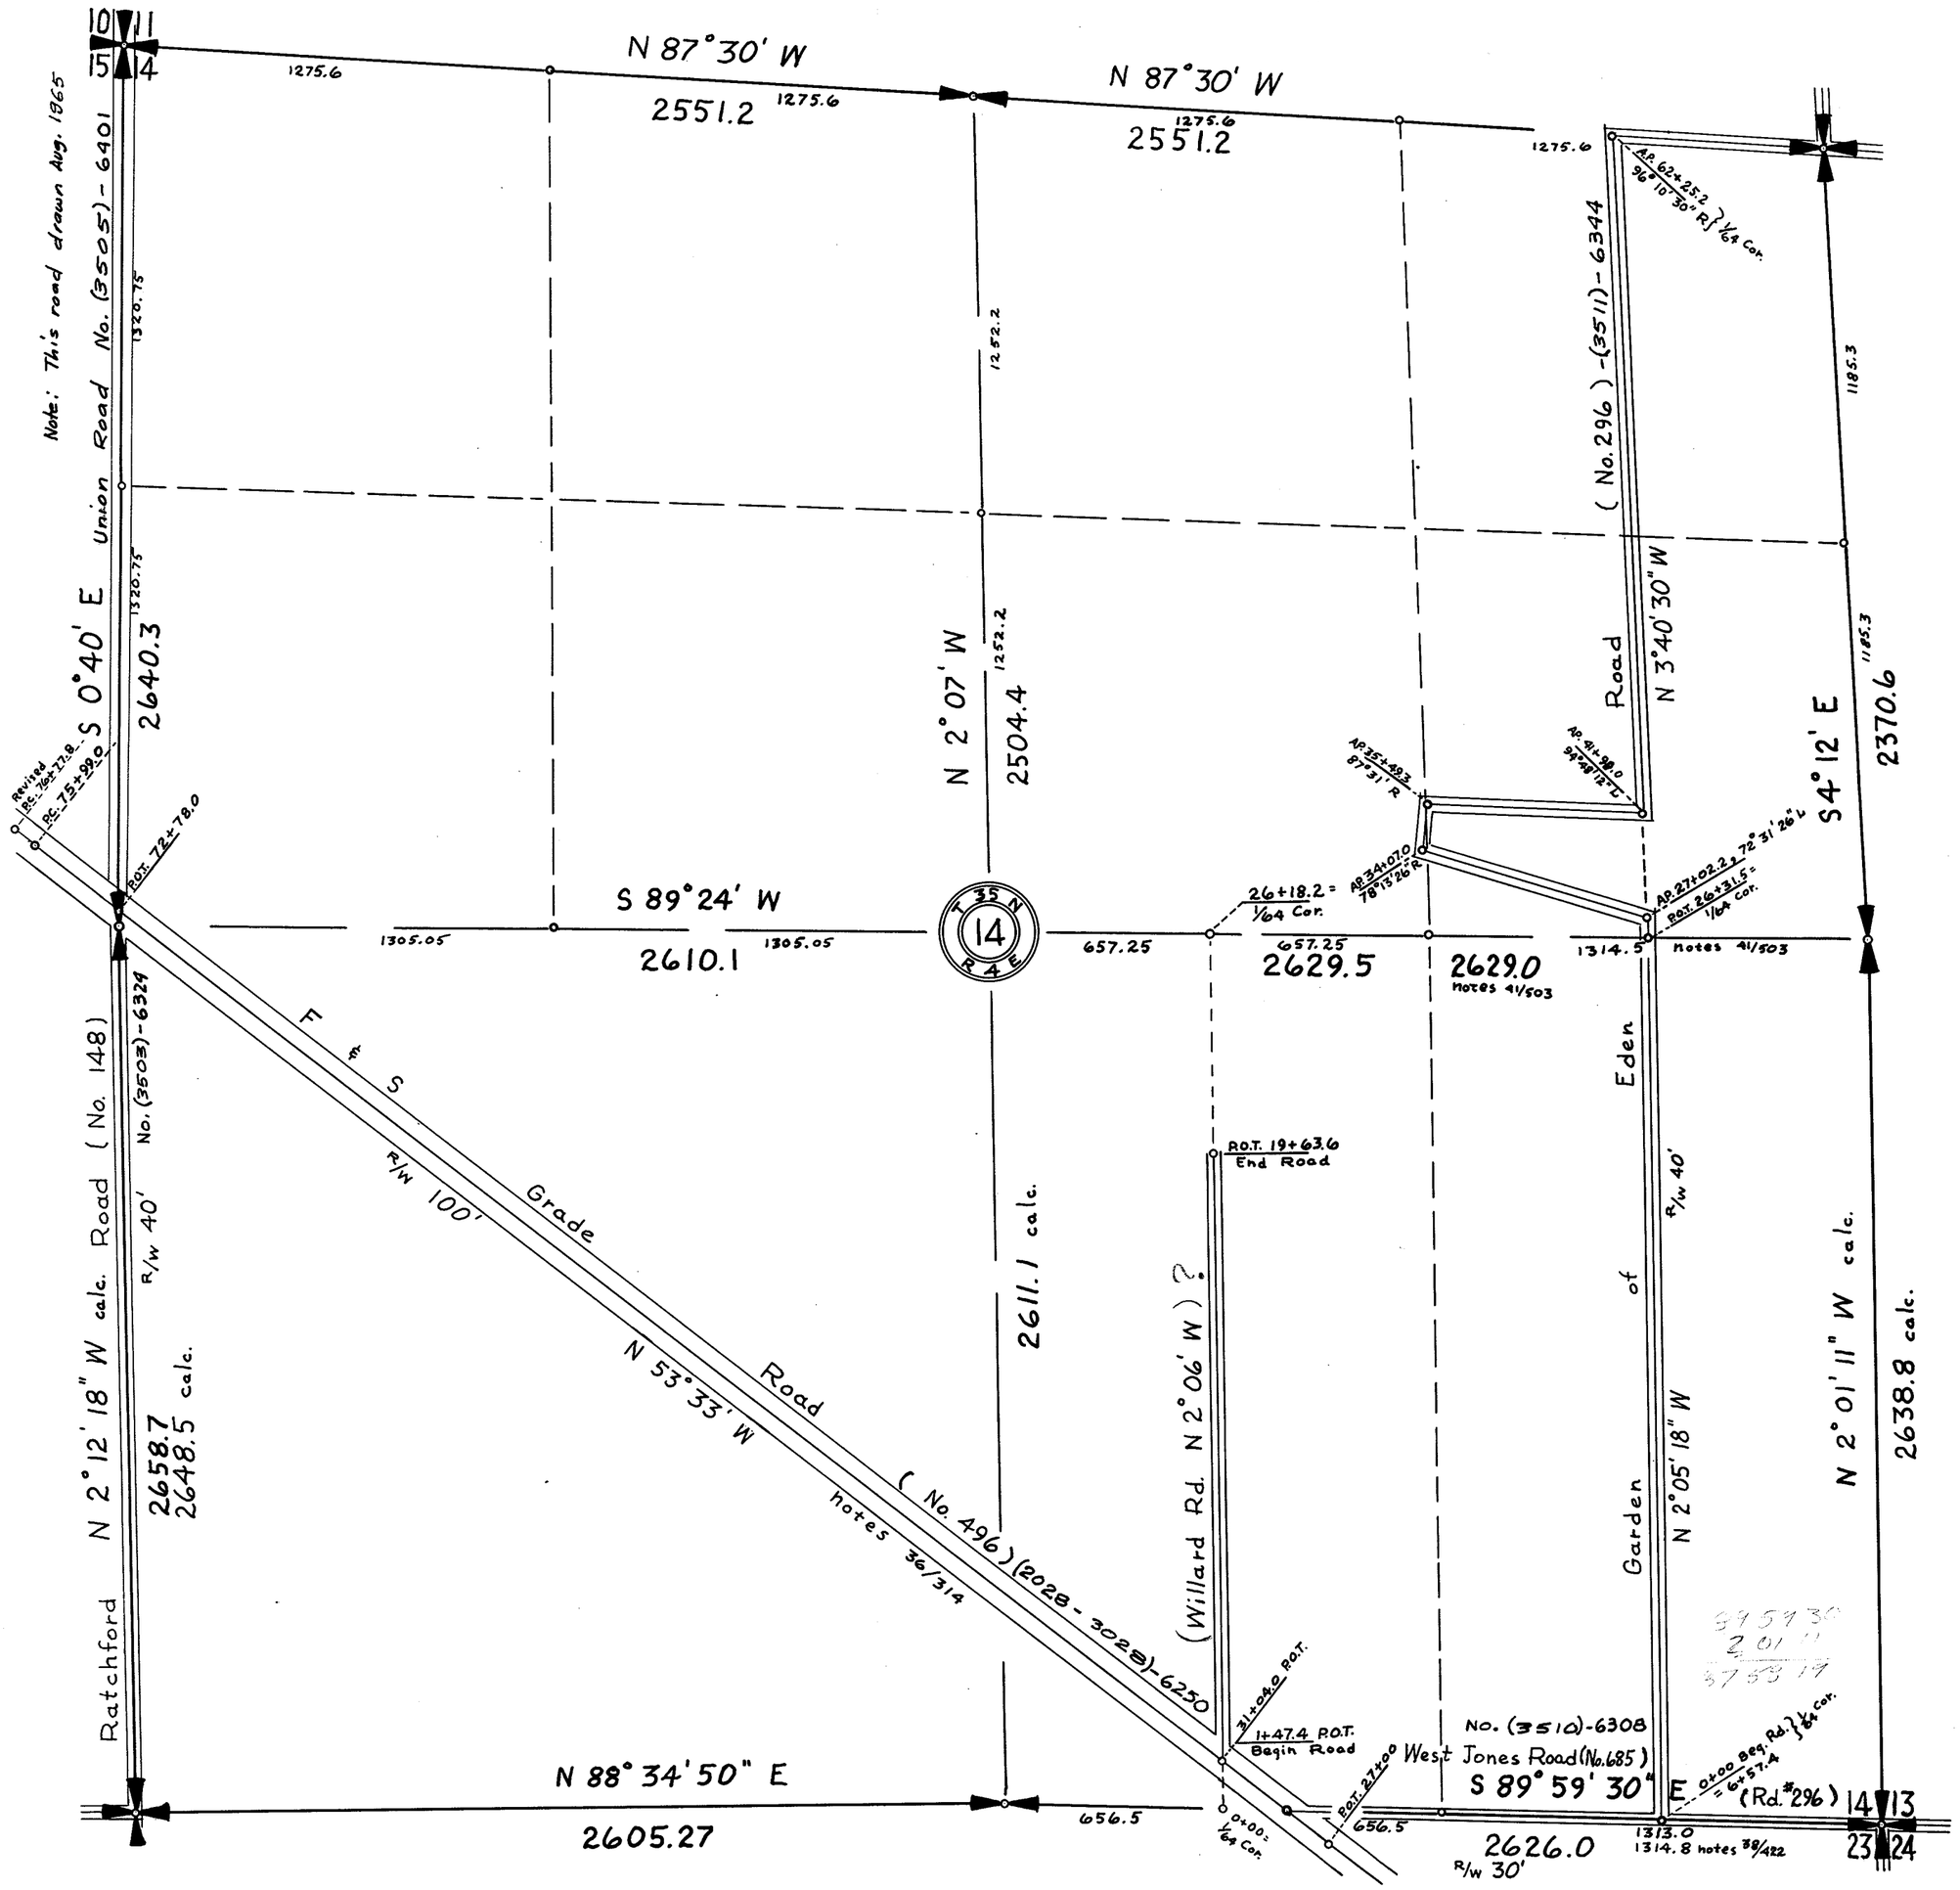

SECTION 14


TOWNSHIP 35 NORTH, RANGE 4 EAST, W. M.

SKAGIT COUNTY, WASH.

SCALE, 1 INCH--400 FEET

H.O. WALBERG COUNTY ENGINEER

FROM 1923 SURVEY

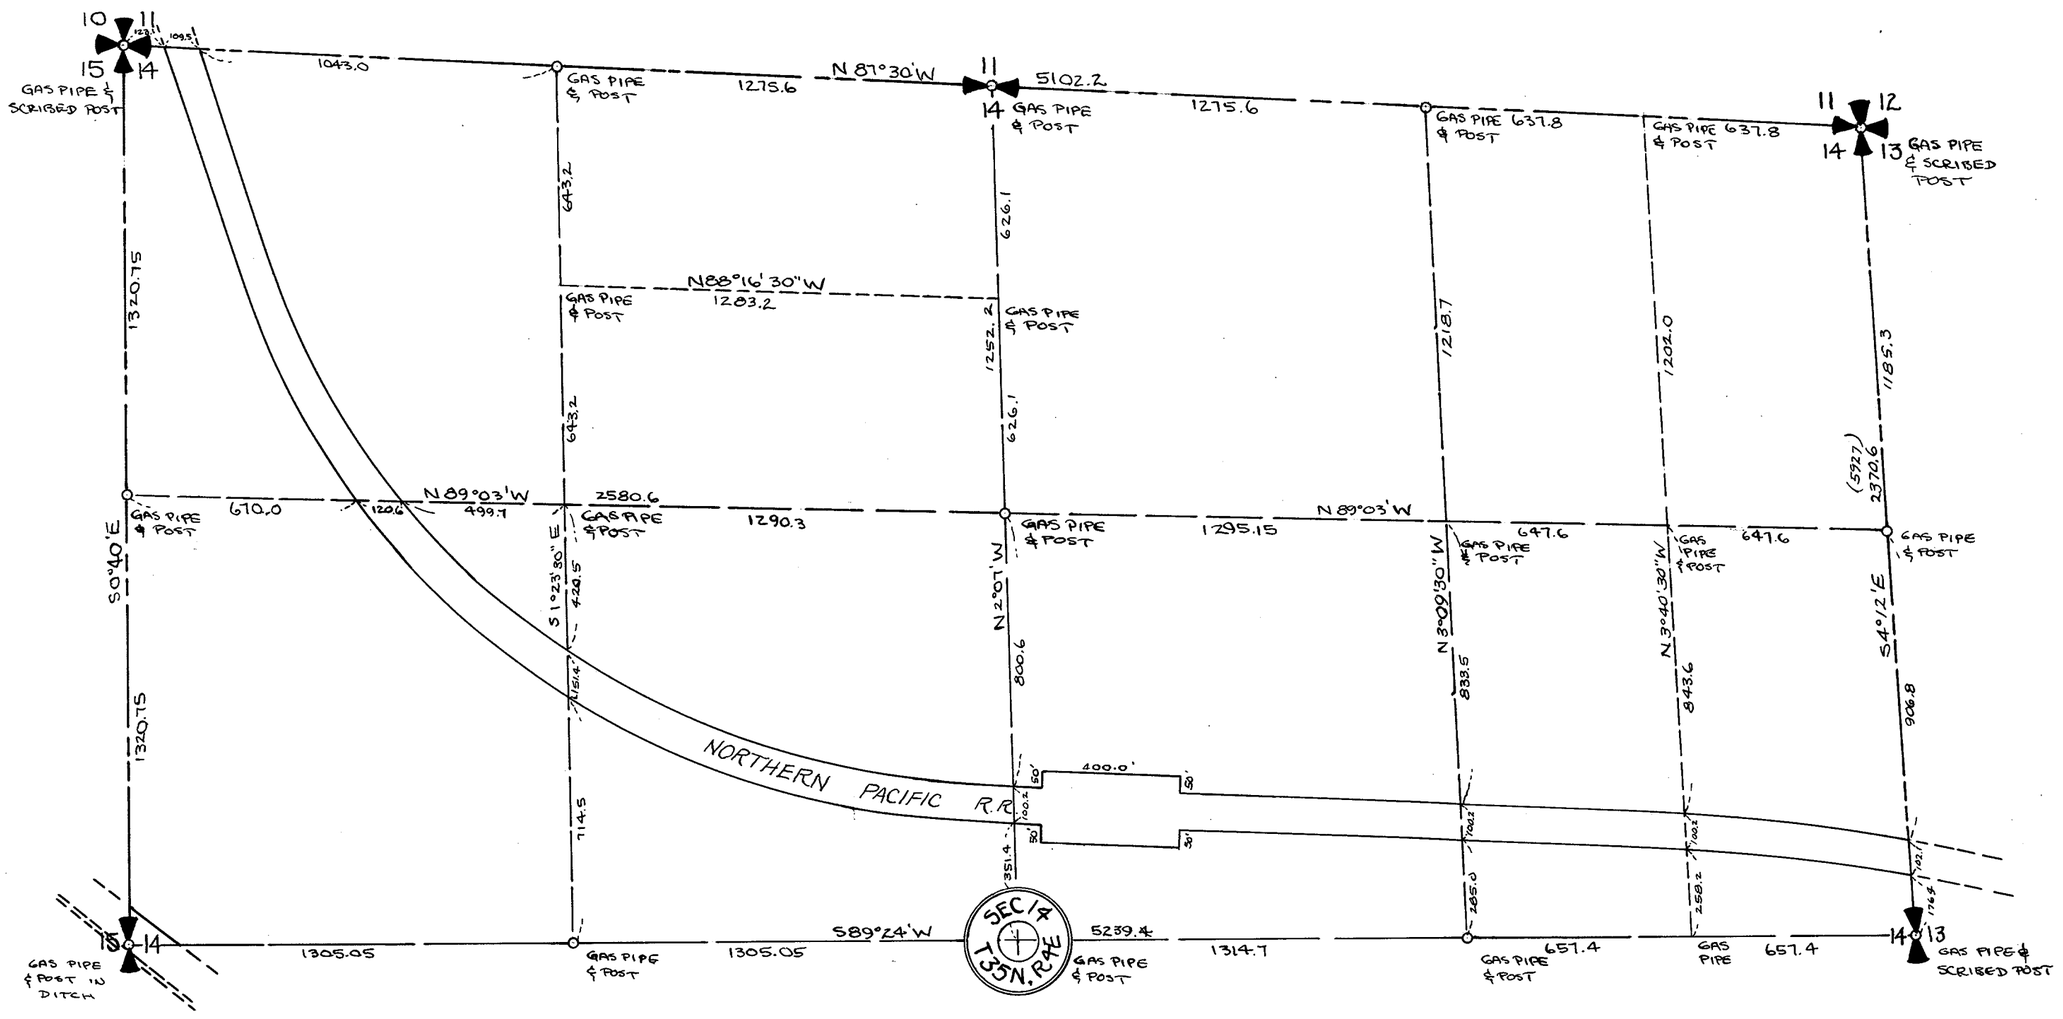



TOWNSHIP 35 NORTH, RANGE 4 EAST, W. M.

SKAGIT COUNTY, WASH.

SCALE, 1 INCH--400 FEET

DATE October, 1959 Frank Gilkey COUNTY ENGINEER

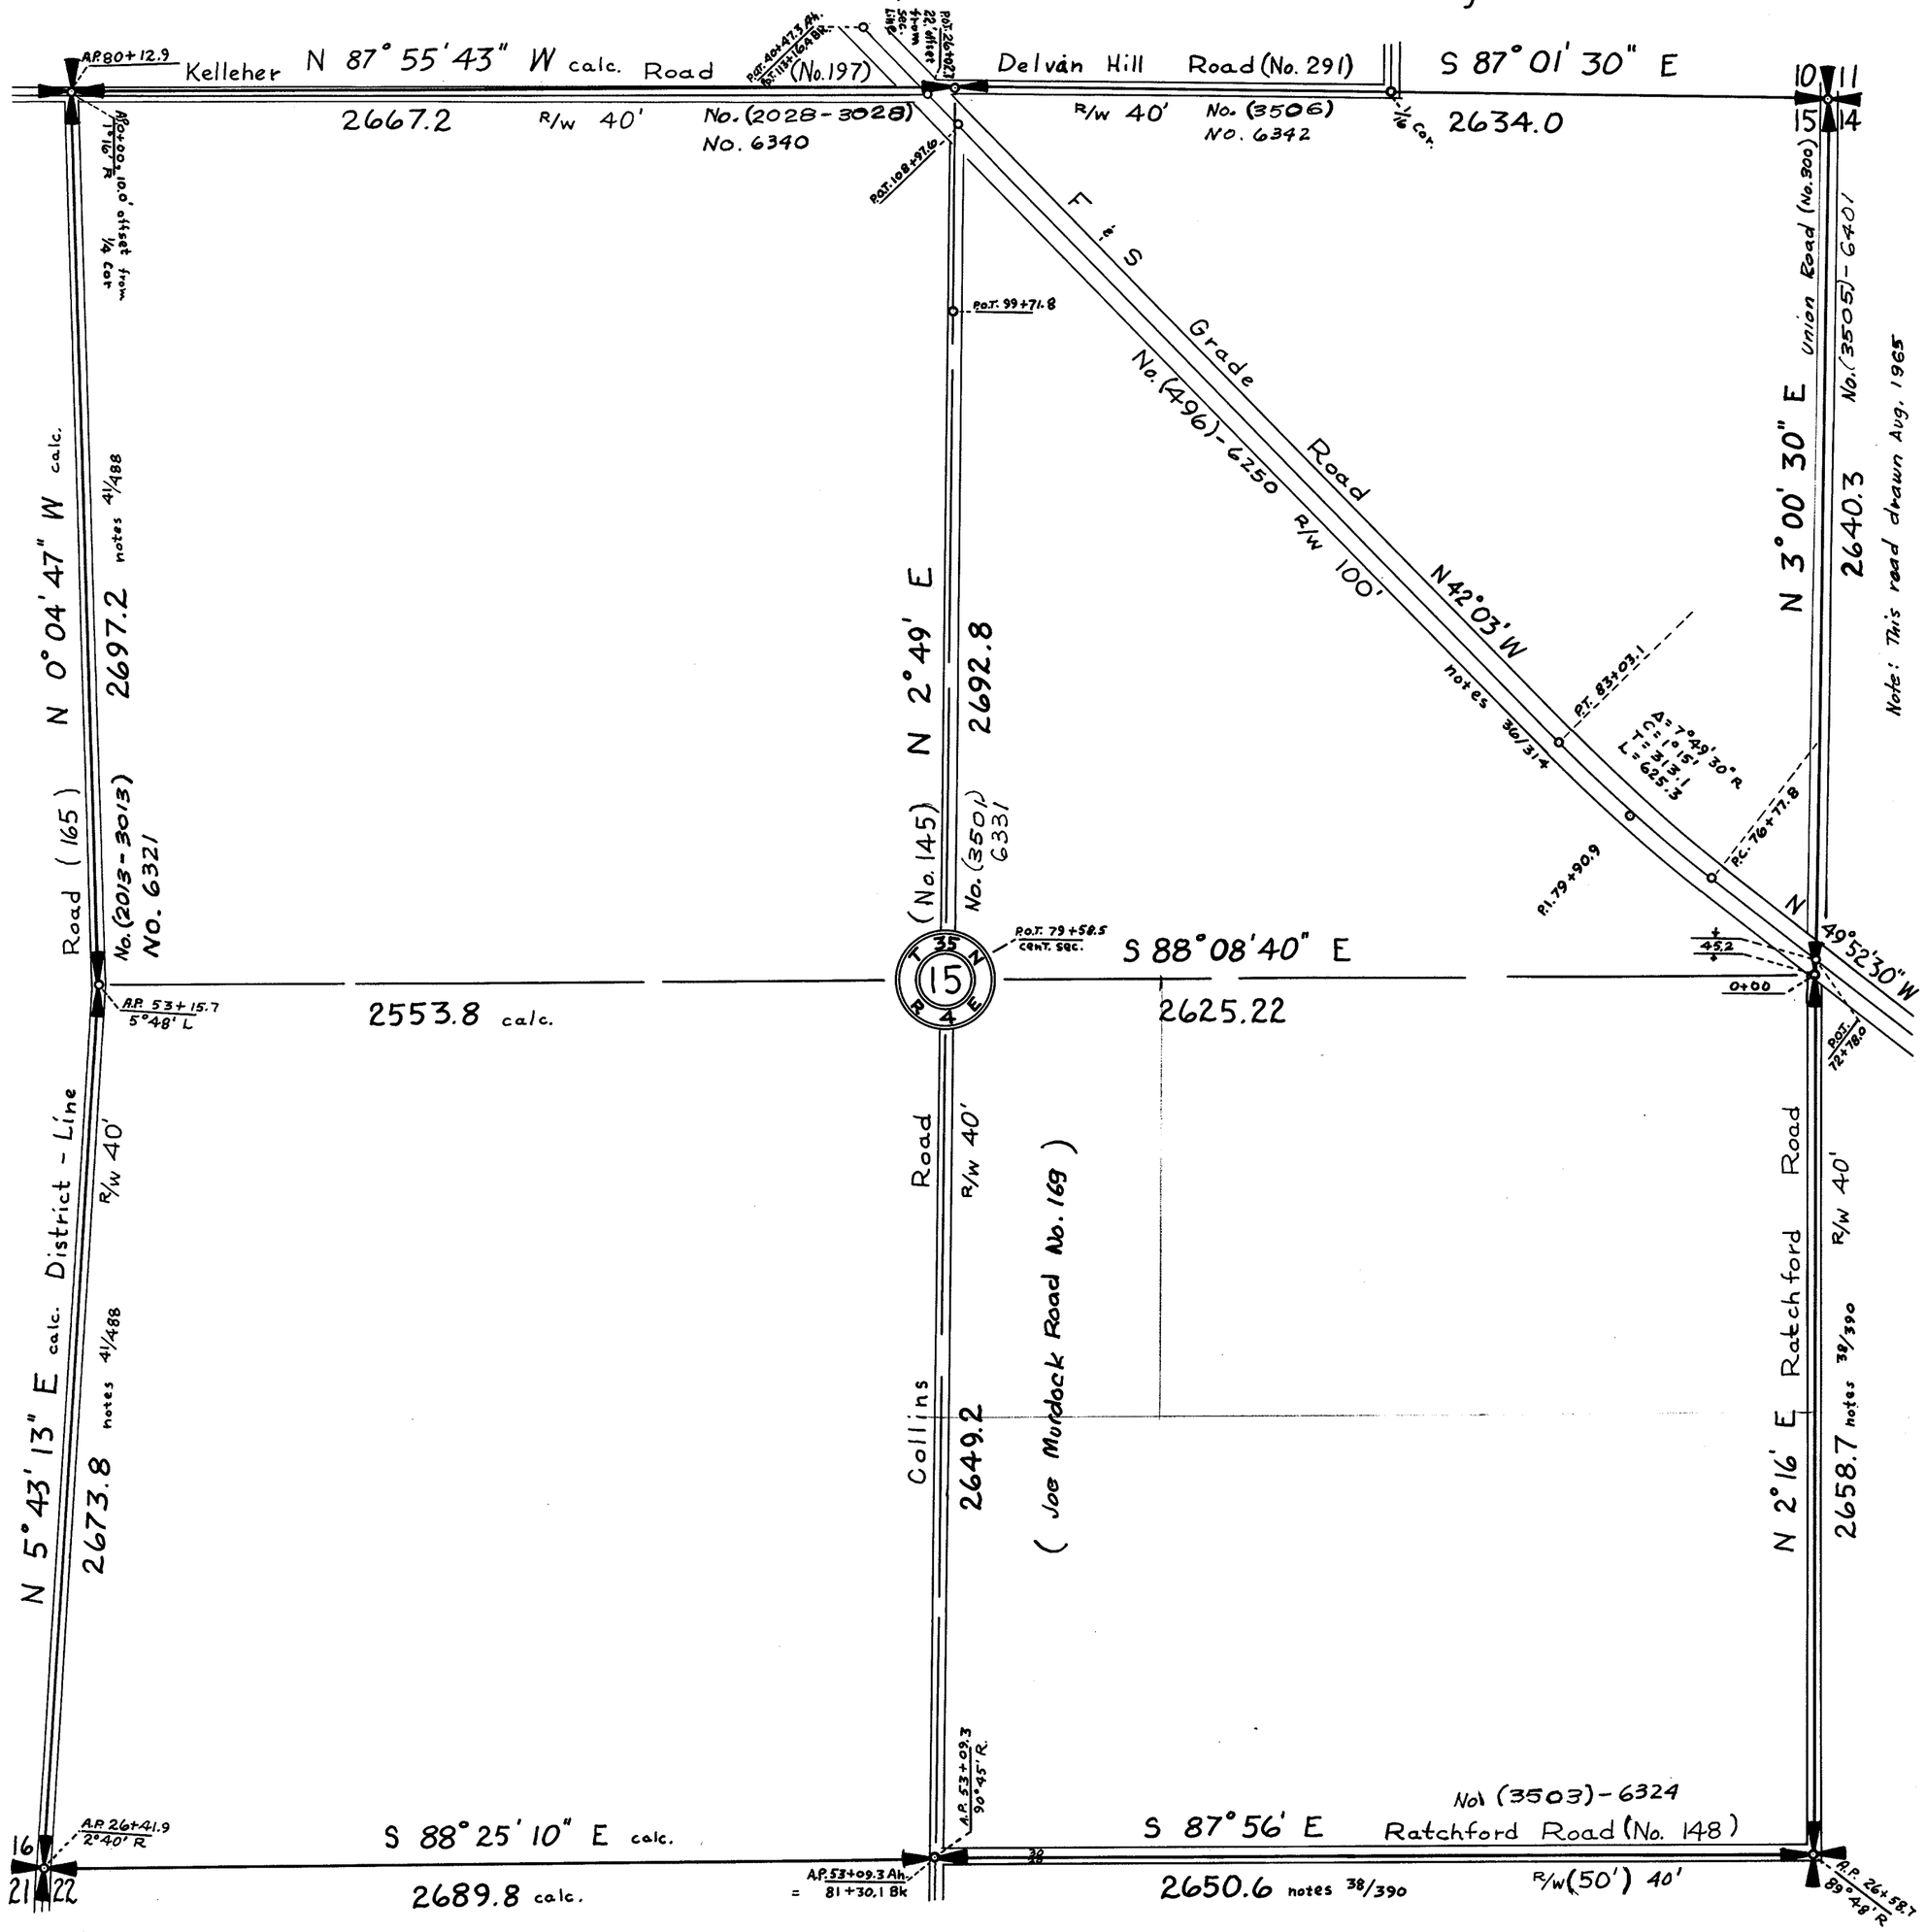


SECTION 15

TOWNSHIP 35 NORTH, RANGE 4 EAST, W. M.

SKAGIT COUNTY, WASH.

SCALE, 1 INCH--400 FEET

H.O. WALBERG COUNTY ENGINEER

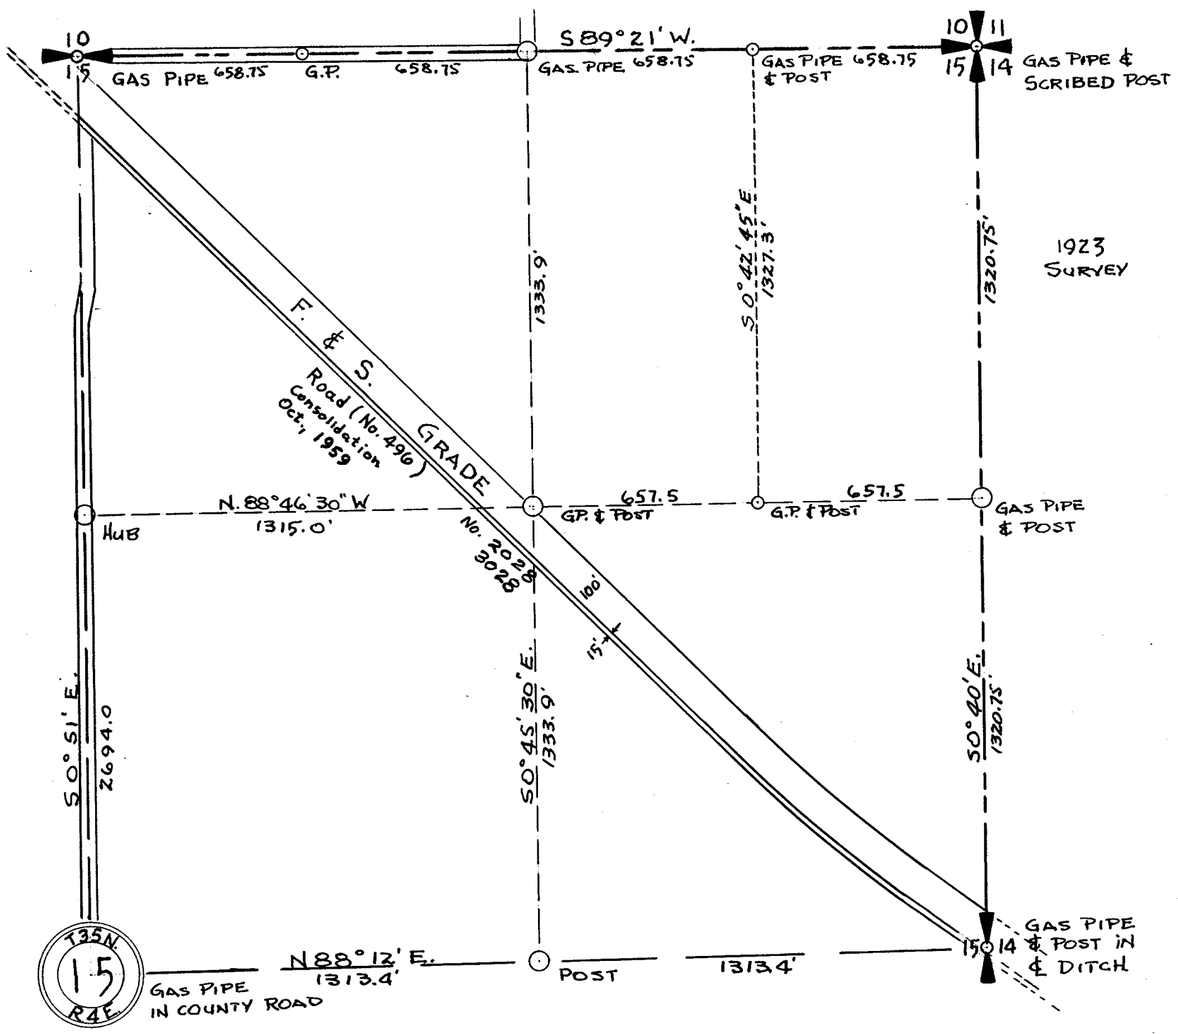


SECTION 15

TOWNSHIP 35 NORTH, RANGE 4 EAST, W. M.

SKAGIT COUNTY, WASH.

SCALE, 1 INCH--400 FEET

_____ COUNTY ENGINEER

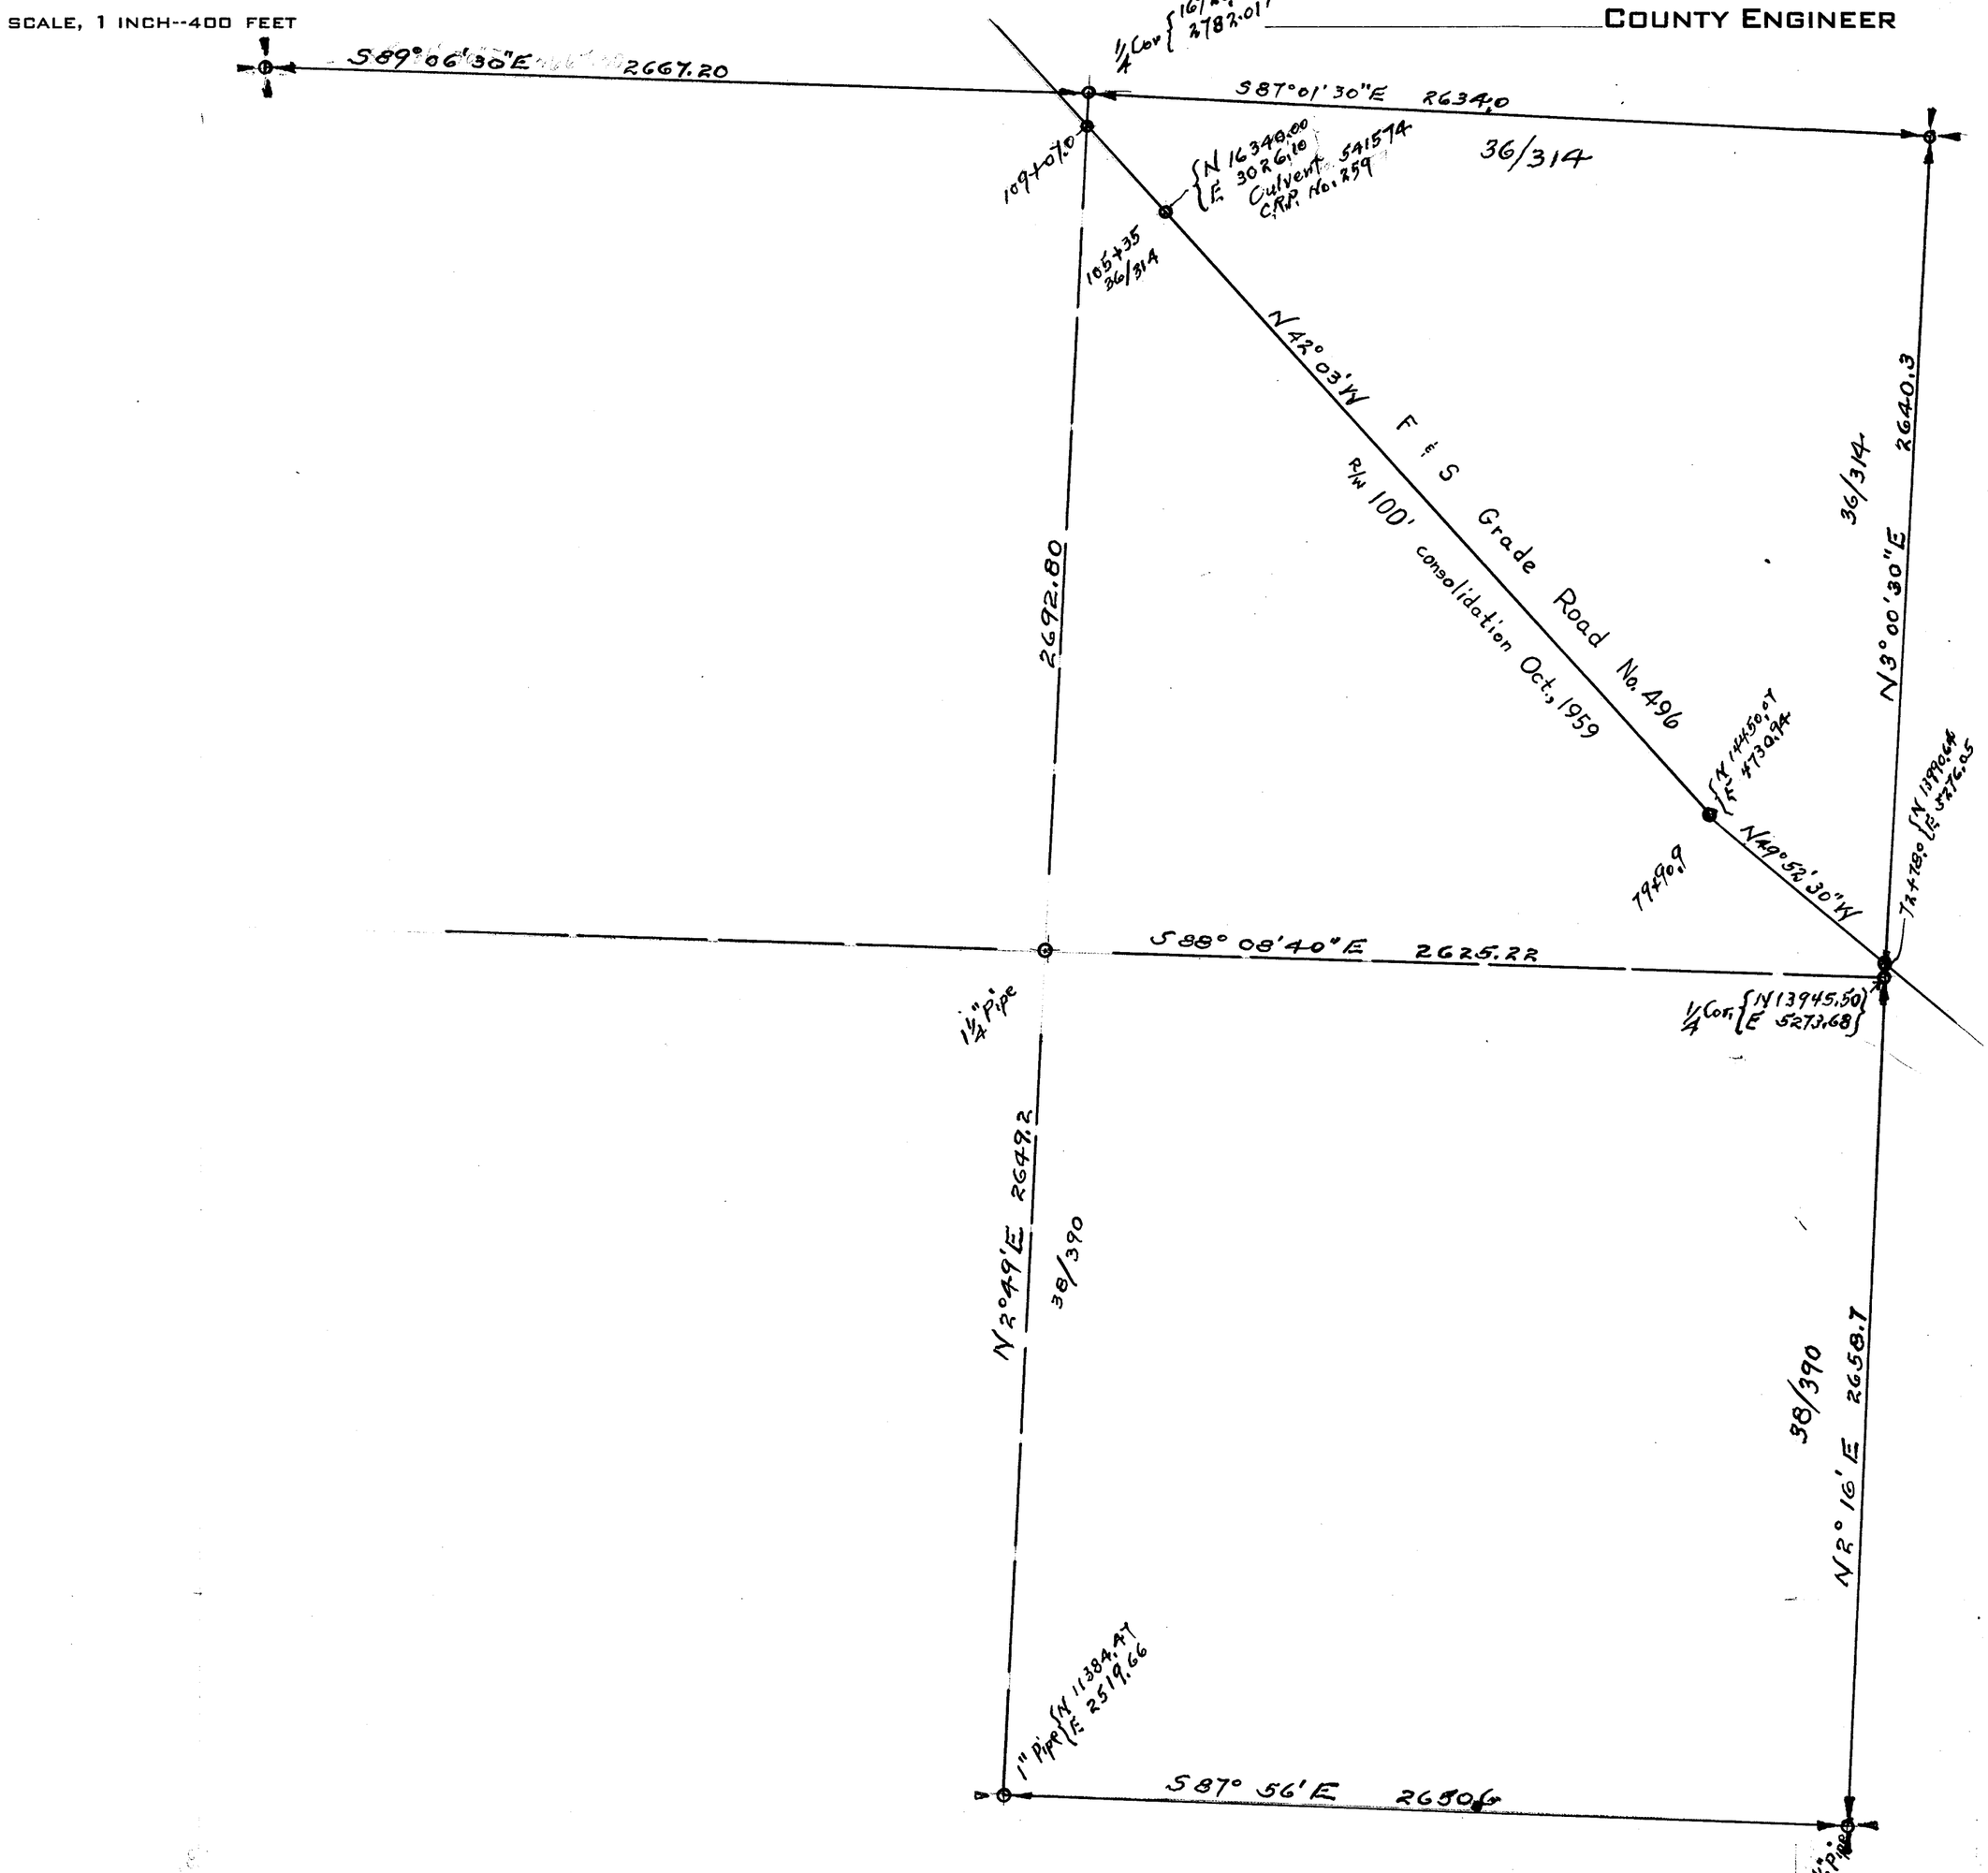


SECTION 15

TOWNSHIP 35 NORTH, RANGE 4 EAST, W. M.
SKAGIT COUNTY, WASH.

SCALE, 1 INCH–400 FEET

A. L. STRONG COUNTY ENGINEER

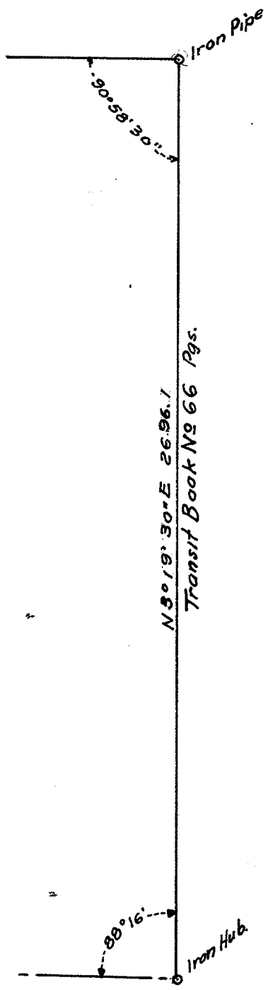


SECTION 16

TOWNSHIP 35 NORTH, RANGE 4 EAST, W. M.
SKAGIT COUNTY, WASH.

SCALE, 1 INCH–400 FEET

A. L. STRONG COUNTY ENGINEER

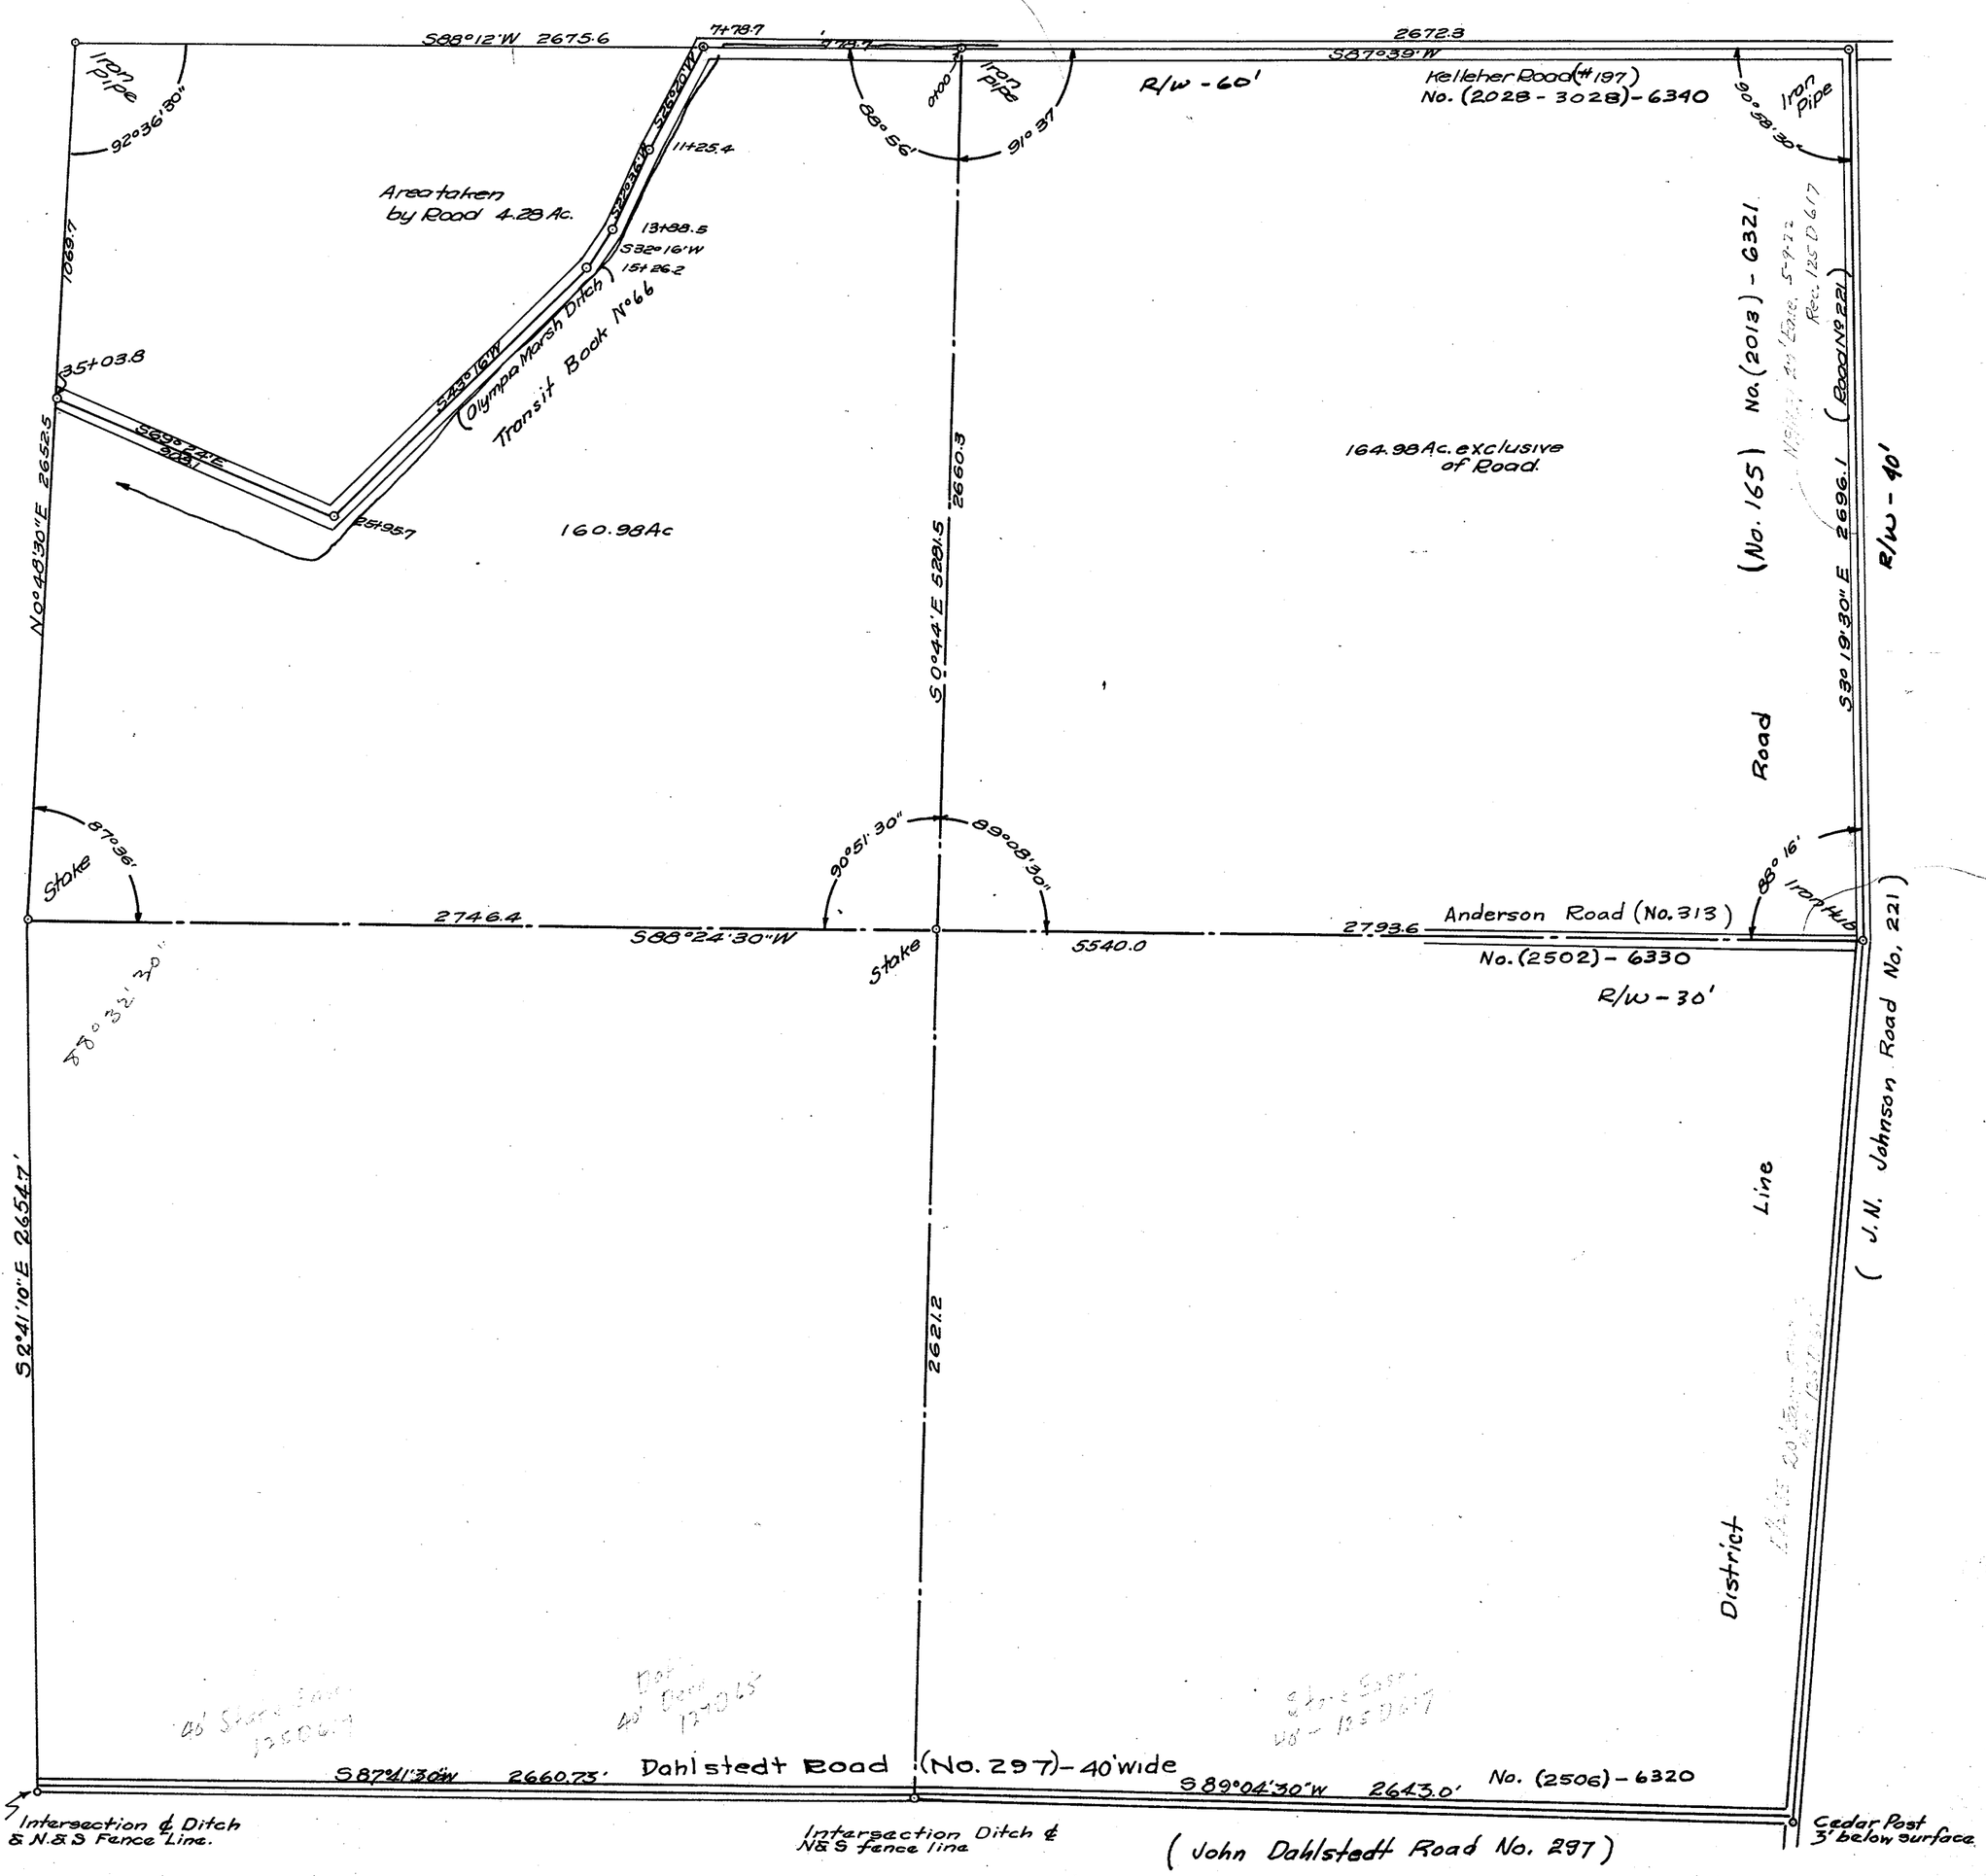


SECTION 16

TOWNSHIP 35 NORTH, RANGE 4 EAST, W. M.
SKAGIT COUNTY, WASH.

SCALE, 1 INCH–400 FEET
H.E.Kerr.

R.E.L.Knapp. COUNTY ENGINEER

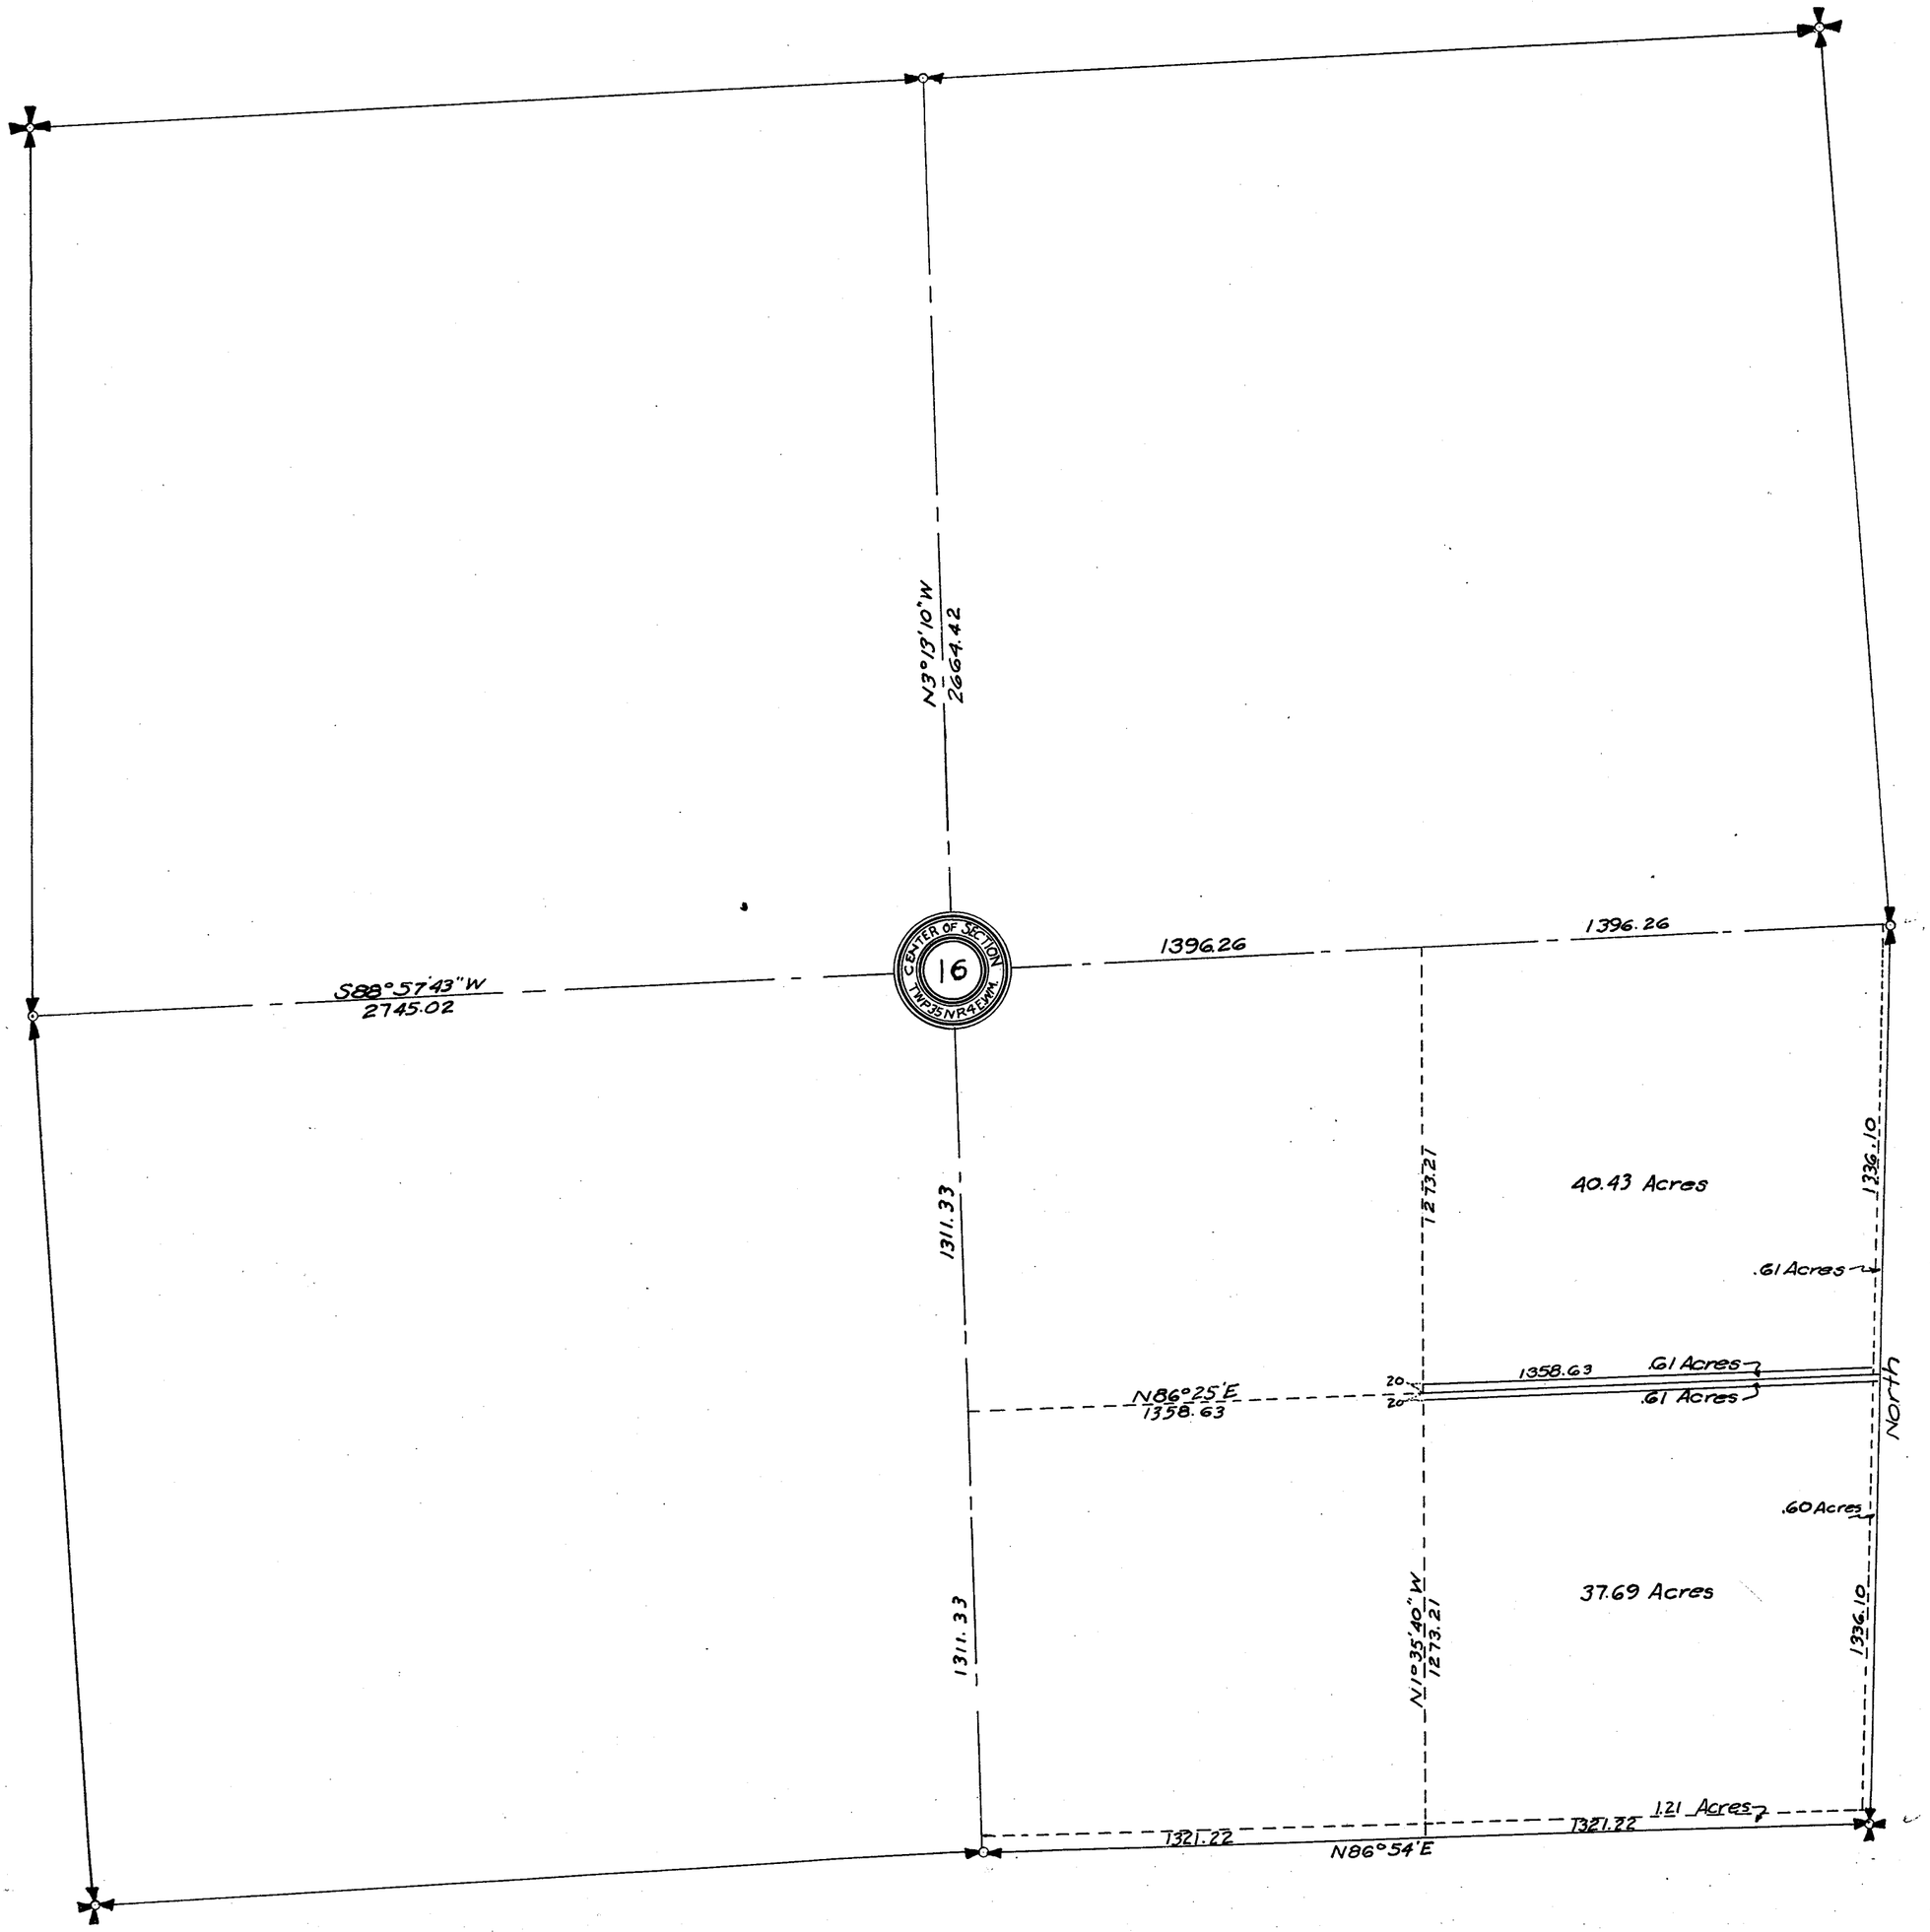


SECTION 17

TOWNSHIP 35 NORTH. RANGE 4 EAST. W. M.

SKAGIT COUNTY. WASH.

SCALE, 1 INCH–400 FEET

A. L. STRONG COUNTY ENGINEER

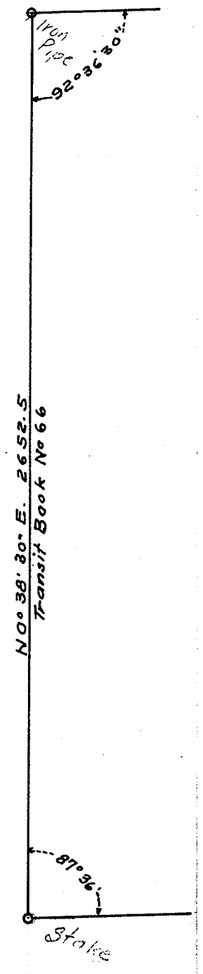

SECTION 17


TOWNSHIP 35 NORTH, RANGE 4 EAST, W. M.

SKAGIT COUNTY, WASH.

SCALE, 1 INCH--400 FEET

DATE Aug. 1963

COUNTY ENGINEER

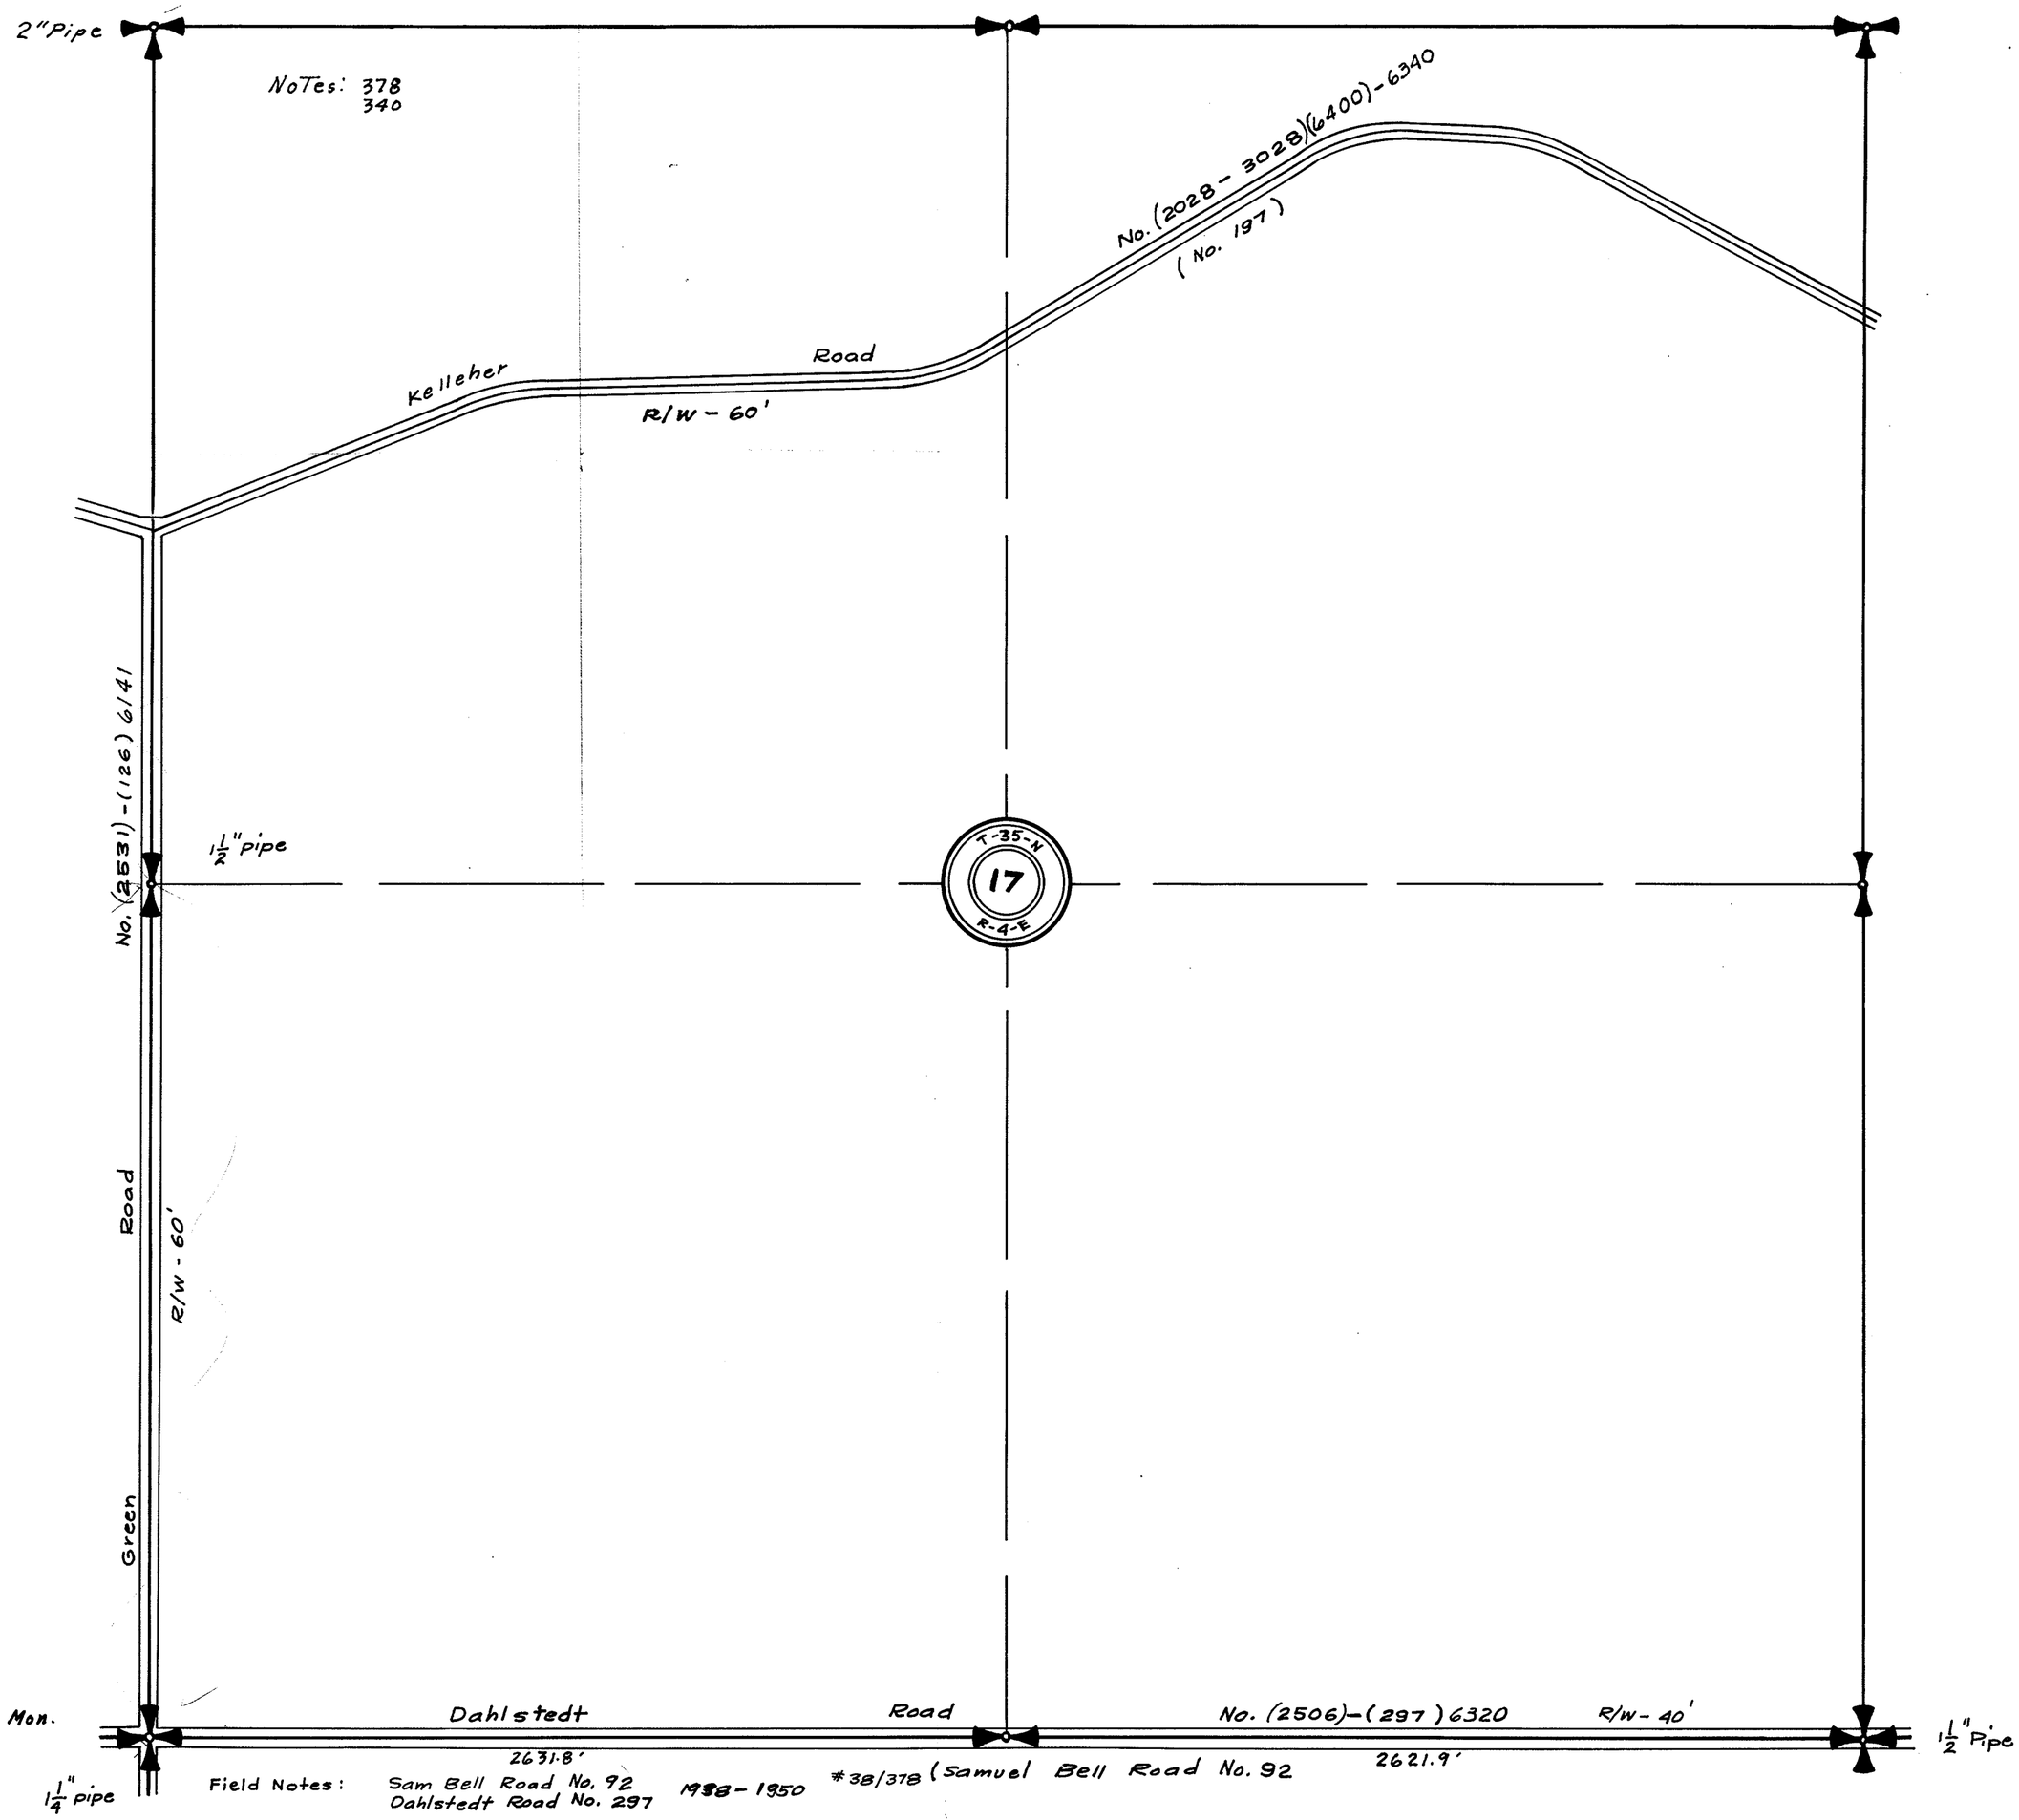

Field Notes: Sam Bell Road No. 92
Dahlstedt Road No. 297
1938 - 1950
#38/378 (Samuel Bell Road No. 92

SECTION 18


TOWNSHIP 35 NORTH, RANGE 4 EAST, W. M.

SKAGIT COUNTY, WASH.

SCALE, 1 INCH--400 FEET

DATE August , 1959

Frank Gilkey COUNTY ENGINEER

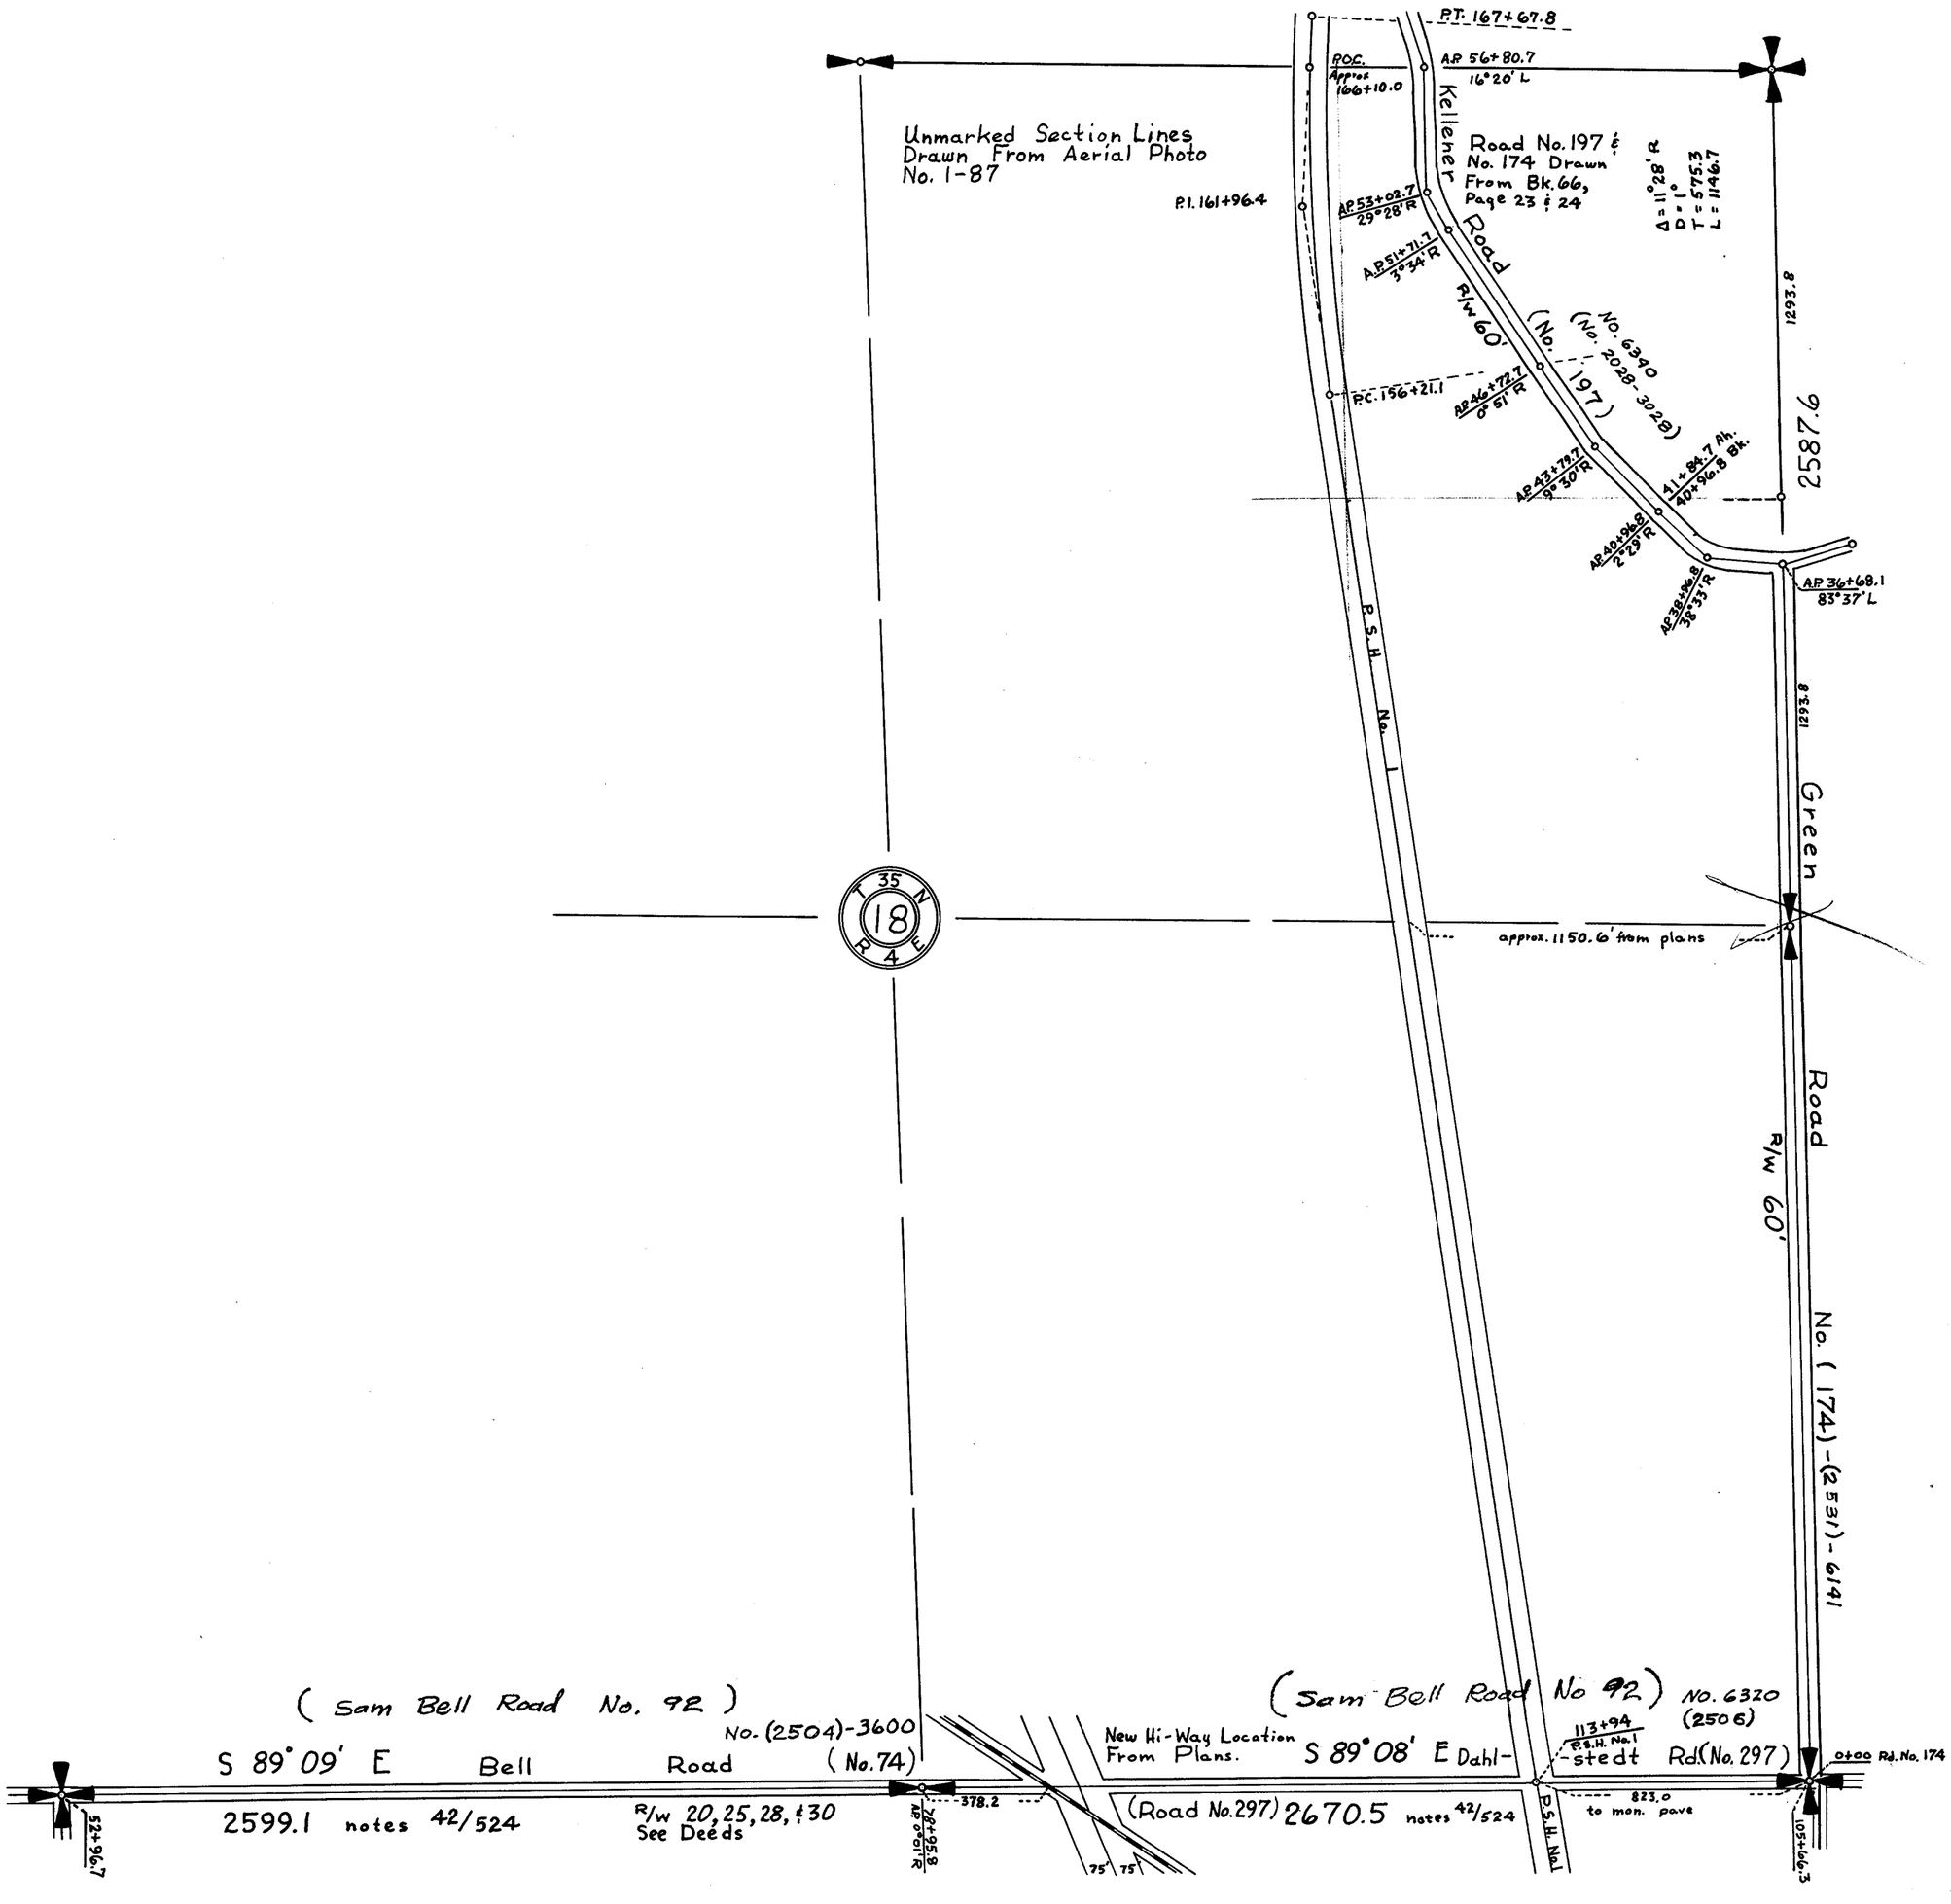

SECTION 18

TOWNSHIP 35 NORTH, RANGE 4 EAST, W. M.

SKAGIT COUNTY, WASH.

SCALE, 1 INCH--400 FEET

_____ COUNTY ENGINEER



SECTION 19

TOWNSHIP 35 NORTH, RANGE 4 EAST, W. M.
SKAGIT COUNTY, WASH.

SCALE, 1 INCH–400 FEET

_____ COUNTY ENGINEER

24 19 (~~PULVER ROAD NO CVII~~) (~~OLYMPIA-MARSH AND RIVERSIDE ROAD NO CXXXIX~~) 19 20

Cook Road 5219.3 by J.W. Meehan (No. 33) by Consolidation July, 1959

(No. 2030 - 3030) R/W - 40'

SECTION 19


TOWNSHIP 35 NORTH, RANGE 4 EAST, W. M.

SKAGIT COUNTY, WASH.

SCALE, 1 INCH--400 FEET

DATE July, 1959

Frank Gilkey COUNTY ENGINEER

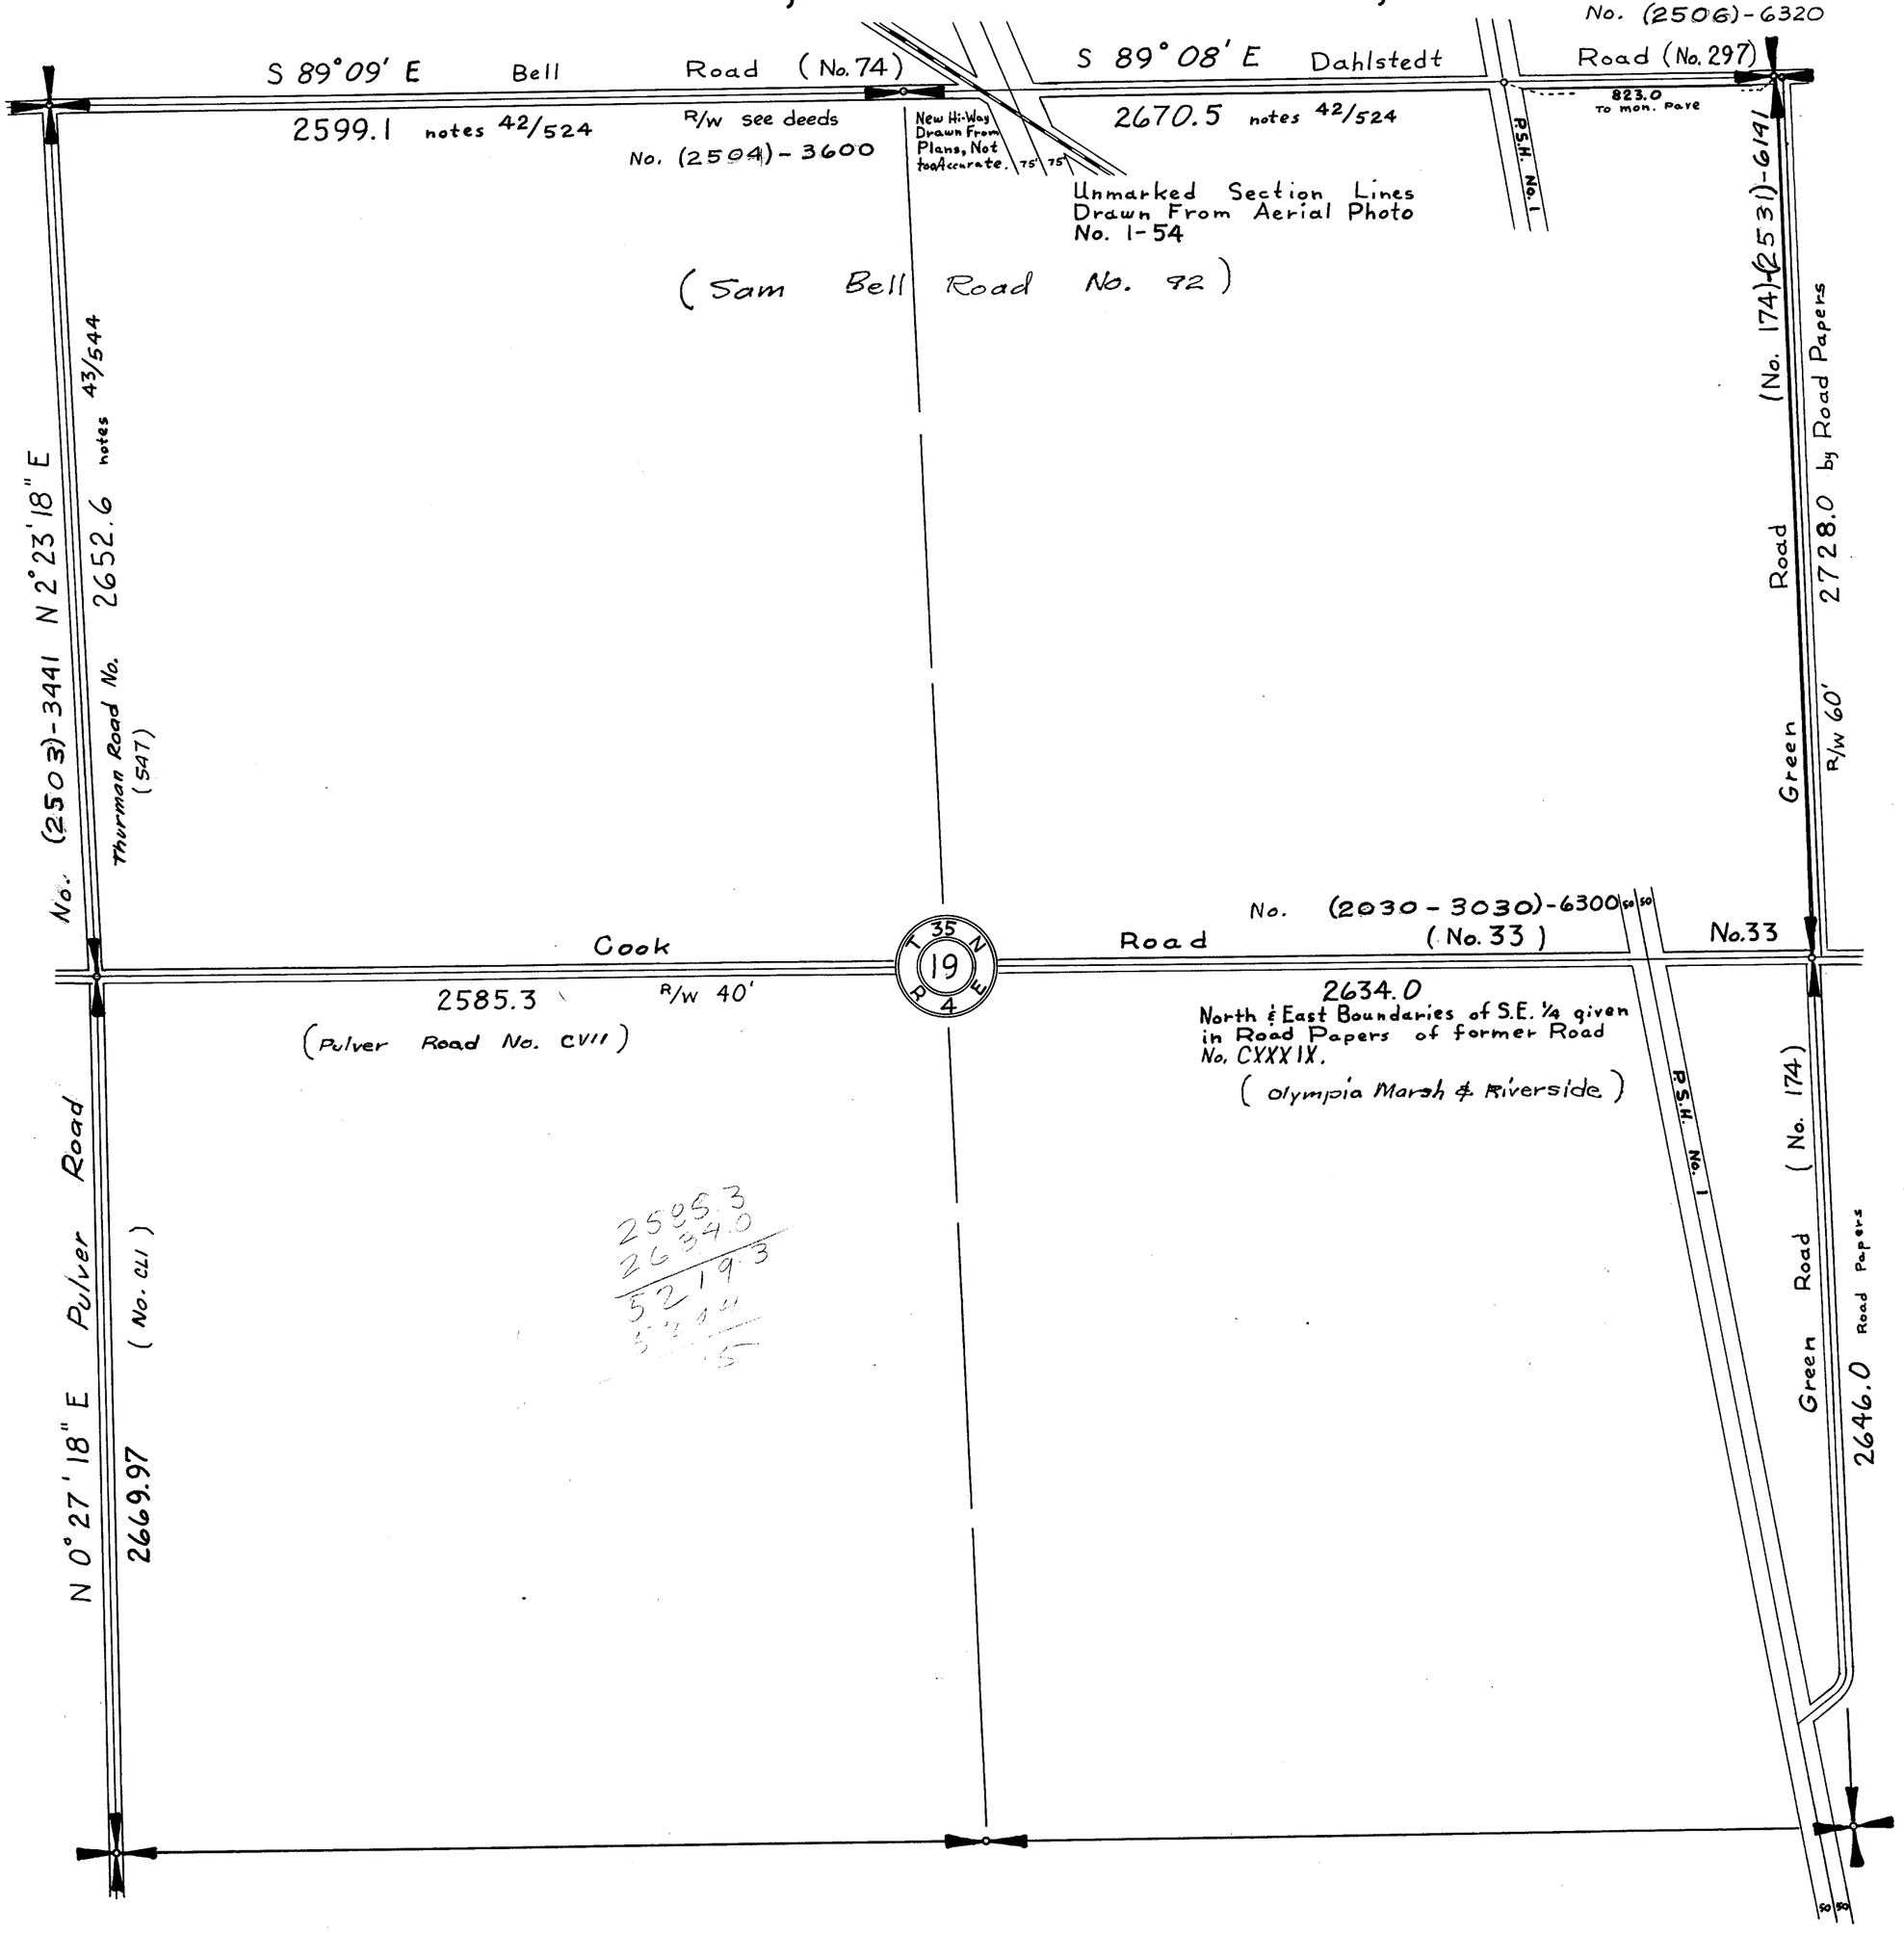

SECTION 20


TOWNSHIP 35 NORTH, RANGE 4 EAST, W. M.

SKAGIT COUNTY, WASH.

SCALE, 1 INCH--400 FEET

DATE July, 1959

Frank Gilkey COUNTY ENGINEER

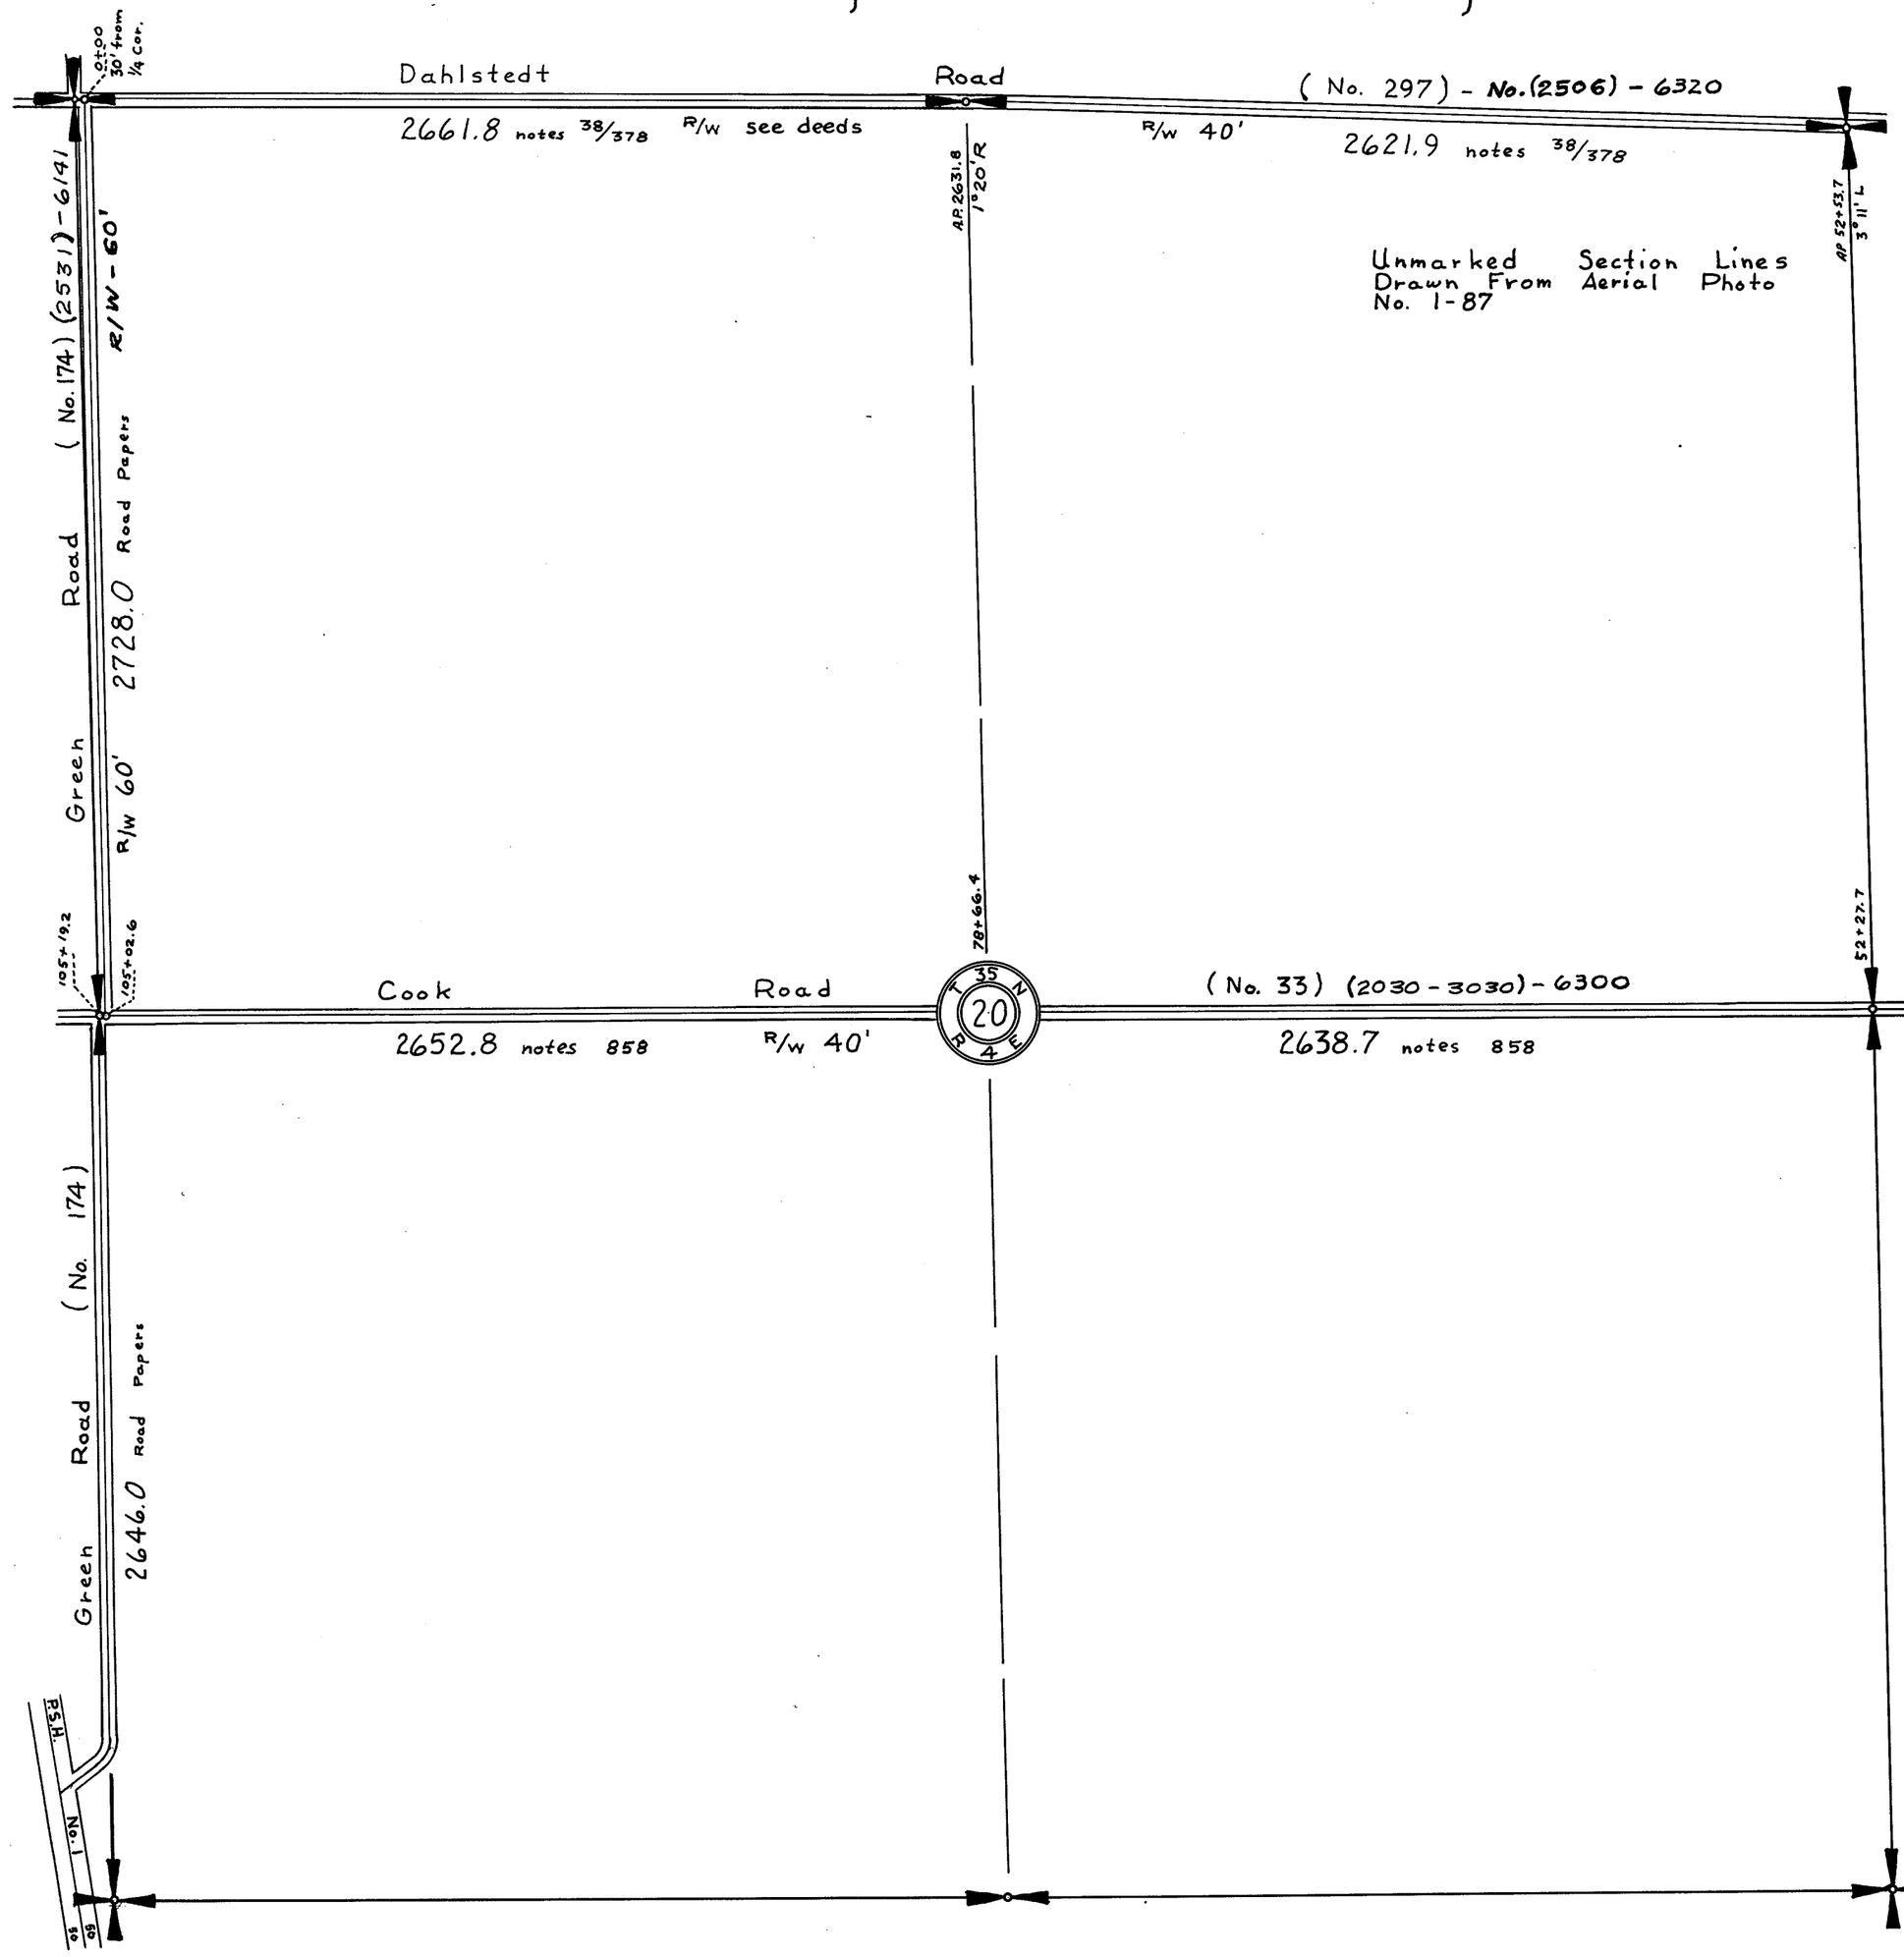


SECTION 20

TOWNSHIP 35 NORTH, RANGE 4E EAST, W. M.
SKAGIT COUNTY, WASH.

SCALE, 1 INCH=400 FEET

_____ COUNTY ENGINEER

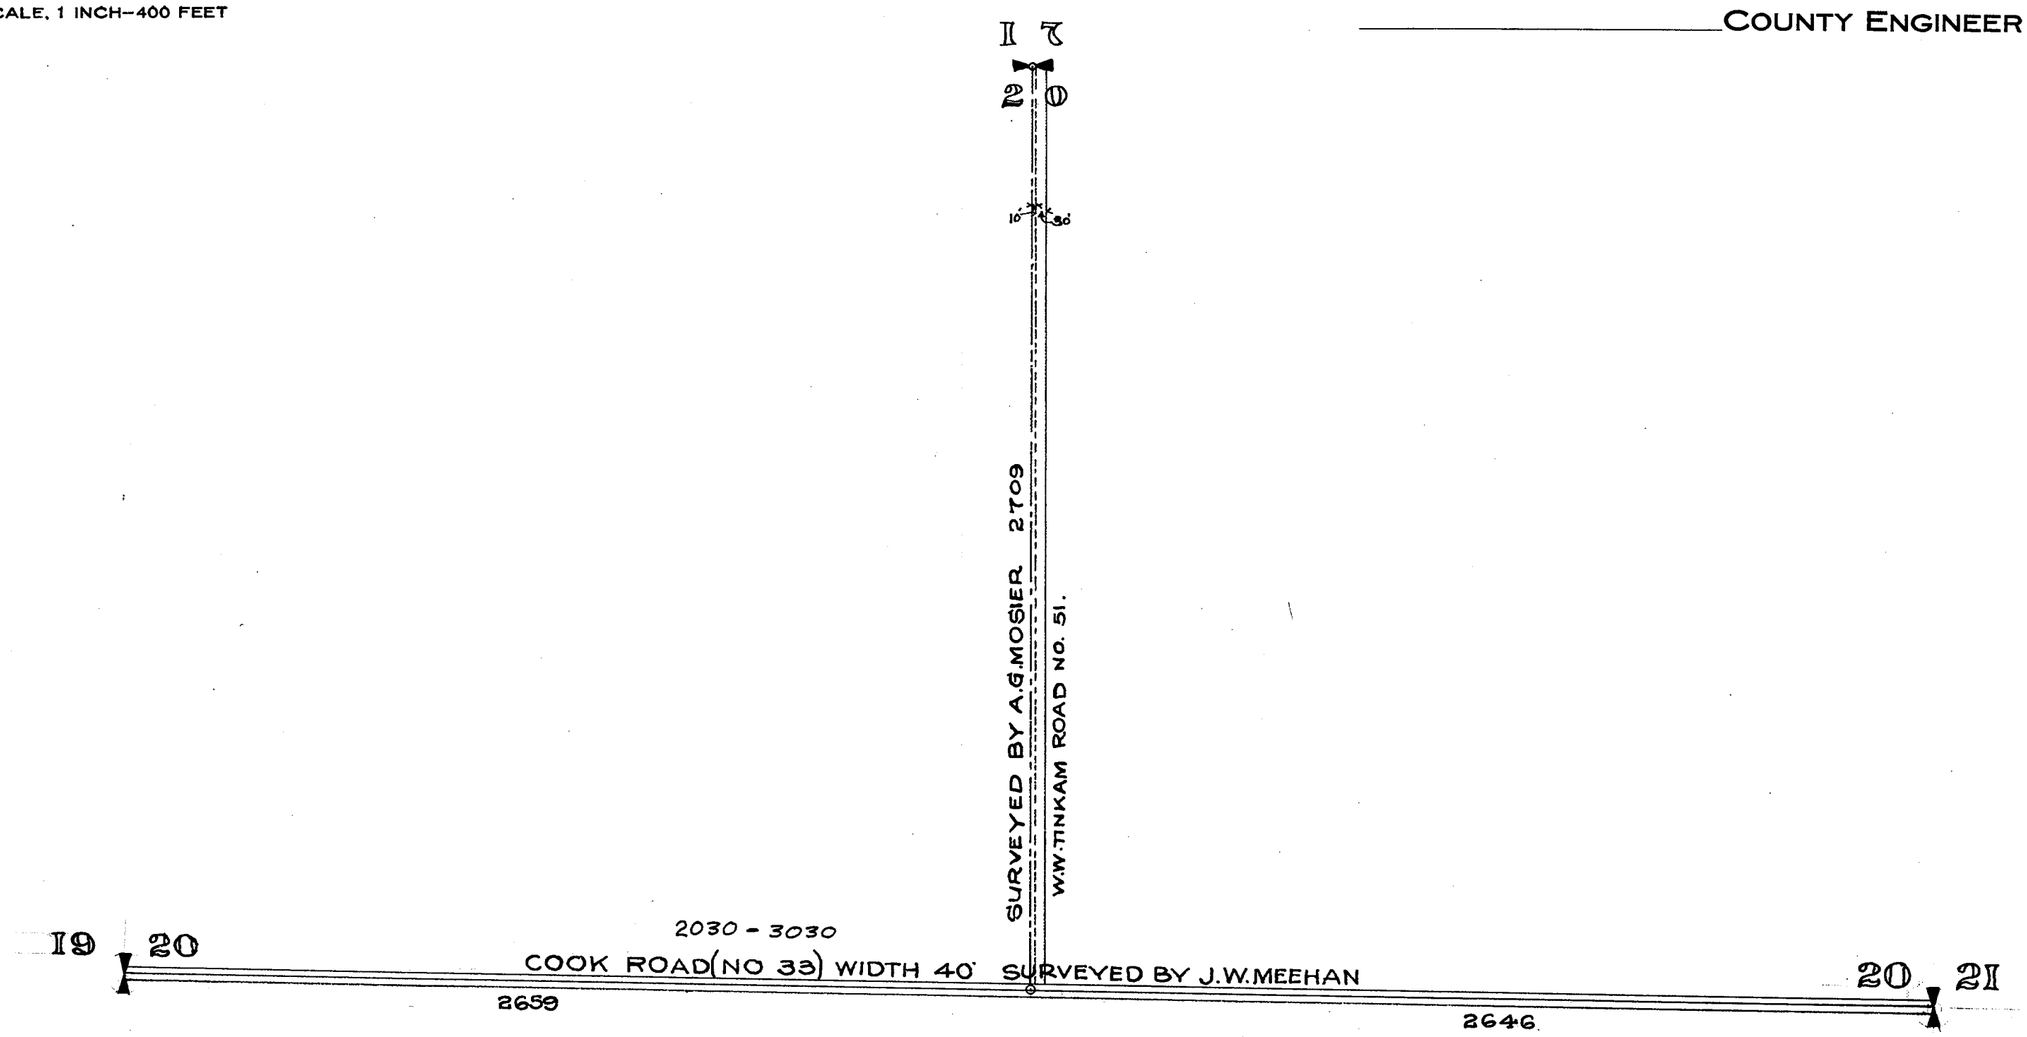


SECTION 21

TOWNSHIP 35 NORTH, RANGE 4 EAST, W. M.

SKAGIT COUNTY, WASH.

SCALE, 1 INCH--400 FEET

DATE July, 1959 Frank Gilkey COUNTY ENGINEER

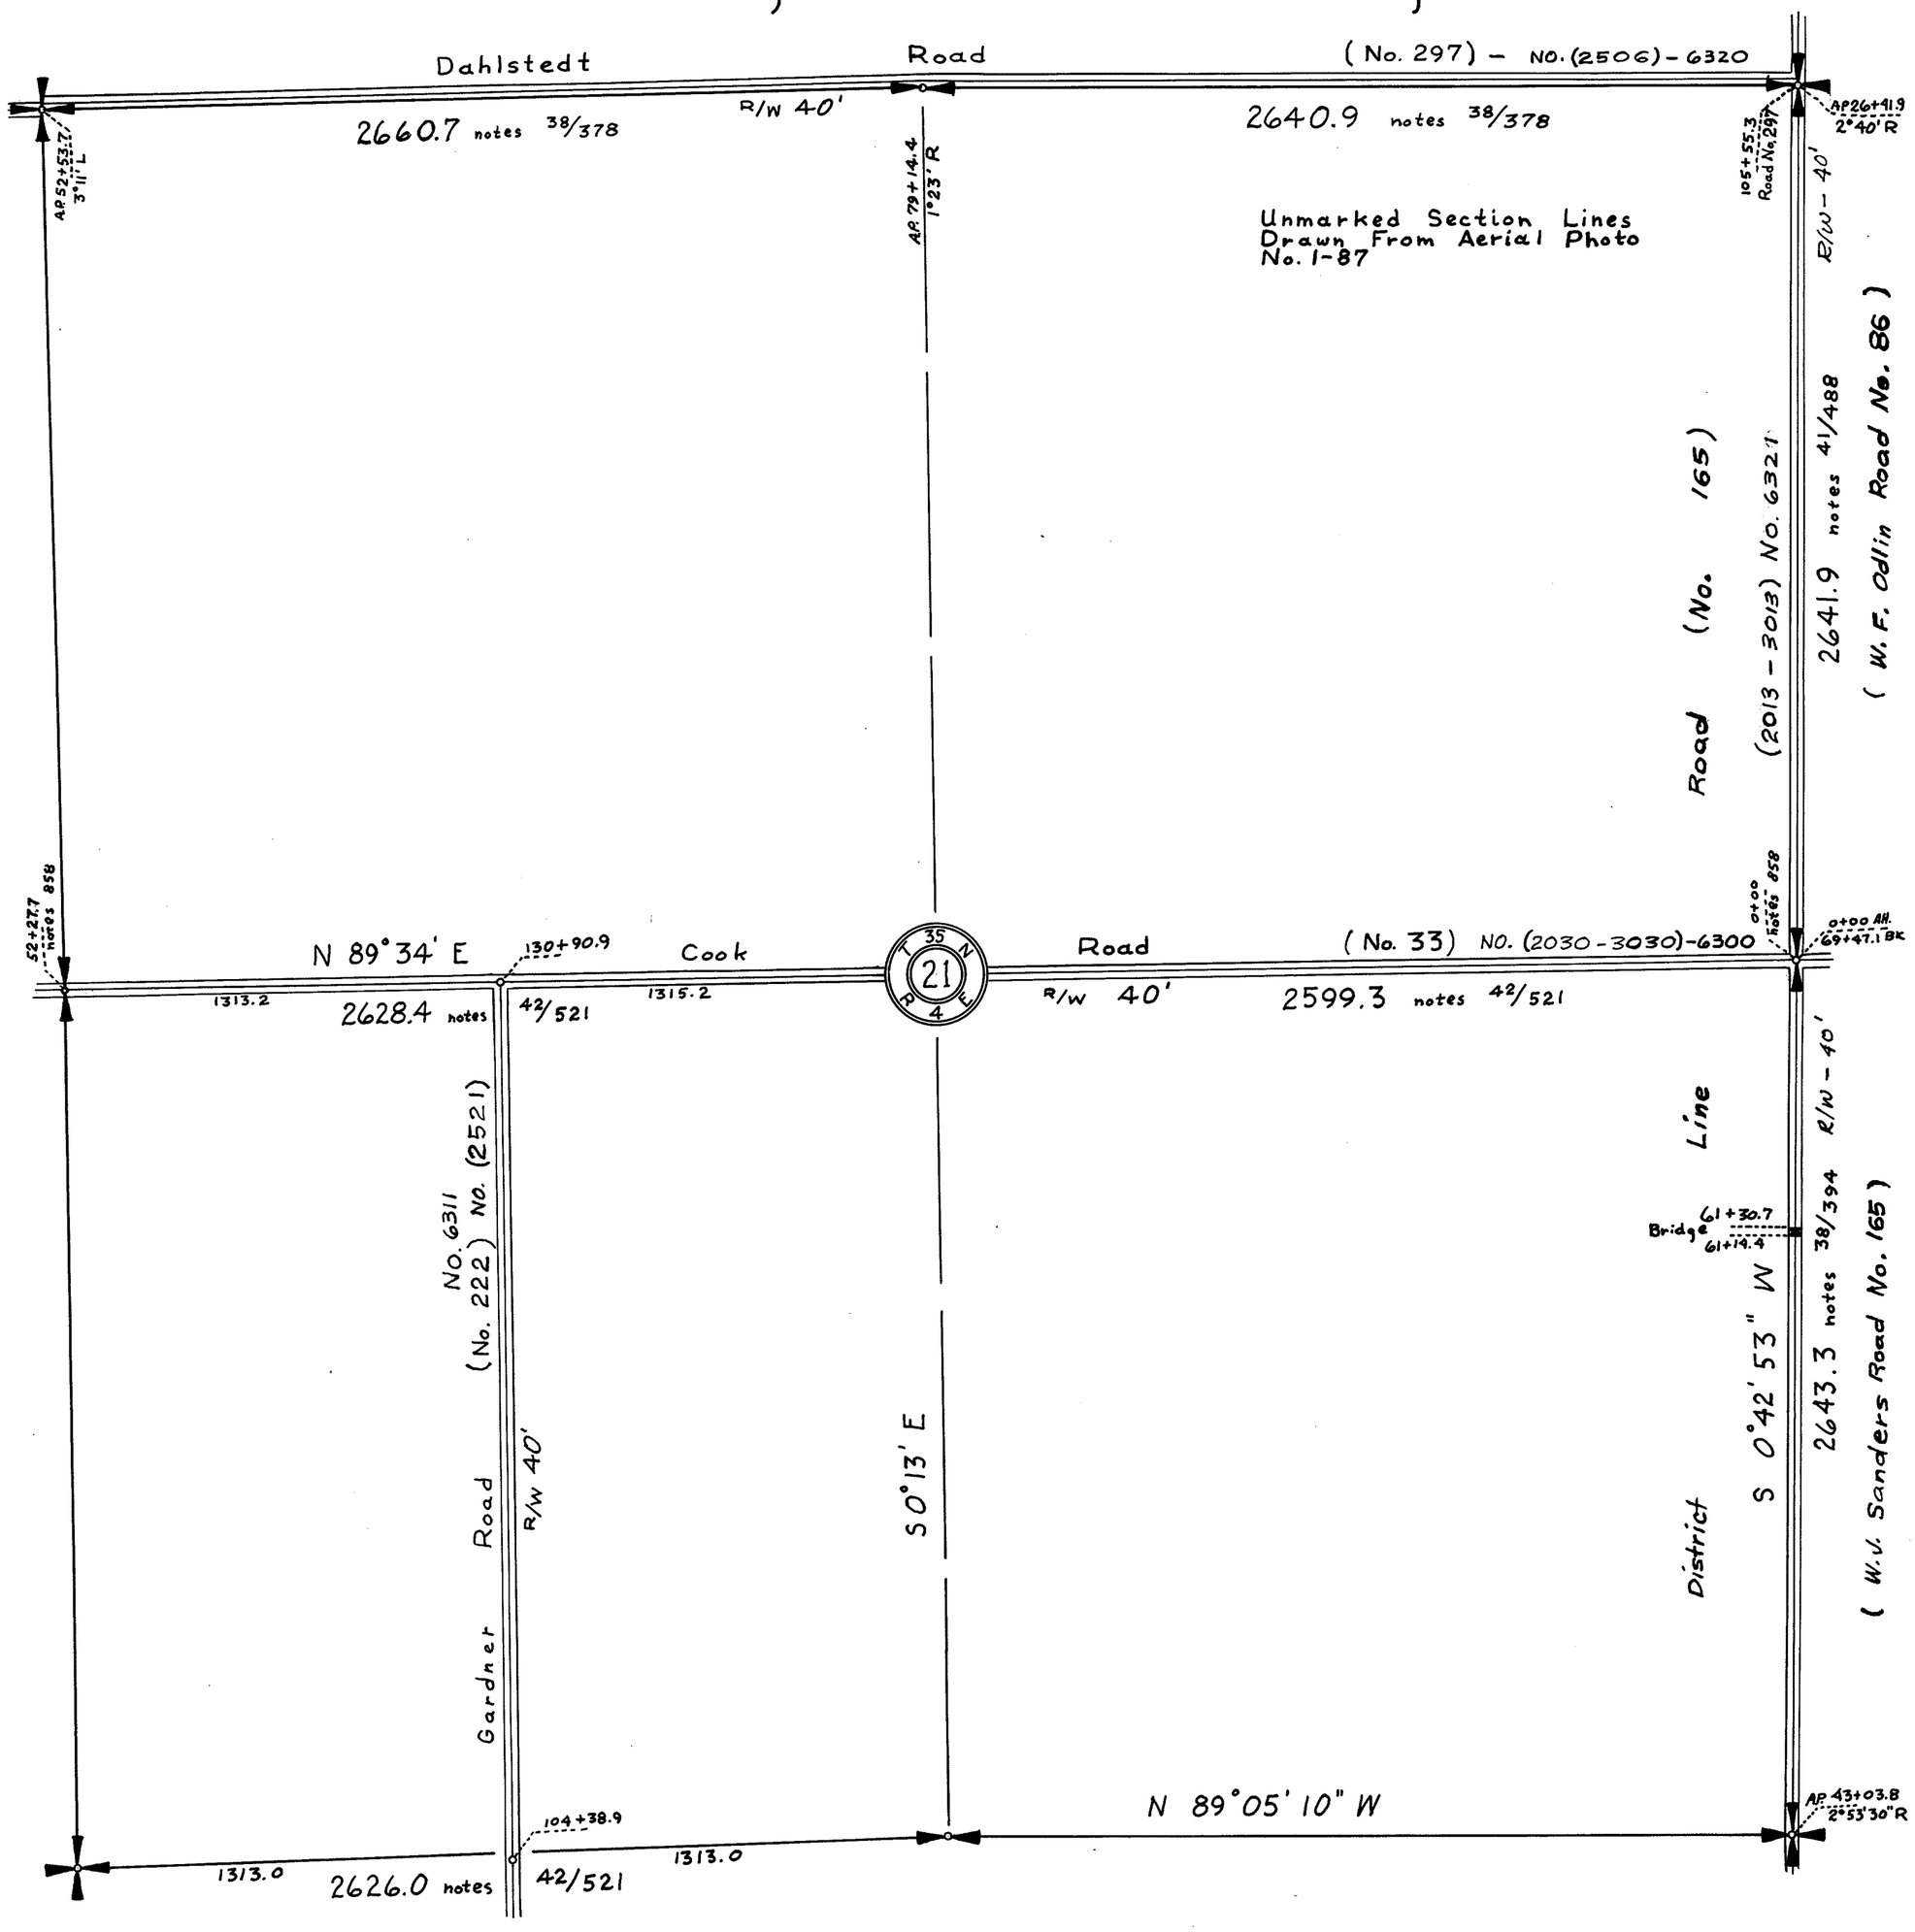


SECTION 21

TOWNSHIP 35 NORTH, RANGE 4 EAST, W. M.

SKAGIT COUNTY, WASH.

SCALE, 1 INCH–400 FEET

_____ COUNTY ENGINEER

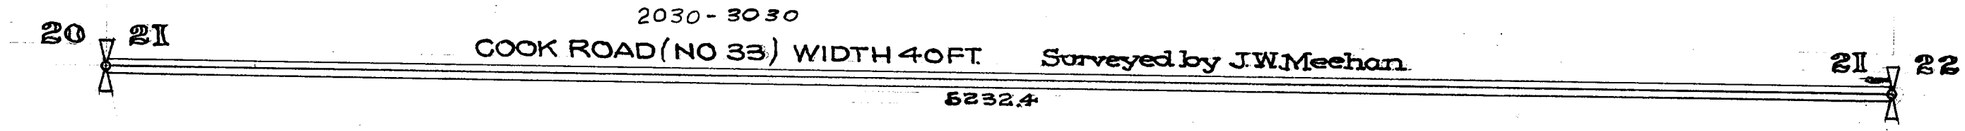

SECTION 22


TOWNSHIP 35 NORTH, RANGE 4 EAST, W. M.

SKAGIT COUNTY, WASH.

SCALE, 1 INCH--400 FEET

DATE July, 1959

Frank Gilkey COUNTY ENGINEER

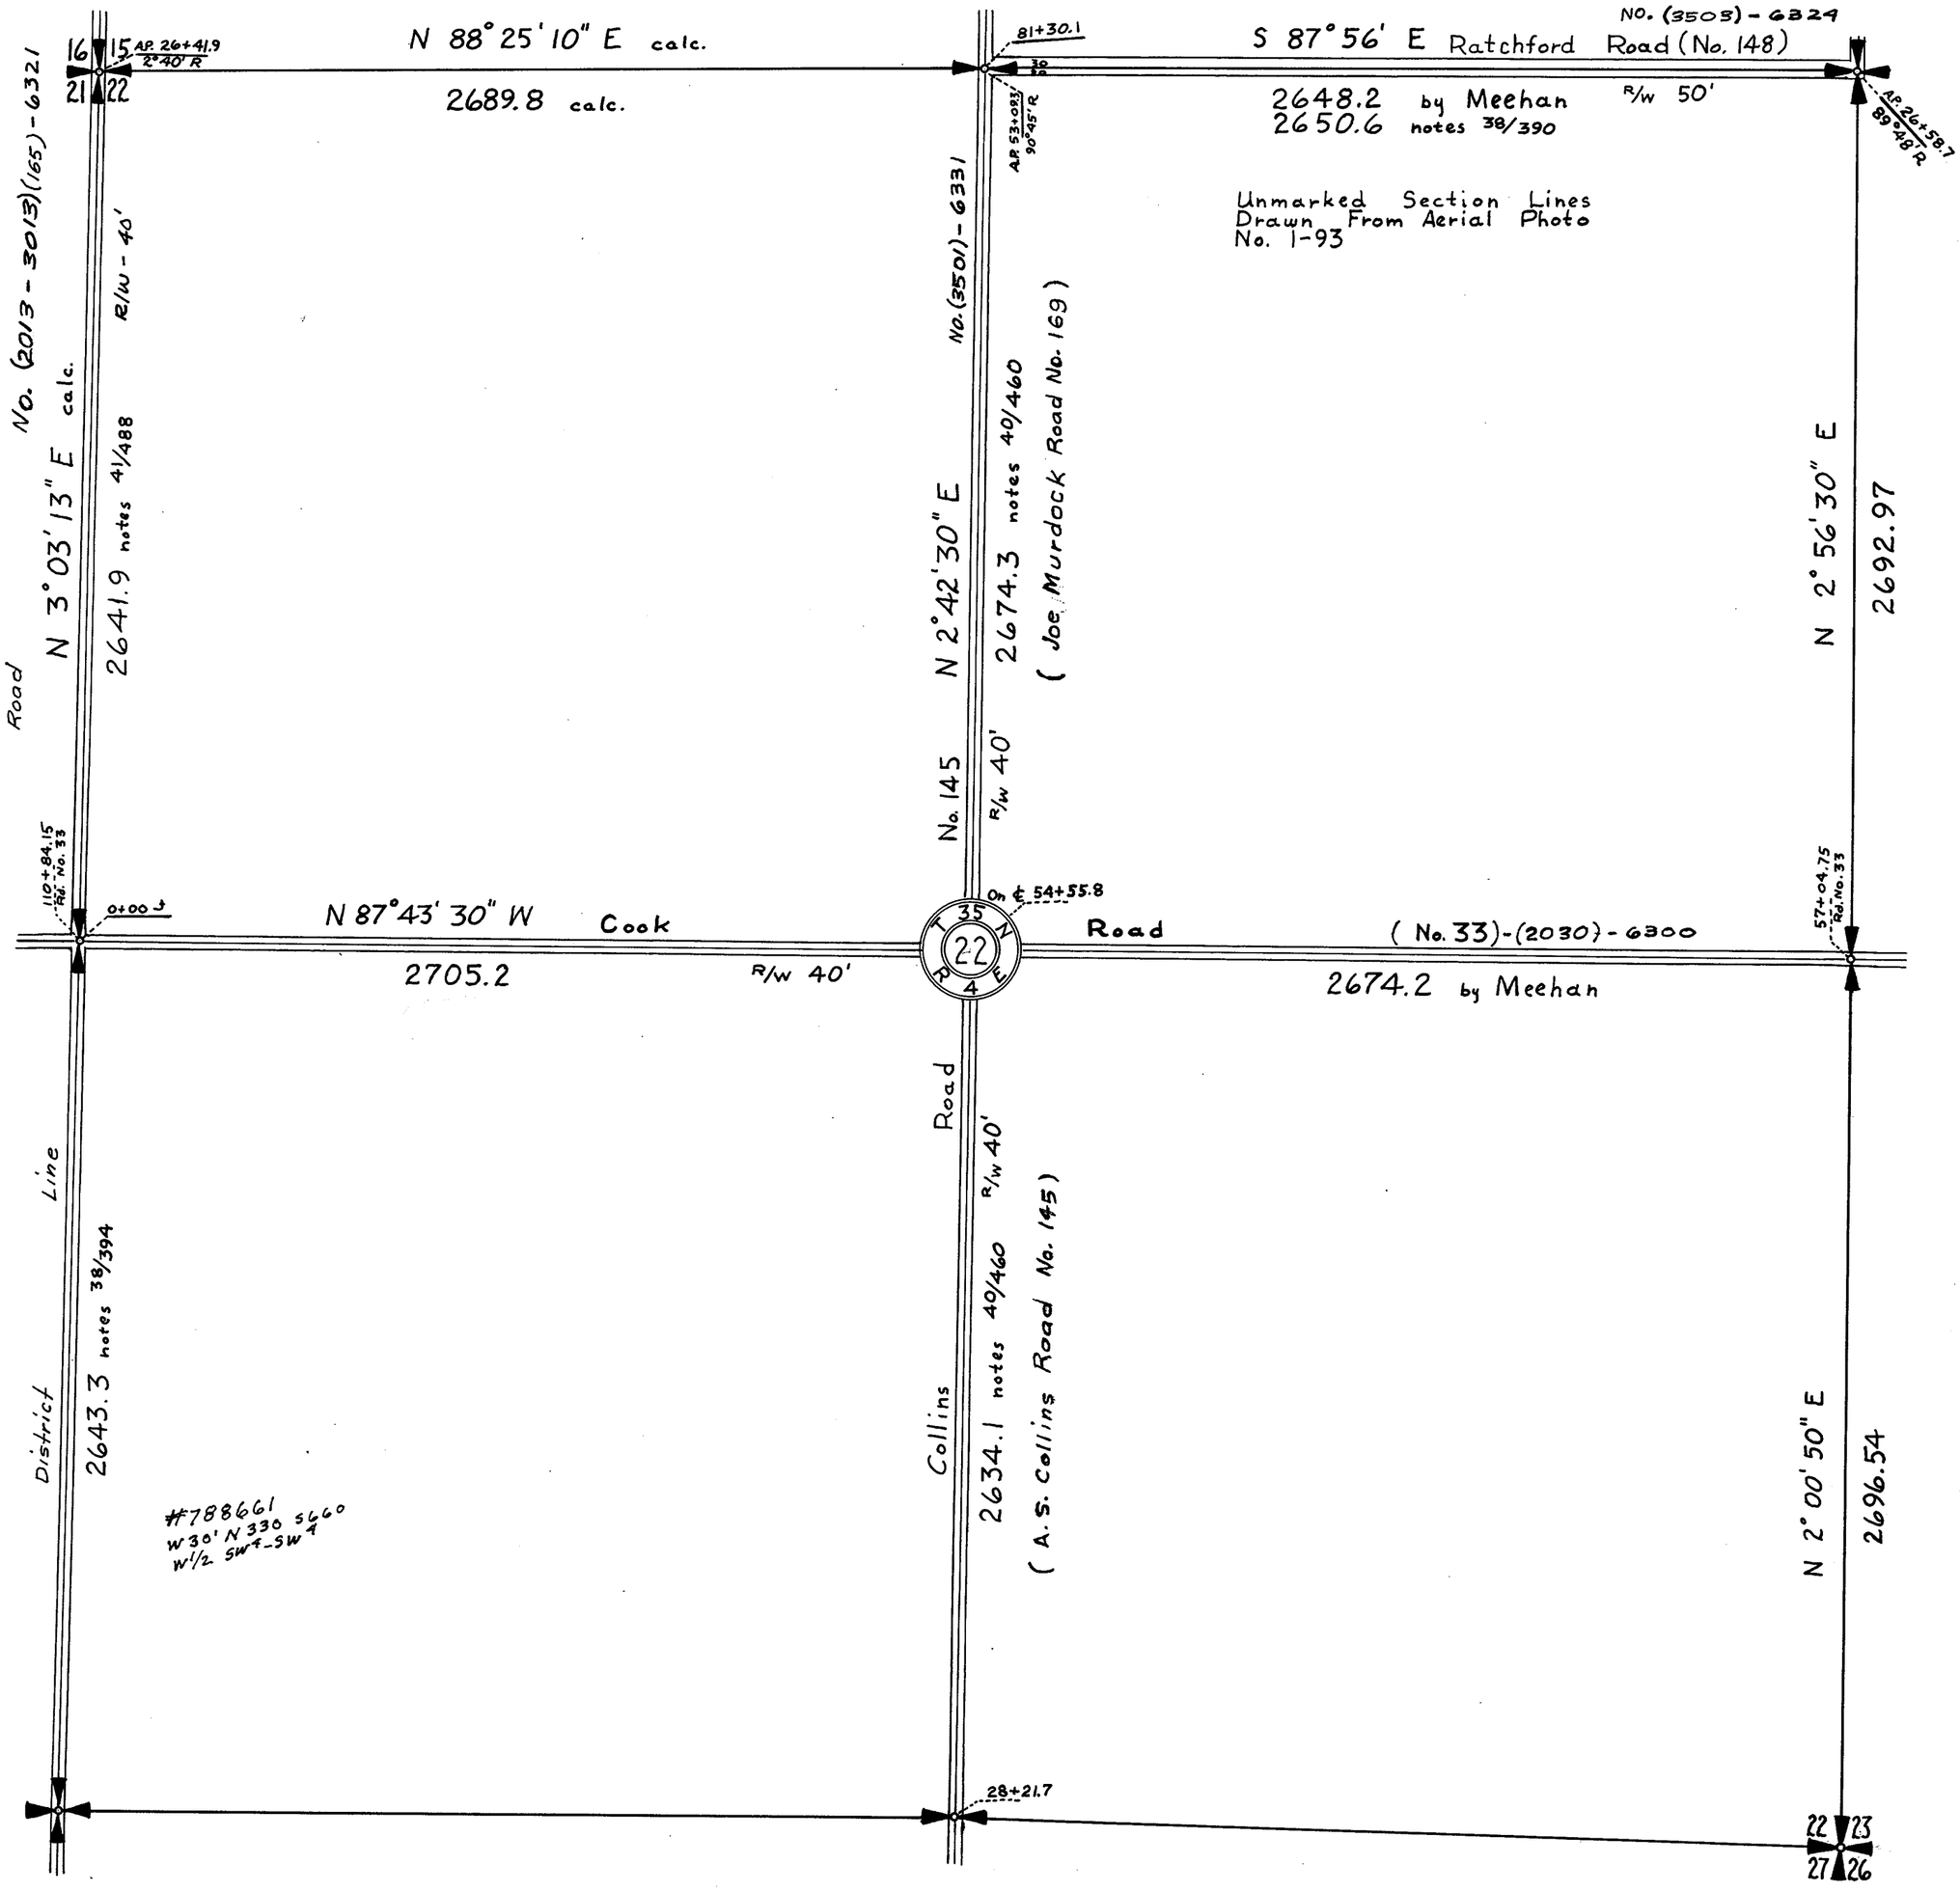


SECTION 22

TOWNSHIP 35 NORTH, RANGE 4 EAST, W. M.
SKAGIT COUNTY, WASH.

SCALE, 1 INCH–400 FEET

_____ COUNTY ENGINEER

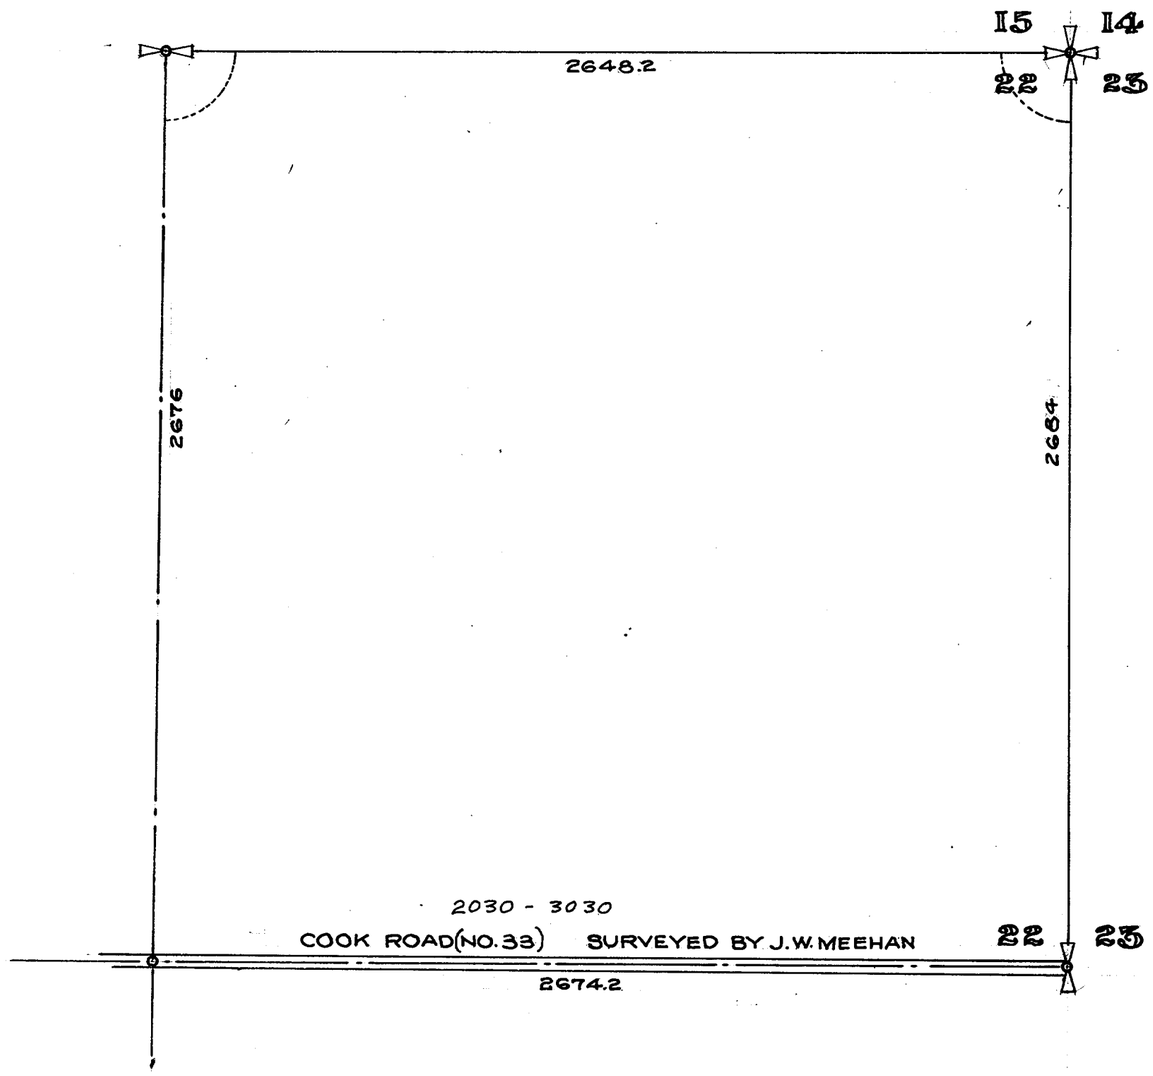


SECTION 23

TOWNSHIP 35 NORTH, RANGE 4 EAST, W. M.
SKAGIT COUNTY, WASH.

SCALE, 1 INCH–400 FEET

_____ COUNTY ENGINEER

Notes # 199

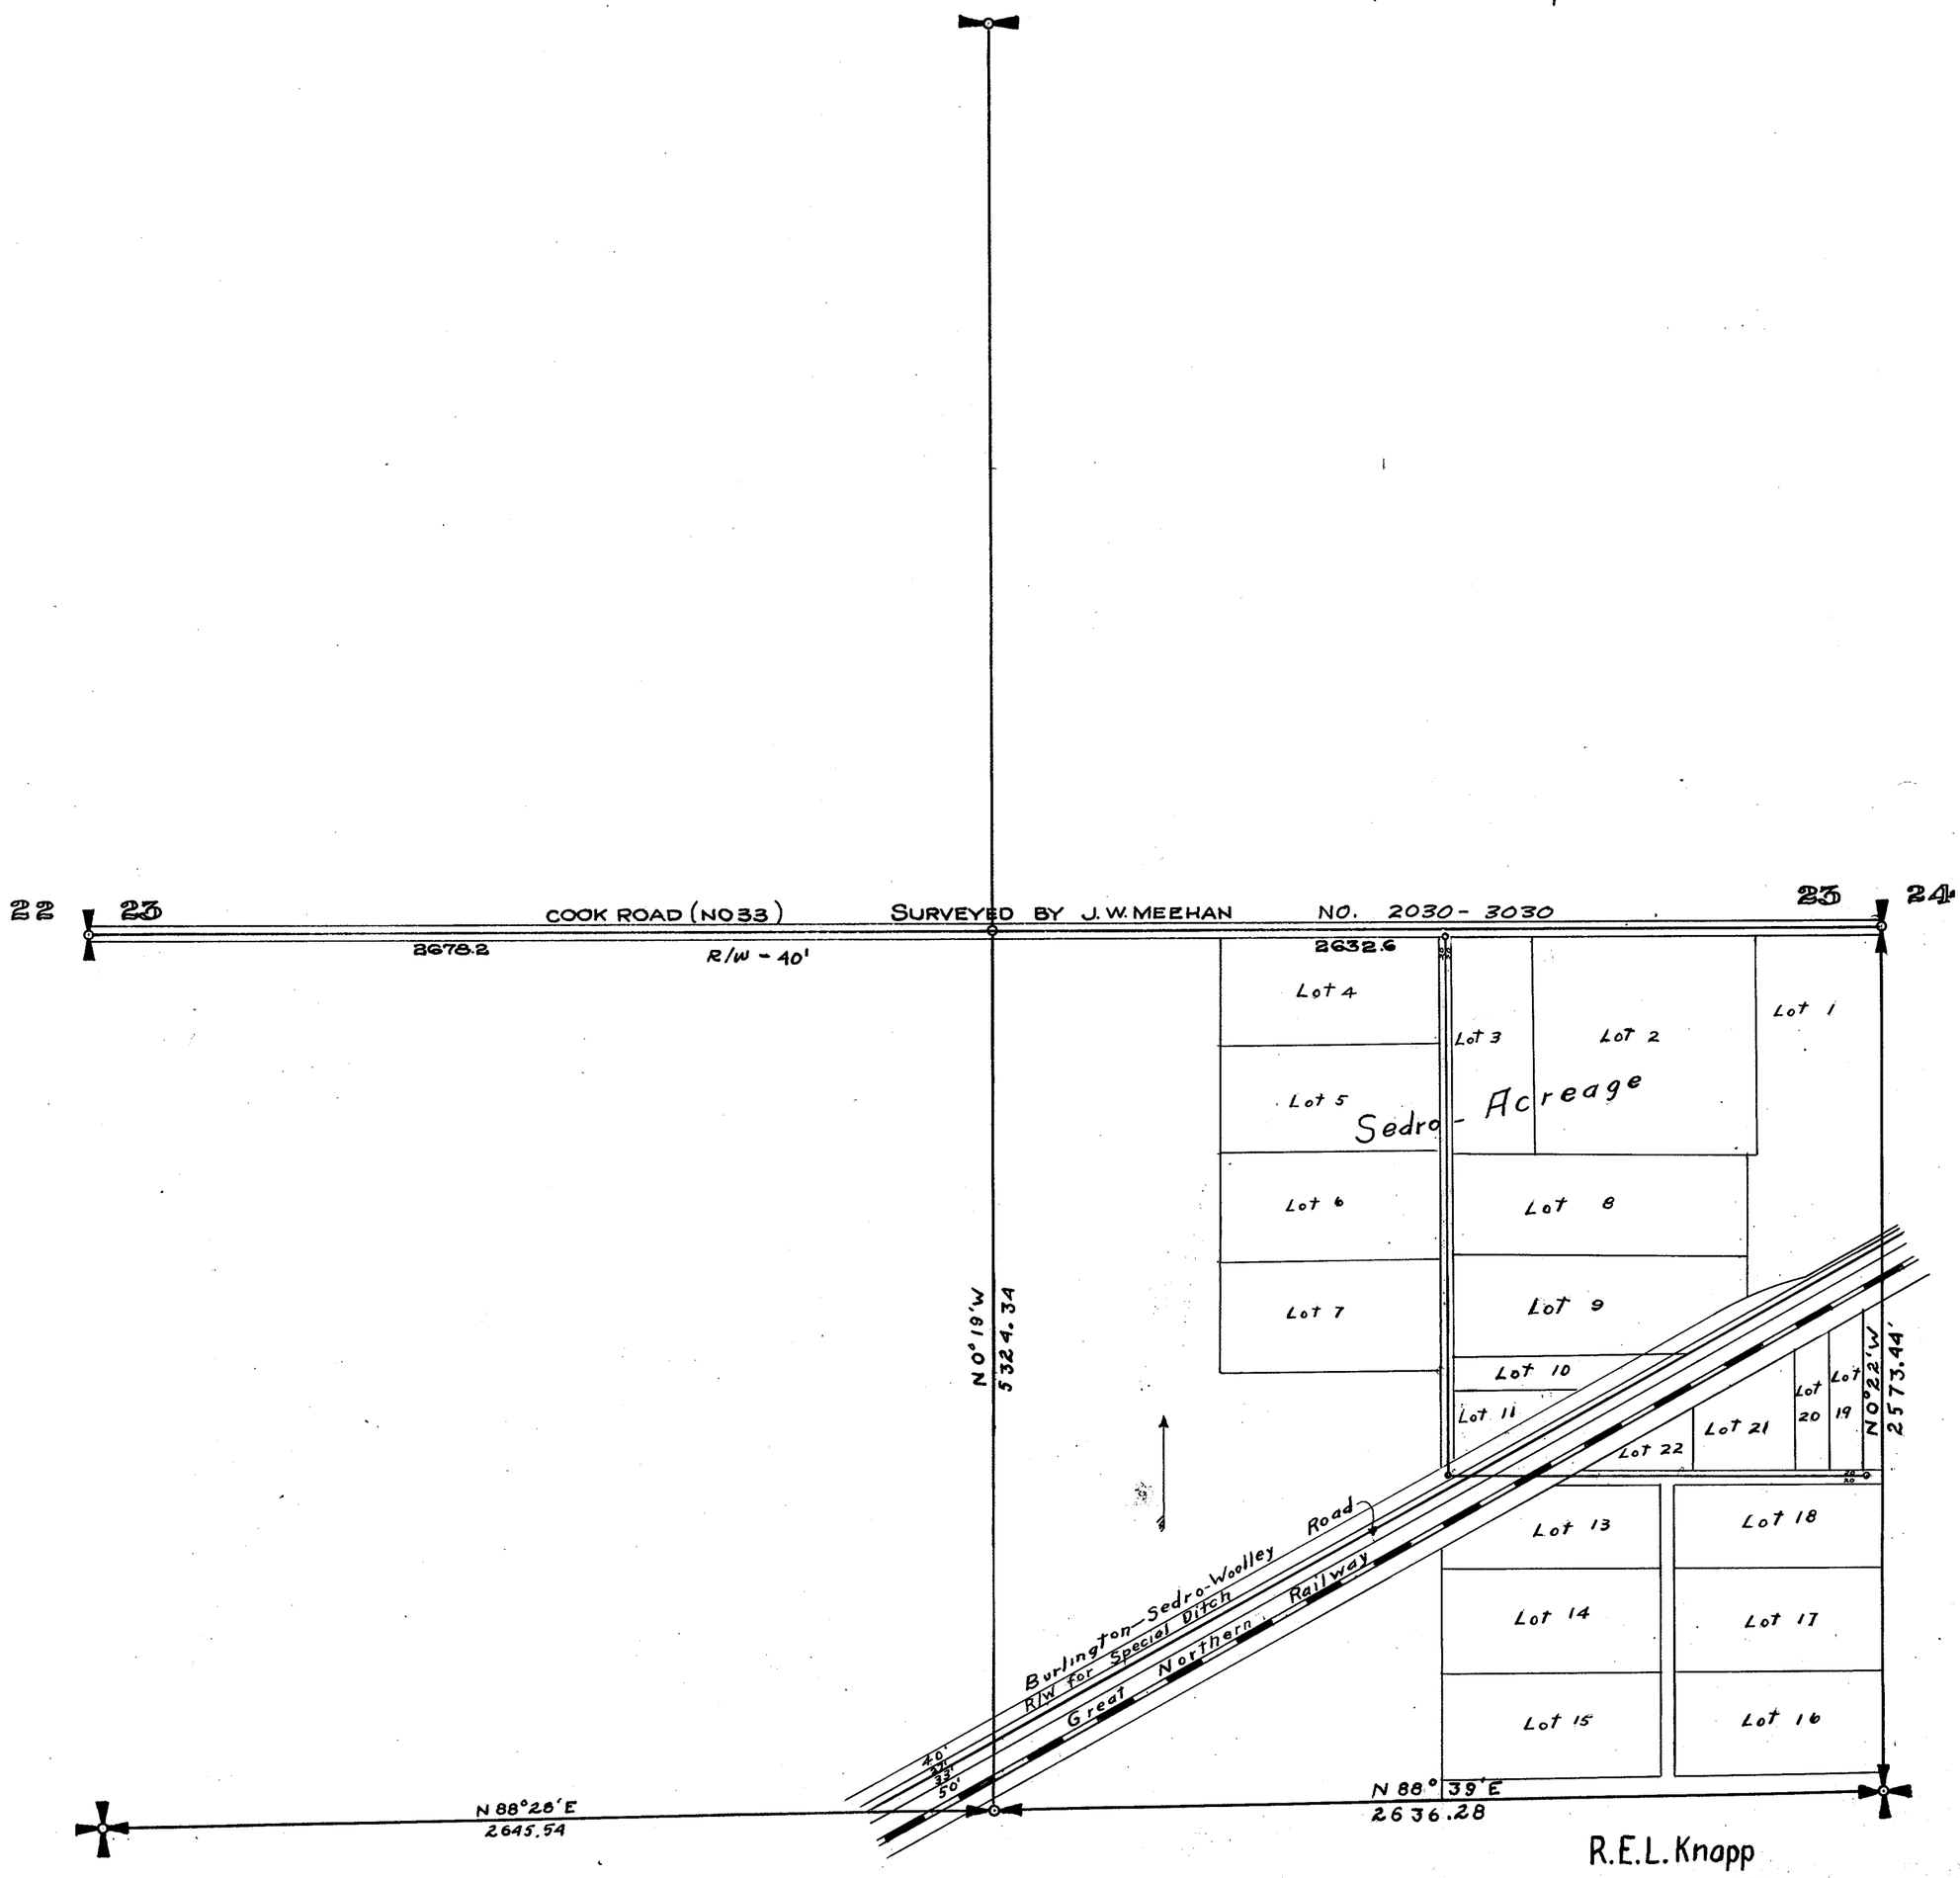

R.E.L. Knapp
Survey 1931


SECTION 23

TOWNSHIP 35 NORTH, RANGE 4 EAST, W. M.

SKAGIT COUNTY, WASH.

SCALE, 1 INCH--400 FEET

DATE July, 1959 — Frank Gilkey COUNTY ENGINEER

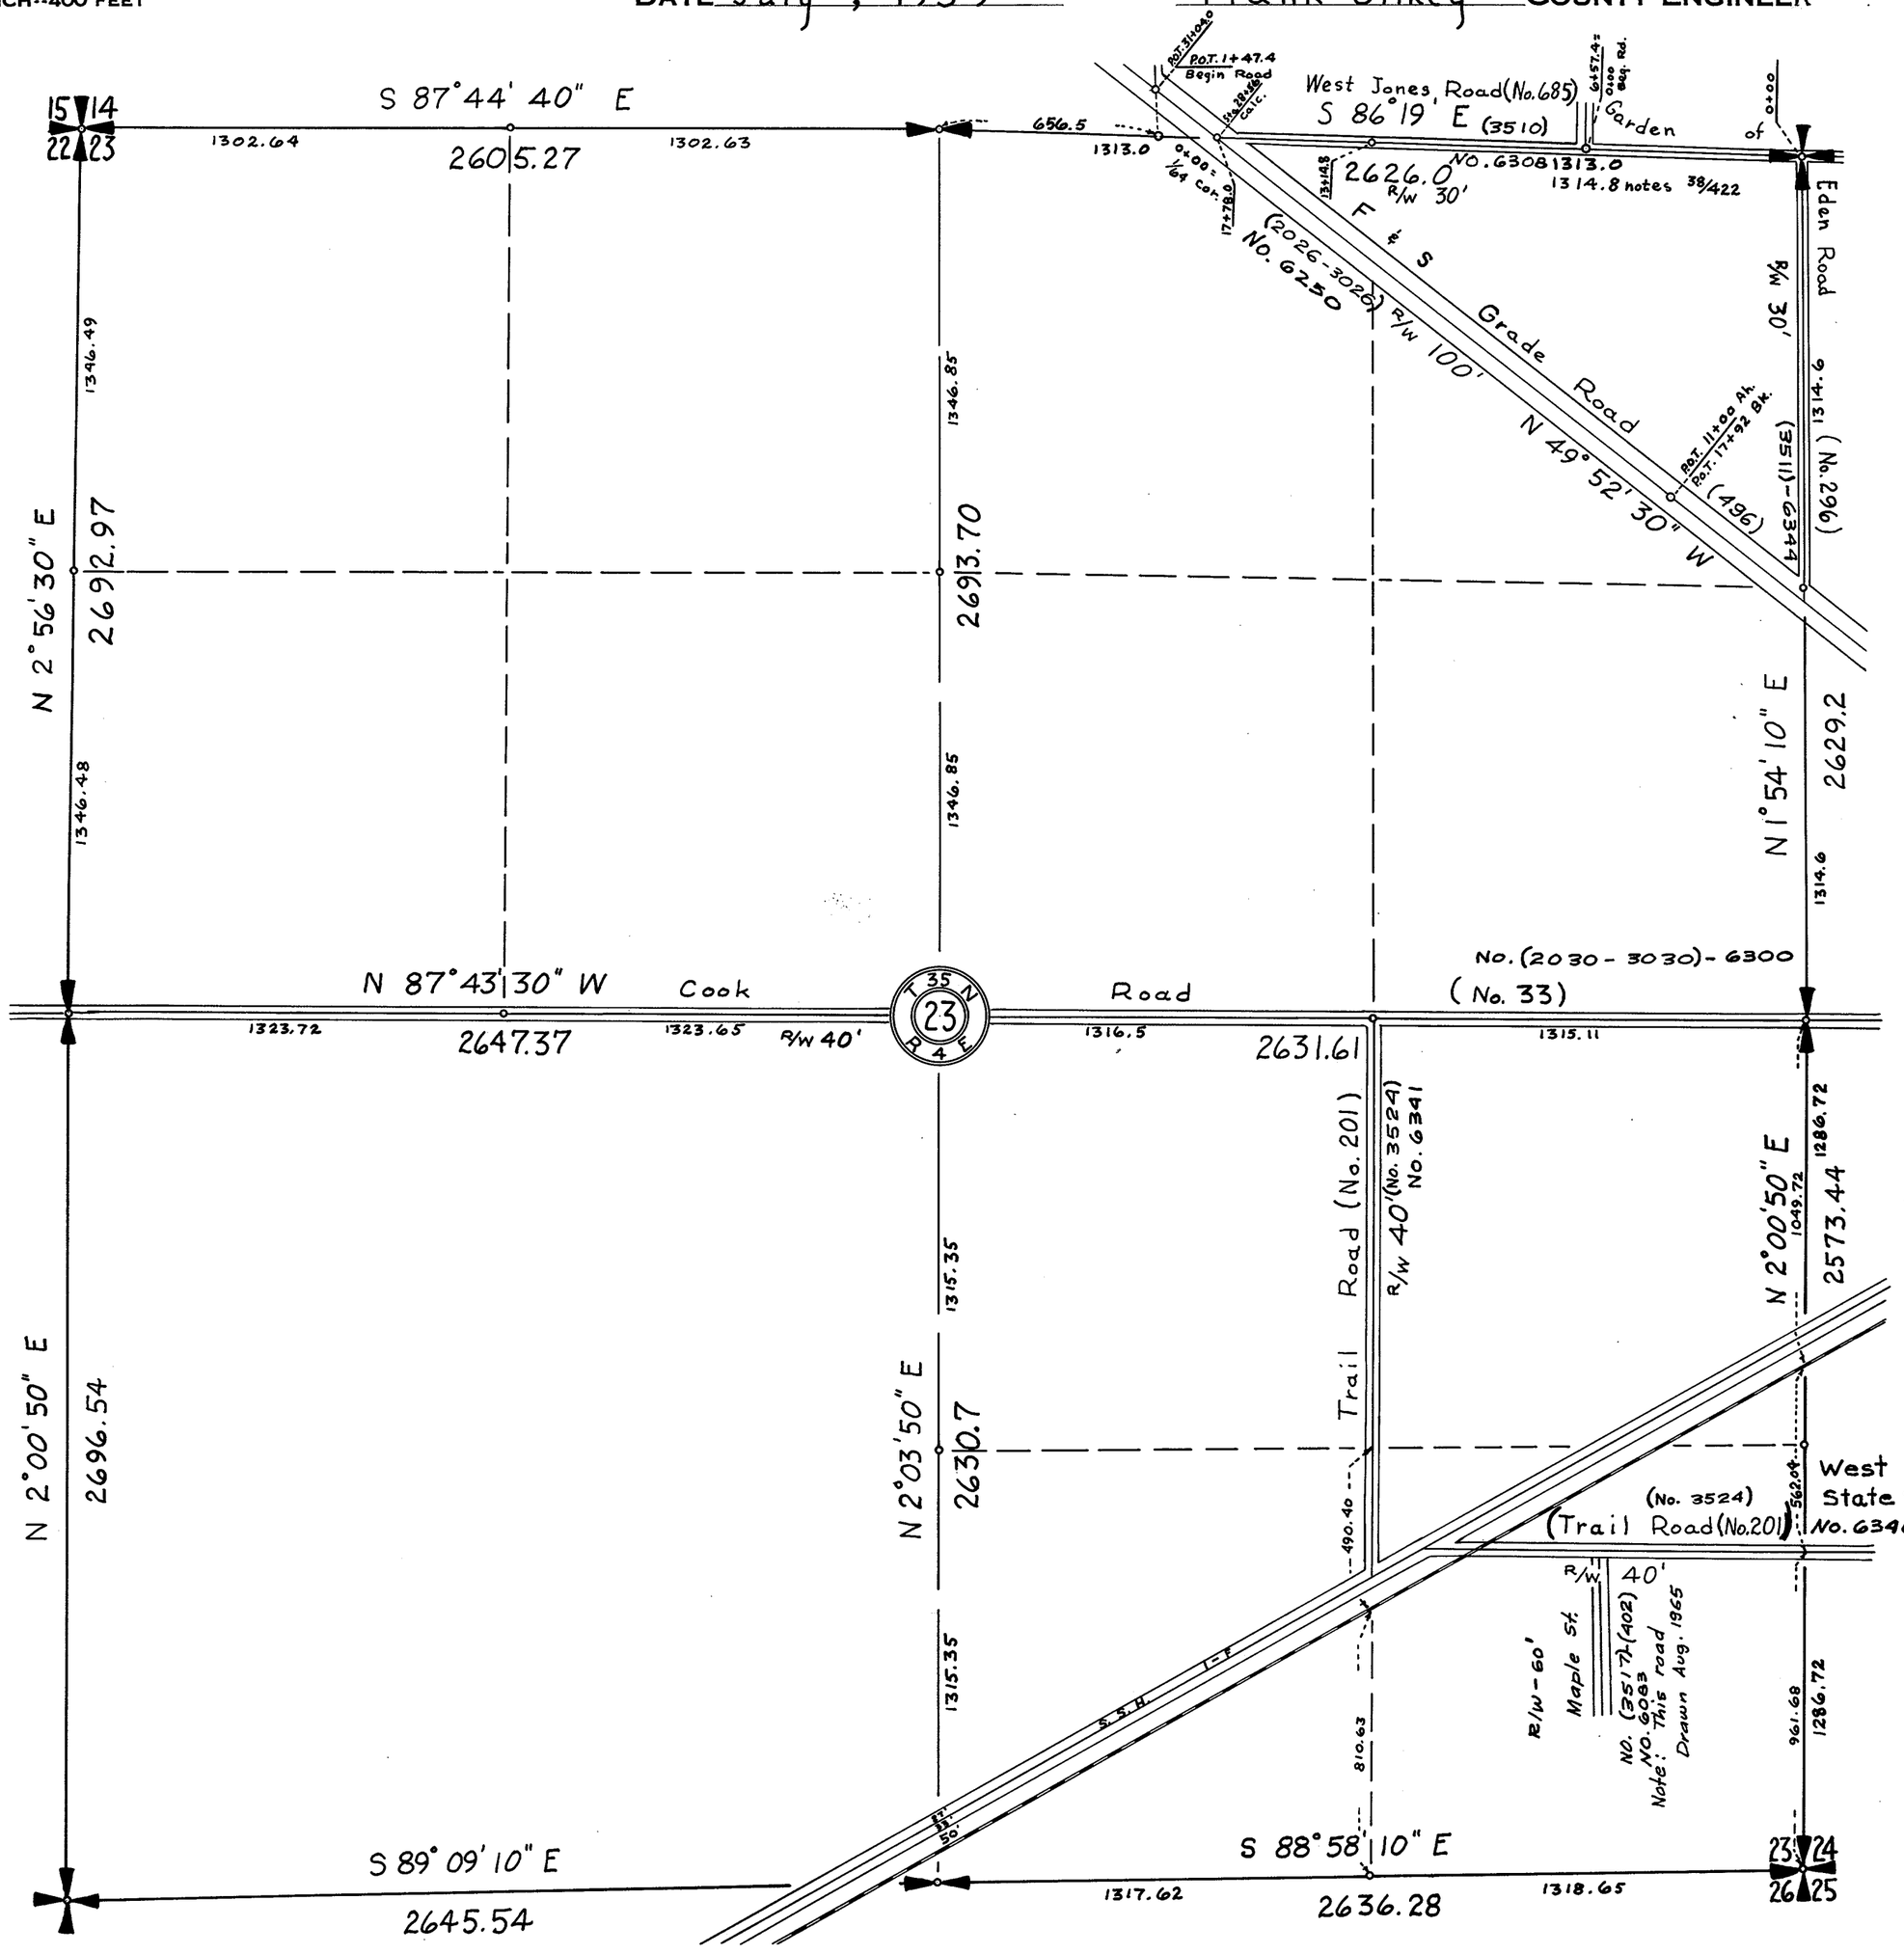


SECTION 24

TOWNSHIP 35 NORTH, RANGE 4 EAST, W. M.

SKAGIT COUNTY, WASH.

DATE July, 1959 — Frank Gilkey COUNTY ENGINEER

SCALE, 1 INCH--400 FEET

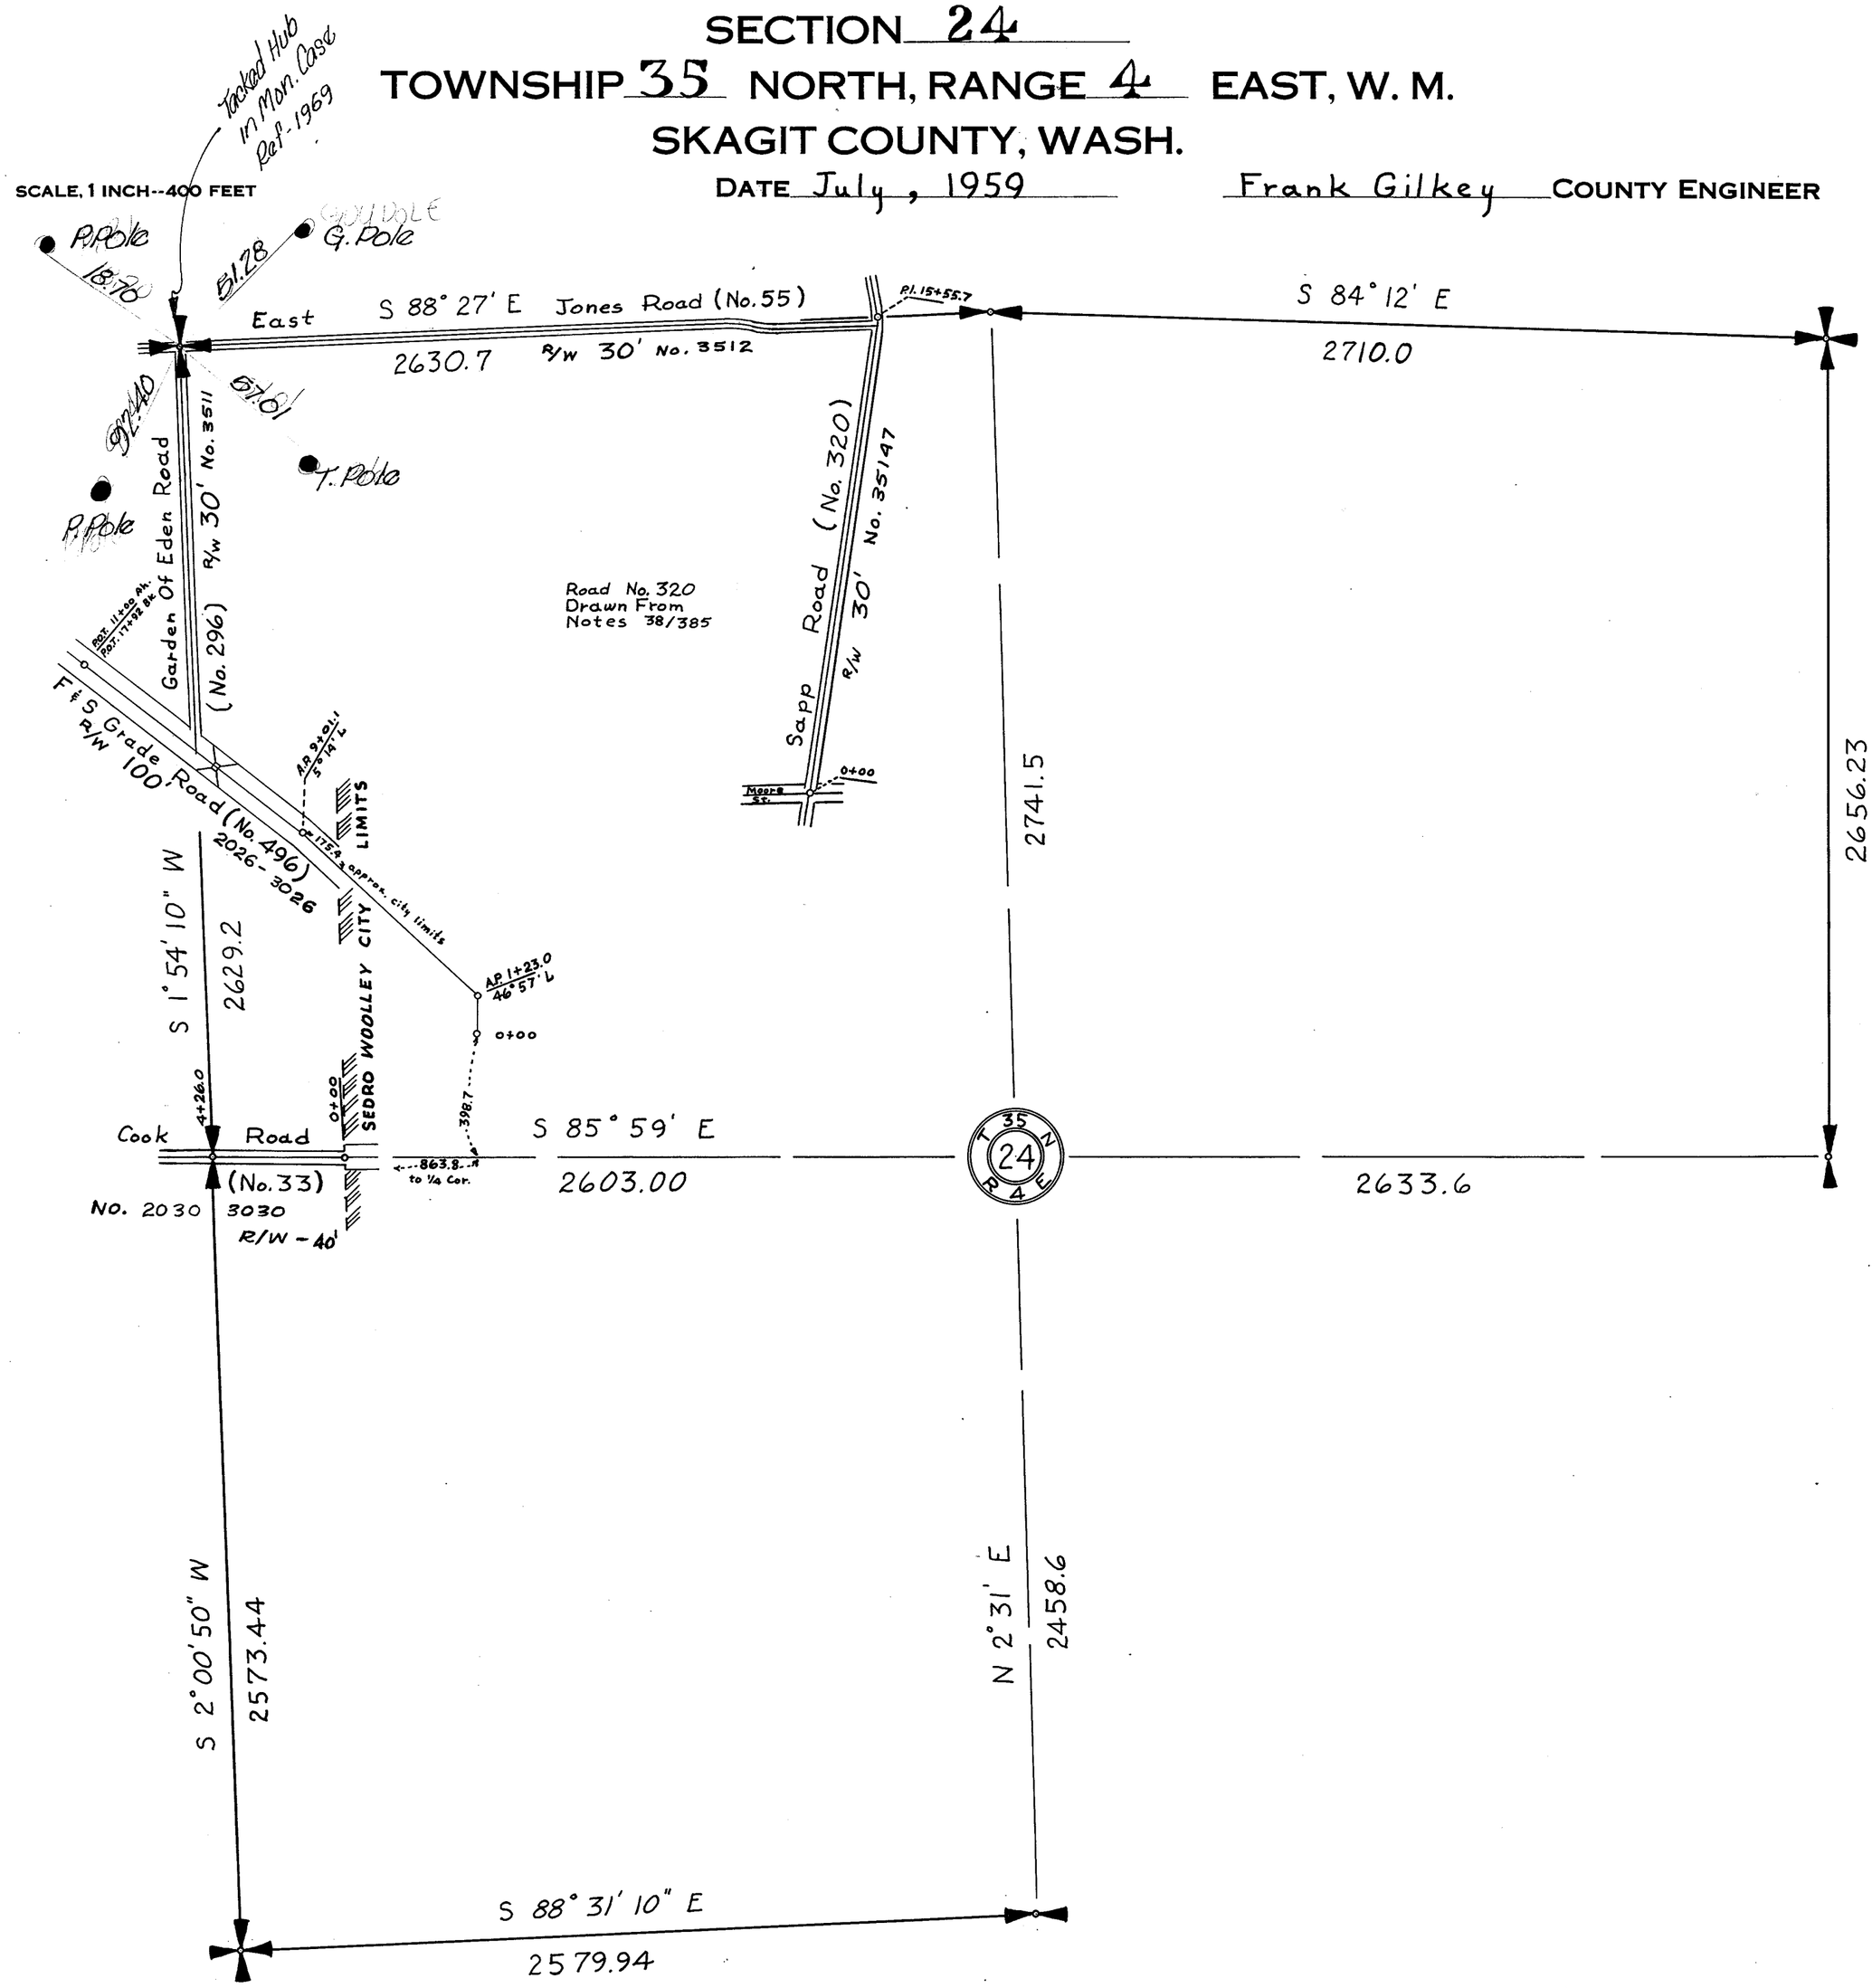

SECTION 24


TOWNSHIP 35 NORTH, RANGE 4 EAST, W. M.

SKAGIT COUNTY, WASH.

SCALE, 1 INCH--400 FEET

DATE Aug. 1964

COUNTY ENGINEER

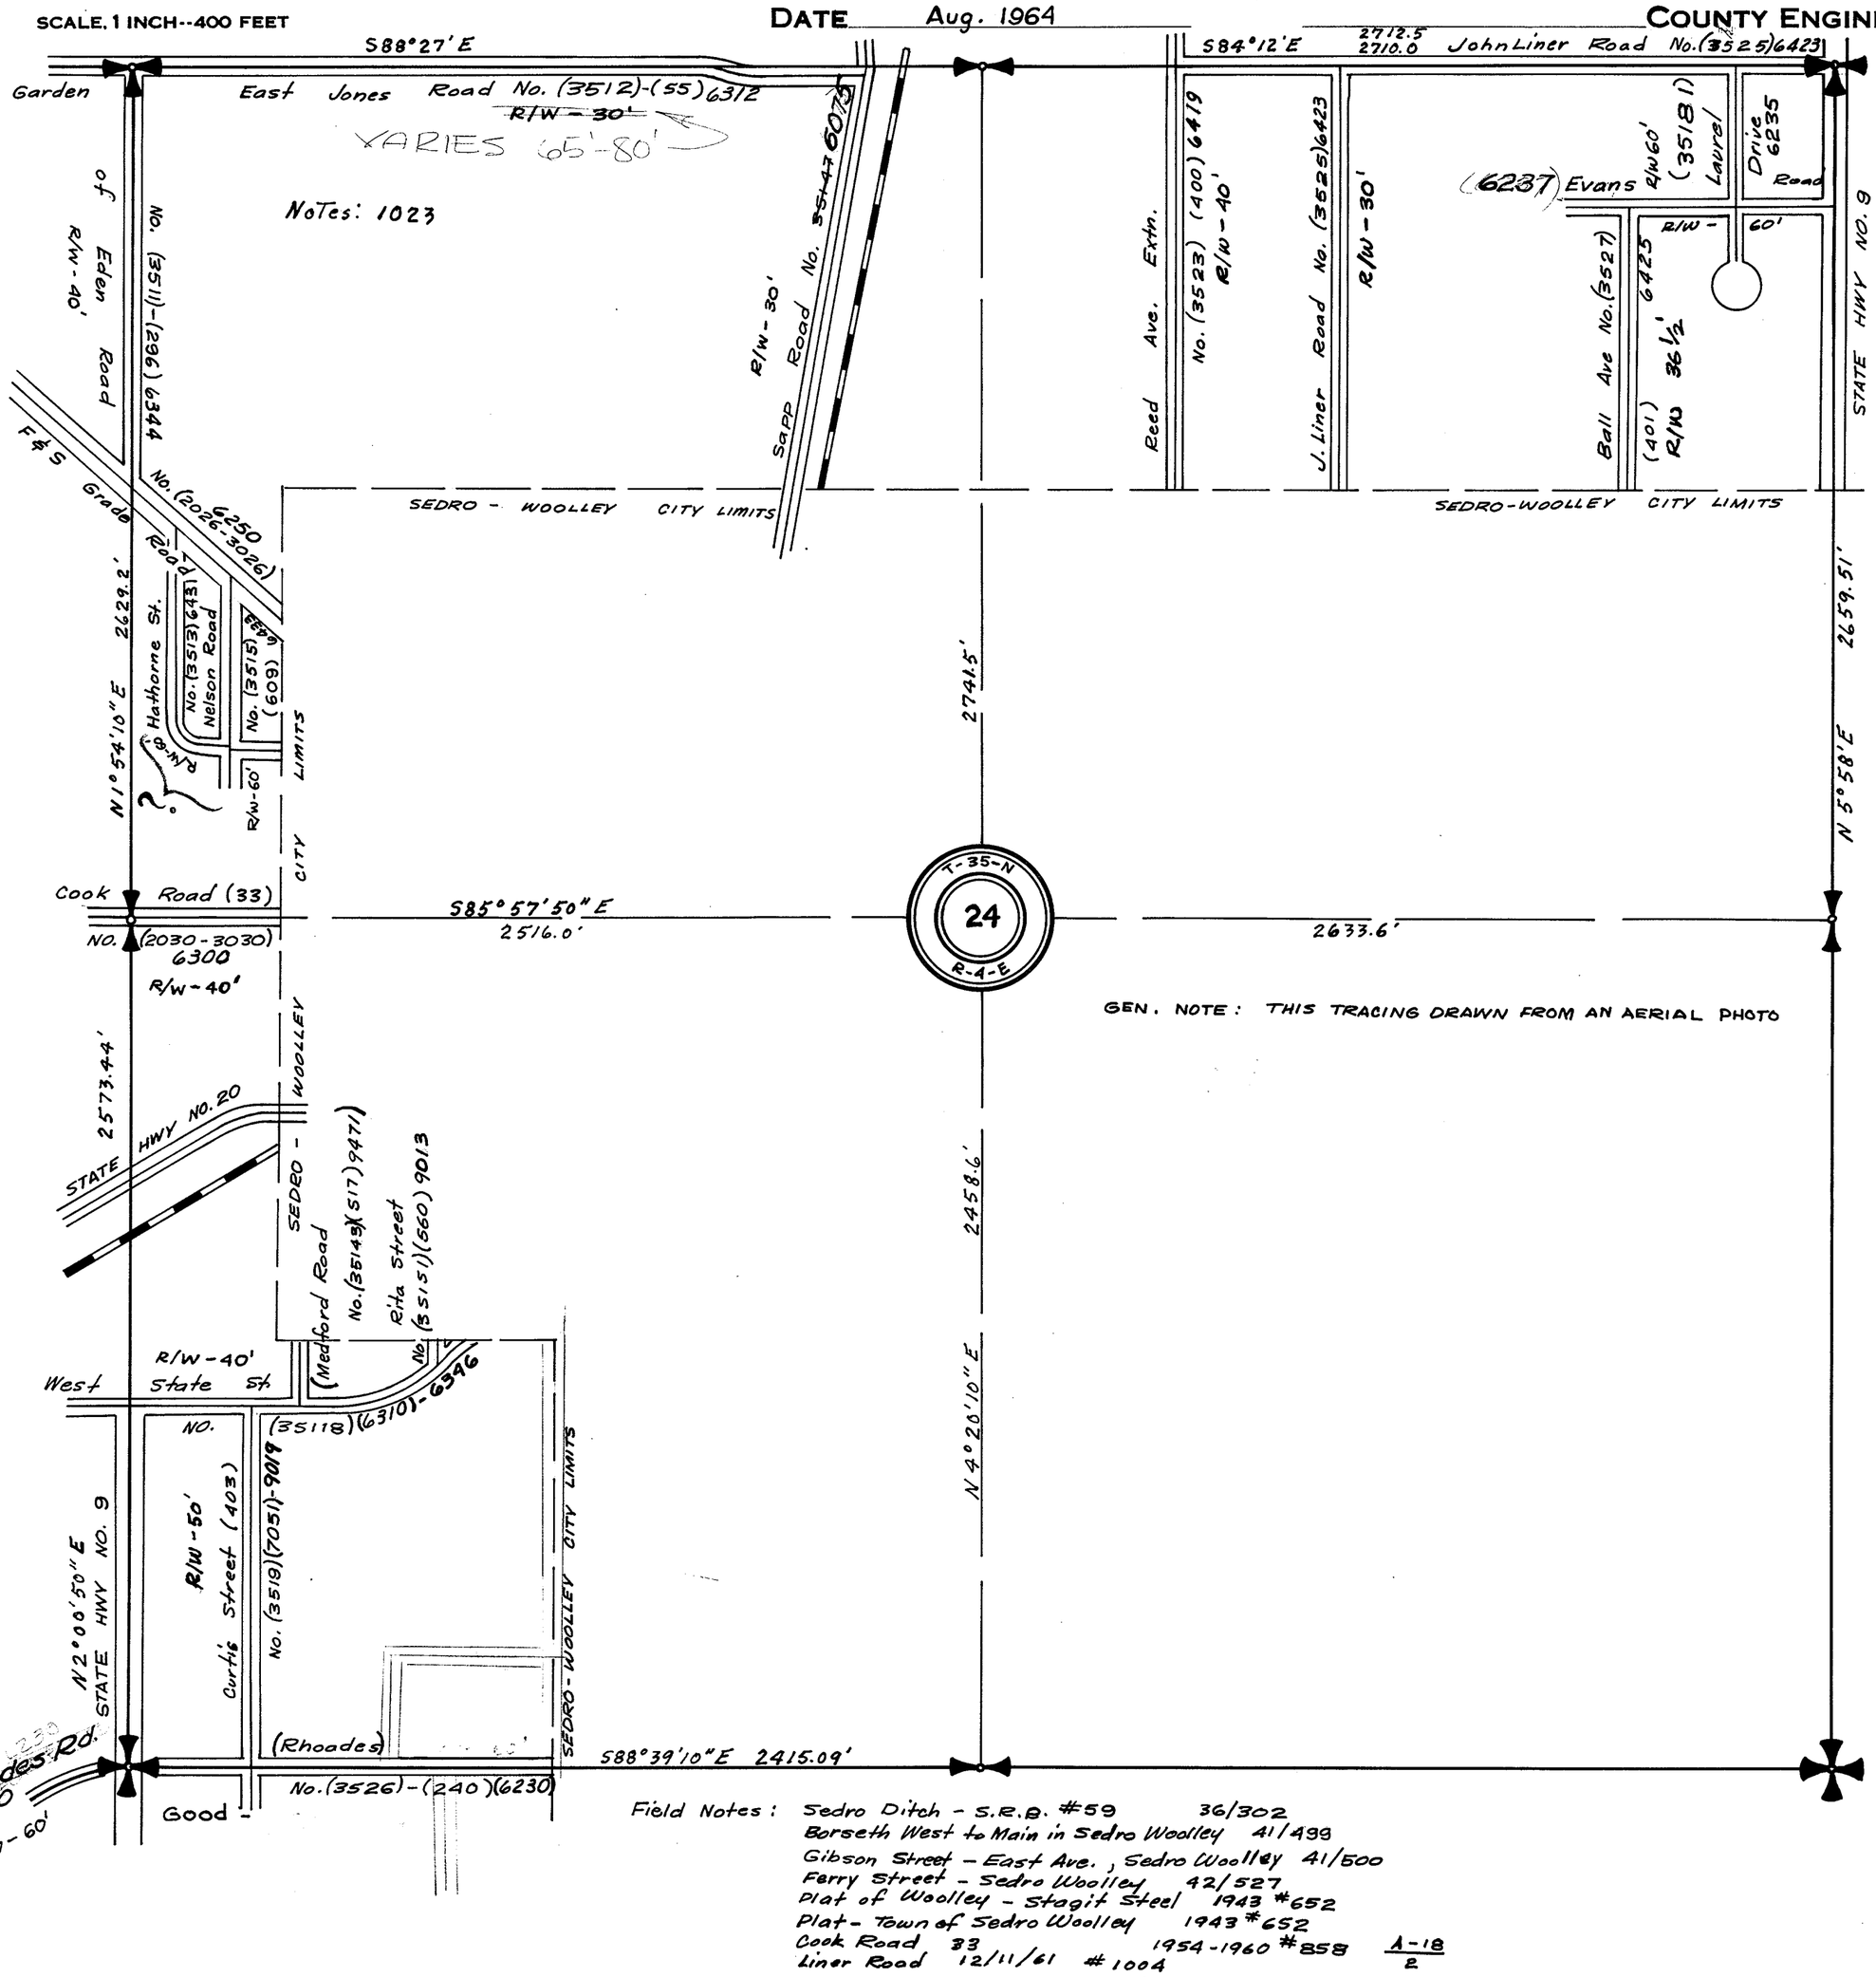

GEN. NOTE: THIS TRACING DRAWN FROM AN AERIAL PHOTO

Field Notes:
Sedro Ditch - S.R.B. #59 36/302
Borseth West to Main in Sedro Woolley 41/499
Gibson Street - East Ave., Sedro Woolley 41/500
Ferry Street - Sedro Woolley 42/527
Plat of Woolley - Stagit Steel 1943 #652
Plat - Town of Sedro Woolley 1943 #652
Cook Road 33 1954-1960 #858
Liner Road 12/11/61 #1004

A-18
2

SECTION 24

TOWNSHIP 35 NORTH, RANGE 4 EAST, W. M.

SKAGIT COUNTY, WASH.

SCALE, 1 INCH--400 FEET

_____ COUNTY ENGINEER

Assembled

{N 11017.62 E 10393.35}

S88°27'E 2630.7

46/598

{N 10946.46 E 13023.09}

S84°12'E 2710.00

{N 10672.60 E 15719.22}

17792 = 11480 1941

{N 10000 E 10000}

N49°52'30"W 830

{N 9649.73 E 10414.36} Culvert No. 542460

(41/500)

9x011 {N 9425.85 E 10681.22}

N44°38'30"W 1423.0

{N 8872.22 E 11227.97}

{N 8749.32 E 11273.02} Intersection Munn & Borseth

Tr. 13 Bk. 50

S1°54'10"W 2629.2

H199

{N 8389.87 E 10306.05 Iron Hub}

S85°59'50"E 2603.00

N 8207.60 E 12902.65

2633.6

{N 8023.13 E 15529.78}

2741.5

Tr. 13 Bk. 104

S1°54'10"W 2656.28

S0°00'50"W 2573.44

H199

N2°31'10"E 2458.6


{N 5818.02 E 10215.61}

2618

S88°31'10"E 2579.94

{N 5751.37 E 12794.69}

SEC. 25-35-4

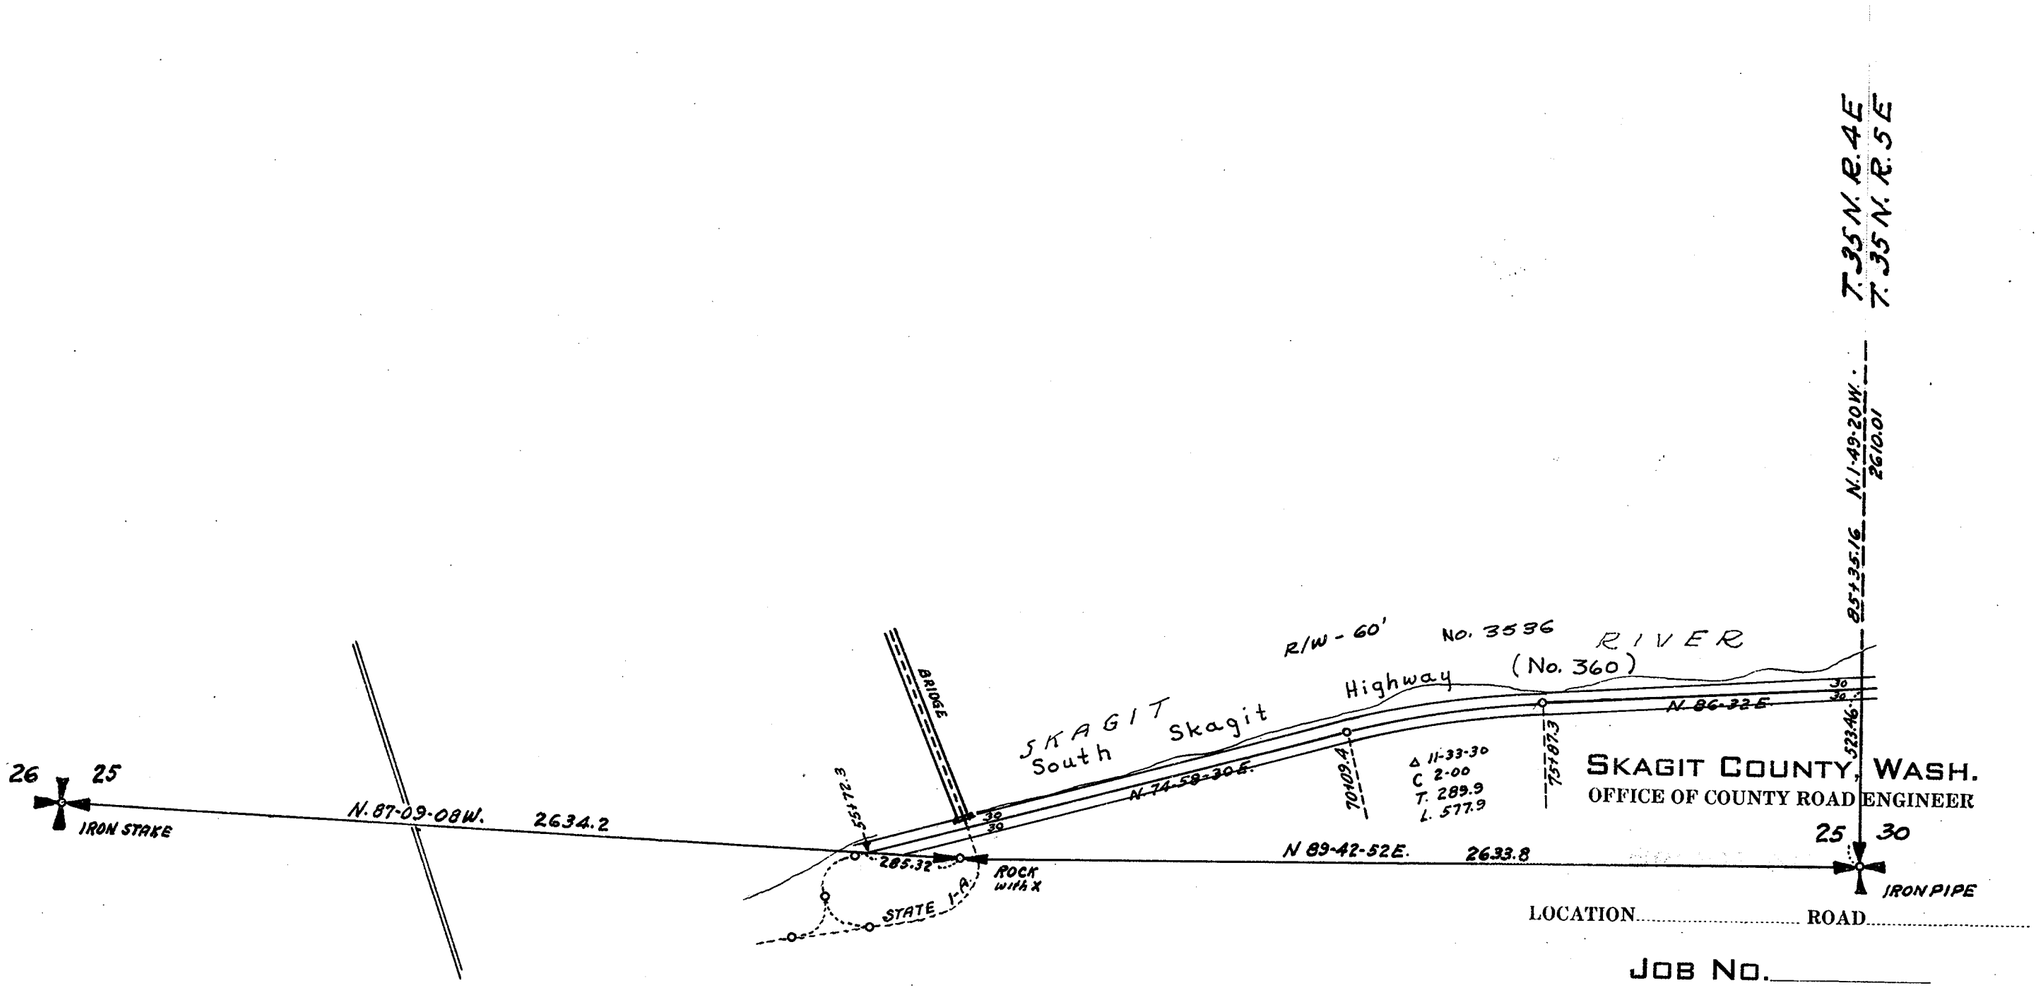

SKAGIT COUNTY, WASH.
OFFICE OF COUNTY ROAD ENGINEER

LOCATION..... ROAD.....

JOB NO._____

DATE..... .....
County Road Engineer

APPROVED..... 194.....

.....
Chairman-Board of County Commissioneers

See C.R.P. No. 408
FAS.PROJ. NO. S-0785(1)
SOUTH SKAGIT HIGHWAY No. 360.

SECTION 25


TOWNSHIP 35 NORTH, RANGE 4 EAST, W. M.

SKAGIT COUNTY, WASH.

SCALE, 1 INCH--400 FEET

DATE Aug. 1965

COUNTY ENGINEER

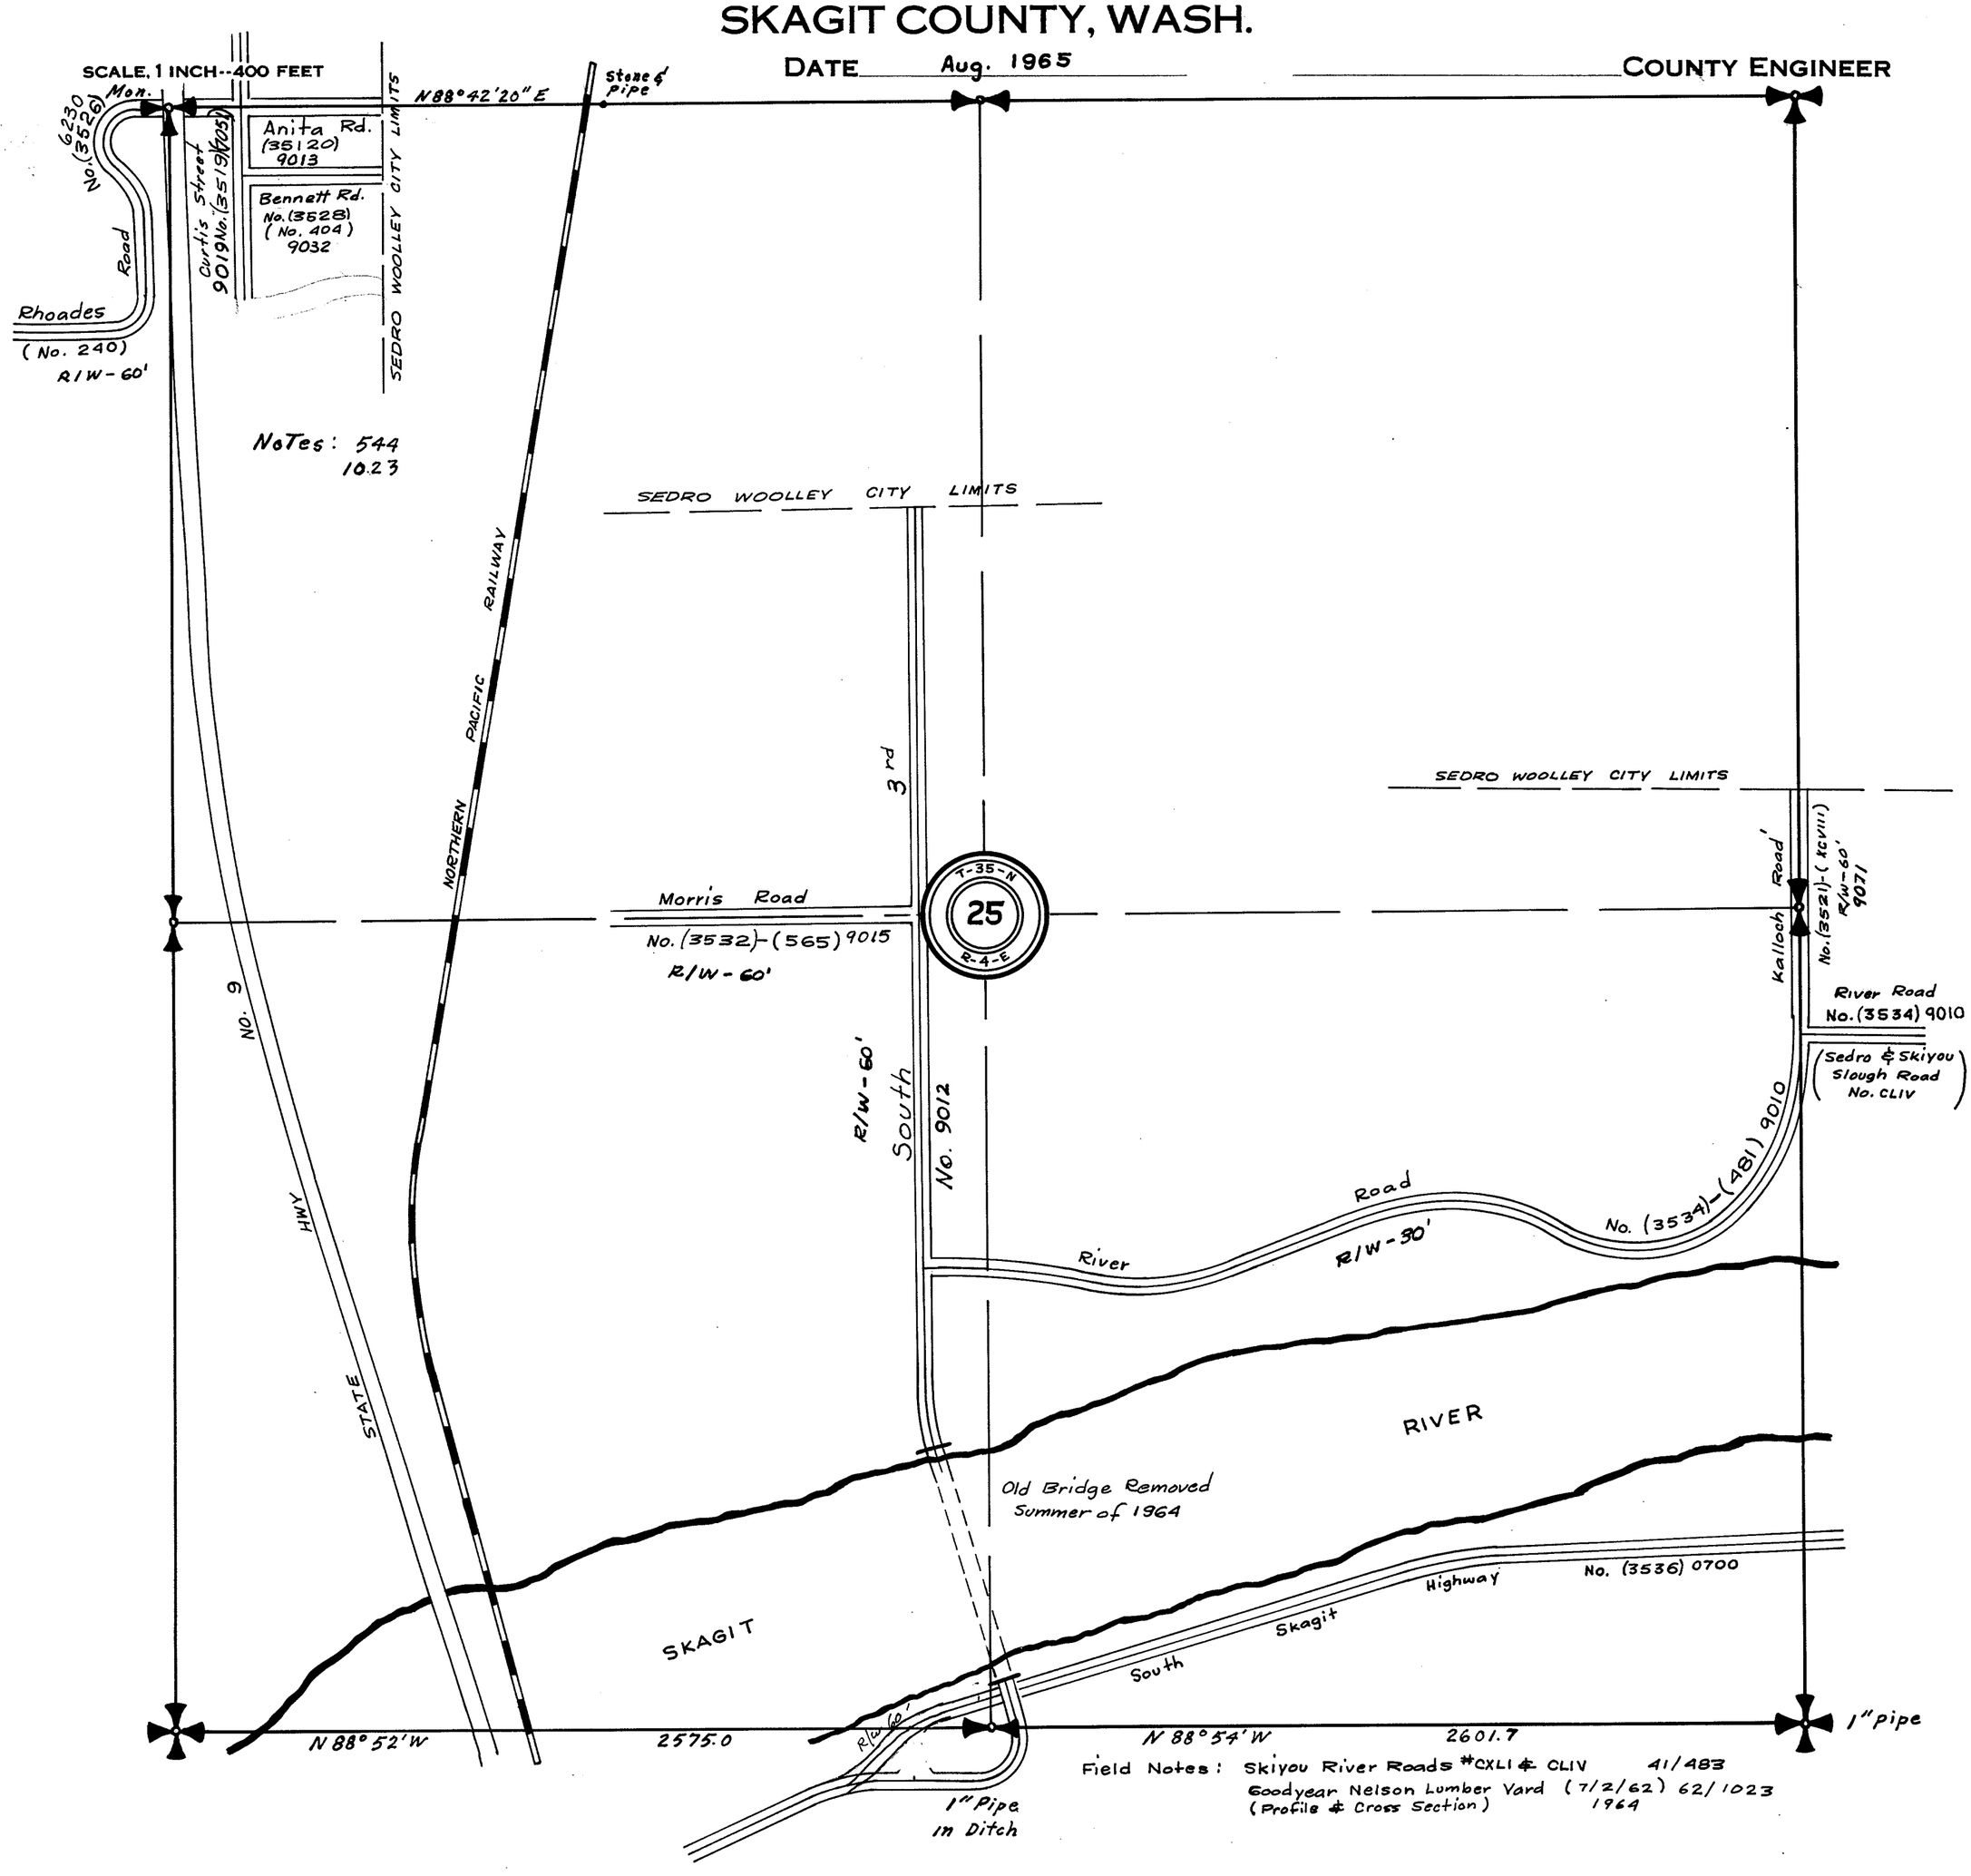

Field Notes: Skiyou River Roads #CXLI & CLIV 41/483

Goodyear Nelson Lumber Yard (7/2/62) 62/1023
(Profile & Cross Section) 1964


SECTION 25

TOWNSHIP 35 NORTH, RANGE 4 EAST, W. M.

SKAGIT COUNTY, WASH.

SCALE, 1 INCH--400 FEET

DATE November, 1959 Frank Gilkey COUNTY ENGINEER

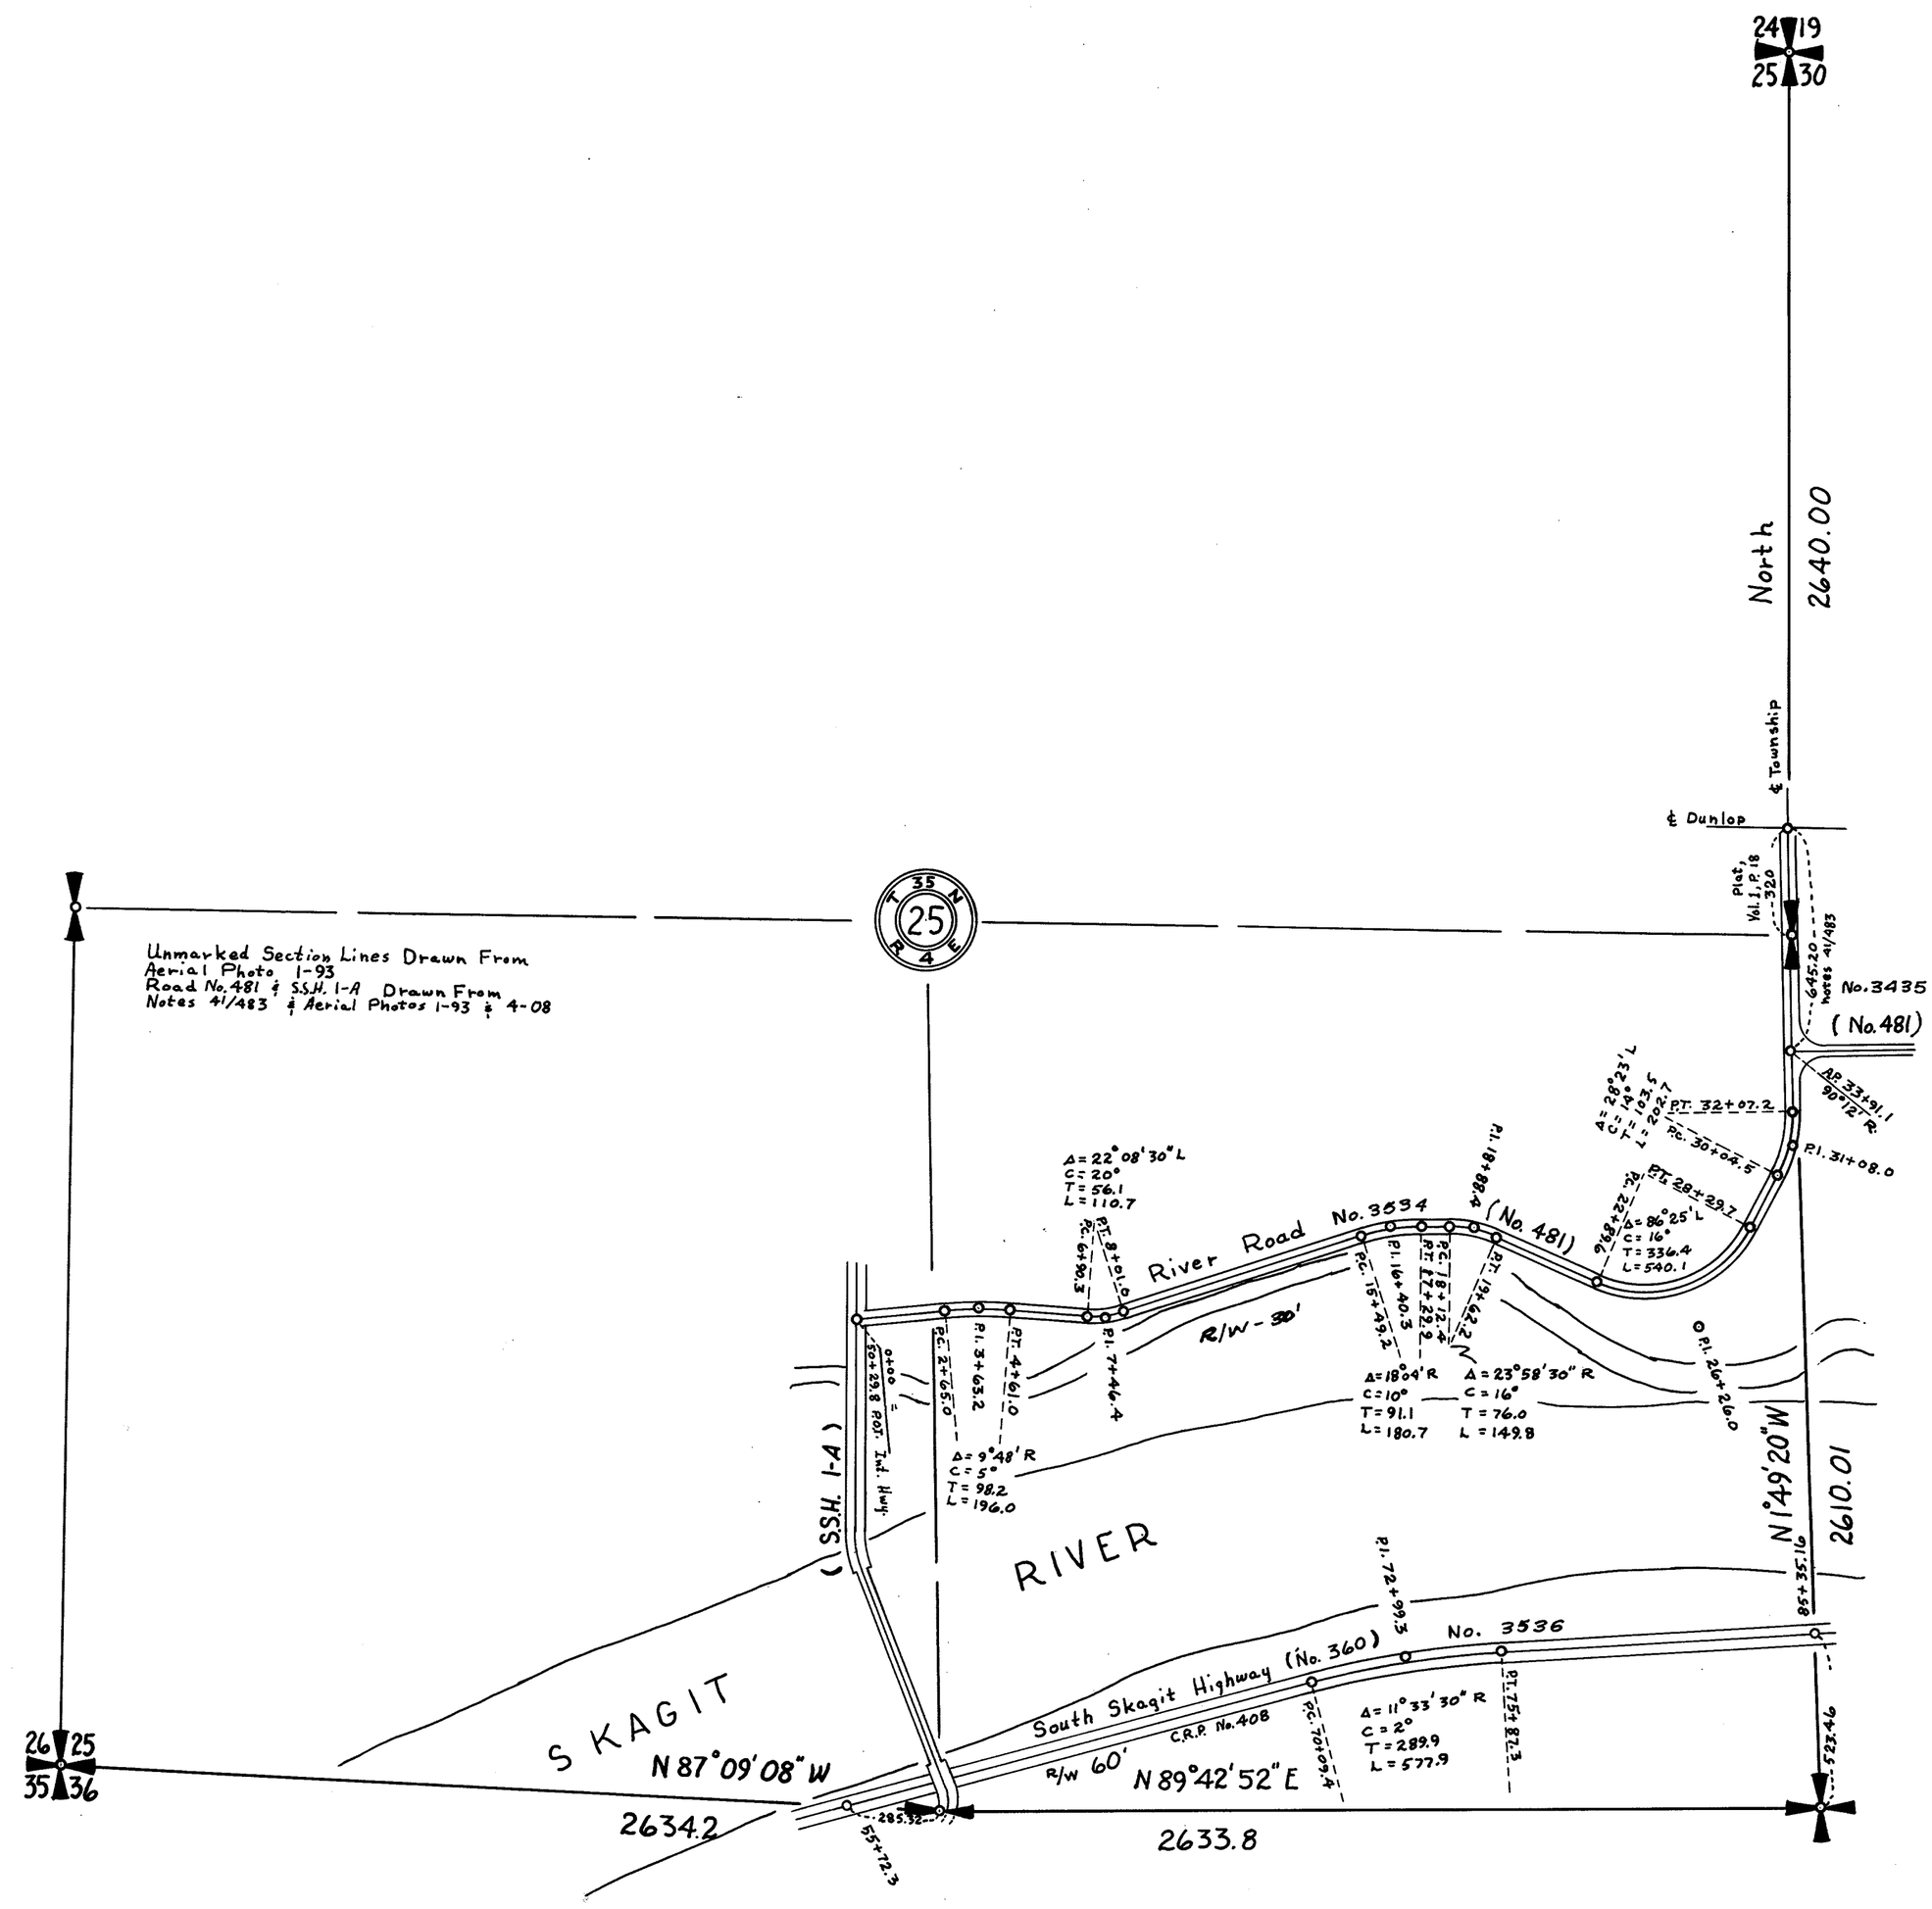



TOWNSHIP 35 NORTH, RANGE 4 EAST, W. M.

SKAGIT COUNTY, WASH.

SCALE, 1 INCH--400 FEET

DATE Aug. 1965

COUNTY ENGINEER

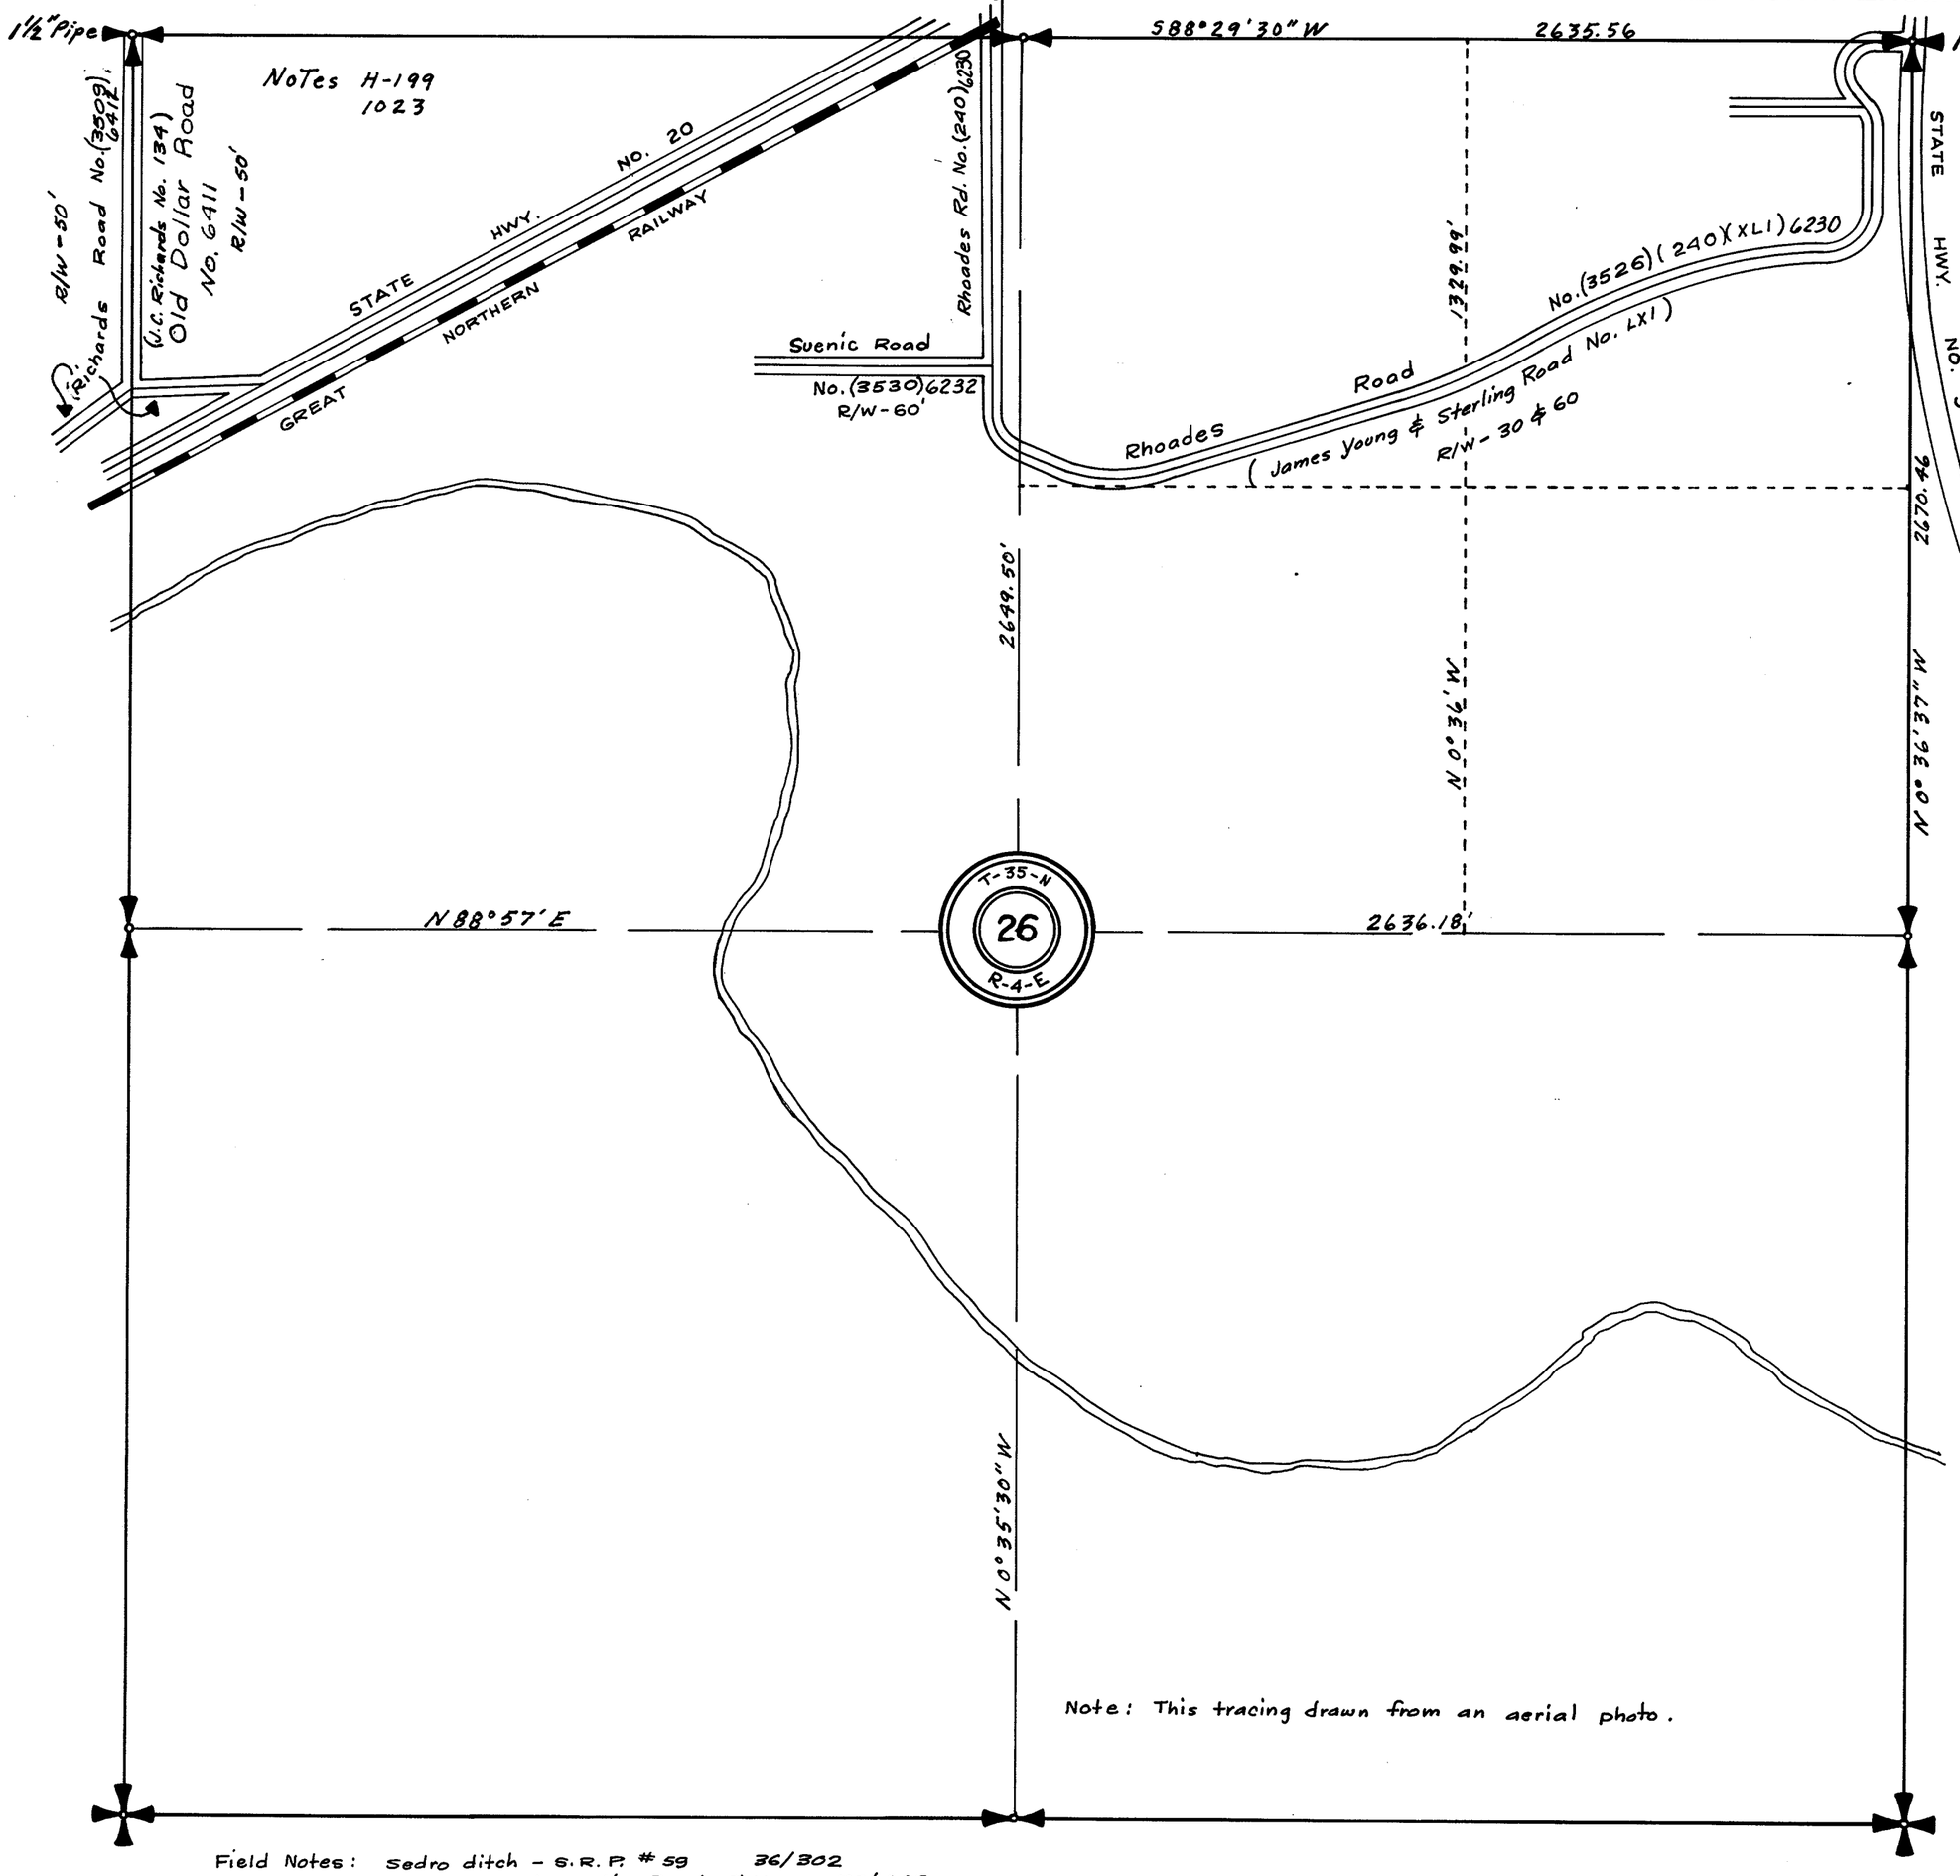

Note: This tracing drawn from an aerial photo.

Field Notes:
Sedro ditch - S.R.P. #59 36/302
James Young & Sterling Roads #LXI 39/442
Skiyou River Roads #CXLI & #CLIV 41/483
Rhoades Road #240 - Ditch - East Side 2/25/58 58/938
Goodyear Street - Ditch Levels 11/20/61 1008


LEGRO DATA

TOWNSHIP 35 NORTH, RANGE 4 EAST, W. M.
SKAGIT COUNTY, WASH.

SCALE, 1 INCH--400 FEET

DATE Aug. 1965

LLOYD H. JOHNSON COUNTY ENGINEER

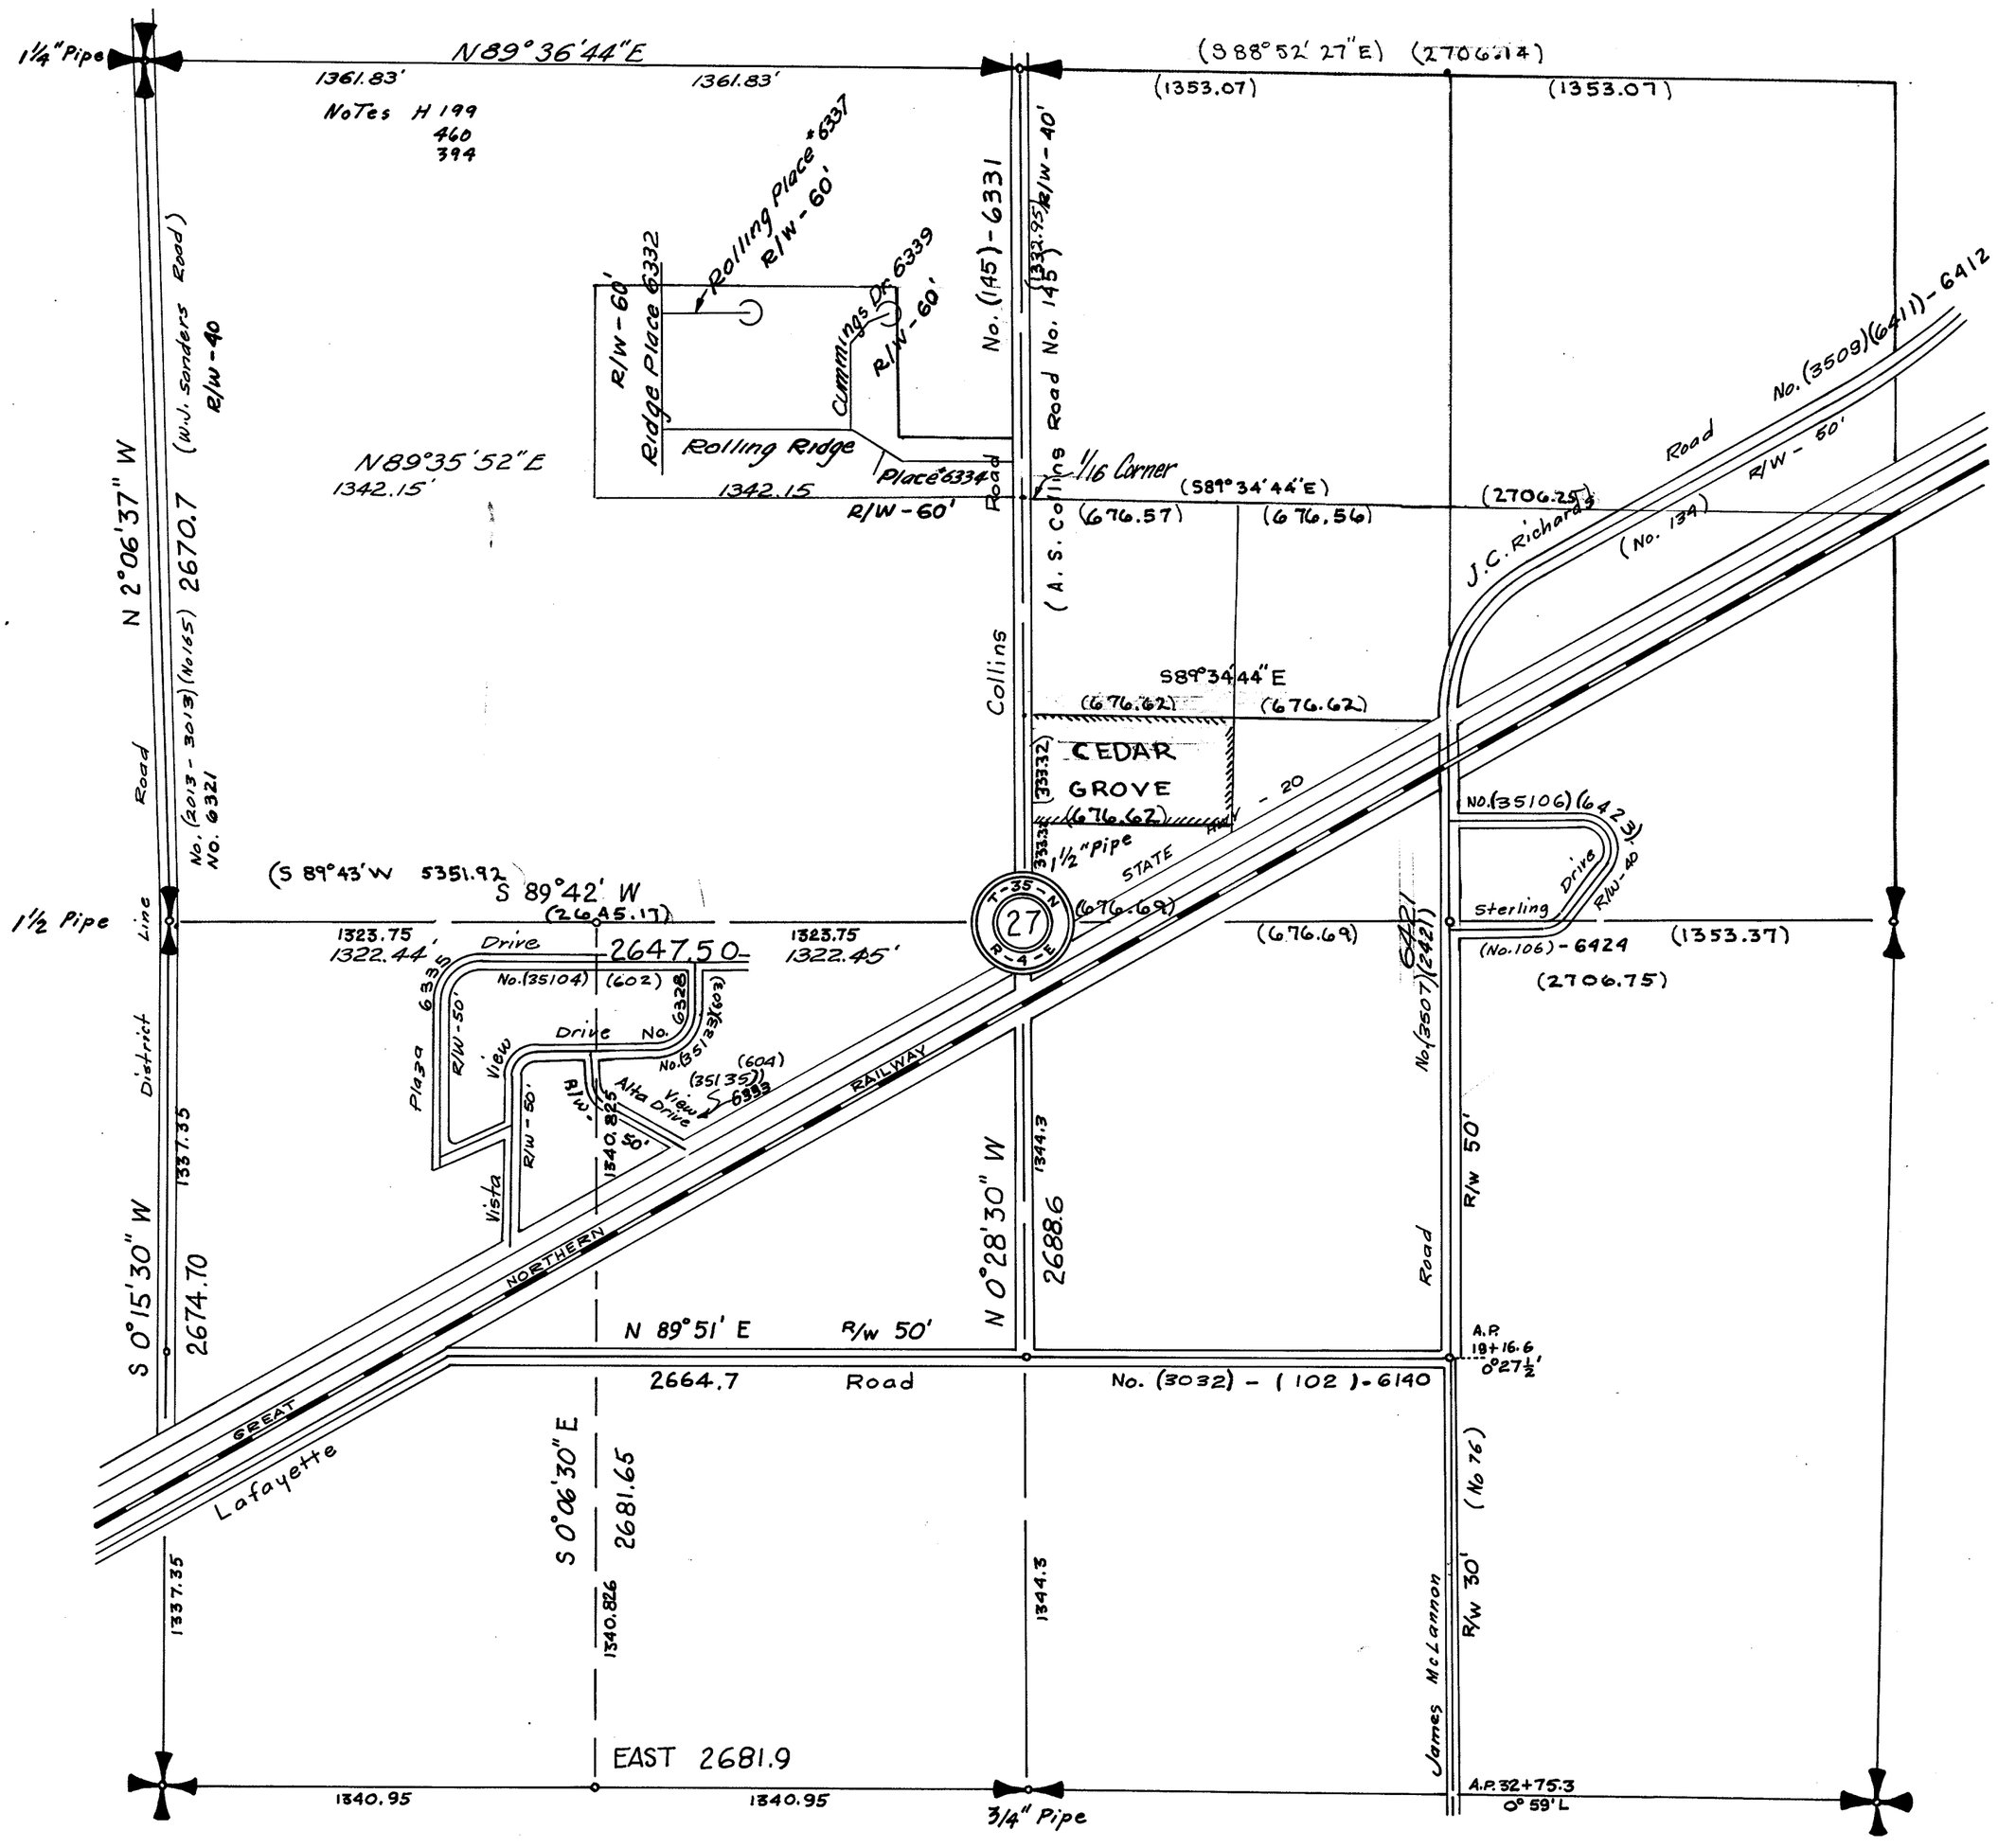

SECTION 27


TOWNSHIP 35 NORTH, RANGE 4 EAST, W. M.

SKAGIT COUNTY, WASH.

SCALE, 1 INCH–400 FEET

A.L. Strong COUNTY ENGINEER

1337.35
1405.2
932.15

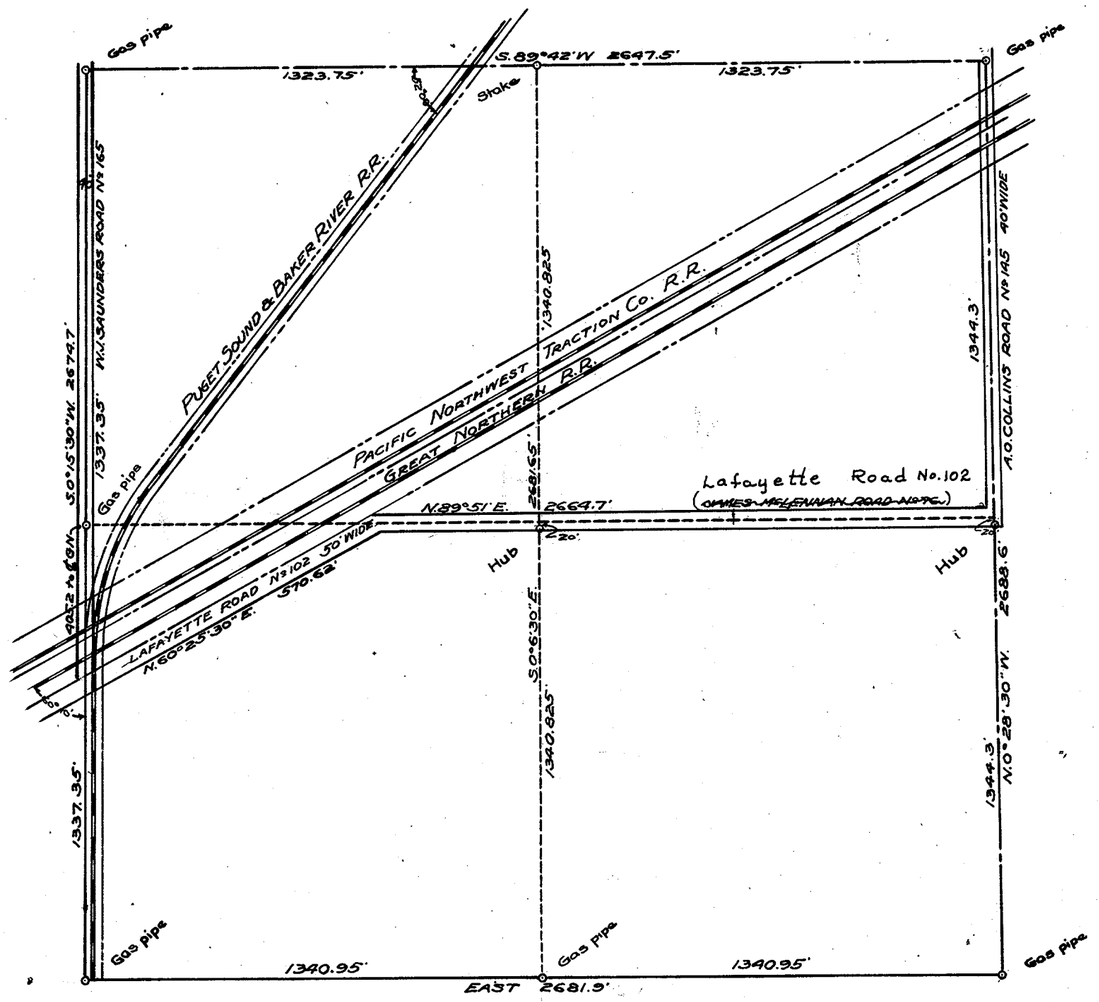

2683.08
N 89°56' E "P.H. 19"


SECTION 27

TOWNSHIP 35 NORTH, RANGE 4 EAST, W. M.

SKAGIT COUNTY, WASH.

SCALE, 1 INCH--400 FEET

DATE August, 1959 Frank Gilkey COUNTY ENGINEER

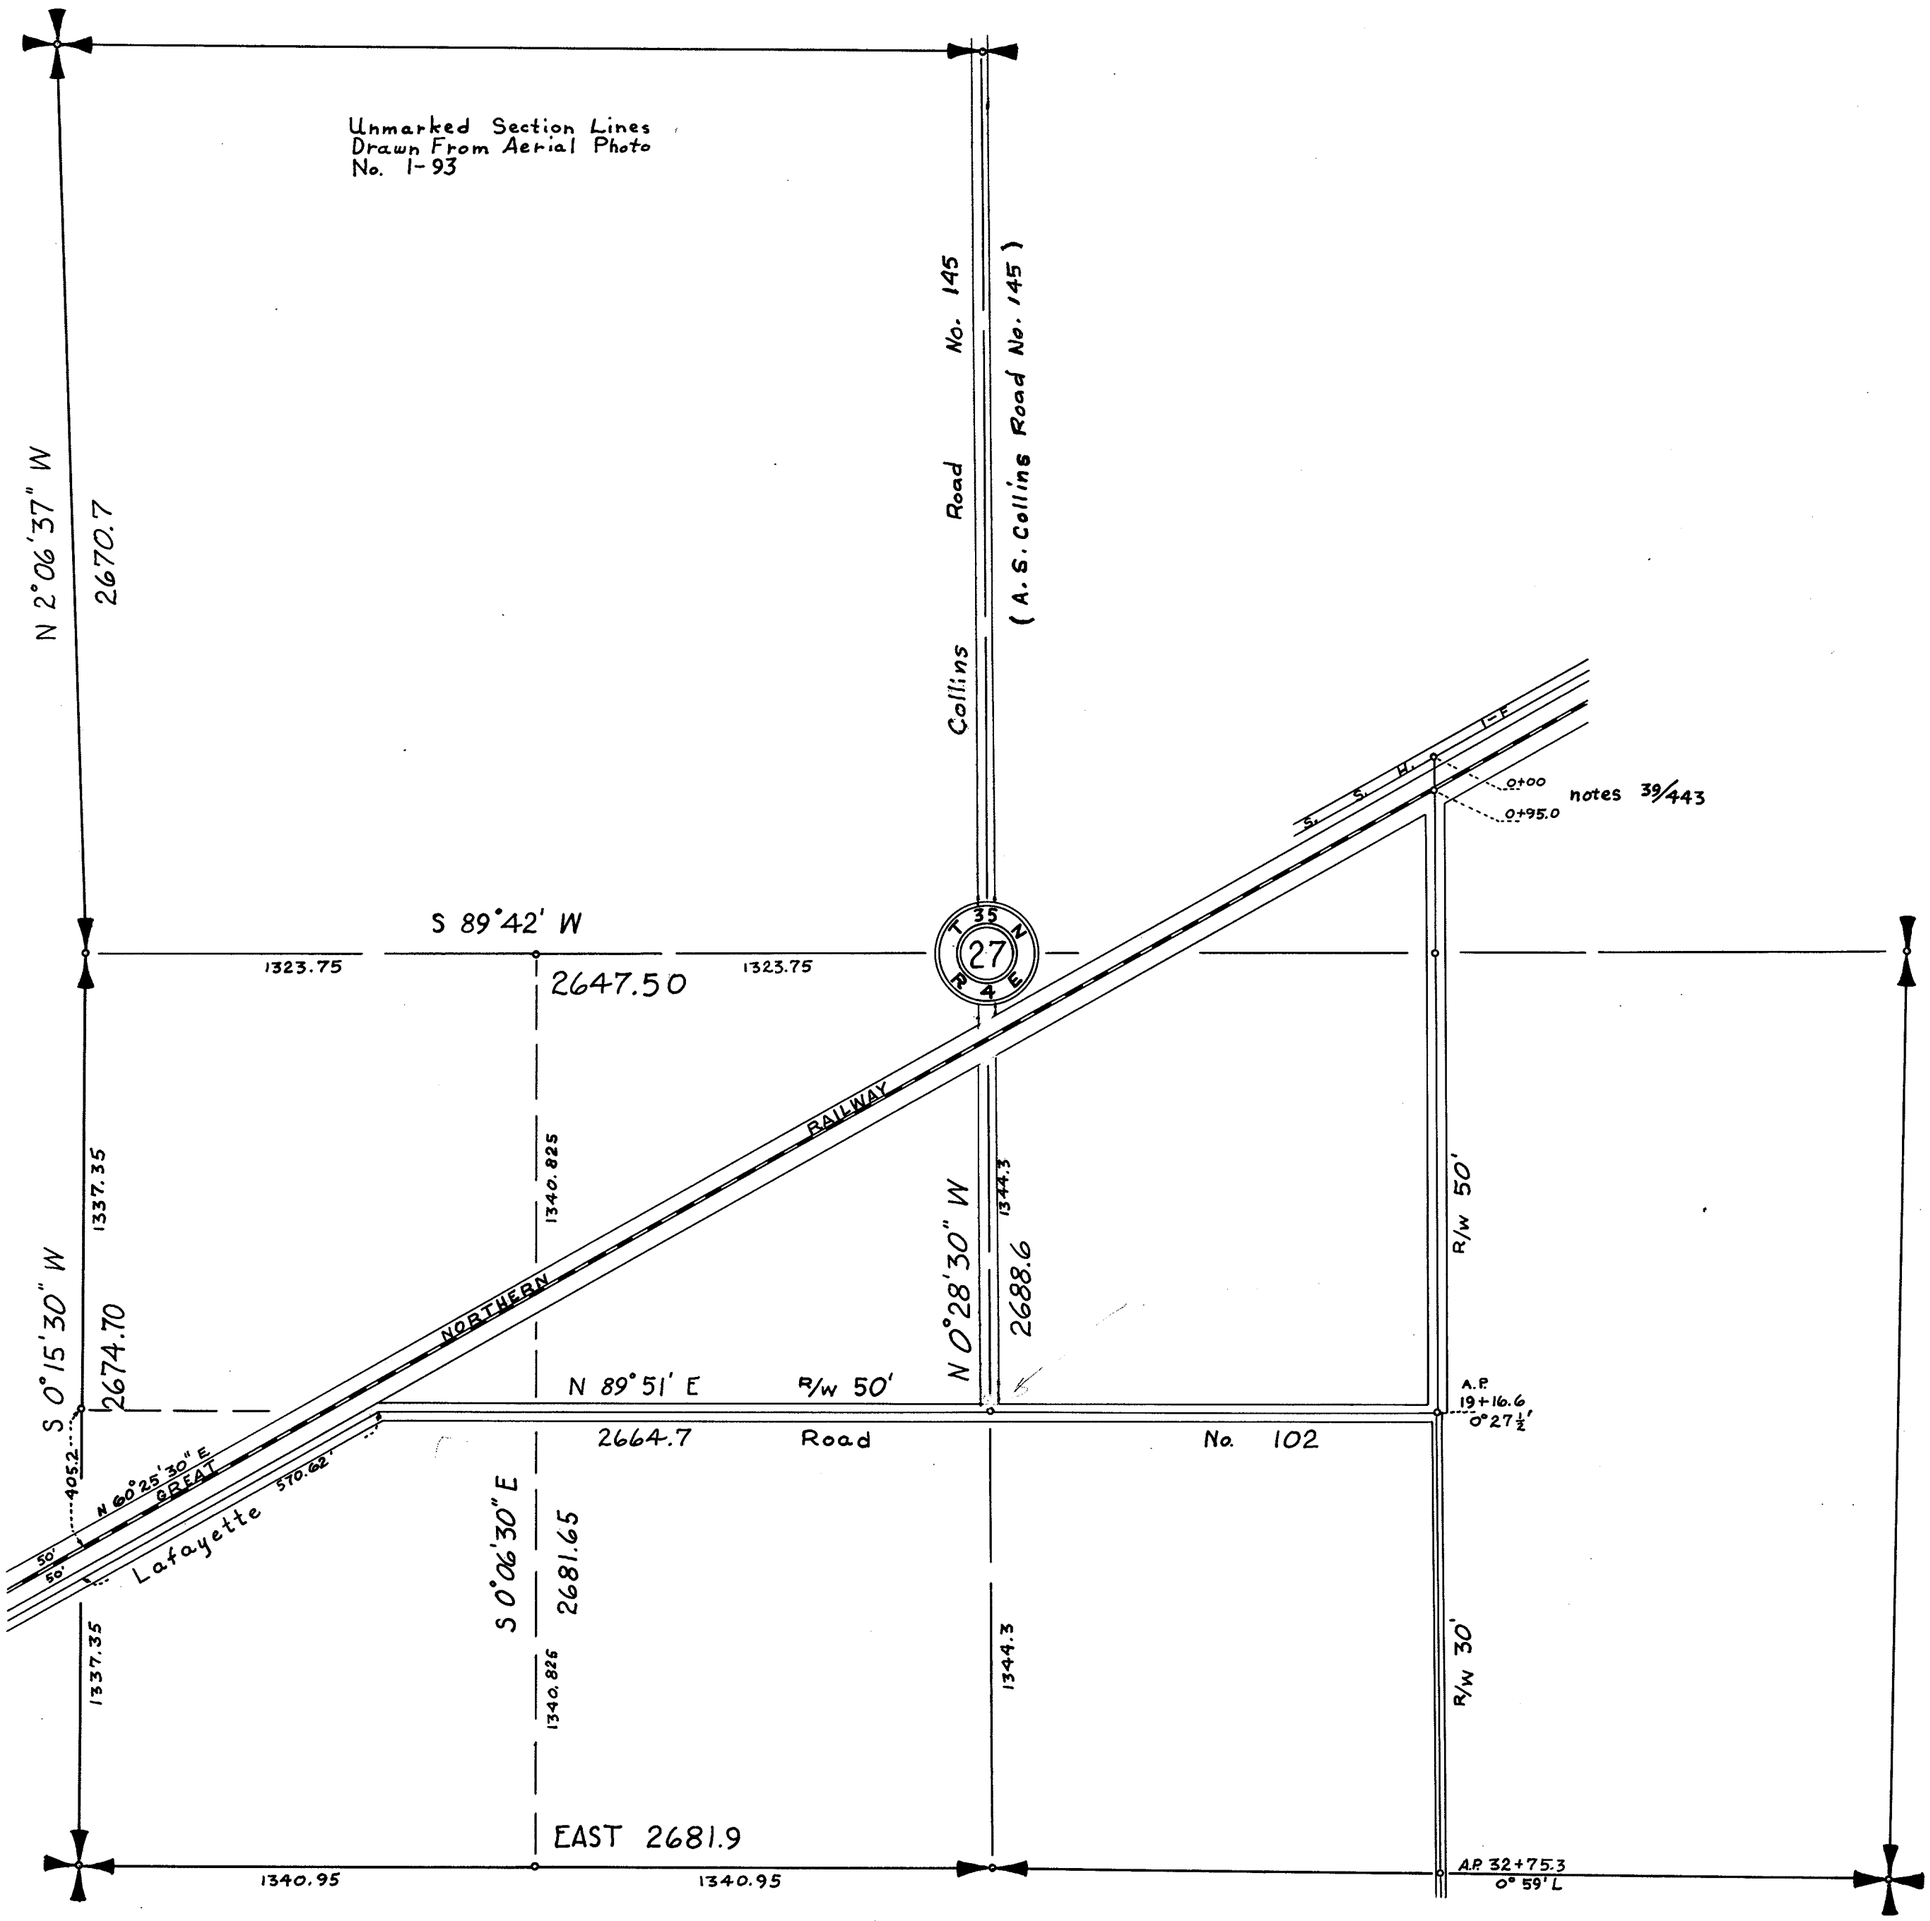

SECTION 28

TOWNSHIP 35 NORTH, RANGE 4 EAST, W. M.


SKAGIT COUNTY, WASH.

See Gardiner Road for County Subdiv.

Gilkey and Wright Subdivision

SCALE, 1 INCH--400 FEET

H.O. Walberg COUNTY ENGINEER

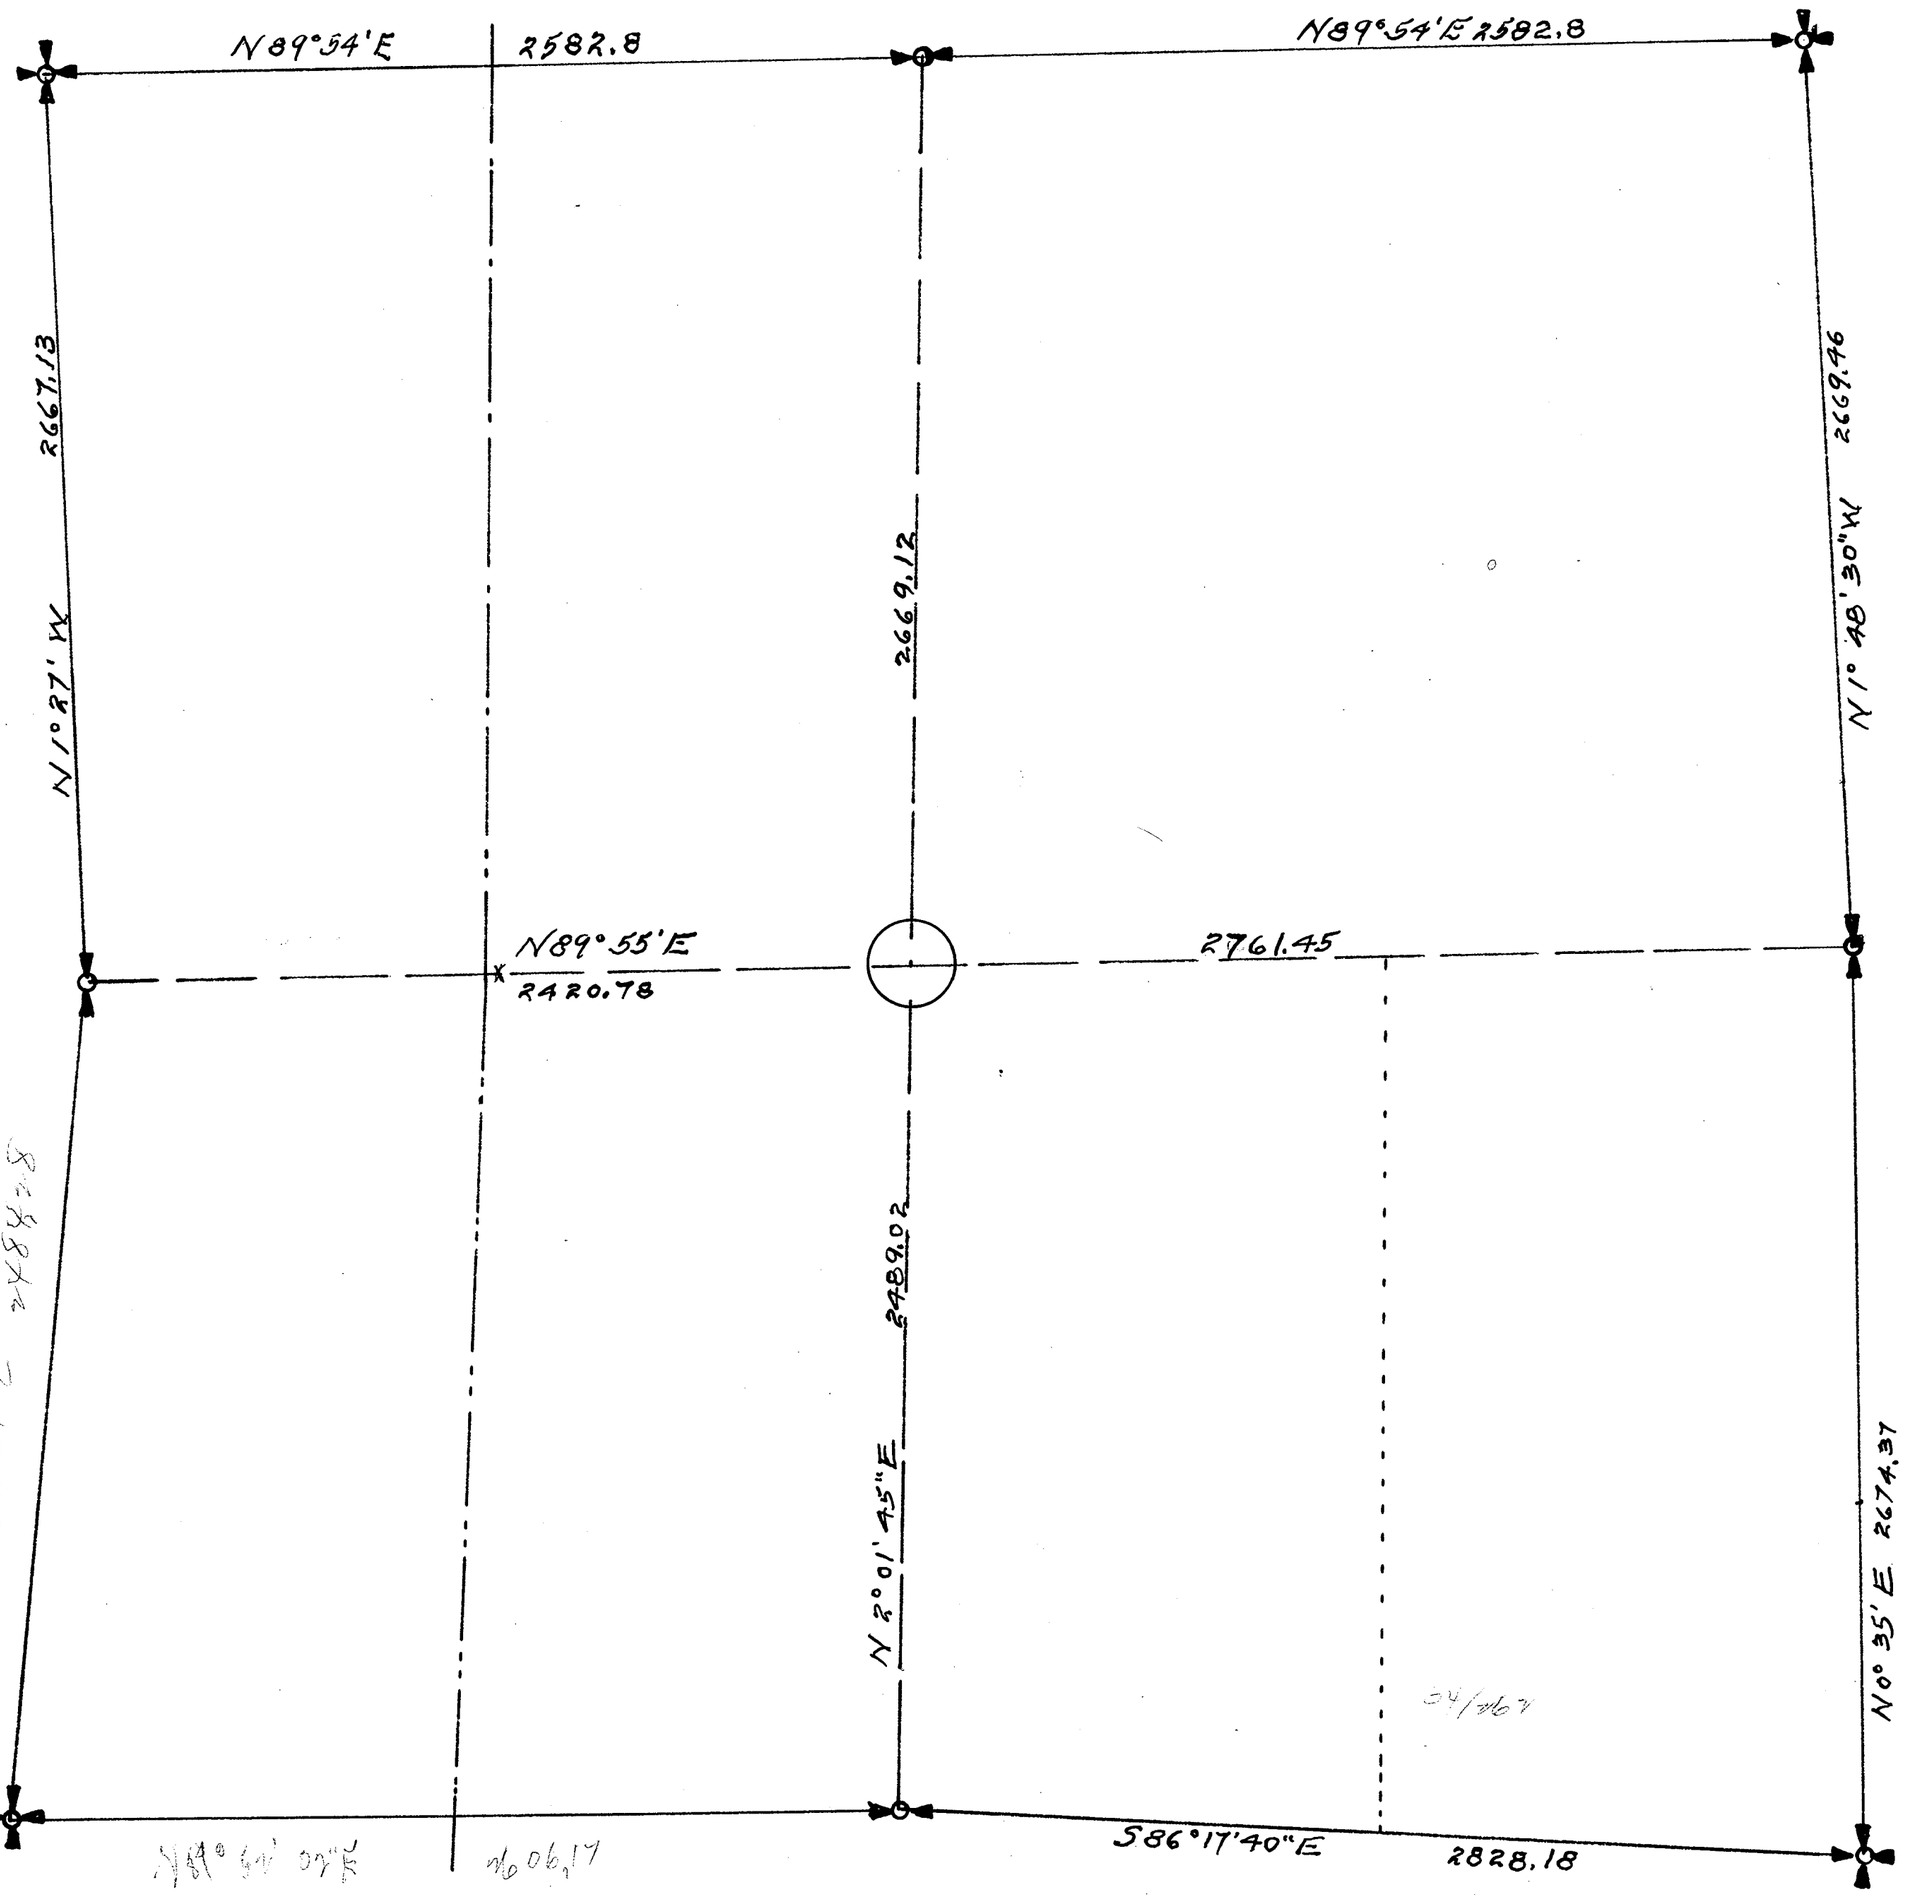

SECTION 28


TOWNSHIP 35 NORTH, RANGE 4 EAST, W. M.

SKAGIT COUNTY, WASH.

Assembled - W. County Surveyor
38/394
34/162

SCALE, 1 INCH--400 FEET
1949

H.O. Walberg COUNTY ENGINEER

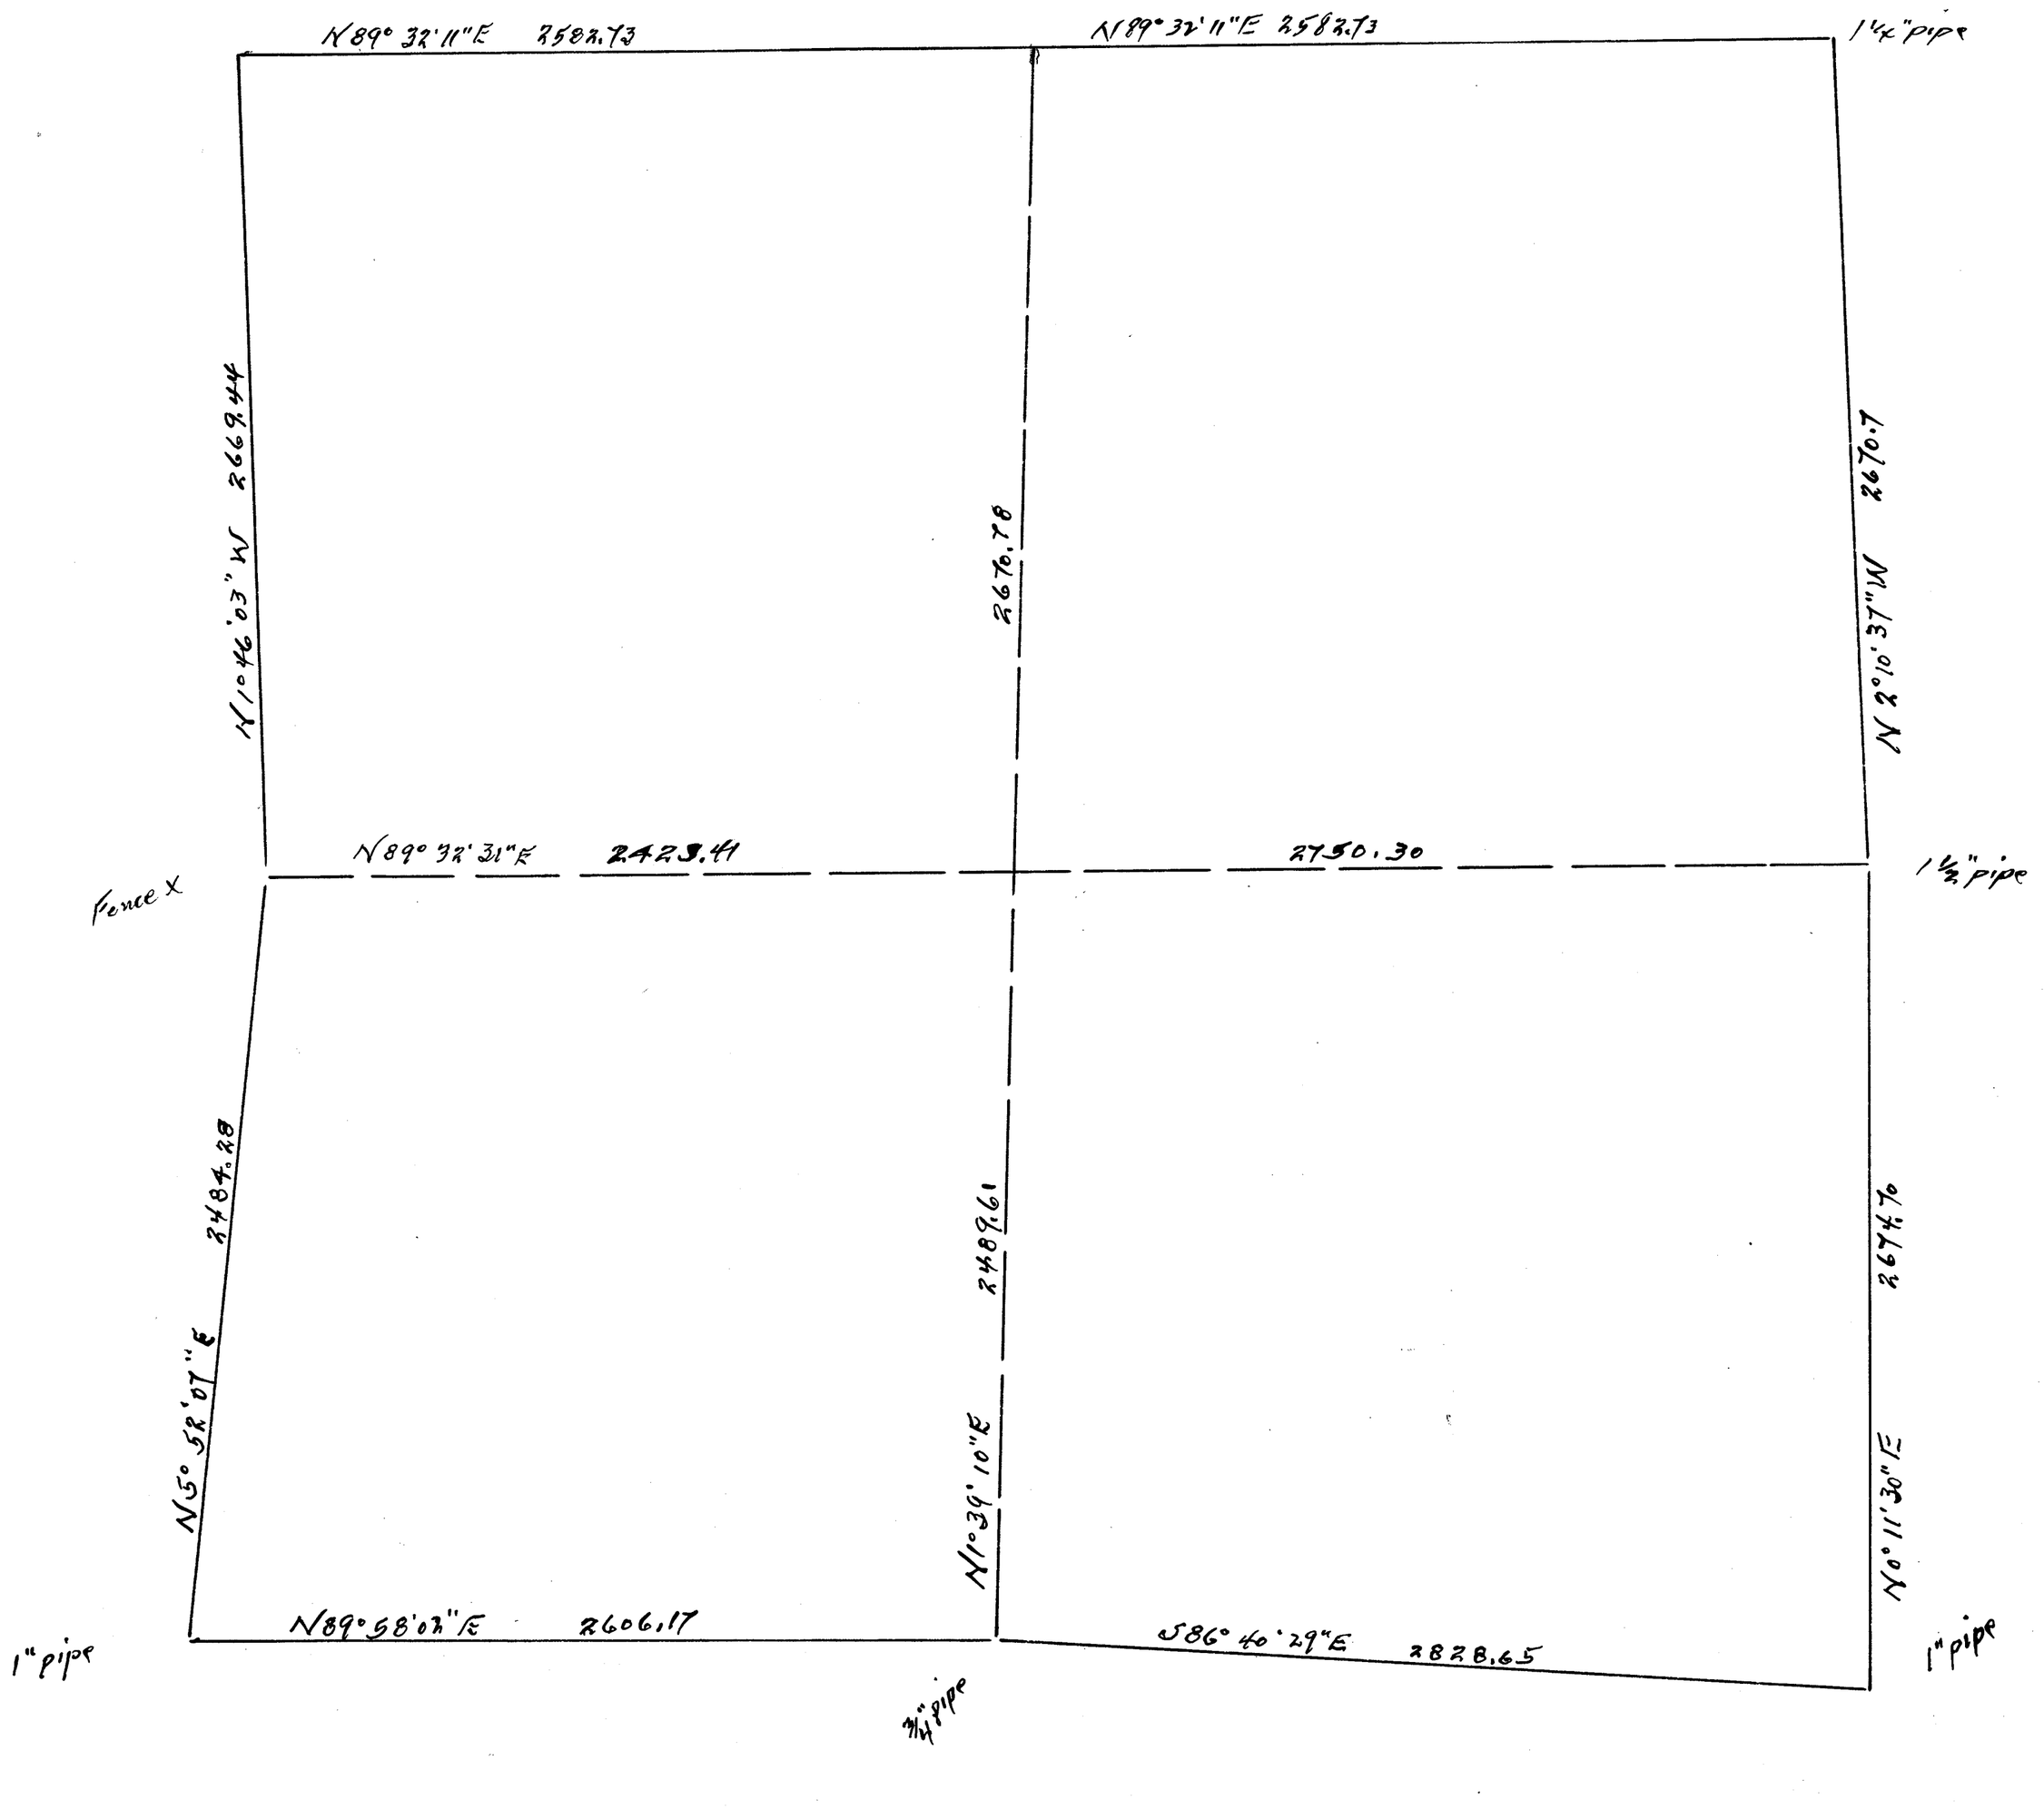


SECTION 28

TOWNSHIP 35 NORTH, RANGE 4 EAST, W. M.

SKAGIT COUNTY, WASH.

SCALE, 1 INCH--400 FEET

DATE August, 1959 Frank Gilkey COUNTY ENGINEER

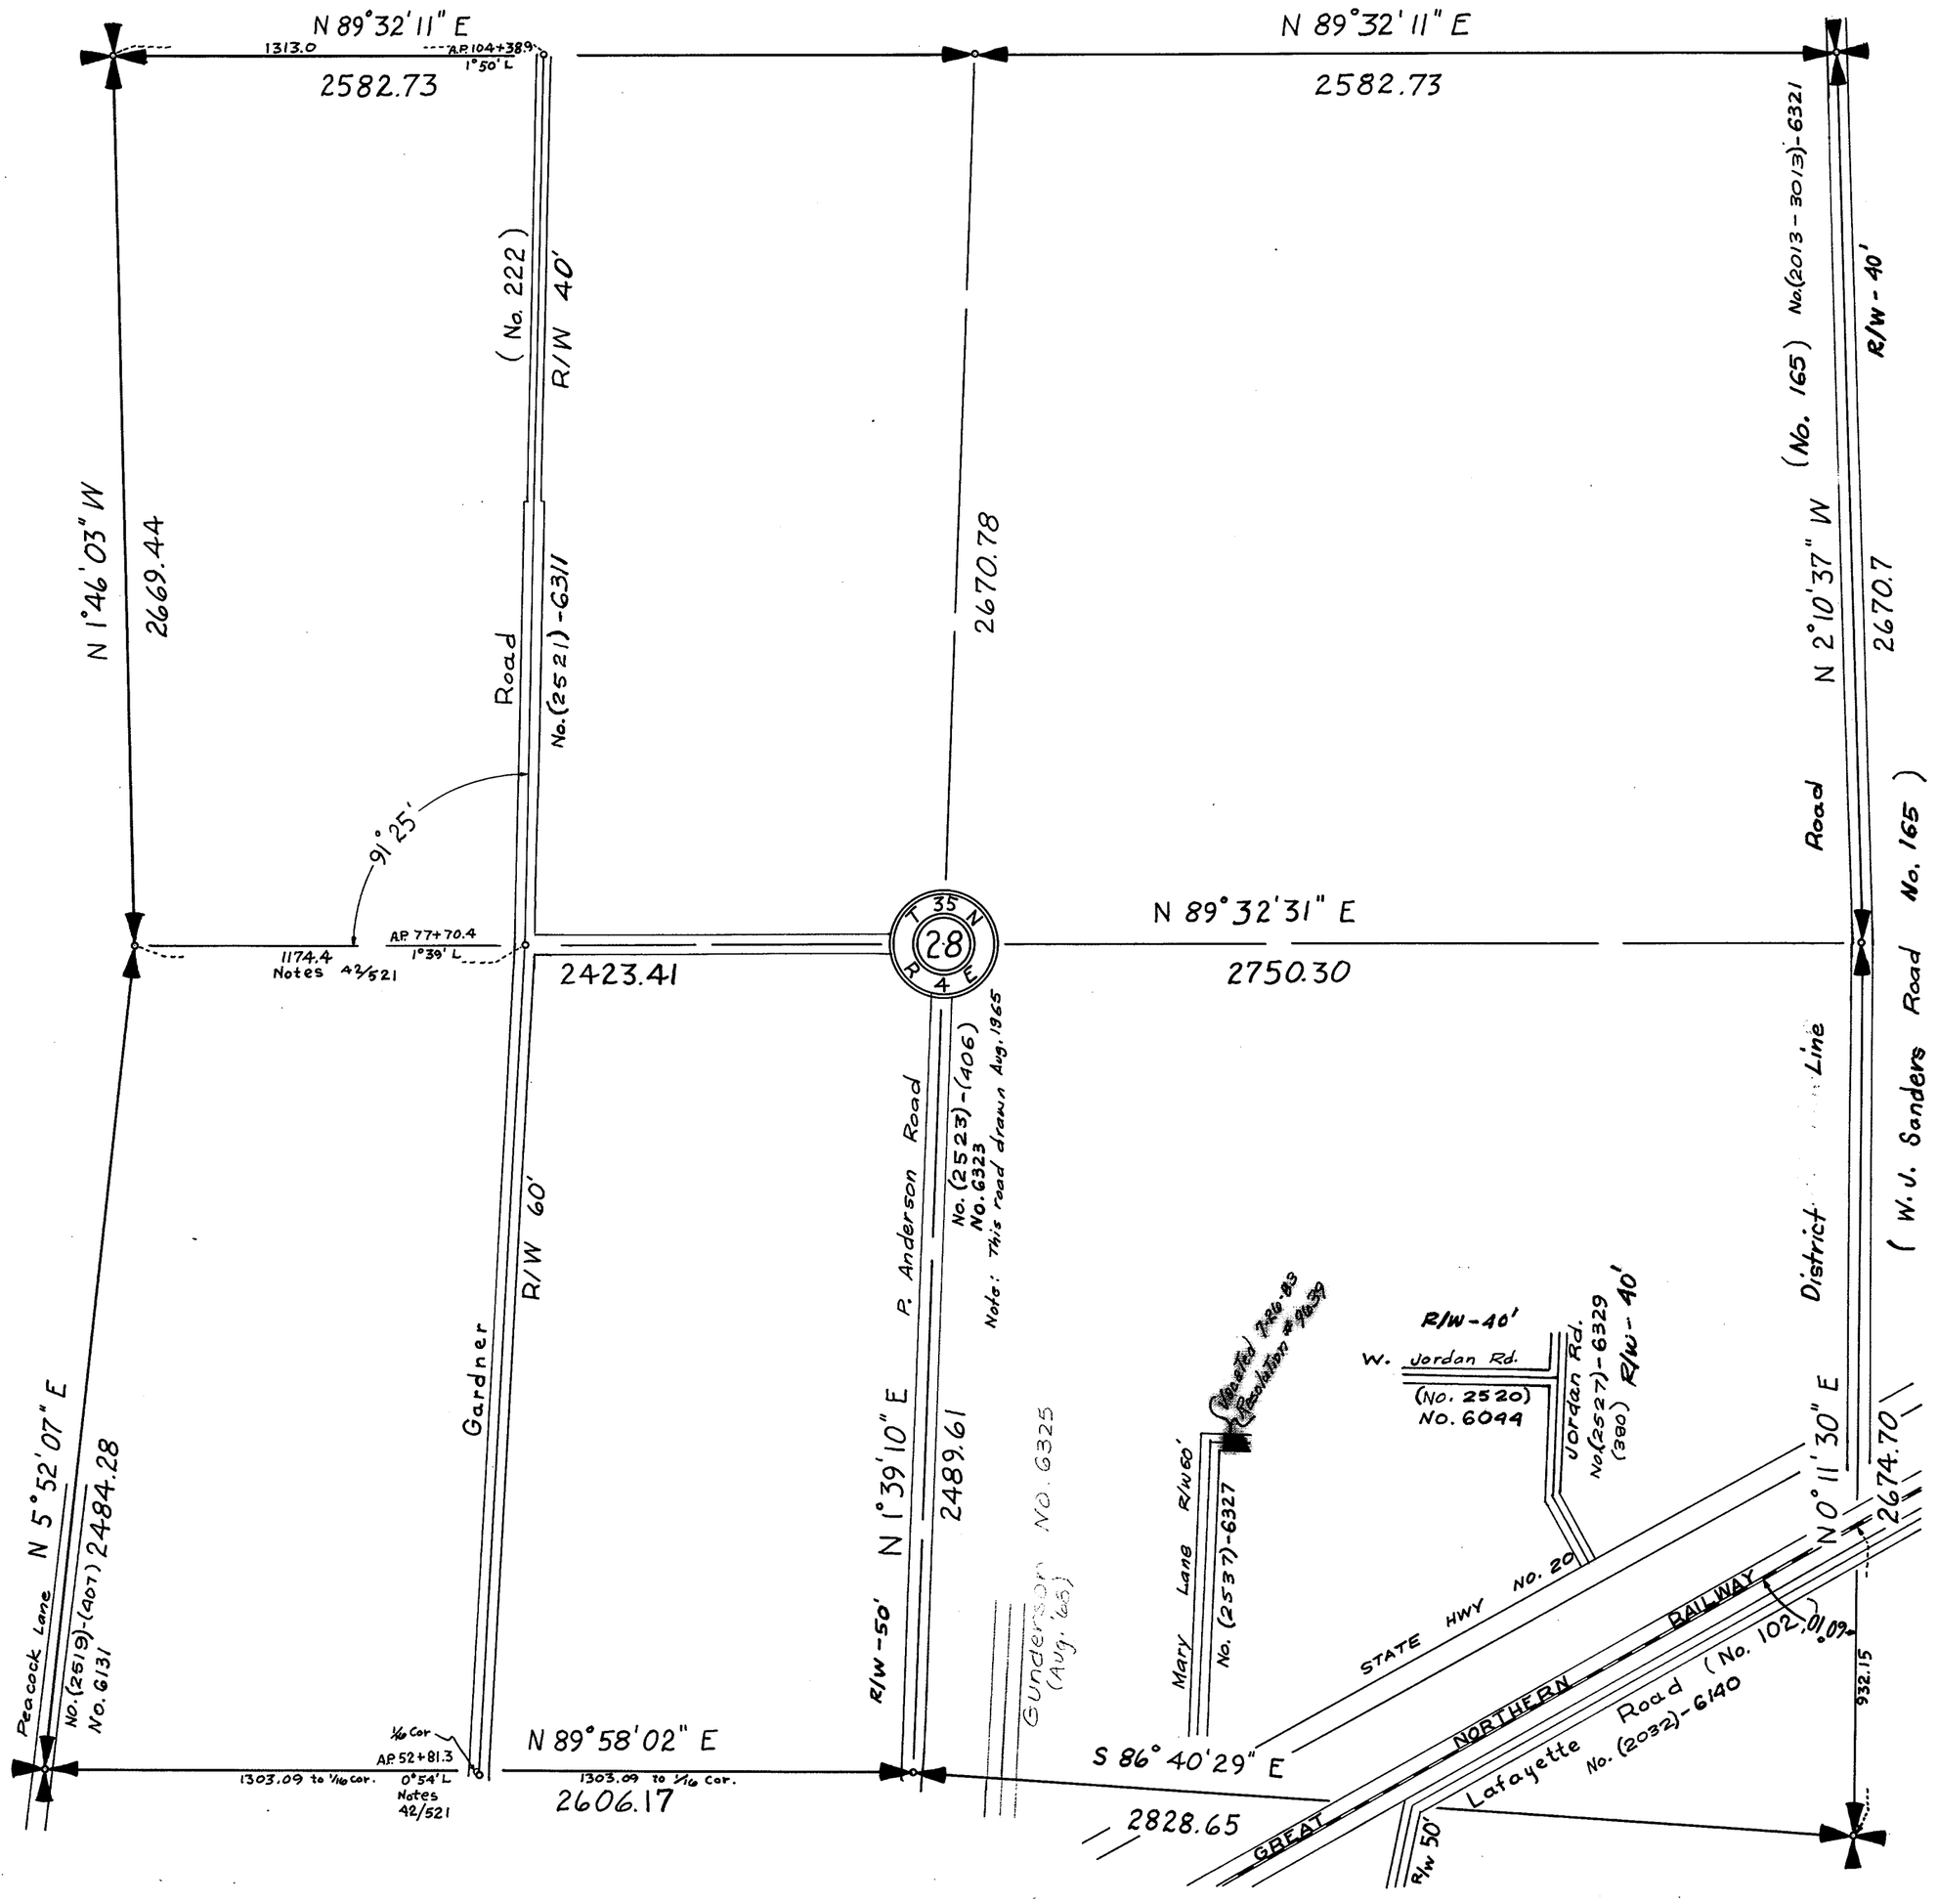

SECTION 29


TOWNSHIP 35 NORTH, RANGE 4 EAST, W. M.

SKAGIT COUNTY, WASH.

SCALE, 1 INCH--400 FEET

DATE Aug. 1965

_____ COUNTY ENGINEER

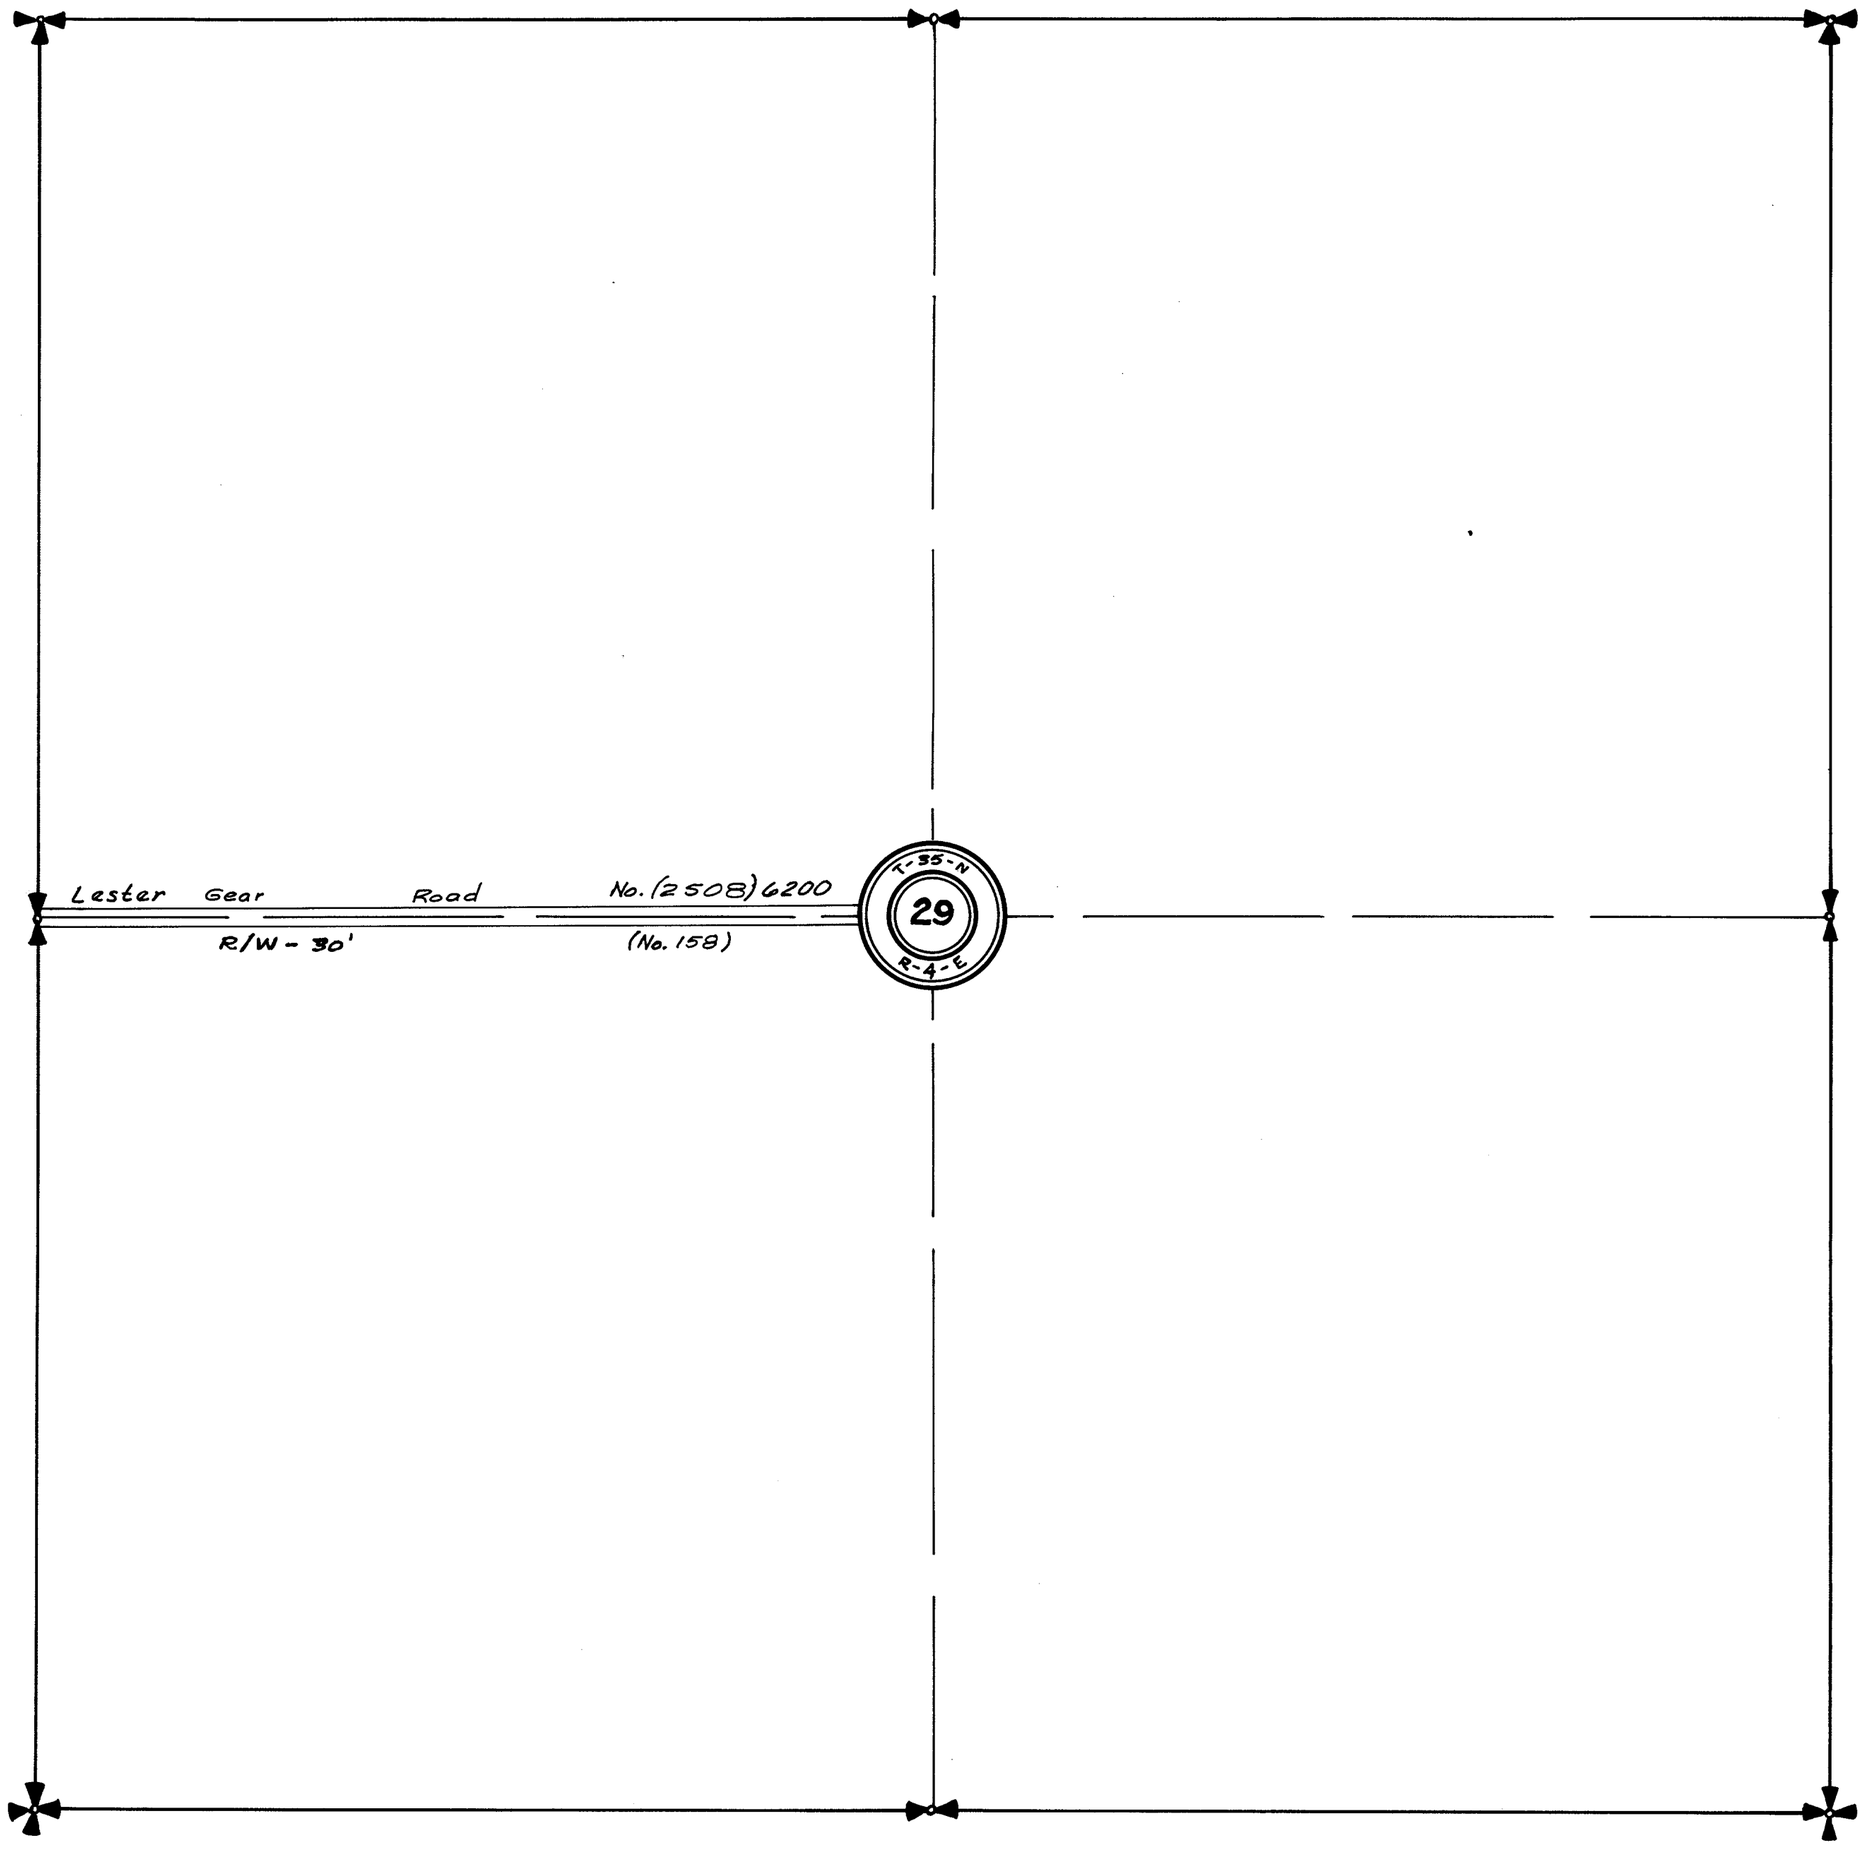

SECTION 30

TOWNSHIP 35 NORTH, RANGE 4 EAST, W. M.

SKAGIT COUNTY, WASH.

Notes 544 - 824

SCALE, 1 INCH--400 FEET

H. O. Walberg COUNTY ENGINEER

N 31898.59
E 39041.95

S88°20'E 2612.7

N 31816.88
E 41653.48

S88°51'E 2633.32

N 31764.03
E 44286.27

176+44.8
43+16.4

234.5'

S42°47'30"E

430.58'

State Hiway

N1°10'30"E 2458.96

2456

N 29240.60
E 38981.47

S88°53'06"E 5278.32

N 29137.93
E 44258.79

143+88.2

Bridge 274

L in Part N0°58'E 2624.45

N0°58'E 2624.45

N0°53'E 2655.0

N 1000.30"E 2729.73

S42°49'30"E

F.G. Subdiv.

N1°47'E 2620.51

N 26587.73
E 38946.54

N 26460.13
E 41554.41

46/600

N 26518.68
E 44177.26

117+33.2

S87°11'30"E 2610.99

N88°41'E 2618.50

367.86

N1°01'E

N 26108.33
E 44179.61

1" pipe
℄ EW ditch

Wilson Road

1½" pipe
℄ EW ditch

(No. 256) - (No. 1008-2008)
R/W - 30 NO. 3300

SECTION 30


TOWNSHIP 35 NORTH, RANGE 4 EAST, W. M.

SKAGIT COUNTY, WASH.

SCALE, 1 INCH--400 FEET

DATE Aug. 1965

_____ COUNTY ENGINEER

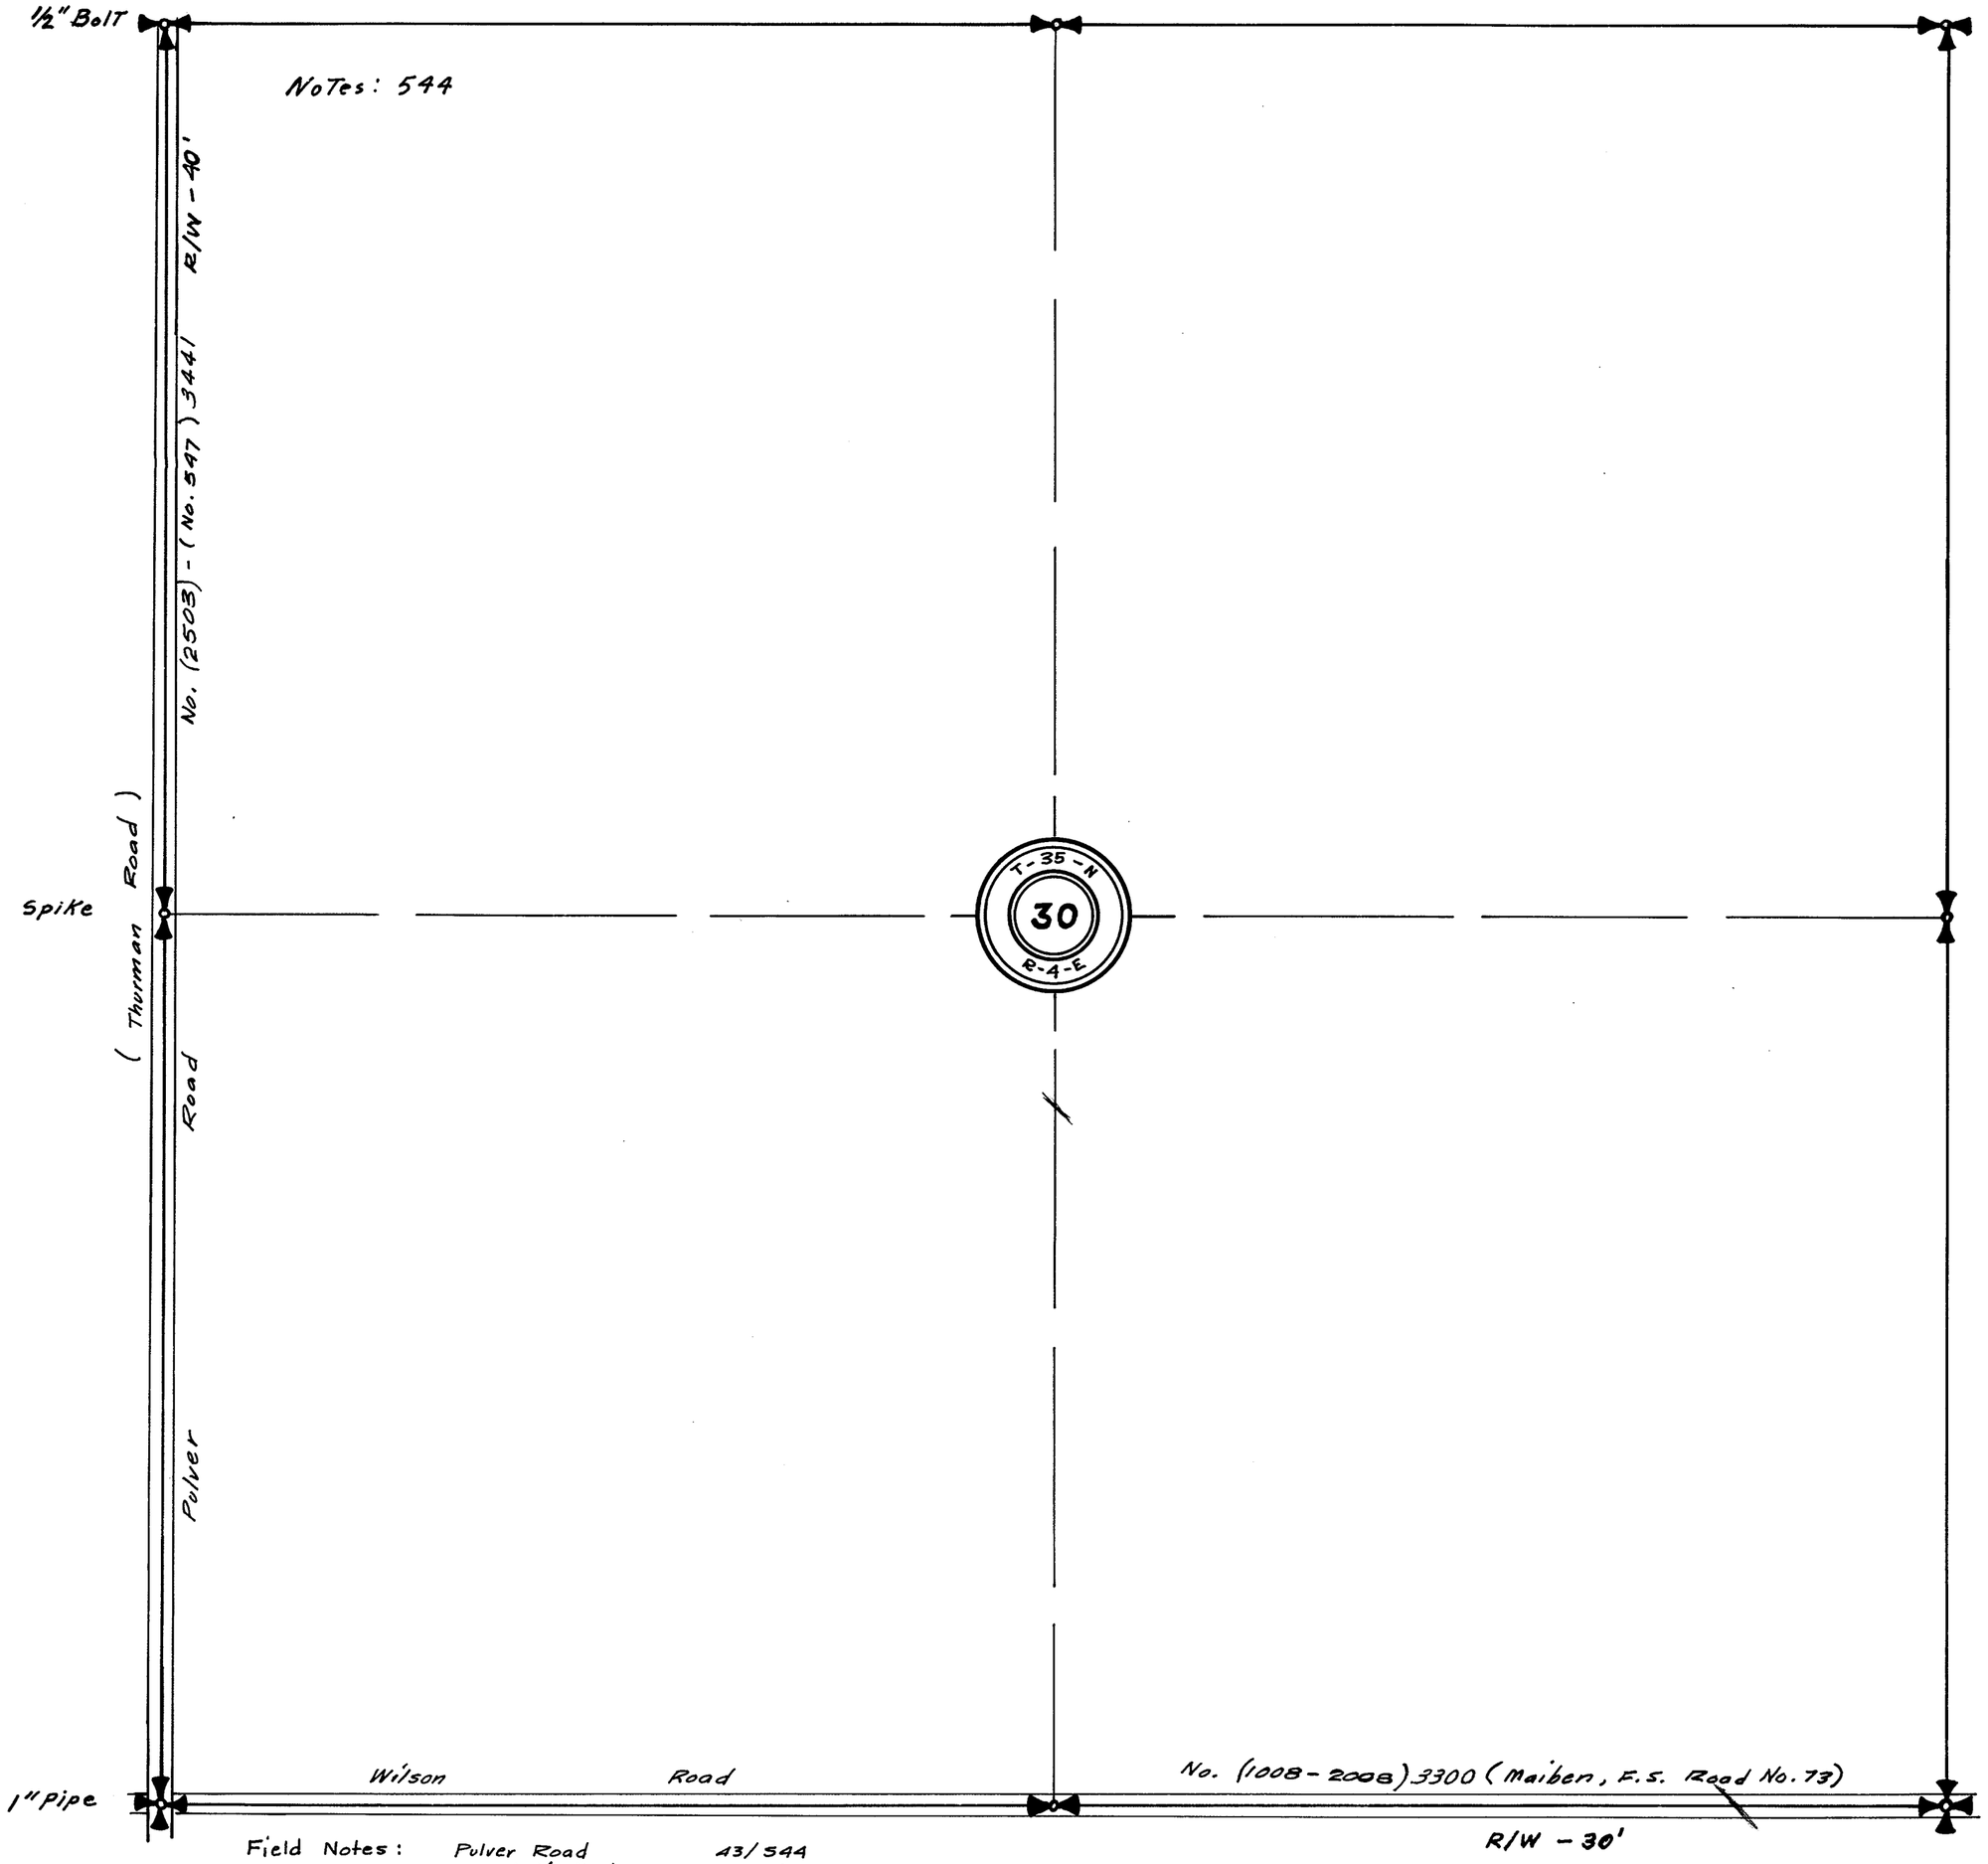

Field Notes:

Pulver Road	43/544		
Naval Airfield Access Road	1944	LL-9	
Alger-Old Colony Road	7/1/31	G-192	


SECTION 30

TOWNSHIP 35 NORTH, RANGE 4 EAST, W. M.

SKAGIT COUNTY, WASH.

SCALE, 1 INCH–400 FEET

_____ COUNTY ENGINEER

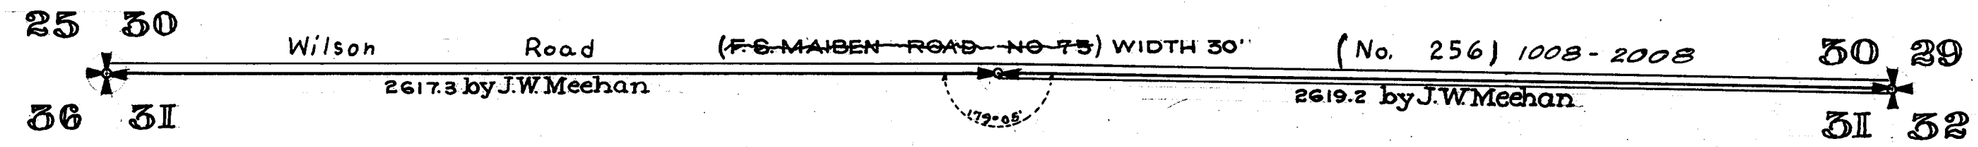

SECTION 31


TOWNSHIP 35 NORTH, RANGE 4 EAST, W. M.

SKAGIT COUNTY, WASH.

SCALE, 1 INCH--400 FEET

DATE Aug. 1965

COUNTY ENGINEER

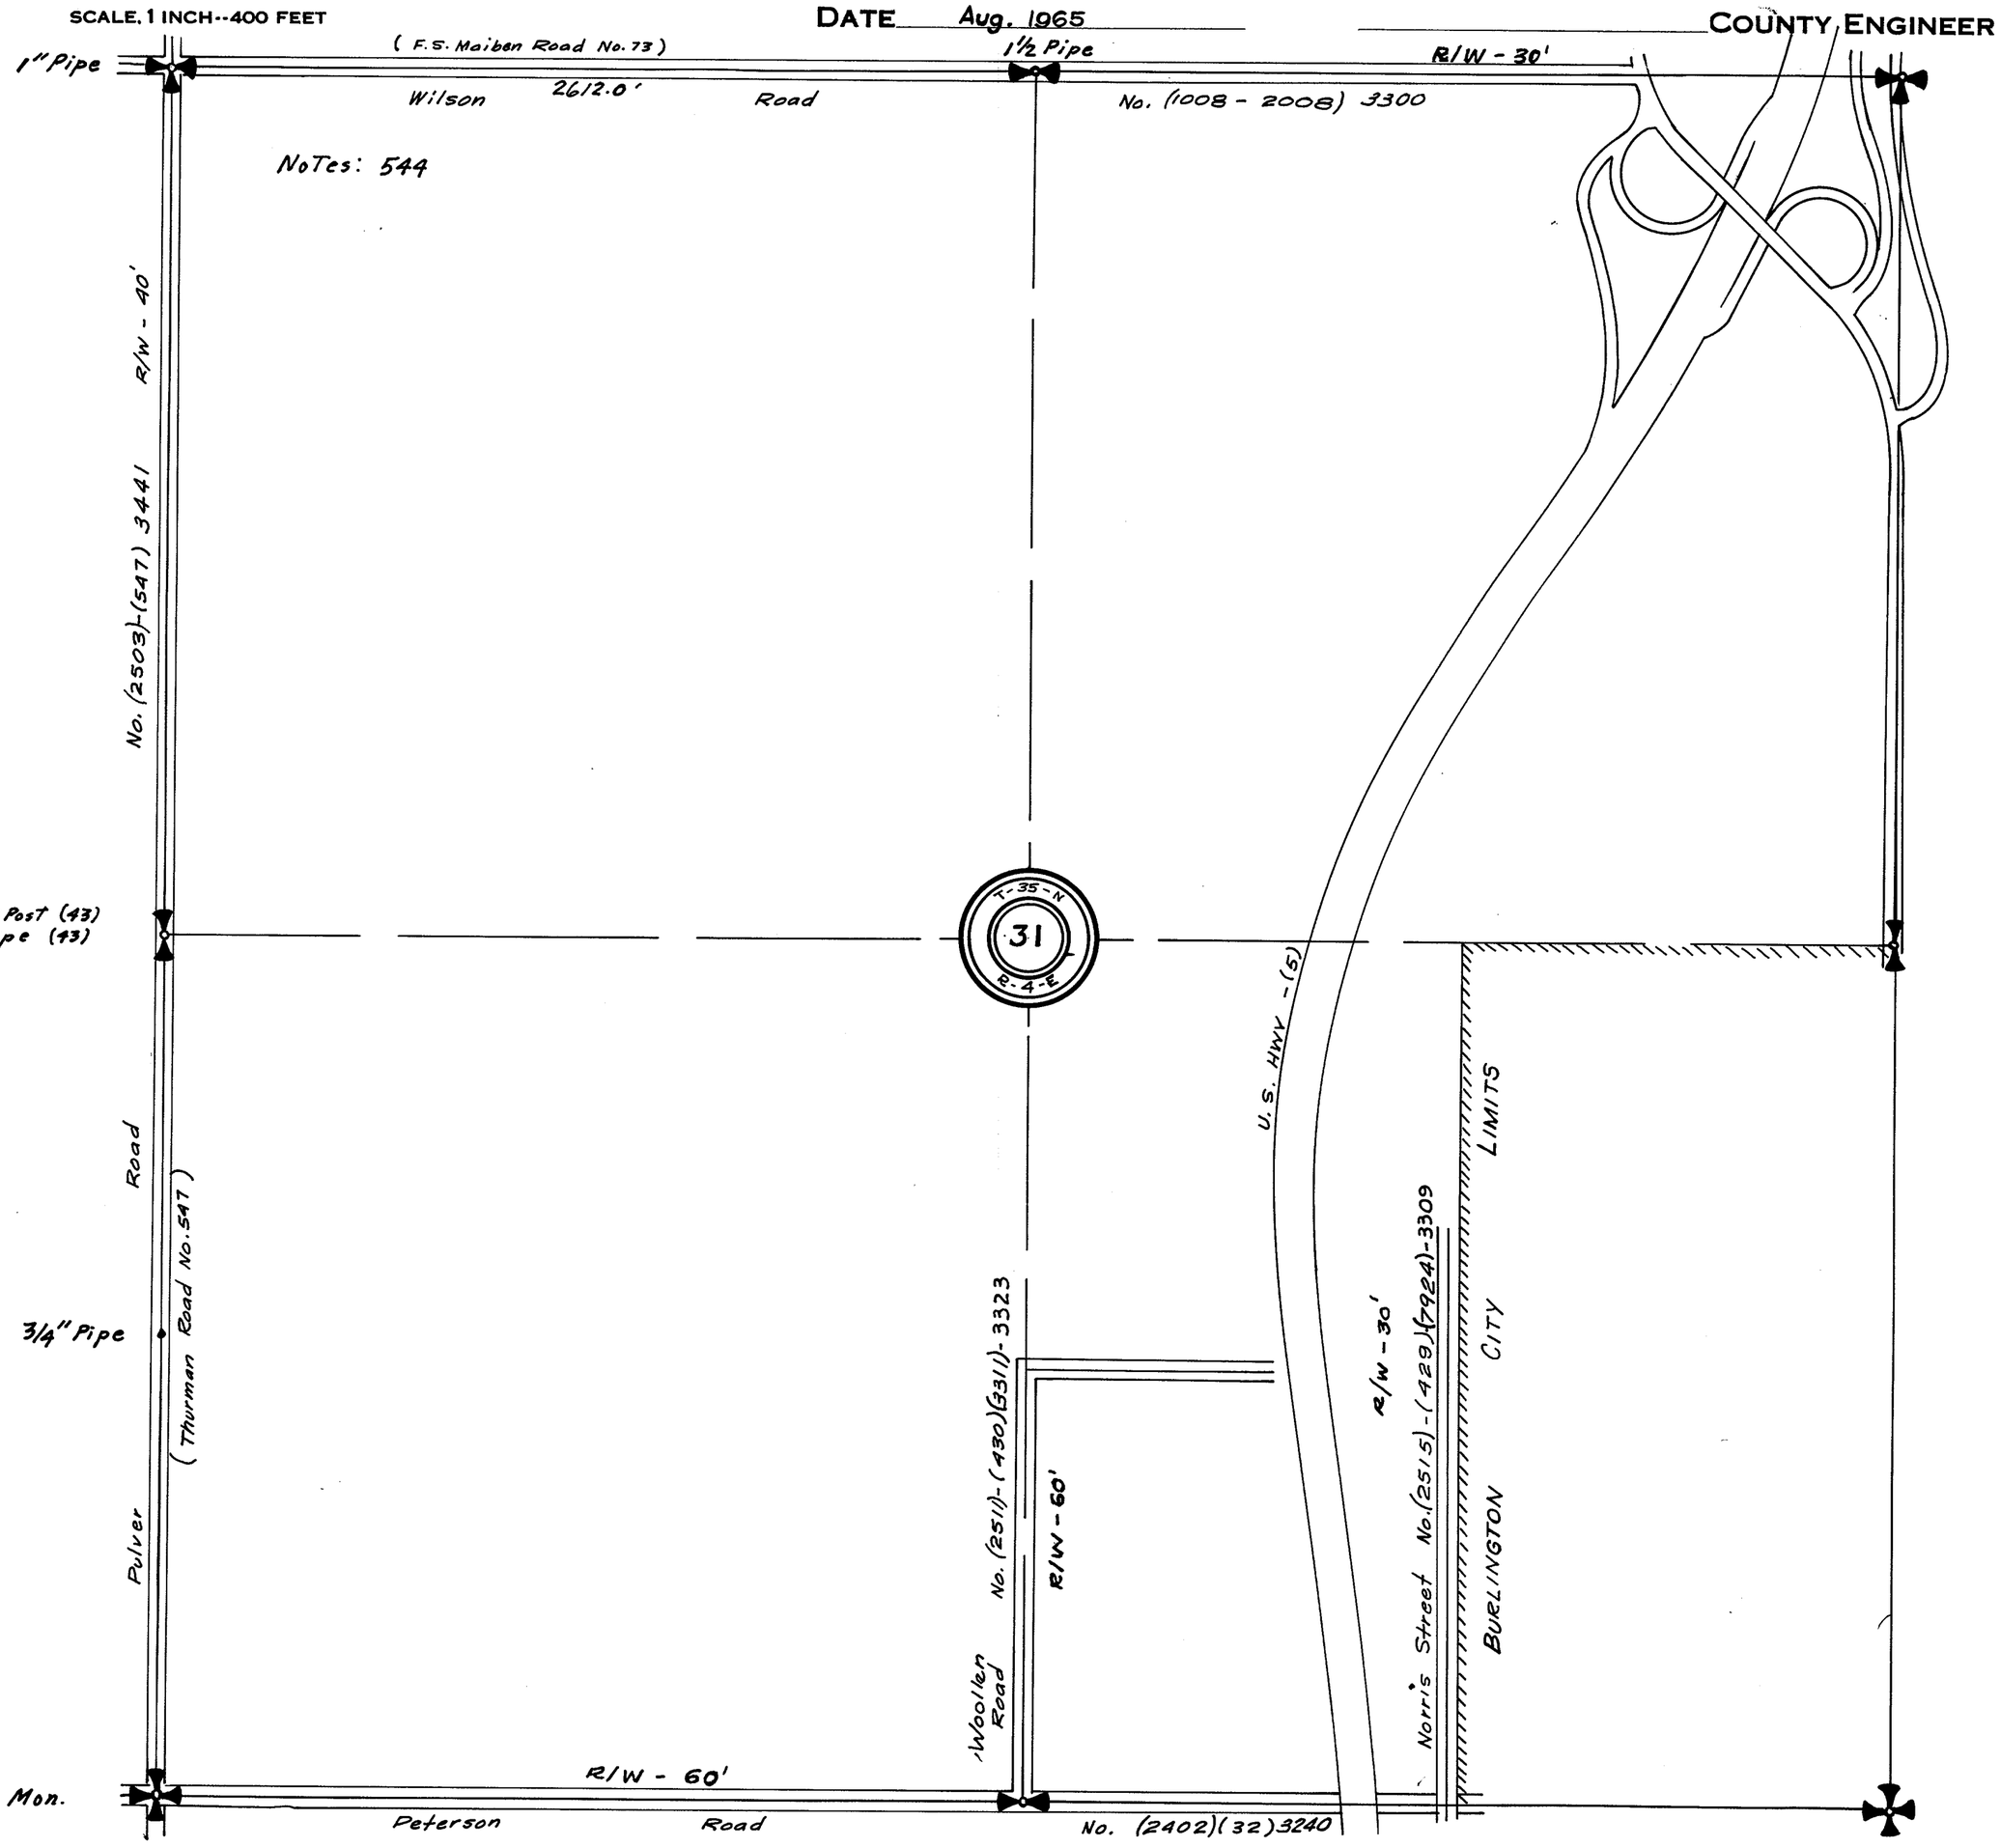

Field Notes: Pulver Road 43/544
Naval Airfied Access Road 1944 LL-9
Norris St. Burl. 10/28/53 852
West Fairhaven St. Burl. 2/15/54 854

SECTION 31


TOWNSHIP 35 NORTH, RANGE 4 EAST, W. M.

SKAGIT COUNTY, WASH.

SCALE, 1 INCH--400 FEET

DATE July, 1959

Frank Gilkey COUNTY ENGINEER

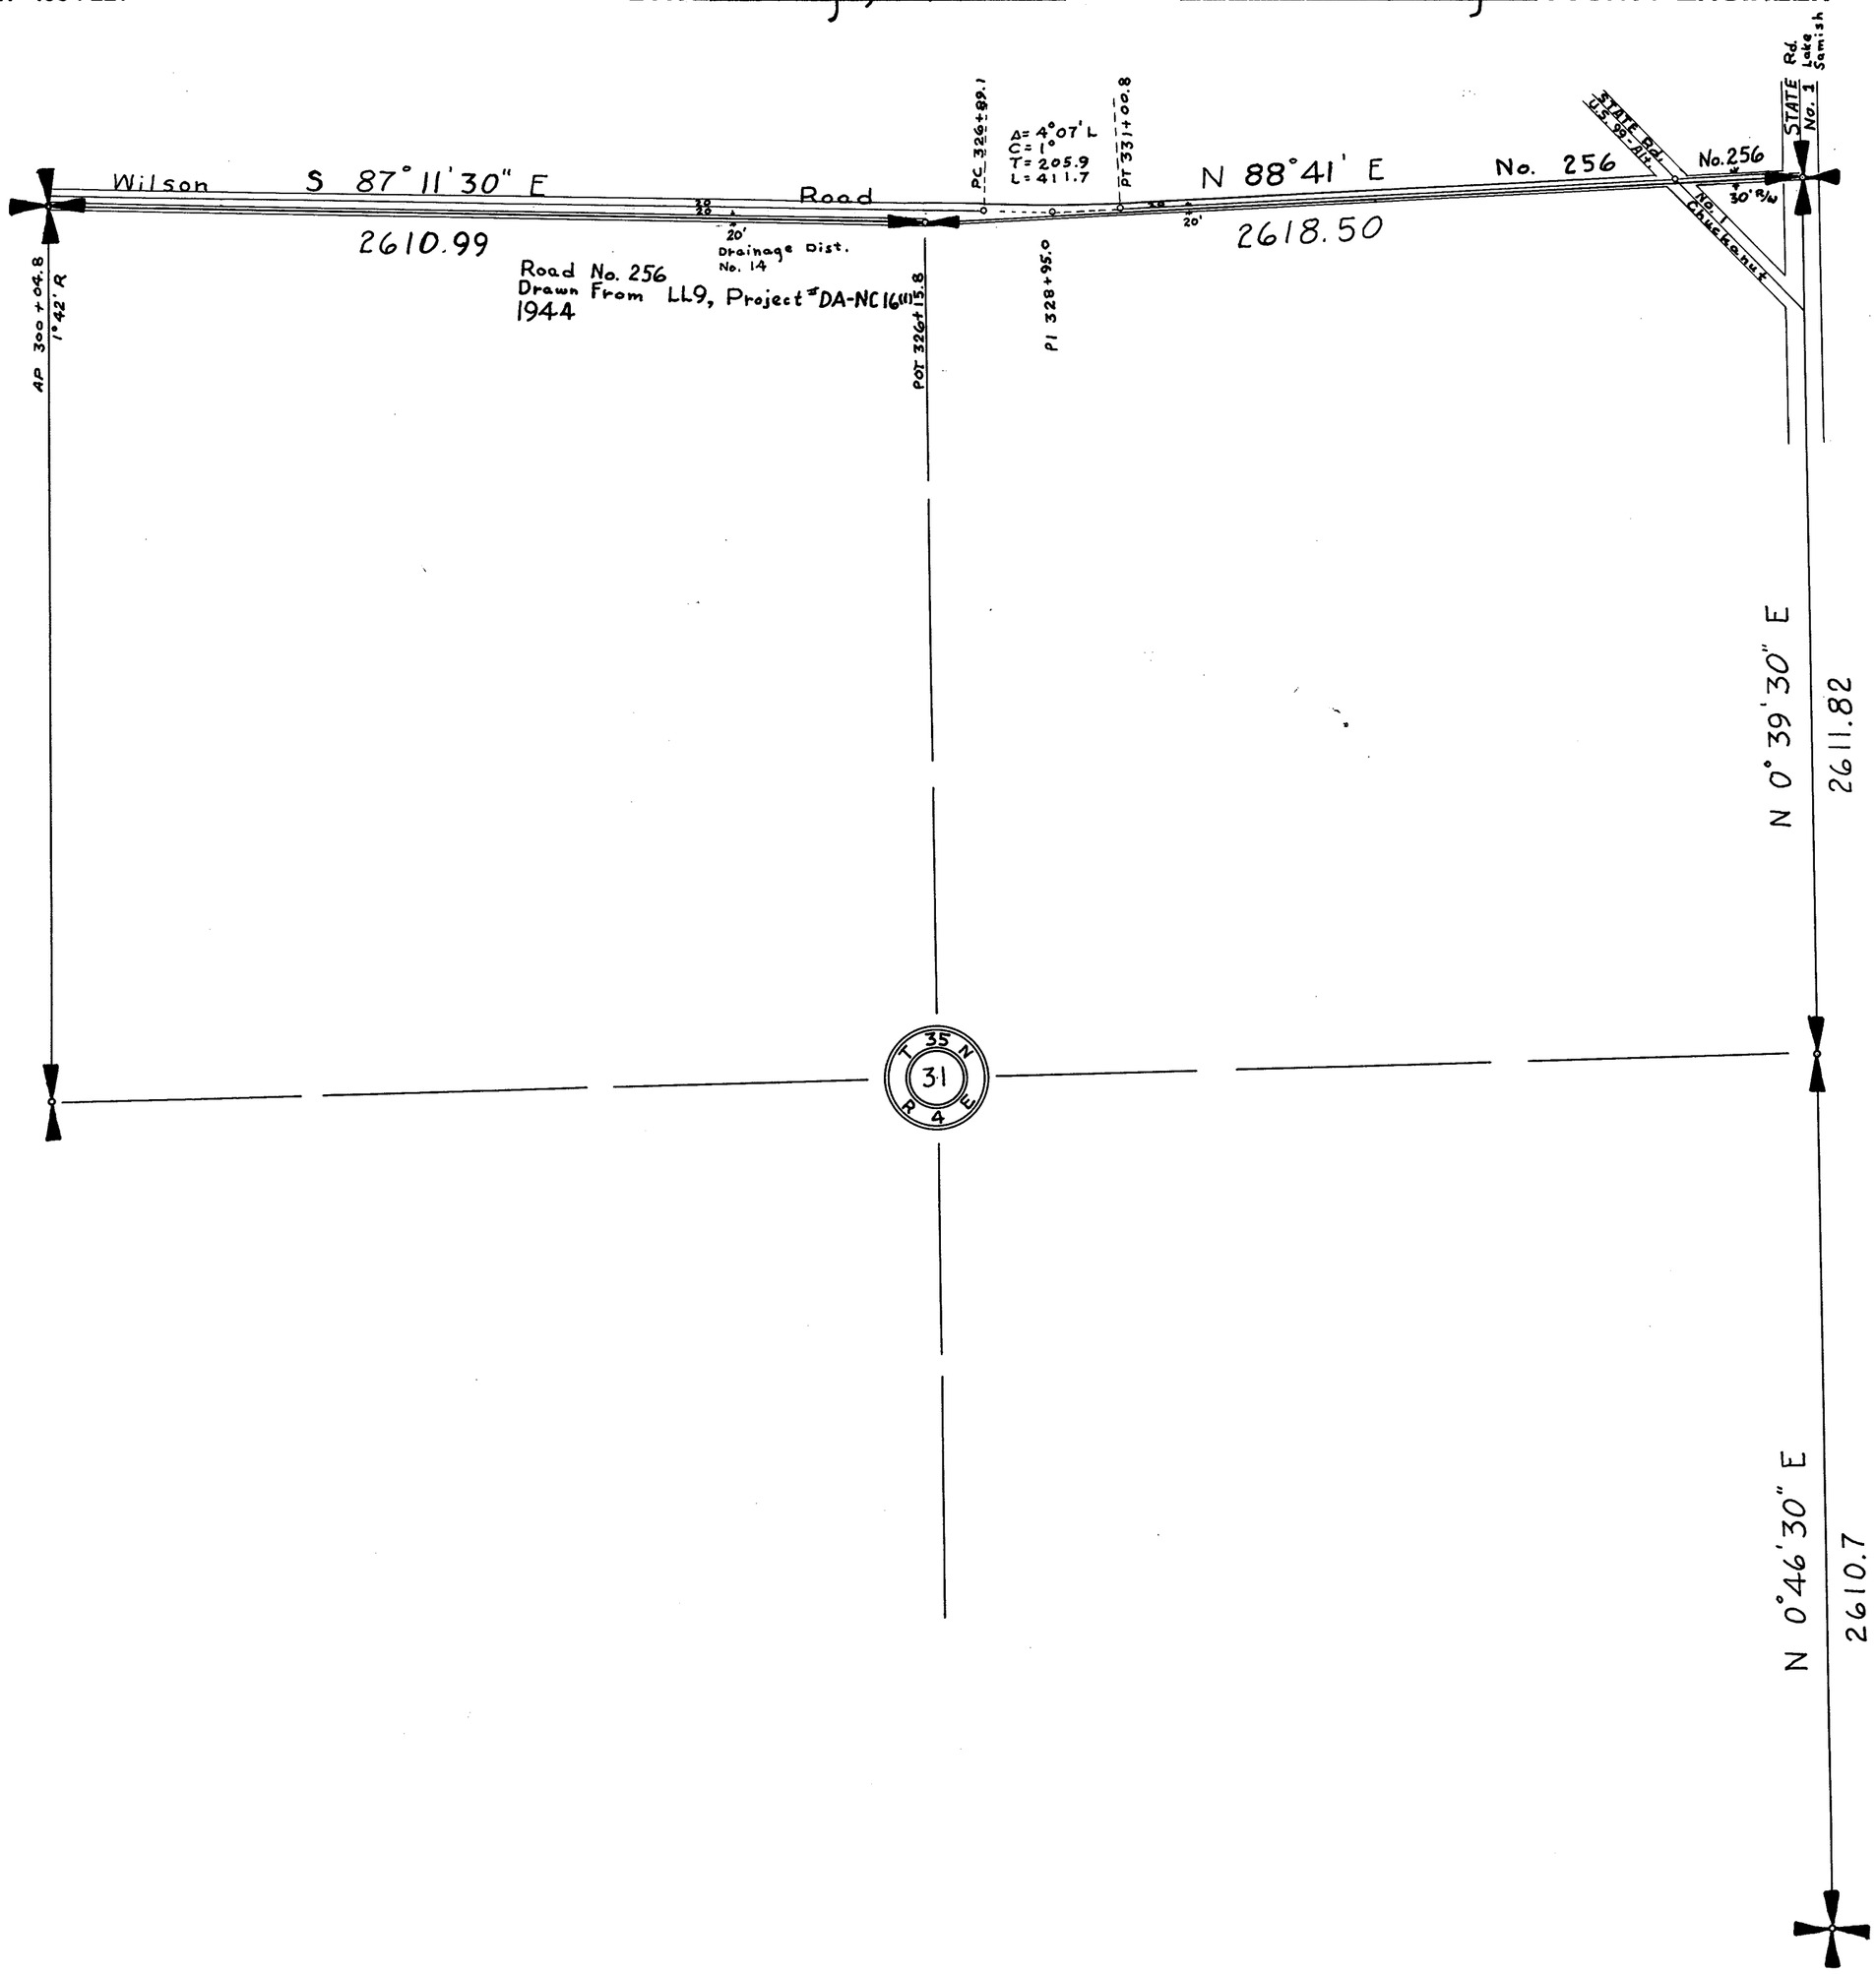

SECTION 32

TOWNSHIP 35 NORTH, RANGE 4 EAST, W. M.


Gilkey & Wright Subdivision

SKAGIT COUNTY, WASH.

SCALE, 1 INCH--400 FEET

DATE Aug. 1965

COUNTY ENGINEER

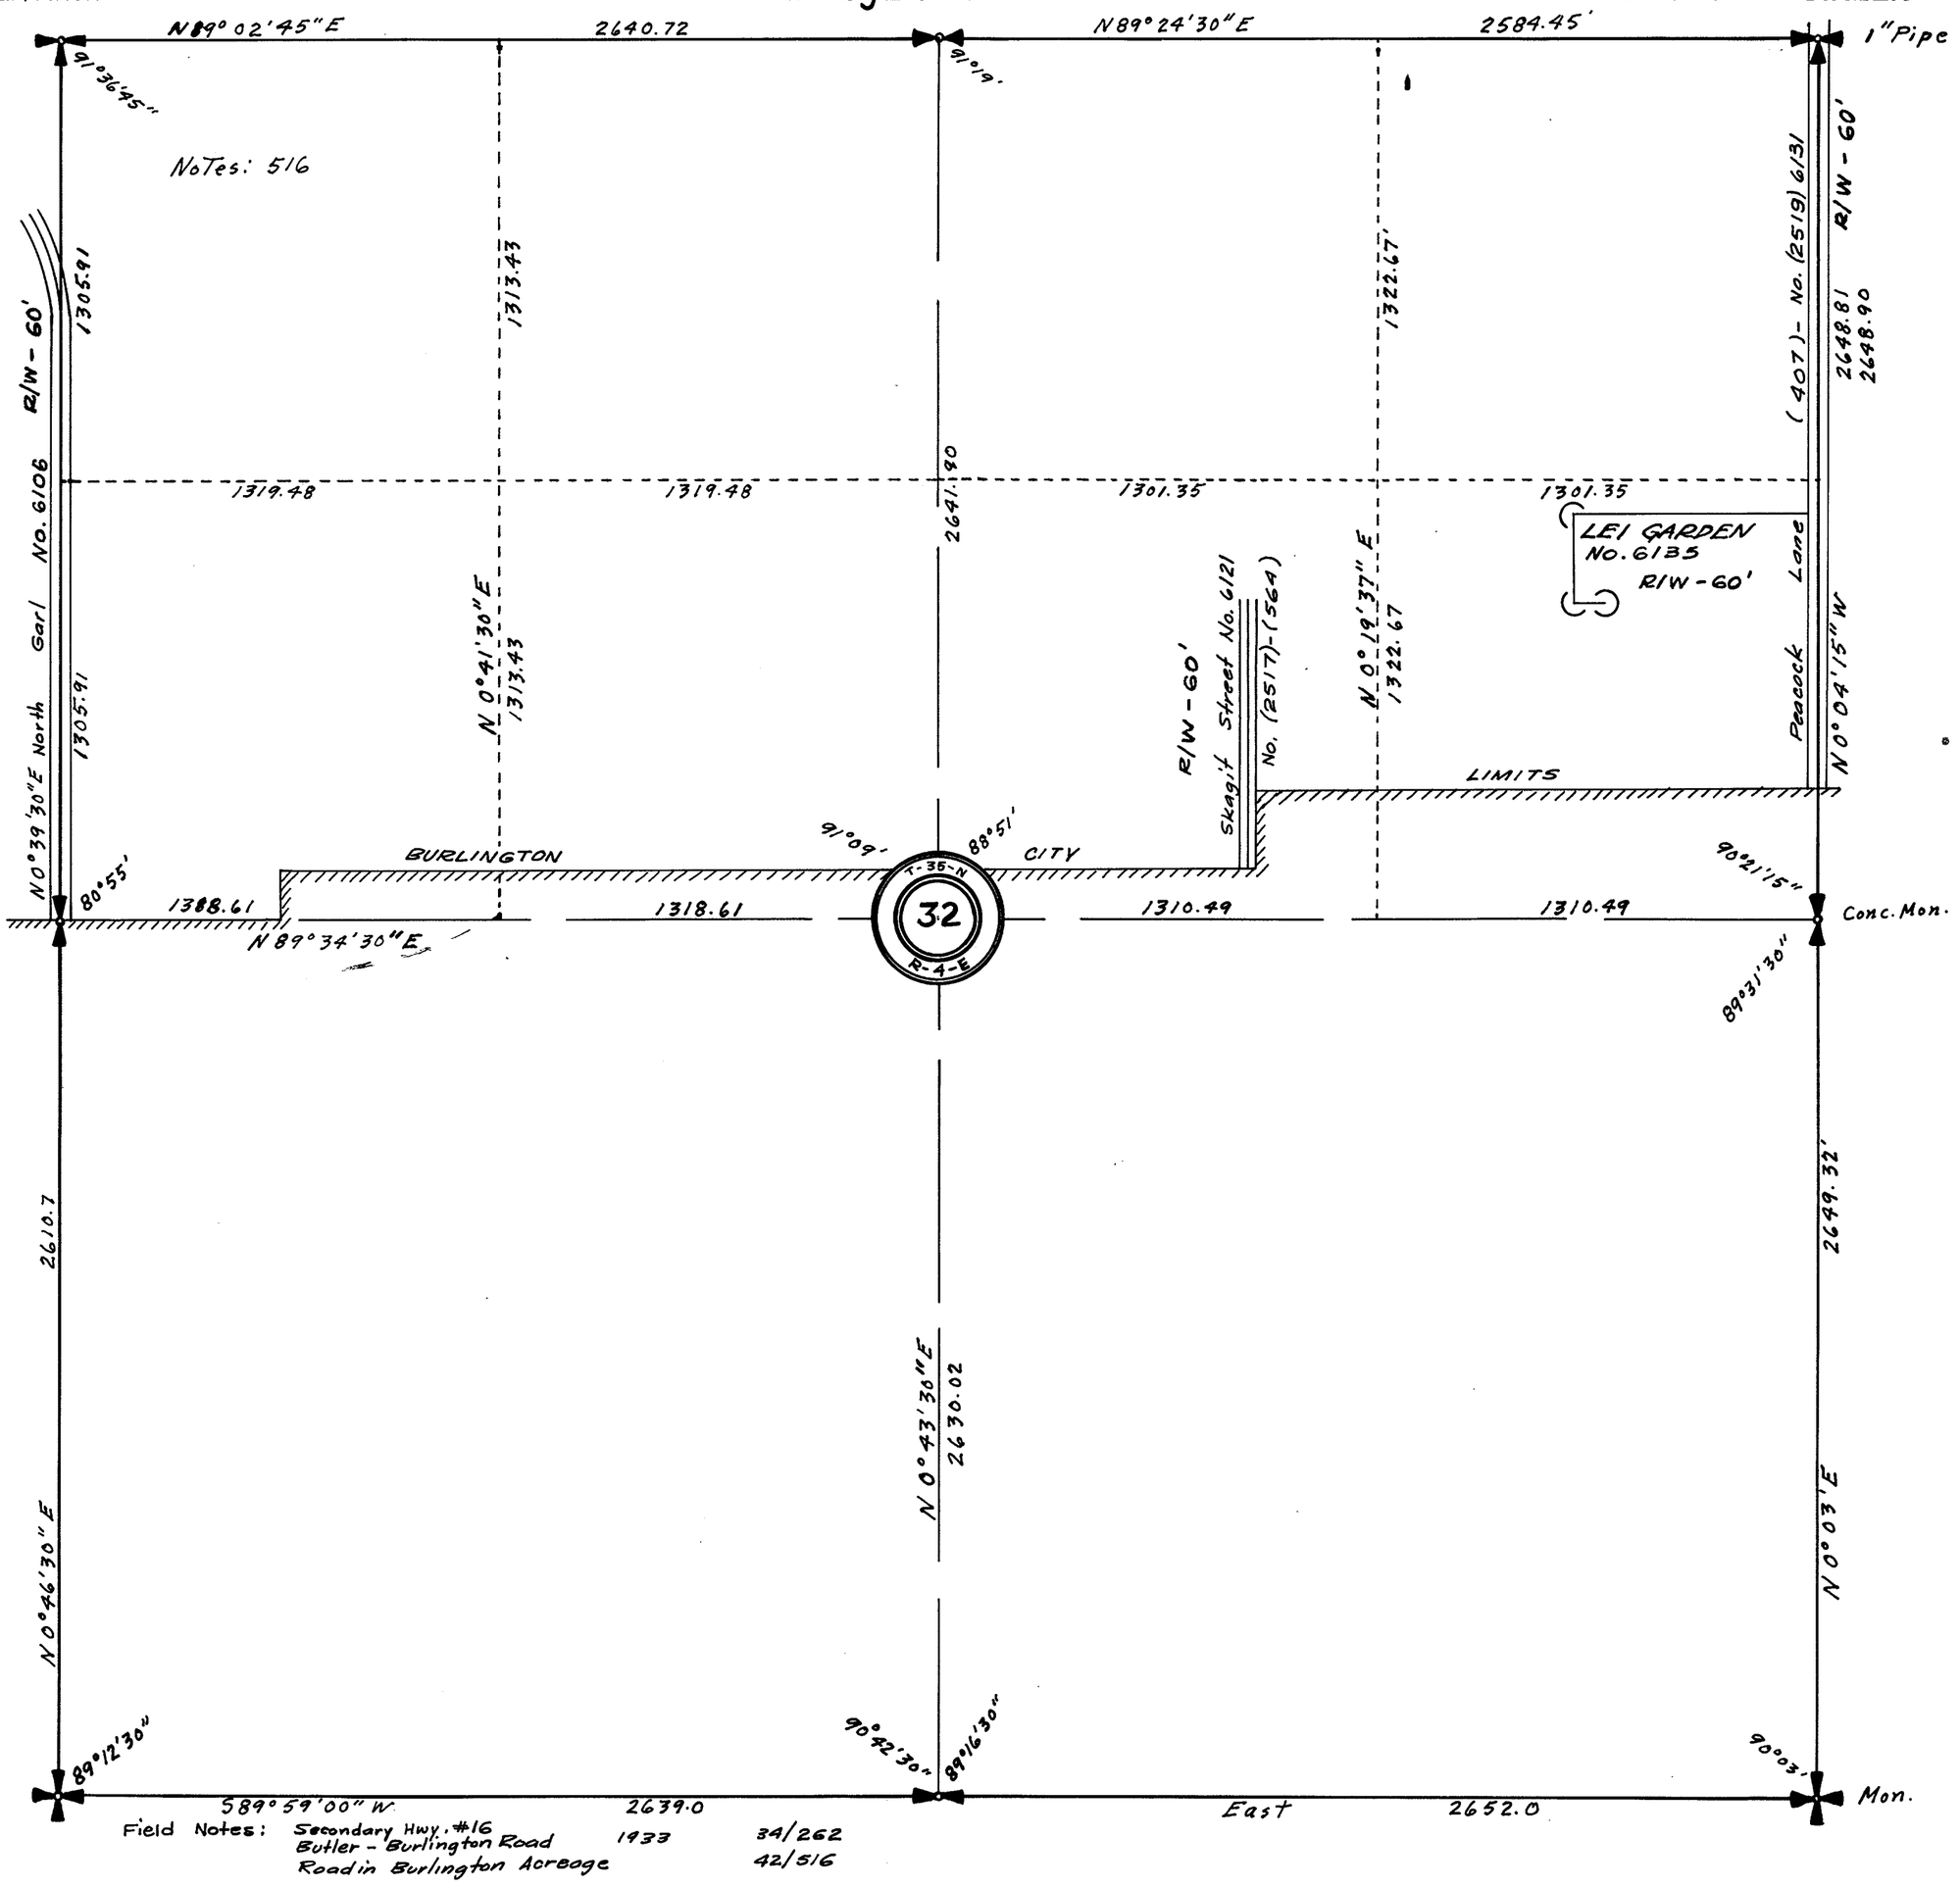

Field Notes: Secondary Hwy. #16 Butler - Burlington Road 1933 34/262
Road in Burlington Acreage 42/516

SECTION 32


TOWNSHIP 35 NORTH, RANGE 4 EAST, W. M.

SKAGIT COUNTY, WASH.

SCALE, 1 INCH--400 FEET

Subdiv. by Gilkey & Wright

H.O. Walberg COUNTY ENGINEER

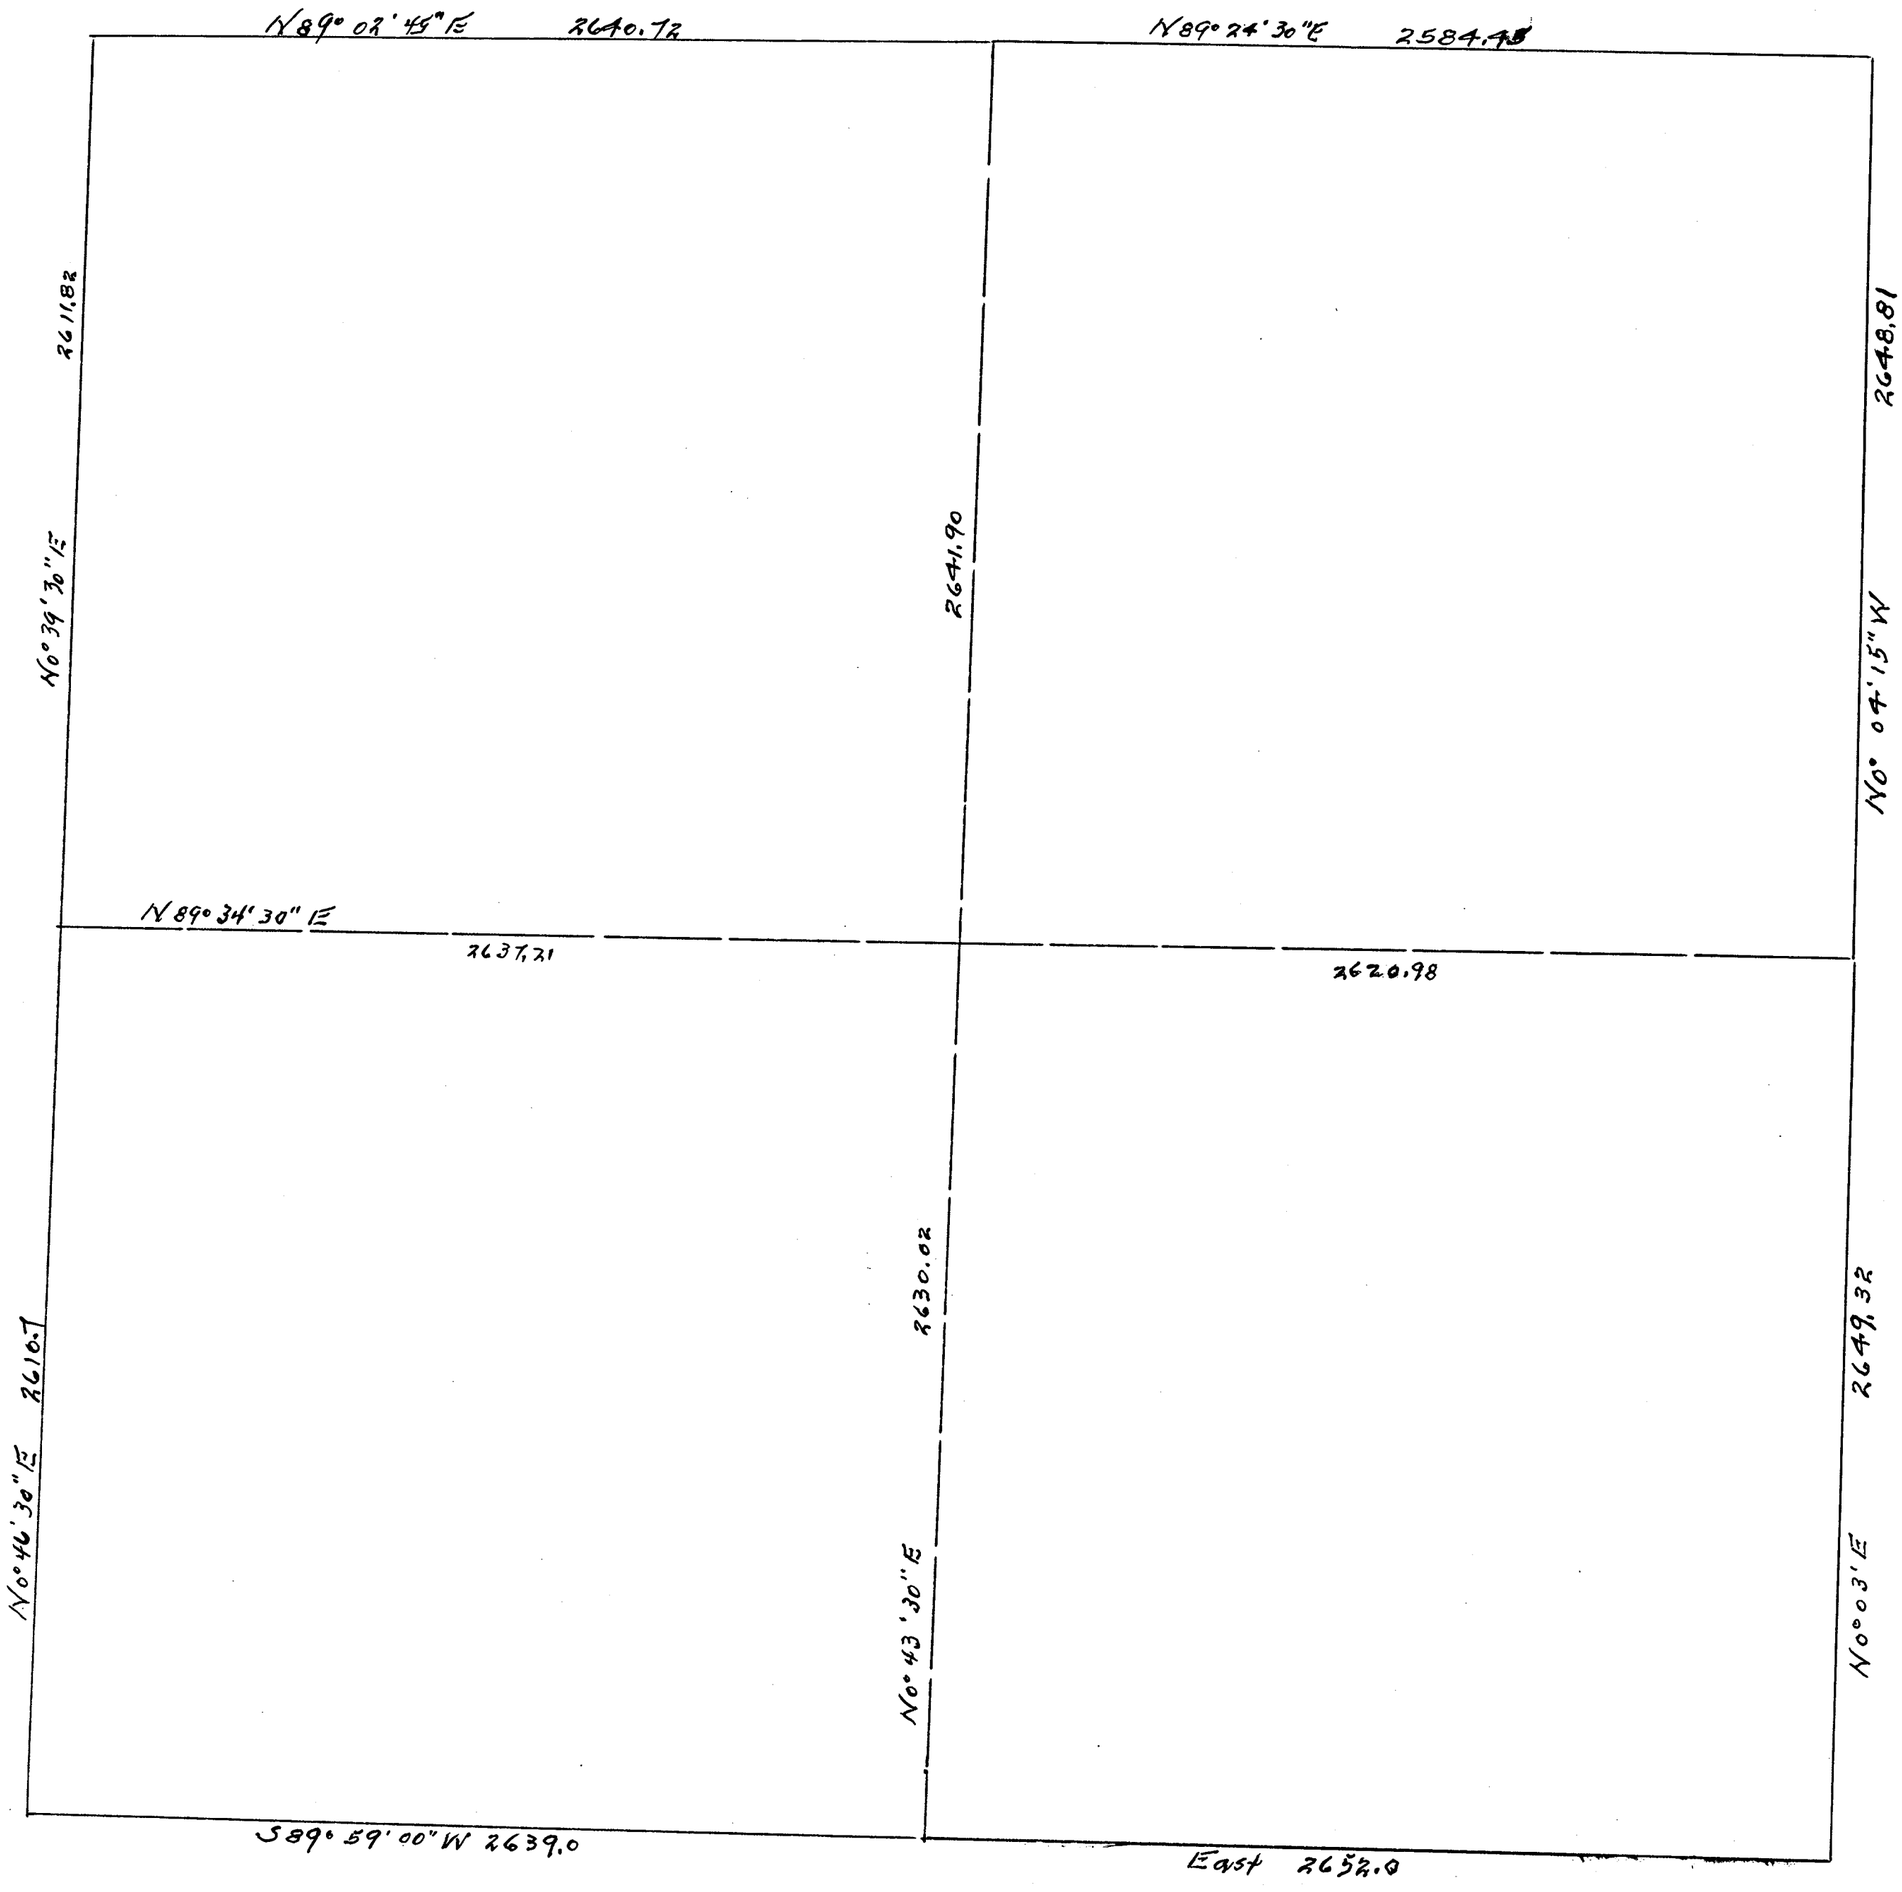


SECTION 32

TOWNSHIP 35 NORTH, RANGE 4 EAST, W. M.

SKAGIT COUNTY, WASH.

SCALE, 1 INCH--400 FEET
OCTOBER - 1941
NOTES: 38/365

H.O. WALBERG COUNTY ENGINEER

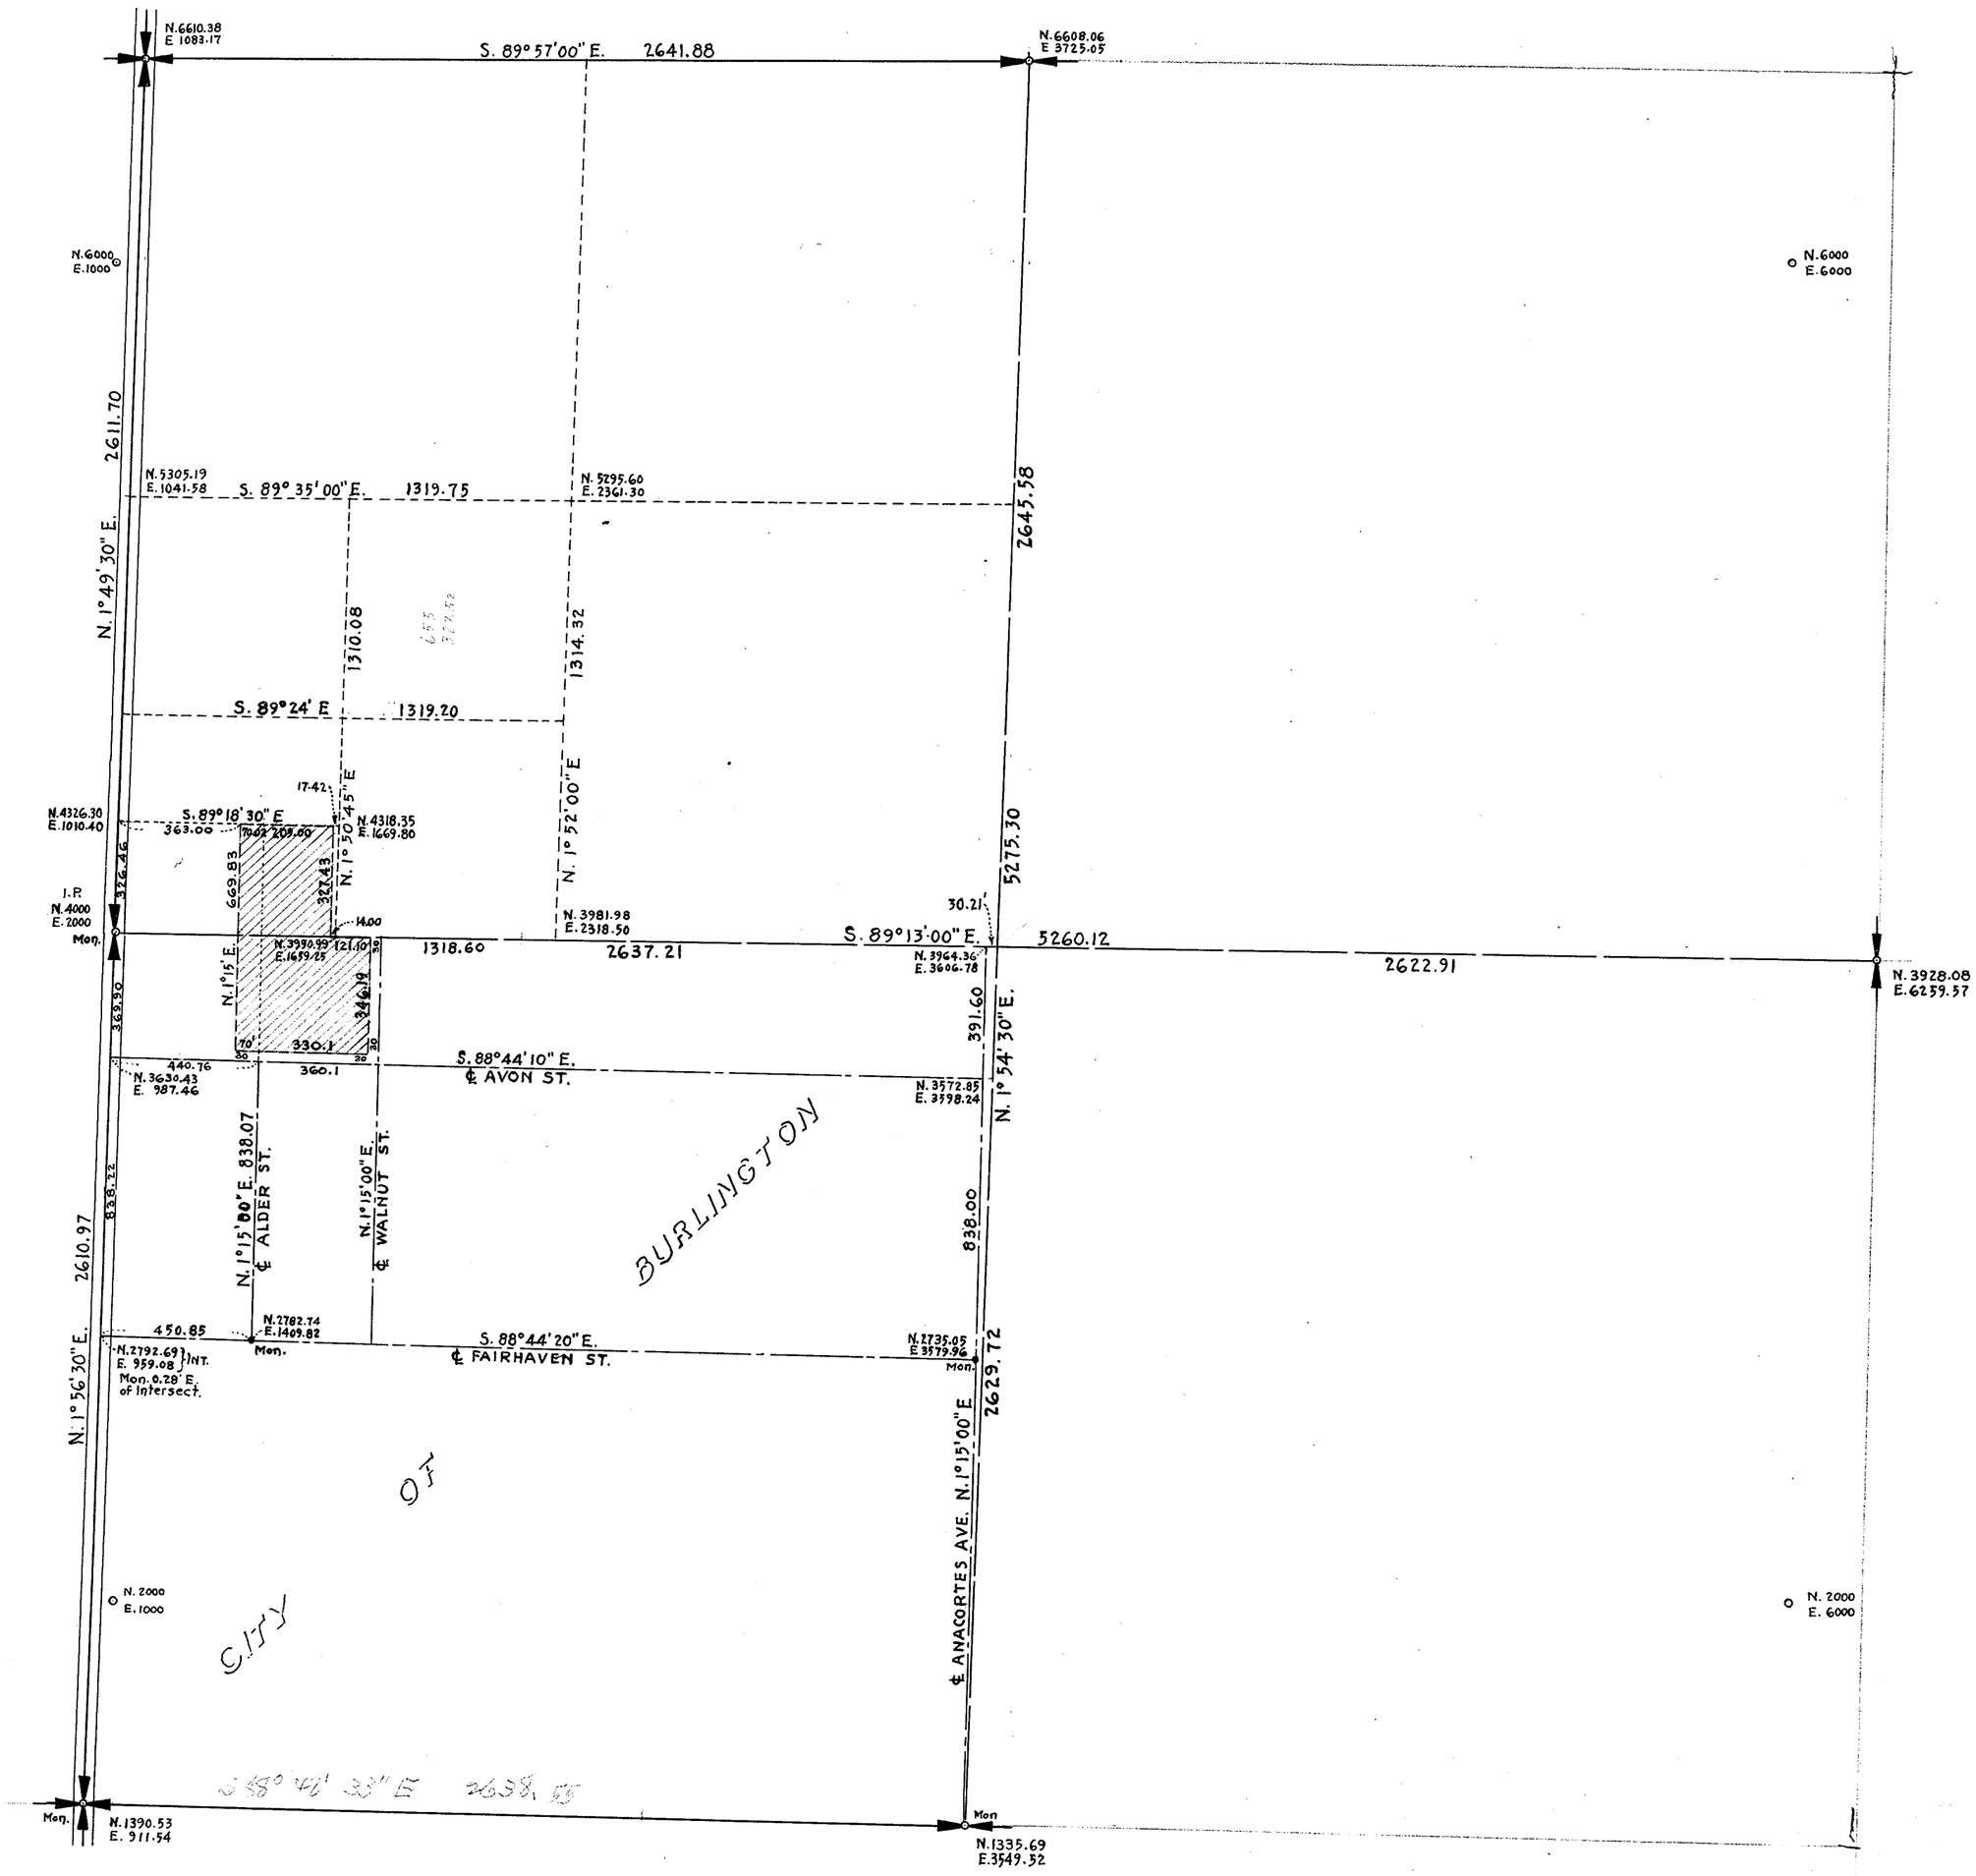


SECTION 33

TOWNSHIP 35 NORTH, RANGE 4 EAST, W. M.

SKAGIT COUNTY, WASH.

SCALE, 1 INCH--400 FEET

DATE August, 1959 Frank Gilkey COUNTY ENGINEER

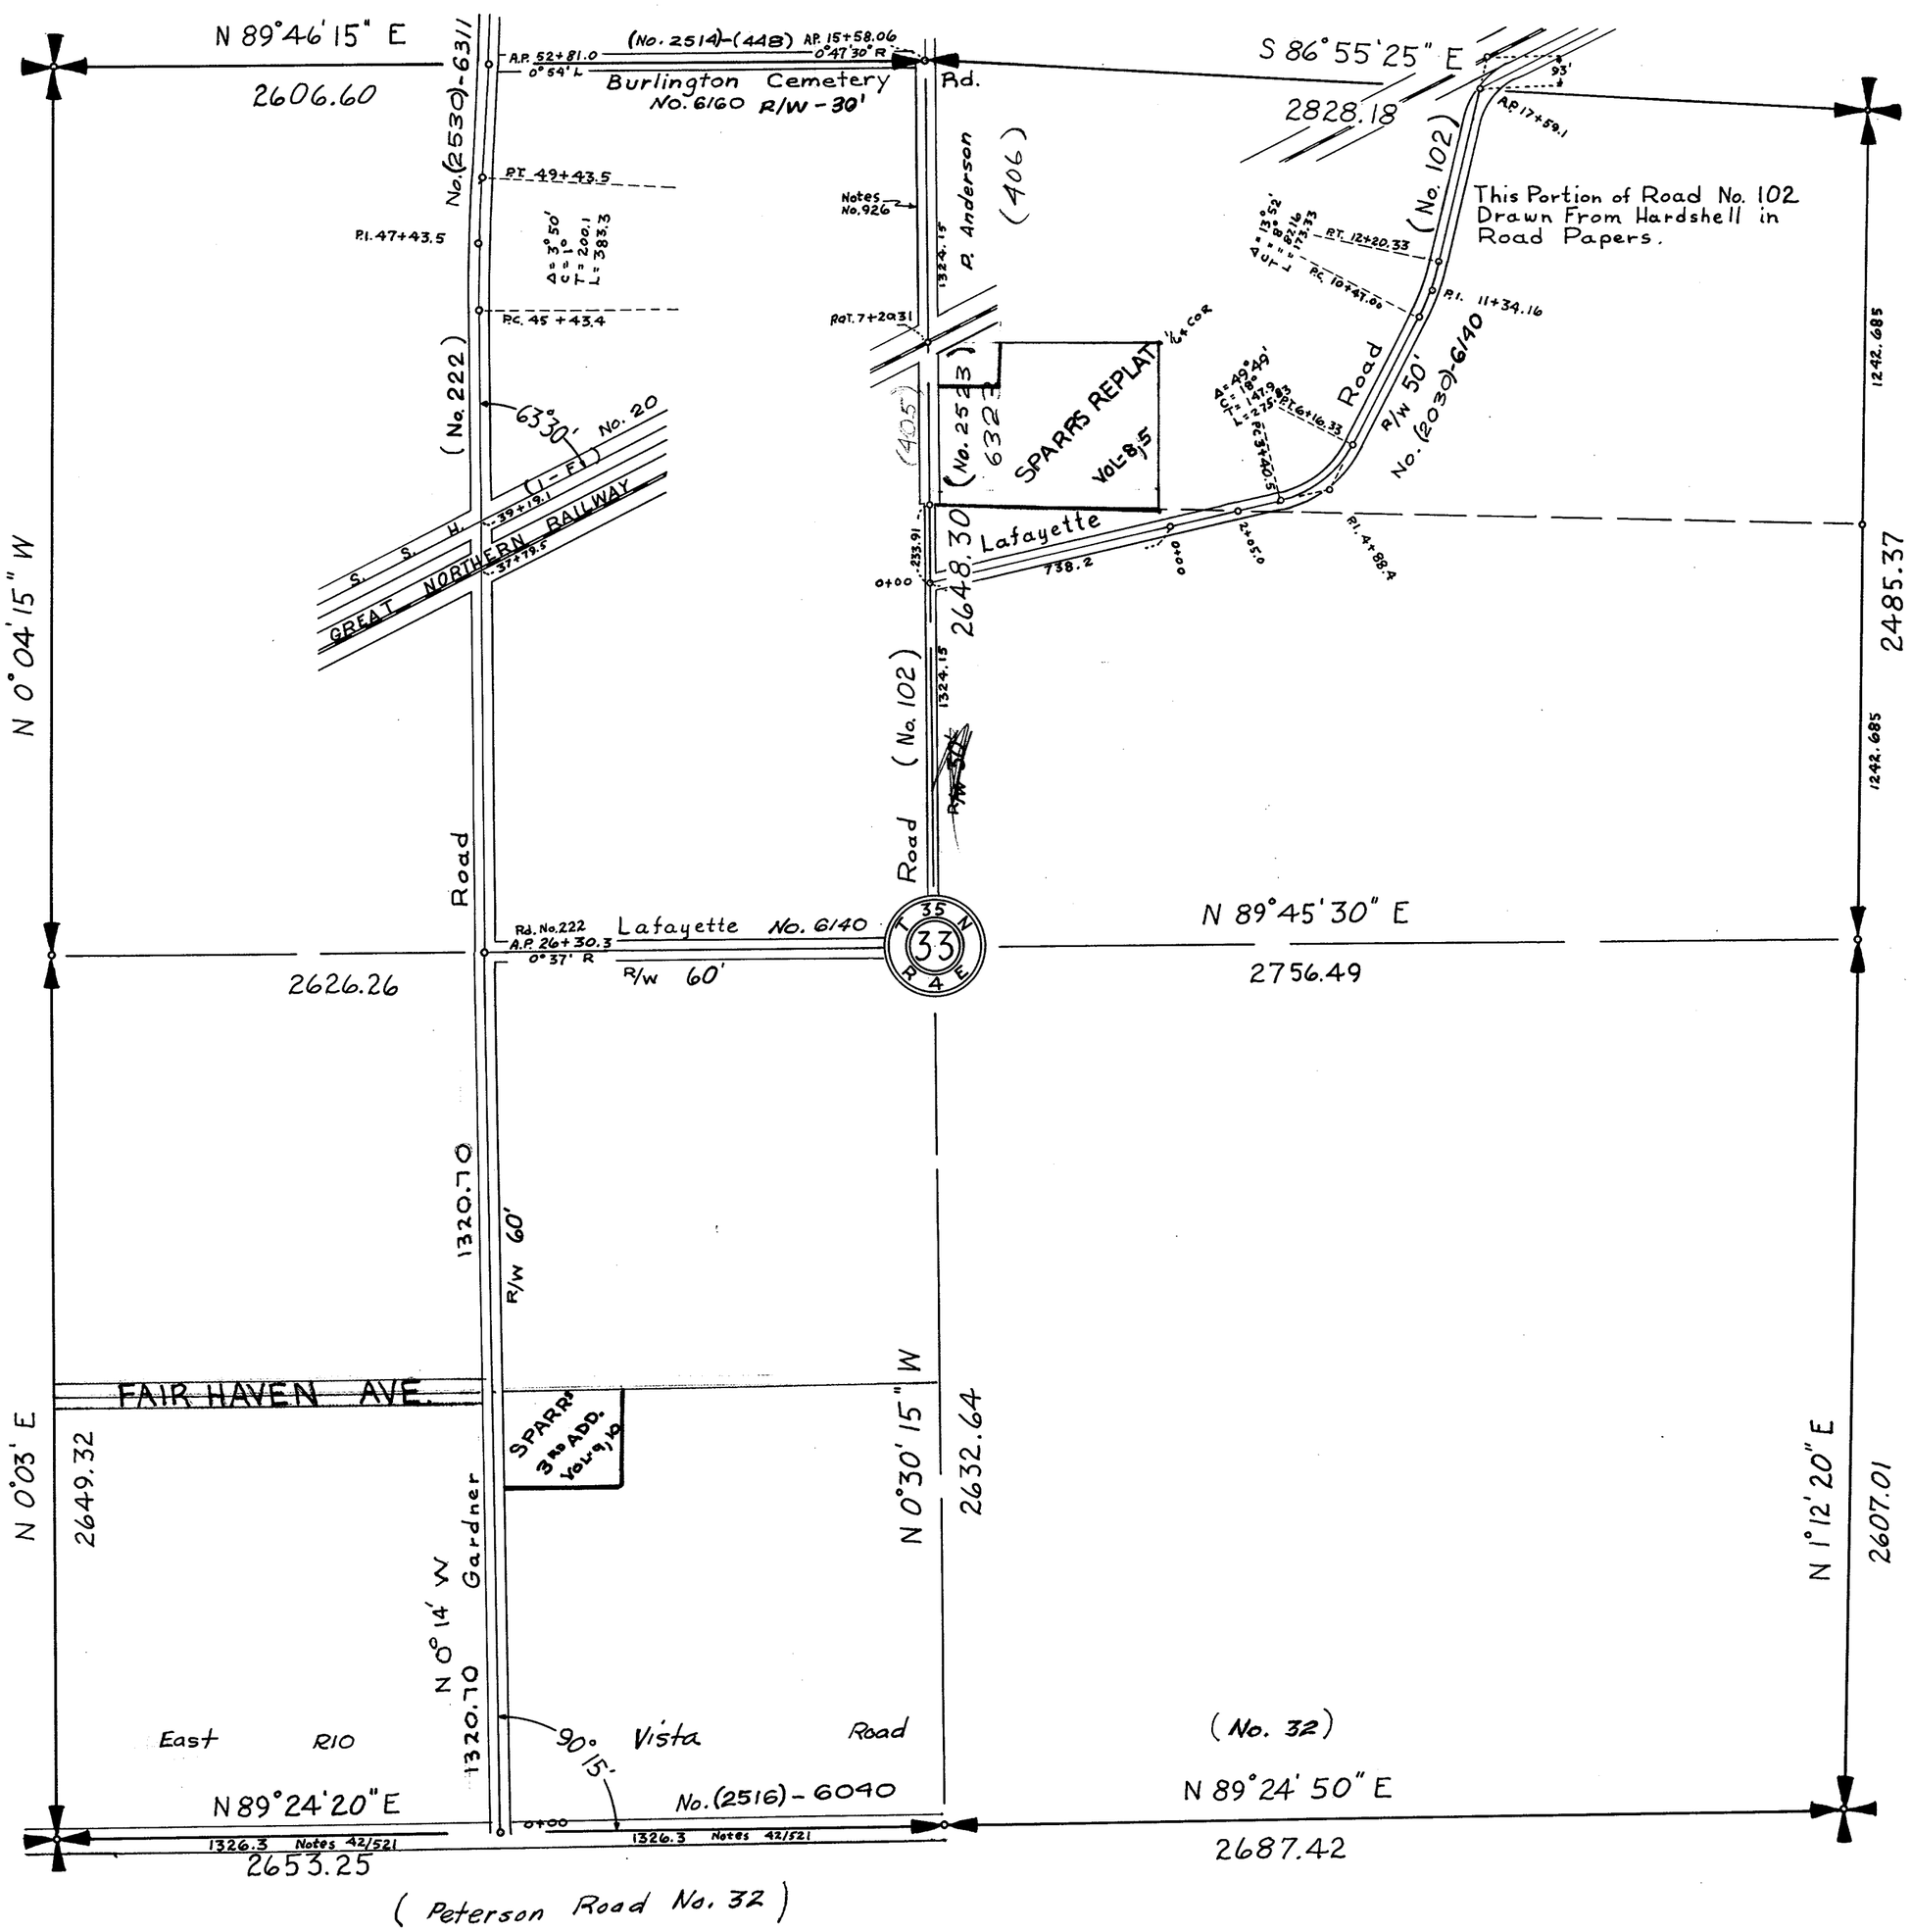


SECTION 33

TOWNSHIP 35 NORTH, RANGE 4 EAST, W. M.

SKAGIT COUNTY, WASH.

SCALE, 1 INCH--400 FEET

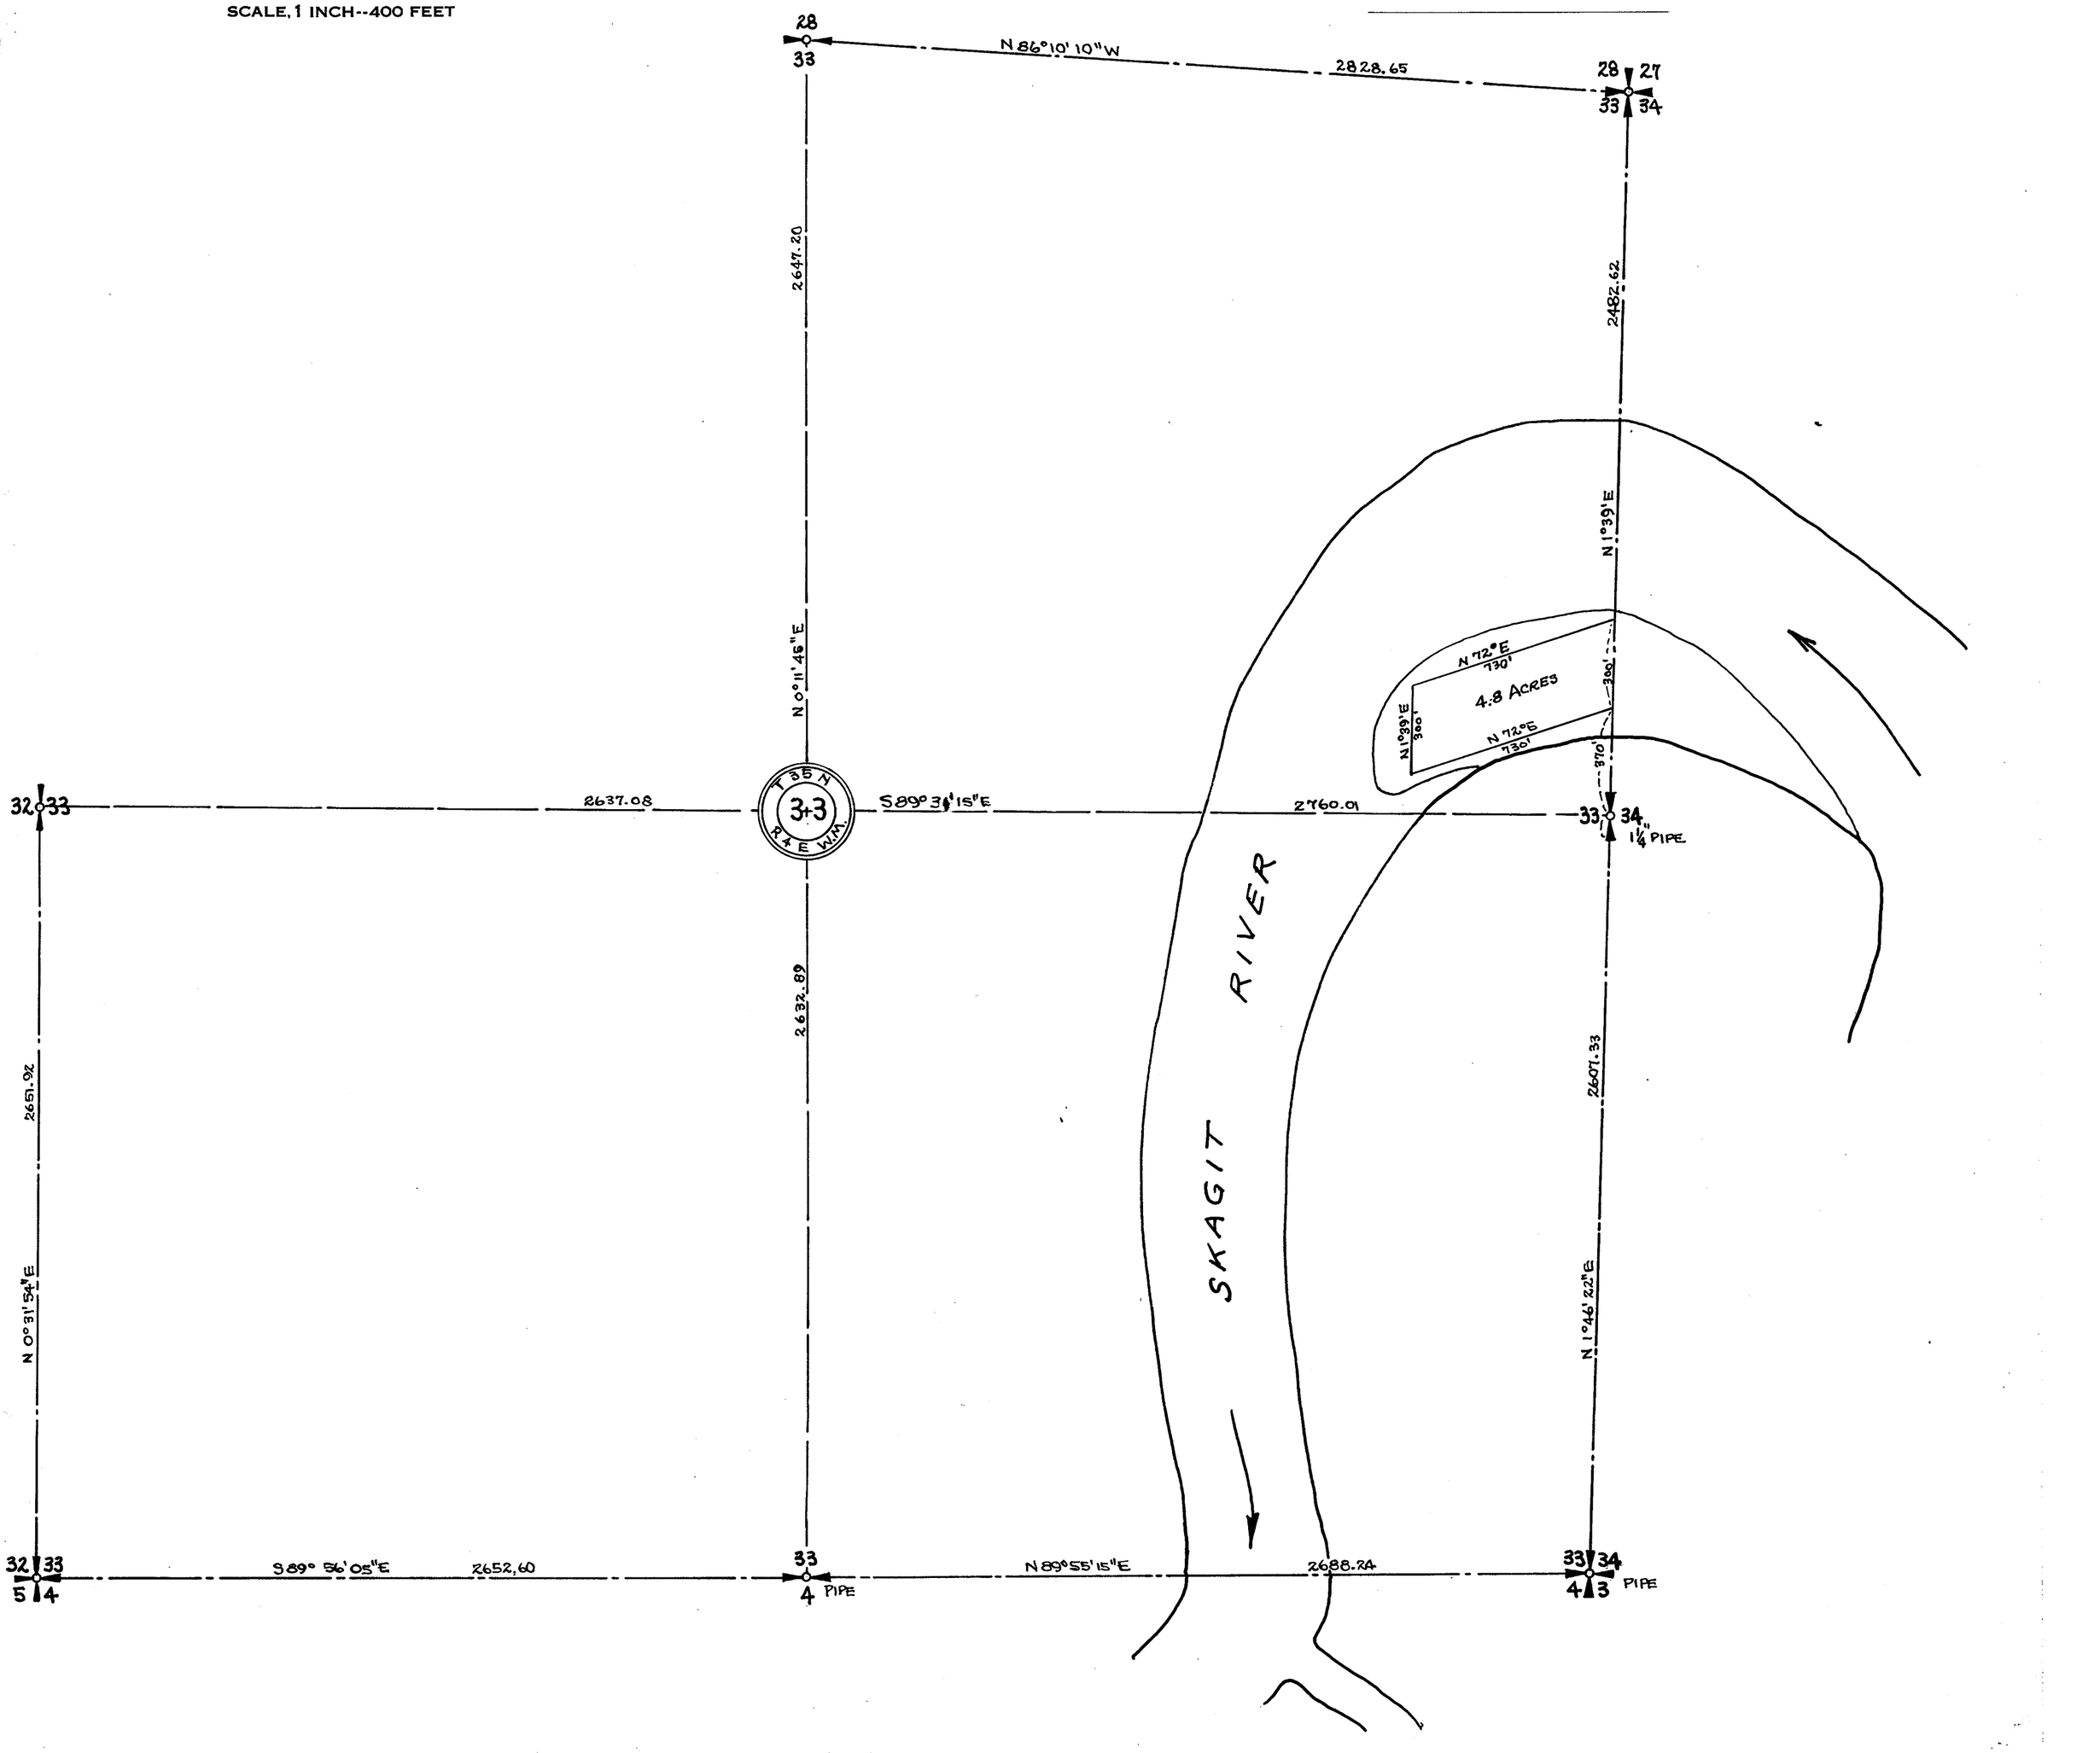

SECTION 33


TOWNSHIP 35 NORTH, RANGE 4 EAST, W. M.

SKAGIT COUNTY, WASH.

Gilkey & Wright Subd.

SCALE, 1 INCH--400 FEET

_____ COUNTY ENGINEER

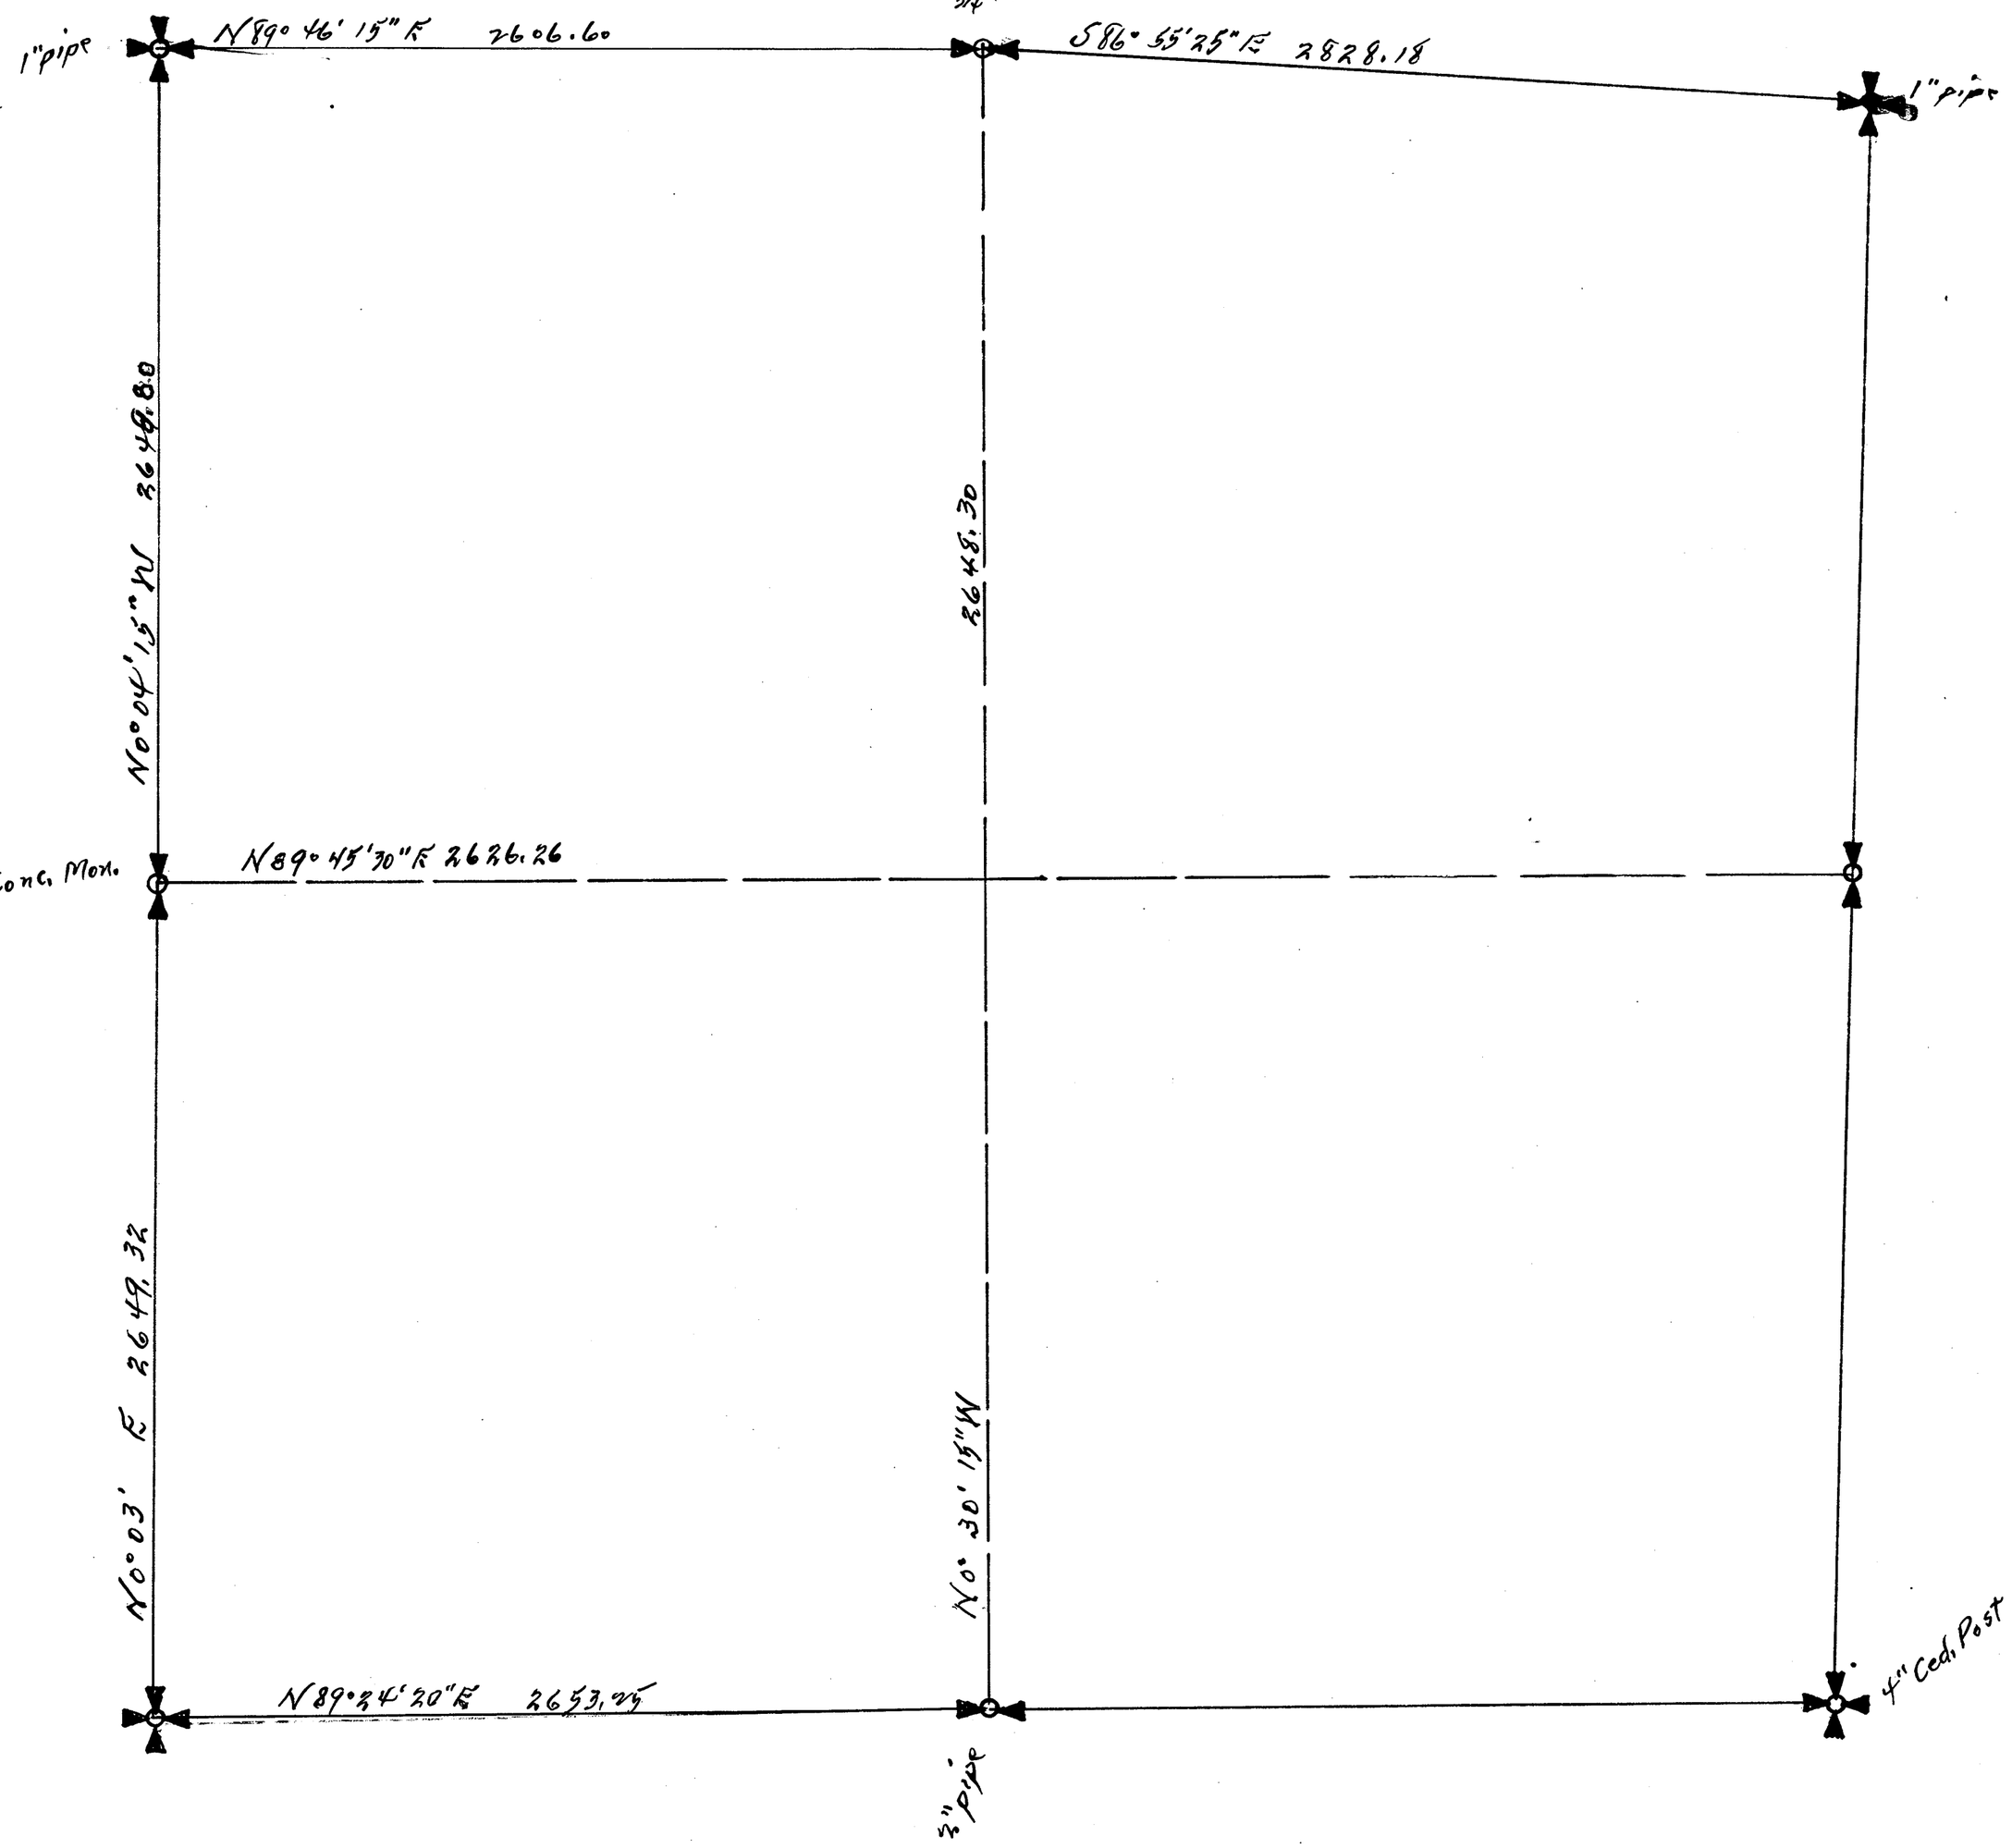

SECTION 34


TOWNSHIP 35 NORTH, RANGE 4 EAST, W. M.

SKAGIT COUNTY, WASH.

SCALE, 1 INCH--400 FEET

DATE Aug. 1965

COUNTY ENGINEER

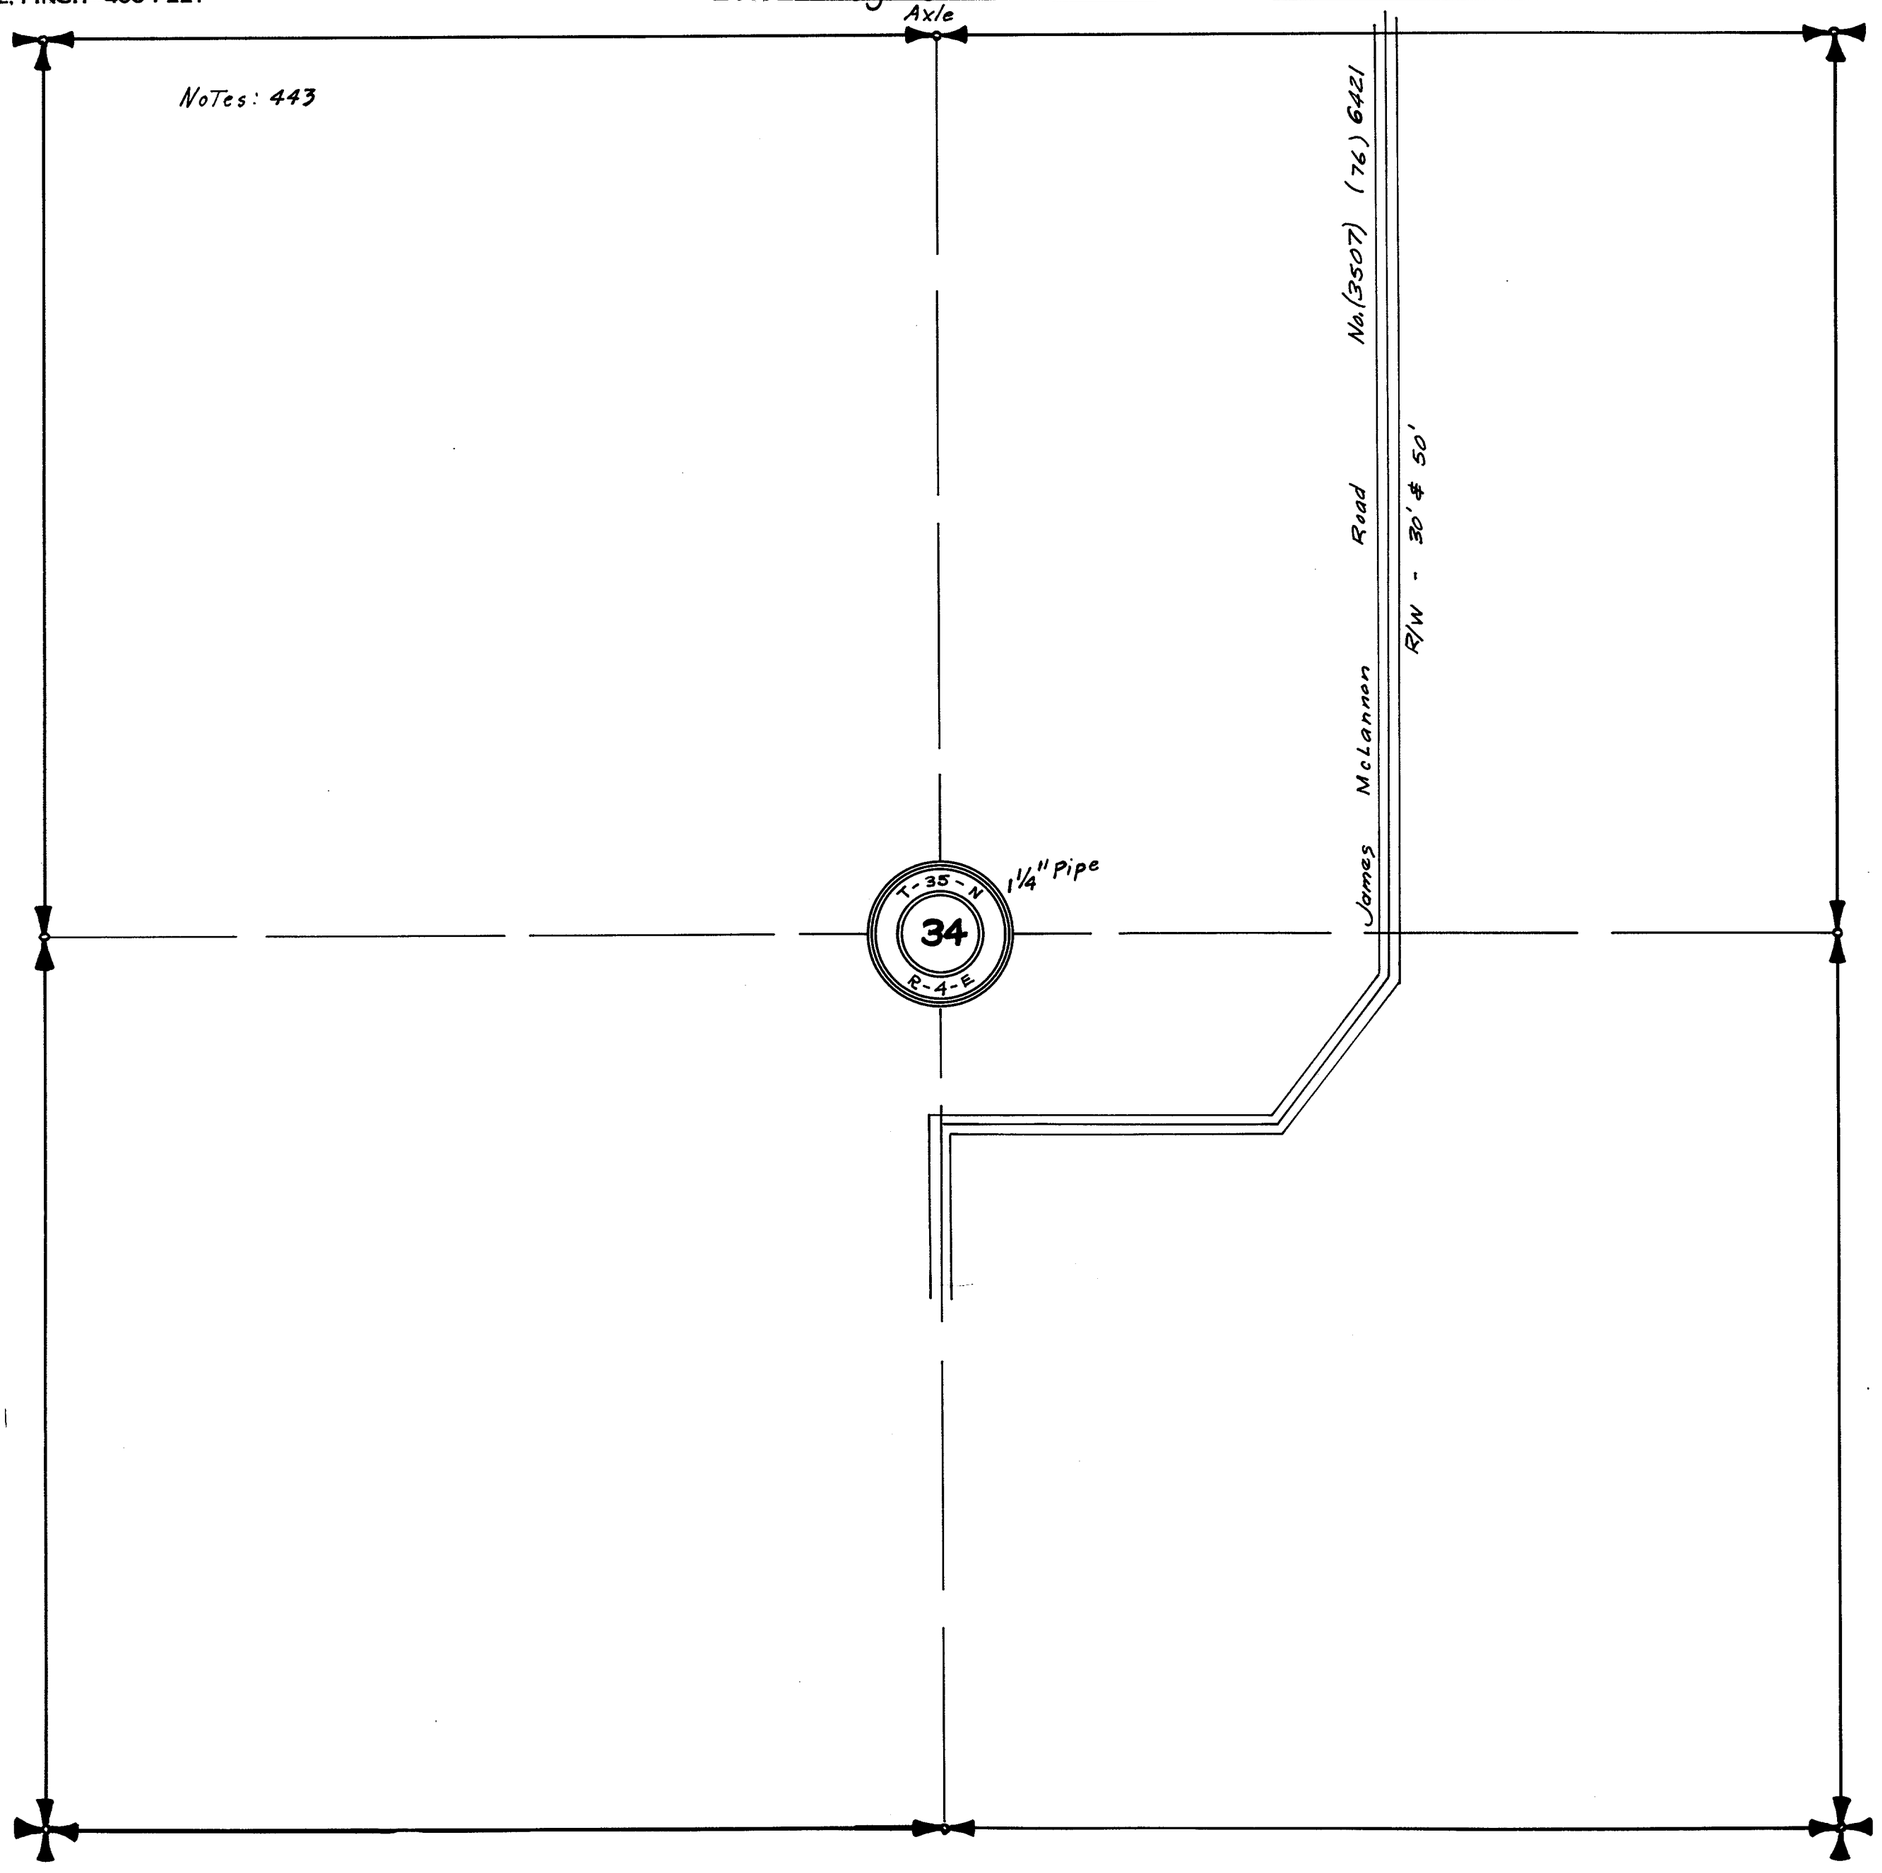


SECTION 34

TOWNSHIP 35 NORTH, RANGE 4 EAST, W. M.

SKAGIT COUNTY, WASH.

SCALE, 1 INCH–400 FEET

Arthur L. Strong COUNTY ENGINEER

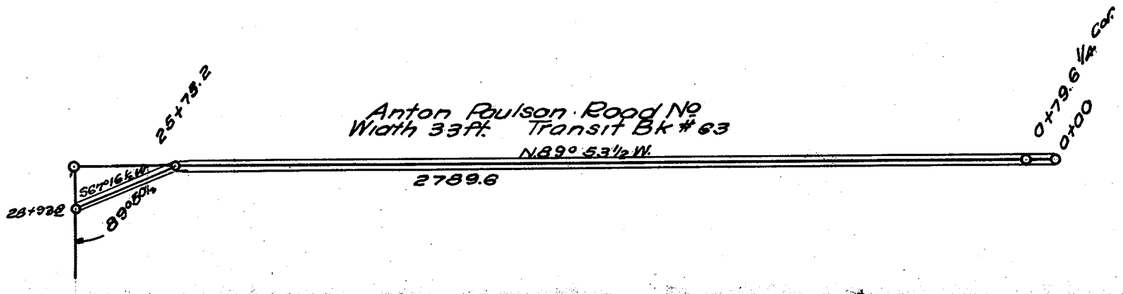


SECTION 35


TOWNSHIP 35 NORTH, RANGE 4 EAST, W. M.
SKAGIT COUNTY, WASH.

SCALE, 1 INCH–400 FEET

A. L. STRONG COUNTY ENGINEER

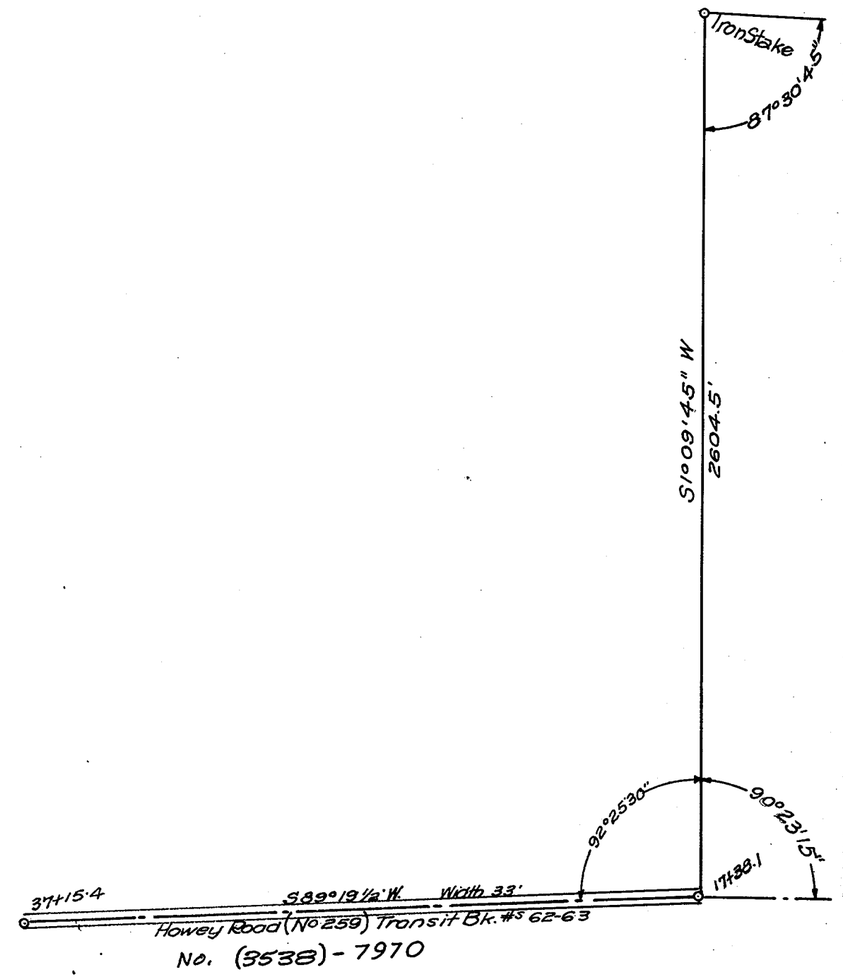

SEC. 36- 35 - 4

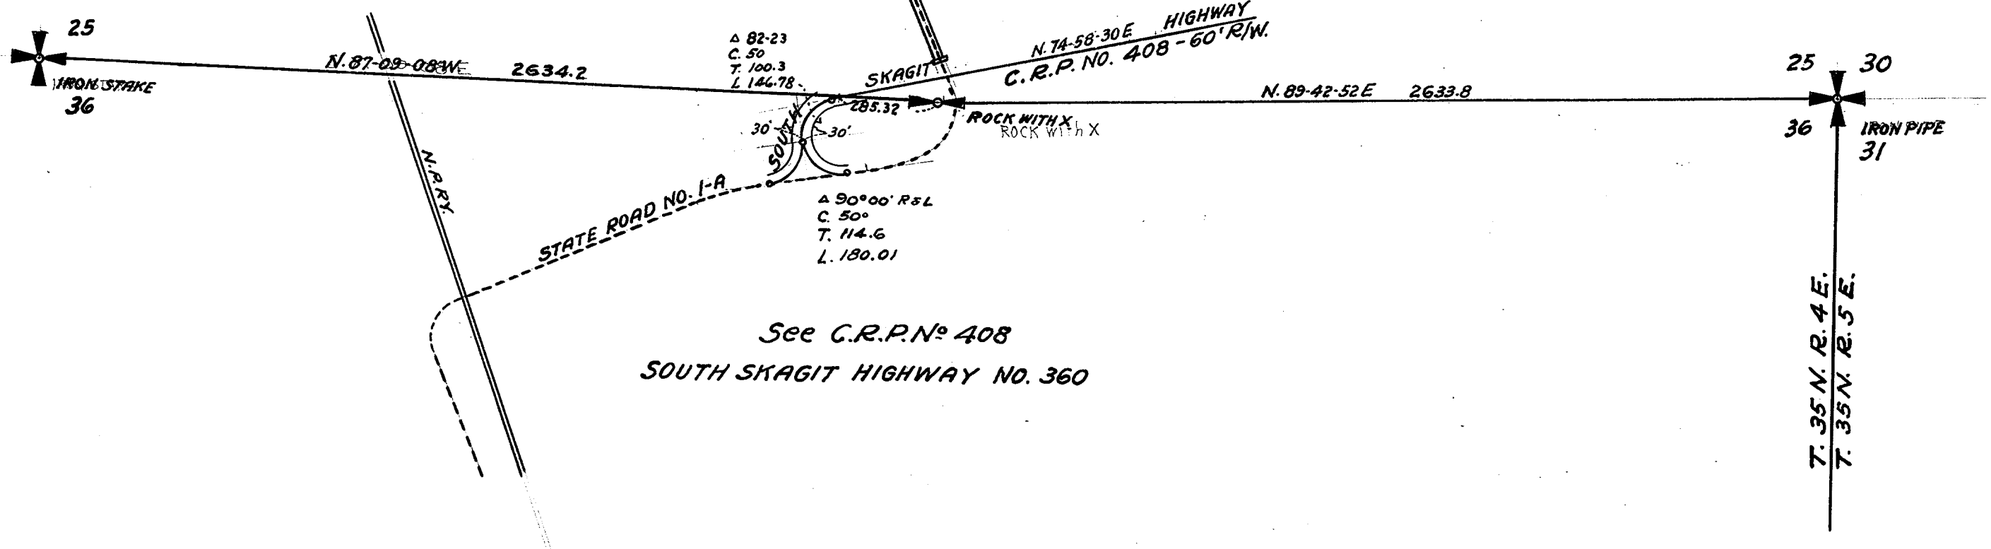

SKAGIT COUNTY, WASH.
OFFICE OF COUNTY ROAD ENGINEER

BRIDGE NO._____

LOCATION..... ROAD.....

JOB NO._____

DATE..... .....
County Road Engineer

APPROVED..... 194....

.....
Chairman-Board of County Commissioneers


SECTION 36

TOWNSHIP 35 NORTH. RANGE 4 EAST. W. M.
SKAGIT COUNTY. WASH.

SCALE, 1 INCH—400 FEET

Lloyd Johnson COUNTY ENGINEER

DATE 11/1/73

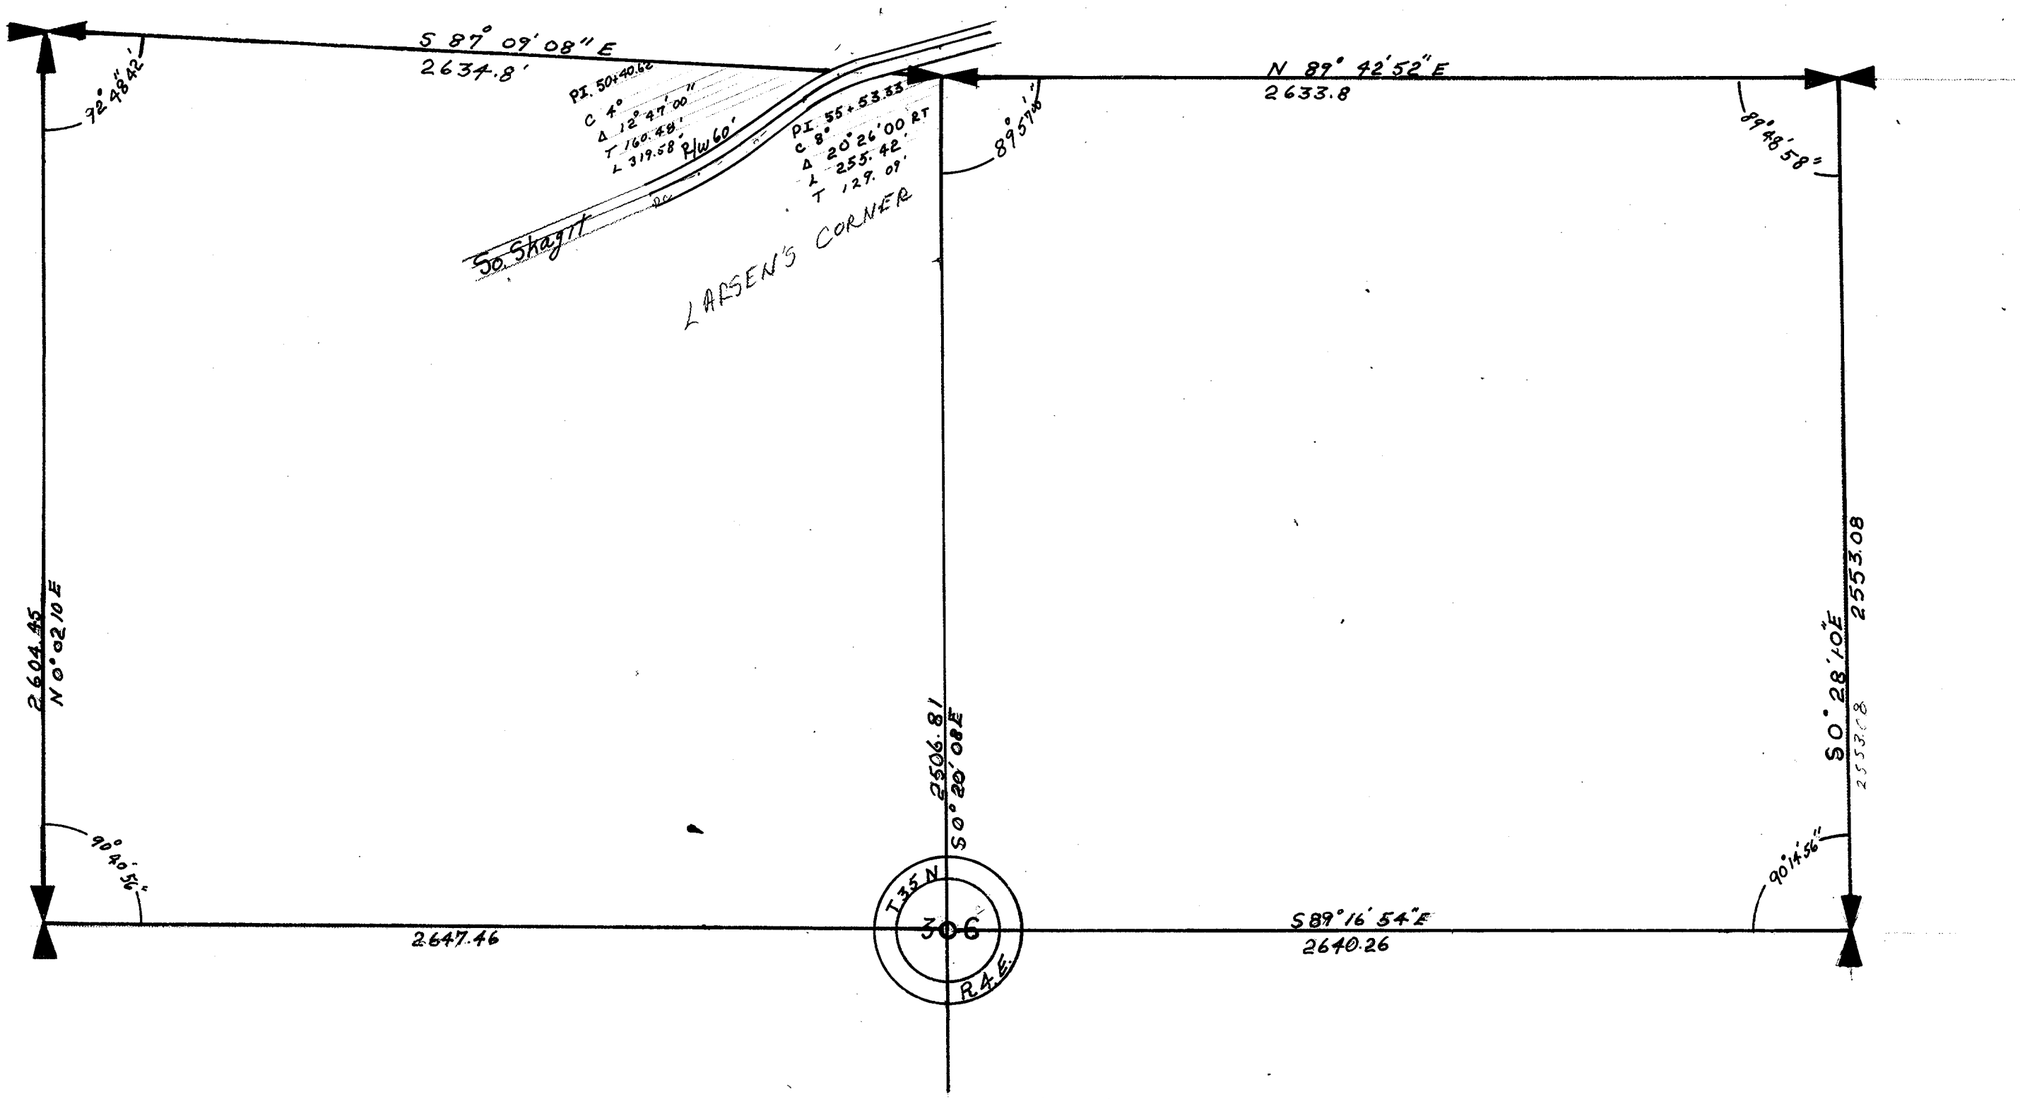


SECTION 36

TOWNSHIP 35 NORTH, RANGE 4 EAST, W. M.
SKAGIT COUNTY, WASH.

SCALE, 1 INCH–400 FEET

A. L. STRONG COUNTY ENGINEER

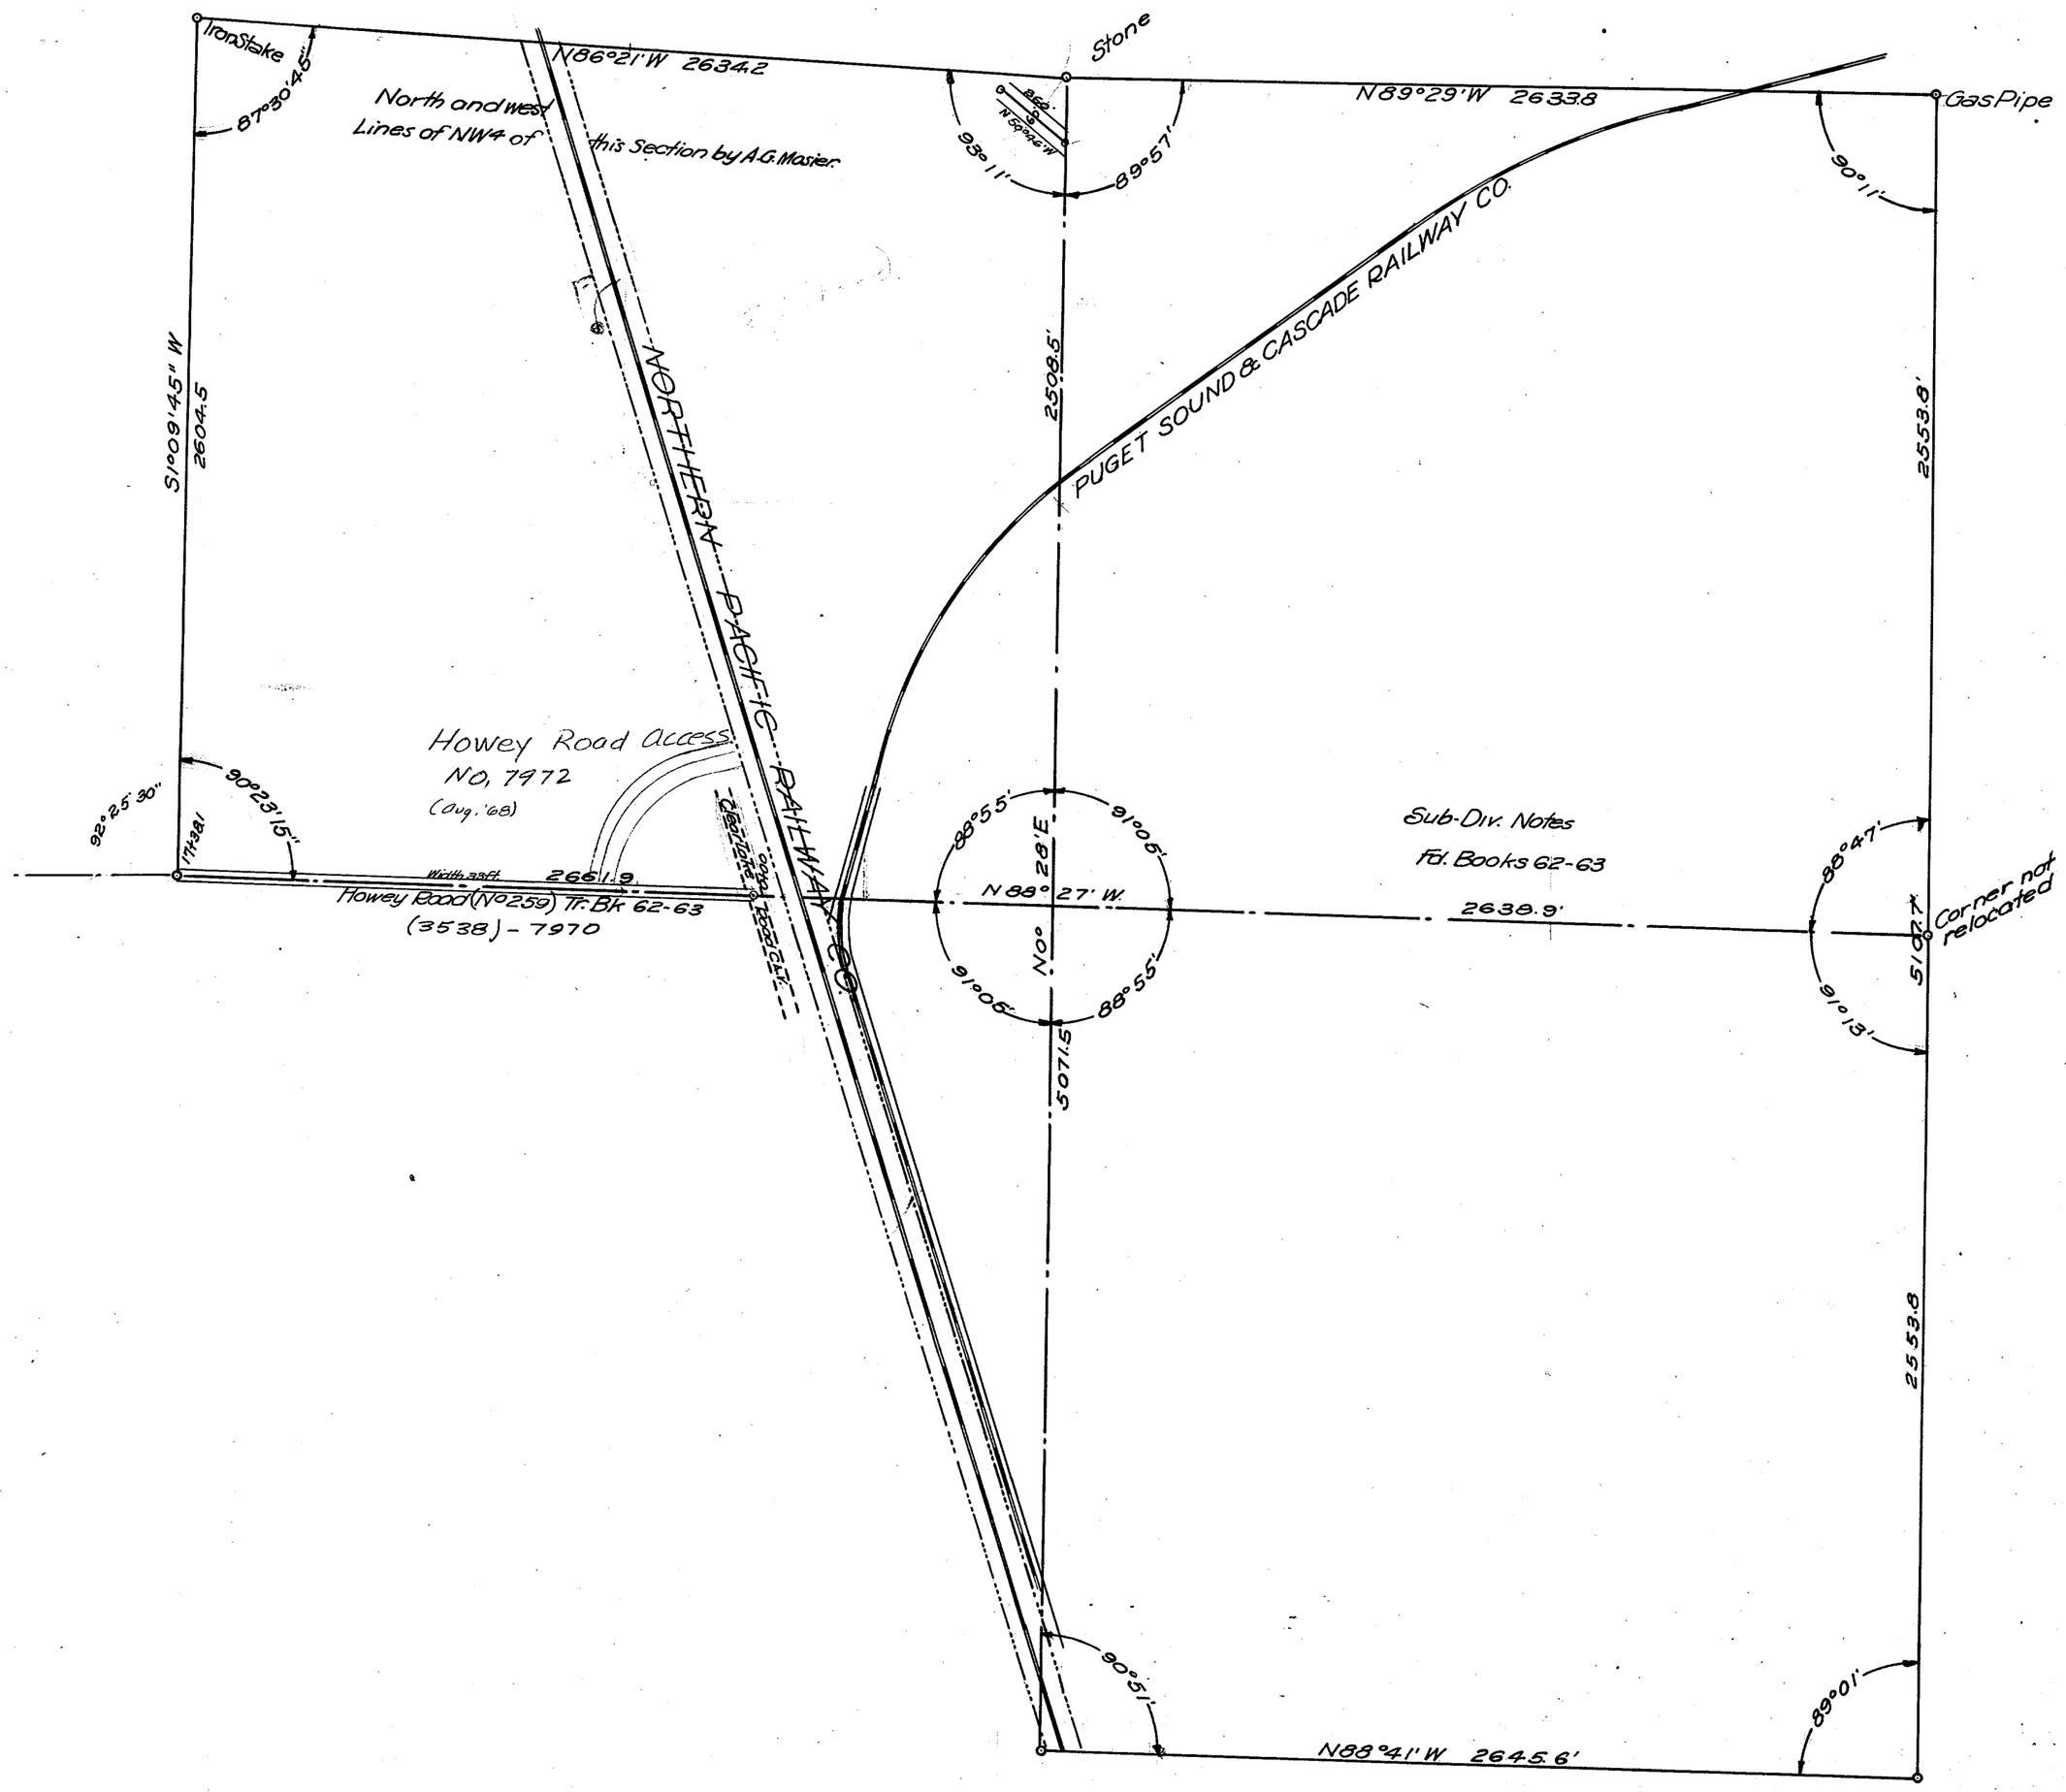

SECTION 6


TOWNSHIP 35 NORTH, RANGE 5 EAST, W. M.

SKAGIT COUNTY, WASH.

SCALE, 1 INCH--400 FEET

H.O. WALBERG COUNTY ENGINEER

(FROM AUG. 1923 MAP BY R.E.L. KNAPP)

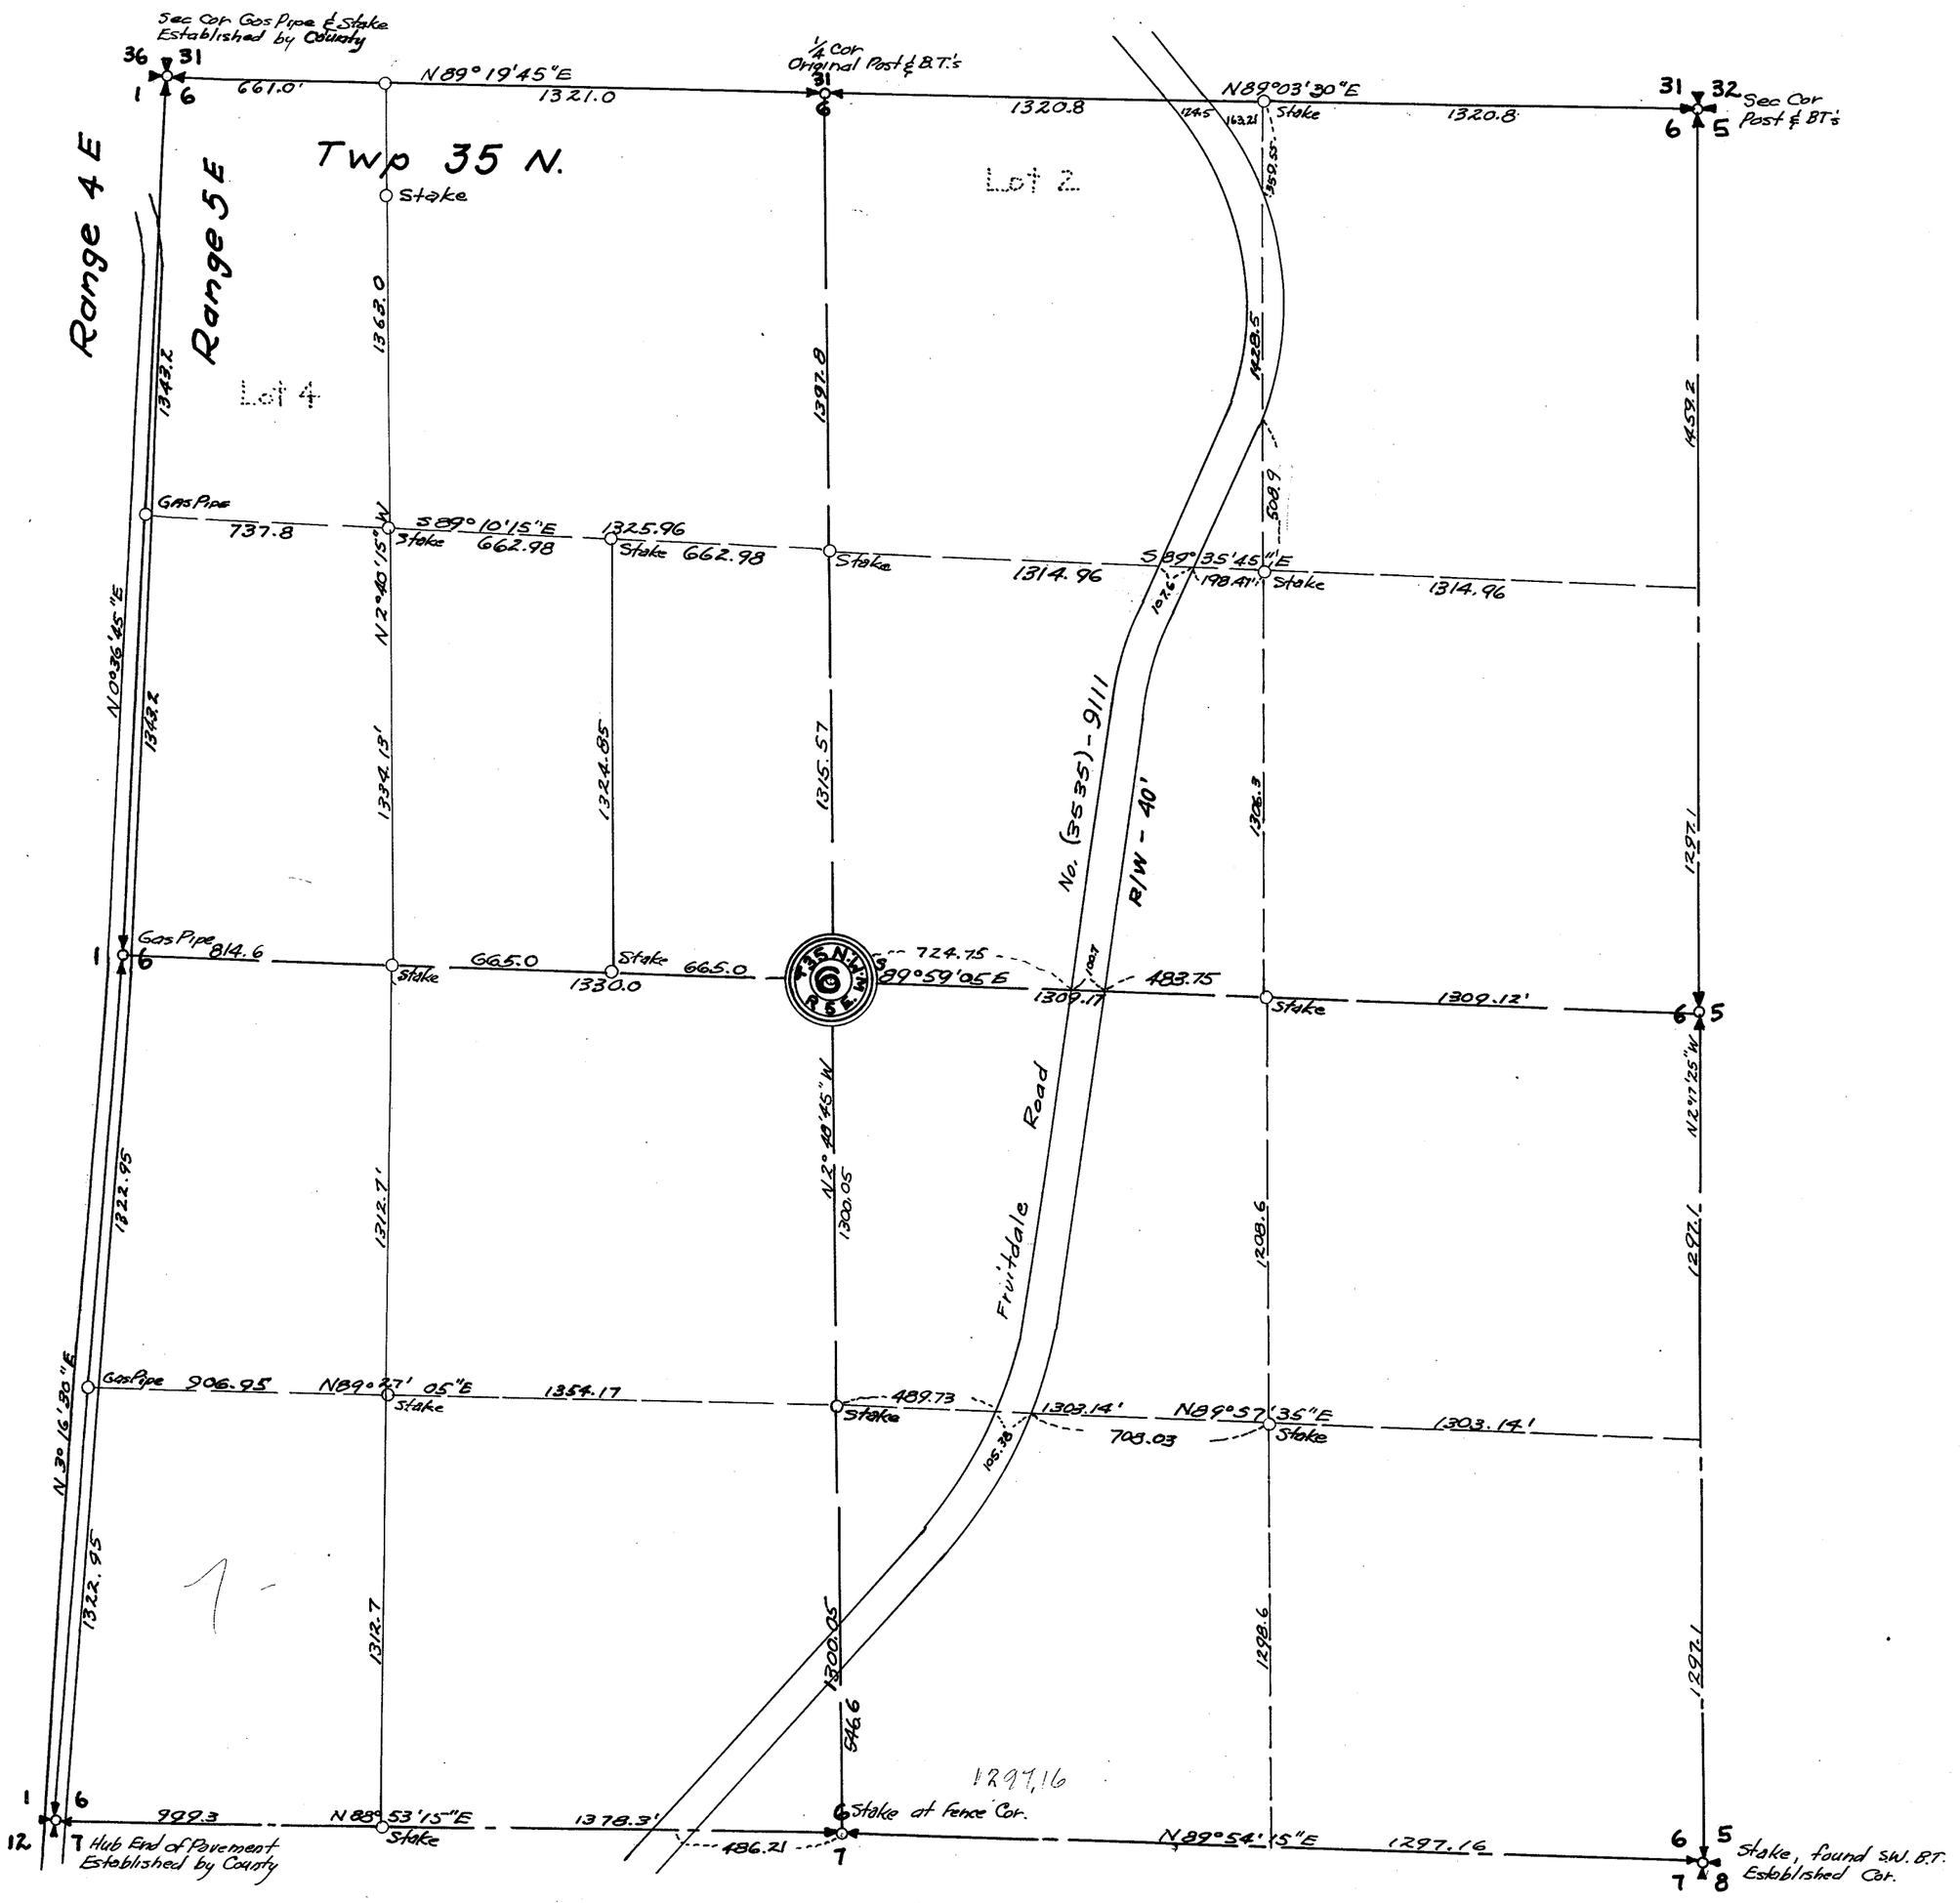


SECTION 7

TOWNSHIP 35 NORTH, RANGE 5 EAST, W. M.

SKAGIT COUNTY, WASH.

SCALE, 1 INCH--400 FEET

H.O. WALBERG COUNTY ENGINEER
(FROM A&C 1923 MAP BY R.E.L. KNAPP)

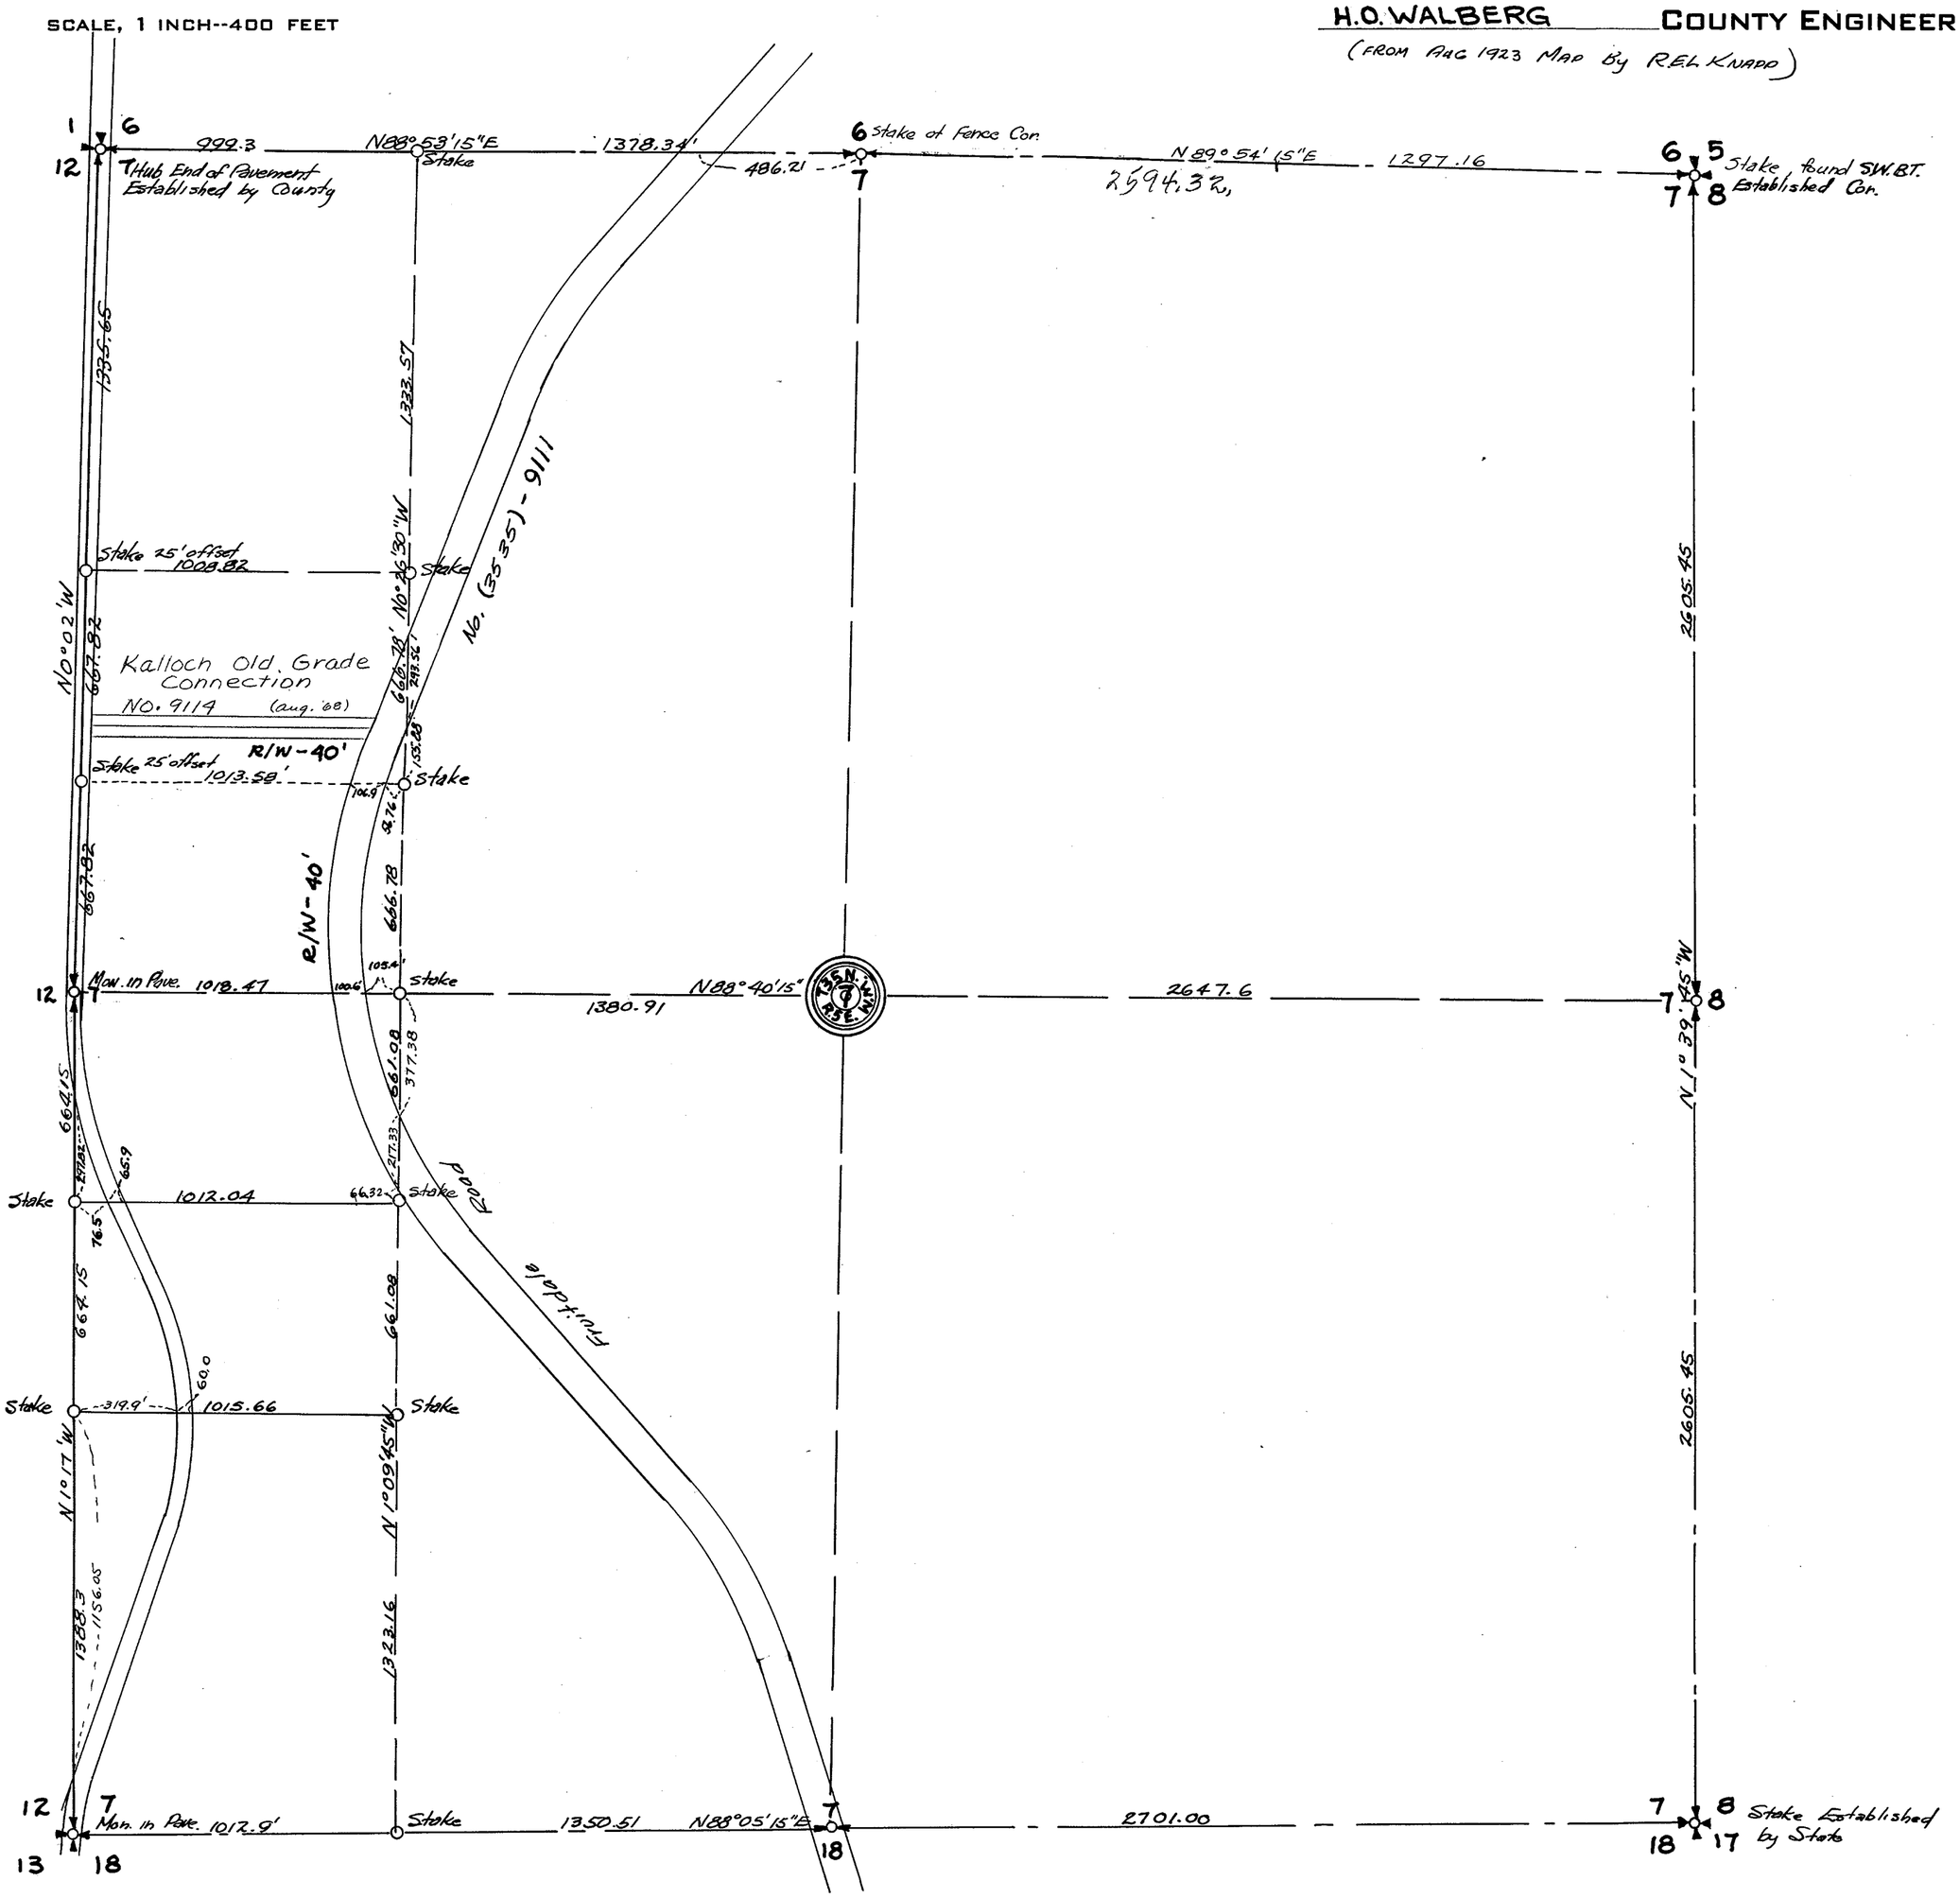

SECTION 8


TOWNSHIP 35 NORTH, RANGE 5 EAST, W. M.

SKAGIT COUNTY, WASH.

SCALE, 1 INCH--400 FEET

DATE Aug. 1965

_____ COUNTY ENGINEER

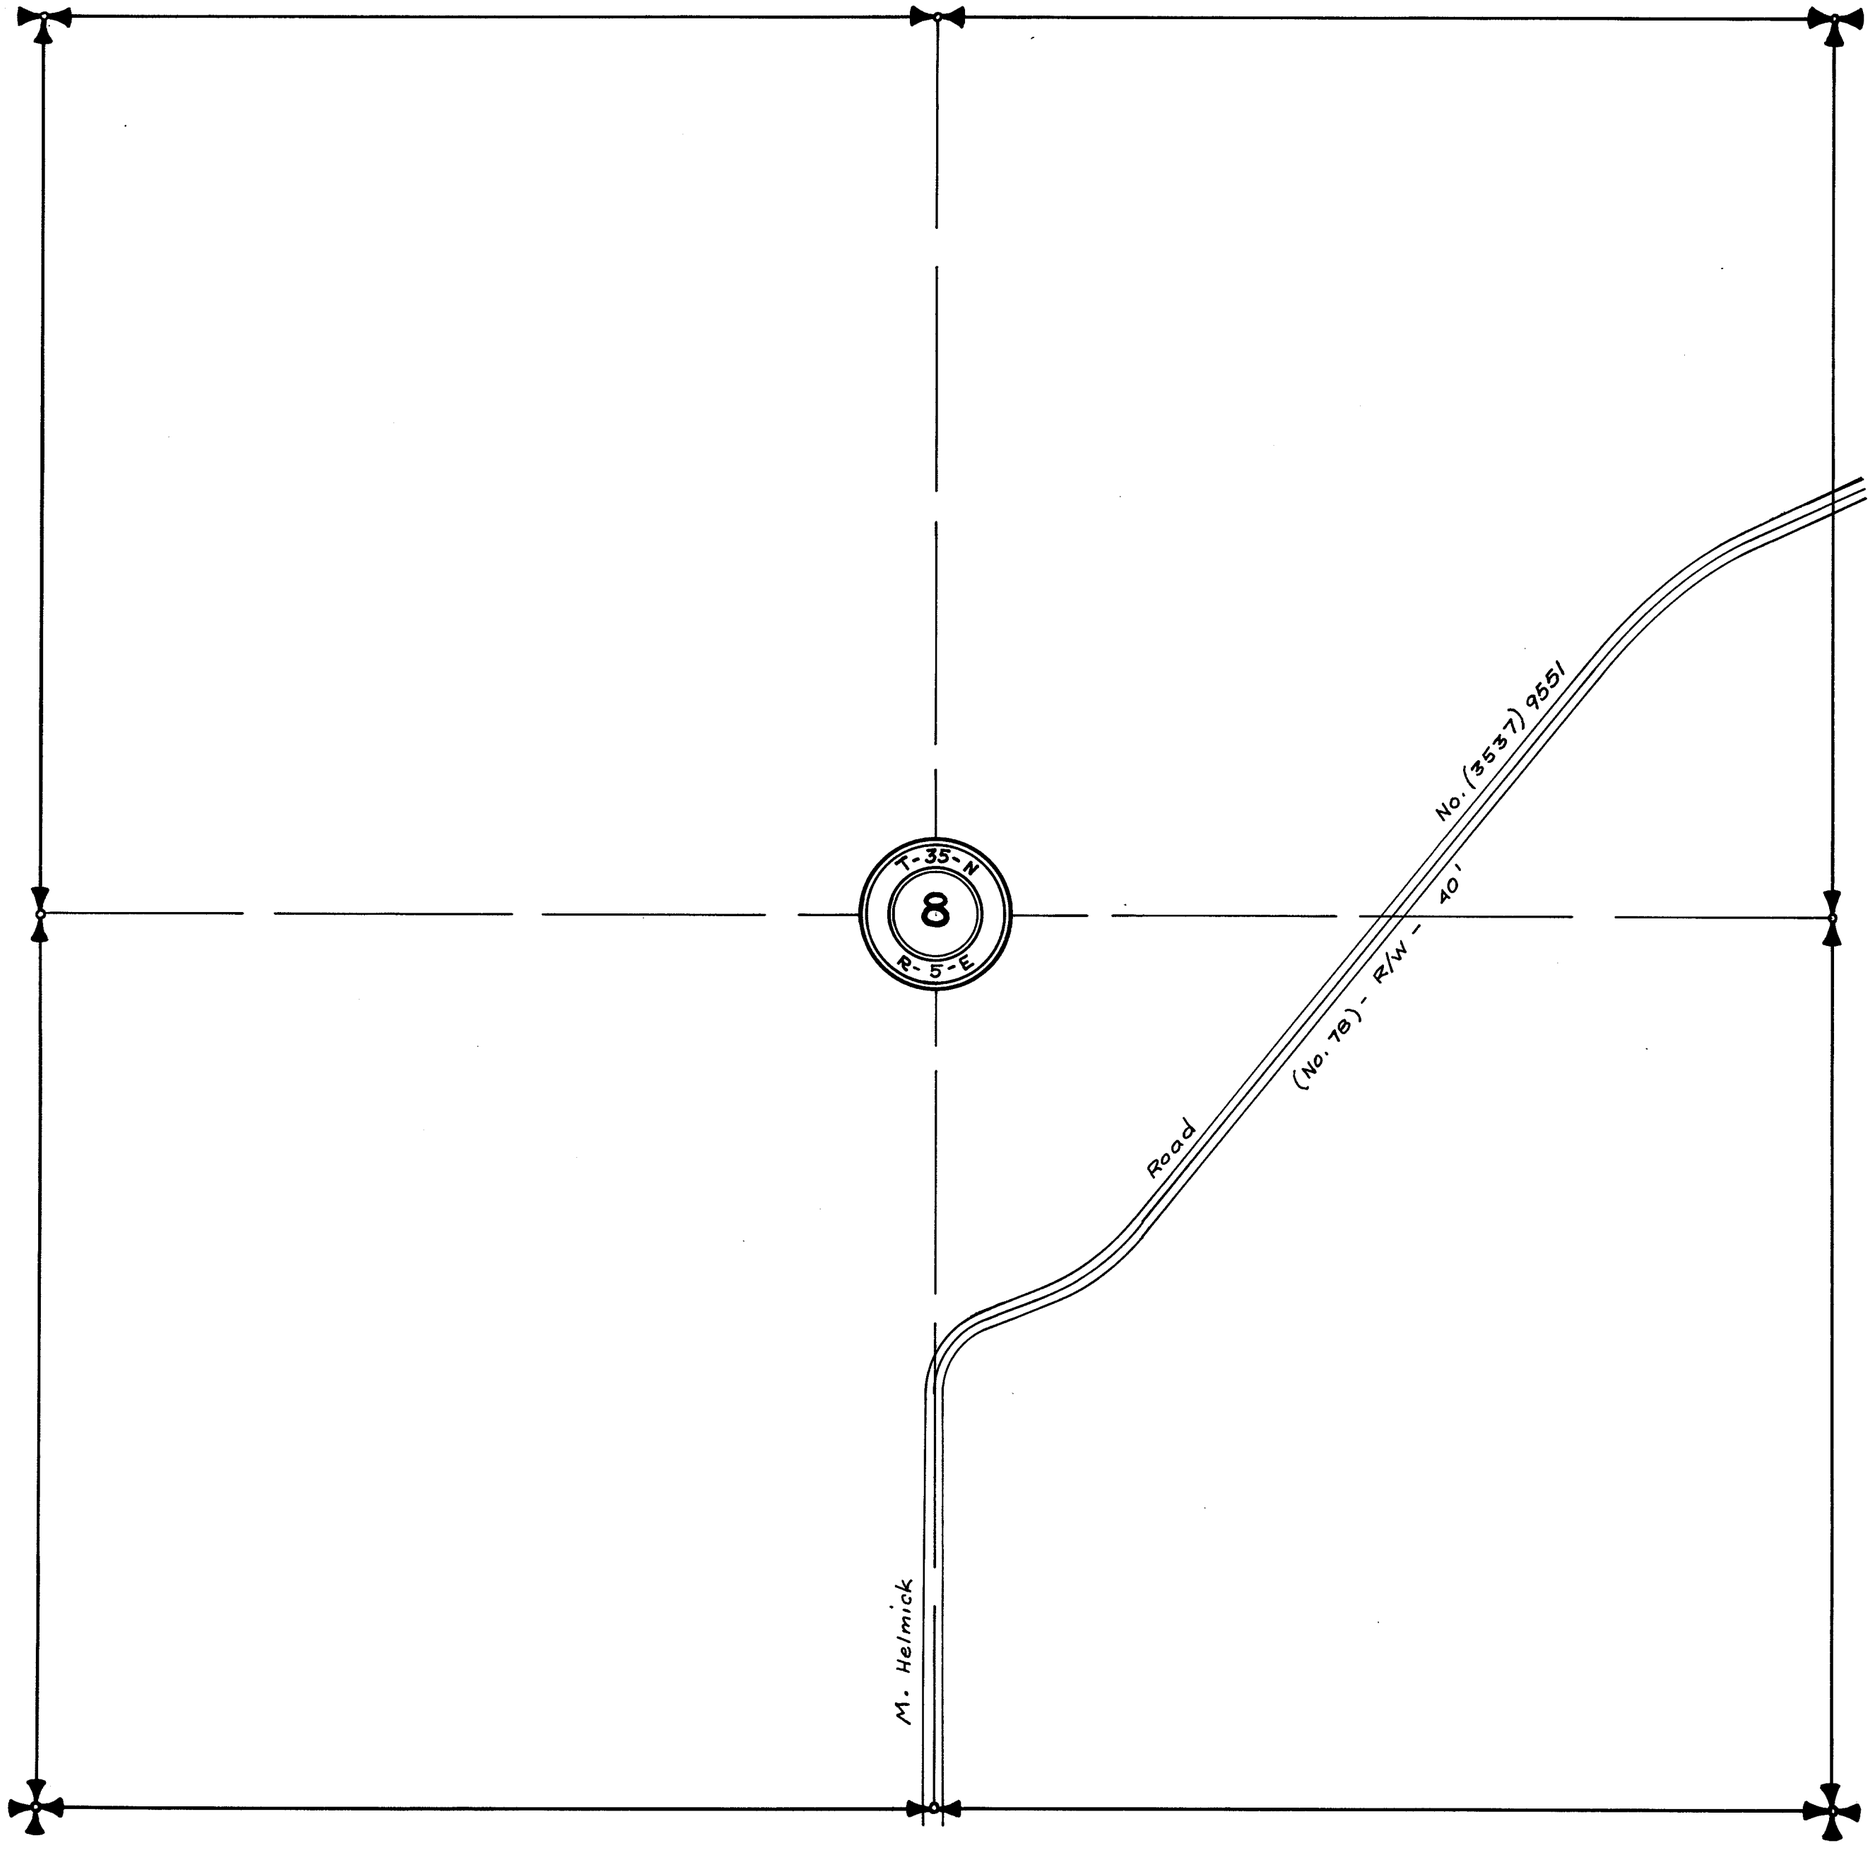


SECTION 8

TOWNSHIP 35 NORTH, RANGE 5 EAST, W. M.
SKAGIT COUNTY, WASH.

SCALE, 1 INCH–400 FEET

~~Robt. E. L. Knapp~~ COUNTY ENGINEER
Platted - 1932

Survey by T.D. MacNeil - 1906
Book 46 Page 30

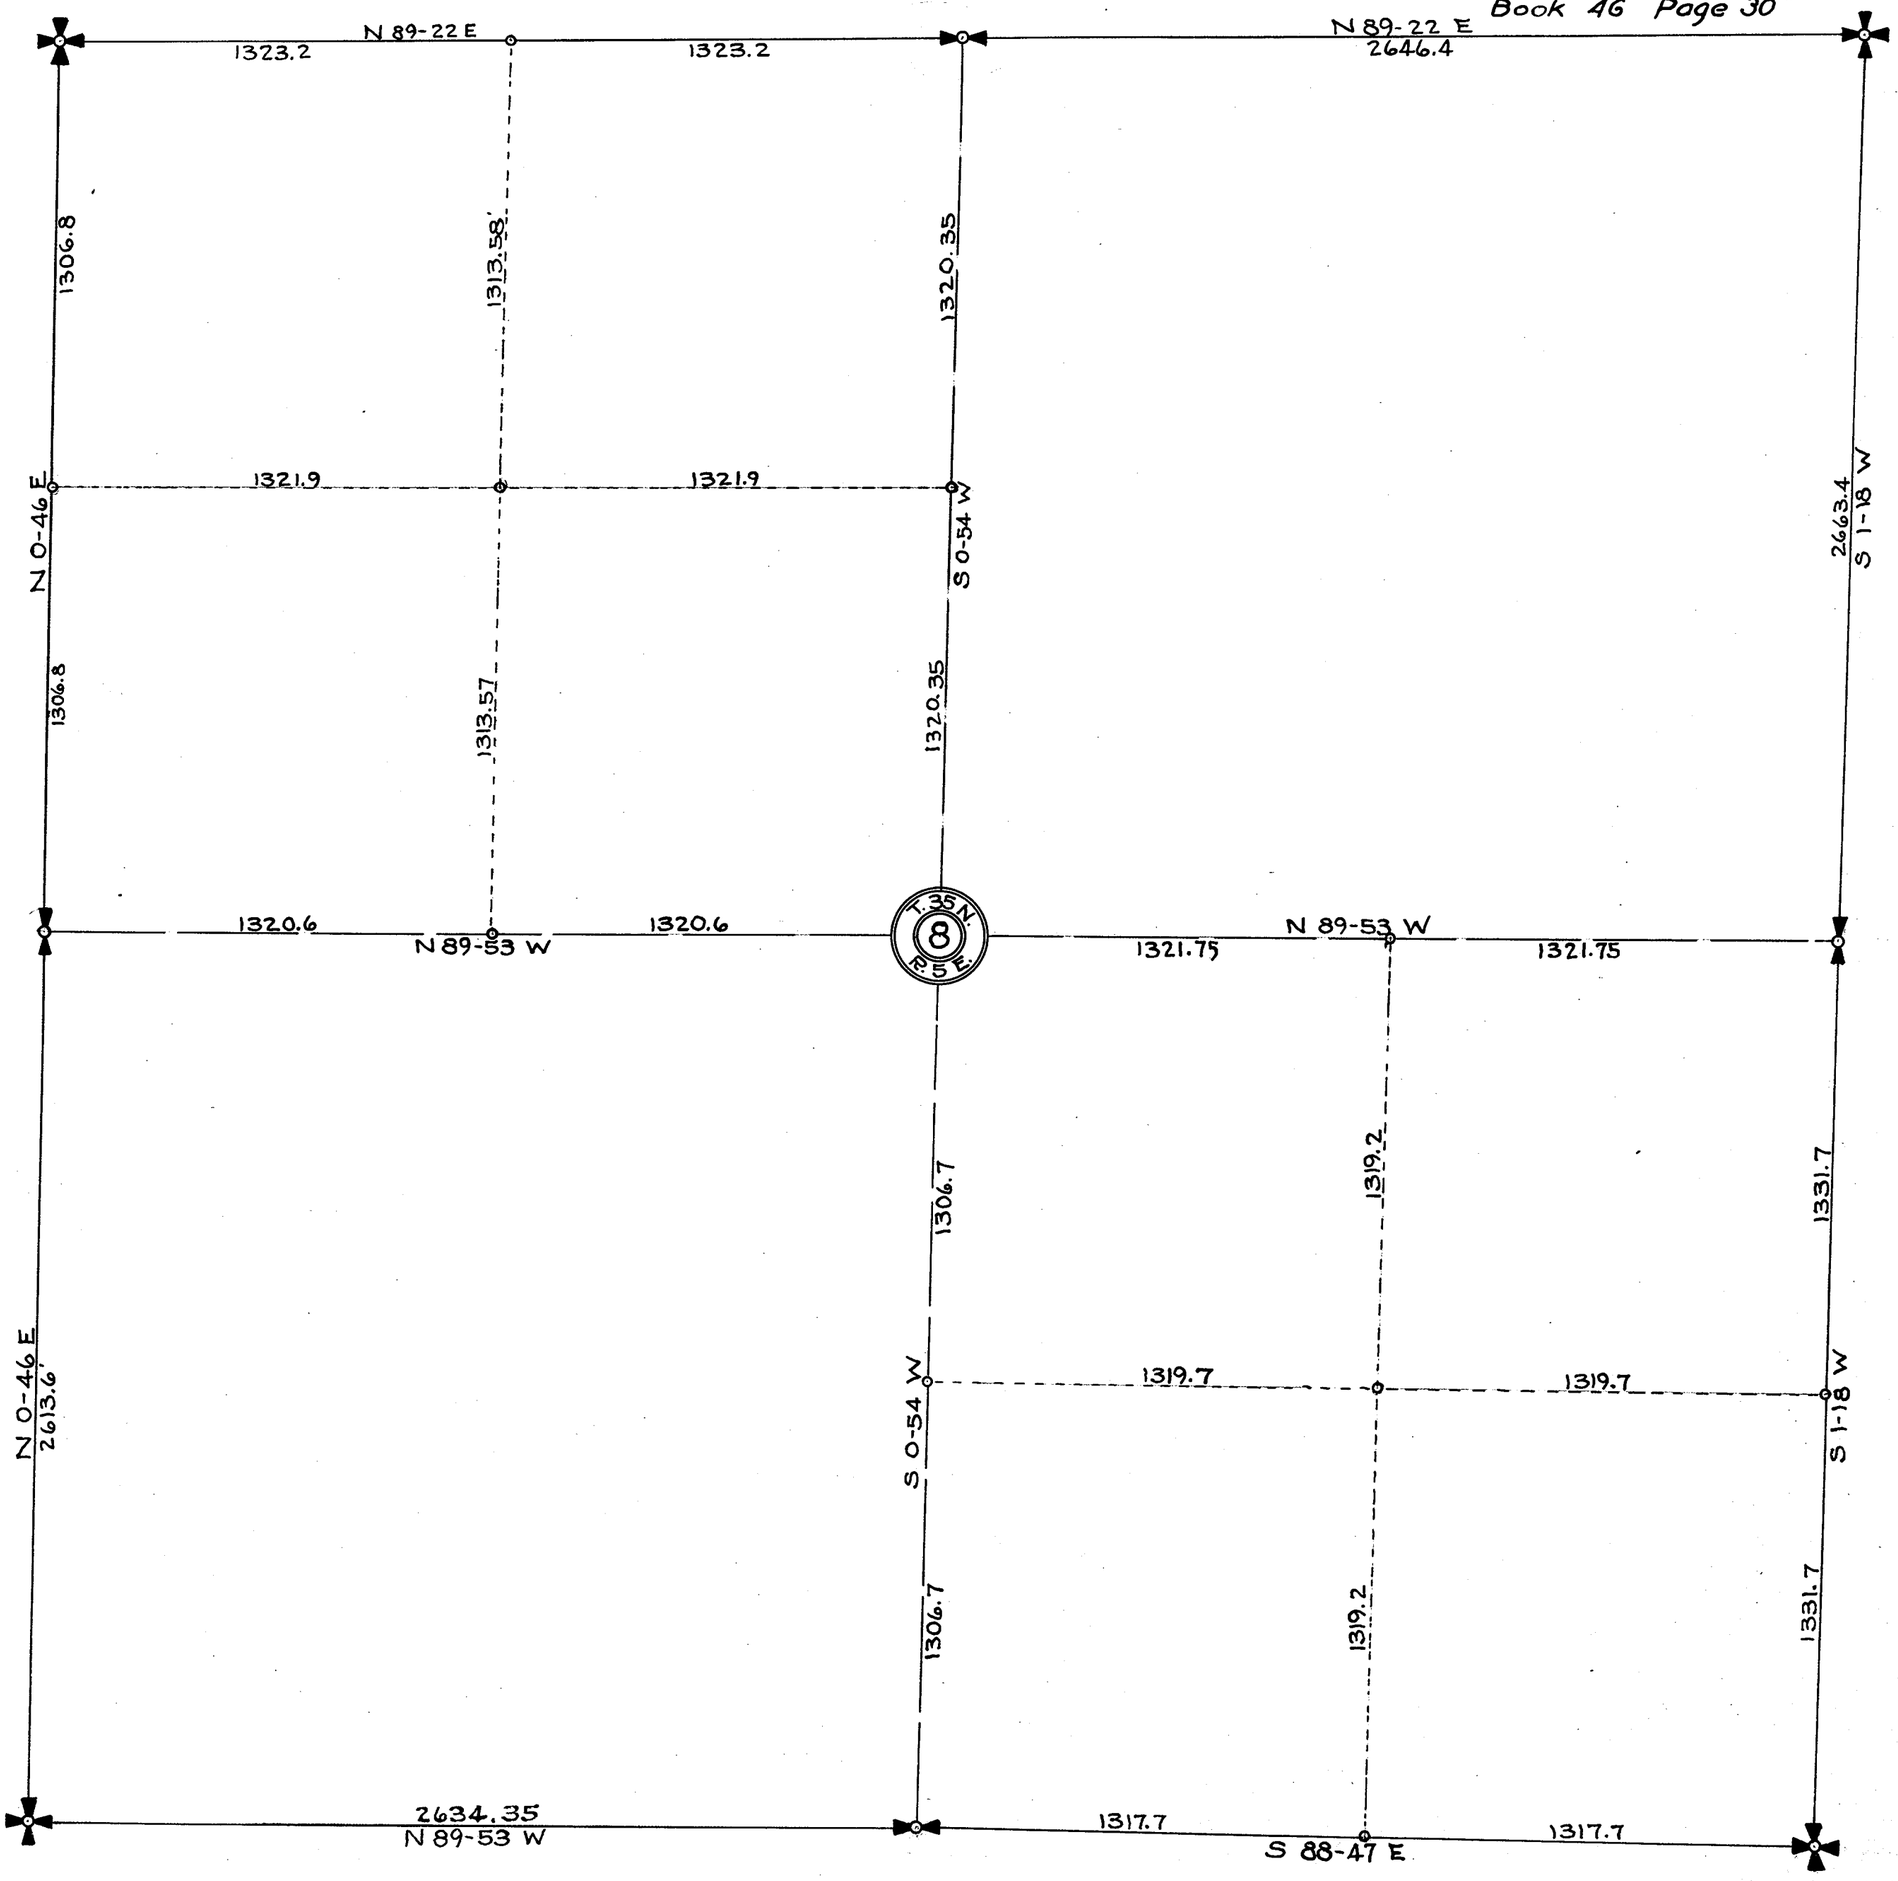

SECTION 10


TOWNSHIP 35 NORTH, RANGE 5 EAST, W. M.

SKAGIT COUNTY, WASH.

SCALE, 1 INCH--400 FEET

W.A. COSTELLO COUNTY ENGINEER

Notes: 39/451

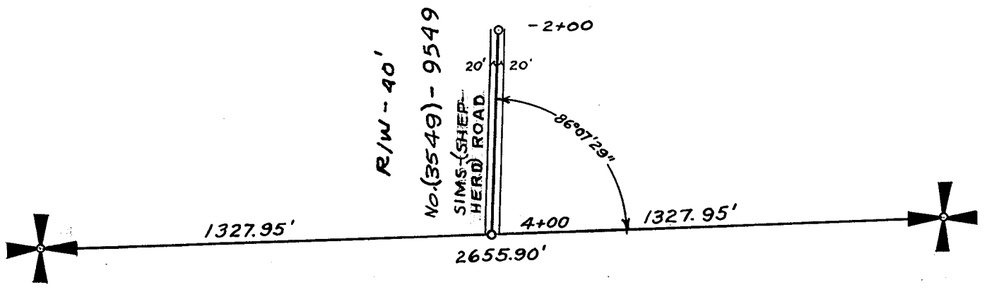


SECTION 13

TOWNSHIP 35 NORTH, RANGE 5 EAST, W. M.

SKAGIT COUNTY, WASH.

SCALE, 1 INCH--400 FEET

DATE November , 1959 Frank Gilkey COUNTY ENGINEER

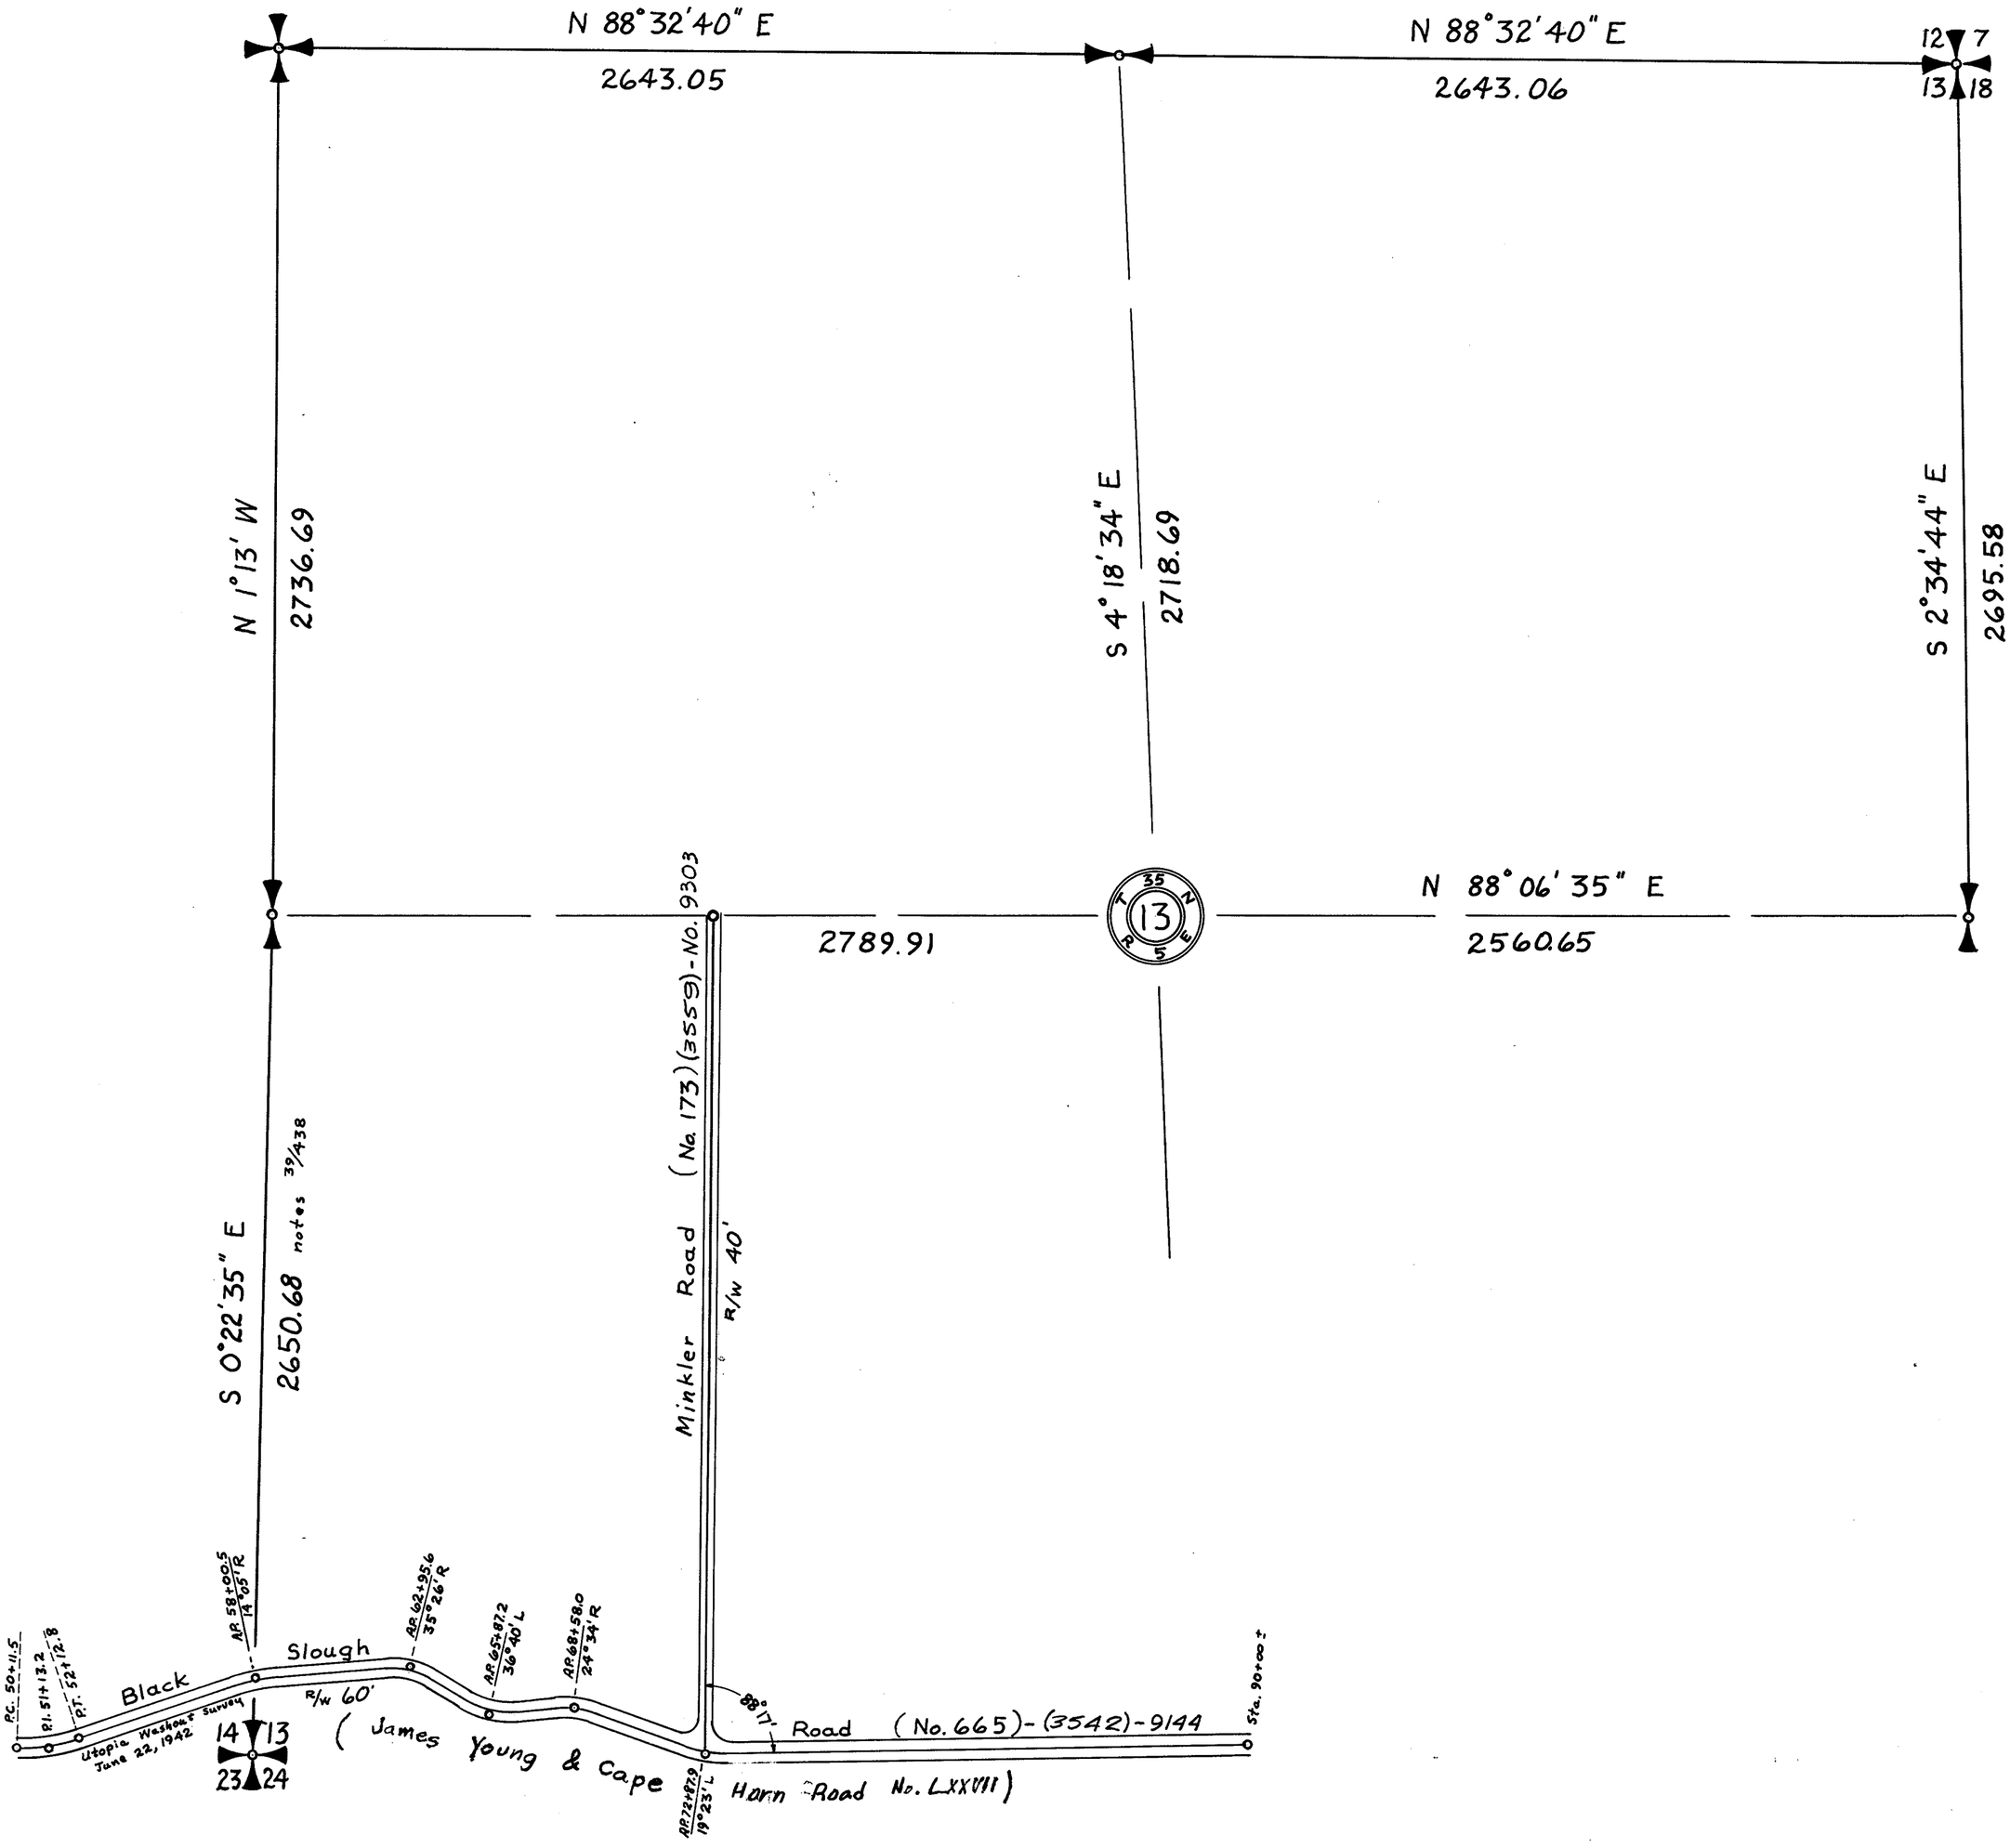


SECTION 13

TOWNSHIP 35 NORTH, RANGE 5 EAST, W. M.

SKAGIT COUNTY, WASH.

SCALE, 1 INCH–400 FEET

A. L. STRONG COUNTY ENGINEER

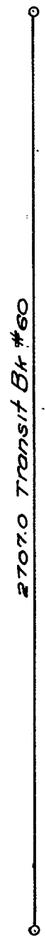


SECTION 13

TOWNSHIP 35 NORTH, RANGE 5 EAST, W. M.
SKAGIT COUNTY, WASH.

SCALE, 1 INCH–400 FEET

Robt. E. L. Knapp COUNTY ENGINEER
May 1932 - Platted

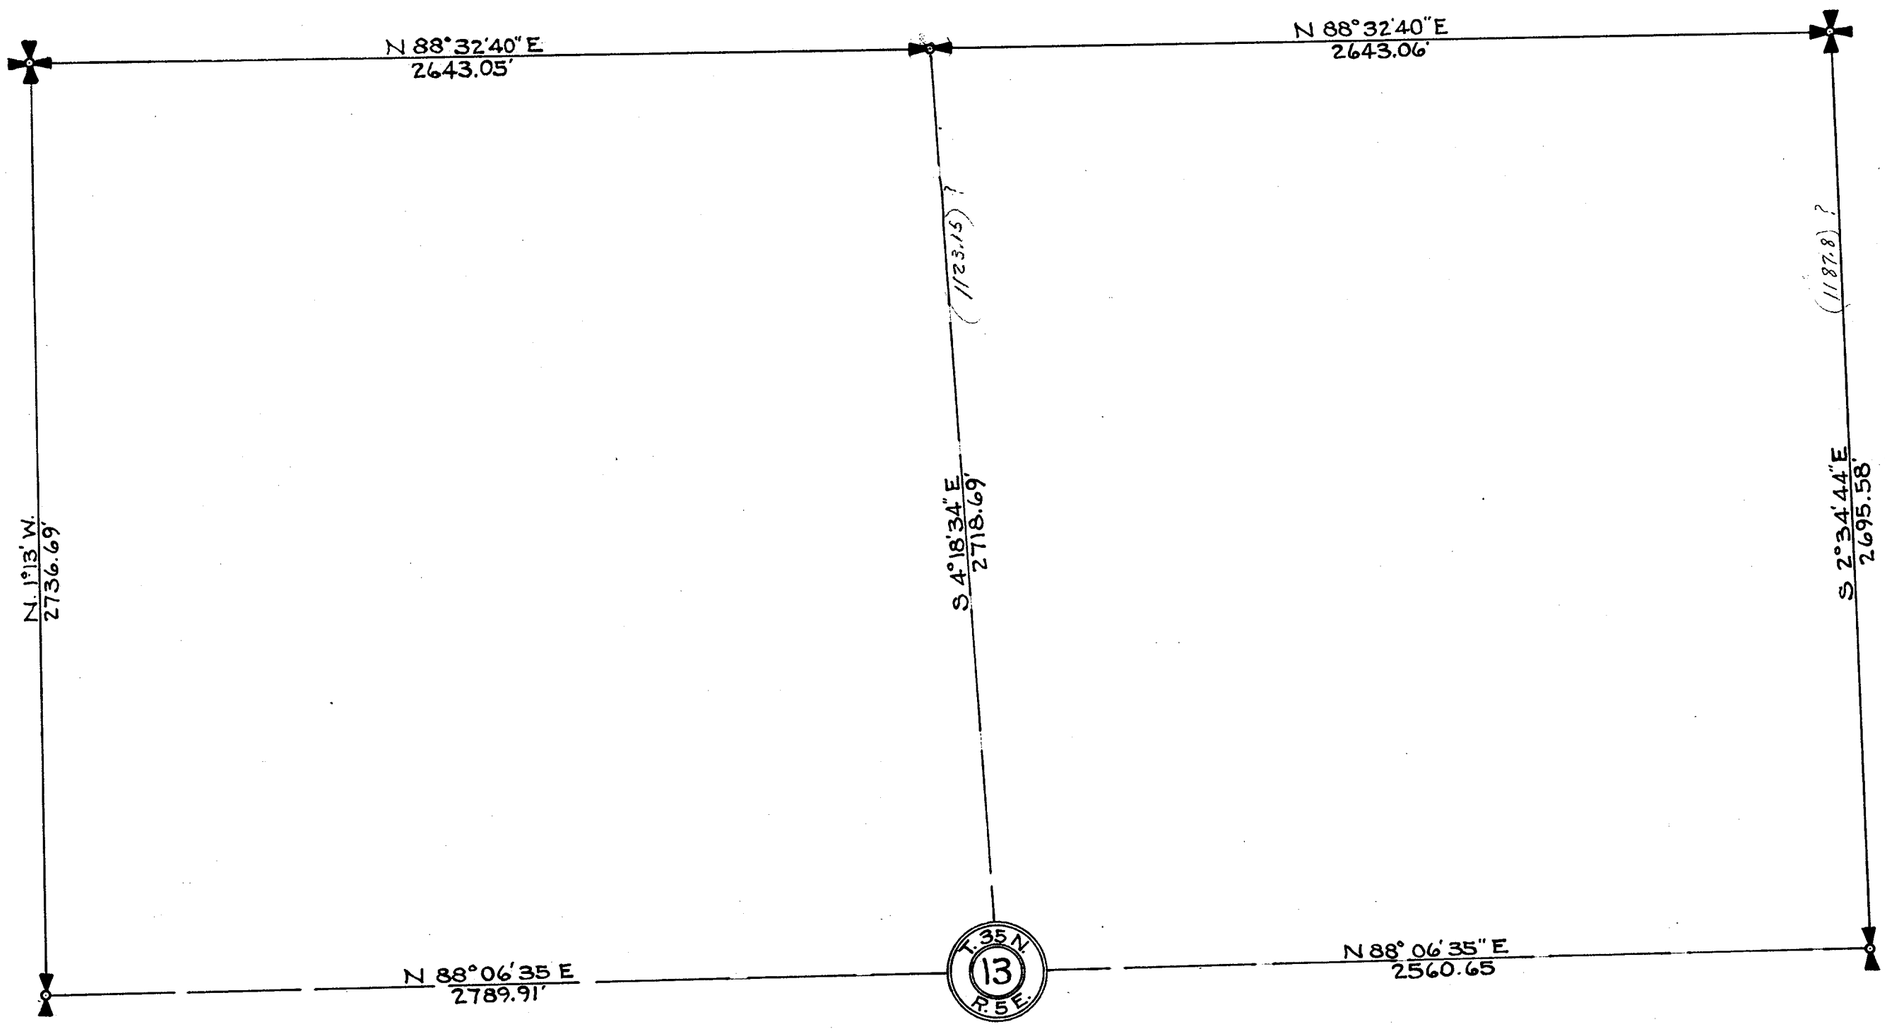


SECTION SE¼-14

TOWNSHIP 35 NORTH, RANGE 5 EAST, W. M.
SKAGIT COUNTY, WASH.

SCALE, 1 INCH--~~400~~ 200 FEET
Notes: 39/438

W. A. COSTELLO COUNTY ENGINEER
AUG. 1940

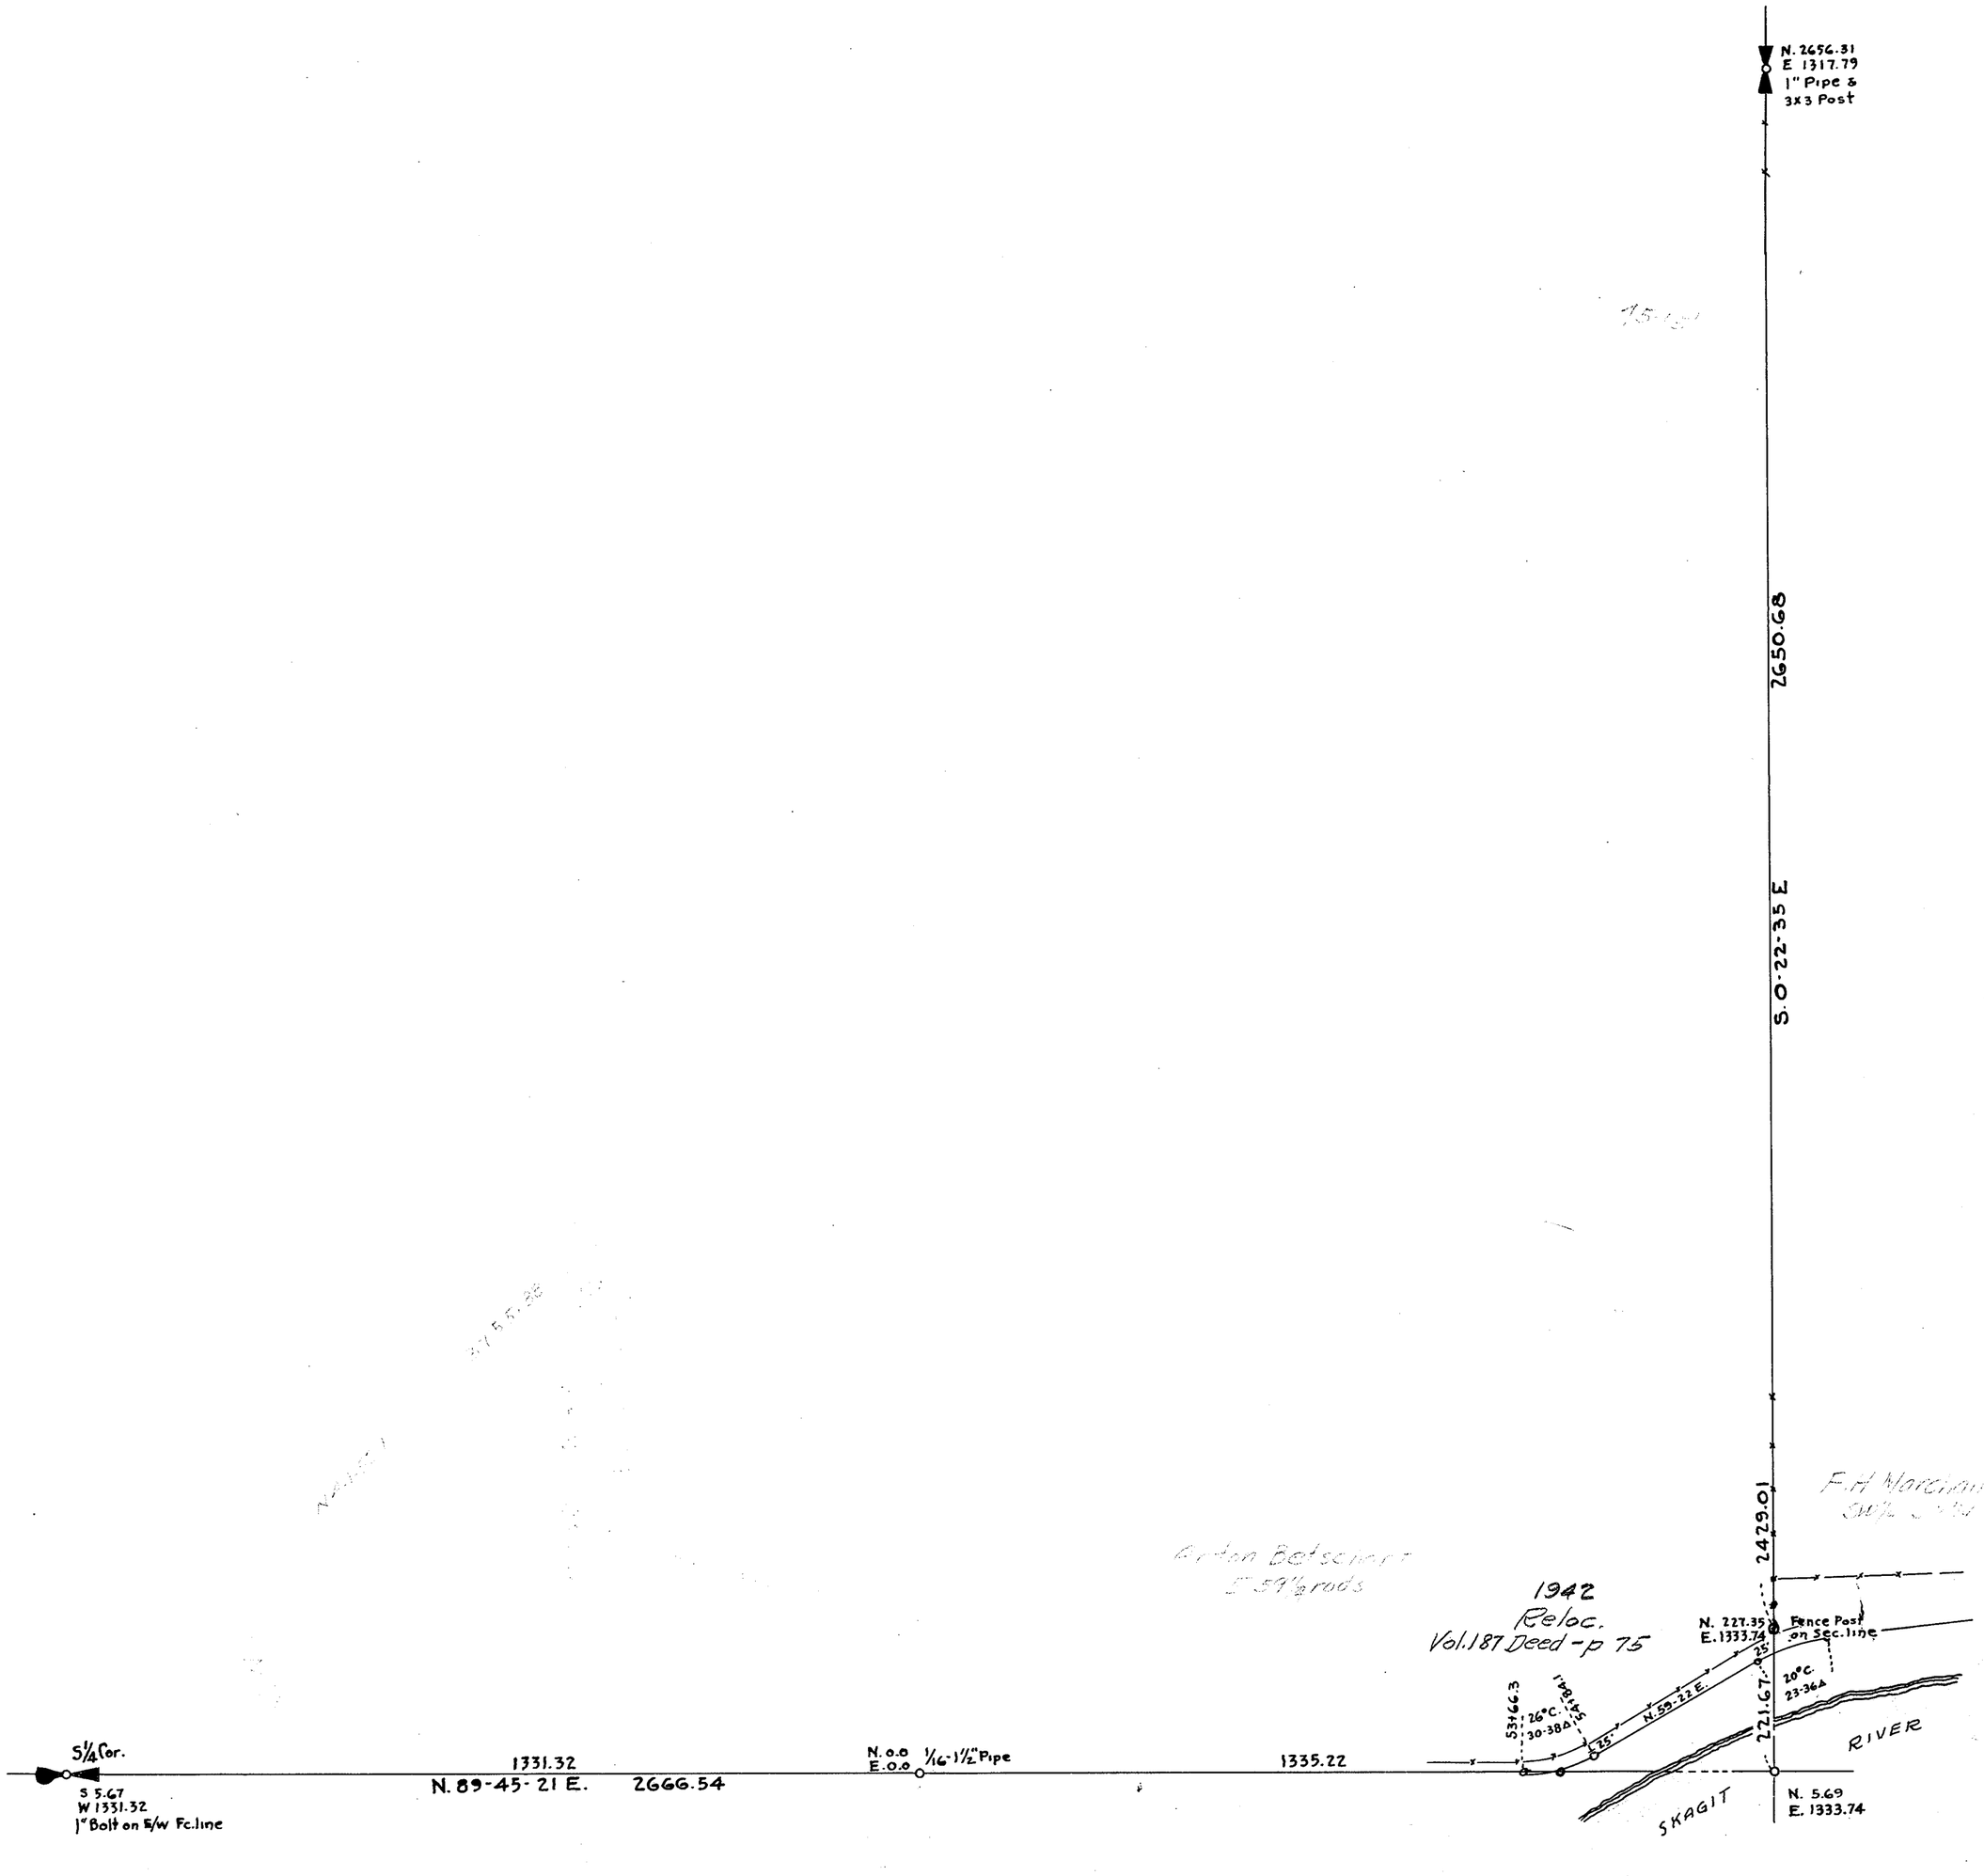


SECTION 14

TOWNSHIP 35 NORTH, RANGE 5 EAST, W. M.

SKAGIT COUNTY, WASH.

SCALE, 1 INCH--400 FEET

DATE November, 1959 Frank Gilkey COUNTY ENGINEER

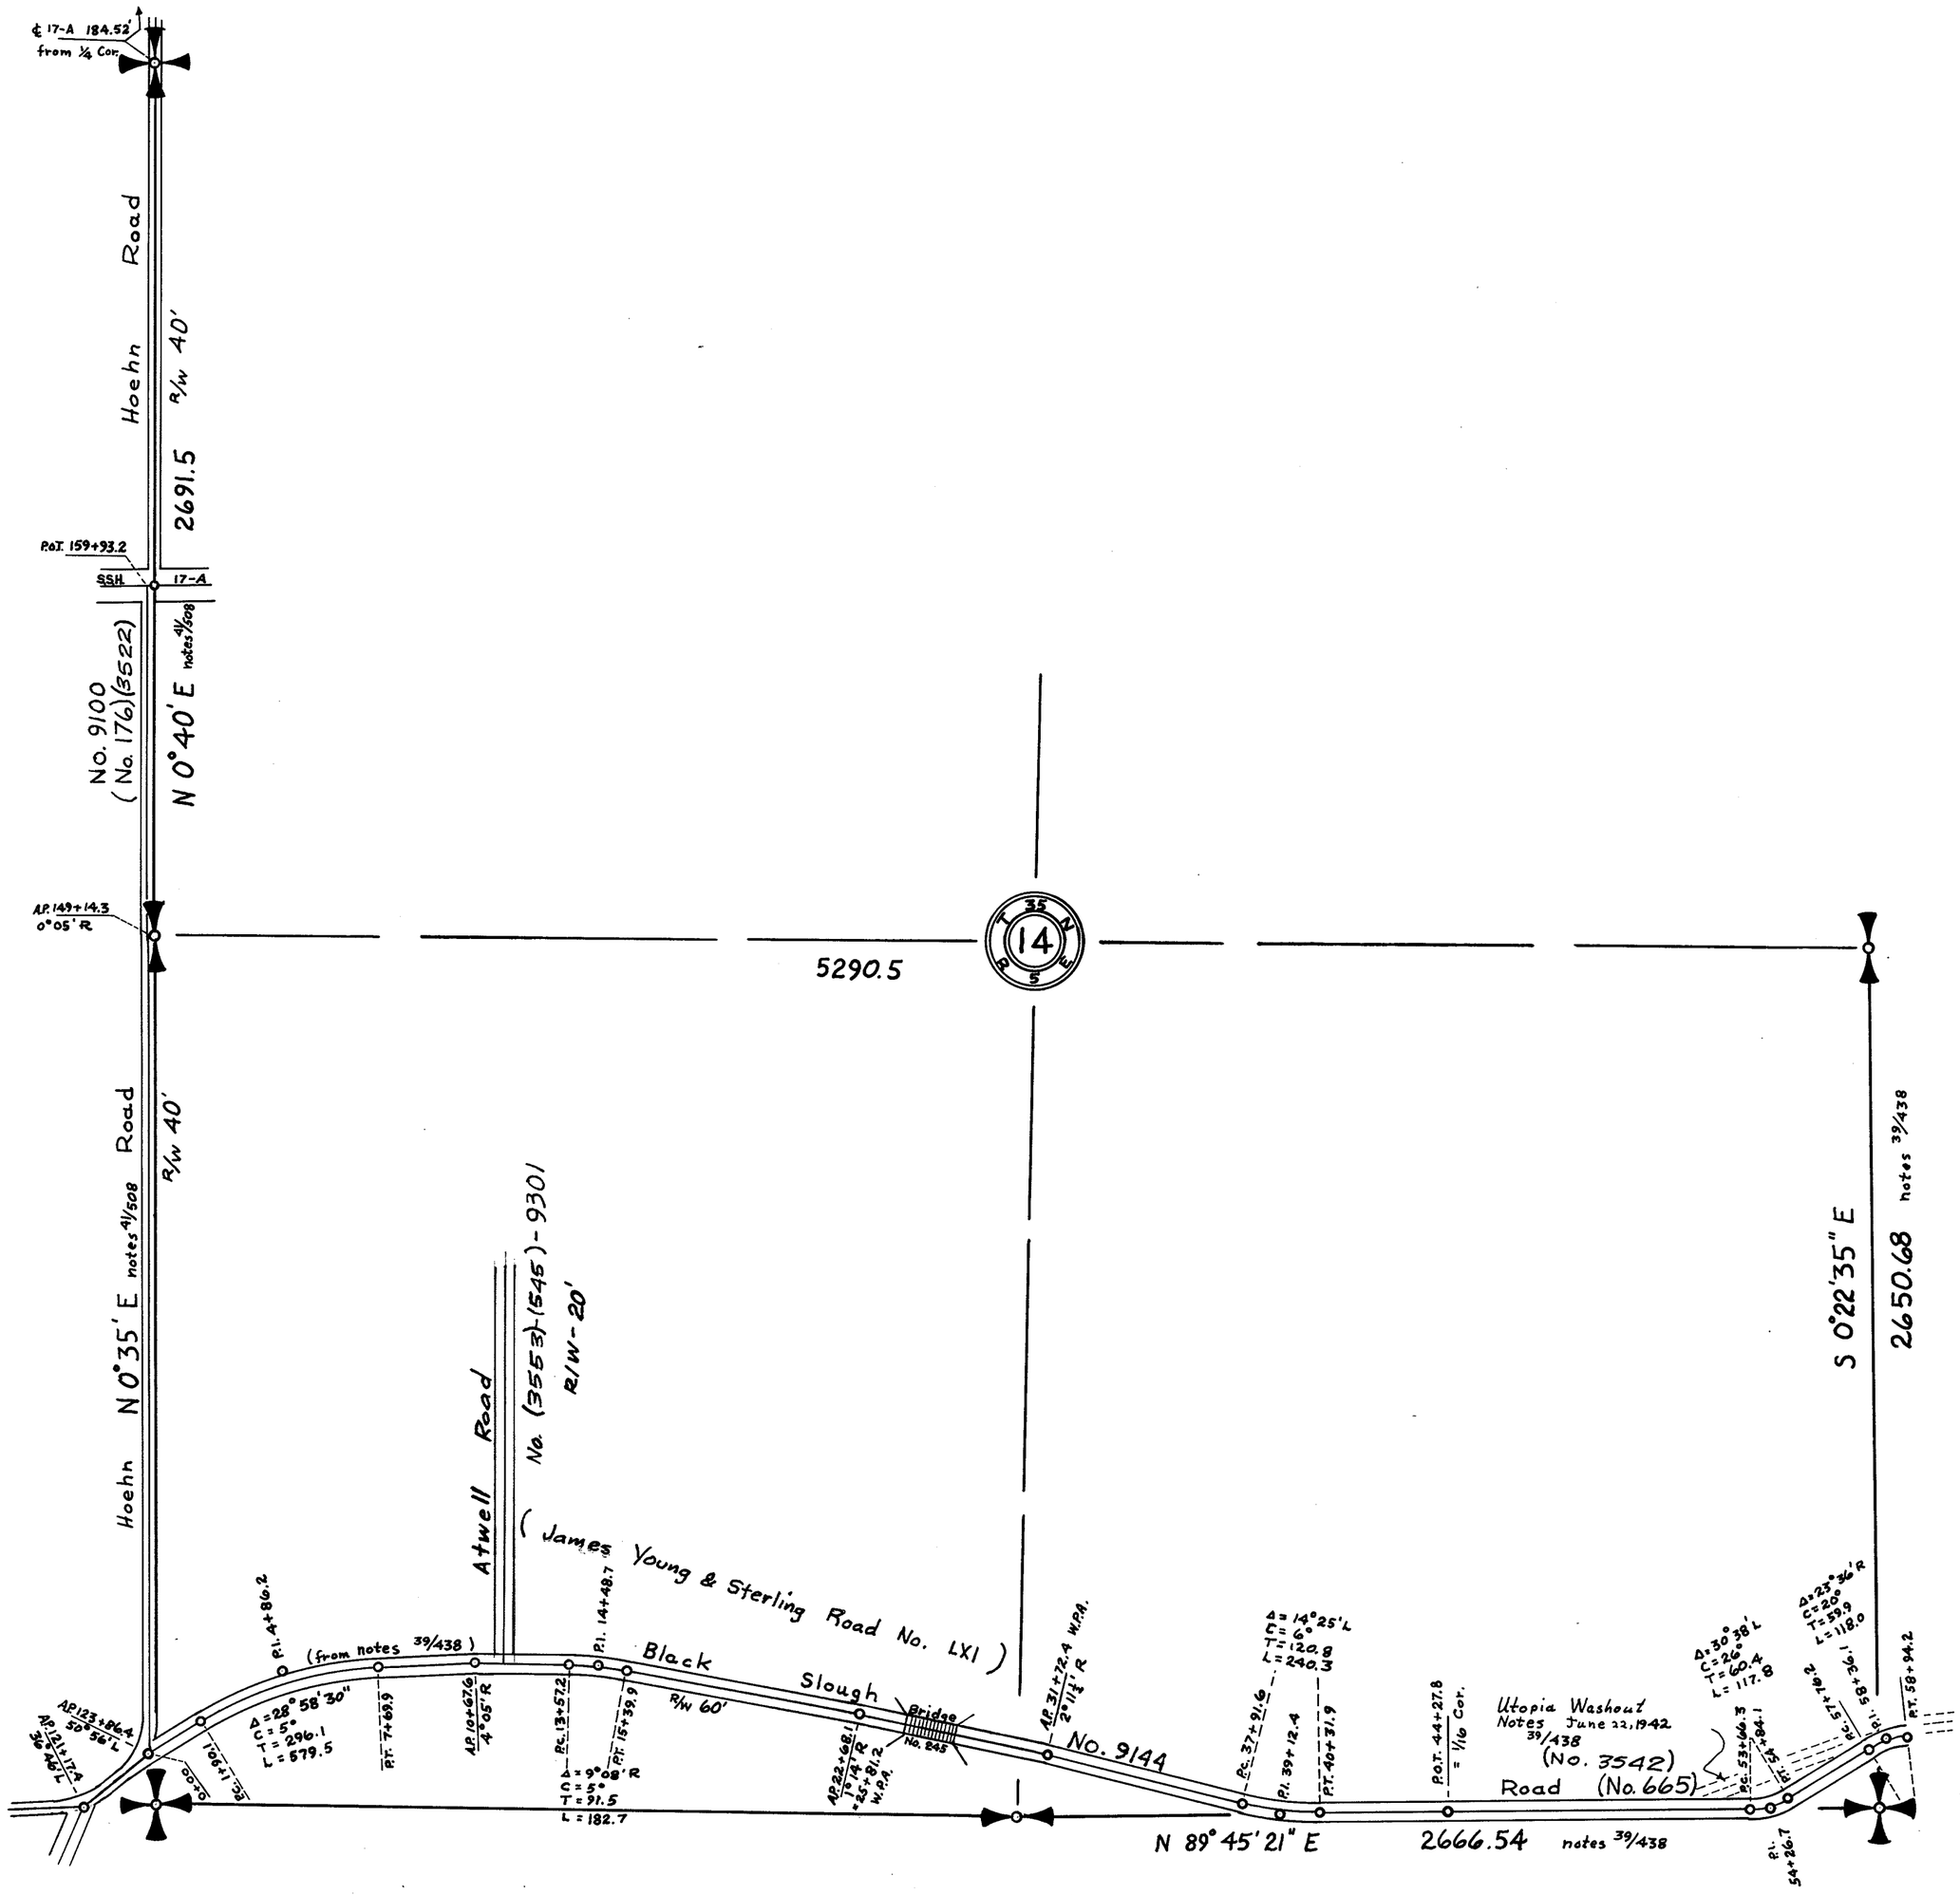

SECTION 15


TOWNSHIP 35 NORTH, RANGE 5 EAST, W. M.

SKAGIT COUNTY, WASH.

SCALE, 1 INCH--400 FEET

W.A. COSTELLO COUNTY ENGINEER

Notes: 39/451

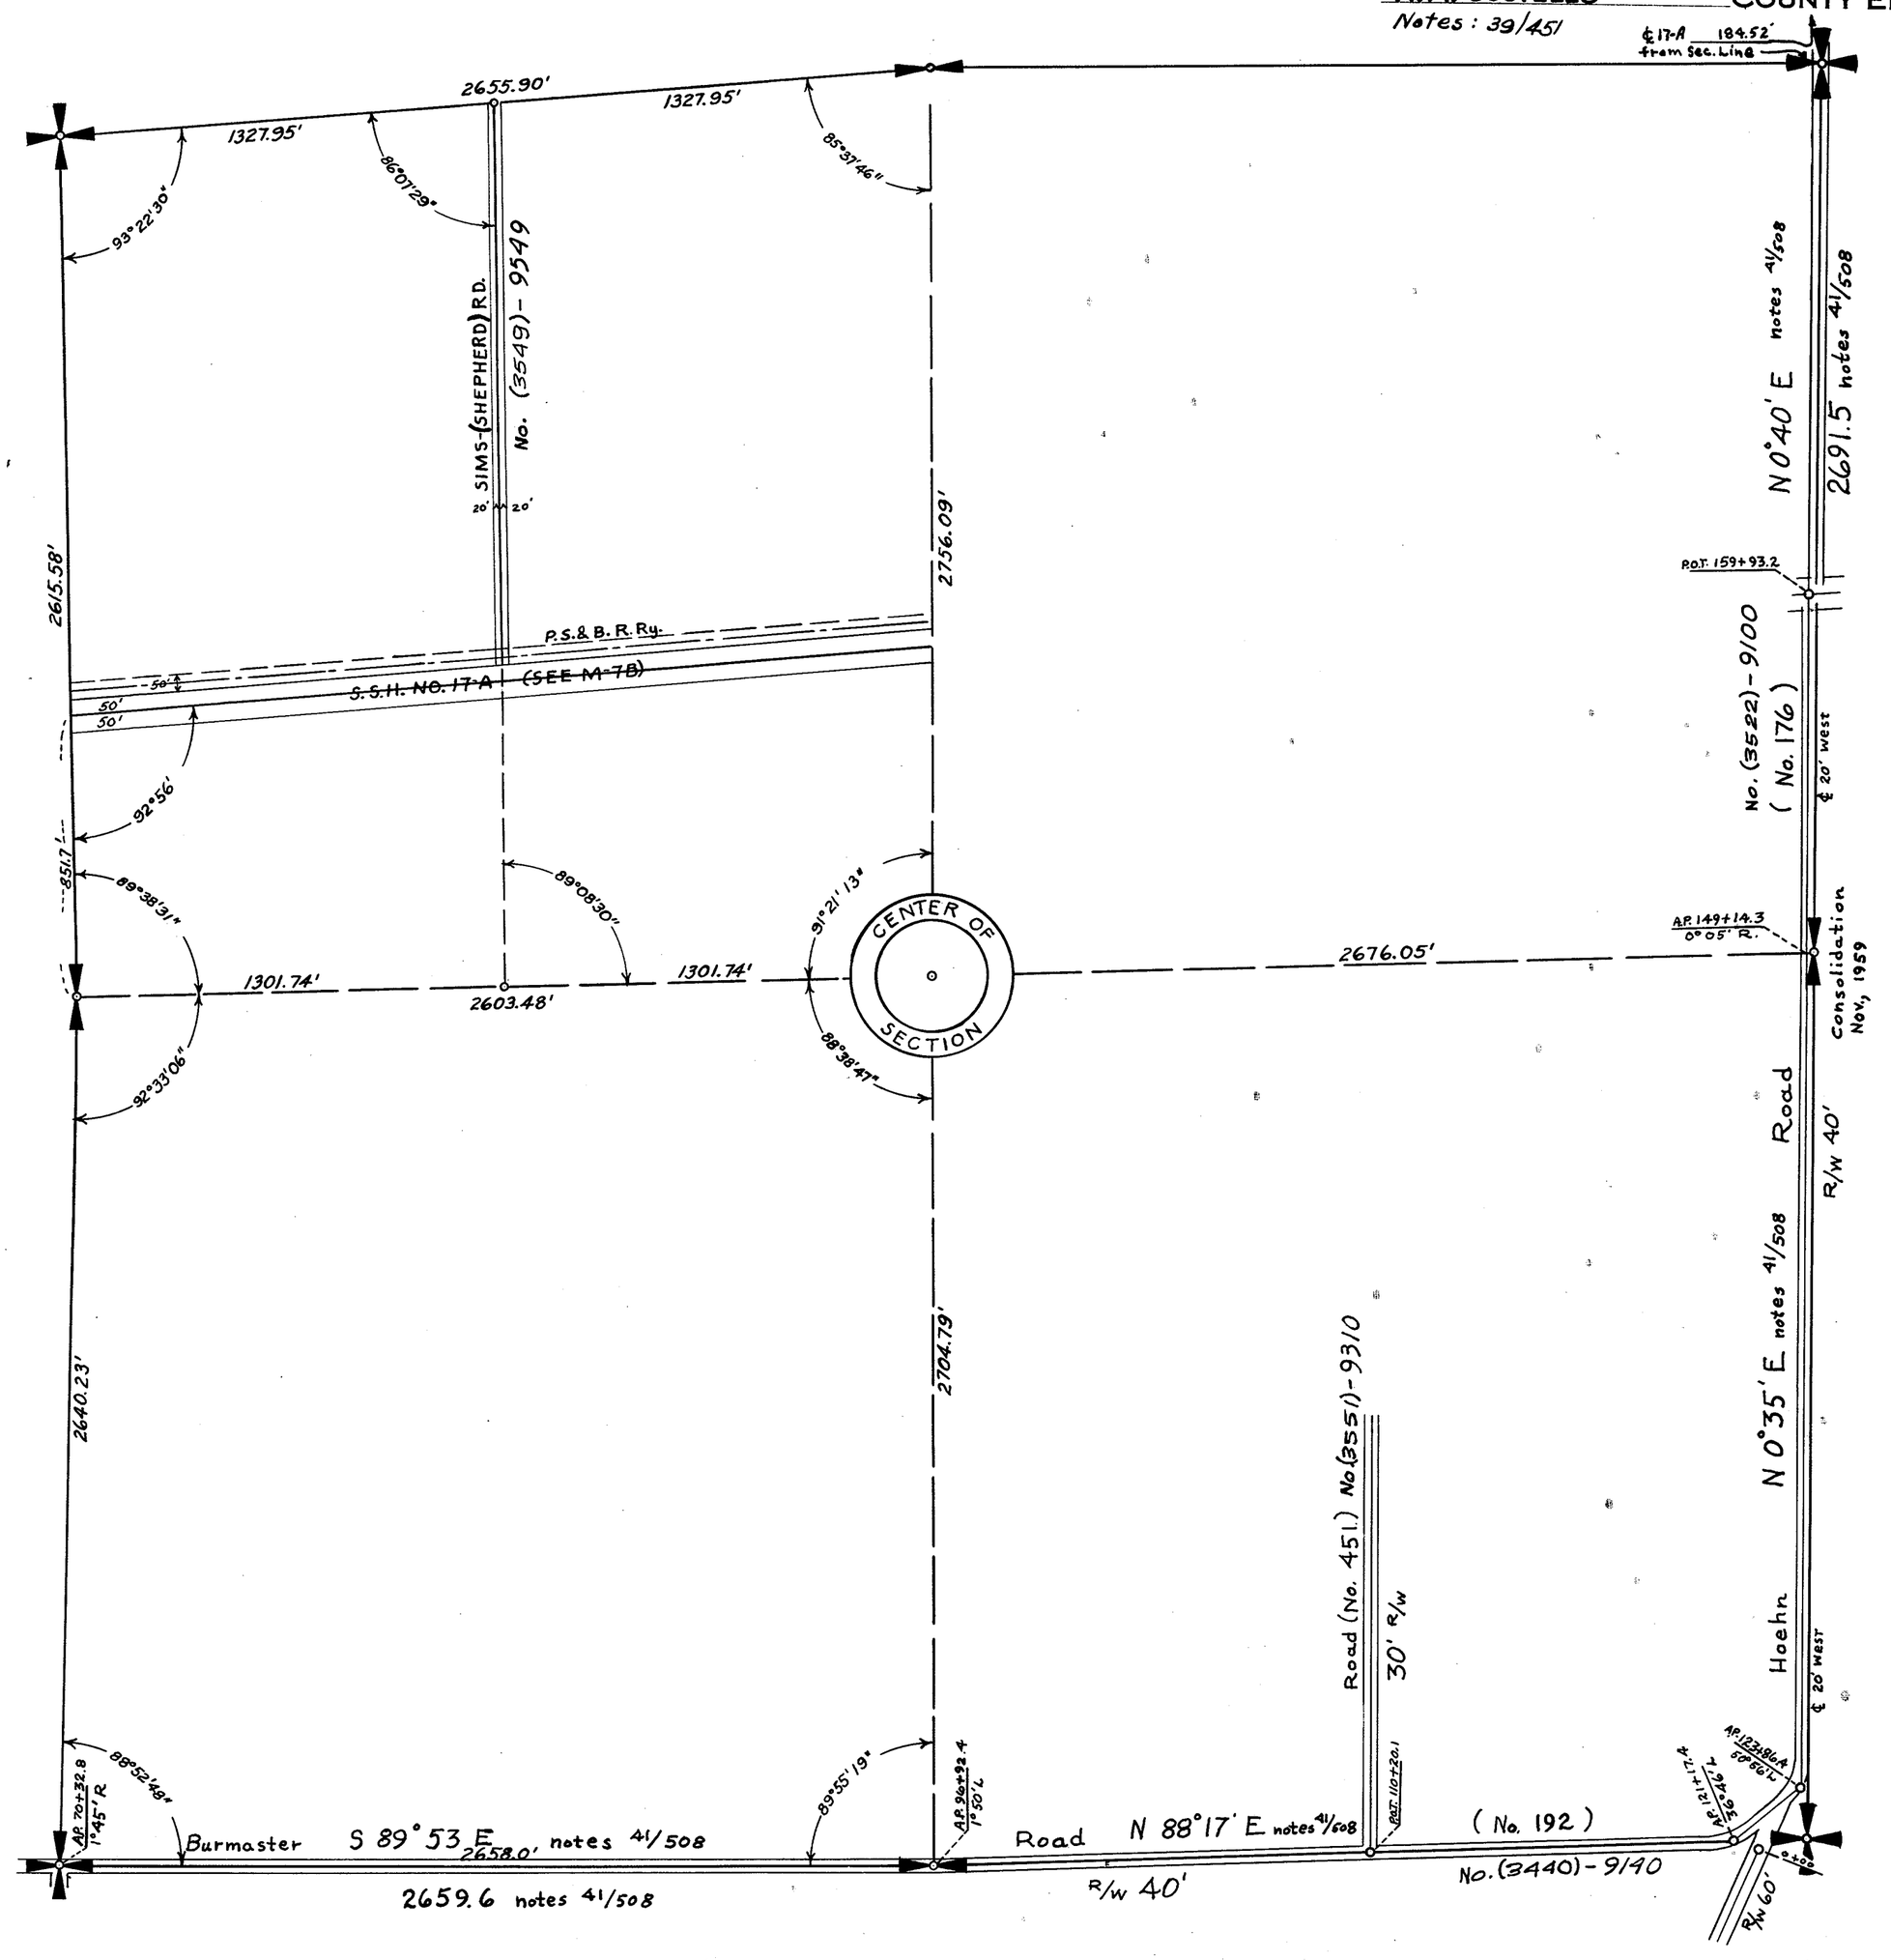


SECTION 16

TOWNSHIP 35 NORTH, RANGE 5 EAST, W. M.
SKAGIT COUNTY, WASH.

SCALE, 1 INCH–400 FEET
Jan. 1932 - Notes H-198

Knapp COUNTY ENGINEER

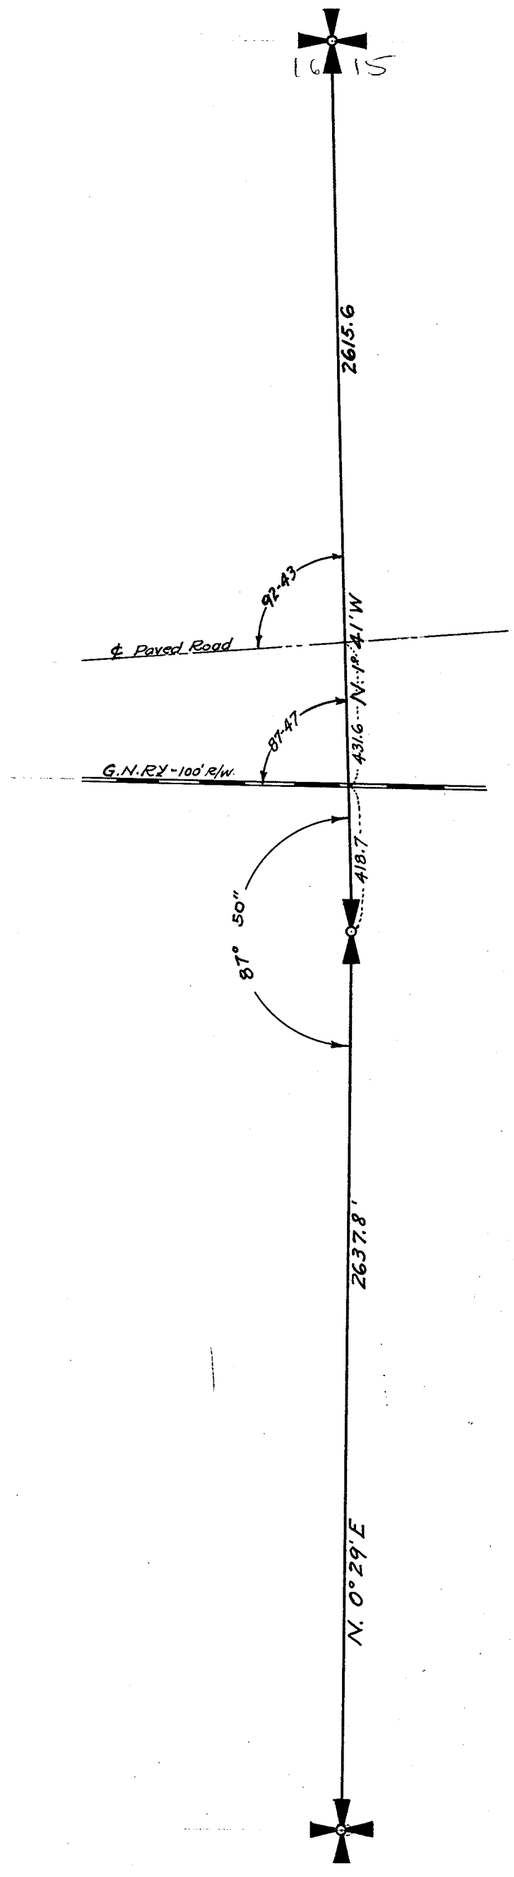


SECTION 16

TOWNSHIP 35 NORTH, RANGE 5 EAST, W. M.

SKAGIT COUNTY, WASH.

SCALE, 1 INCH–400 FEET

Arthur L. Strong. COUNTY ENGINEER

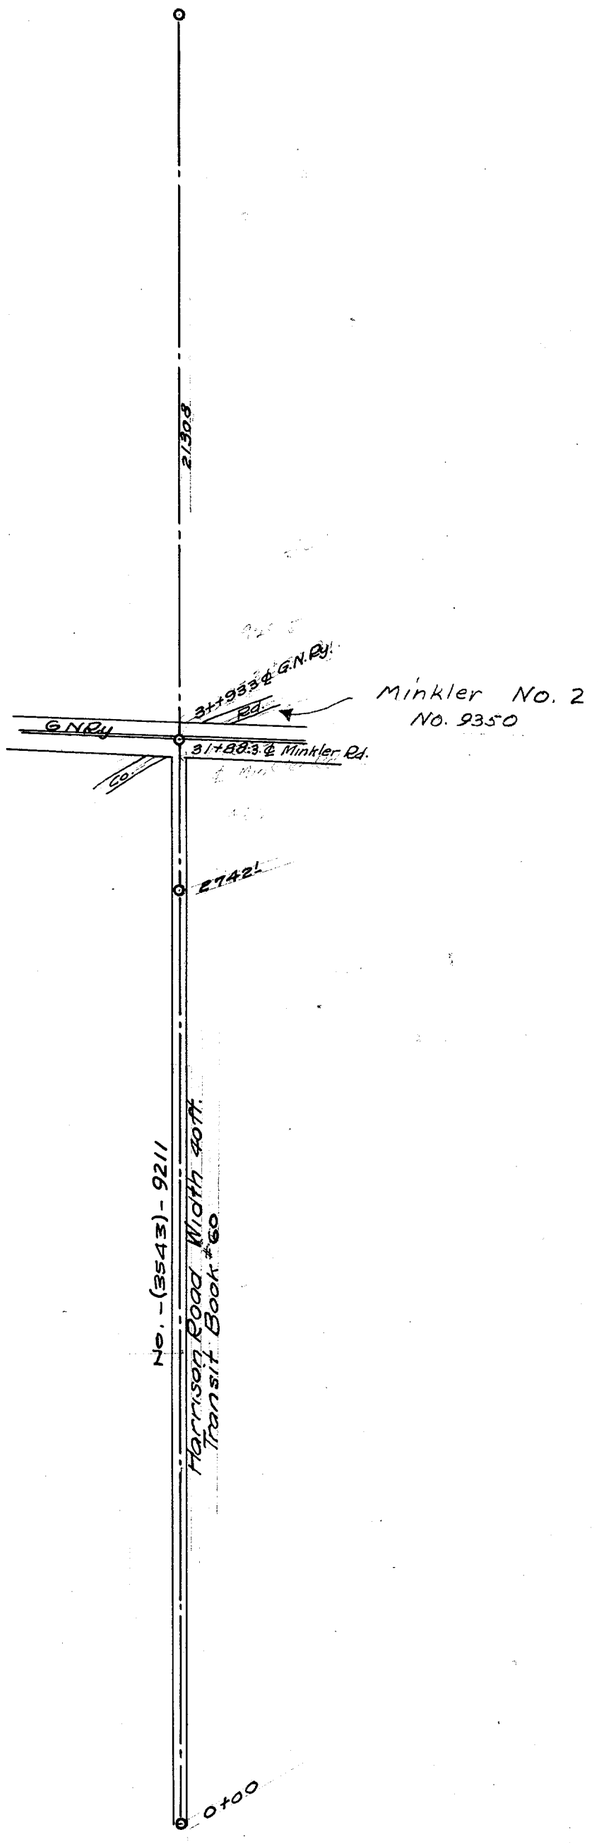

SECTION 17


TOWNSHIP 35 NORTH, RANGE 5 EAST, W. M.

SKAGIT COUNTY, WASH.

SCALE, 1 INCH--400 FEET

DATE Aug. 1965

COUNTY ENGINEER

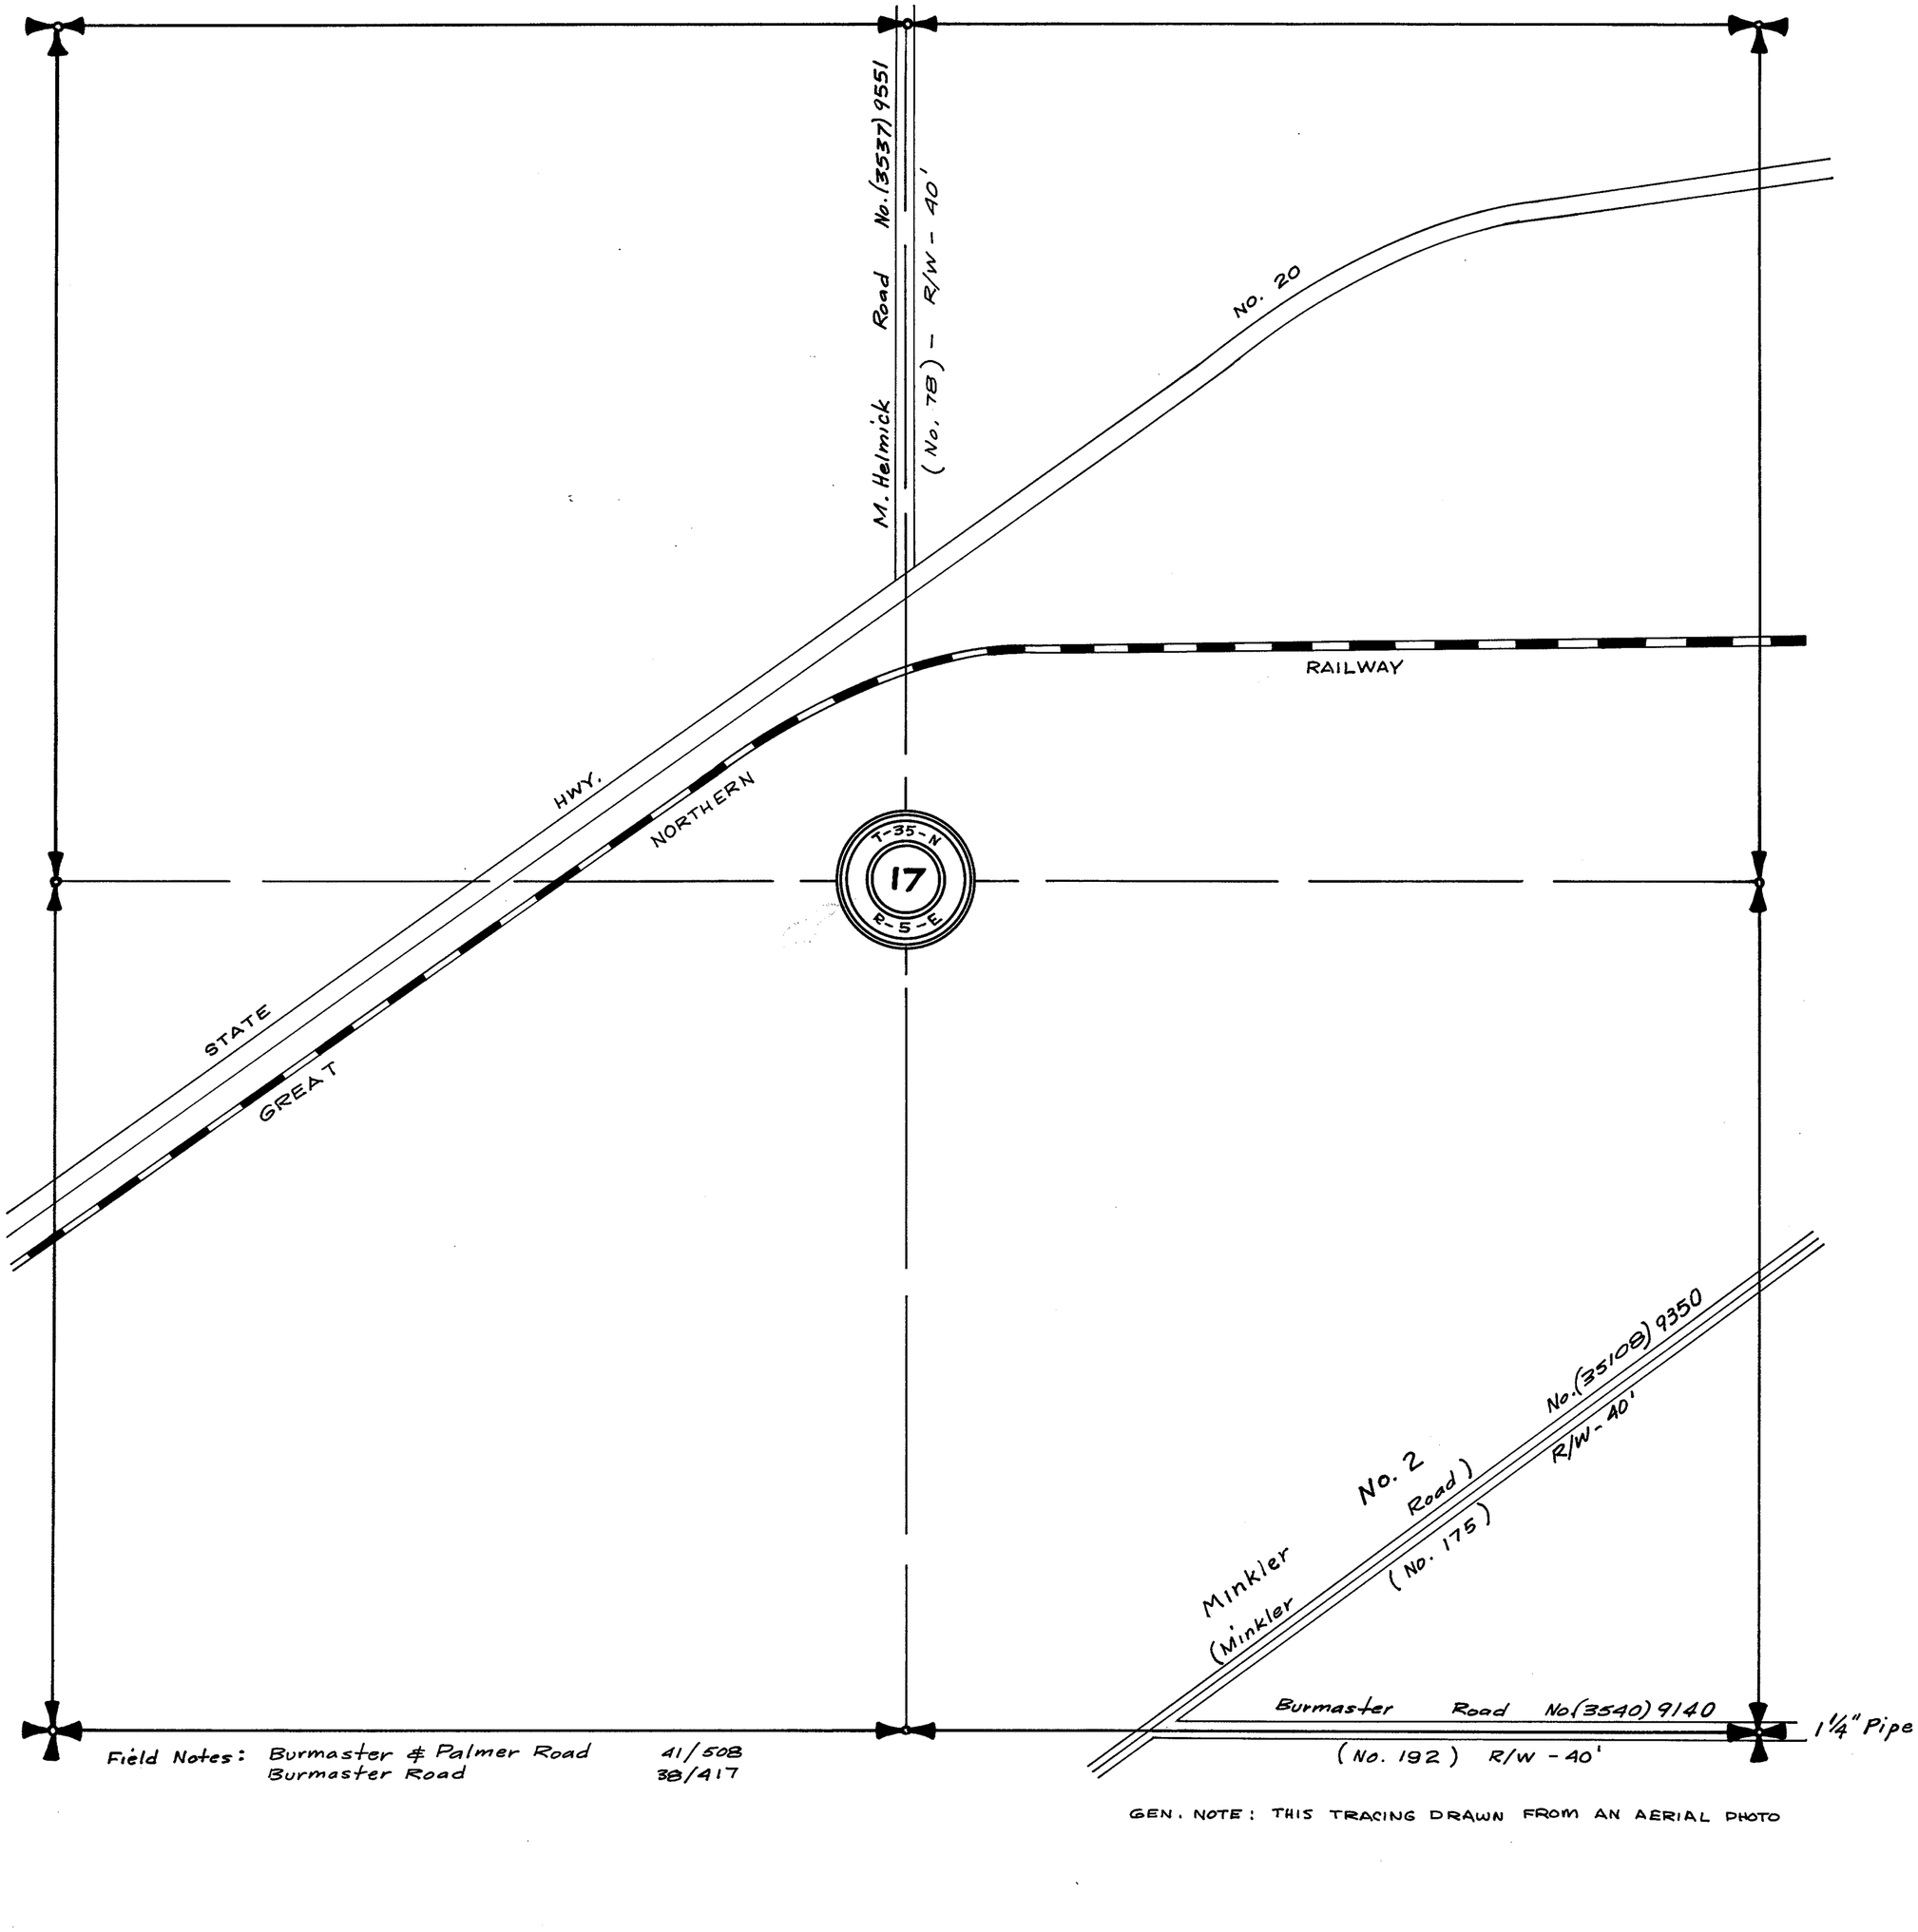

Field Notes: Burmaster & Palmer Road 41/508
Burmaster Road 38/417

GEN. NOTE: THIS TRACING DRAWN FROM AN AERIAL PHOTO



TOWNSHIP 35 NORTH. RANGE 5 EAST. W. M.
SKAGIT COUNTY. WASH.

SCALE, 1 INCH—400 FEET

LLOYD H. JOHNSON COUNTY ENGINEER

DATE JUNE 29, 1972

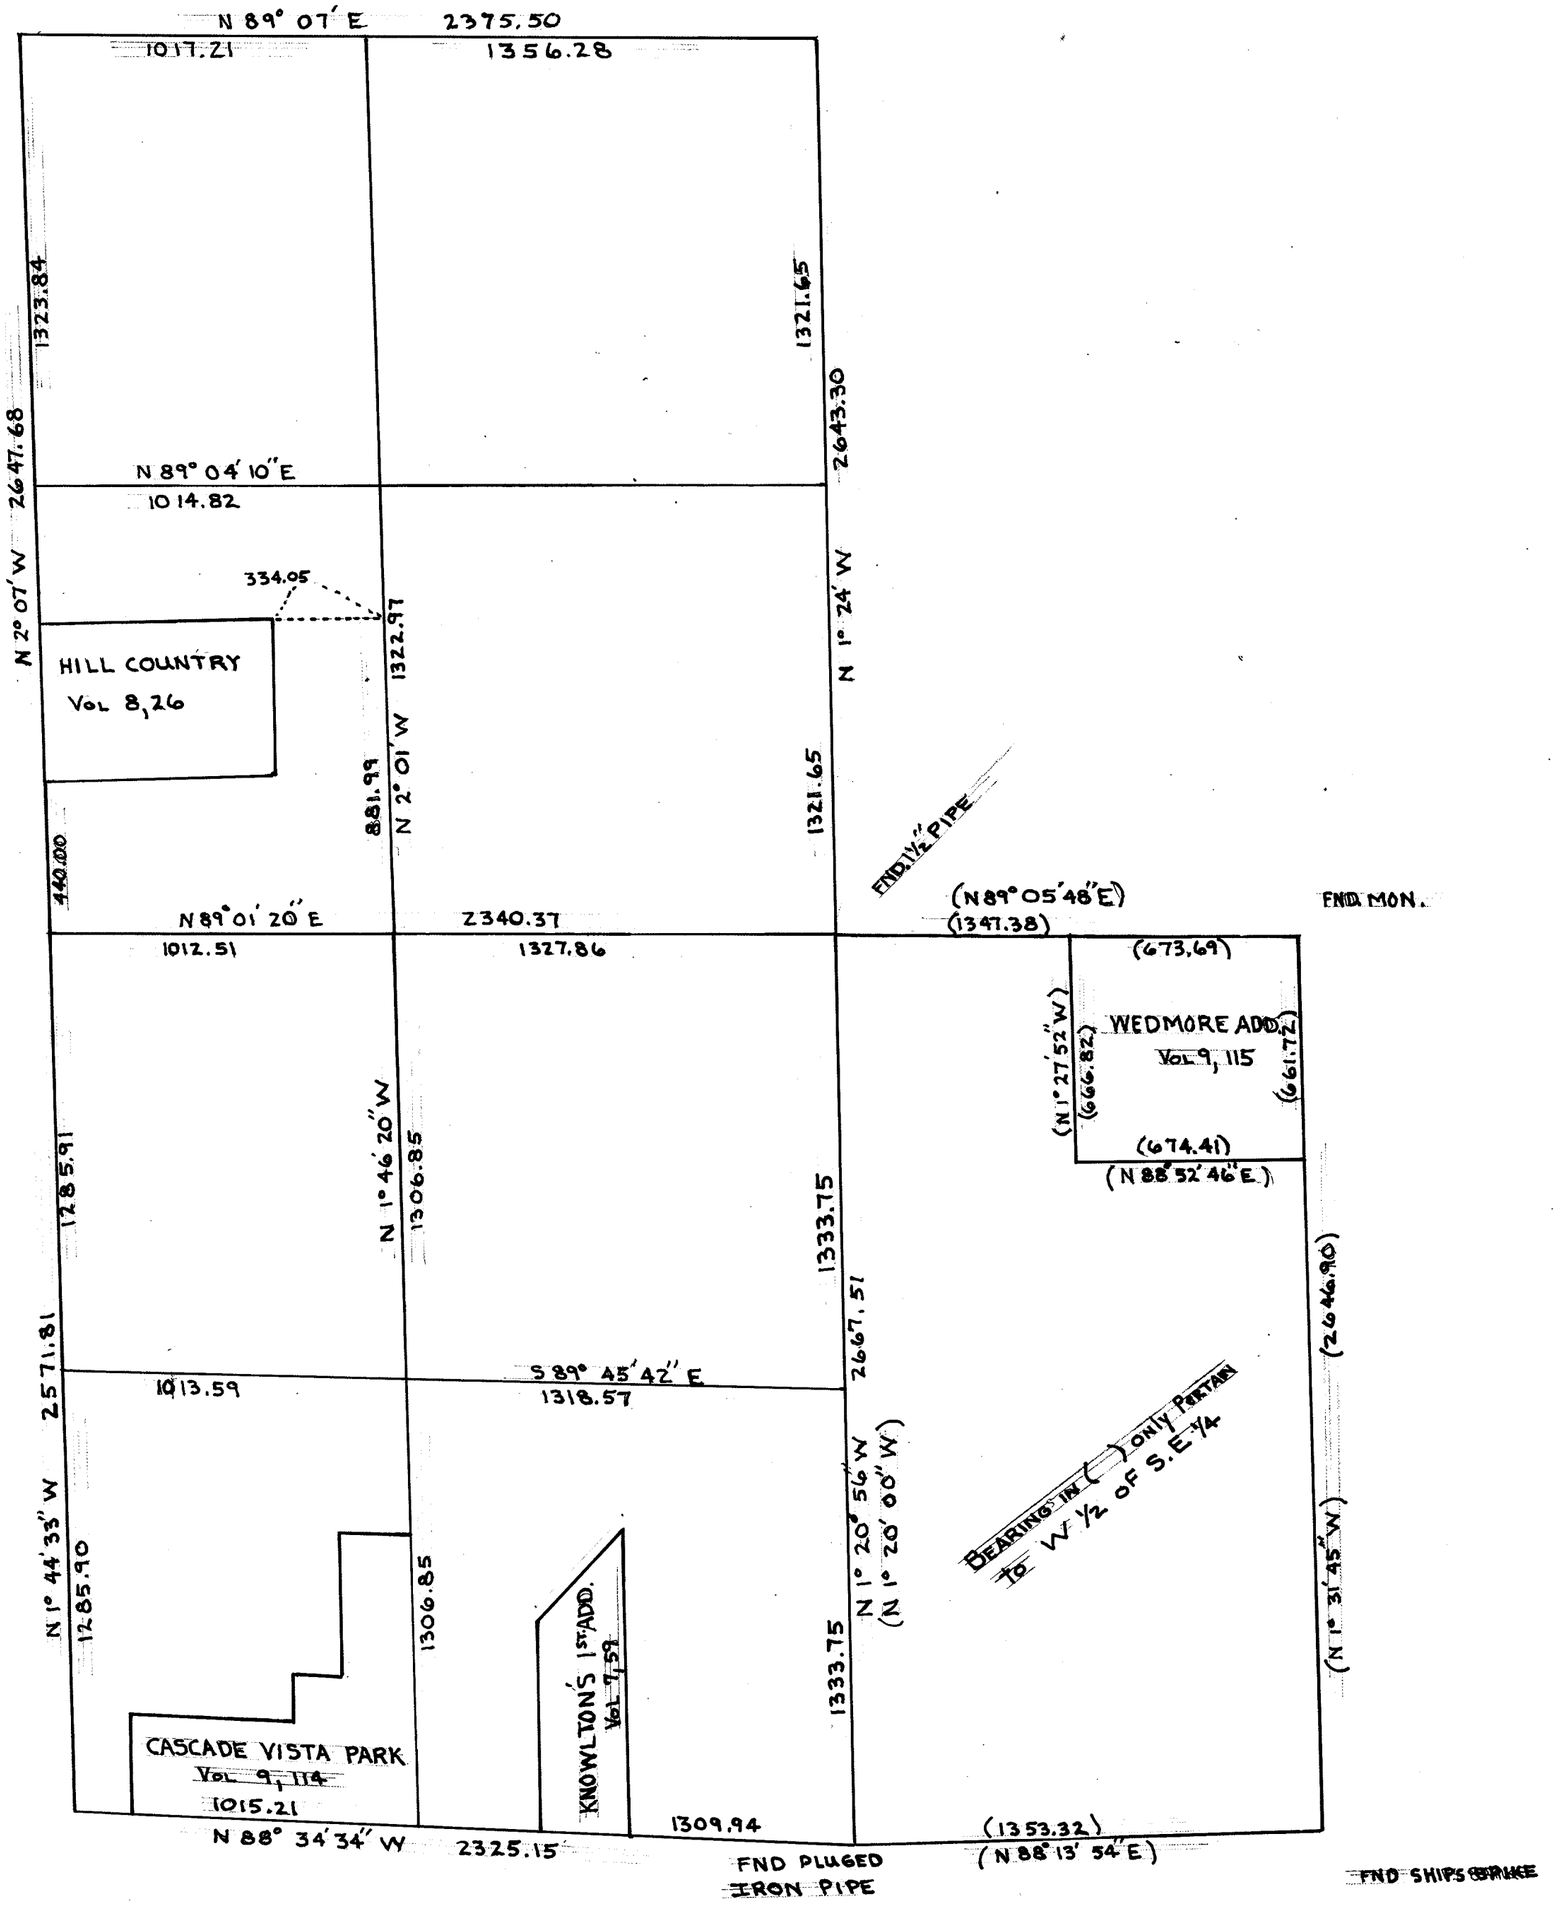

SECTION 18


TOWNSHIP 35 NORTH, RANGE 5 EAST, W. M.

SKAGIT COUNTY, WASH.

SCALE, 1 INCH--400 FEET

DATE Aug. 1965

COUNTY ENGINEER

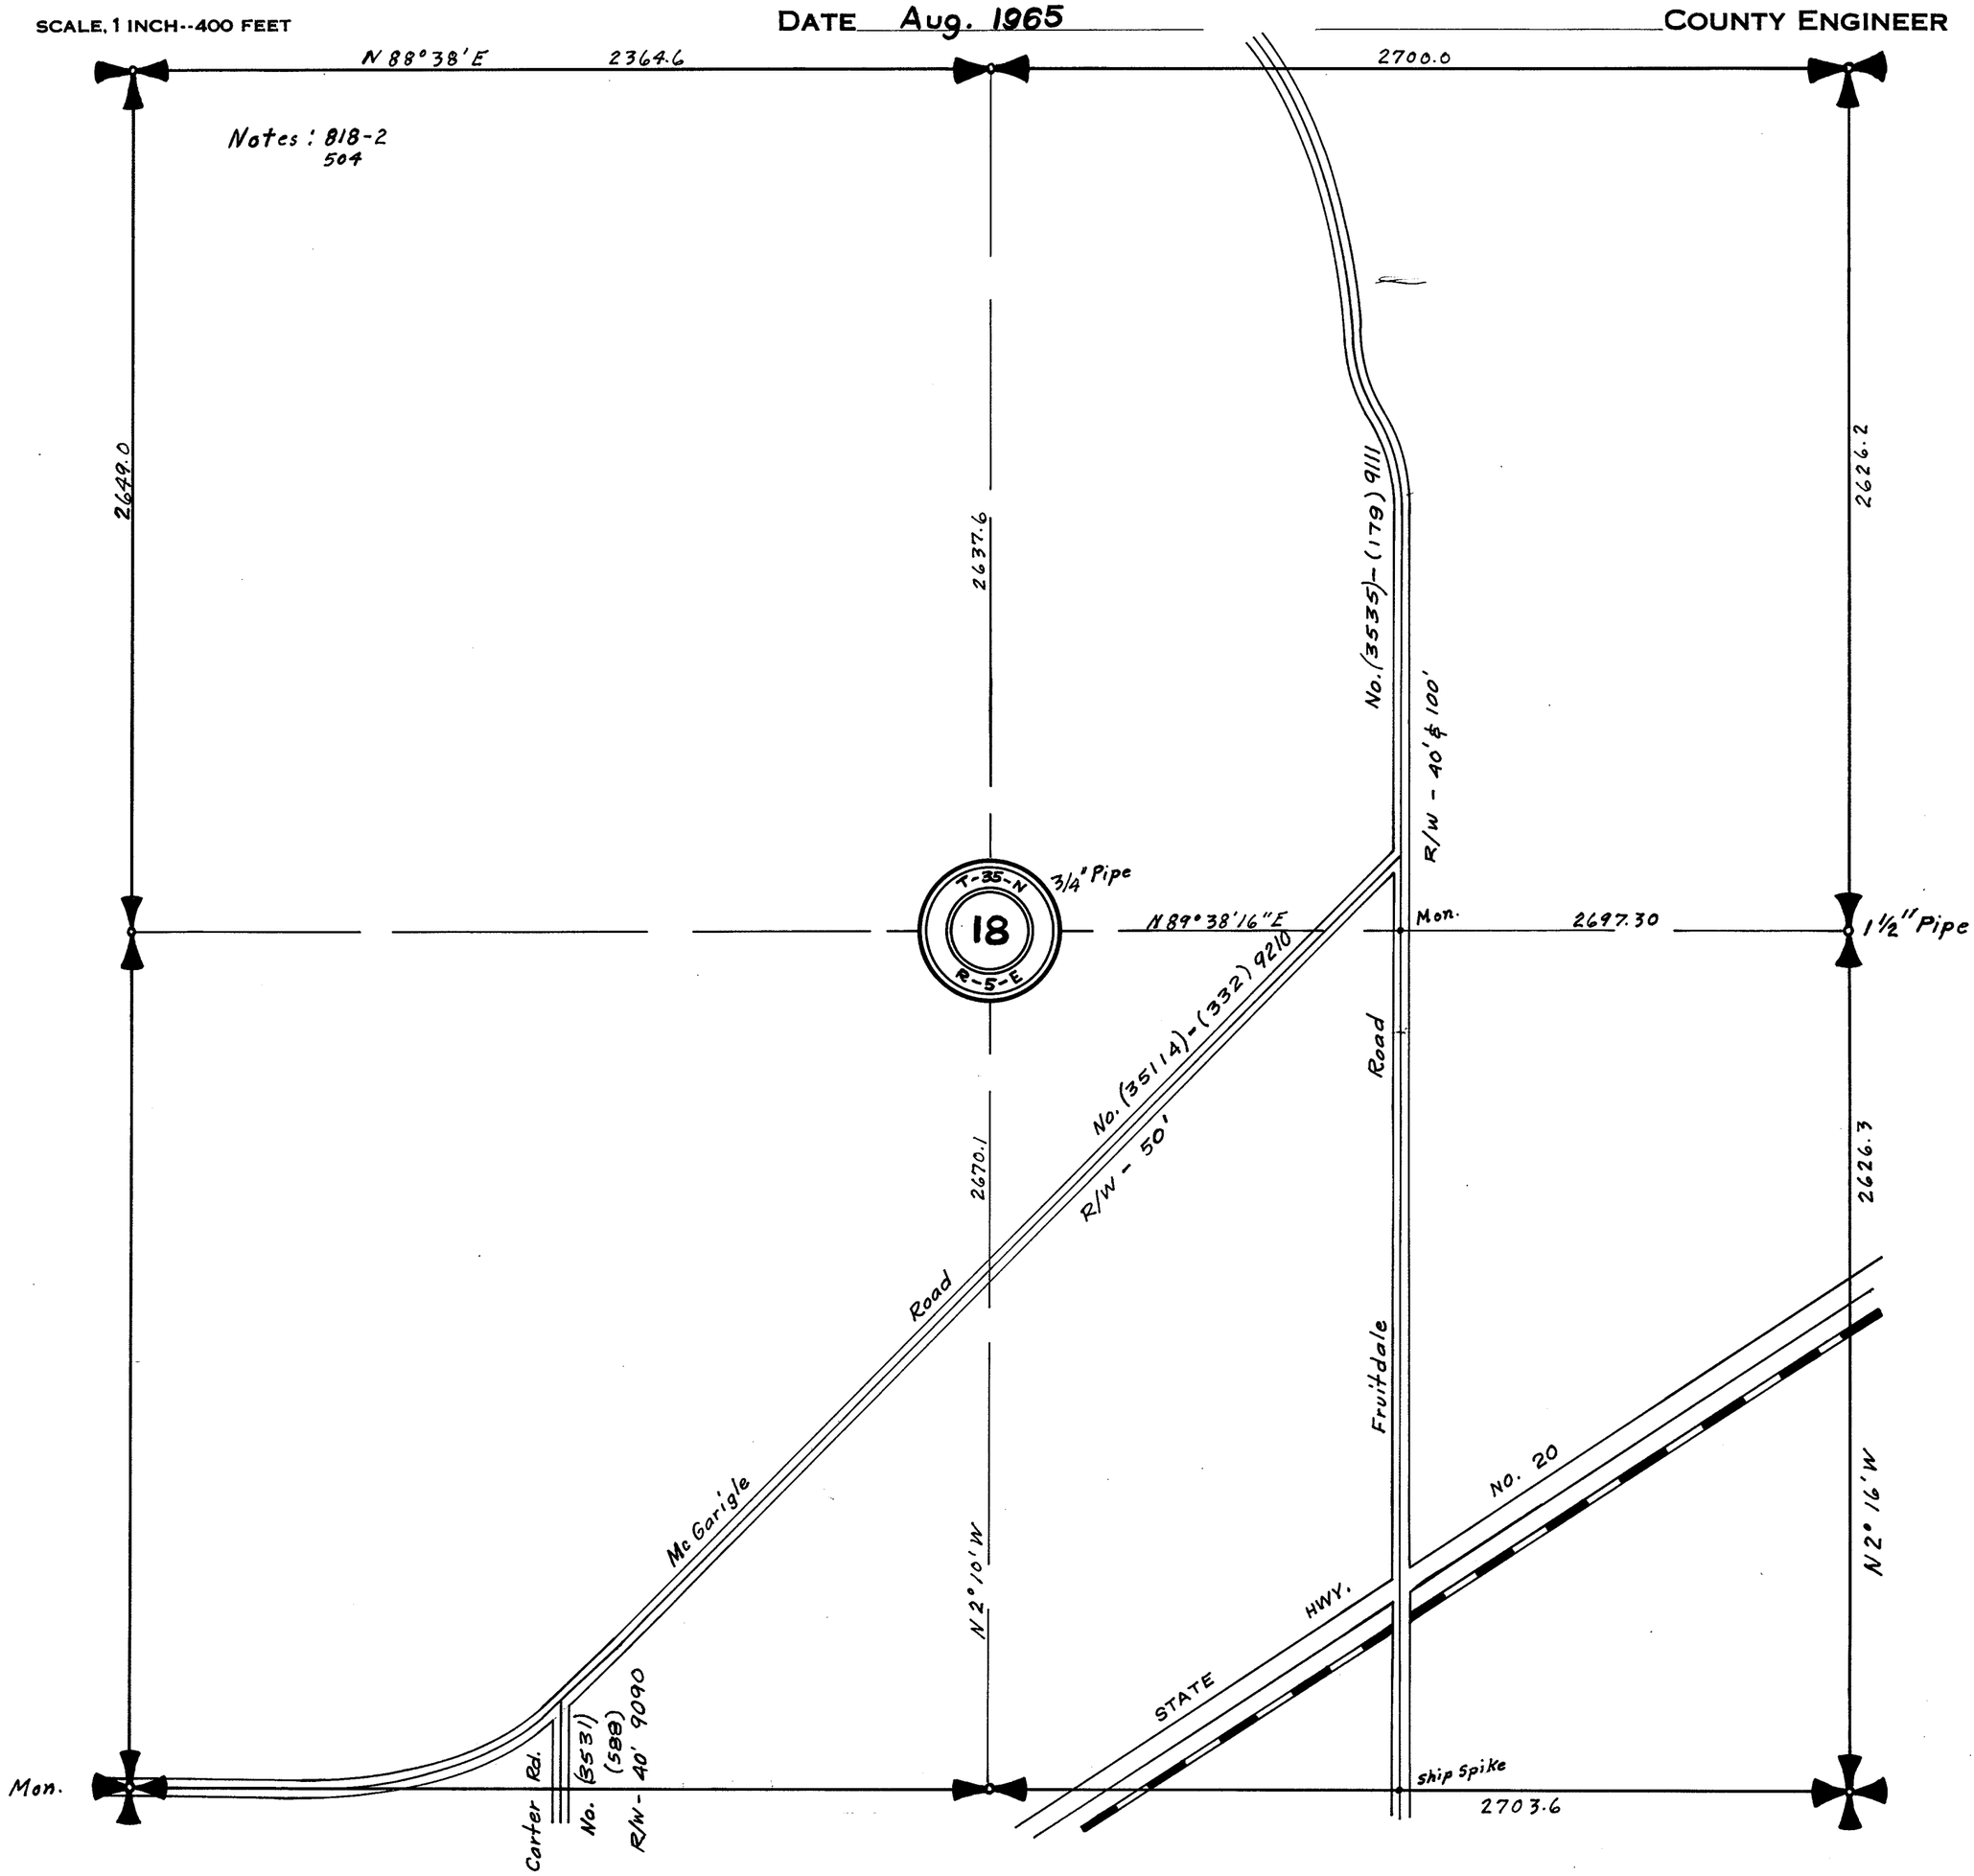



SECTION 19
TOWNSHIP 35 NORTH, RANGE 5 EAST, W. M.
SKAGIT COUNTY, WASH.

SCALE, 1 INCH--400 FEET


COUNTY ENGINEER

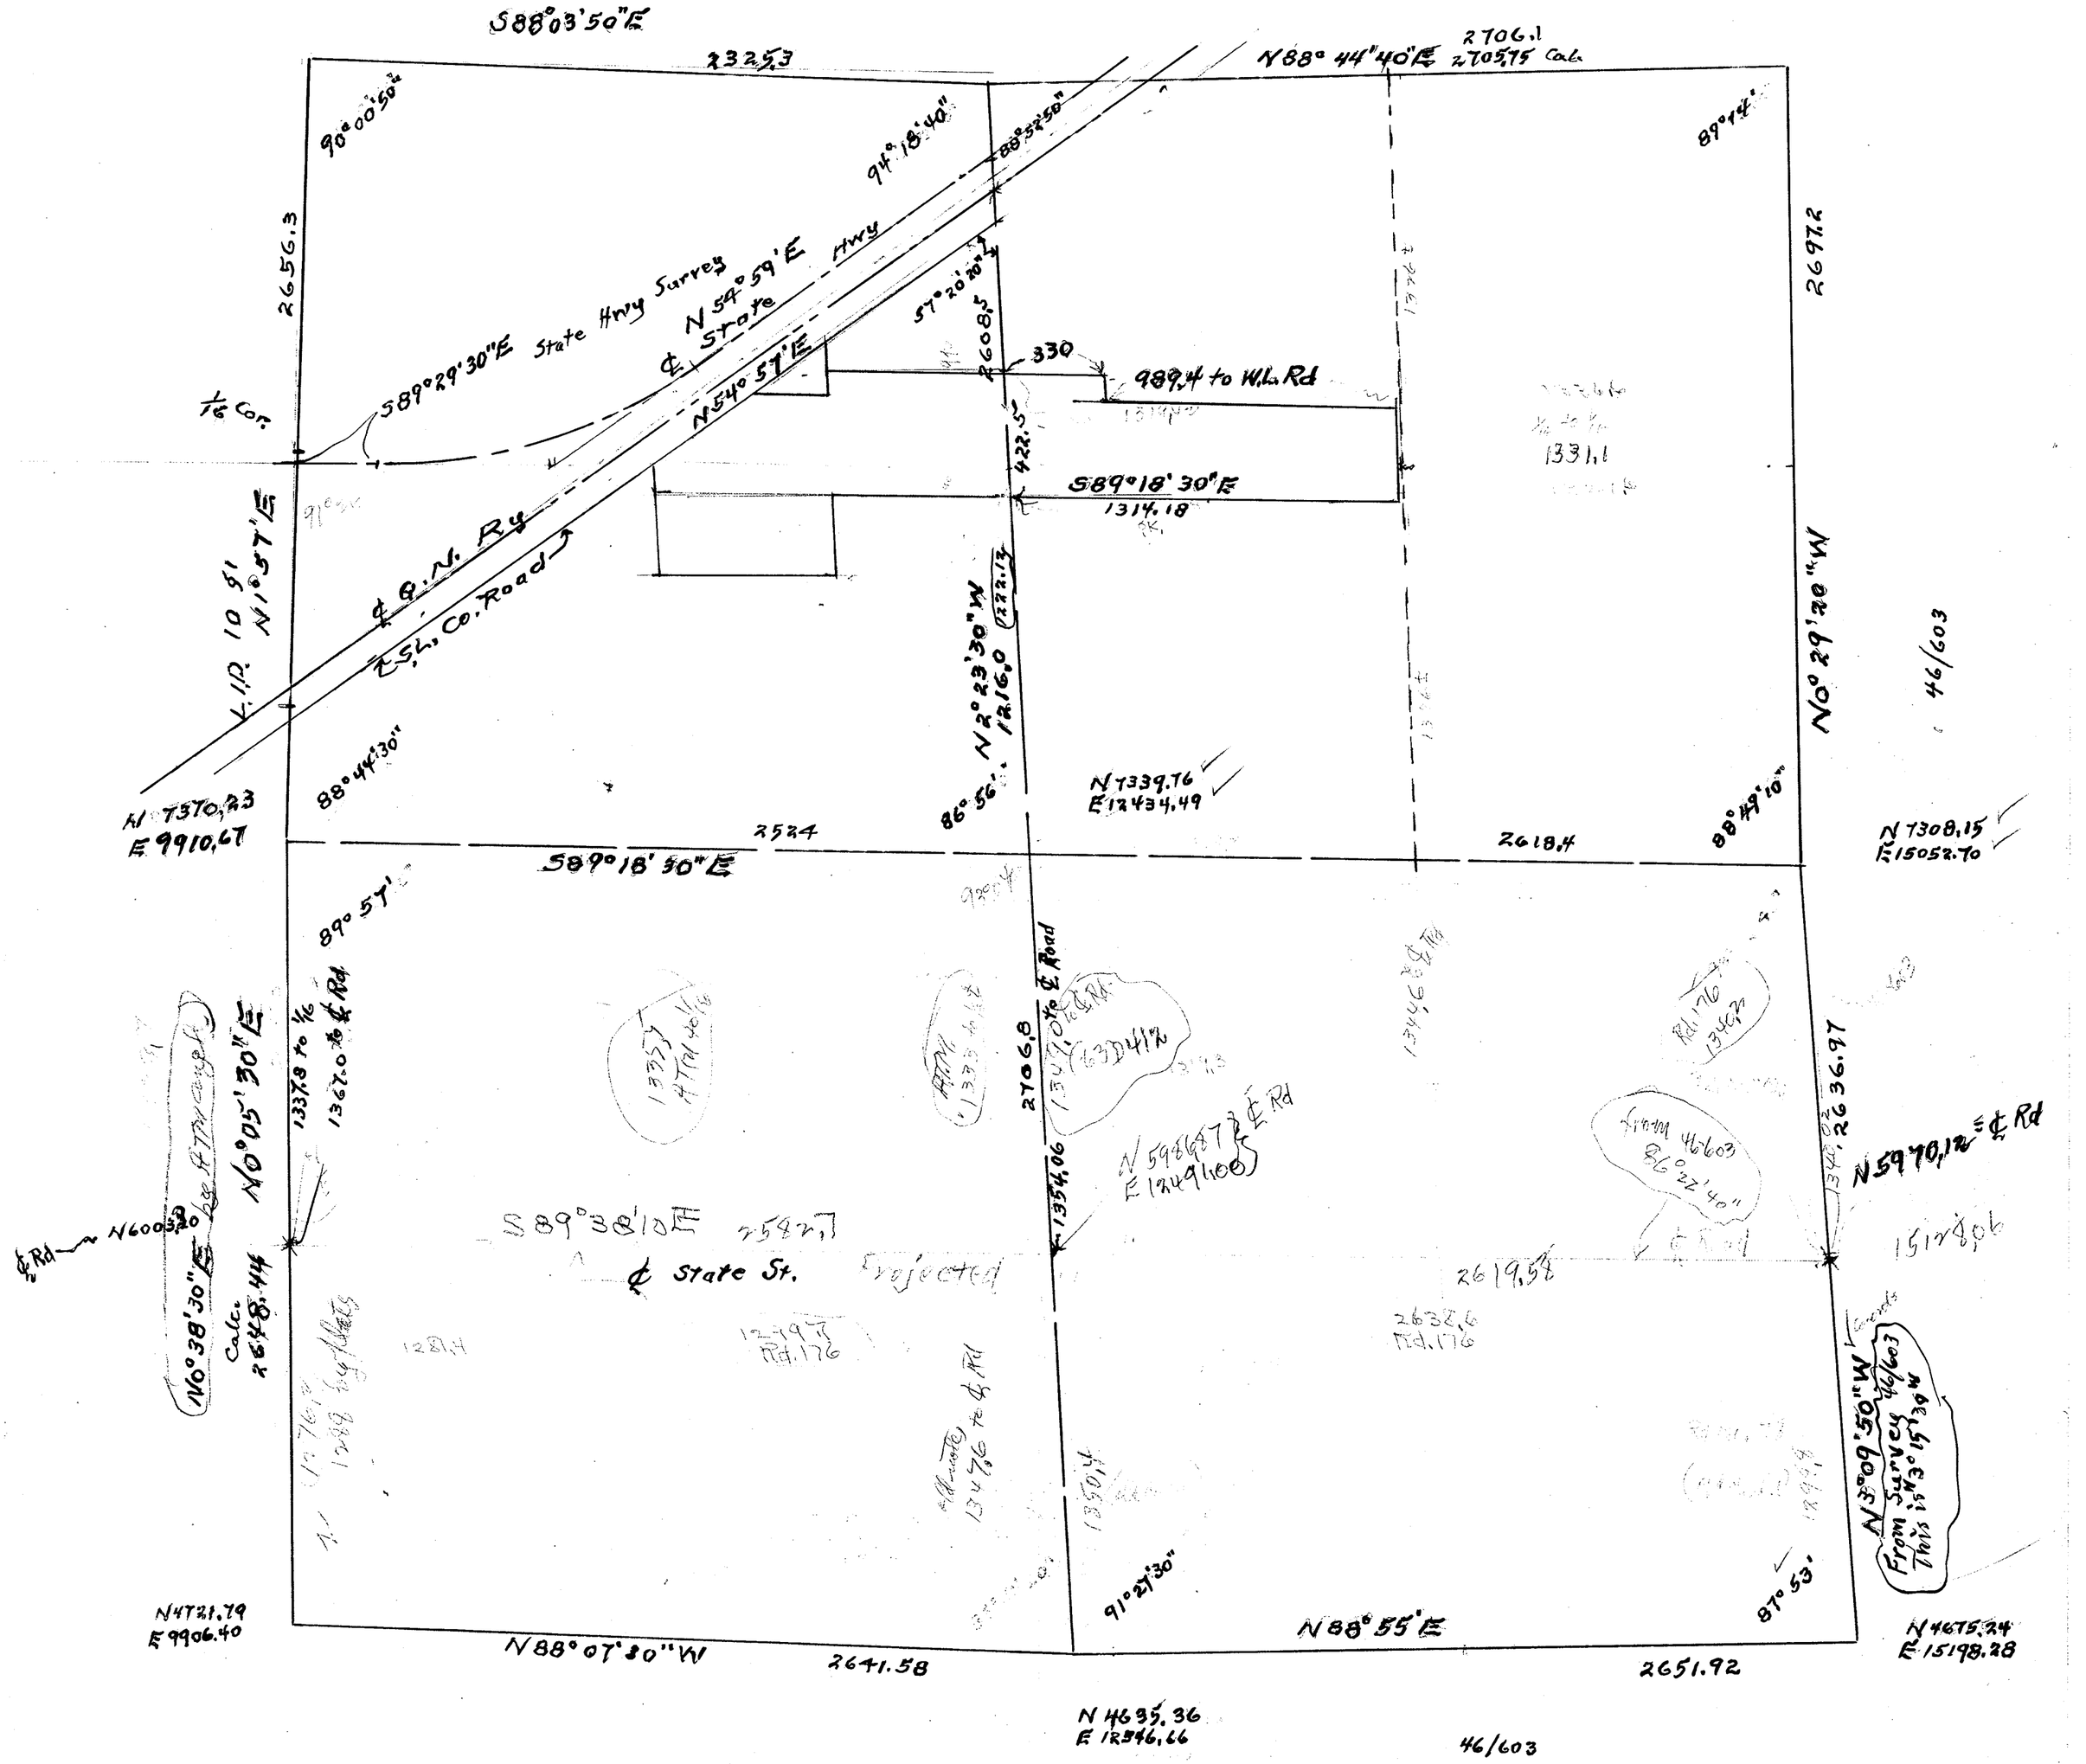

SECTION 19
TOWNSHIP 35 NORTH, RANGE 5 EAST, W. M.
SKAGIT COUNTY, WASH.


SCALE, 1 INCH--400 FEET

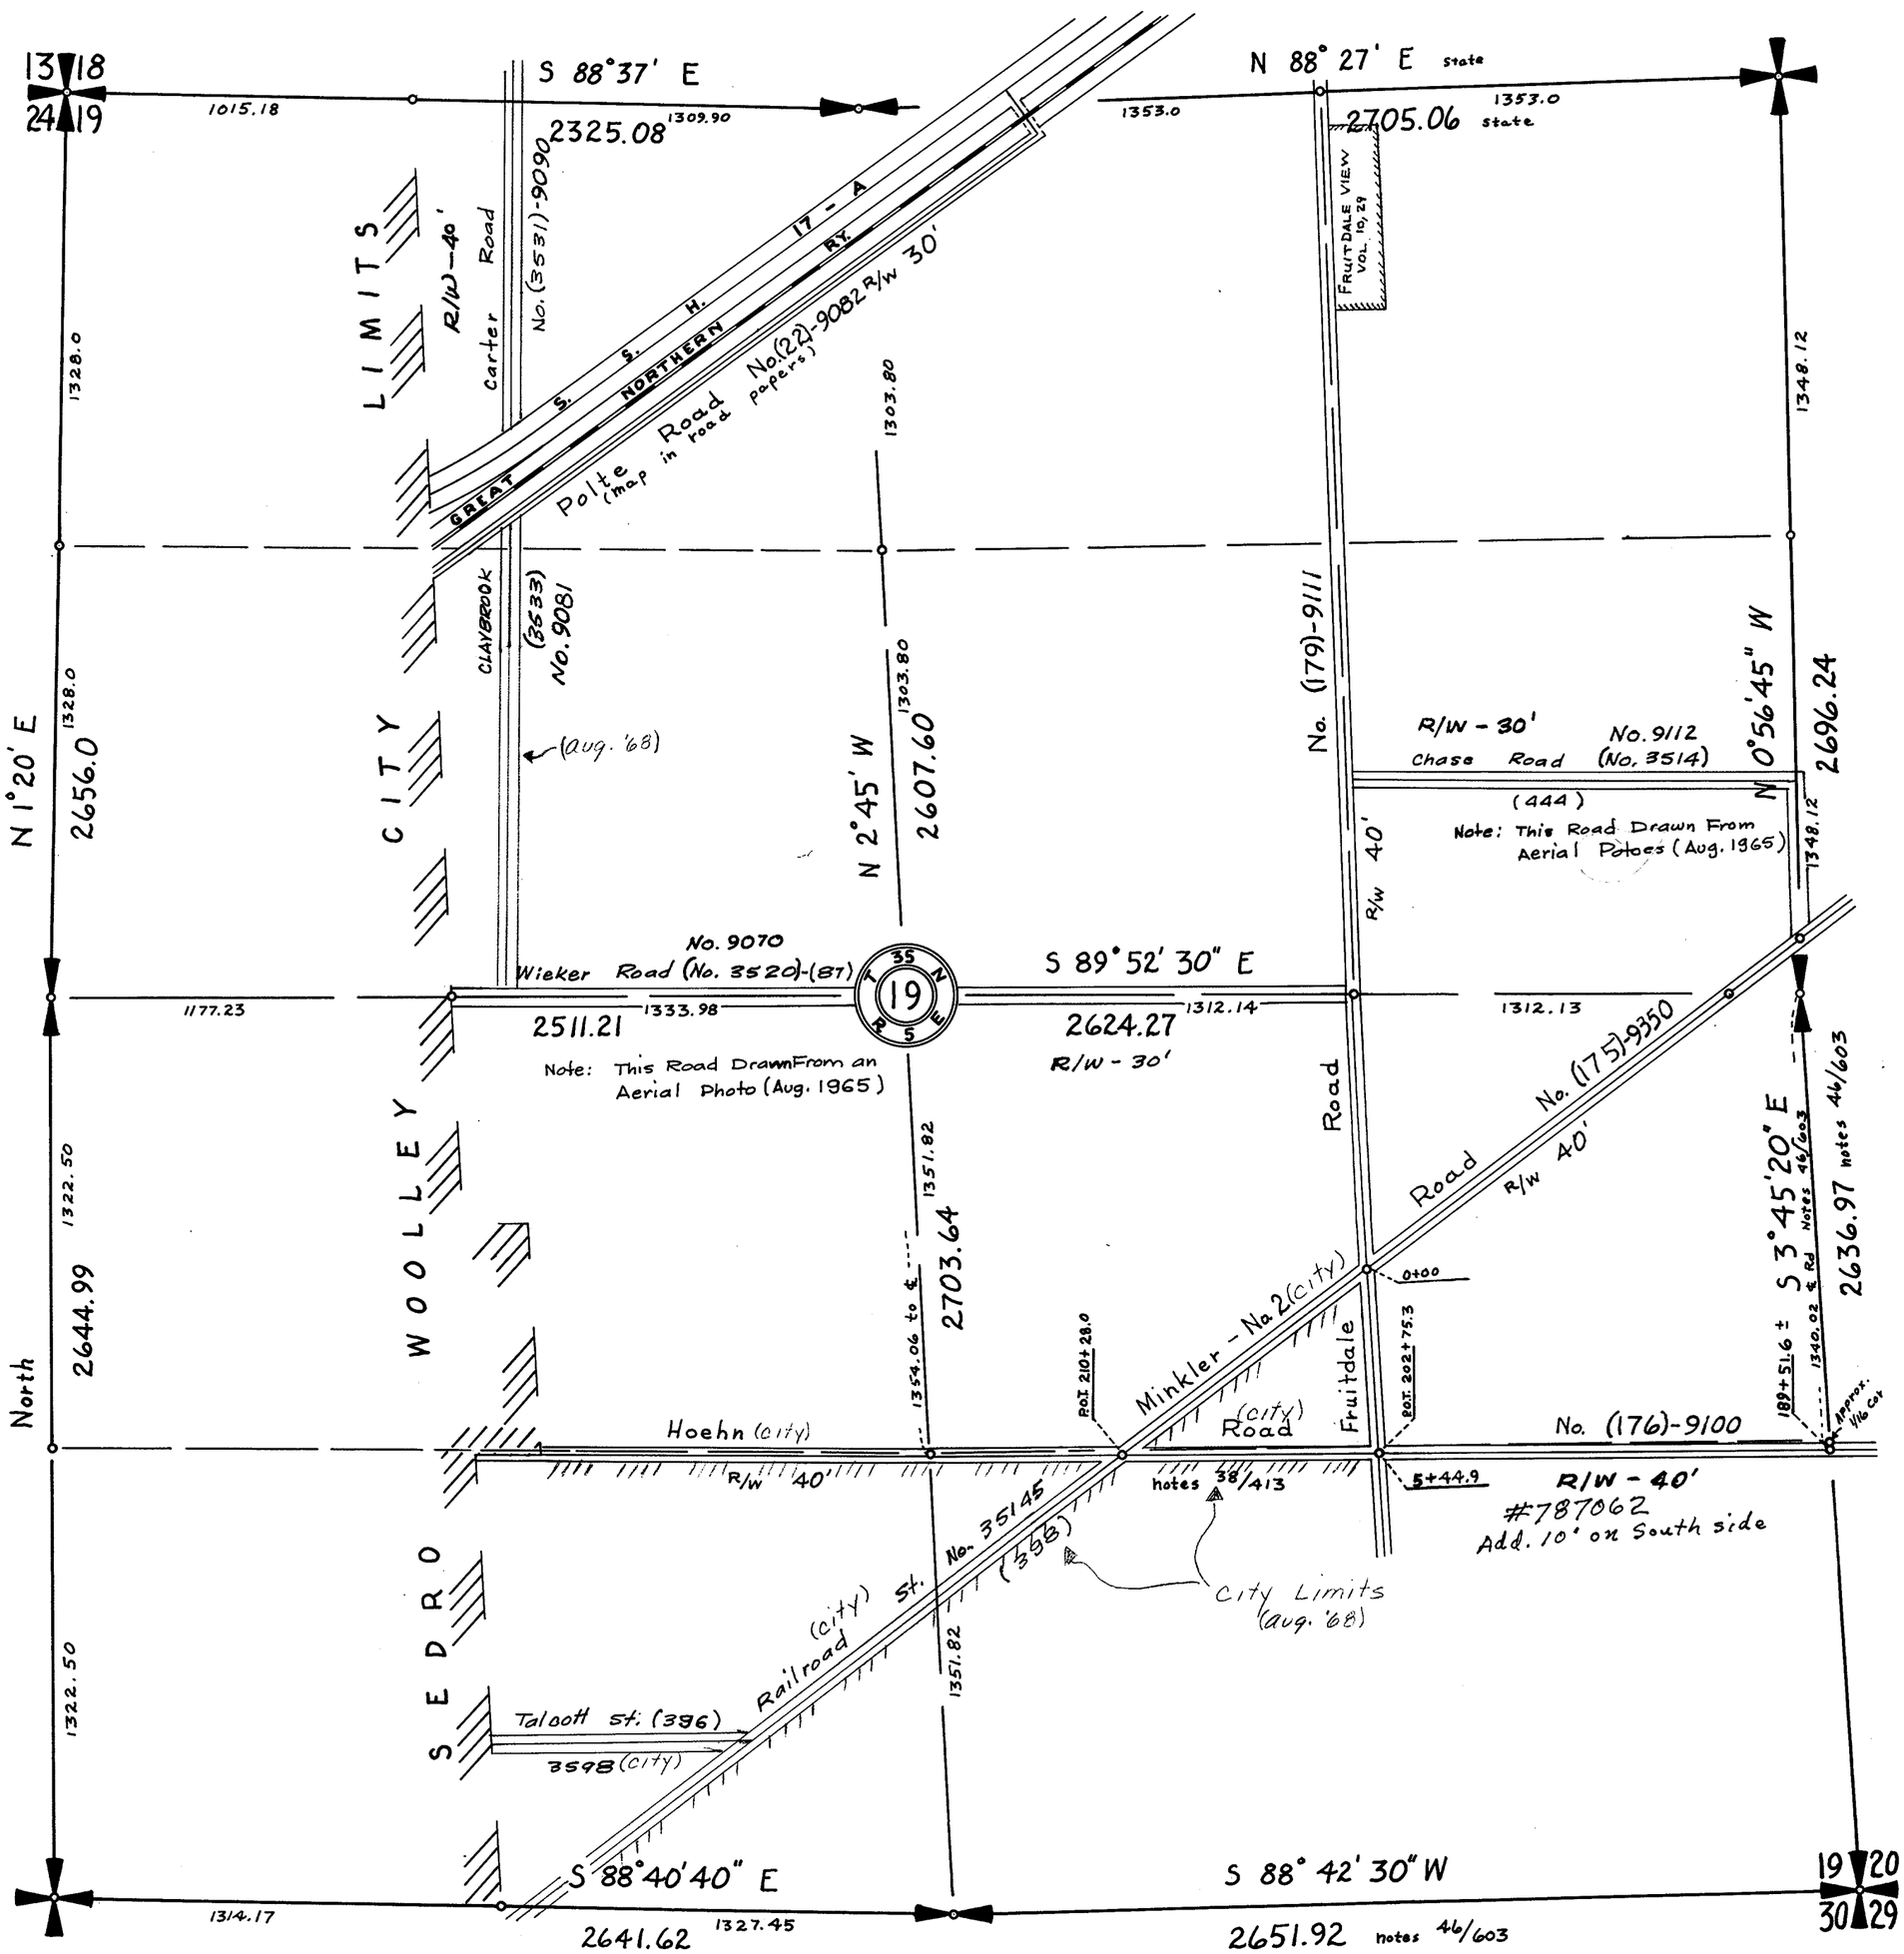

SECTION 20

TOWNSHIP 35 NORTH, RANGE 5 EAST, W. M.

SKAGIT COUNTY, WASH.

SCALE, 1 INCH--400 FEET

H.O. Walberg COUNTY ENGINEER

Compiled from Notes as indicated WSCW-6-12-47

N 13468.97
E 3569.44

N87°41'20"W 2626.6

N 13363.02
E 6193.90

S88°52'30"E 2634.5

N 13311.29
E 8828.40

N1°07'10"E 2697.20

S88°50'E 5290.50

N0°35'55"E 2640.6

Centre N 10718.35
E 6166.32

N0°29'E 2640.3

10771.87
3516.72

10671.09
8806.13

Δ = 38°04' R
C = 16°
T = 123.5
L = 237.9

P.T. 179+90.7
P.C. 177+52.8

Pat. 180+00.5 Mk. (notes 39/413)

N 9599.49
E 4910.61

N 9659.74
E 4993.13

N 9725.22
E 5083.01

P.T. 173+16.2
P.C. 172+01.3

P.T. 163+60.3

Δ = 3°33½' R
C = 1°
T = 178.4
L = 355.8

P.C. 160+04.5

P.I. 161+82.9

S77°30'W 599.2

P.I. 155+84.2

S86°22'W

P.T. 150+84.1

P.T. 148+86.6

P.C. 148+13.7

No. 9100
(No. 3522)
(No. 176)

N88°39'W 1207.5

(No. 3539) - 9220

(408) R/W-32'

Soren Rd.

A.P. 136+92.9
0°51'30" R

P.O.T. 135+69.56
N 10010.28
E 8800.89

N88°30'30"W 78.34

R/W 40'

Δ = 4°22½' R
C = 6°
T = 36.5
L = 72.9

S81°04'W 1134.30

36/295

38/413

S64°00'W 364.40

P.T. 174+26.8

P.T. 173+25.3

P.C. 172+01.3

P.T. 157+31.6

P.C. 154+36.3

Δ = 8°51½' L
C = 3°
T = 147.9
L = 295.3

N84°16'30"W 133.40

P.T. 151+61.9

P.C. 150+05.9

Δ = 9°21½' L
C = 6°
T = 78.2
L = 156.0

R/W 219-D.44

E Rd. N 9432.35
E 3623.50

Hoehn

N87°56'W 1003.55

Br. 151

Notes 609

N 9397.17
E 6152.98

S88°41'50"E

R/W 219D43

Hansen Creek

PI 178+76.3 = PI 176+82.0
N 9393.47
E 4626.40

Δ = 27°04' L
C = 12°
T = 114.9
L = 225.5

Plat of Peavey's Acreage

2636.97

N1°33'20"W

2650.6

N0°28'40"W

2640.6

N0°29'40"E

N 8135.87
E 3588.30

8071.82
6138.64

8030.49
8783.32

S88°33'40"E 2551.14

S89°06'20"E 2645.00

SECTION 21

TOWNSHIP 35 NORTH, RANGE 5 EAST, W. M.

SKAGIT COUNTY, WASH.


H.O. WALBERG. COUNTY ENGINEER

SCALE, 1 INCH--400 FEET

NOTES: 36/295

Plat made Feb. 6-1945

Roads Added Nov., 1959

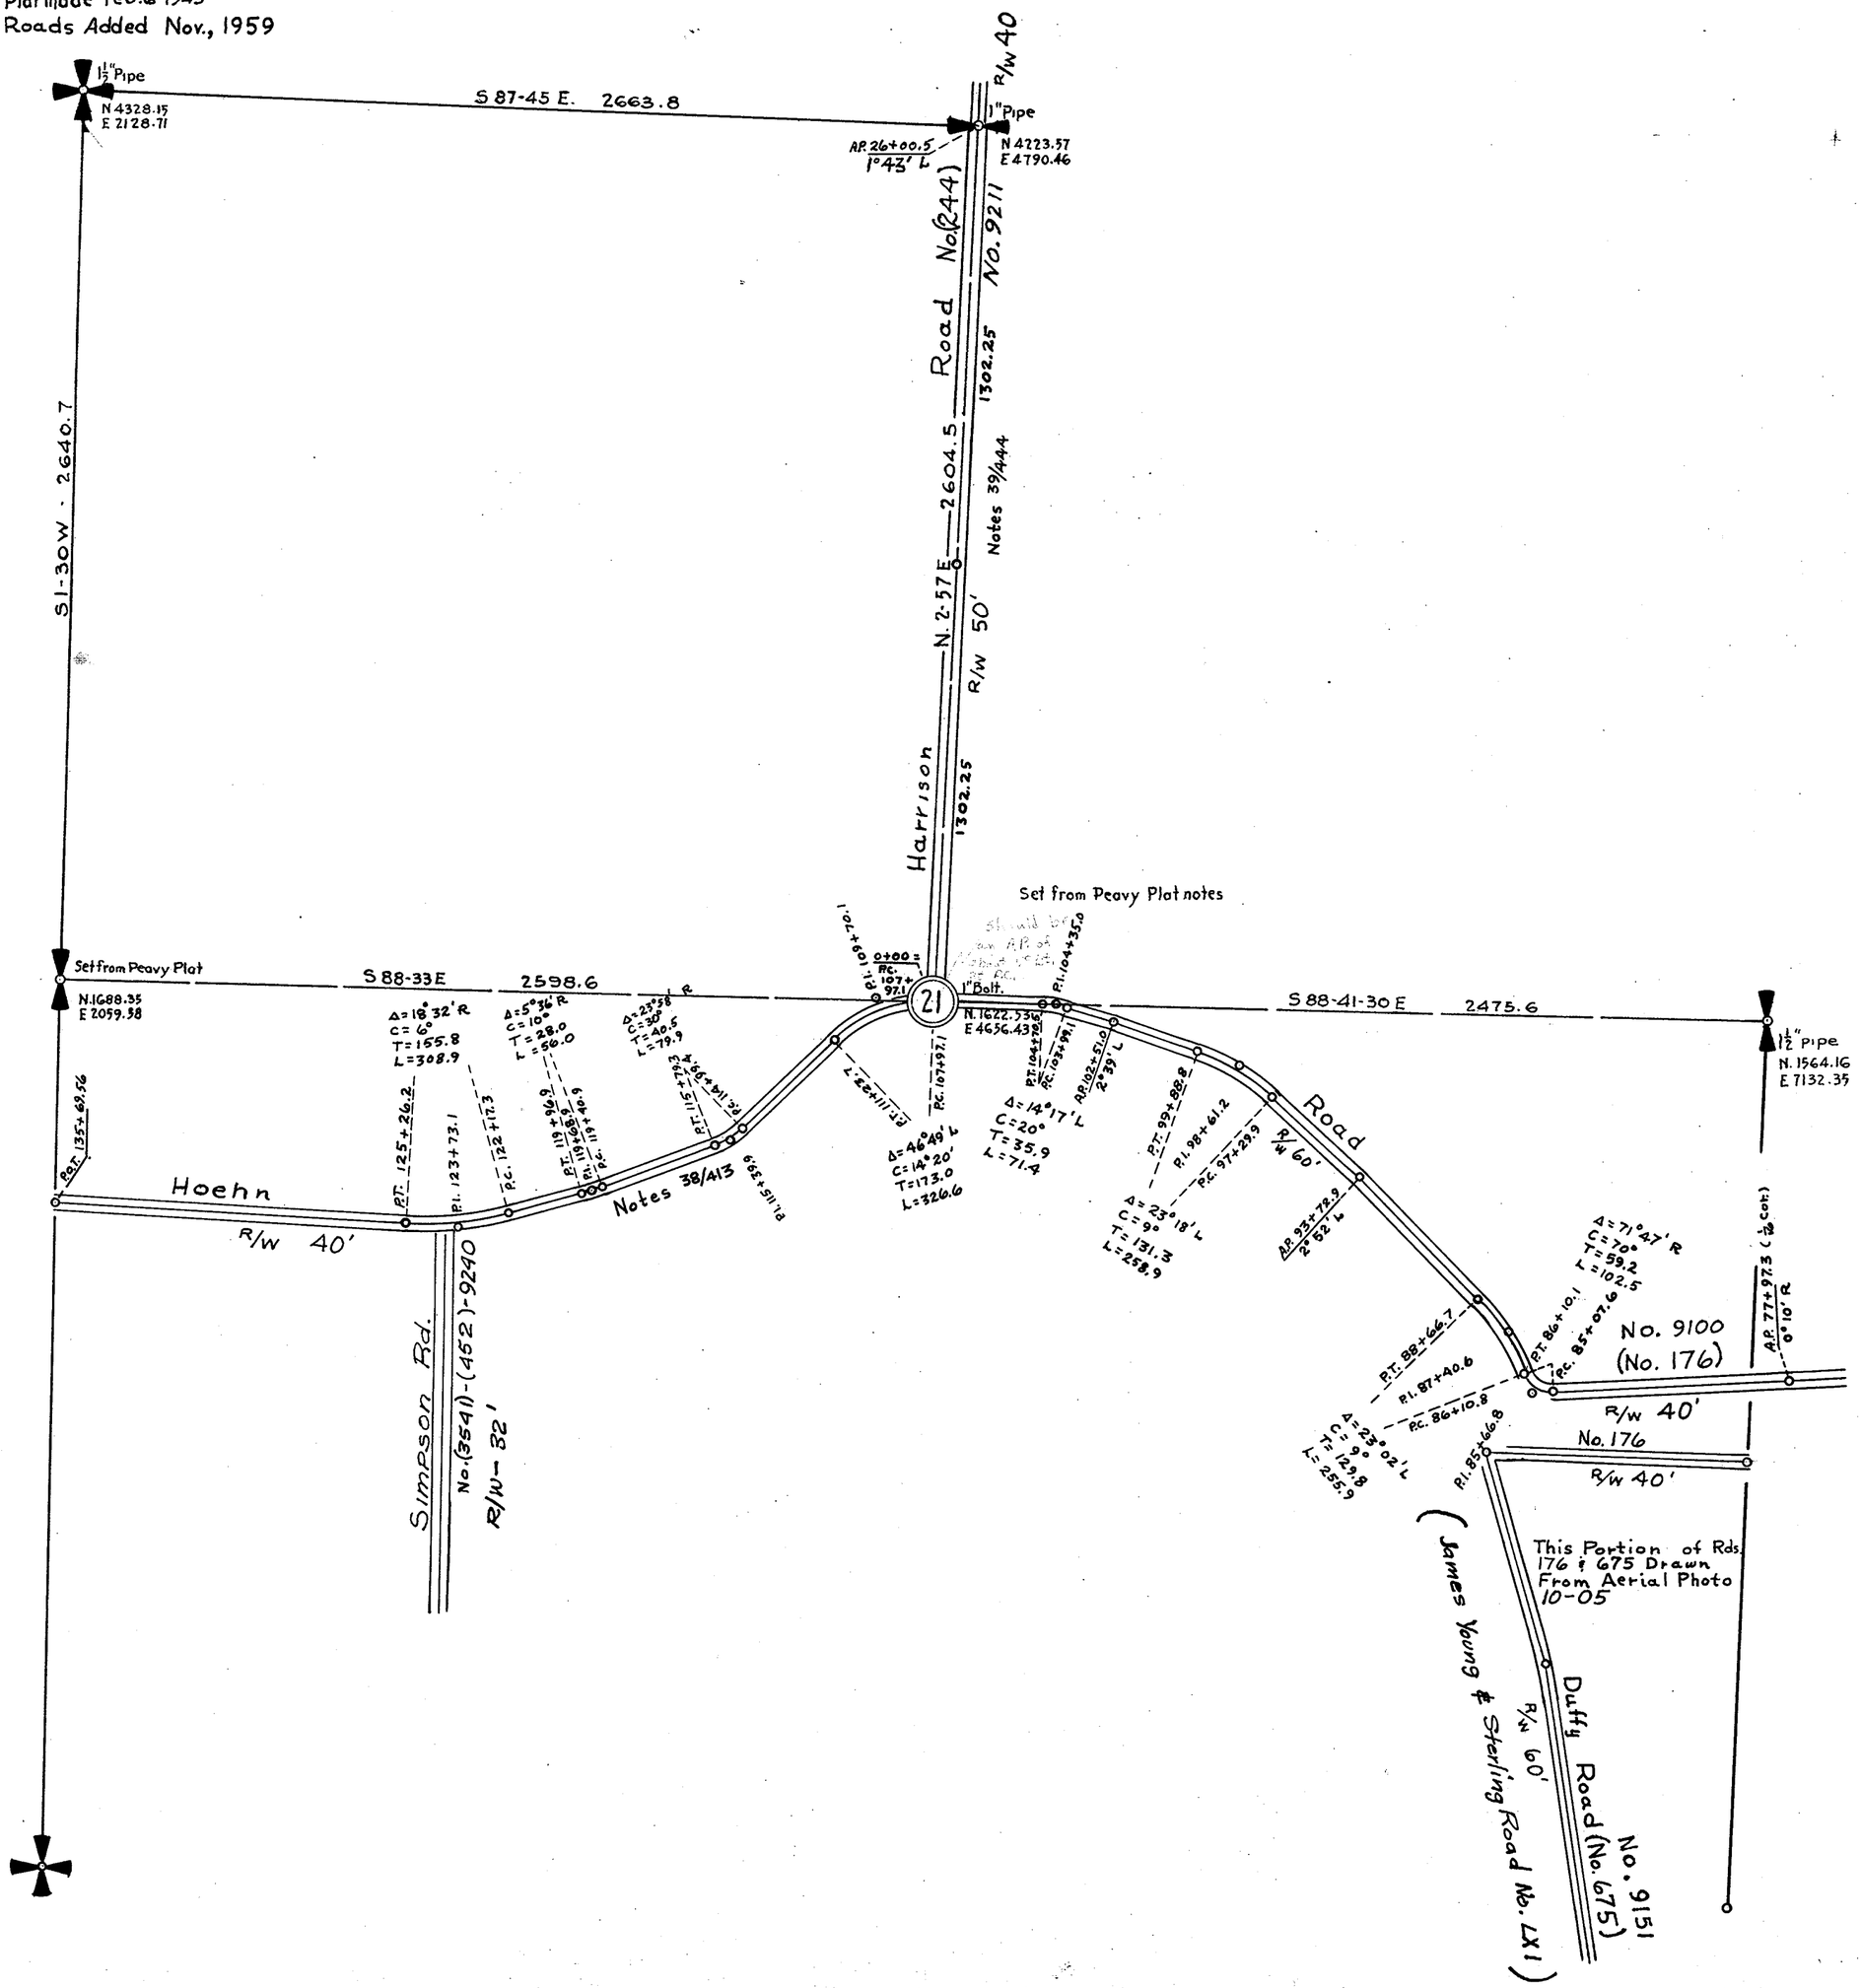


SECTION 22
TOWNSHIP 35 NORTH, RANGE 5 EAST, W. M.
SKAGIT COUNTY, WASH.

SCALE, 1 INCH--400 FEET
Subdivision Taken From PEAVY'S ACREAGE
Vol. 3, P 37
Bearings Taken From Notes 41/508

DATE November, 1959 — Frank Gilkey COUNTY ENGINEER



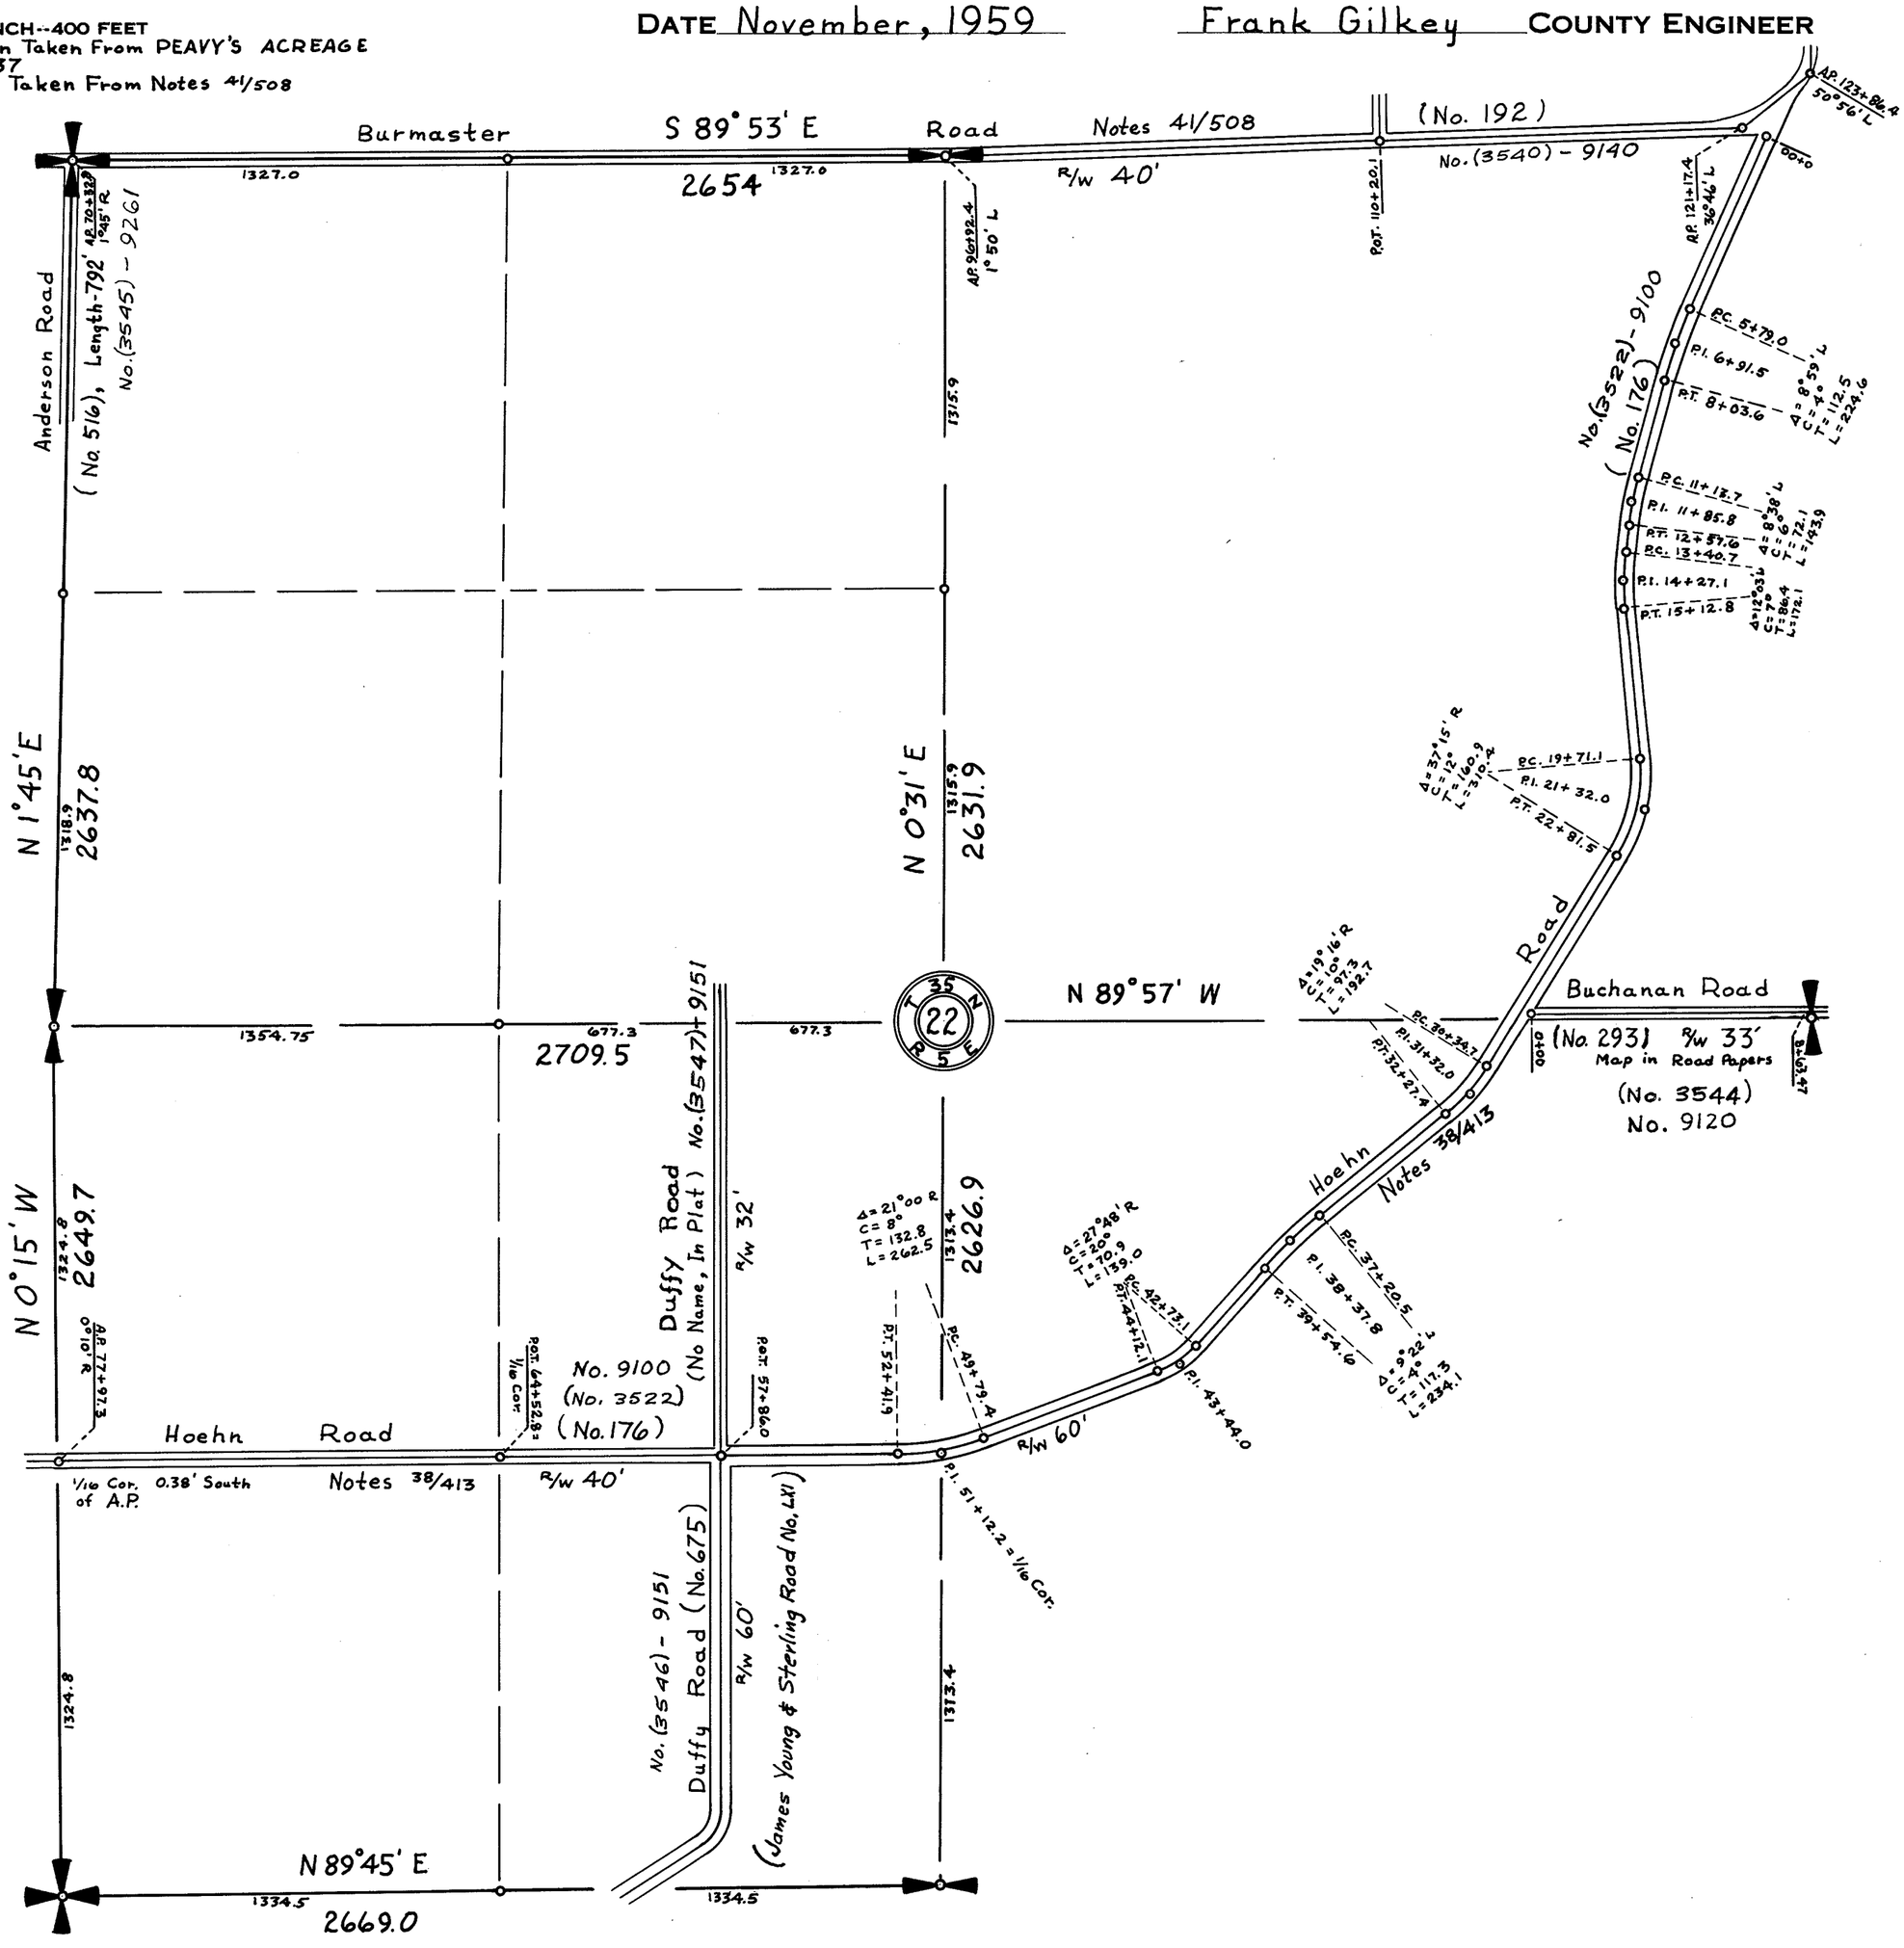


SECTION 22

TOWNSHIP 35 NORTH, RANGE 5 EAST, W. M.
SKAGIT COUNTY, WASH.

SCALE, 1 INCH–400 FEET

_____ COUNTY ENGINEER

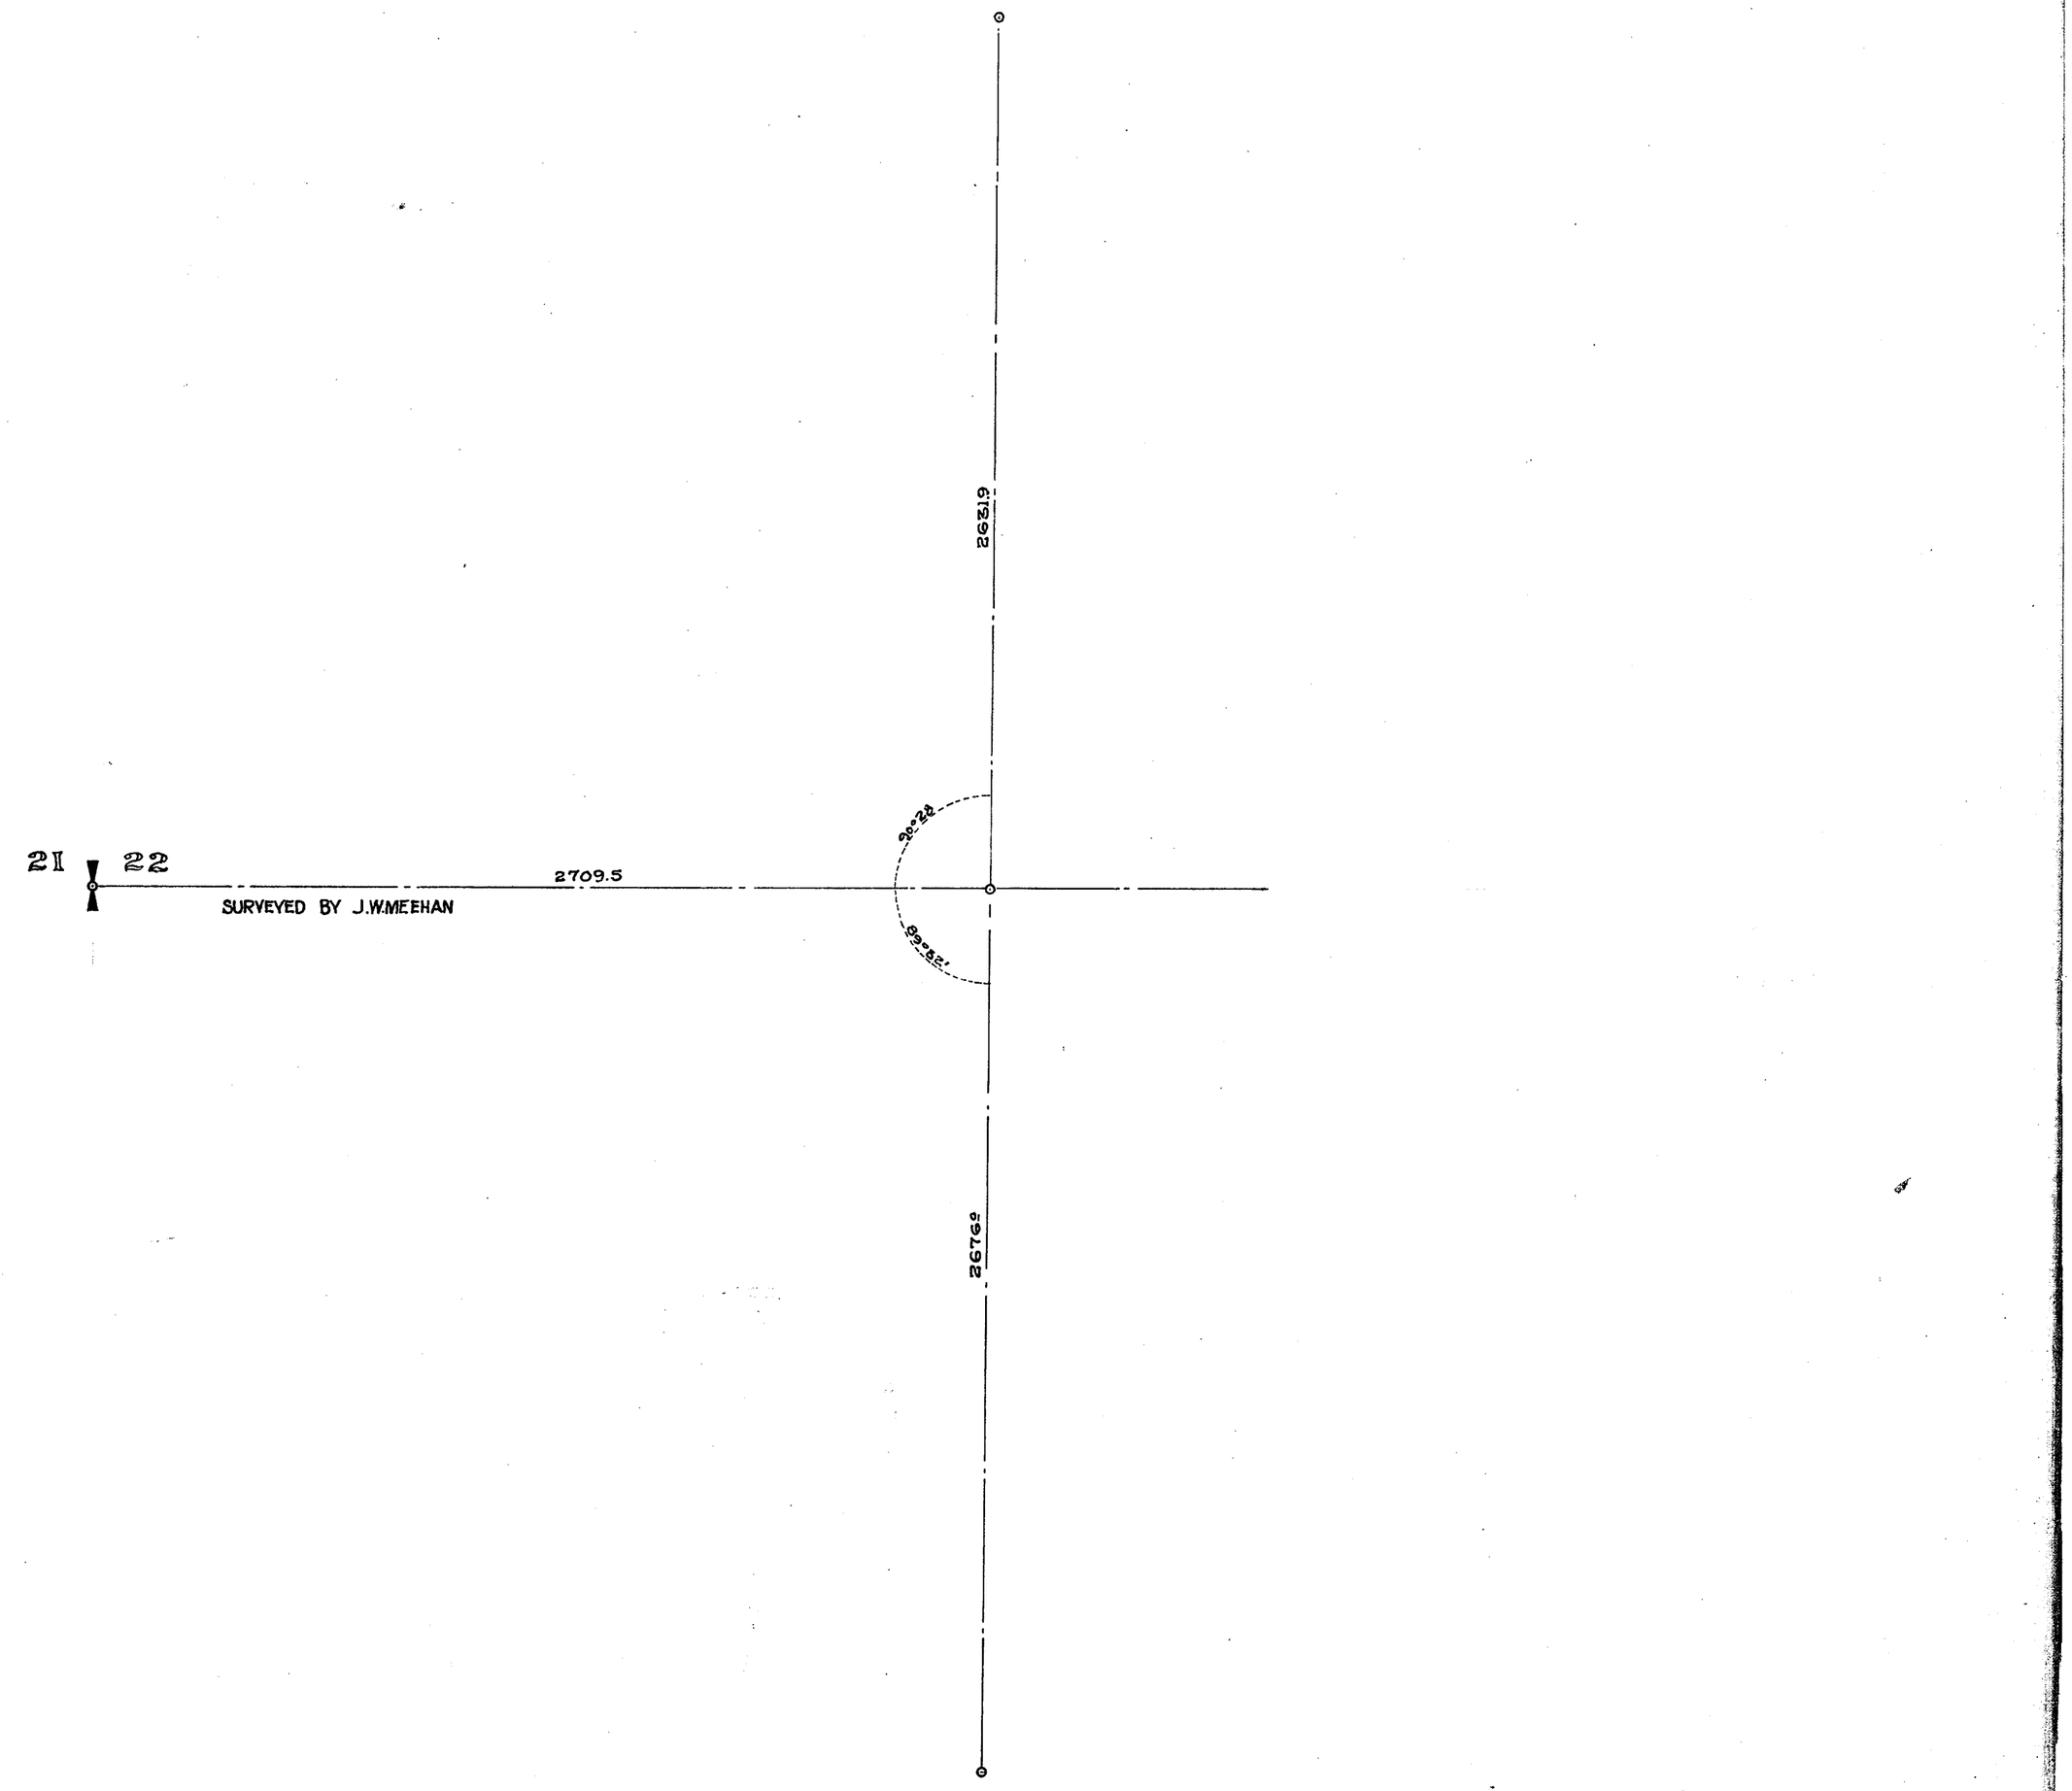


SECTION 22

TOWNSHIP 35 NORTH, RANGE 5 EAST, W. M.
SKAGIT COUNTY, WASH.

SCALE, 1 INCH–400 FEET

ArthurL Strong COUNTY ENGINEER

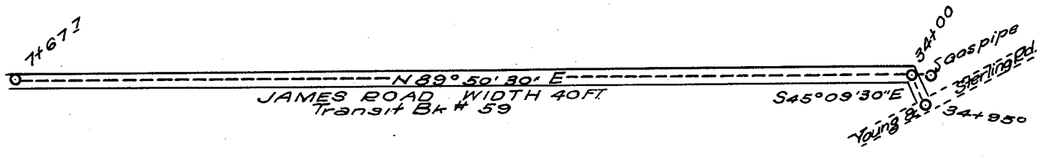


SECTION 25

TOWNSHIP 35 NORTH, RANGE 5 EAST, W. M.
SKAGIT COUNTY, WASH.

SCALE, 1 INCH--400 FEET

W.A. COSTELLO~1940 COUNTY ENGINEER

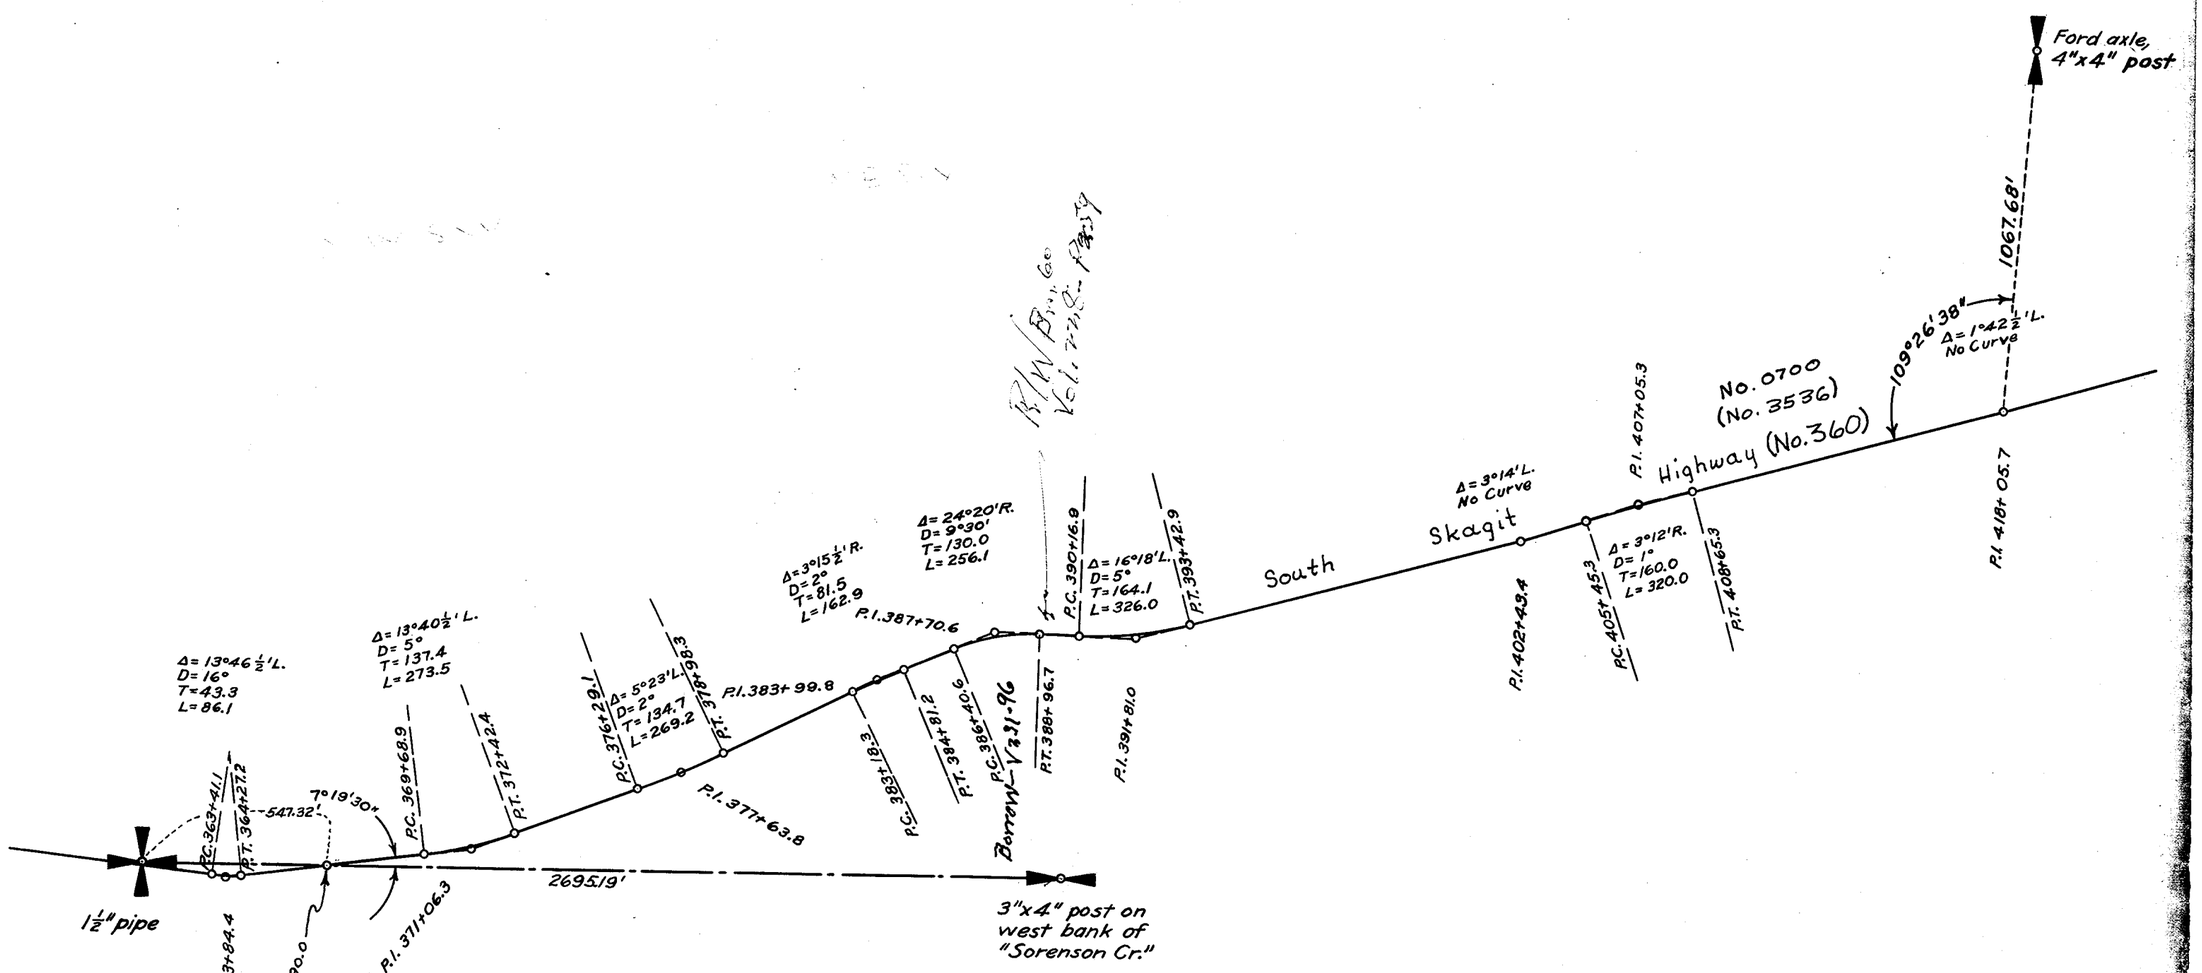


SECTION 26

TOWNSHIP 35 NORTH, RANGE 5 EAST, W. M.
SKAGIT COUNTY, WASH.

SCALE, 1 INCH--400 FEET

W. A. COSTELLO~1940 COUNTY ENGINEER

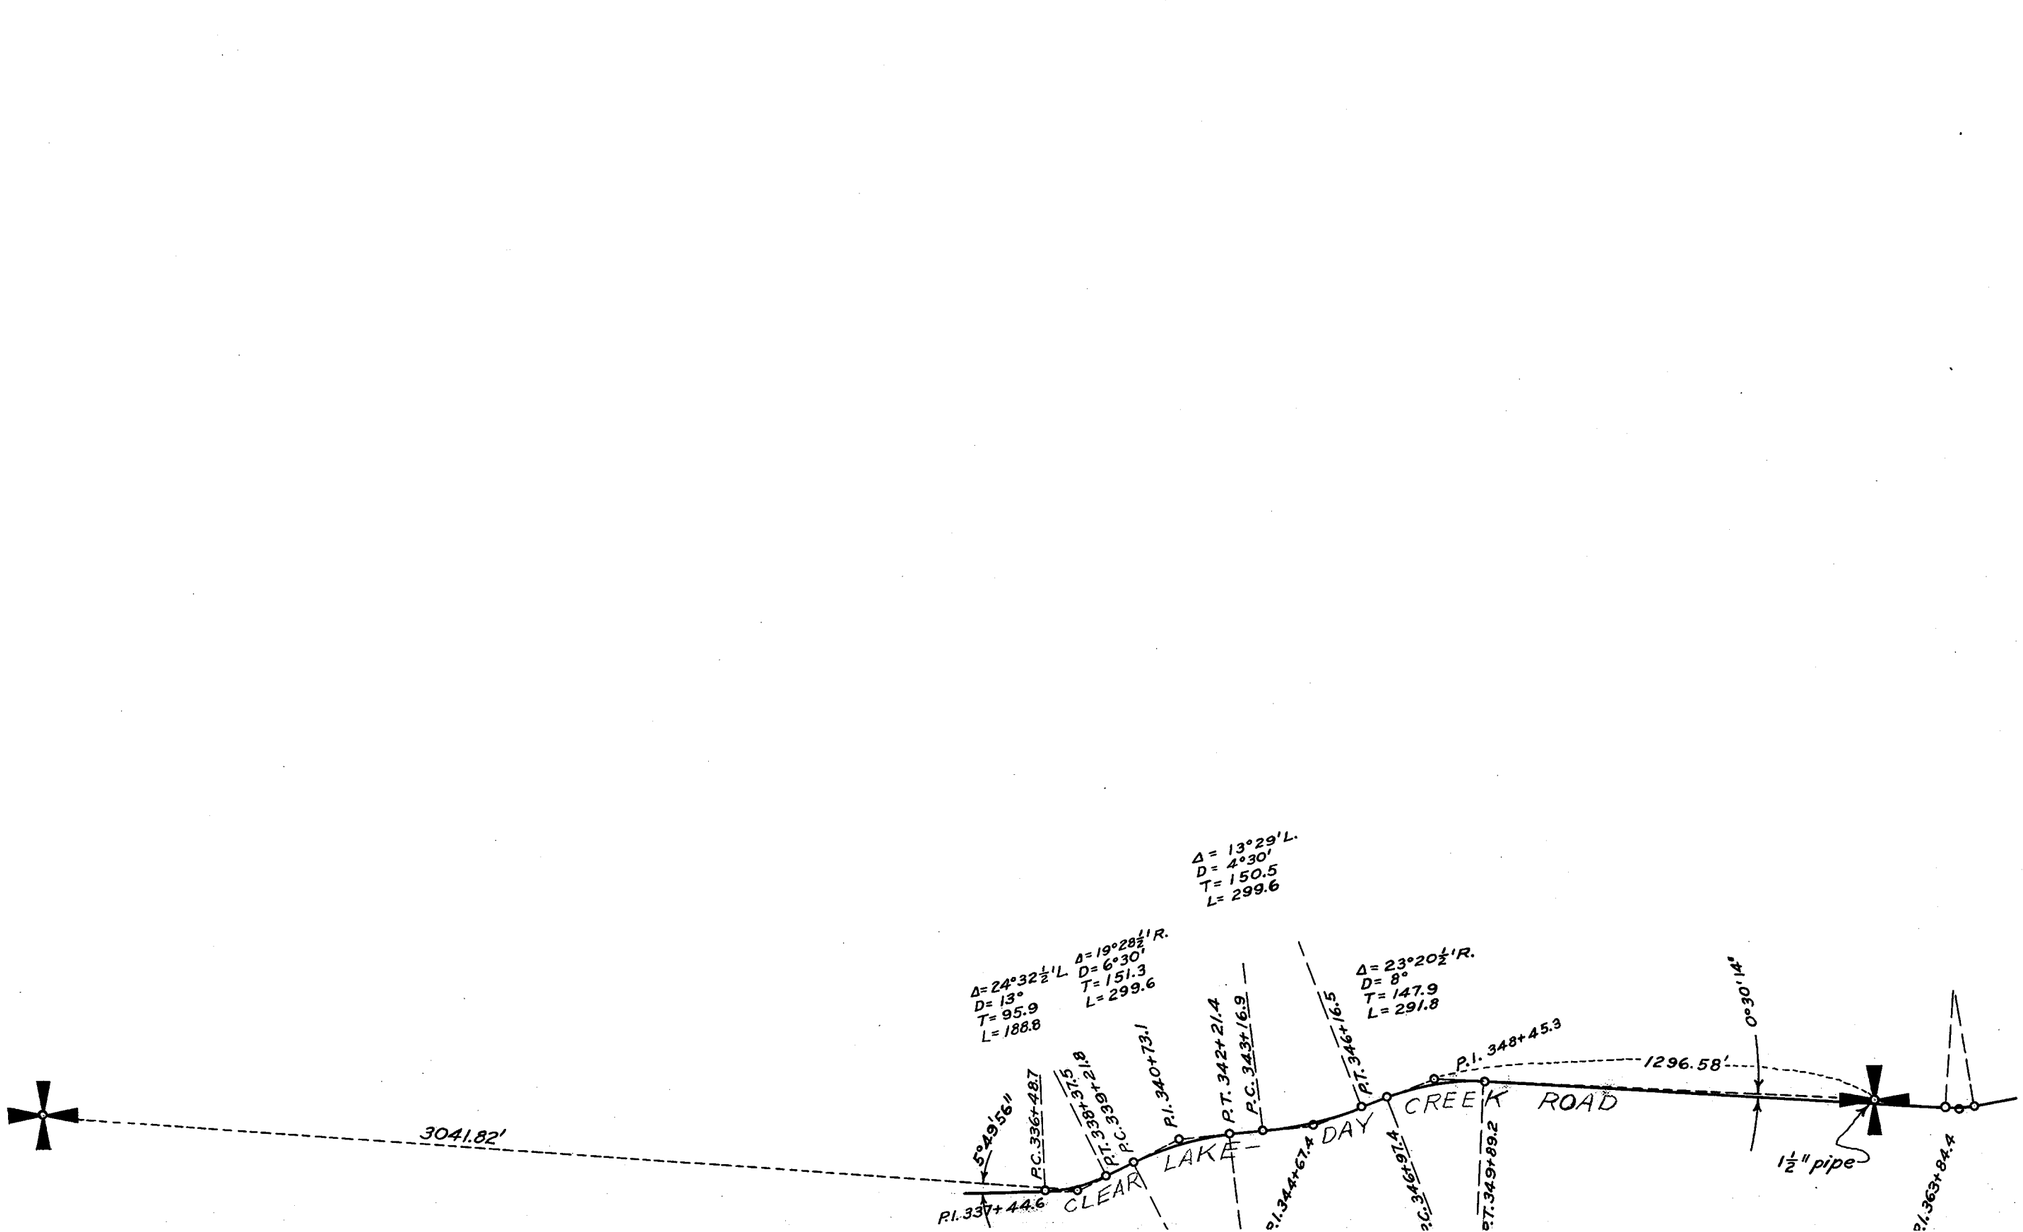

SECTION 27


TOWNSHIP 35 NORTH, RANGE 5 EAST, W. M.

SKAGIT COUNTY, WASH.


SCALE, 1 INCH--400 FEET

DATE Aug. 21, 1963

COUNTY ENGINEER

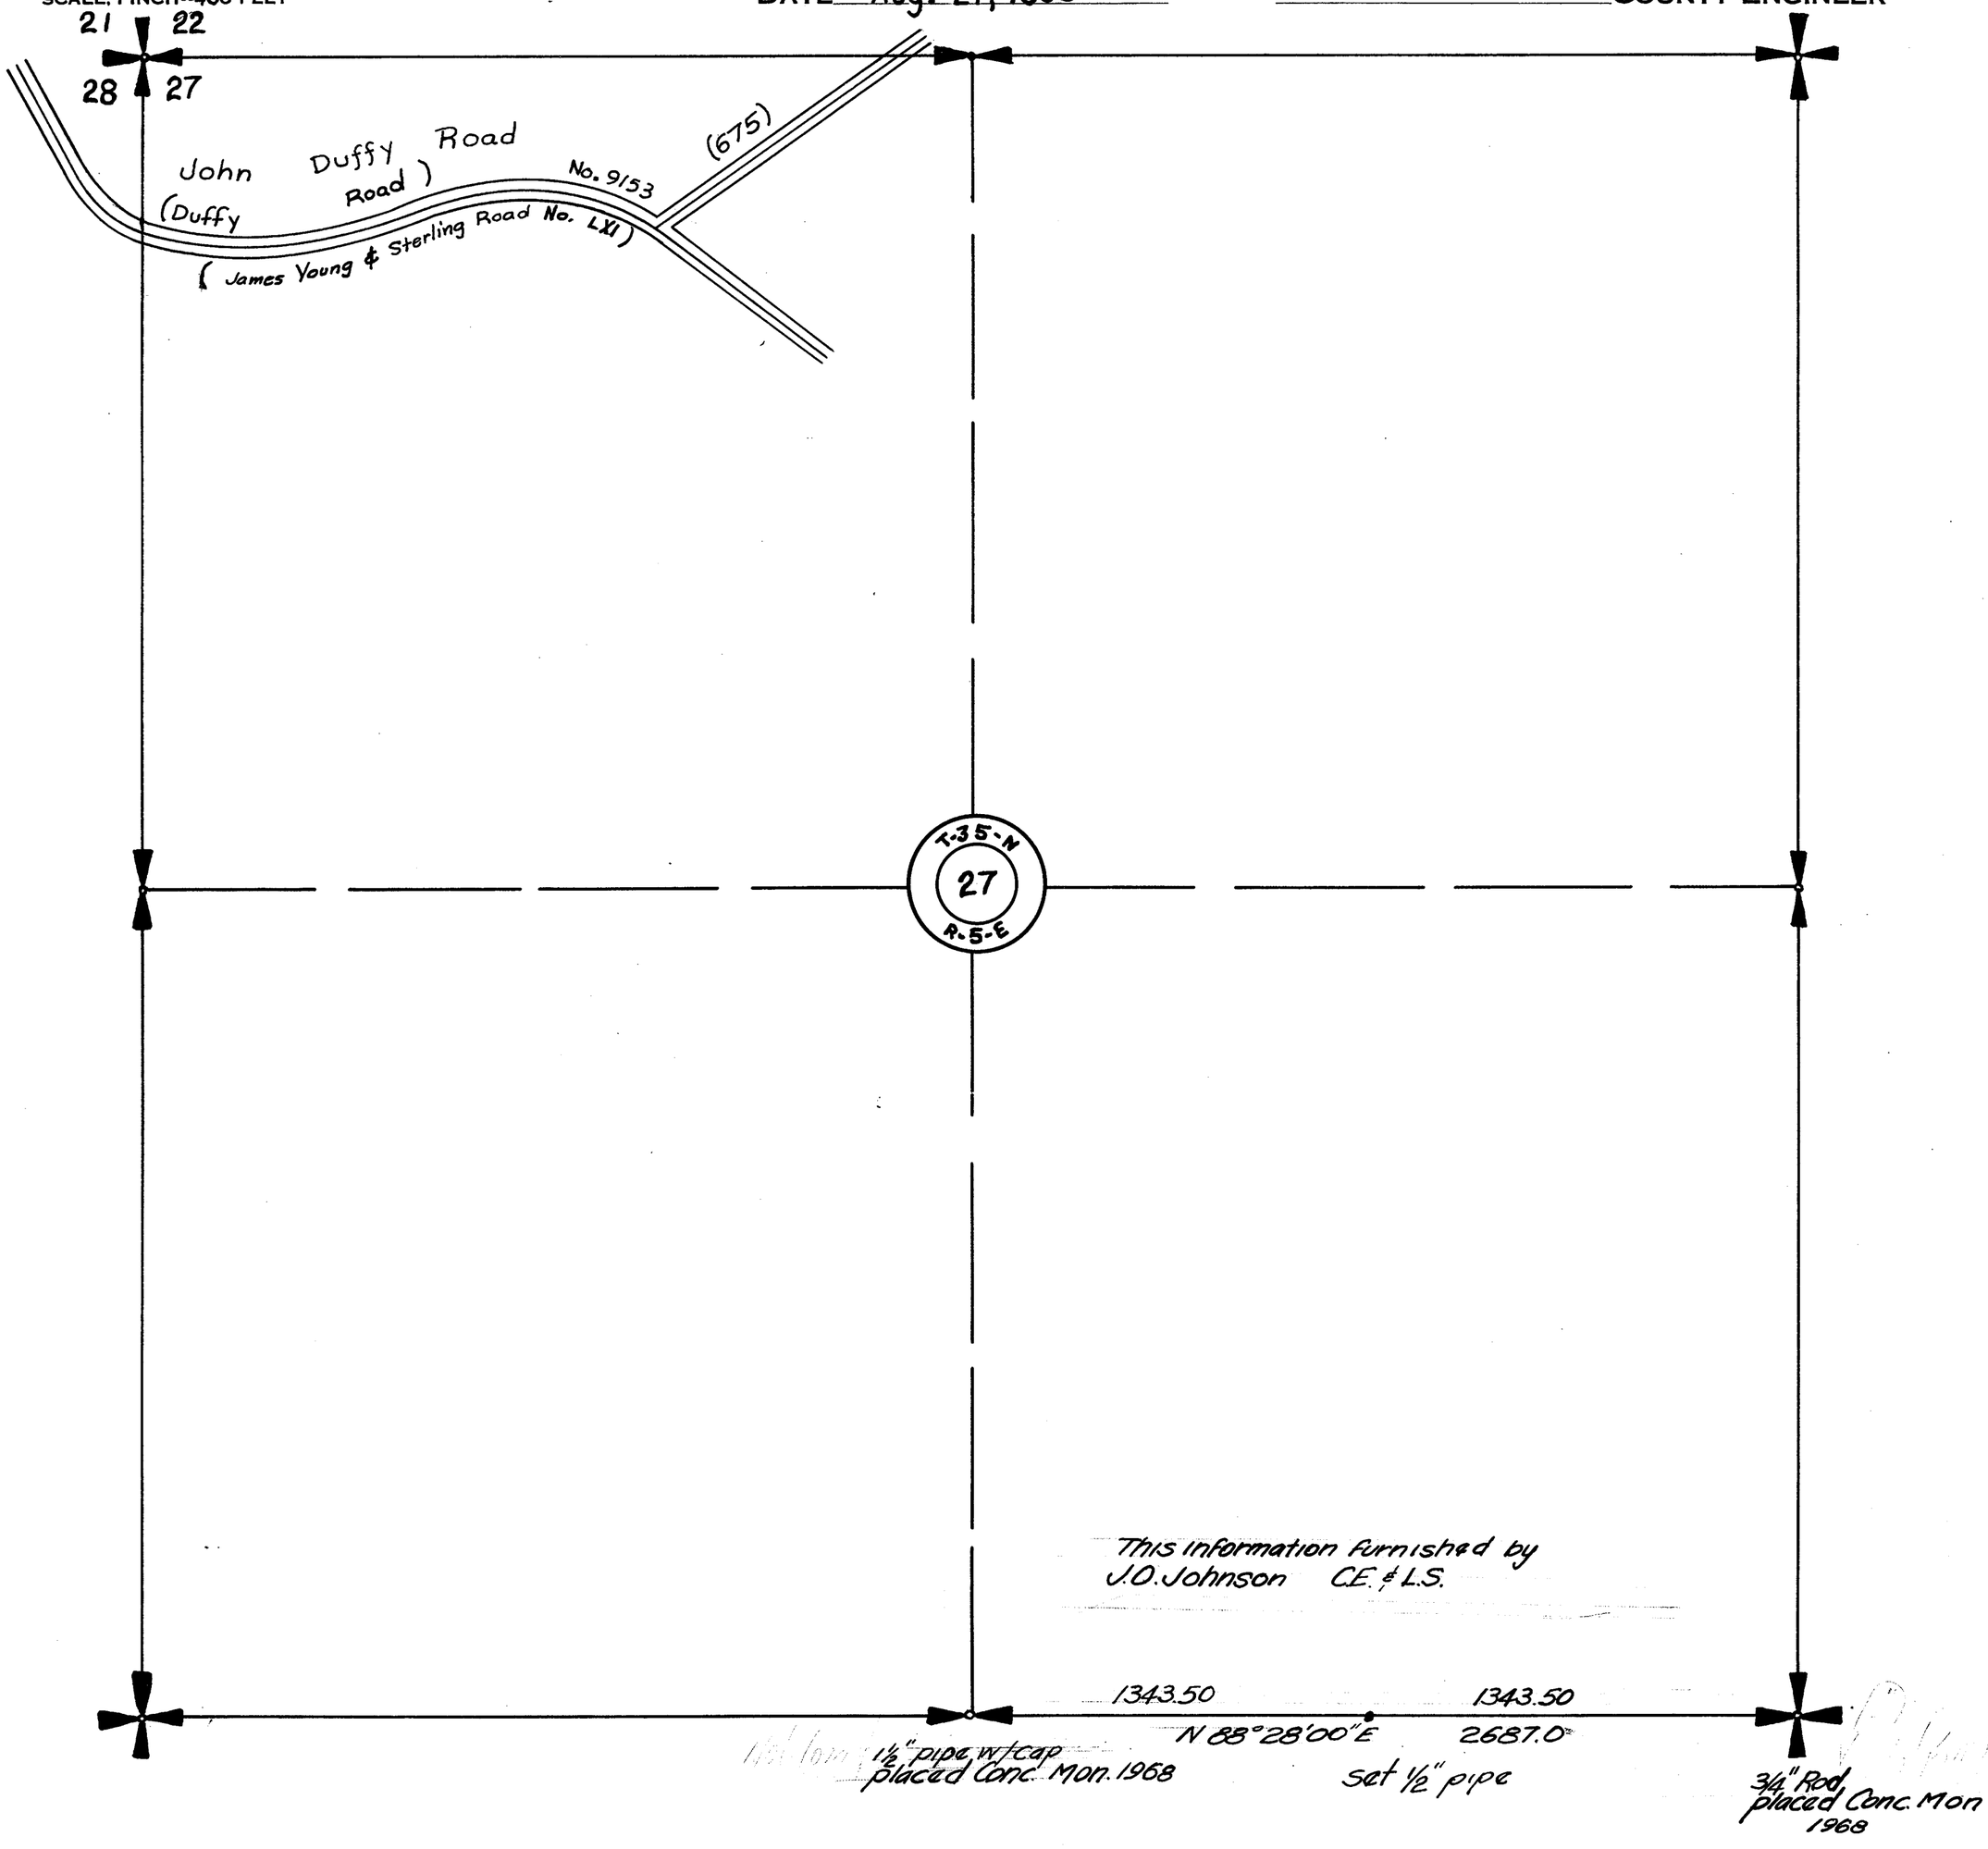

SEC. 28-35-5

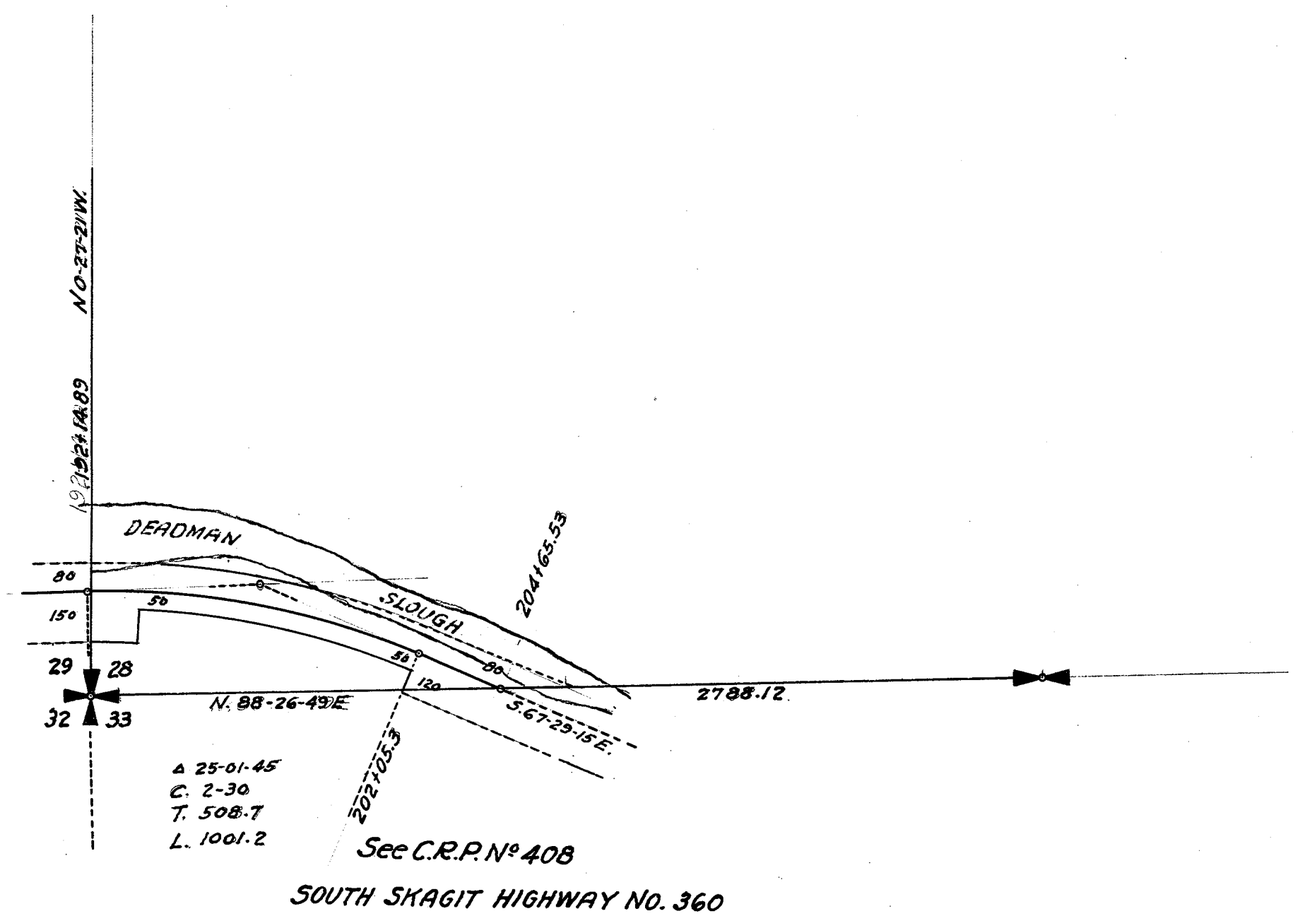

SOUTH SKAGIT HIGHWAY NO. 360

SKAGIT COUNTY, WASH.
OFFICE OF COUNTY ROAD ENGINEER

BRIDGE NO._____

LOCATION..... ROAD.....


JOB NO._____

DATE..... .....
County Road Engineer

APPROVED..... 194....

.....
Chairman-Board of County Commissioneers

SEC. 29-35-5

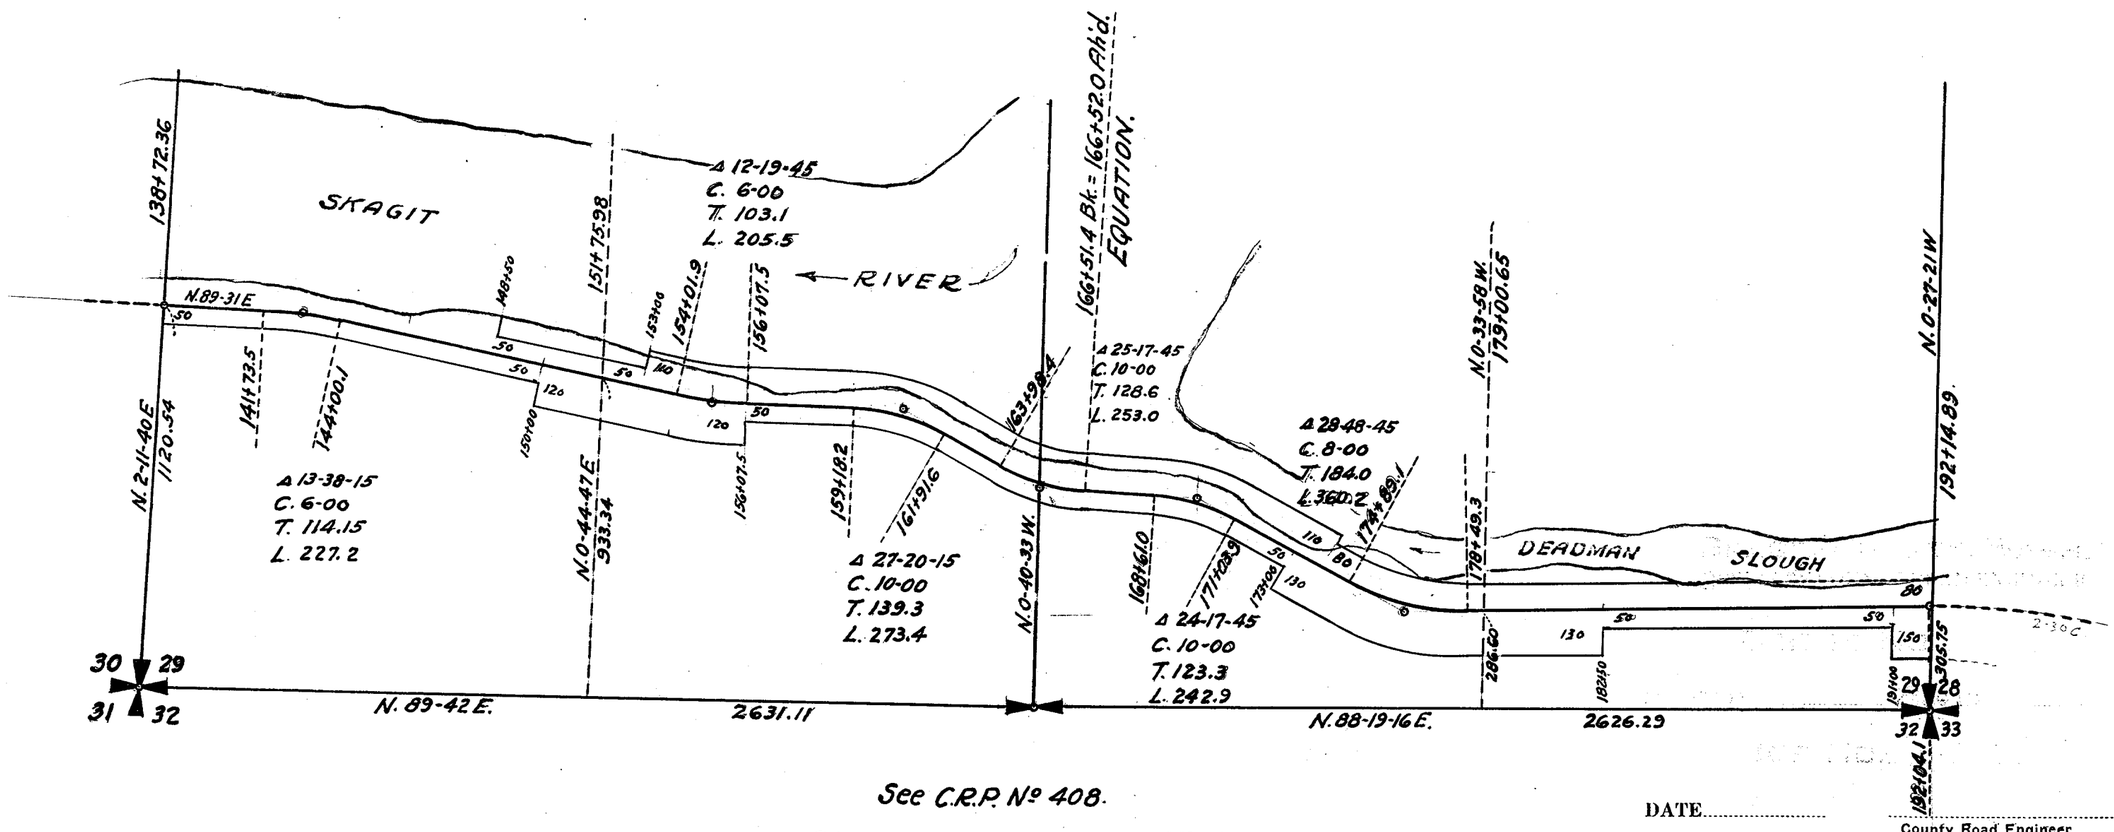

See C.R.P. No 408.

SOUTH SKAGIT HIGHWAY NO. 360

DATE.....

County Road Engineer

APPROVED..... 194.....

Chairman-Board of County Commissioneers


SECTION 29

TOWNSHIP 35 NORTH, RANGE 5 EAST, W. M.


SKAGIT COUNTY, WASH.

SCALE, 1 INCH--400 FEET

DATE November, 1959 Frank Gilkey COUNTY ENGINEER

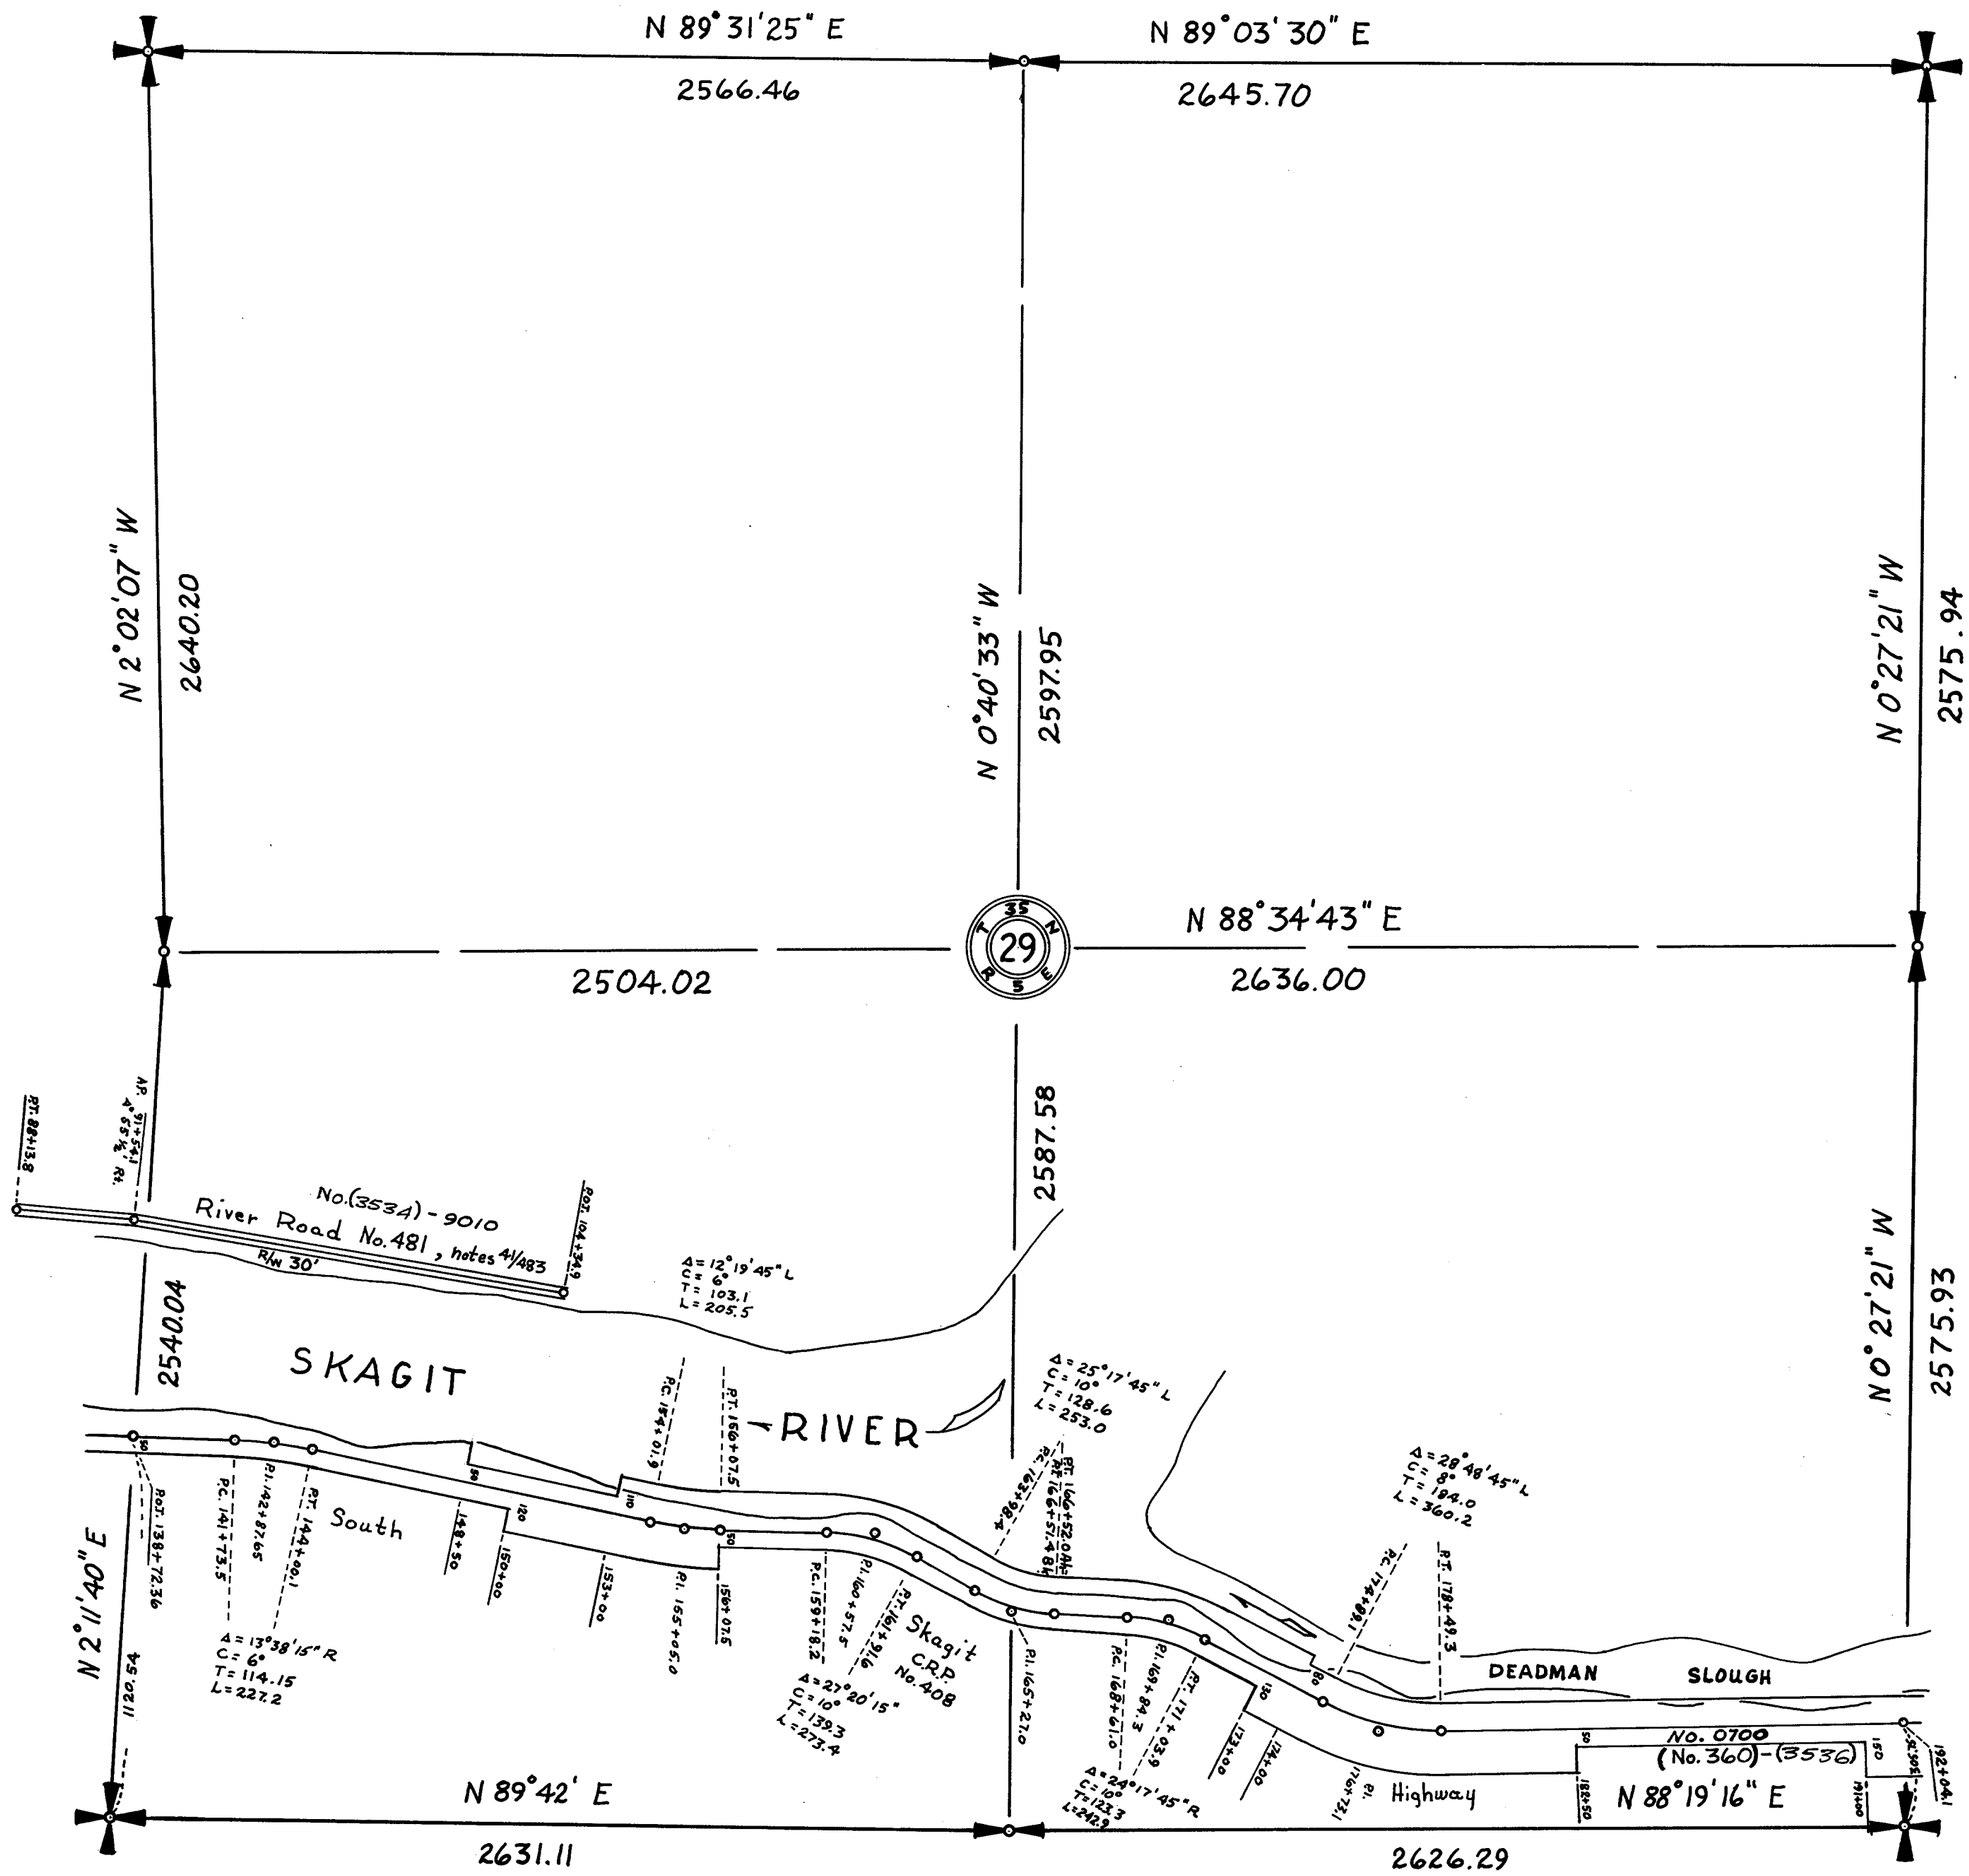

SEC. 30-35-5

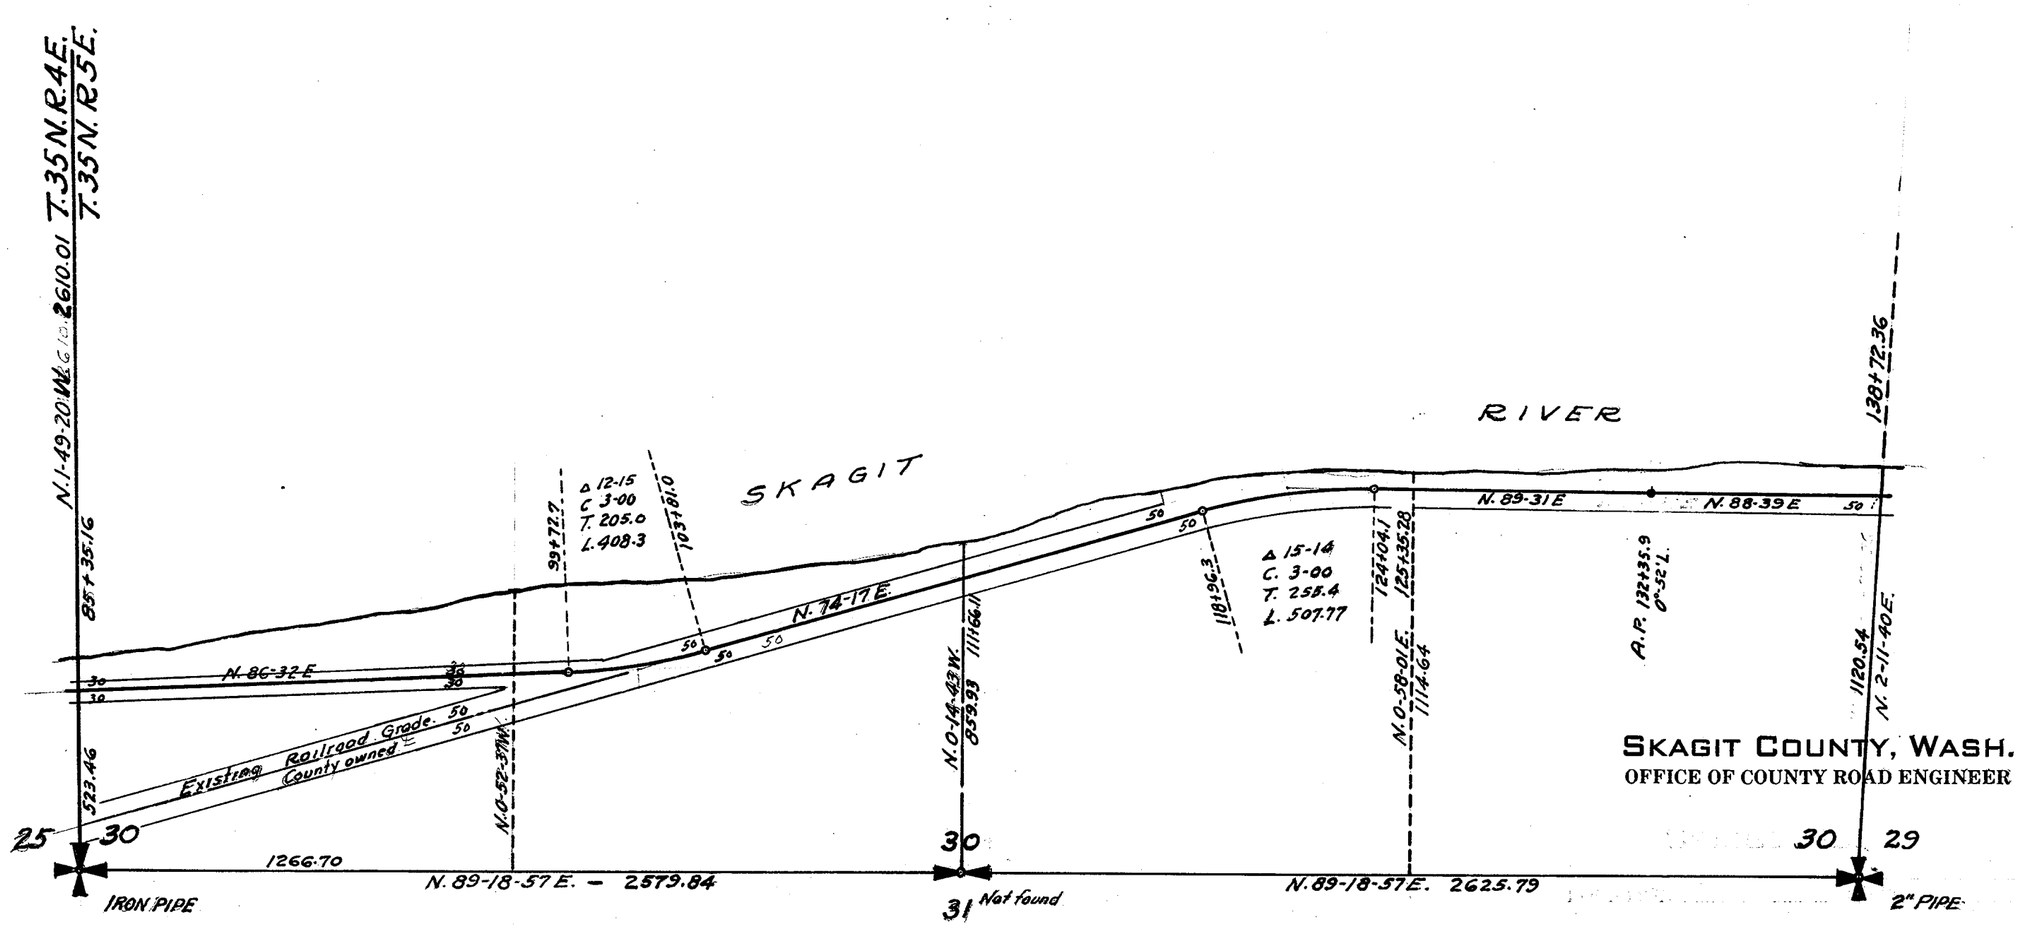

JOB NO._____

See C.R.P. No 408

SOUTH SKAGIT HIGHWAY NO. 360

DATE..... .....
County Road Engineer

APPROVED..... 194.....

.....
Chairman-Board of County Commissioners

SECTION 30


TOWNSHIP 35 NORTH, RANGE 5 EAST, W. M.

SKAGIT COUNTY, WASH.

SCALE, 1 INCH--400 FEET

DATE November, 1959

Frank Gilkey COUNTY ENGINEER

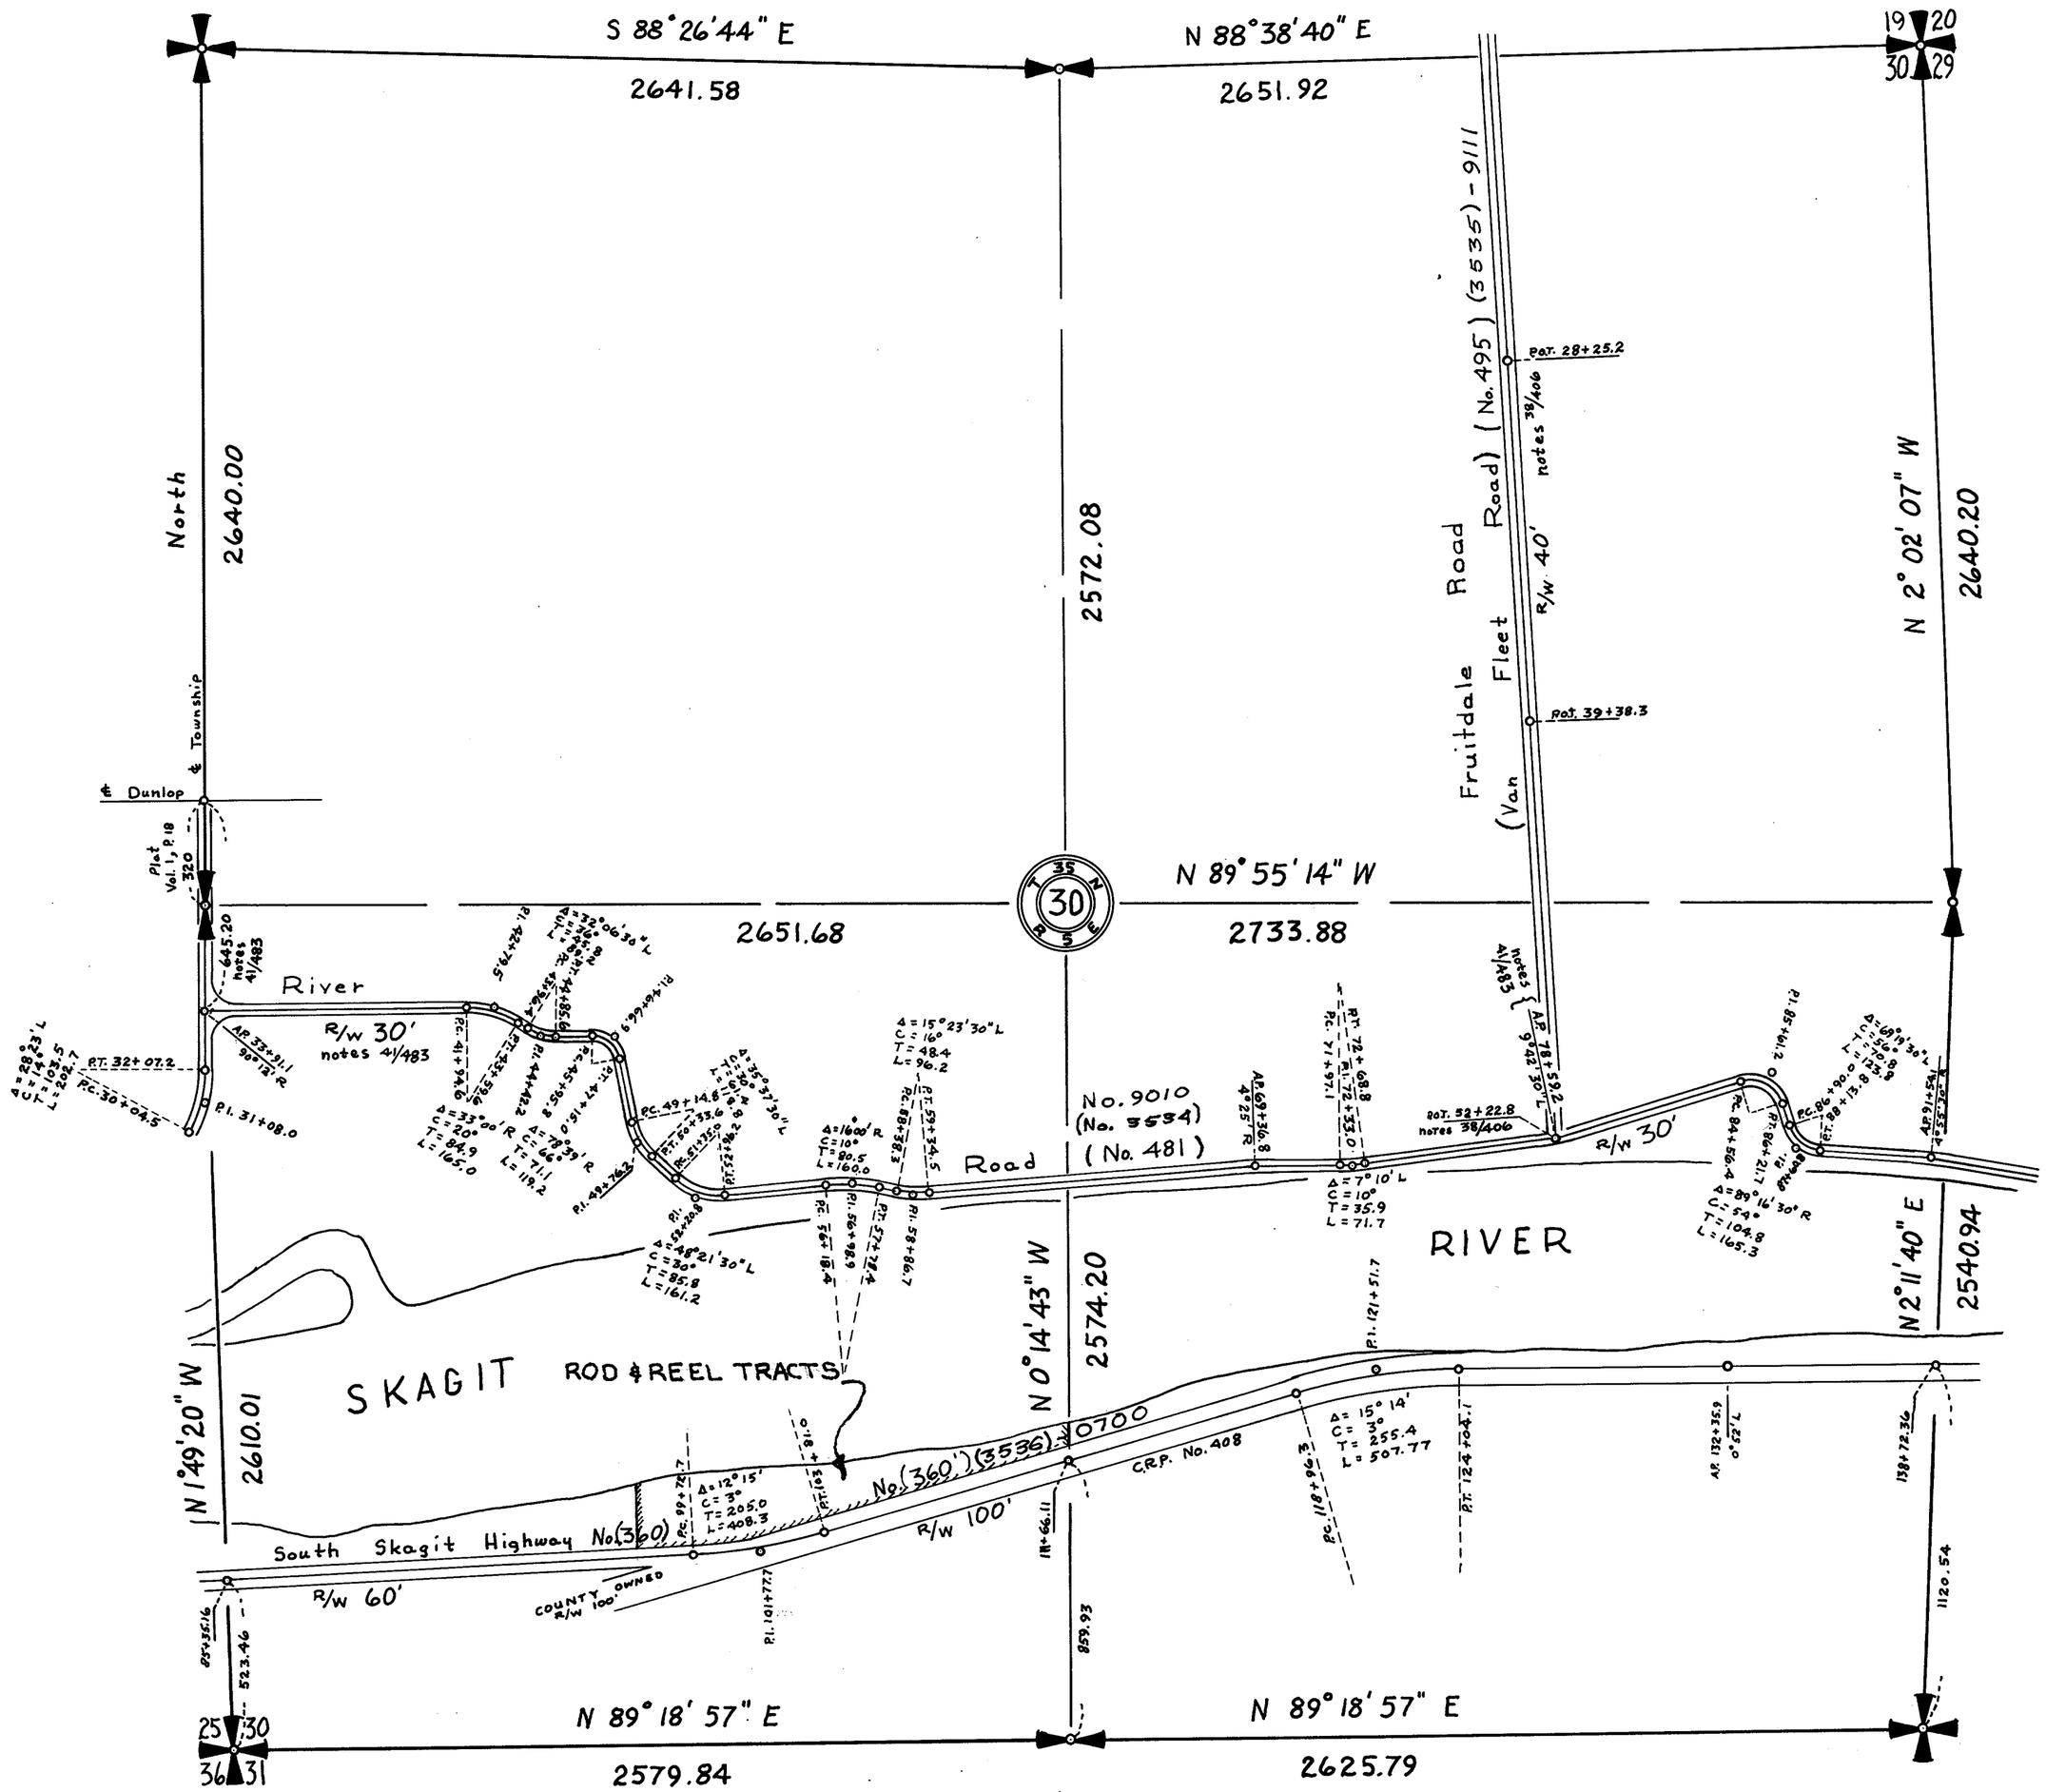


SECTION 31

TOWNSHIP 35 NORTH, RANGE 5 EAST, W. M.
SKAGIT COUNTY, WASH.

A. L. STRONG COUNTY ENGINEER

South line added 1940 Notes: 38/402 402
W. A. COSTELLO, Co. Rd. Engr.

SCALE, 1 INCH—400 FEET

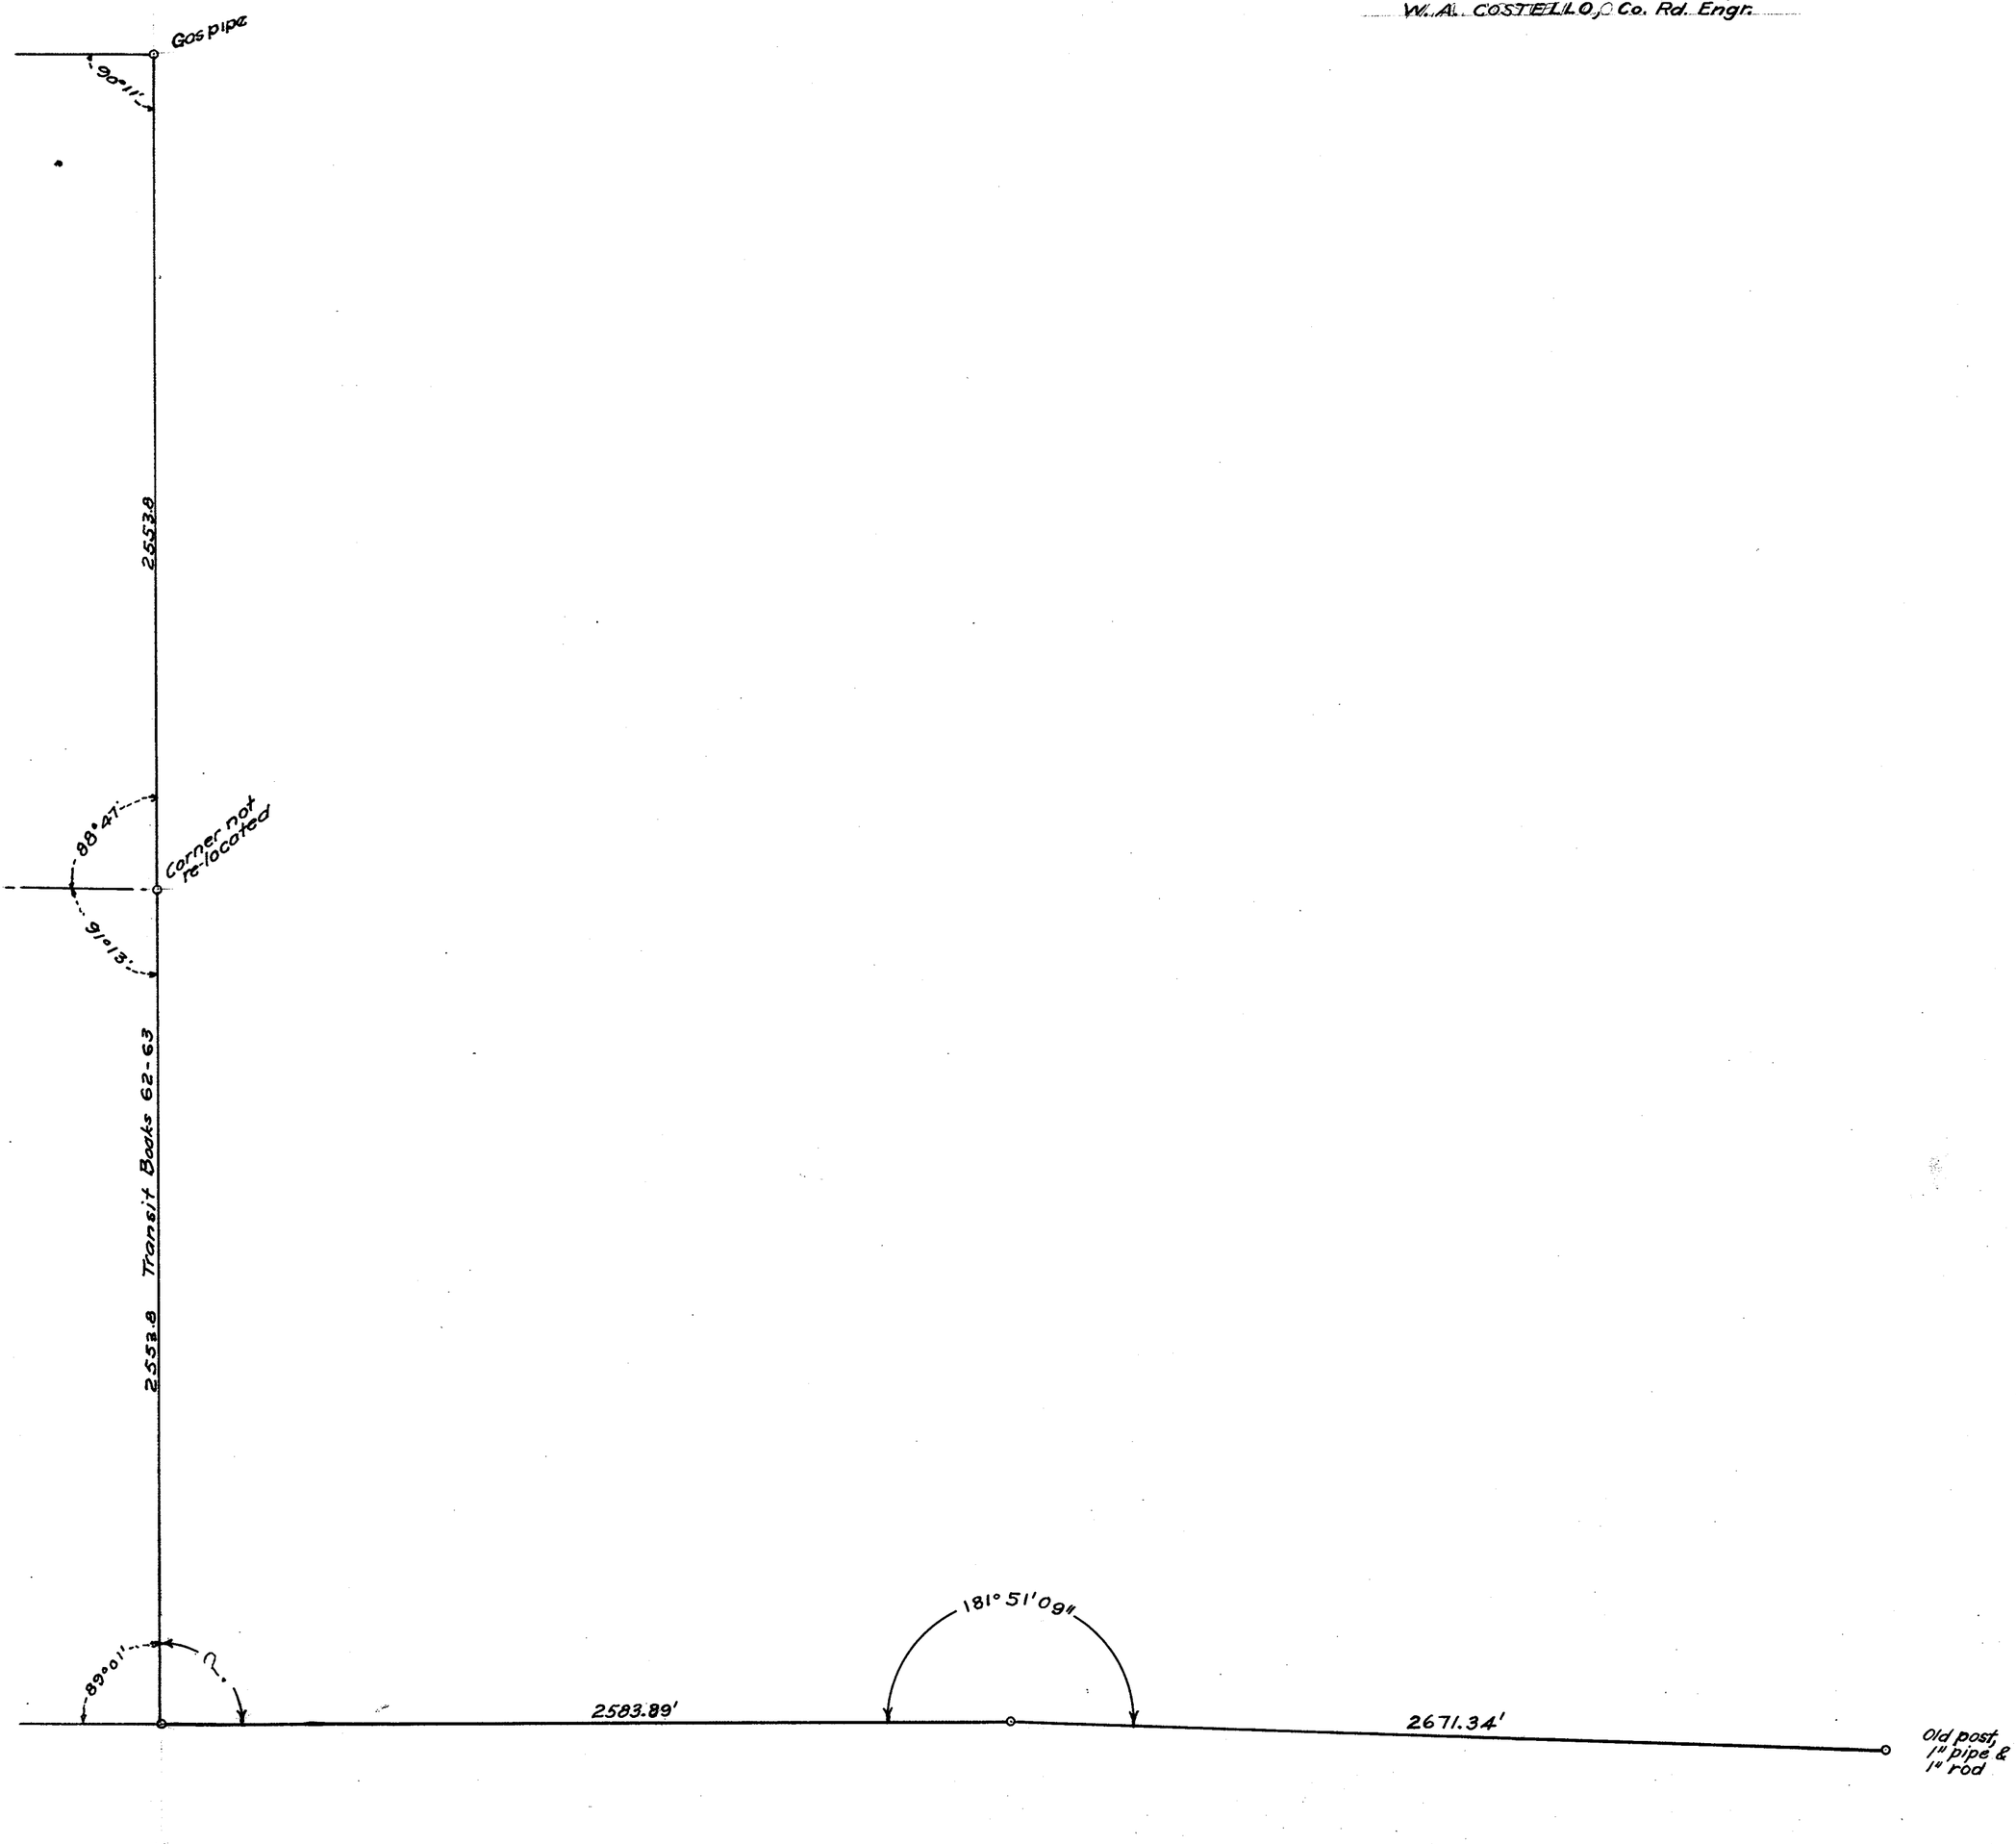


SECTION 32

TOWNSHIP 35 NORTH, RANGE 5 EAST, W. M.
SKAGIT COUNTY, WASH.

SCALE, 1 INCH–400 FEET

W.E. Costello COUNTY ENGINEER
W.A. COSTELLO ~ 1940
Morford Rd. Notes: 40/471

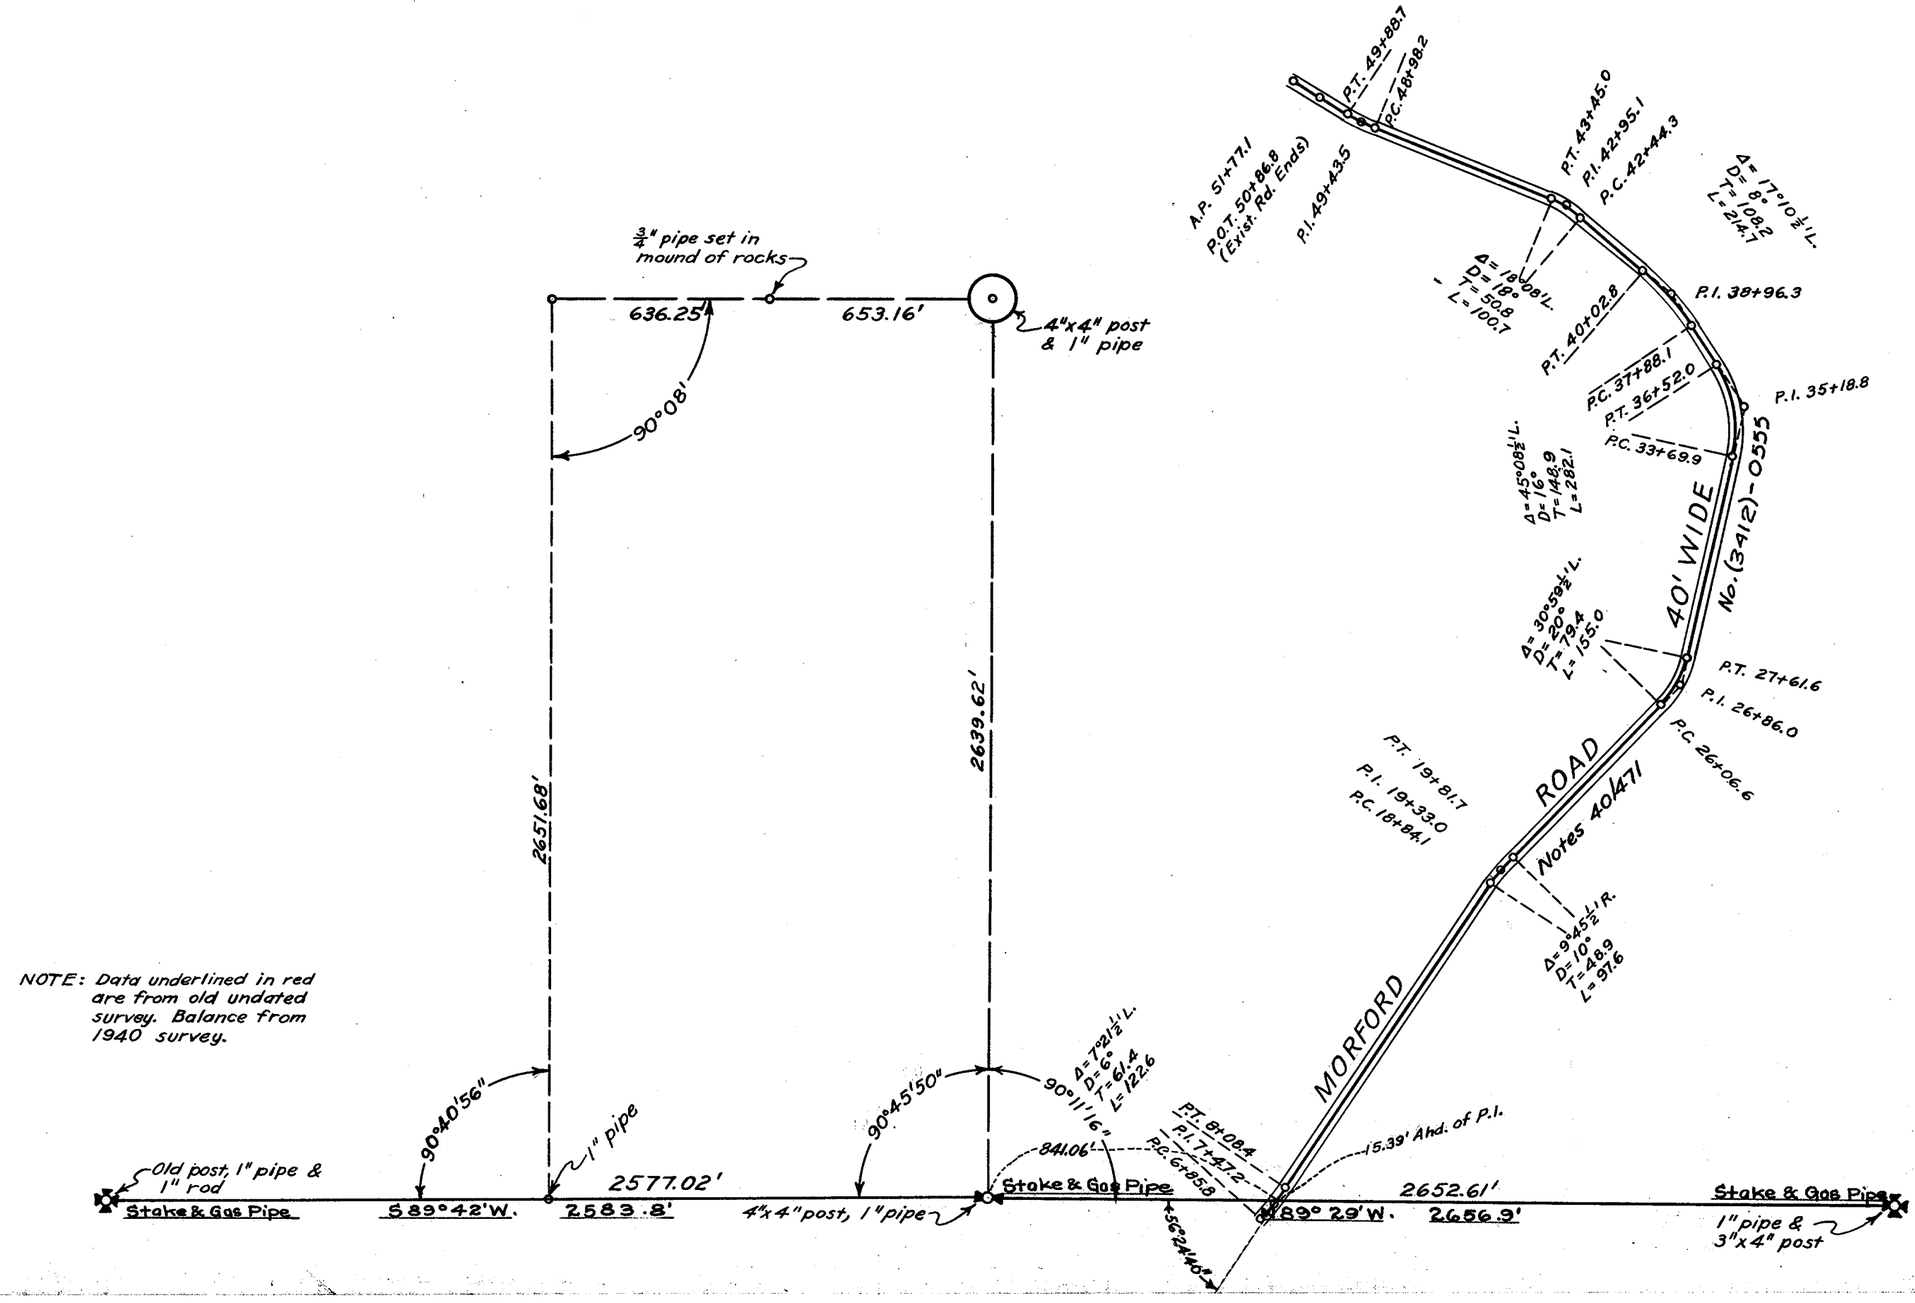

SECTION 32


TOWNSHIP 35 NORTH, RANGE 5 EAST, W. M.

SKAGIT COUNTY, WASH.


Calc. by W.C.W.
SCALE, 1 INCH--400 FEET
Notes 40/471

Center Lines Run & Intersected In Field
Closures Calc. to Corners
Distances and Angles
Rechecked to NW-SE & SW. Cors.

H.O. WALBERG COUNTY ENGINEER

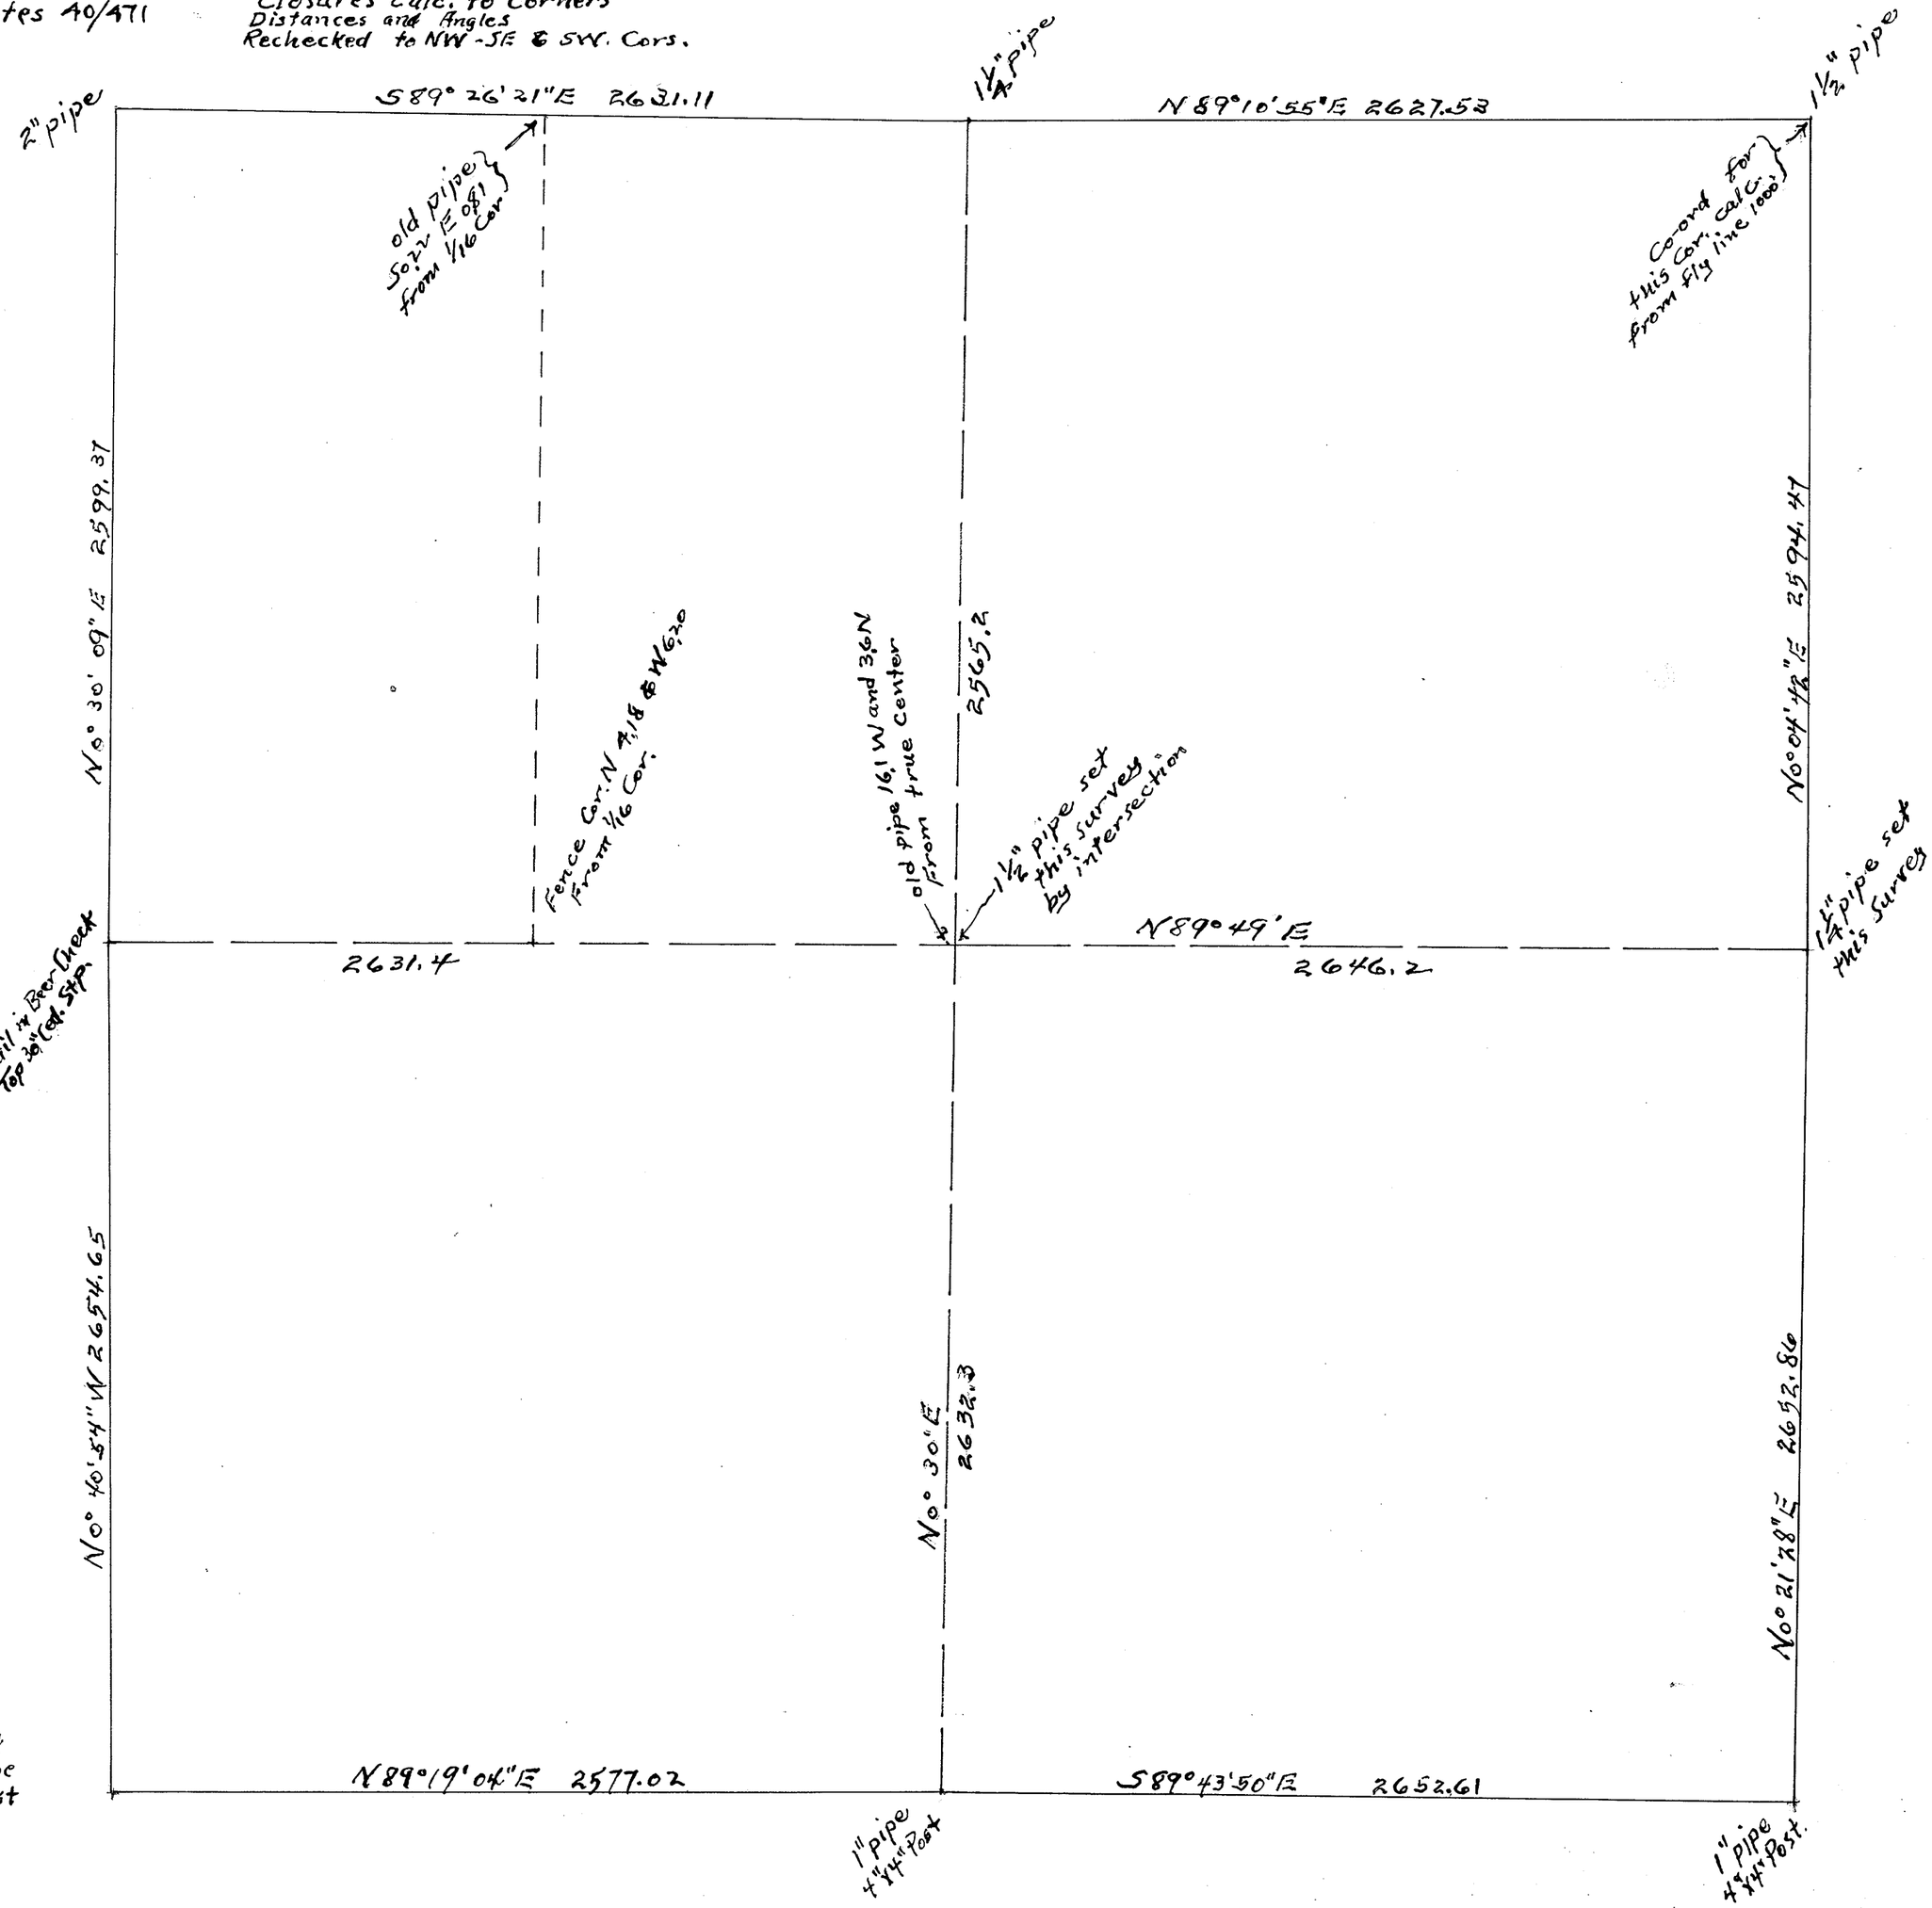

SEC. 33-35-5

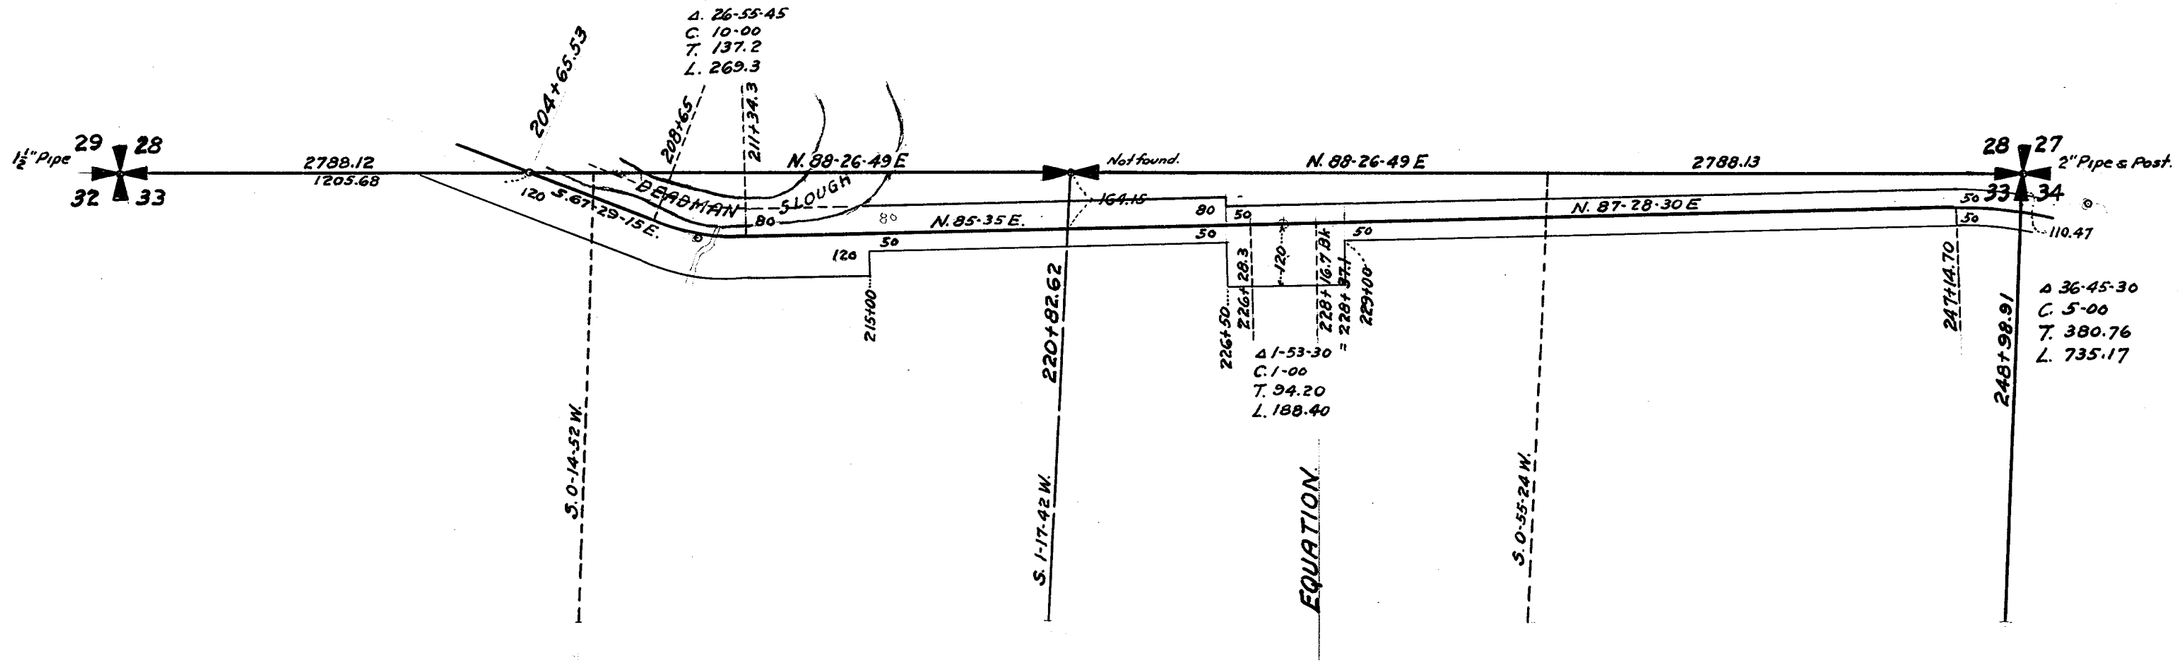

See C.R.P. No. 408

SOUTH SKAGIT HIGHWAY NO. (360) - 0700

SKAGIT COUNTY, WASH.
OFFICE OF COUNTY ROAD ENGINEER

BRIDGE NO._____

LOCATION..... ROAD.....

JOB NO._____

DATE.....

.....
County Road Engineer

APPROVED..... 194.....

.....
Chairman-Board of County Commissioneers


SECTION 33

TOWNSHIP 35 NORTH, RANGE 5 EAST, W. M.

SKAGIT COUNTY, WASH.

SCALE, 1 INCH--400 FEET

W.A. COSTELLO ~ 1940 COUNTY ENGINEER

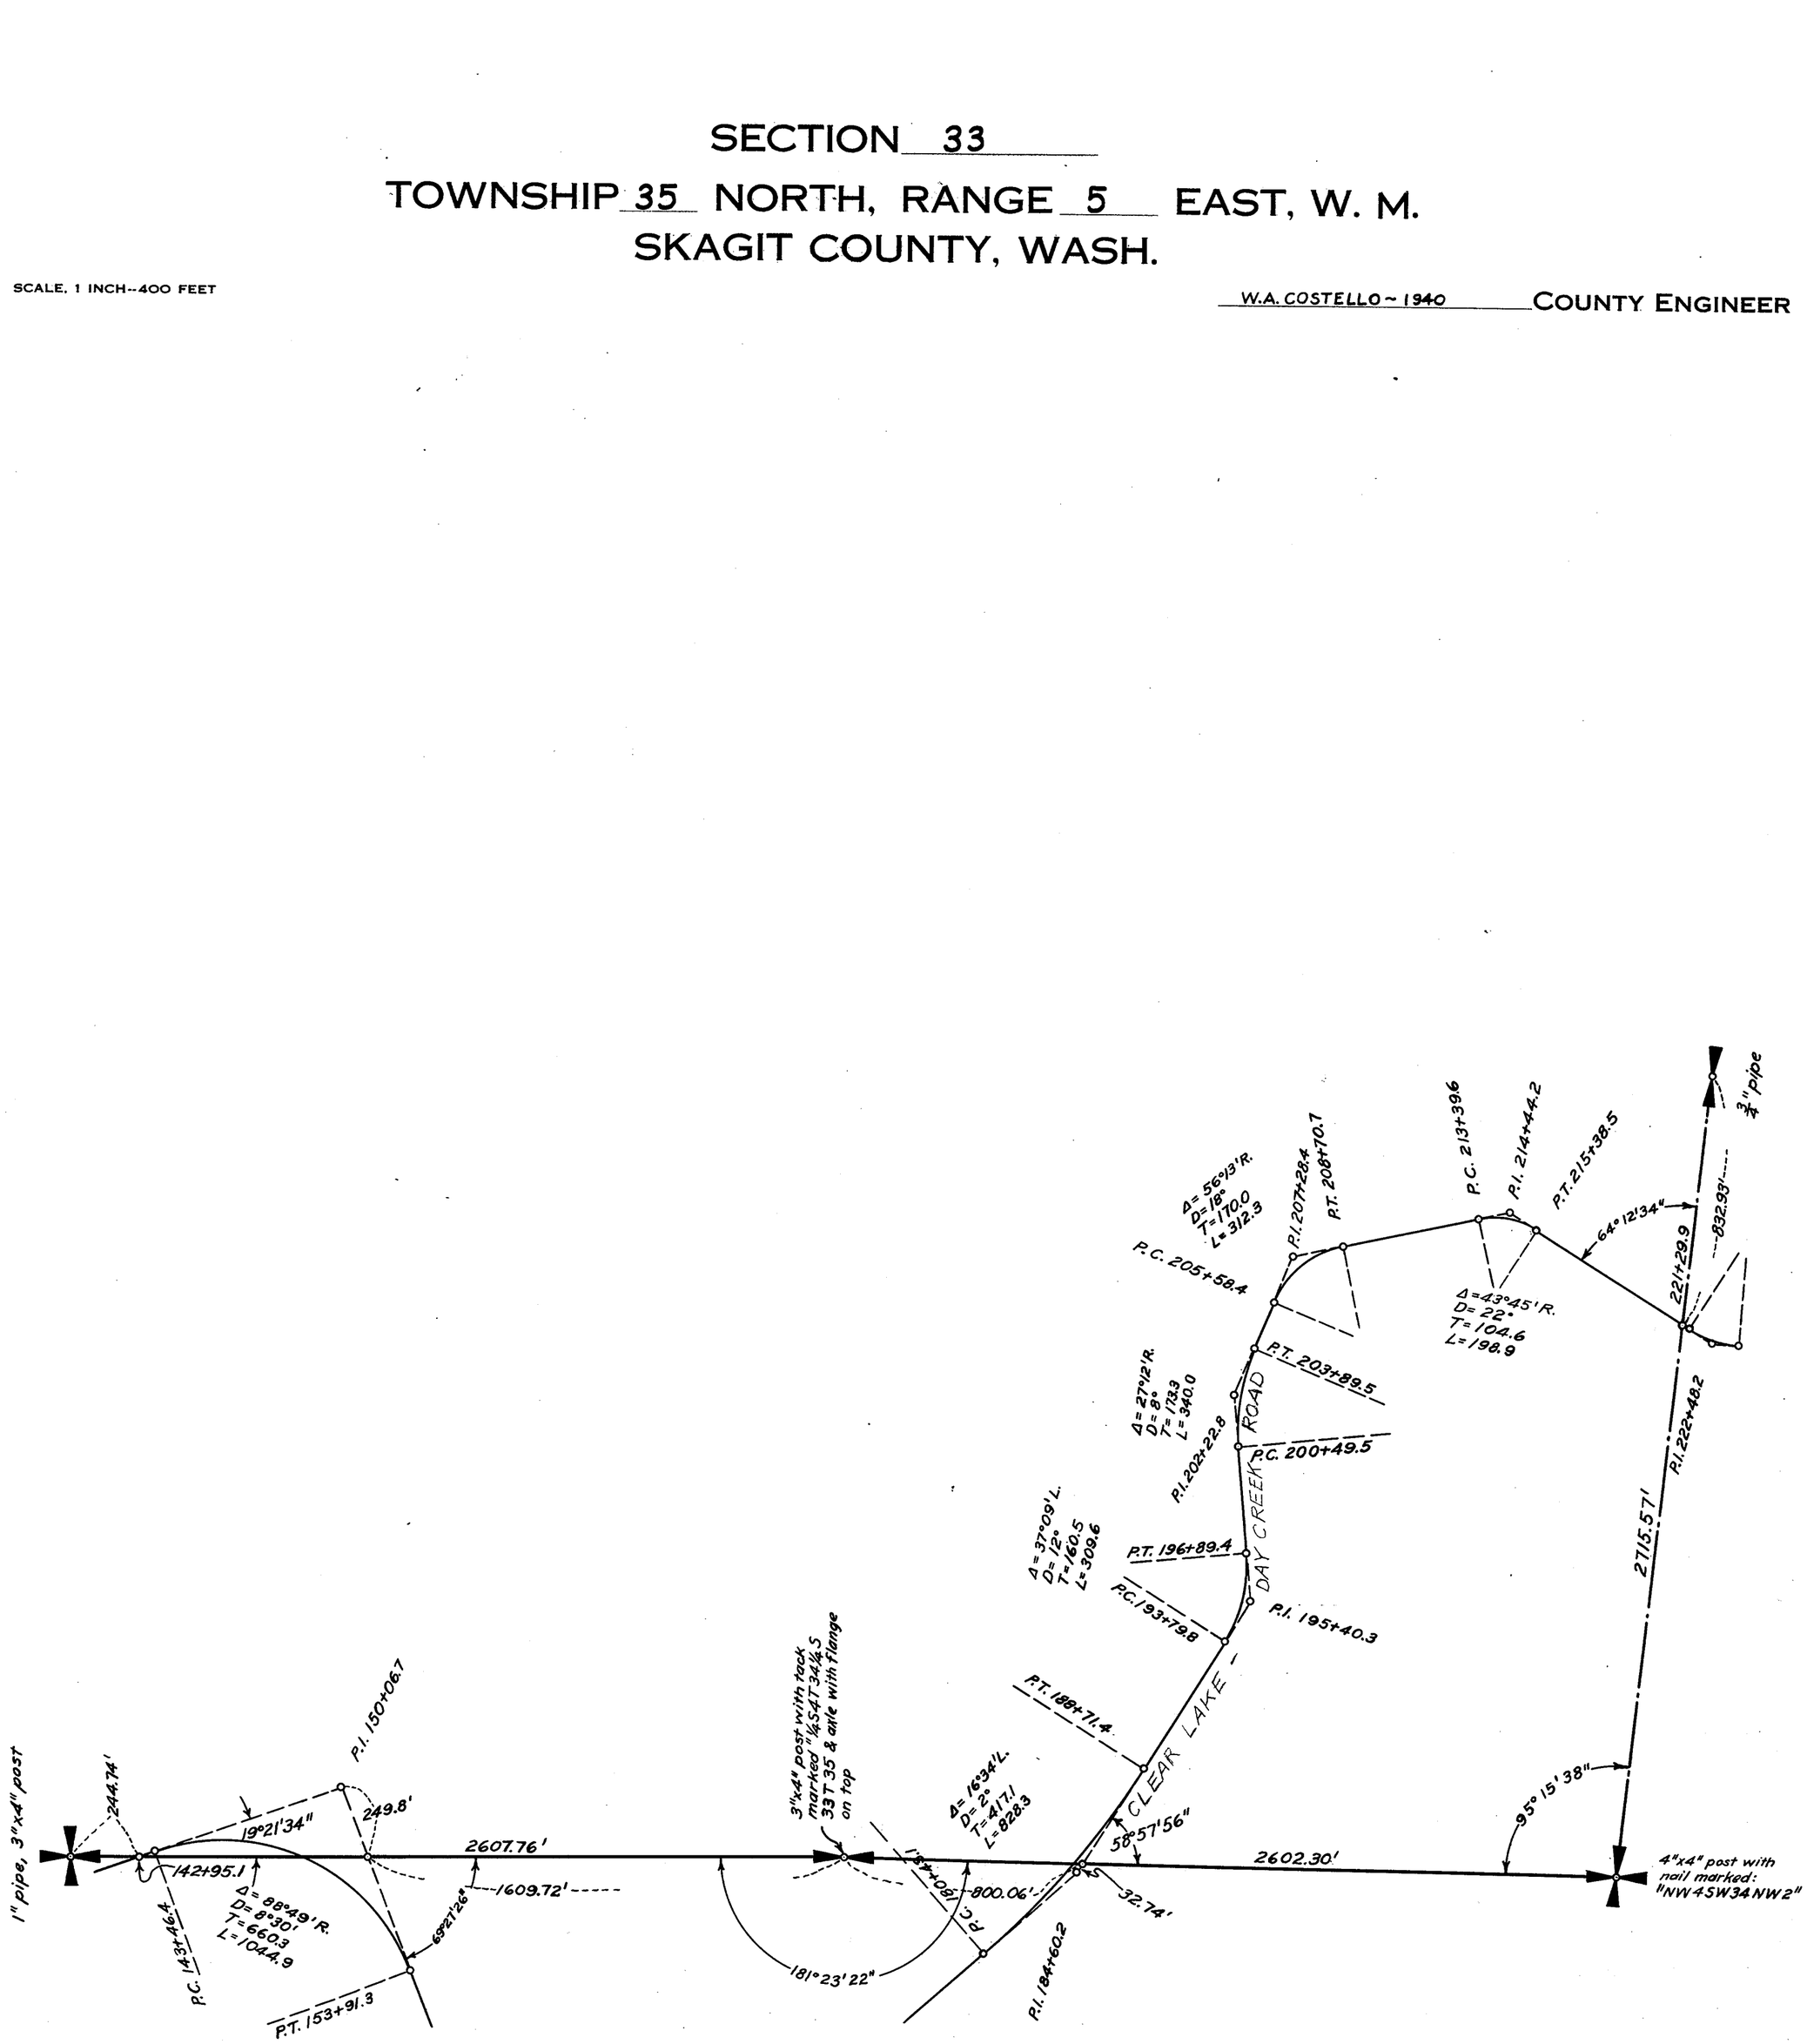


SECTION 33

TOWNSHIP 35 NORTH, RANGE 5 EAST, W. M.

SKAGIT COUNTY, WASH.

SCALE, 1 INCH–400 FEET

W.E. Costello COUNTY ENGINEER

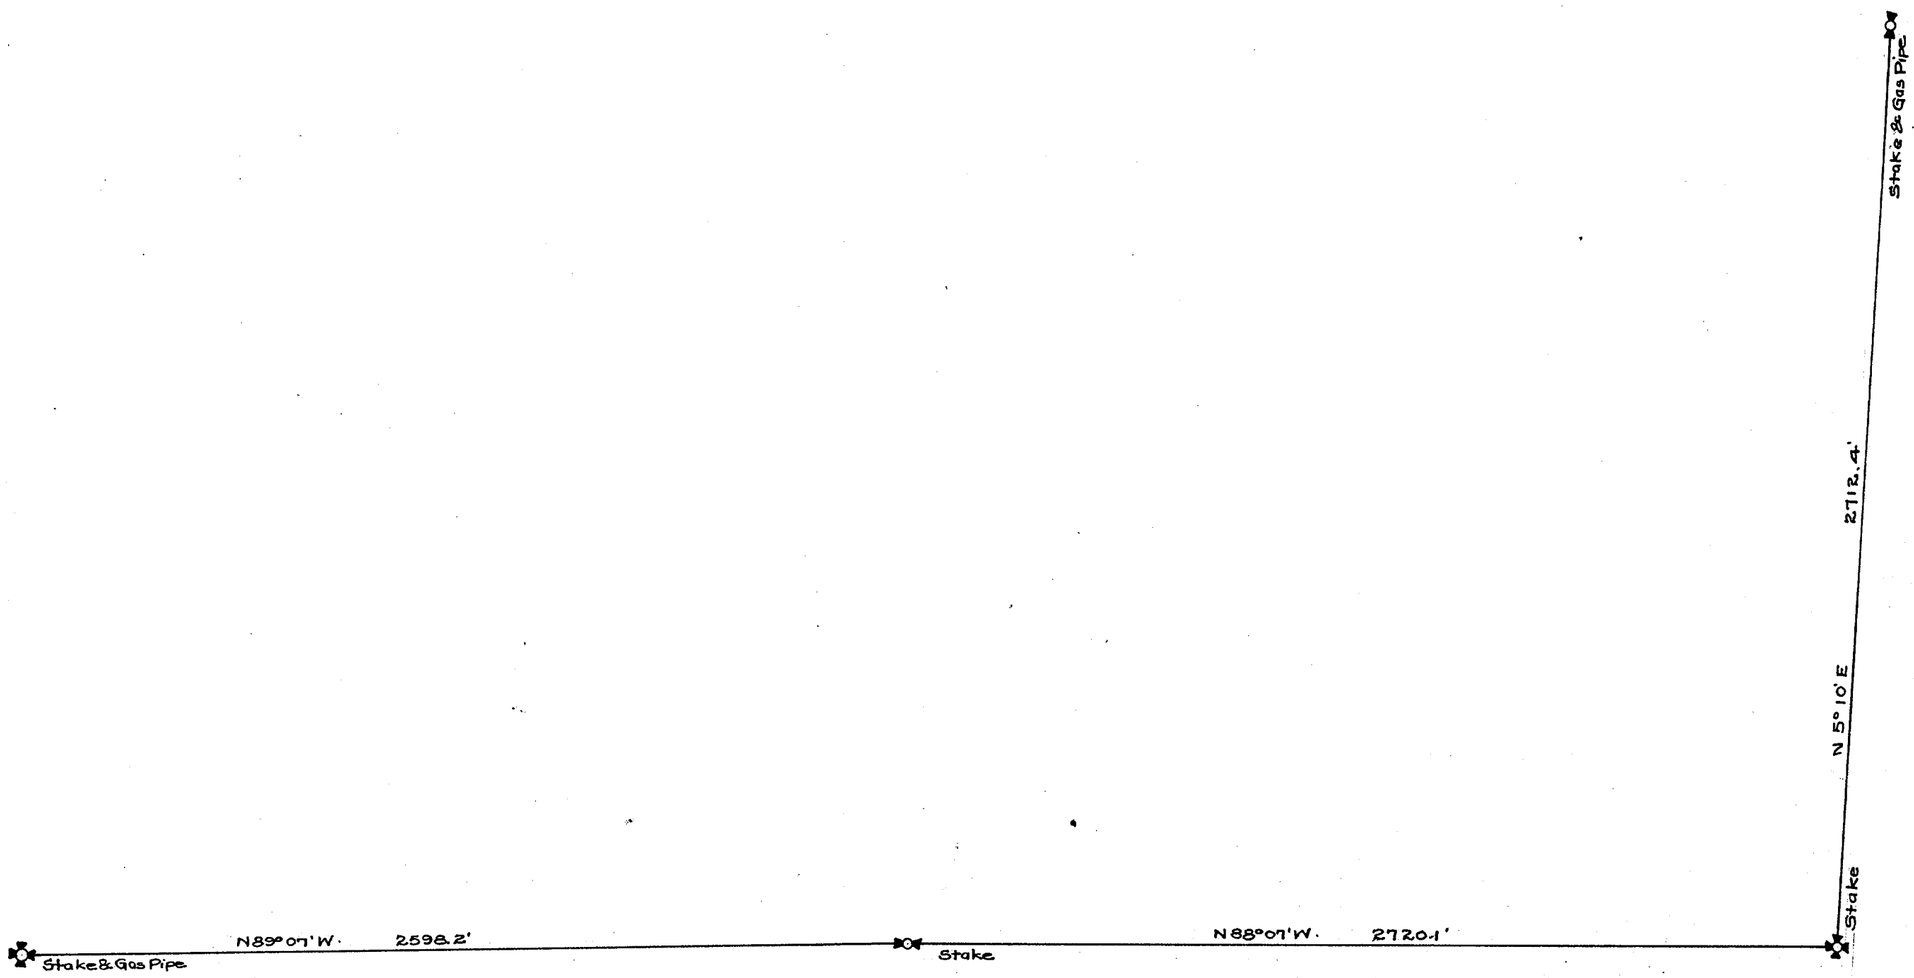


SECTION 34

TOWNSHIP 35 NORTH, RANGE 5 EAST, W. M.


SKAGIT COUNTY, WASH.

SCALE, 1 INCH--400 FEET

W.A. COSTELLO ~ 1940 COUNTY ENGINEER

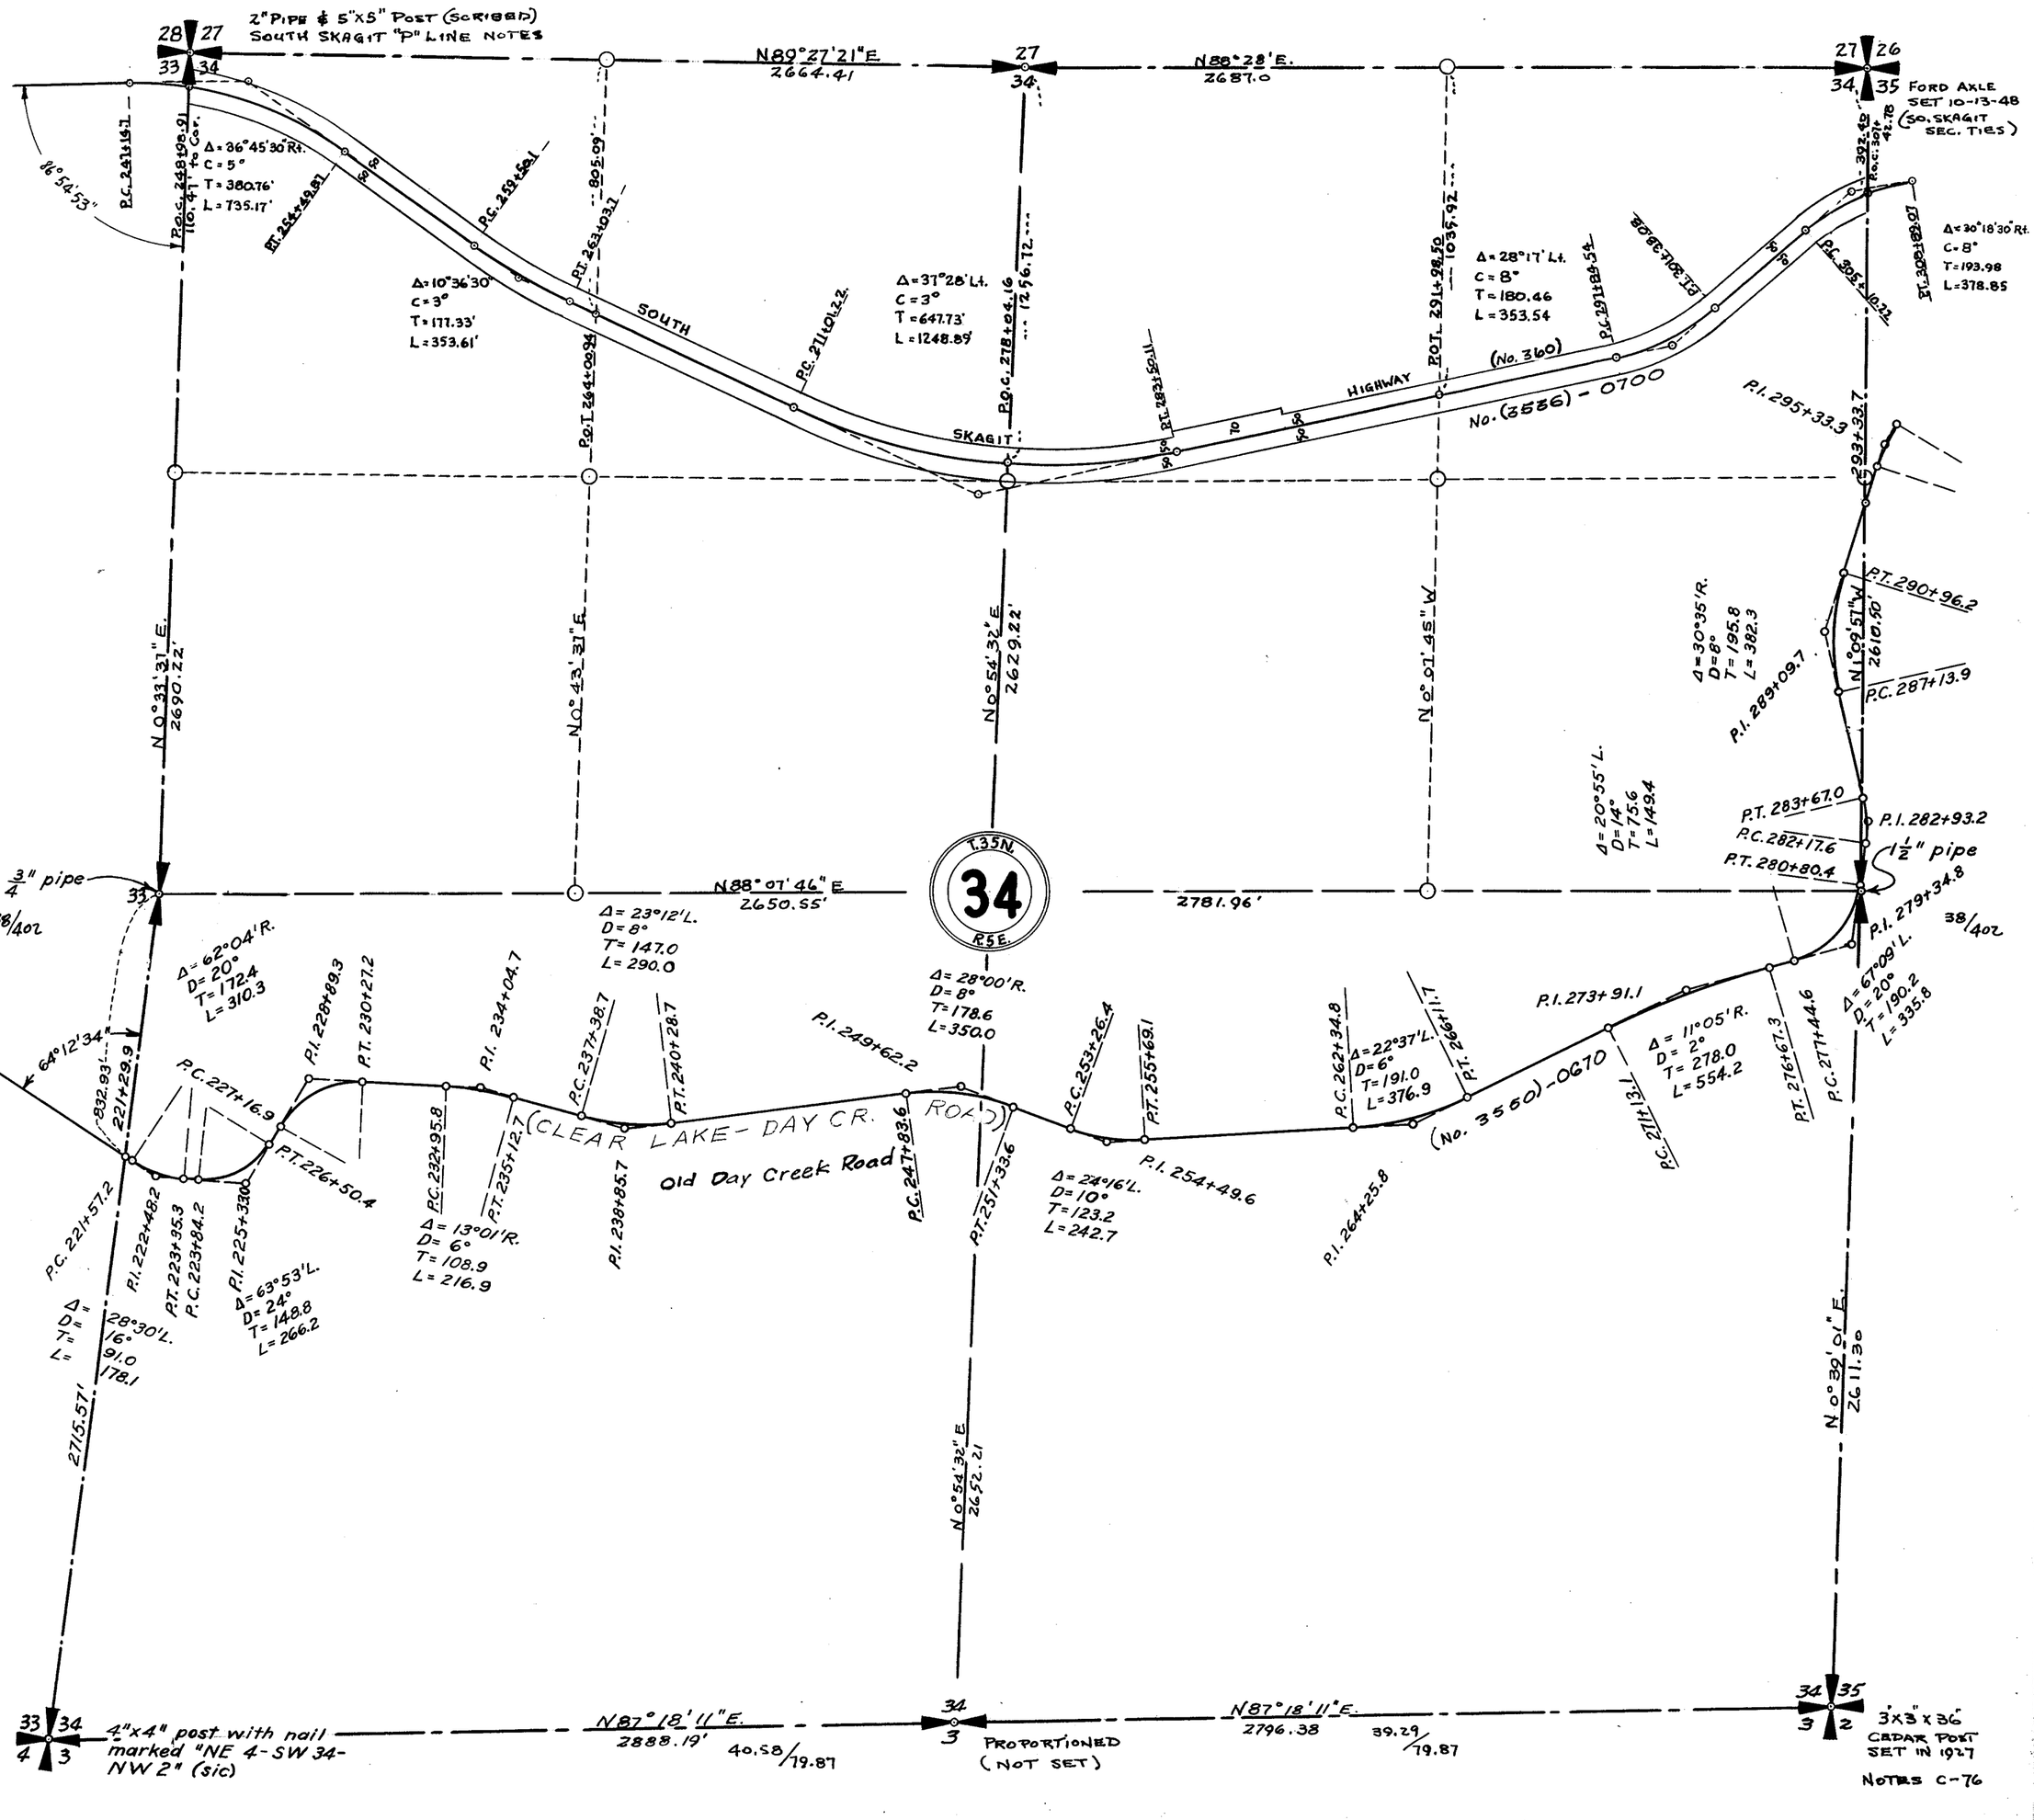

SEC. 34-35-5

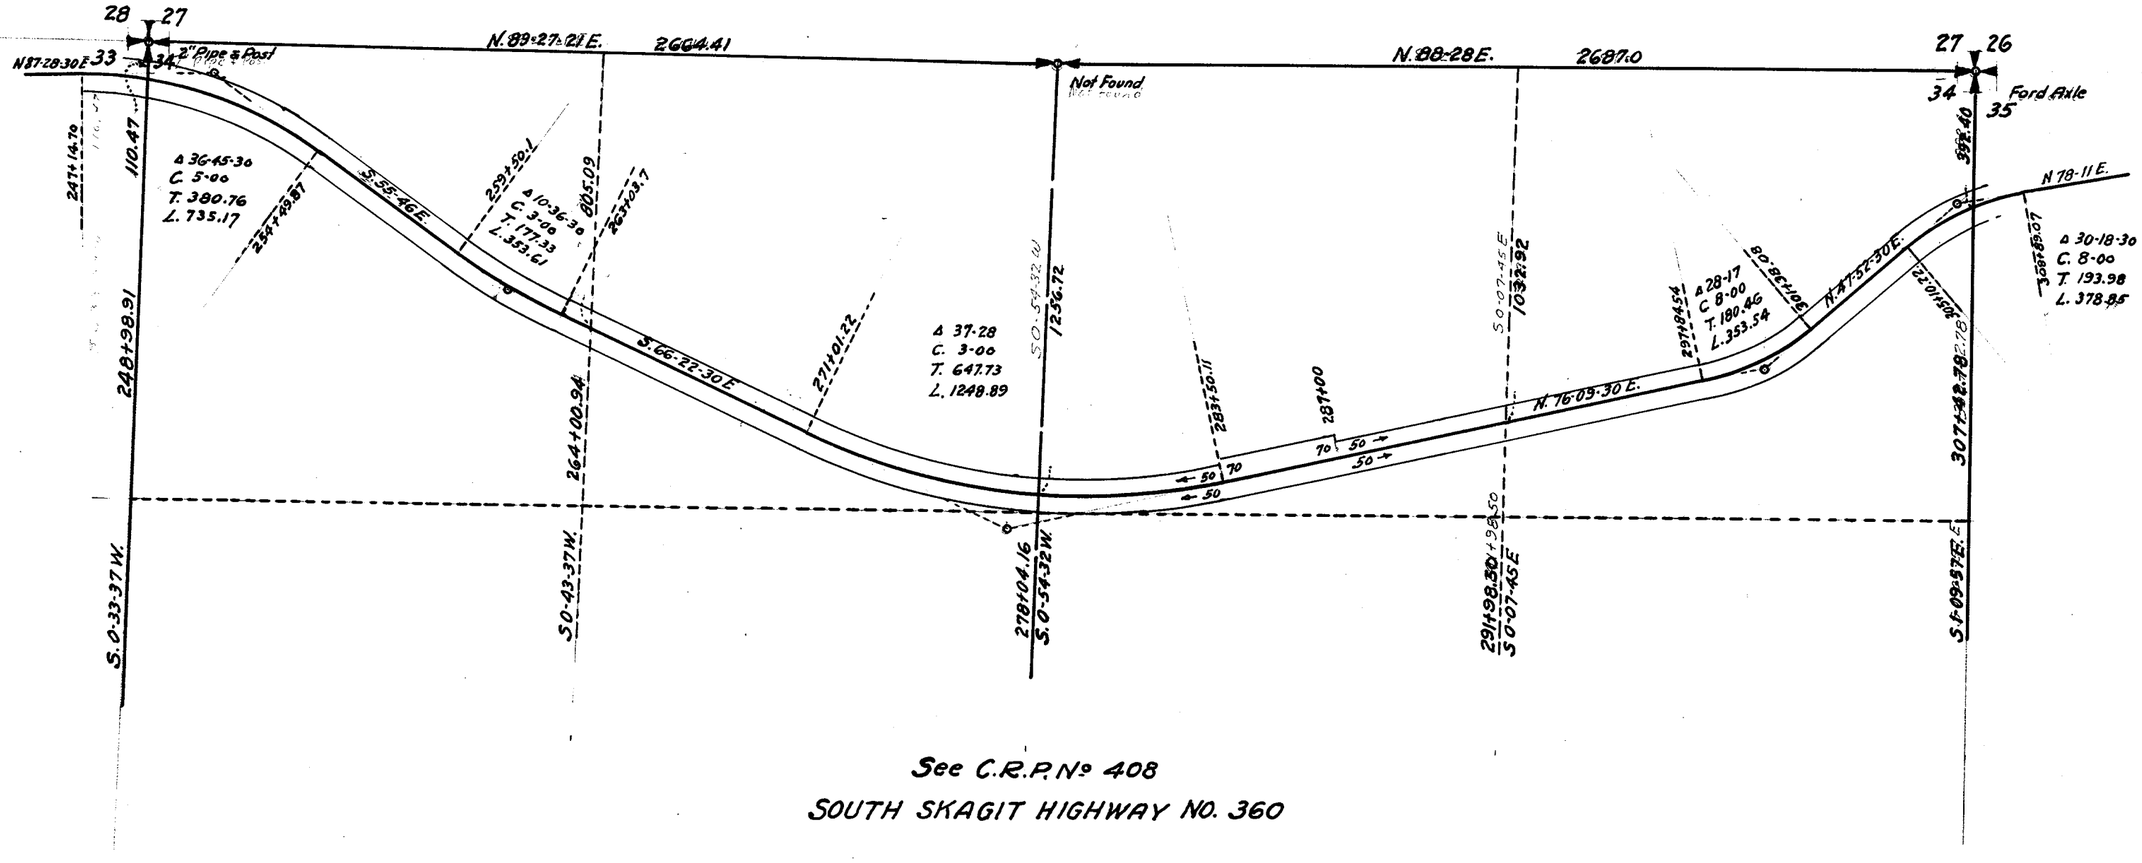

See C.R.P. No 408

SOUTH SKAGIT HIGHWAY NO. 360

SKAGIT COUNTY, WASH.
OFFICE OF COUNTY ROAD ENGINEER

BRIDGE NO._____

LOCATION..... ROAD.....

JOB NO._____

DATE.....

.....
County Road Engineer

APPROVED..... 194.....


.....
Chairman-Board of County Commissioneers

SECTION 35

TOWNSHIP 35 NORTH, RANGE 5 EAST, W. M.
SKAGIT COUNTY, WASH.


SCALE, 1 INCH--400 FEET

W. A. COSTELLO ~ 1940 COUNTY ENGINEER

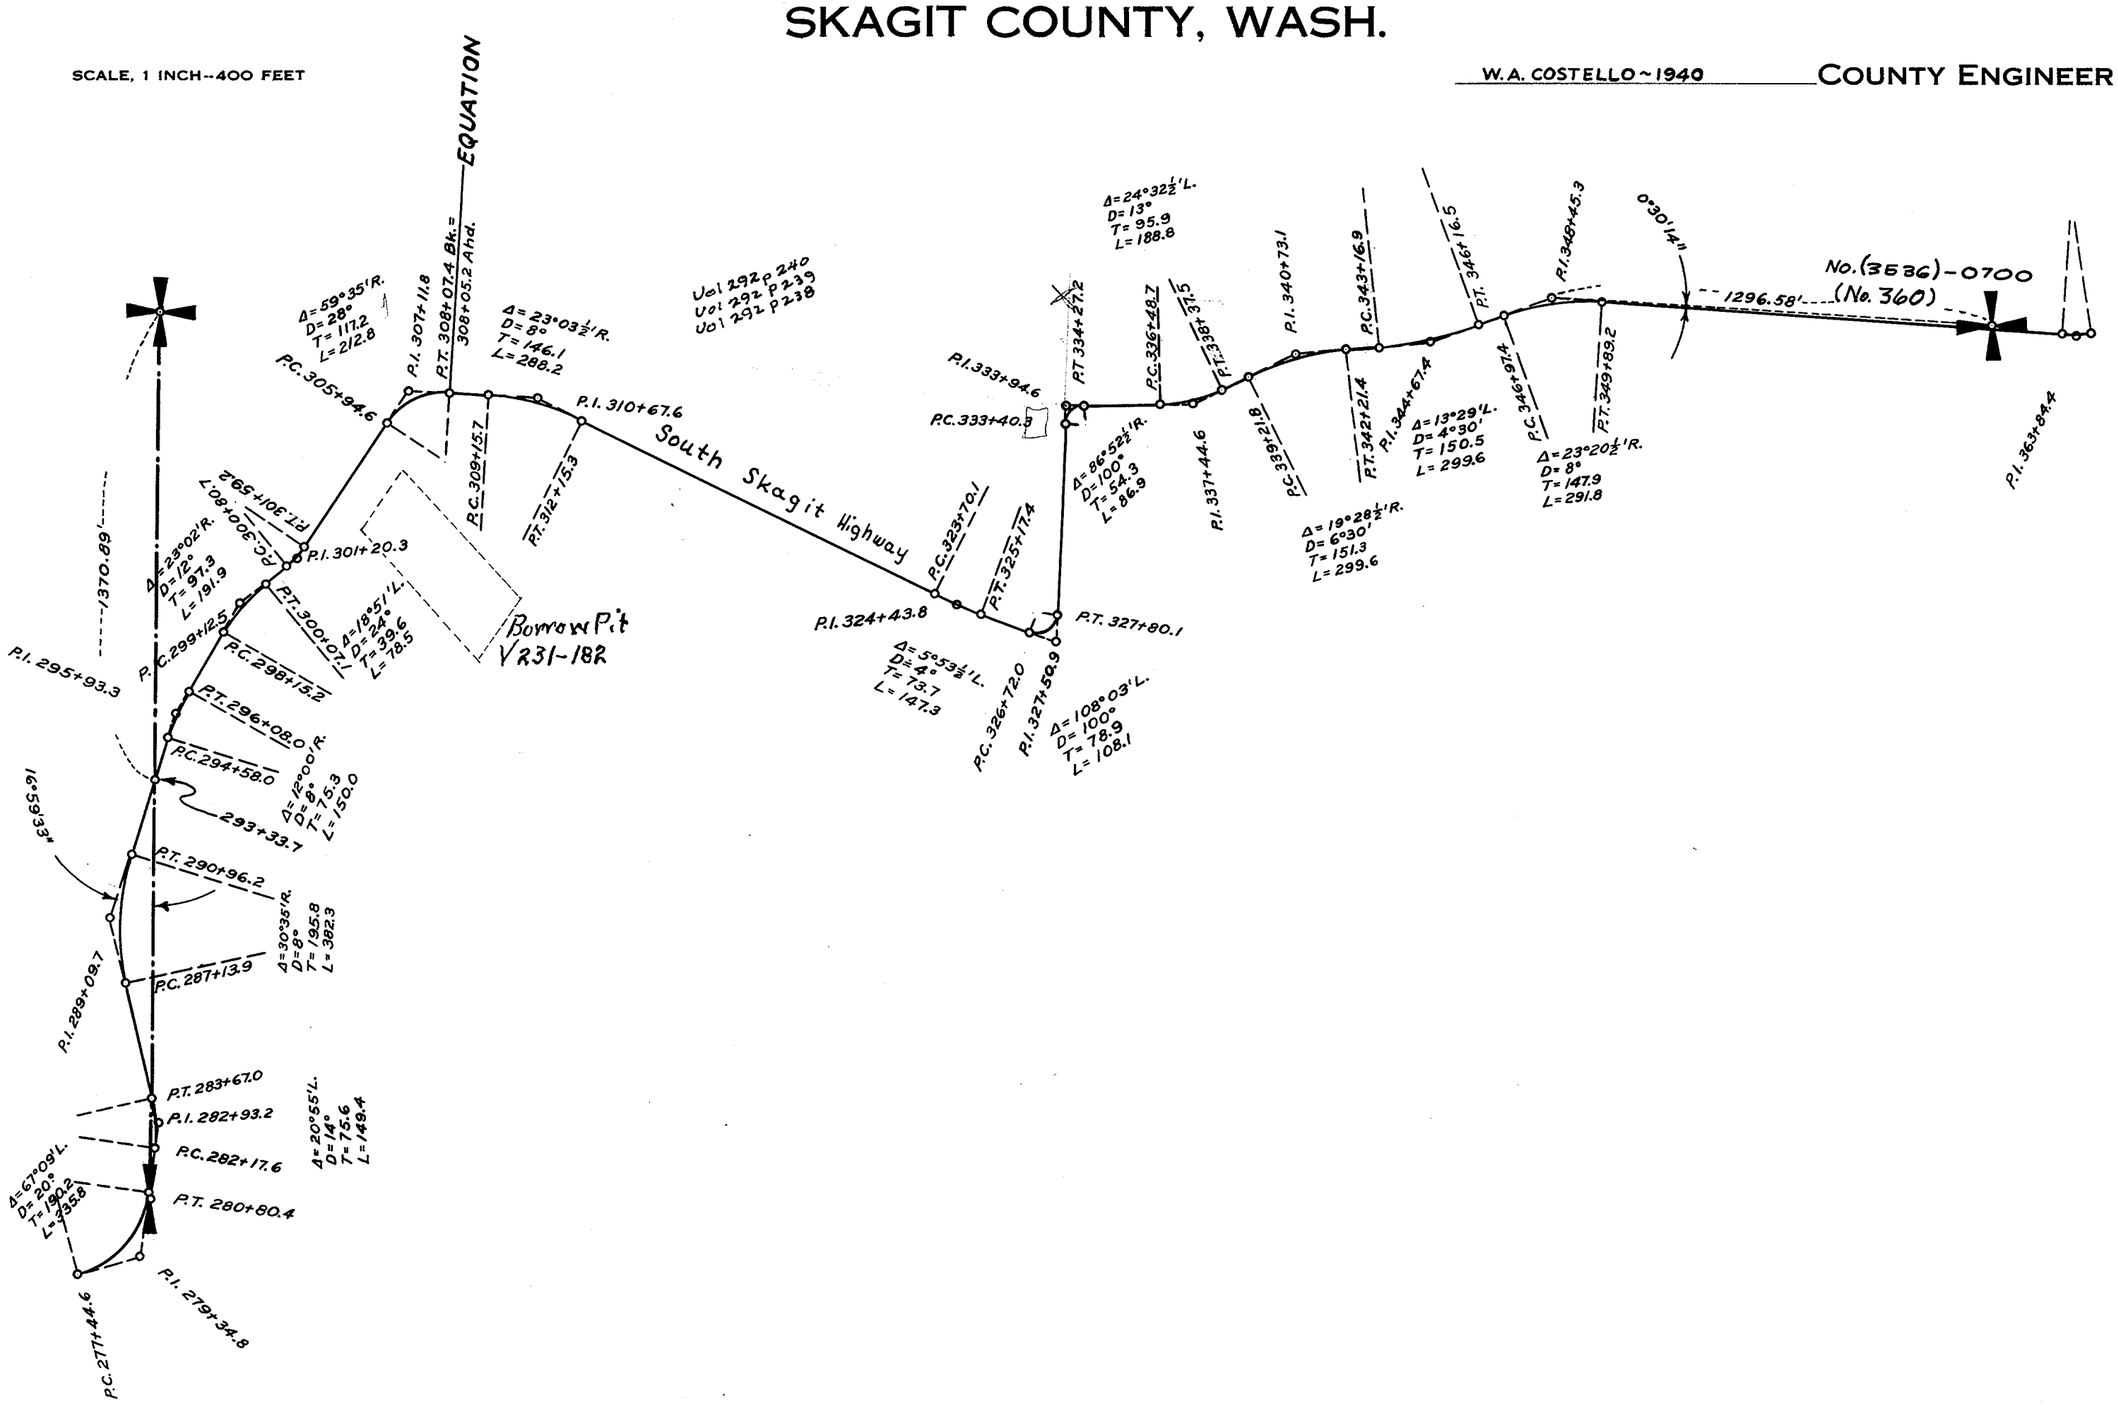

SEC. 35-35-5

Scale : 1 Inch = 200 Feet

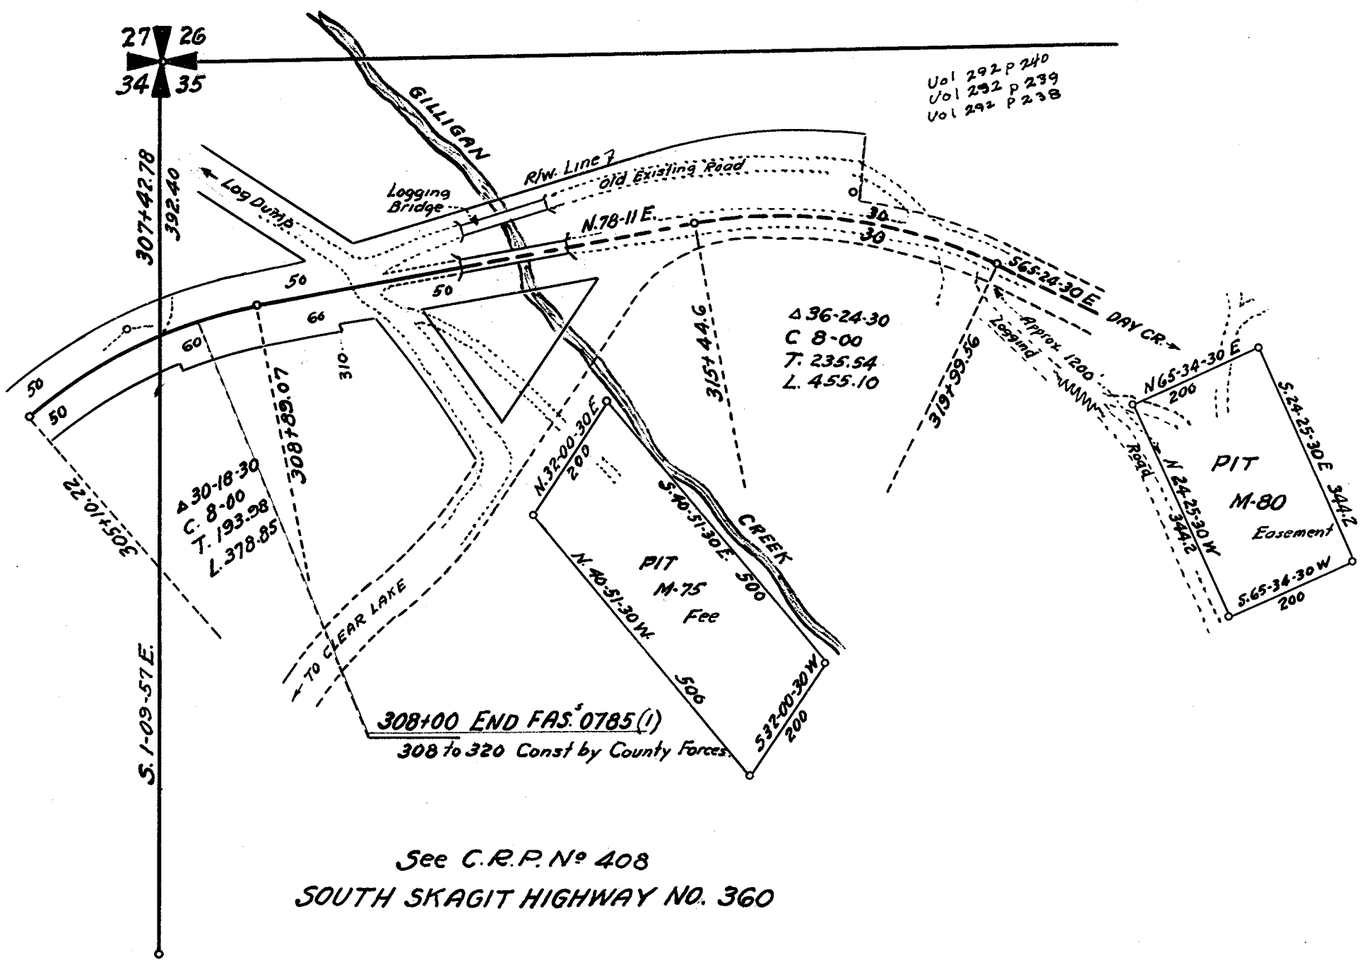

See C.R.P. Nº 408

SOUTH SKAGIT HIGHWAY NO. 360

SKAGIT COUNTY, WASH.

OFFICE OF COUNTY ROAD ENGINEER

BRIDGE NO._____

LOCATION..... ROAD.....

JOB NO._____

DATE.....

.....
County Road Engineer

APPROVED..... 194.....


.....
Chairman-Board of County Commissioneers

SECTION 36

TOWNSHIP 35 NORTH, RANGE 5 EAST, W. M.
SKAGIT COUNTY, WASH.

SCALE, 1 INCH--400 FEET

W.A. COSTELLO~1940 COUNTY ENGINEER

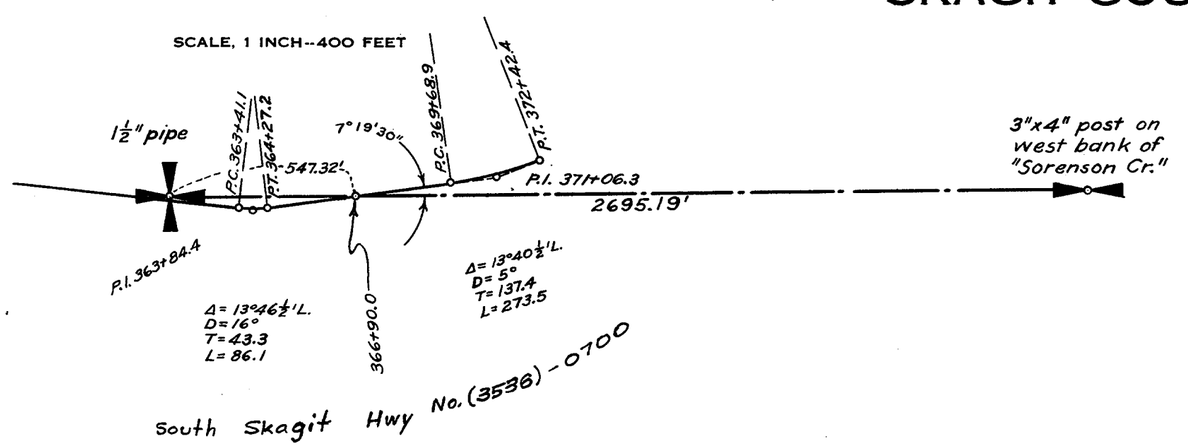


SECTION 9

TOWNSHIP 35 NORTH, RANGE 6 EAST, W. M.

SKAGIT COUNTY, WASH.

SCALE, 1 INCH--400 FEET
Road No. 281 From Notes 41/496
Subdivision From Bk. 71, P. 59

DATE December, 1959 Frank Gilkey COUNTY ENGINEER

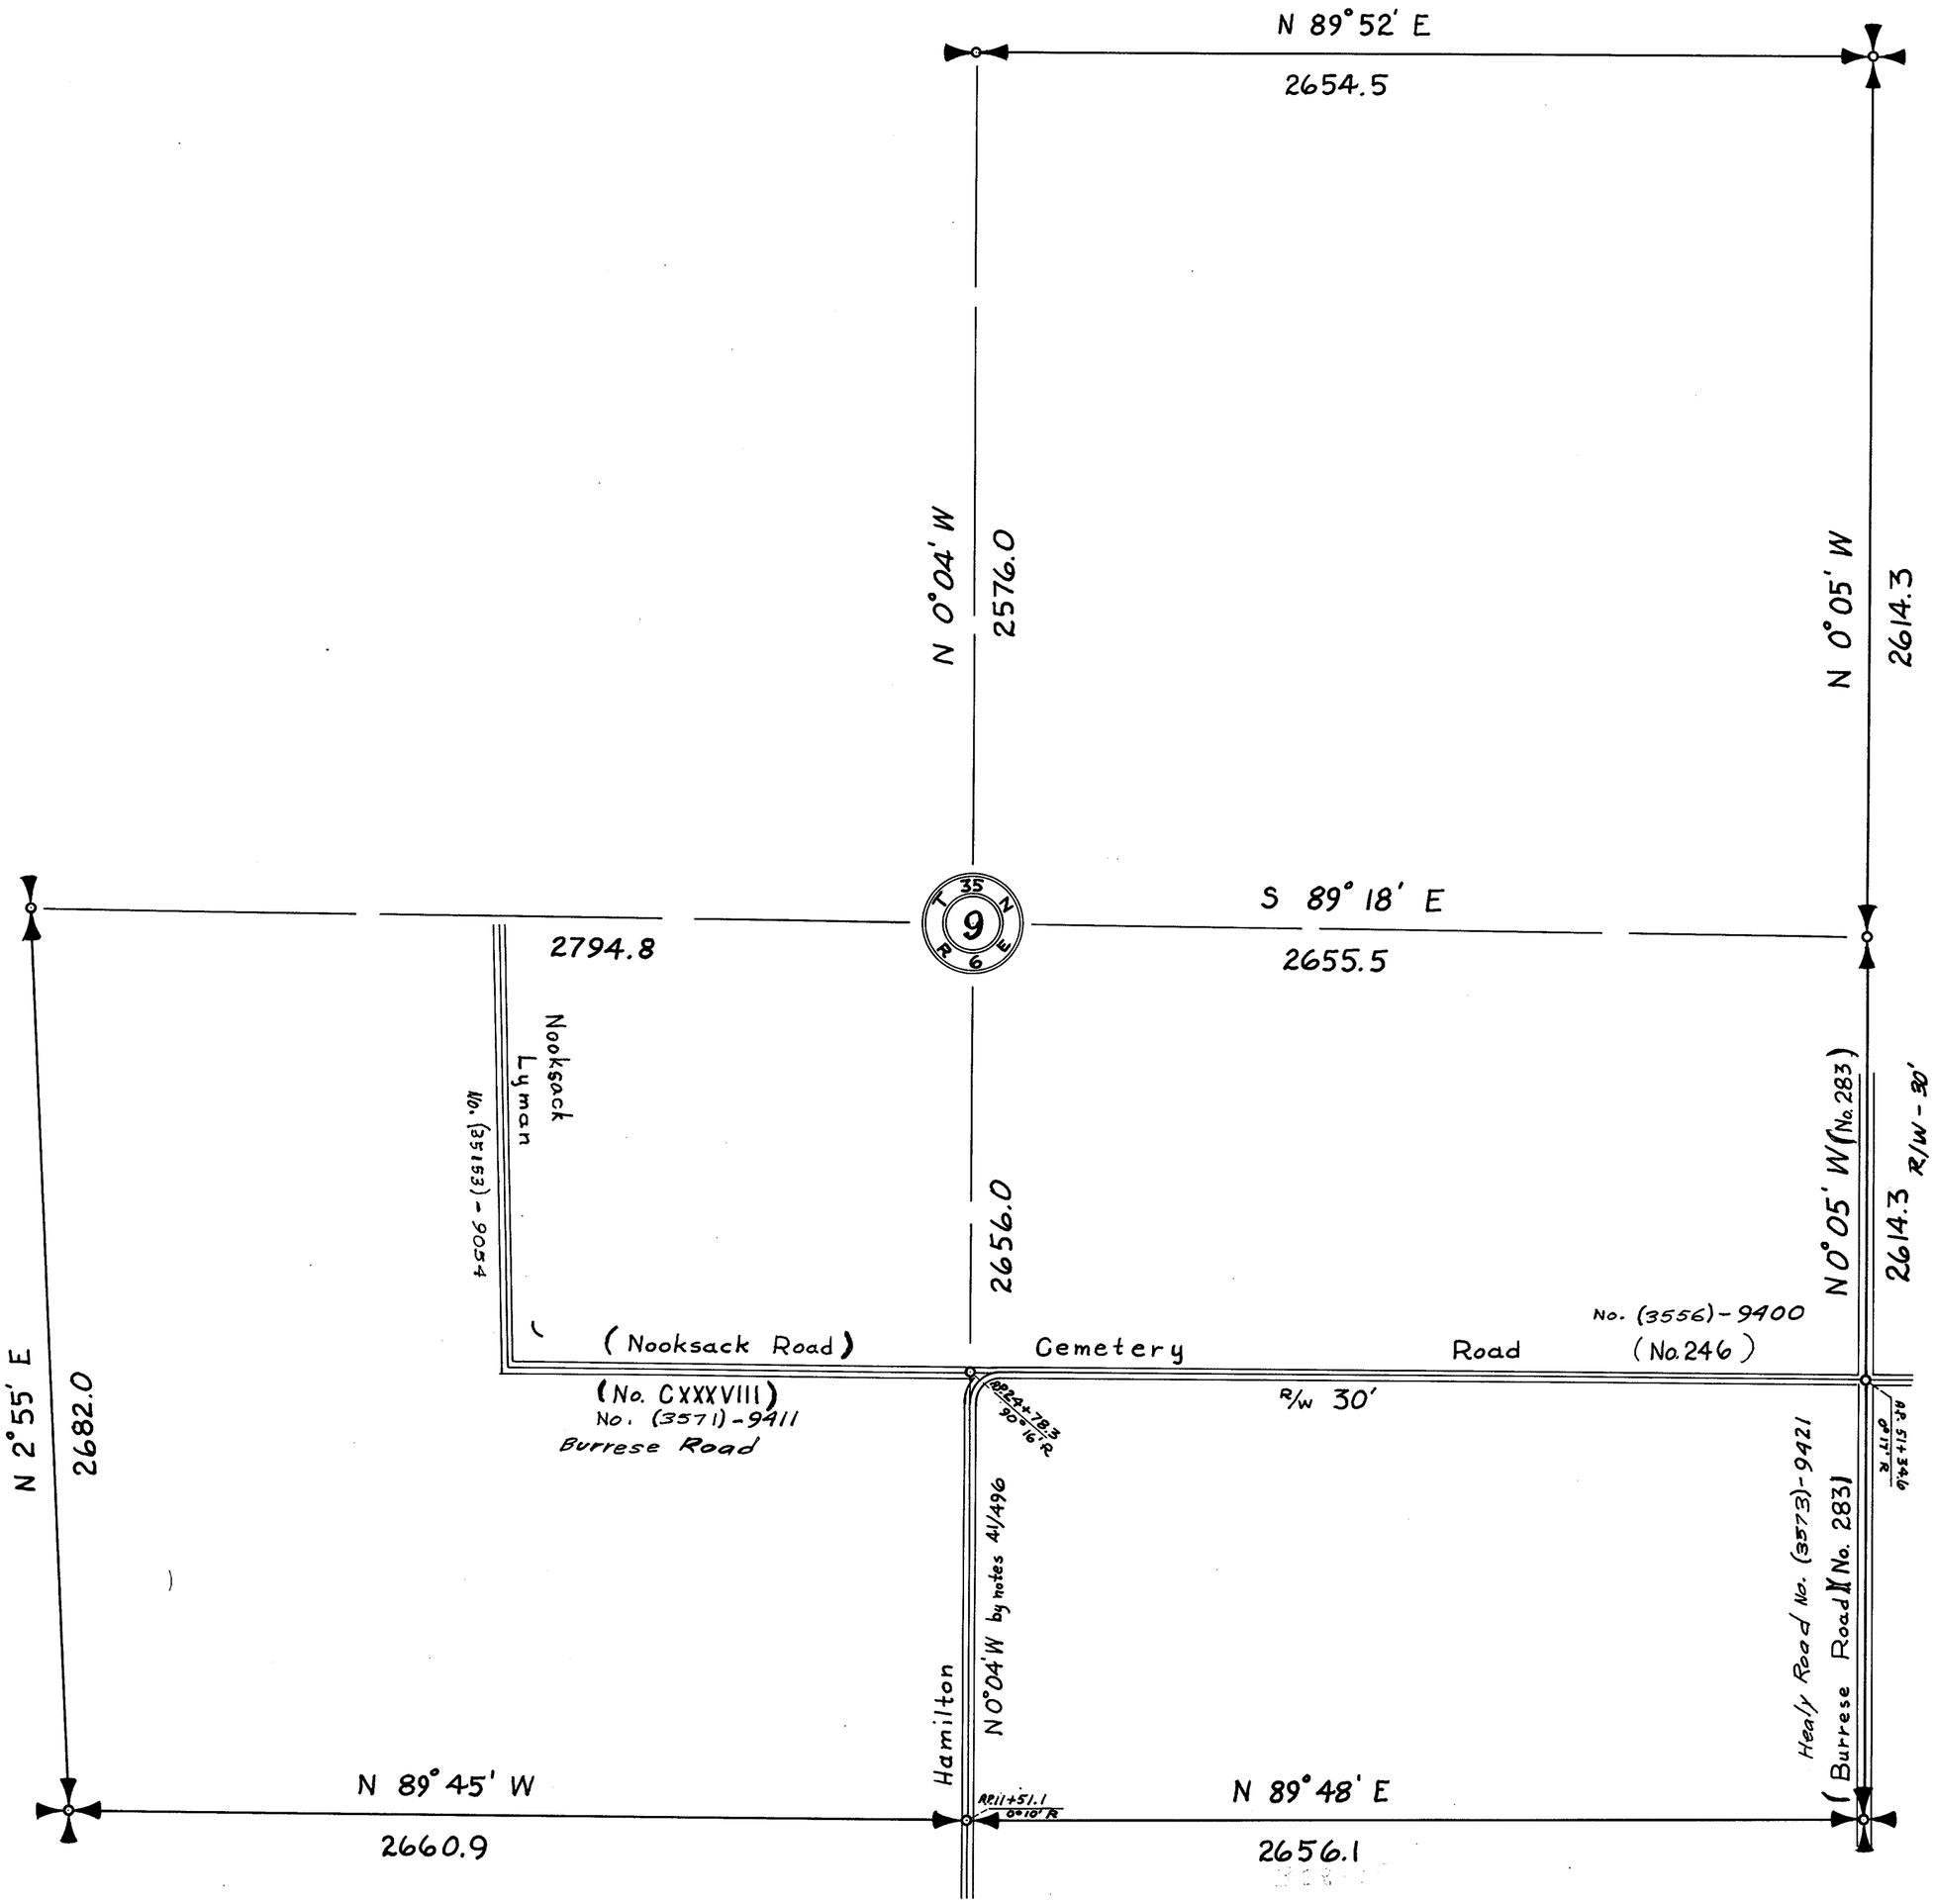

SECTION 9


TOWNSHIP 35 NORTH, RANGE 6 EAST, W. M.
SKAGIT COUNTY, WASH.

SCALE, 1 INCH–400 FEET

A. L. STRONG COUNTY ENGINEER

W. E. COSTELLO,

See also E.Y. 12 · 1929 Knapp

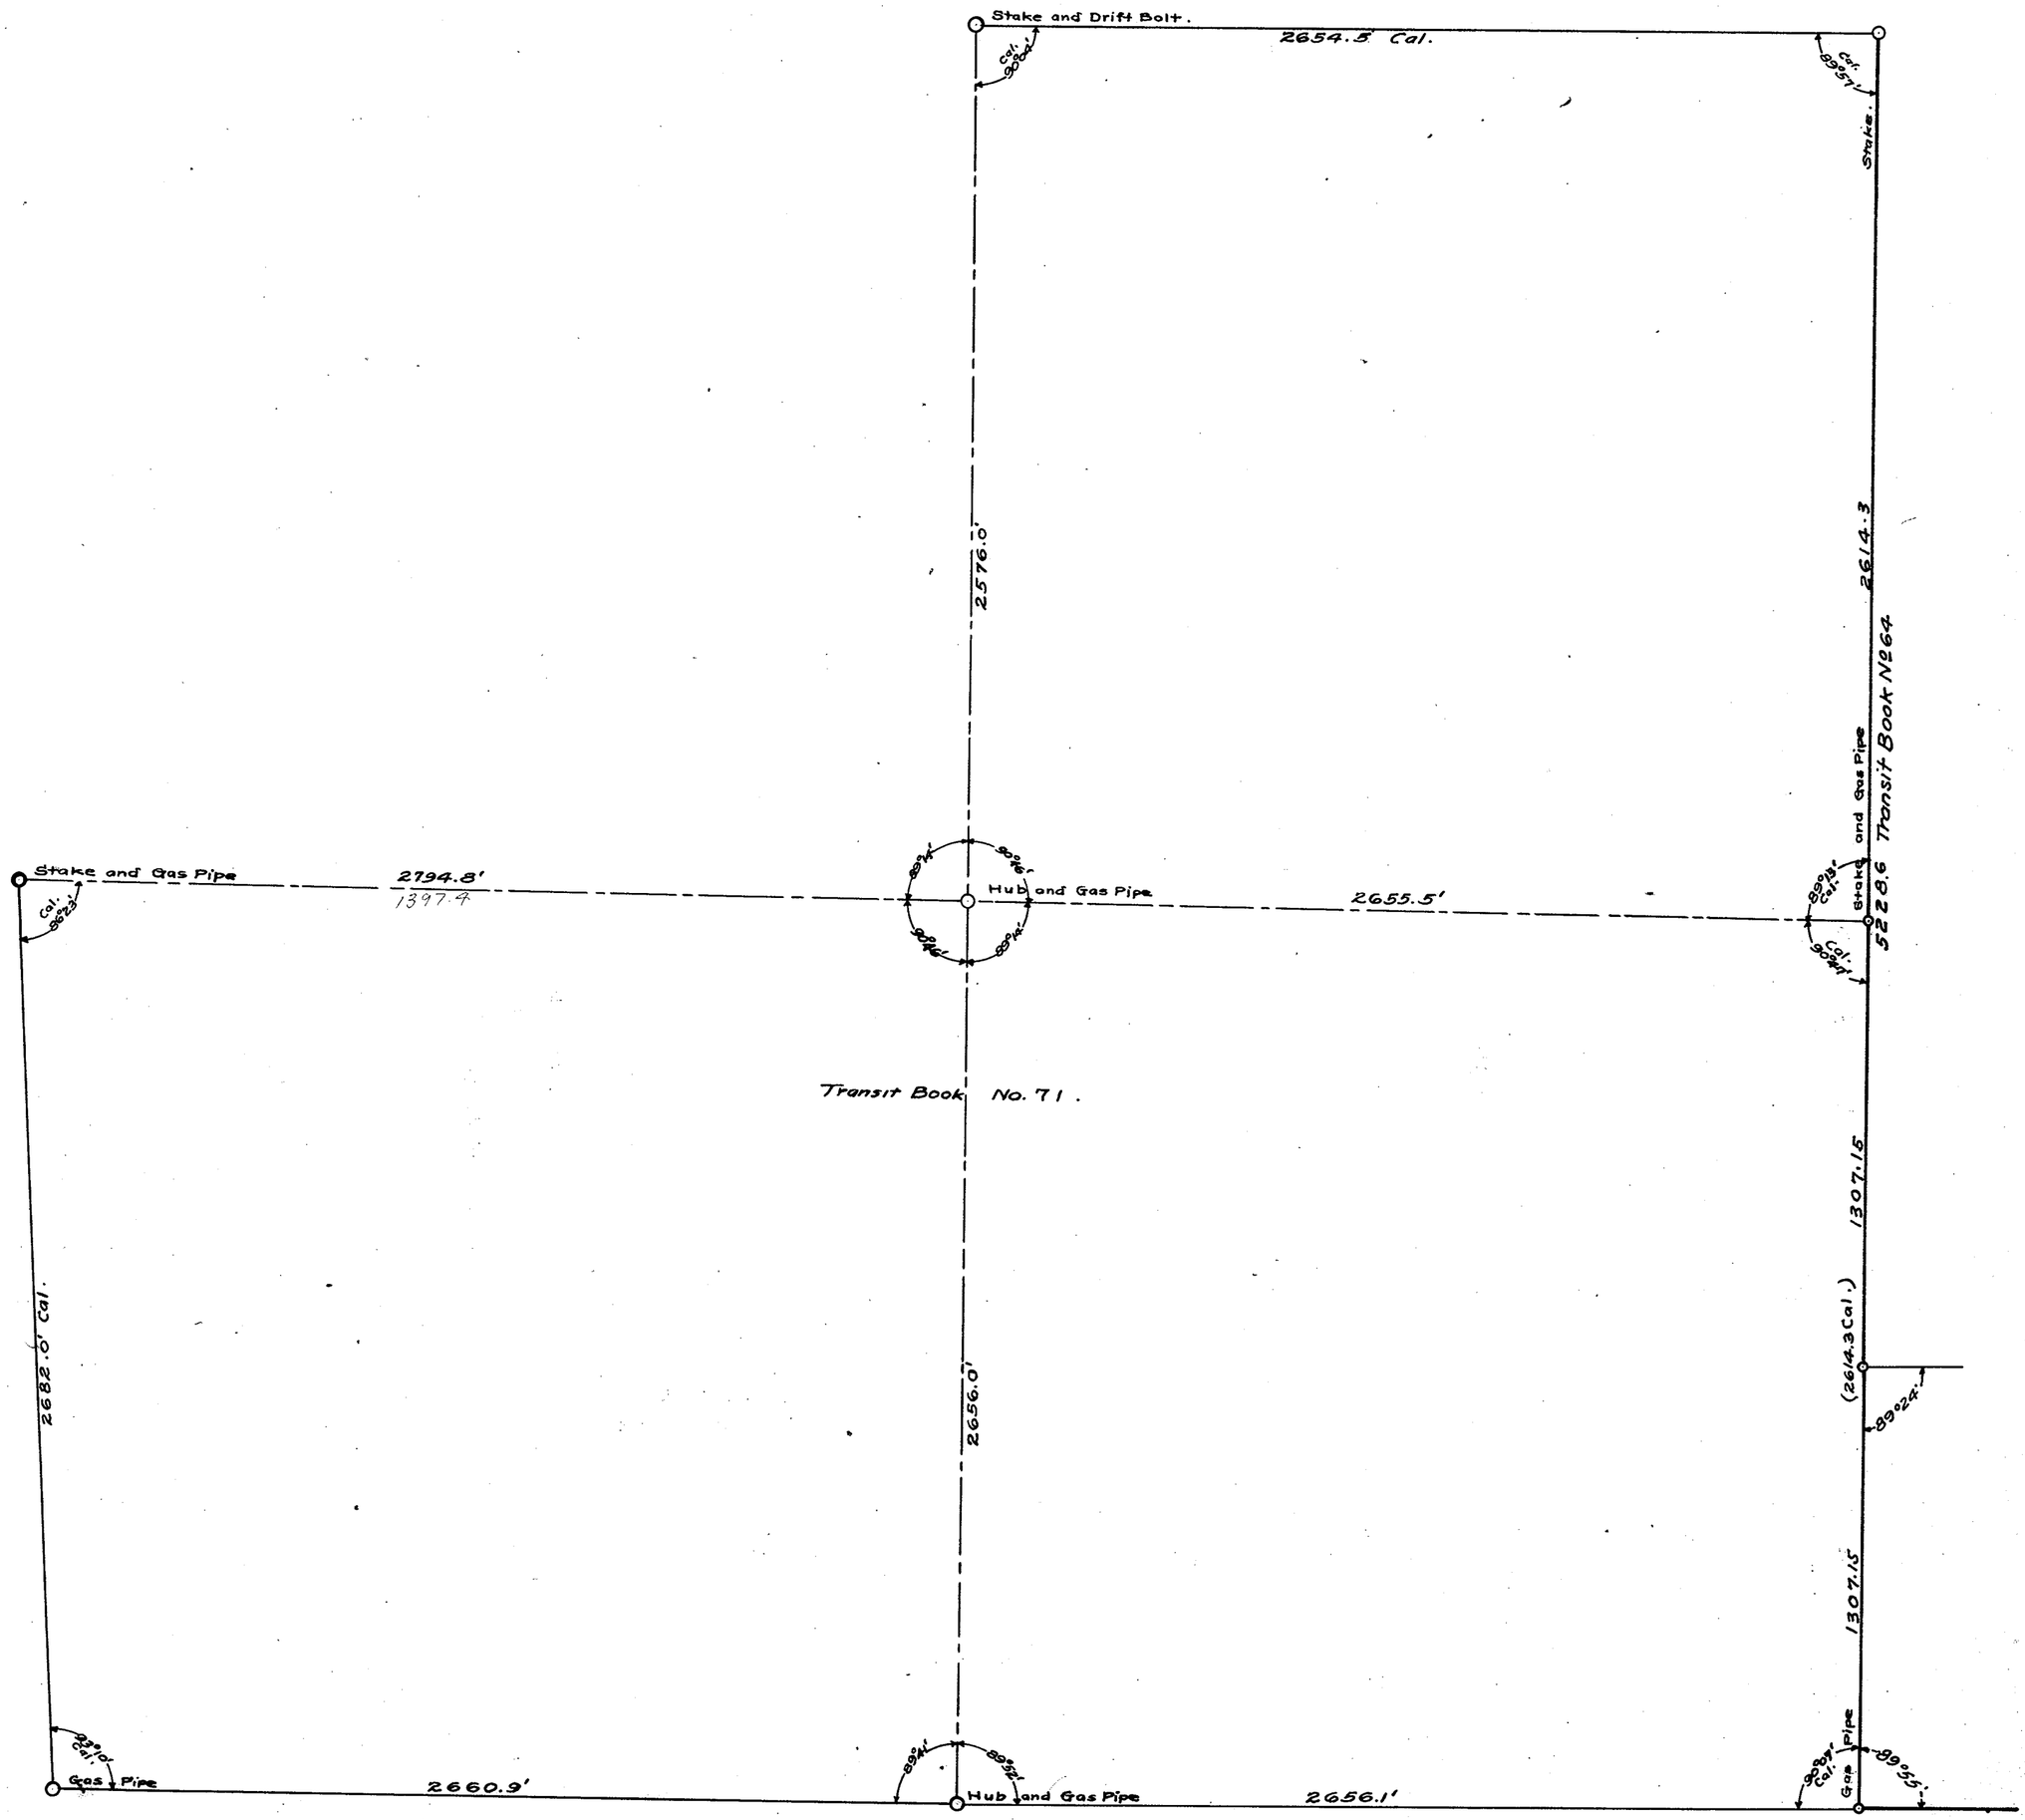

SECTION 10


TOWNSHIP 35 NORTH, RANGE 6 EAST, W. M.

SKAGIT COUNTY, WASH.

SCALE, 1 INCH–400 FEET

A. L. STRONG, COUNTY ENGINEER

See also EY-12 - 1929 Knapp

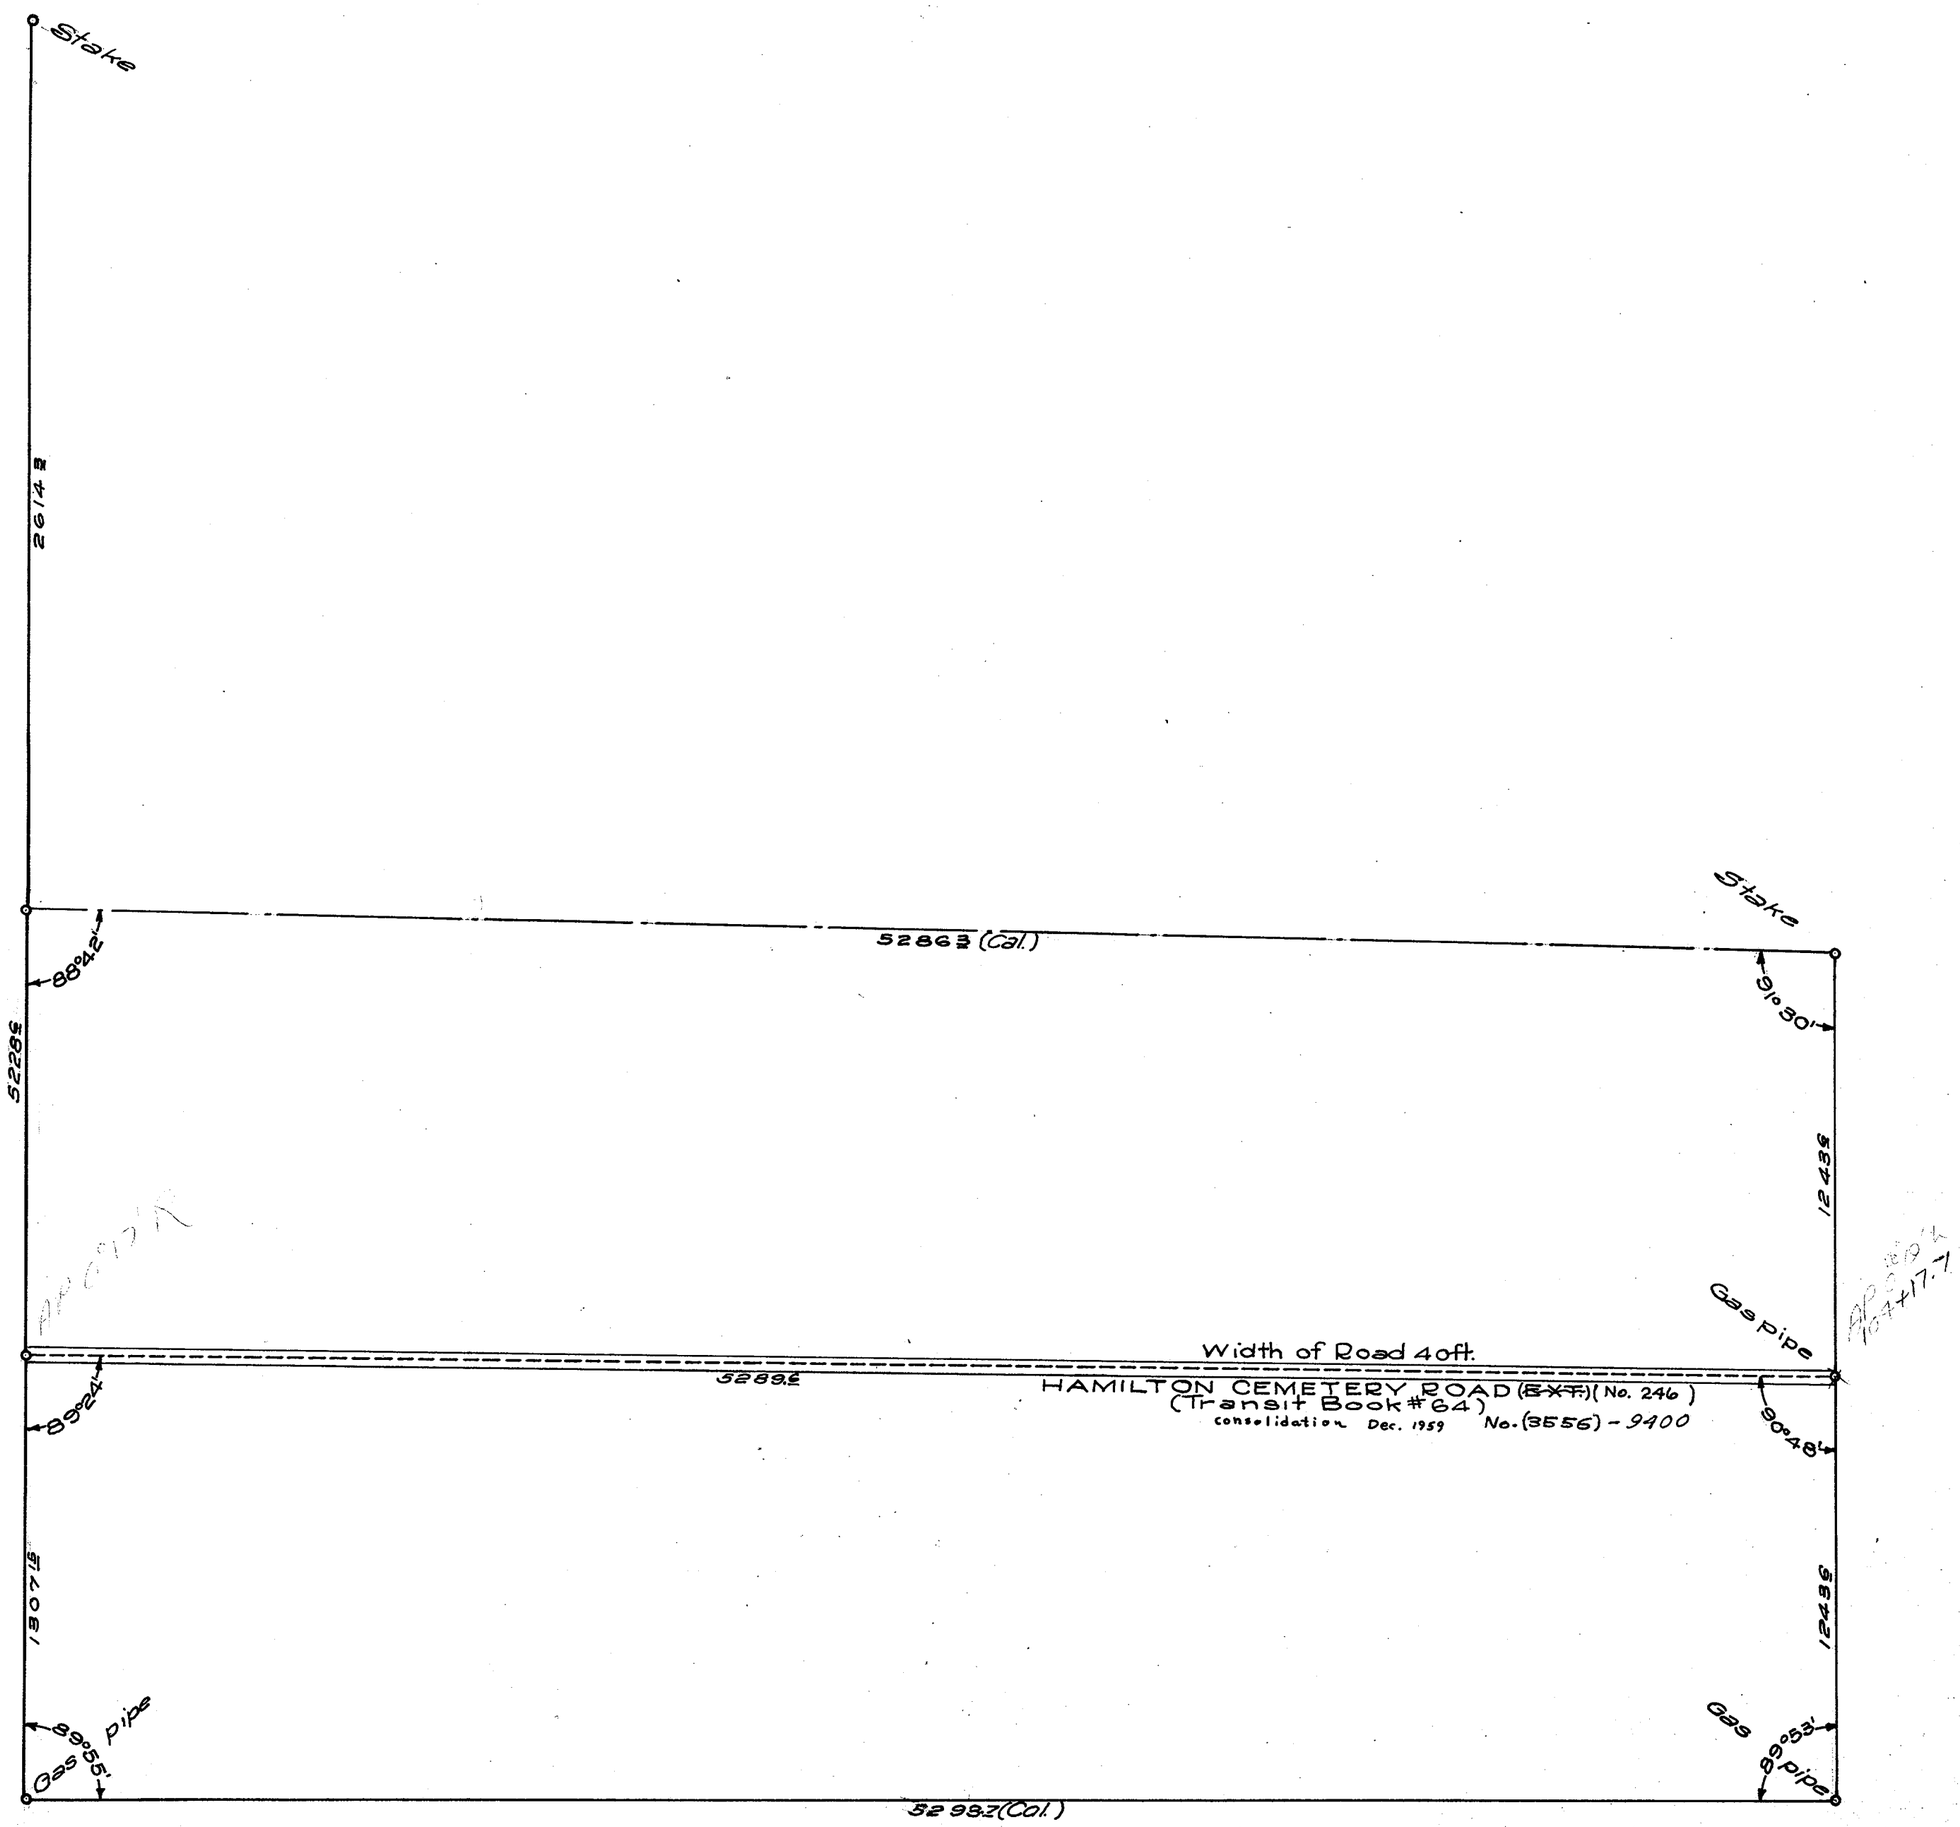


SECTION 11

TOWNSHIP 35 NORTH, RANGE 6 EAST, W. M.

SKAGIT COUNTY, WASH.

SCALE, 1 INCH--400 FEET
Road No. 246 From Notes 41/496
Subdivision From Notes 41/496 & Subdivision Bk.

DATE December, 1959 Frank Gilkey COUNTY ENGINEER

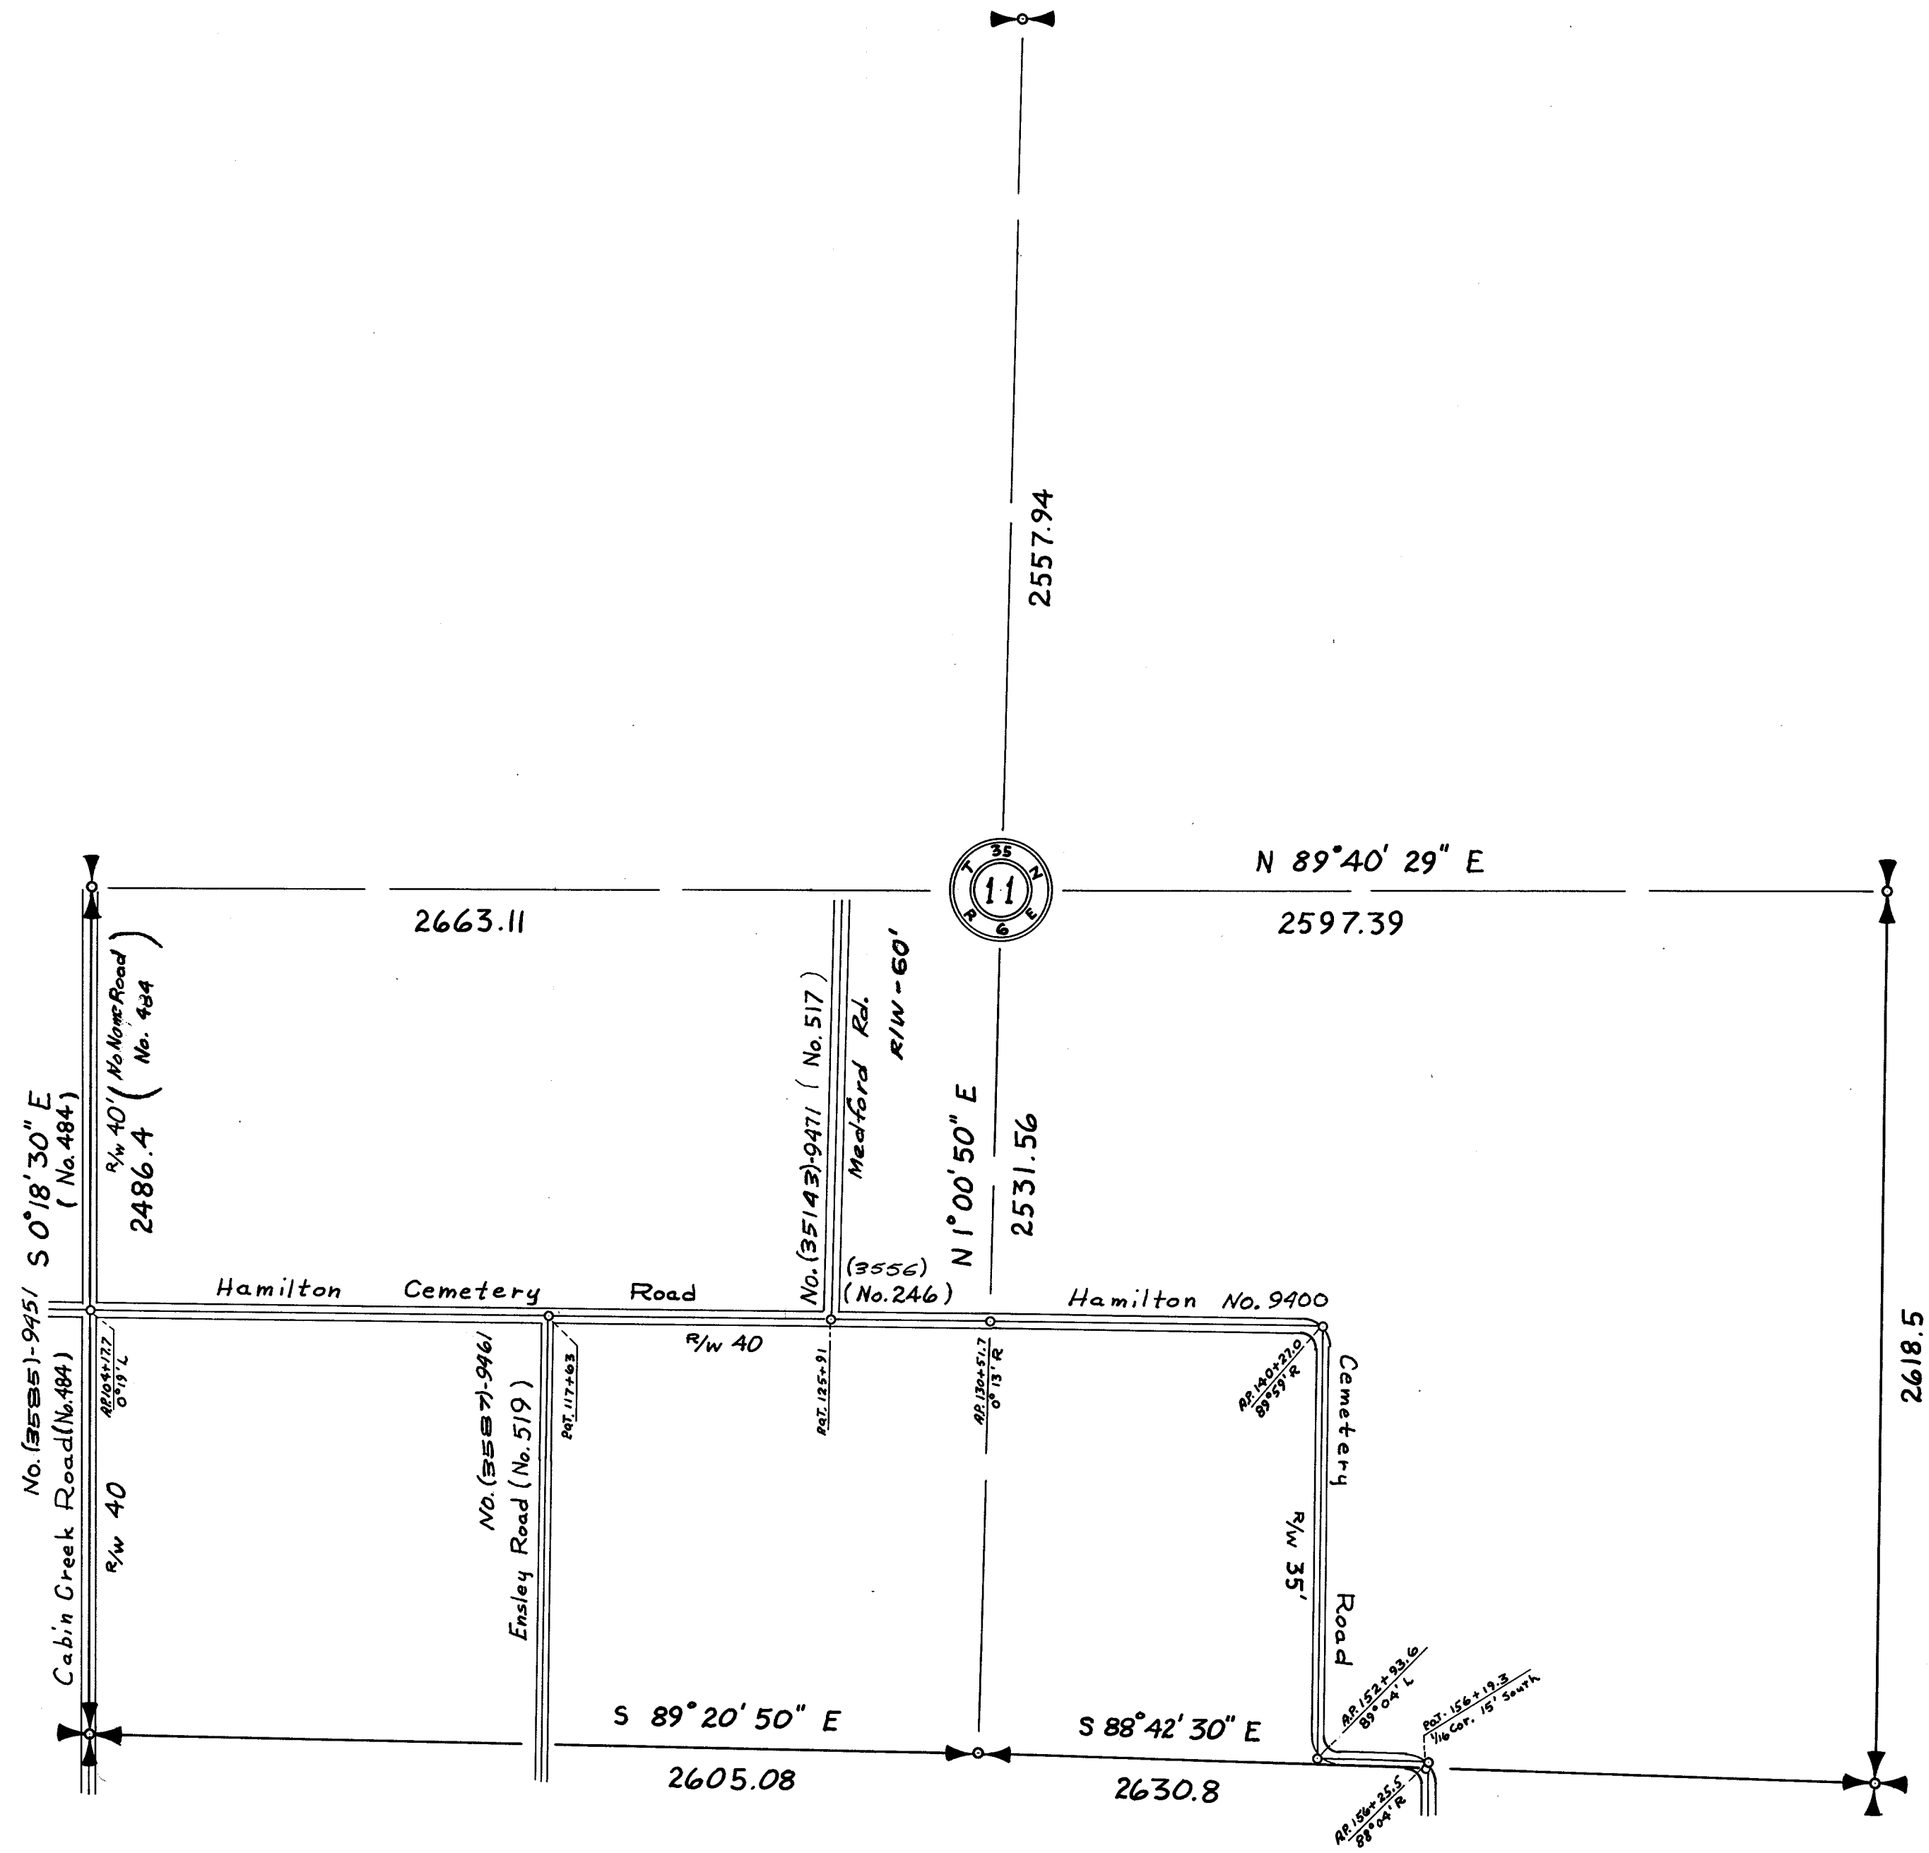

Check. 11-35


SECTION 11

TOWNSHIP 35 NORTH, RANGE 6 EAST, W. M.

SKAGIT COUNTY, WASH.

SCALE, 1 INCH—400 FEET

A. L. STRONG COUNTY ENGINEER

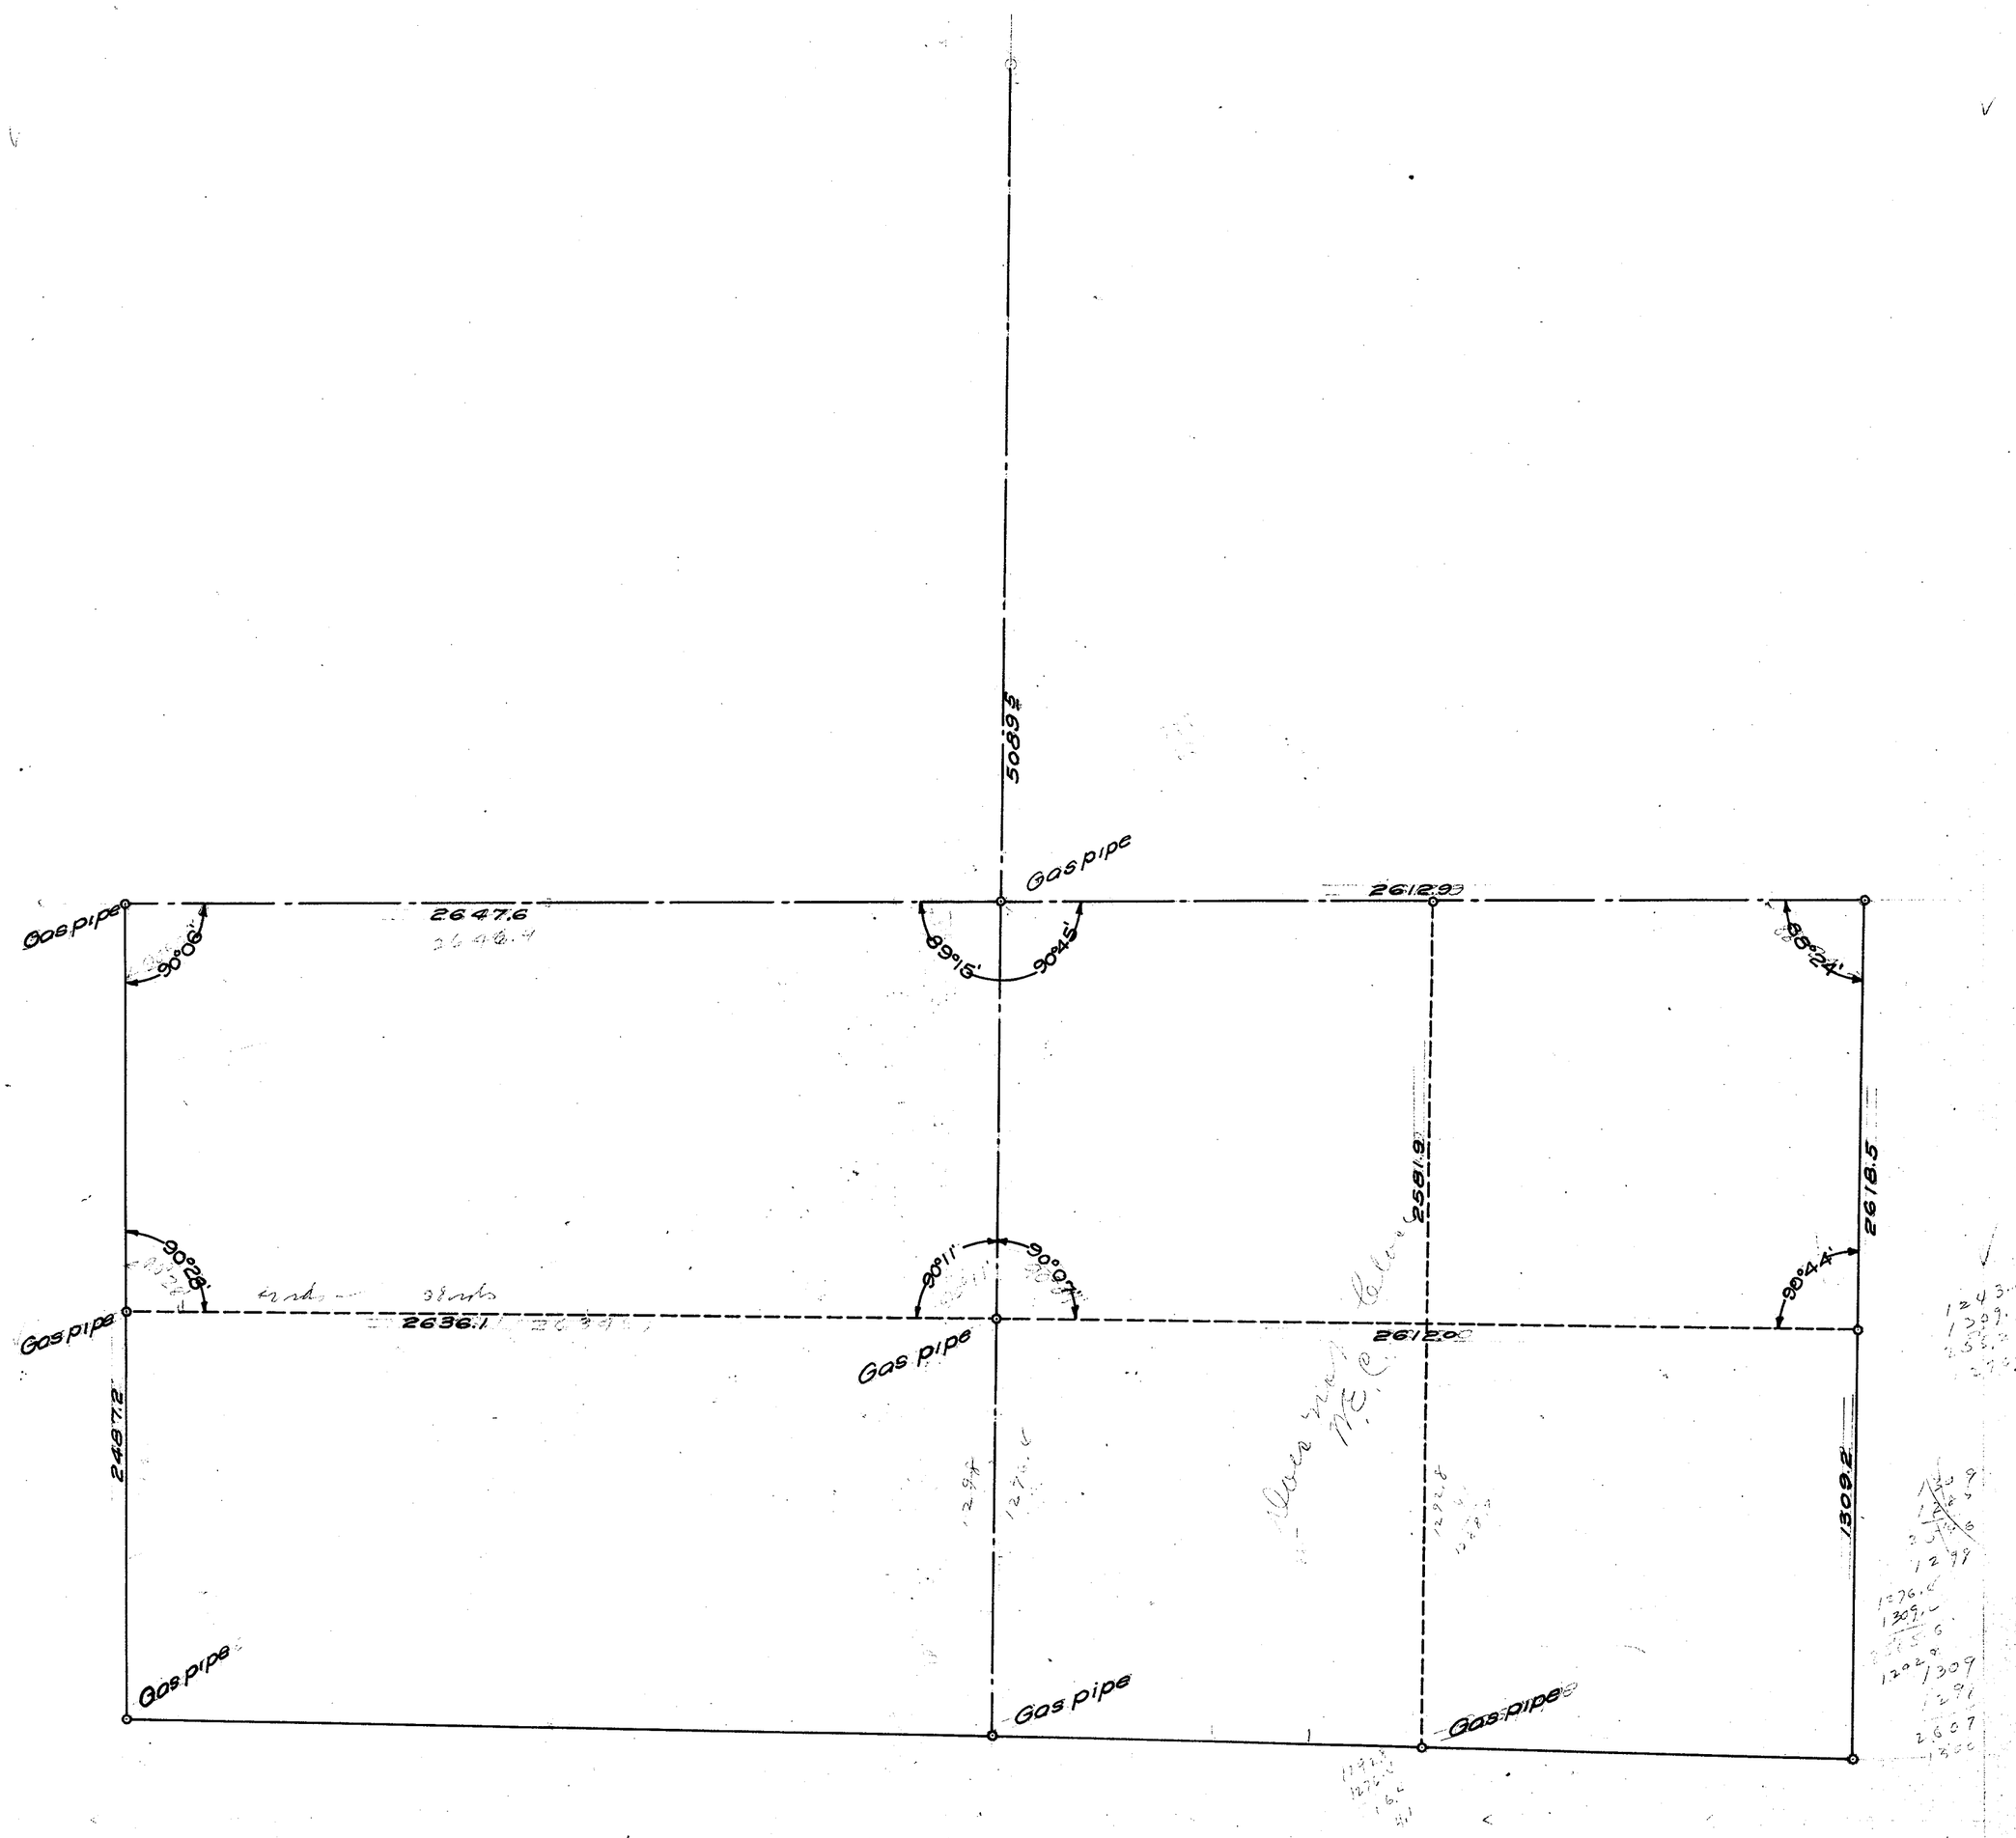

SECTION 13


TOWNSHIP 35 NORTH. RANGE 6 EAST. W. M.

SKAGIT COUNTY. WASH.

SCALE, 1 INCH—400 FEET

LLOYD H. JOHNSON COUNTY ENGINEER

DATE June 30, 1972

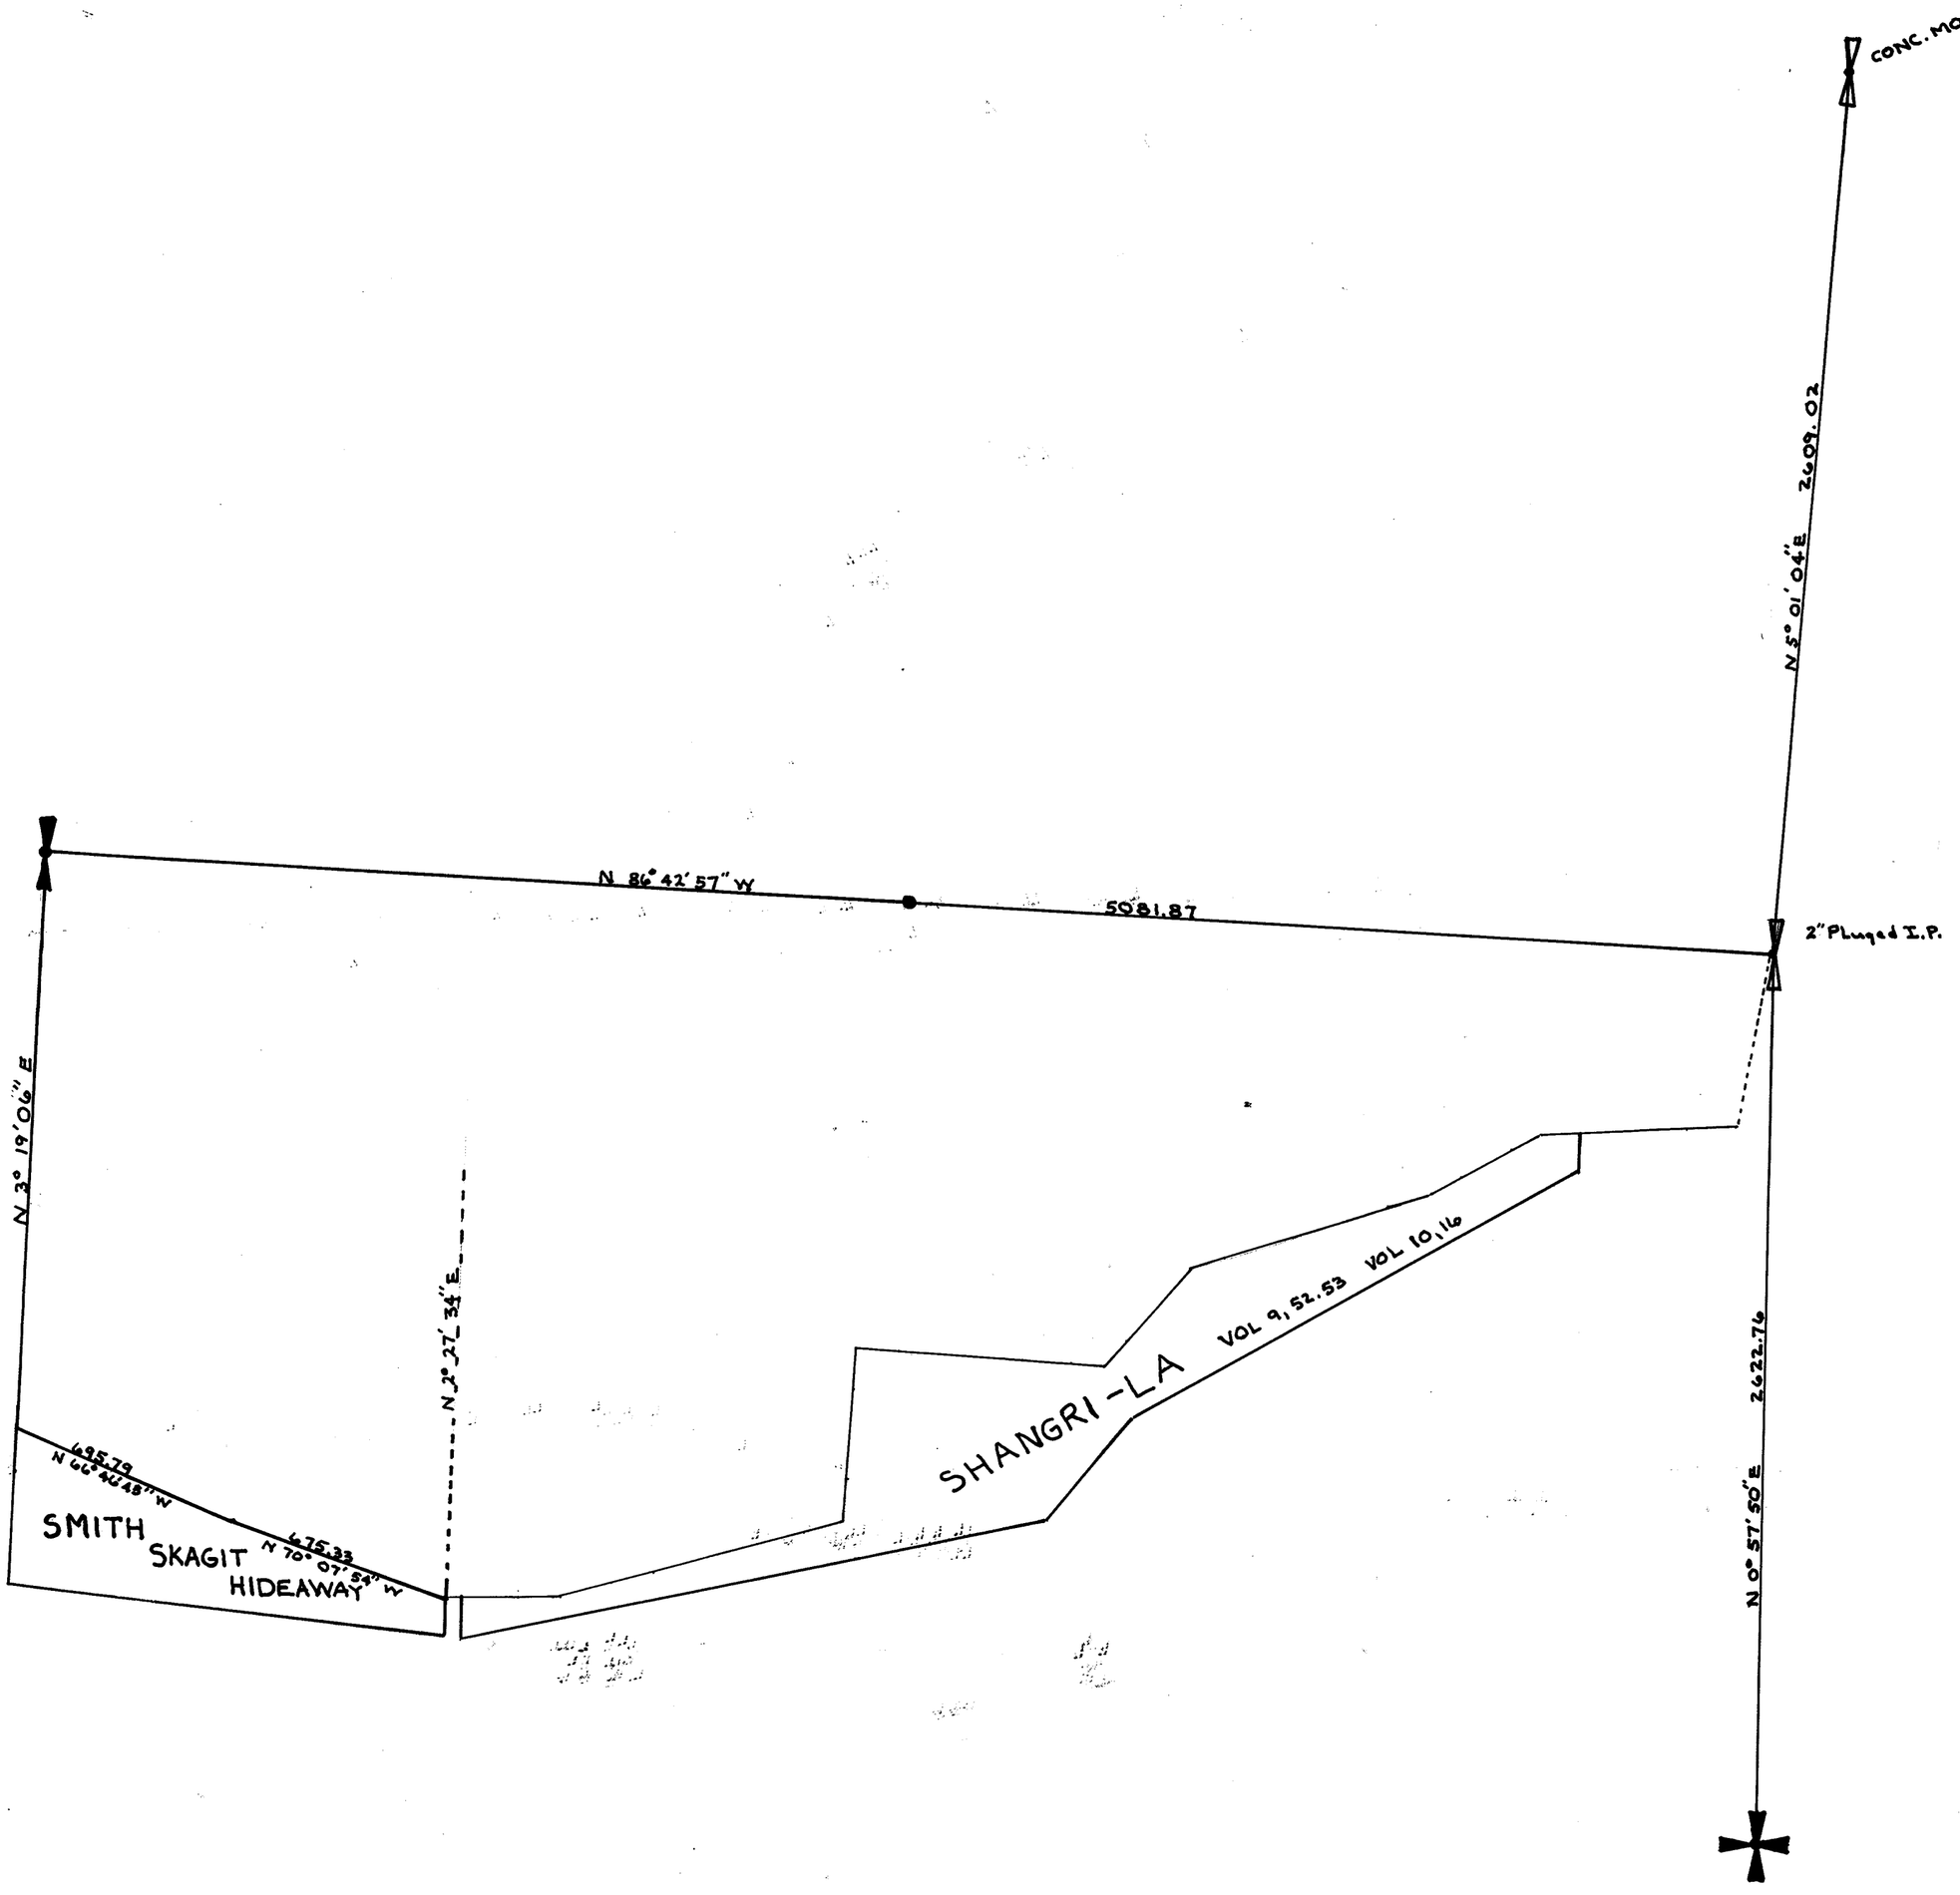

SECTION 13

TOWNSHIP 35 NORTH, RANGE 6 EAST, W. M.

SKAGIT COUNTY, WASH.

SCALE, 1 INCH--400 FEET

DATE Aug. 26, 1963

COUNTY ENGINEER

Dw. By W.G.W.

BT 22" D.Fir Windfall S42½°E 13.2'

Ida J. Walders Road No. (149)-(3560) 9480

GREAT NORTHERN RAILWAY

S.S.H. (17-A)-20

T-35-N
13
R-6-E

Shangra La Drive No 9492 aug. 68

R/W-60'

Cedar Court
No. 9481
aug 68

R/W-60'

Vacation - Comm's File 12,092 Dec. 19, 1967

Shangra La Drive # 9492

(East Hamilton Road) No. (674)-(3562)(9490)

(Jame Yoong & Cape Horn Road No. LXXVII)

SKAGIT RIVER

SECTION 14

TOWNSHIP 35 NORTH, RANGE 6 EAST, W. M.


SKAGIT COUNTY, WASH.

SCALE, 1 INCH--400 FEET

DATE Aug. 26, 1963

COUNTY ENGINEER

2" Pipe
2' feet down

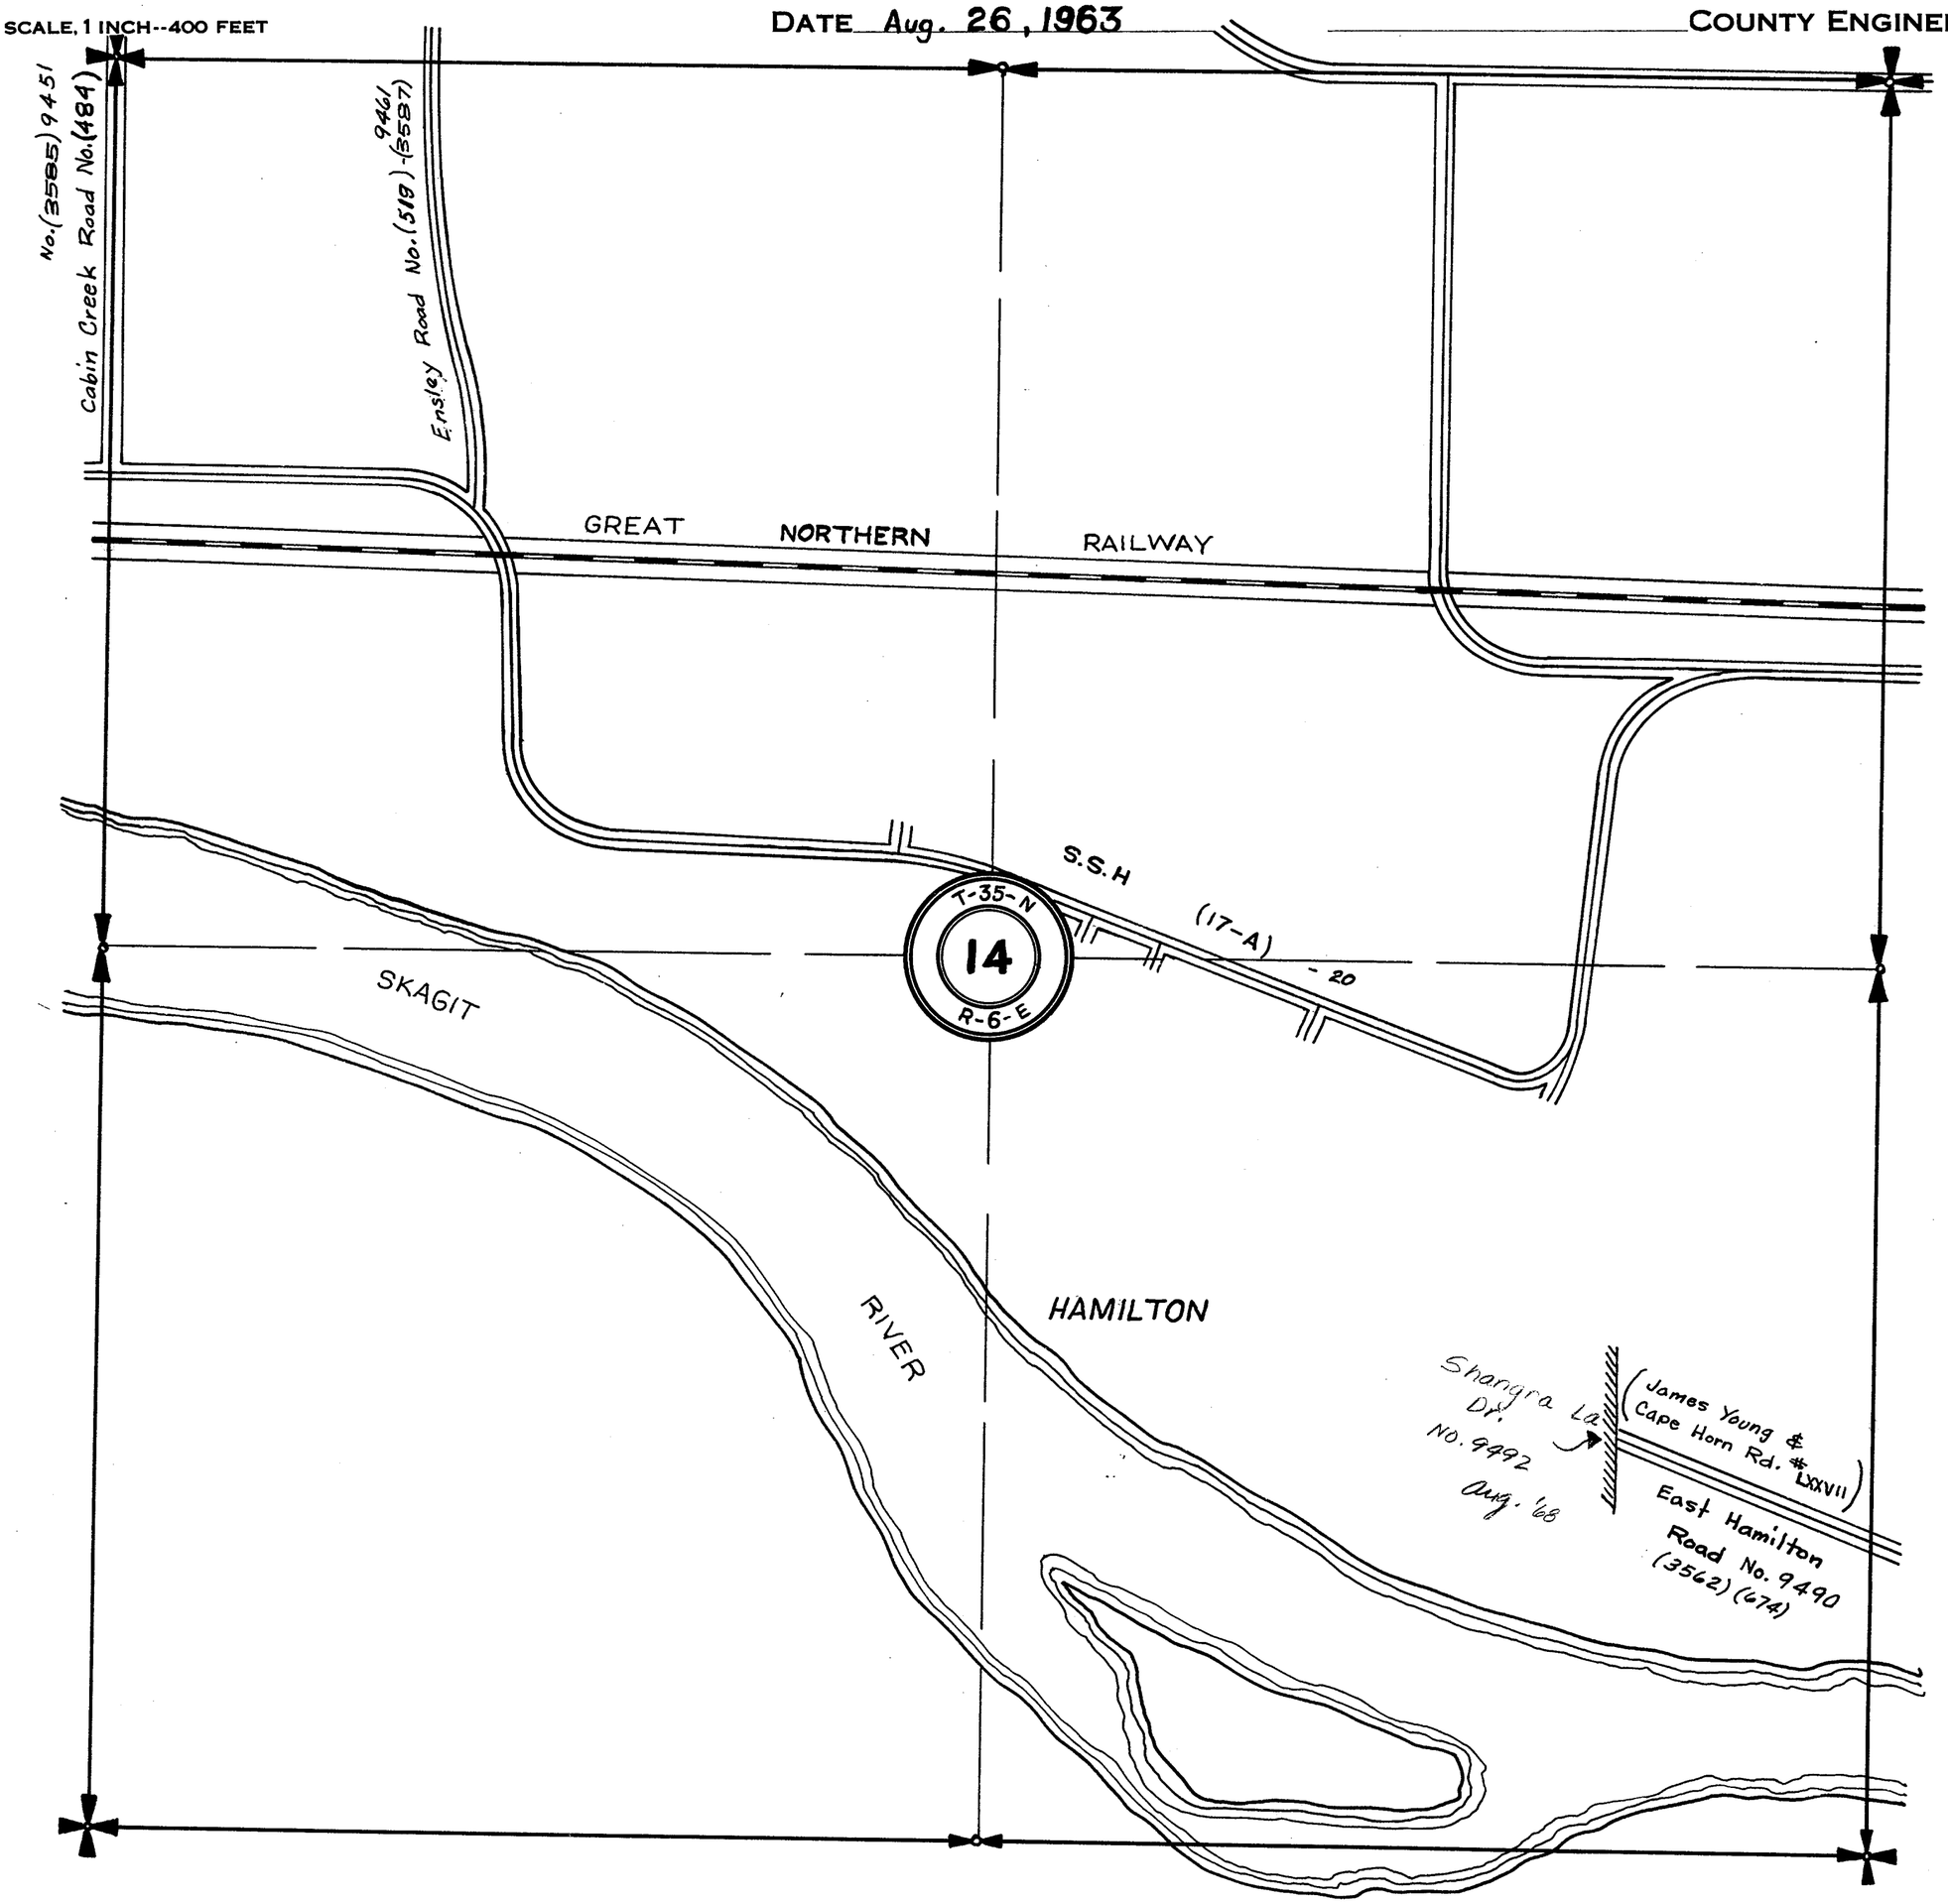


SECTION 15

TOWNSHIP 35 NORTH, RANGE 6 EAST, W. M.

SKAGIT COUNTY, WASH.

SCALE, 1 INCH–400 FEET

W.E. Costello COUNTY ENGINEER

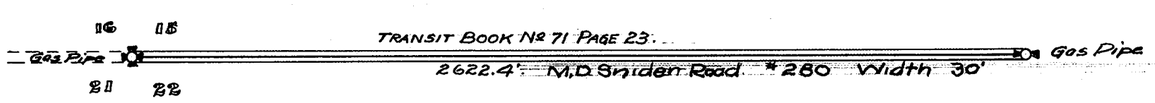

SECTION 15

TOWNSHIP 35 NORTH, RANGE 6 EAST, W. M.


SKAGIT COUNTY, WASH.

SCALE, 1 INCH--400 FEET

DATE Aug. 8, 1963

COUNTY ENGINEER


Dr. By N.G. Wells

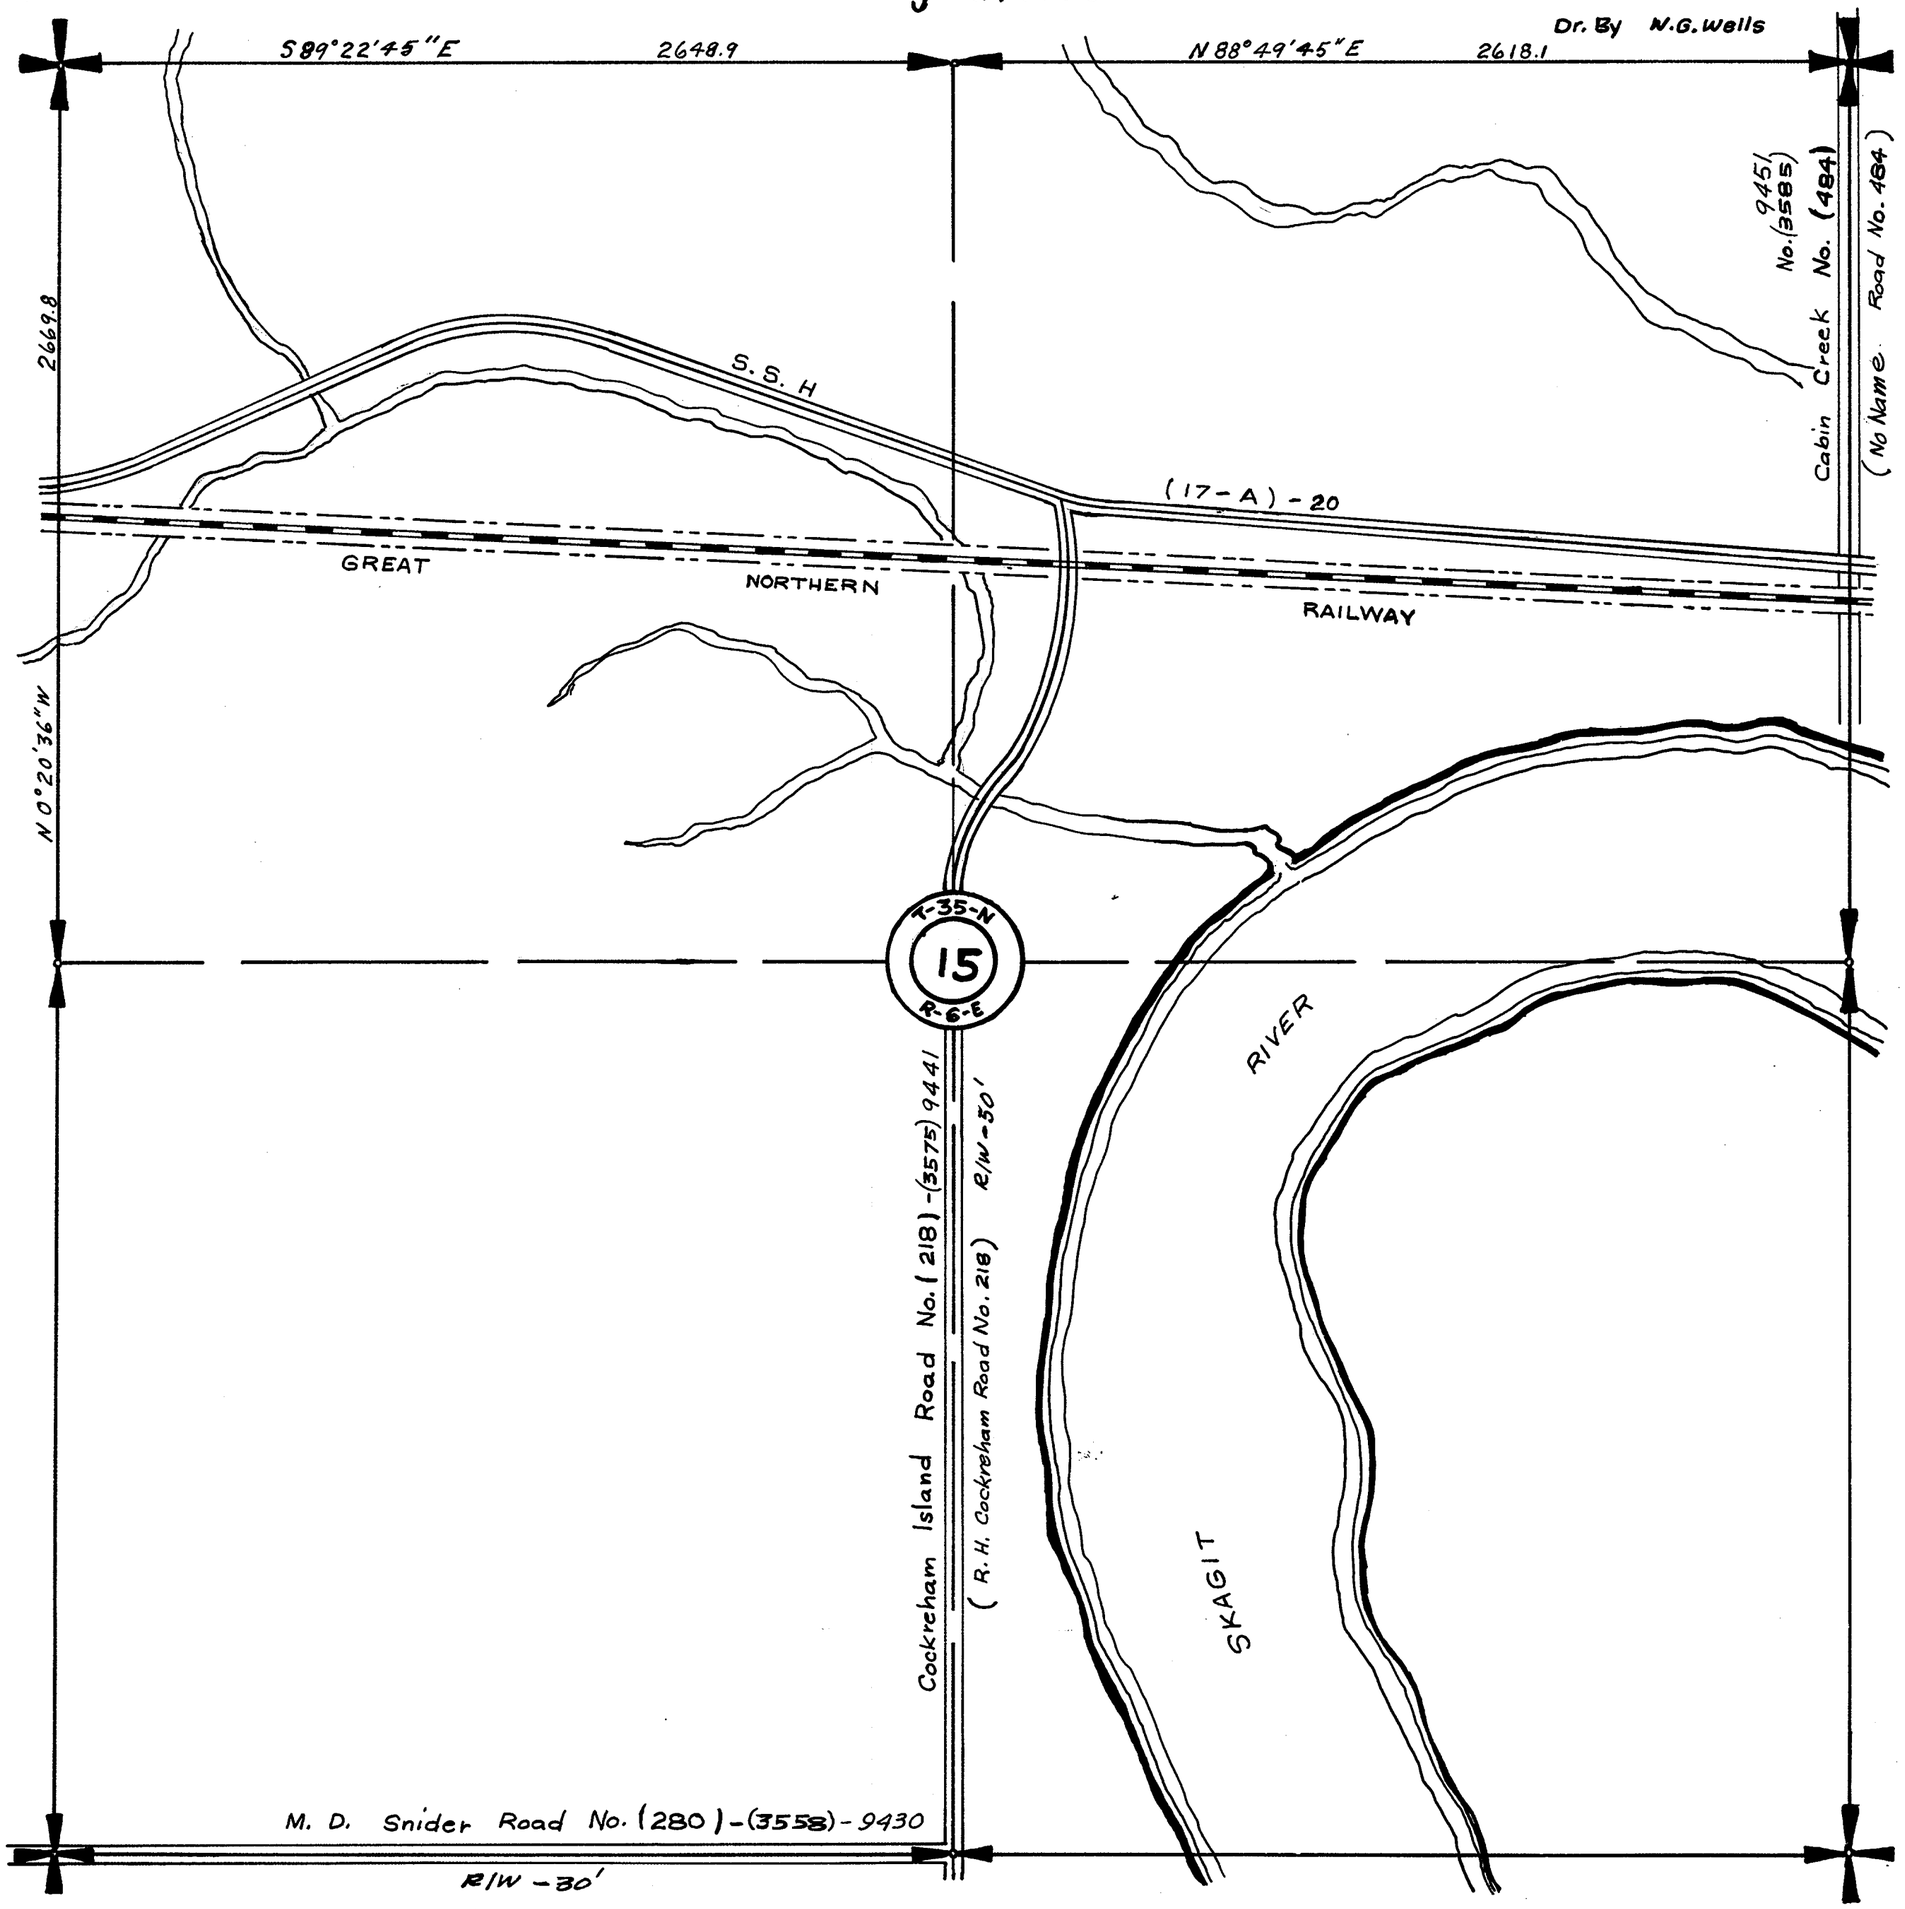

SECTION 16
TOWNSHIP 35 NORTH, RANGE 6 EAST, W. M.
SKAGIT COUNTY, WASH.

SCALE, 1 INCH--400 FEET
Road No. 281 Drawn From Notes 41/496
Road No. CXXXIV Drawn From Notes 38/405

DATE December, 1959 Frank Gilkey COUNTY ENGINEER

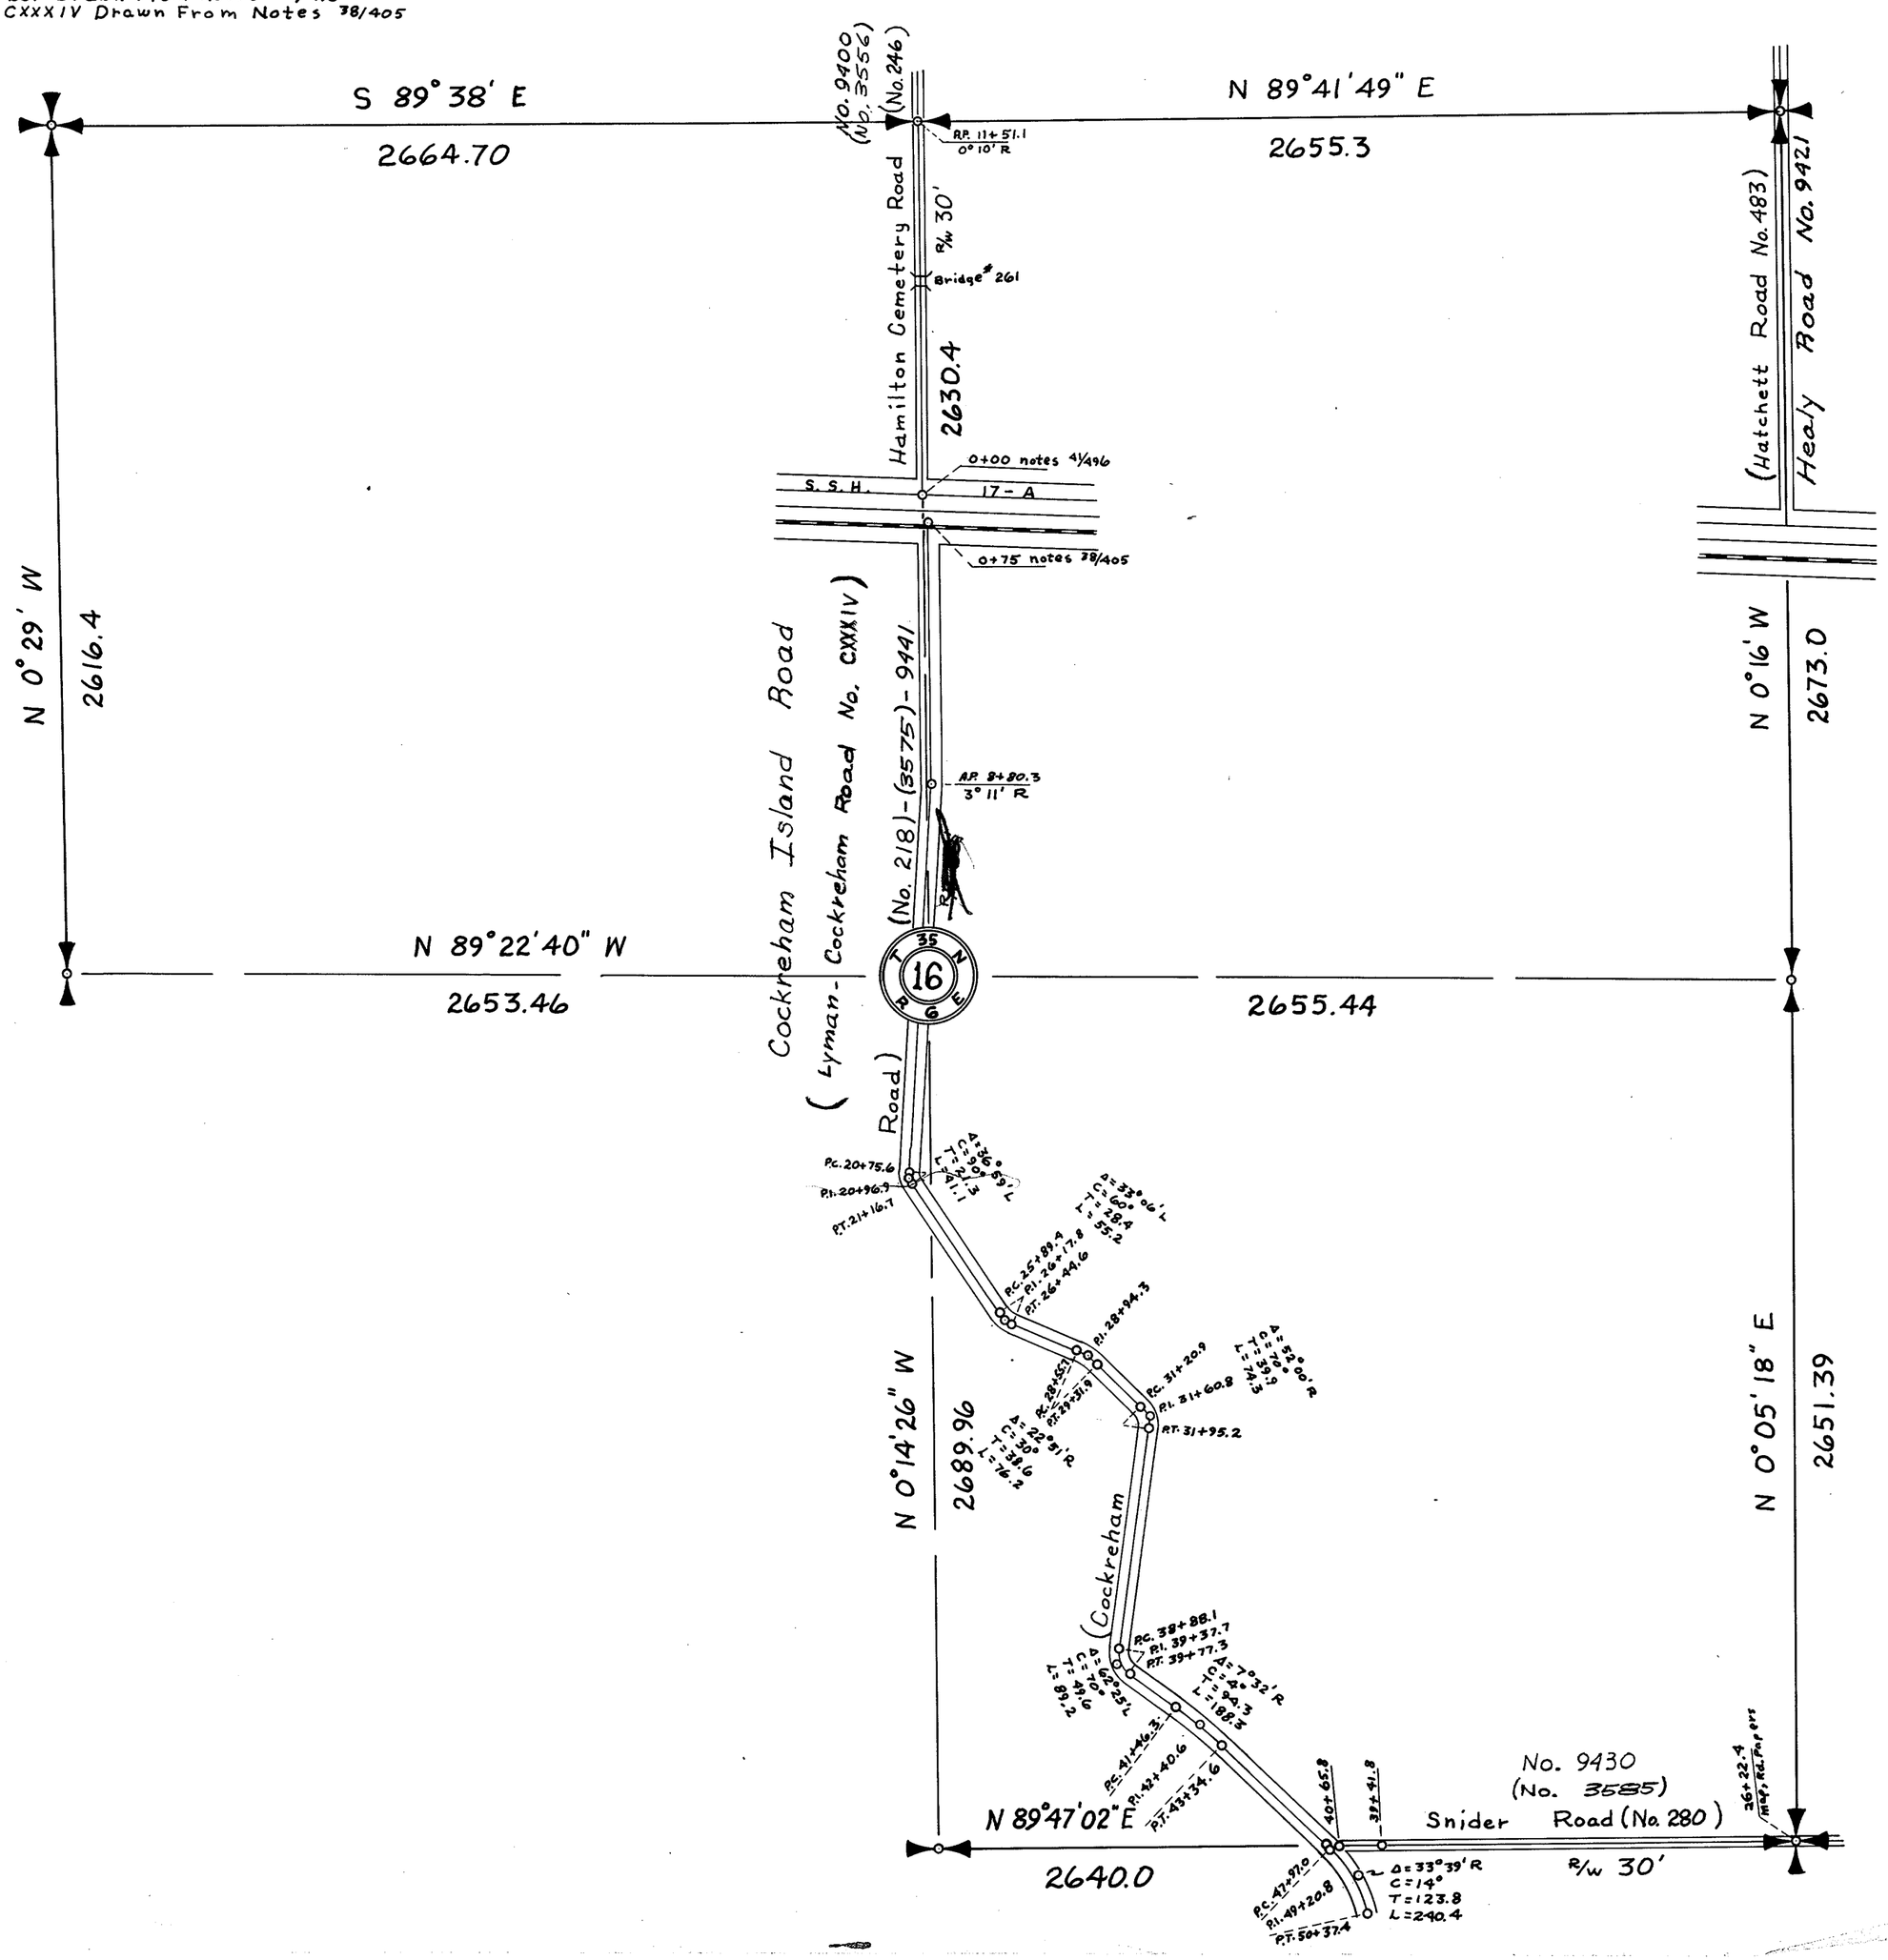


SECTION 16

TOWNSHIP 35 NORTH, RANGE 6 EAST, W. M.

SKAGIT COUNTY, WASH.

SCALE, 1 INCH–400 FEET

W.E. Costello COUNTY ENGINEER

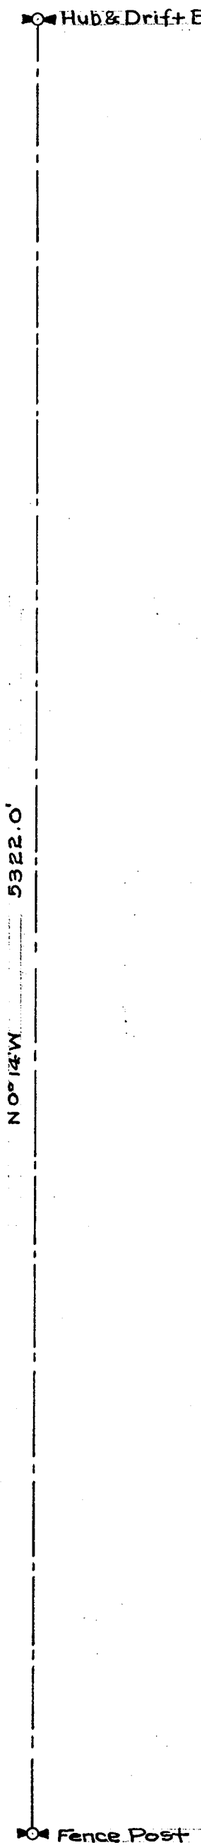


SECTION 16

TOWNSHIP 35 NORTH, RANGE 6 EAST, W. M.

SKAGIT COUNTY, WASH.

SCALE, 1 INCH–400 FEET

W.E. Costello COUNTY ENGINEER

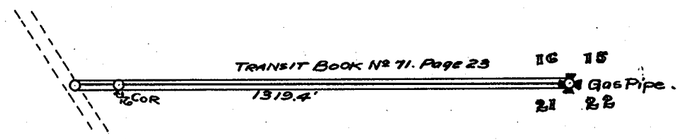


SECTION 16

TOWNSHIP 35 NORTH, RANGE 6 EAST, W. M.
SKAGIT COUNTY, WASH.

SCALE, 1 INCH–400 FEET

A. L. STRONG COUNTY ENGINEER

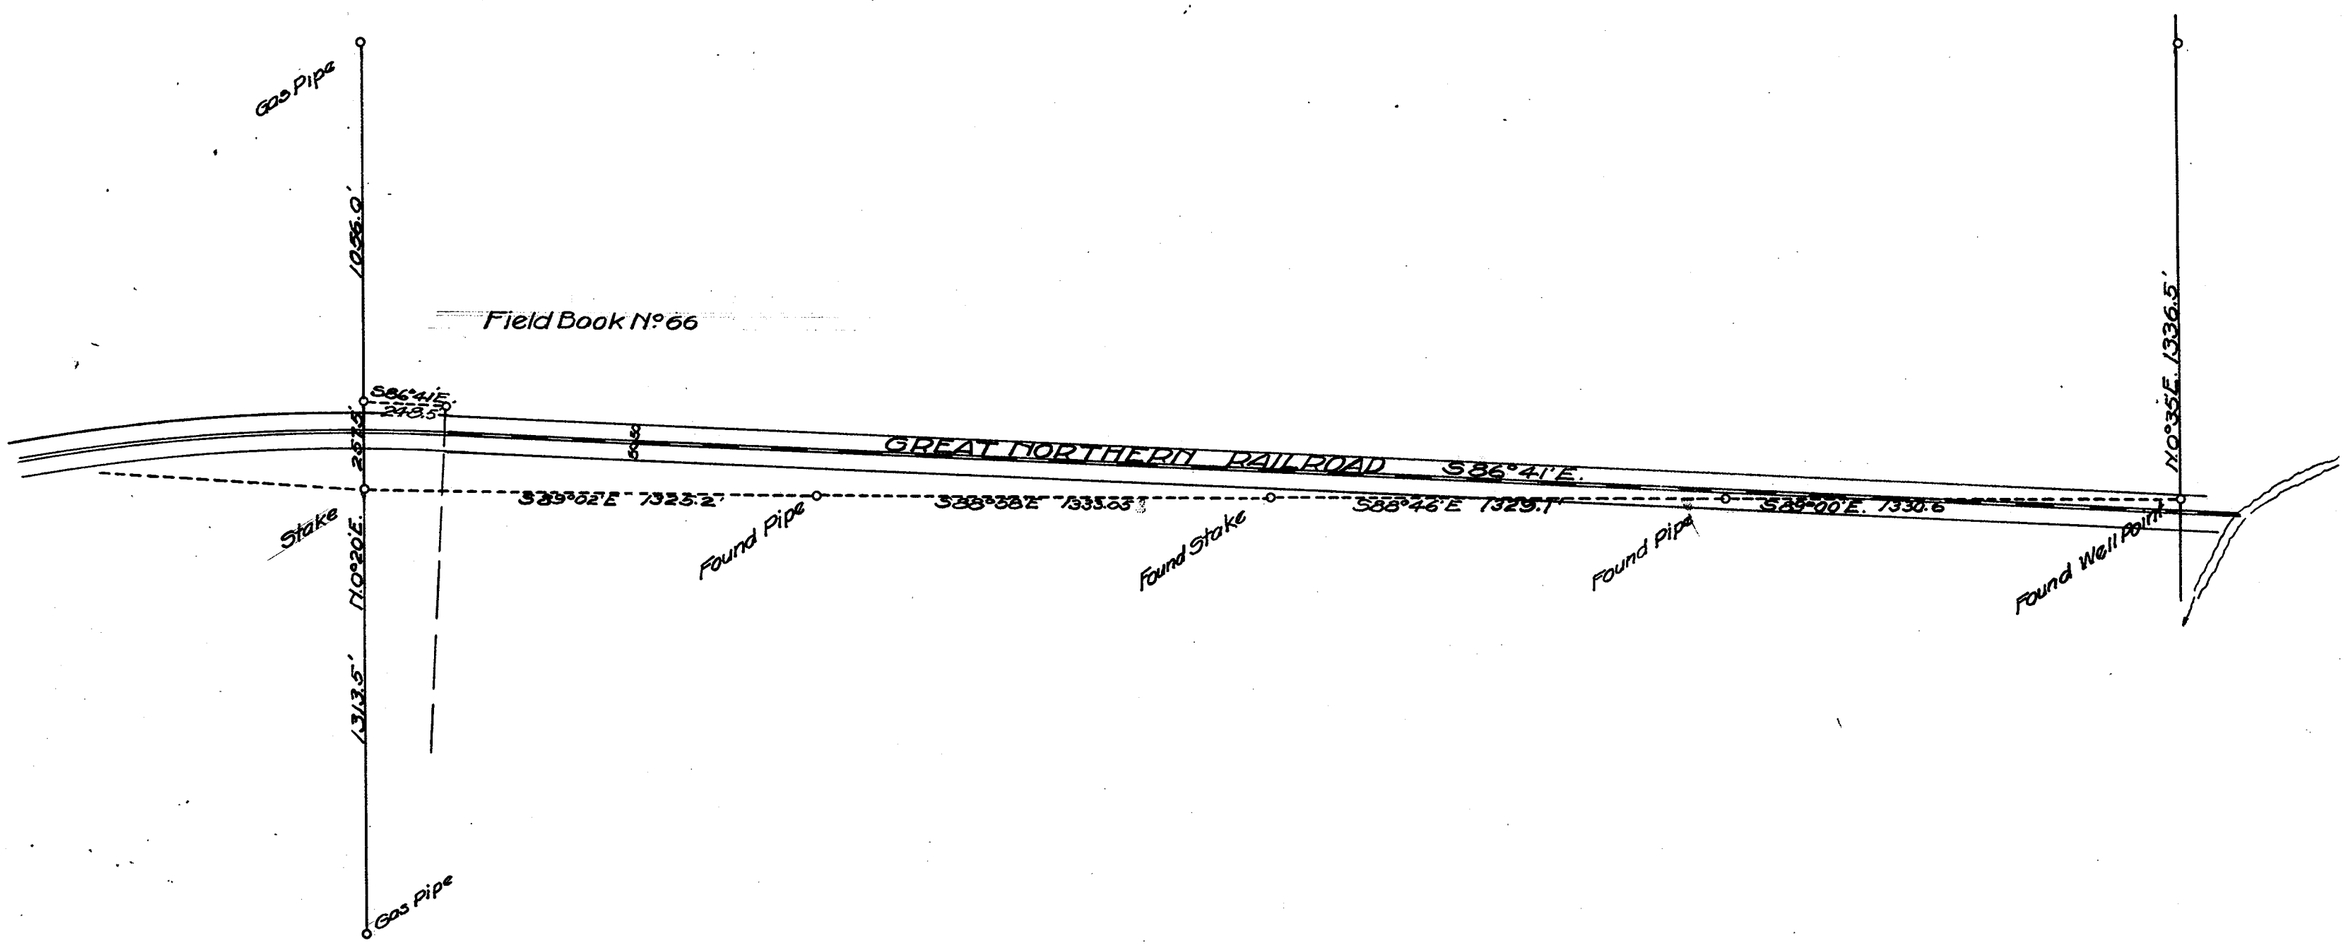


SECTION 18

TOWNSHIP 35 NORTH, RANGE 6 EAST, W. M.

SKAGIT COUNTY, WASH.

SCALE, 1 INCH–400 FEET

_____ COUNTY ENGINEER

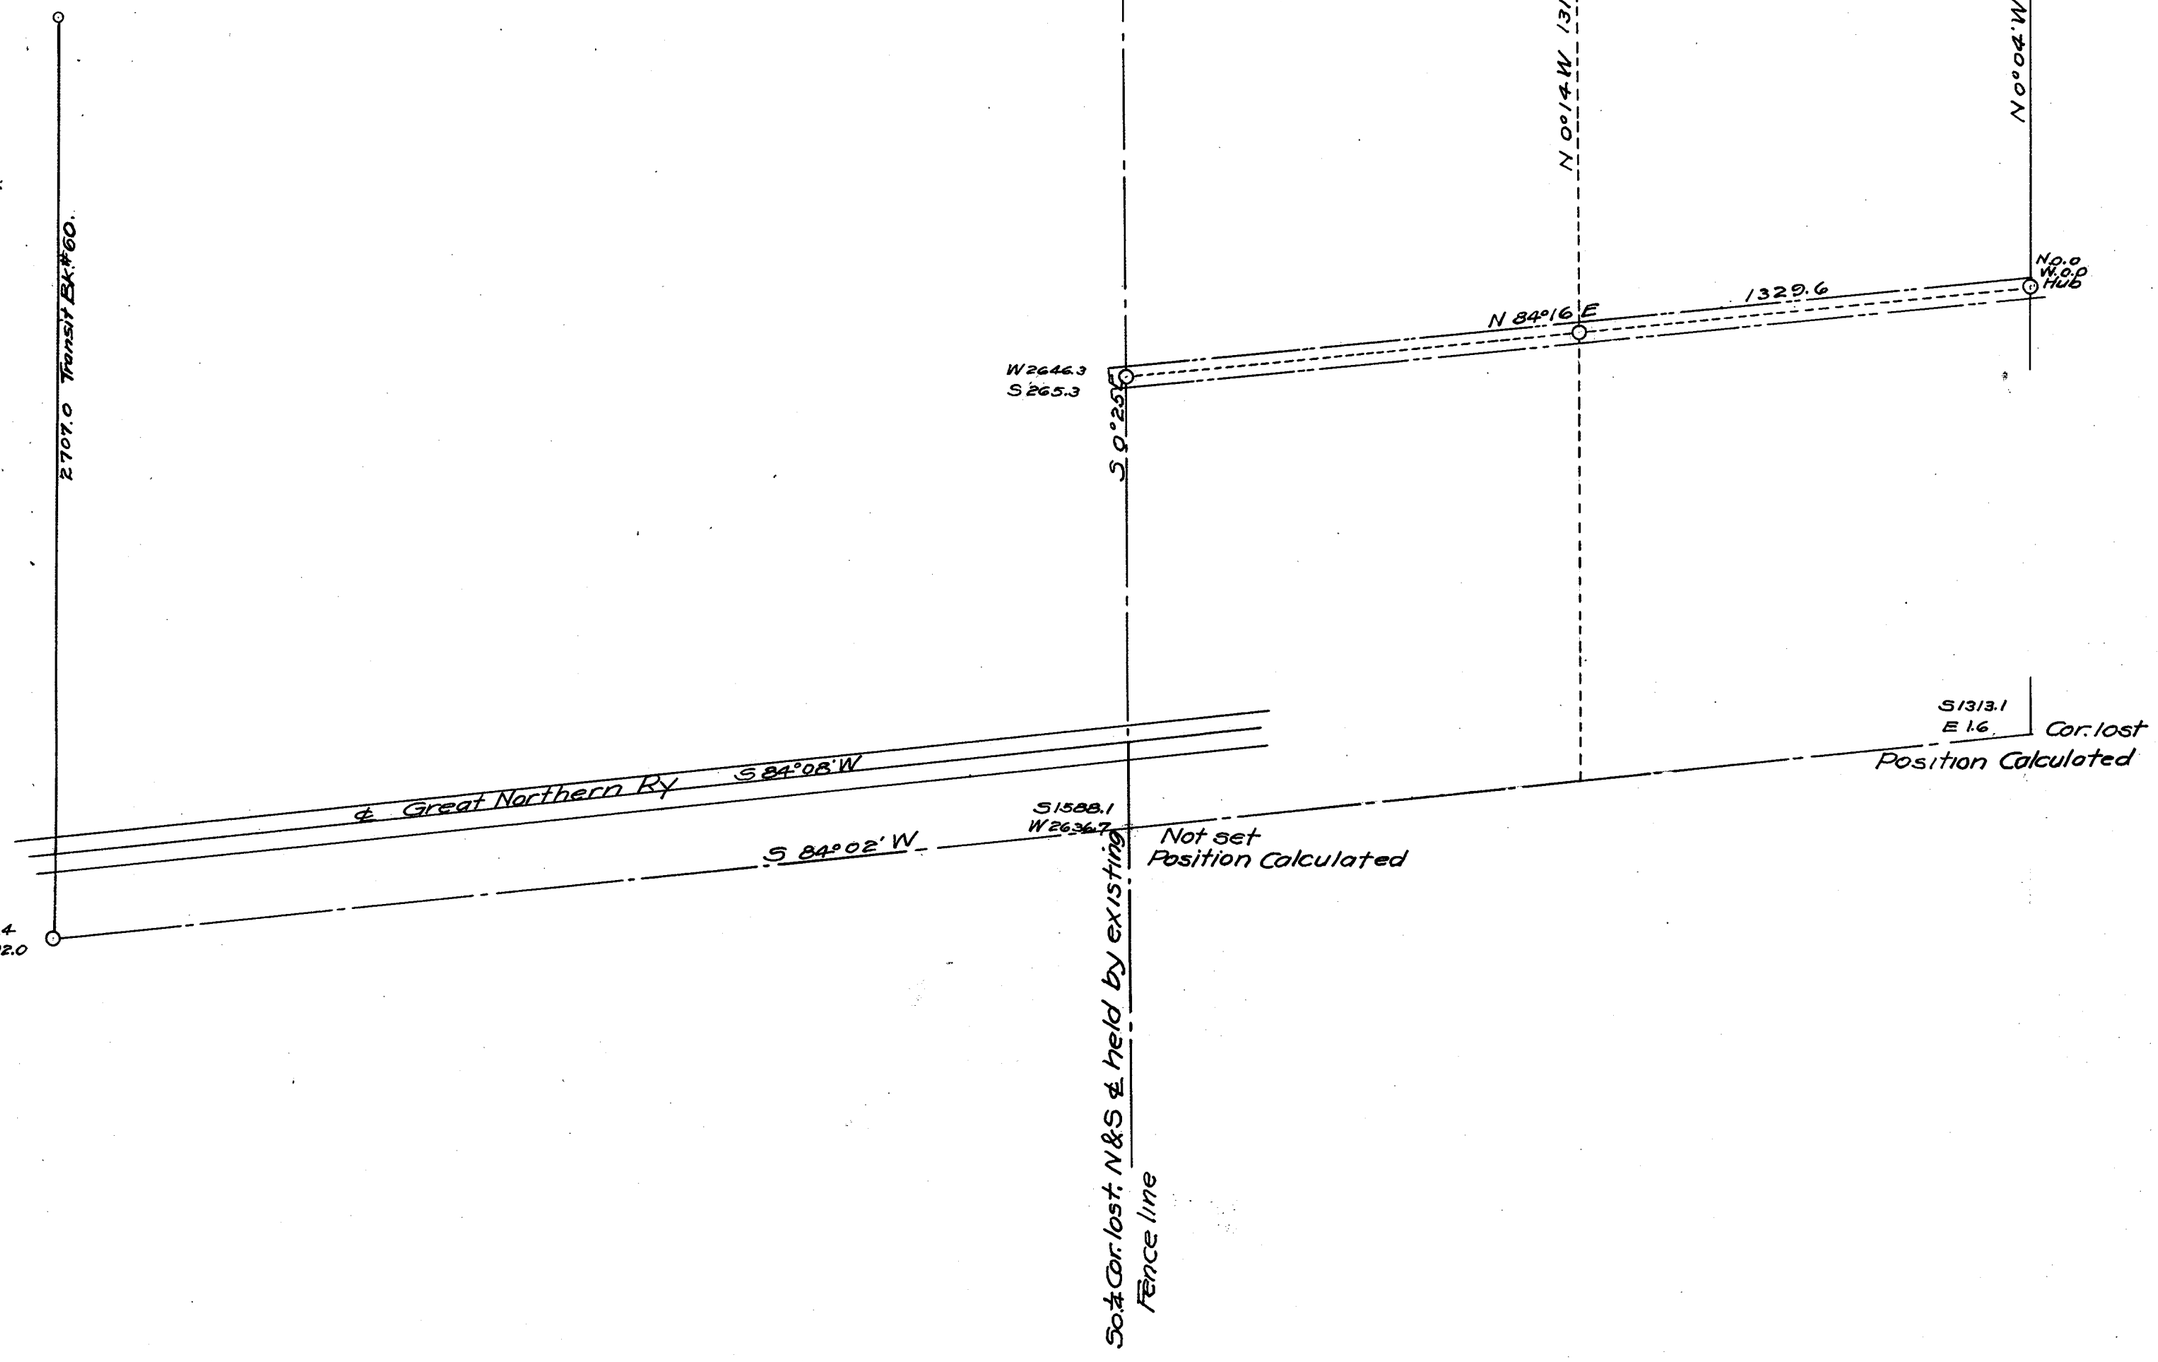


SECTION 19

TOWNSHIP 35 NORTH, RANGE 6 EAST, W. M.
SKAGIT COUNTY, WASH.

SCALE, 1 INCH–400 FEET

A.L. STRONG COUNTY ENGINEER

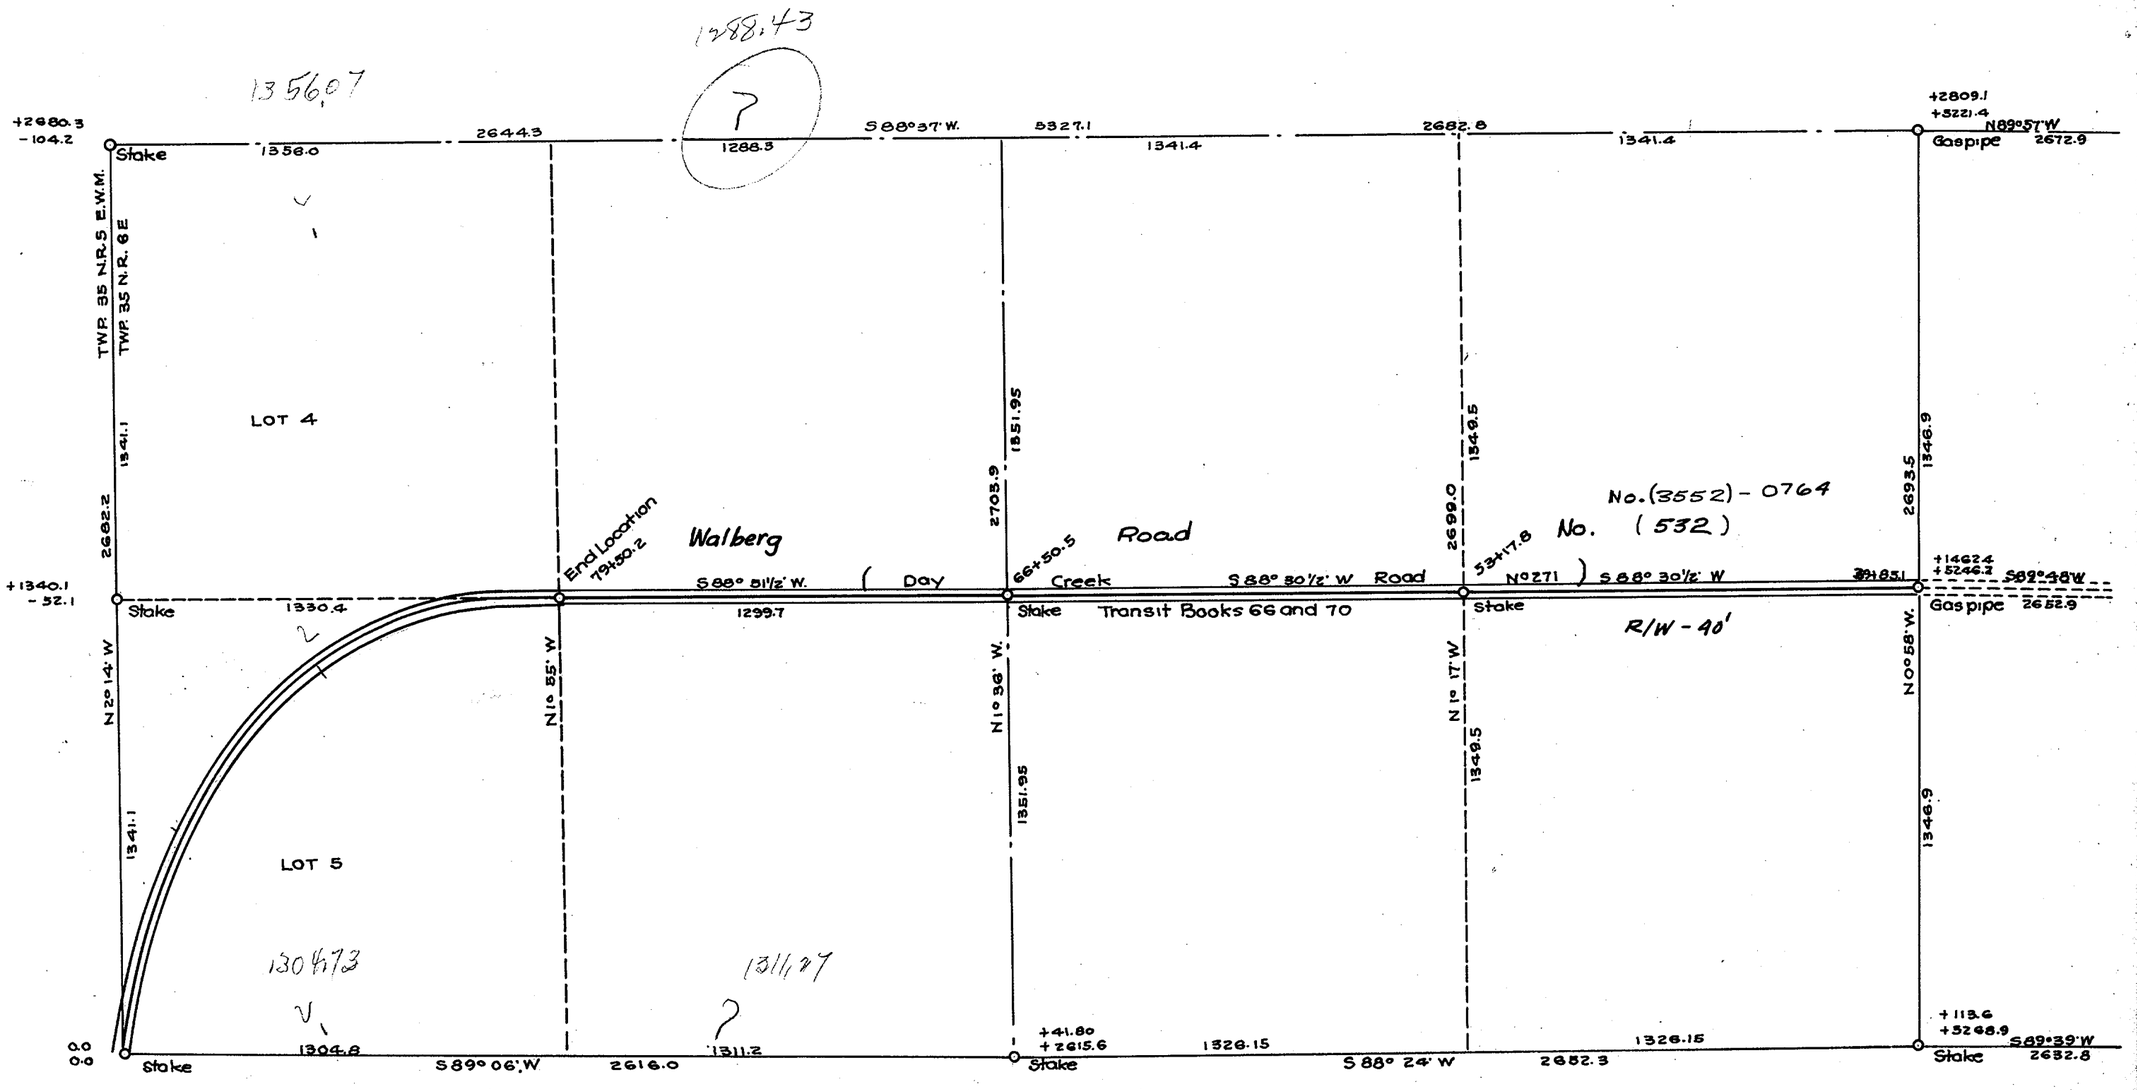

SECTION 20


TOWNSHIP 35 NORTH, RANGE 6 EAST, W. M.

SKAGIT COUNTY, WASH.

SCALE, 1 INCH--400 FEET

DATE July 11, 1963

COUNTY ENGINEER

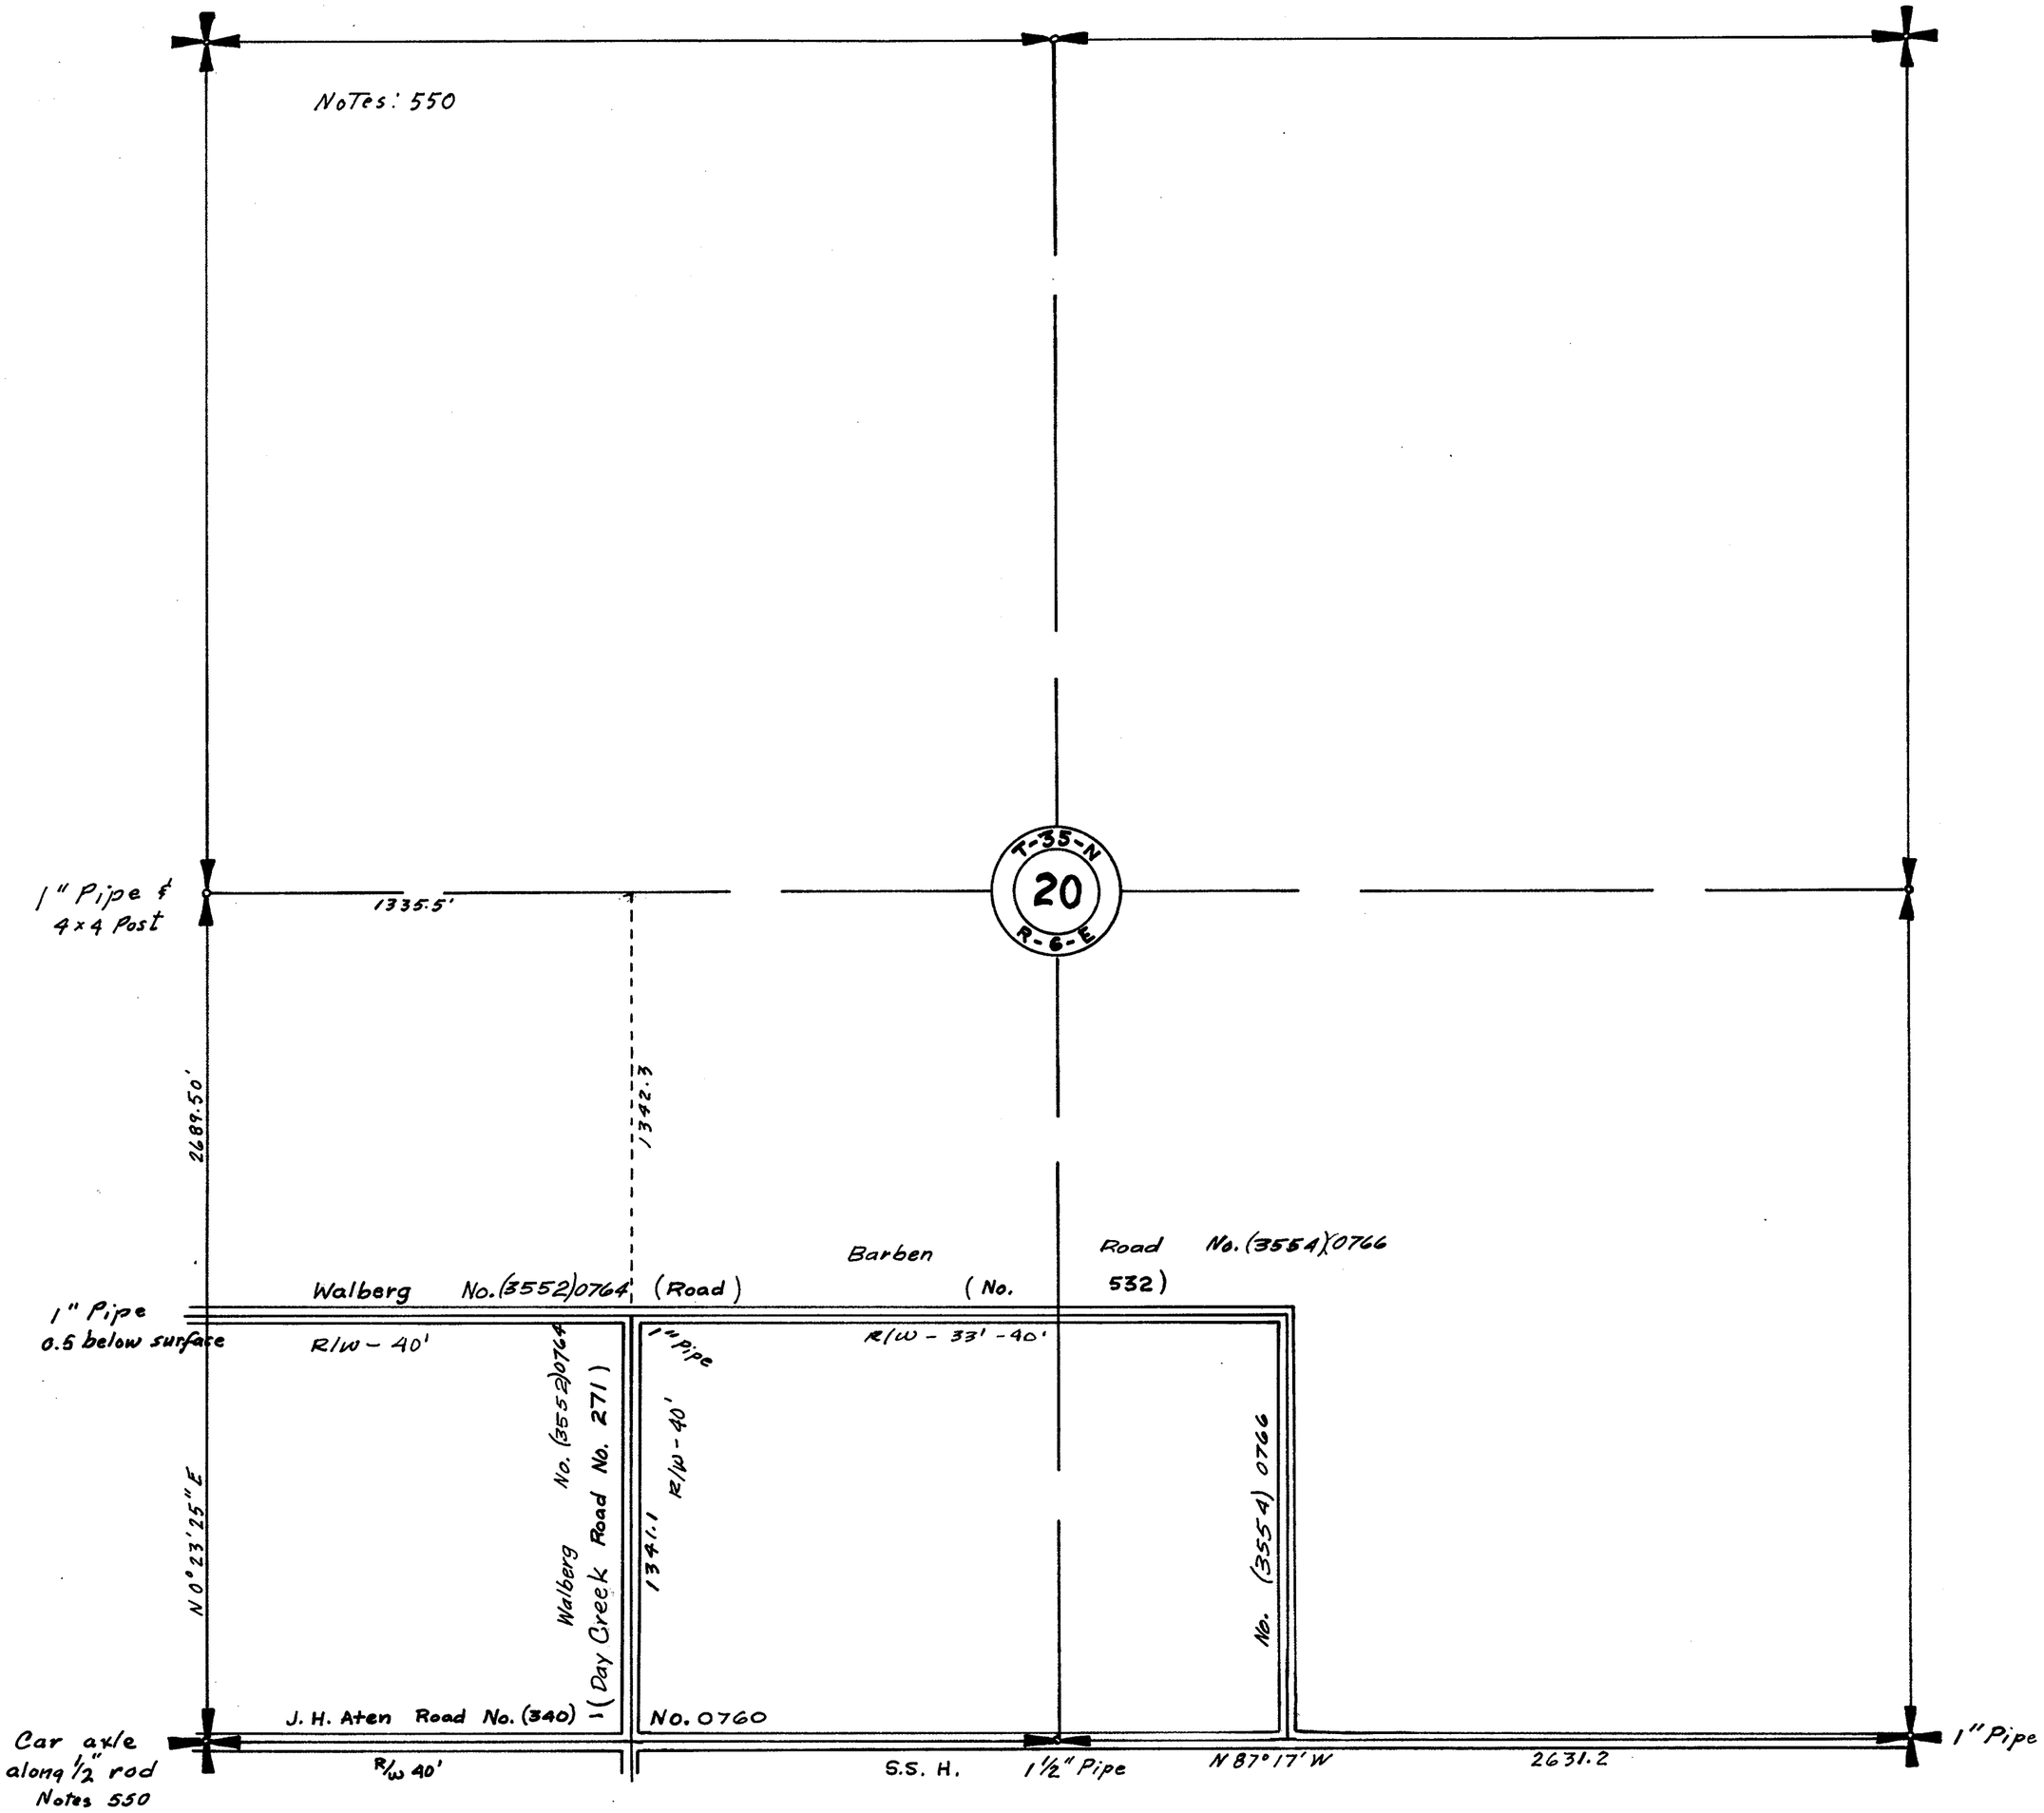


SECTION 20

TOWNSHIP 35 NORTH. RANGE 6 EAST. W. M.

SKAGIT COUNTY. WASH.

SCALE, 1 INCH–400 FEET

AL. STRONG COUNTY ENGINEER

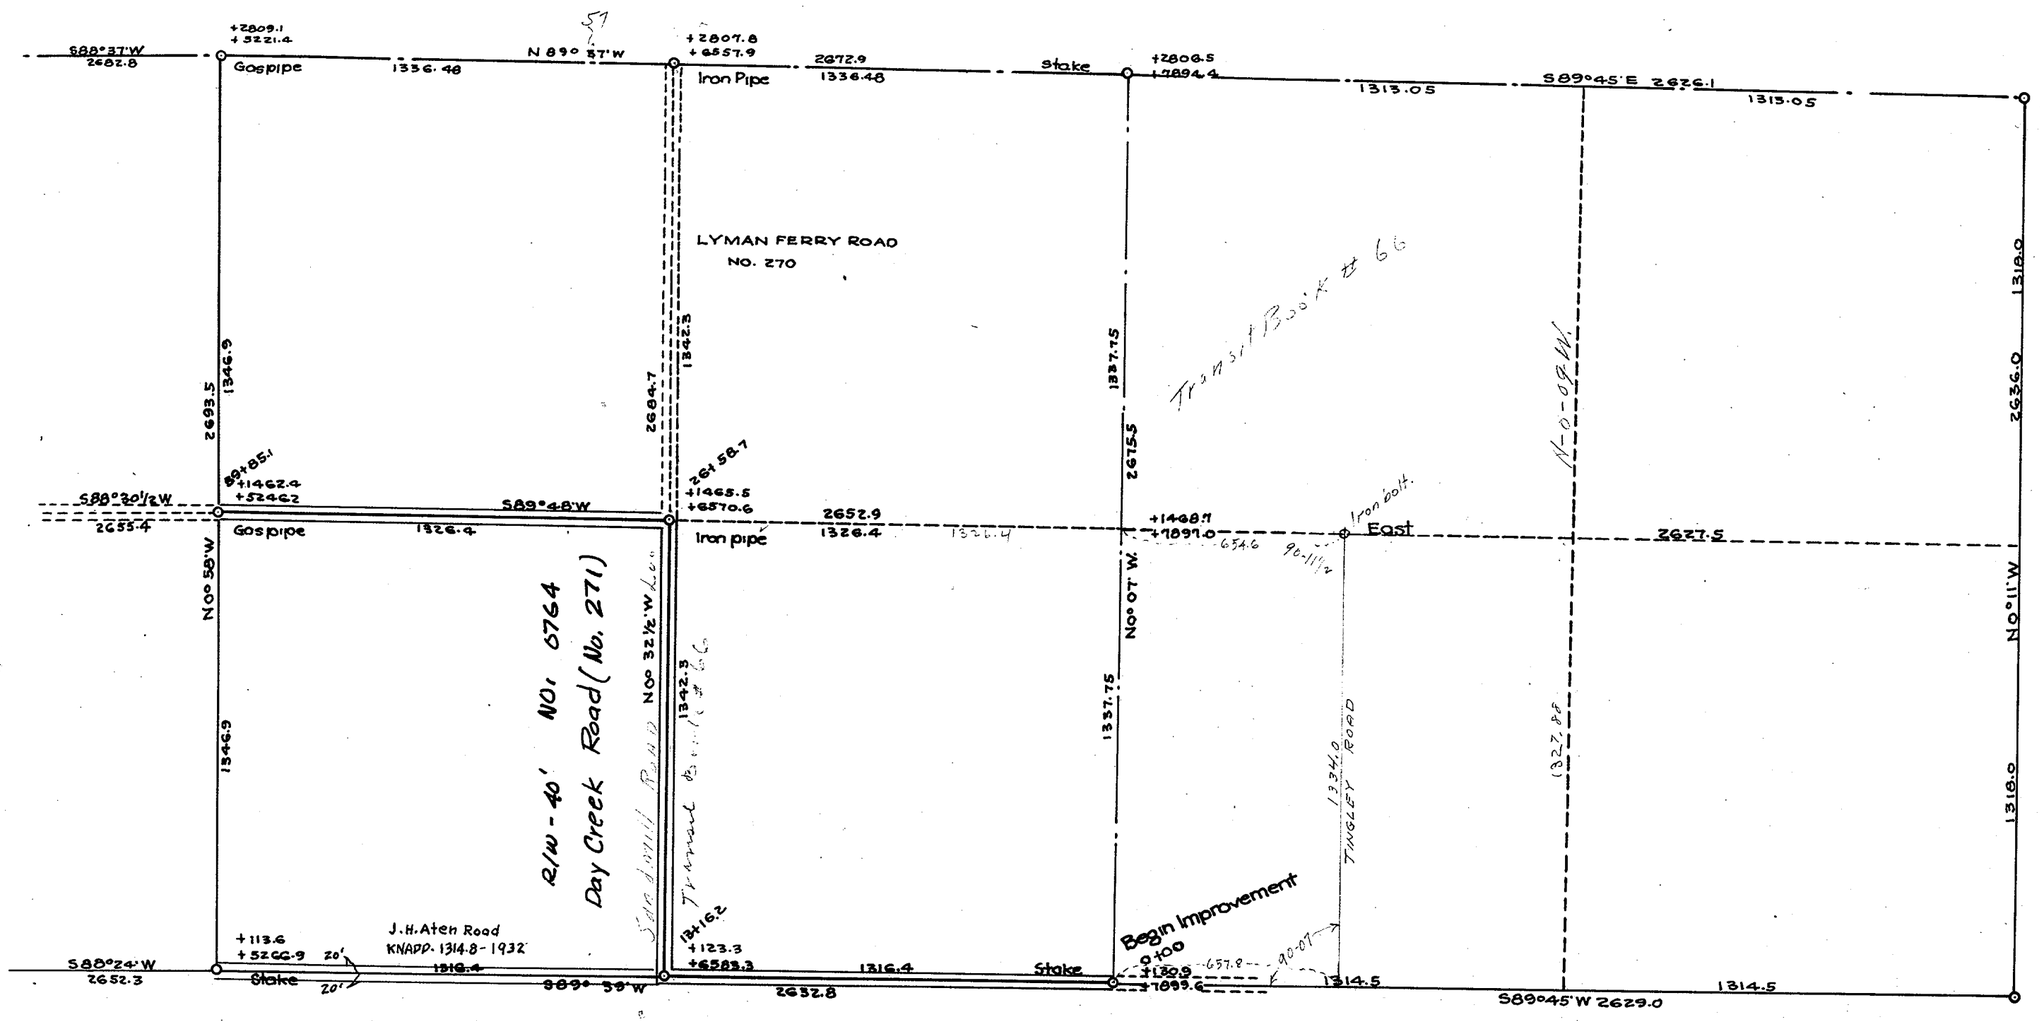


SECTION 20

TOWNSHIP 35 NORTH, RANGE 6 EAST, W. M.
SKAGIT COUNTY, WASH.

SCALE, 1 INCH--400 FEET

W. A. COSTELLO~ 1940 COUNTY ENGINEER

Notes: 38/402

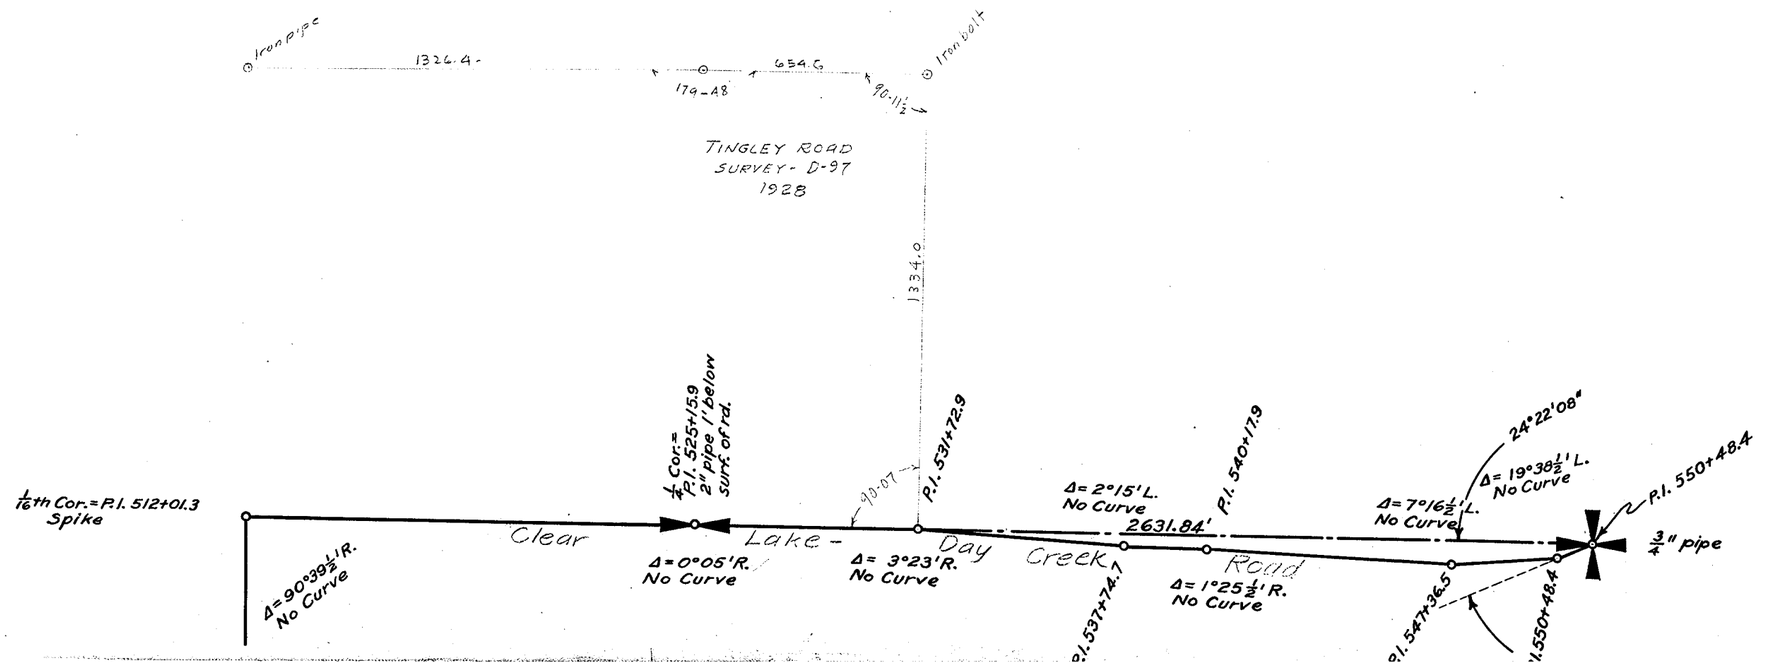


SECTION 21

TOWNSHIP 35 NORTH. RANGE 6 EAST. W. M.
SKAGIT COUNTY. WASH.

SCALE. 1 INCH—400 FEET

LLOYD H. JOHNSON COUNTY ENGINEER

DATE July 3, 1972

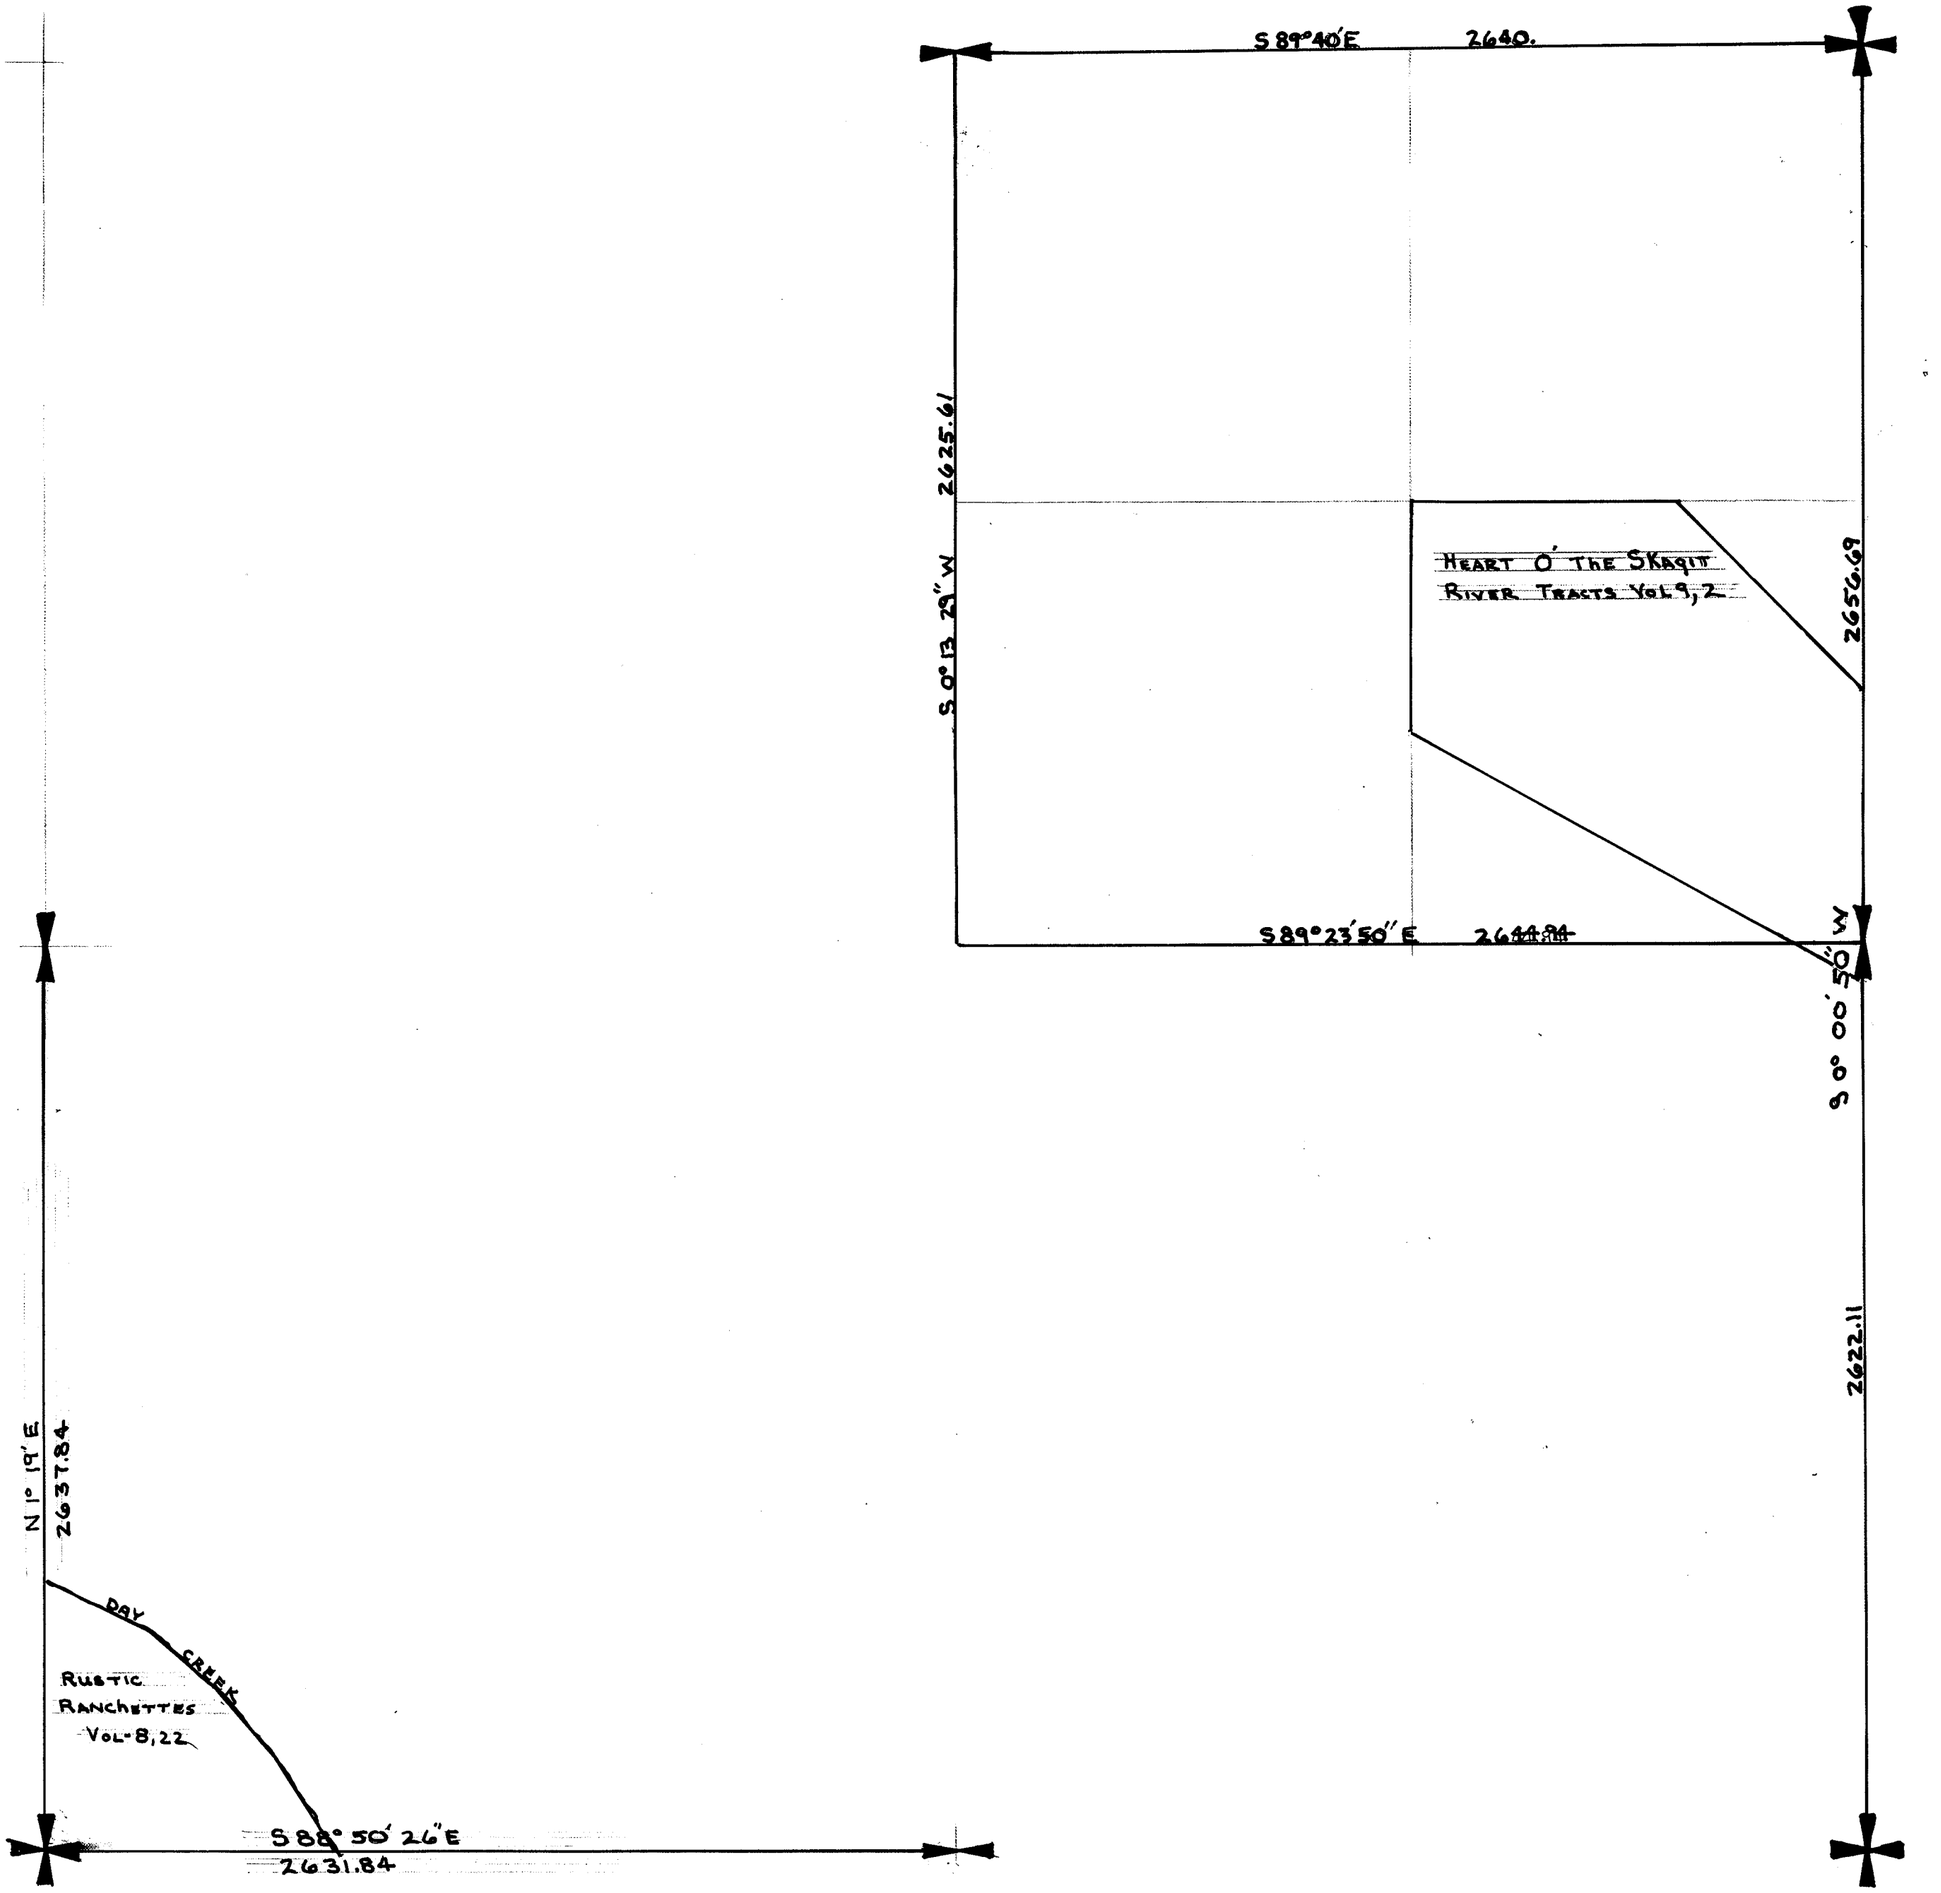


SECTION 21

TOWNSHIP 35 NORTH, RANGE 6 EAST, W. M.
SKAGIT COUNTY, WASH.

SCALE, 1 INCH--400 FEET

W. A. COSTELLO ~ 1940 COUNTY ENGINEER

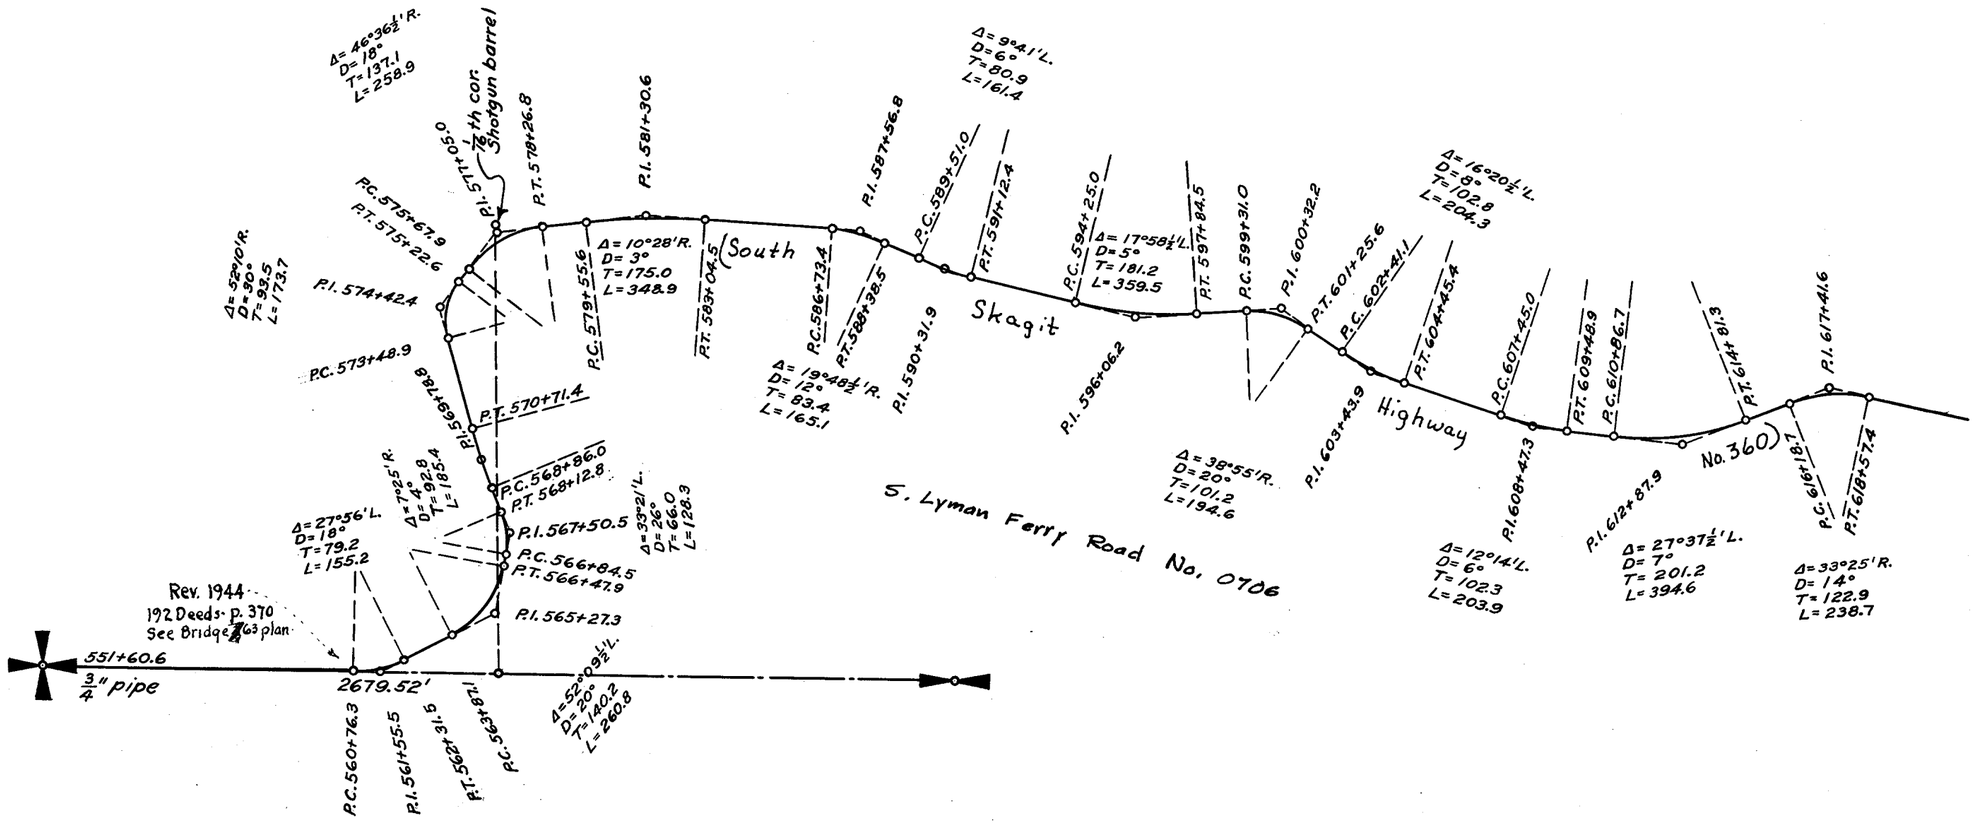

SECTION 21

TOWNSHIP 35 NORTH, RANGE 6 EAST, W. M.


SKAGIT COUNTY, WASH.

SCALE, 1 INCH--400 FEET

DATE Aug. 8, 1963

COUNTY ENGINEER

Dr. By W.G. Wells

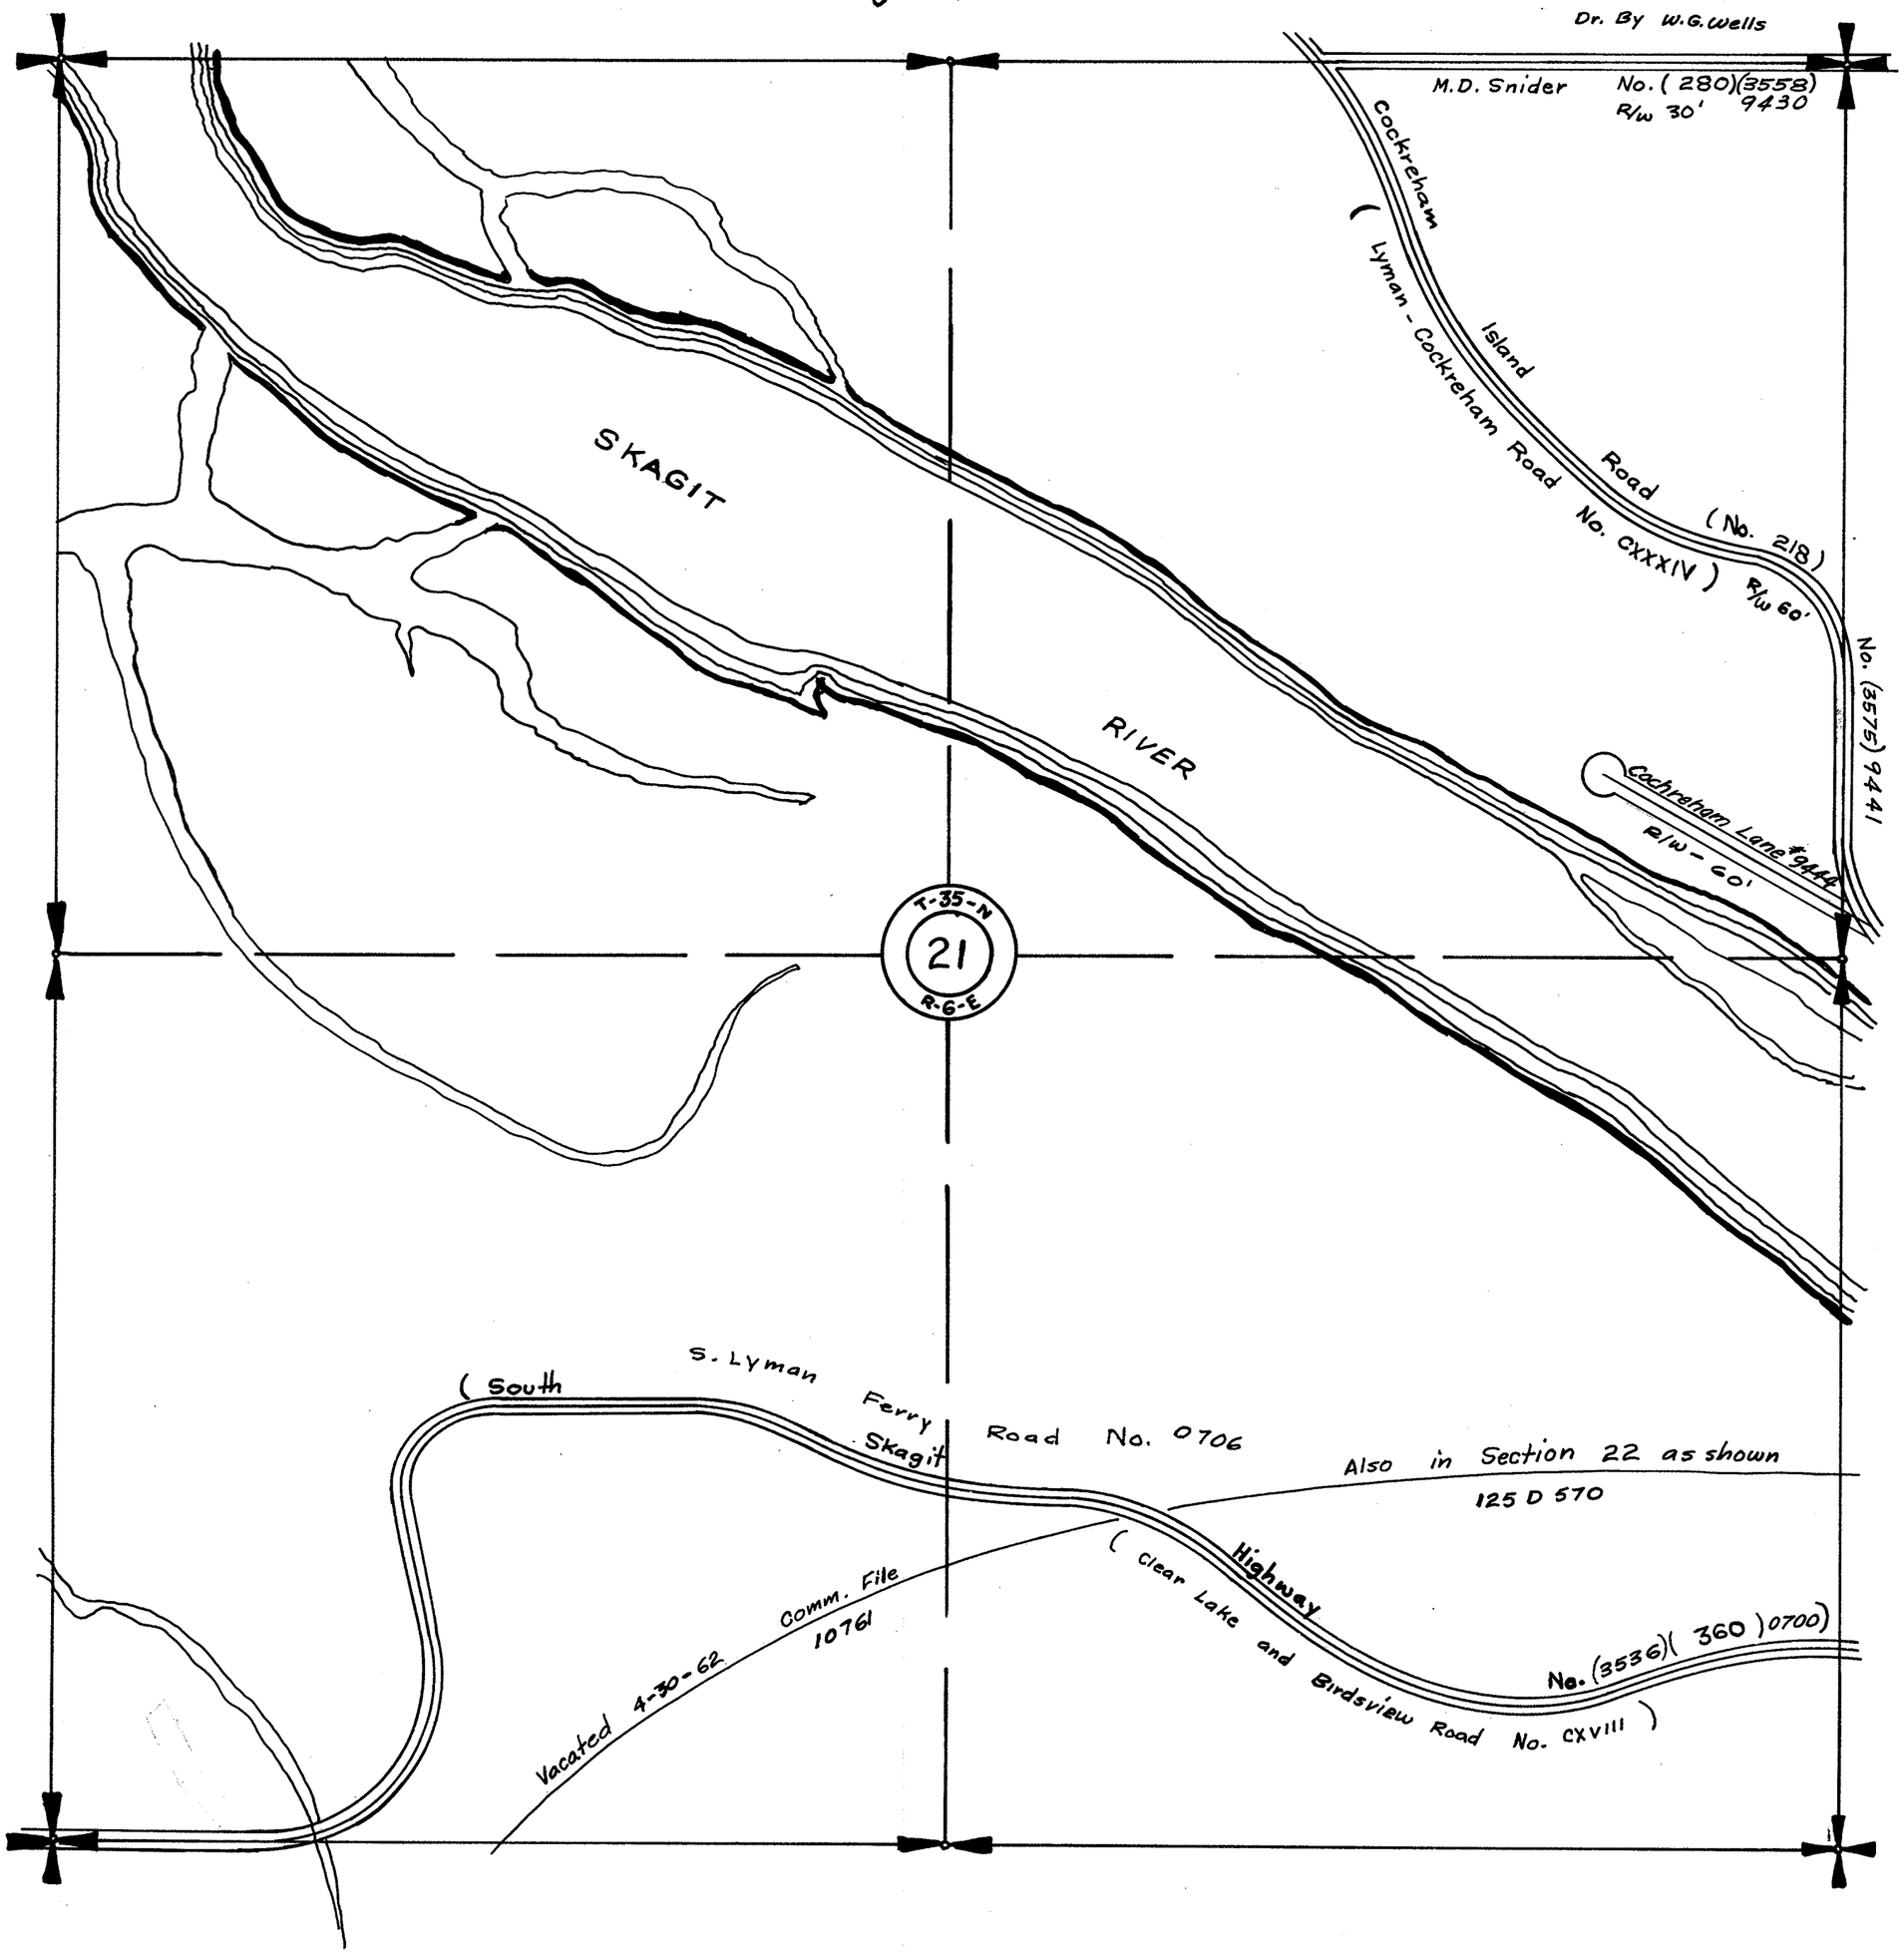


SECTION 21

TOWNSHIP 35 NORTH, RANGE 6 EAST, W. M.

SKAGIT COUNTY, WASH.

SCALE, 1 INCH–400 FEET

W.E. Castello COUNTY ENGINEER

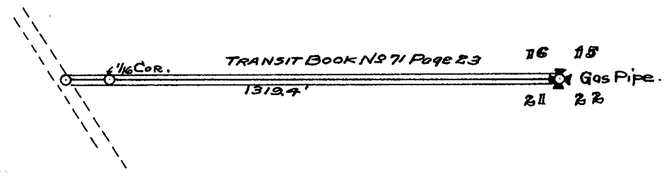


SECTION 22

TOWNSHIP 35 NORTH, RANGE 6 EAST, W. M.

SKAGIT COUNTY, WASH.

SCALE, 1 INCH–400 FEET

W.E. Costello COUNTY ENGINEER

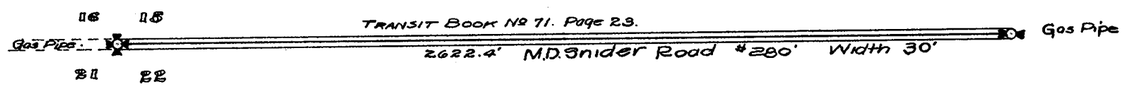

SECTION 22

TOWNSHIP 35 NORTH, RANGE 6 EAST, W. M.


SKAGIT COUNTY, WASH.

SCALE, 1 INCH--400 FEET

DATE Aug. 8, 1963

COUNTY ENGINEER

Dr. By W.G. Wells

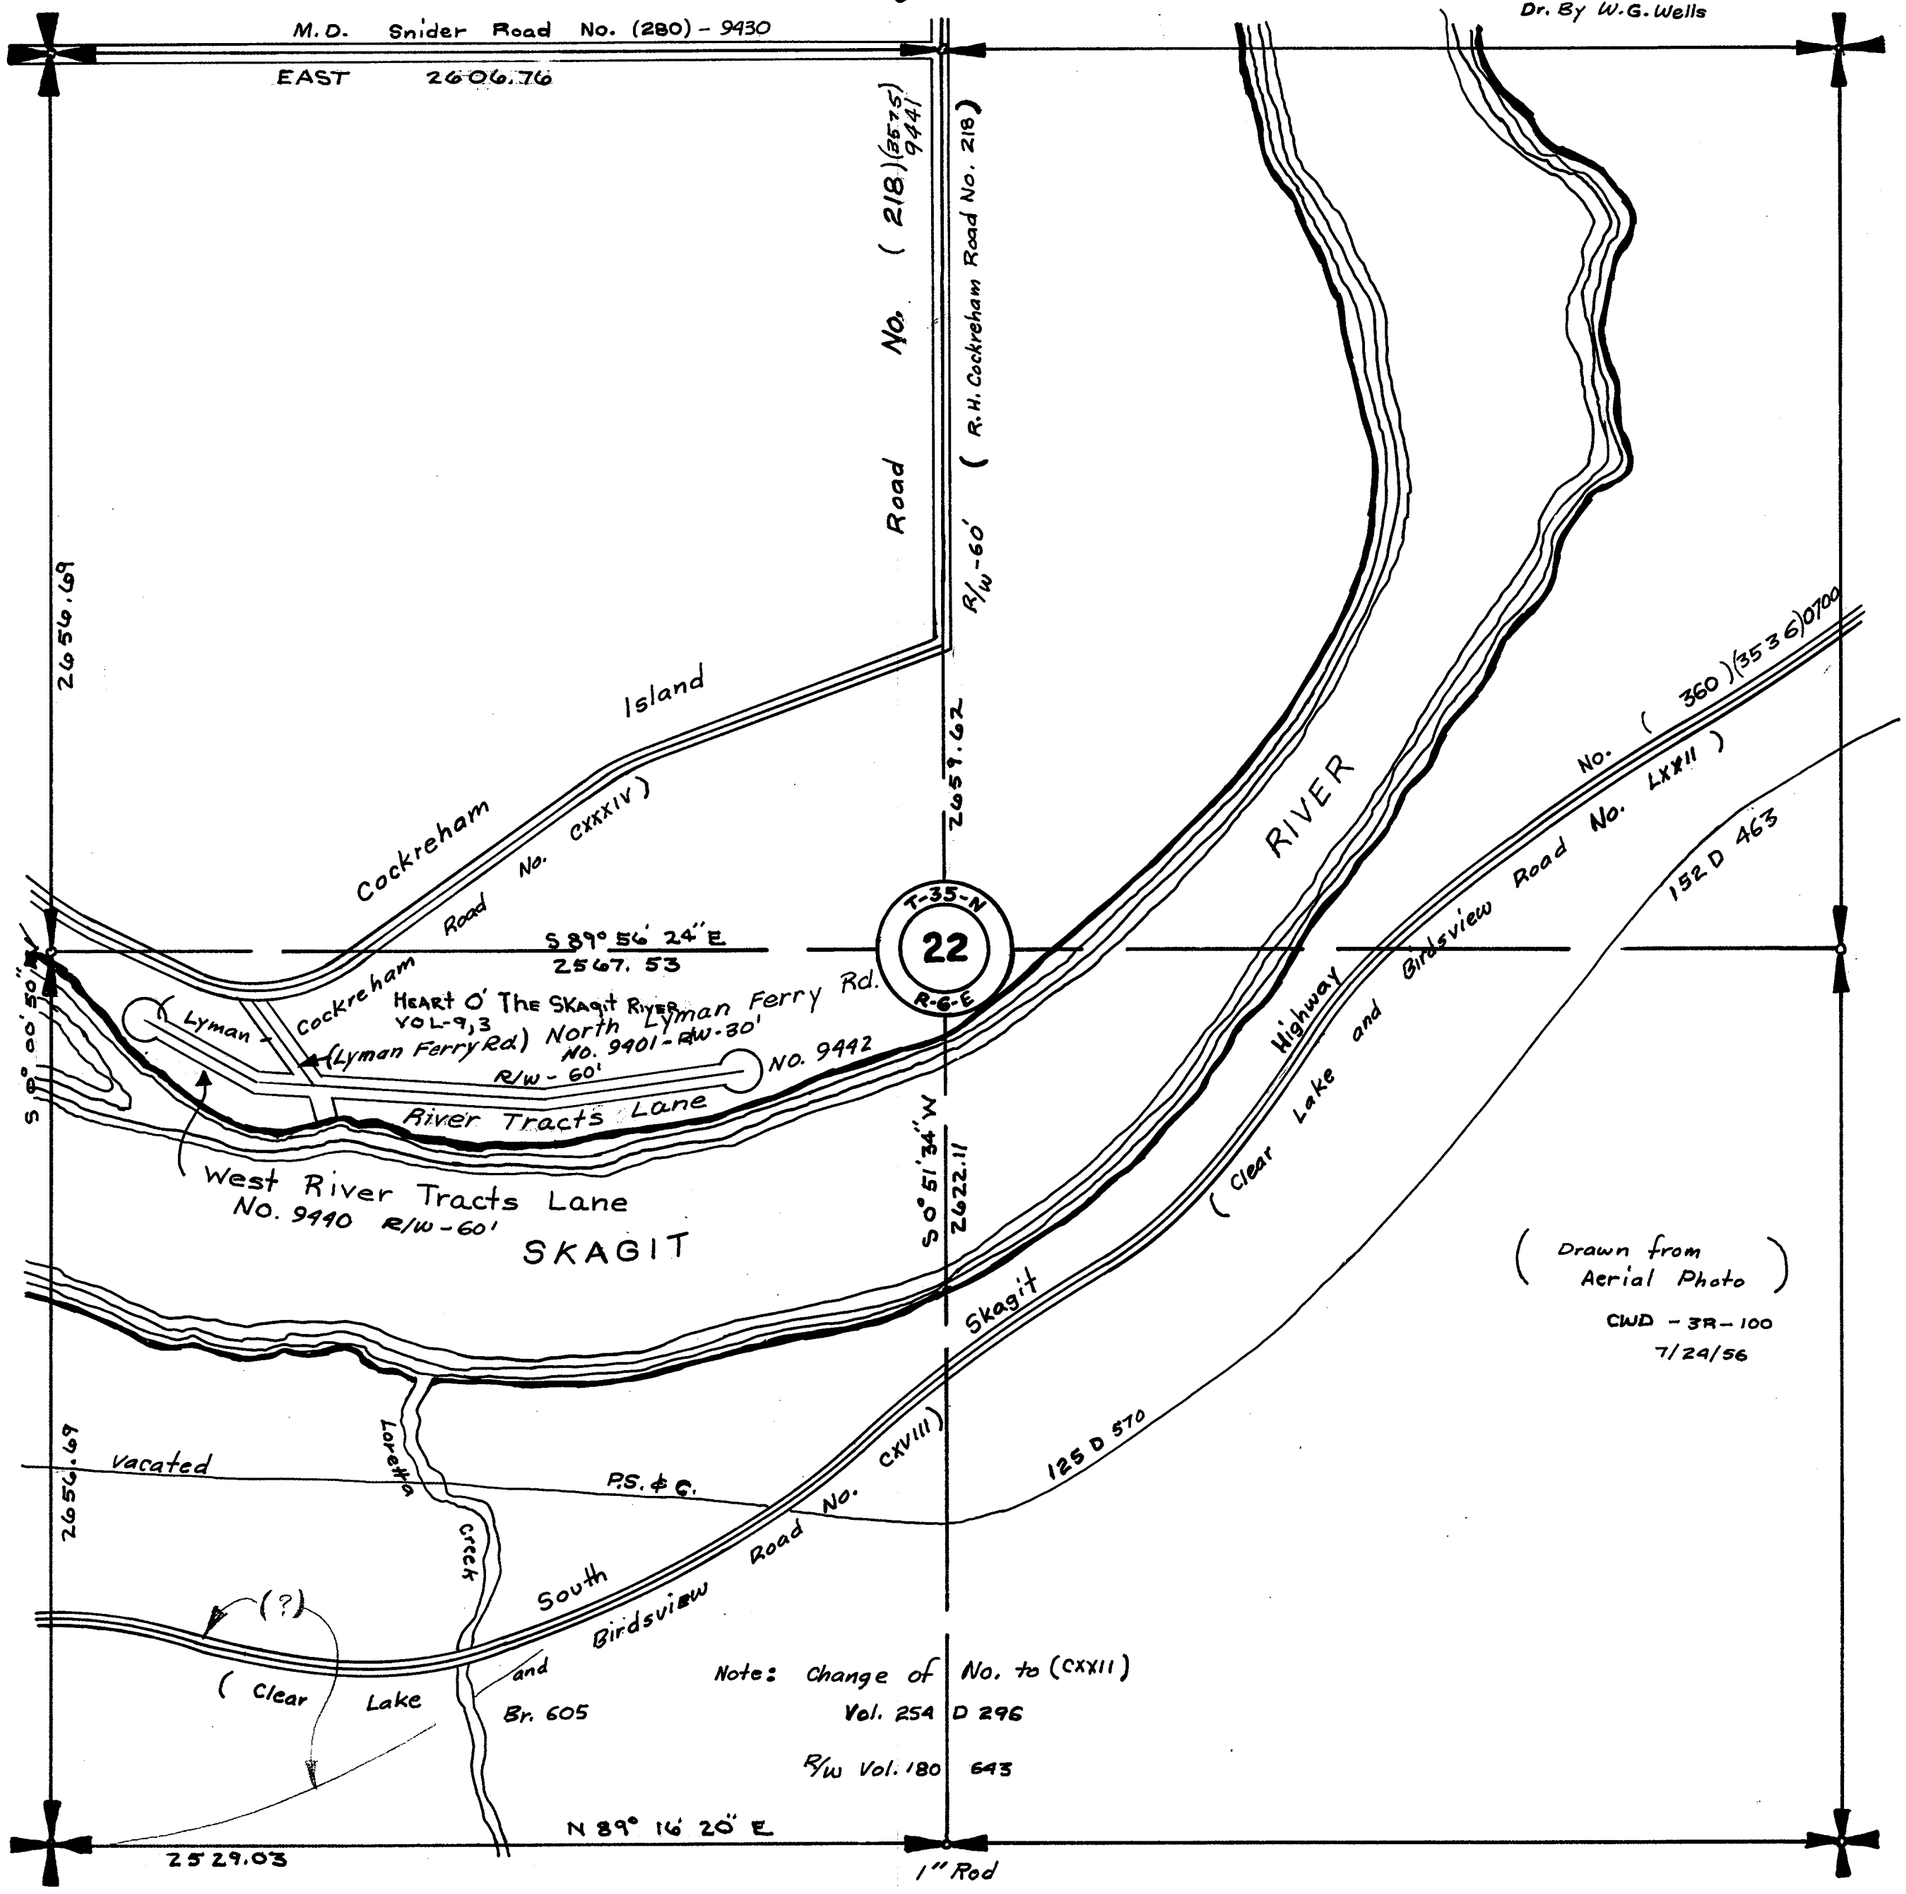


SECTION 28

TOWNSHIP 35 NORTH, RANGE 6 EAST, W. M.

SKAGIT COUNTY, WASH.

SCALE, 1 INCH--400 FEET

W.A. COSTELLO COUNTY ENGINEER

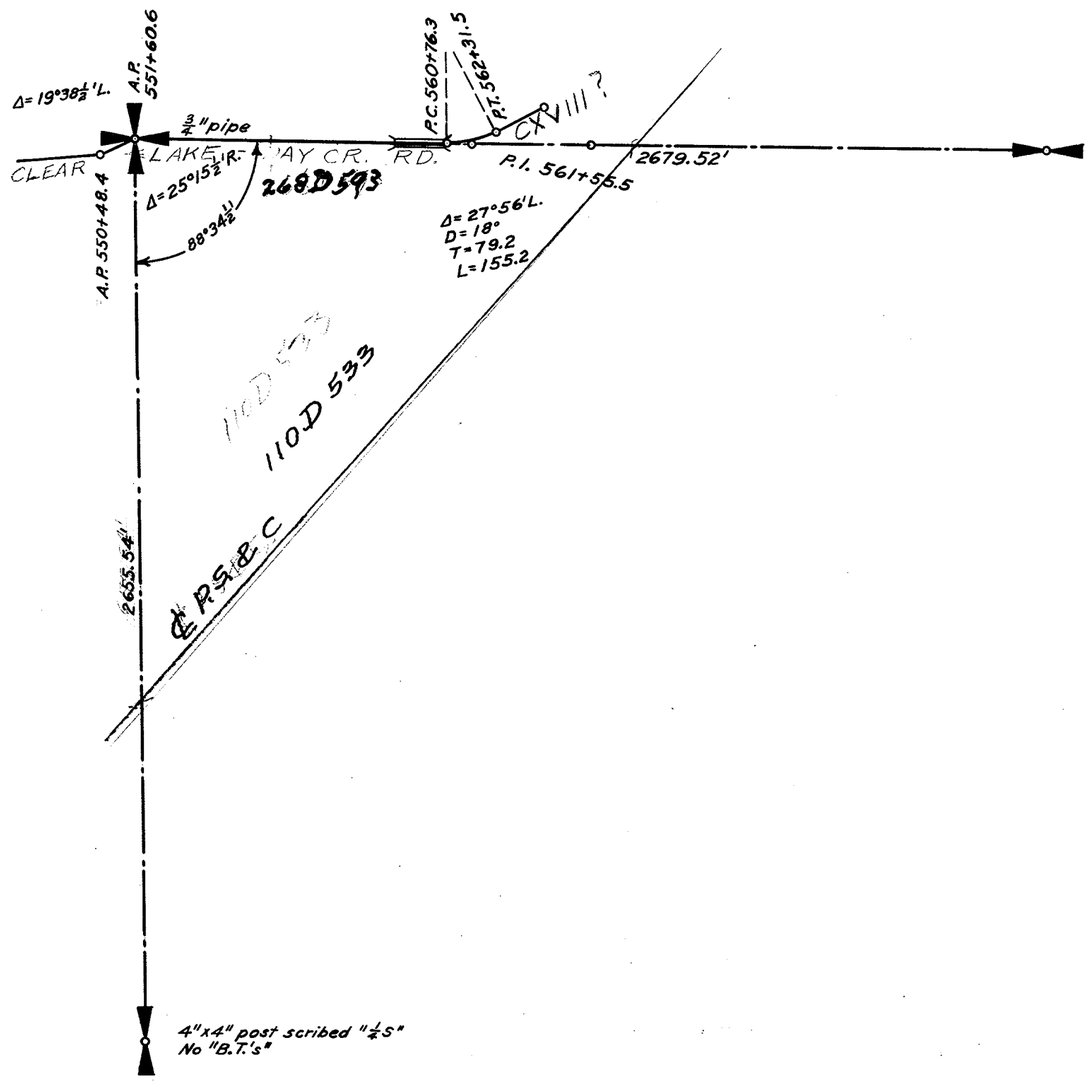


SECTION 29

TOWNSHIP 35 NORTH, RANGE 6 EAST, W. M.
SKAGIT COUNTY, WASH.

SCALE, 1 INCH--400 FEET

W. A. COSTELLO ~ 1940 COUNTY ENGINEER

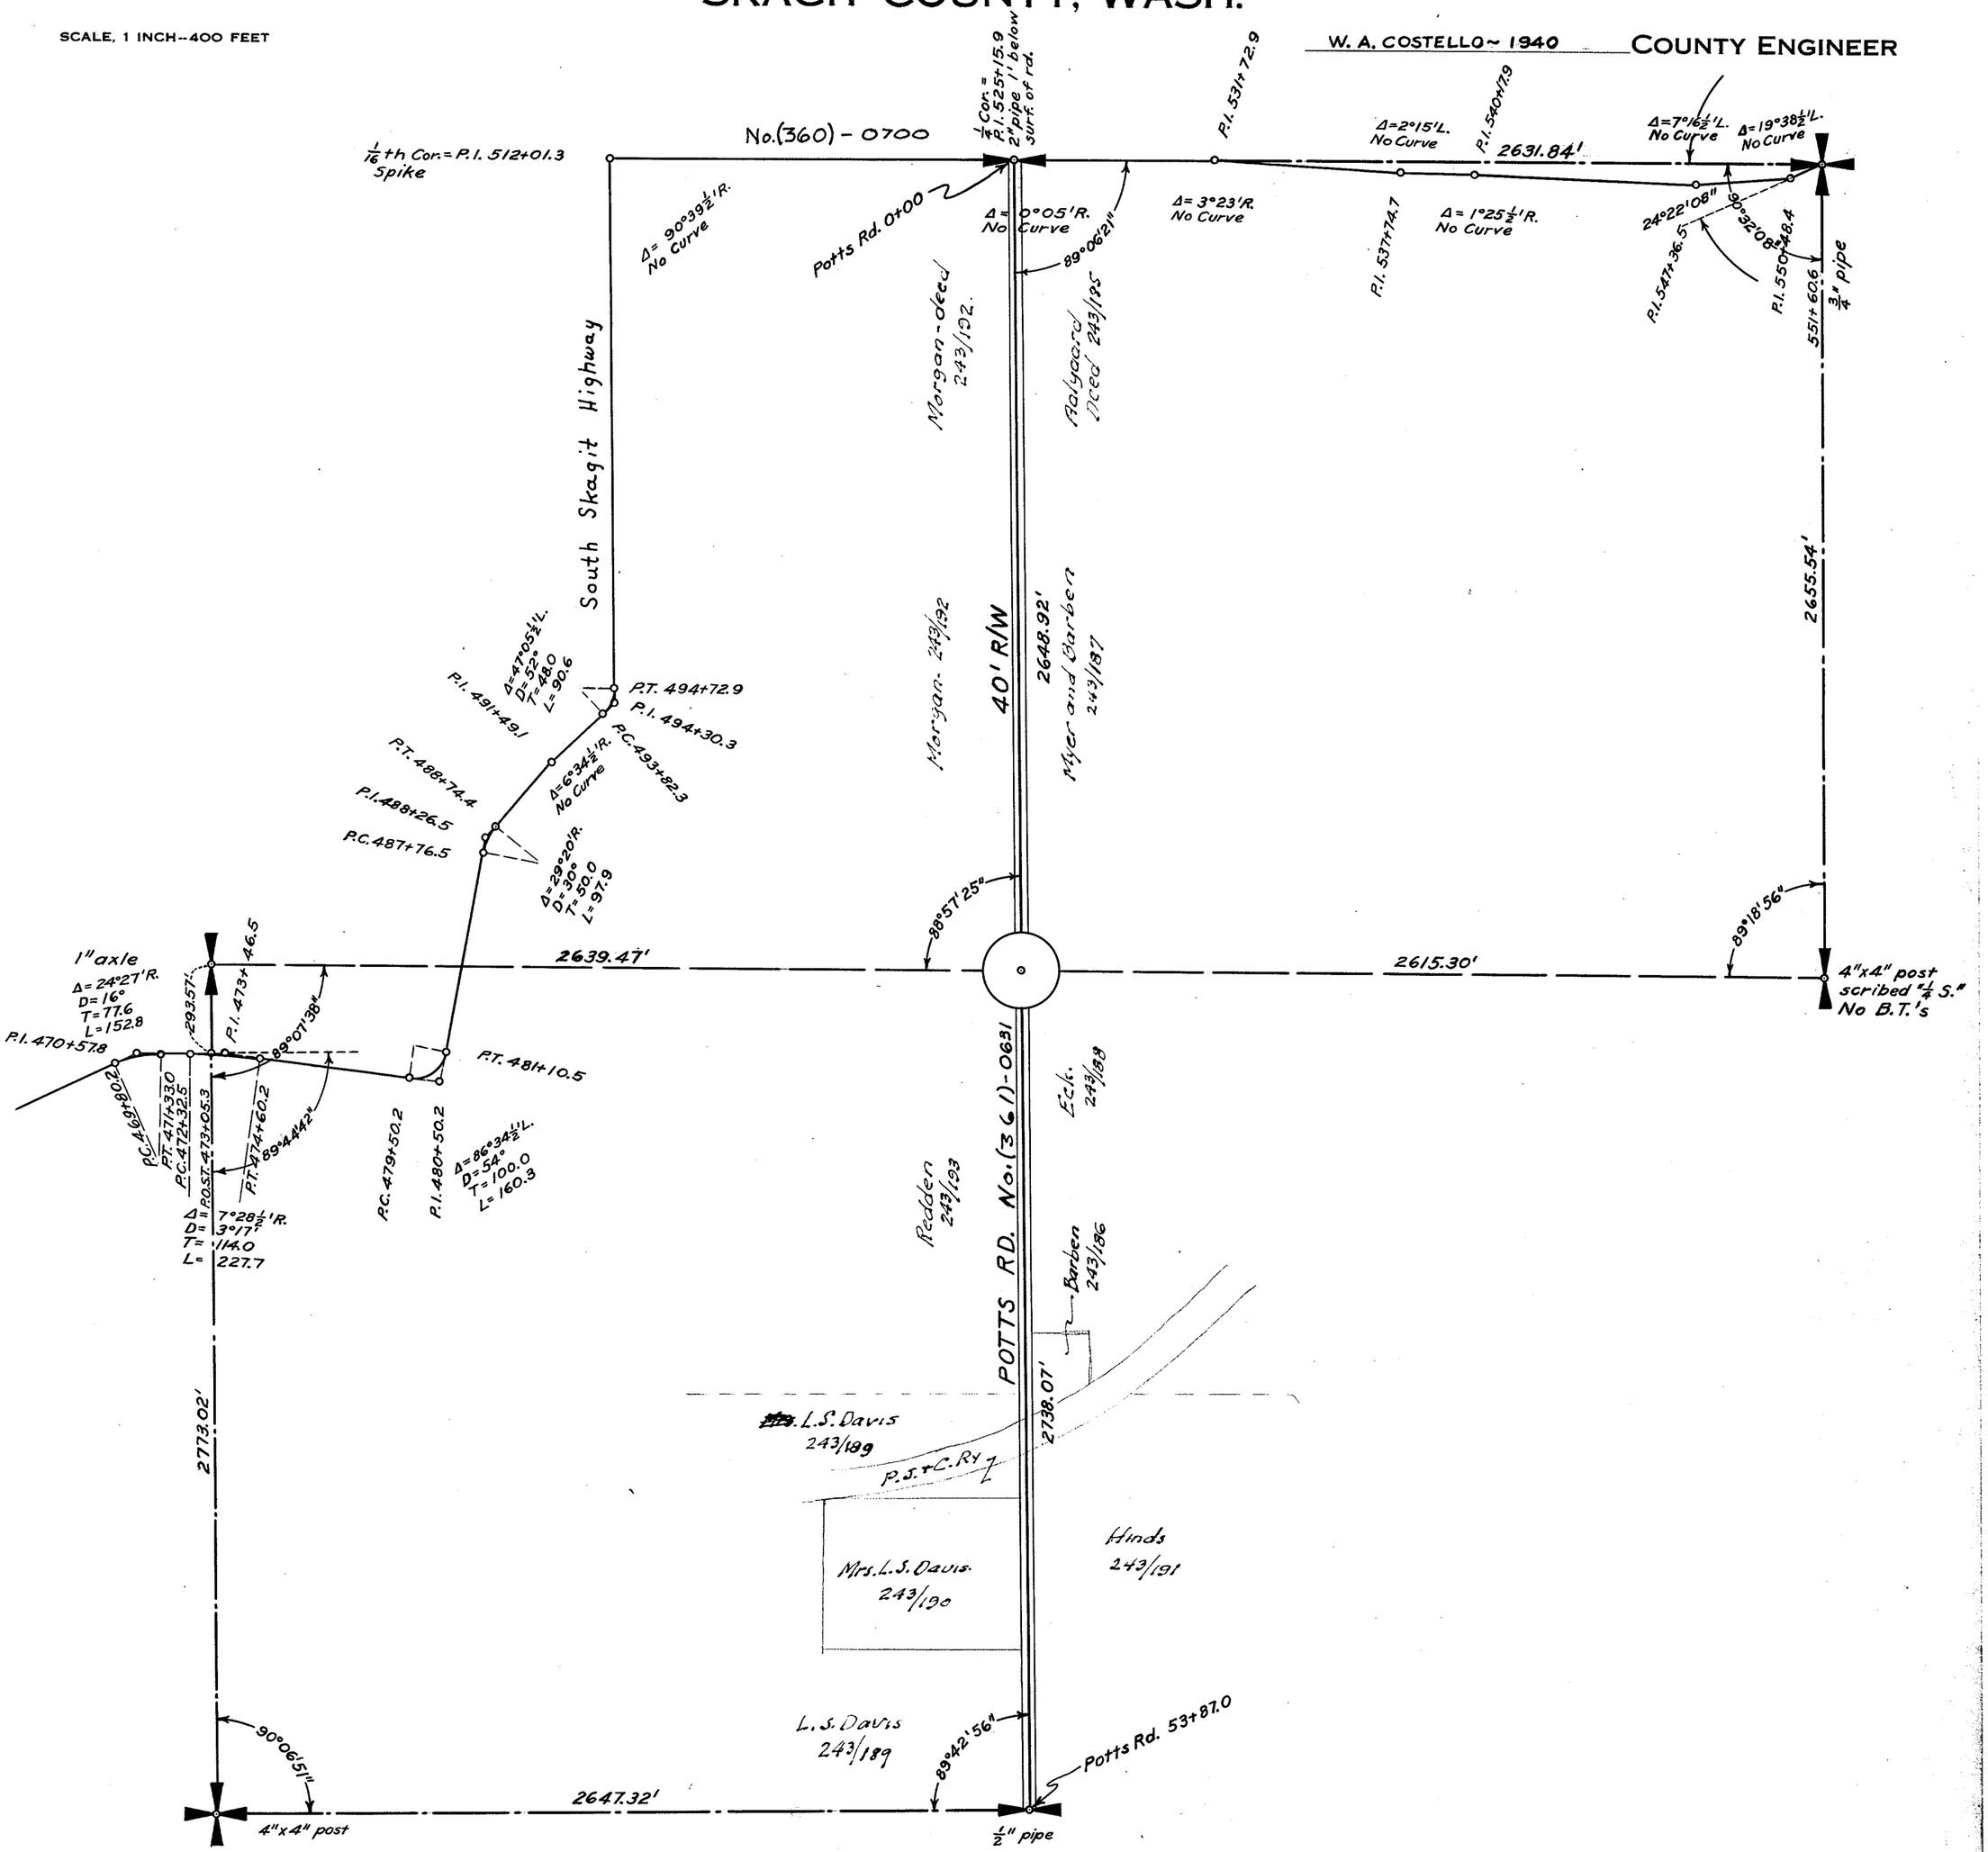


SECTION 30

TOWNSHIP 35 NORTH, RANGE 6 EAST, W. M.
SKAGIT COUNTY, WASH.

SCALE, 1 INCH--400 FEET

W. A. COSTELLO~1940 COUNTY ENGINEER

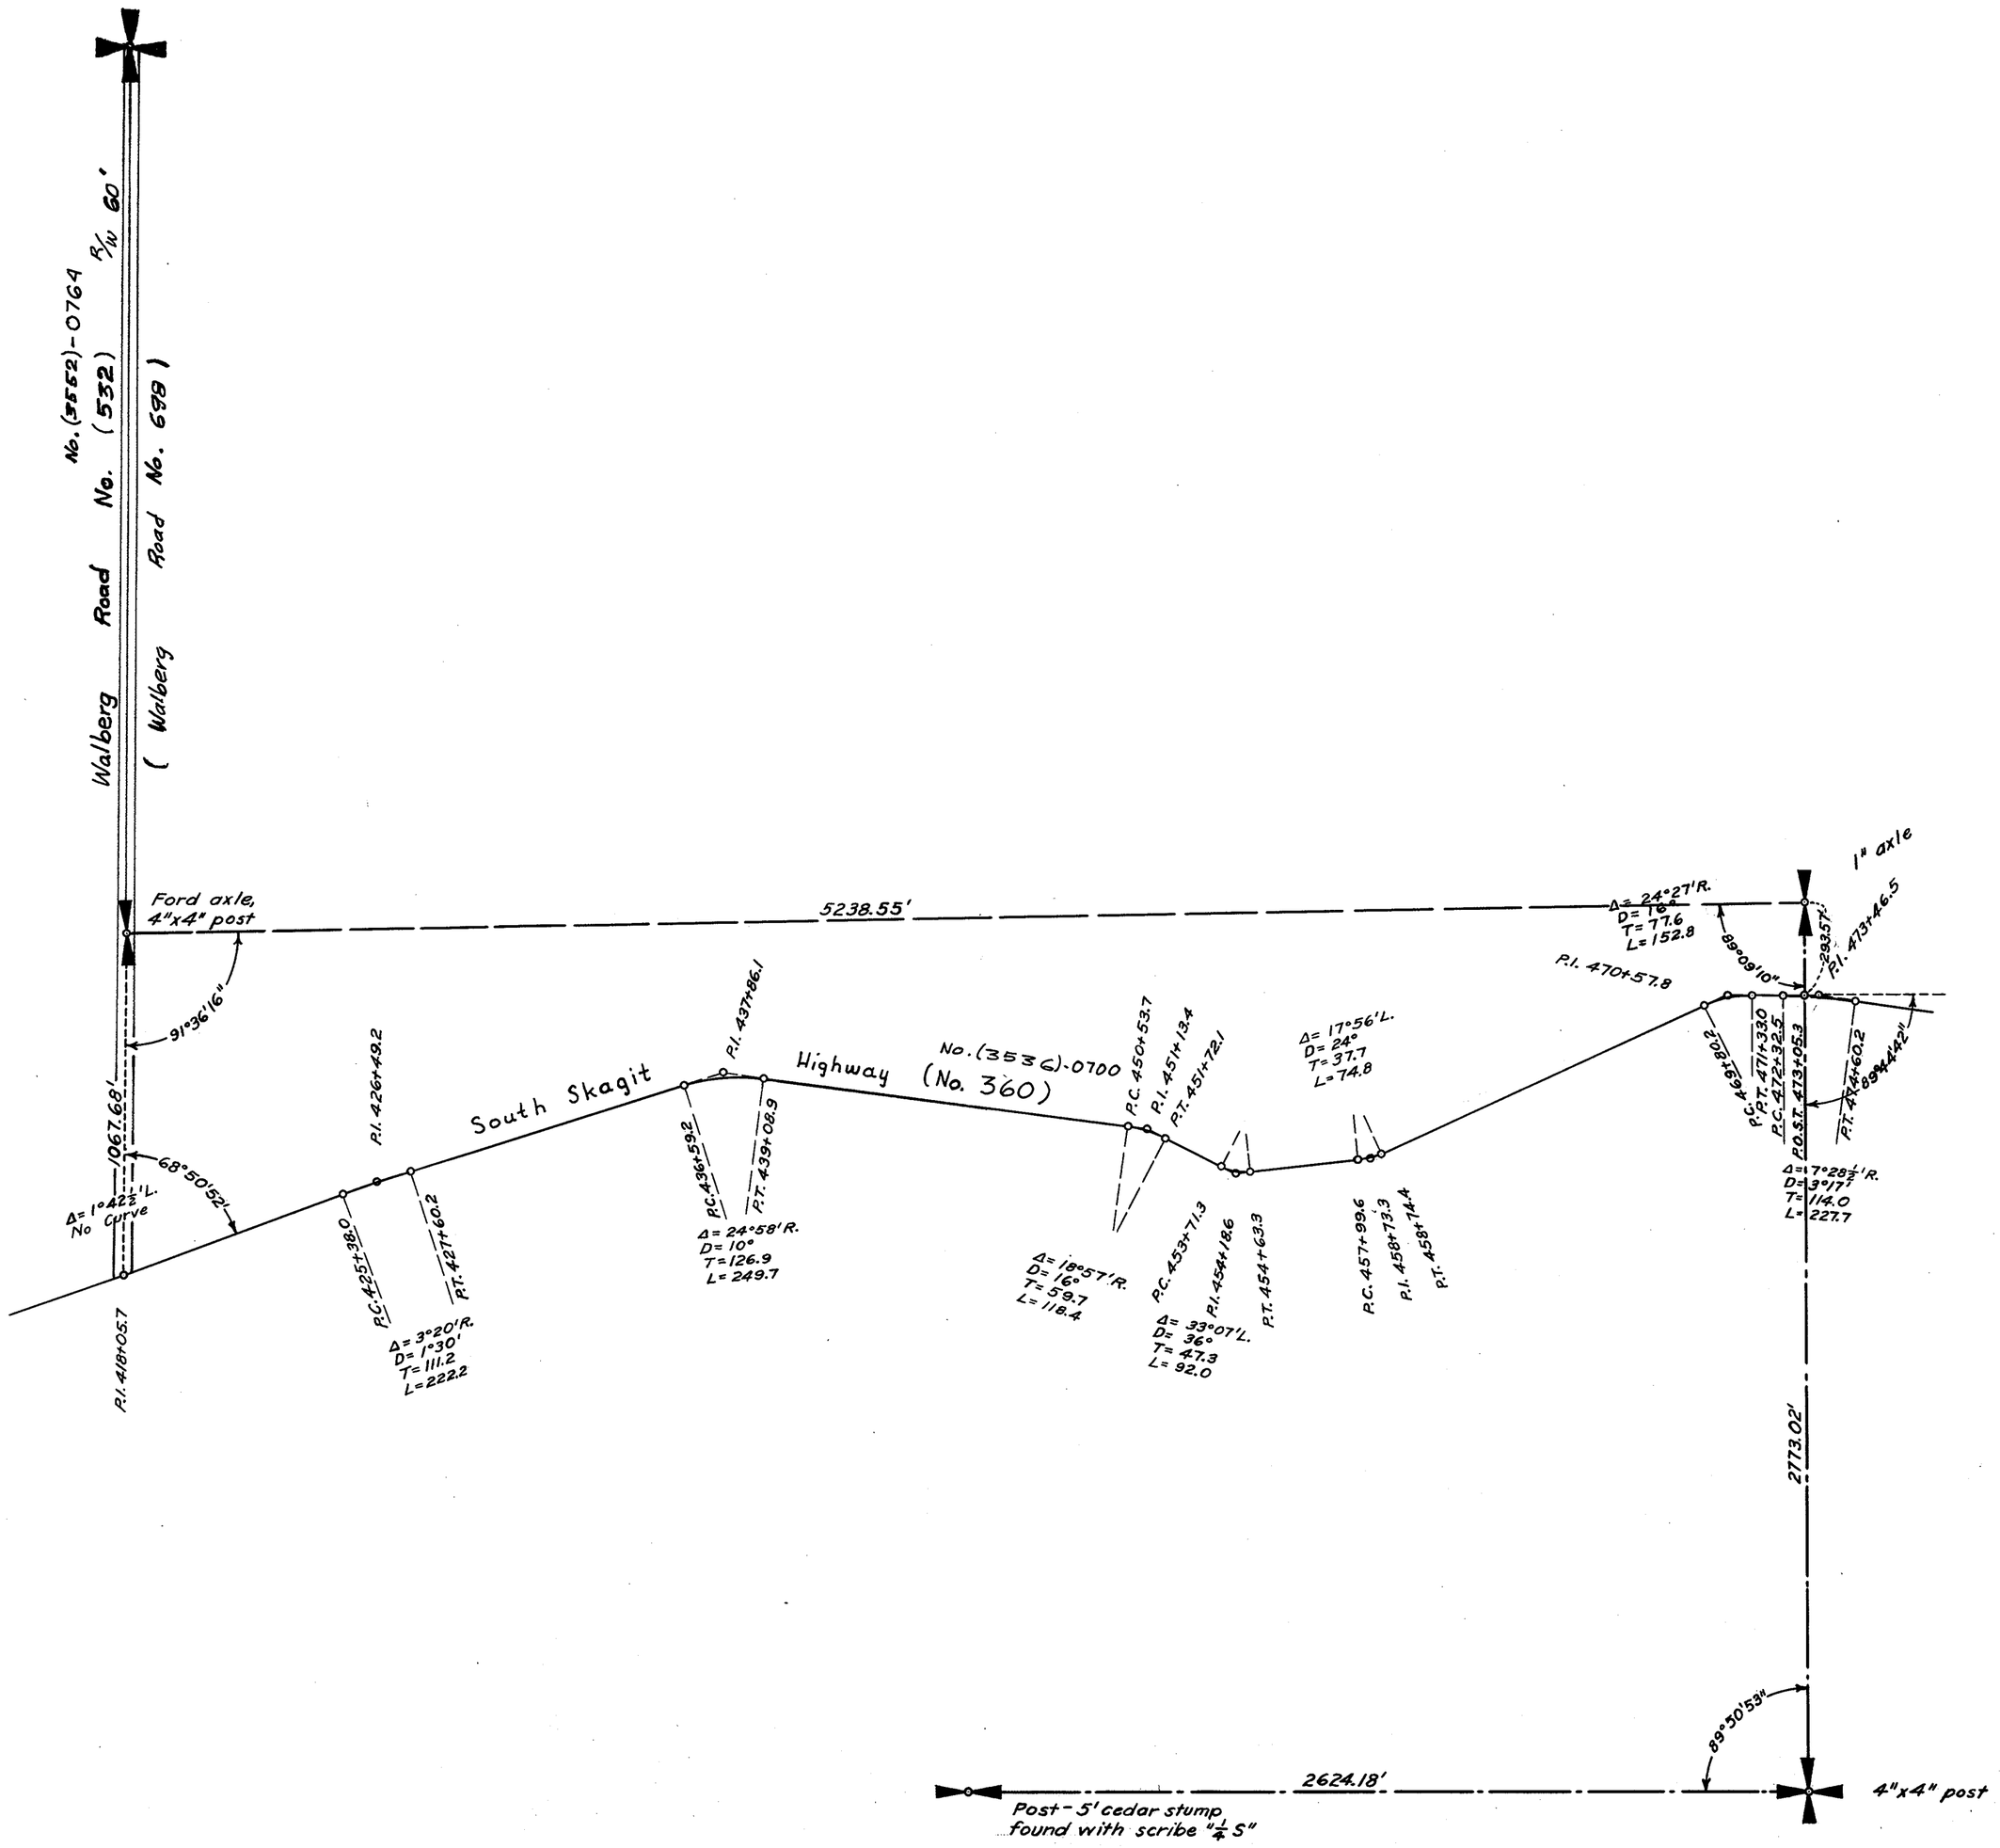


SECTION 31

TOWNSHIP 35 NORTH, RANGE 6 EAST, W. M.
SKAGIT COUNTY, WASH.

SCALE, 1 INCH--400 FEET

W. A. COSTELLO~1940 COUNTY ENGINEER

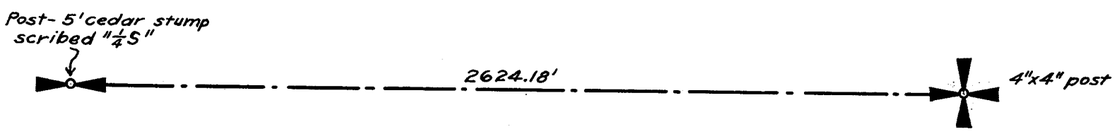


SECTION 32

TOWNSHIP 35 NORTH, RANGE 6 EAST, W. M.
SKAGIT COUNTY, WASH.

SCALE, 1 INCH--400 FEET

W.A. COSTELLO~1940 COUNTY ENGINEER

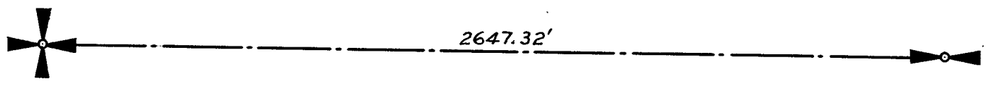


SECTION 1

TOWNSHIP 35 NORTH, RANGE 7 EAST, W. M.

SKAGIT COUNTY, WASH.

SCALE, 1 INCH--400 FEET

DATE _____ _____ COUNTY ENGINEER

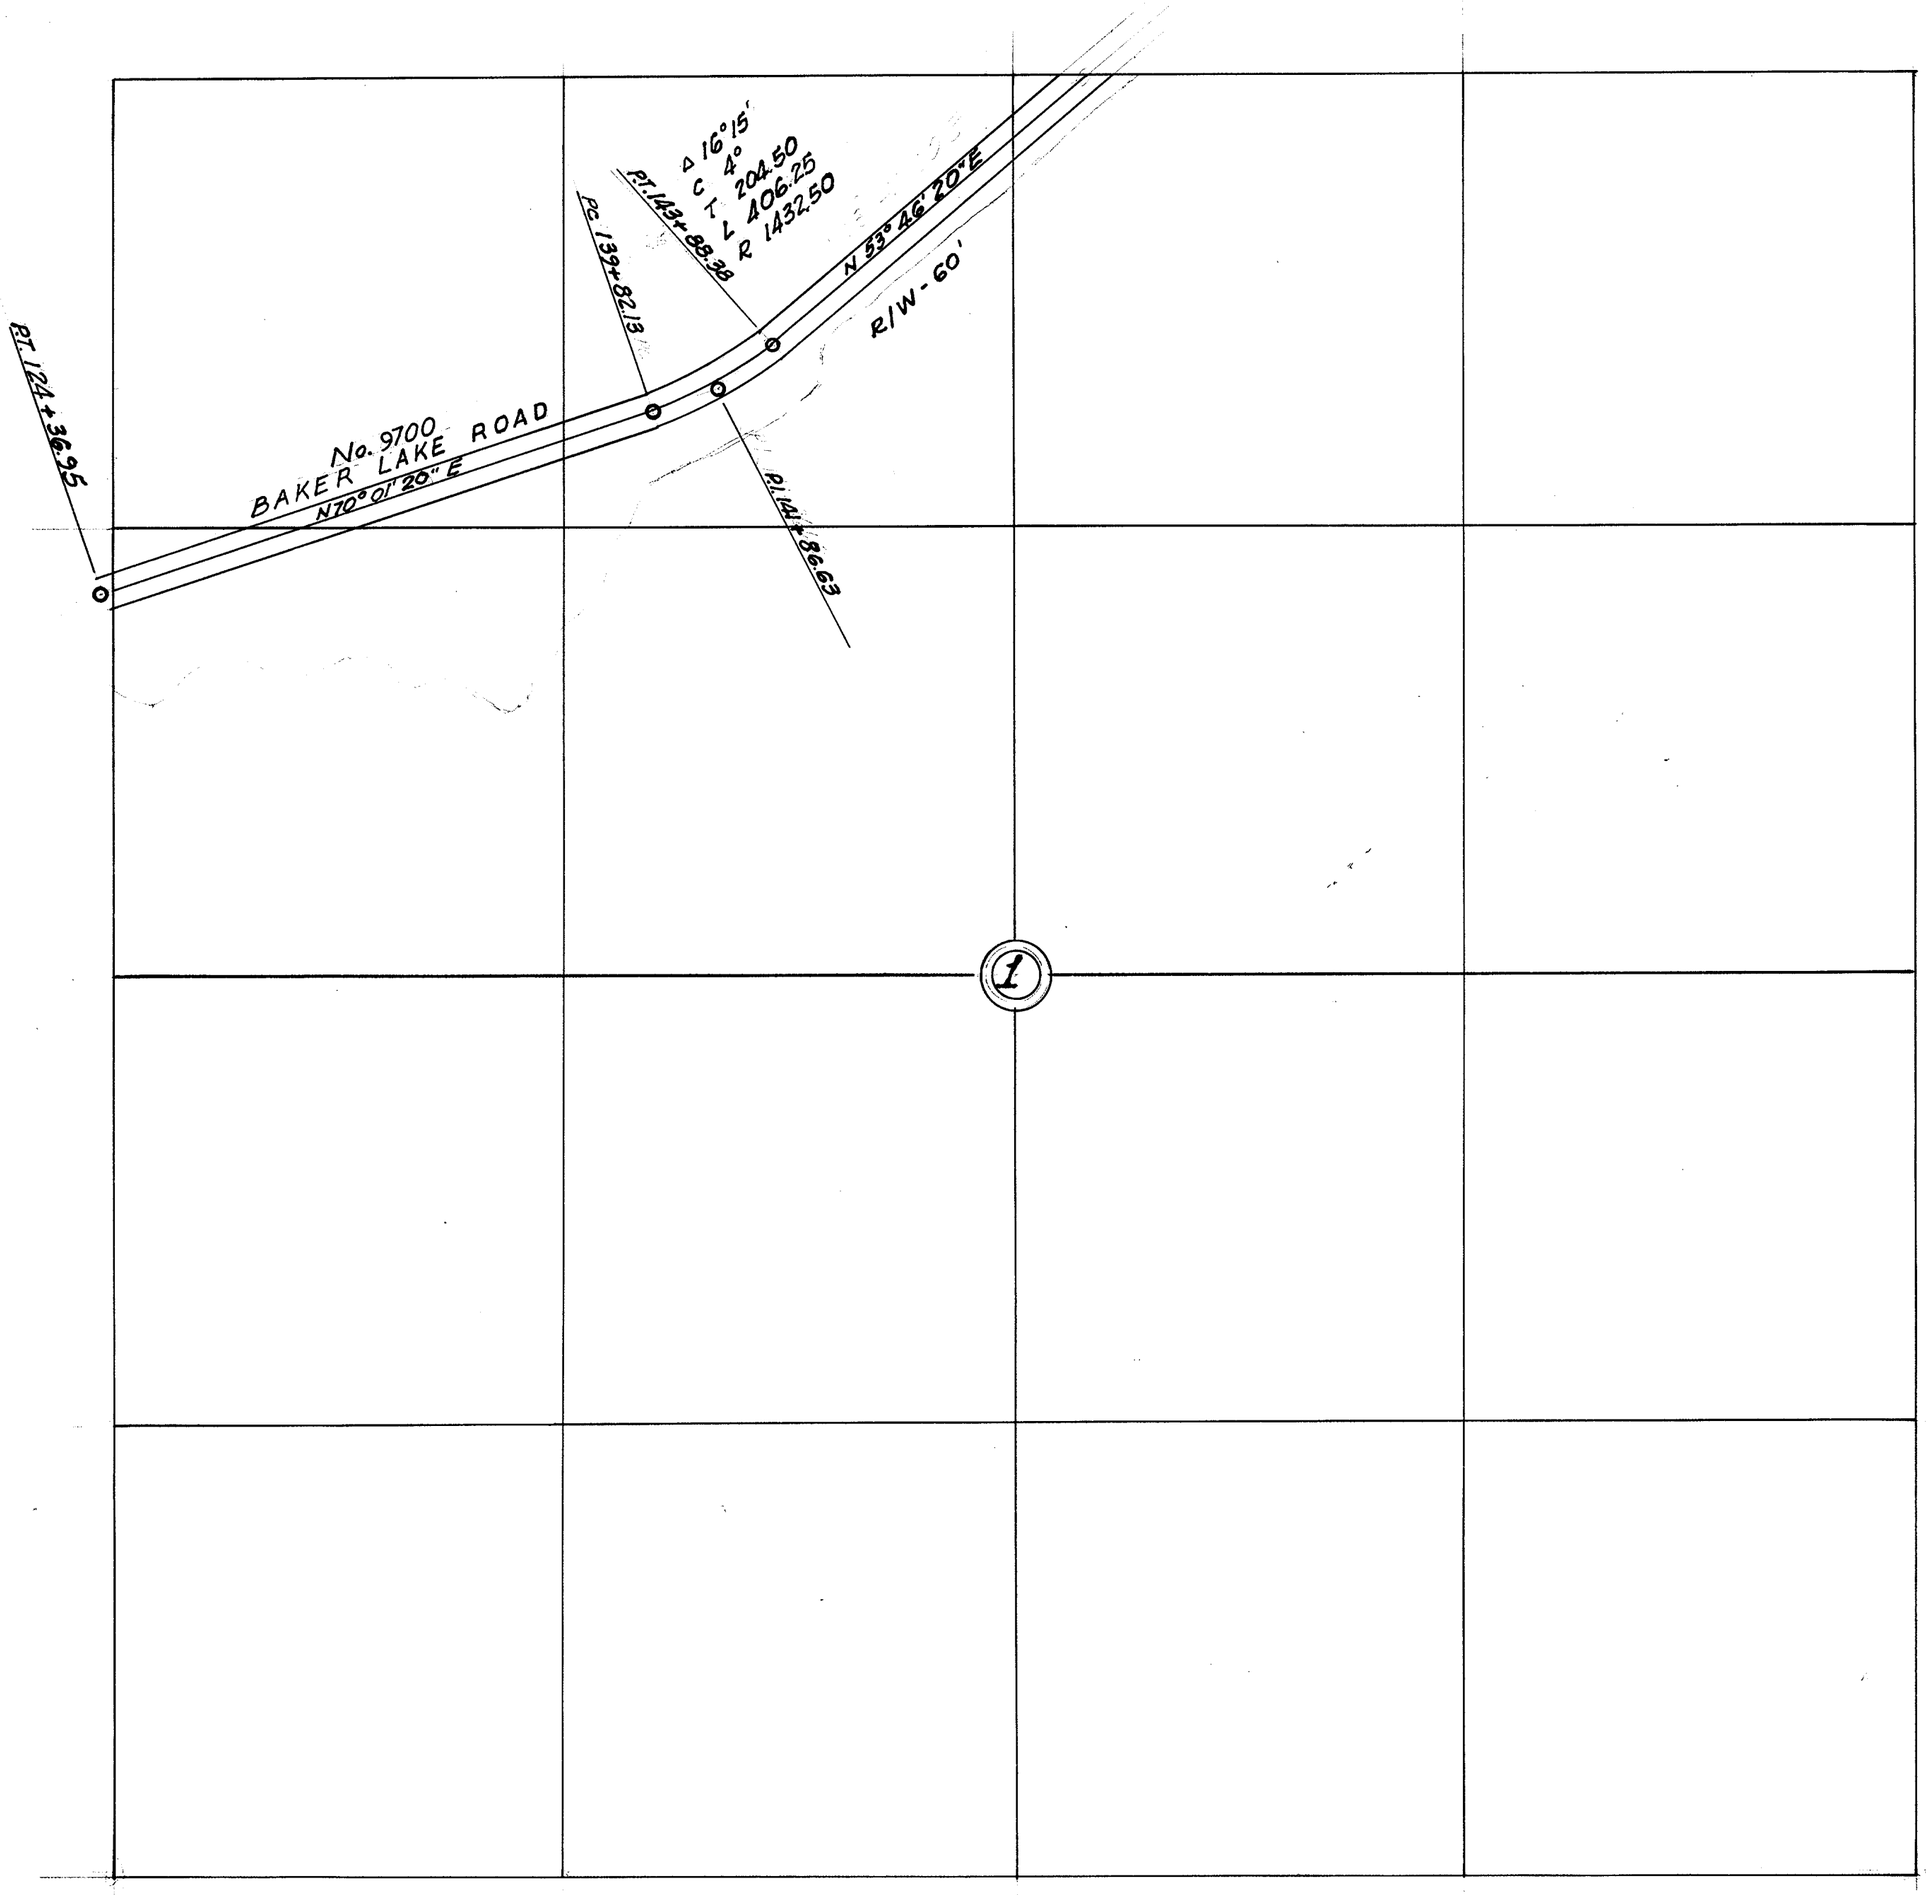

SECTION 2


TOWNSHIP 35 NORTH, RANGE 7 EAST, W. M.

SKAGIT COUNTY, WASH.

SCALE, 1 INCH--400 FEET

DATE 4-24-66

COUNTY ENGINEER

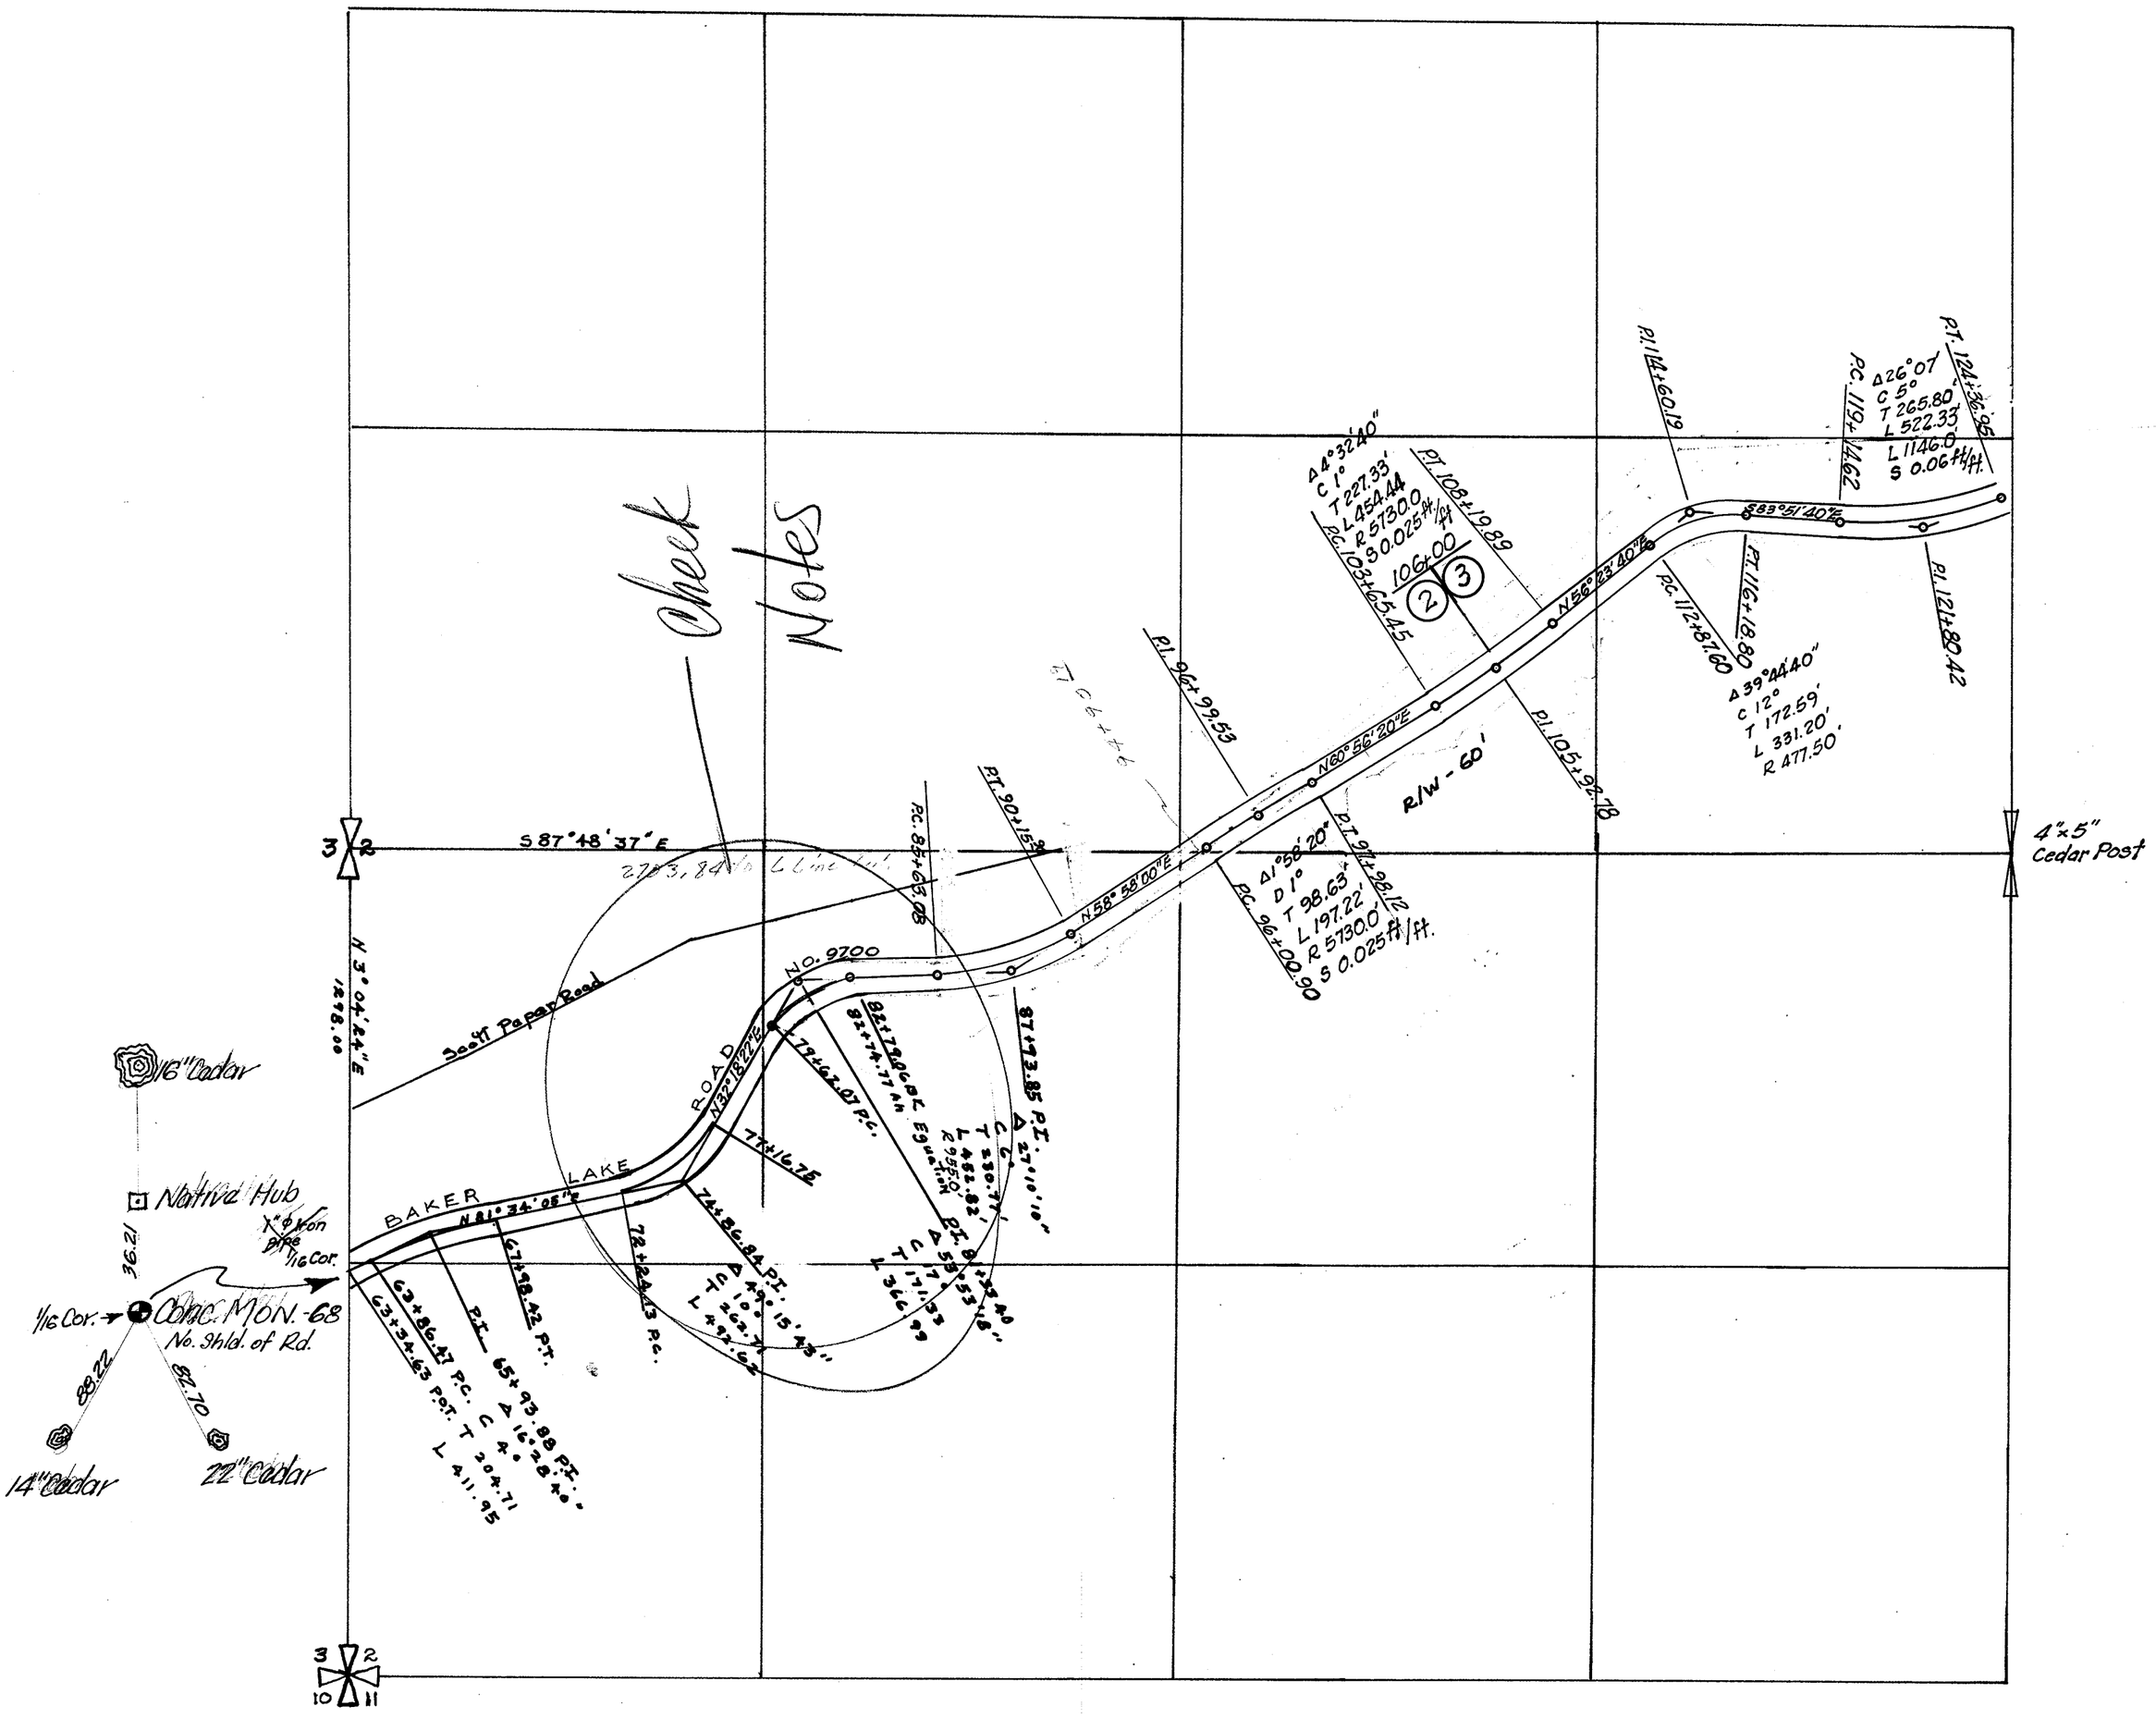

SECTION 8

TOWNSHIP 35 NORTH. RANGE 7 EAST. W. M.

SKAGIT COUNTY. WASH.

SCALE. 1 INCH--400 FEET
APRIL-1935
Pinelli Road Ext. Survey 35/276

R.E.L. Knapp COUNTY ENGINEER

Ref.
NE Cor
BT 30" D. Fir Stp.
N18°E 7.6'

B.T. Post.
N 11417.10
E 2089.90

2586.00
N. 3-52 E.

Stake
N. 8837.00
E 1915.25

N. 89-11 E 5514.46

Post. Iron Rod 1/16(?) N&W E&W &

Post & Iron Bar
N 8915.51
E 7429.16

2739.64
N. 6-01 W.

2631.10
N. 3-51 W.

N. 88-35 E. 2624.69

N. 87-57 E. 2641.04

B.T.s Post Iron Rod
N. 6131.22
E 2344.67

3 B.T.s Iron Bar Fence Cor.
N. 6790.36
E 7607.90

N. 2-10 W.

N. 6195.95
E 4968.55

Abd. Road

Top Hill

N.S. & E.B.R.R.Y.

35+52.2

Bat

N. 3-19-30 W

33+39.2

N. 26-30-30 E

28+87.6

R/W - 40'

Ex. N. 72-44-30 E Road

PINELLI (EXT.) ROAD NO. (328)
No. 9515

17+33.8

N. 46-57-30 E

14+21.4

N. 7-02-30 E

12+47.8

Post

Bearings based on ℄ G.H. Clark Road, as being N. 77-22 E.

0+00 = 80+81.0. S.M. No. 7.

SECTION 10


TOWNSHIP 35 NORTH, RANGE 7 EAST, W. M.

SKAGIT COUNTY, WASH.

SCALE, 1 INCH--400 FEET

DATE March 22, 1966

Lloyd Johnson COUNTY ENGINEER

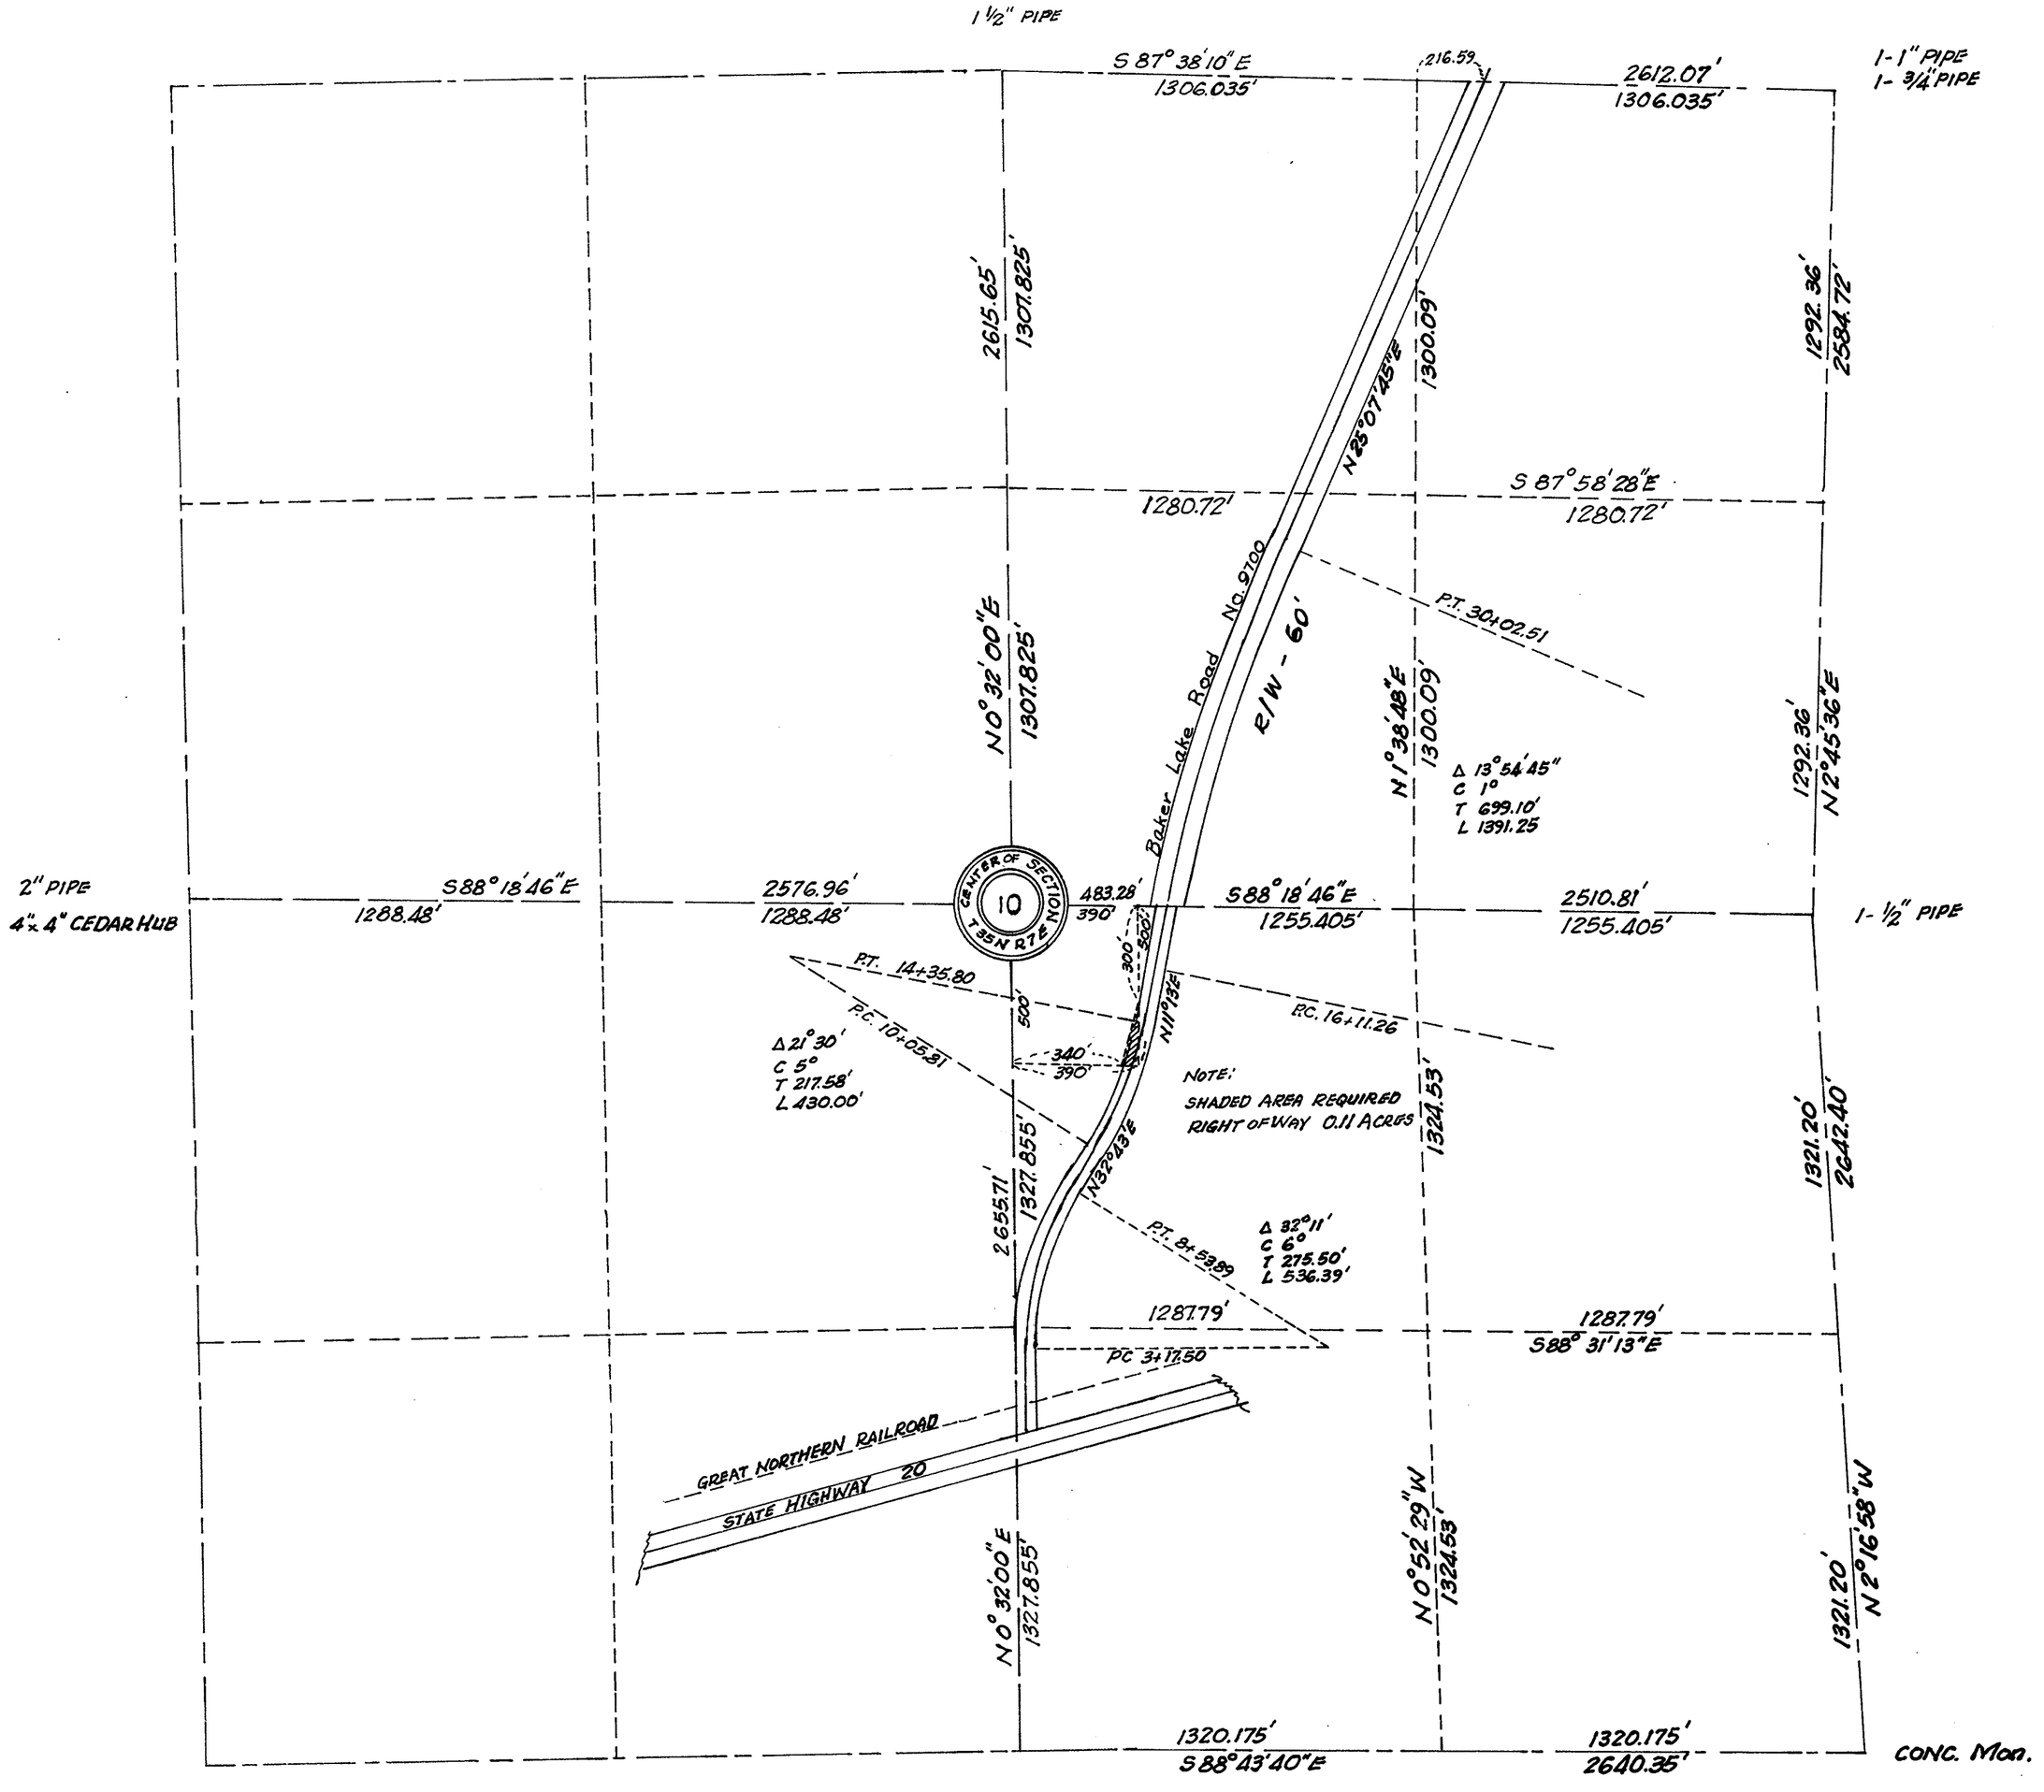

SECTION 11


TOWNSHIP 35 NORTH, RANGE 7 EAST, W. M.

SKAGIT COUNTY, WASH.

SCALE, 1 INCH--400 FEET

DATE Aug. 15, 1963

Lloyd Johnson COUNTY ENGINEER

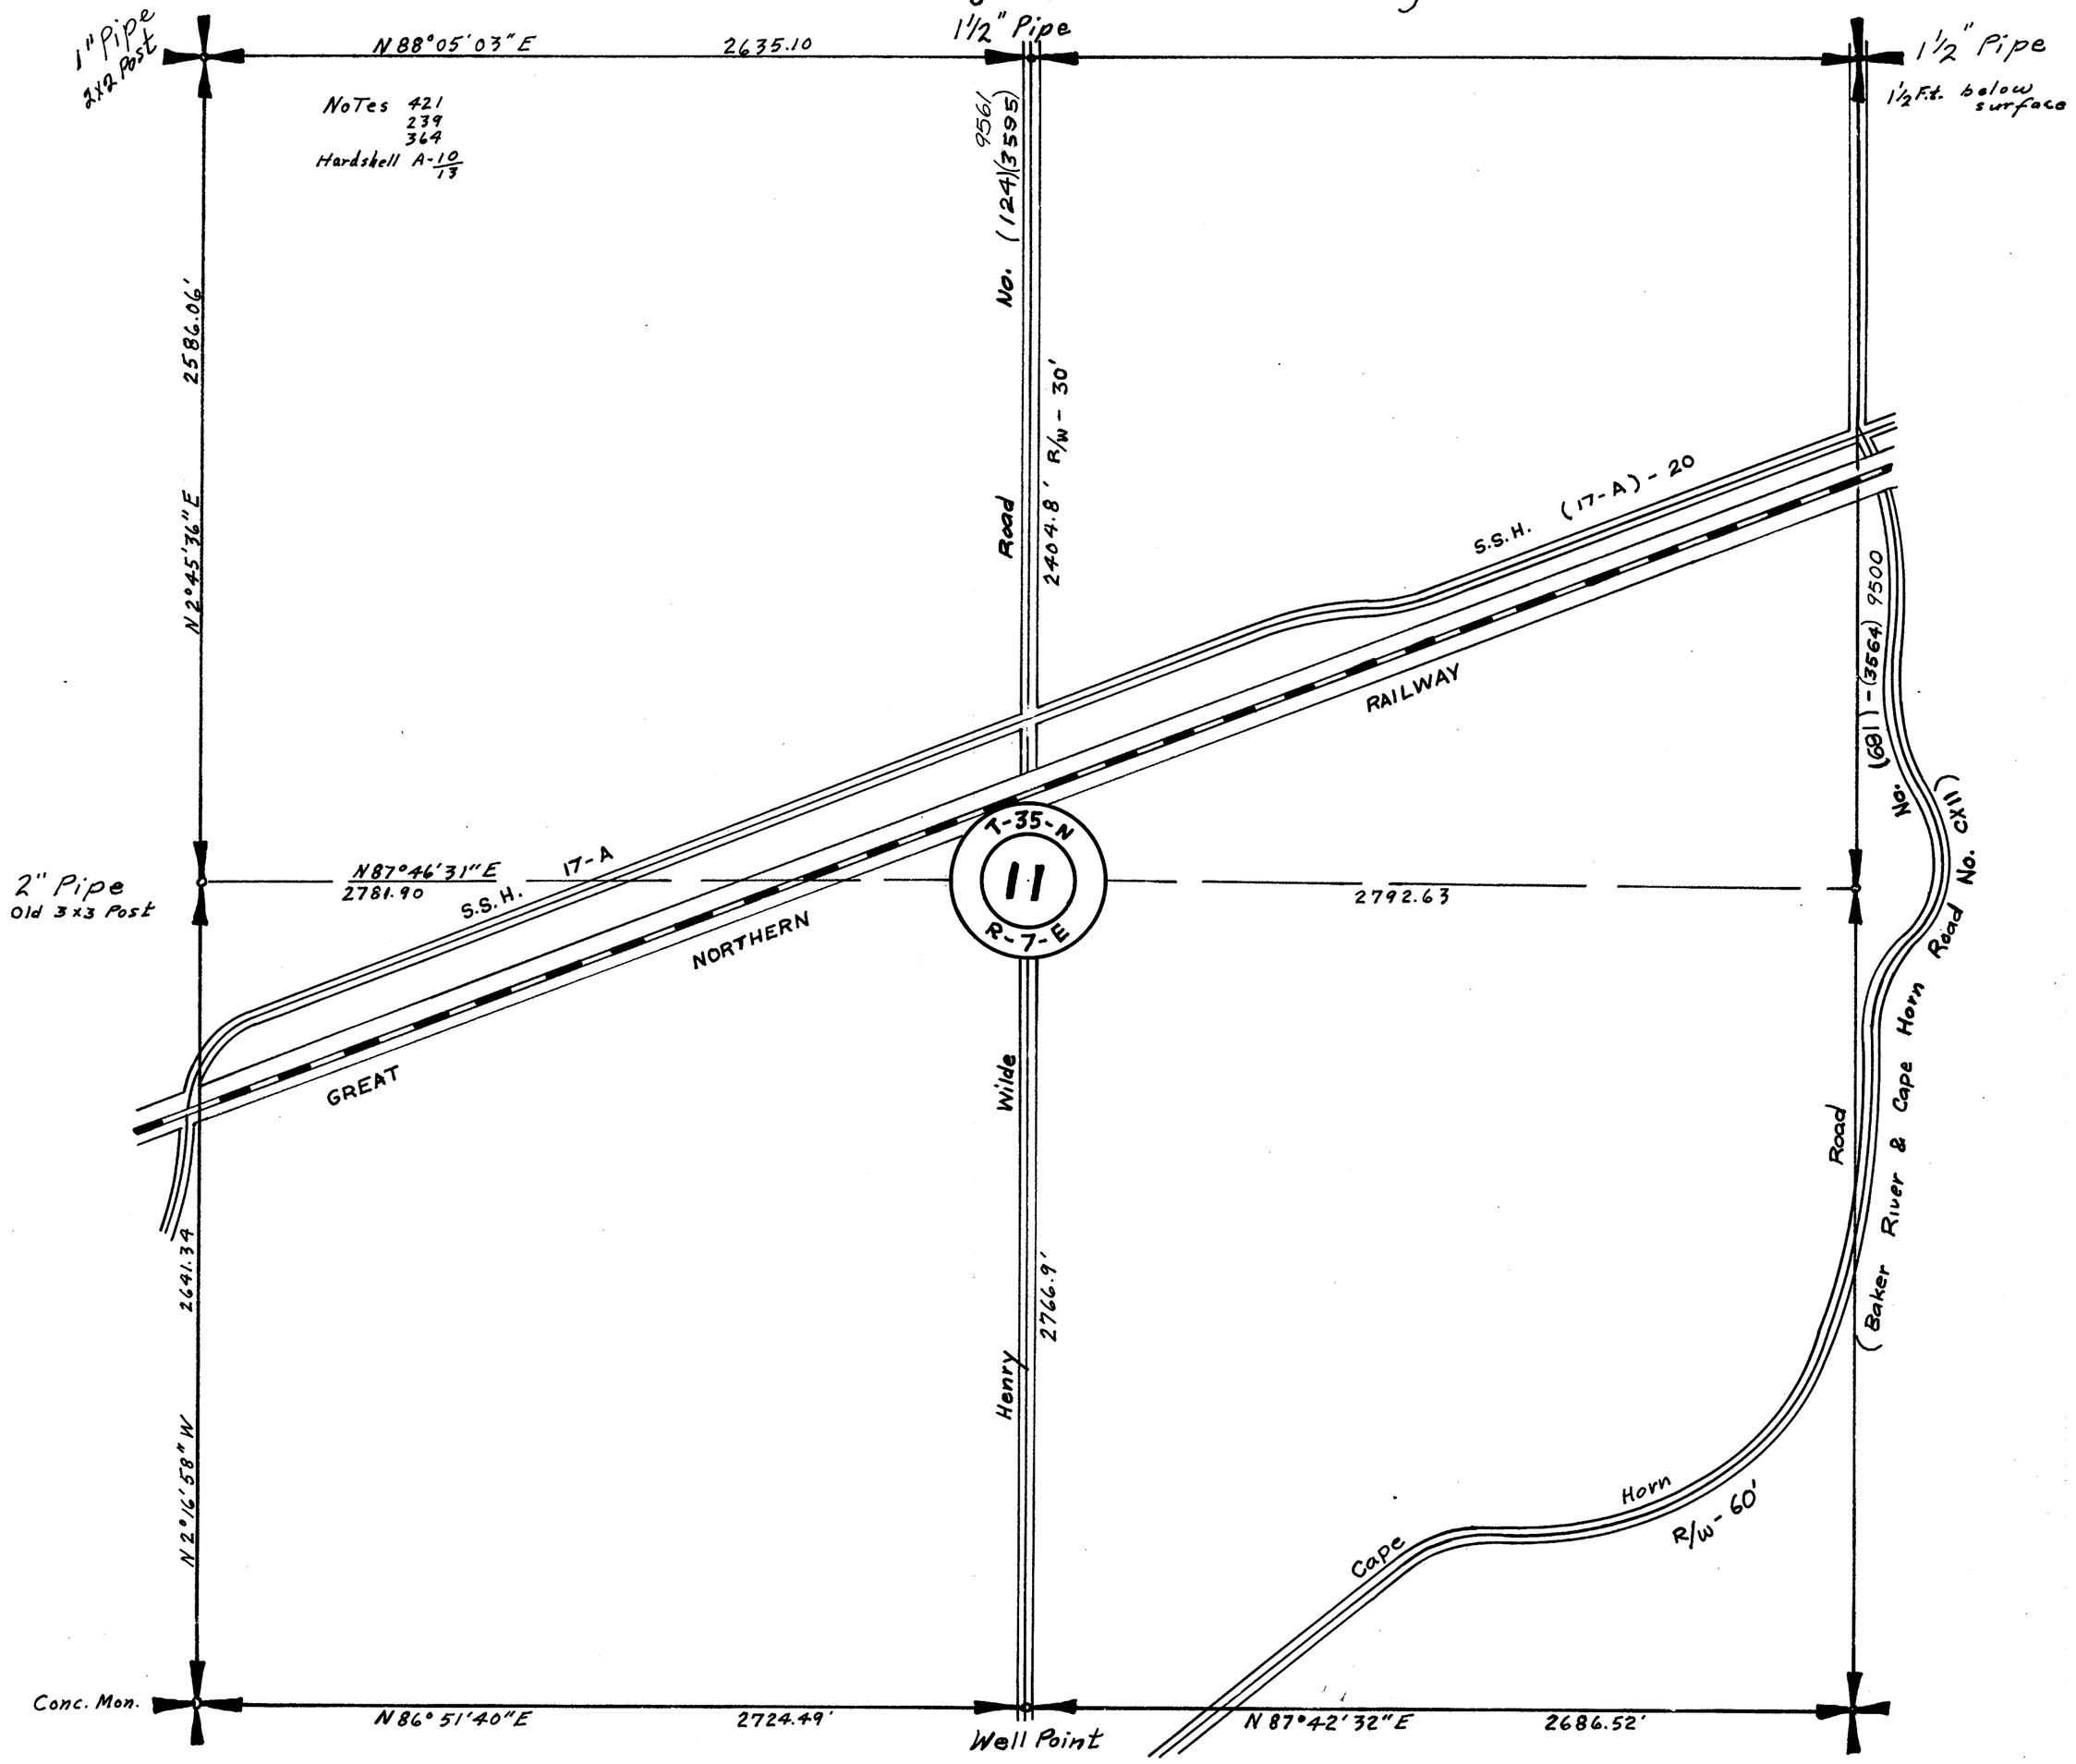

SECTION 12



SKAGIT COUNTY, WASH.

SCALE, 1 INCH - - 400 FEET

DATE Aug. 24, 1966

Lloyd Johnson COUNTY ENGINEER

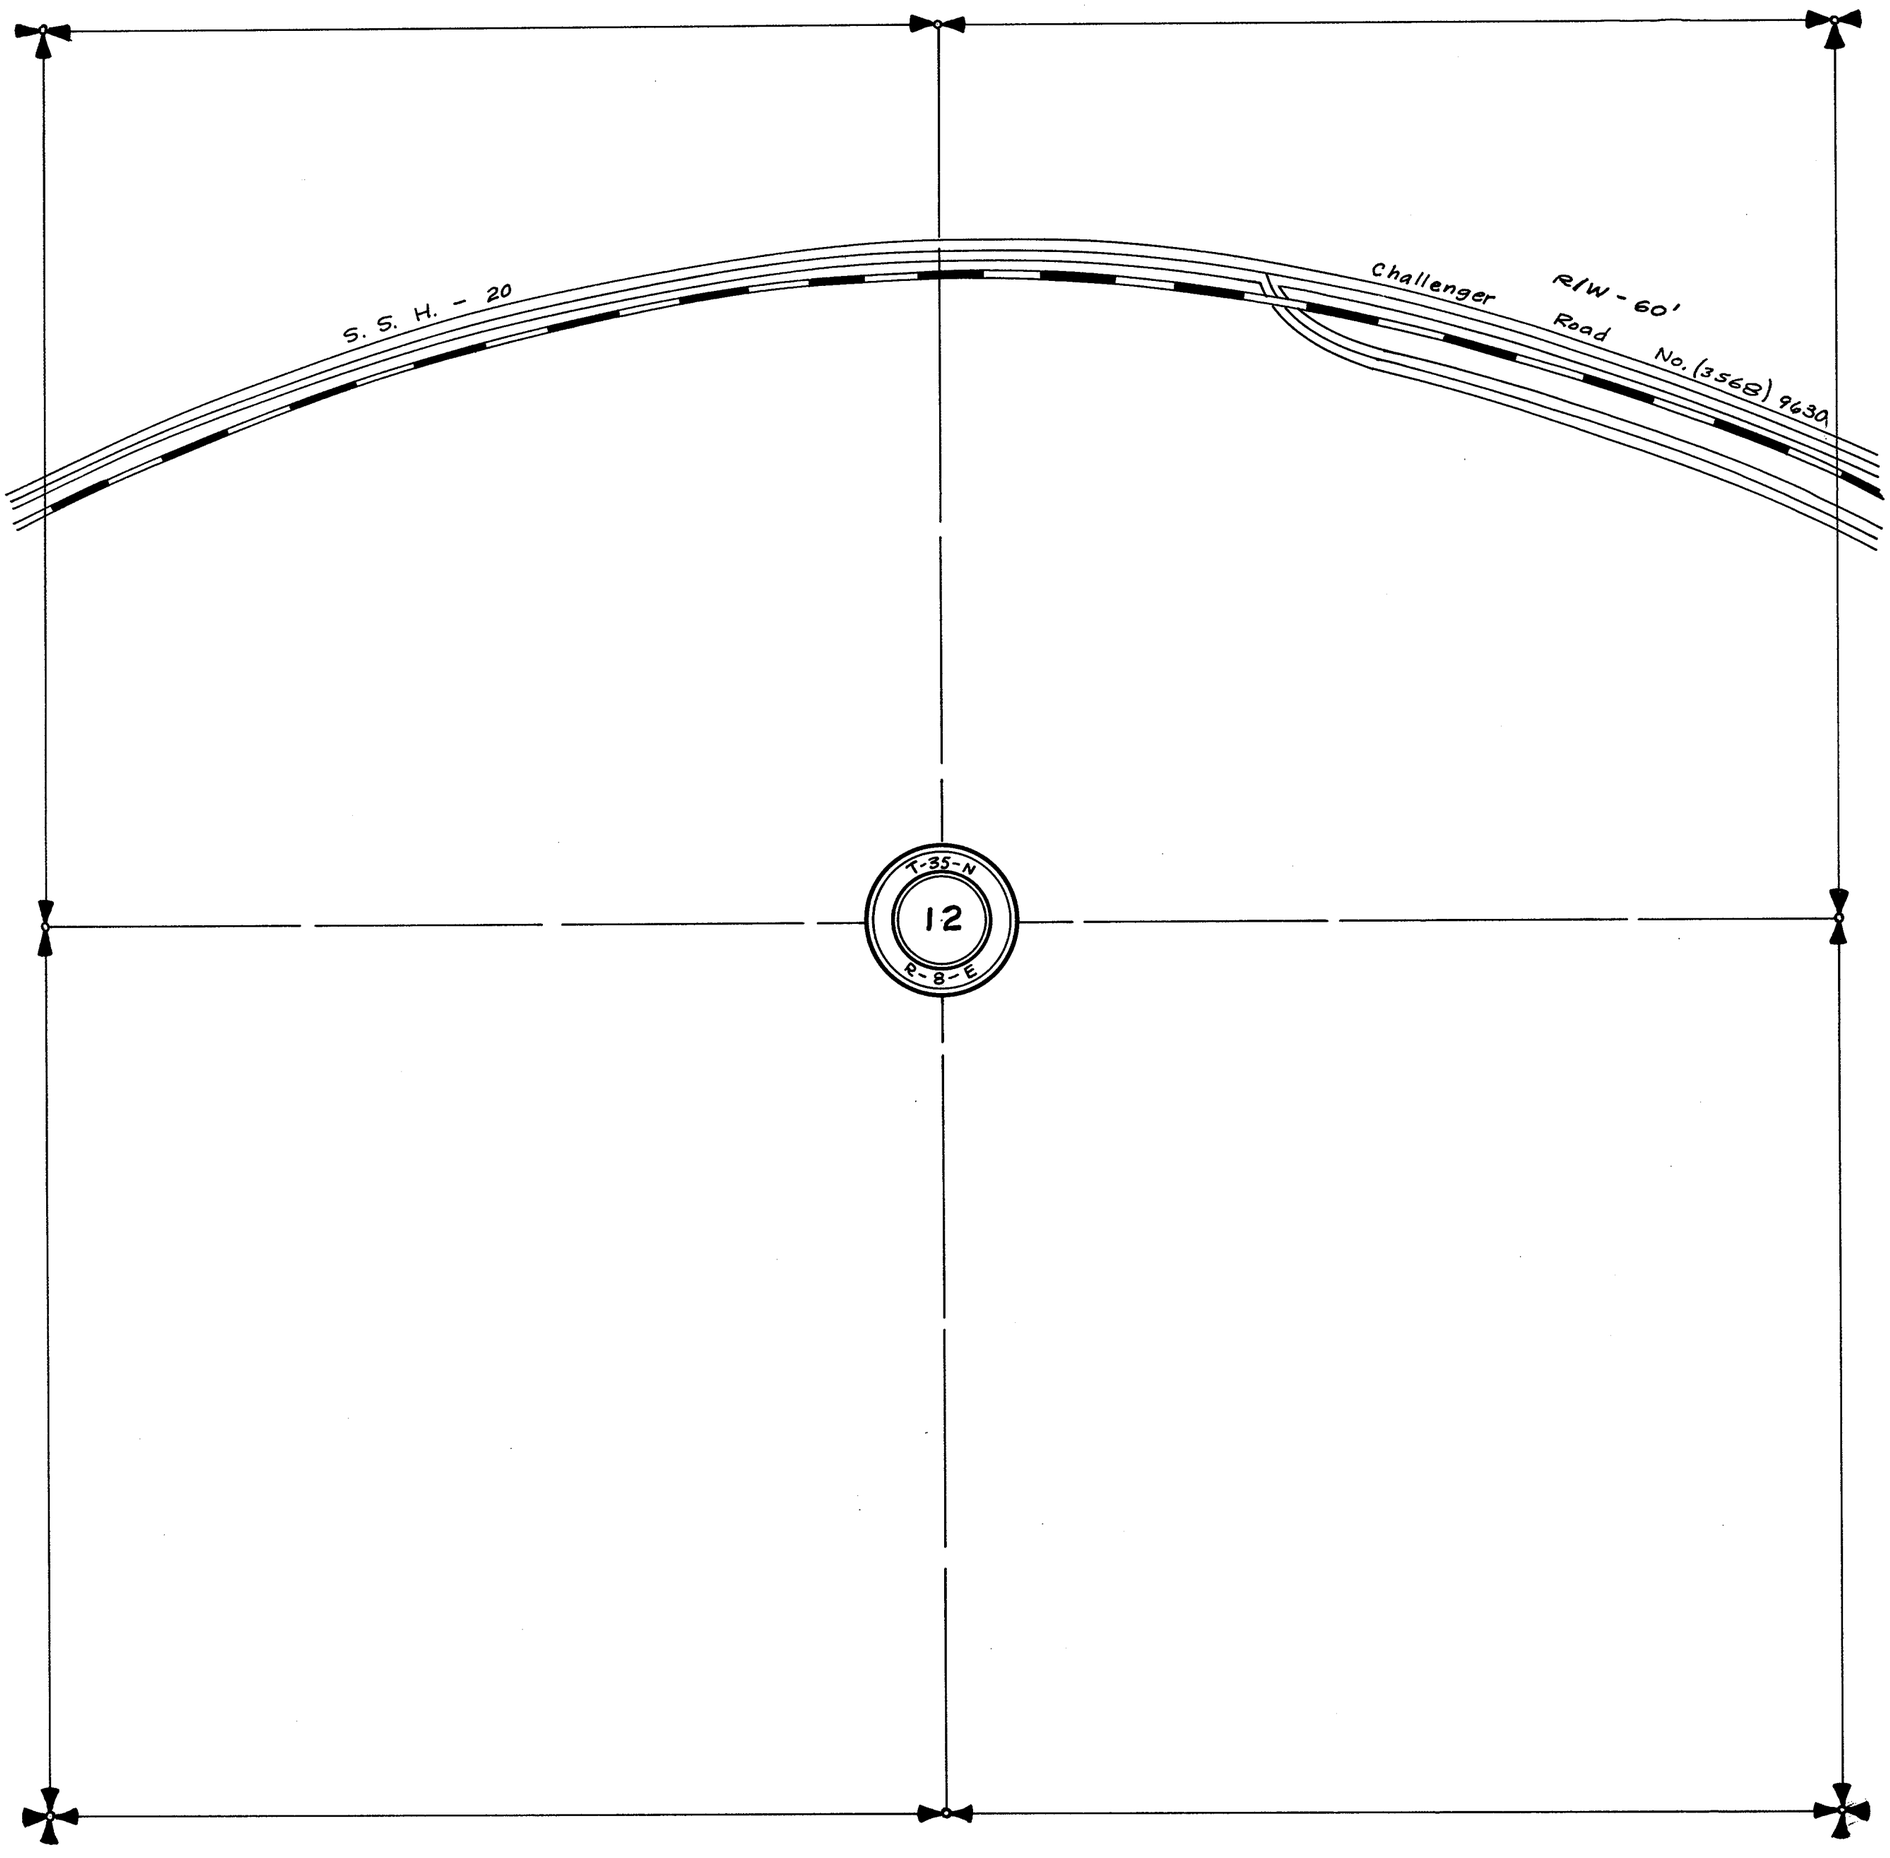


SECTION 13

Compiled from G193
W.C.W. 7-31-41

TOWNSHIP 35 NORTH, RANGE 7 EAST, W. M.
SKAGIT COUNTY, WASH.

SCALE, 1 INCH--400 FEET

H.O. WALBERG COUNTY ENGINEER

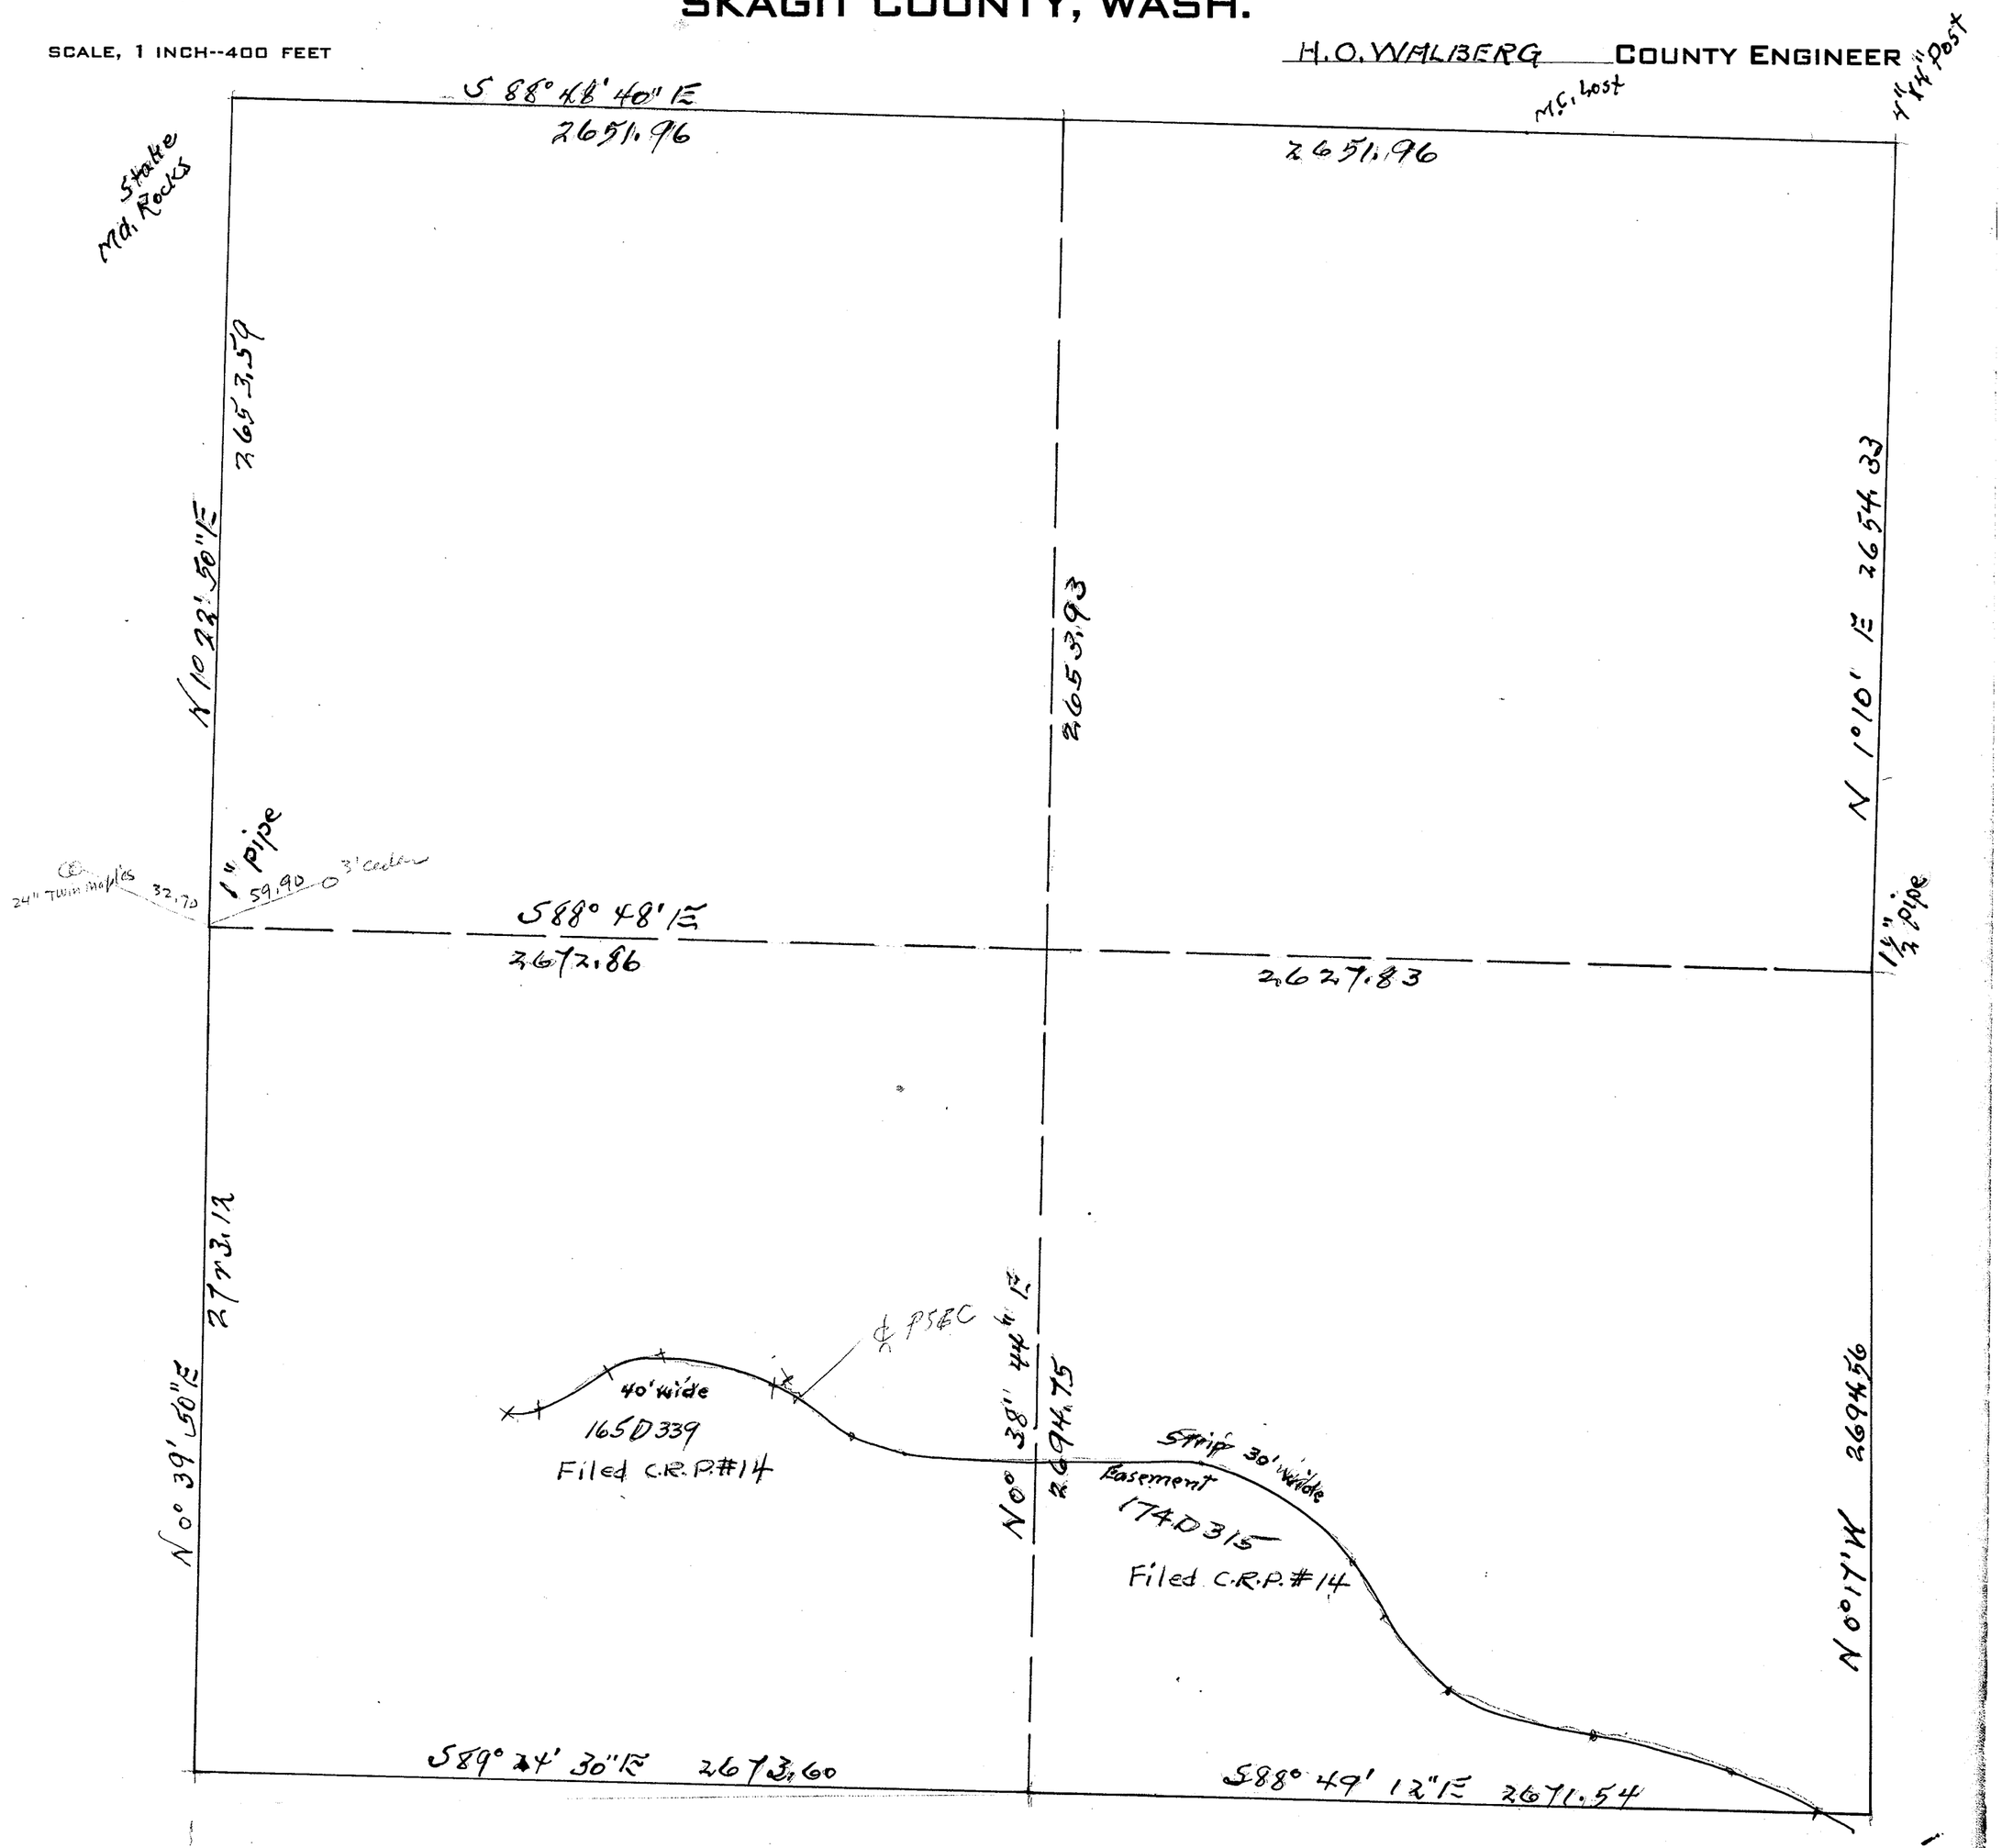


SECTION 13

TOWNSHIP 35 NORTH. RANGE 7 EAST. W. M.

SKAGIT COUNTY. WASH.

SCALE, 1 INCH–400 FEET

Robt. E. L. Knapp COUNTY ENGINEER
May 1932

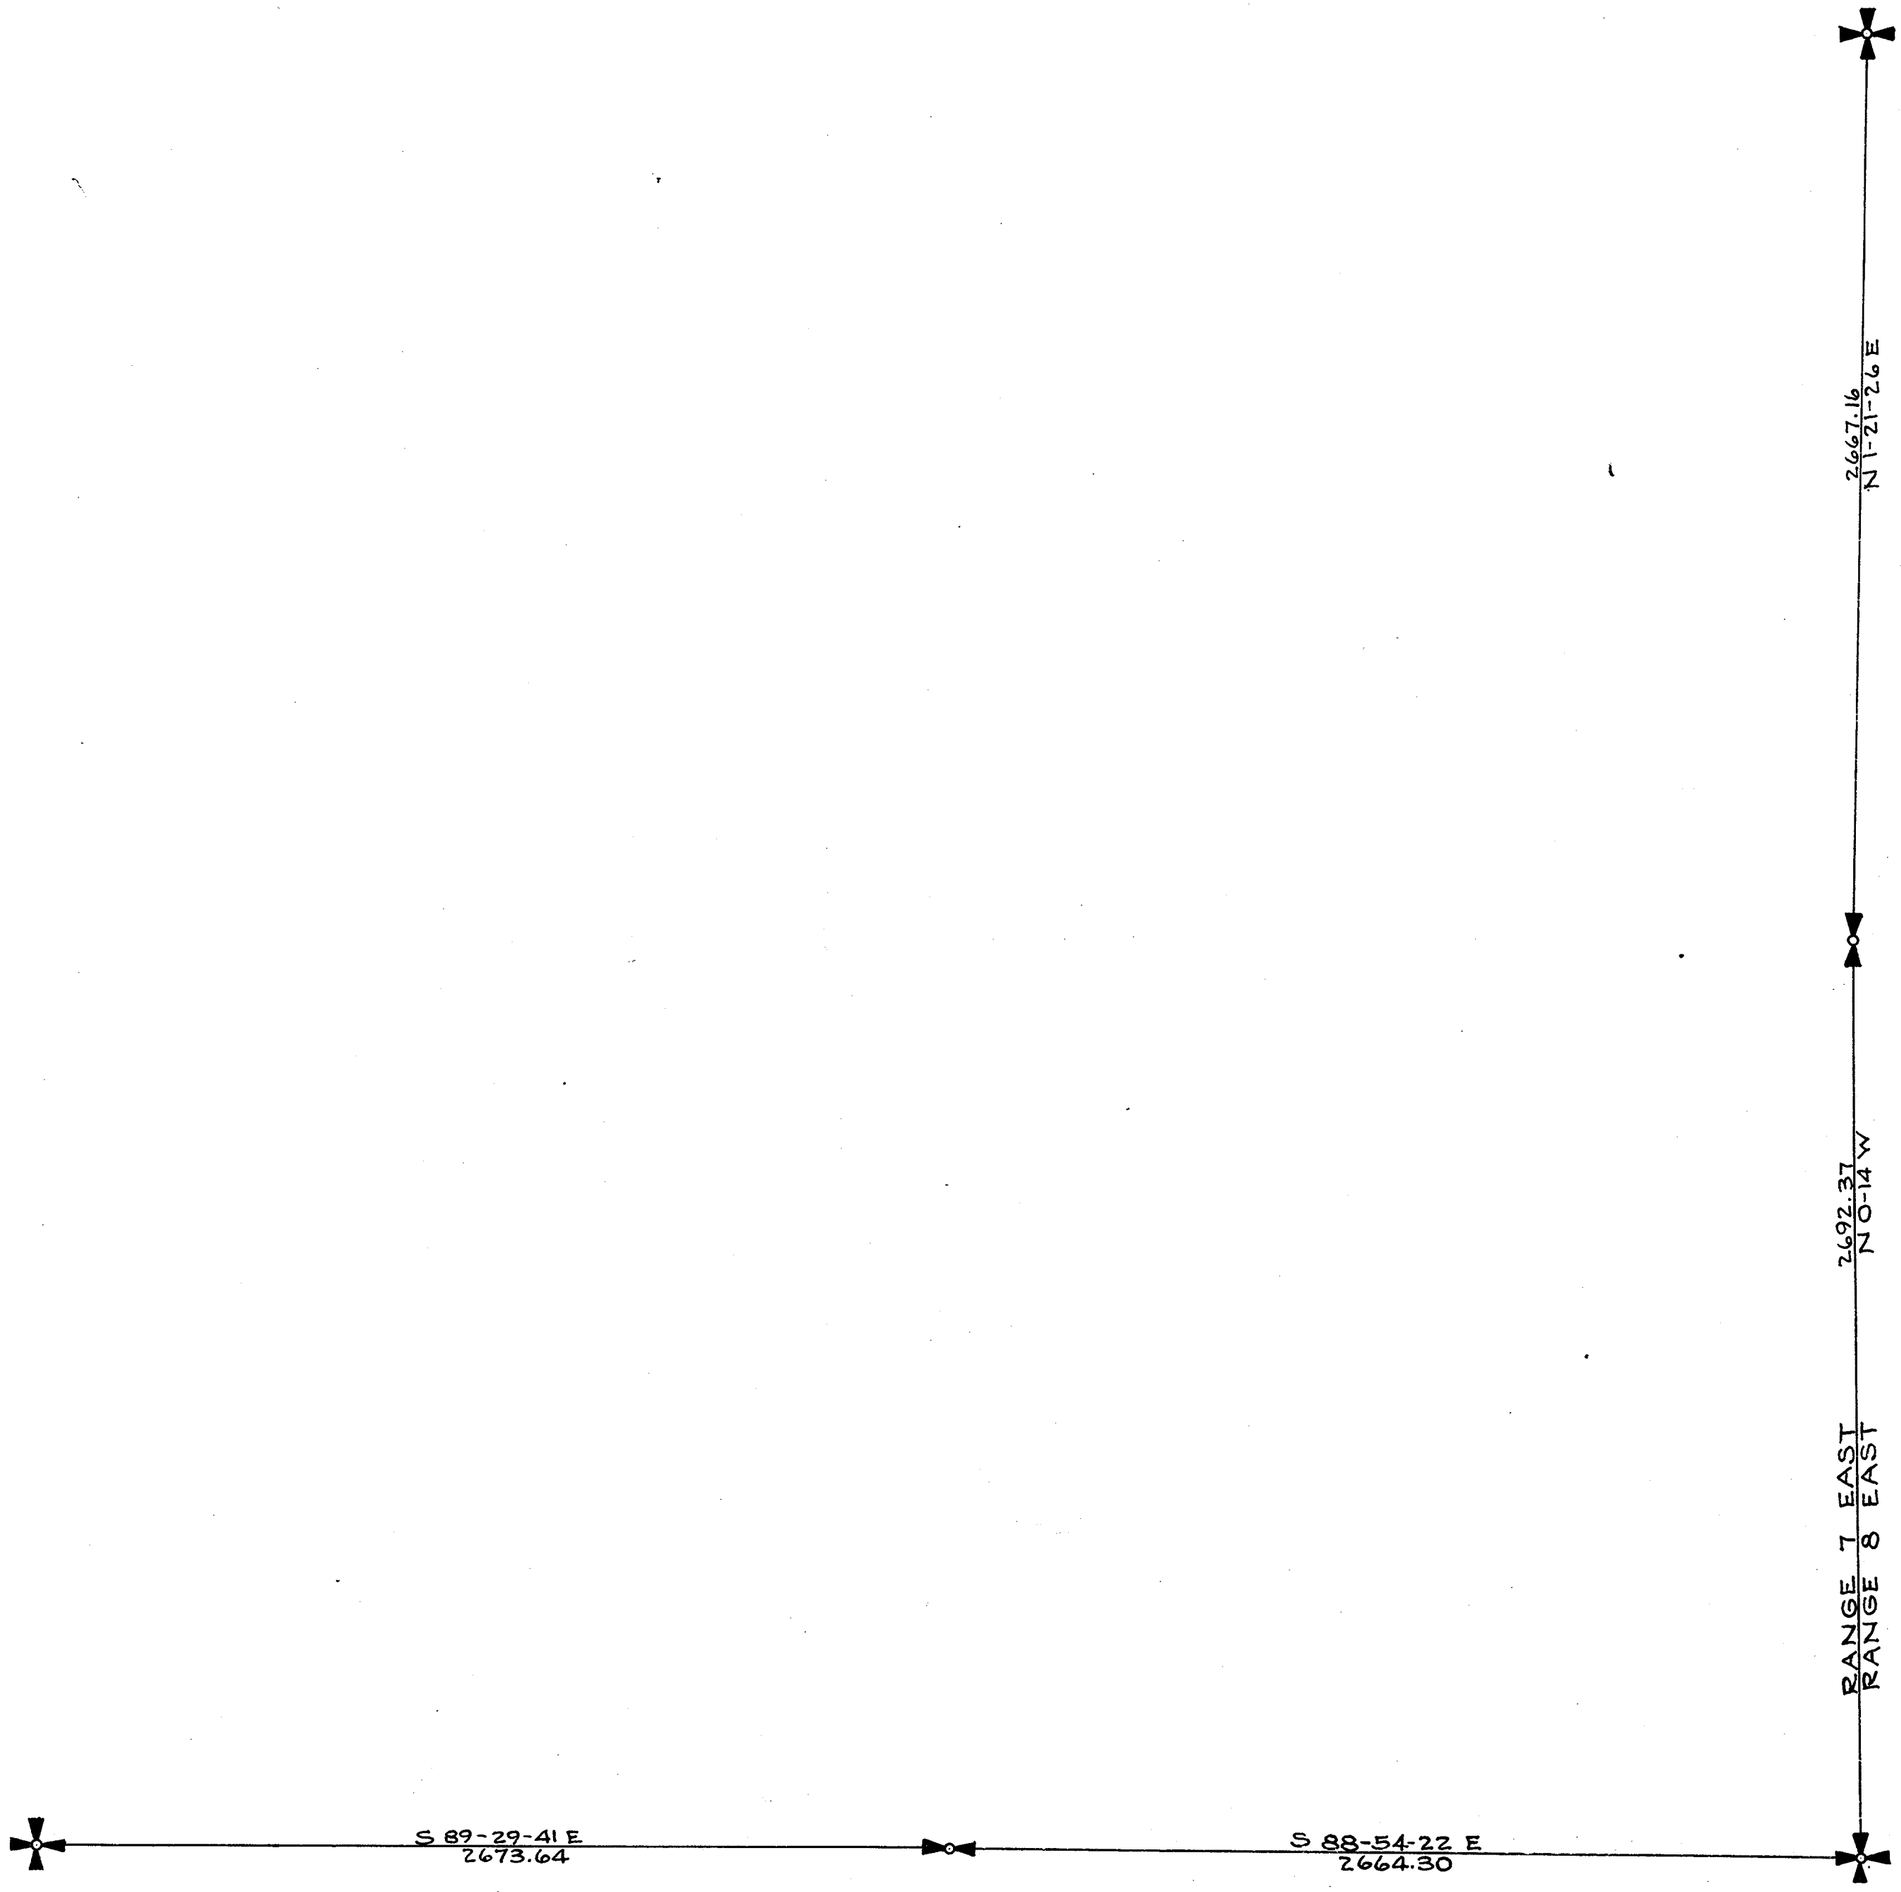

SECTION 13


TOWNSHIP 35 NORTH, RANGE 7 EAST, W. M.

SKAGIT COUNTY, WASH.

SCALE, 1 INCH -- 400 FEET

DATE Aug. 24, 1966

Lloyd Johnson COUNTY ENGINEER

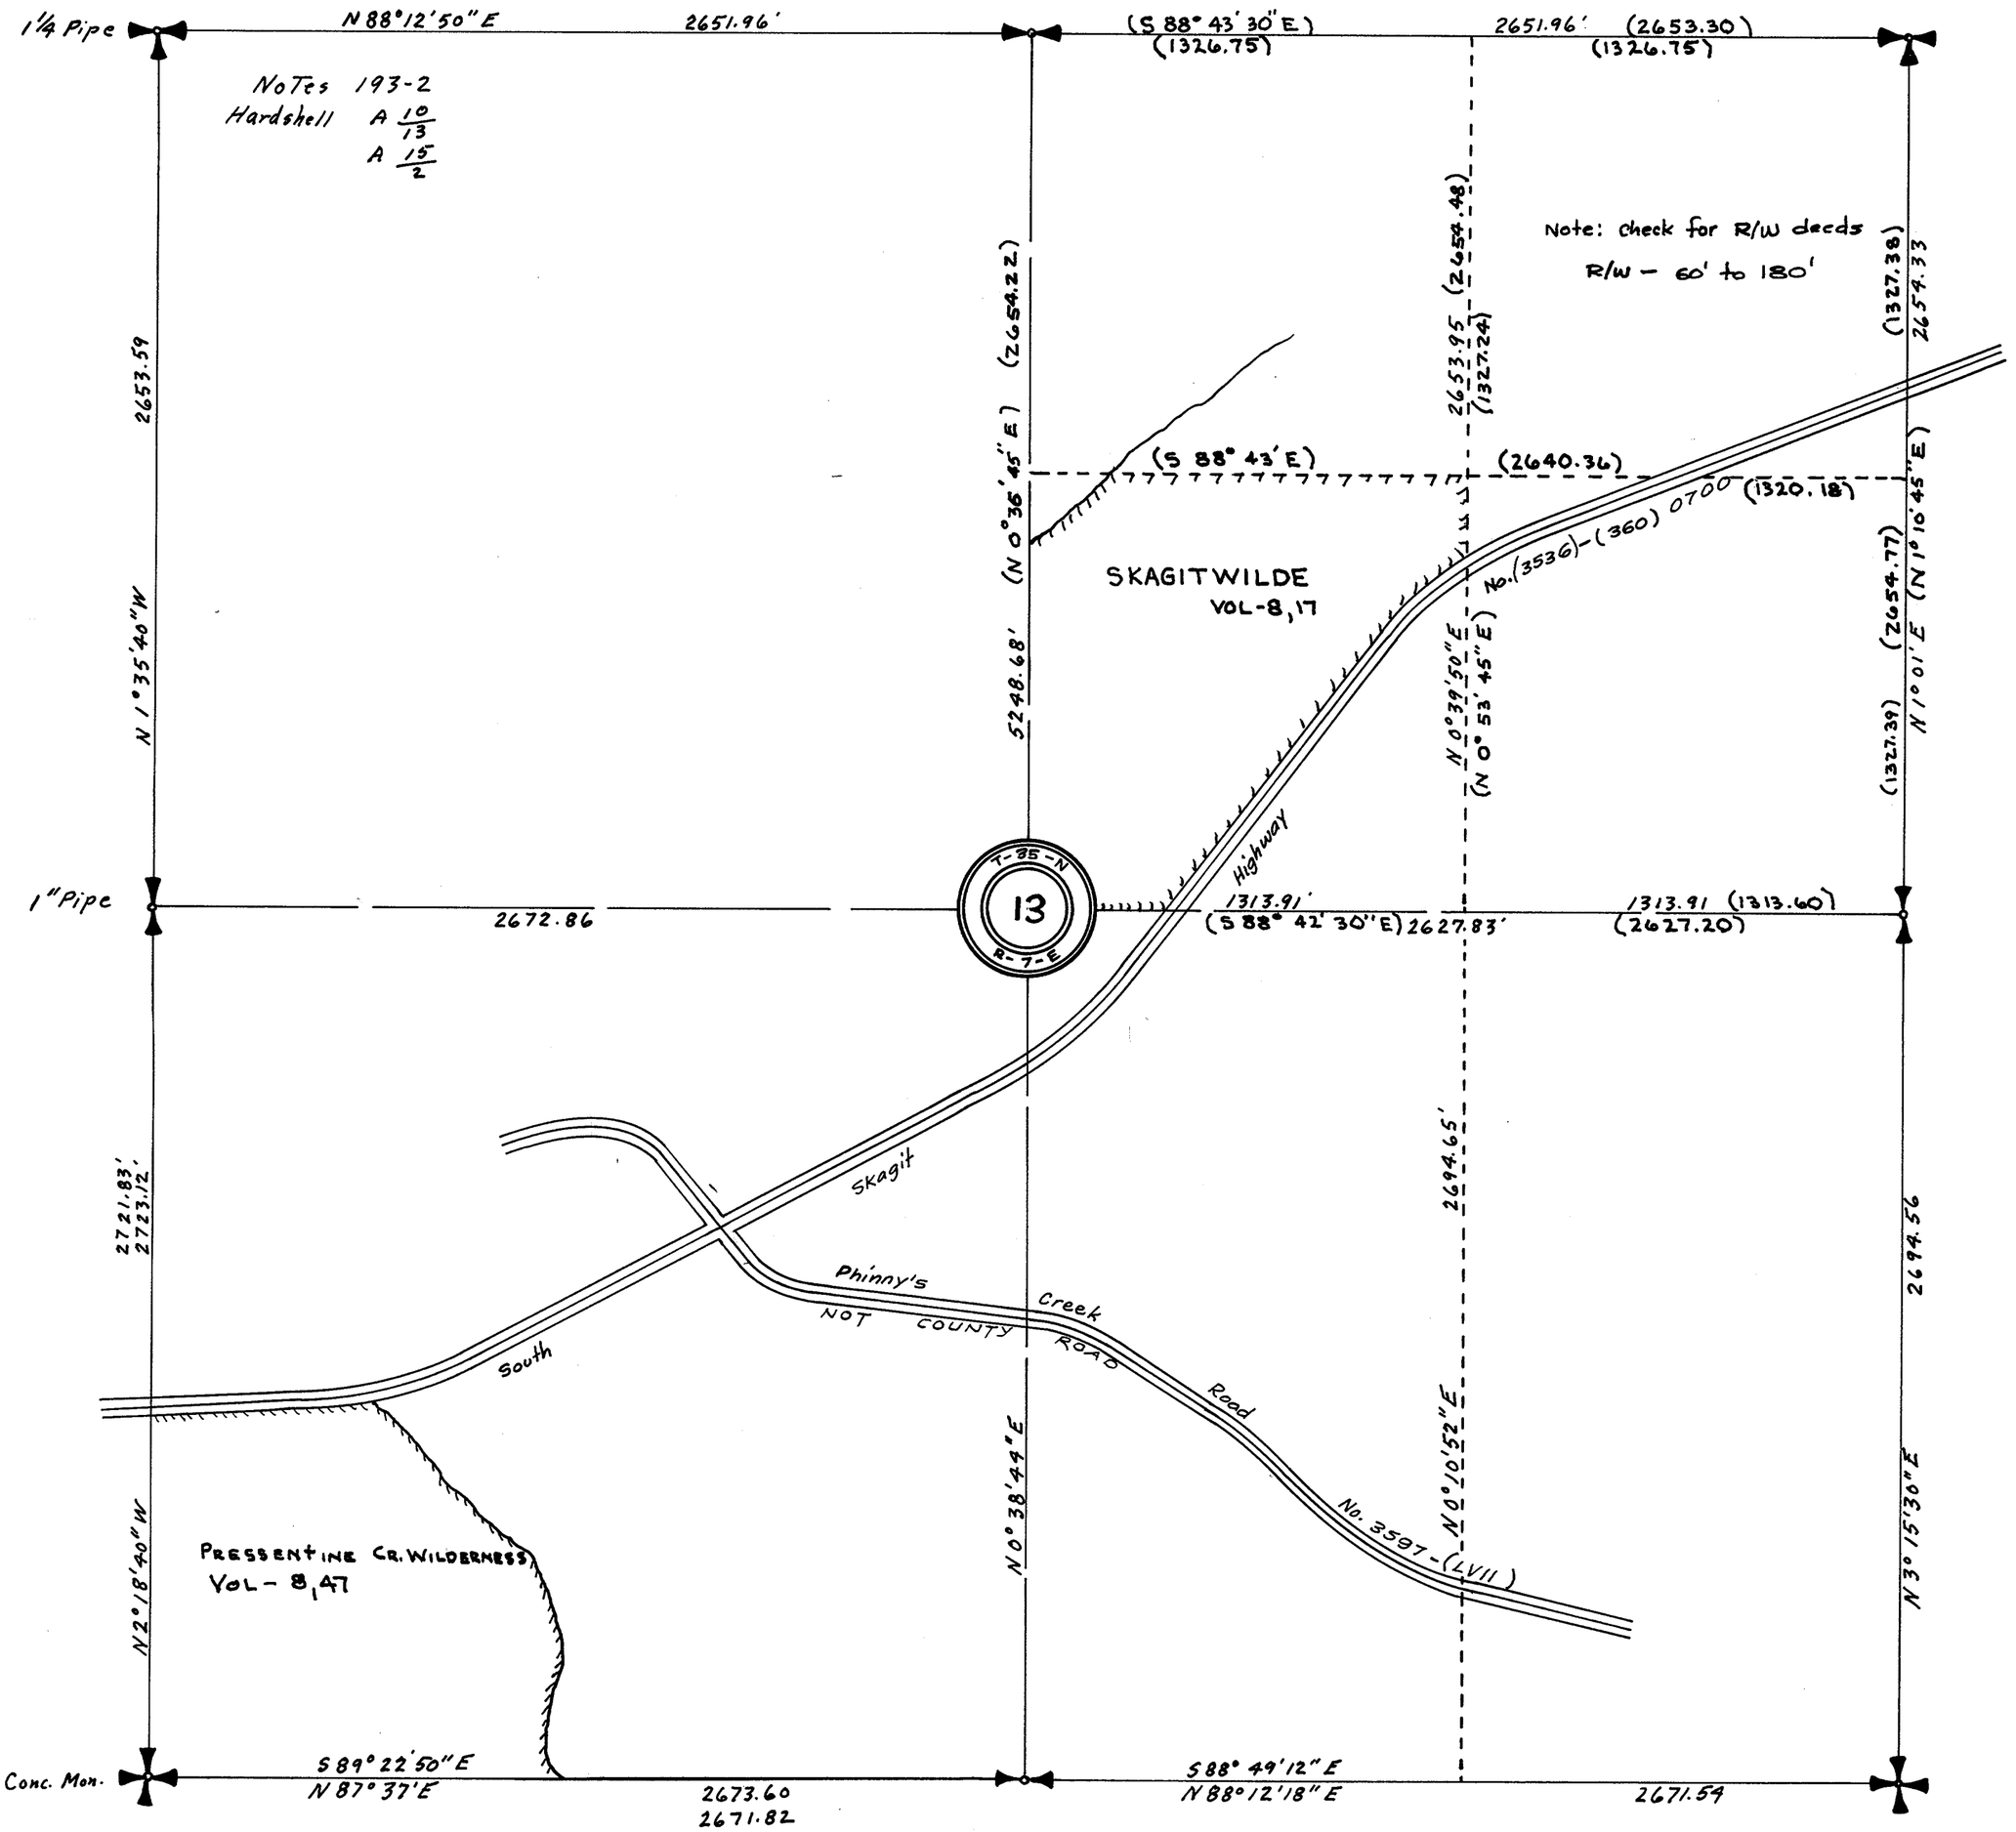


A15
2

SECTION 13
TOWNSHIP 35 NORTH, RANGE 7 EAST, W. M.
SKAGIT COUNTY, WASH.

SCALE, 1 INCH--400 FEET

DATE 1969

COUNTY ENGINEER

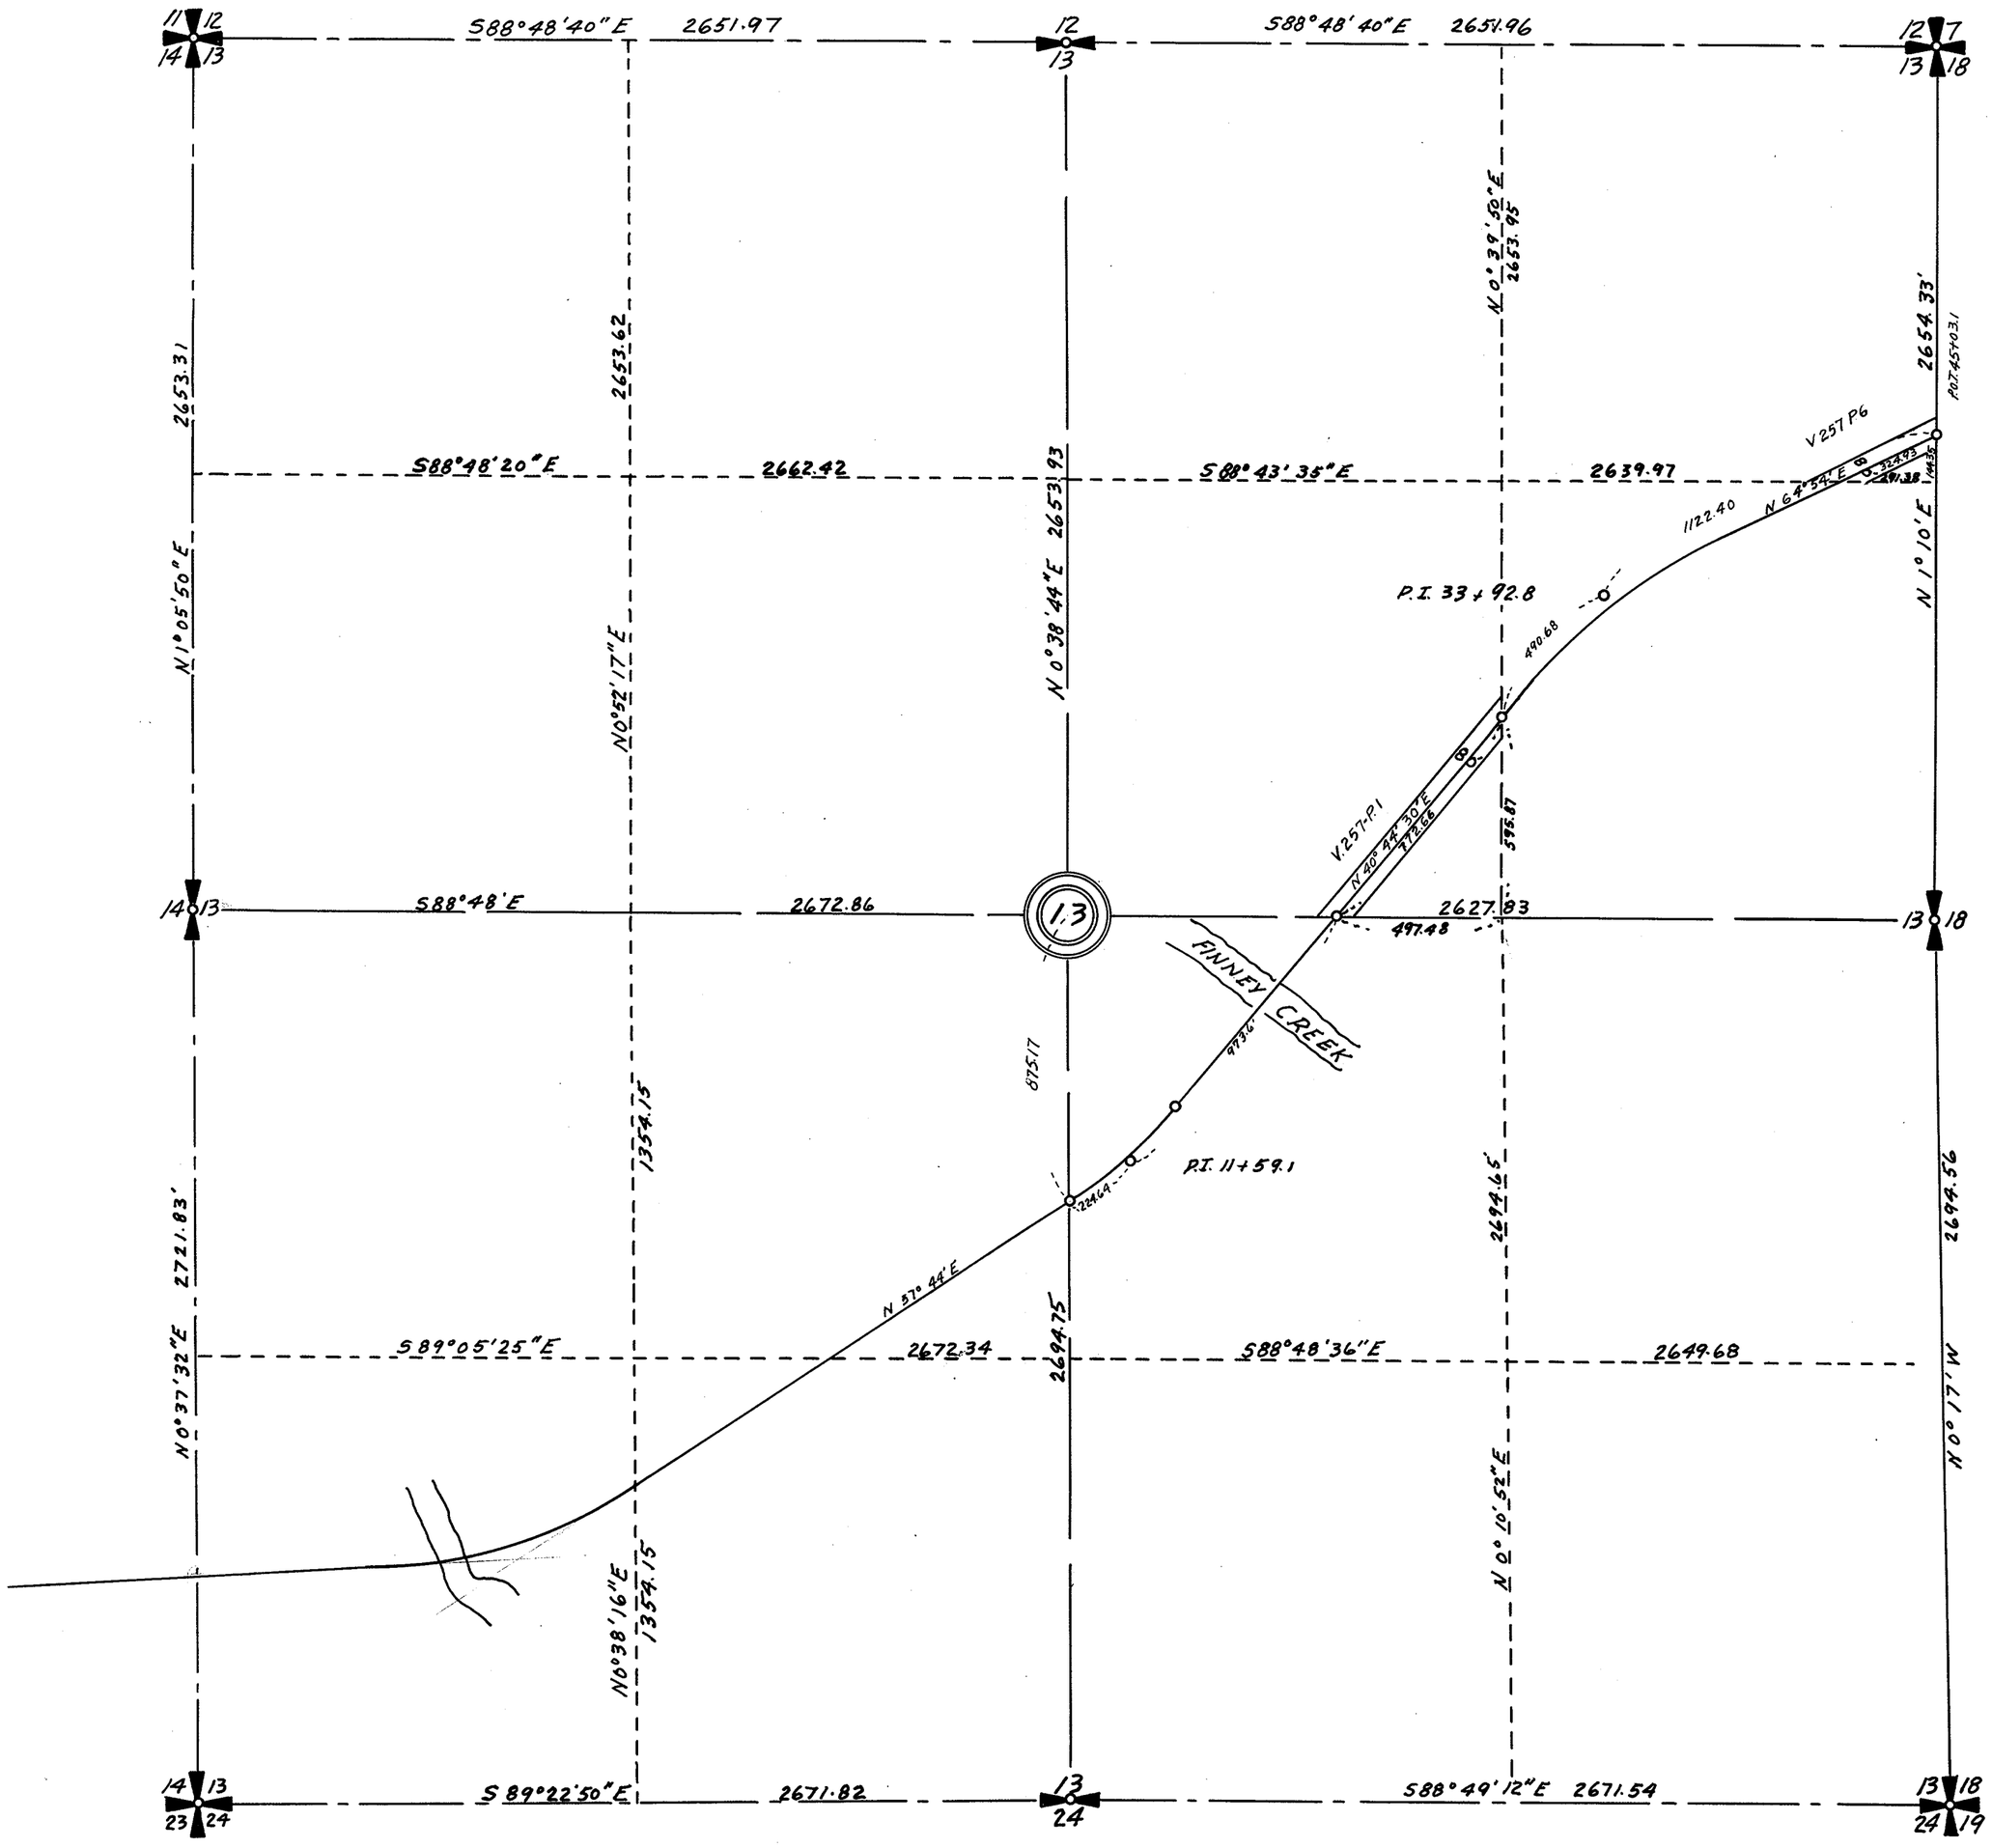



TOWNSHIP 35 NORTH, RANGE 7 EAST, W. M.

SKAGIT COUNTY, WASH.

SCALE, 1 INCH--400 FEET

DATE Aug. 14, 1963

COUNTY ENGINEER

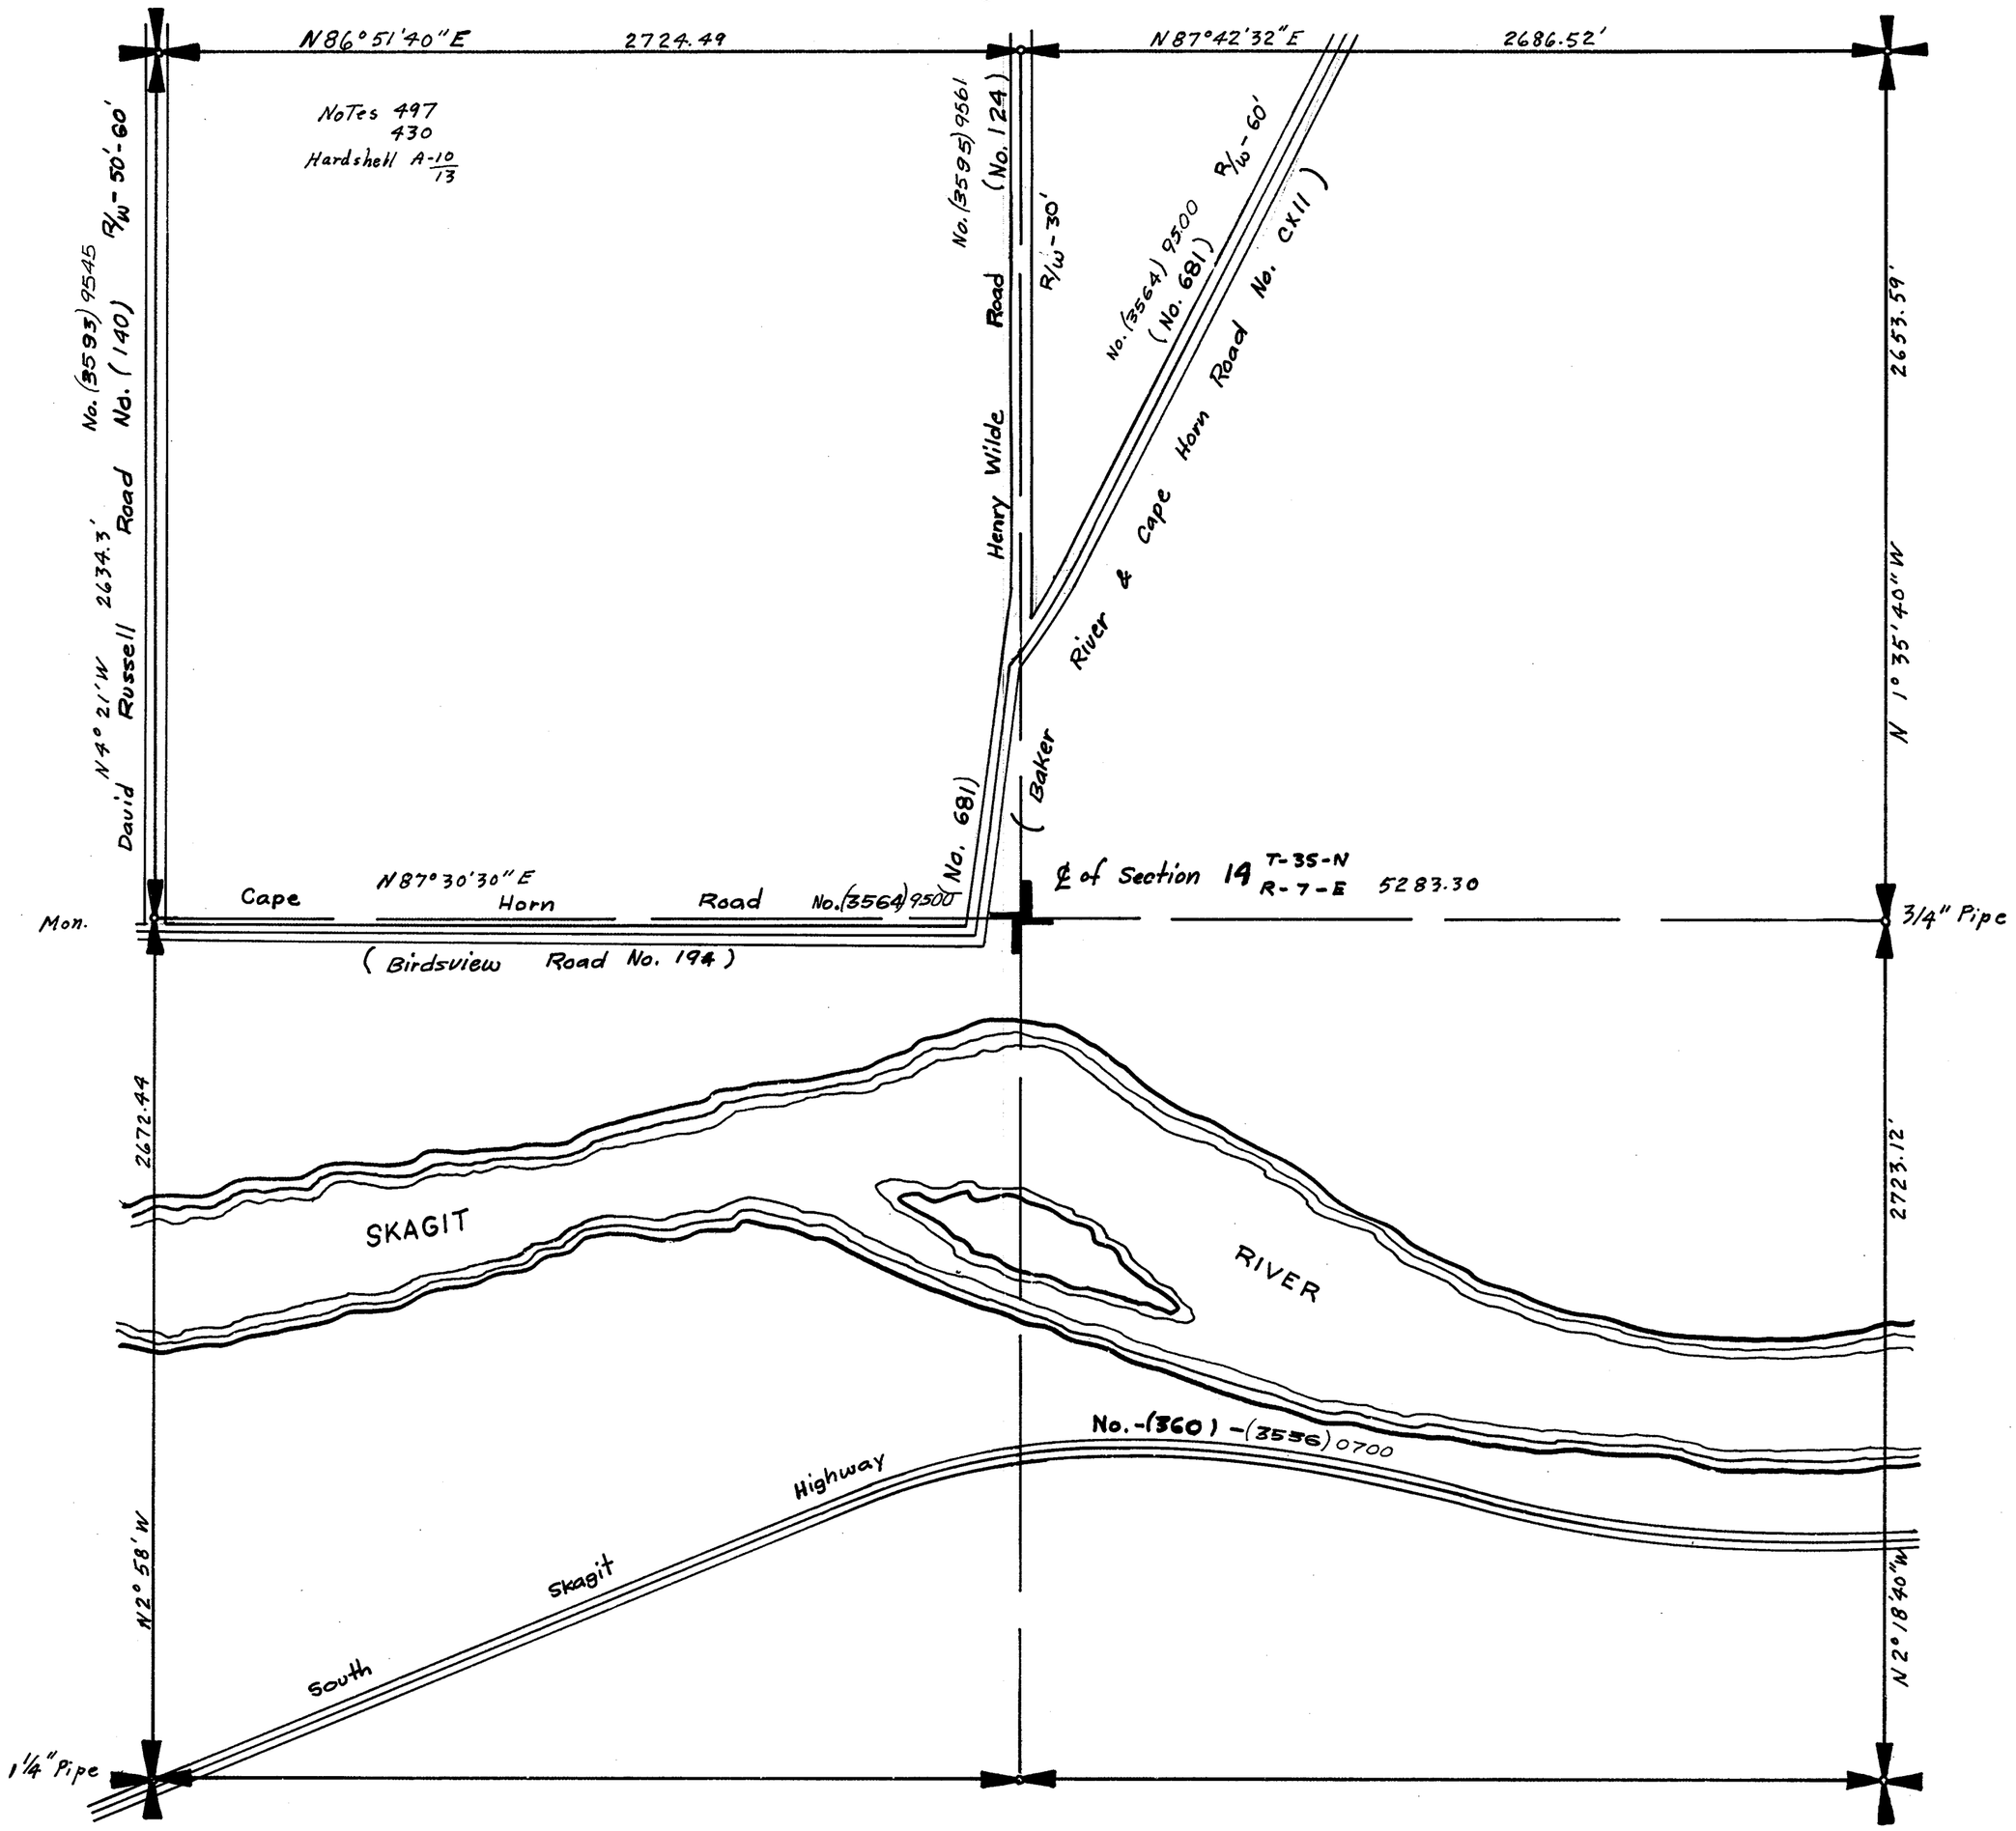

SECTION 15


TOWNSHIP 35 NORTH. RANGE 7 EAST. W. M.

SKAGIT COUNTY. WASH.

SCALE. 1 INCH—400 FEET

LLOYD H. JOHNSON COUNTY ENGINEER

DATE SEPT. 5, 1972

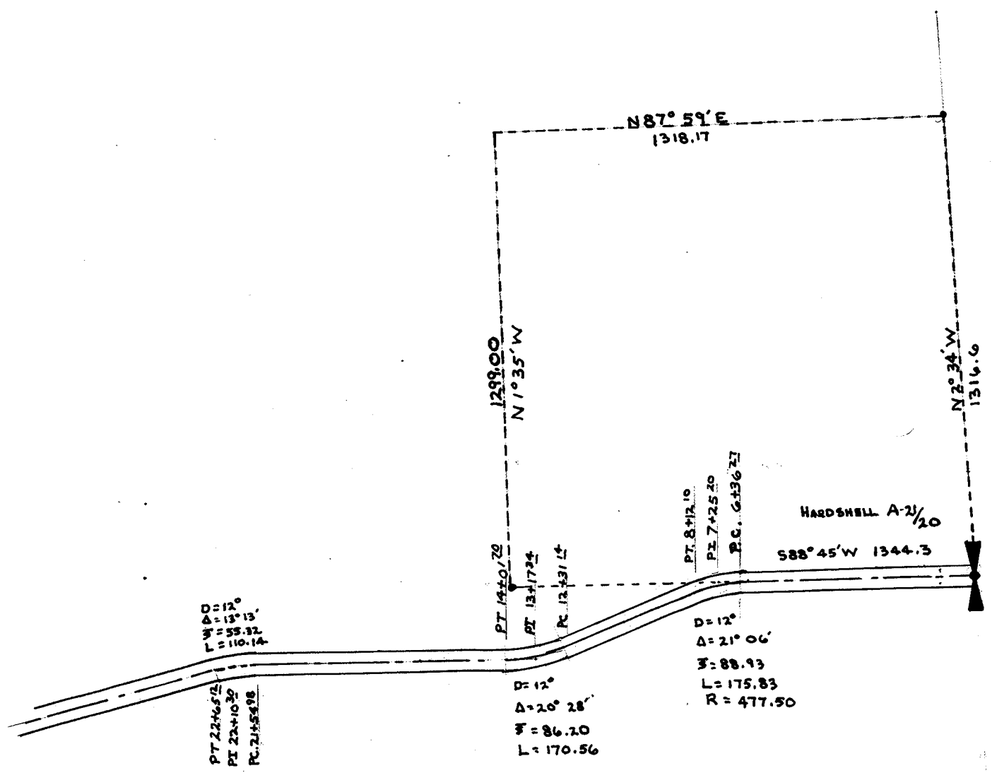


SECTION 15
TOWNSHIP 35 NORTH, RANGE 7 EAST, W. M.
SKAGIT COUNTY, WASH.

SCALE, 1 INCH--400 FEET

DATE Aug. 14, 1963

COUNTY ENGINEER

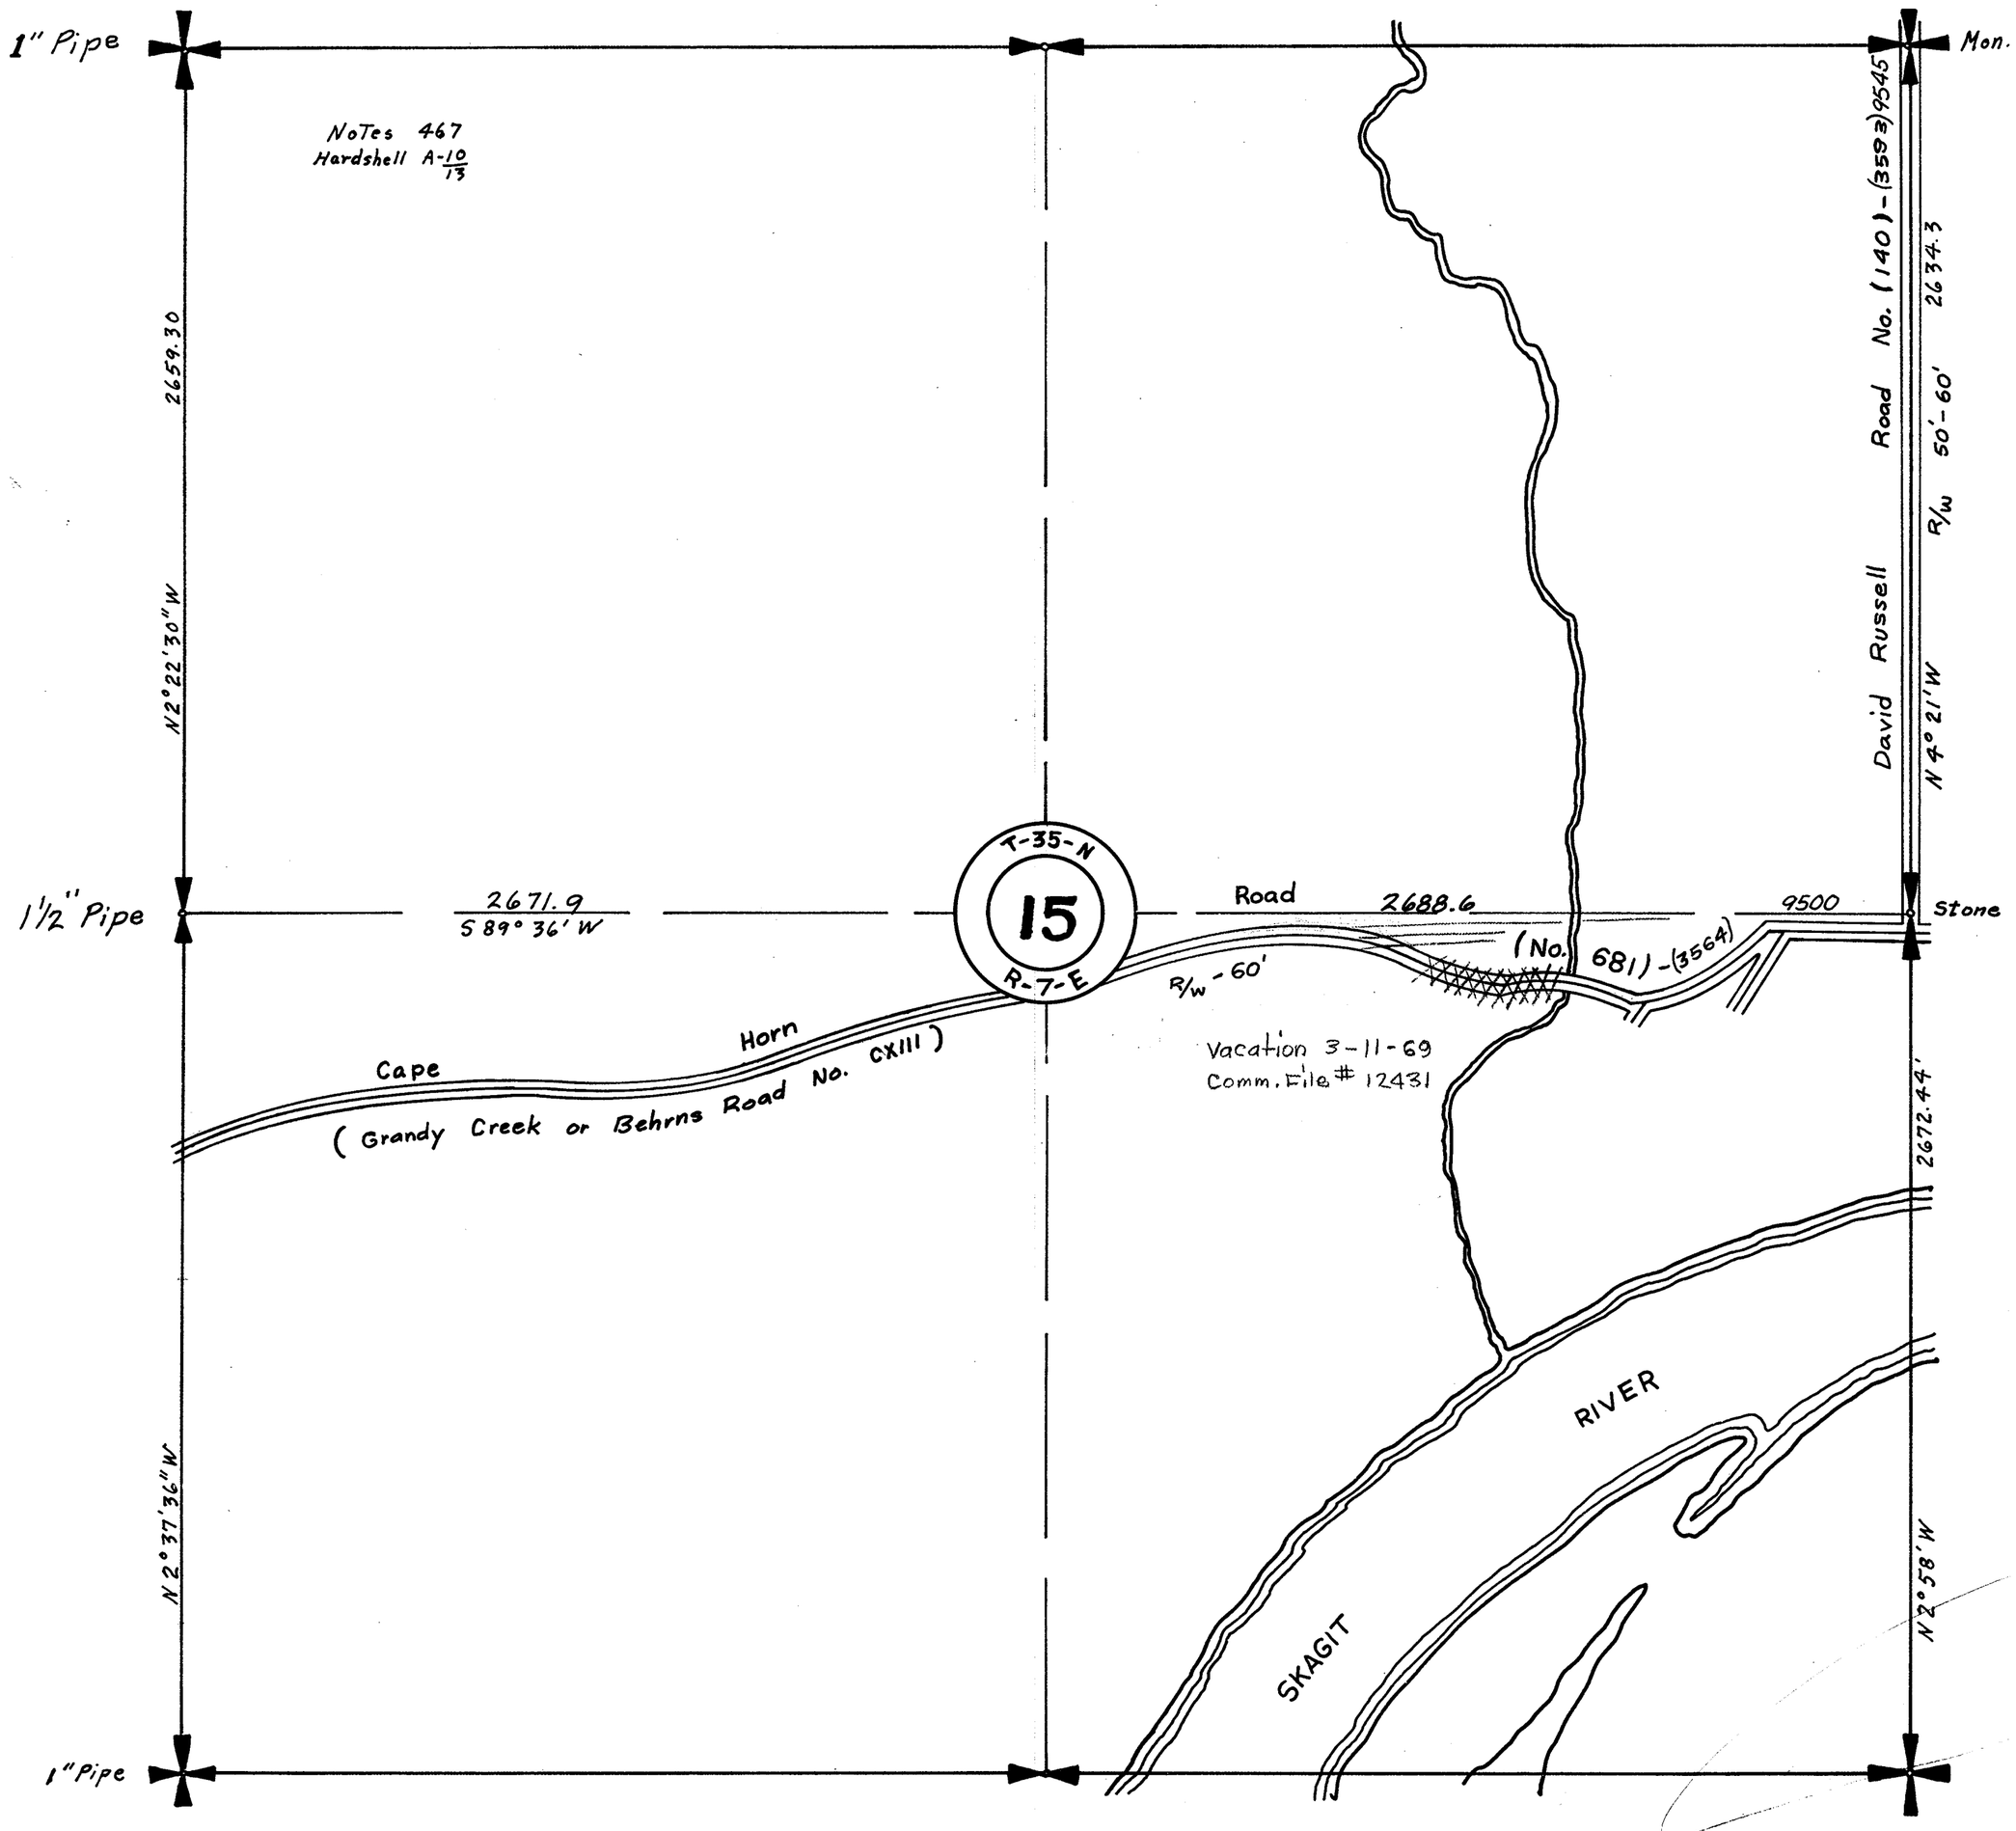

SECTION 16


TOWNSHIP 35 NORTH, RANGE 7 EAST, W. M.

SKAGIT COUNTY, WASH.

SCALE, 1 INCH--400 FEET

DATE Aug. 14, 1963

COUNTY ENGINEER

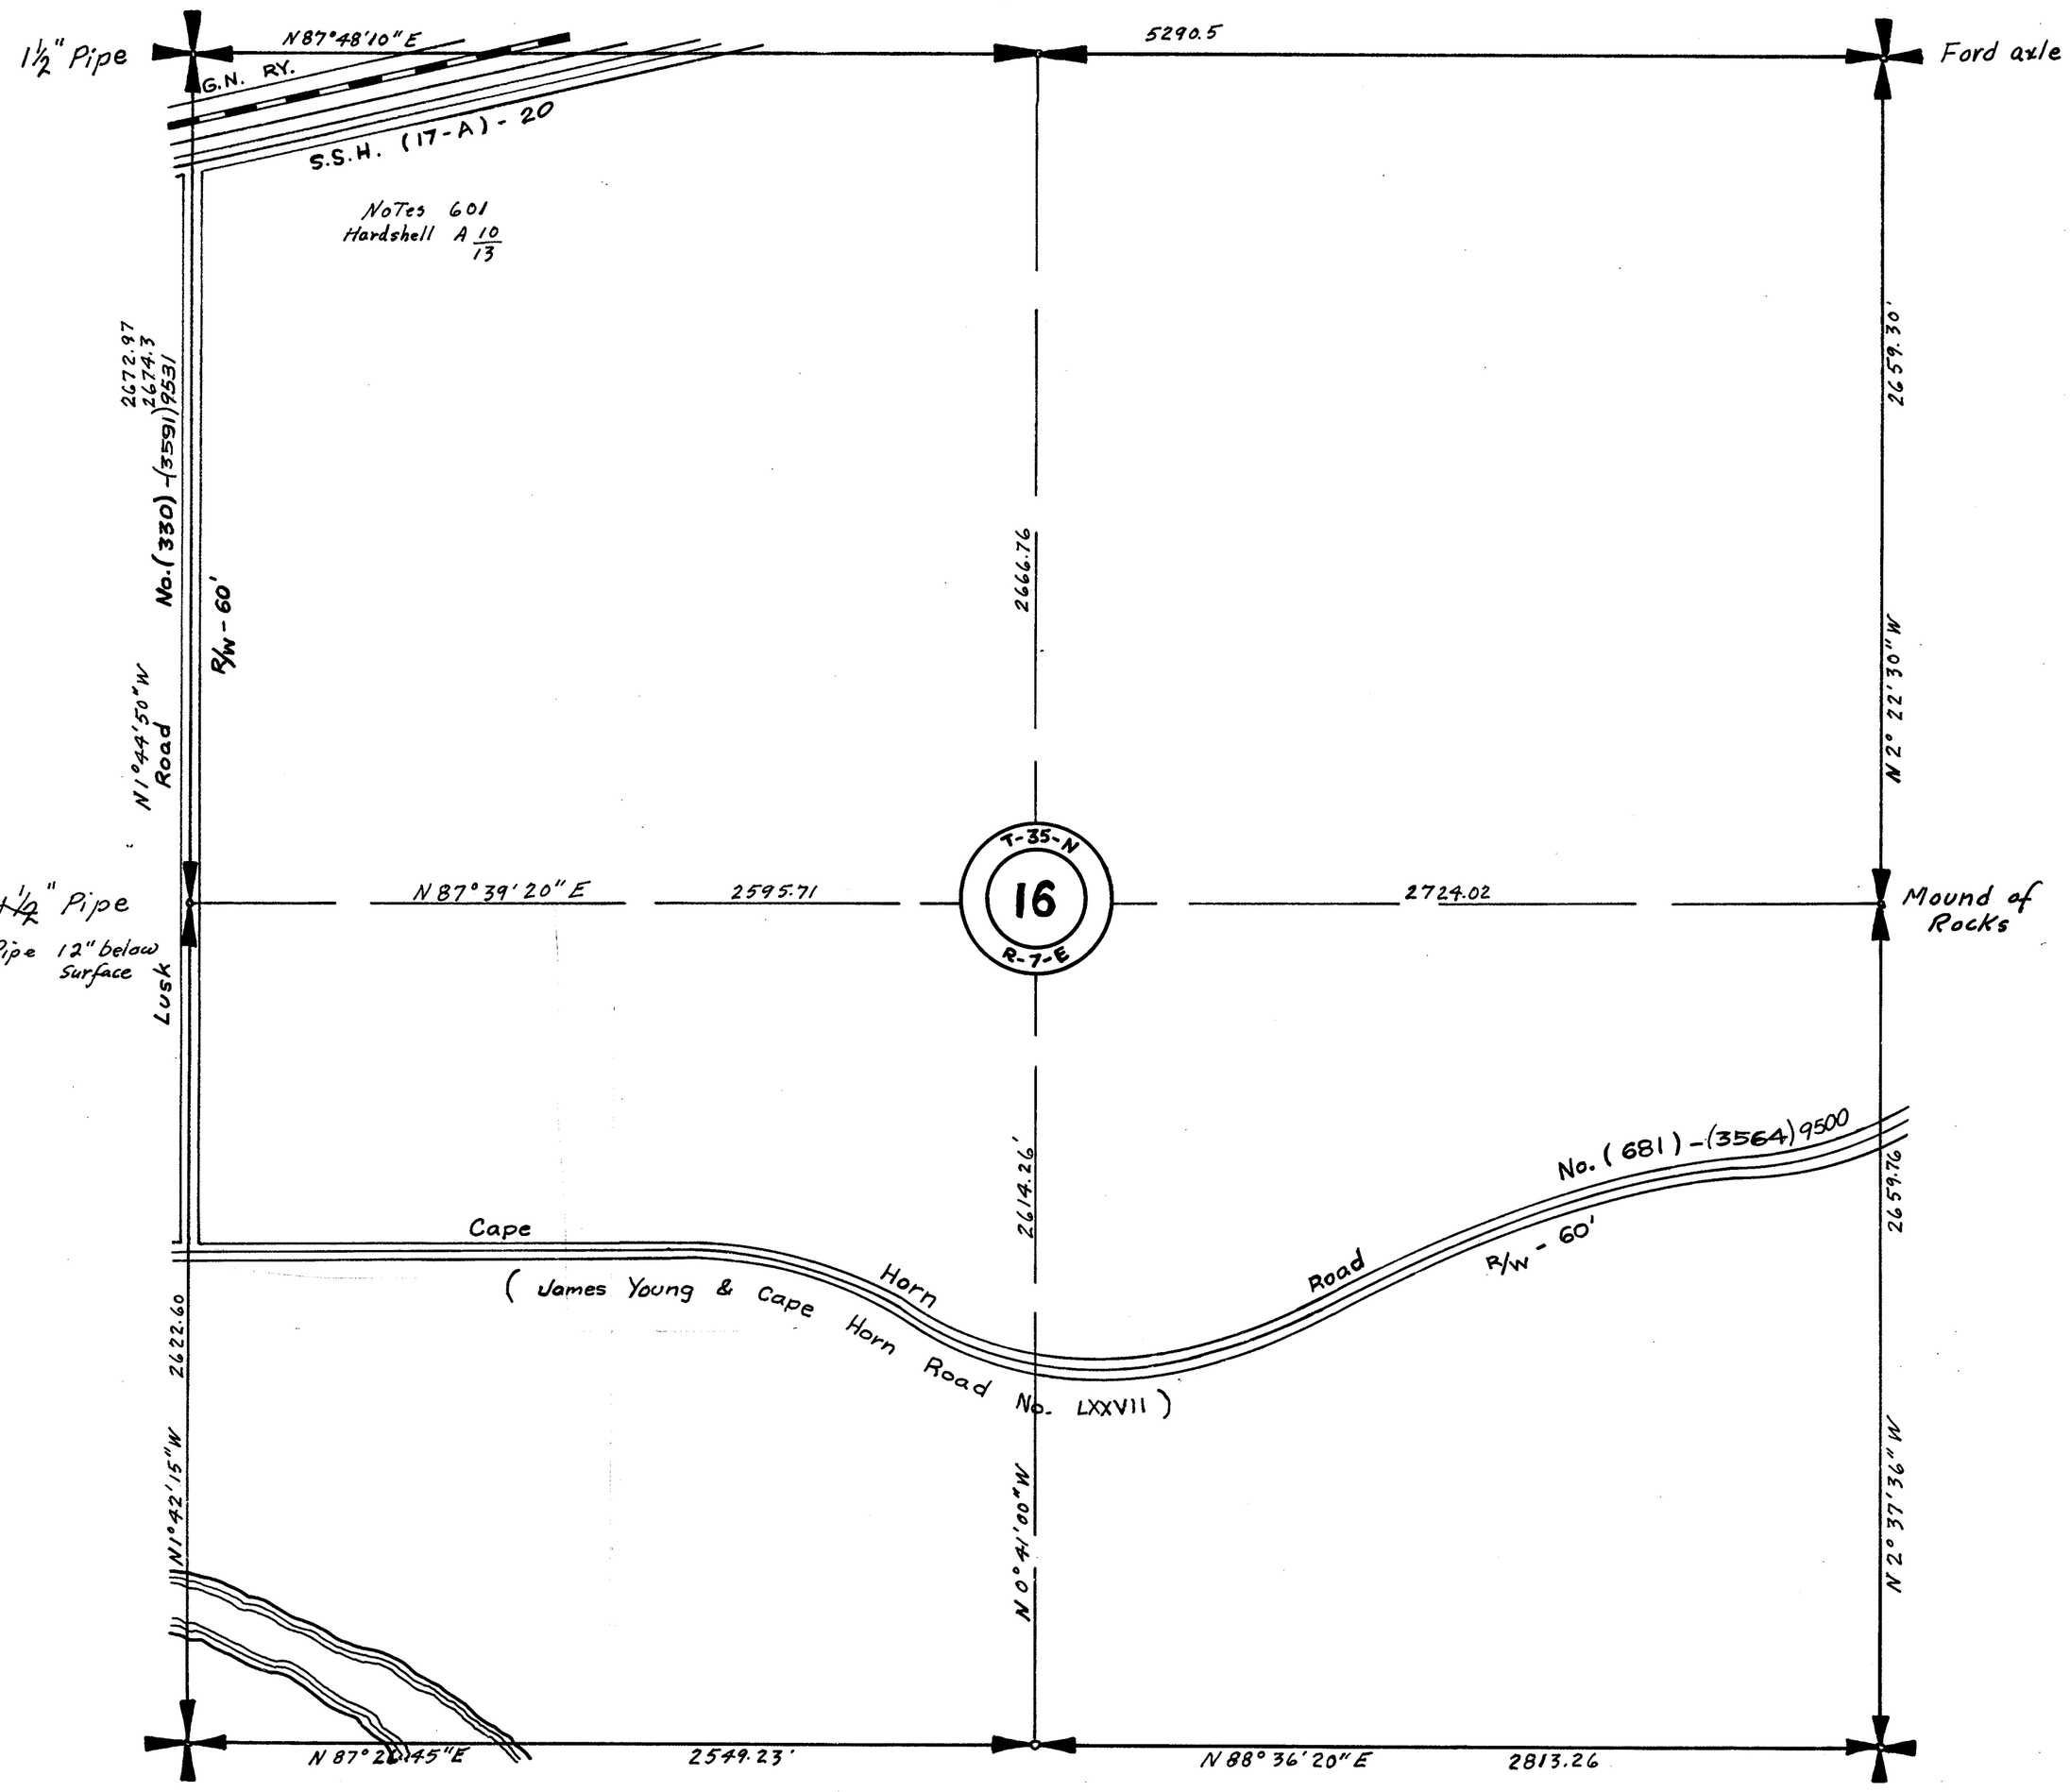


SECTION 16

TOWNSHIP 35 NORTH, RANGE 7 EAST, W. M.
SKAGIT COUNTY, WASH.

SCALE, 1 INCH—400 FEET

Rob't E. L. Knapp. COUNTY ENGINEER
Survey 1929 - Notes: F-144

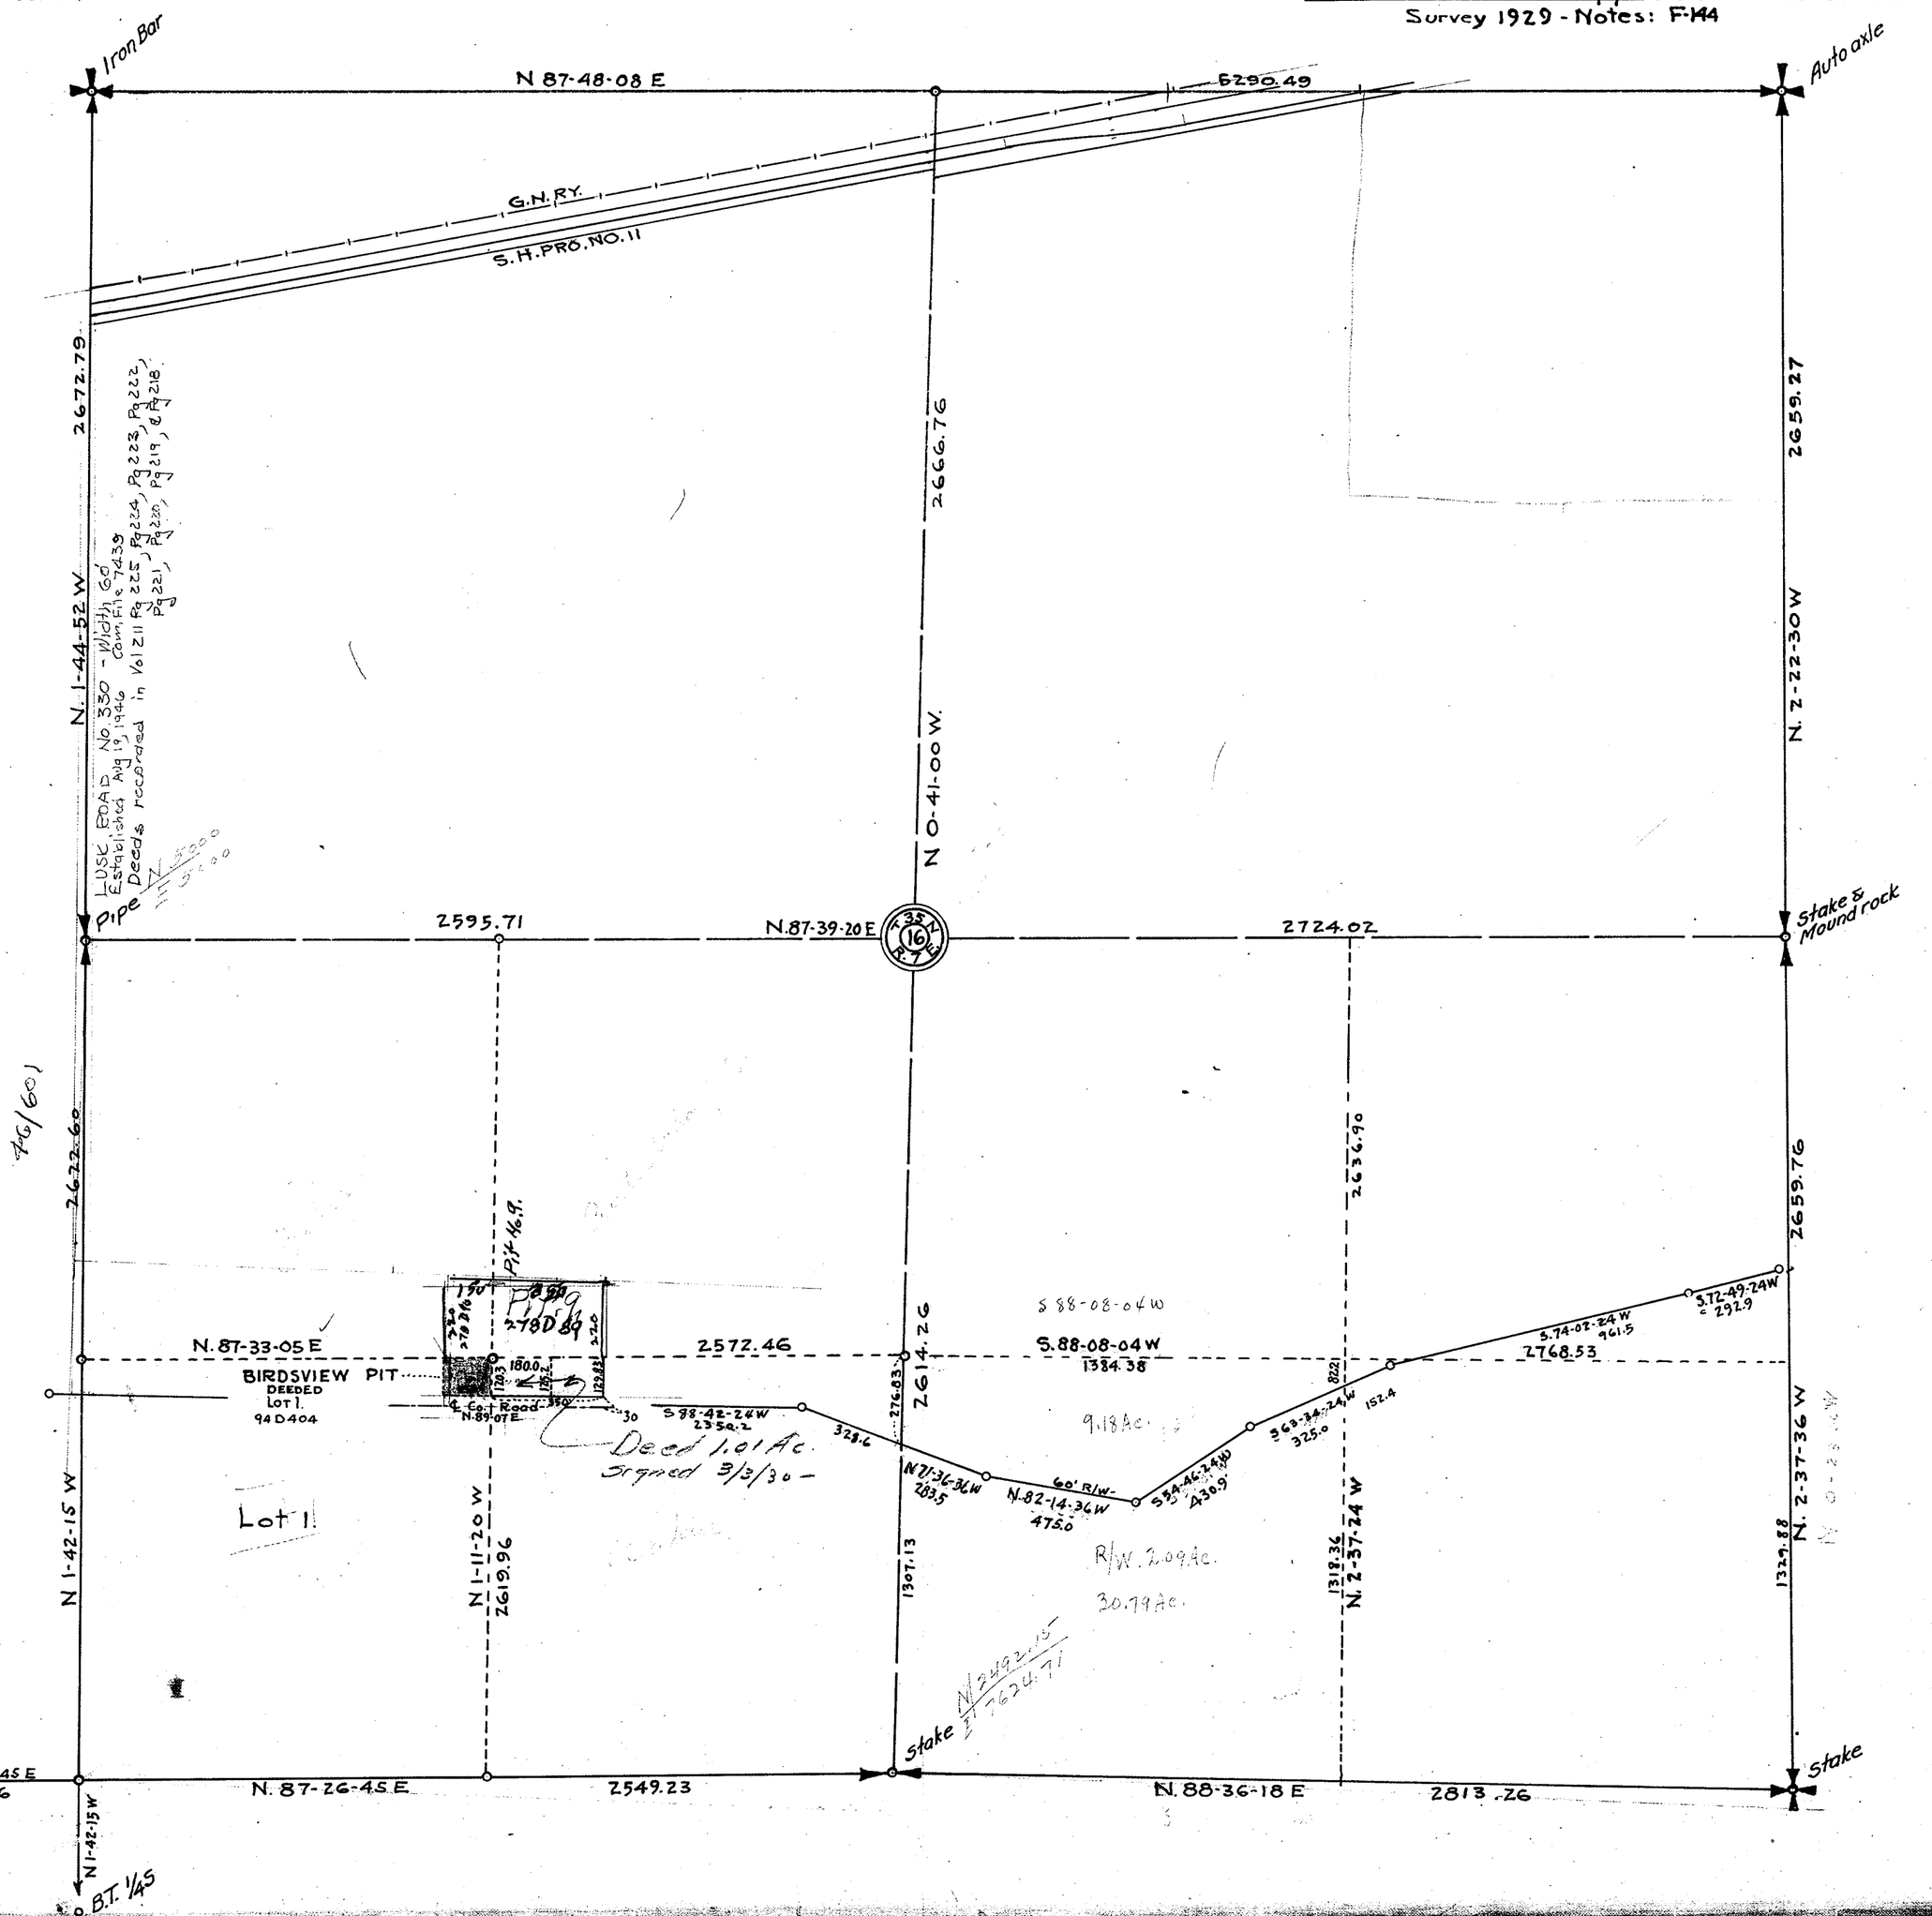

SECTION 17


TOWNSHIP 35 NORTH, RANGE 7 EAST, W. M.

SKAGIT COUNTY, WASH.

SCALE, 1 INCH--400 FEET

DATE Aug. 14, 1963

_____ COUNTY ENGINEER

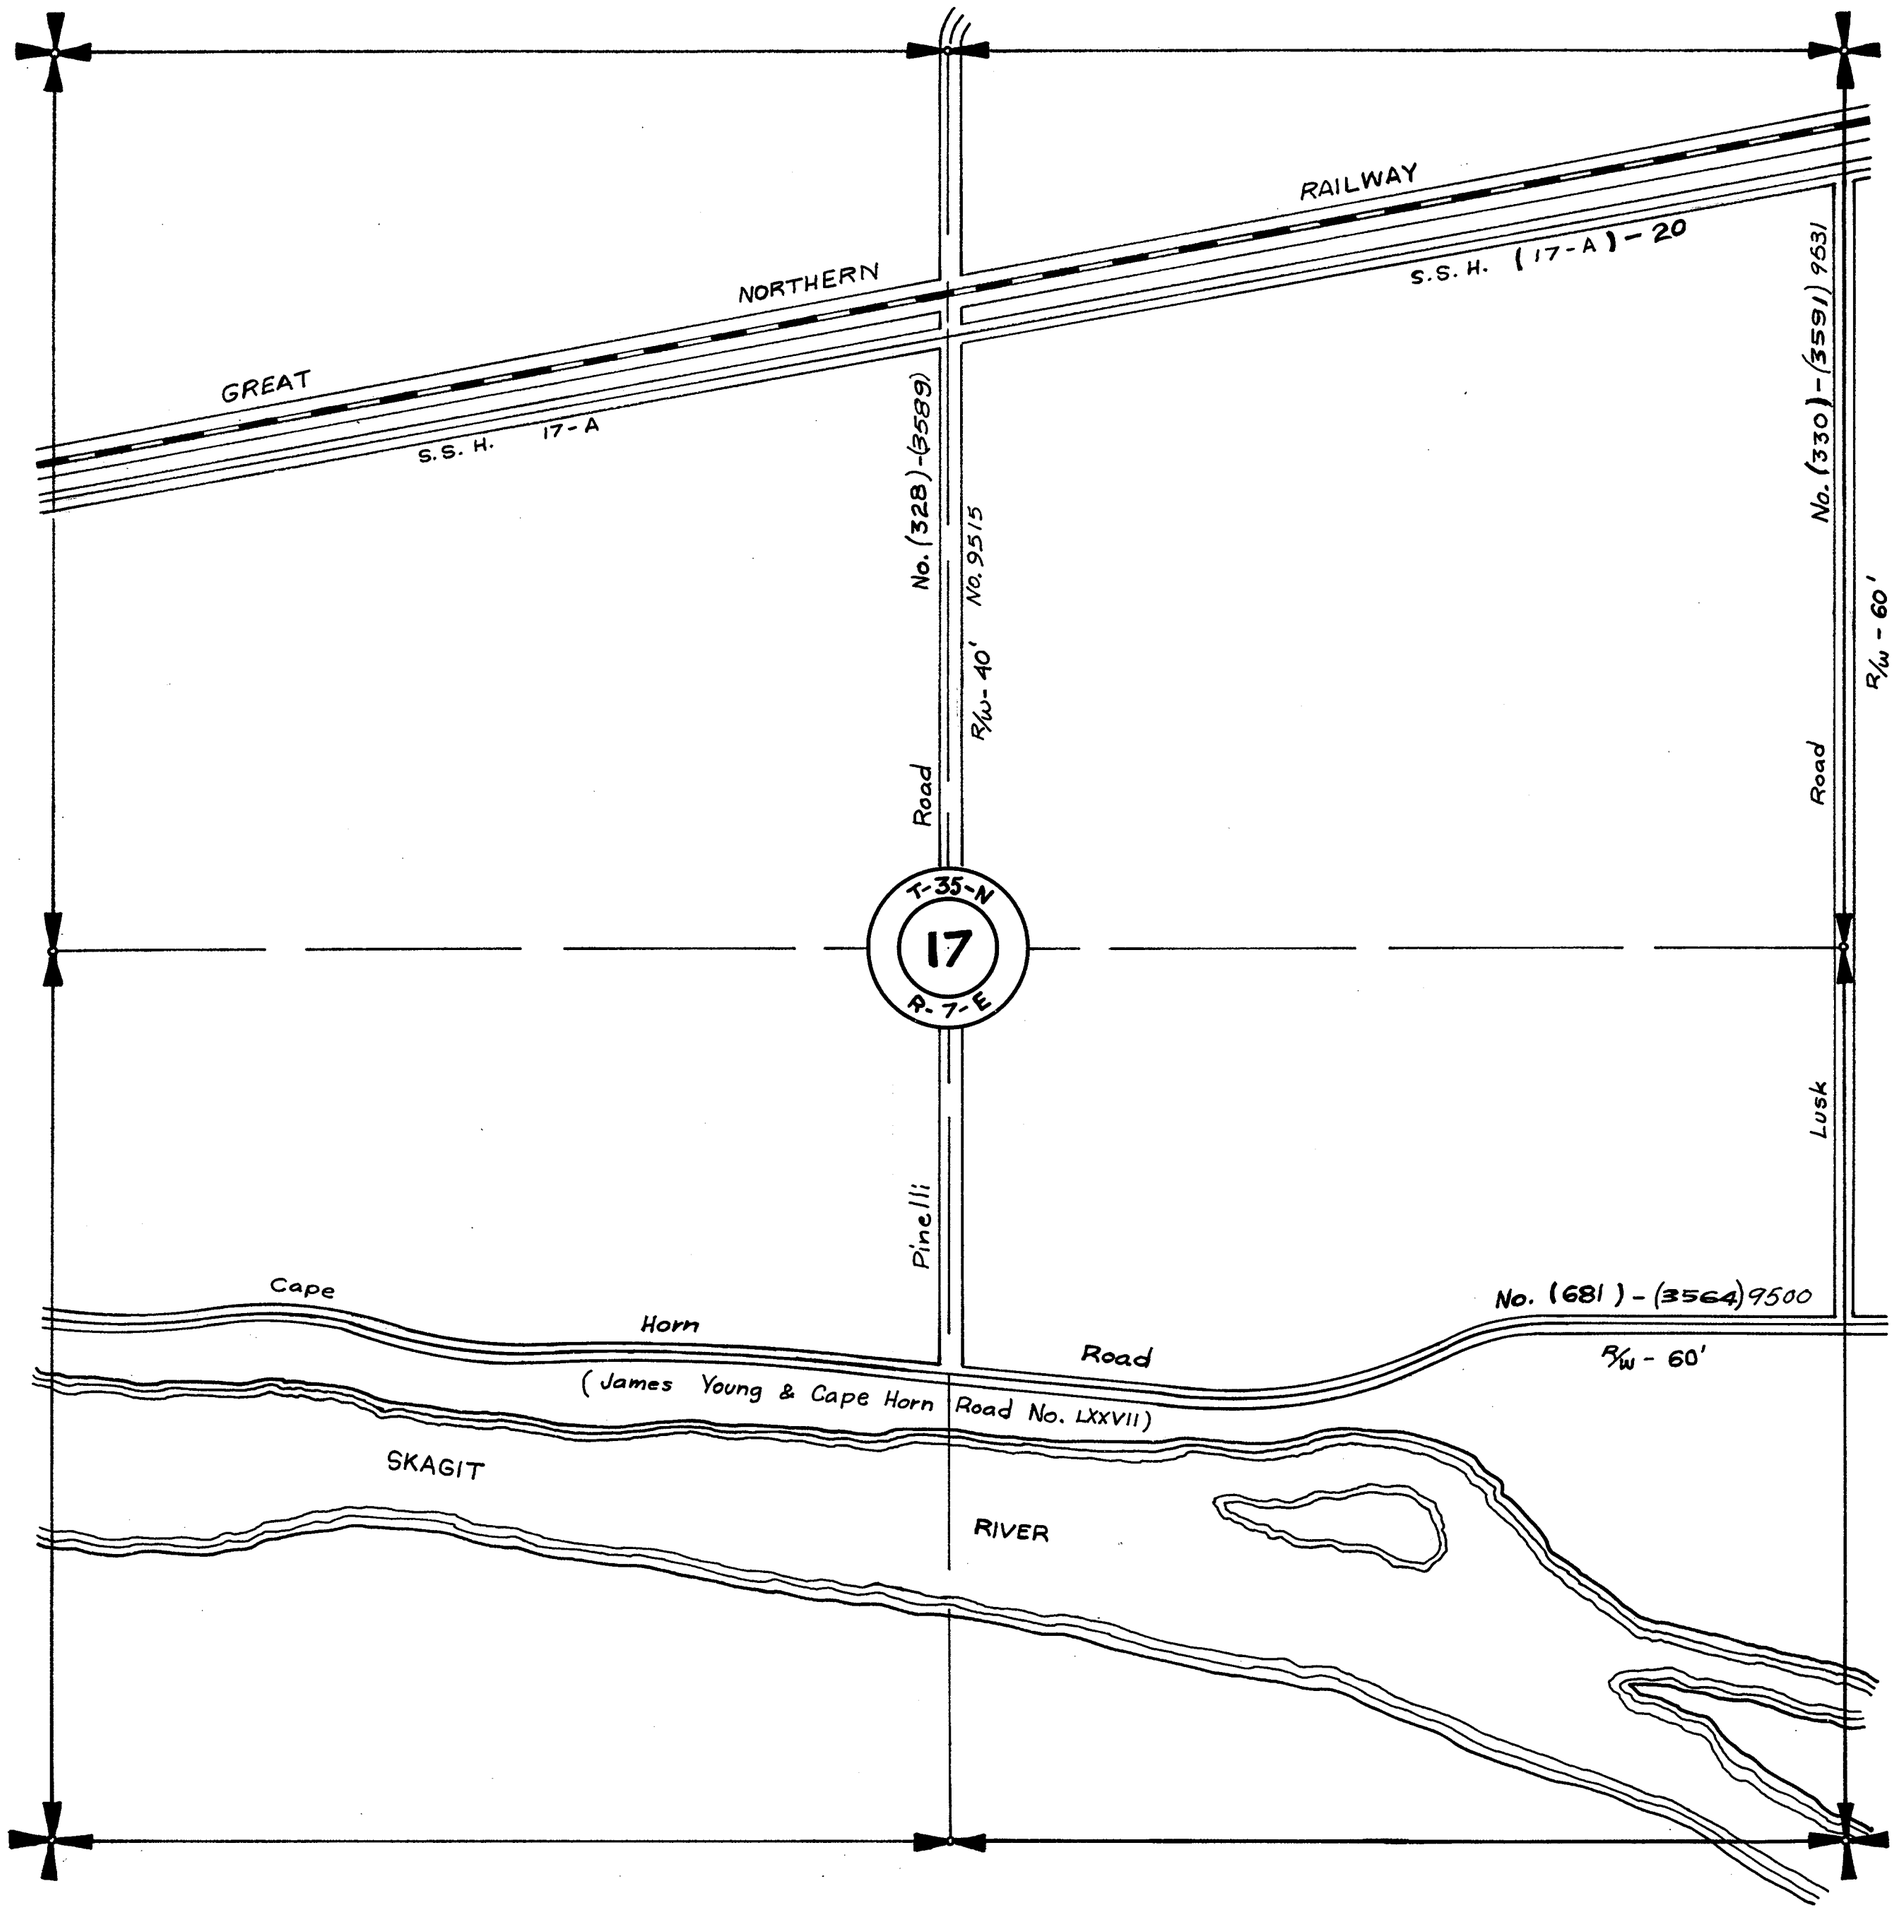

SECTION 18


TOWNSHIP 35 NORTH, RANGE 7 EAST, W. M.

SKAGIT COUNTY, WASH.

SCALE, 1 INCH--400 FEET

DATE Aug. 13, 1963

COUNTY ENGINEER

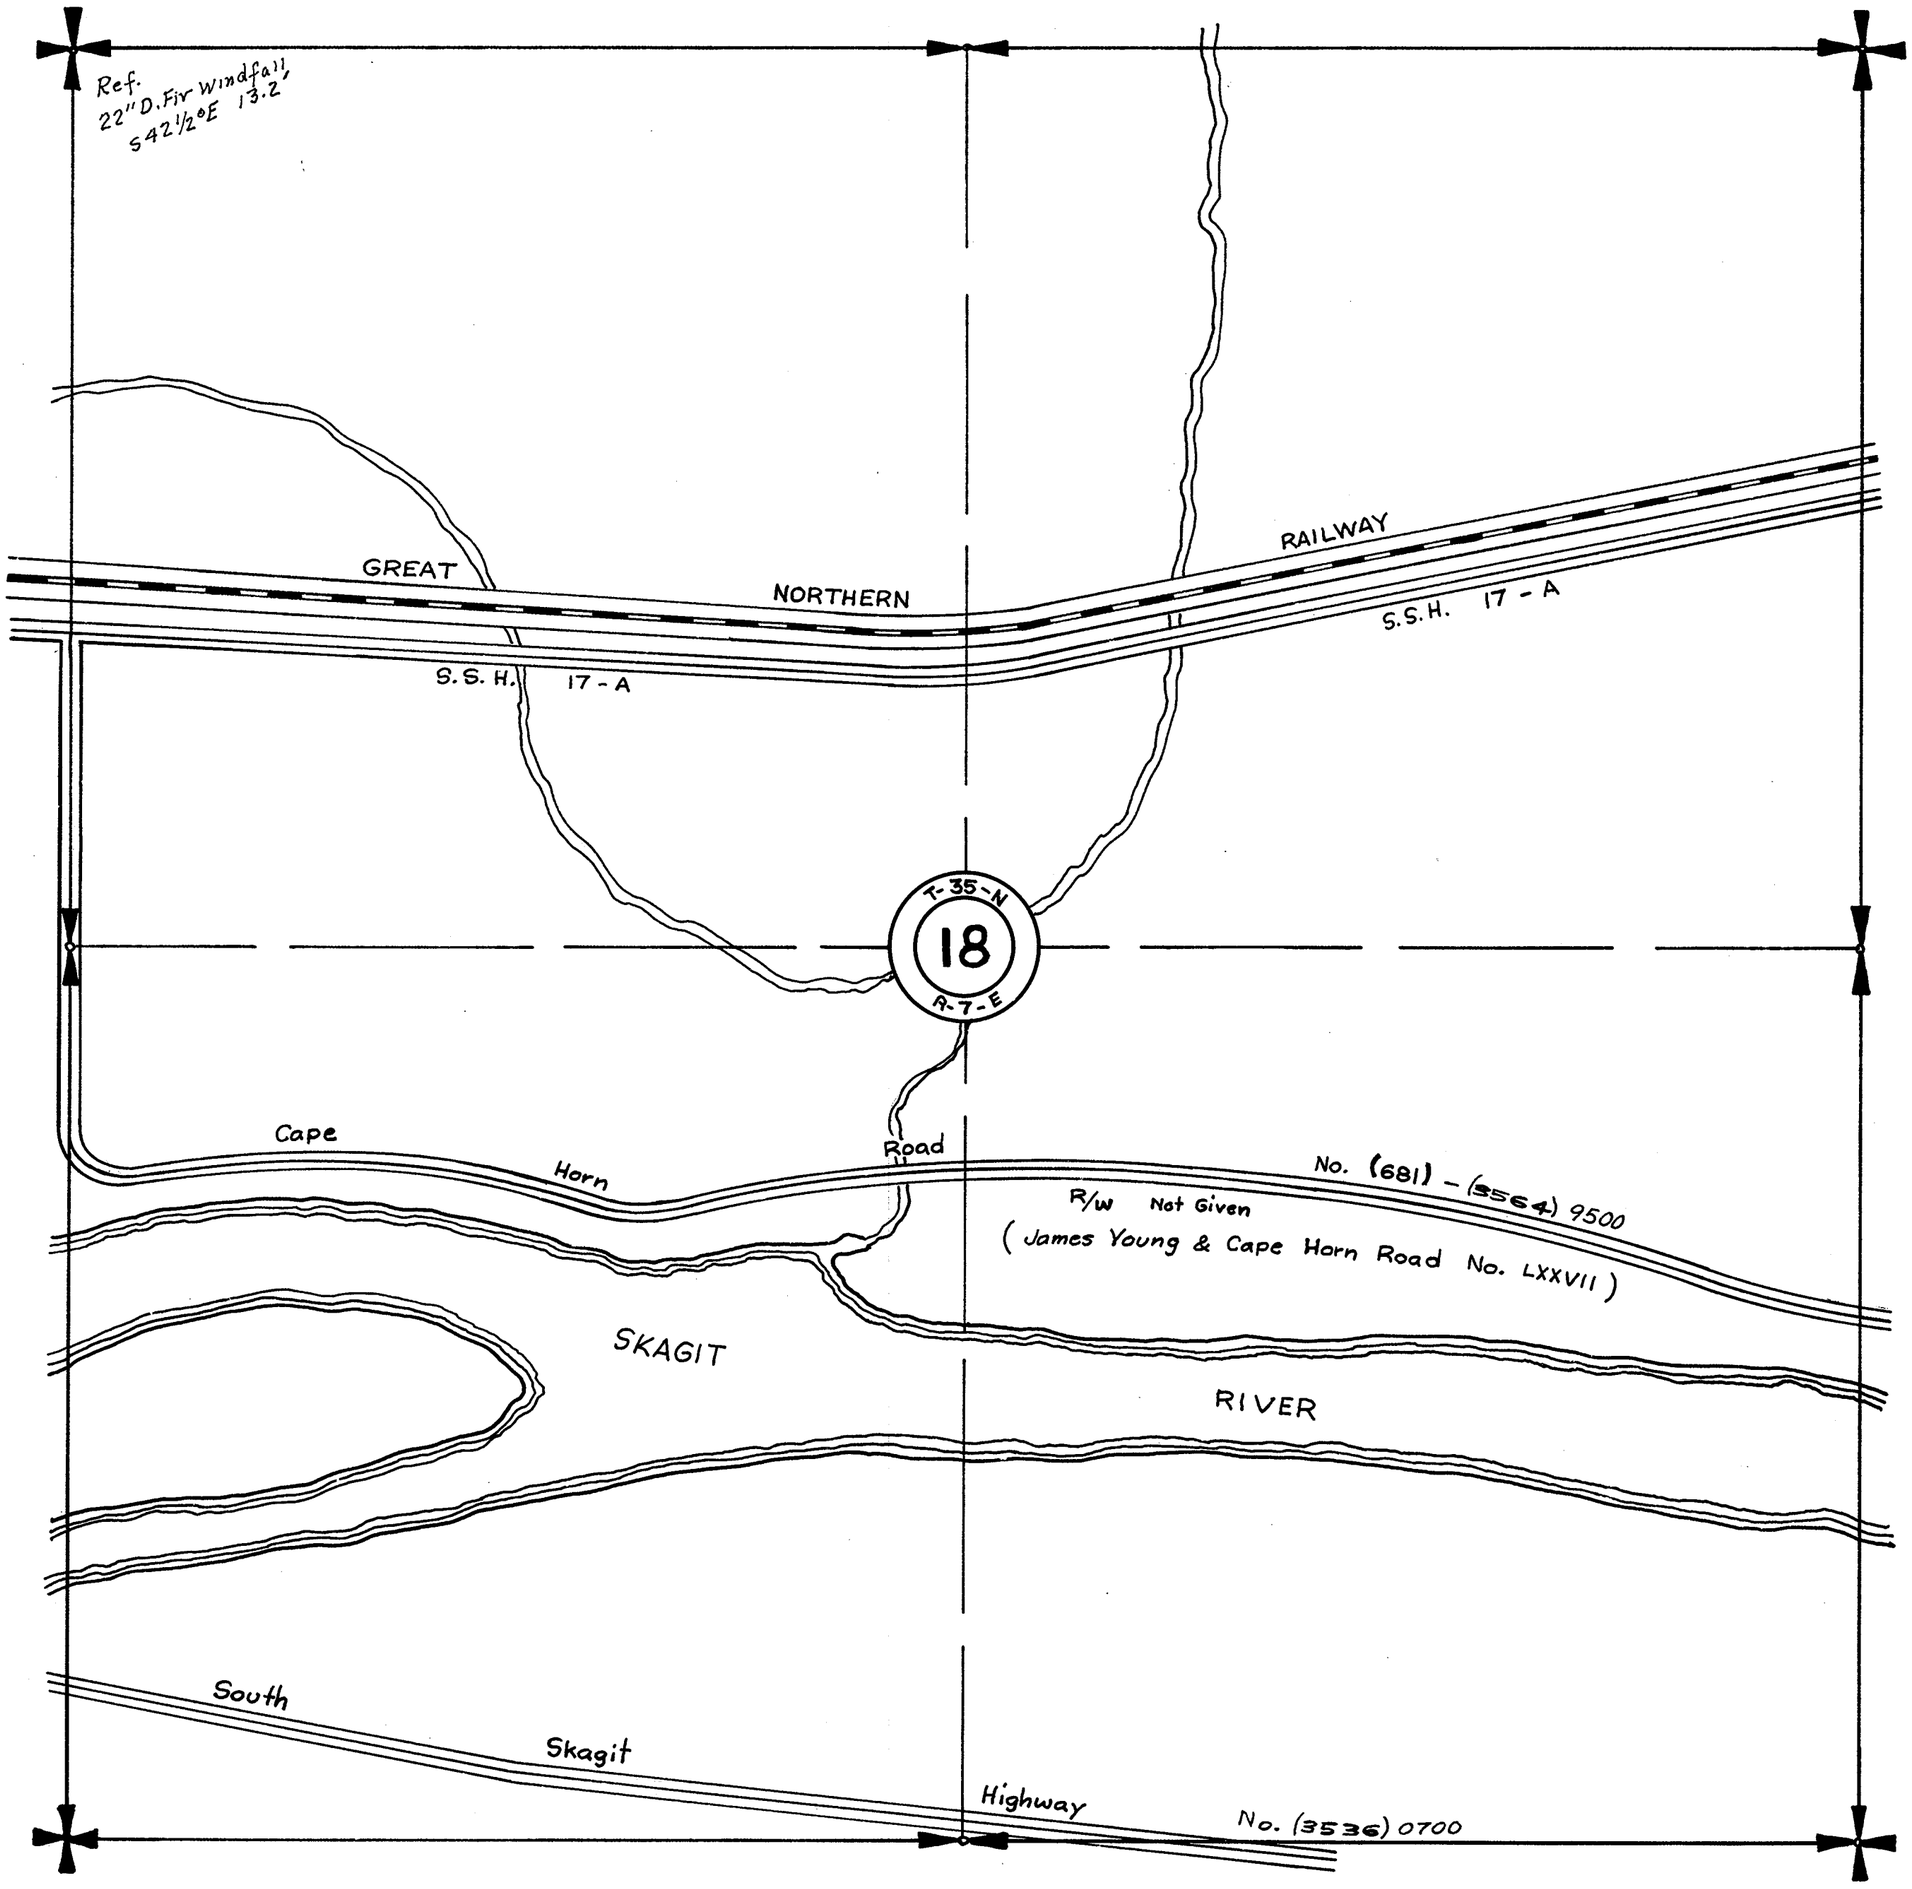


SECTION 24

TOWNSHIP 35 NORTH. RANGE 7 EAST. W. M.
SKAGIT COUNTY. WASH.

SCALE. 1 INCH—400 FEET

Lloyd H. Johnson COUNTY ENGINEER

DATE July 5, 1972

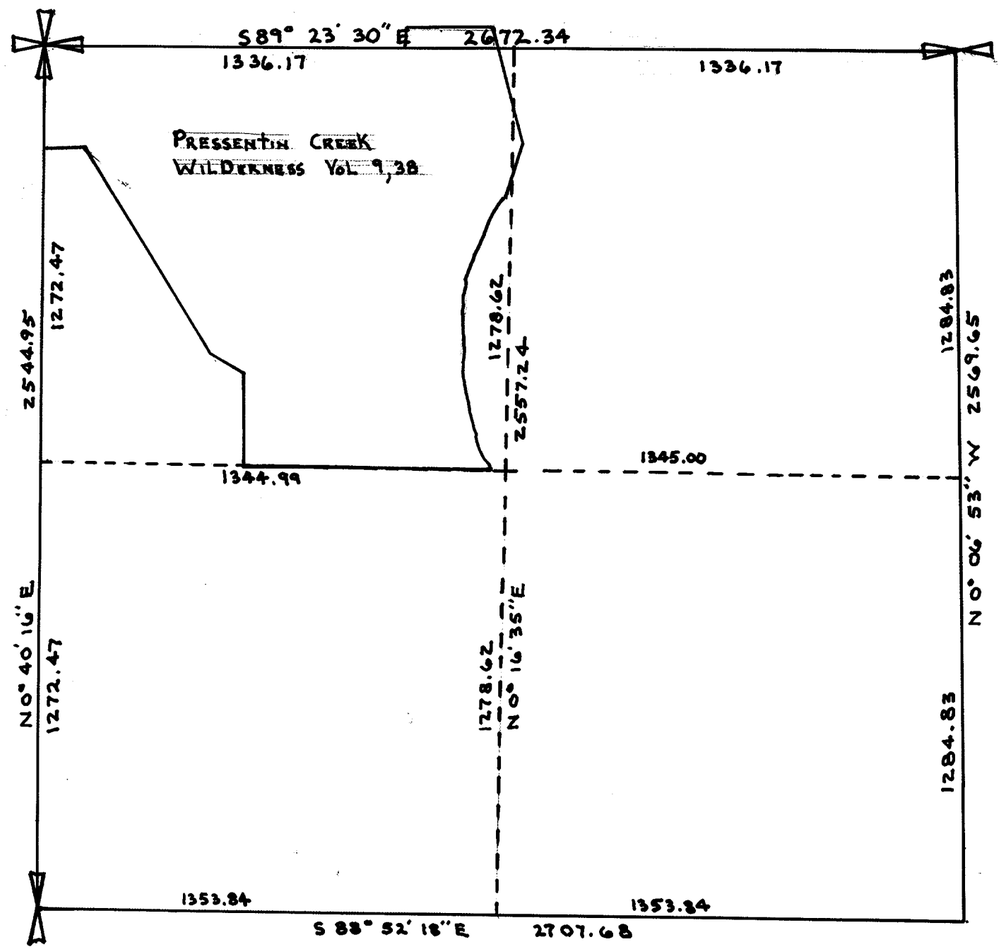

SECTION 2


TOWNSHIP 35 NORTH, RANGE 8 EAST, W. M.

SKAGIT COUNTY, WASH.

SCALE, 1 INCH -- 400 FEET

DATE *September, 1971*

Lloyd Johnson COUNTY ENGINEER

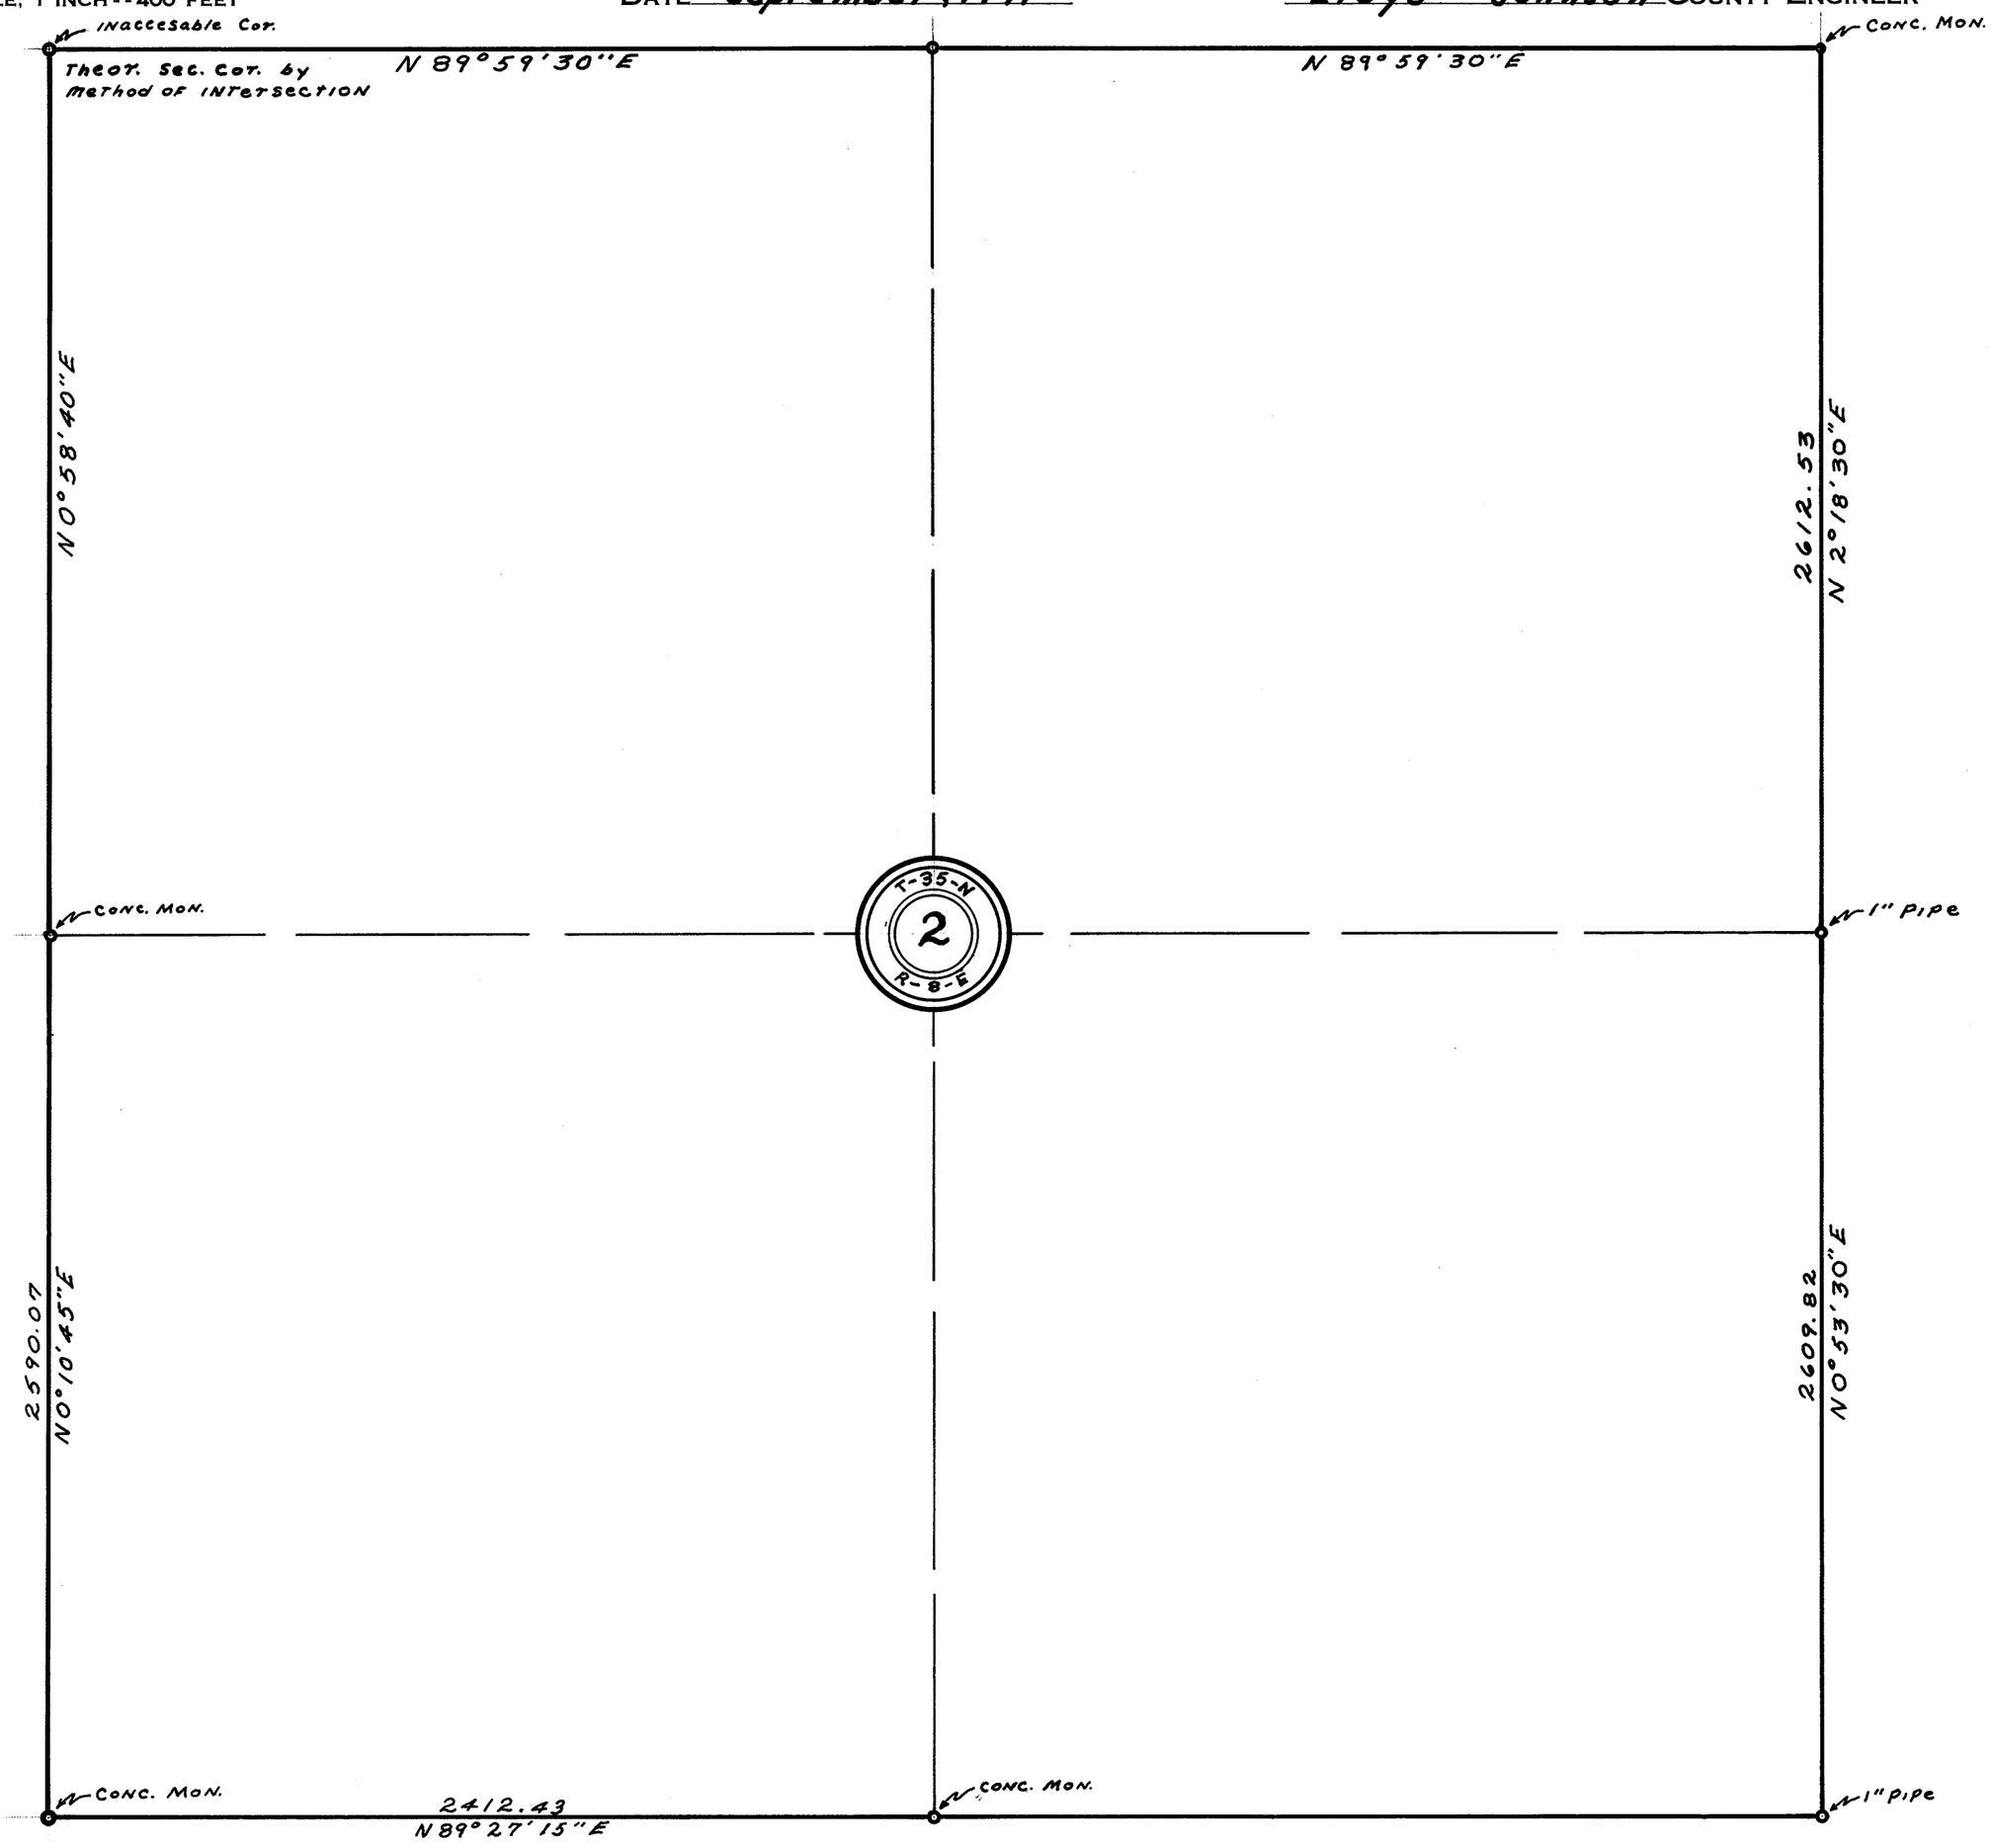


SECTION 3

TOWNSHIP 35 NORTH, RANGE 8 EAST, W. M.

SKAGIT COUNTY, WASH.

DATE January 1960 — Frank Gilkey COUNTY ENGINEER

SCALE, 1 INCH--400 FEET
Road No. 310, P.C. 0+00 to 23+73.9 from Notes 41/486
Road No. 310, P.C. 25+01.8 to P.I. 72+29.74 from Notes in Rd. Papers & Oy-10
(C° in this portion = the angle subtending 100' chord)

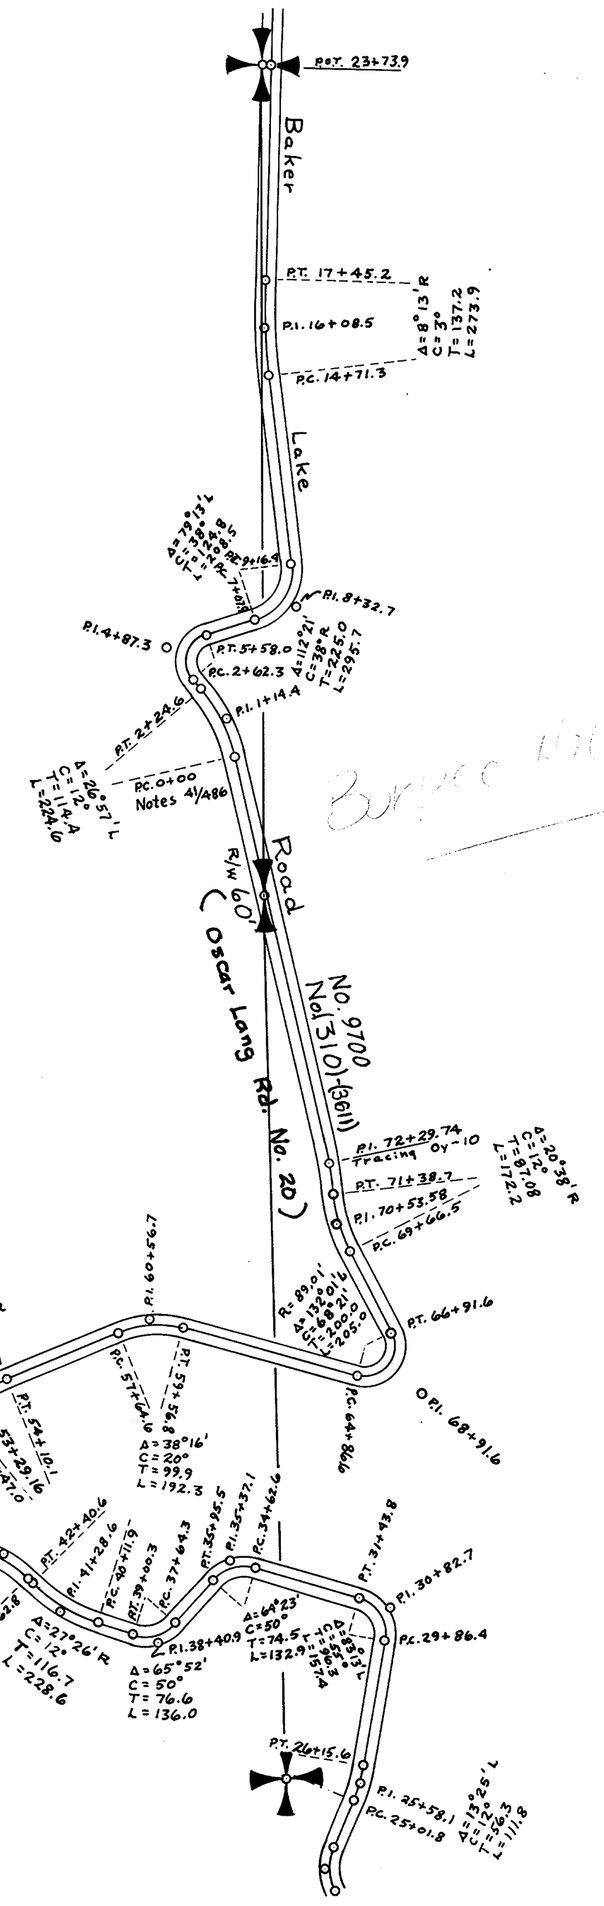


SECTION 3

TOWNSHIP 35 NORTH, RANGE 5 EAST, W. M.
SKAGIT COUNTY, WASH.

SCALE, 1 INCH–400 FEET

W.E. Costello COUNTY ENGINEER

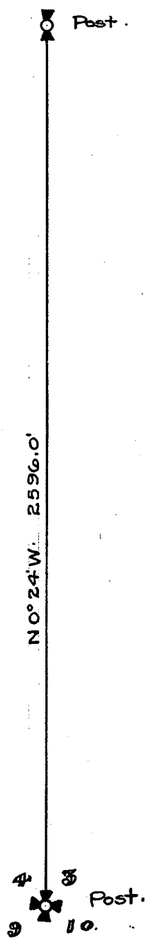


SECTION 4

TOWNSHIP 35 NORTH, RANGE 8 EAST, W. M.

SKAGIT COUNTY, WASH.

SCALE, 1 INCH–400 FEET

W.E. Costello COUNTY ENGINEER

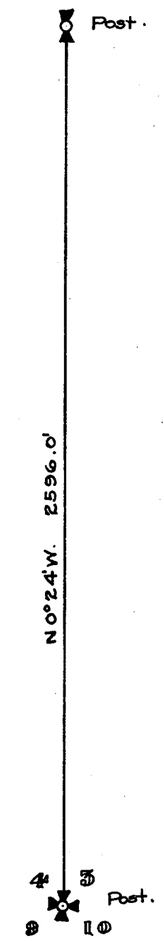

SECTION 7


TOWNSHIP 35 NORTH, RANGE 8 EAST, W. M.

SKAGIT COUNTY, WASH.

SCALE, 1 INCH -- 400 FEET

DATE Aug. 24, 1966

Lloyd Johnson COUNTY ENGINEER

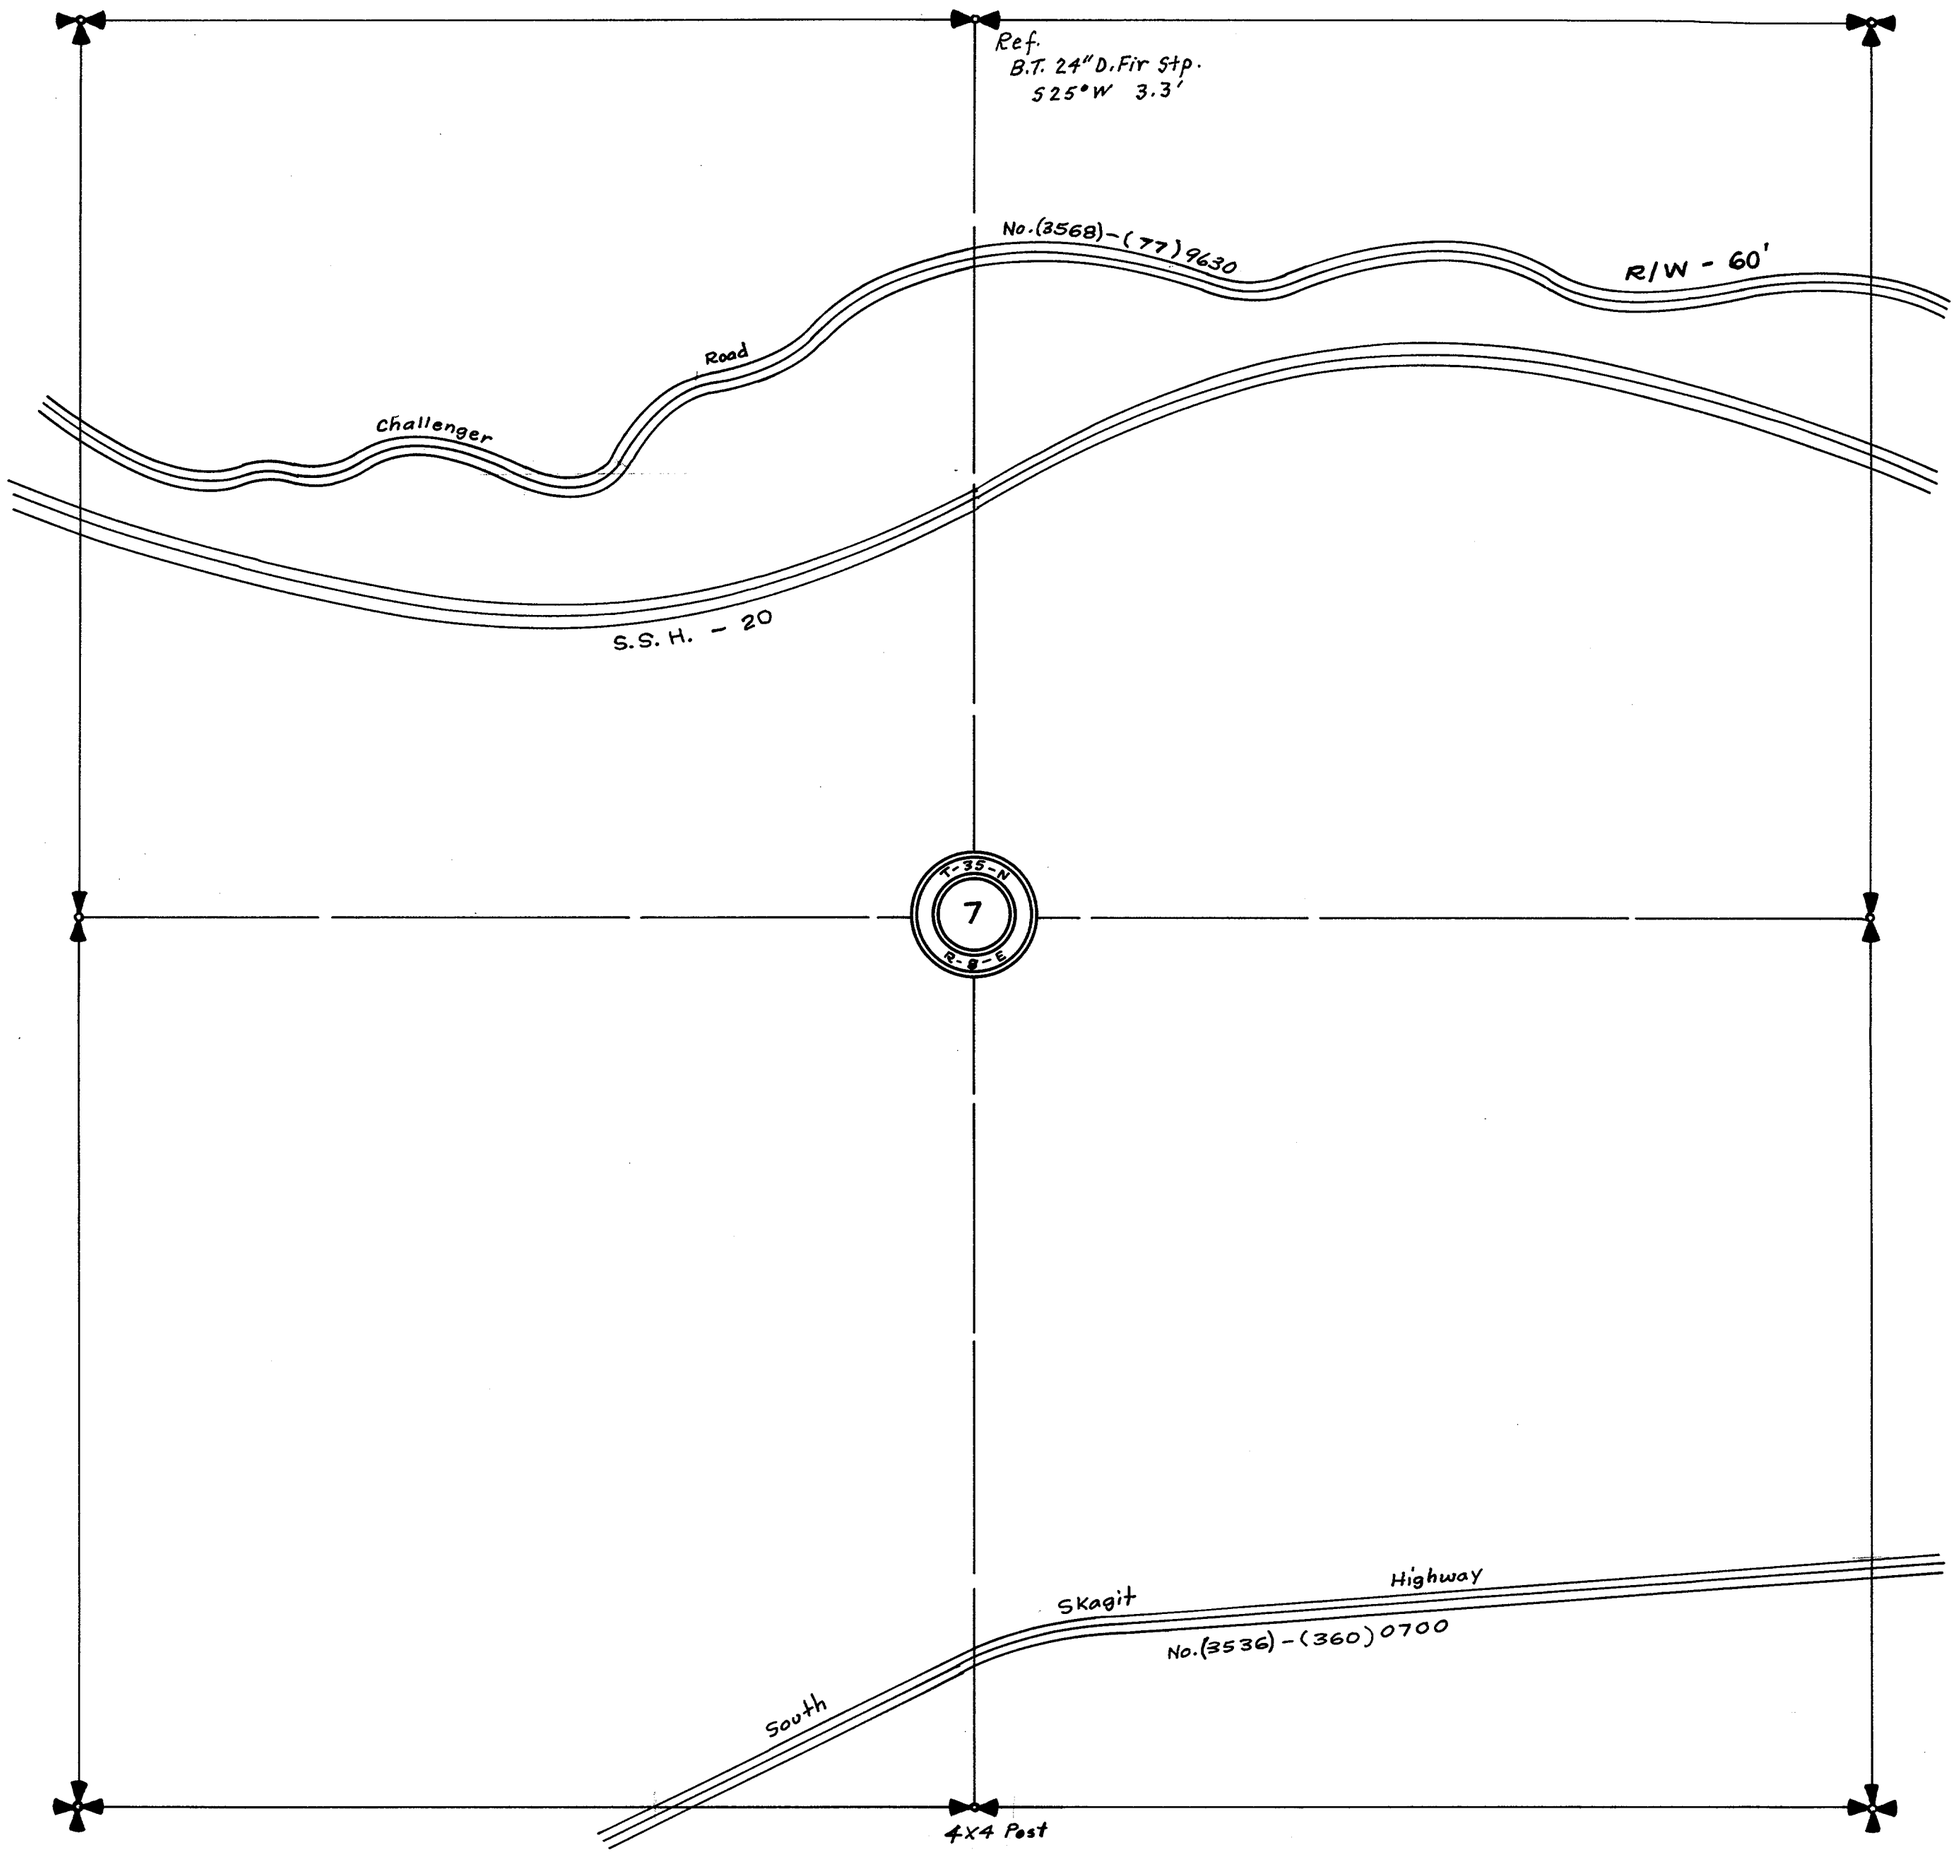

A15
2

SECTION 7


TOWNSHIP 35 NORTH, RANGE 8 EAST, W. M.

SKAGIT COUNTY, WASH.

SCALE, 1 INCH -- 400 FEET

DATE 1969

COUNTY ENGINEER

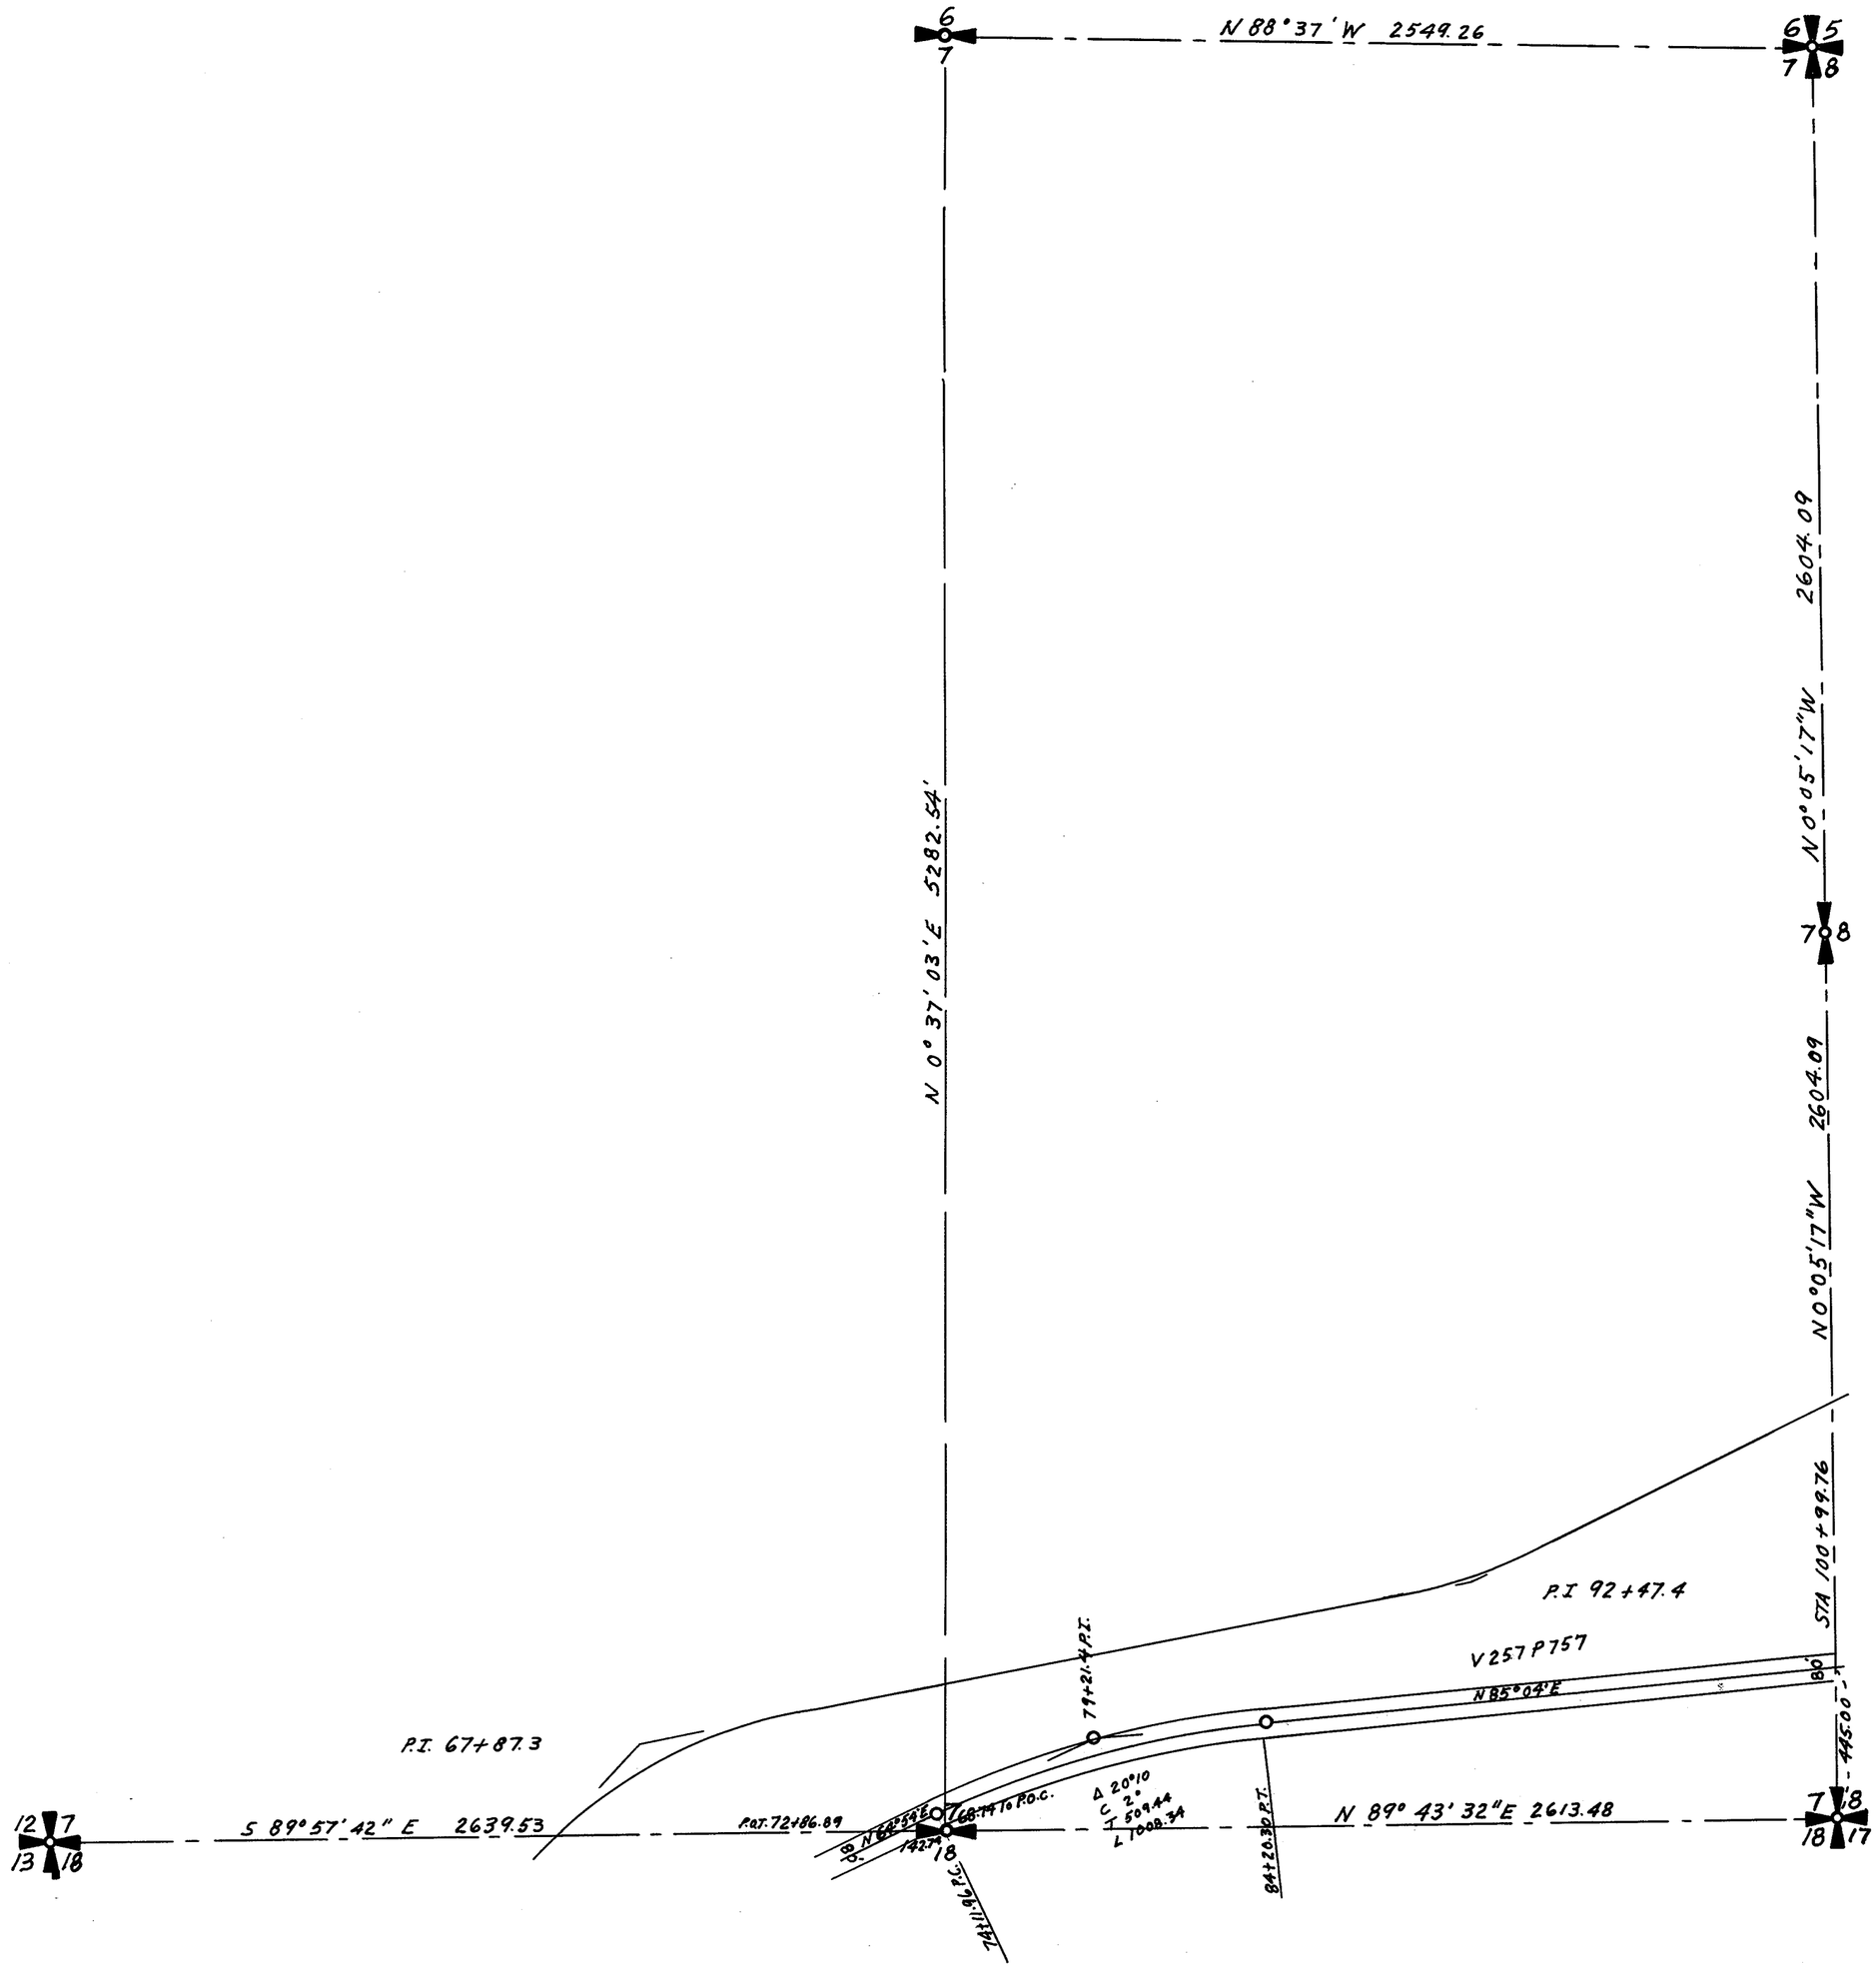

A15
2


SECTION 8

TOWNSHIP 35 NORTH, RANGE 8 EAST, W. M.

SKAGIT COUNTY, WASH.

SCALE, 1 INCH--400 FEET

H.O. WALBERG COUNTY ENGINEER

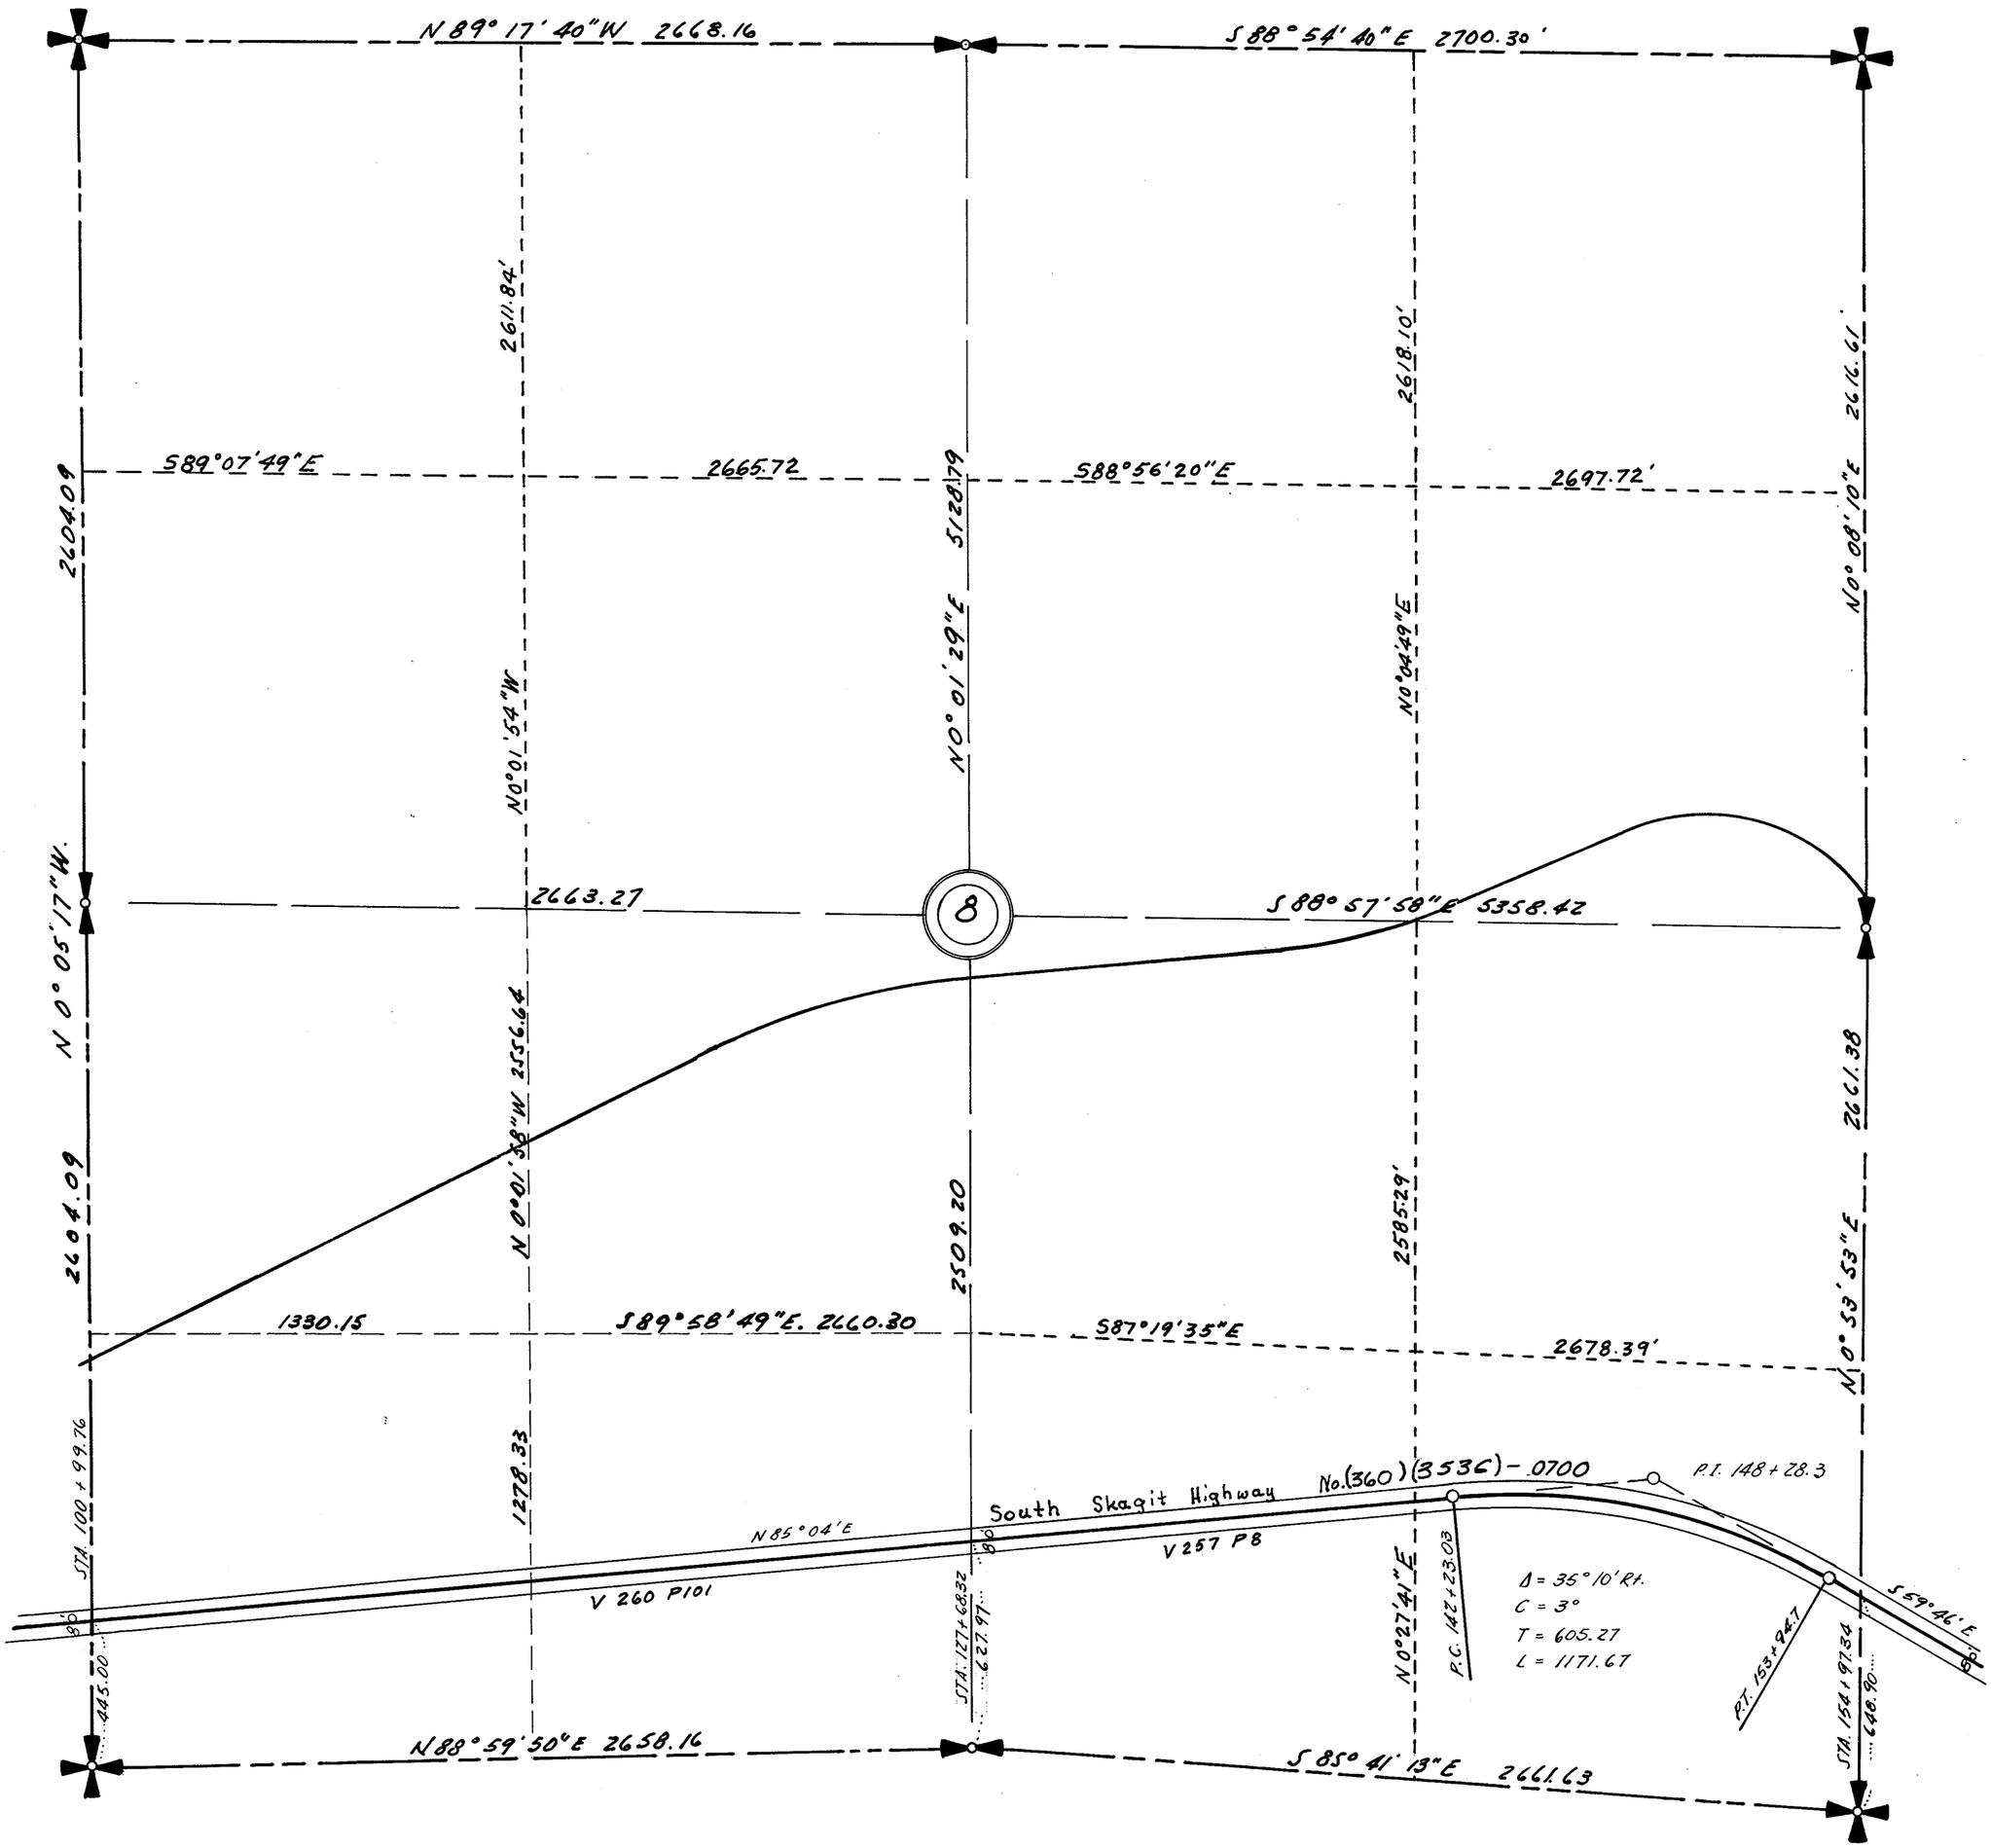


SECTION 9
TOWNSHIP 35 NORTH, RANGE 8 EAST, W. M.
SKAGIT COUNTY, WASH.

SCALE 1 INCH--400 FEET

DATE Aug. 22, 1963

COUNTY ENGINEER

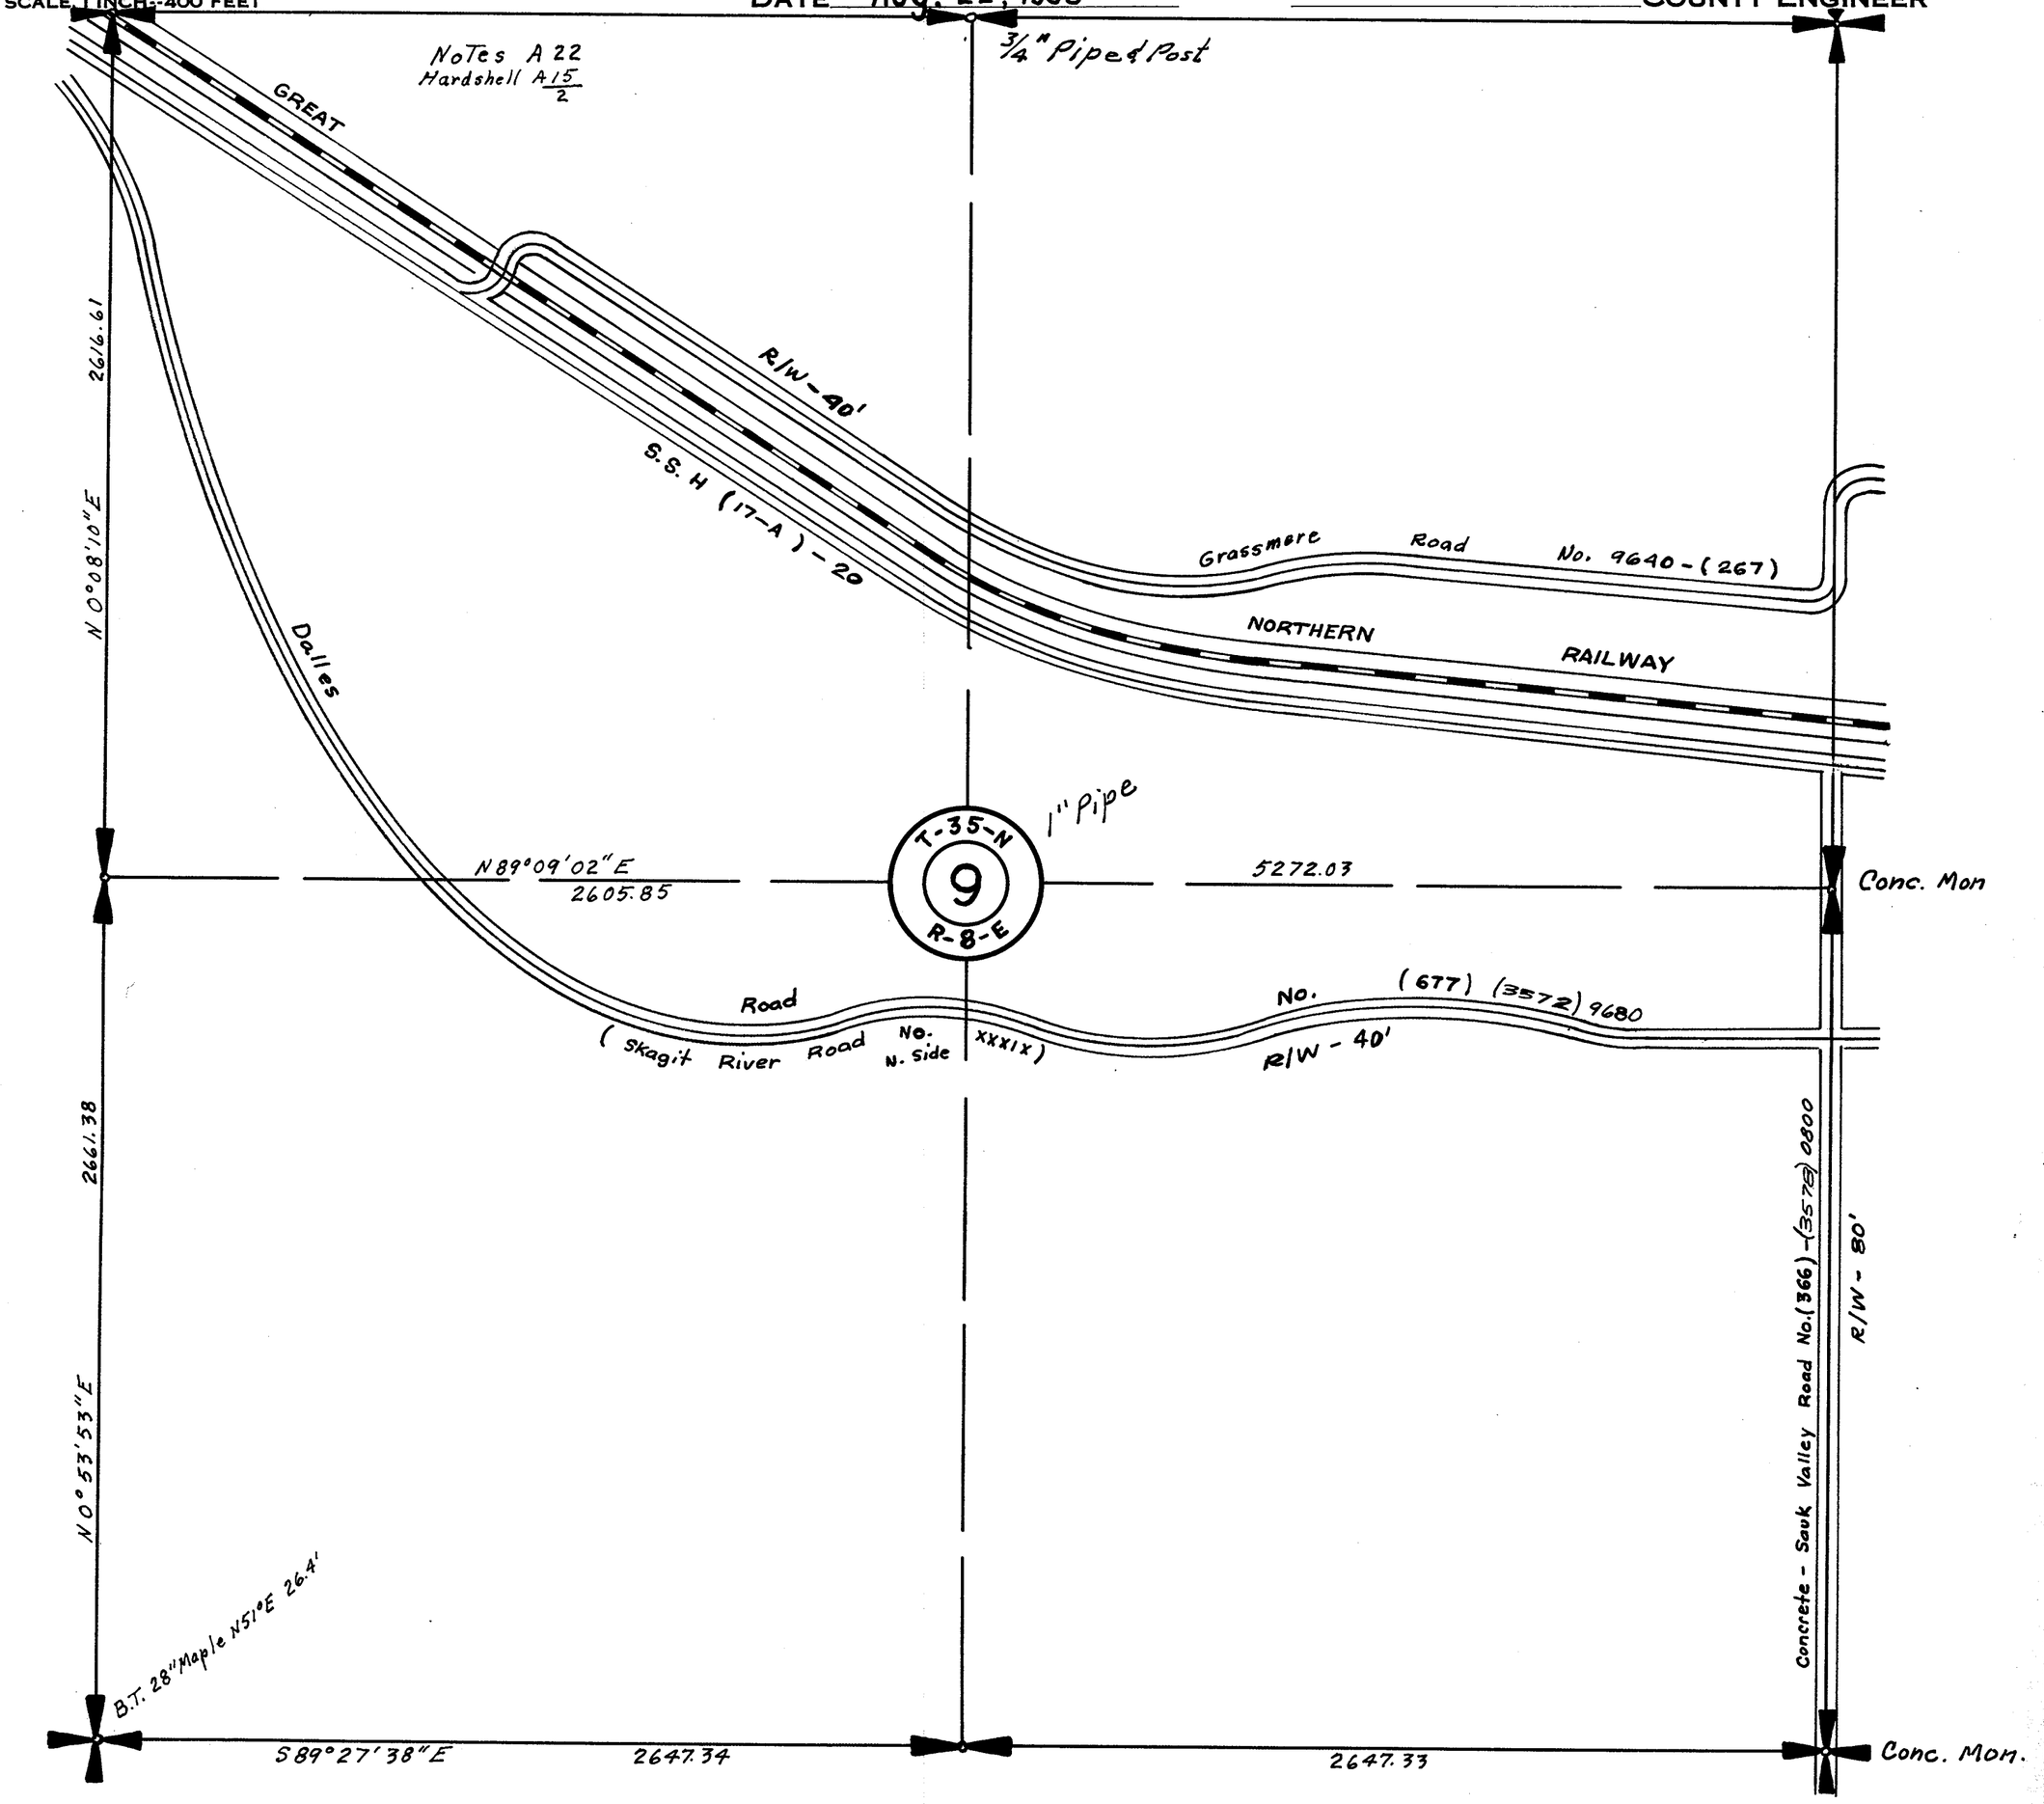

A15
2

SECTION 9


TOWNSHIP 35 NORTH, RANGE 8 EAST, W. M.

SKAGIT COUNTY, WASH.

SCALE, 1 INCH -- 400 FEET

DATE 6 1969

LLOYD H. JOHNSON COUNTY ENGINEER

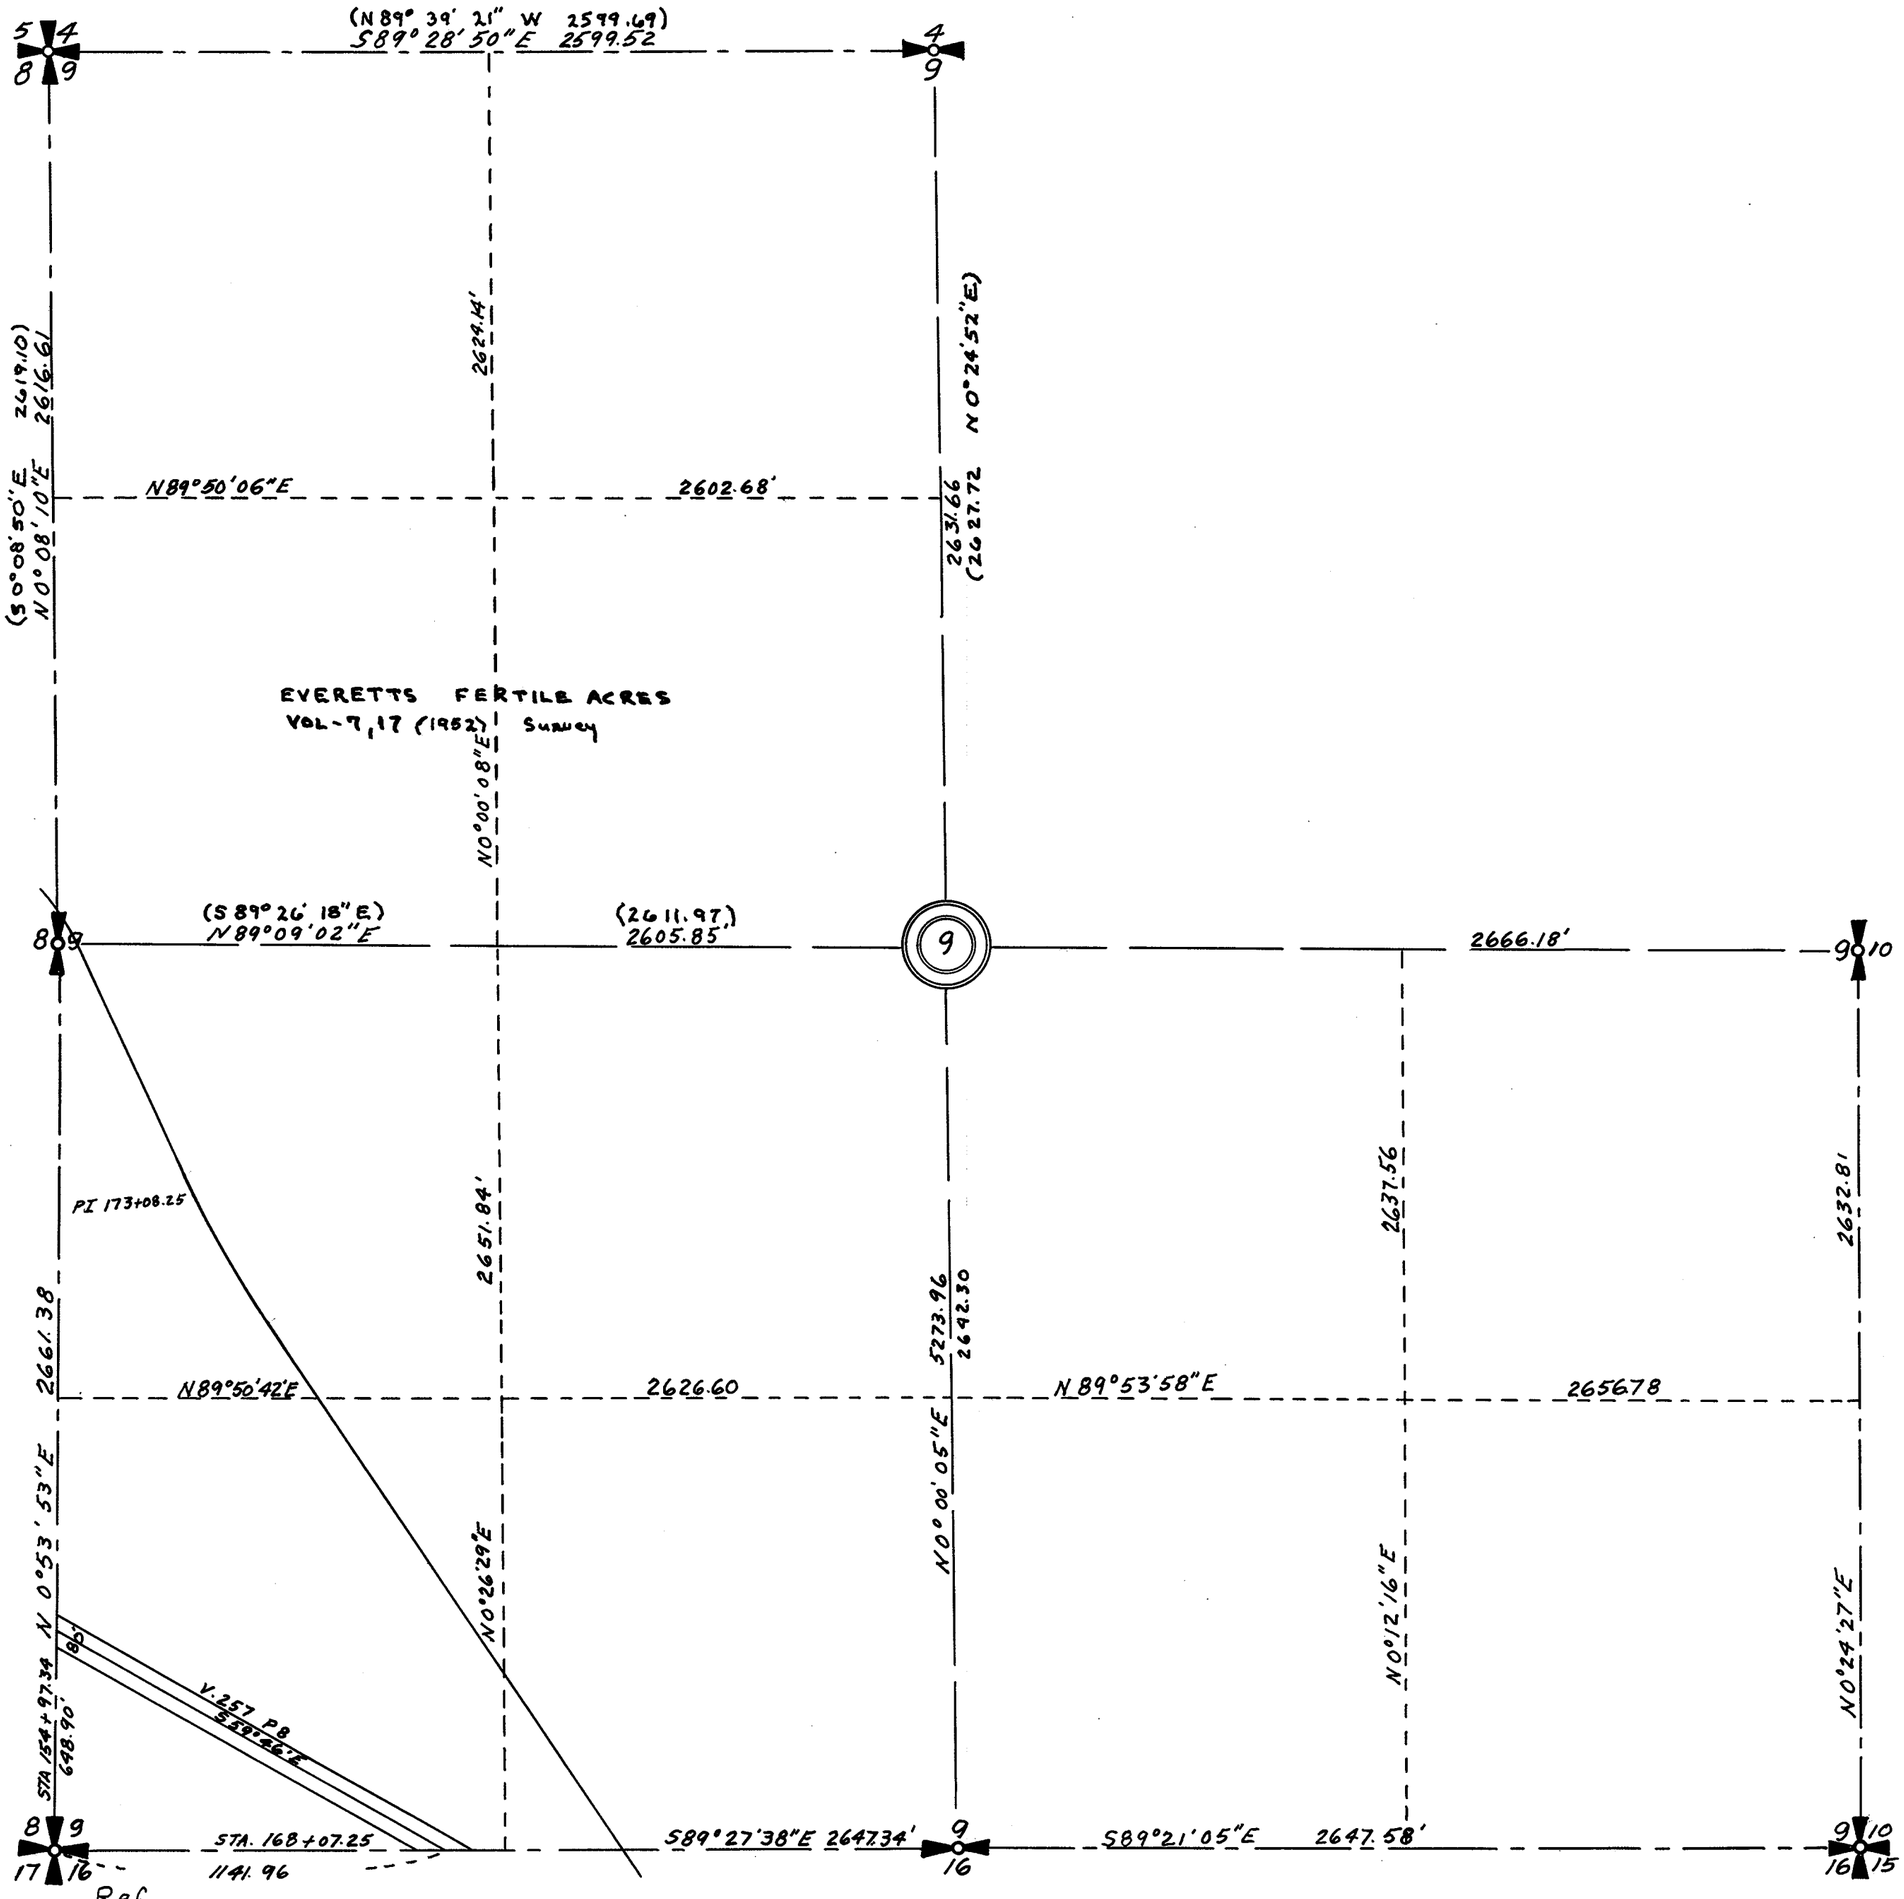


Ref.
B.T. 28" Maple N51°E 26.4'

SECTION 9

TOWNSHIP 35 NORTH, RANGE 8 EAST, W. M.
SKAGIT COUNTY, WASH.

SCALE, 1 INCH–400 FEET

A.L. STRONG COUNTY ENGINEER

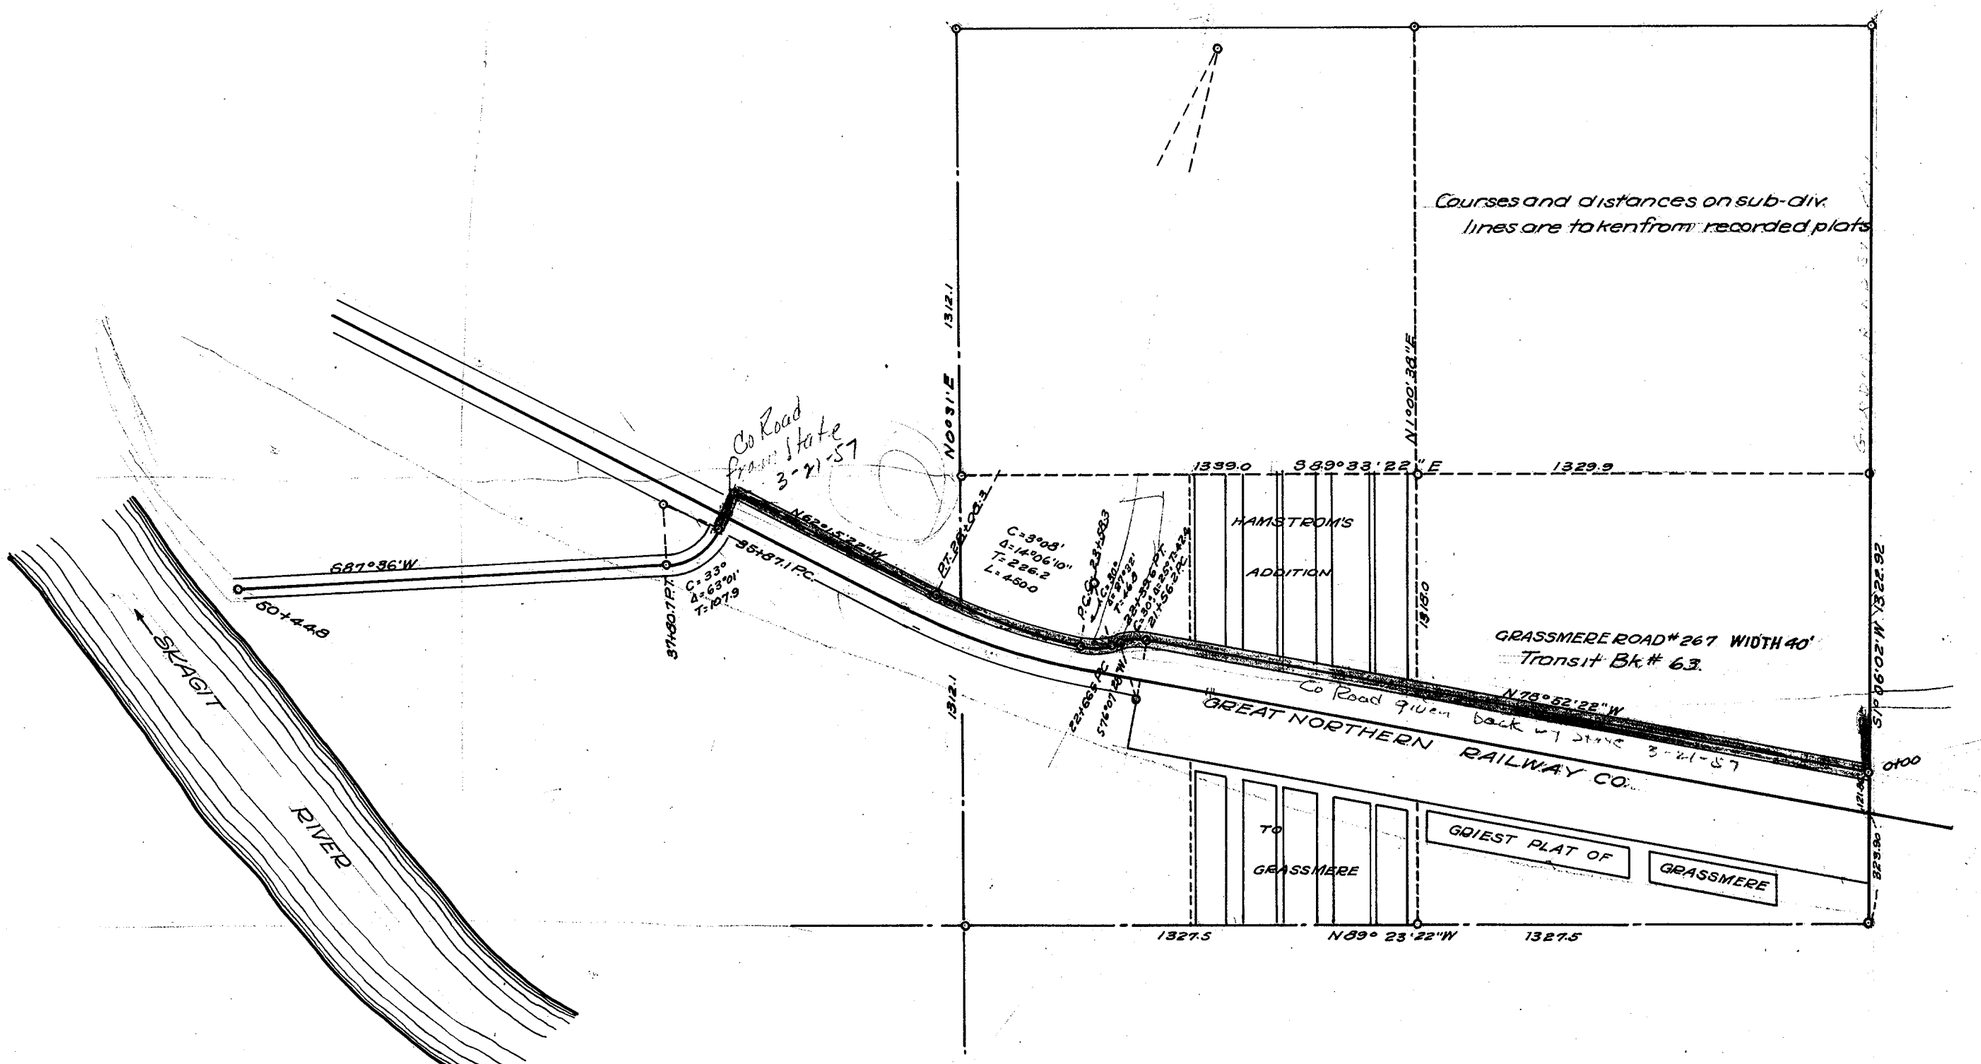

SECTION 10


TOWNSHIP 35 NORTH, RANGE 8 EAST, W. M.

SKAGIT COUNTY, WASH.

SCALE, 1 INCH--400 FEET
Road No.310 from OY-10 & Subdivision from Plat Vol.4, P13

DATE January, 1960

Frank Gilkey COUNTY ENGINEER

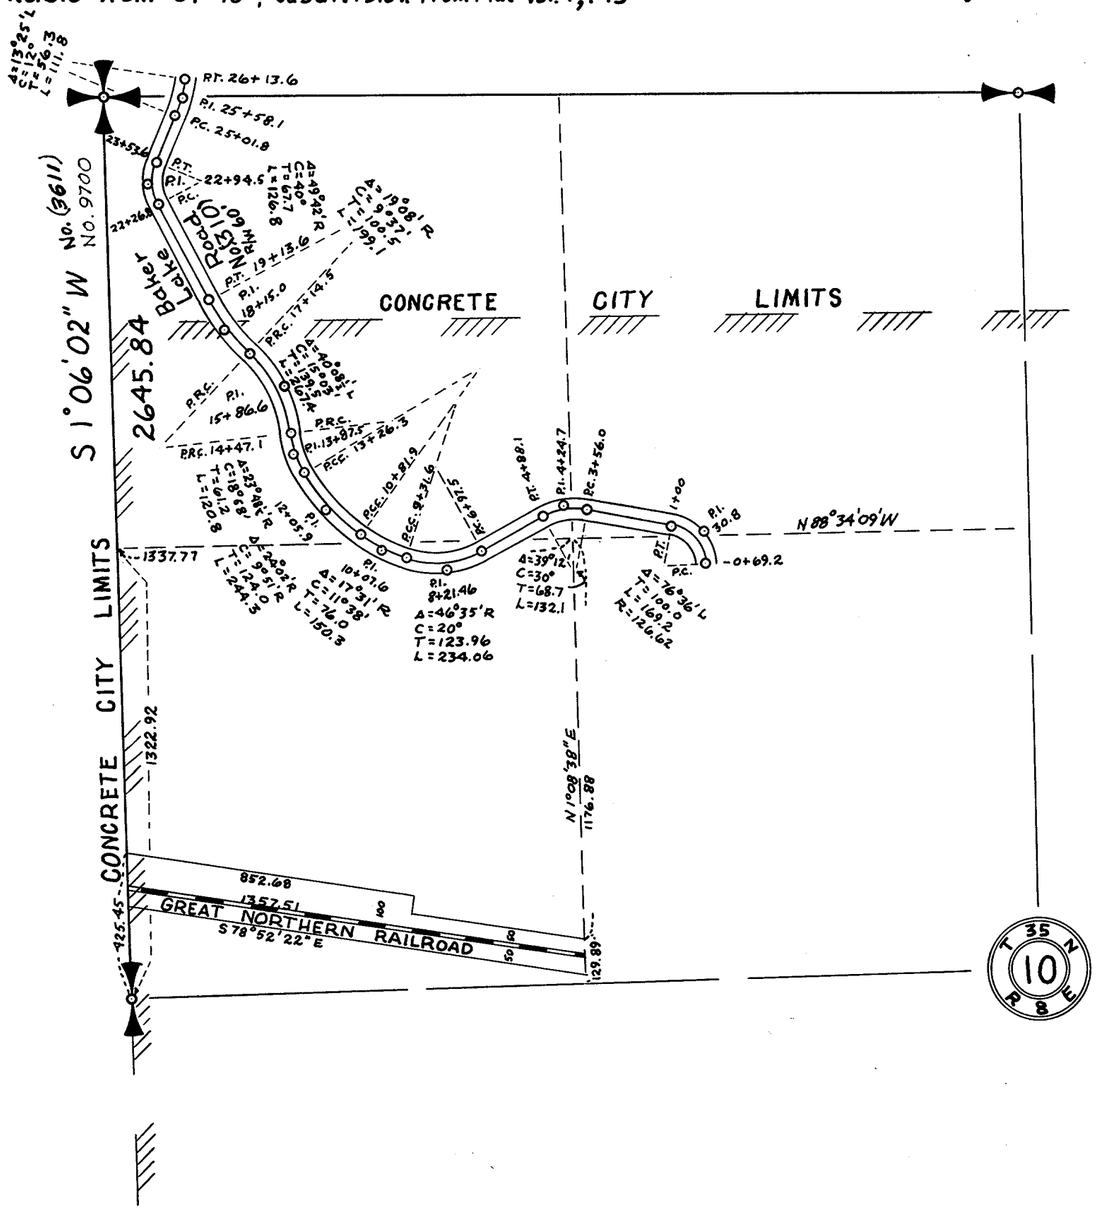

SECTION 11


TOWNSHIP 35 NORTH, RANGE 8 EAST, W. M.

SKAGIT COUNTY, WASH.

SCALE, 1 INCH -- 400 FEET

DATE Aug. 25, 1966

Lloyd Johnson COUNTY ENGINEER

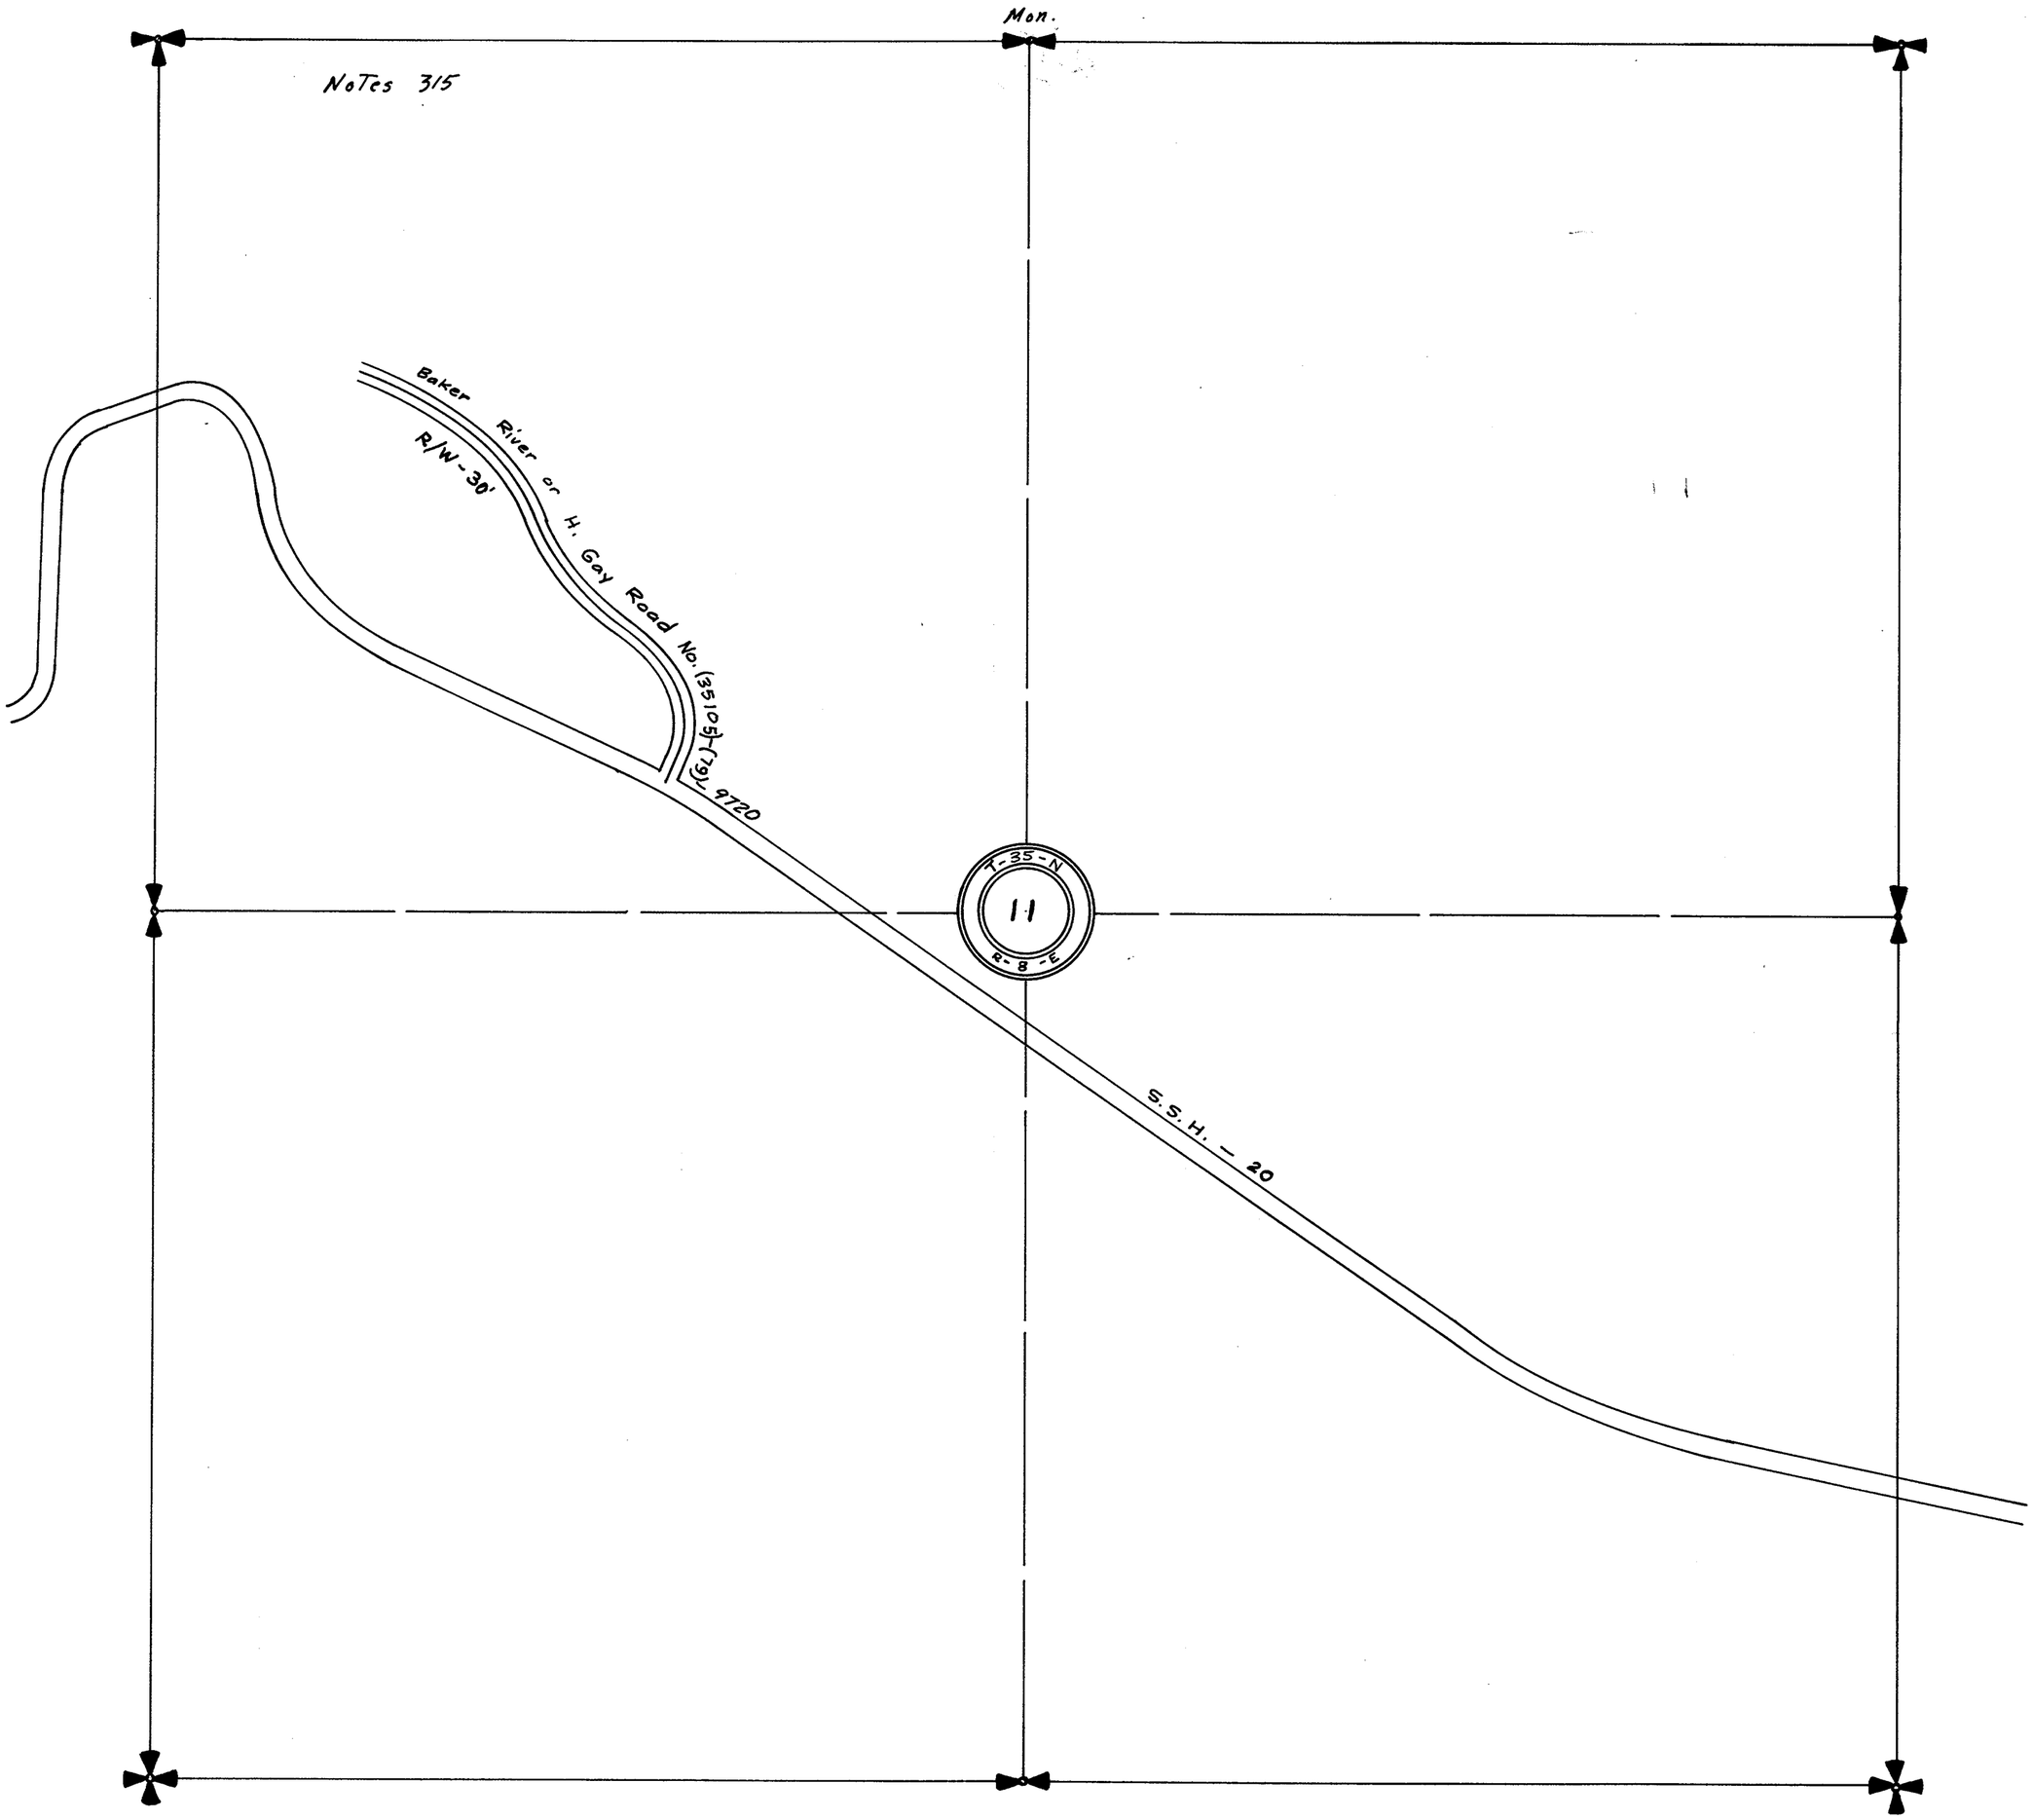

SECTION 13


TOWNSHIP 35 NORTH, RANGE 8 EAST, W. M.

SKAGIT COUNTY, WASH.

SCALE, 1 INCH -- 400 FEET

DATE Aug 25, 1966

Lloyd Johnson COUNTY ENGINEER

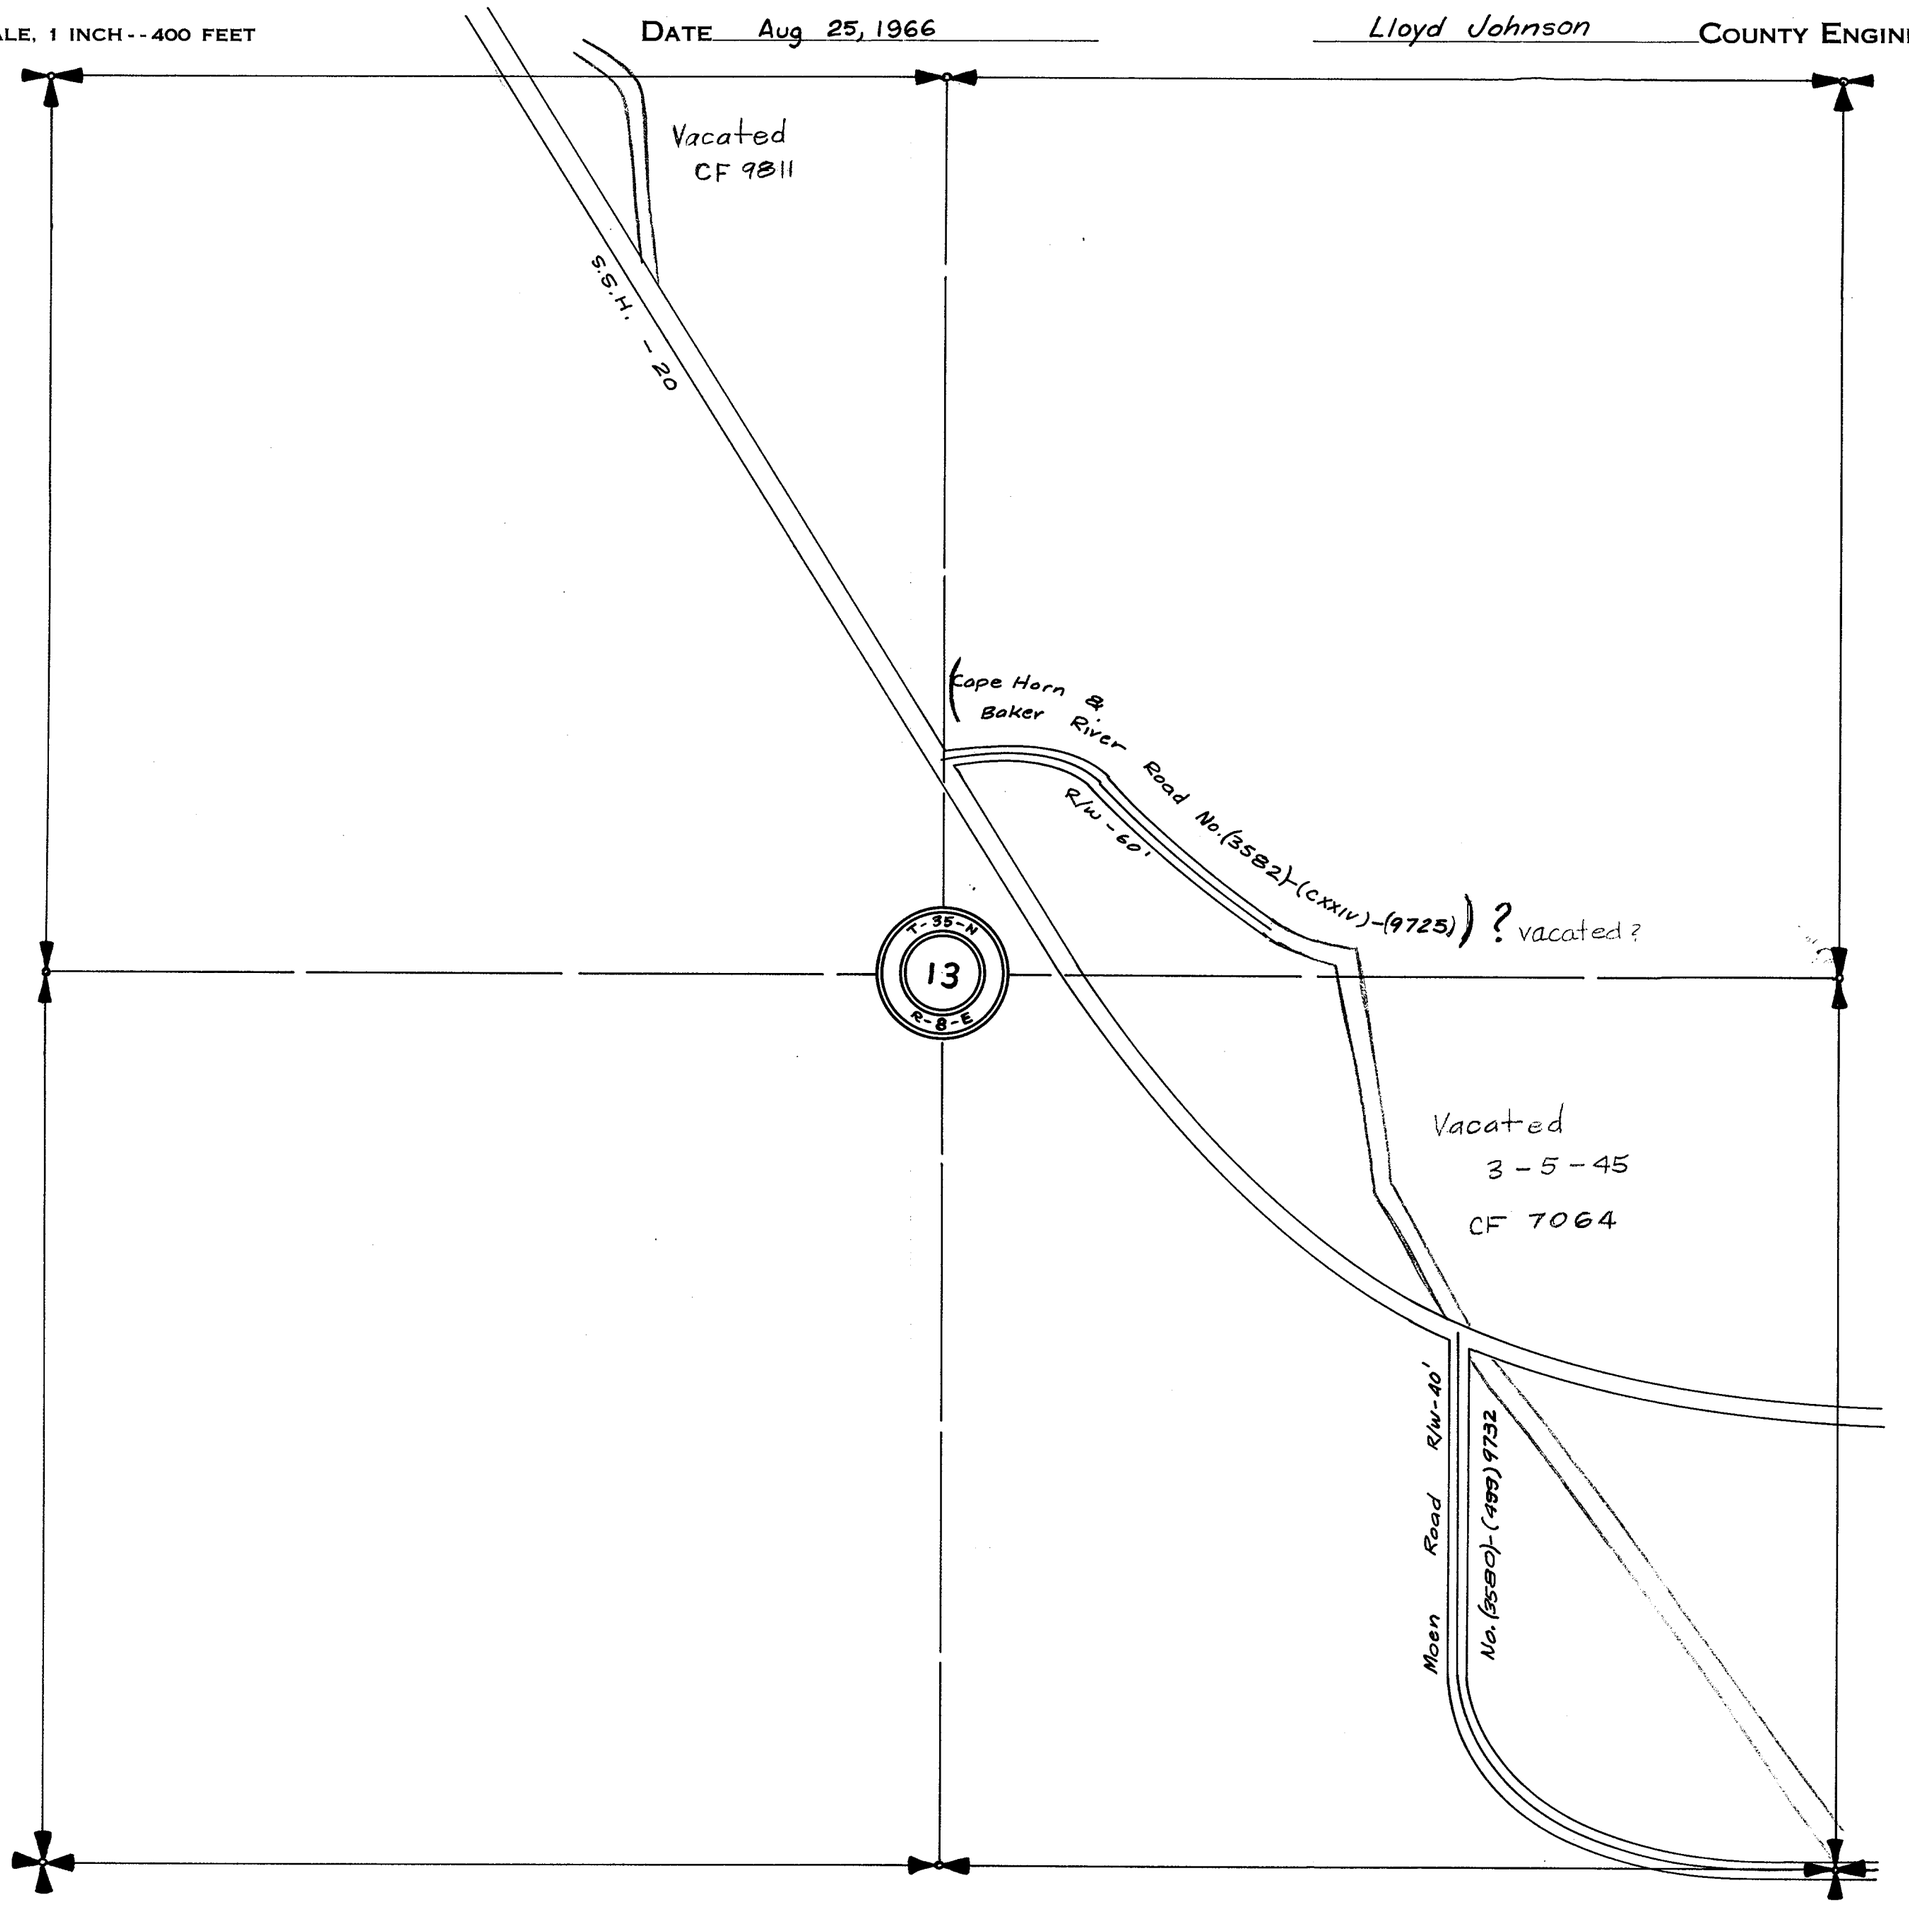

SECTION 14


TOWNSHIP 35 NORTH. RANGE 8 EAST. W. M.

SKAGIT COUNTY. WASH.

SCALE. 1 INCH—400 FEET

LLOYD H. JOHNSON COUNTY ENGINEER

DATE July 5, 1972

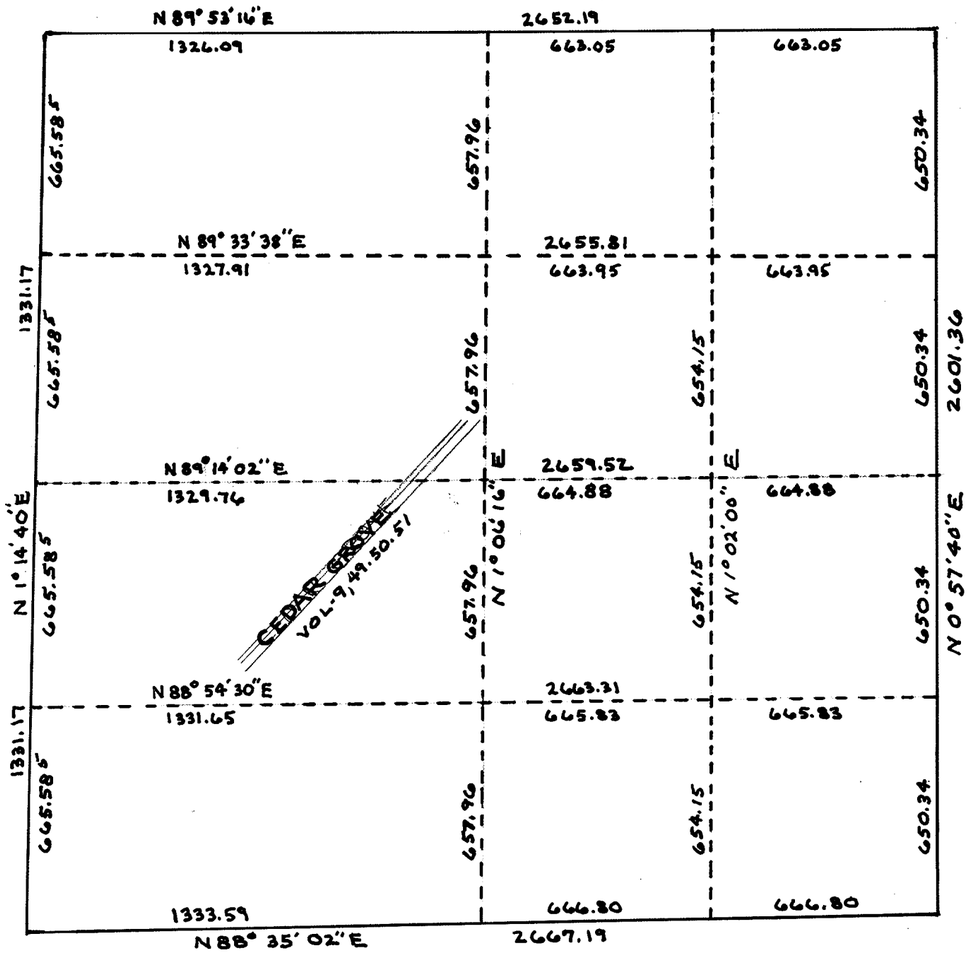

SECTION 14


TOWNSHIP 35 NORTH, RANGE 8 EAST, W. M.

SKAGIT COUNTY, WASH.

H. O. Walberg COUNTY ENGINEER

SCALE, 1 INCH--400 FEET

Fabor-Dalles Co-ordinates '50

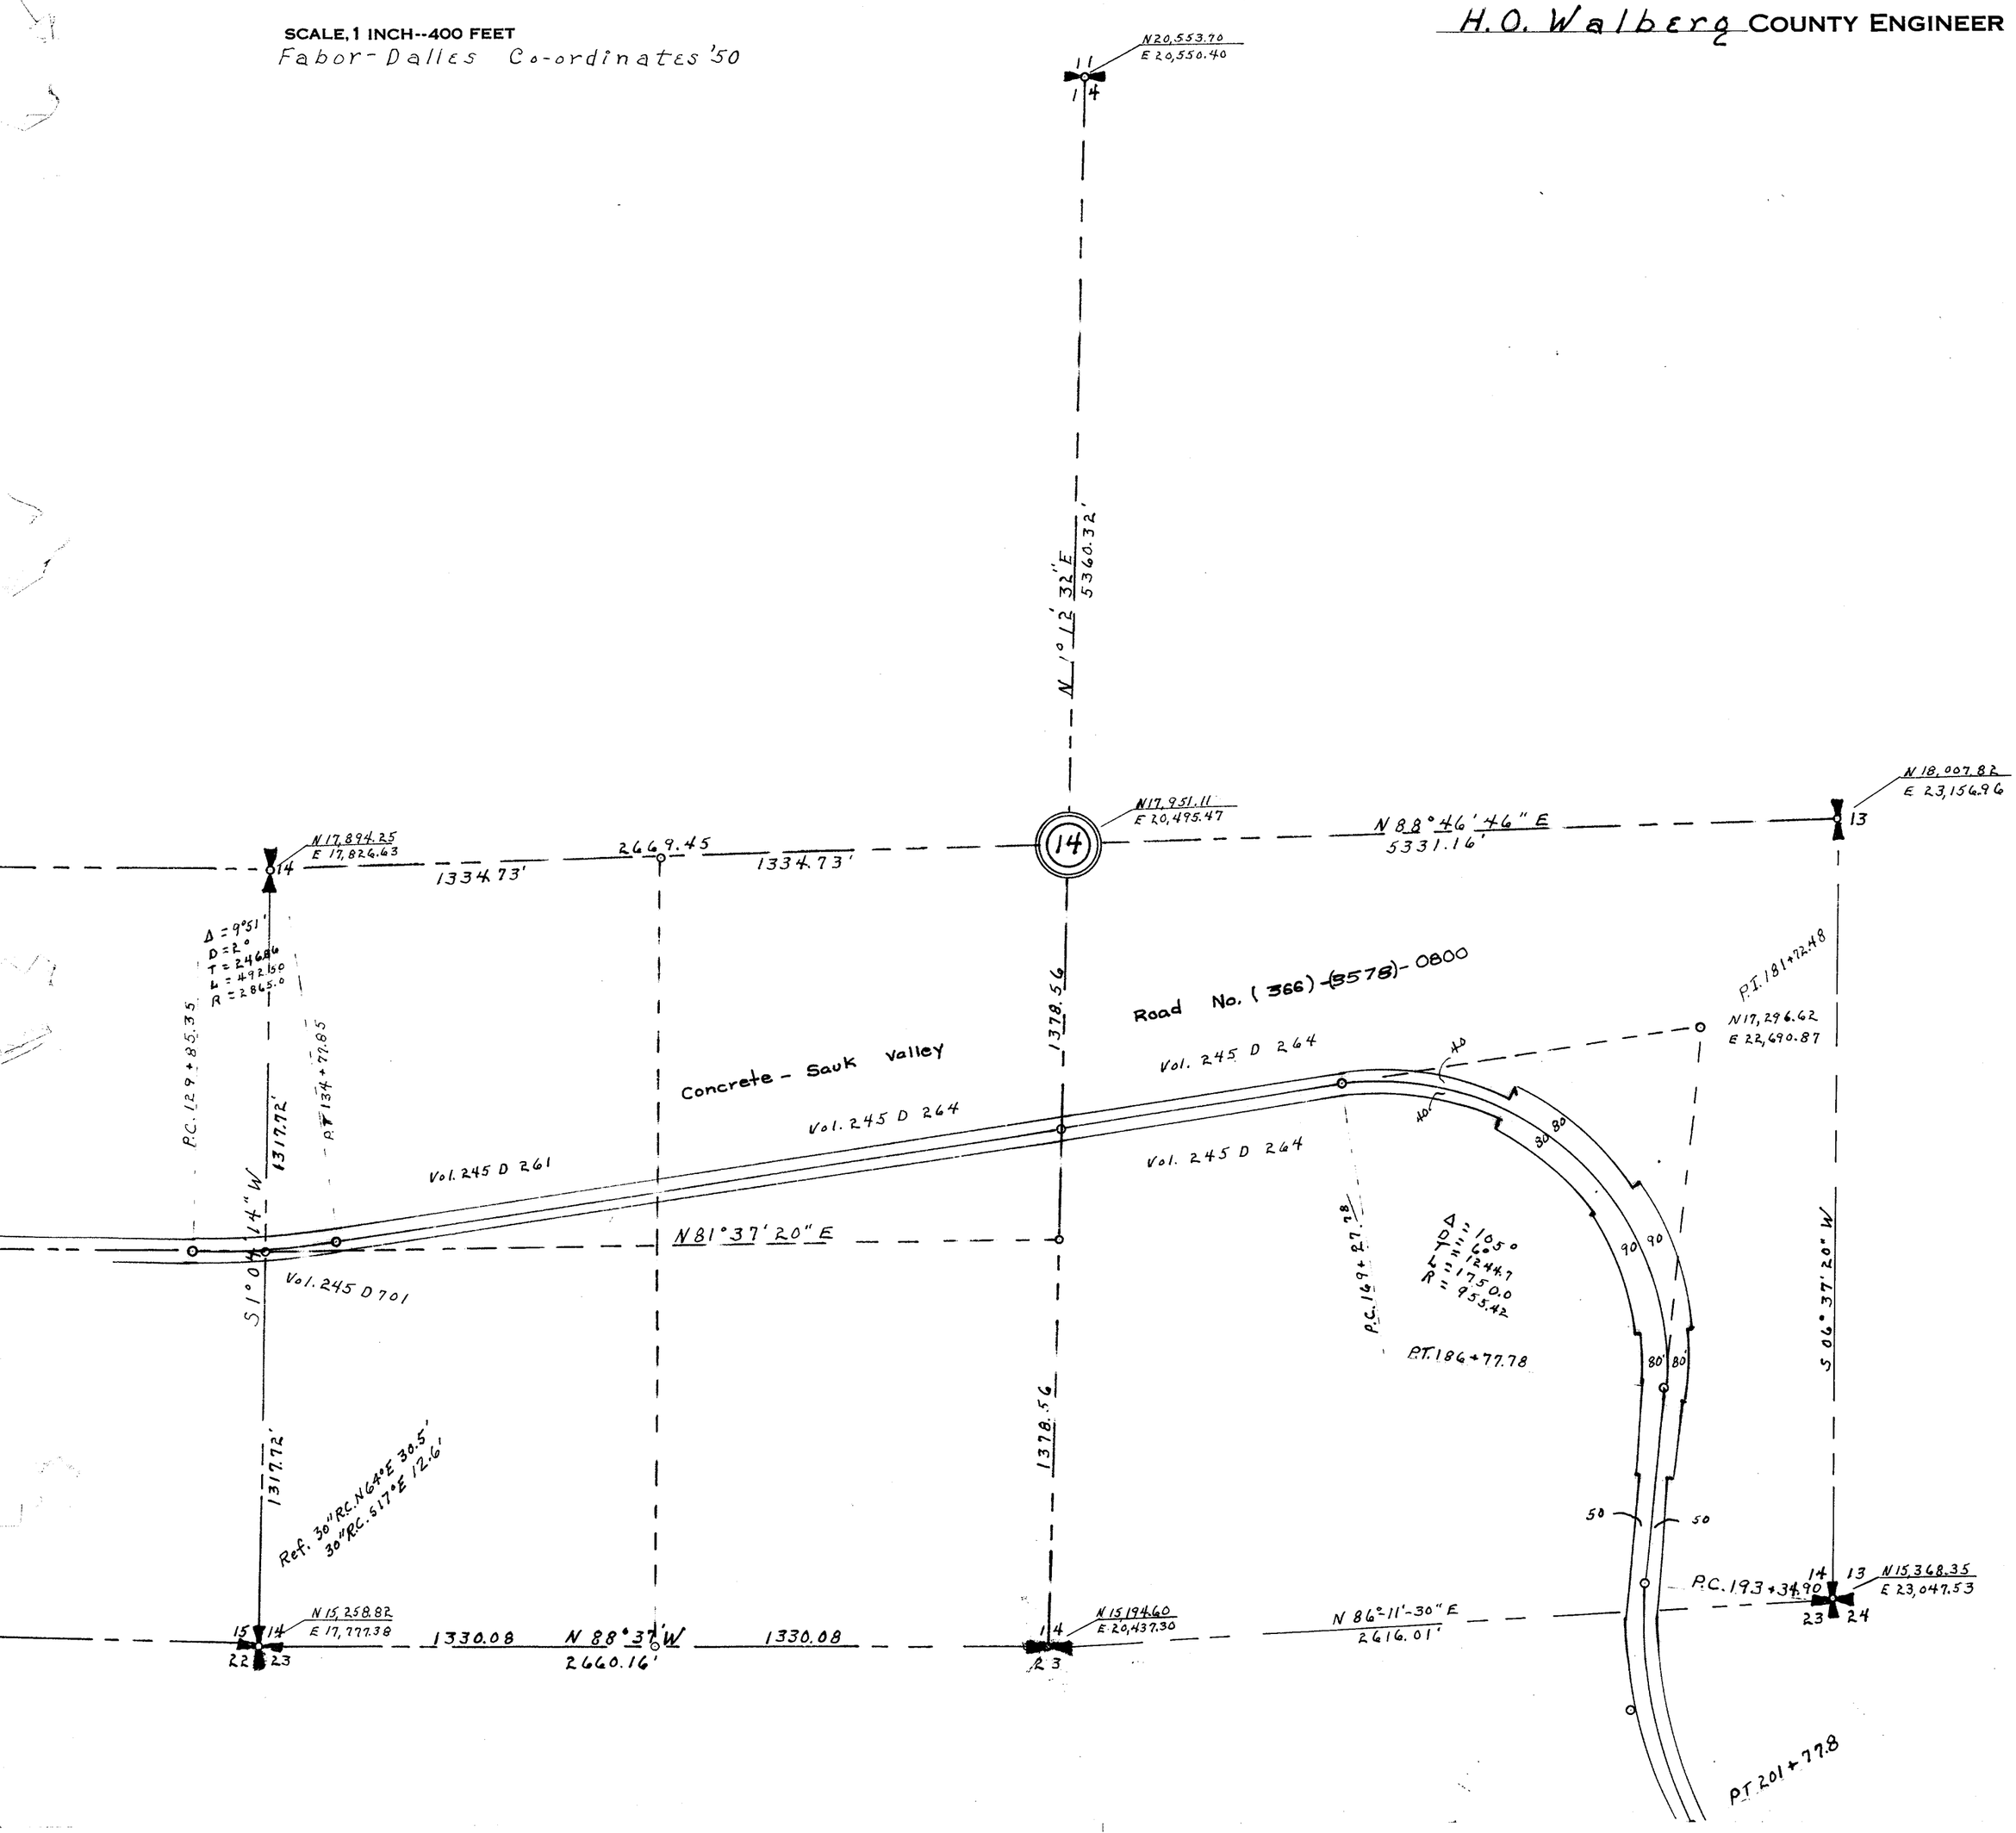


SECTION 15

TOWNSHIP 35 NORTH. RANGE 8 EAST. W. M.
SKAGIT COUNTY. WASH.

SCALE, 1 INCH—400 FEET

LLOYD H. JOHNSON COUNTY ENGINEER

DATE July 5, 1972

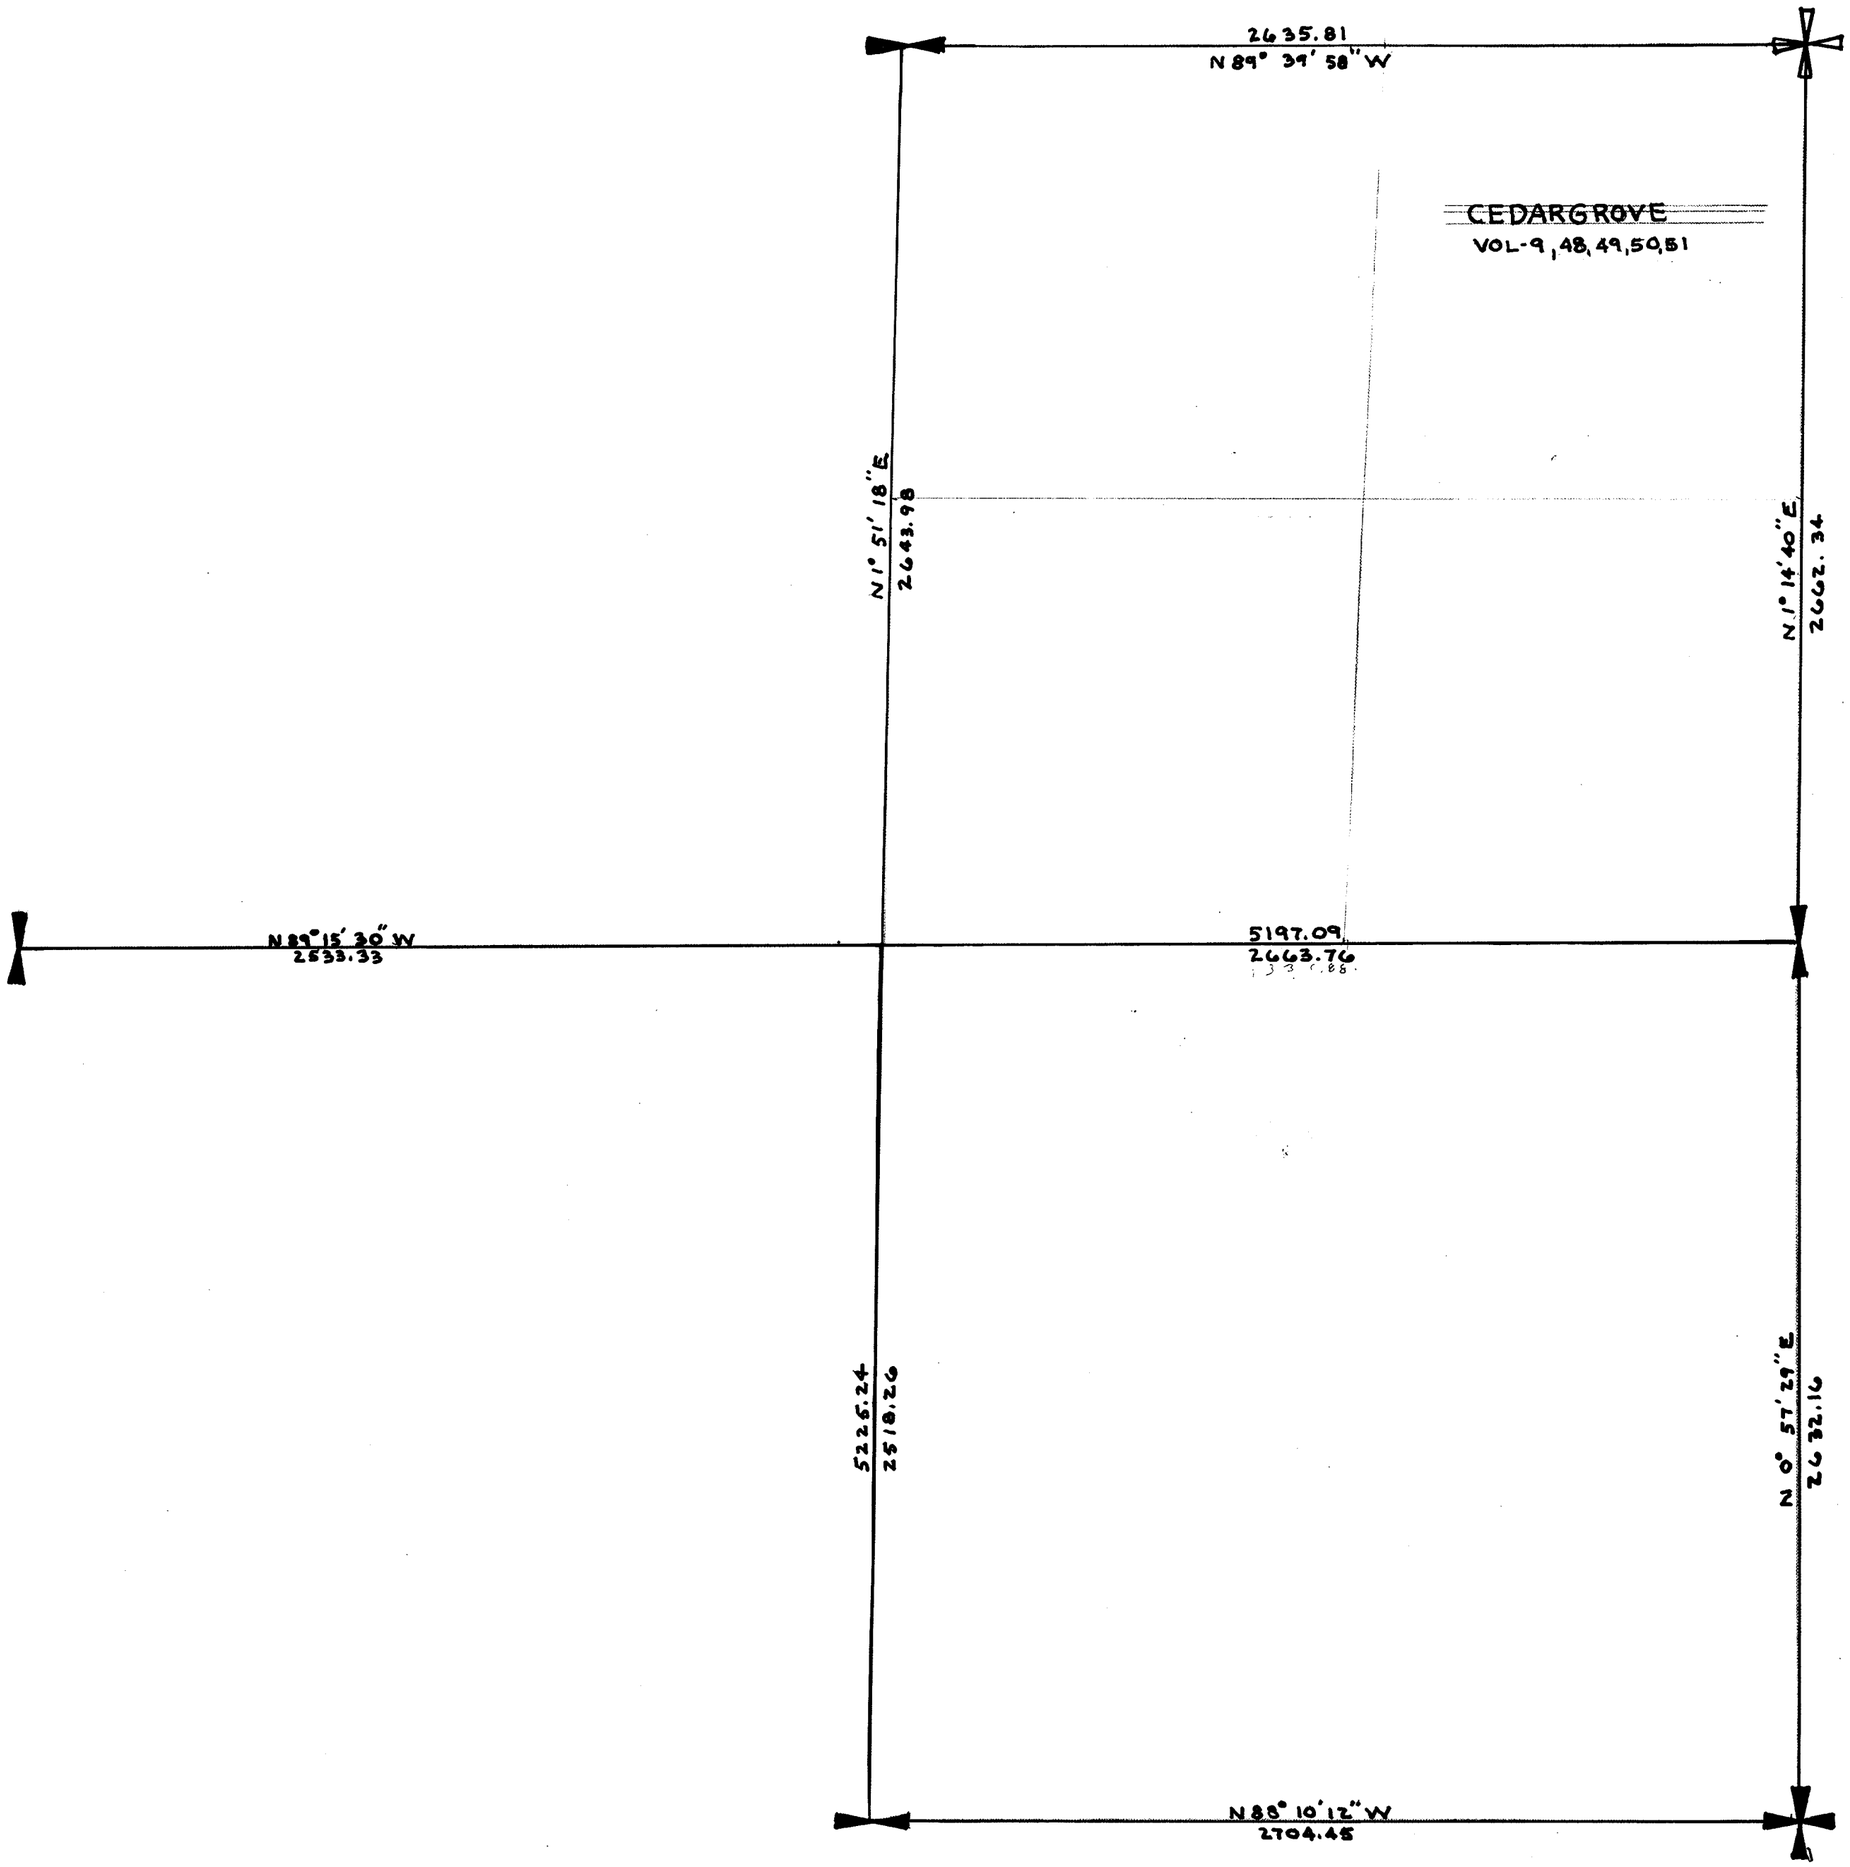

SECTION 15

TOWNSHIP 35 NORTH, RANGE 8 EAST, W. M.

SKAGIT COUNTY, WASH.

H. O. Walberg COUNTY ENGINEER

SCALE, 1 INCH--400 FEET

Fabor-Dalles Co-ordinates '50

N 20614.68
E 12,626.34

N 20,577.55
E 15,253.48

1351.03'

S 89° 11' 25" E
2627.40'

Vol. 242 D 238

N 0° 05' 50" E 1318.90'
2437.80'

1318.90'

N 2° 02' 05" E
2642.53

N 17,936.60
E 15,159.42

N 17996.88
E 12621.81

1368.63'

S 89°05'25"E

1249.03'

2538.07'

1249.03'

13,333.67'

1333.68

N 17,894.25
E 17,826.63

Δ = 52° 52' Lt
D = 3° 40'
T = 776.83
L = 1441.82
R = 1562.61

P.C. 6+47.28

Δ = 9°51'
D = 2°
T = 246.86
L = 492.43
R = 2864.80

P.C. 129+85.35

P.T. 134+77.85

1317.71'

1226.86'

O.T. 80+91.10 B
80+79.72 A

Skagit River

P.T. 89+77.89

P.C. 94+26

P.T. 98+05.38

Δ = 18°40'
D = 6°
T = 159.02
L = 311.12
R = 954.90

1291.85

Lot 8

Lot 9

Sta 105+42.93
N 16,645.56
E 15,113.75

Vol. 245 D 260

N 16,576.78
E 17,802.02

P.I 132+34.21

S 87°53'40"E

135'

P.T. 94+26'

N 2° 05' 50" E

Vol. 245 D 262

Vol. 245 D 263

S 88° 32' 01" E
1344.63'

1344.64'

Vol. 242 D 239

Lot 6

P.C. 88+26.42

P.T. 91+26.42

Δ = 18°
D = 6°
T = 151.32
L = 300'
R = 954.90

P.T. 96+51.28

Vol. 245 D 702

Lot 7

Vol. 245 D 702

Vol. 245 D 702

1226.86'

1291.84'

Finney Cr. Rd.

1317.72'

S 1° 04' 14" W

Ref.
30" R.C. N 64° E 30.5'
30" R.C. 517° E 12.6'

N 15,527.19
E 12,532.61

1340.09'

S 86° 06' 14" E

1270.57'

1270.57'

N 15,354.53
E 15,047.88

S 87° 58' 37" E
1355.57'

1355.60'

N 15,258.82
E 17,777.38

Run 6½

SECTION 15


TOWNSHIP 35 NORTH, RANGE 8 EAST, W. M.

SKAGIT COUNTY, WASH.

SCALE, 1 INCH--400 FEET

COUNTY ENGINEER

CRP # 423

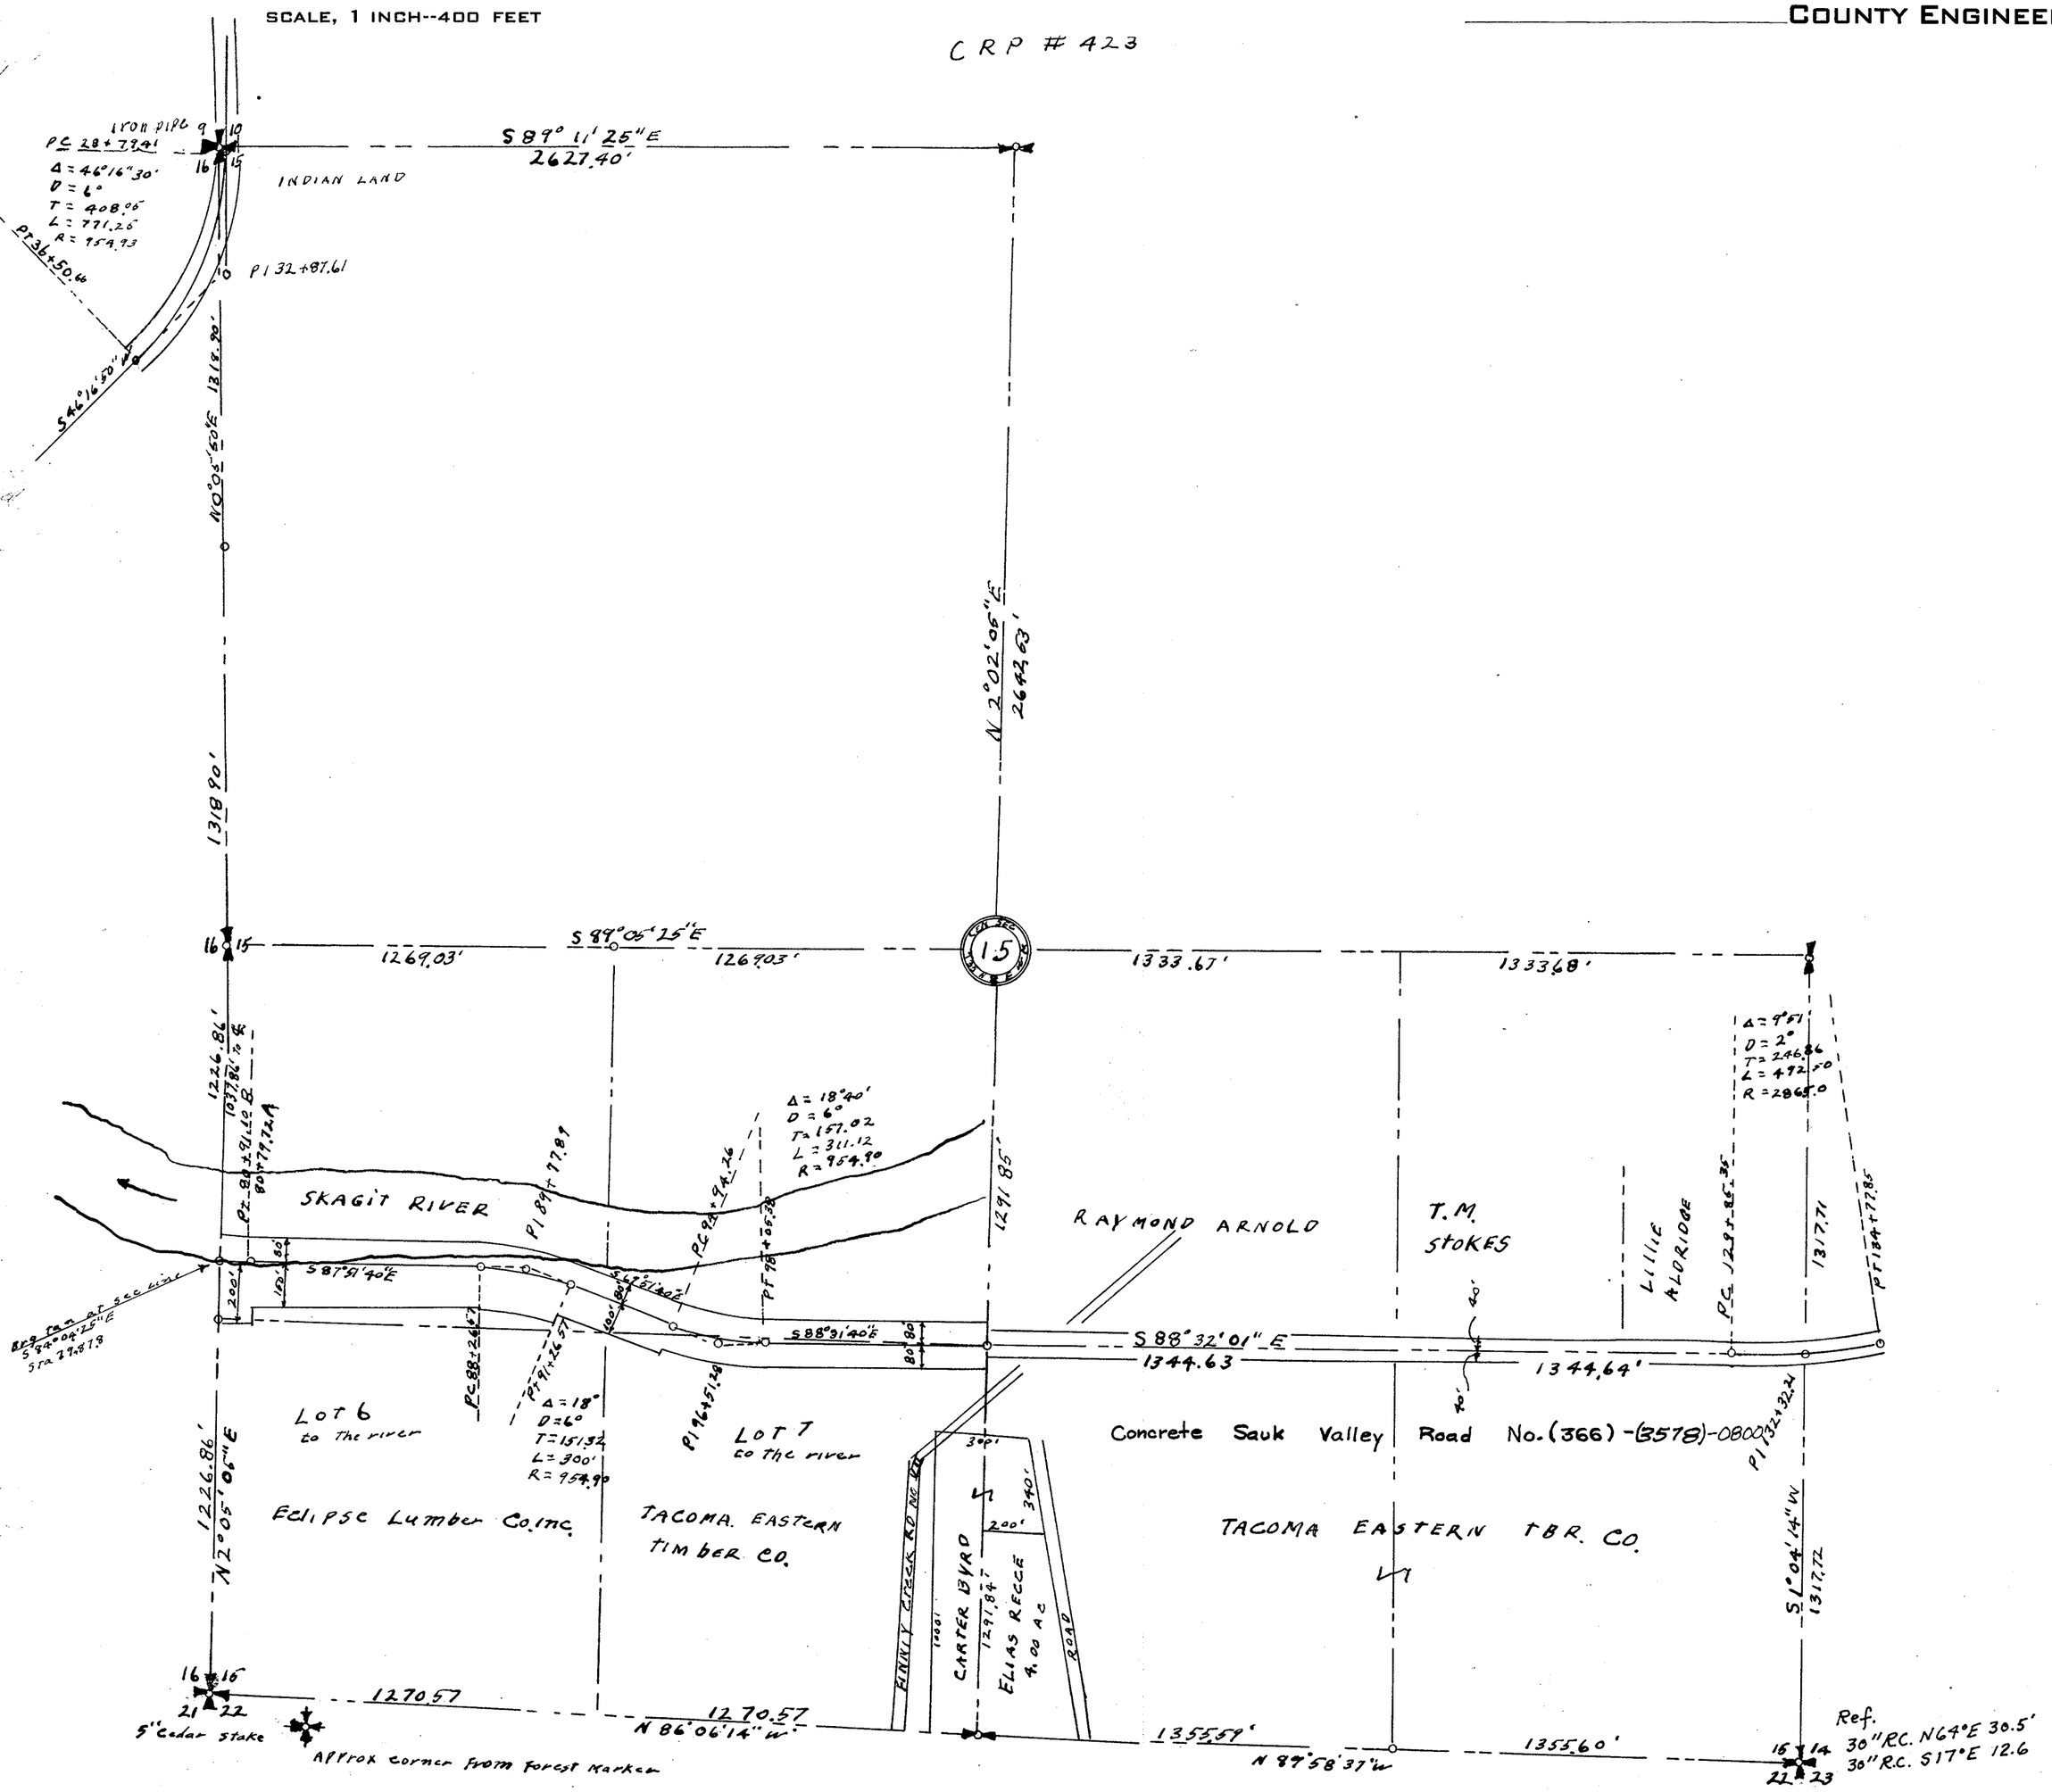


RIGHT OF WAY PLAT

SECTION 16
TOWNSHIP 35 NORTH, RANGE 8 EAST, W.M.
FOR SKAGIT COUNTY, WASH.

SCALE 1 INCH = 400 FEET

_____ COUNTY ENGINEER

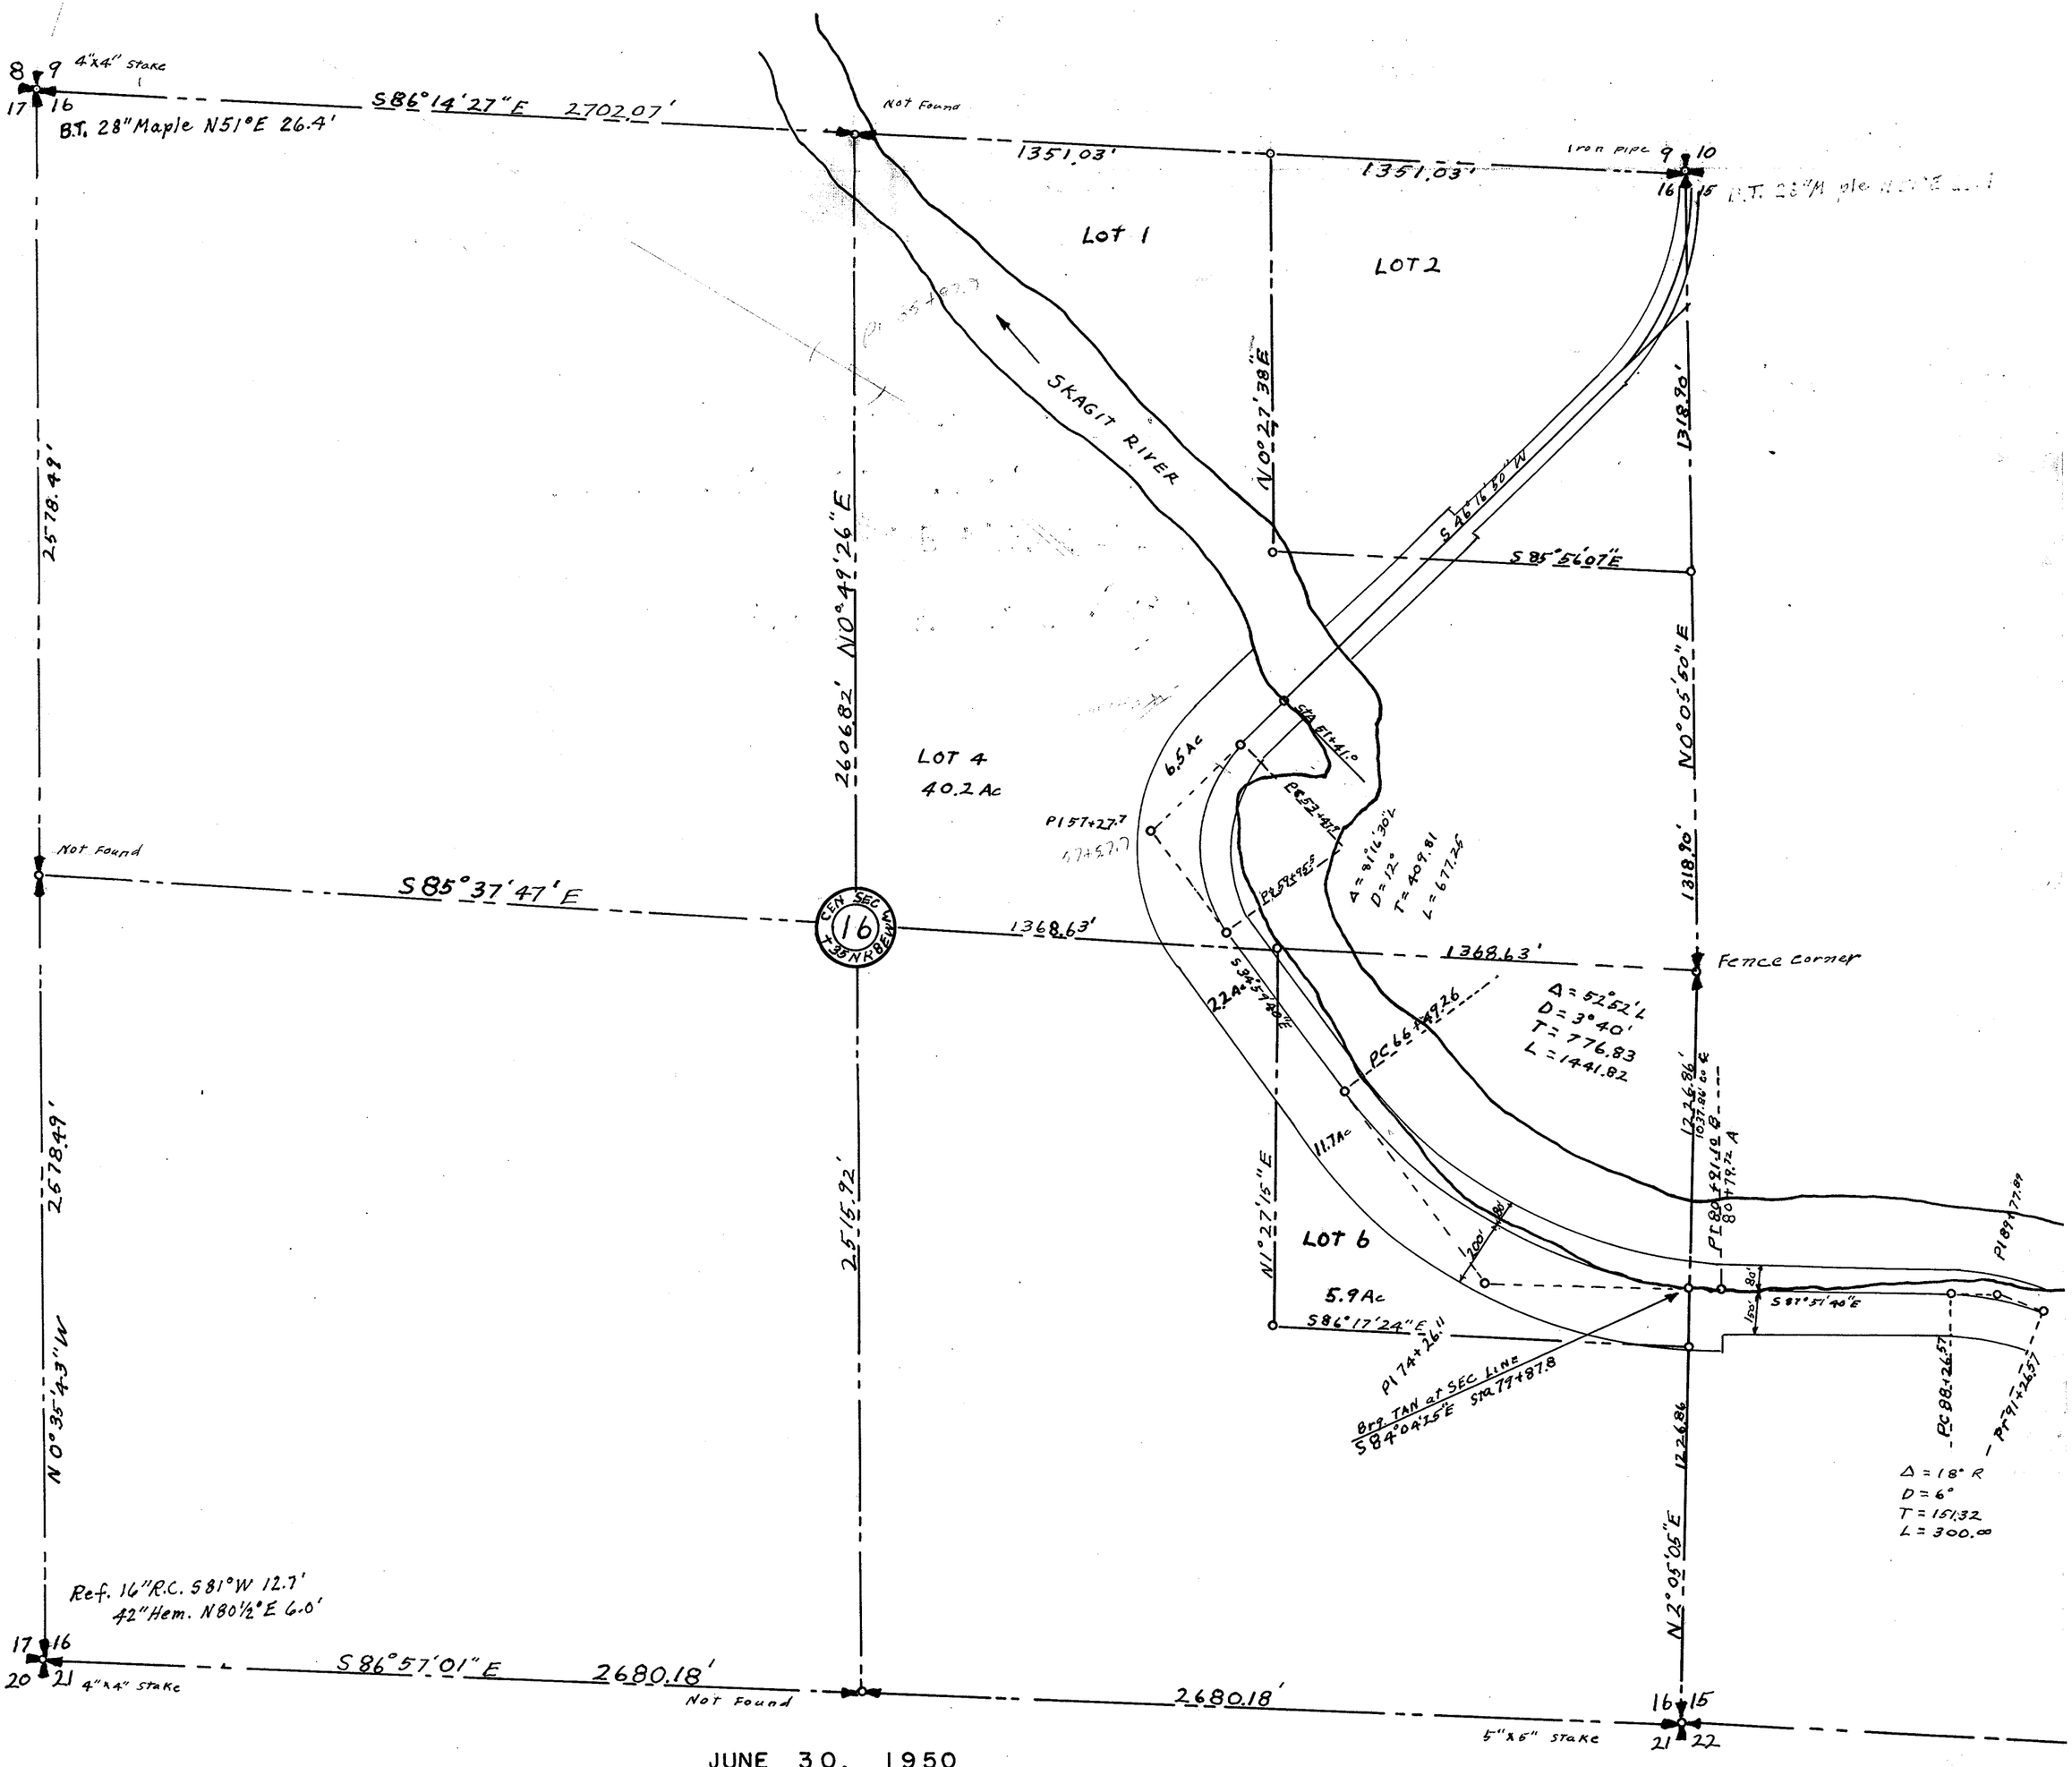

JUNE 30, 1950

I HJALMAR WALBERG COUNTY ROAD ENGINEER OF SKAGIT COUNTY, WASH., DO HEREBY CERTIFY THAT THIS MAP ACCURATELY REPRESENTS THE LOCATION OF SAID COUNTY'S ROAD ACROSS SECTION 16, TOWNSHIP 35 NORTH, RANGE 8 EAST W.M.

H.O. Walberg
COUNTY ROAD ENGINEER SKAGIT COUNTY

H. O. WALBERG STATE OF WASHINGTON REGISTERED PROFESSIONAL ENGINEER


SECTION 16

TOWNSHIP 35 NORTH, RANGE 8 EAST, W. M.

SKAGIT COUNTY, WASH.

DATE January, 1960 — Frank Gilkey COUNTY ENGINEER

SCALE, 1 INCH--400 FEET
Road No. 360 from Notes #868
Road No. 366 from Notes #638-0
Bearings from Hardshell A15/2

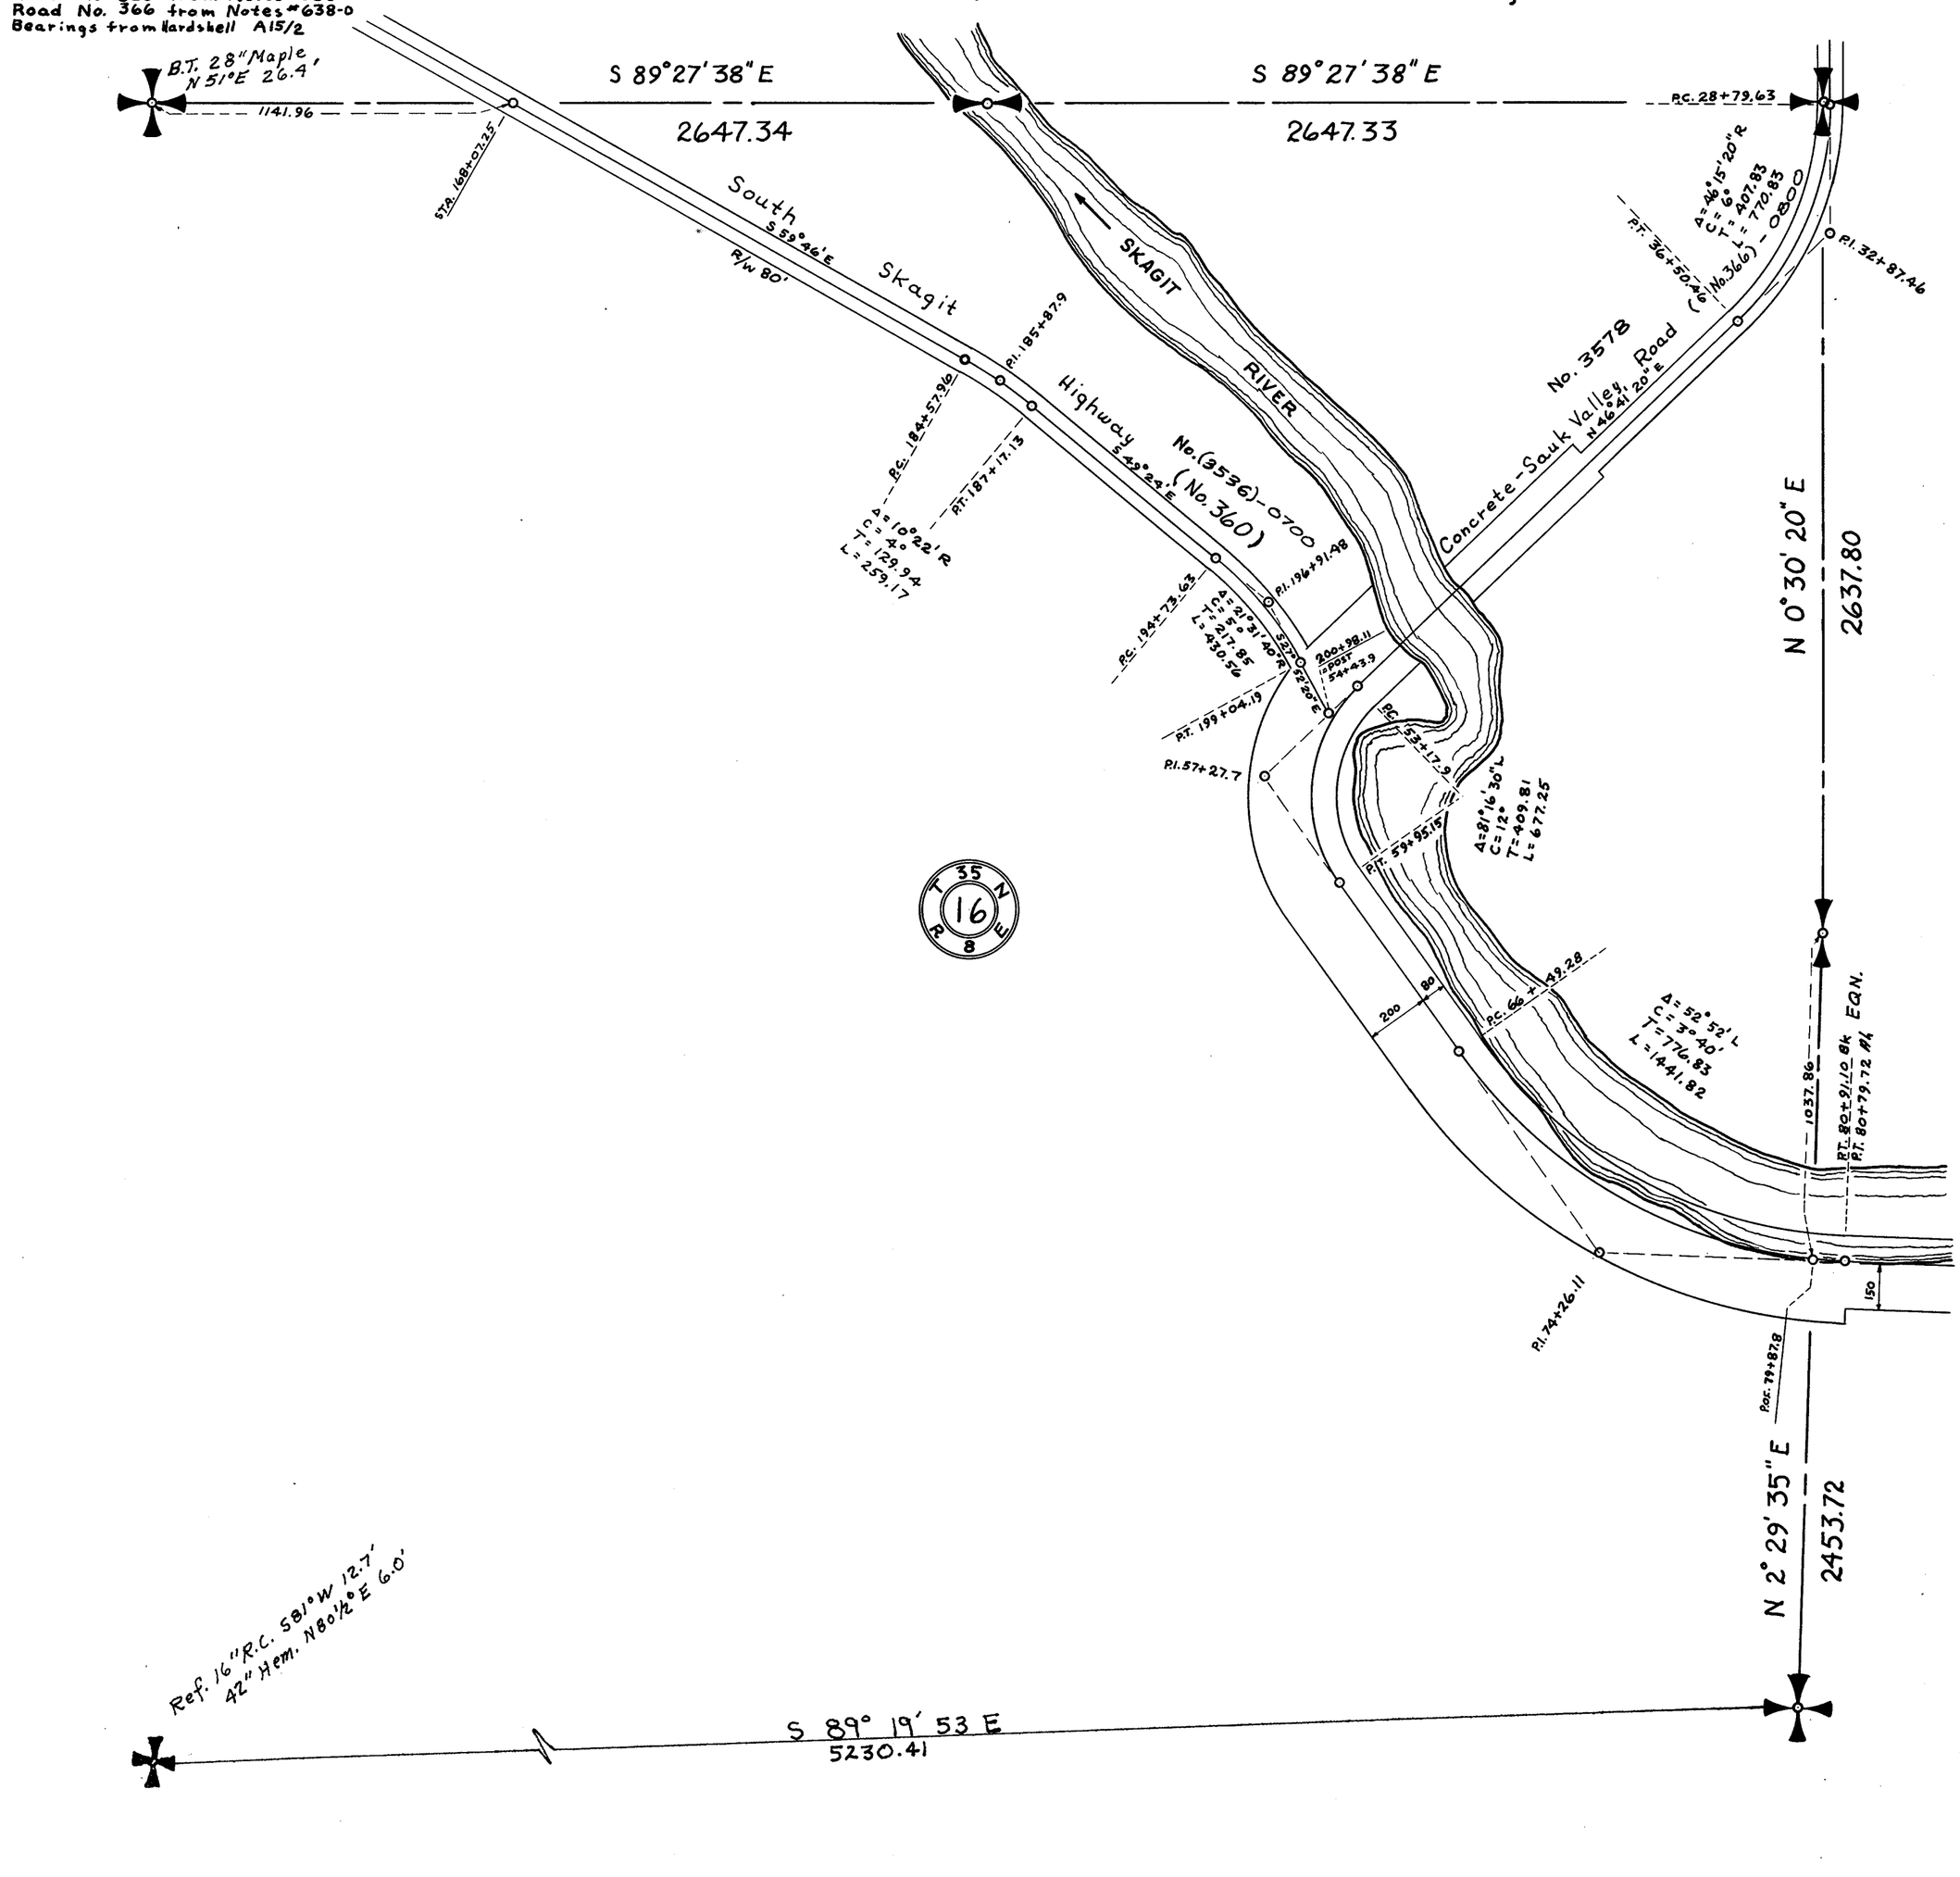


SECTION 17

TOWNSHIP 35 NORTH, RANGE 8 EAST, W. M.
SKAGIT COUNTY, WASH.

SCALE, 1 INCH–400 FEET

Robt. E. L. Knapp COUNTY ENGINEER
May 1932 Notes G 193

NE Cor.
B.T. 28" Maple N51°E
26.4'

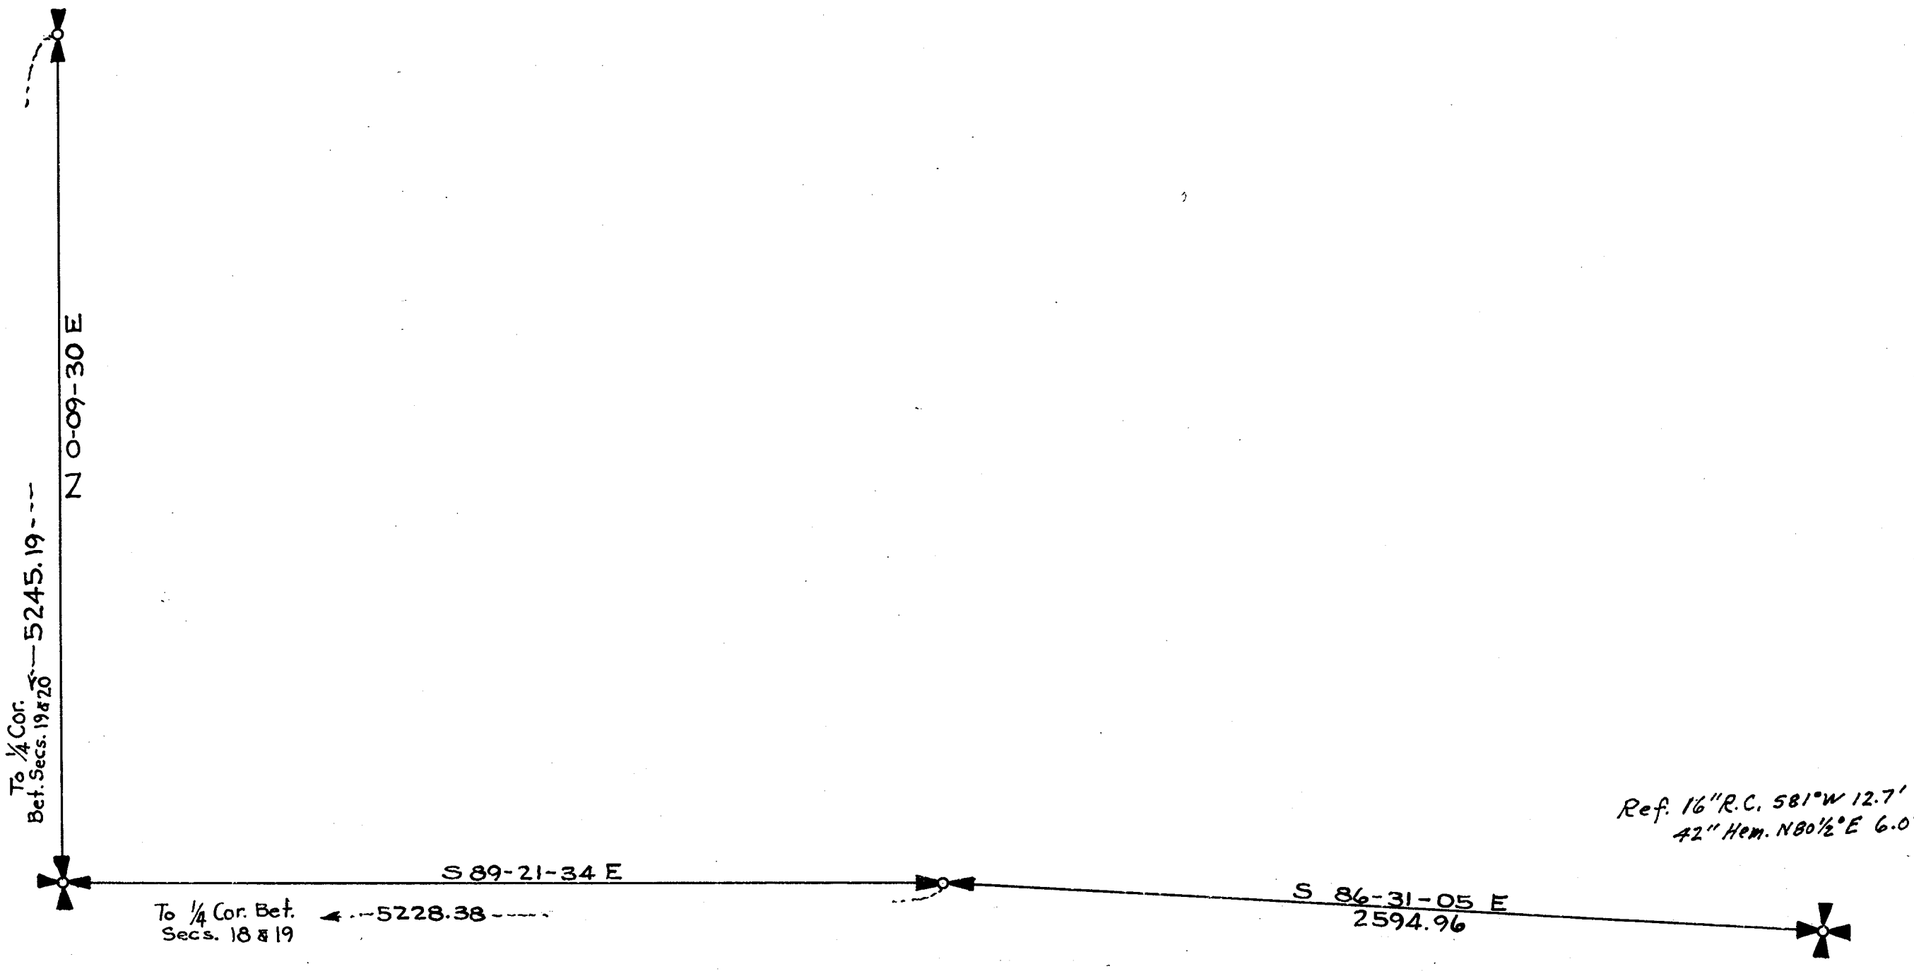

A15
2

SECTION 18

TOWNSHIP 35 NORTH, RANGE 8 EAST, W. M.

SKAGIT COUNTY, WASH.

SCALE, 1 INCH -- 400 FEET

DATE 1969

COUNTY ENGINEER




SECTION 18

TOWNSHIP 35 NORTH, RANGE 8 EAST, W. M.

SKAGIT COUNTY, WASH.

SCALE, 1 INCH–400 FEET

Robt. E. L. Knapp COUNTY ENGINEER
May 1932 Notes G 193

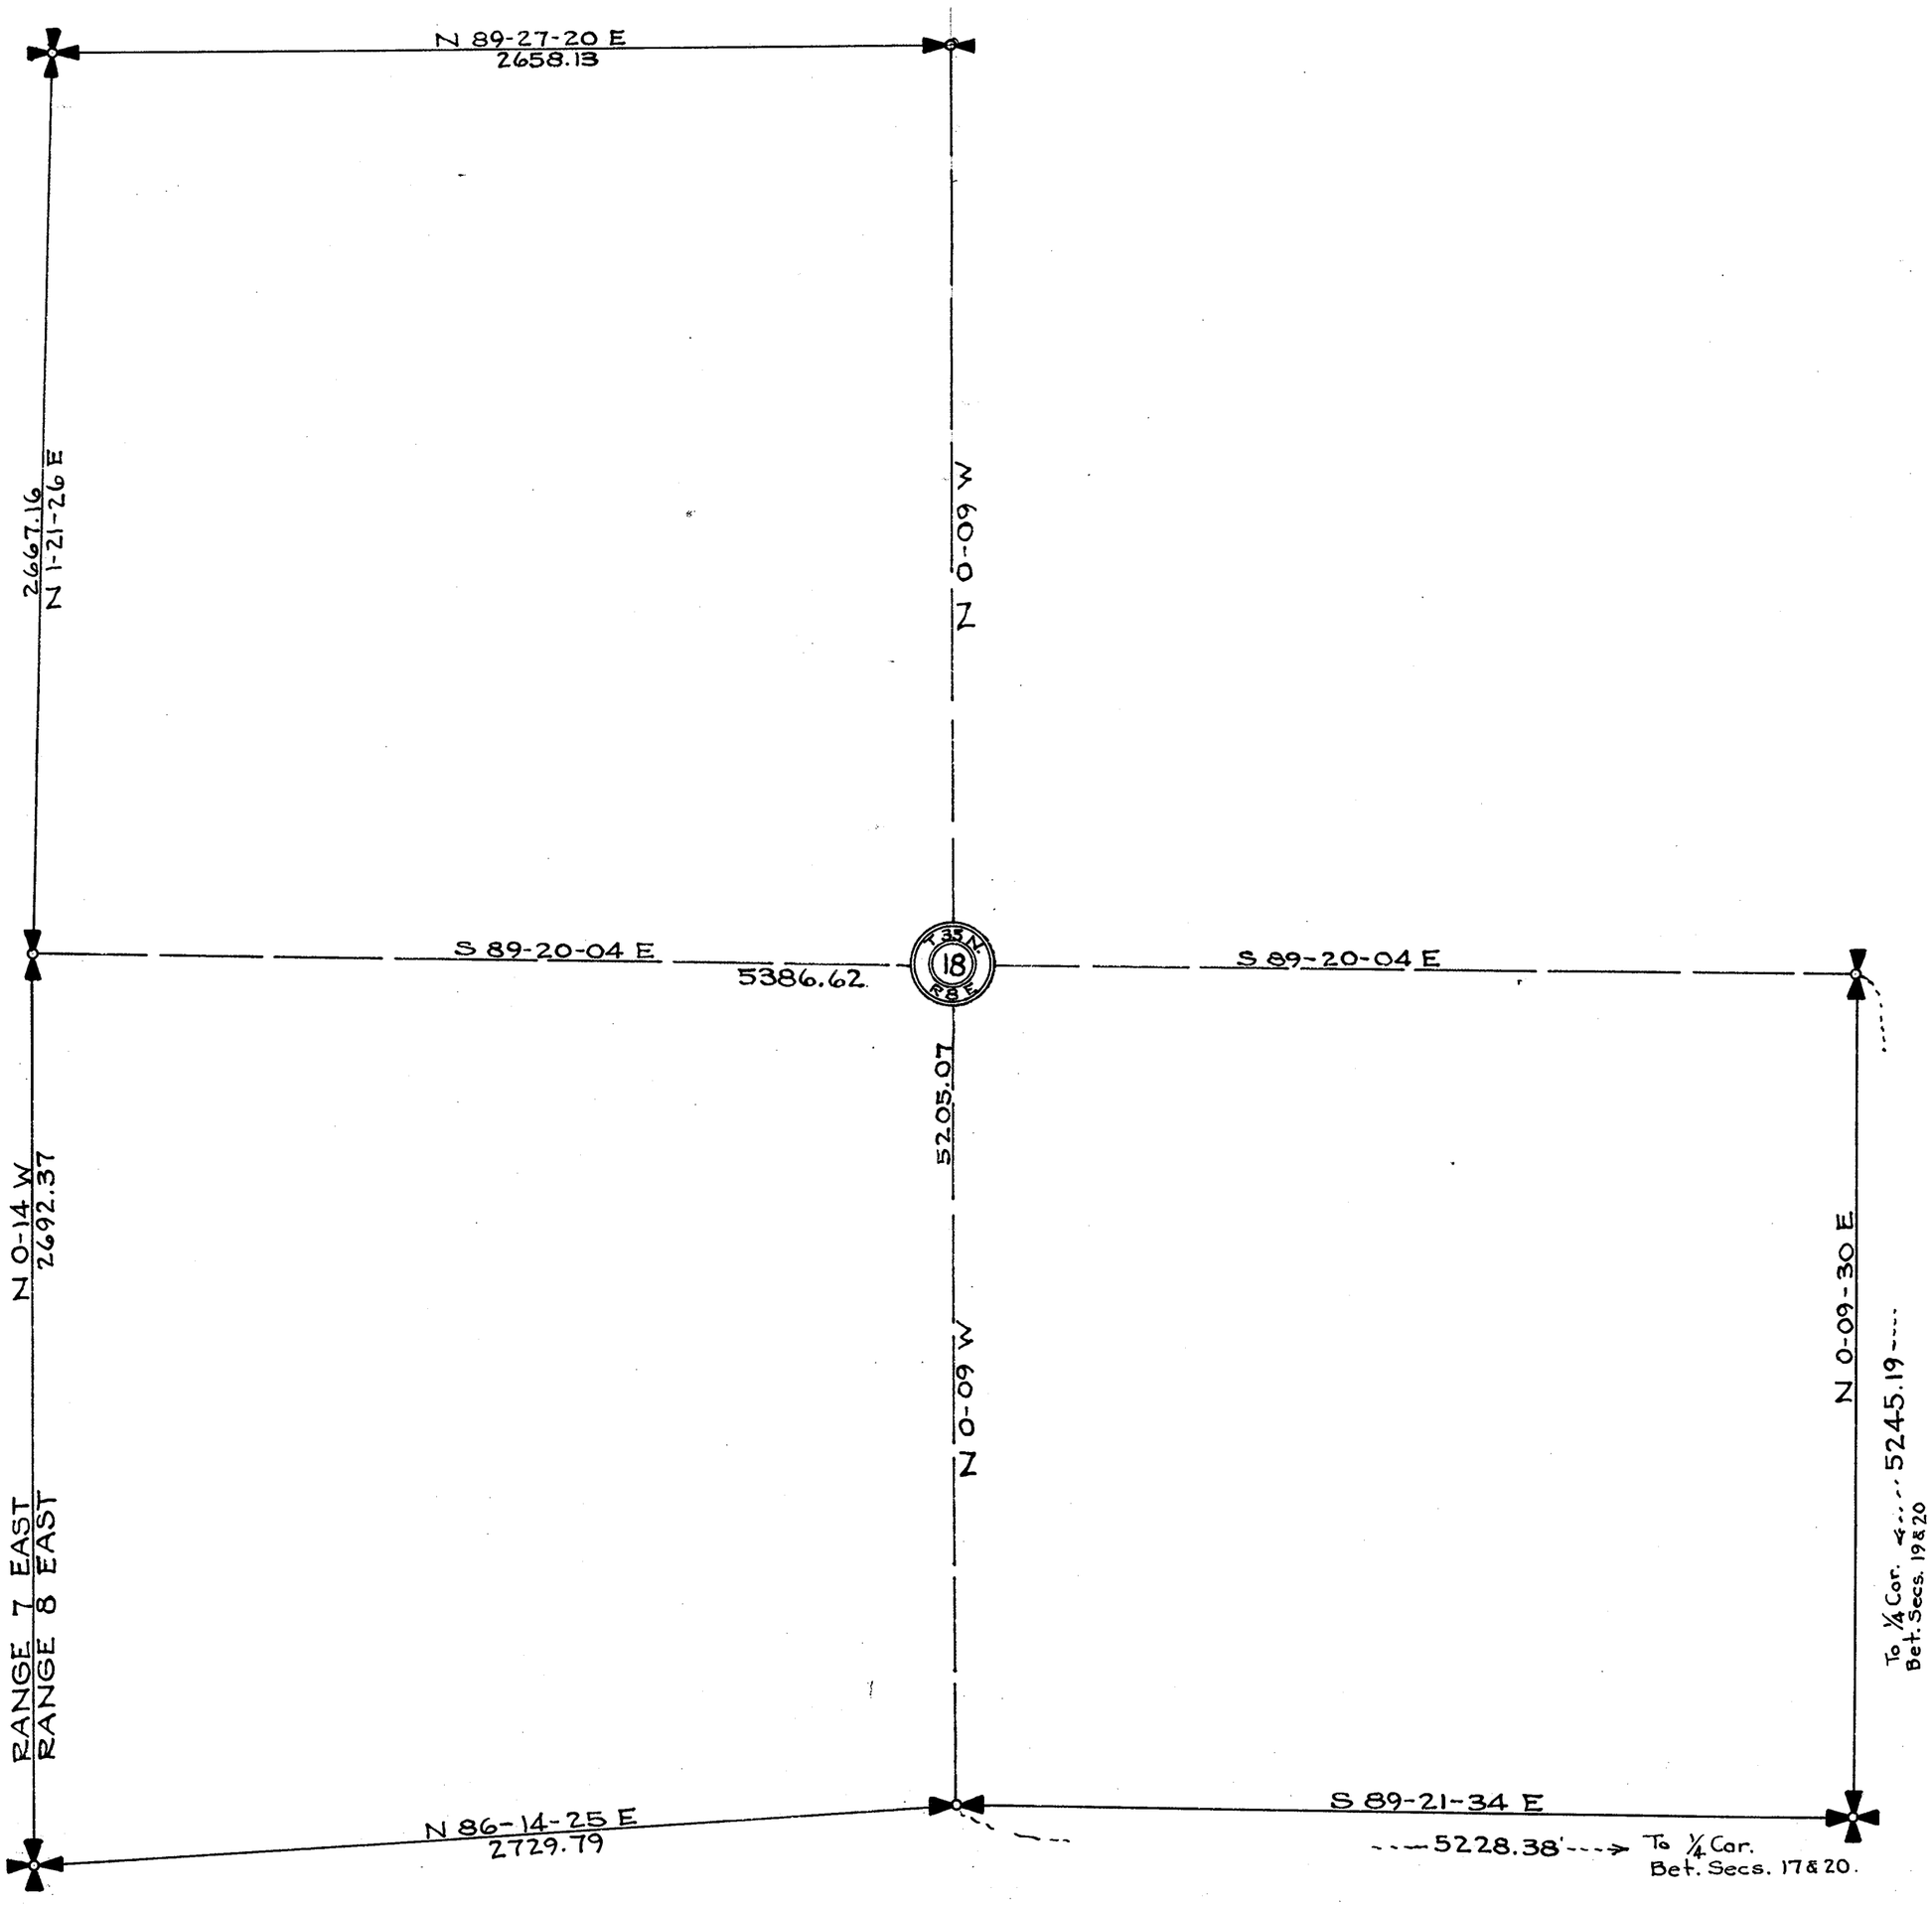

SECTION 18


TOWNSHIP 35 NORTH, RANGE 8 EAST, W. M.

SKAGIT COUNTY, WASH.

SCALE, 1 INCH--400 FEET

DATE _____ _____ COUNTY ENGINEER

W. E. Crane & Ass. Subdivision
1965

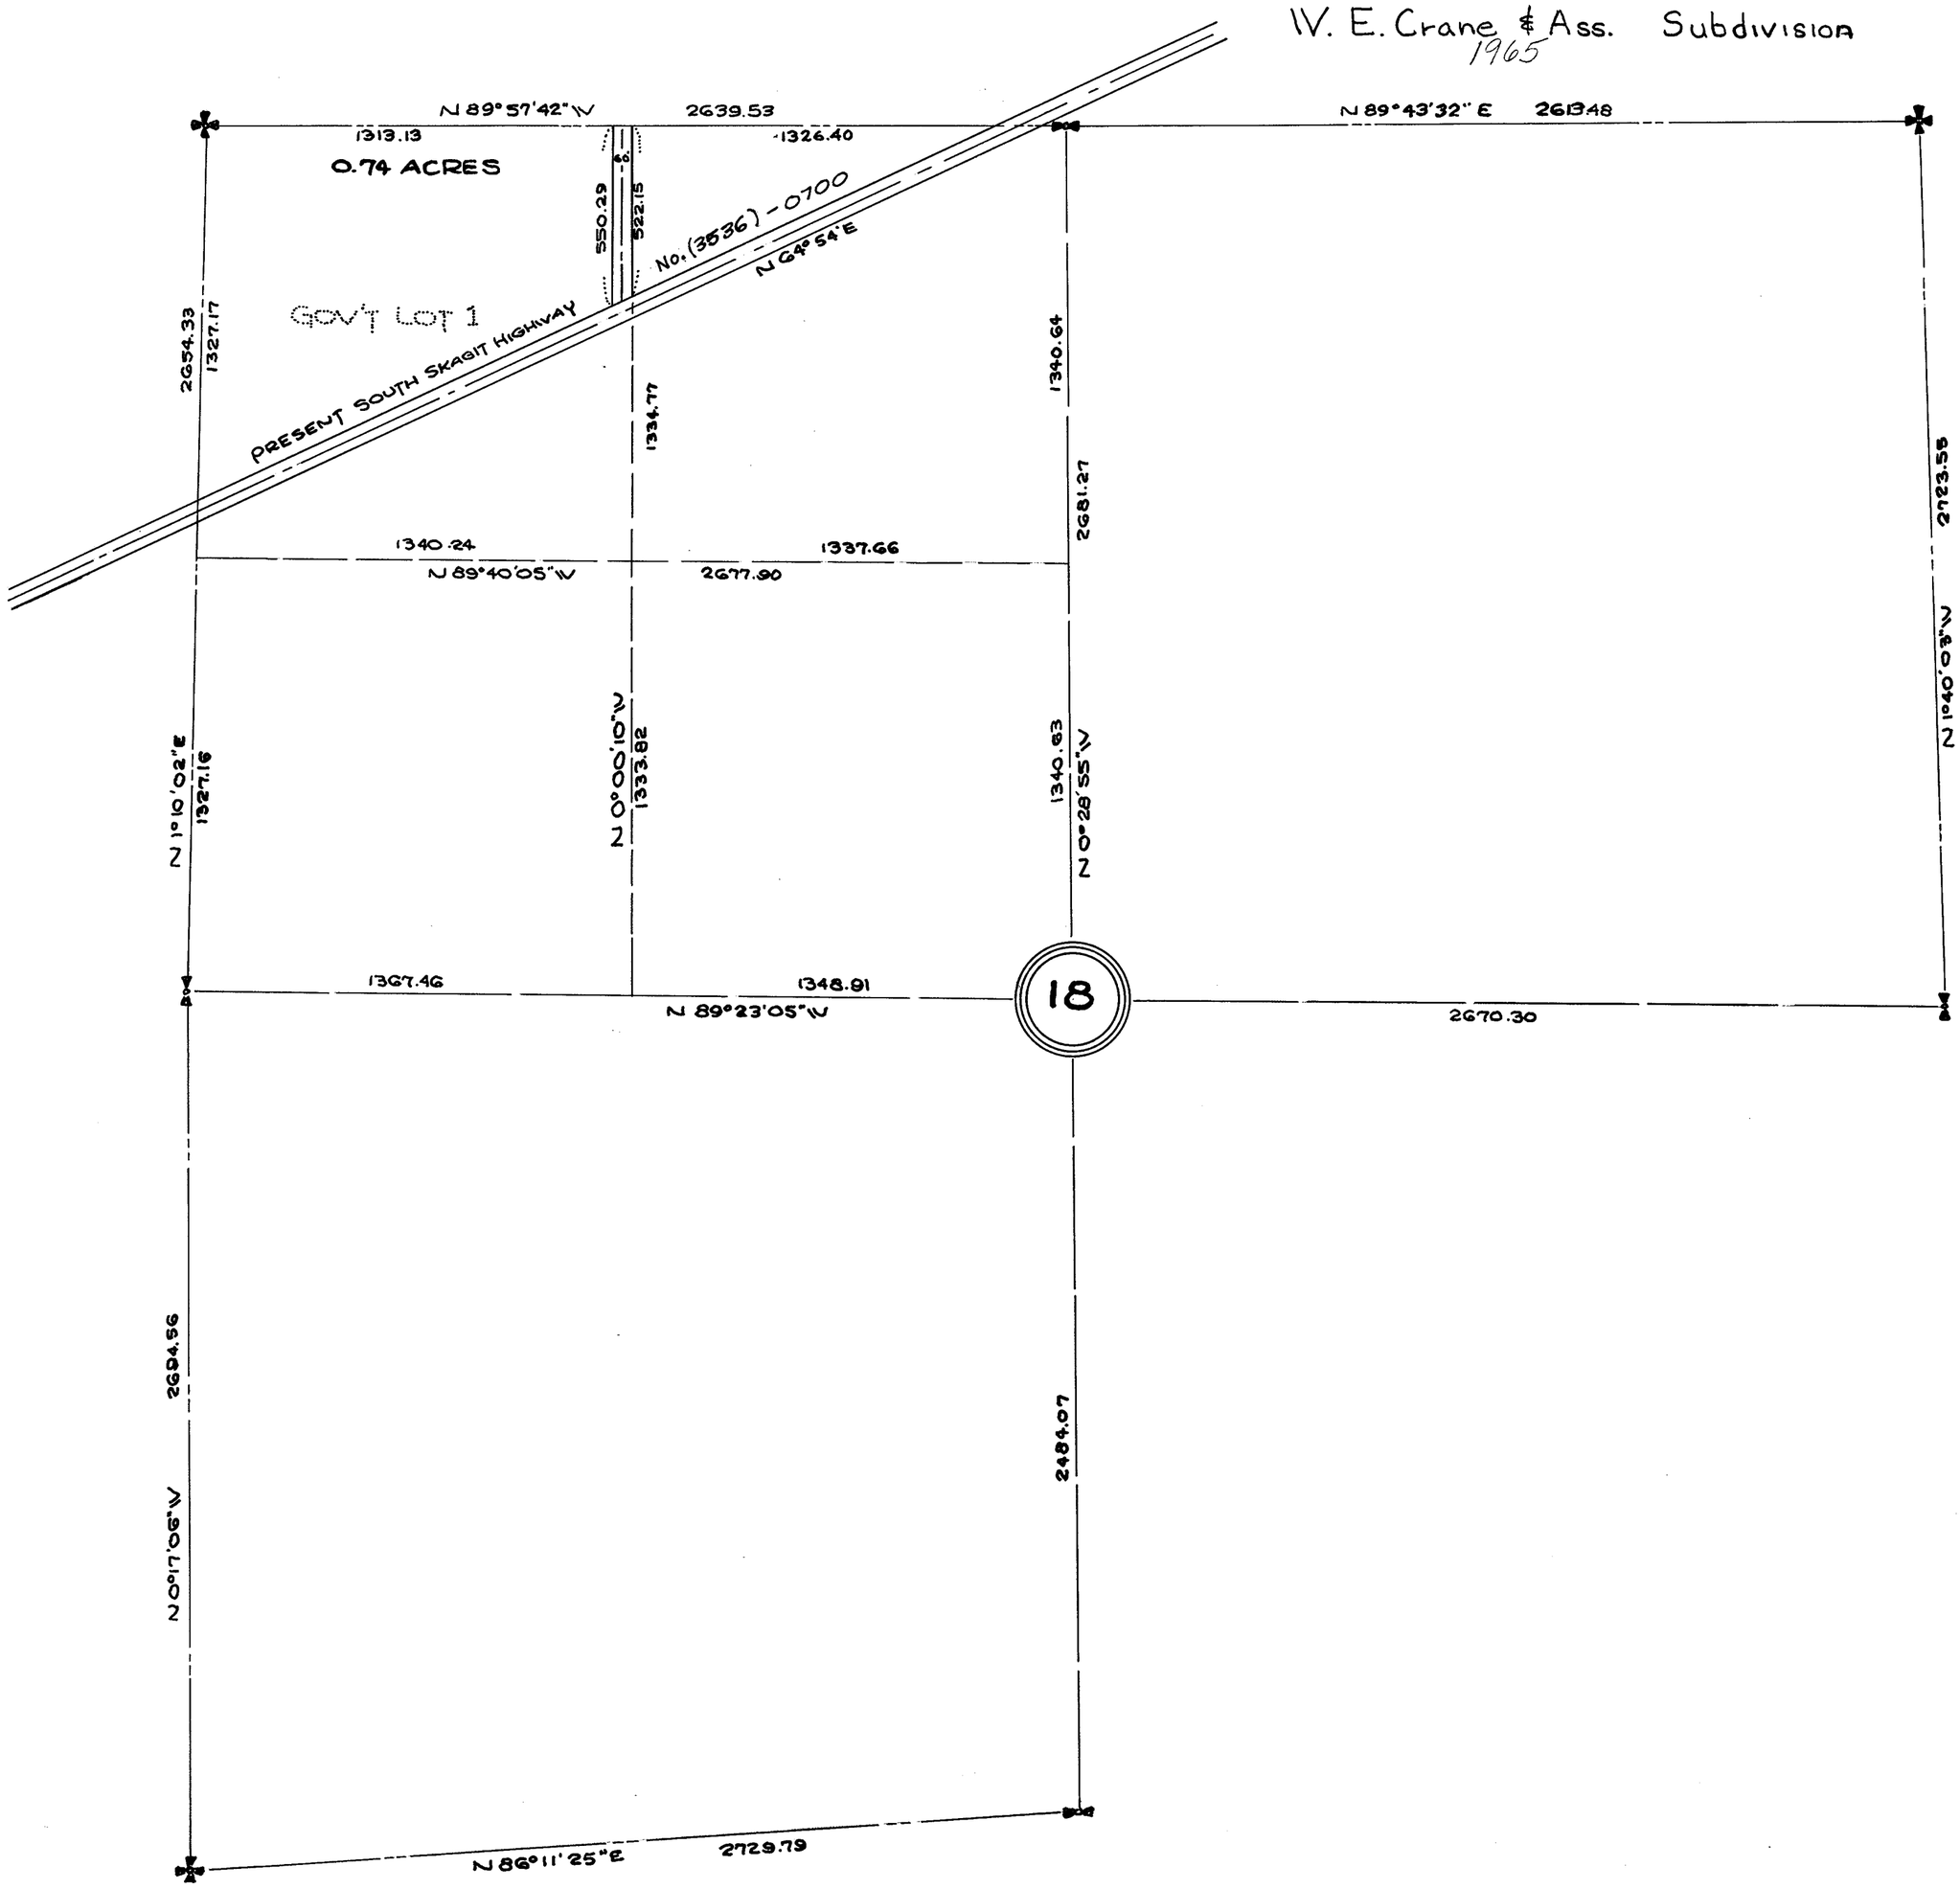


SECTION 18

TOWNSHIP 35 NORTH, RANGE 8 EAST, W. M.

SKAGIT COUNTY, WASH.

SCALE, 1 INCH--400 FEET

H.O. WALBERG COUNTY ENGINEER

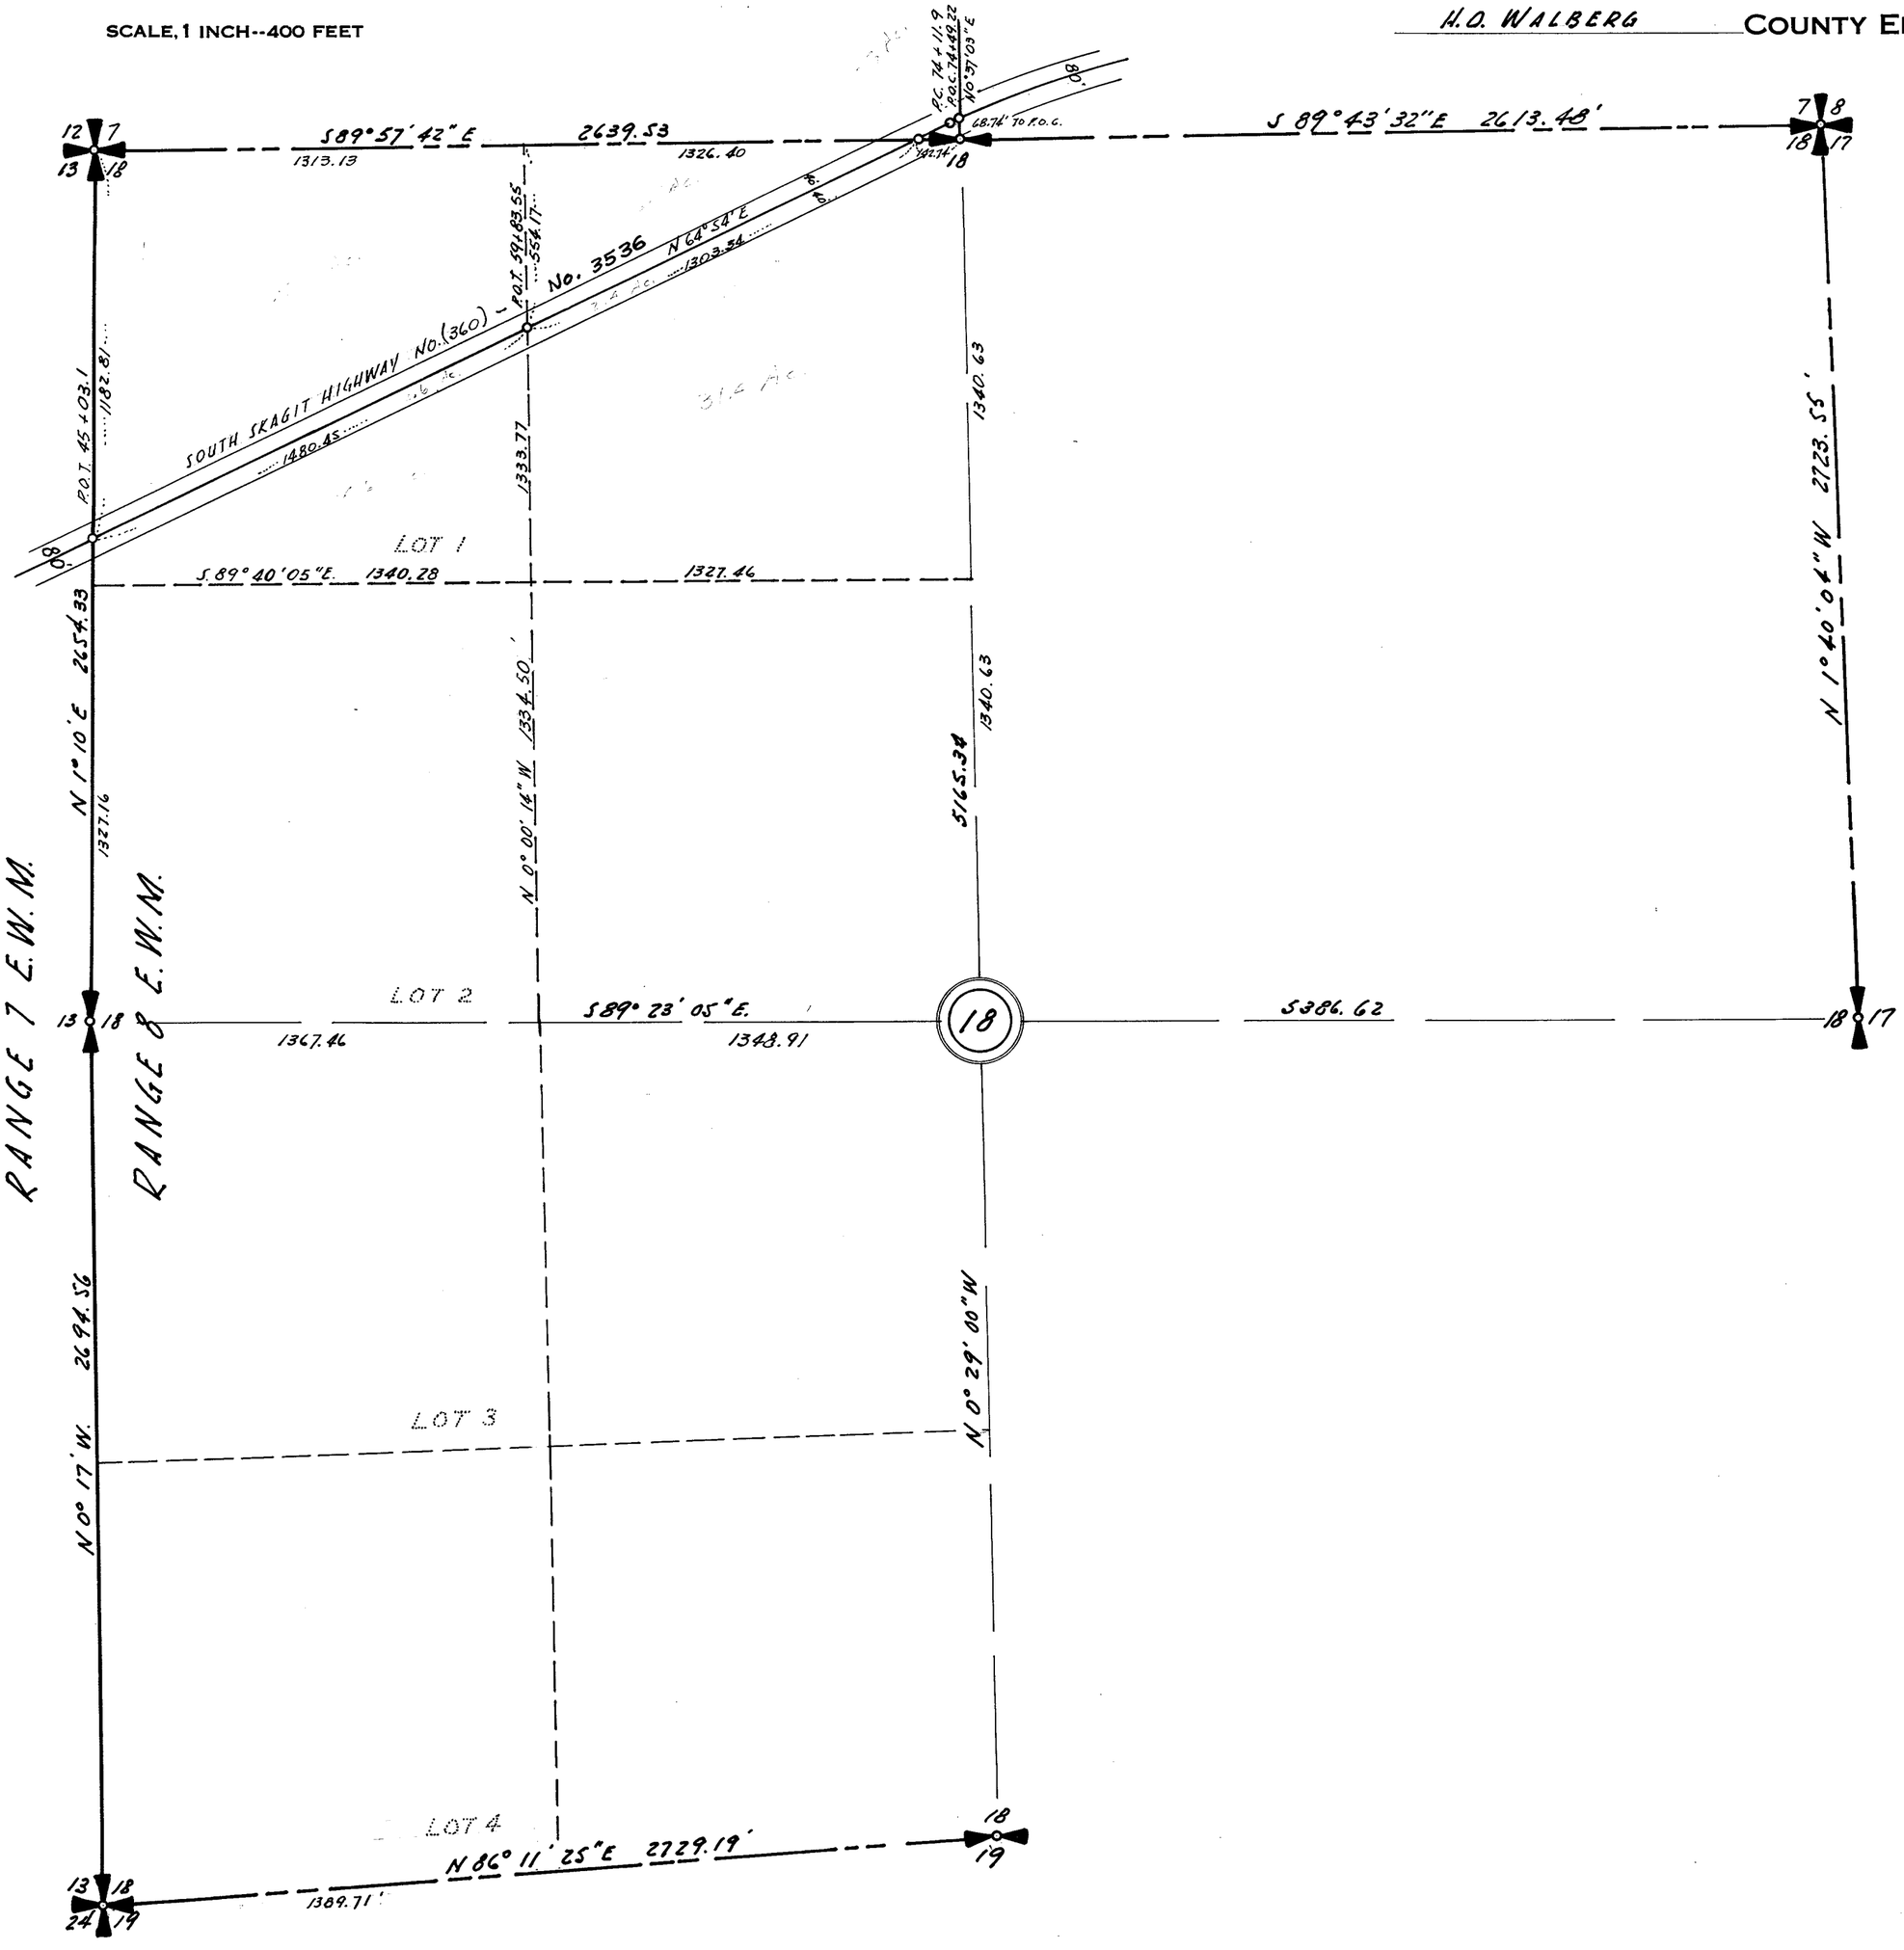


SECTION 20

TOWNSHIP 35 NORTH, RANGE 8 EAST, W. M.

SKAGIT COUNTY, WASH.

SCALE, 1 INCH–400 FEET

Robt. E. L. Knapp COUNTY ENGINEER
May 1932 Notes-G 193

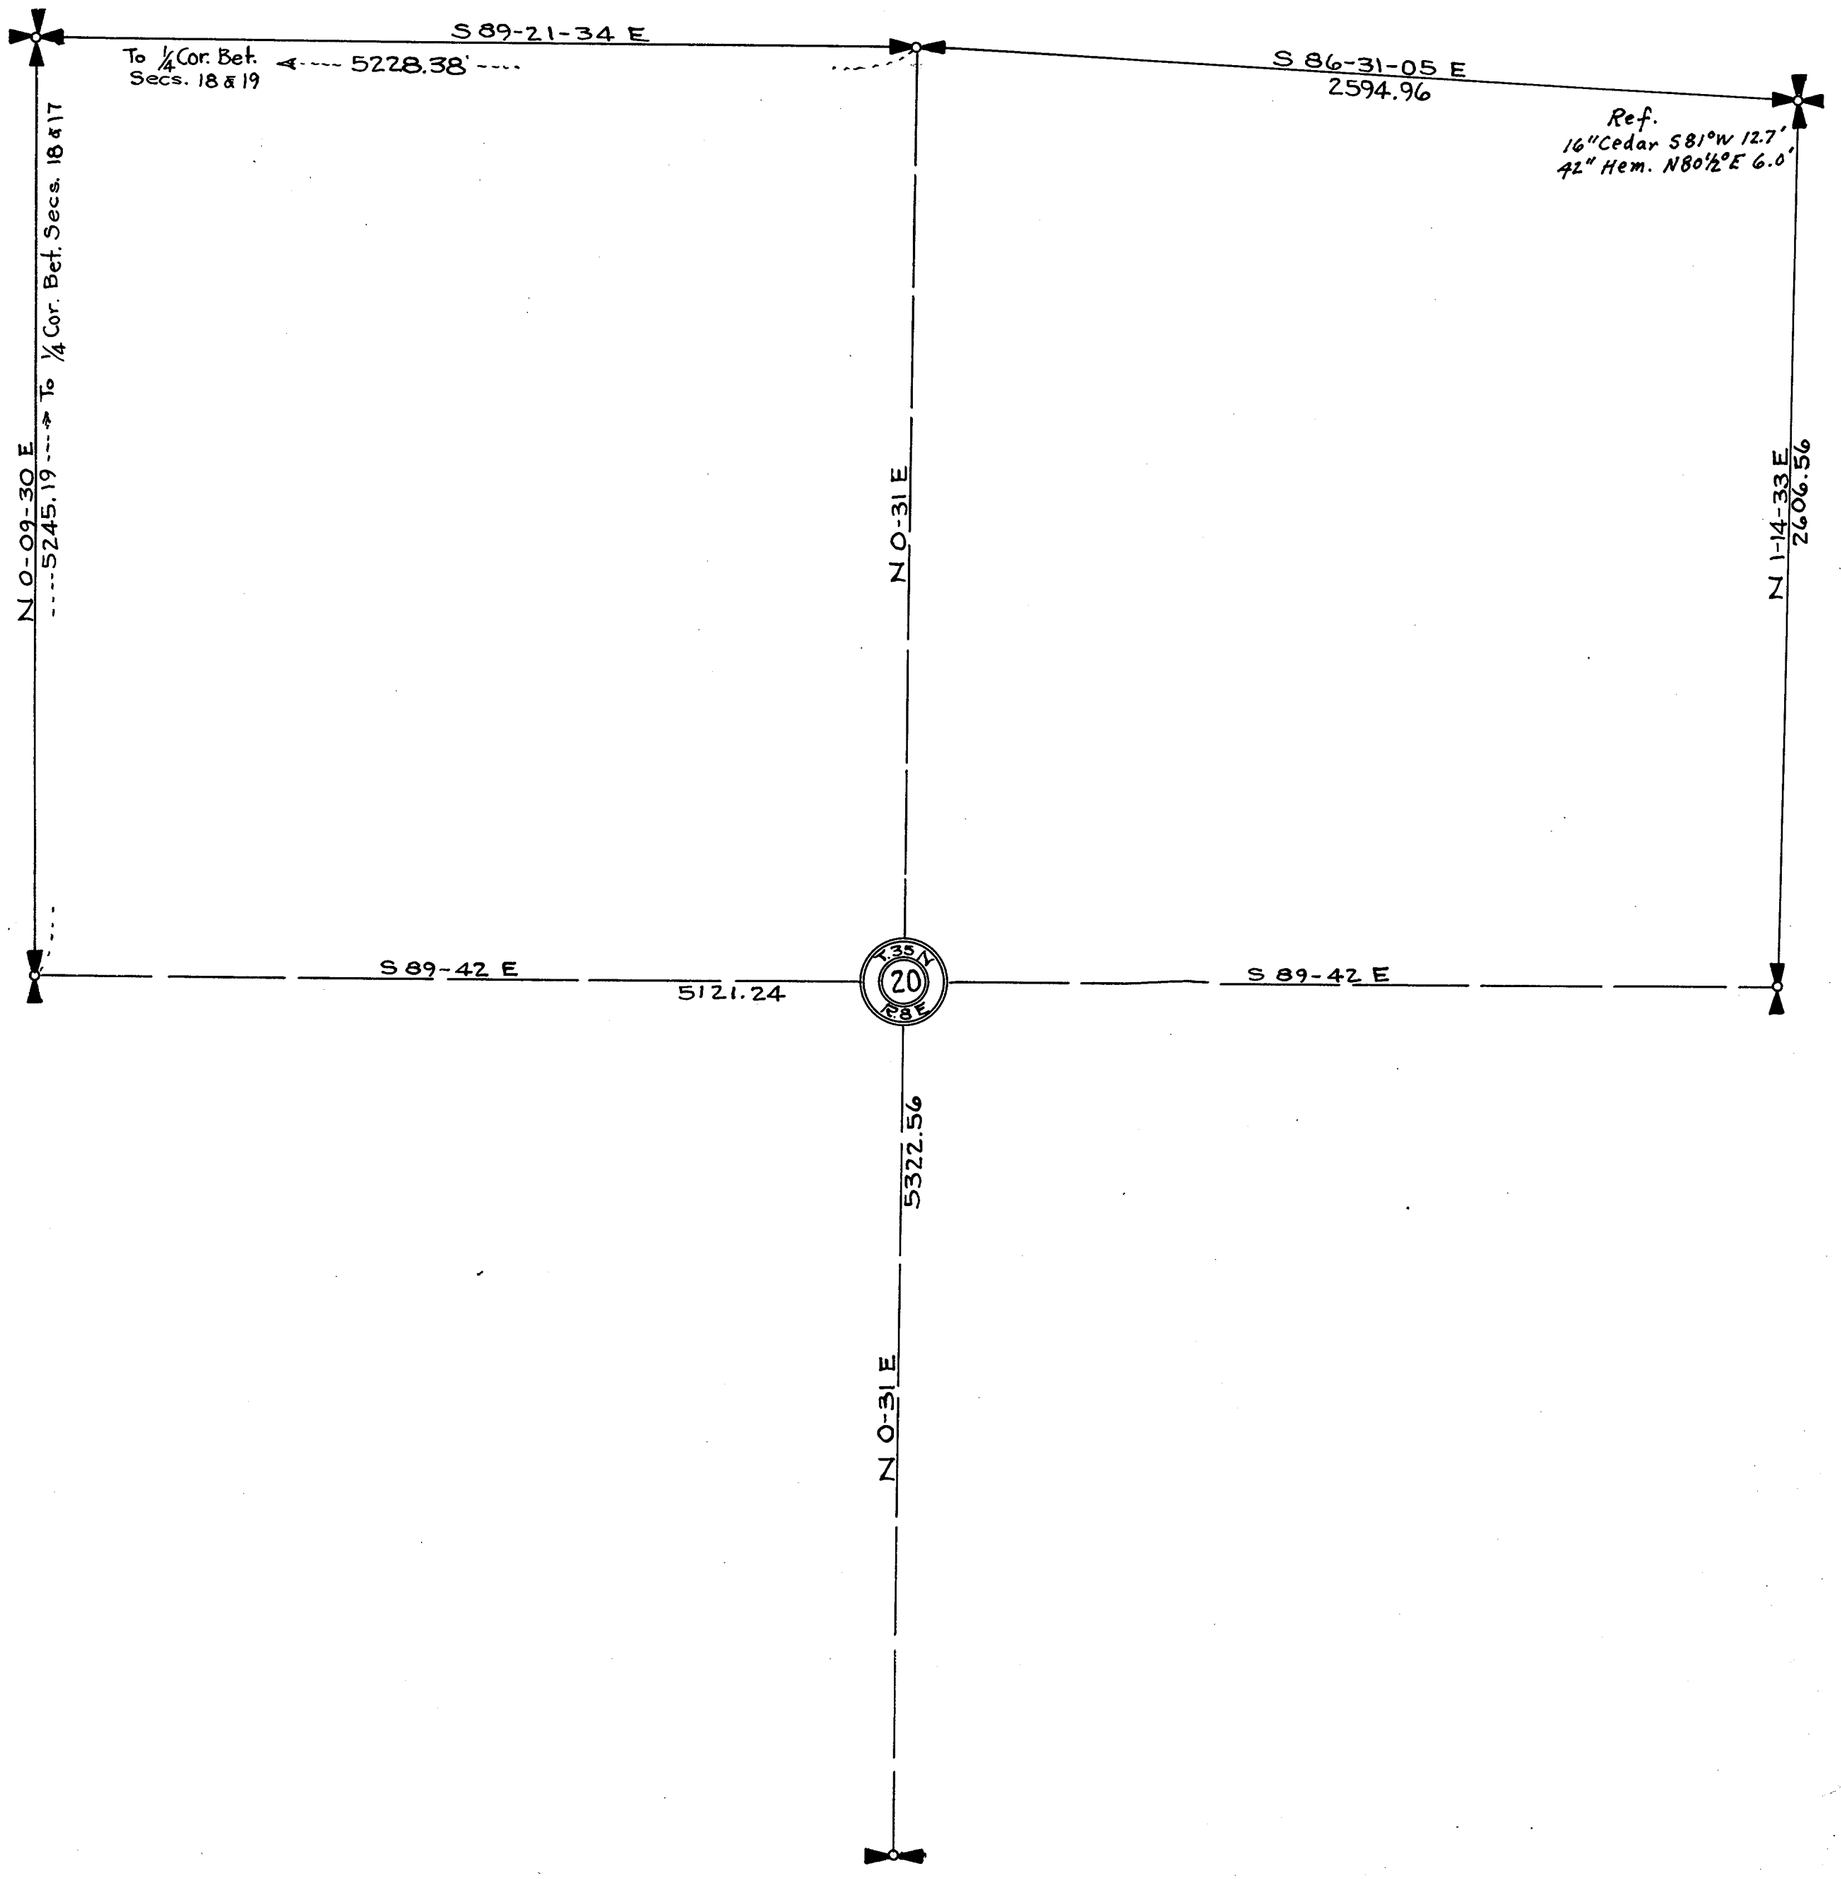

SECTION 23


TOWNSHIP 35 NORTH, RANGE 8 EAST, W. M.

SKAGIT COUNTY, WASH.

SCALE, 1 INCH--400 FEET

DATE Aug. 9, 1963

COUNTY ENGINEER

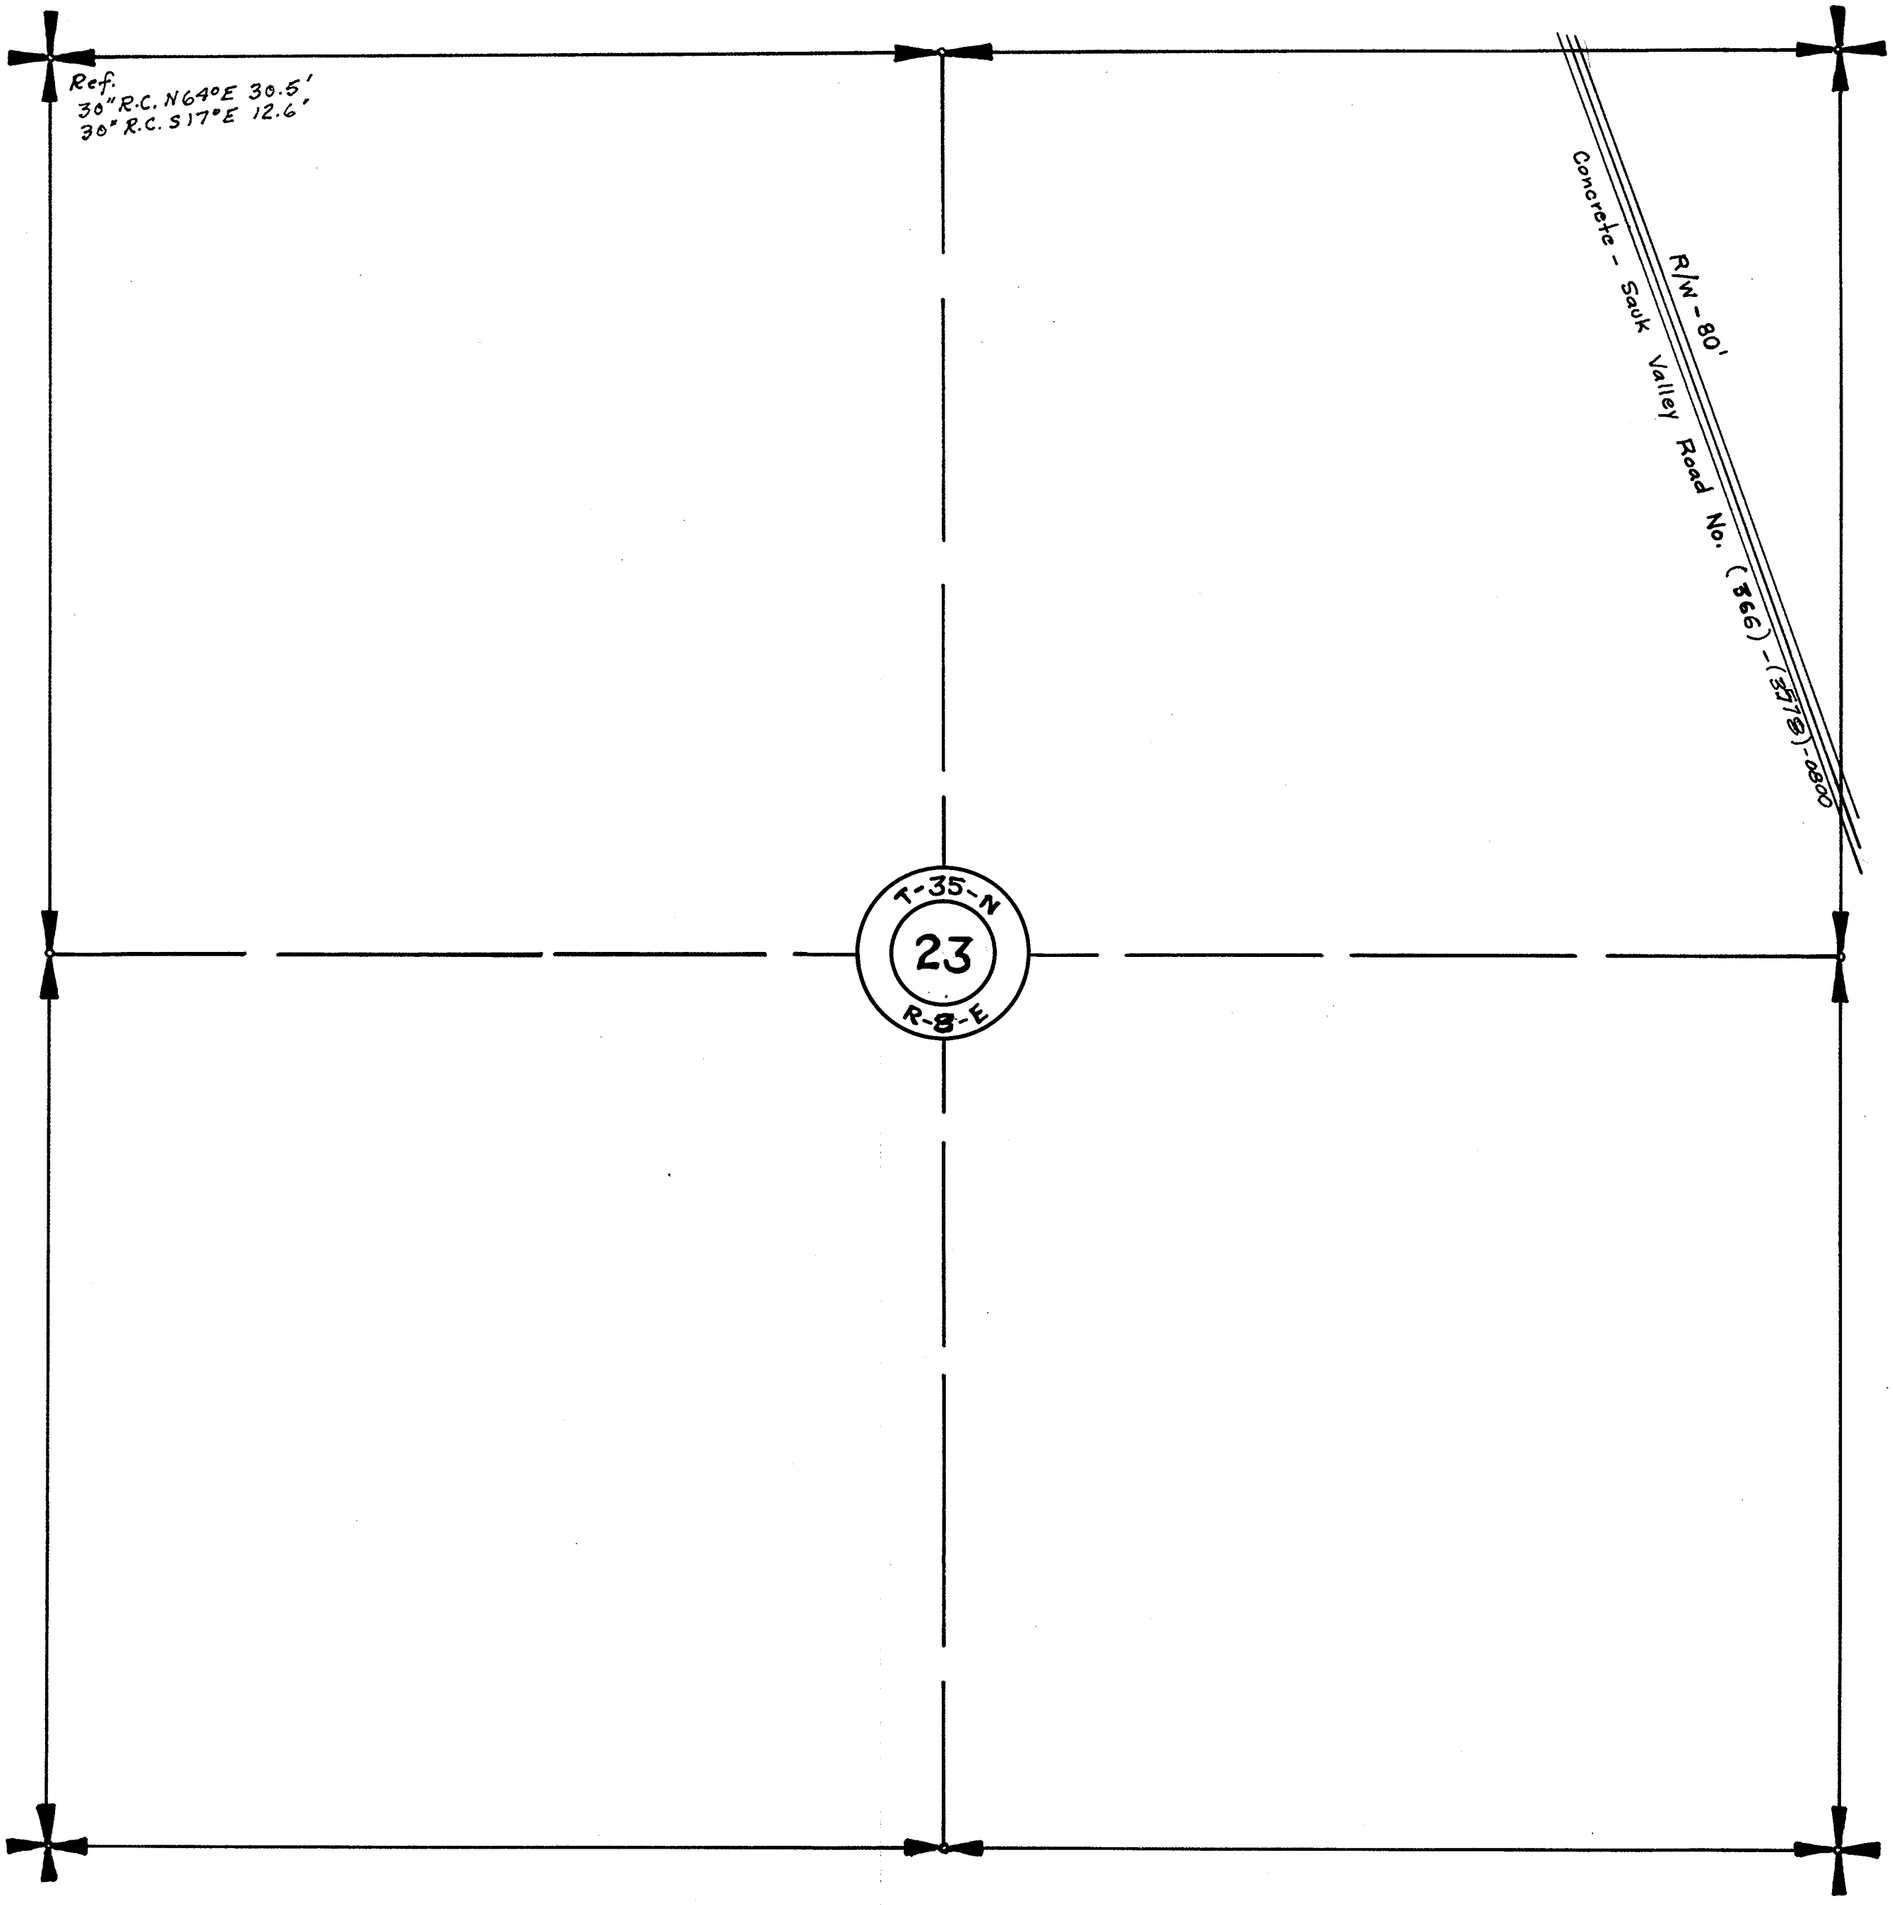


RIGHT OF WAY PLAT

SECTION 24
TOWNSHIP 35 NORTH, RANGE 8 EAST, W. M.
FOR SKAGIT COUNTY, WASH,

SCALE 1 INCH = 400 FEET

COUNTY ENGINEER

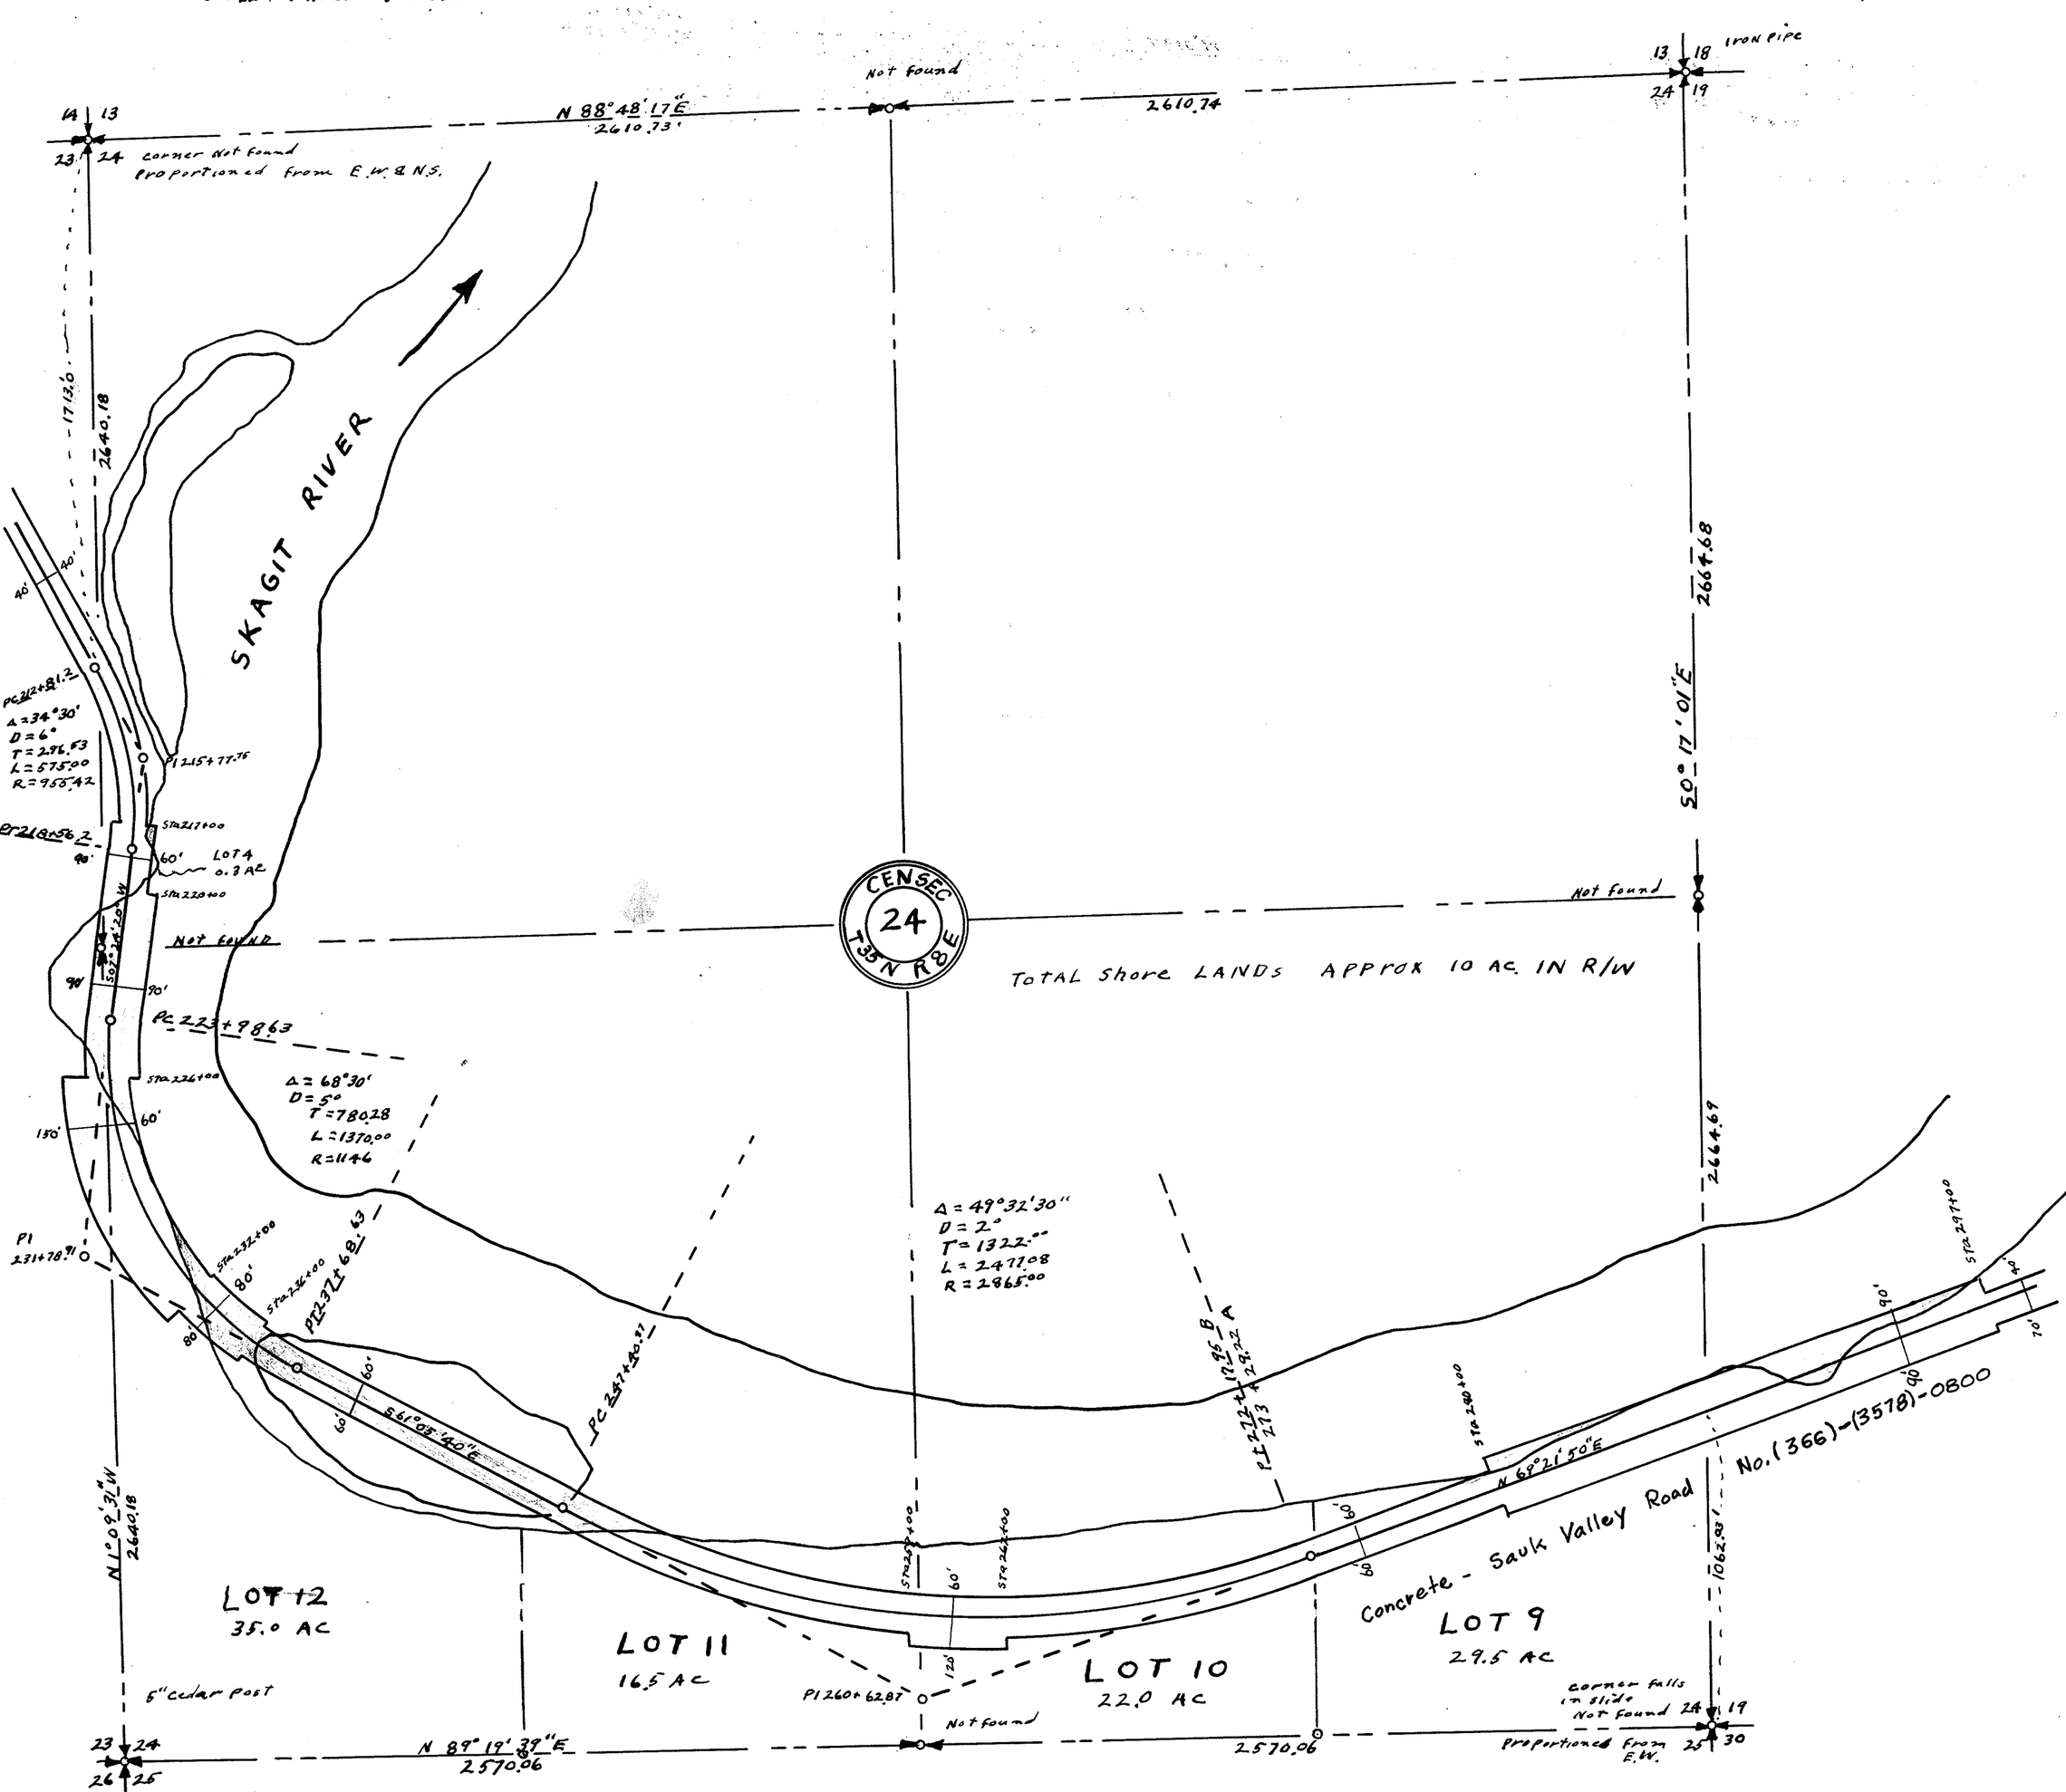

SEPT 26, 1950

I HJALMAR WALBERG COUNTY ROAD ENGINEER OF SKAGIT COUNTY, WASH, DO HEREBY CERTIFY THAT THIS MAP ACCURATELY REPRESENTS THE LOCATION OF SAID COUNTY'S ROAD ACROSS SECTION 24, TOWNSHIP 35 NORTH, RANGE 8 EAST W M

COUNTY ROAD ENGINEER SKAGIT COUNTY

SECTION 24


TOWNSHIP 35 NORTH, RANGE 8 EAST, W. M.


SKAGIT COUNTY, WASH.

SCALE, 1 INCH--400 FEET

Faber-Dalles Co-ordinates '50

H.O.Walberg COUNTY ENGINEER

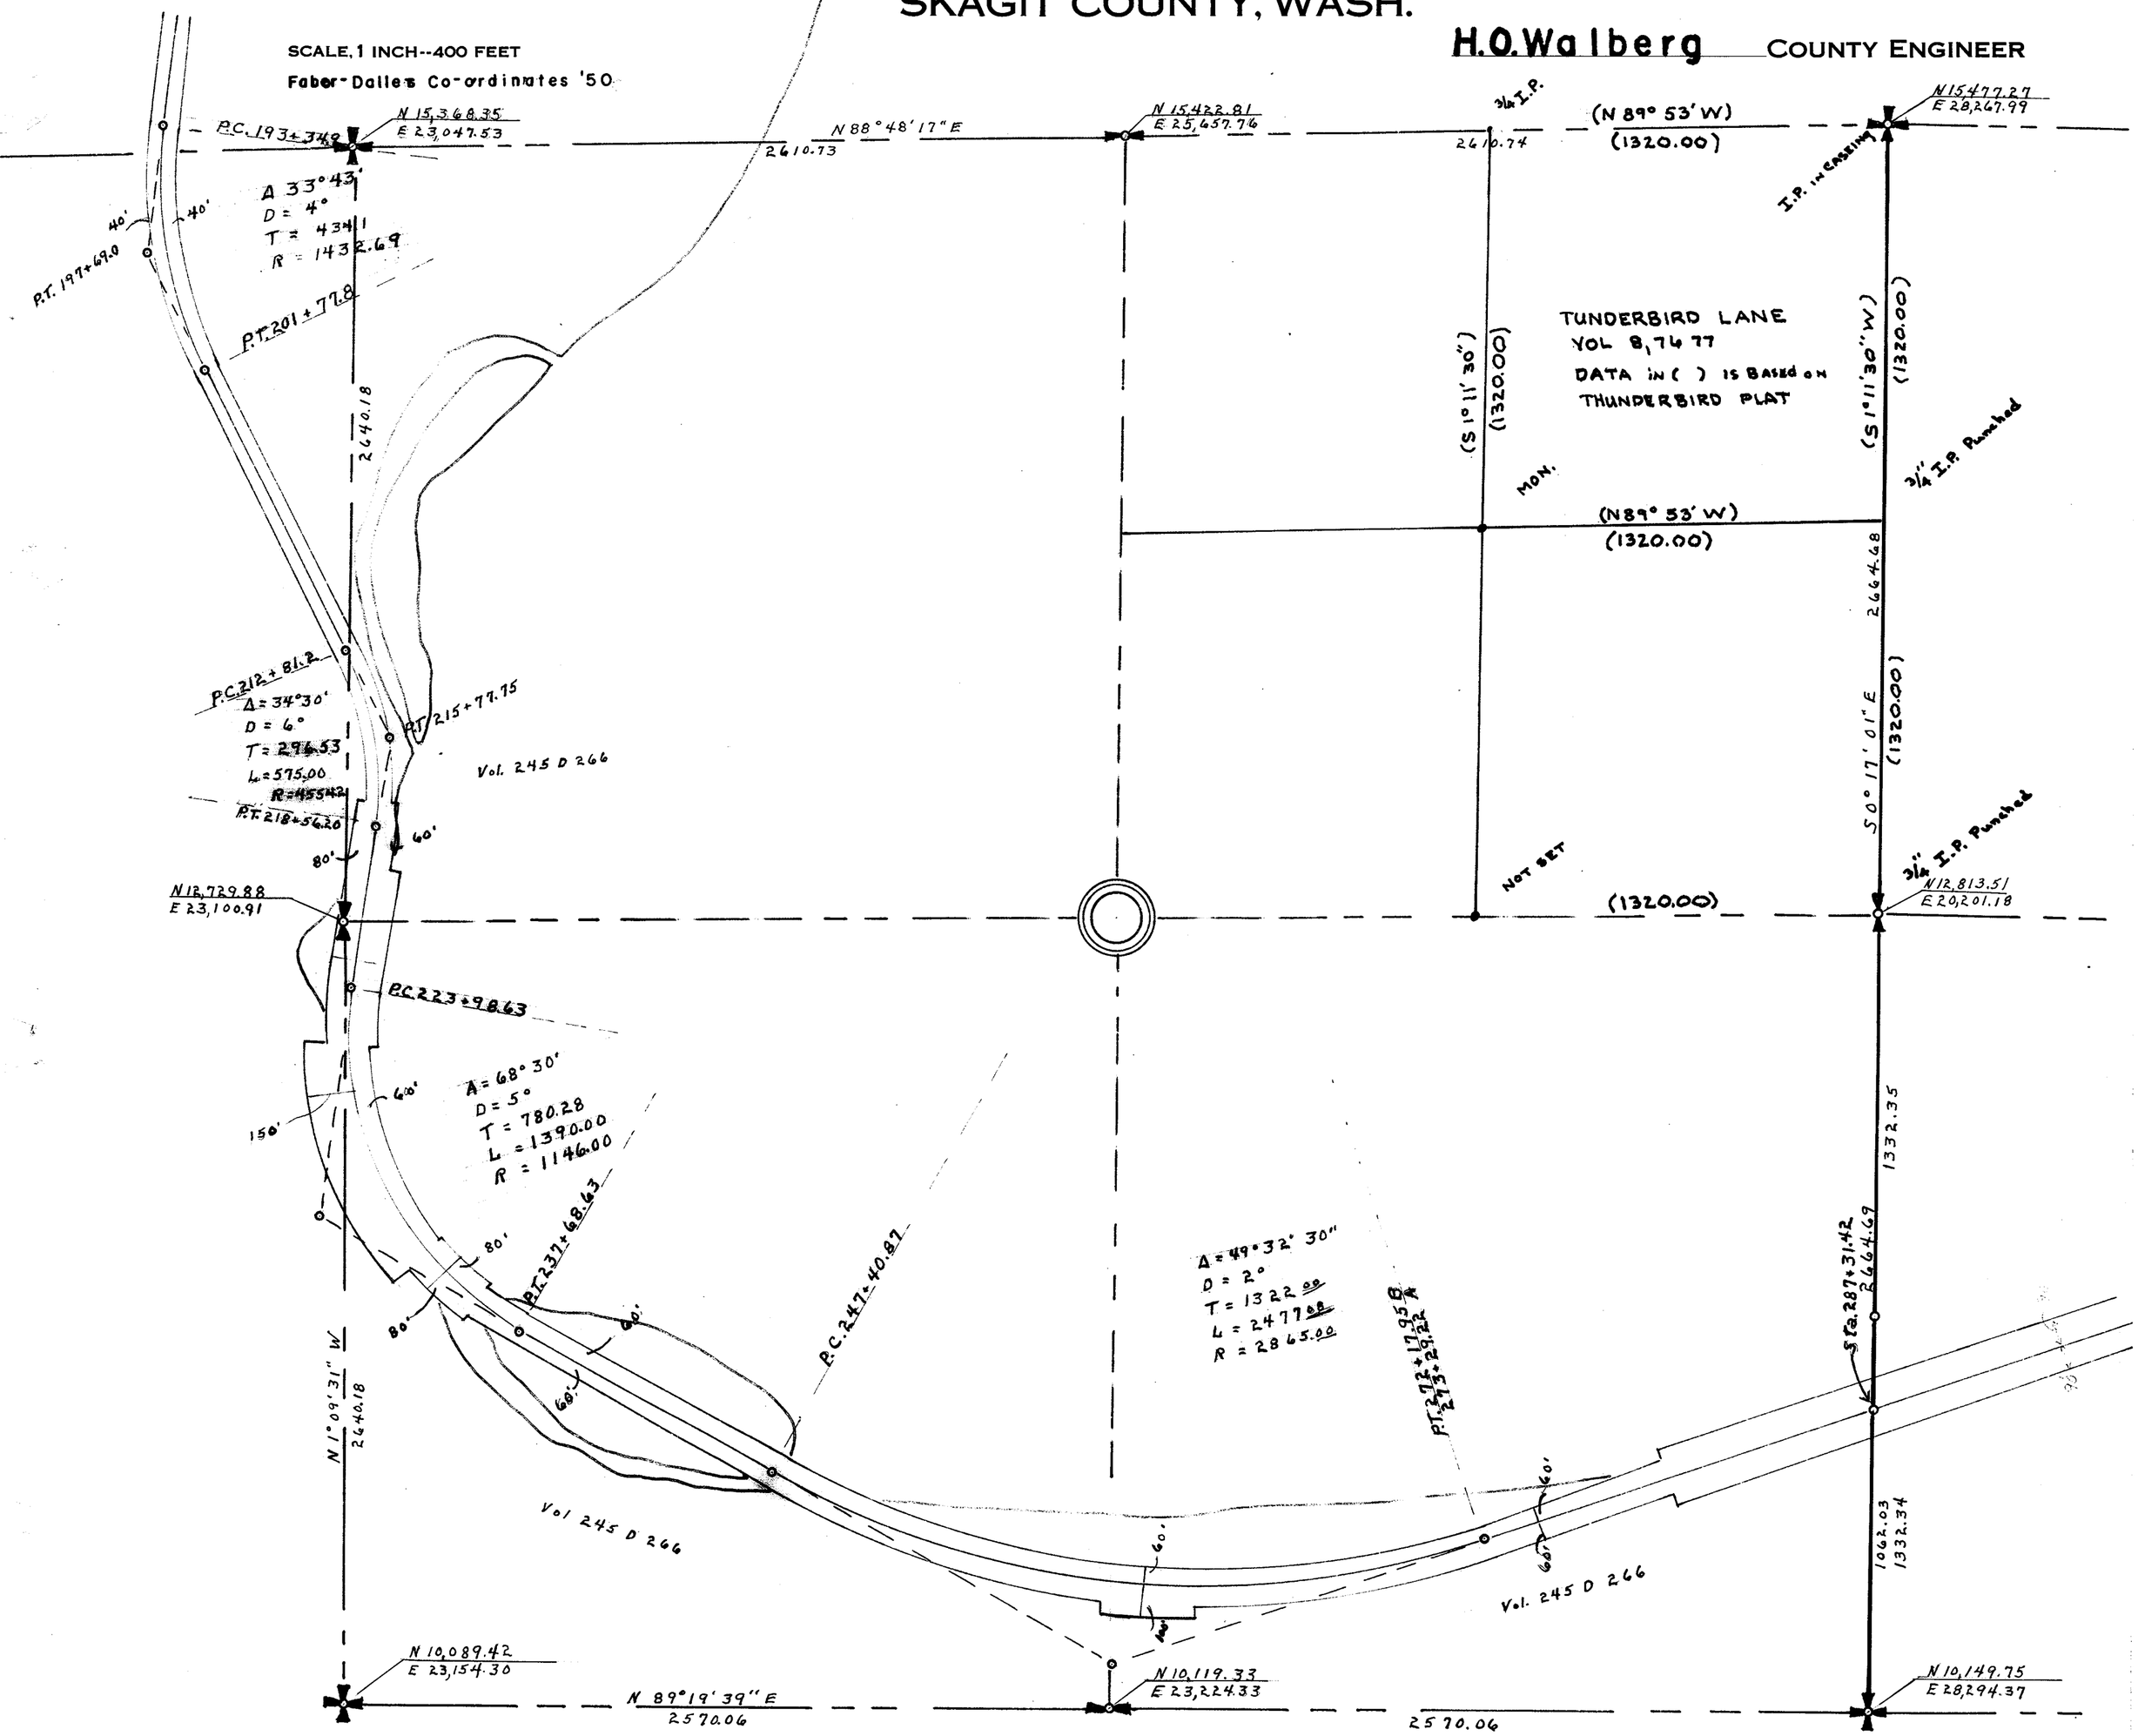

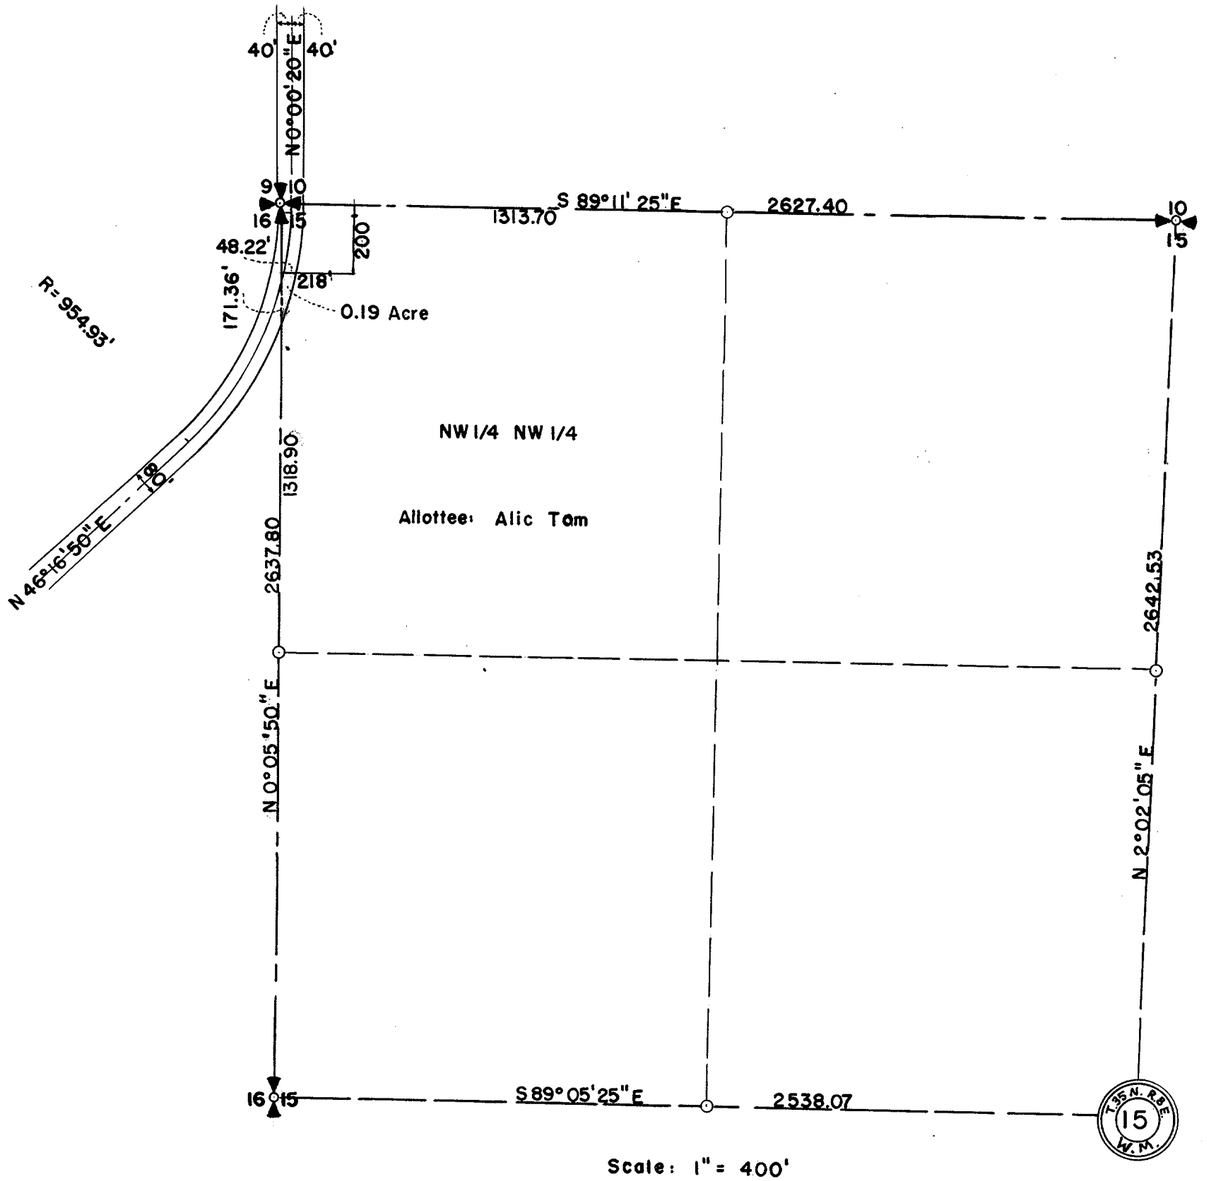

Scale: 1" = 400'

STATE OF WASHINGTON
COUNTY OF SKAGIT | ss

H.O. Walberg, being first duly sworn, says that he is the County Road Engineer of Skagit County, of the State of Washington, said County hereinafter designated as the "Applicant"; that the survey of the Concrete—Sauk Valley Road, a portion of which is described as a tract of land lying in the Northwest Quarter of the Northwest Quarter of Section Fifteen, Township Thirty-Five North, Range Eight East of Willamette Meridian, more particularly described as follows: beginning at a point in the West line of said Section Fifteen, said point lying S. 0°05'50" W. 200 feet from the Northwest Corner of said Section; thence S. 89°11'25" E. 48.22 feet; thence S. 10°38'39" W. on a curve to the right of radius 994.93 feet, a distance 178.71 feet; thence N. 0° 05'50" E. 171.36 feet to the point of beginning, containing 0.19 Acre, in Skagit County, Washington, was made under his direction as County Road Engineer of the "Applicant" and under its authority, commencing on the Second of May 1949 and continuing through the present date, and that such survey is accurately represented on this tracing for road right of way.

H.O. Walberg
H. O. Walberg, Co. Road Engr.

Subscribed and sworn to before me this 26 day of June 1950.

E. Danielson
Notary Public

AUDITOR, SKAGIT COUNTY, WASH.

H. O. WALBERG * STATE OF WASHINGTON * REGISTERED * PROFESSIONAL ENGINEER

SECTION 18


TOWNSHIP 35 NORTH, RANGE 9 EAST, W. M.

SKAGIT COUNTY, WASH.

SCALE, 1 INCH--400 FEET

DATE Aug. 25, 1966

Lloyd Johnson COUNTY ENGINEER

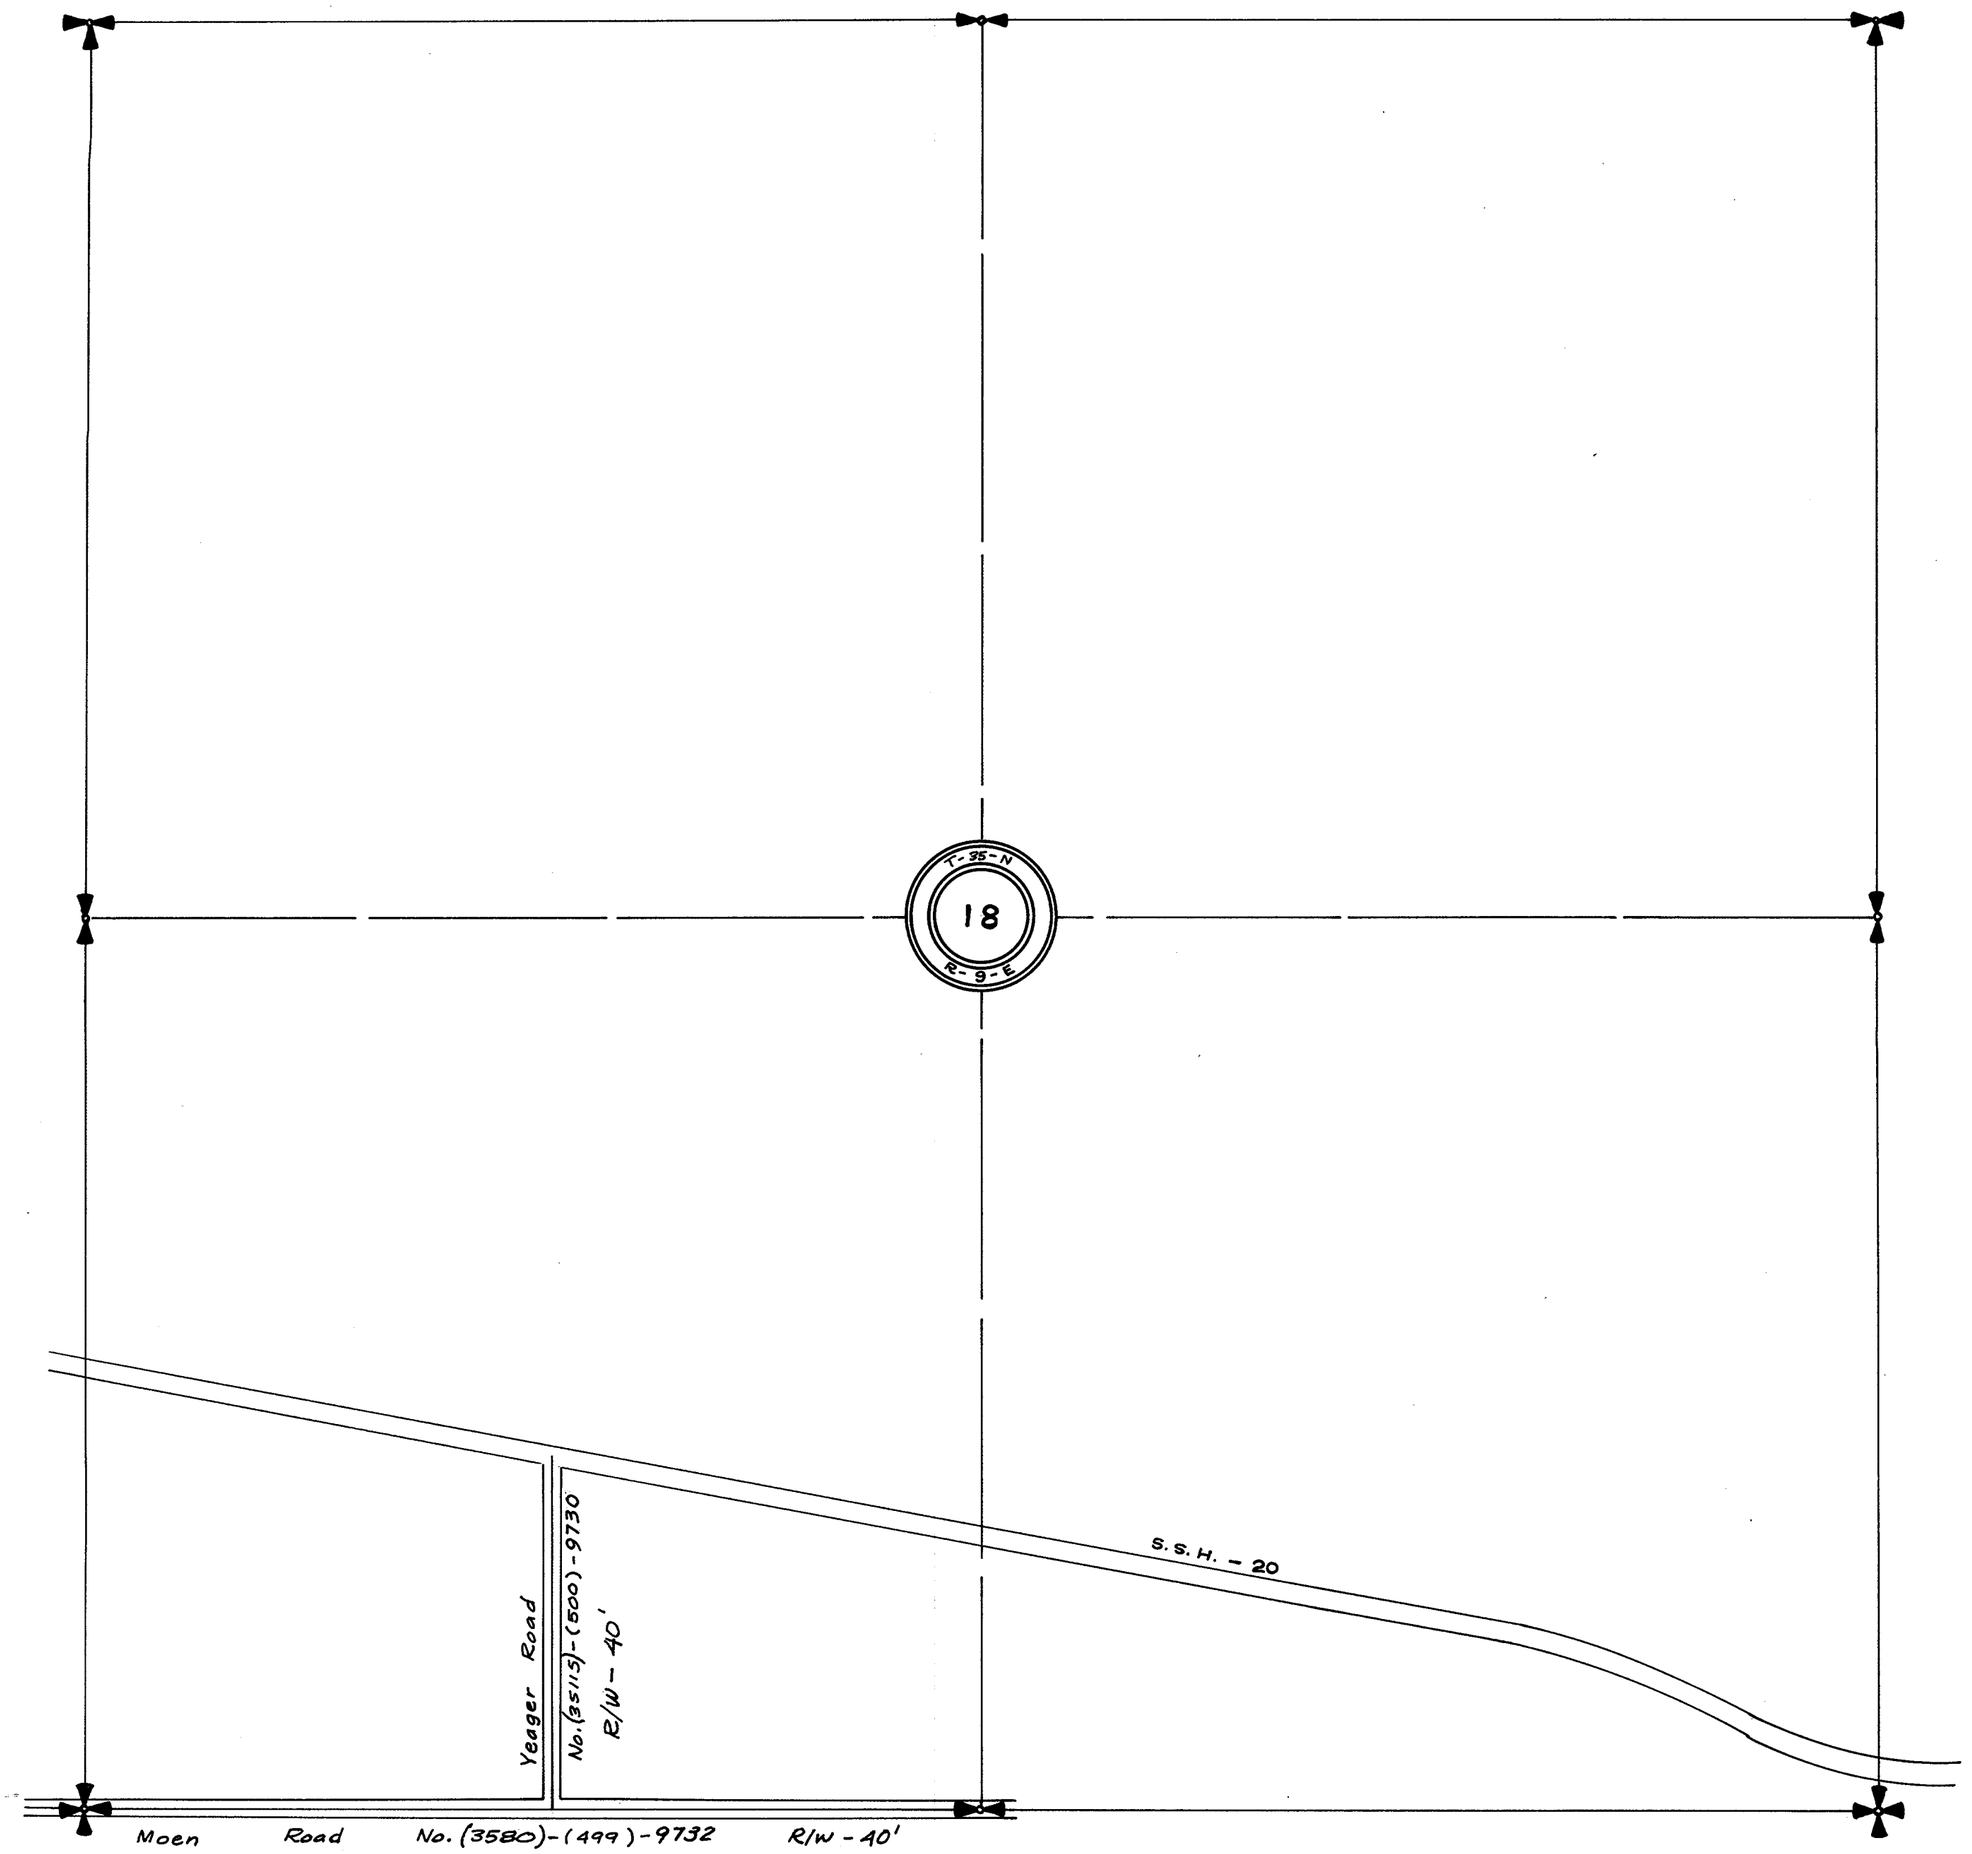

SECTION 19

TOWNSHIP 35 NORTH, RANGE 9 EAST, W. M.

SKAGIT COUNTY, WASH.

SCALE, 1 INCH--400 FEET

Fabor-Dalles Co-orinates '50

H.O. Walberg COUNTY ENGINEER

N 15,497.27
E 28,247.99

S 89° 52' 49" E
2654.77

N 15,491.72
E 30,922.75

N 15,380.91
E 32,274.14

N 15,290.10
E 33,425.54

1329.11

N 1° 01' E

N 14,142.69
E 30,907.66

N 14,059.97
E 33,403.54

P.I 337+73.16

Court Order
#21057

S 0° 17' 01" E
2644.68

N 00° 39' E
1329.10

N12,813.51
E 28,281.18

N 89° 59' 47" E
1297.16

N12,813.59
E 29,578.34

2611.40

1314.24

N 12,813.47
E 30,892.58

N 12,813.76
E 32,237.06

1344.48

1344.48

N12,813.85
E 33,581.54

Δ = 12° 34' 45"
D = 3°
T = 210.5
L = 419.0
R = 1910.00

P.C 301+82.40

P.T 305+72.37

Lot 10

Lot 10

Lot 11

P.I 303+72.9

Court Order
#21057

P.C 320+04.50

1317.96

1317.96

Δ = 34° 18'
D = 1°
T = 1768.12
L = 3430.0
R = 5730

1332.35

2644.69

1063.03

1332.34

N11,481.63
E 28,287.37

N11,496.79
E 30,878.50

2607.92

N 3° 14' E

N 10,149.75
E 28,294.37

1280.46

N 10,164.78
E 29,574.74

1290.14

N 89° 19' 39" E

N 10,179.91
E 30,864.41

2570.6

N 10,210.08
E 33,434.45


SECTION 19

TOWNSHIP 35 NORTH, RANGE 9 EAST, W. M.

SKAGIT COUNTY, WASH.

SCALE, 1 INCH--400 FEET

COUNTY ENGINEER

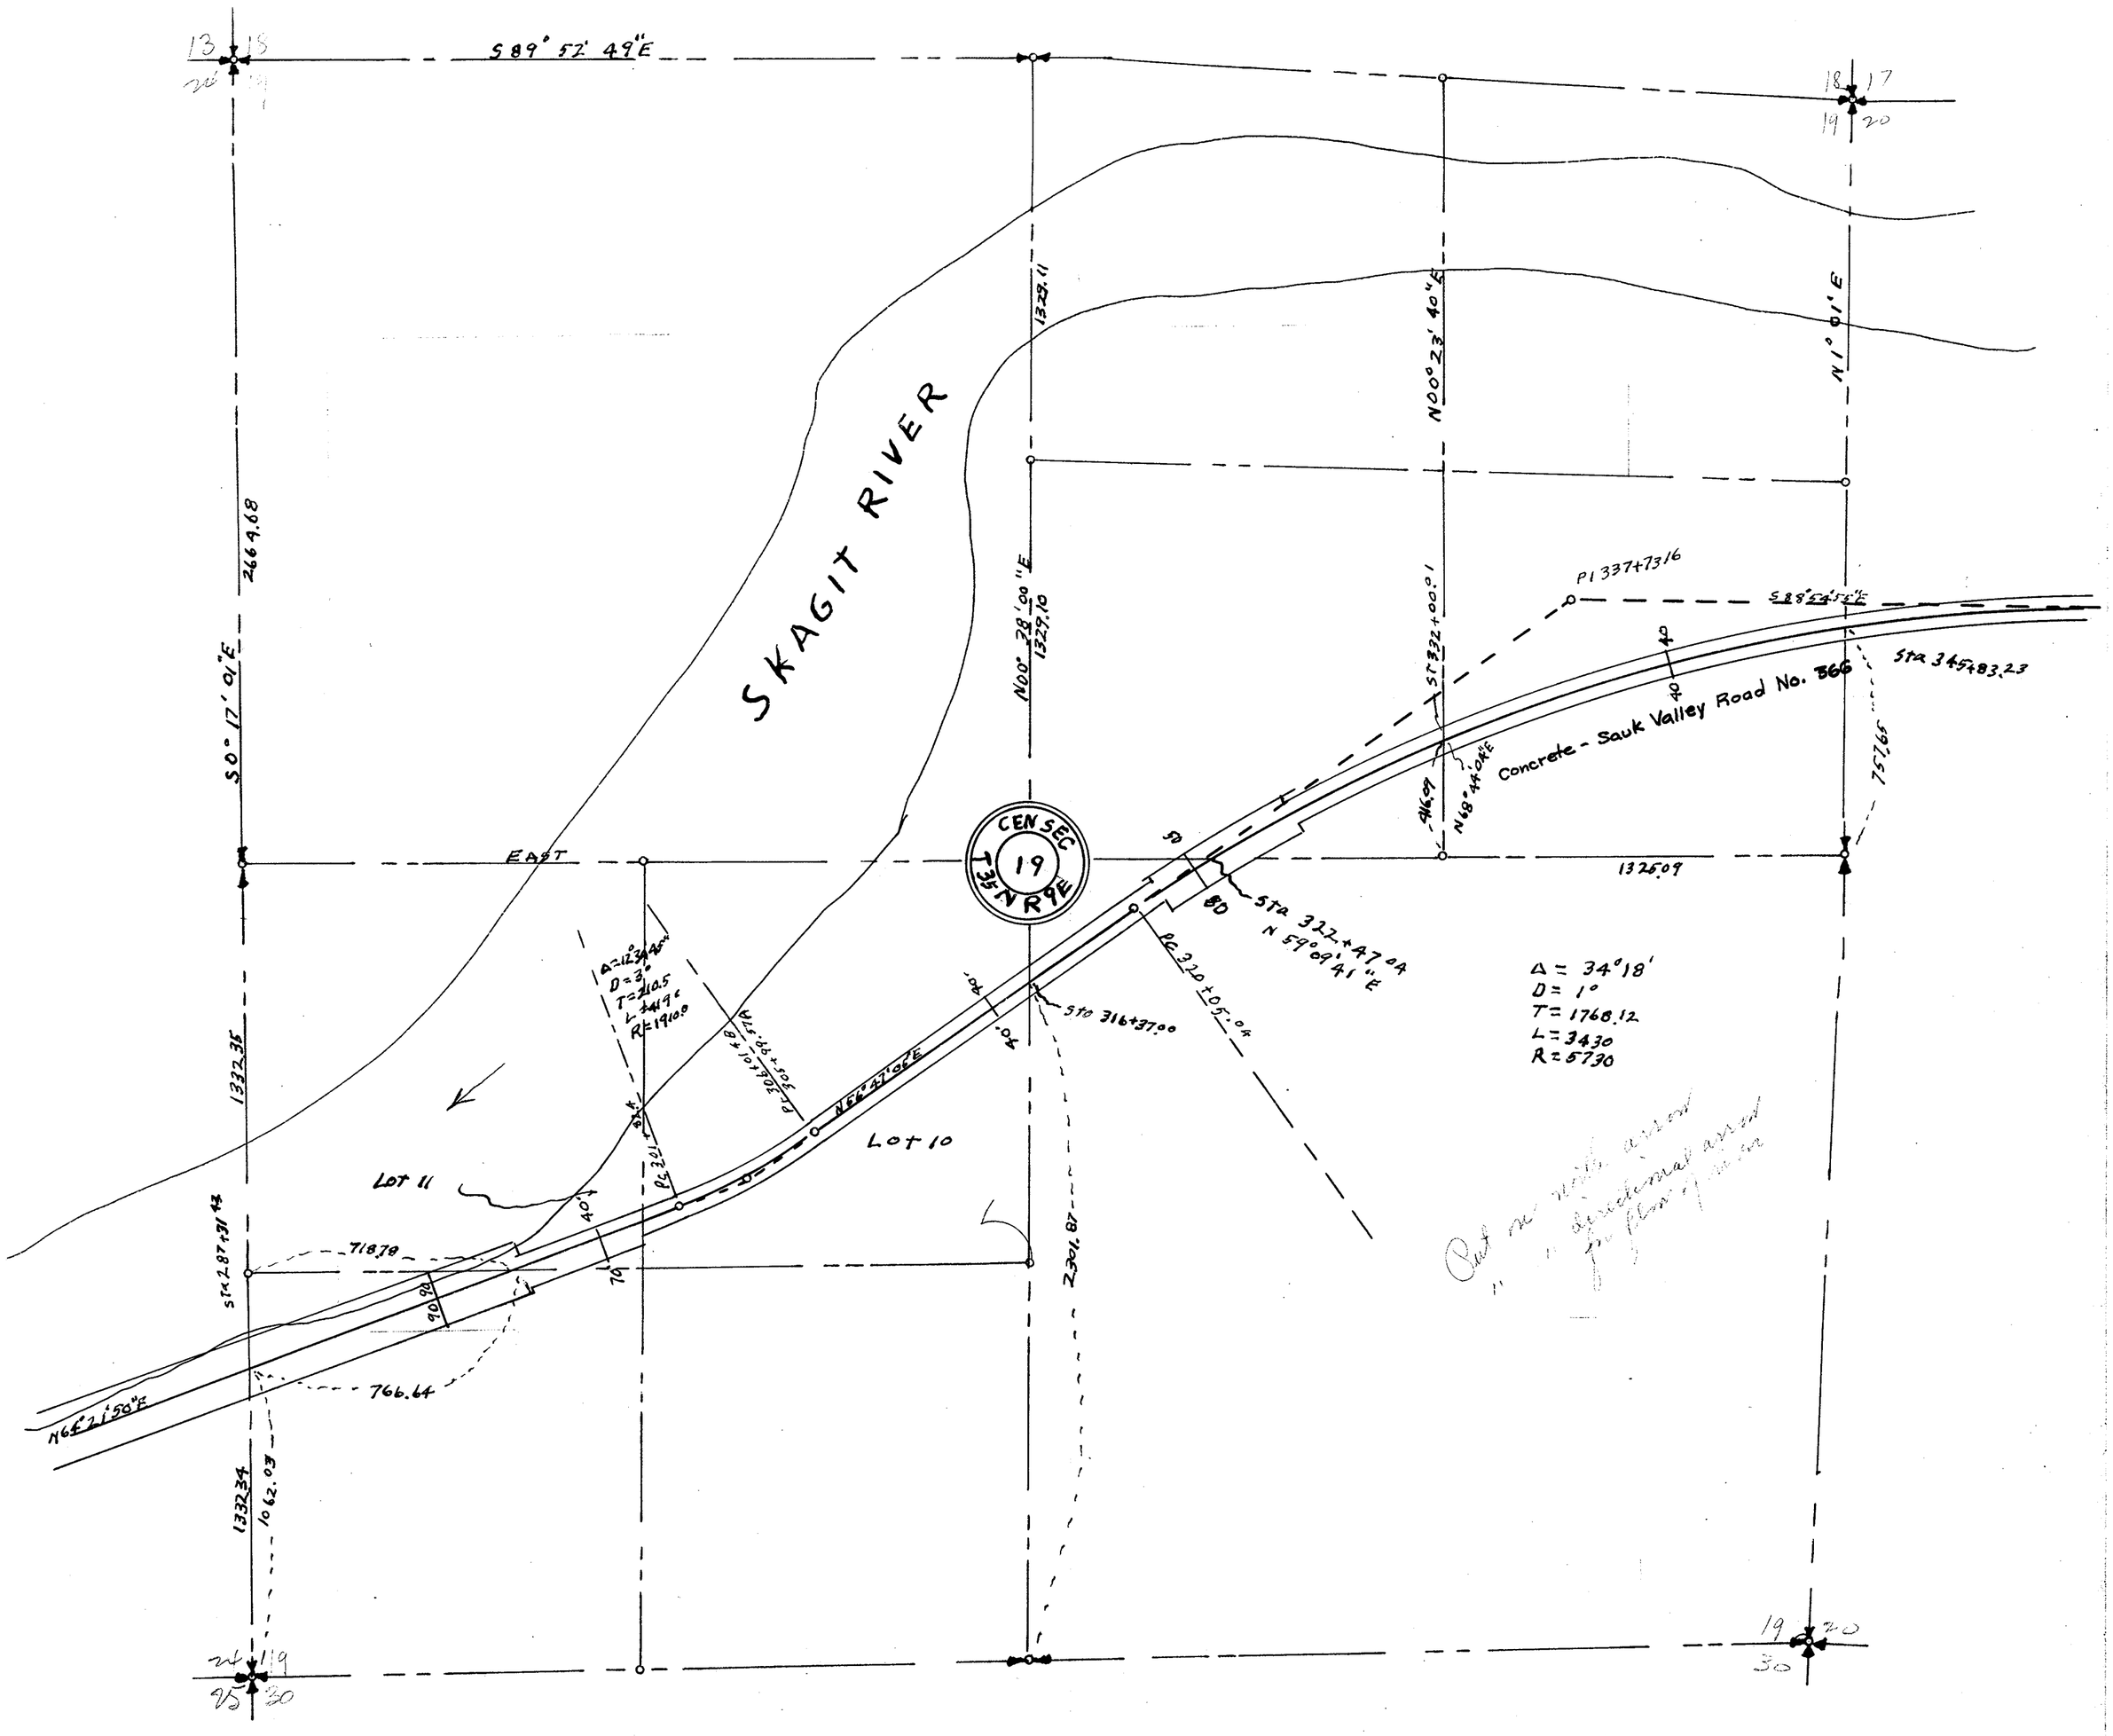

Cut on with arcual

SECTION 19

TOWNSHIP 35 NORTH, RANGE 9 EAST, W. M.

SKAGIT COUNTY, WASH.

SCALE, 1 INCH -- 400 FEET

DATE Aug. 25, 1966

Lloyd Johnson COUNTY ENGINEER

Yeager Rd. No. (3515-) (500) 9730

Moen Road No. 3580(499) - 9732

R/W - 40'

Skagit Ridge Road No. 0890 (No. 3584)-(XCIII) R/W - 60'

No. (3578)-(336)-0800

Sauk Valley Road

Concrete

T-35-N
19
R-9-E

SECTION 20

TOWNSHIP 35 NORTH, RANGE 9 EAST, W. M.


SKAGIT COUNTY, WASH.

SCALE, 1 INCH--400 FEET

DATE Aug. 9, 1963

COUNTY ENGINEER

Dr. By W.G.Wells

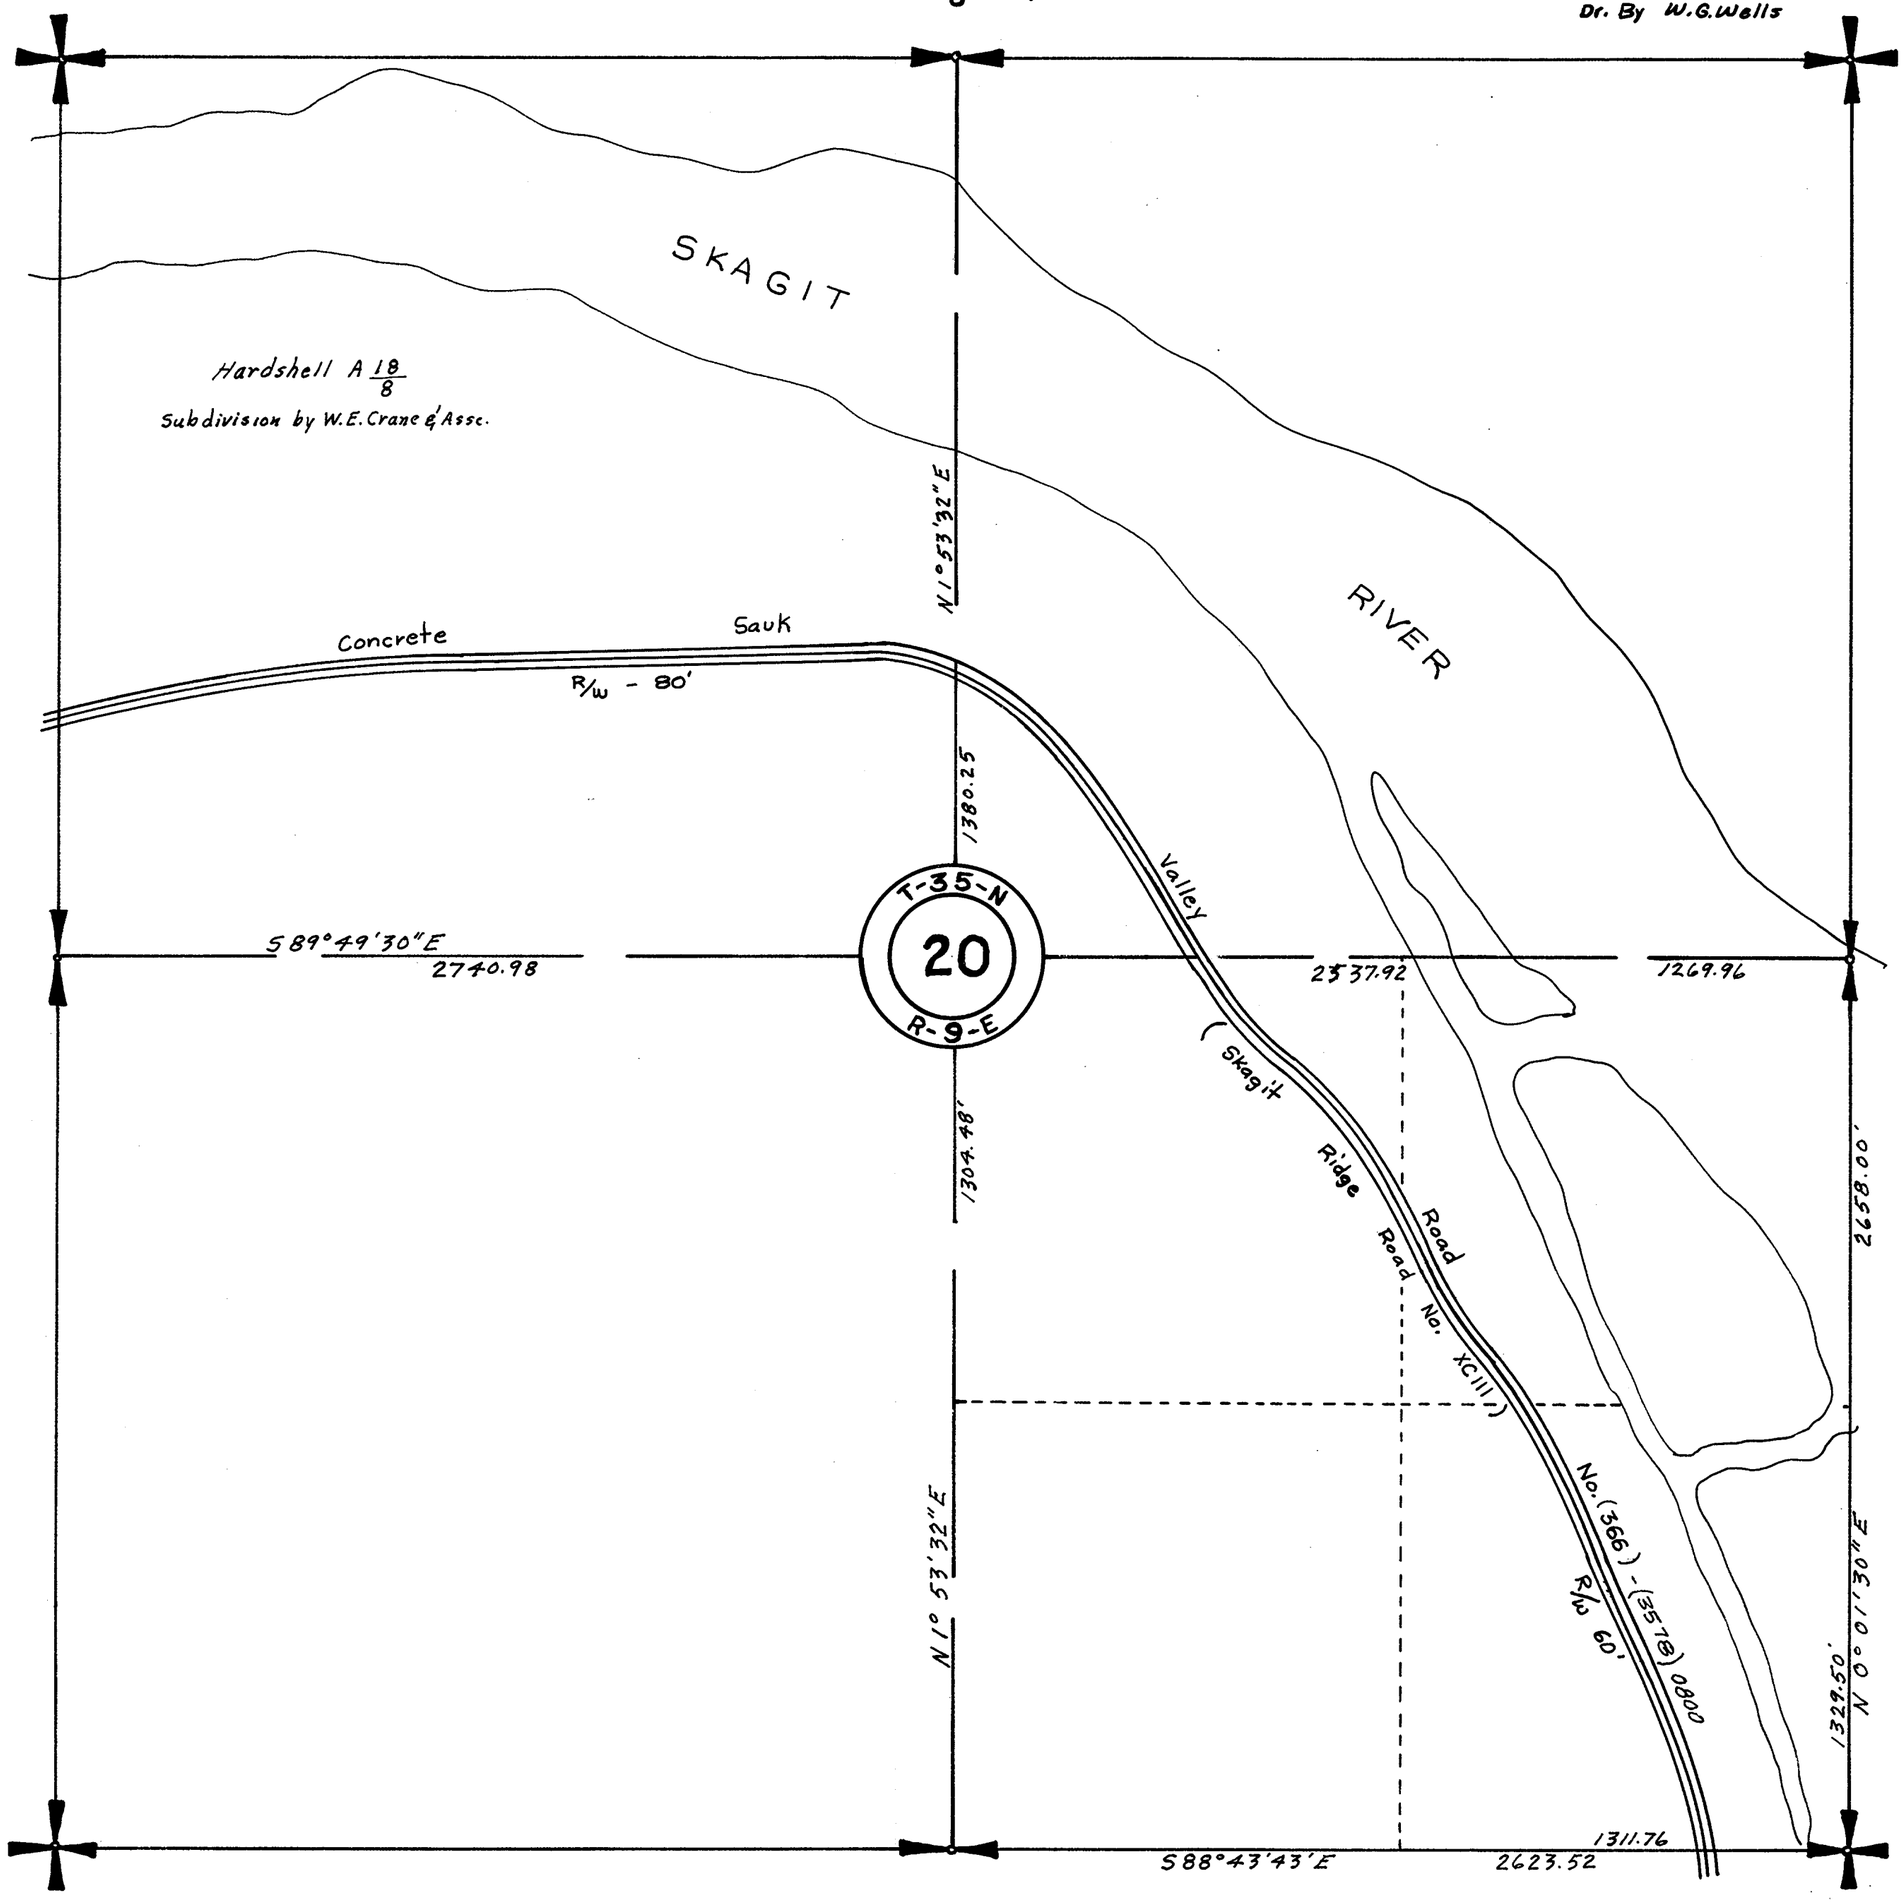

SECTION 20


TOWNSHIP 35 NORTH. RANGE 9 EAST. W. M.

SKAGIT COUNTY. WASH.

SCALE. 1 INCH—400 FEET

Lloyd H. Johnson COUNTY ENGINEER

DATE Nov. 16, 1973

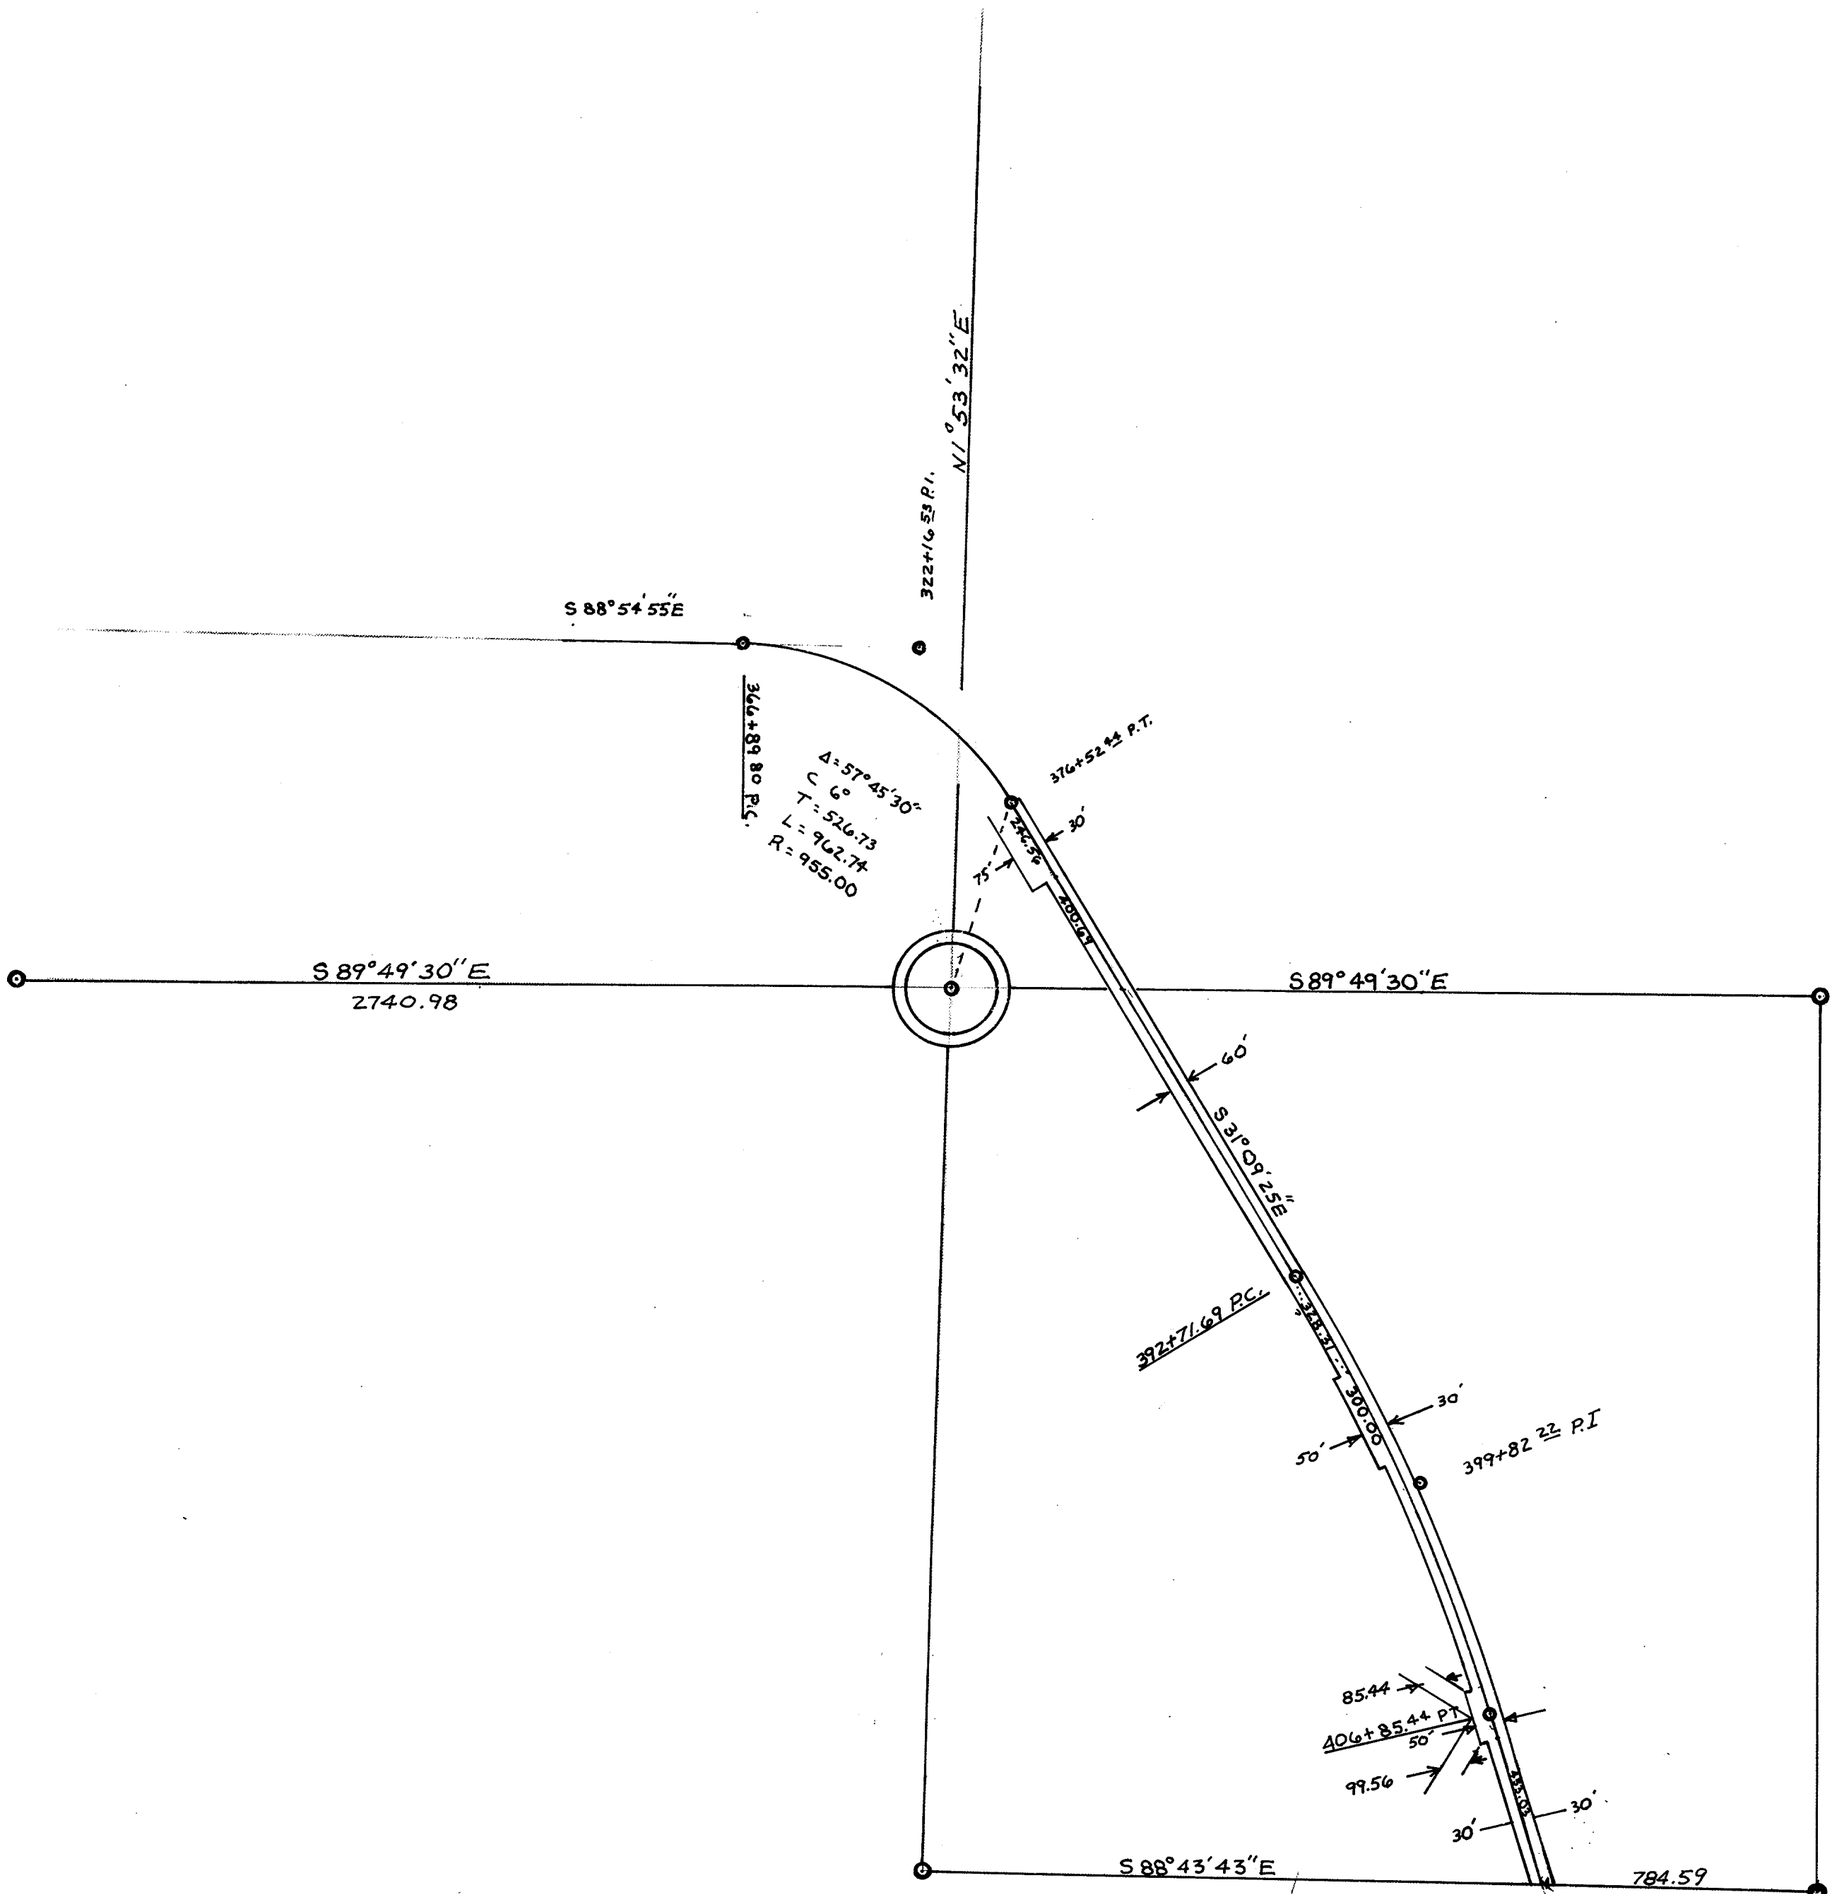


SECTION 20
TOWNSHIP 35 NORTH, RANGE 9 EAST, W. M.
SKAGIT COUNTY, WASH.

H.O. Walberg COUNTY ENGINEER

SCALE, 1 INCH--400 FEET

Fabor-Dalles Co-ordinates '50

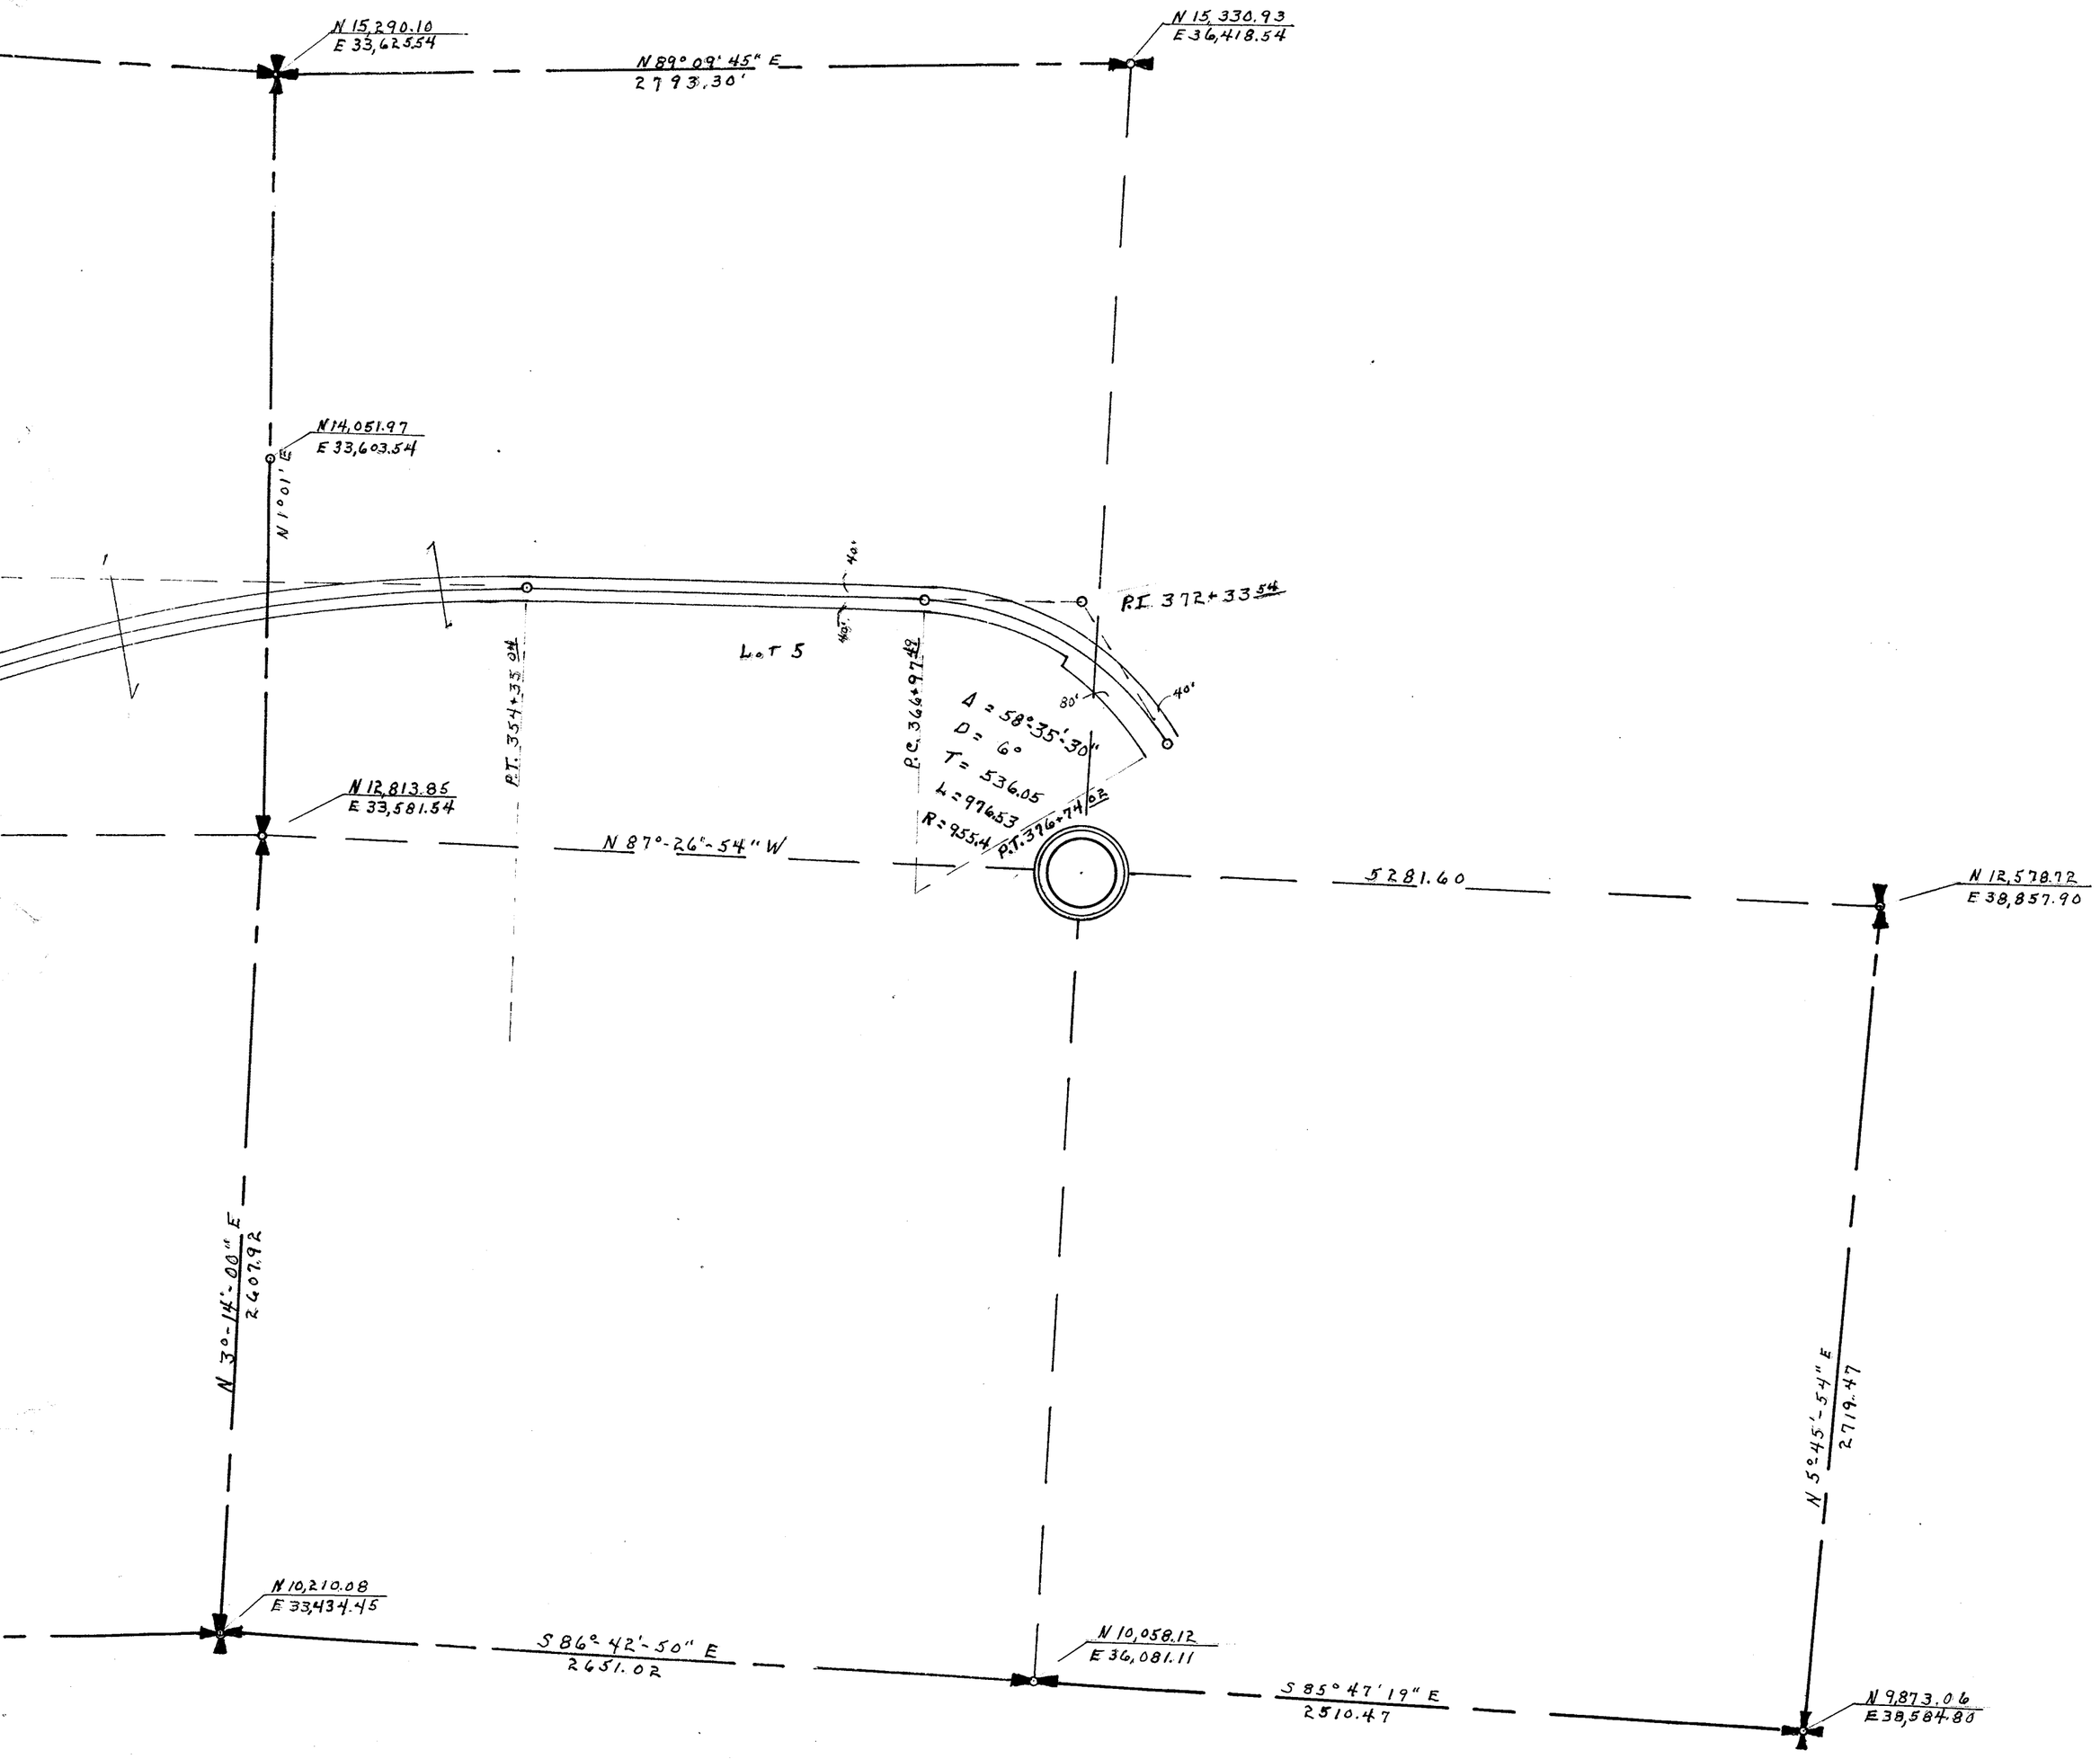

SECTION 20


TOWNSHIP 35 NORTH, RANGE 9 EAST, W. M.

SKAGIT COUNTY, WASH.

SCALE, 1 INCH--400 FEET

JULY 6, 1972

LLOYD JOHNSON COUNTY ENGINEER

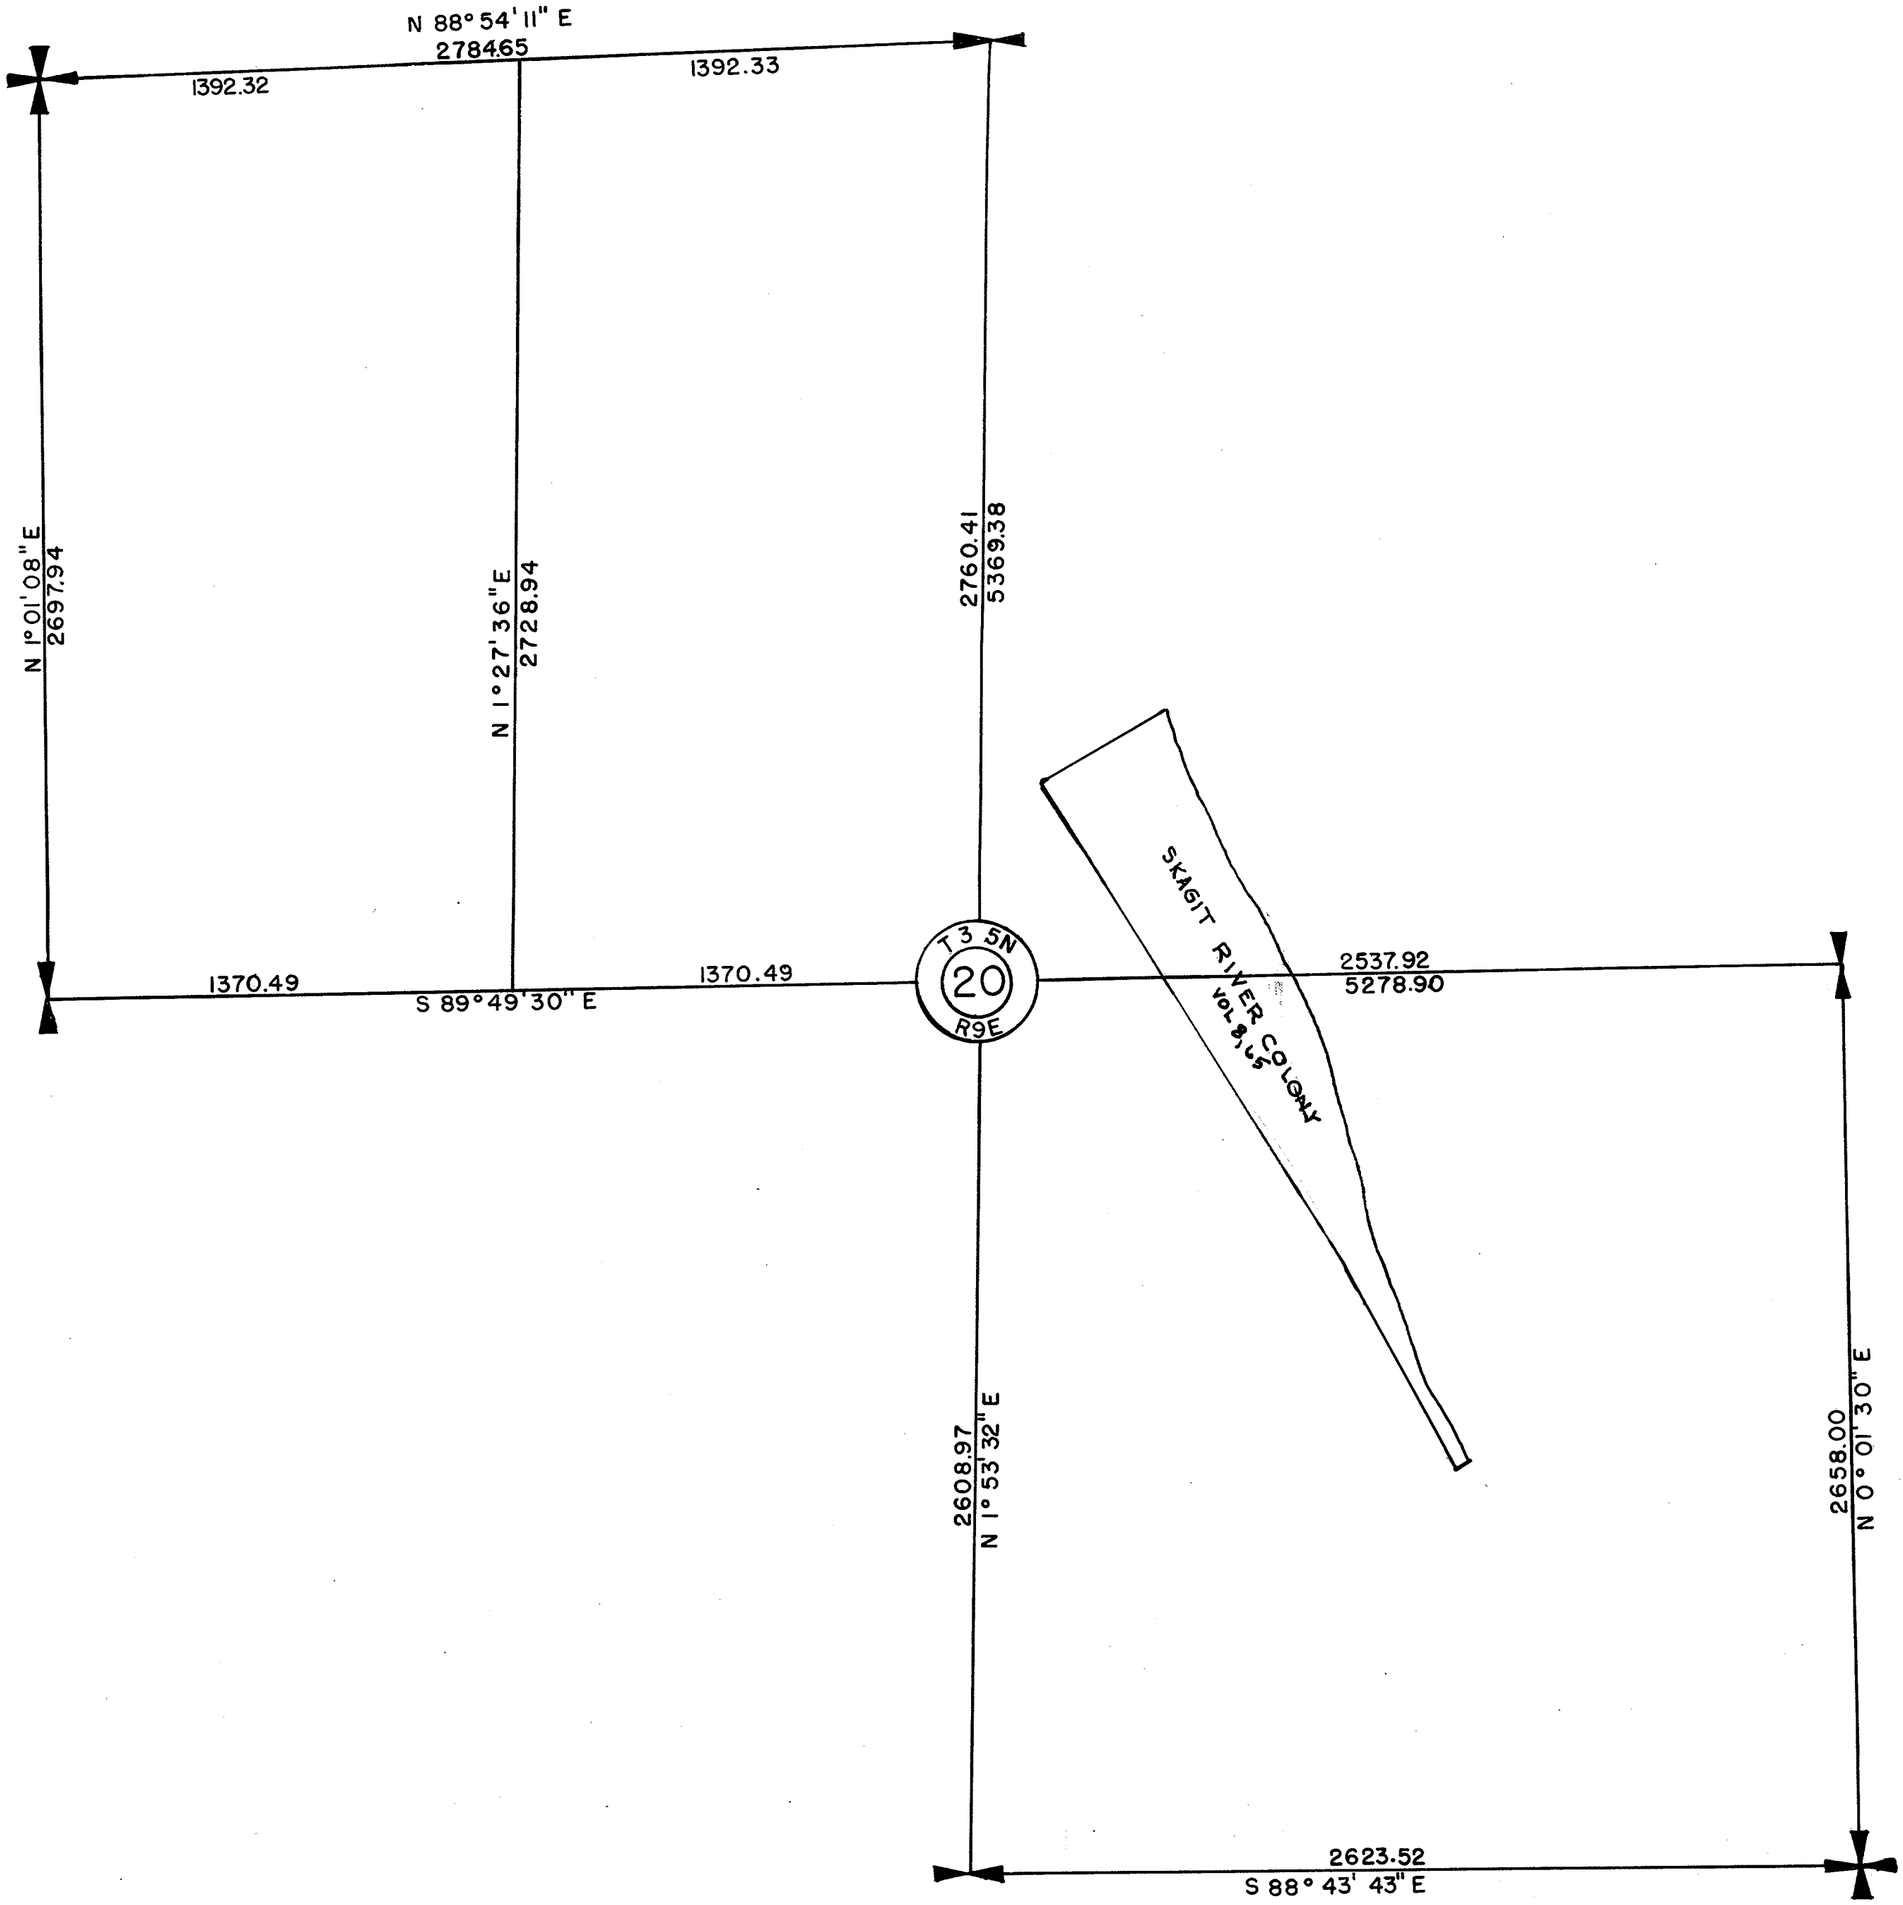


SECTION 21

TOWNSHIP 35 NORTH, RANGE 9 EAST, W. M.

SKAGIT COUNTY, WASH.

SCALE, 1 INCH--400 FEET

G. D. LeGro COUNTY ENGINEER

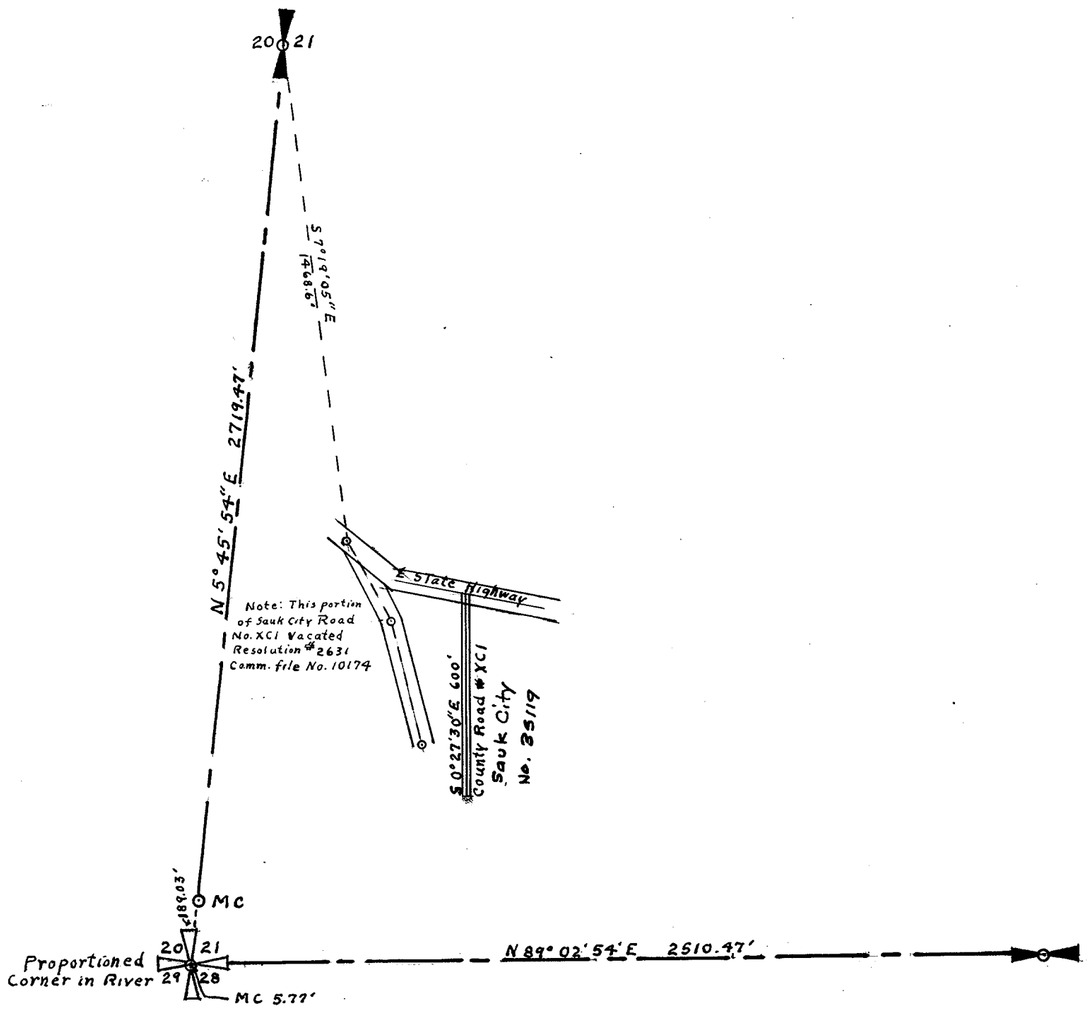

SECTION 26

TOWNSHIP 35 NORTH, RANGE 9 EAST, W. M.

SKAGIT COUNTY, WASH.

SCALE, 1 INCH -- 400 FEET

DATE Aug. 25, 1966

Lloyd Johnson COUNTY ENGINEER

B.T. D.Fir Snag 22"
N 20° E 10.6'

T-35-N
26
R-9-E

S.S.H. - 20

ROCKPORT

(No. 35183) (Short St. No. 9757)

(Main St. No. (35140) 9754) (No. 35185)

(Front St. (35138) No. 9752)

(NB) Rockport St. (NB) Edward St.

Alfred Street No. 9767 R/W - 60'

R/W - 30'

No. (35142) - 9751

East Sauk Ave.

No. (35443) - (5551) - 0860

Road R/W - 80'

Railroad

SECTION 27

TOWNSHIP 35 NORTH, RANGE 9 EAST, W. M.


SKAGIT COUNTY, WASH.

SCALE, 1 INCH–400 FEET

Robt. E. L. Knapp COUNTY ENGINEER

N 1/4 Ref.
12" Hem. N 70° W 44.5'
20" Hem. S 16° E 52.0'

Ref. E 1/4 Cor.
22" D. Fir Snag
N 20° E 10.6'

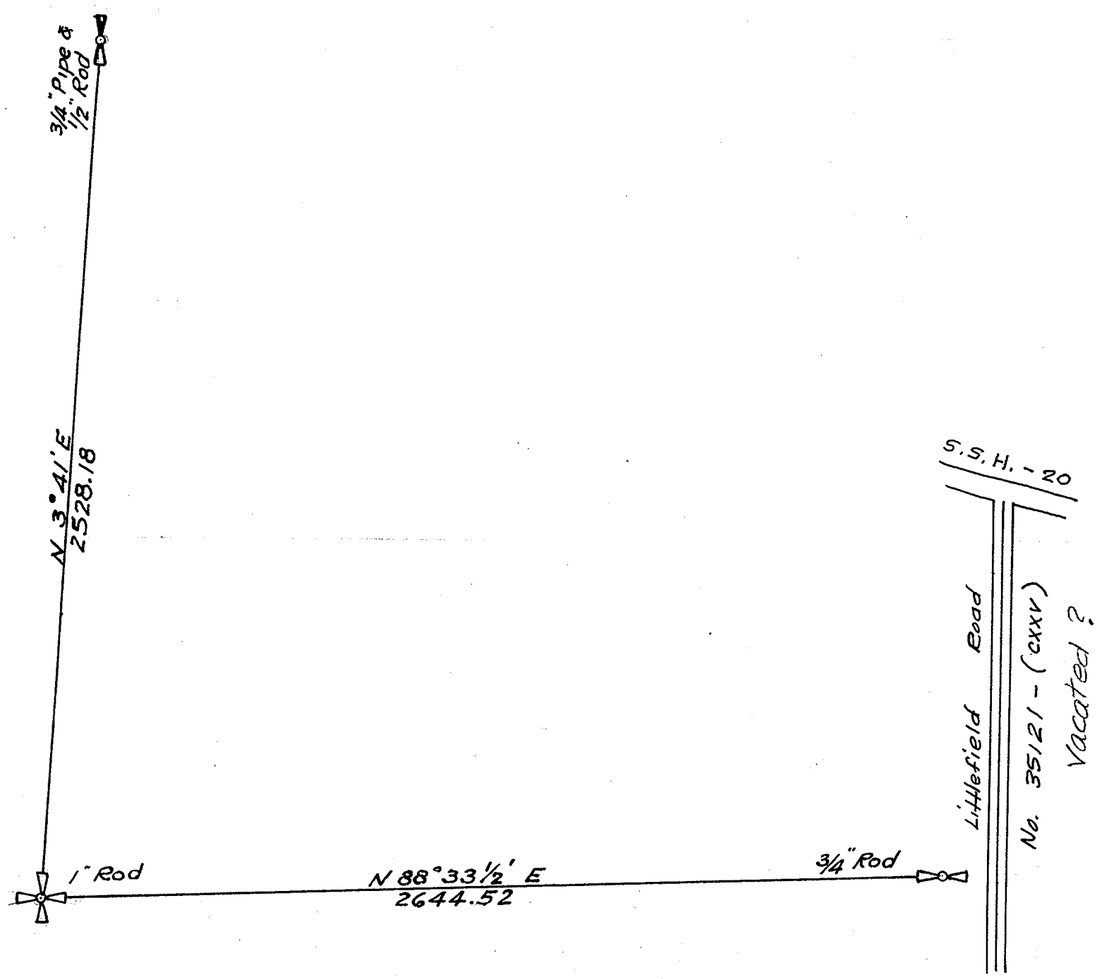

SECTION 28


TOWNSHIP 35 NORTH. RANGE 9 EAST. W. M.

SKAGIT COUNTY. WASH.

SCALE. 1 INCH—400 FEET

DATE_____

_____ COUNTY ENGINEER

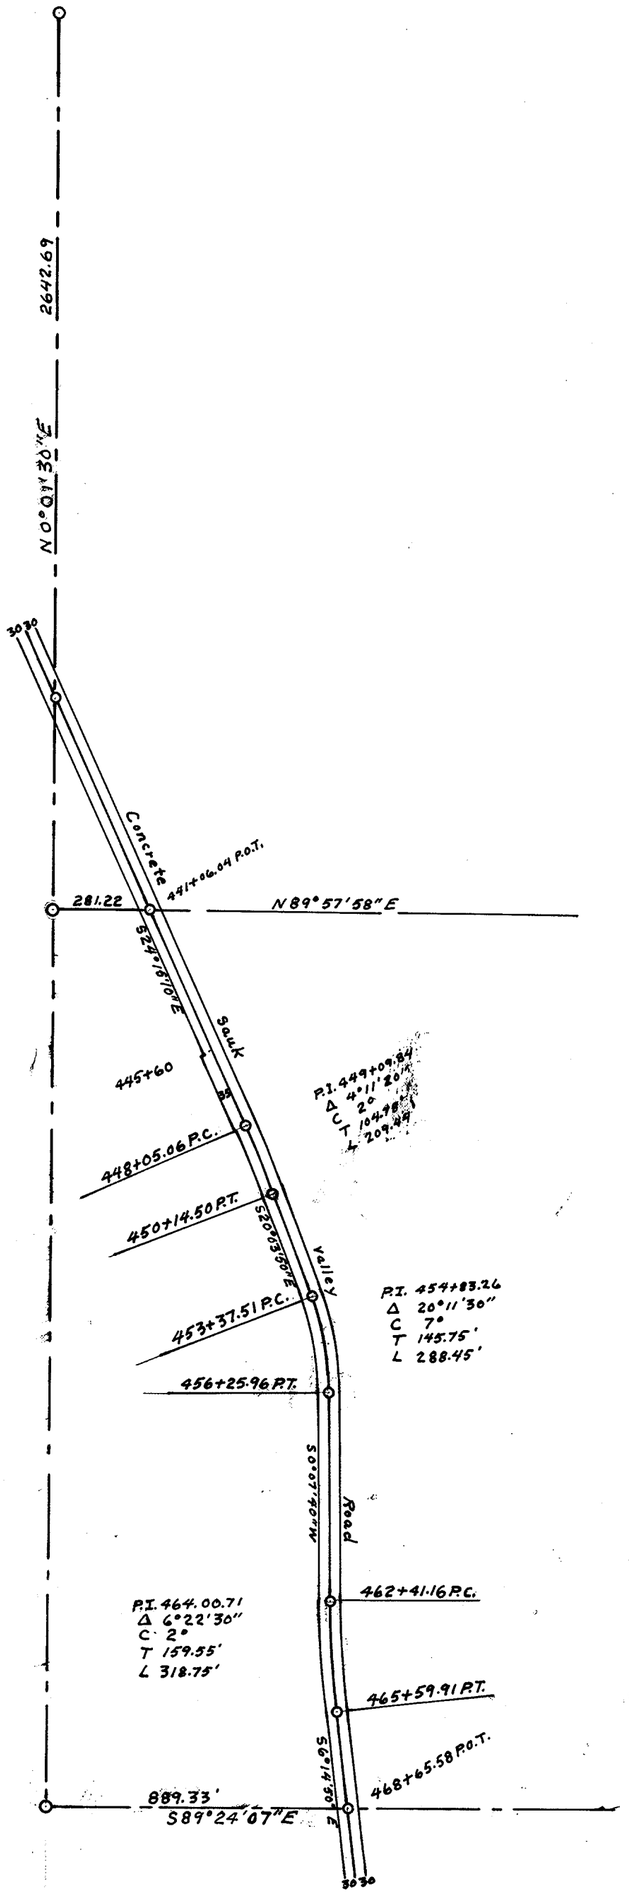

SECTION 28


TOWNSHIP 35 NORTH, RANGE 9 EAST, W. M.

SKAGIT COUNTY, WASH.

SCALE, 1 INCH--400 FEET

DATE Aug. 9, 1963

LLOYD H. JOHNSON COUNTY ENGINEER

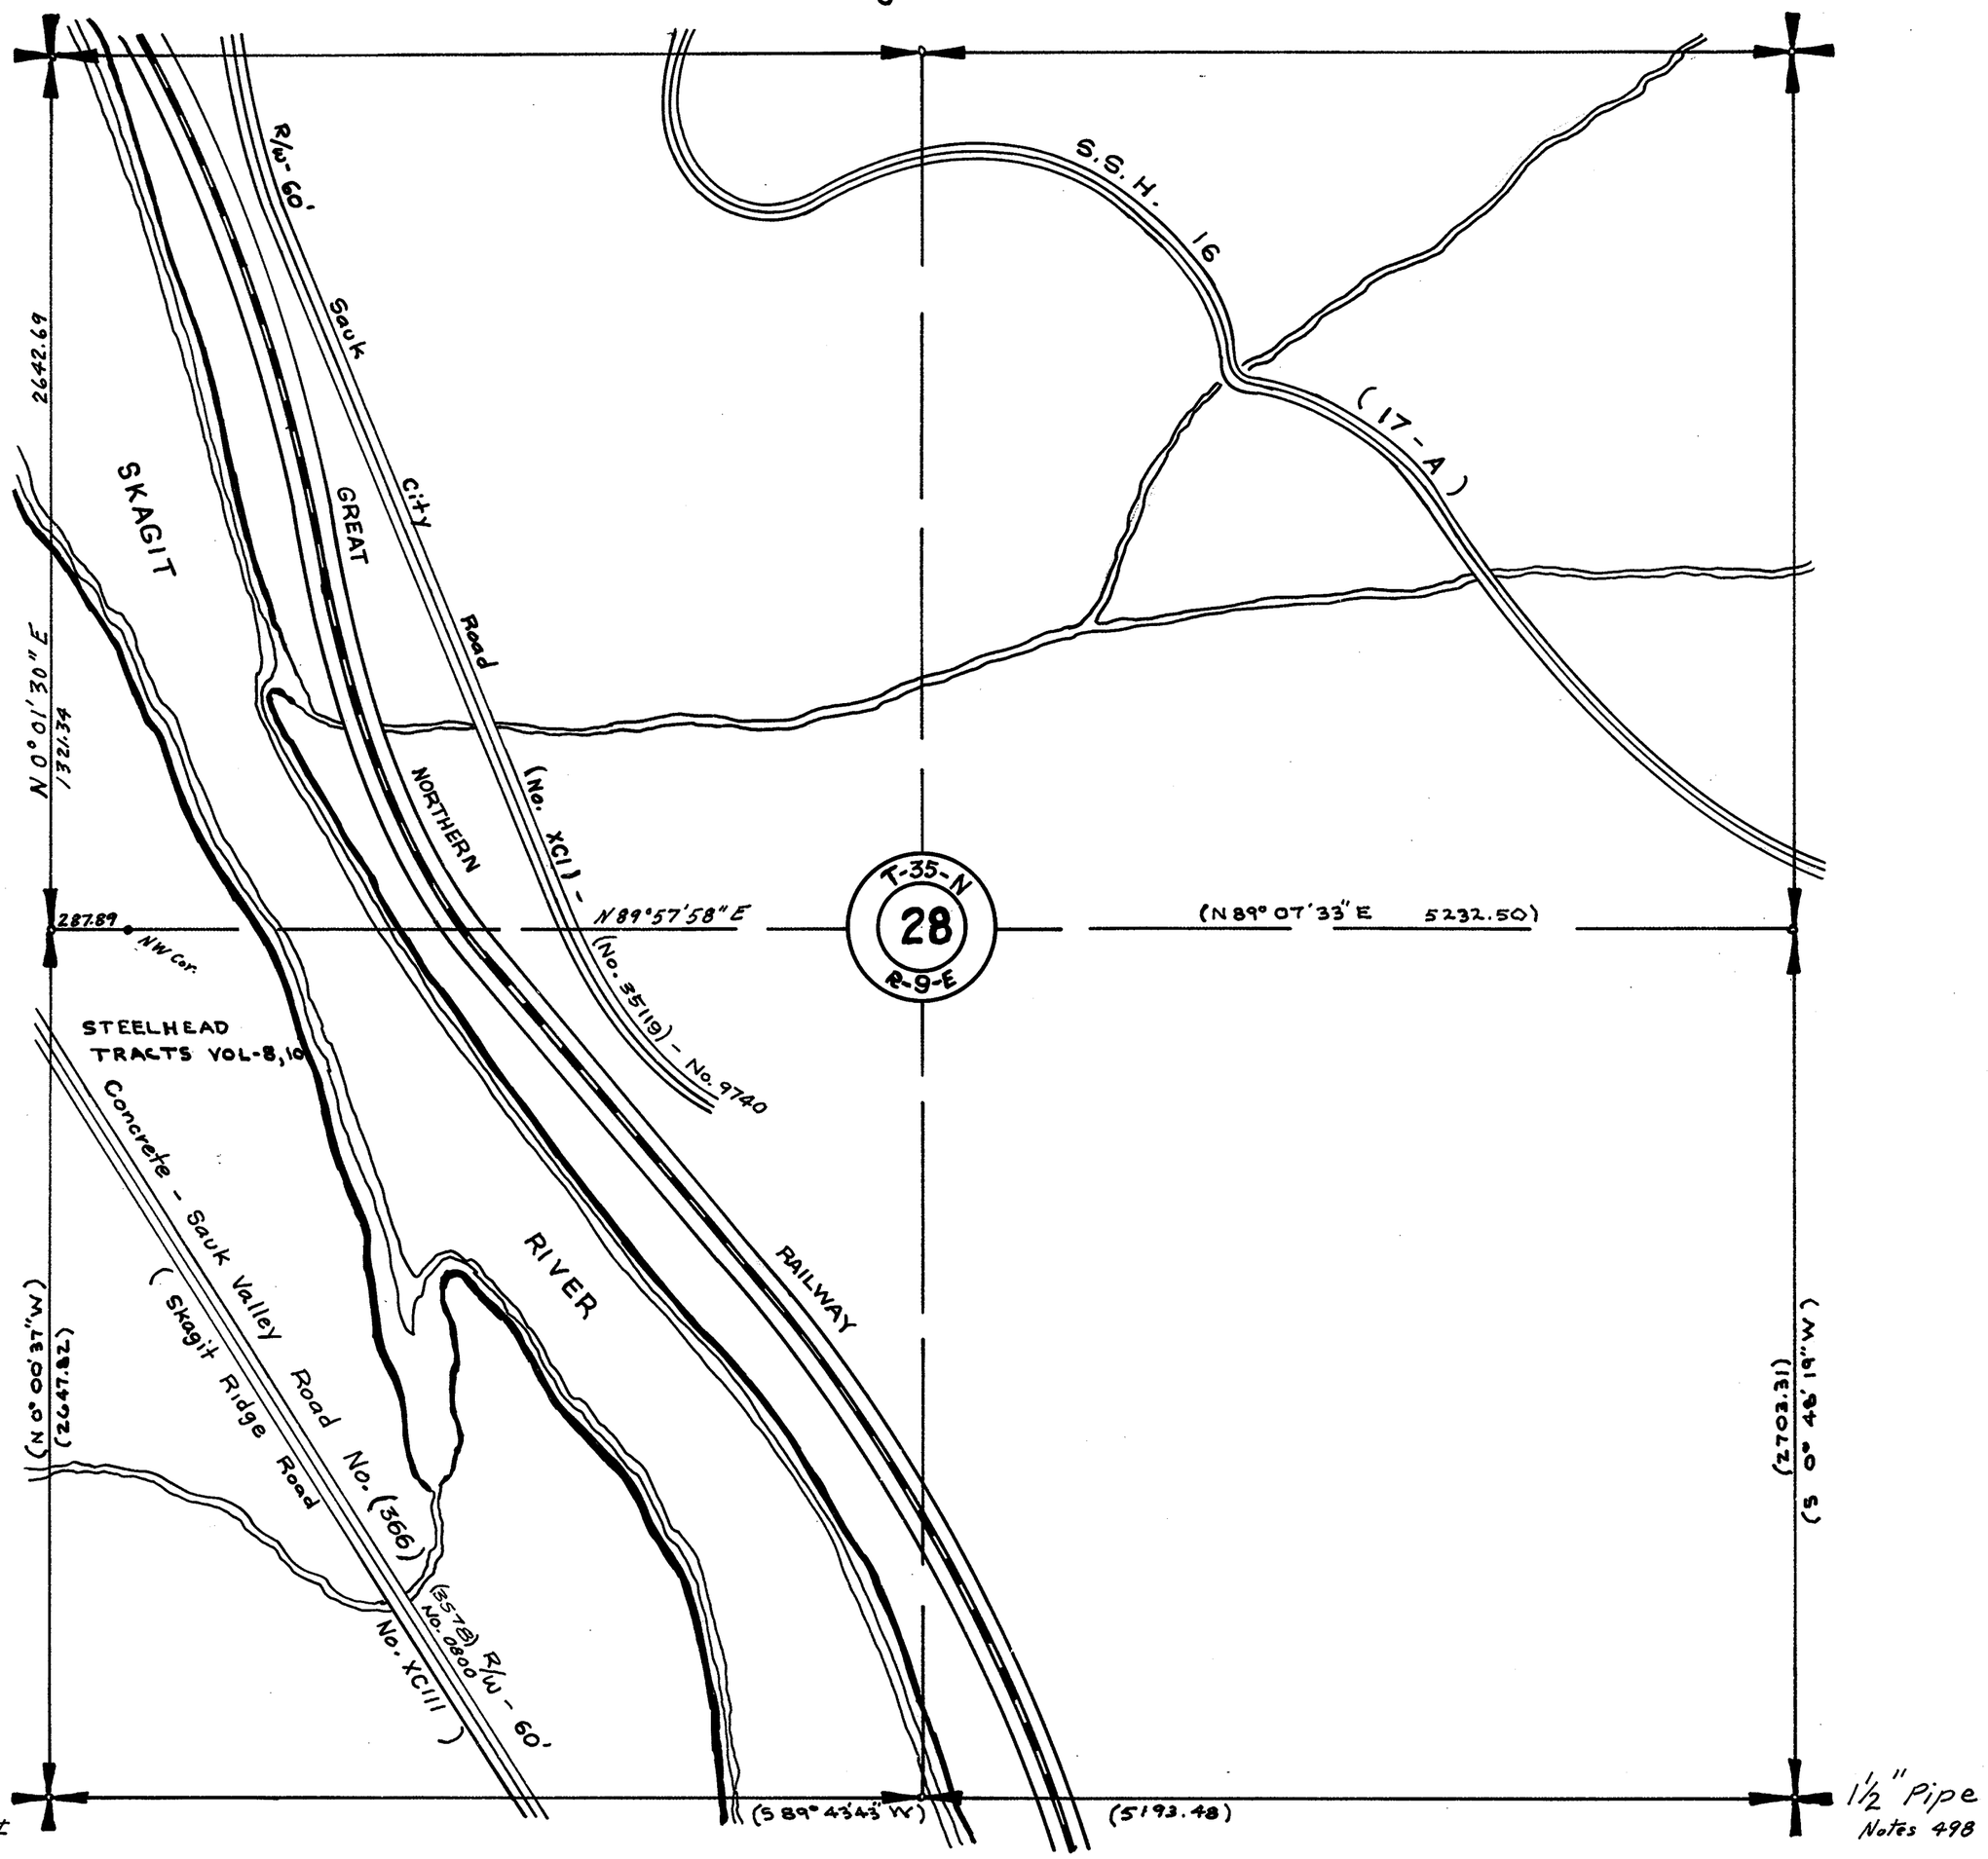

SECTION 29


TOWNSHIP 35 NORTH. RANGE 9 EAST. W. M.

SKAGIT COUNTY. WASH.

SCALE, 1 INCH—400 FEET

Lloyd Johnson COUNTY ENGINEER

DATE 7-1-75

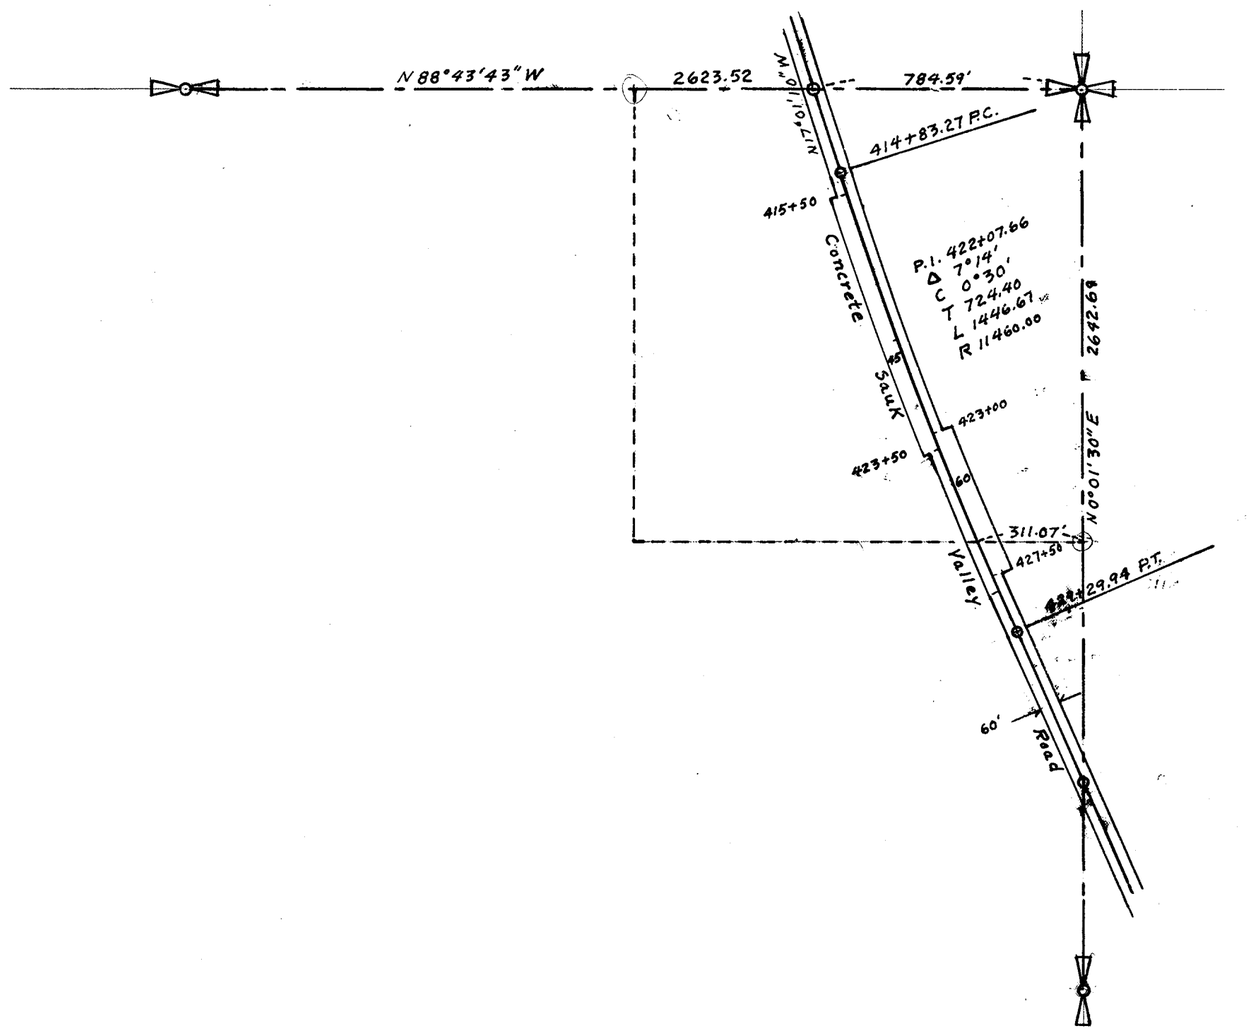

SECTION 33


TOWNSHIP 35 NORTH, RANGE 9 EAST, W. M.

SKAGIT COUNTY, WASH.

SCALE, 1 INCH--400 FEET

DATE Aug. 12, 1963

COUNTY ENGINEER

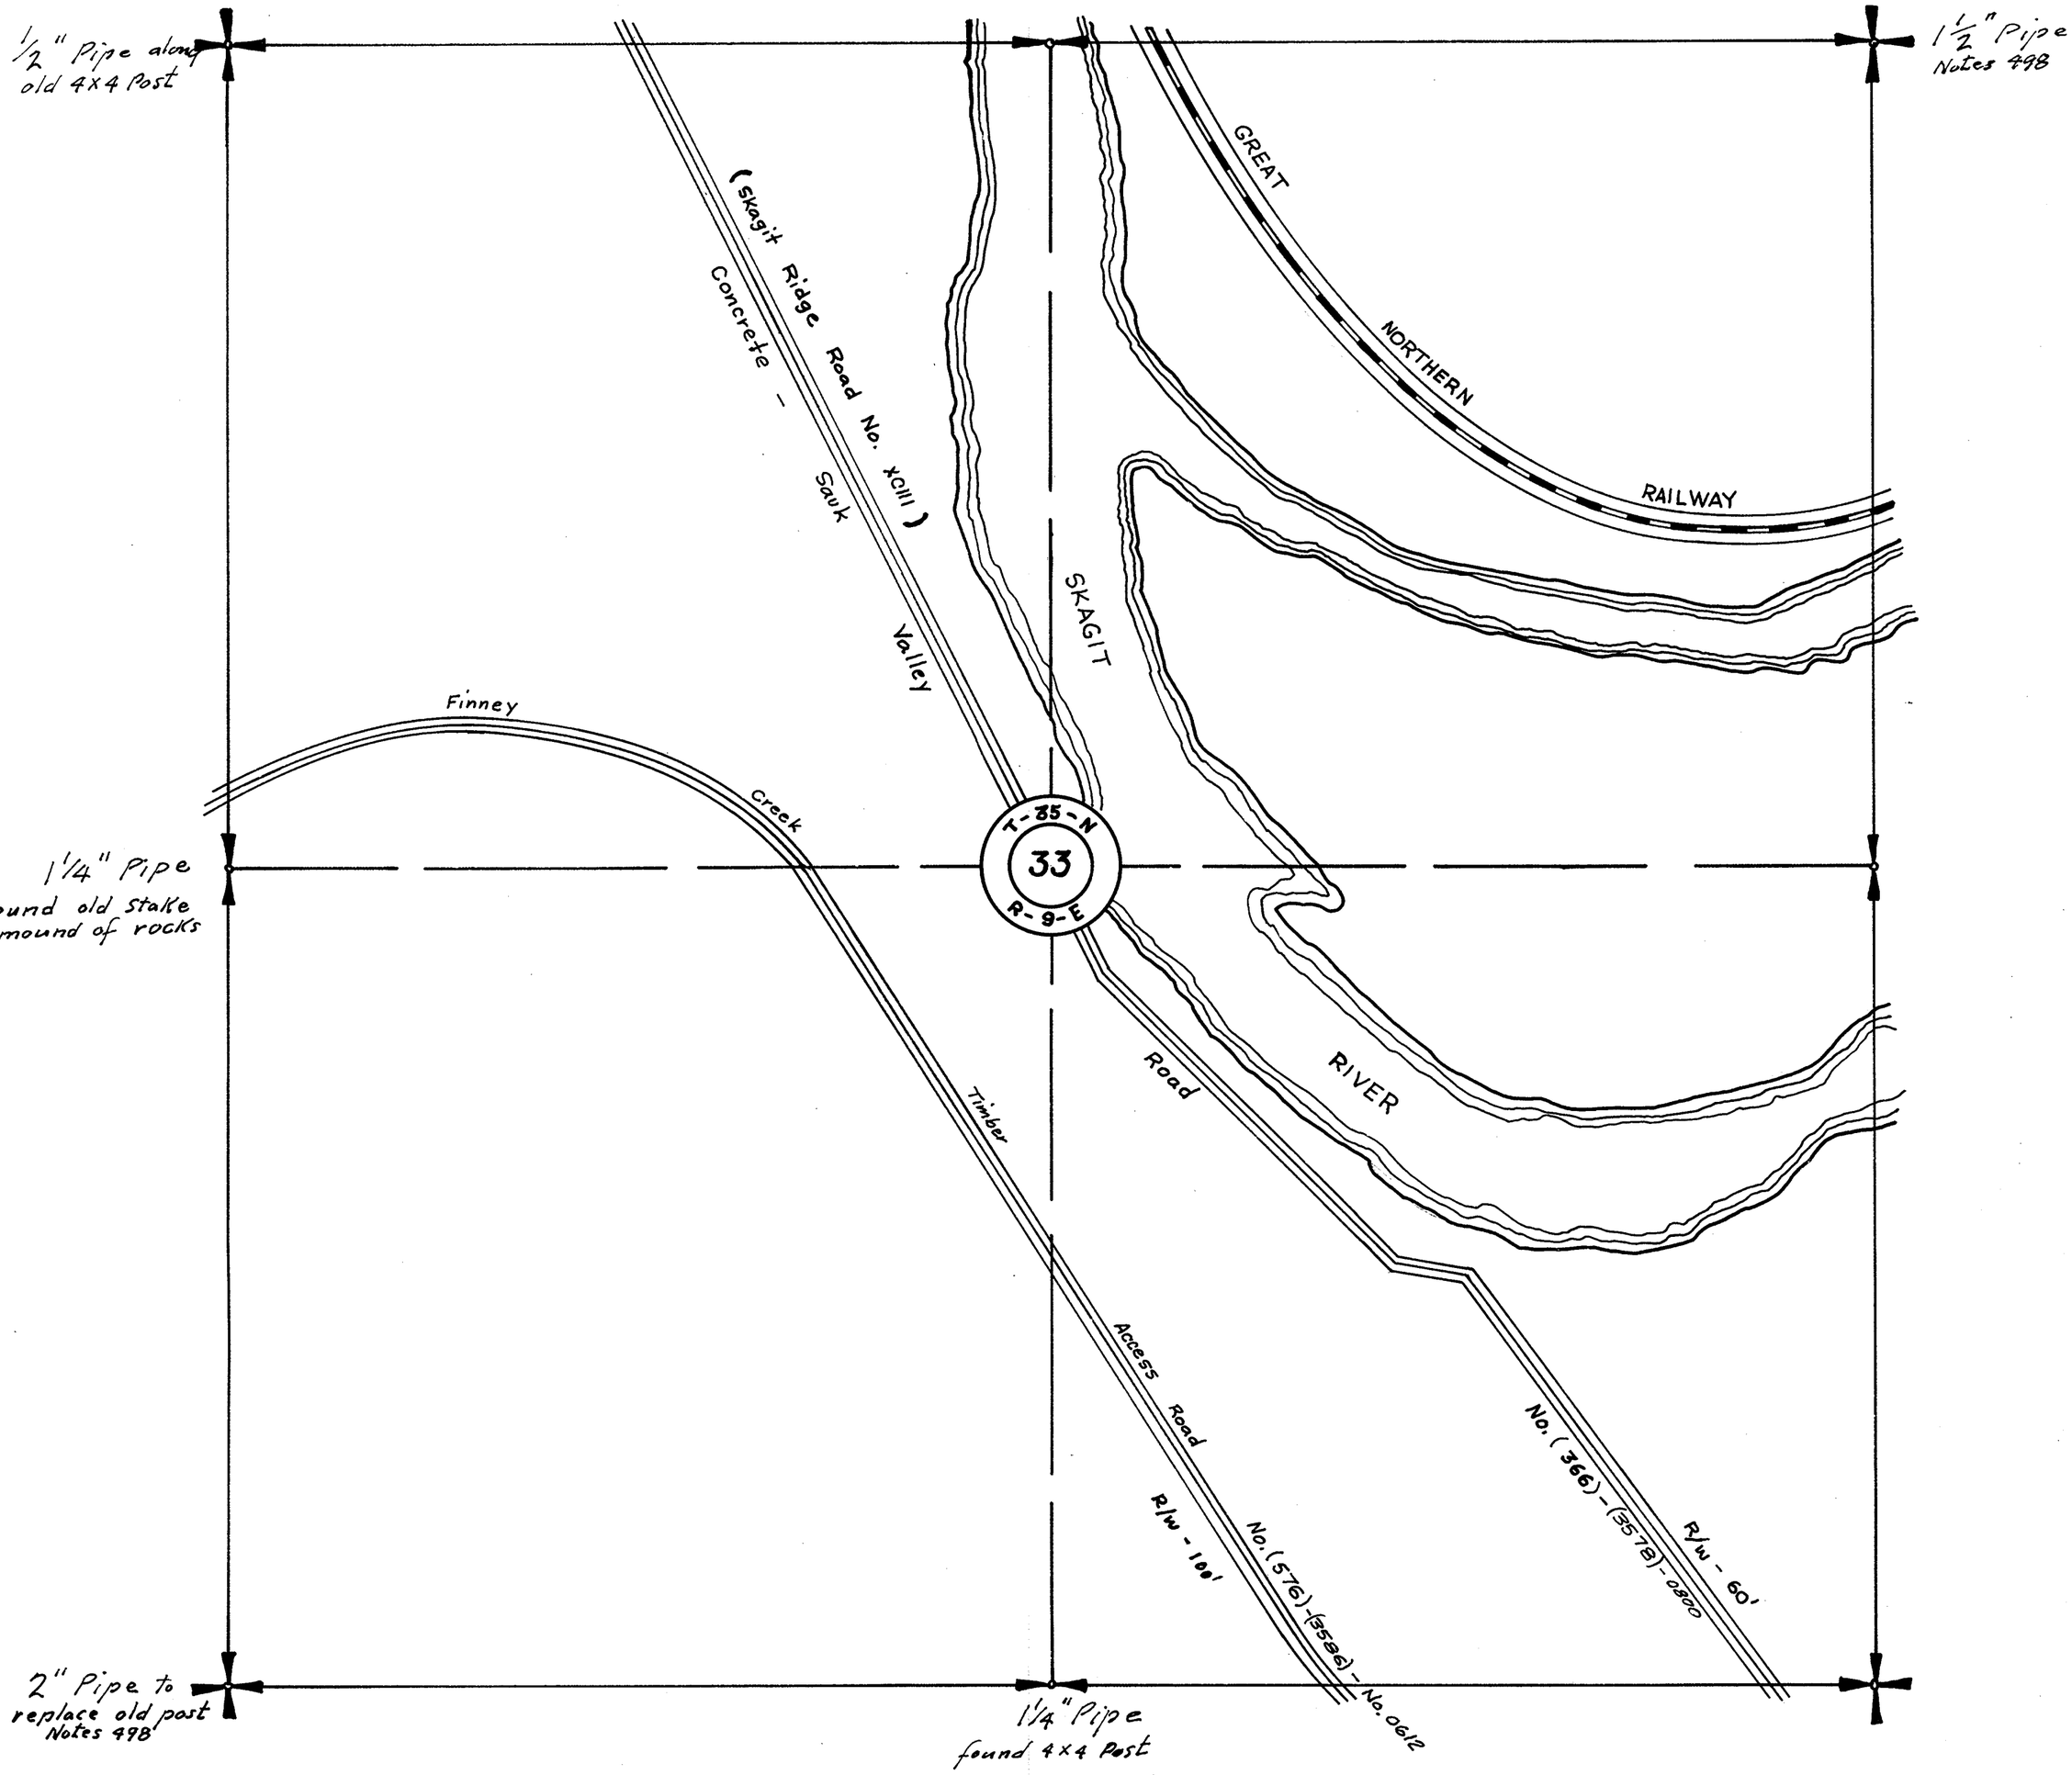

SECTION 34


TOWNSHIP 35 NORTH, RANGE 9 EAST, W. M.

SKAGIT COUNTY, WASH.

SCALE, 1 INCH--400 FEET

DATE Aug. 12, 1963

COUNTY ENGINEER

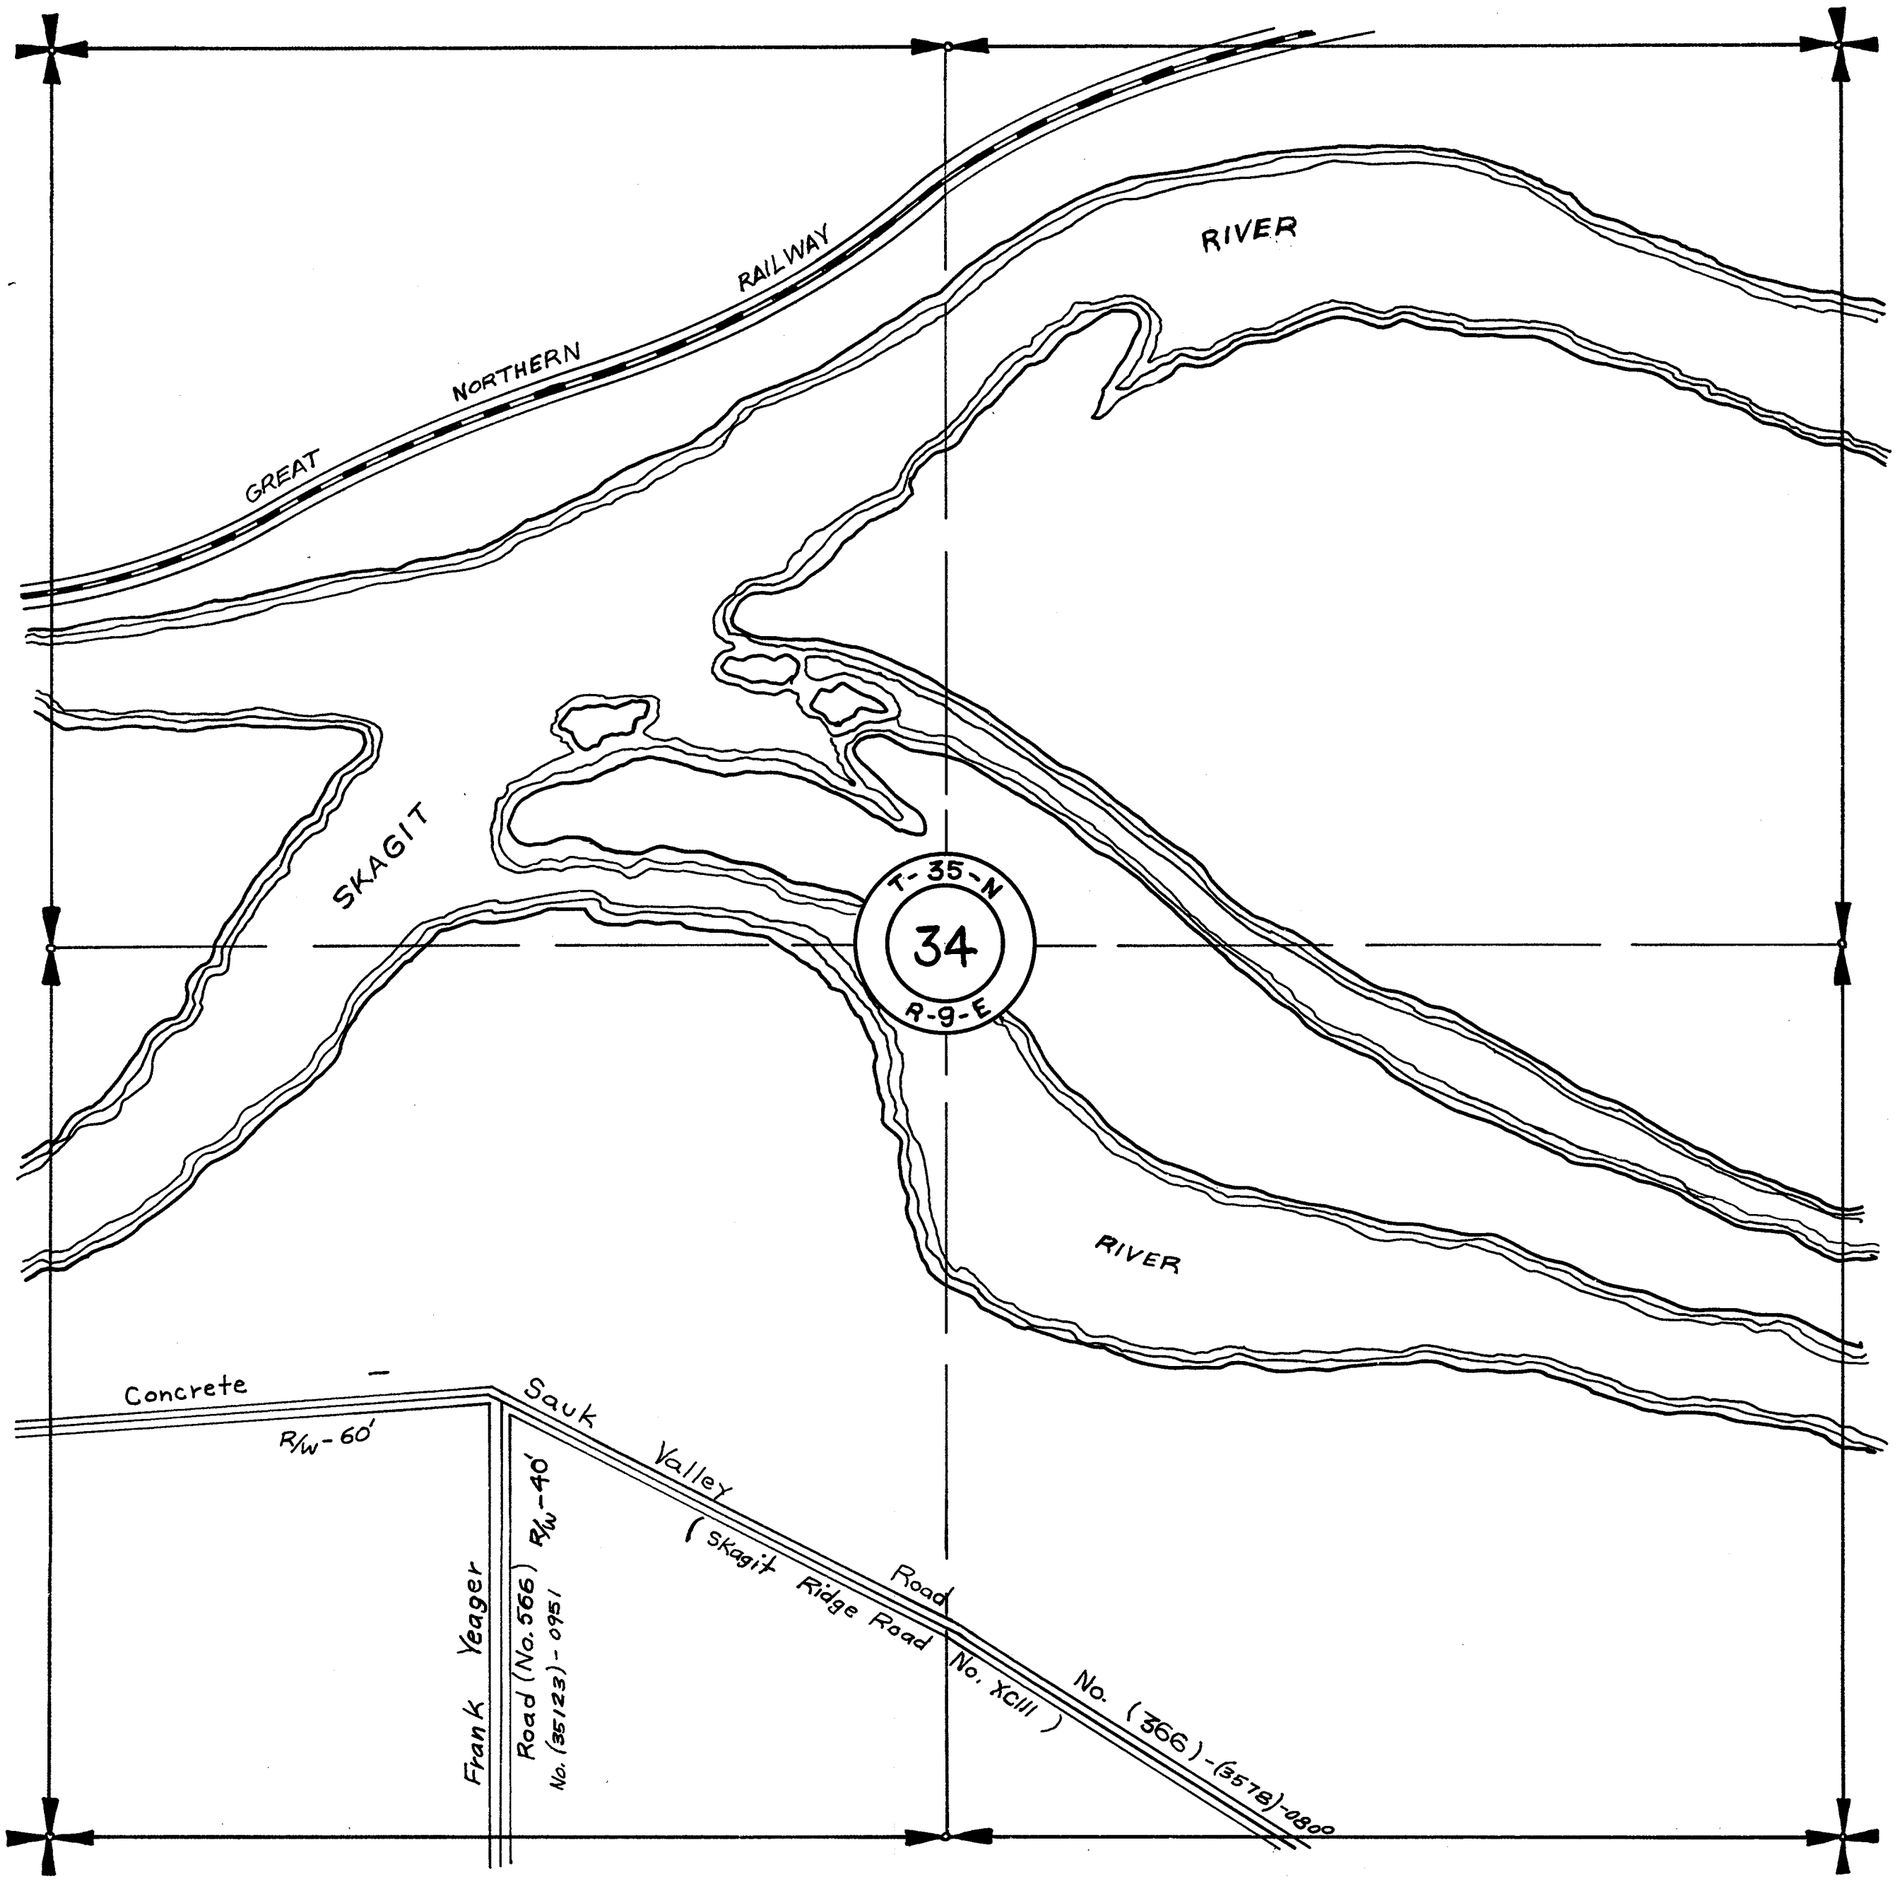


SECTION 34

TOWNSHIP 35 NORTH, RANGE 9 EAST, W. M.
SKAGIT COUNTY, WASH.

SCALE, 1 INCH–400 FEET

Robt. E. L. Knapp COUNTY ENGINEER

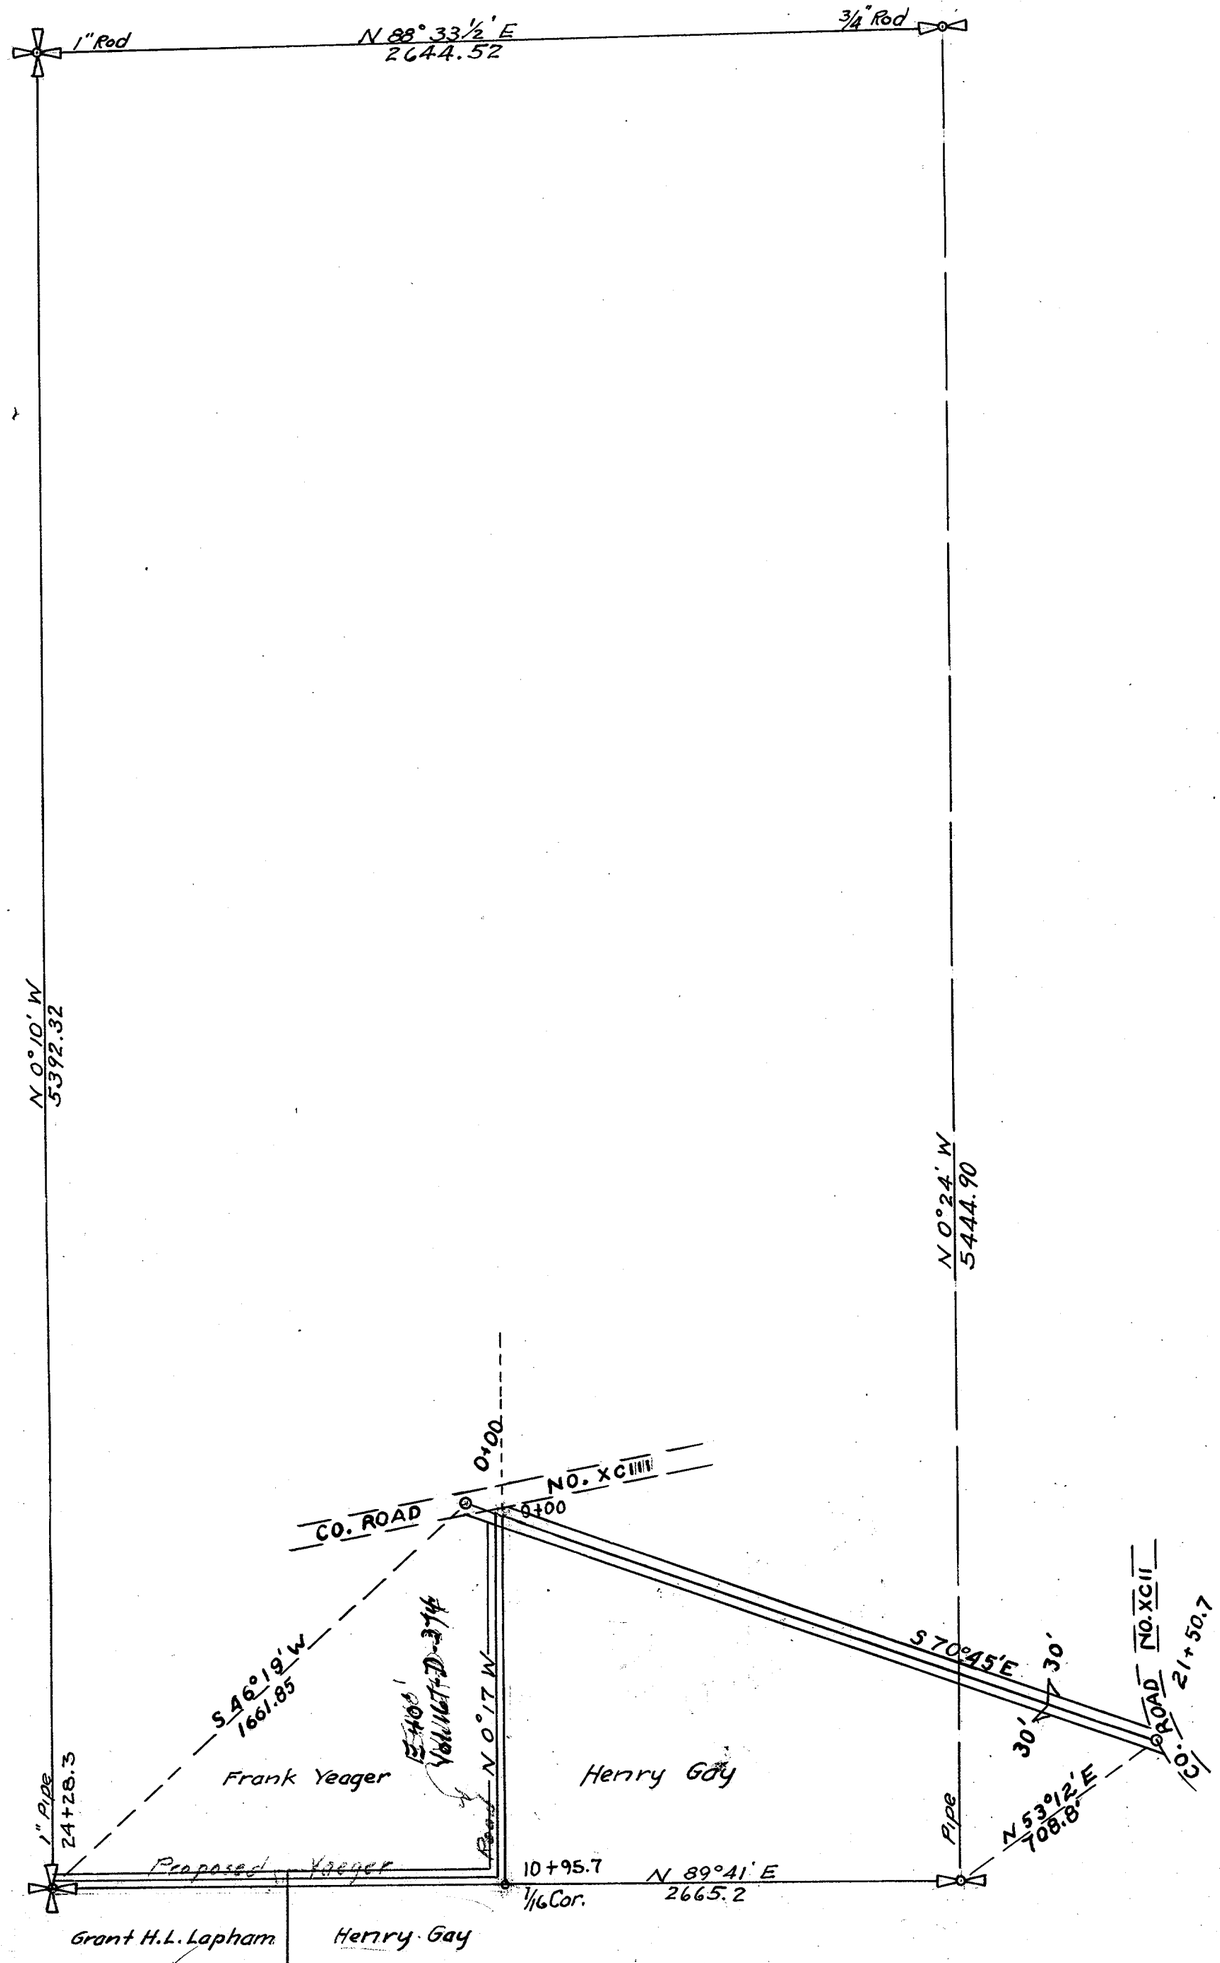

SECTION 36


TOWNSHIP 35 NORTH, RANGE 9 EAST, W. M.

SKAGIT COUNTY, WASH.

SCALE, 1 INCH - - 400 FEET

DATE Aug. 25, 1966

Lloyd Johnson COUNTY ENGINEER

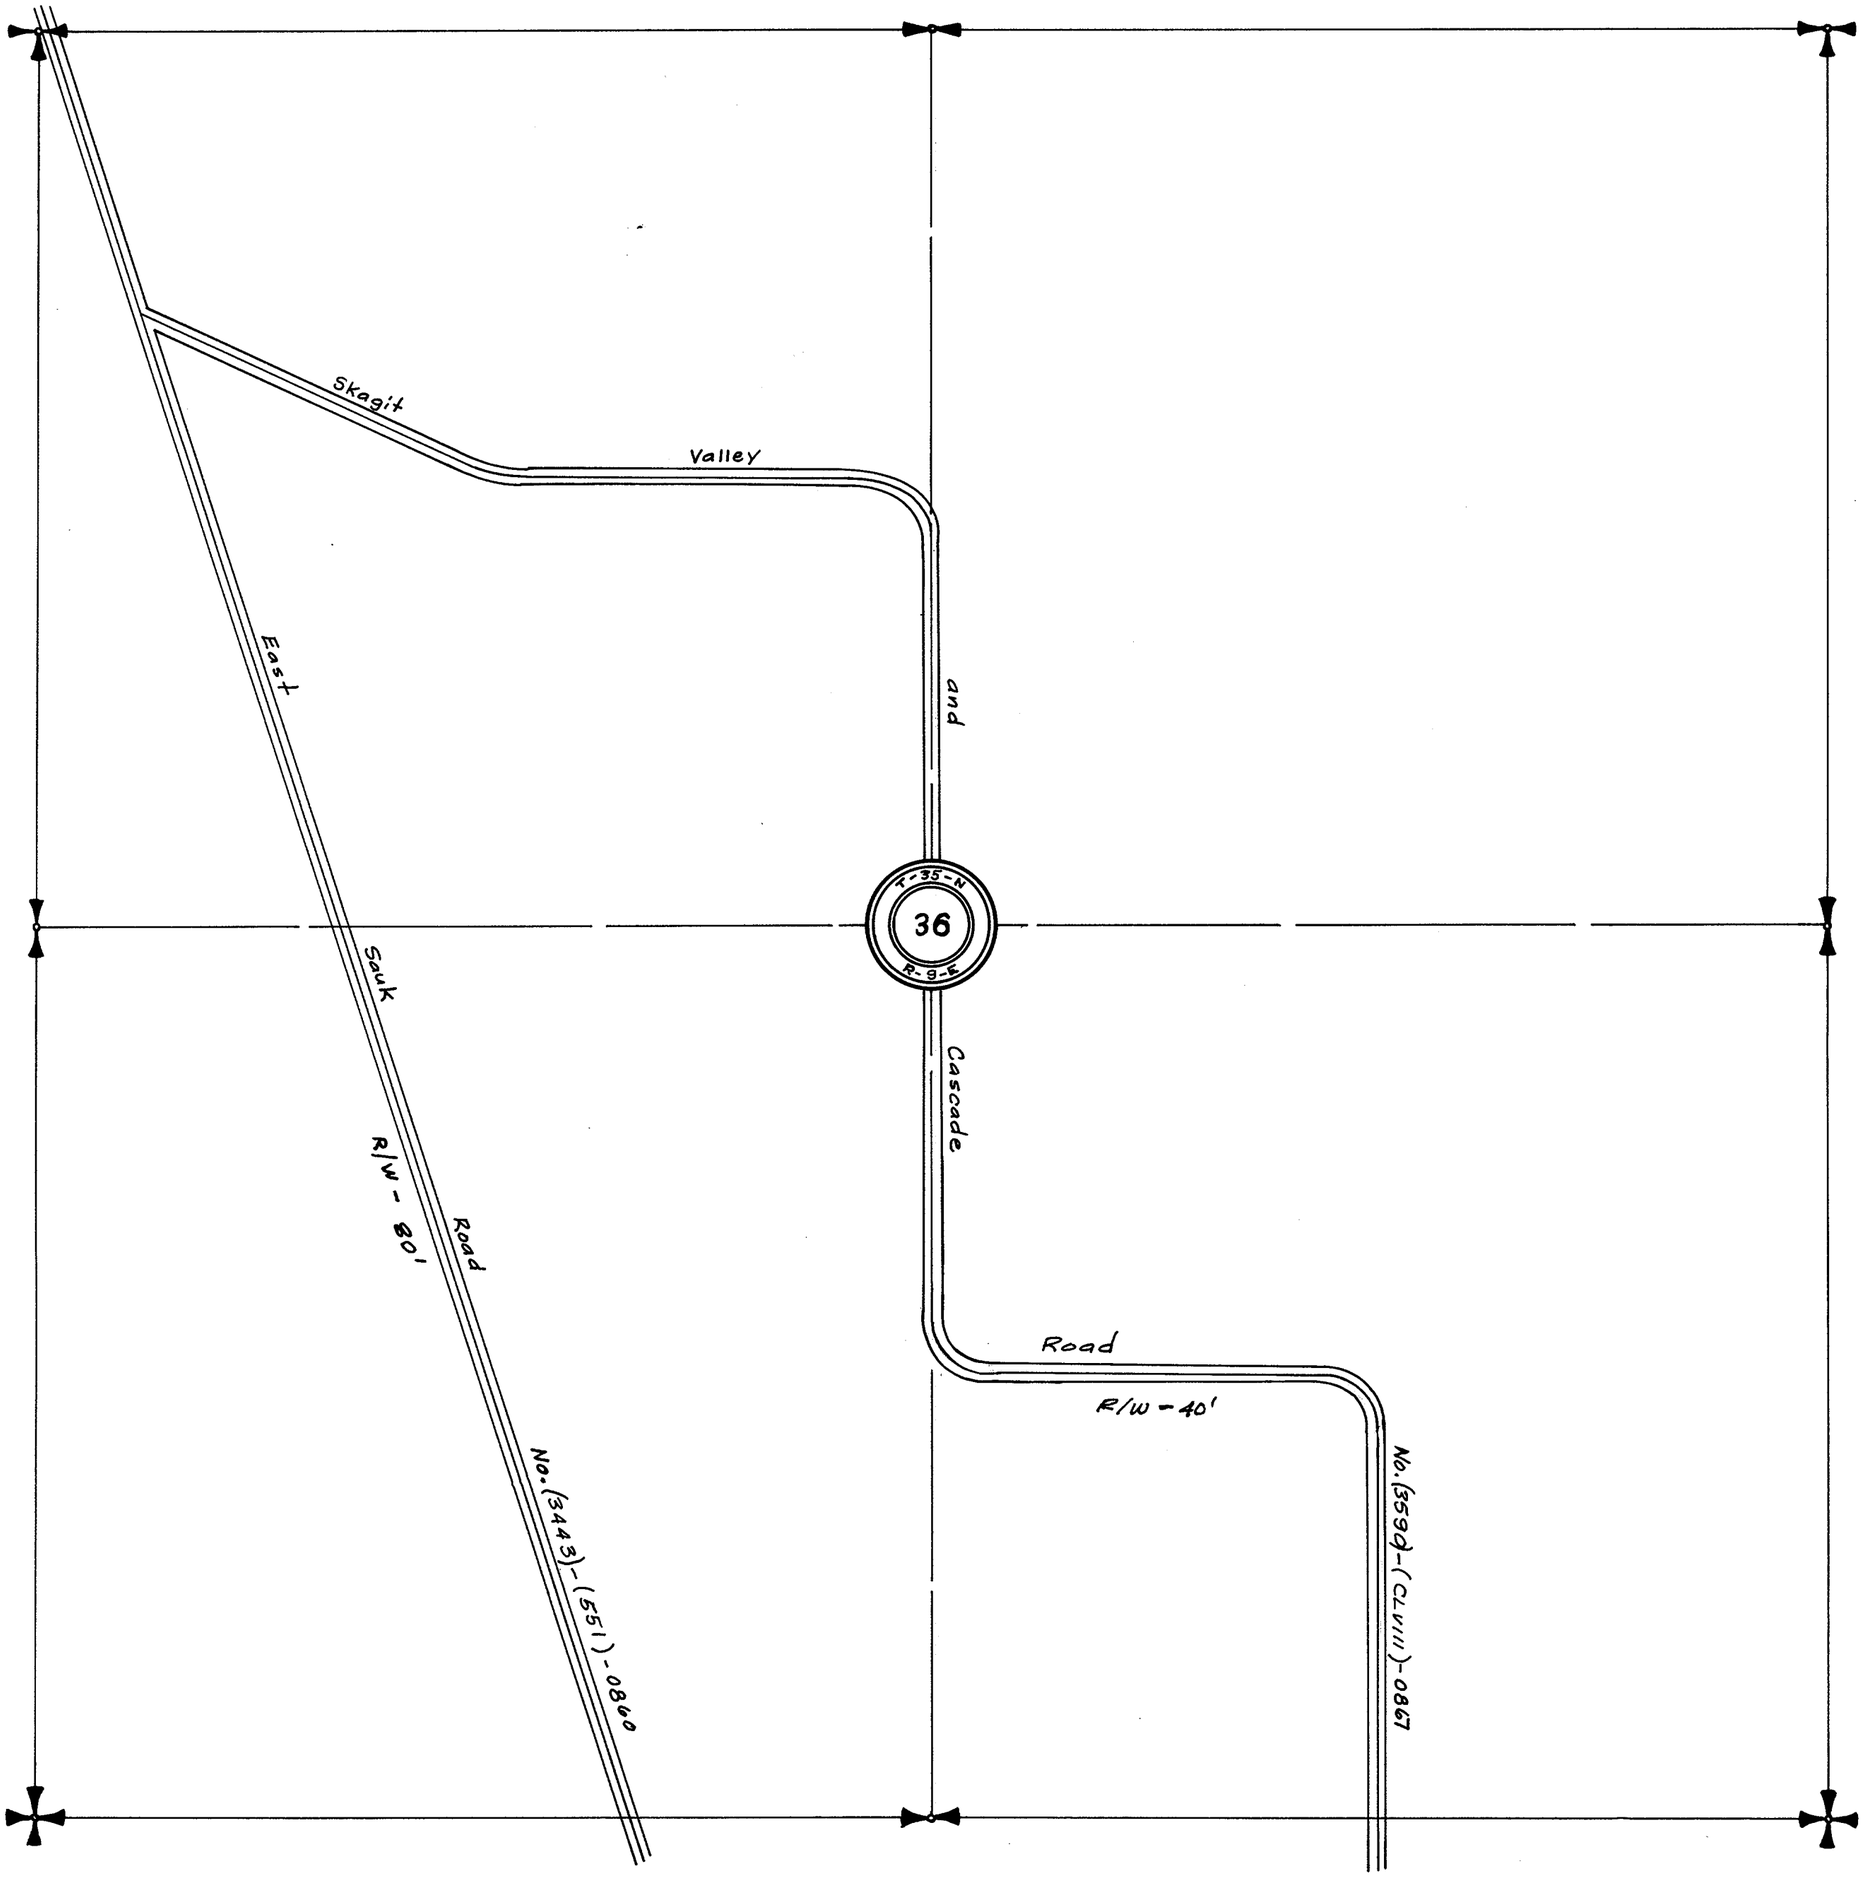




SKAGIT COUNTY, WASH.

SCALE, 1 INCH--400 FEET

DATE Aug. 29, 1966

Lloyd Johnson COUNTY ENGINEER

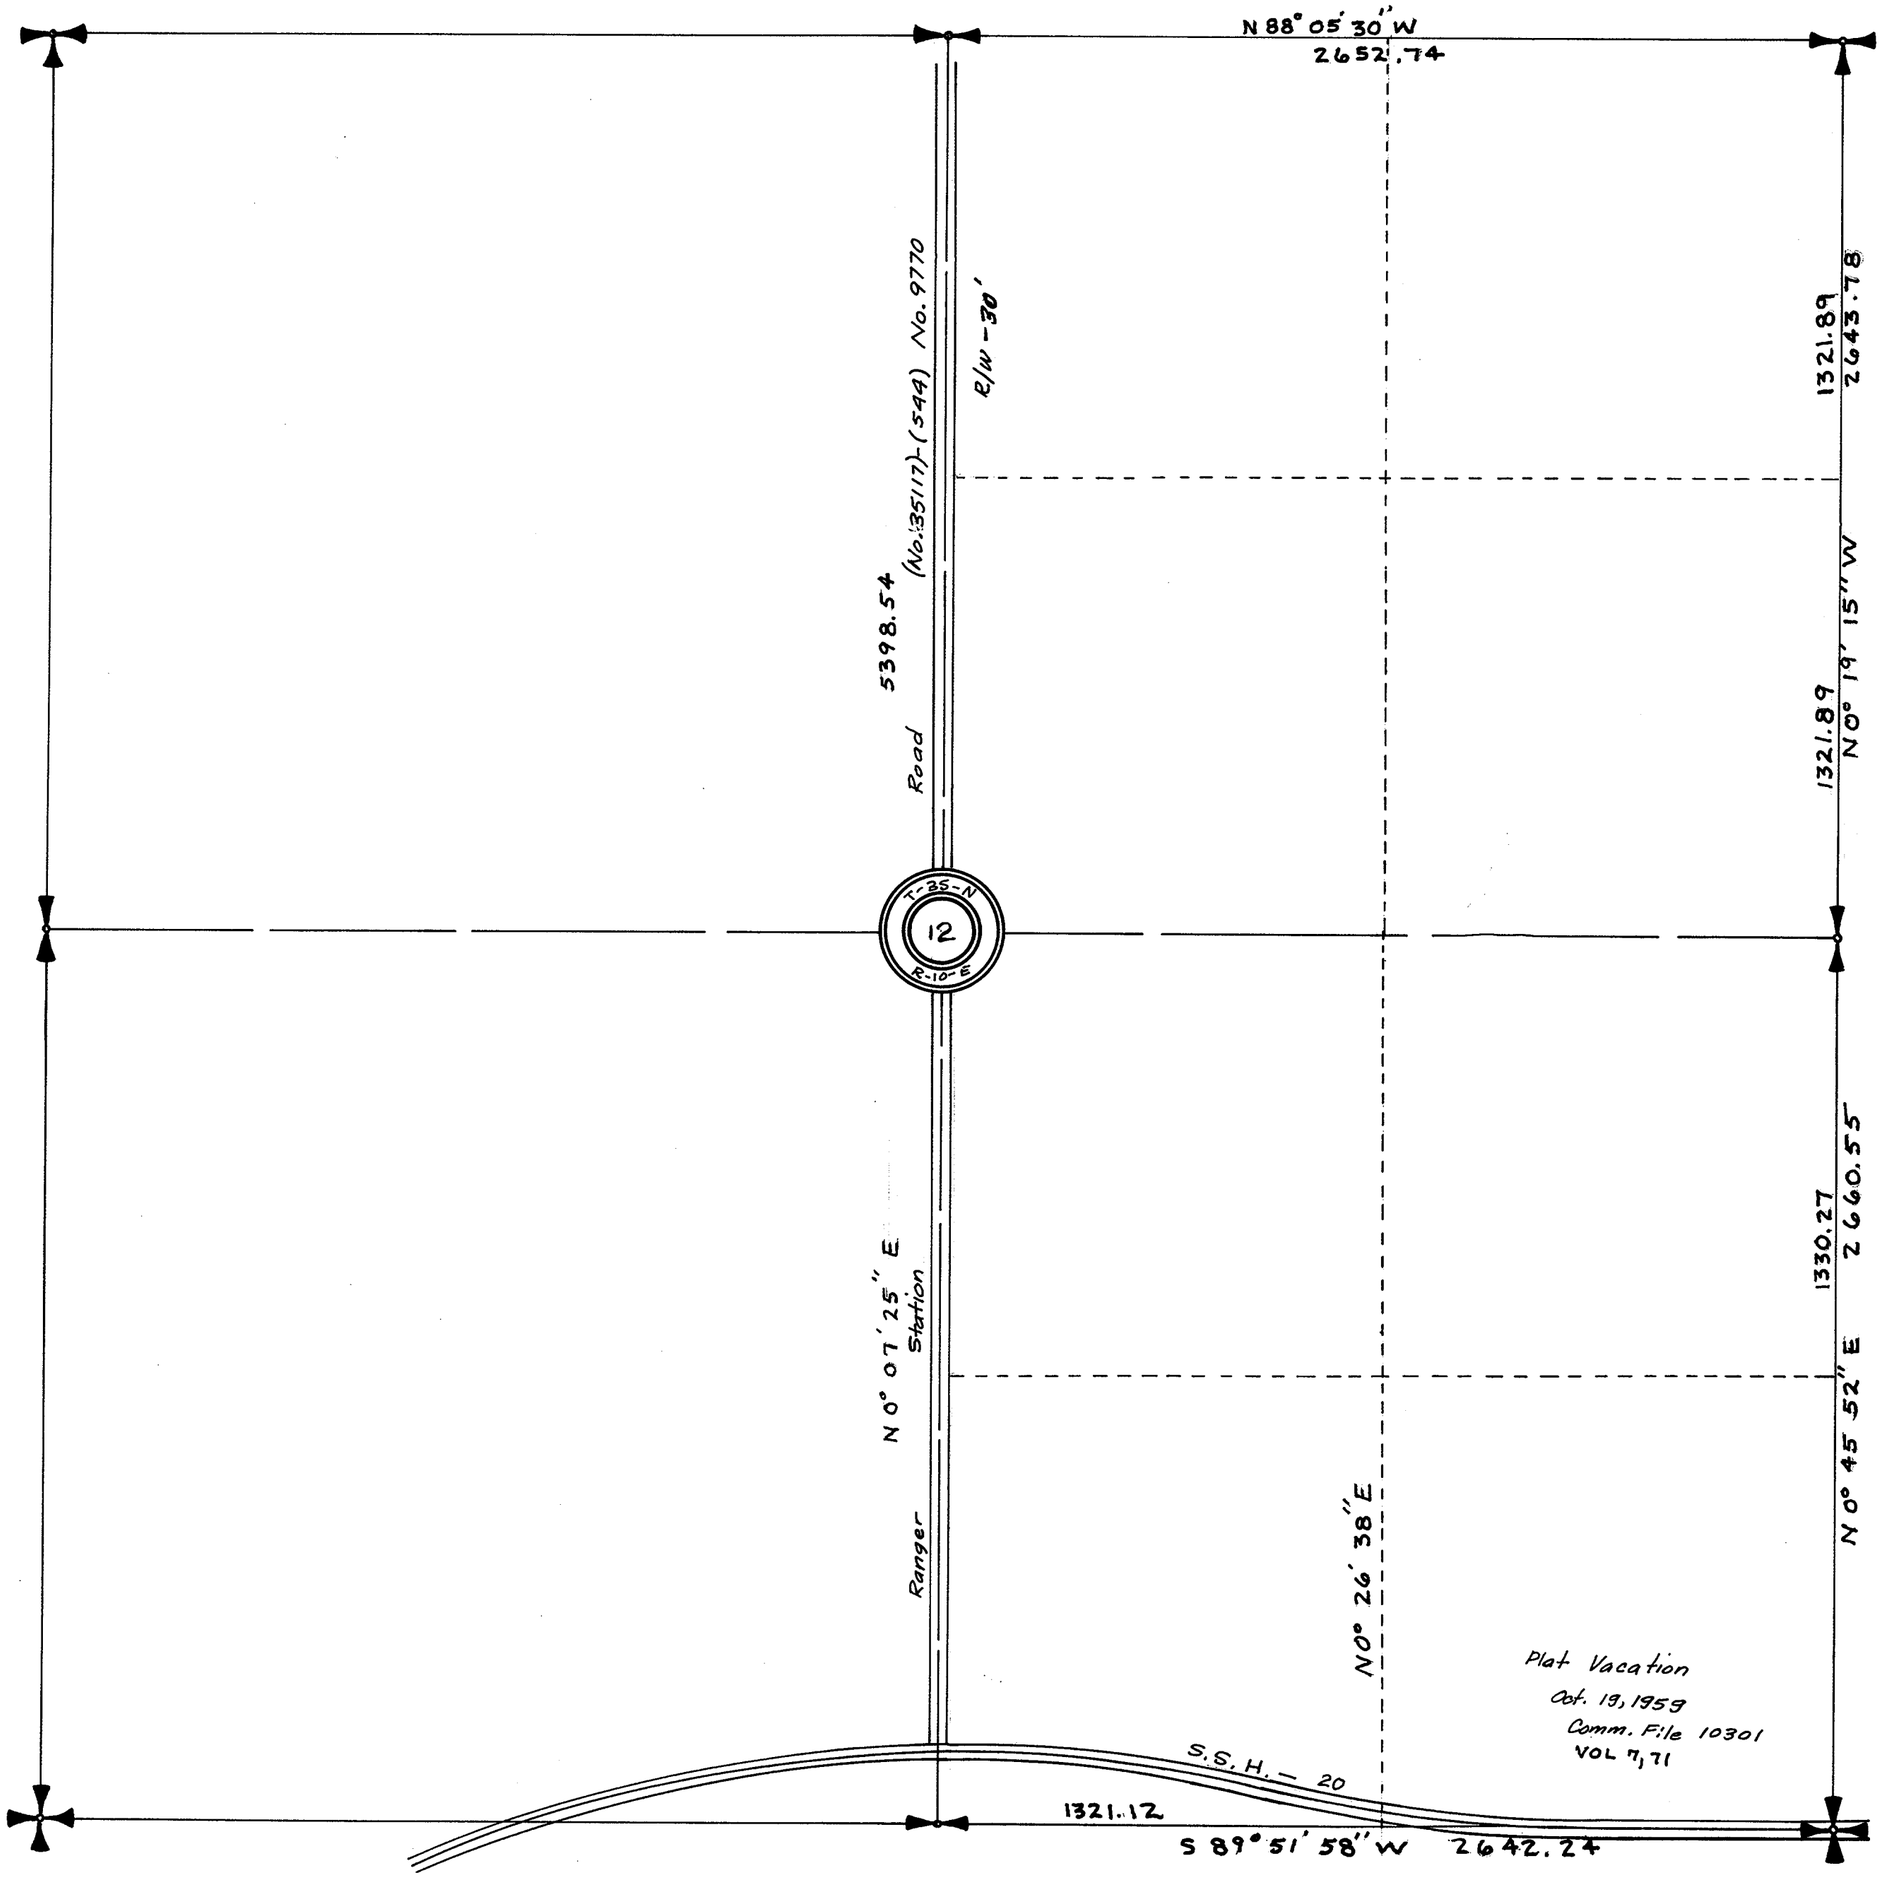

SECTION 13


TOWNSHIP 35 NORTH, RANGE 10 EAST, W. M.

SKAGIT COUNTY, WASH.

SCALE, 1 INCH--400 FEET

DATE Aug. 29, 1966

Lloyd Johnson COUNTY ENGINEER

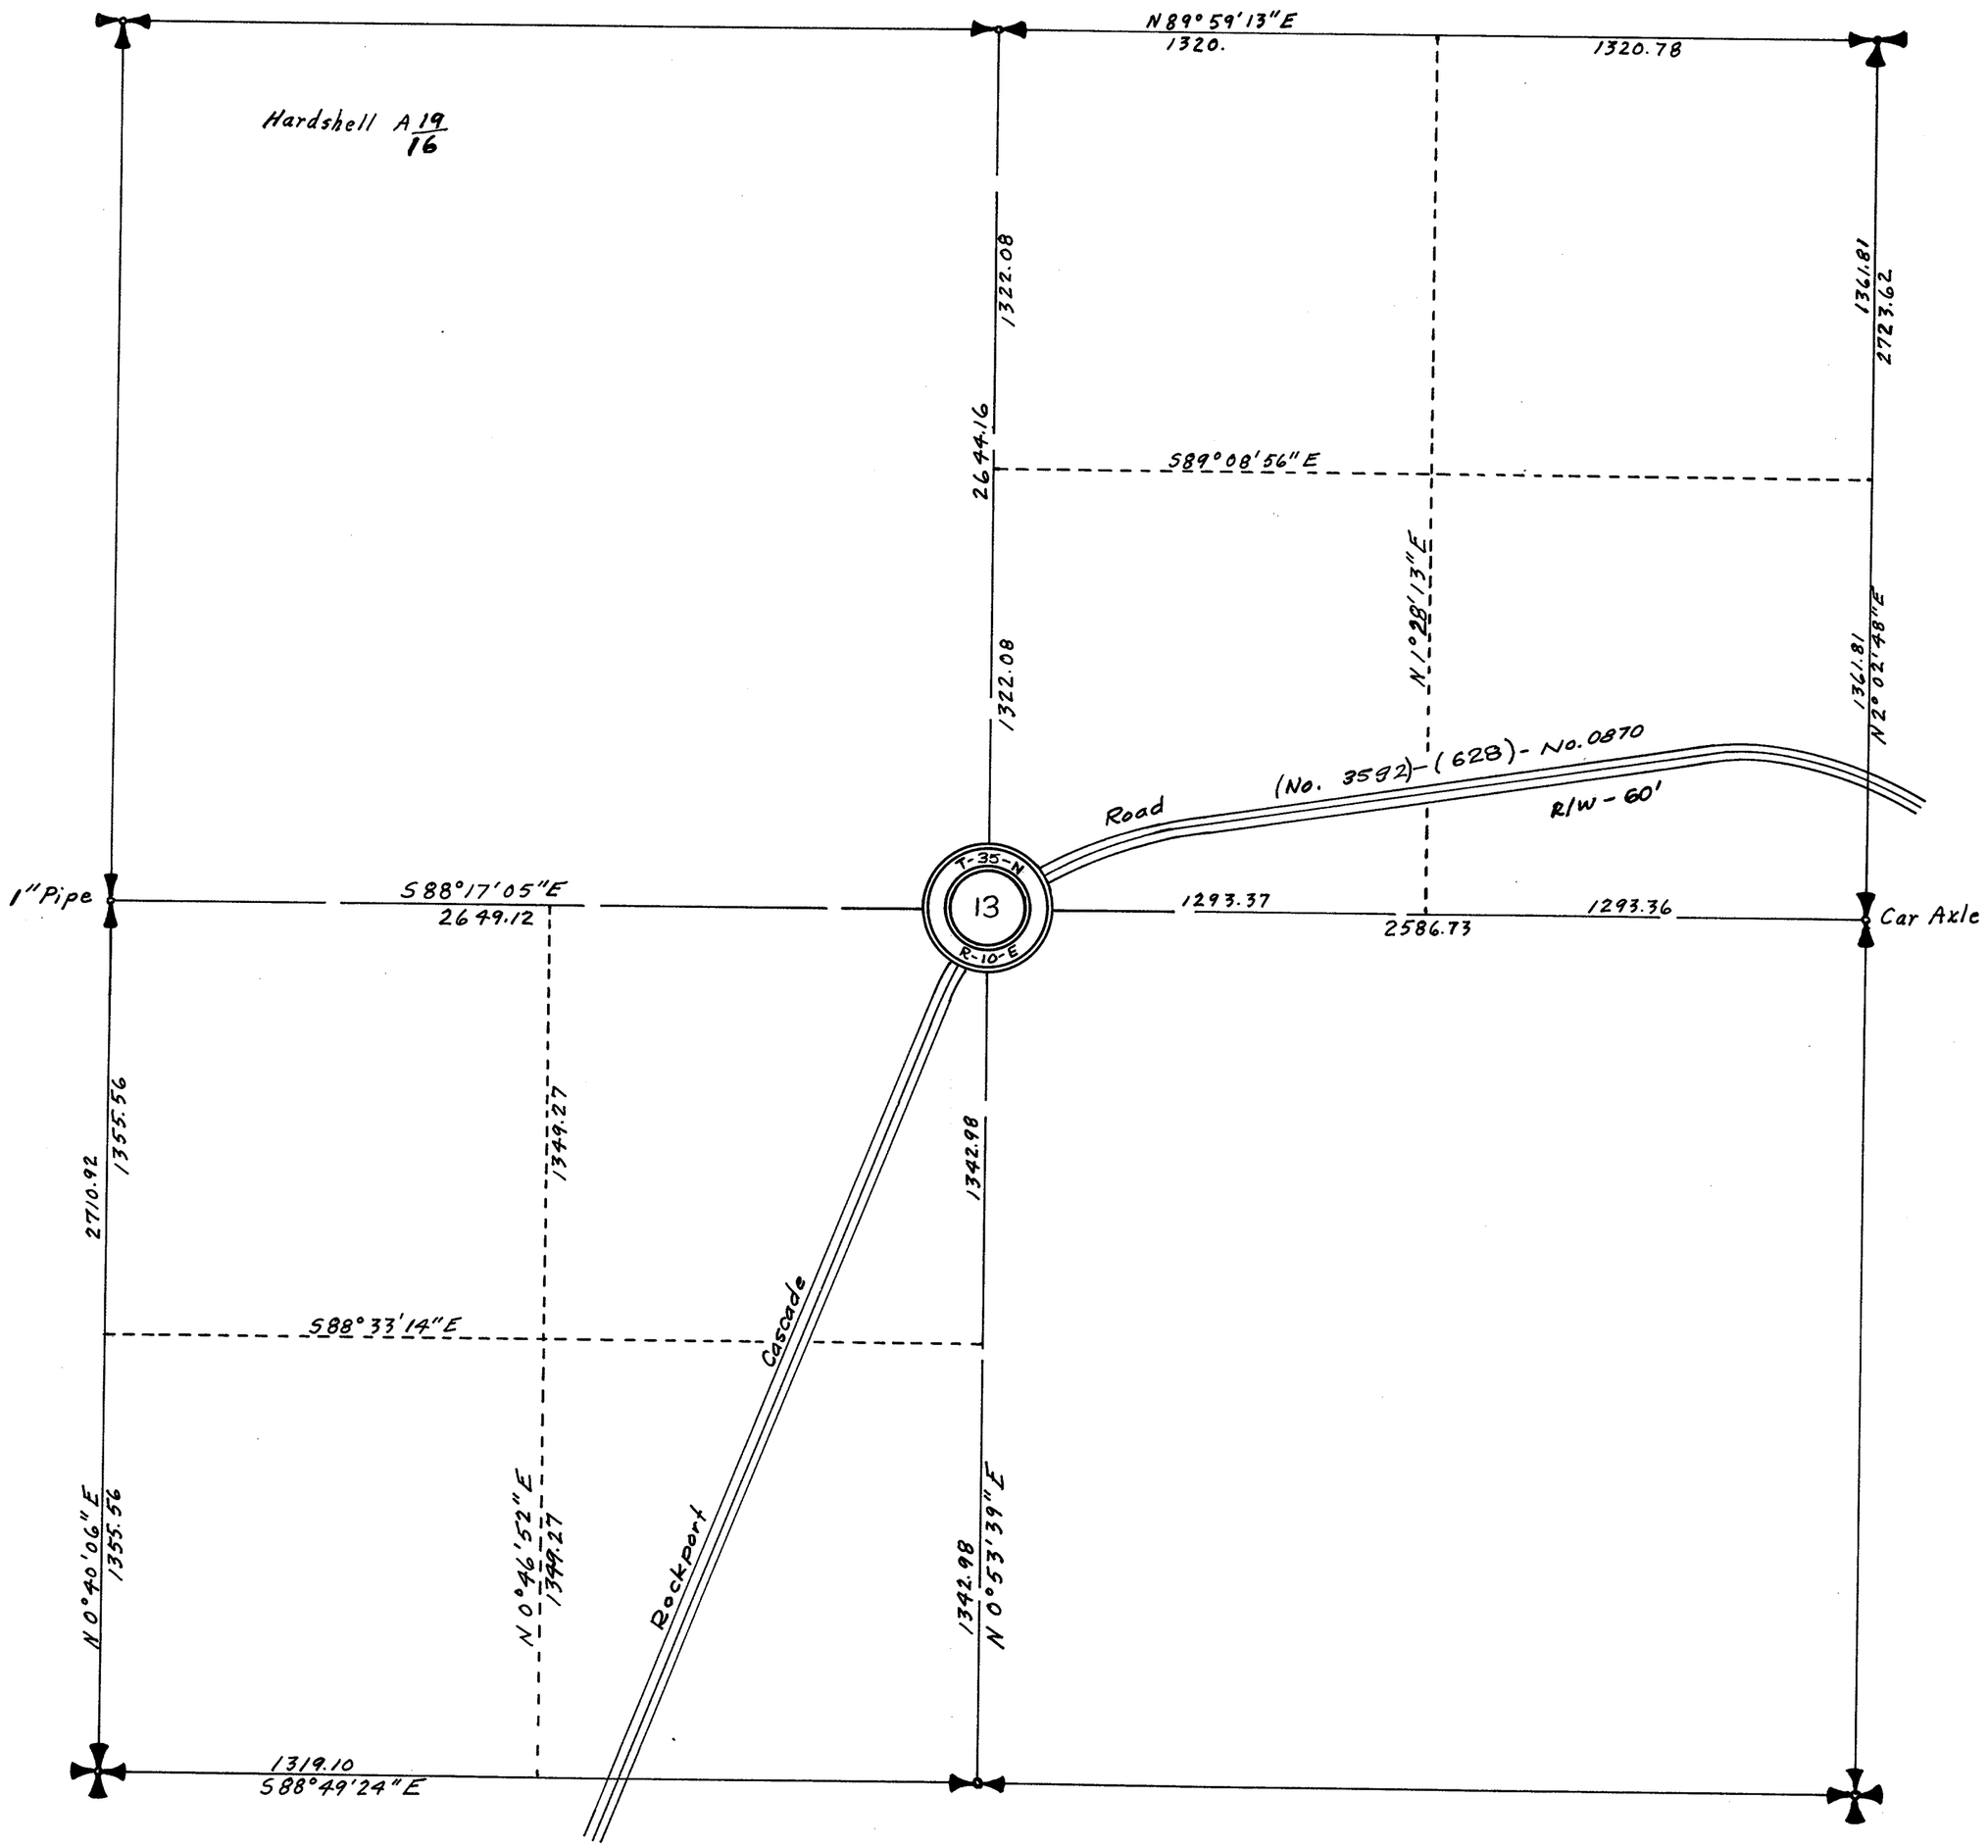

SECTION 23


TOWNSHIP 35 NORTH. RANGE 10 EAST. W. M.

SKAGIT COUNTY. WASH.

SCALE, 1 INCH—400 FEET

LLOYD H. JOHNSON COUNTY ENGINEER

DATE JUNE 28, 1972

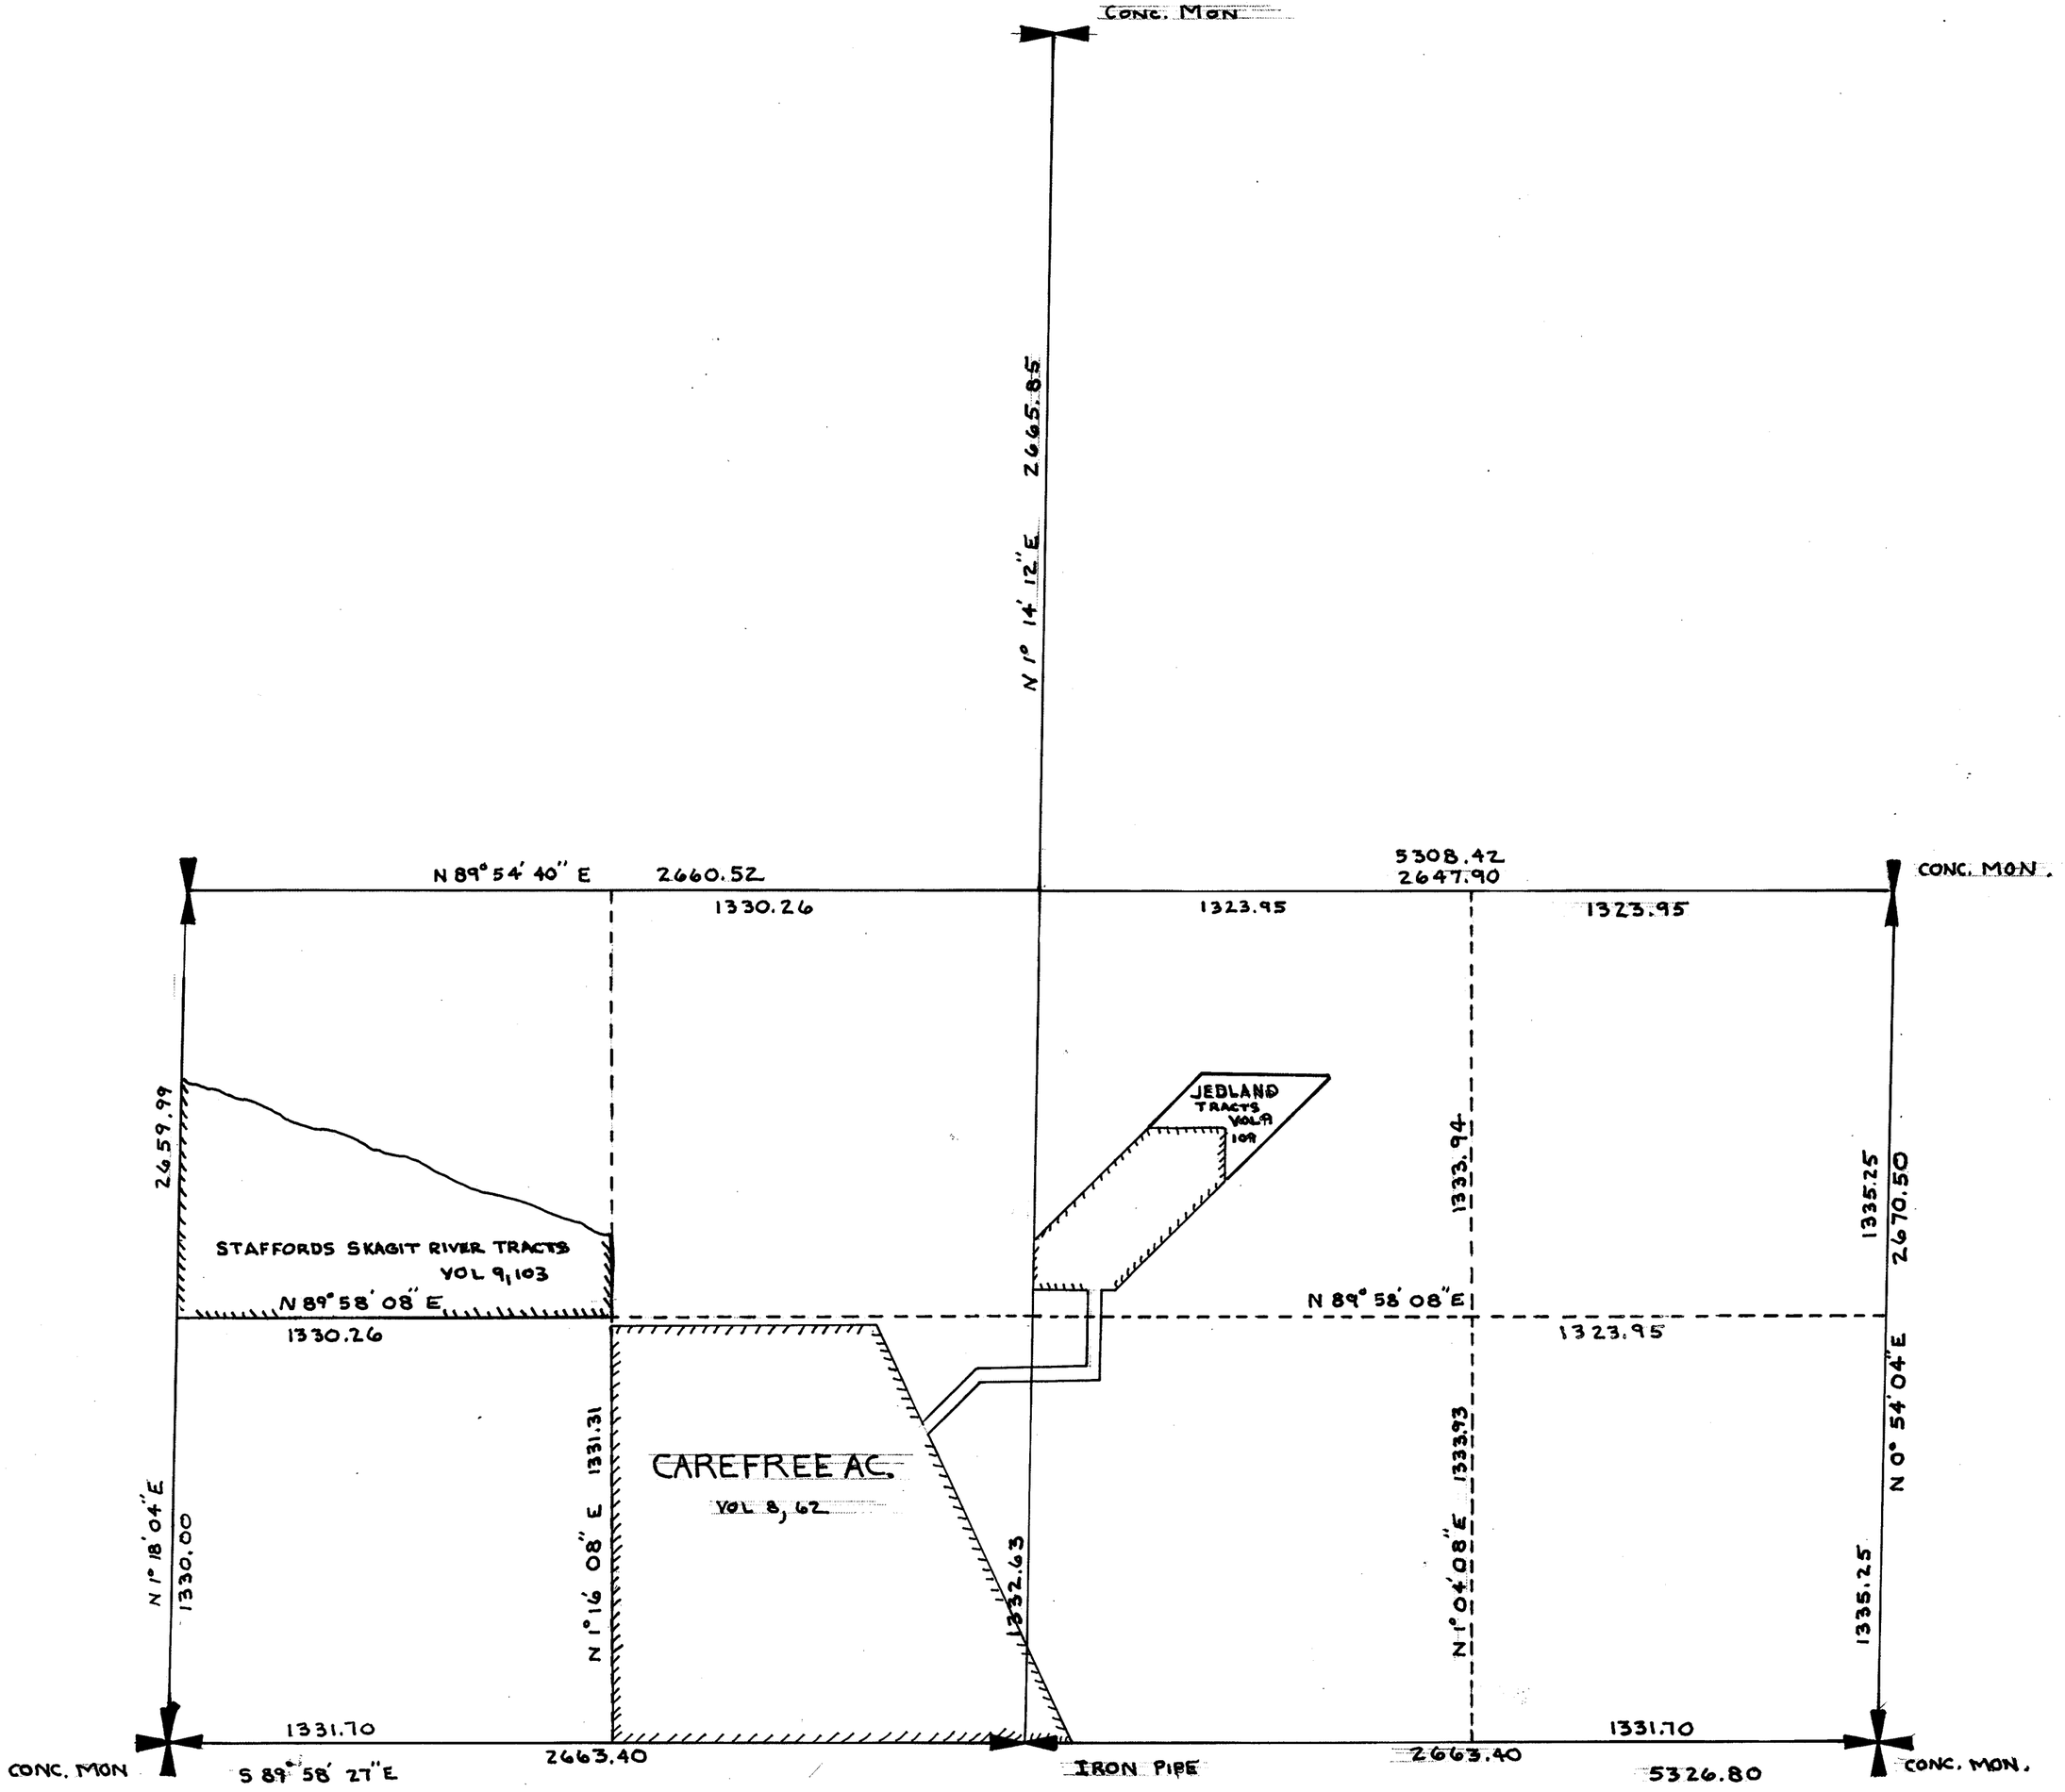

SECTION 24


TOWNSHIP 35 NORTH, RANGE 10 EAST, W. M.

SKAGIT COUNTY, WASH.

SCALE, 1 INCH -- 400 FEET

DATE Aug. 29, 1966

Lloyd Johnson COUNTY ENGINEER

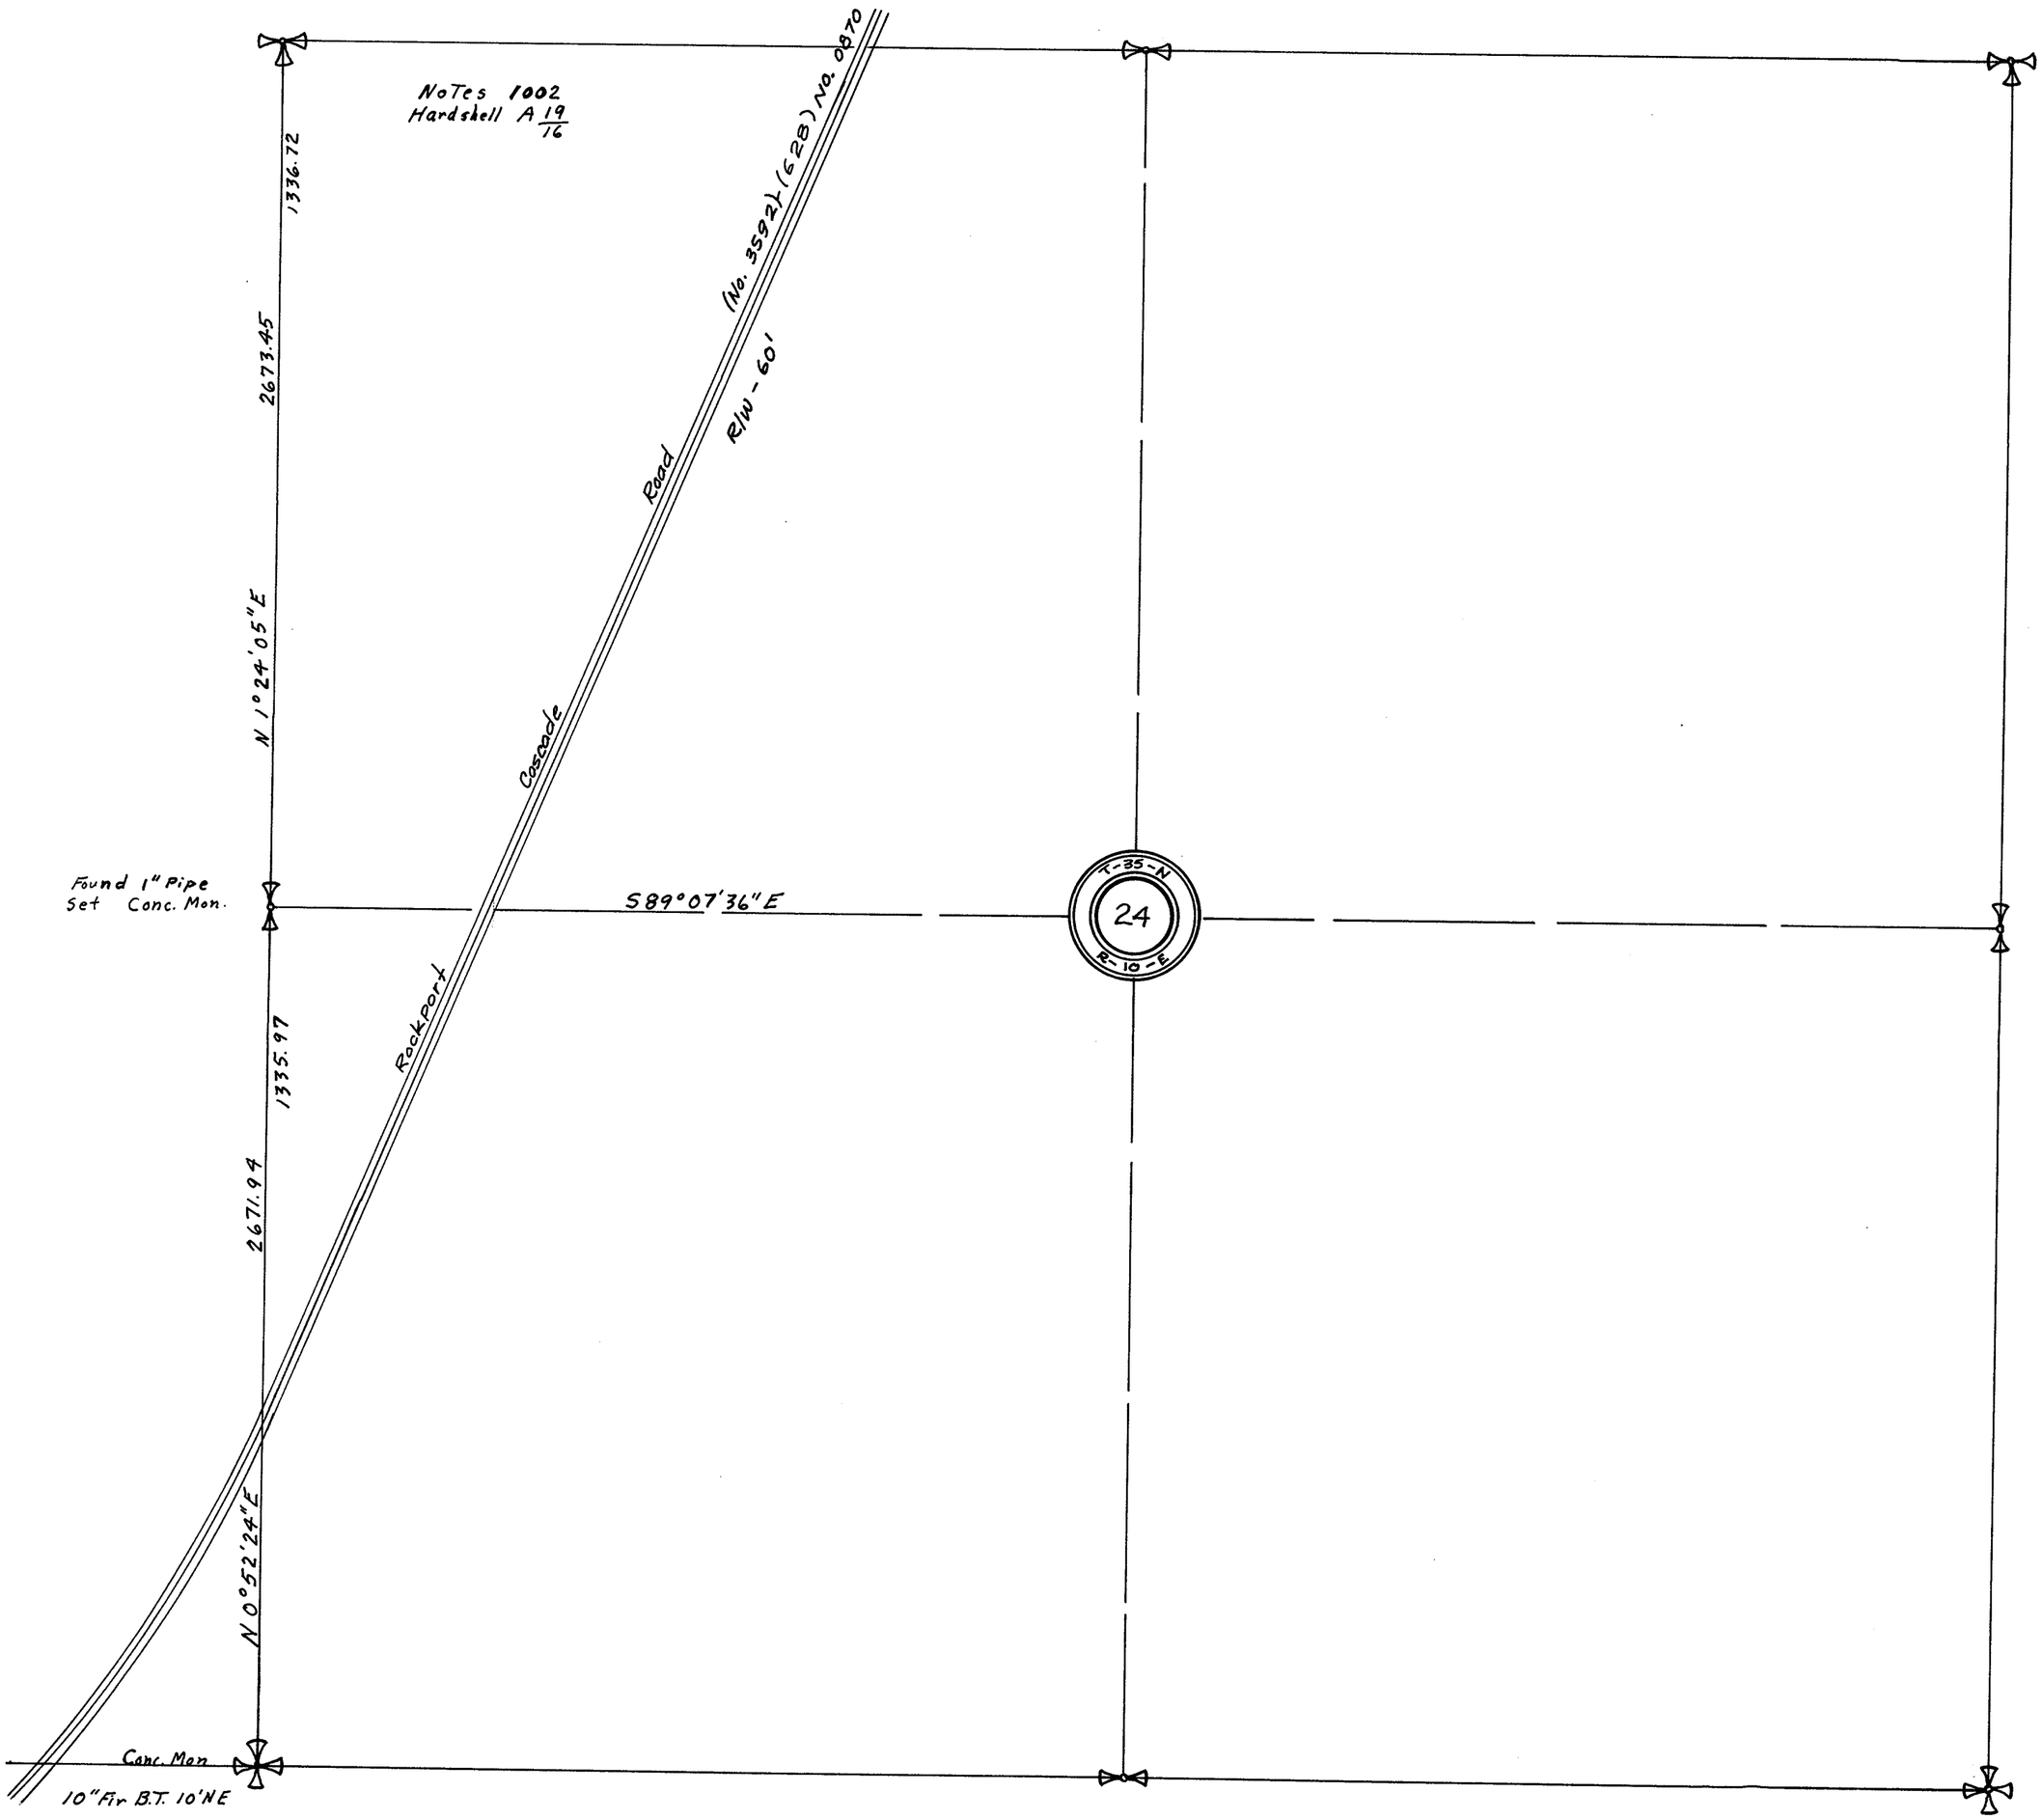

SECTION 26


TOWNSHIP 35 NORTH, RANGE 10 EAST, W. M.

SKAGIT COUNTY, WASH.

SCALE, 1 INCH -- 400 FEET

DATE Aug. 29, 1966

Lloyd Johnson COUNTY ENGINEER

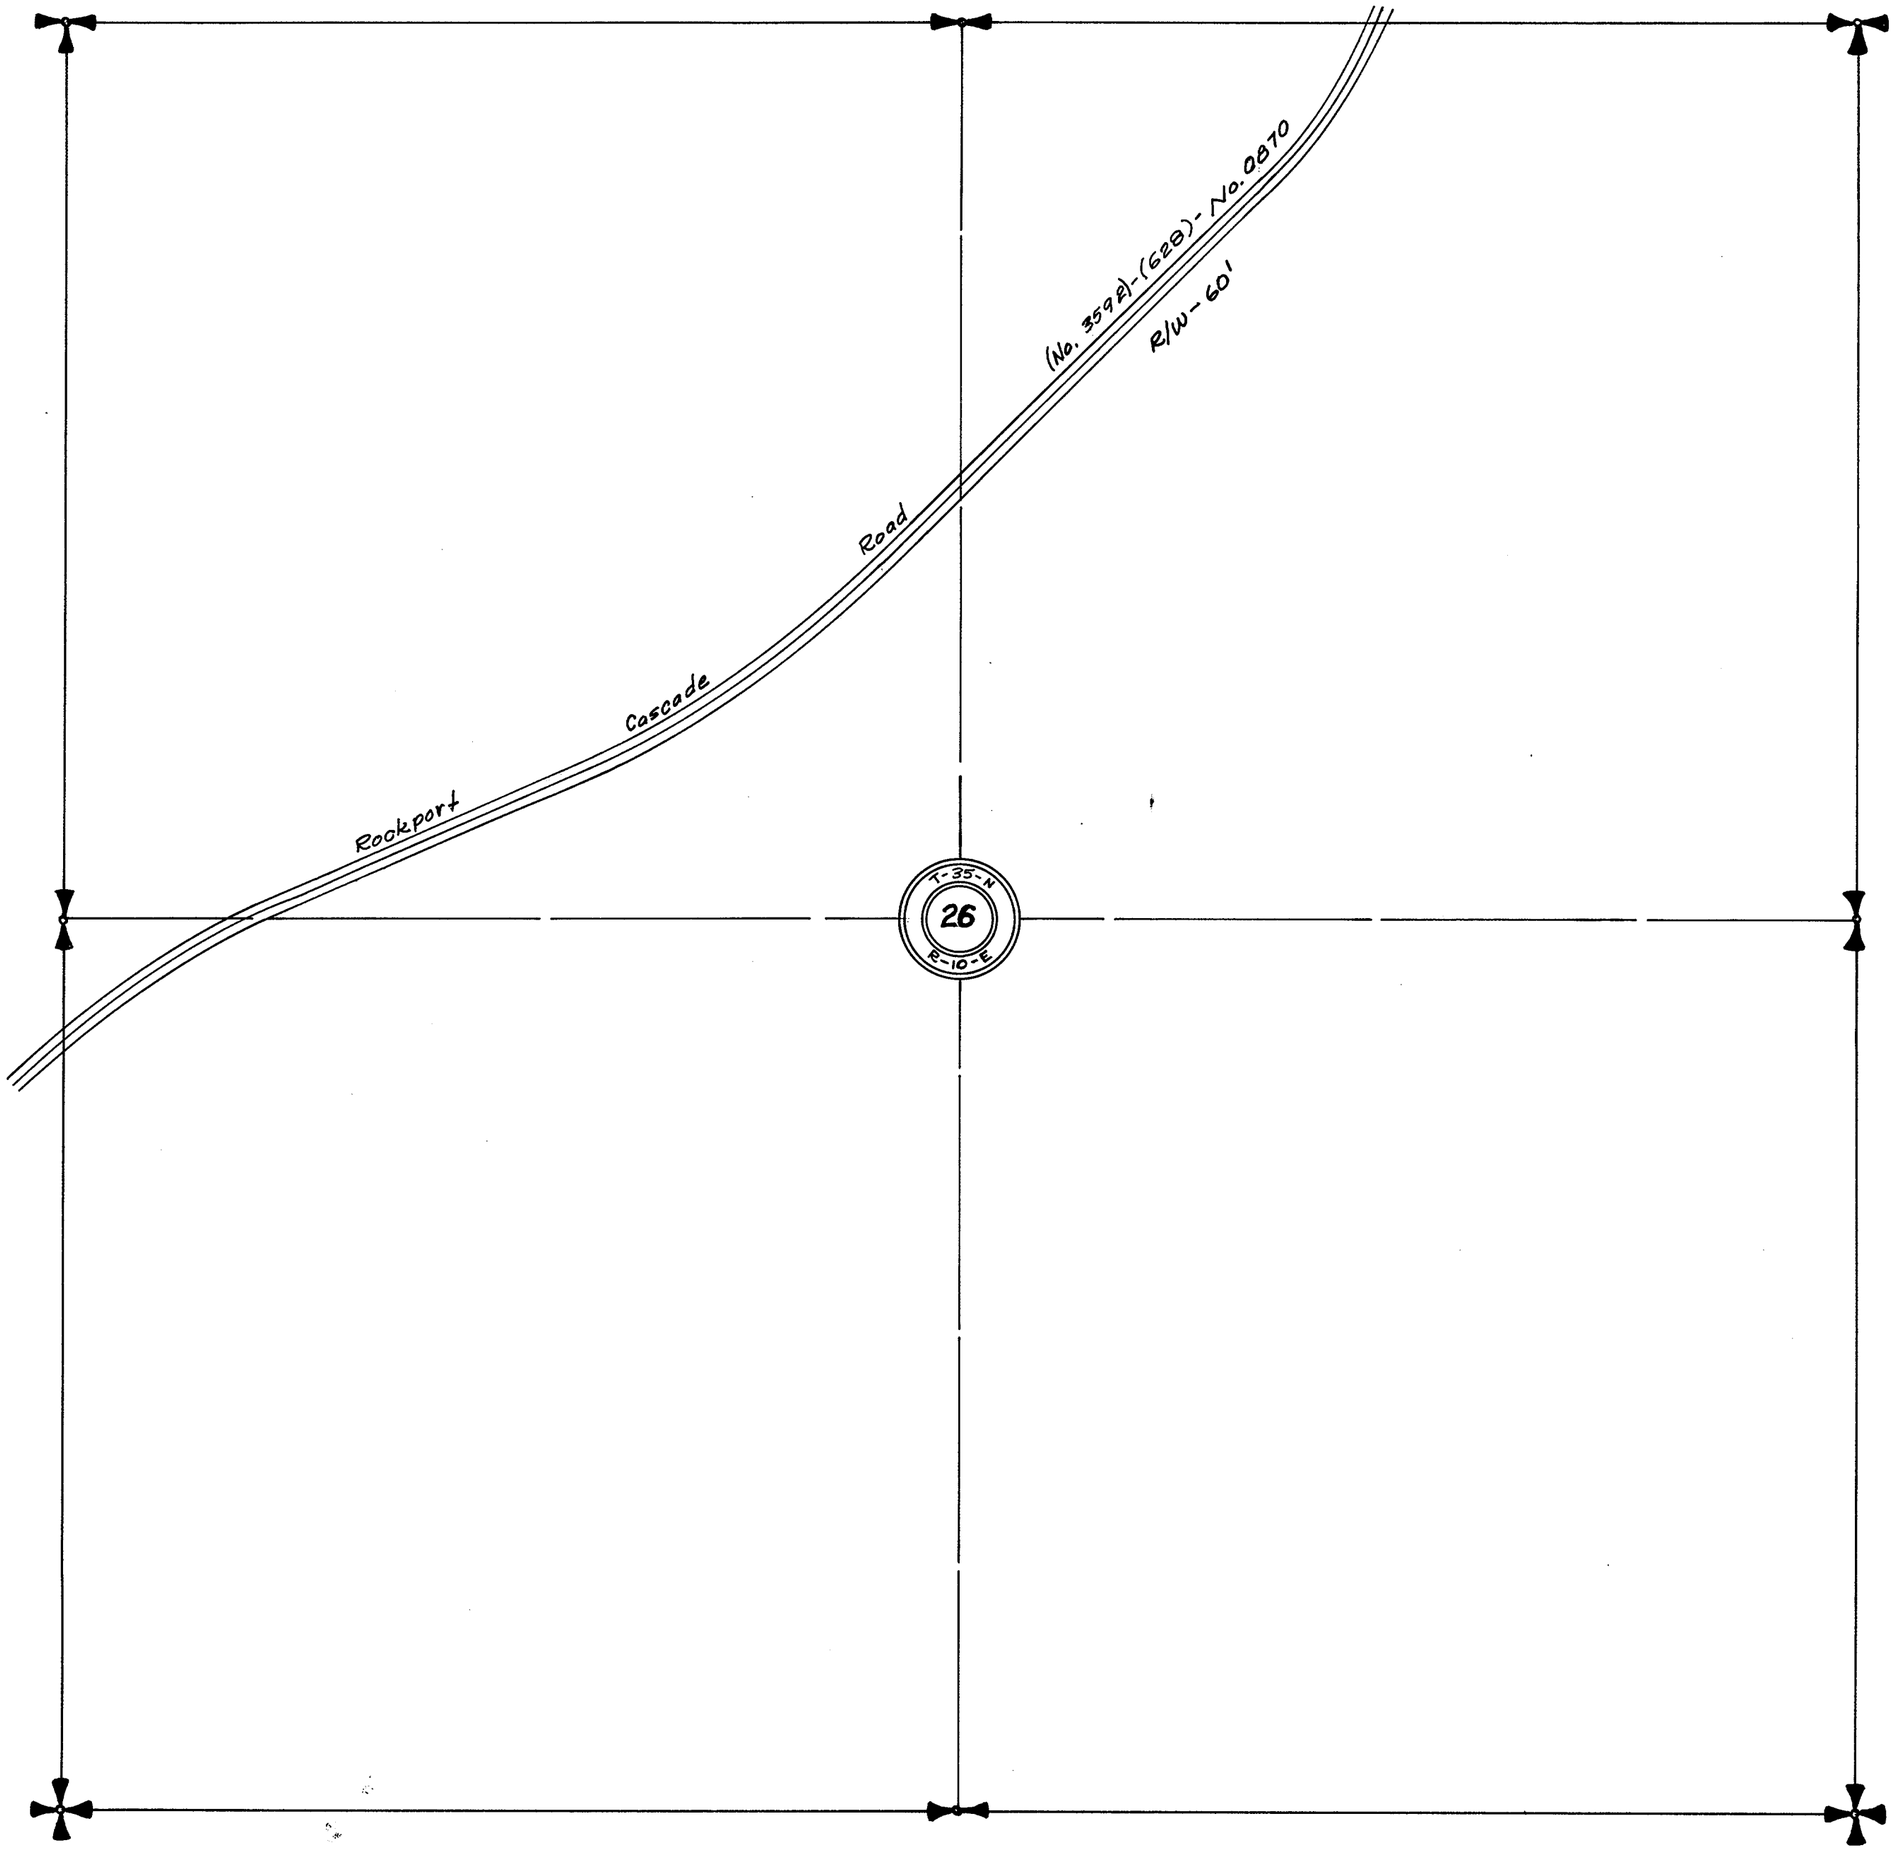

SECTION 27


TOWNSHIP 35 NORTH, RANGE 10 EAST, W. M.

SKAGIT COUNTY, WASH.

SCALE, 1 INCH--400 FEET

DATE Aug. 26, 1966

Lloyd Johnson COUNTY ENGINEER

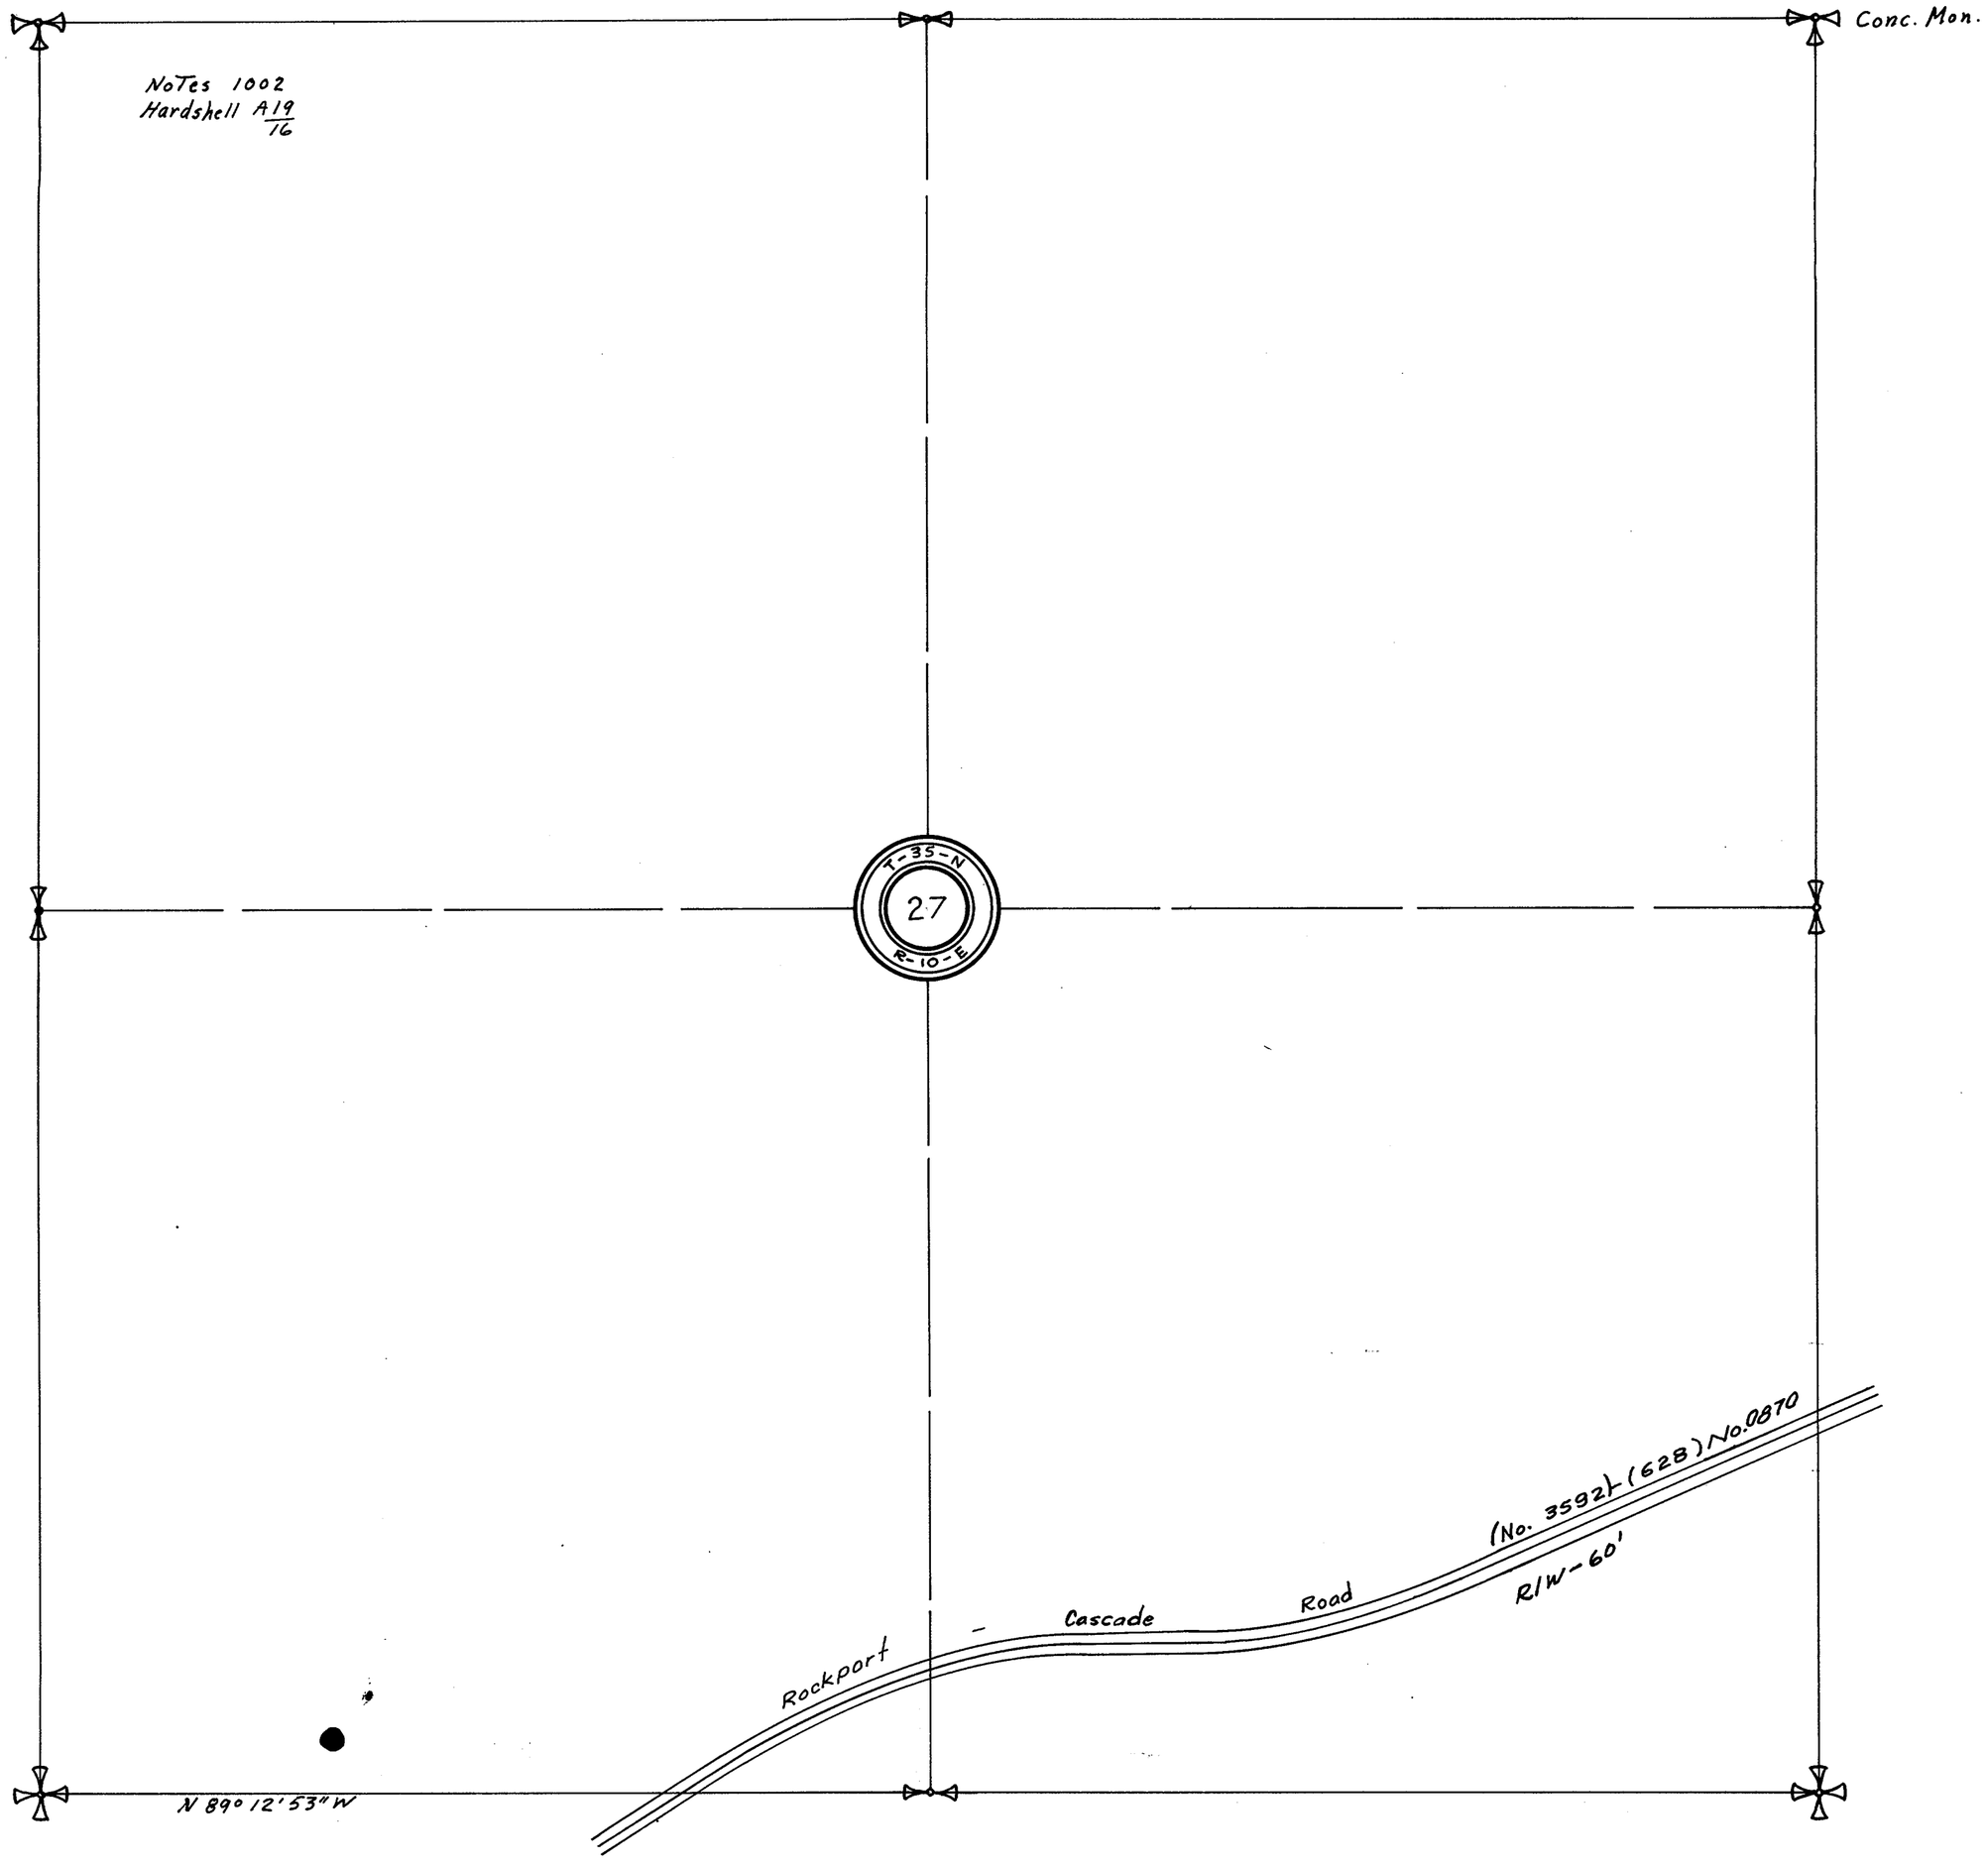

SECTION 32

TOWNSHIP 35 NORTH, RANGE 10 EAST, W. M.

SKAGIT COUNTY, WASH.

SCALE, 1 INCH -- 400 FEET

DATE Aug. 26, 1966

Lloyd Johnson COUNTY ENGINEER

Notes 1002
Hardshell A19
16

T-35-N
32
R-10-E

2633.20

N 0° 31' 05" W

(No. 3590) - (CLVIII)(0847) 0868
R/W - 80'

Concrete

St

Valley

Skagit

(No. 3592) - (628) - No. 0870
R/W - 60'

Cascade

Rockport

2630.52

N 3° 54' 45" E

31 32
6 5

S 89° 29' 03" E 2644.10 1½" Pipe S 89° 29' 03" E 2644.11

SECTION 33


TOWNSHIP 35 NORTH, RANGE 10 EAST, W. M.

SKAGIT COUNTY, WASH.

SCALE, 1 INCH -- 400 FEET

DATE Aug. 26, 1966

Lloyd Johnson COUNTY ENGINEER

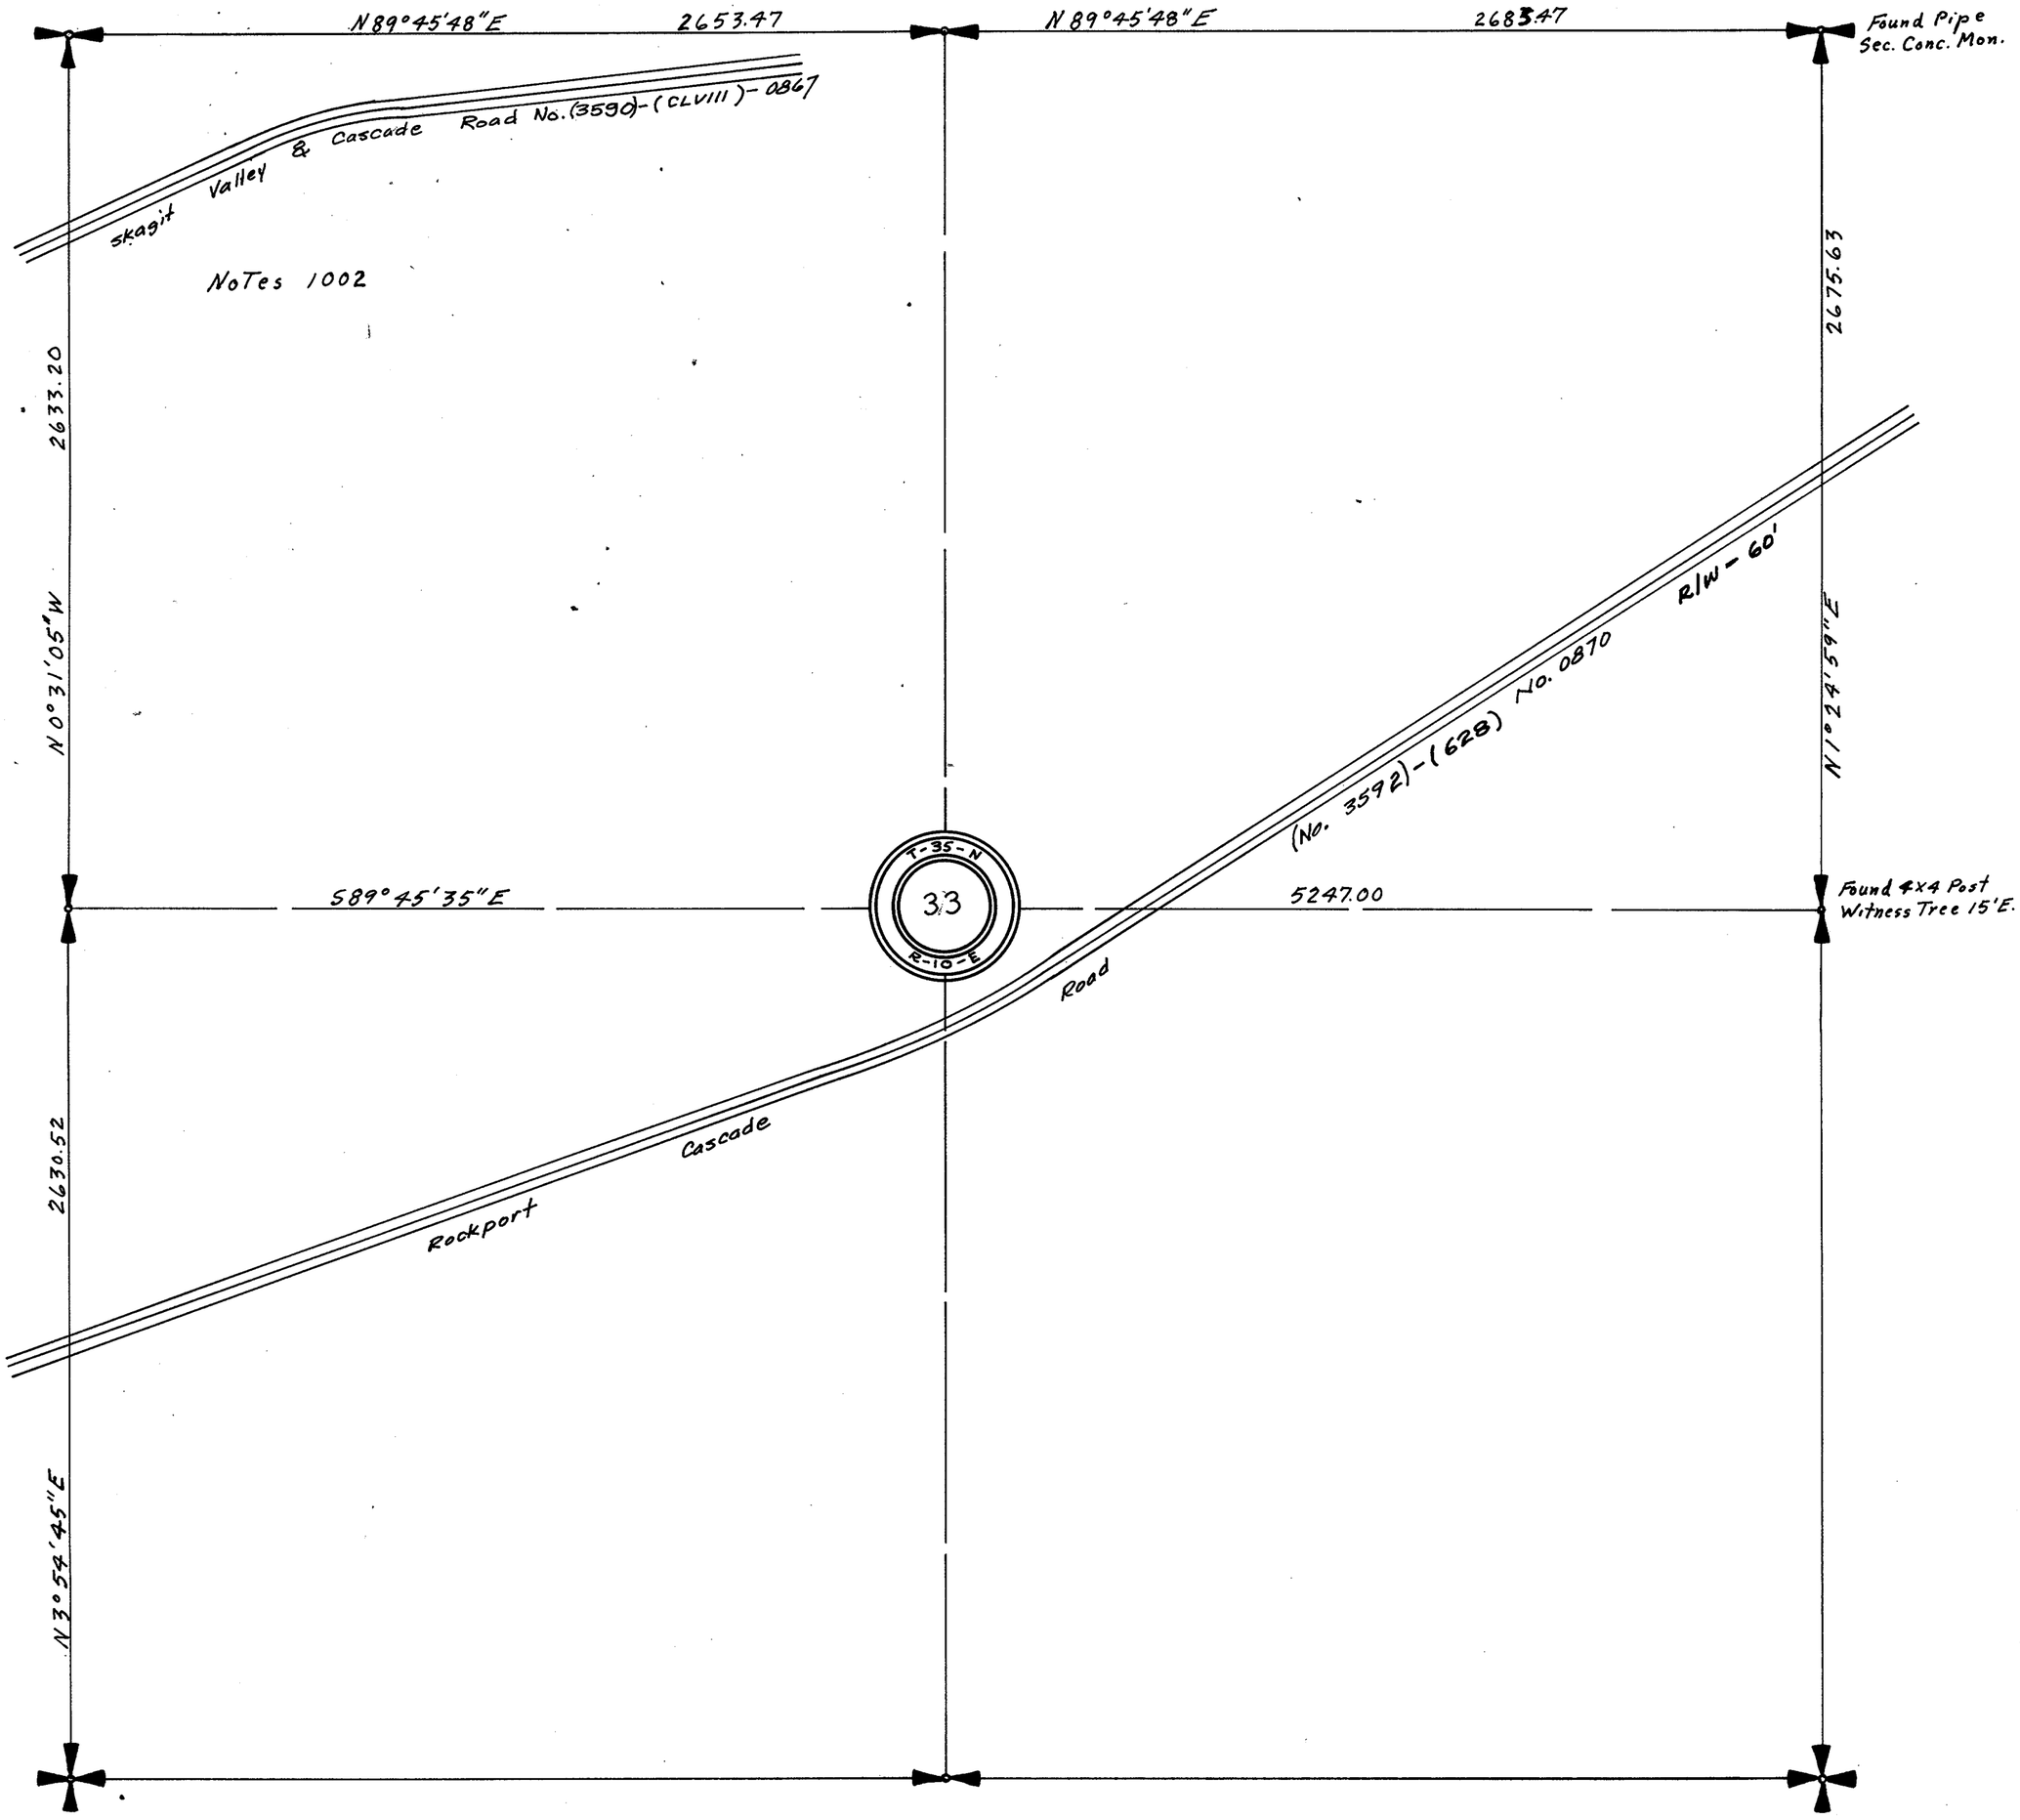


SECTION 33

TOWNSHIP 35 NORTH, RANGE 10 EAST, W. M.

SKAGIT COUNTY, WASH.

SCALE, 1 INCH--400 FEET

COUNTY ENGINEER

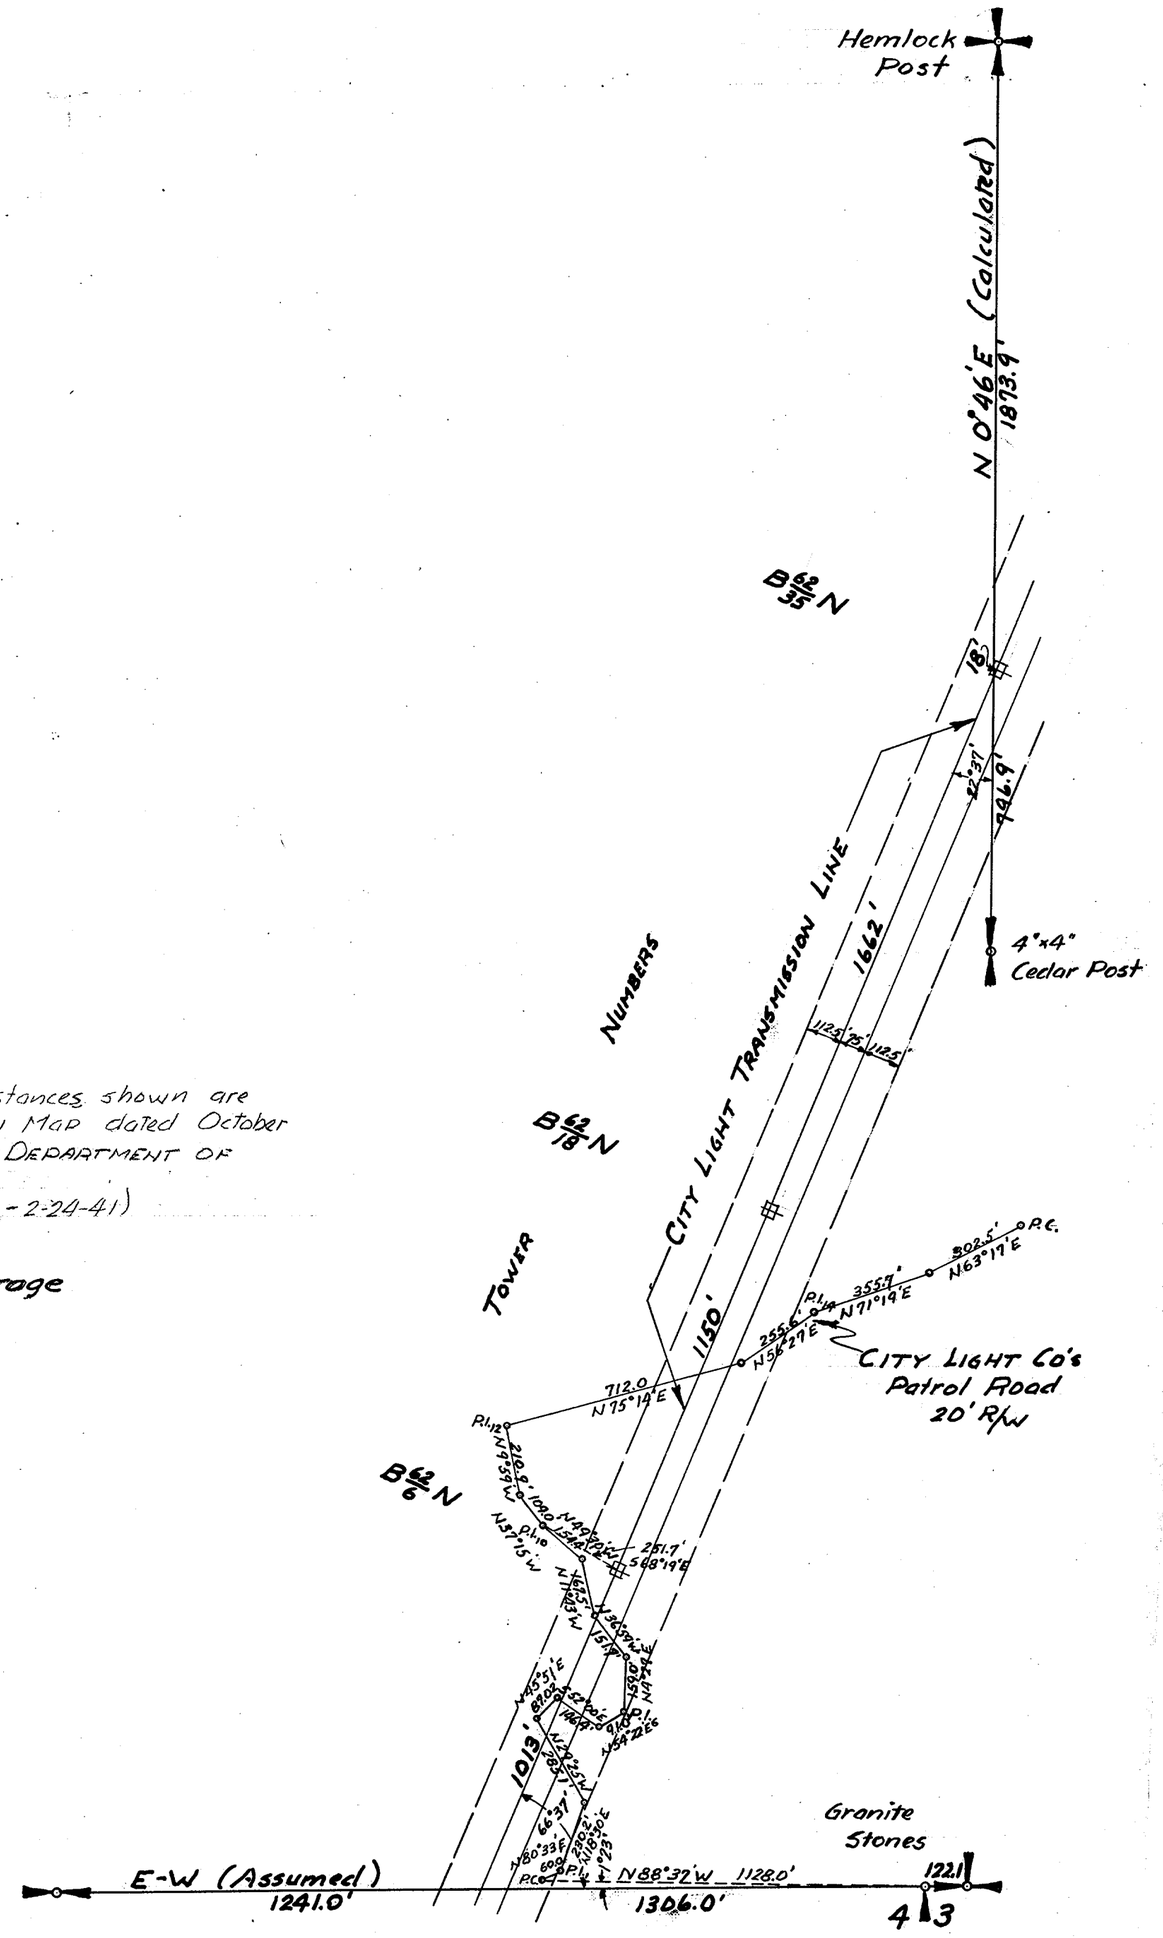

NOTE: The bearings and distances shown are calculated or taken from SECTION MAP dated October 1940 by the CITY OF SEATTLE — DEPARTMENT OF LIGHTING.

(T.A.S - 2-24-41)

Original Filed A-3/10 Garage

Co-ords 41/474.

SECTION 34

TOWNSHIP 35 NORTH, RANGE 10 EAST, W. M.

SKAGIT COUNTY, WASH.


SCALE, 1 INCH--400 FEET

DATE 1960

Frank Gilkey COUNTY ENGINEER

Hardshell A19/16

Notes 1002

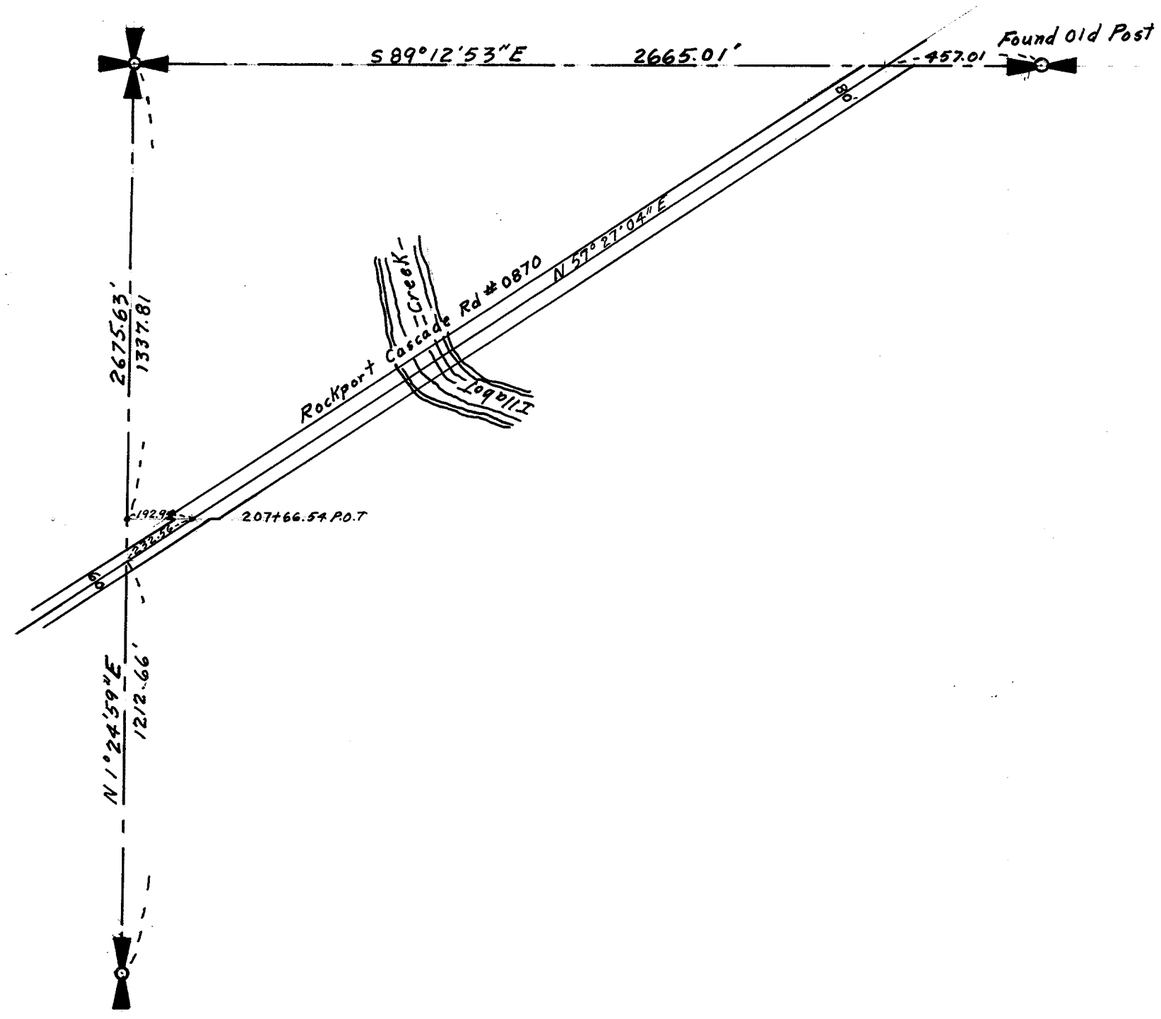

SECTION 34


TOWNSHIP 35 NORTH, RANGE 10 EAST, W. M.

SKAGIT COUNTY, WASH.

SCALE, 1 INCH -- 400 FEET

DATE Aug. 26, 1966

Lloyd Johnson COUNTY ENGINEER

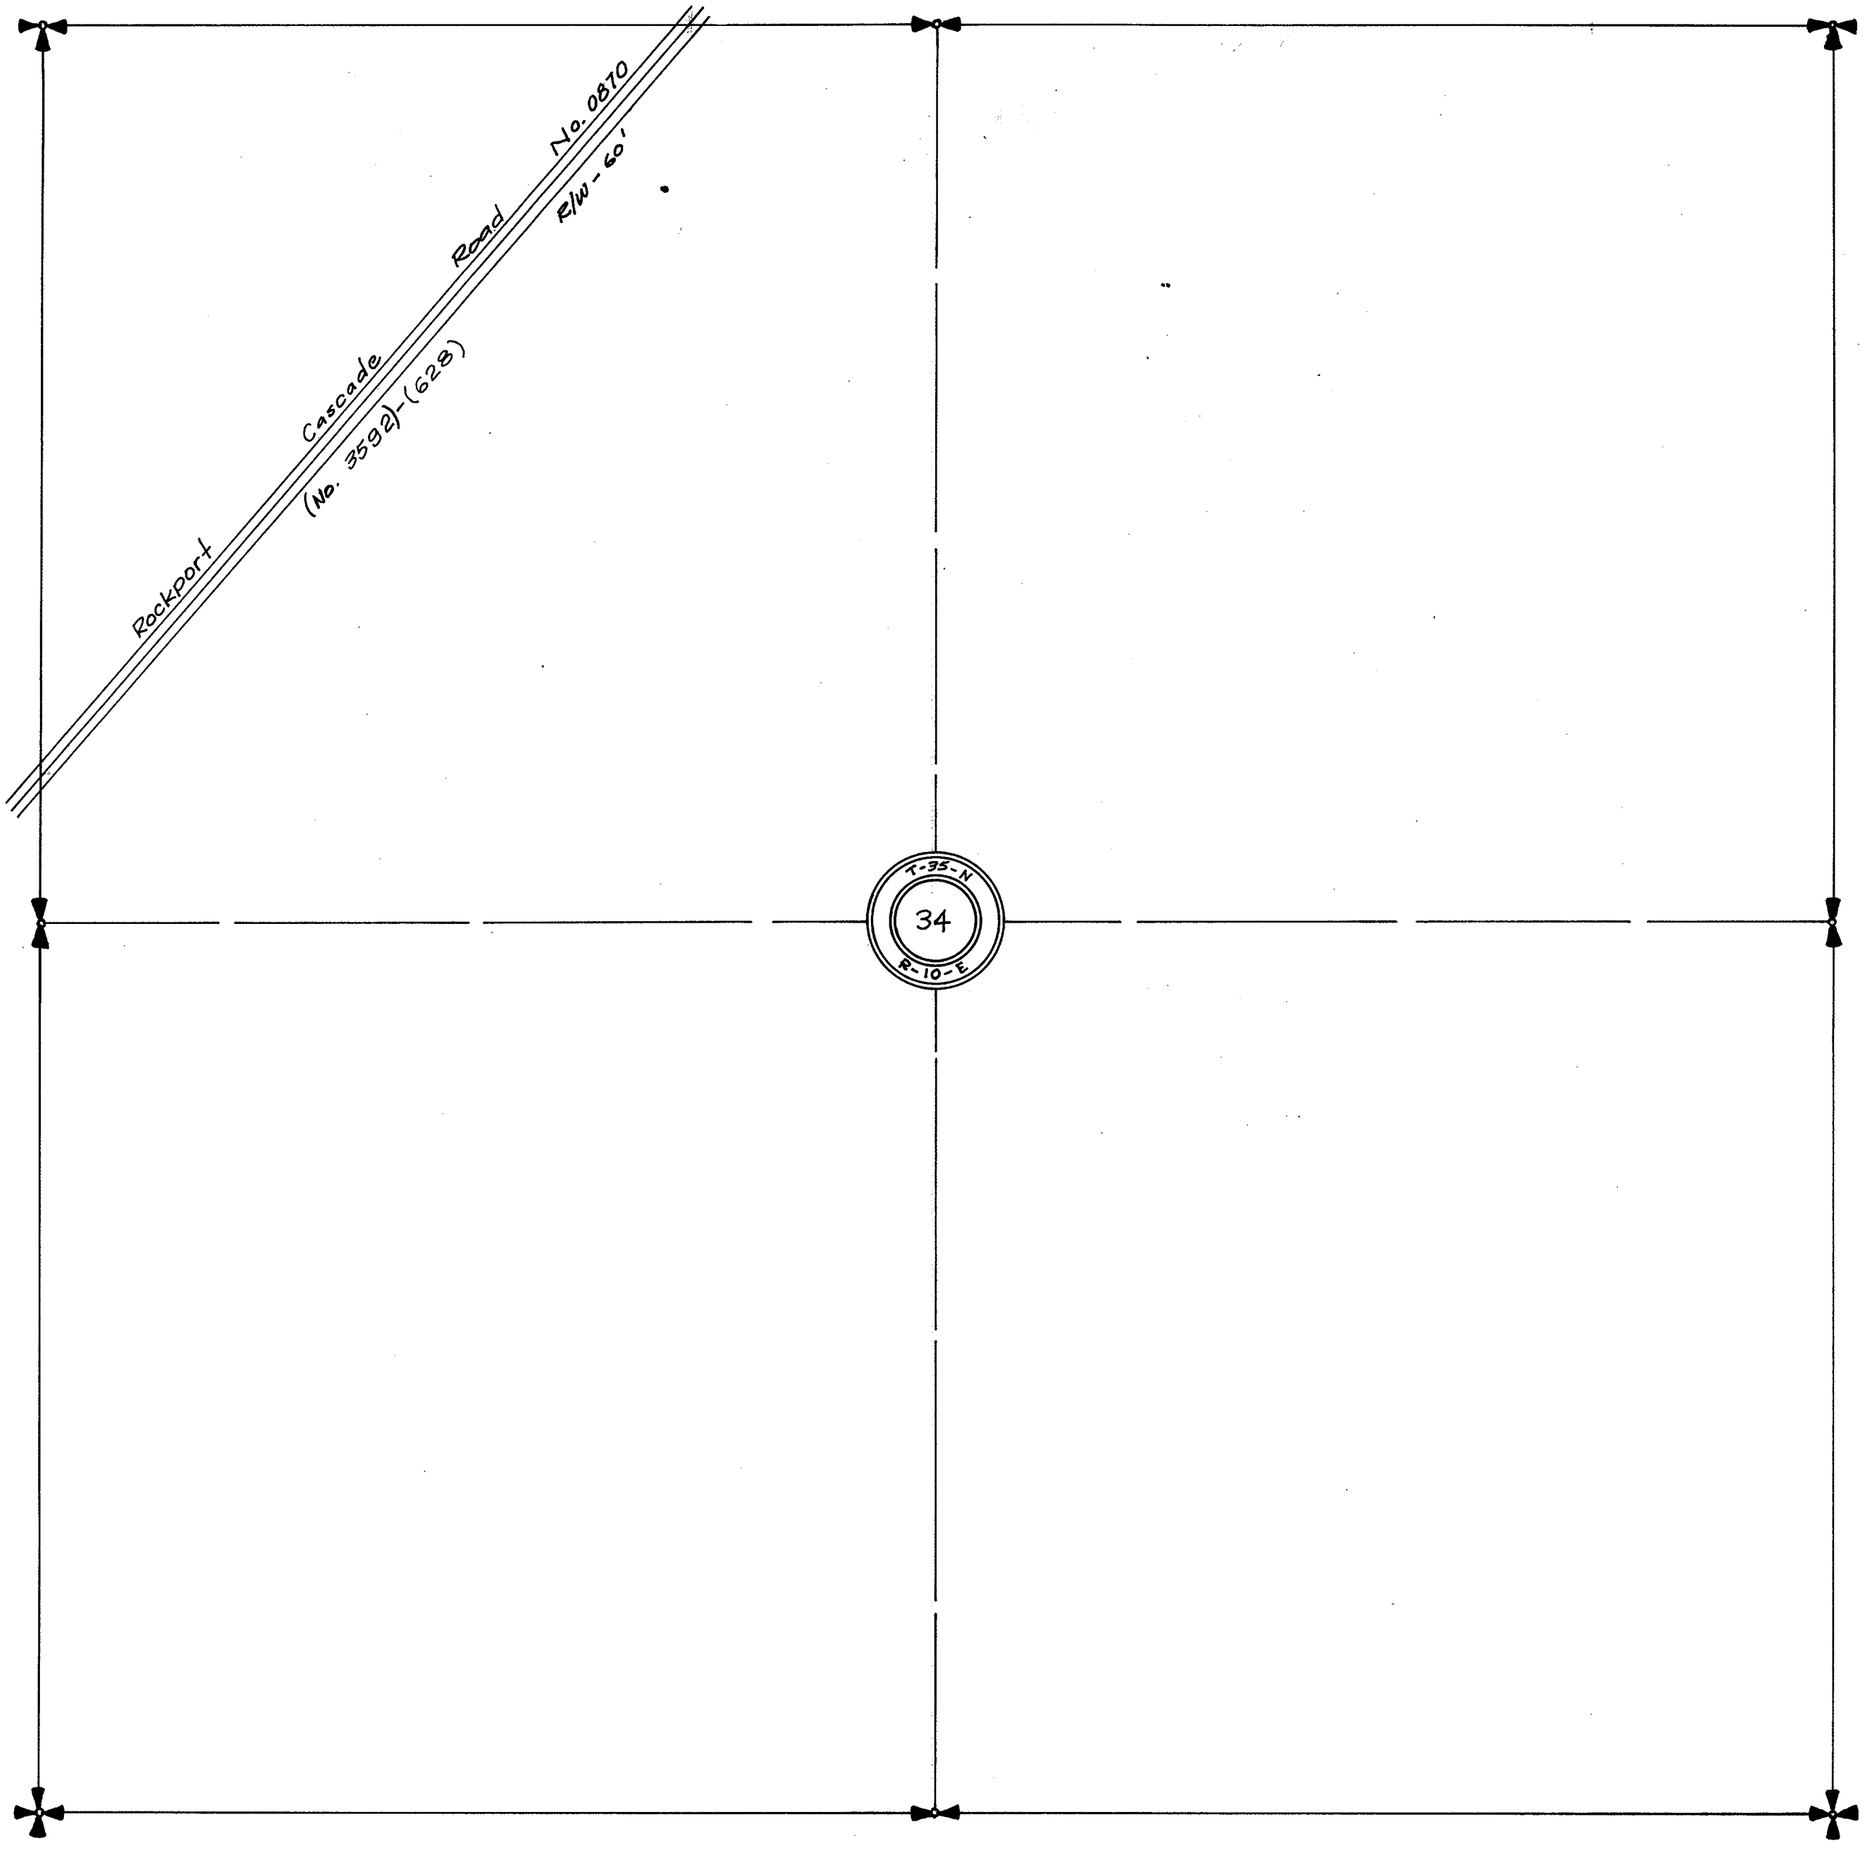


SECTION 14

TOWNSHIP 35 NORTH. RANGE 11 EAST. W. M.
SKAGIT COUNTY. WASH.

SCALE. 1 INCH—400 FEET

LLOYD H. JOHNSON COUNTY ENGINEER

DATE July 6, 1972

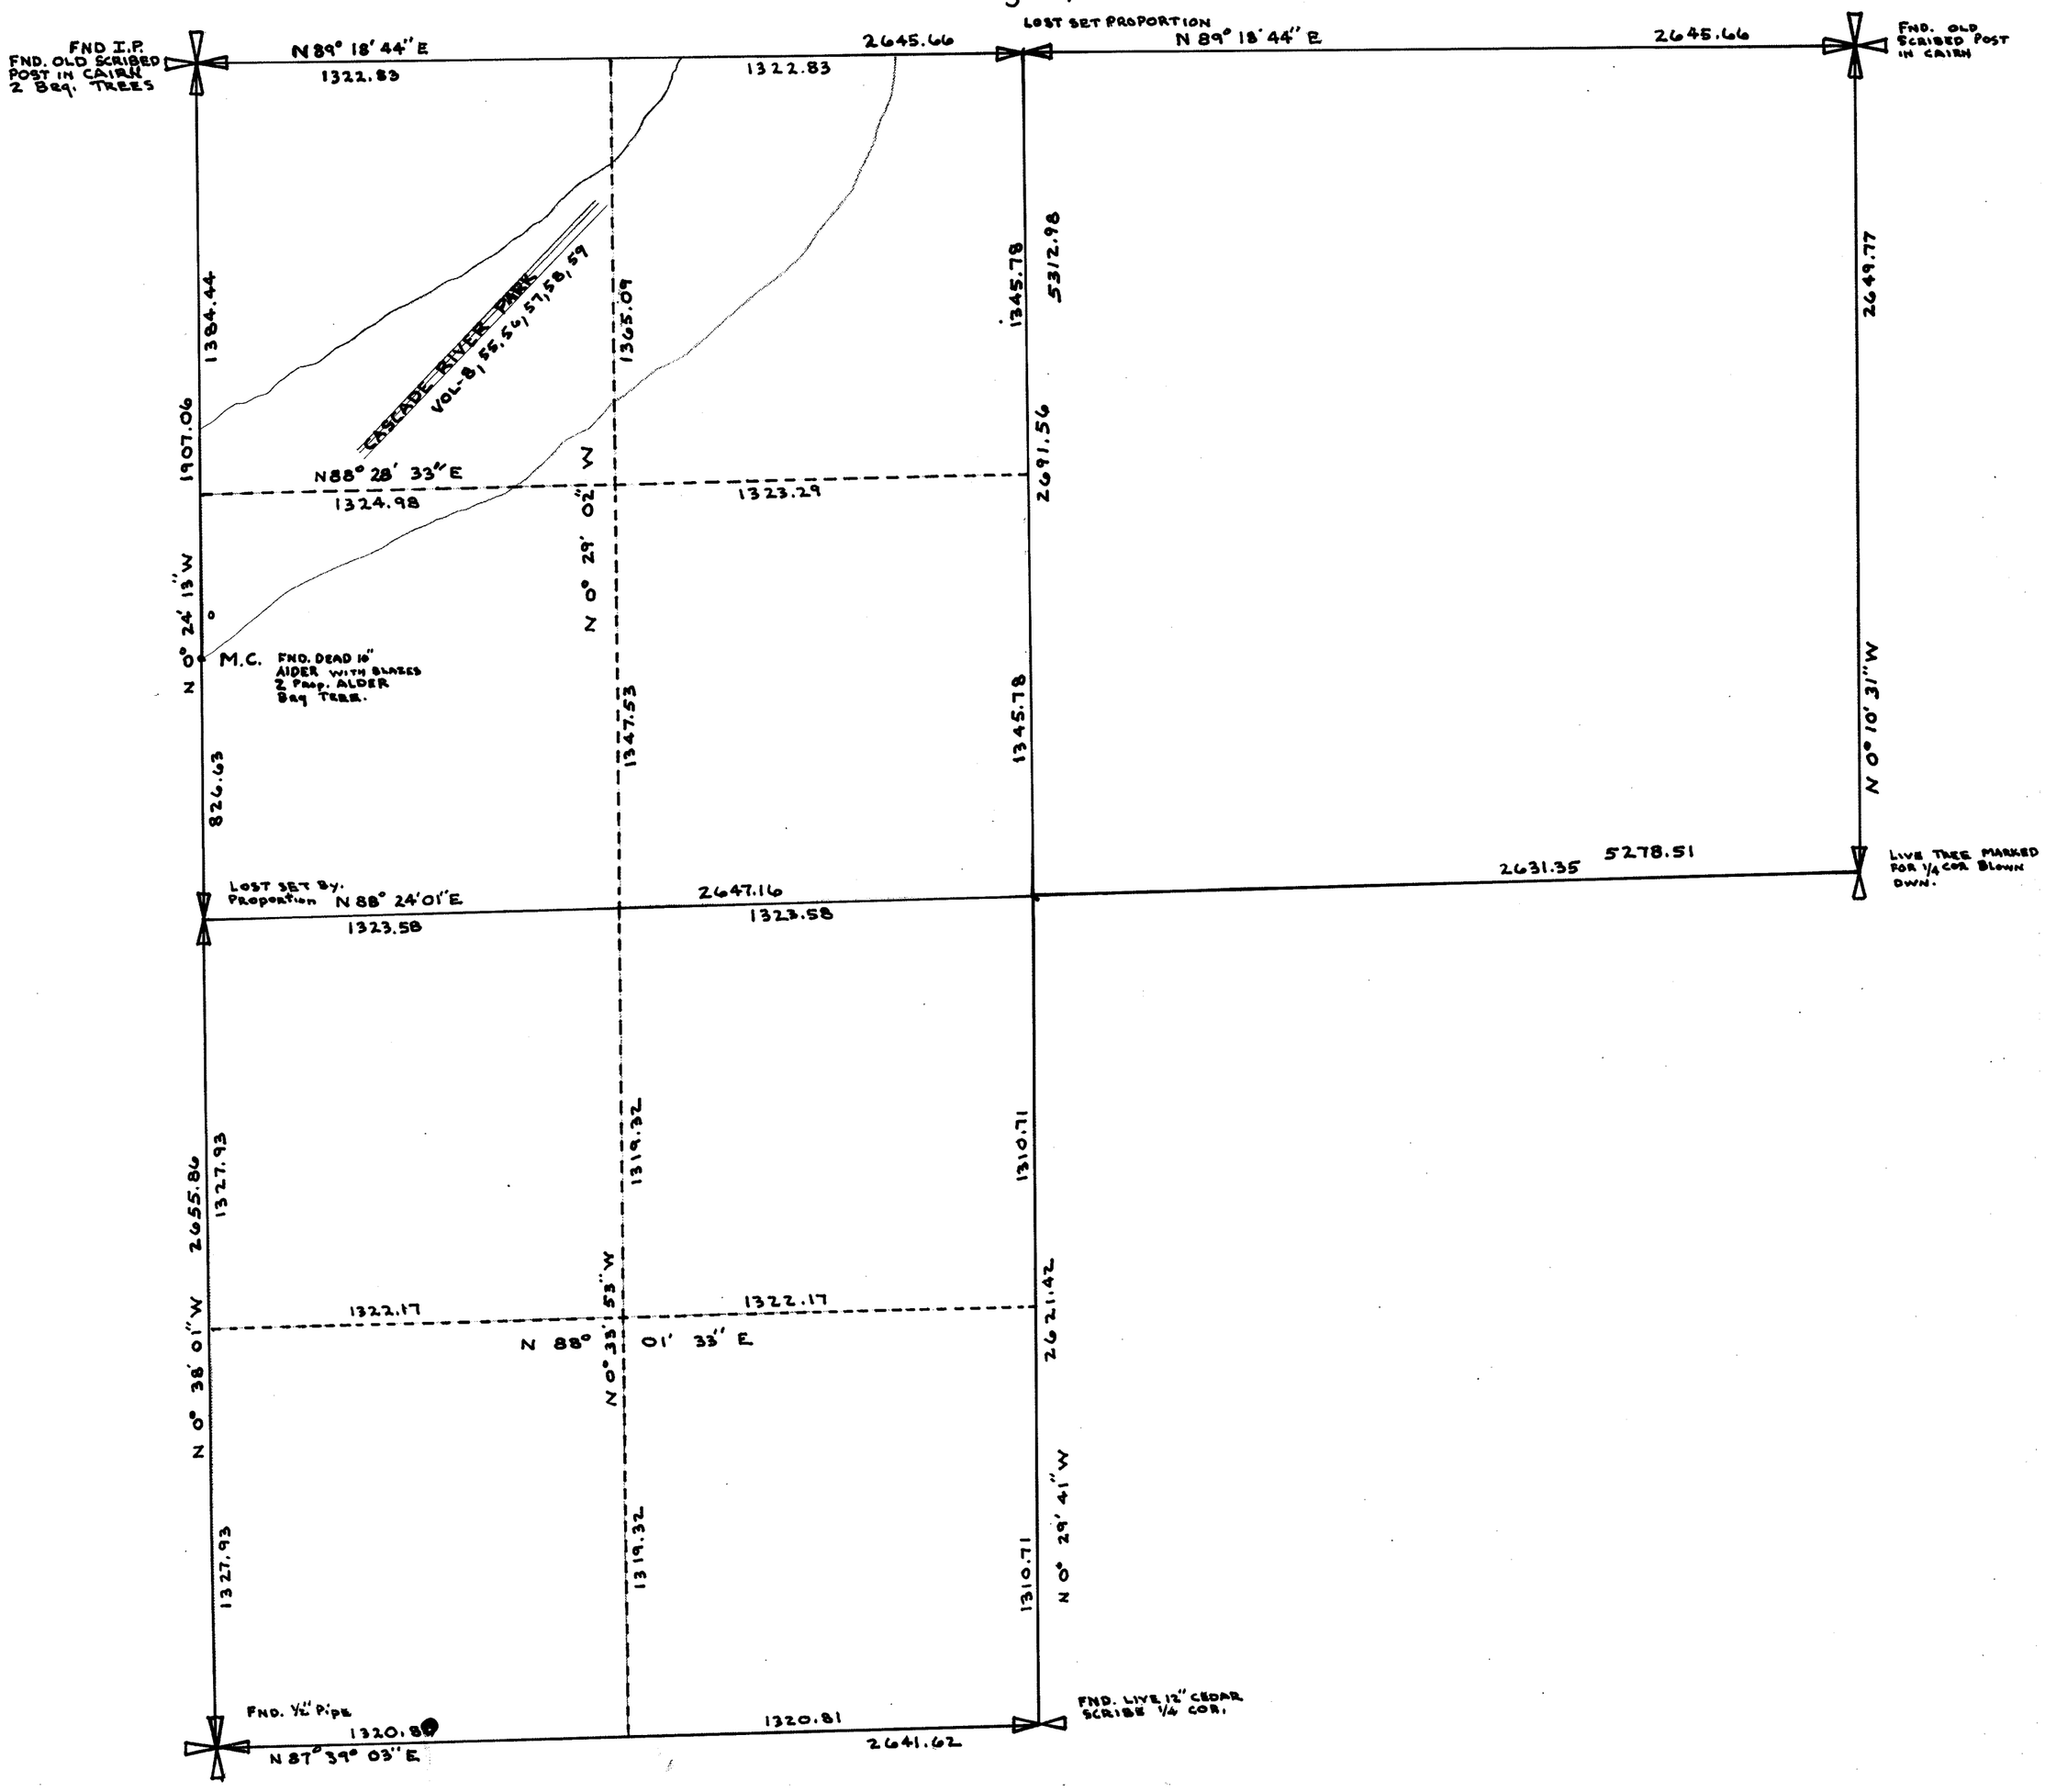


SECTION 15

TOWNSHIP 35 NORTH. RANGE 11 EAST. W. M.
SKAGIT COUNTY. WASH.

SCALE. 1 INCH—400 FEET

LLOYD H. JOHNSON COUNTY ENGINEER

DATE July 7, 1972

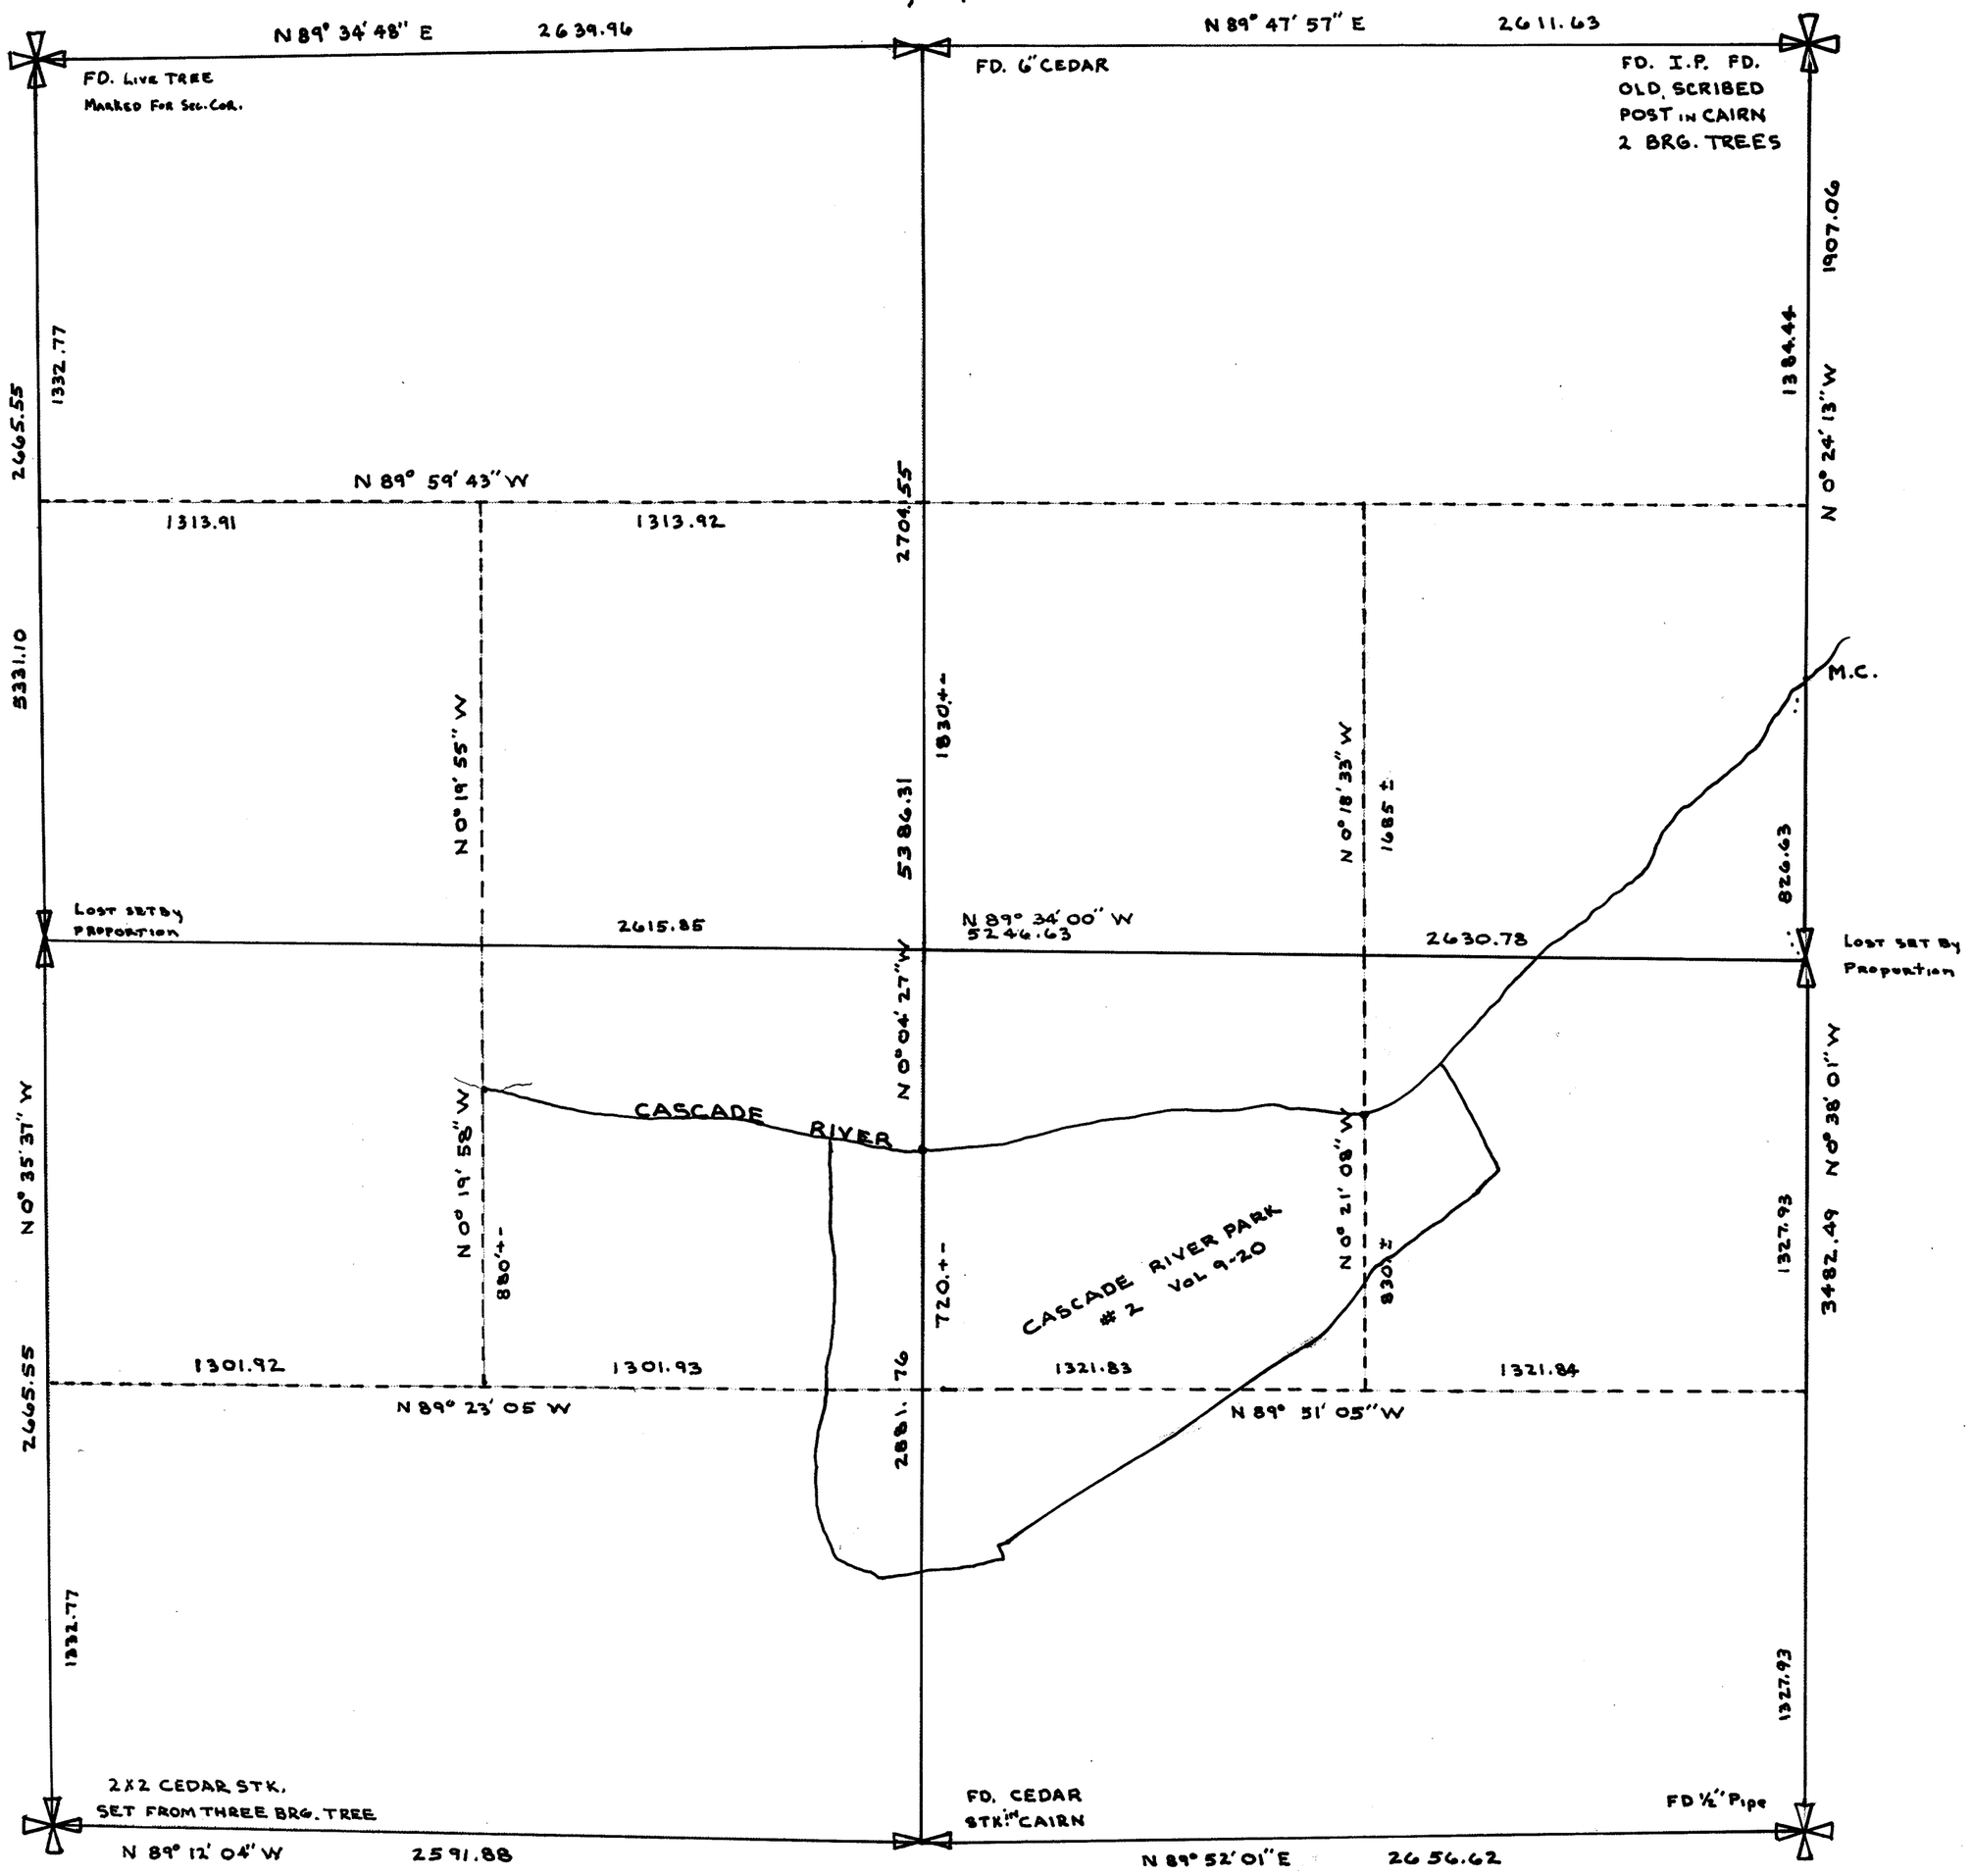


SECTION 17

TOWNSHIP 35 NORTH, RANGE 11 EAST, W. M.

SKAGIT COUNTY, WASH.

DATE Aug. 29, 1966 — Lloyd Johnson — COUNTY ENGINEER

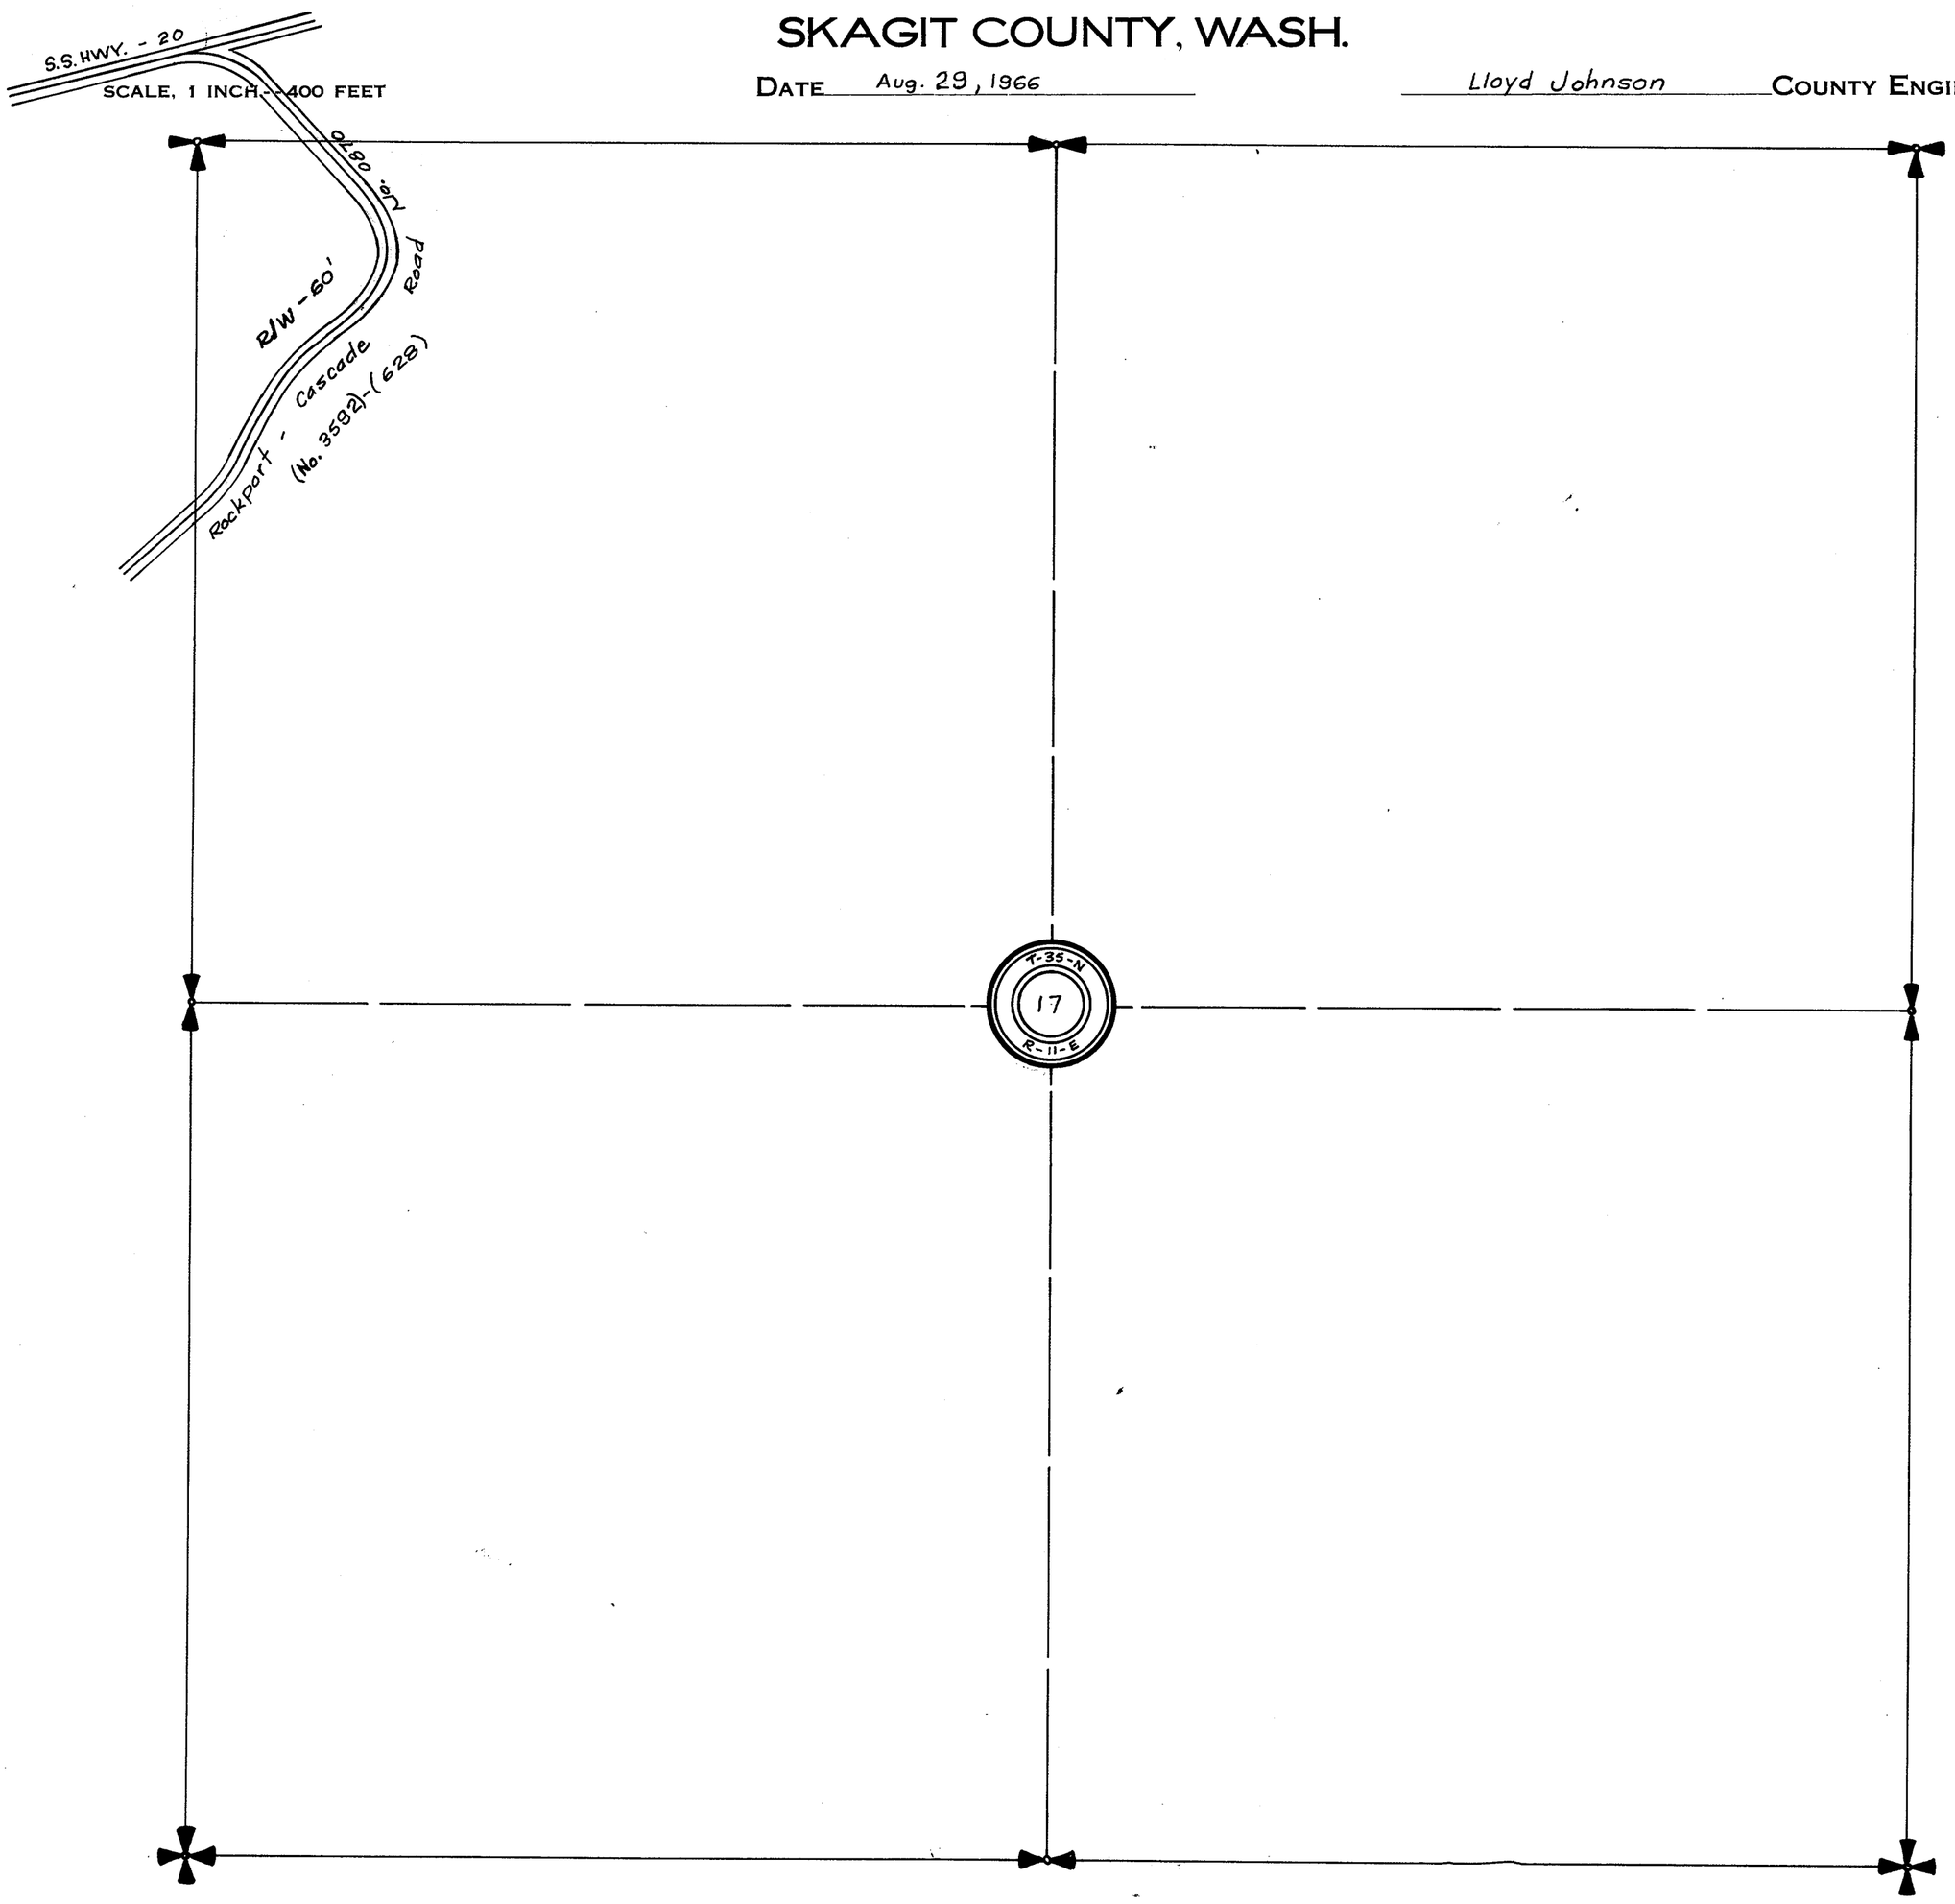

SECTION 17


TOWNSHIP 35 NORTH, RANGE 11 EAST, W. M.

SKAGIT COUNTY, WASH.

SCALE, 1 INCH -- 400 FEET


LLOYD H. JOHNSON COUNTY ENGINEER

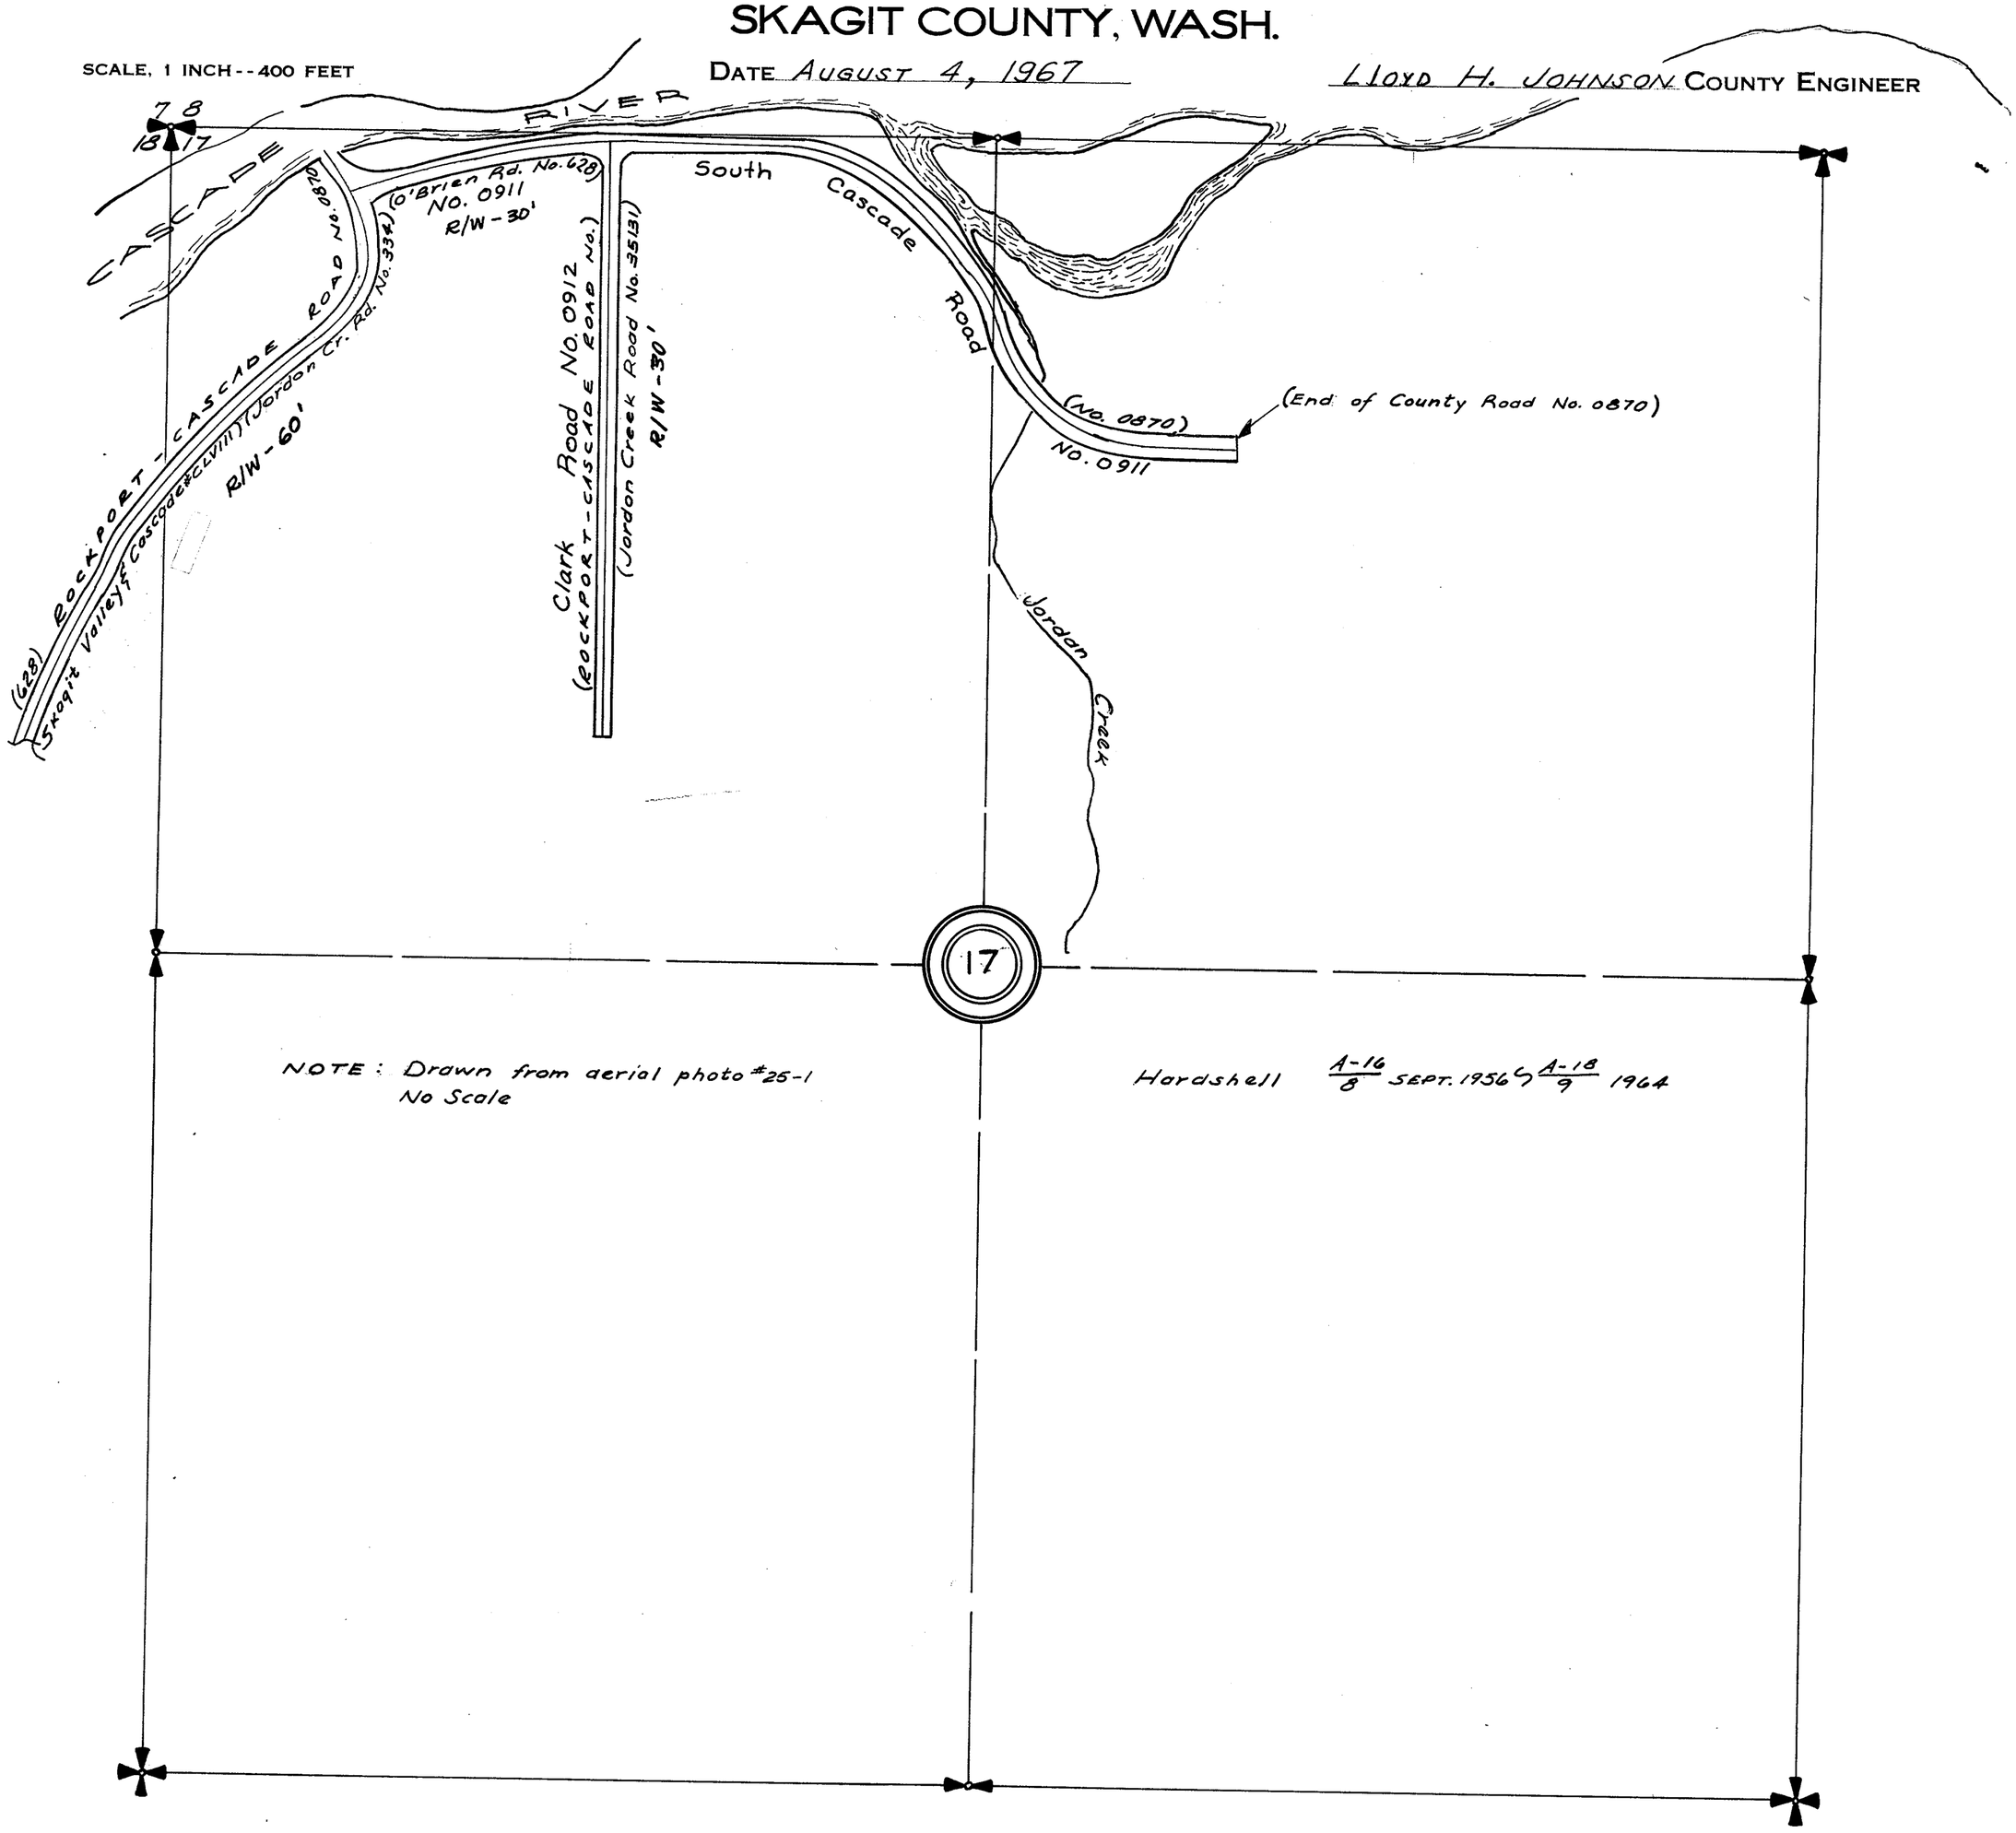

NOTE : Drawn from aerial photo #25-1
No Scale

Hardshell A-16/8 SEPT. 1956 & A-18/9 1964


SECTION 17

TOWNSHIP 35 NORTH. RANGE 11 EAST. W. M.
SKAGIT COUNTY. WASH.

Lloyd Johnson COUNTY ENGINEER


SCALE. 1 INCH—400 FEET

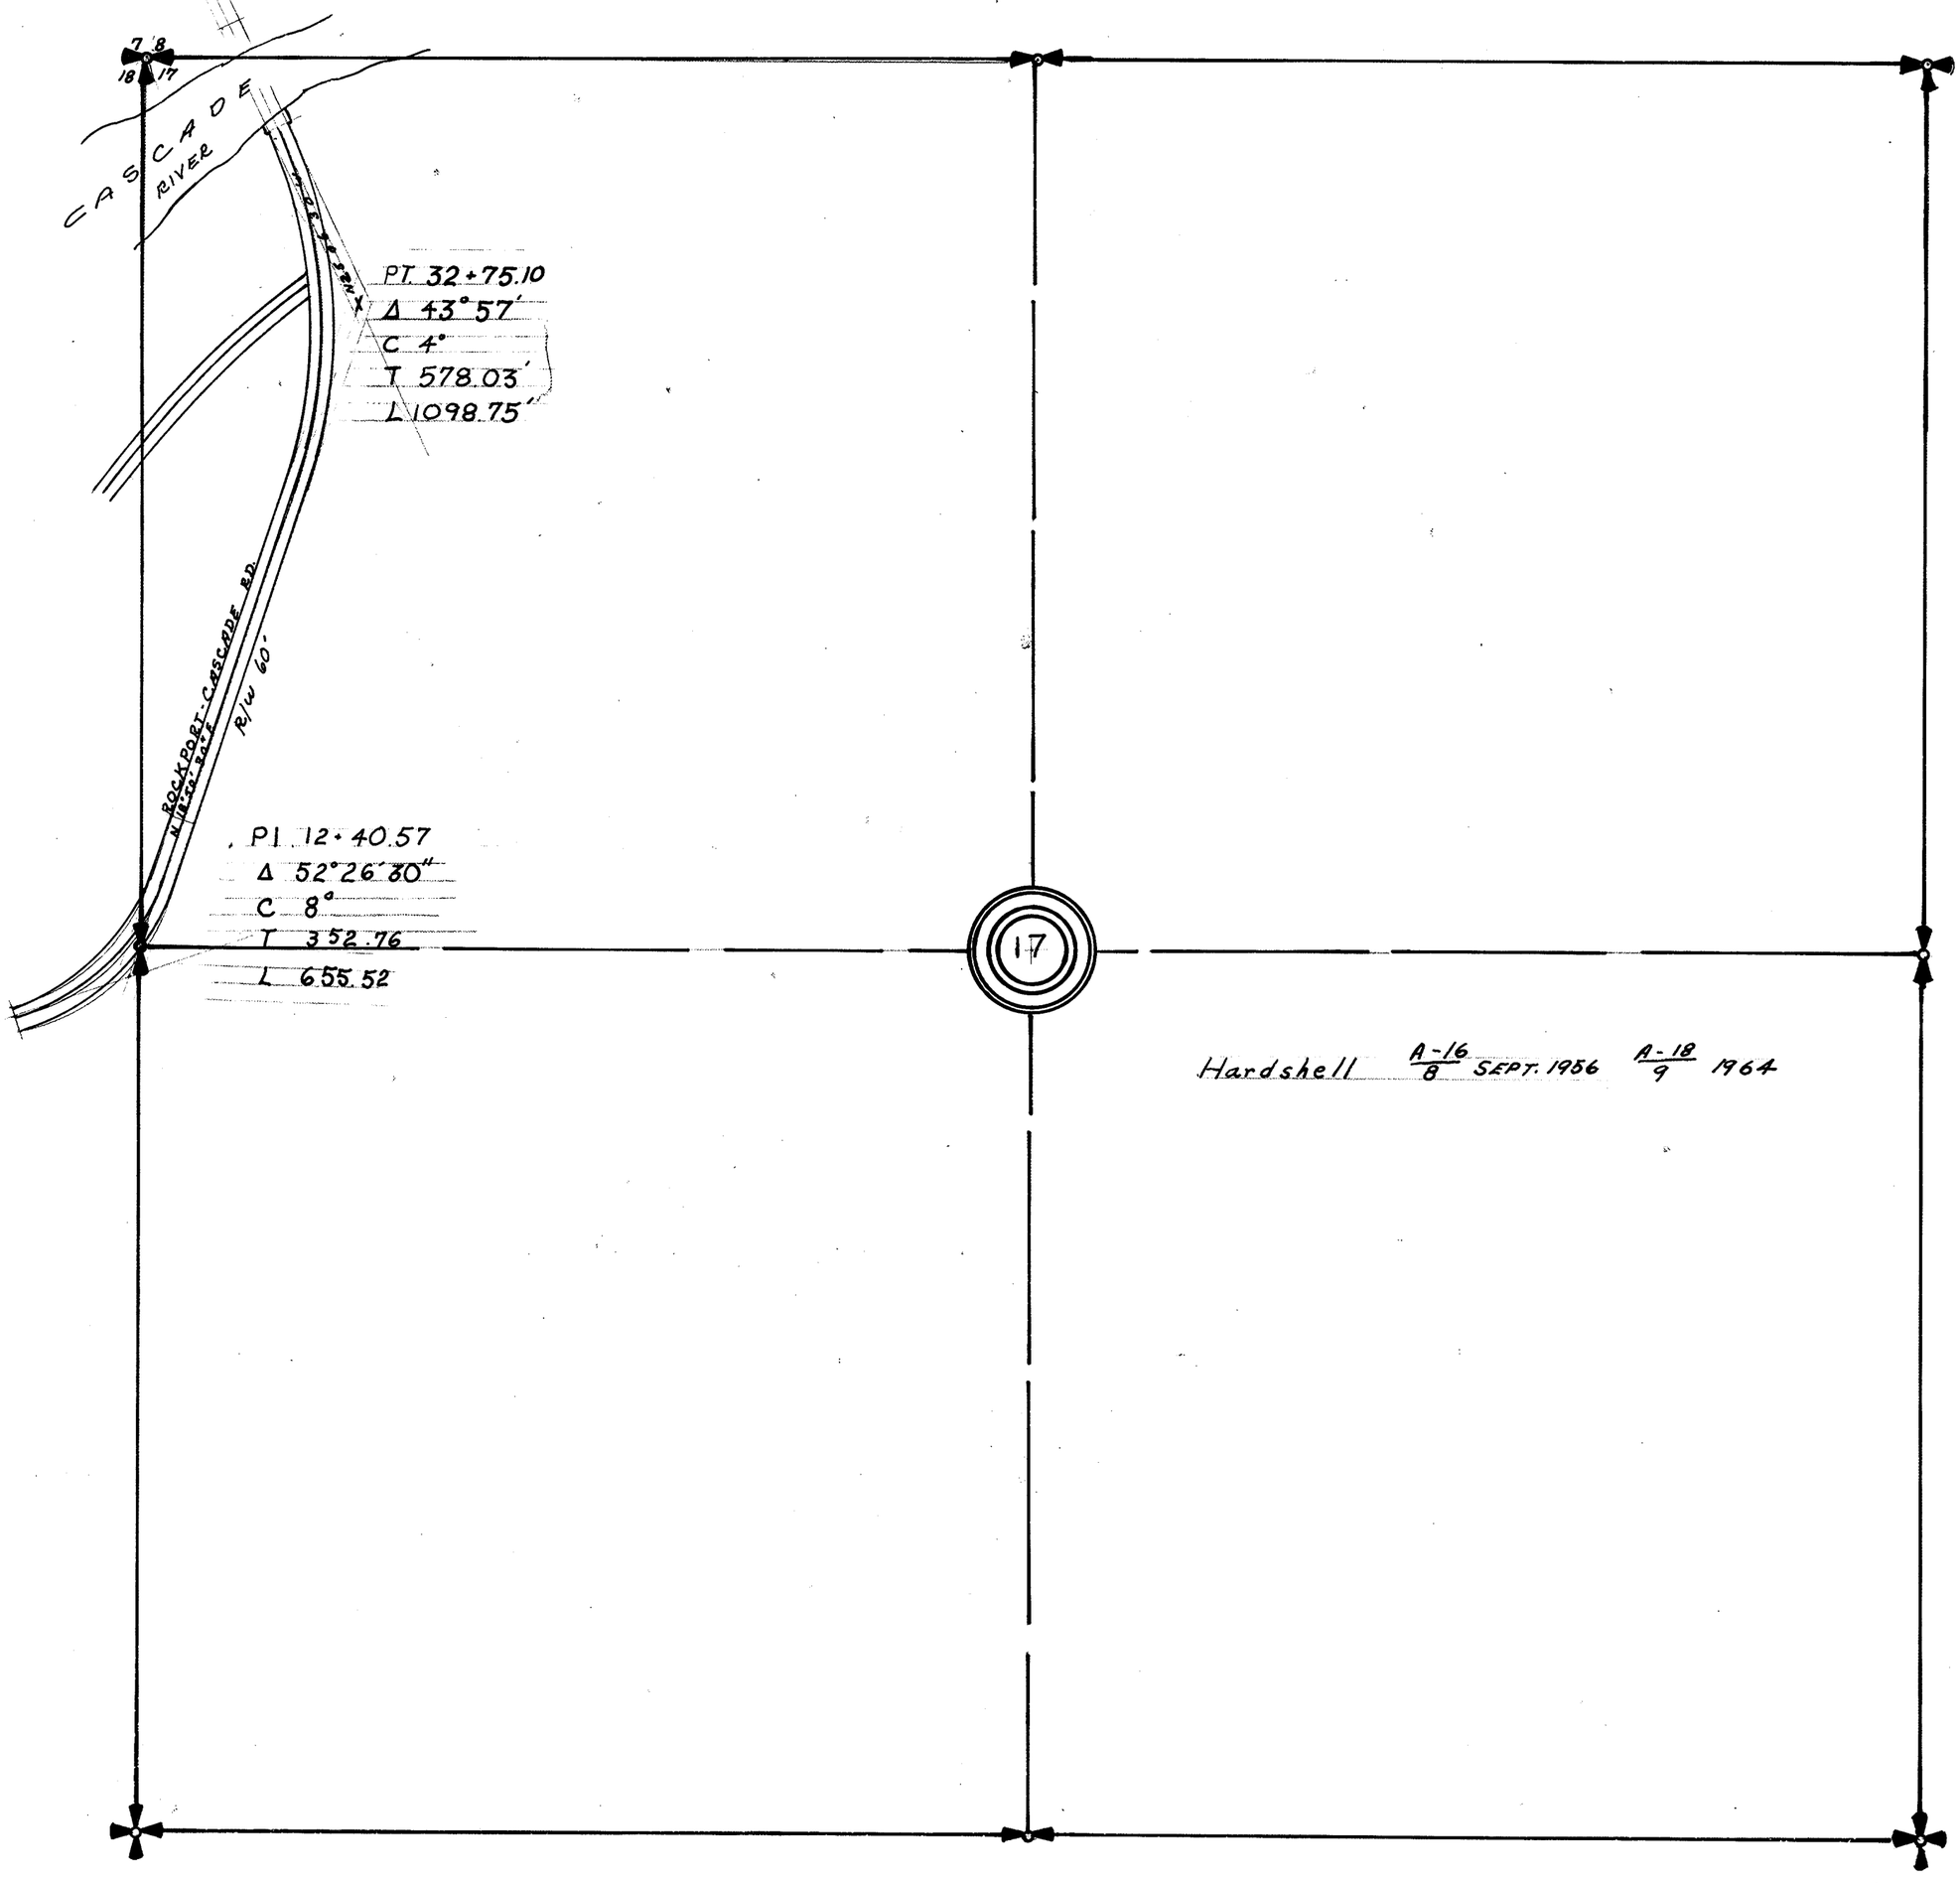

Hardshell A-16/8 SEPT. 1956 A-18/9 1964



TOWNSHIP 35 NORTH, RANGE 11 EAST, W. M.

SKAGIT COUNTY, WASH.

Notes 833-188-116

SCALE, 1 INCH--400 FEET

COUNTY ENGINEER

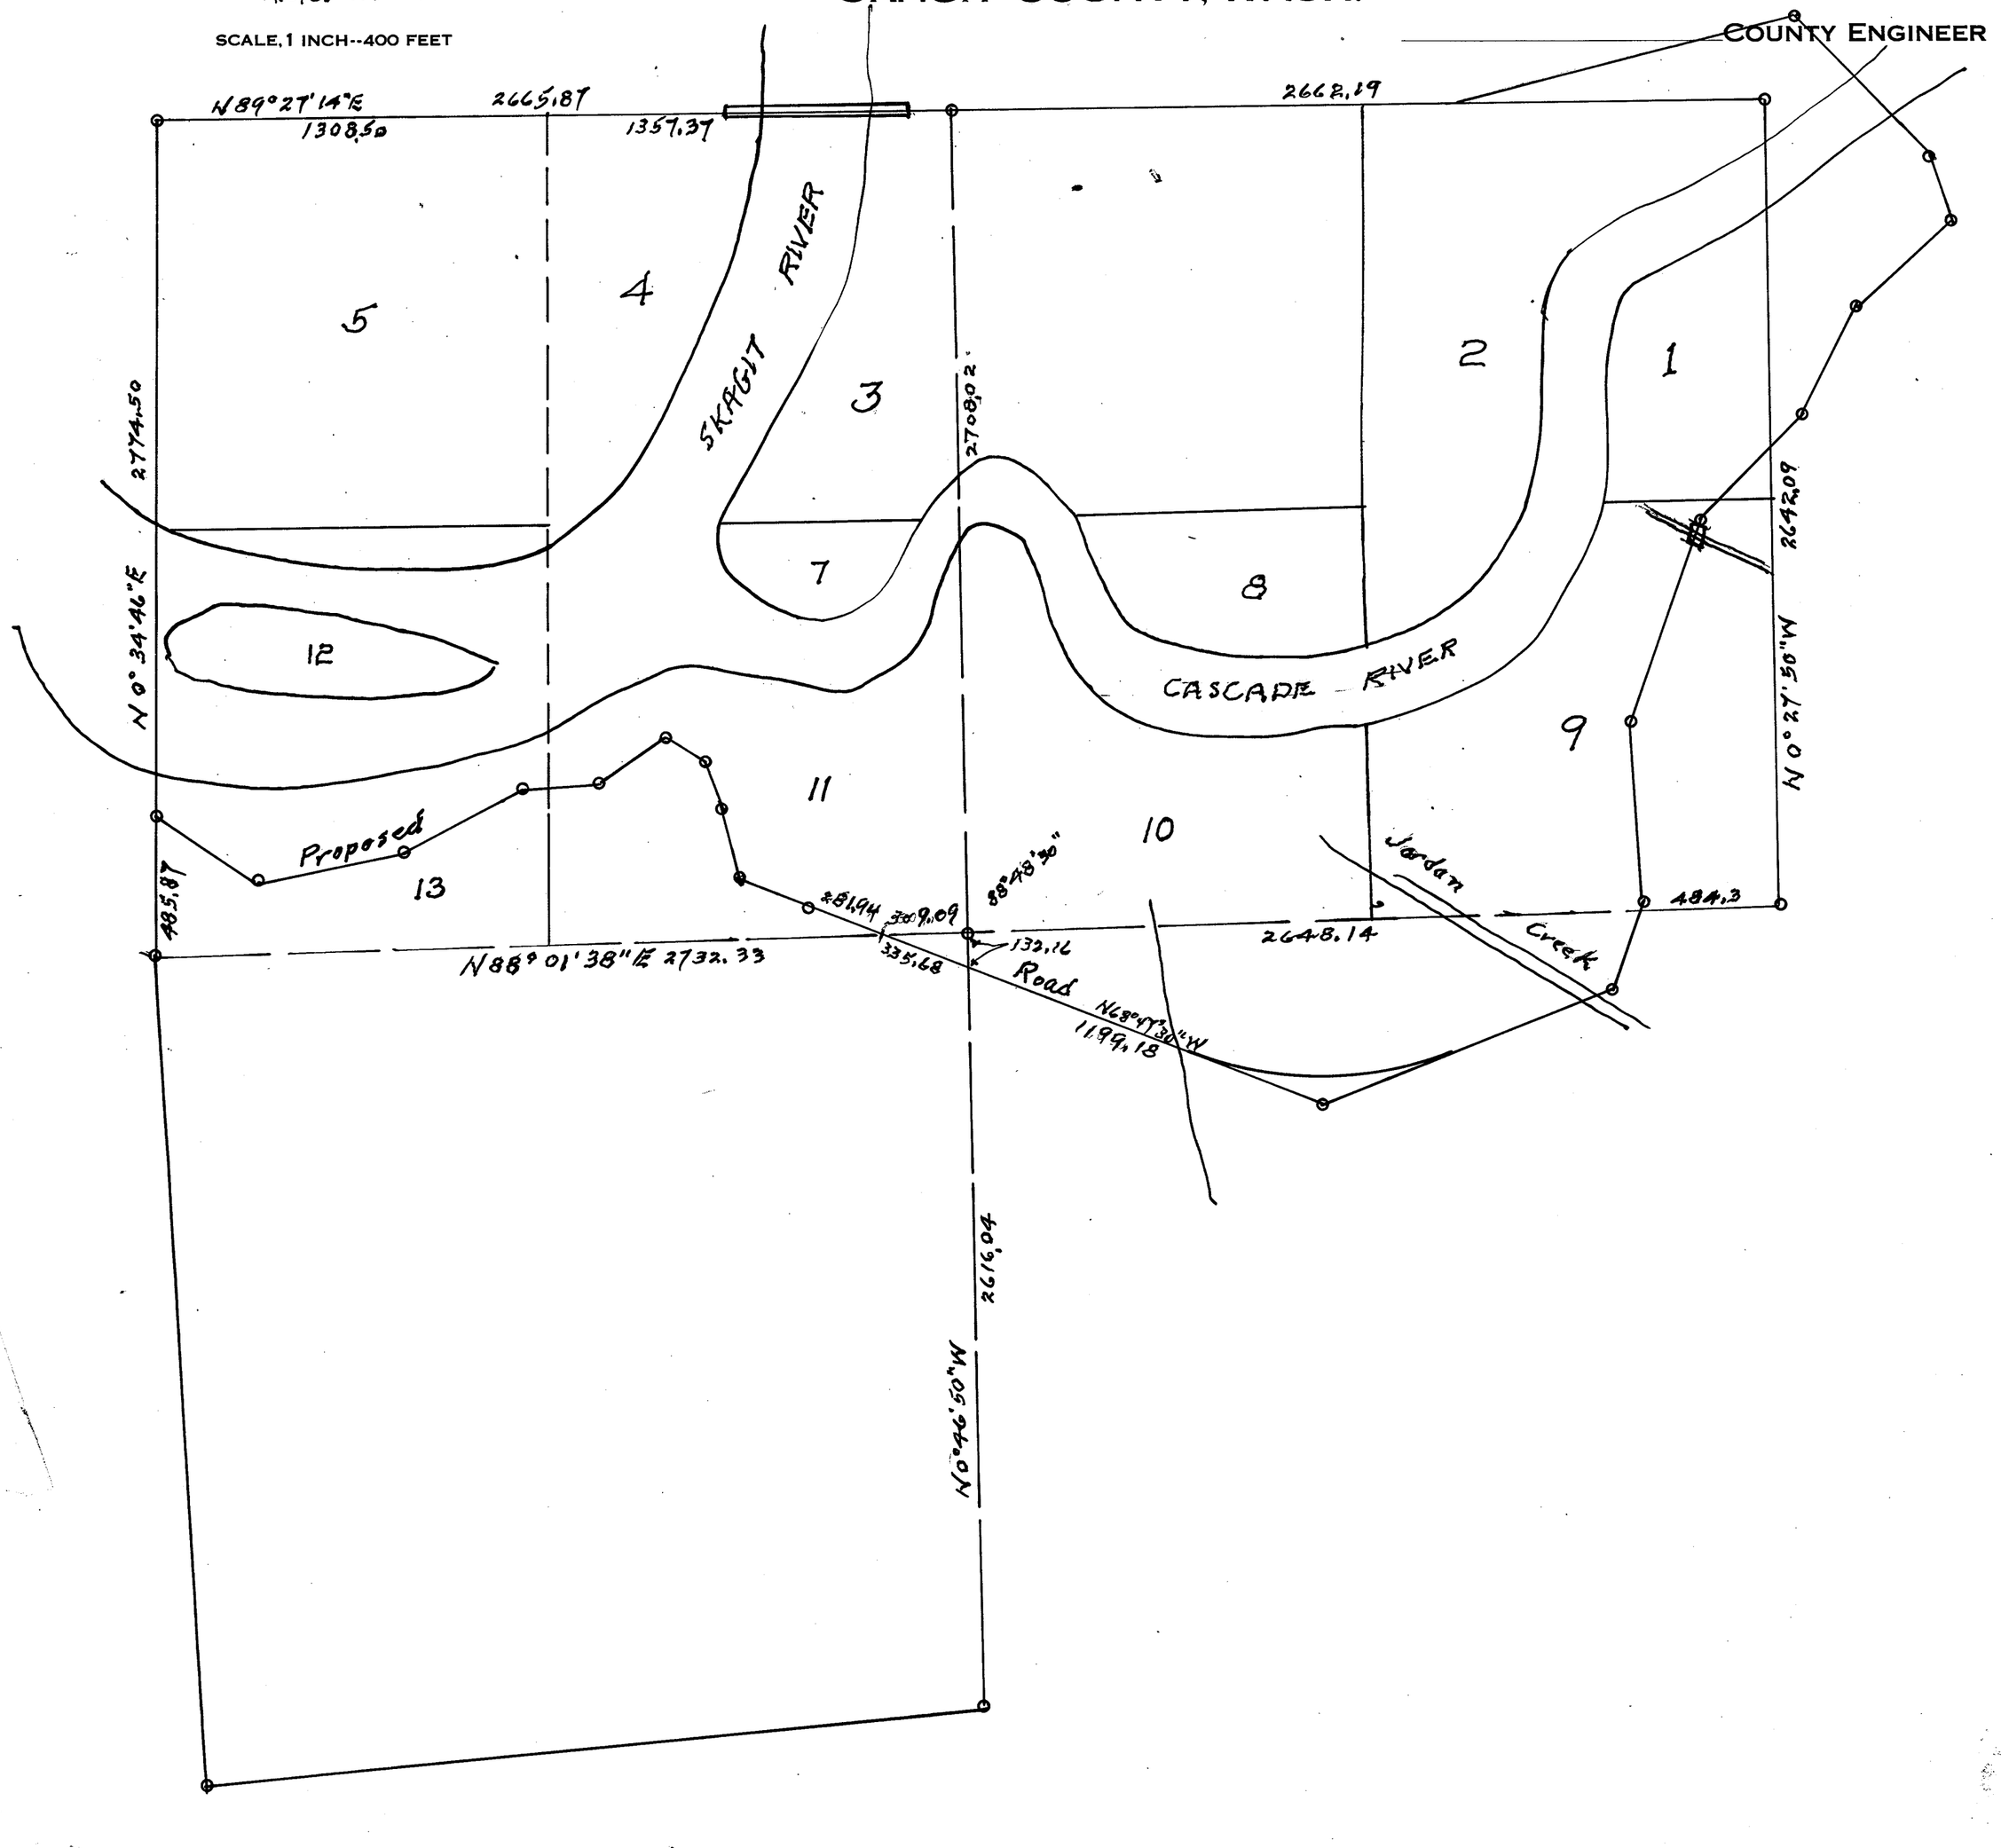

SECTION 18


TOWNSHIP 35 NORTH, RANGE 11 EAST, W. M.

SKAGIT COUNTY, WASH.

SCALE, 1 INCH -- 400 FEET

DATE Aug. 29, 1966

Lloyd Johnson COUNTY ENGINEER

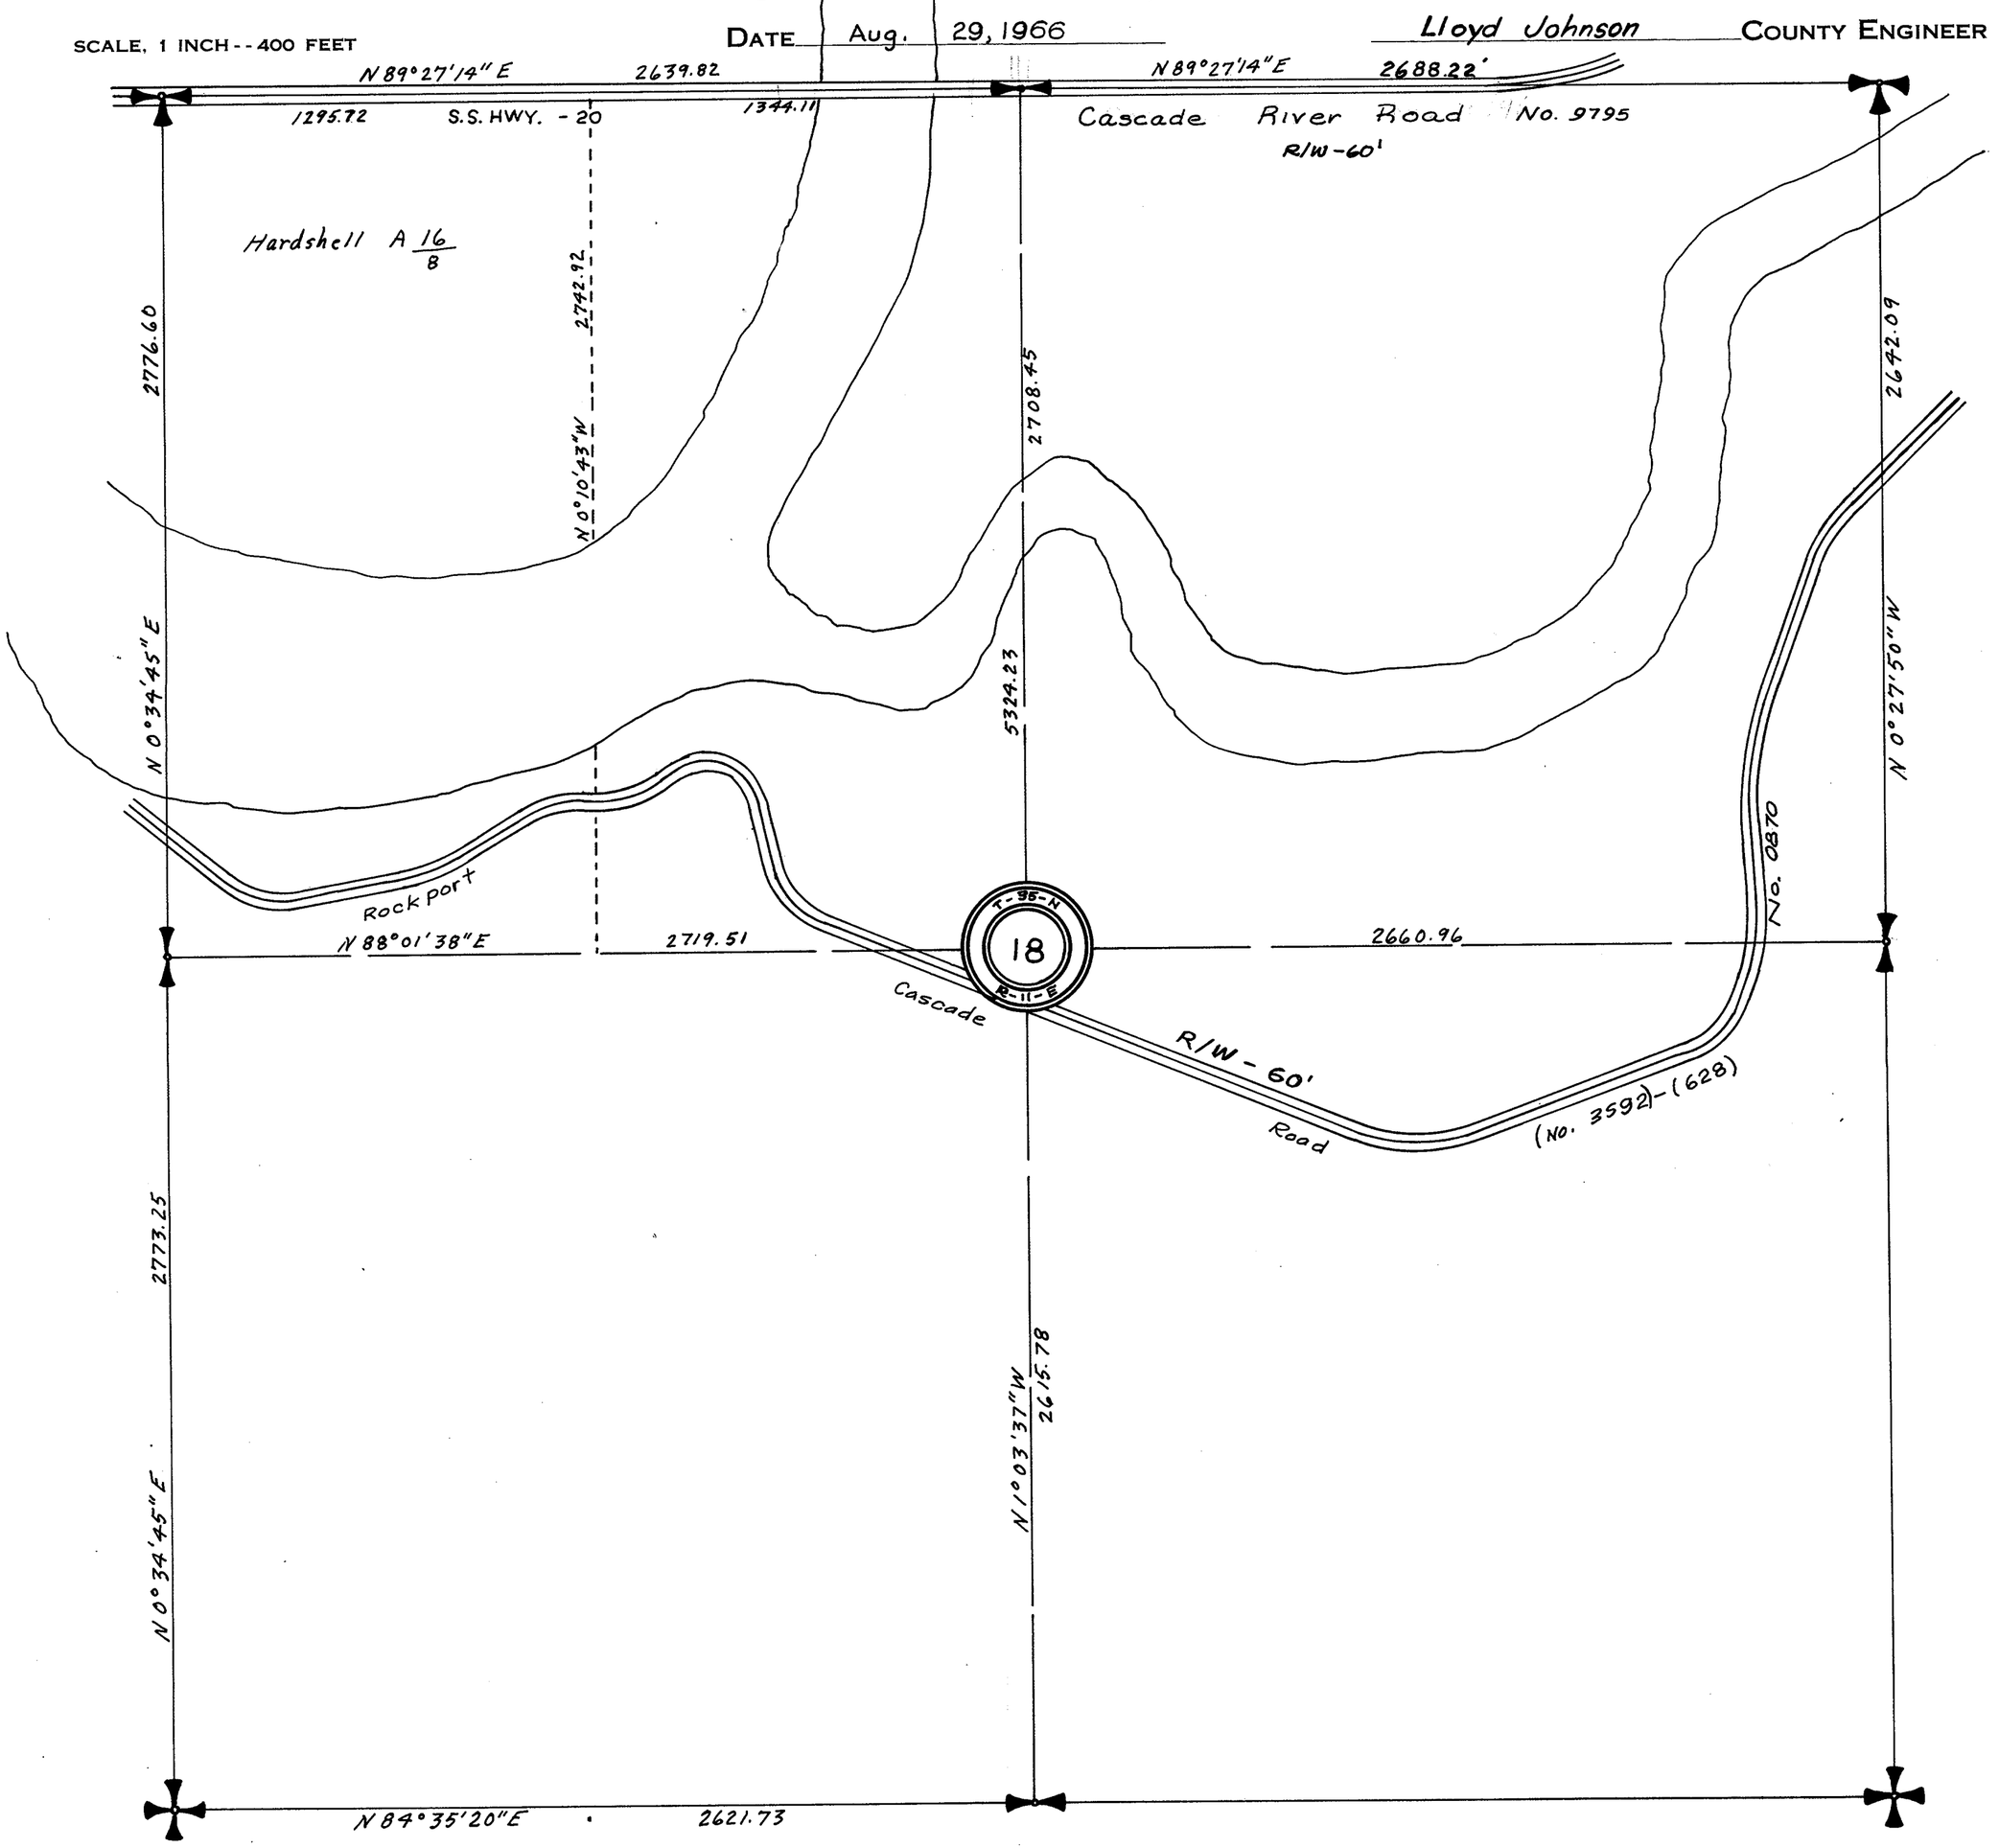

SECTION 9

TOWNSHIP 36 NORTH, RANGE 1 EAST, W. M.

SKAGIT COUNTY, WASH.


NOTES: L.L.-E.119
SCALE, 1 INCH-400 FEET

R.E.L KNAPP COUNTY ENGINEER

REVISION OF JACKSON ROAD NO. 56

SEC. 9-36-1

SCALE
1 INCH=400 FEET
R/W 30 FT.
Notes:- E 119

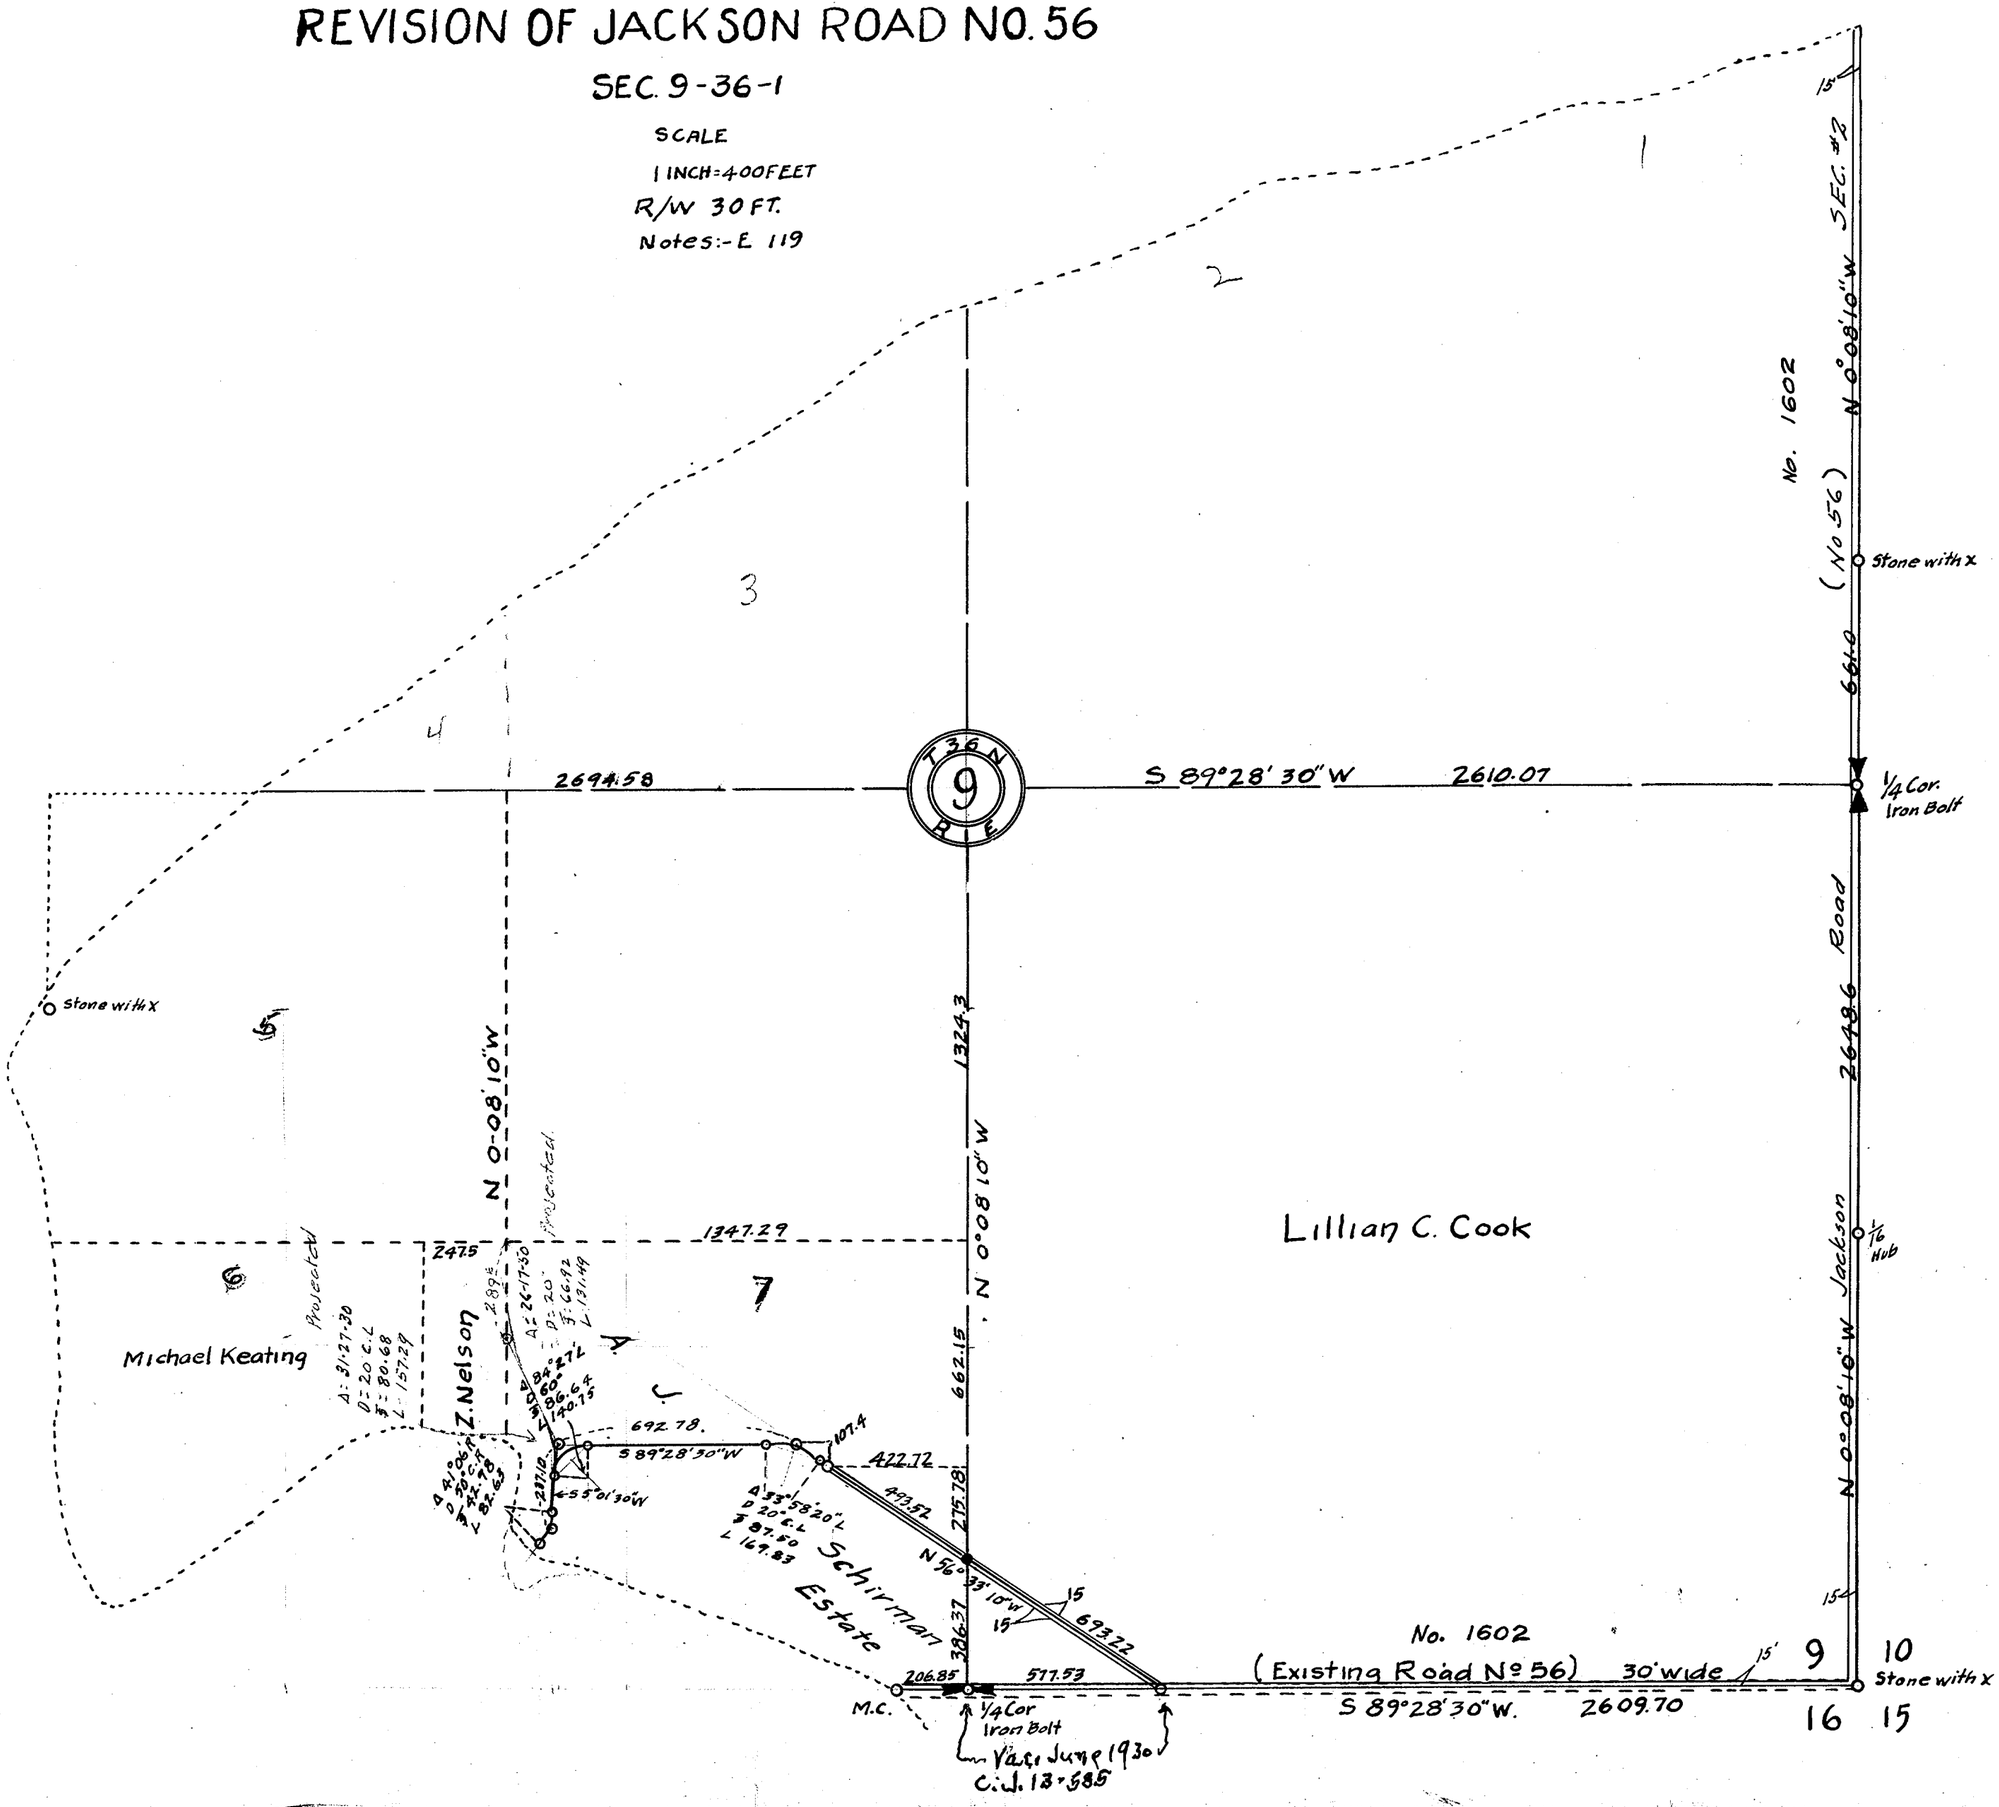

E-Z-21


SECTION 9

TOWNSHIP 36 NORTH, RANGE 1 EAST, W. M.

SKAGIT COUNTY, WASH.

SCALE, 1 INCH--400 FEET

_____ COUNTY ENGINEER

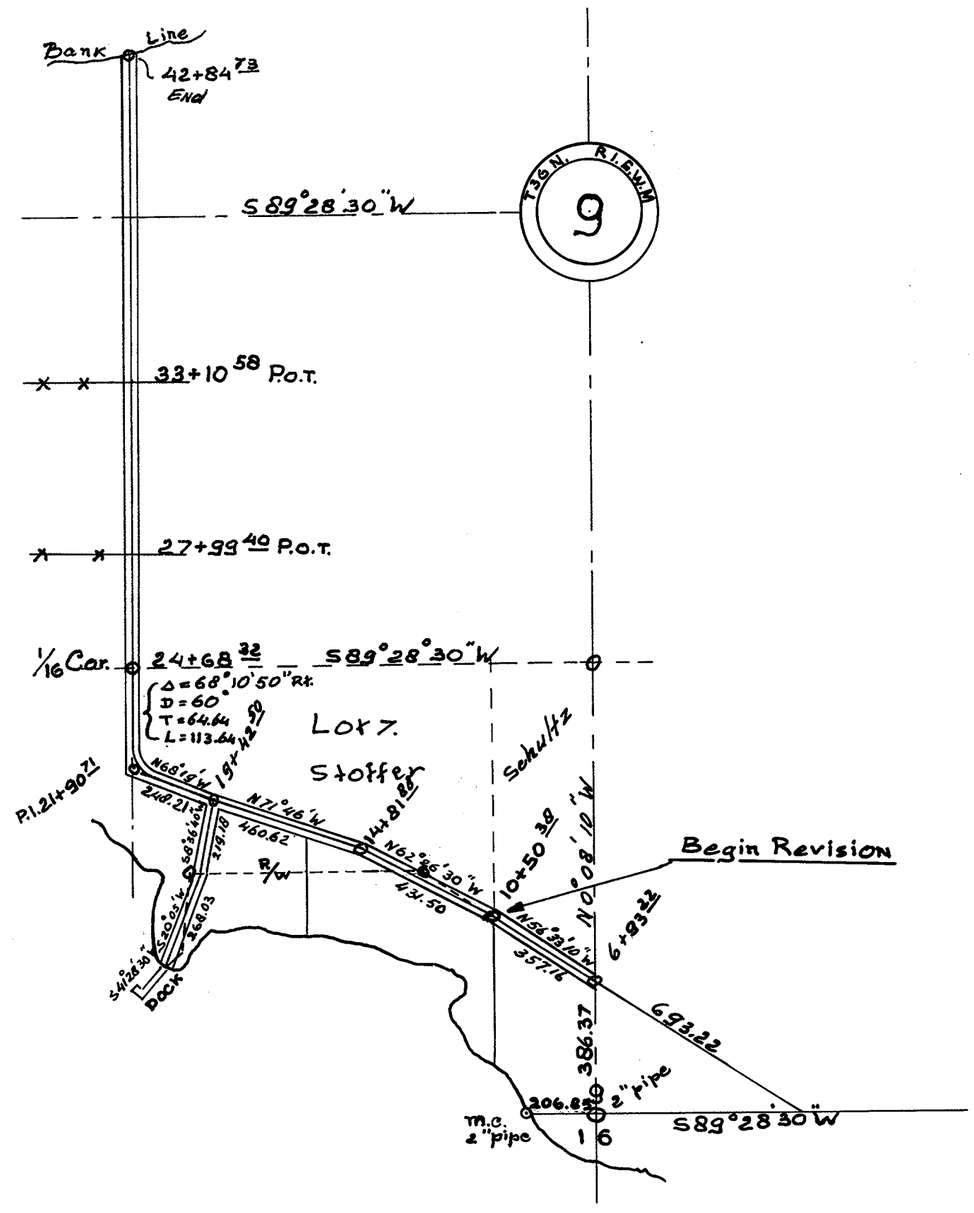

RE-VISION JACKSON ROAD NO. 56

SINCLAIR ISLAND

40 Ft. R/W Aug. 1957

FIELD NOTES — #924

RUSSELL H. DAVIS - LAND SURVEYOR

SECTION 9

TOWNSHIP 36 NORTH, RANGE 1 EAST, W. M.

SKAGIT COUNTY, WASH.

SCALE, 1 INCH--400 FEET

DATE August, 1965

Lloyd Johnson COUNTY ENGINEER

Gen. Notation : SUB-DIVISION INFORMATION TAKEN FROM OLD TRACING

R/W REVISED BY AERIAL PHOTO

* 2 - OTHER OLD TRACINGS { Aug. 1957 / Not given

* 1 - INK DRAWING

HARD SHELL A-1 / 18

T-36-N 9 R-1-E

Lot (4) 2694.58

S 89°28' 30"W 2610.07

RW-40'

671932/RW-20'

673253/RW-20'

758850/RW 20'

673223/RW-20'

671933/RW-20'

N0°08'10"W

1324.3

N 0°08' 10" W 2648.6'

Sinclair Island

Lot(5)

S89°28'30"W 1347.29

Lot(6)

LEADBETTERS SINCLAIR TRACTS VOL-9, 30

Stoffer's Addition Plat Vol. 8 Page 69

673163/RW-40'

Lot (7)

Jackson

Road No. 1990 (No. 1602) (56)

R/W 30'

Road Papers: Name — Jackson; Deed File # — 56

ENG. NOTES : E-119 — 9/26/28

924 — 1957

Vacation by Comm. June 1930 C. J. Vol. 13 p. 585

S-89°-28'-30" W 2609.70

Note: All bearings taken from old tracing

0.19 (56)

No. 1990 (No. 1602)

30'

Stone with X mark

Fence Post (1929) 16.32

660.38'

Road

1/4 Cor. Iron Bolt

Fence Post 36.09

1324.3 R/W

1/16 Corner Found hub

2648.6

Jackson

N 0°-08'-10" W

1324.3

18" Cedar (1929) Tree 86.92

Stone with X

72.00

Cedar Stp.

B.T. 30" White Fir

M.C. Set from B.T. & Field Notes

206.85'

1/4 Cor. Iron Bolt

SECTION 10


TOWNSHIP 36 NORTH, RANGE 1 EAST, W. M.

SKAGIT COUNTY, WASH.

SCALE, 1 INCH--400 FEET

DATE August 1, 1965

Lloyd Johnson COUNTY ENGINEER

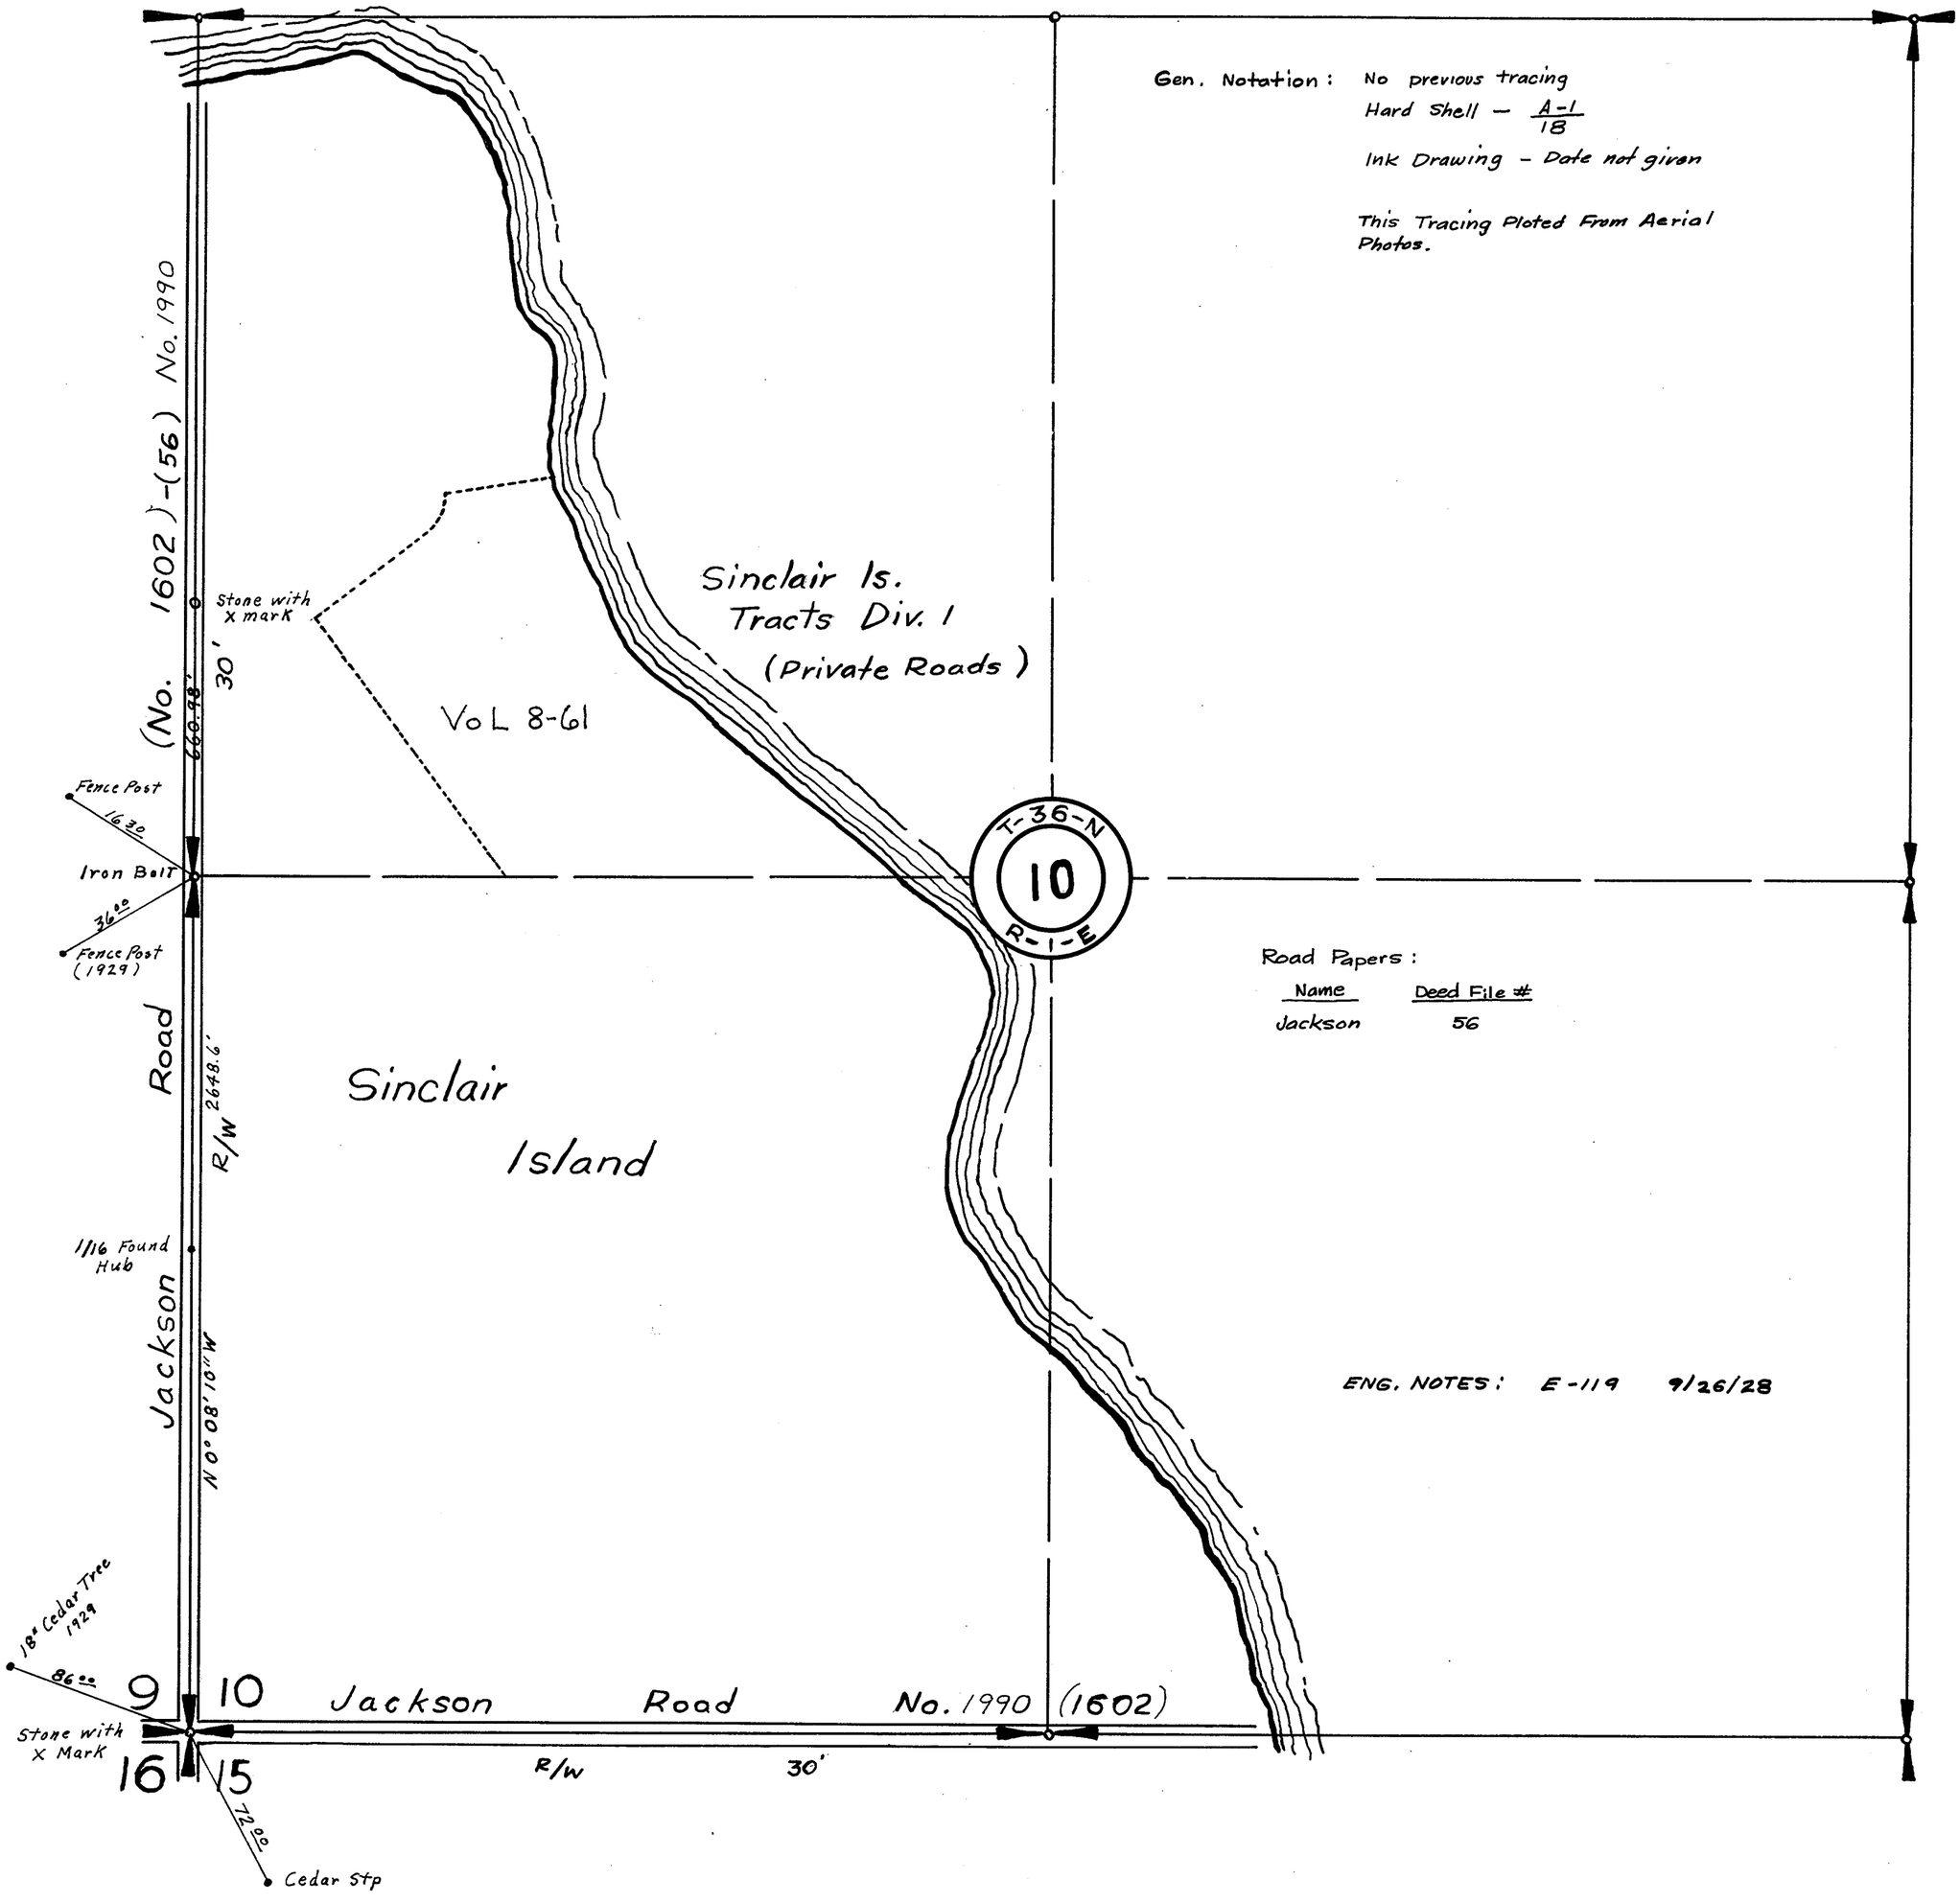

Gen. Notation: No previous tracing
Hard Shell — A-1/18
Ink Drawing - Date not given

This Tracing Ploted From Aerial Photos.


SECTION 16

TOWNSHIP 36 NORTH, RANGE 1 EAST, W. M.

SKAGIT COUNTY, WASH.

SCALE, 1 INCH--400 FEET

DATE August, 1965 Lloyd Johnson COUNTY ENGINEER

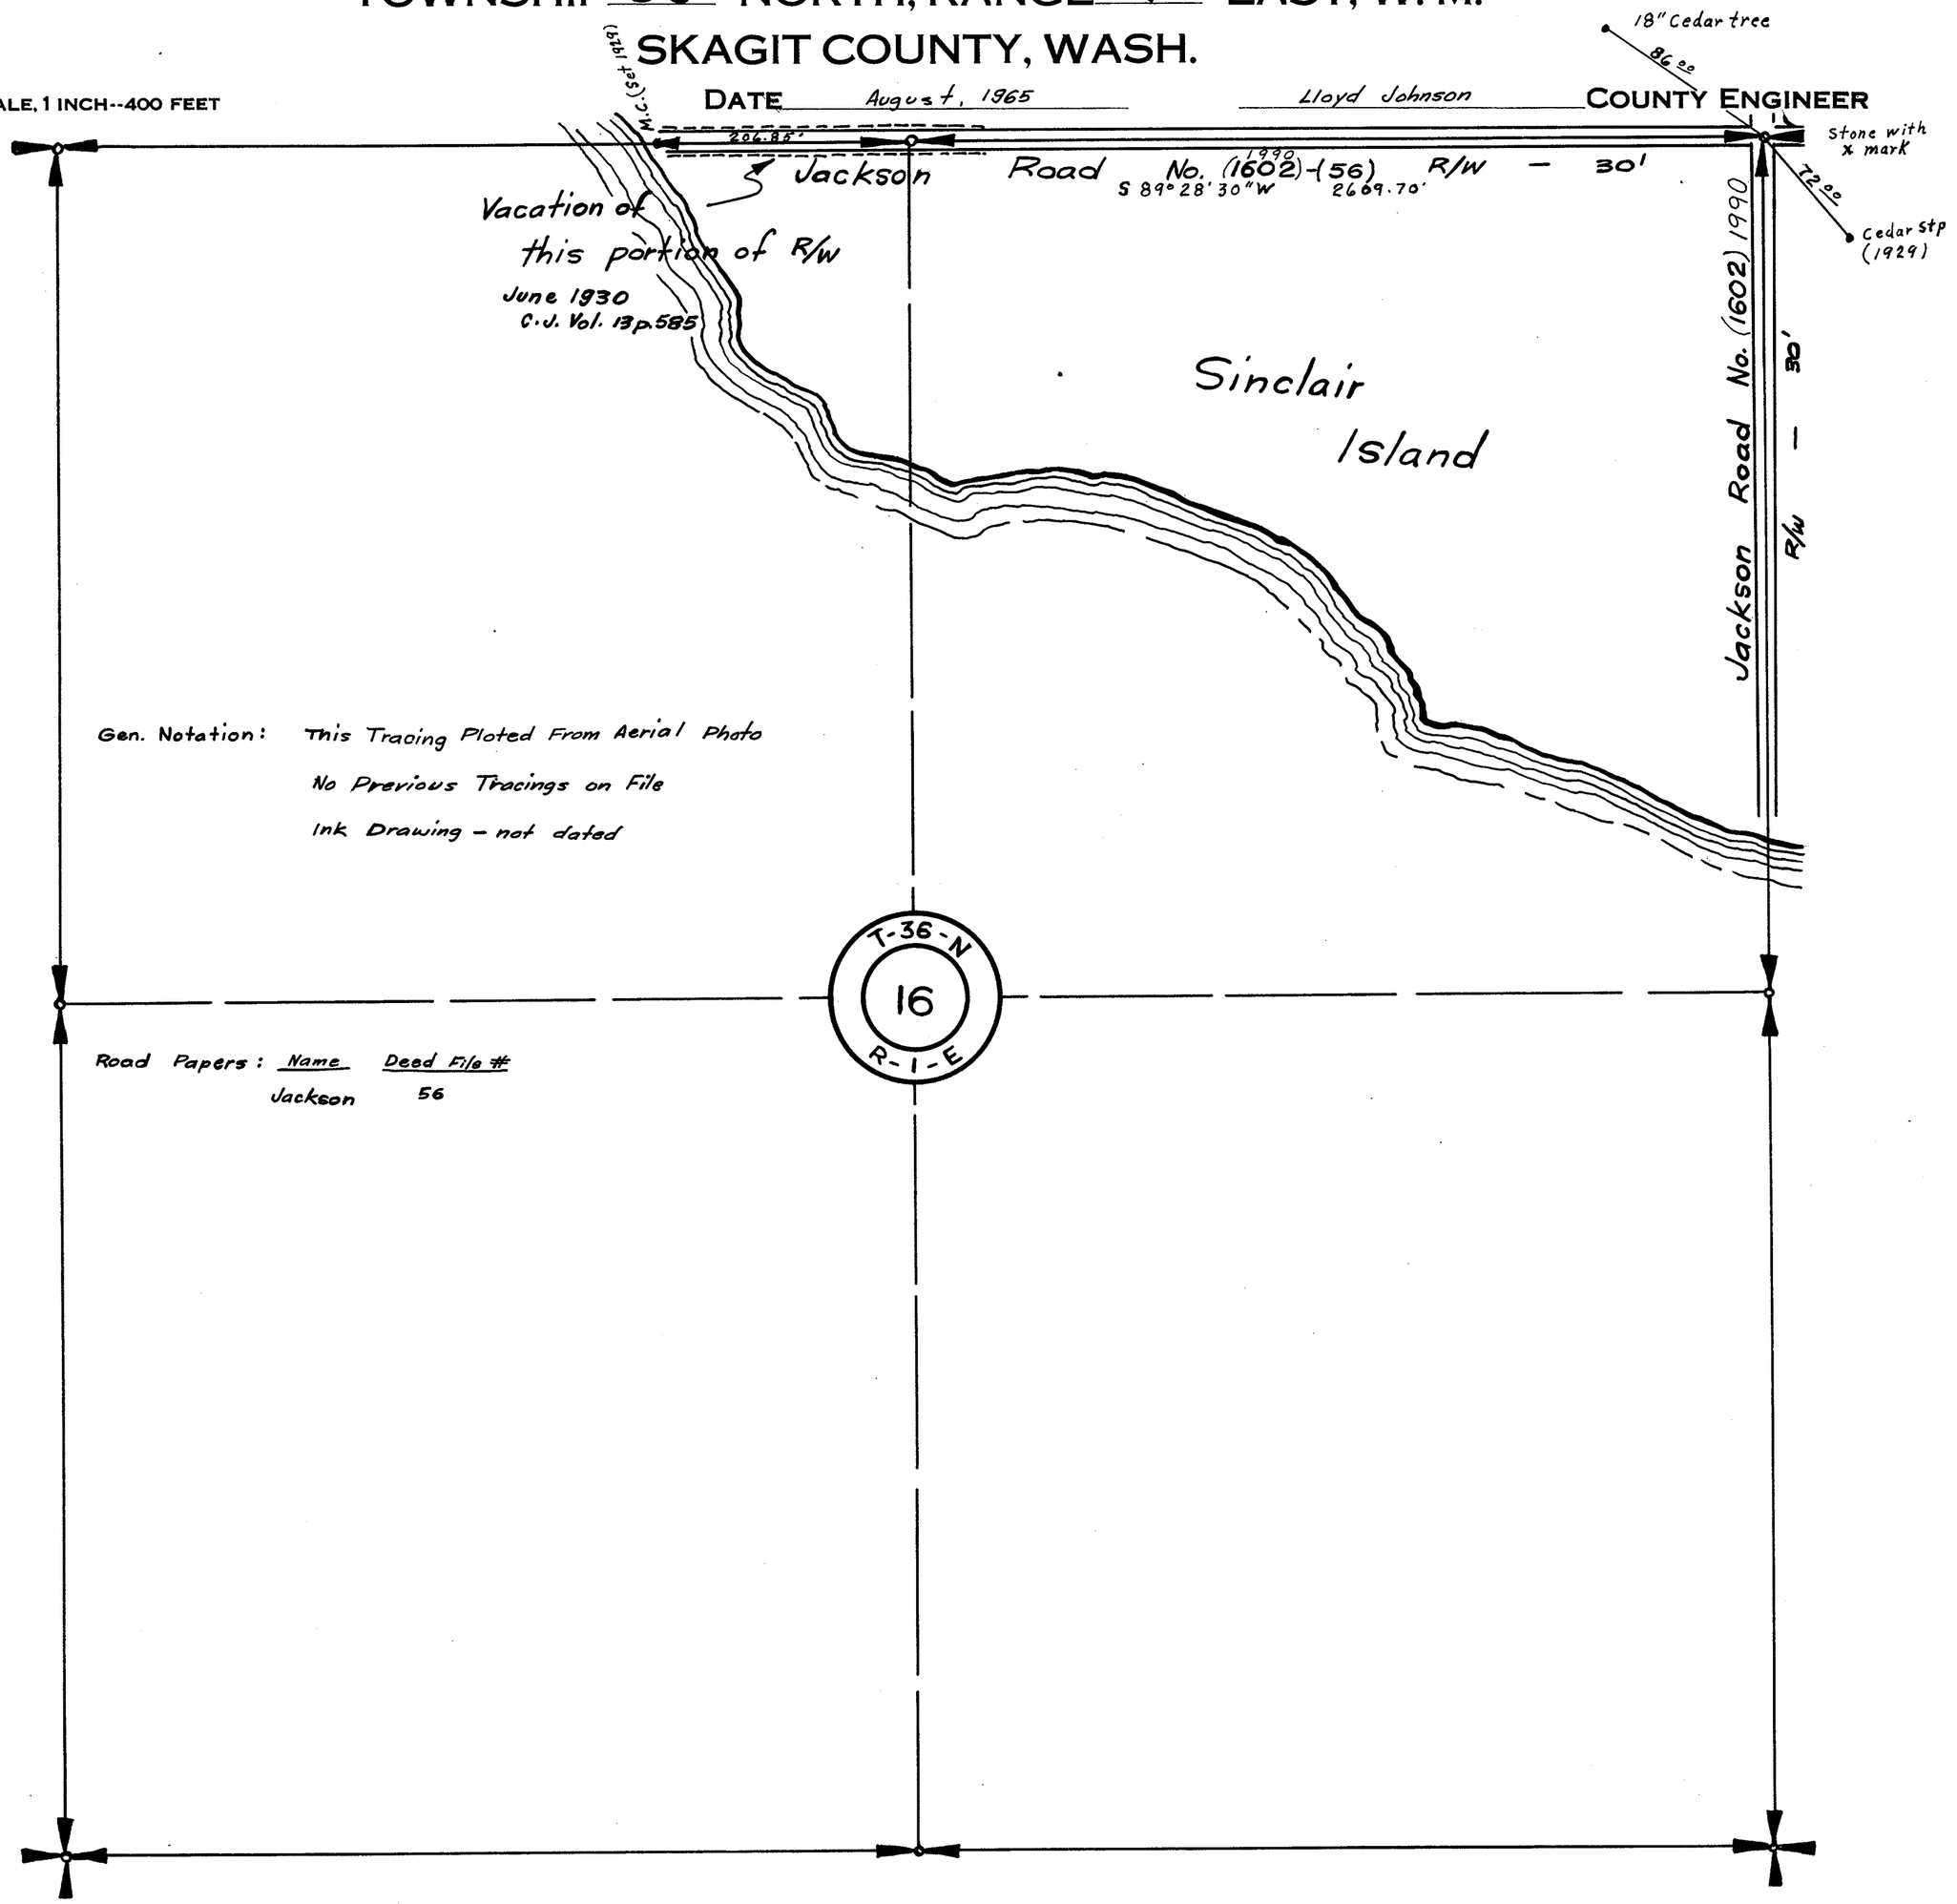

Gen. Notation: This Tracing Ploted From Aerial Photo

No Previous Tracings on File

Ink Drawing - not dated

Road Papers:

Name	Deed File #
Jackson	56

SECTION 25

TOWNSHIP 36 NORTH, RANGE 1 EAST, W. M.

SKAGIT COUNTY, WASH.

SCALE, 1 INCH--400 FEET


DATE August, 1965

Lloyd Johnson COUNTY ENGINEER

Gen. Notations: This Tracing Ploted From Aerial Photo
Ink Drawing - Showing Vacations
Sec. 25 & 26 Previous Tracing Showing R/W To Scale
Sub-Division Information shown on Previous Tracing

Road Papers: Name File No.

Guemes Is. 543
Notes 36/310.

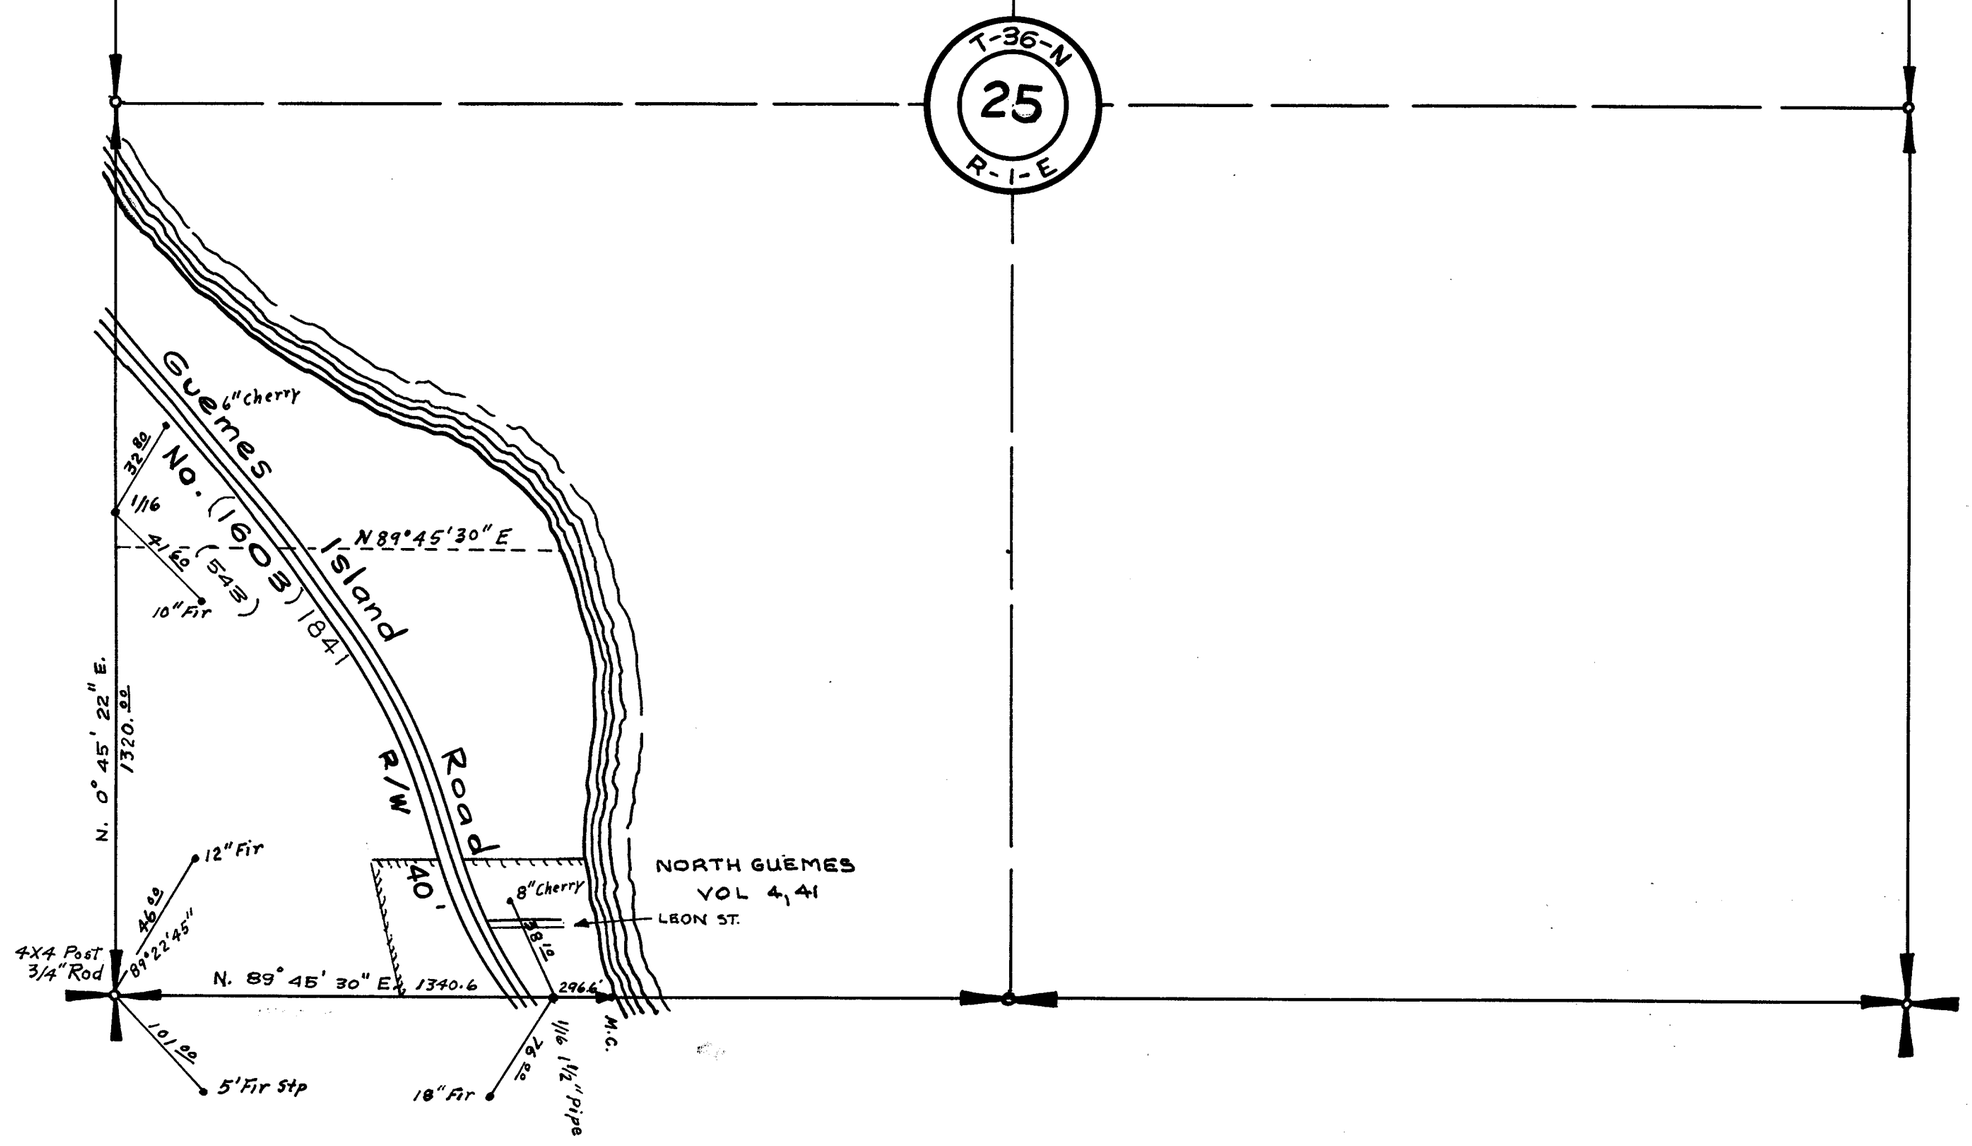

SECTION 25 & 26


TOWNSHIP 36 NORTH, RANGE 1 EAST, W. M.

SKAGIT COUNTY, WASH.

SCALE. 1 INCH--400 FEET

R.E.L. Knapp
Notes 36-310
COUNTY ENGINEER

West Shore Rd. No. 327 & Guemes Island Rd. No. 543
July 1958

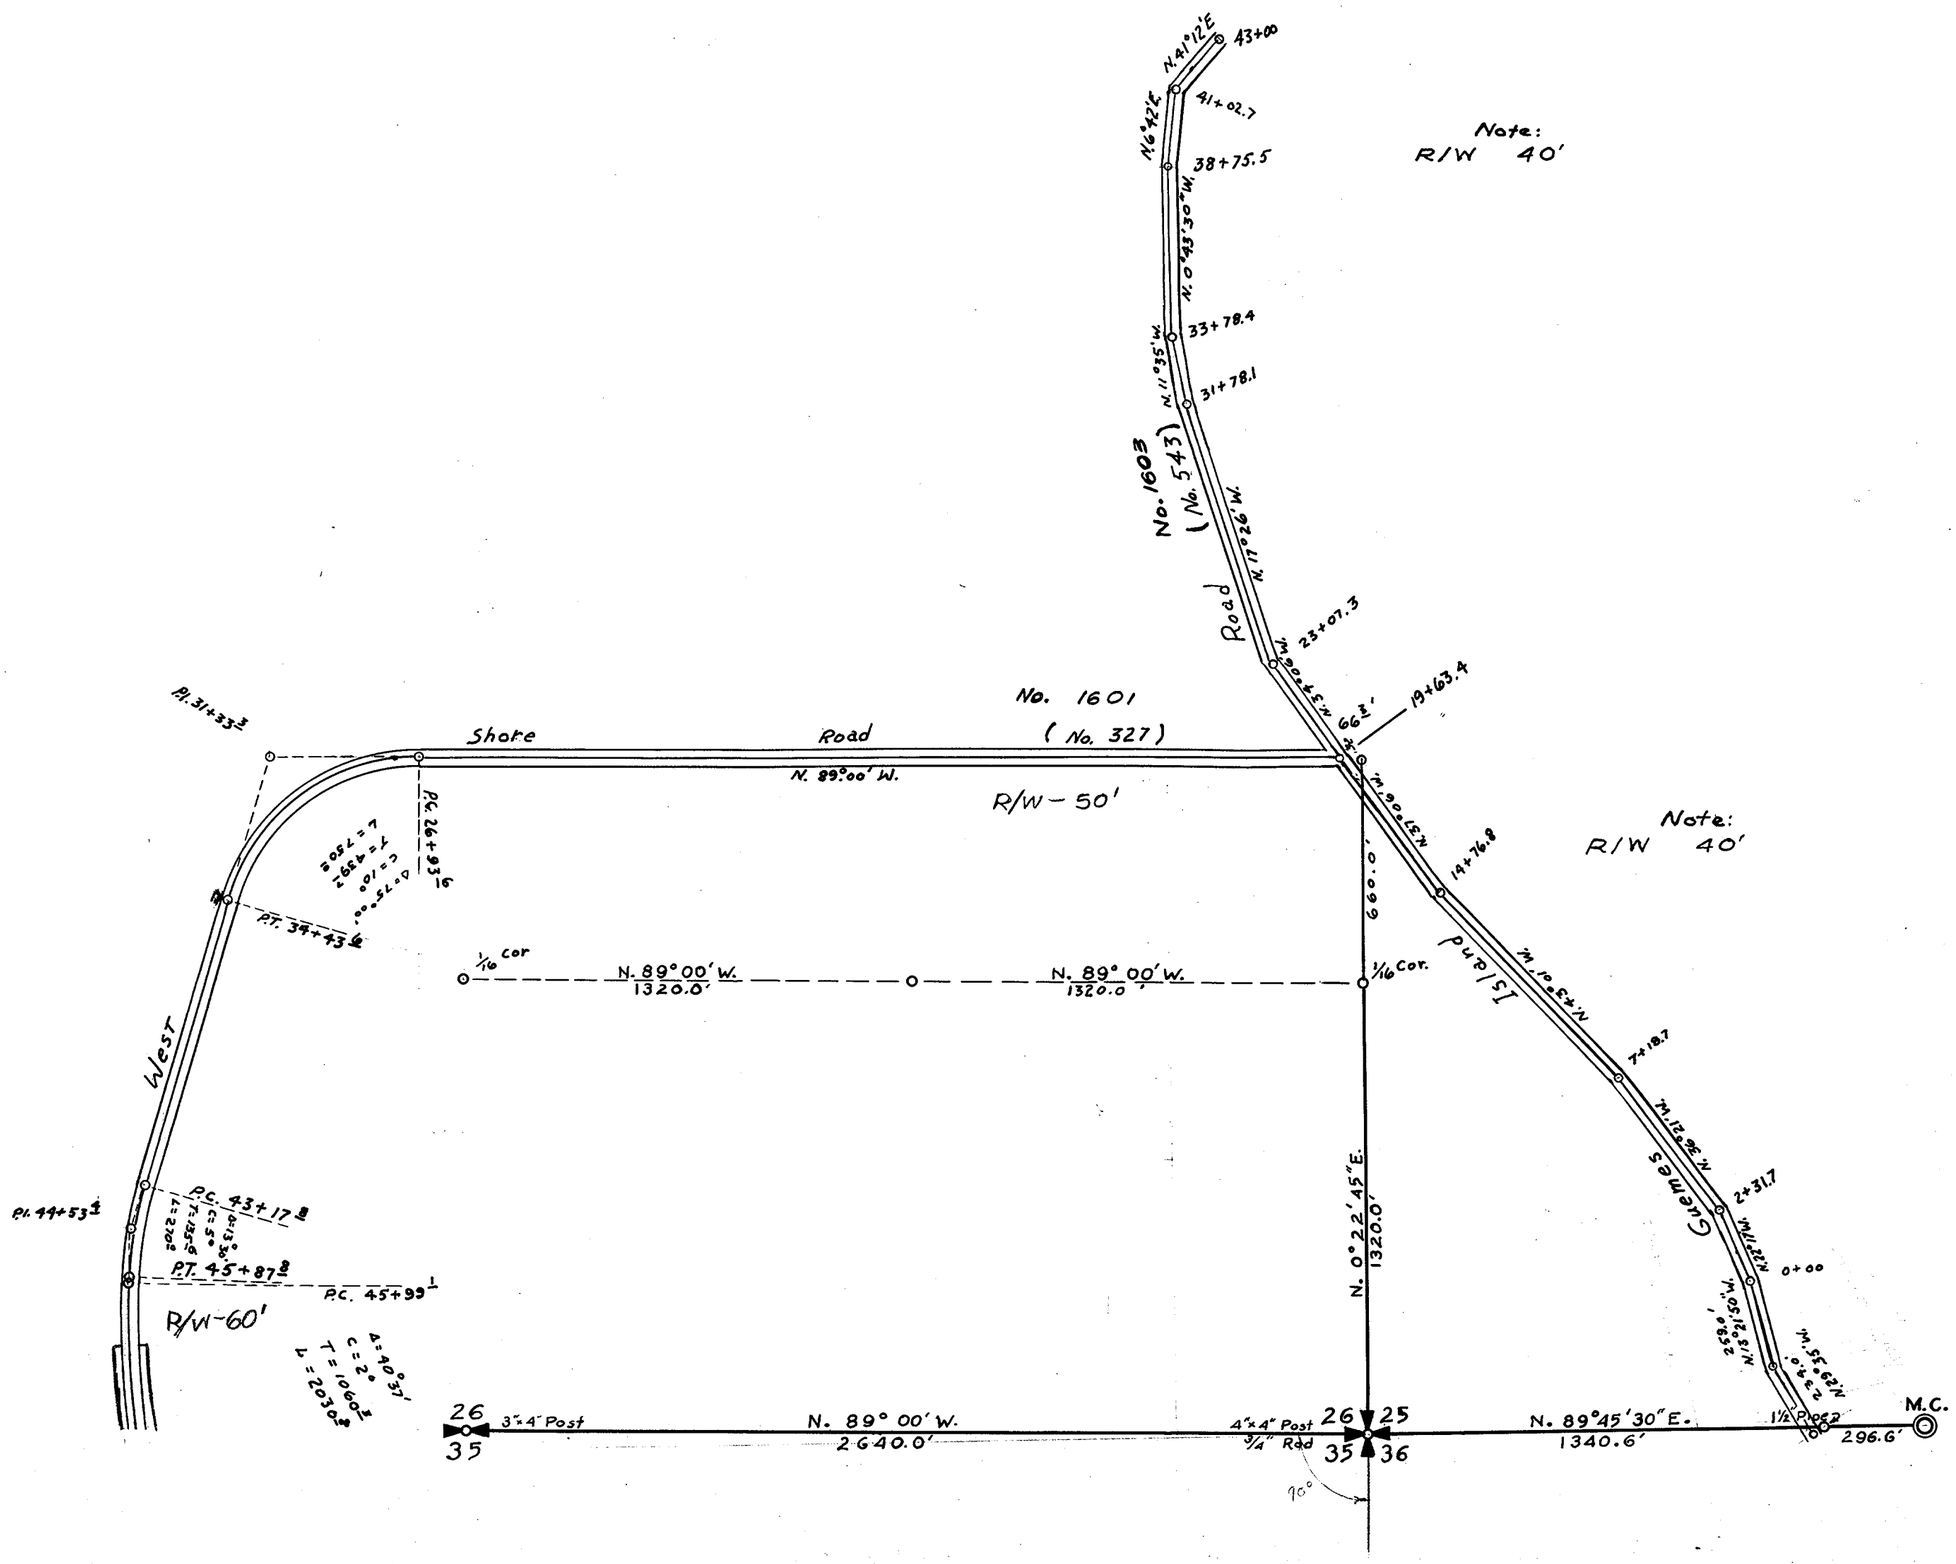

SECTION 26

TOWNSHIP 36 NORTH, RANGE 1 EAST, W. M.

SKAGIT COUNTY, WASH.

SCALE, 1 INCH--400 FEET

DATE August, 1965

Lloyd Johnson COUNTY ENGINEER

Road Papers: Name File No.

Guemes Is. W. Shore 543

Gen. Notations:

This tracing made from aerial photo.

Sub-division infor. taken from previous tracing

Guemes Island

Guemes Island Road (543) No. 1841 No. (1603)

T-36-N 26 R-1-E

Shore Road No. (1601) 1751

R/W (40') 50' (540) (327)

West

R/W - 60'

16" Hem 40 deg

40 deg 18" Fir

N 89° 00' W 1320.0

18" Willow 70 deg

39 deg 5' Cedar Stp.

1320.0

6" Cherry 32 deg 20

41 deg 10" Fir

N. 0° 22' 45" E. 1320.0'

Notes: C-63 - 1926

36/310 - 1937

37/327 - 1937

10" Alder 40.5

3"x4" Post

N. 89° 00' W. 2640.0'

4"x4" Post

3/4" Rod

46 deg 00 12" Fir

101 deg 5' Fir Stp.


SECTION 26

TOWNSHIP 36 NORTH, RANGE 1 EAST, W. M.

SKAGIT COUNTY, WASH.

SCALE, 1 INCH--400 FEET

DATE _____ _____ COUNTY ENGINEER

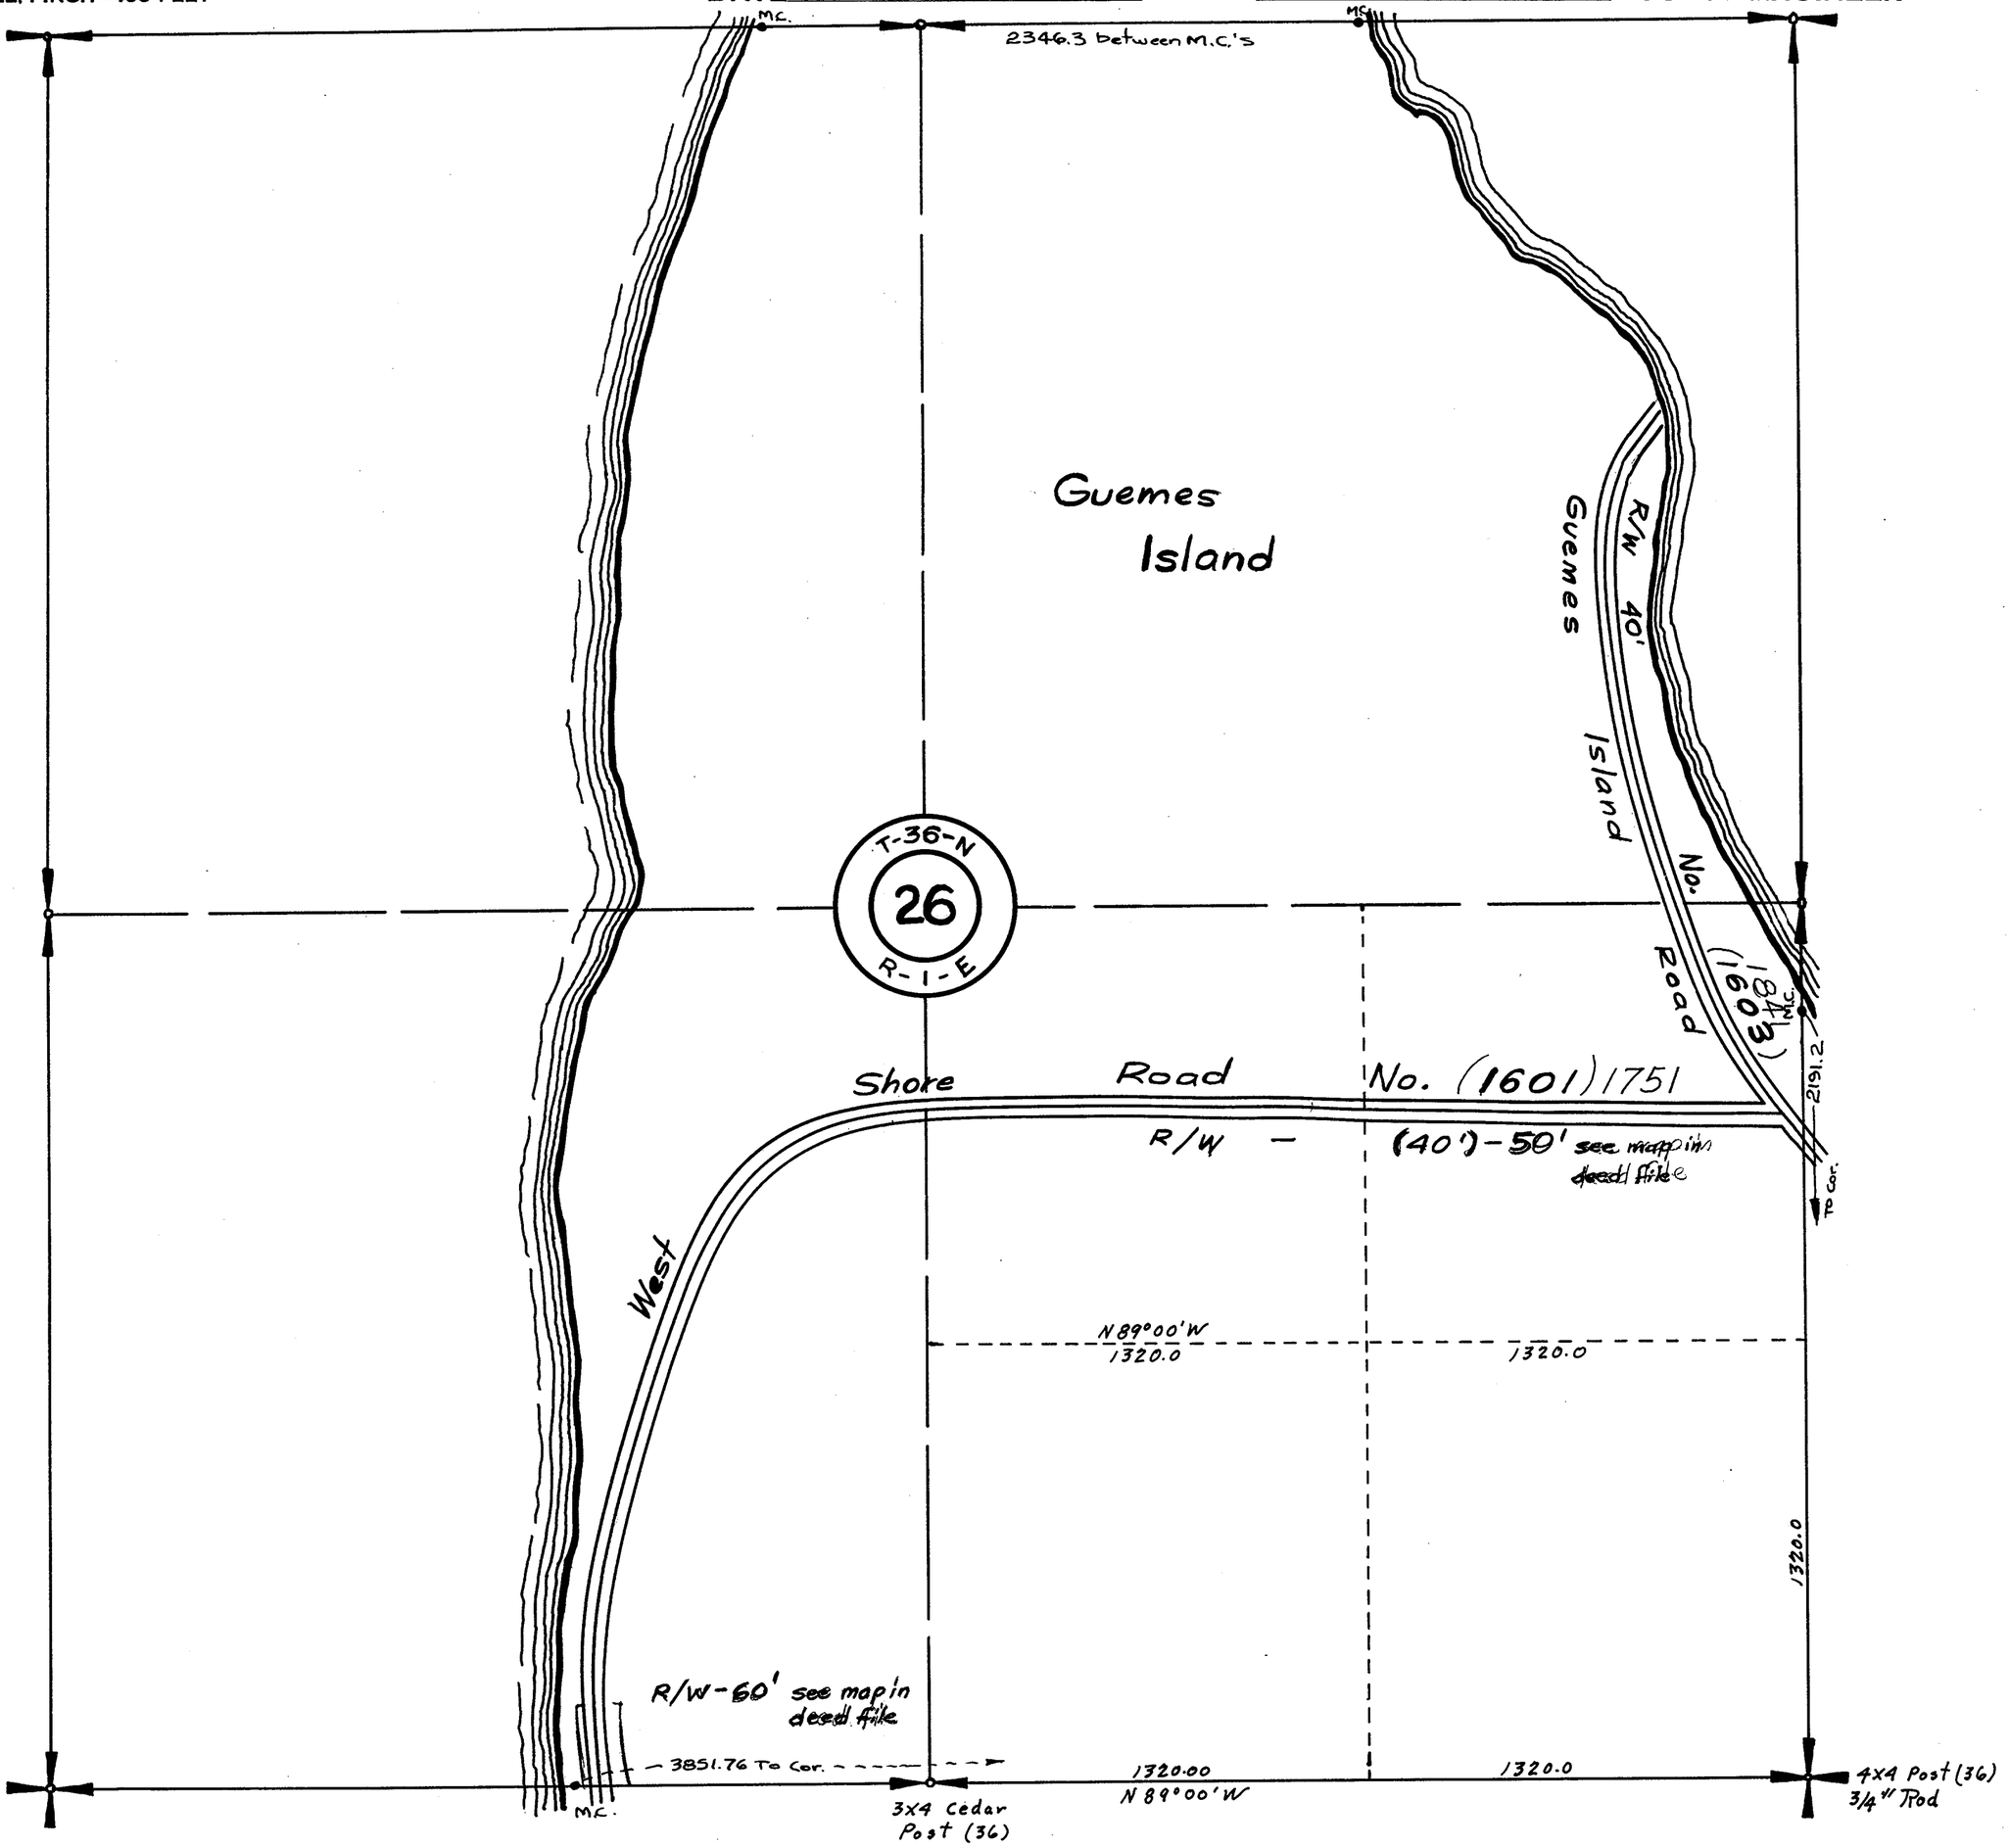

Sub div. by H.P. Rader


SECTION 31

TOWNSHIP 36 NORTH. RANGE 1 EAST. W. M.
SKAGIT COUNTY. WASH.

SCALE. 1 INCH—400 FEET

LLOYD H. JOHNSON COUNTY ENGINEER

DATE July 7, 1972

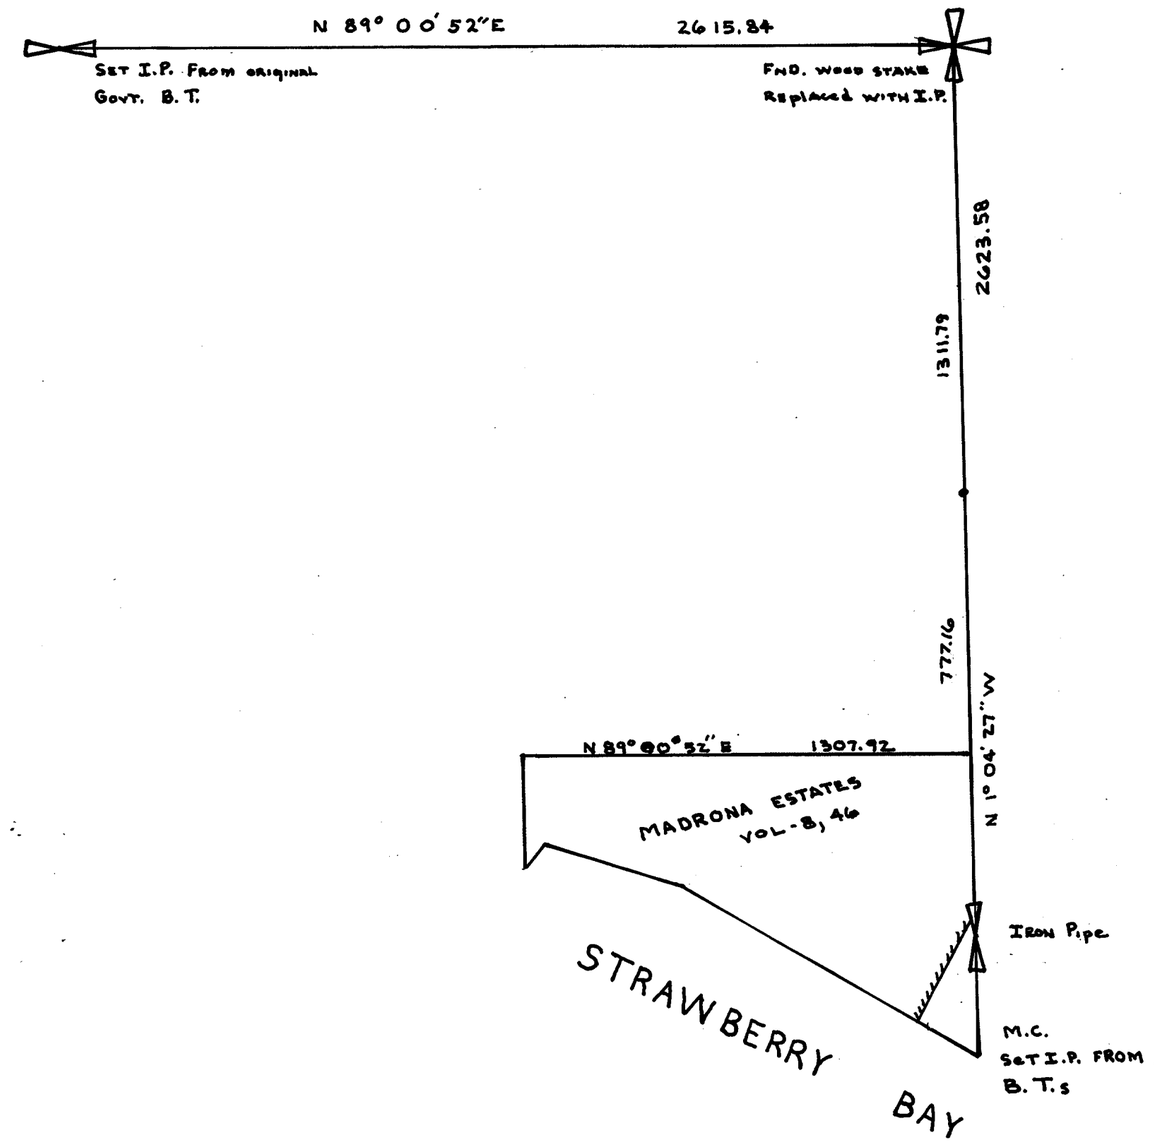

Surveyed Jan. 1939 by Thiret
Calc. " " " AH
Platted: " " " "
Notes: 37/327


SECTION 35

TOWNSHIP 36 NORTH, RANGE 1 EAST, W. M.

SKAGIT COUNTY, WASH.

SCALE, 1 INCH--400 FEET

W. A. Costello COUNTY ENGINEER

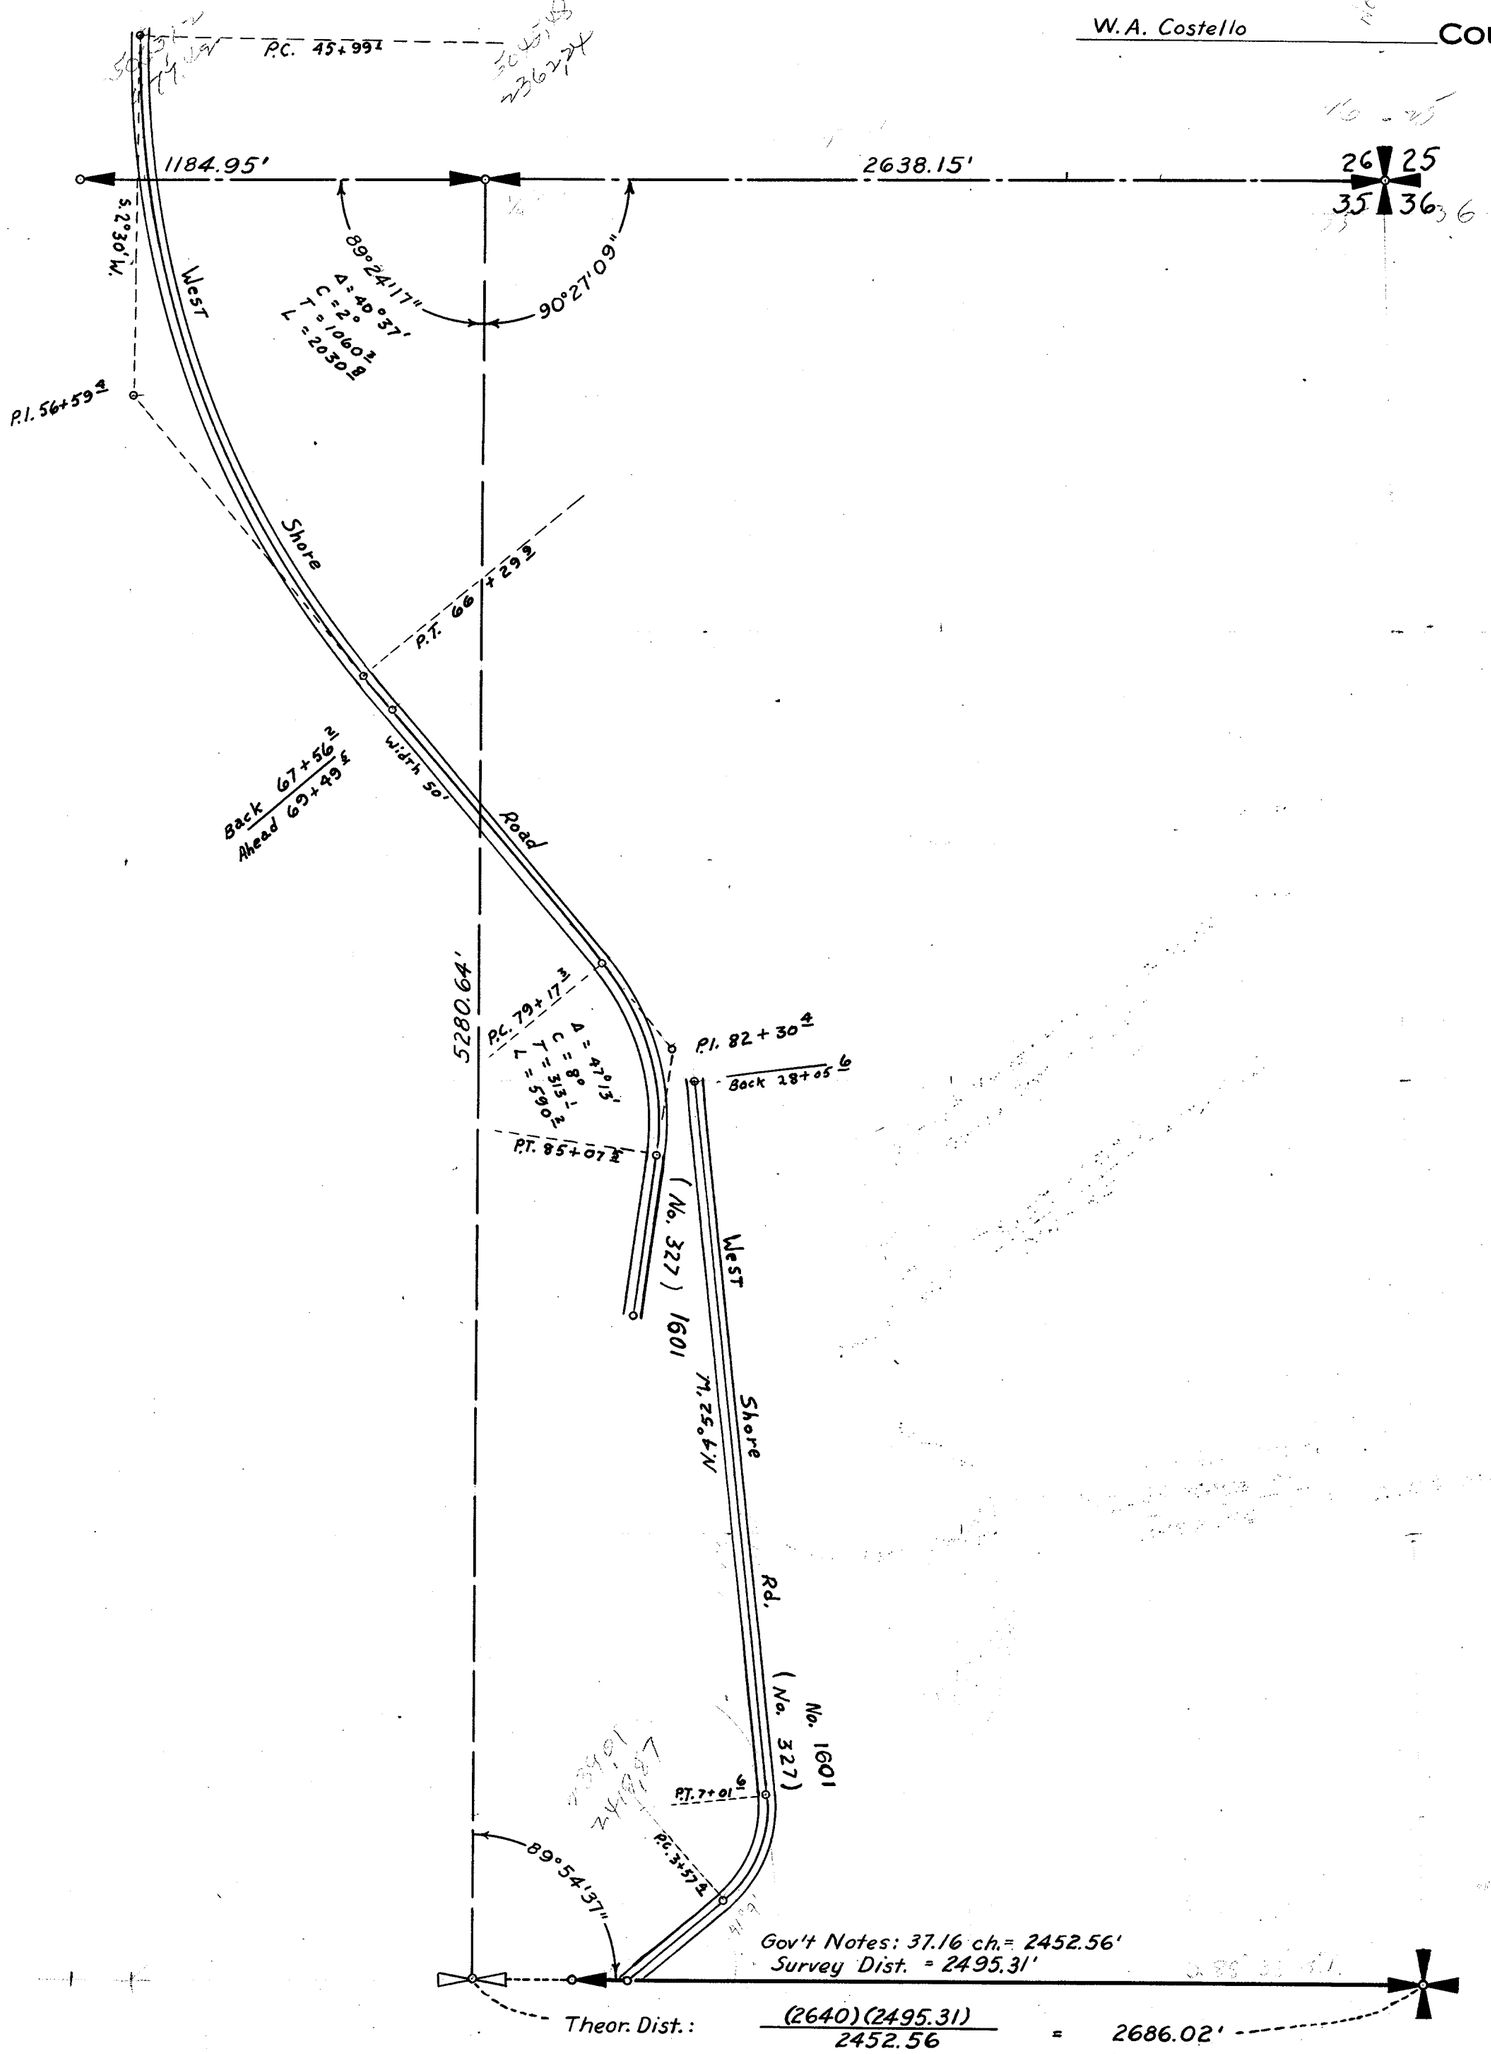

SECTION 35


TOWNSHIP 36 NORTH, RANGE 1 EAST, W. M.

SKAGIT COUNTY, WASH.

SCALE, 1 INCH--400 FEET

DATE August, 1965

Lloyd Johnson COUNTY ENGINEER

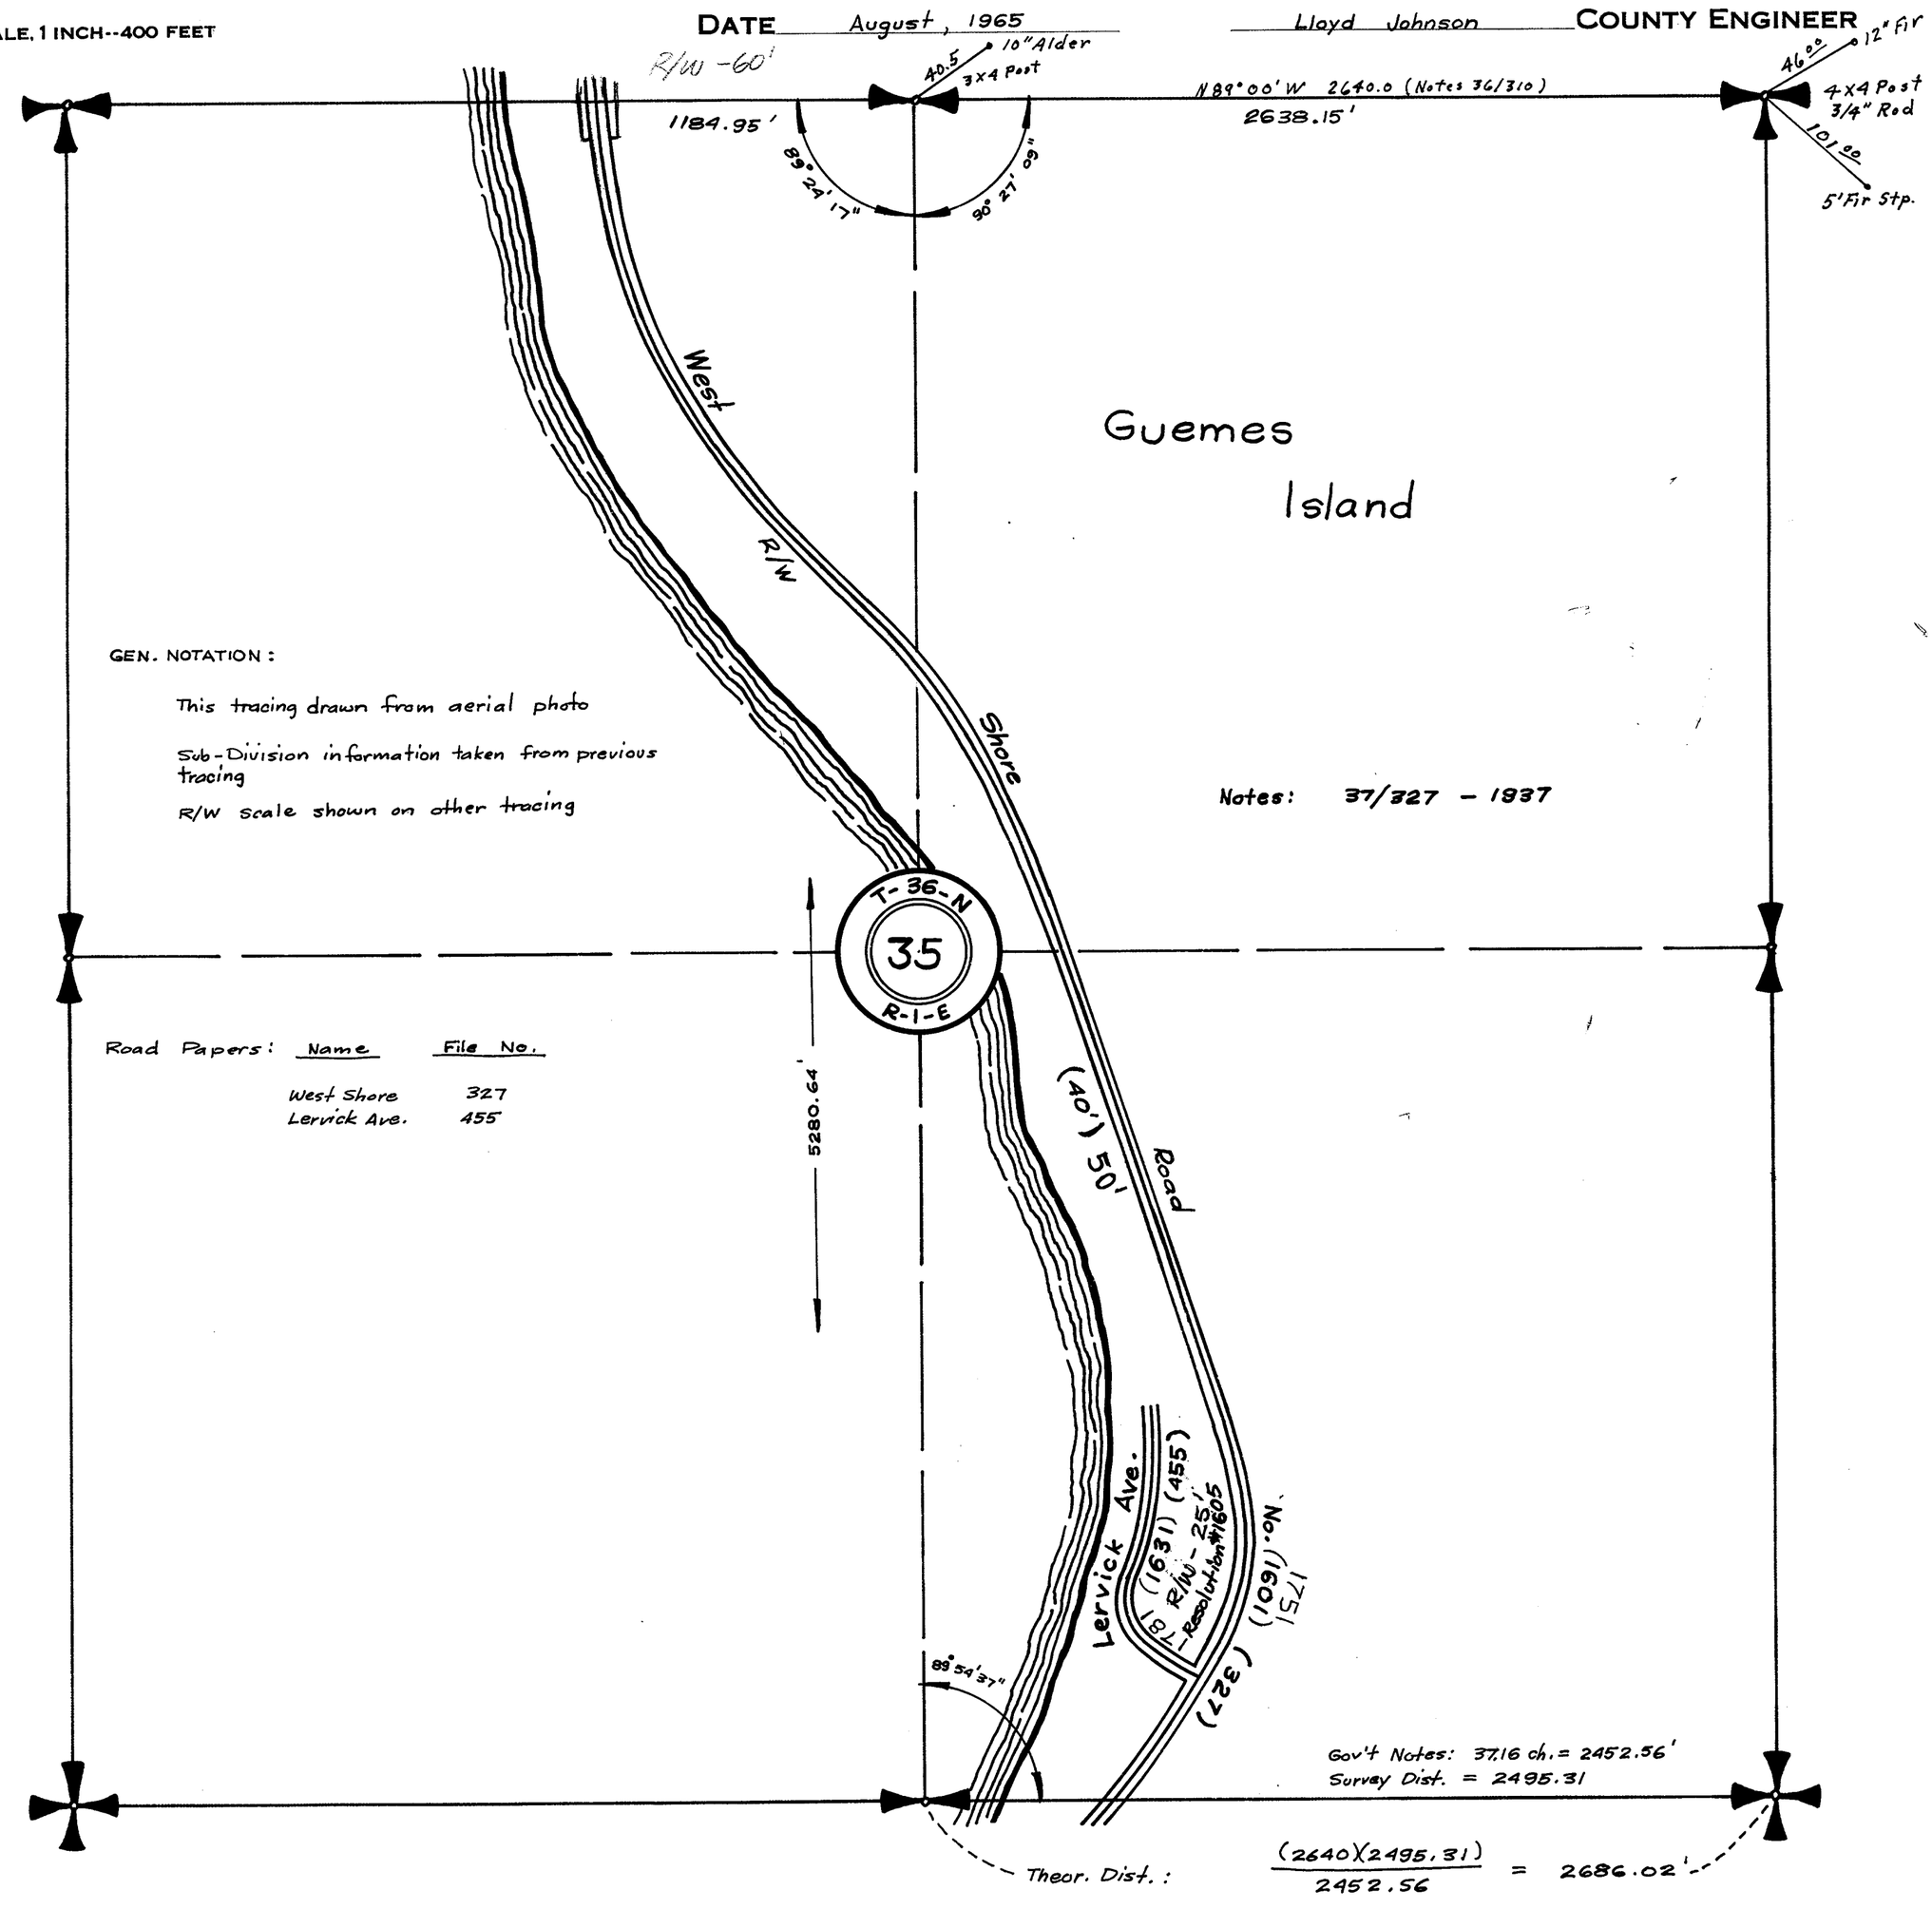

GEN. NOTATION :

This tracing drawn from aerial photo

Sub-Division information taken from previous tracing

R/W scale shown on other tracing

Notes: 37/327 - 1937

Road Papers:

Name	File No.
West Shore	327
Lervick Ave.	455

Gov't Notes: 37.16 ch. = 2452.56'
Survey Dist. = 2495.31

Theor. Dist. : $\frac{(2640)(2495.31)}{2452.56} = 2686.02'$

SECTION 35


TOWNSHIP 36 NORTH, RANGE 1 EAST, W. M.

SKAGIT COUNTY, WASH.

SCALE, 1 INCH--400 FEET

DATE June 28, 1972

LLOYD H. JOHNSON COUNTY ENGINEER

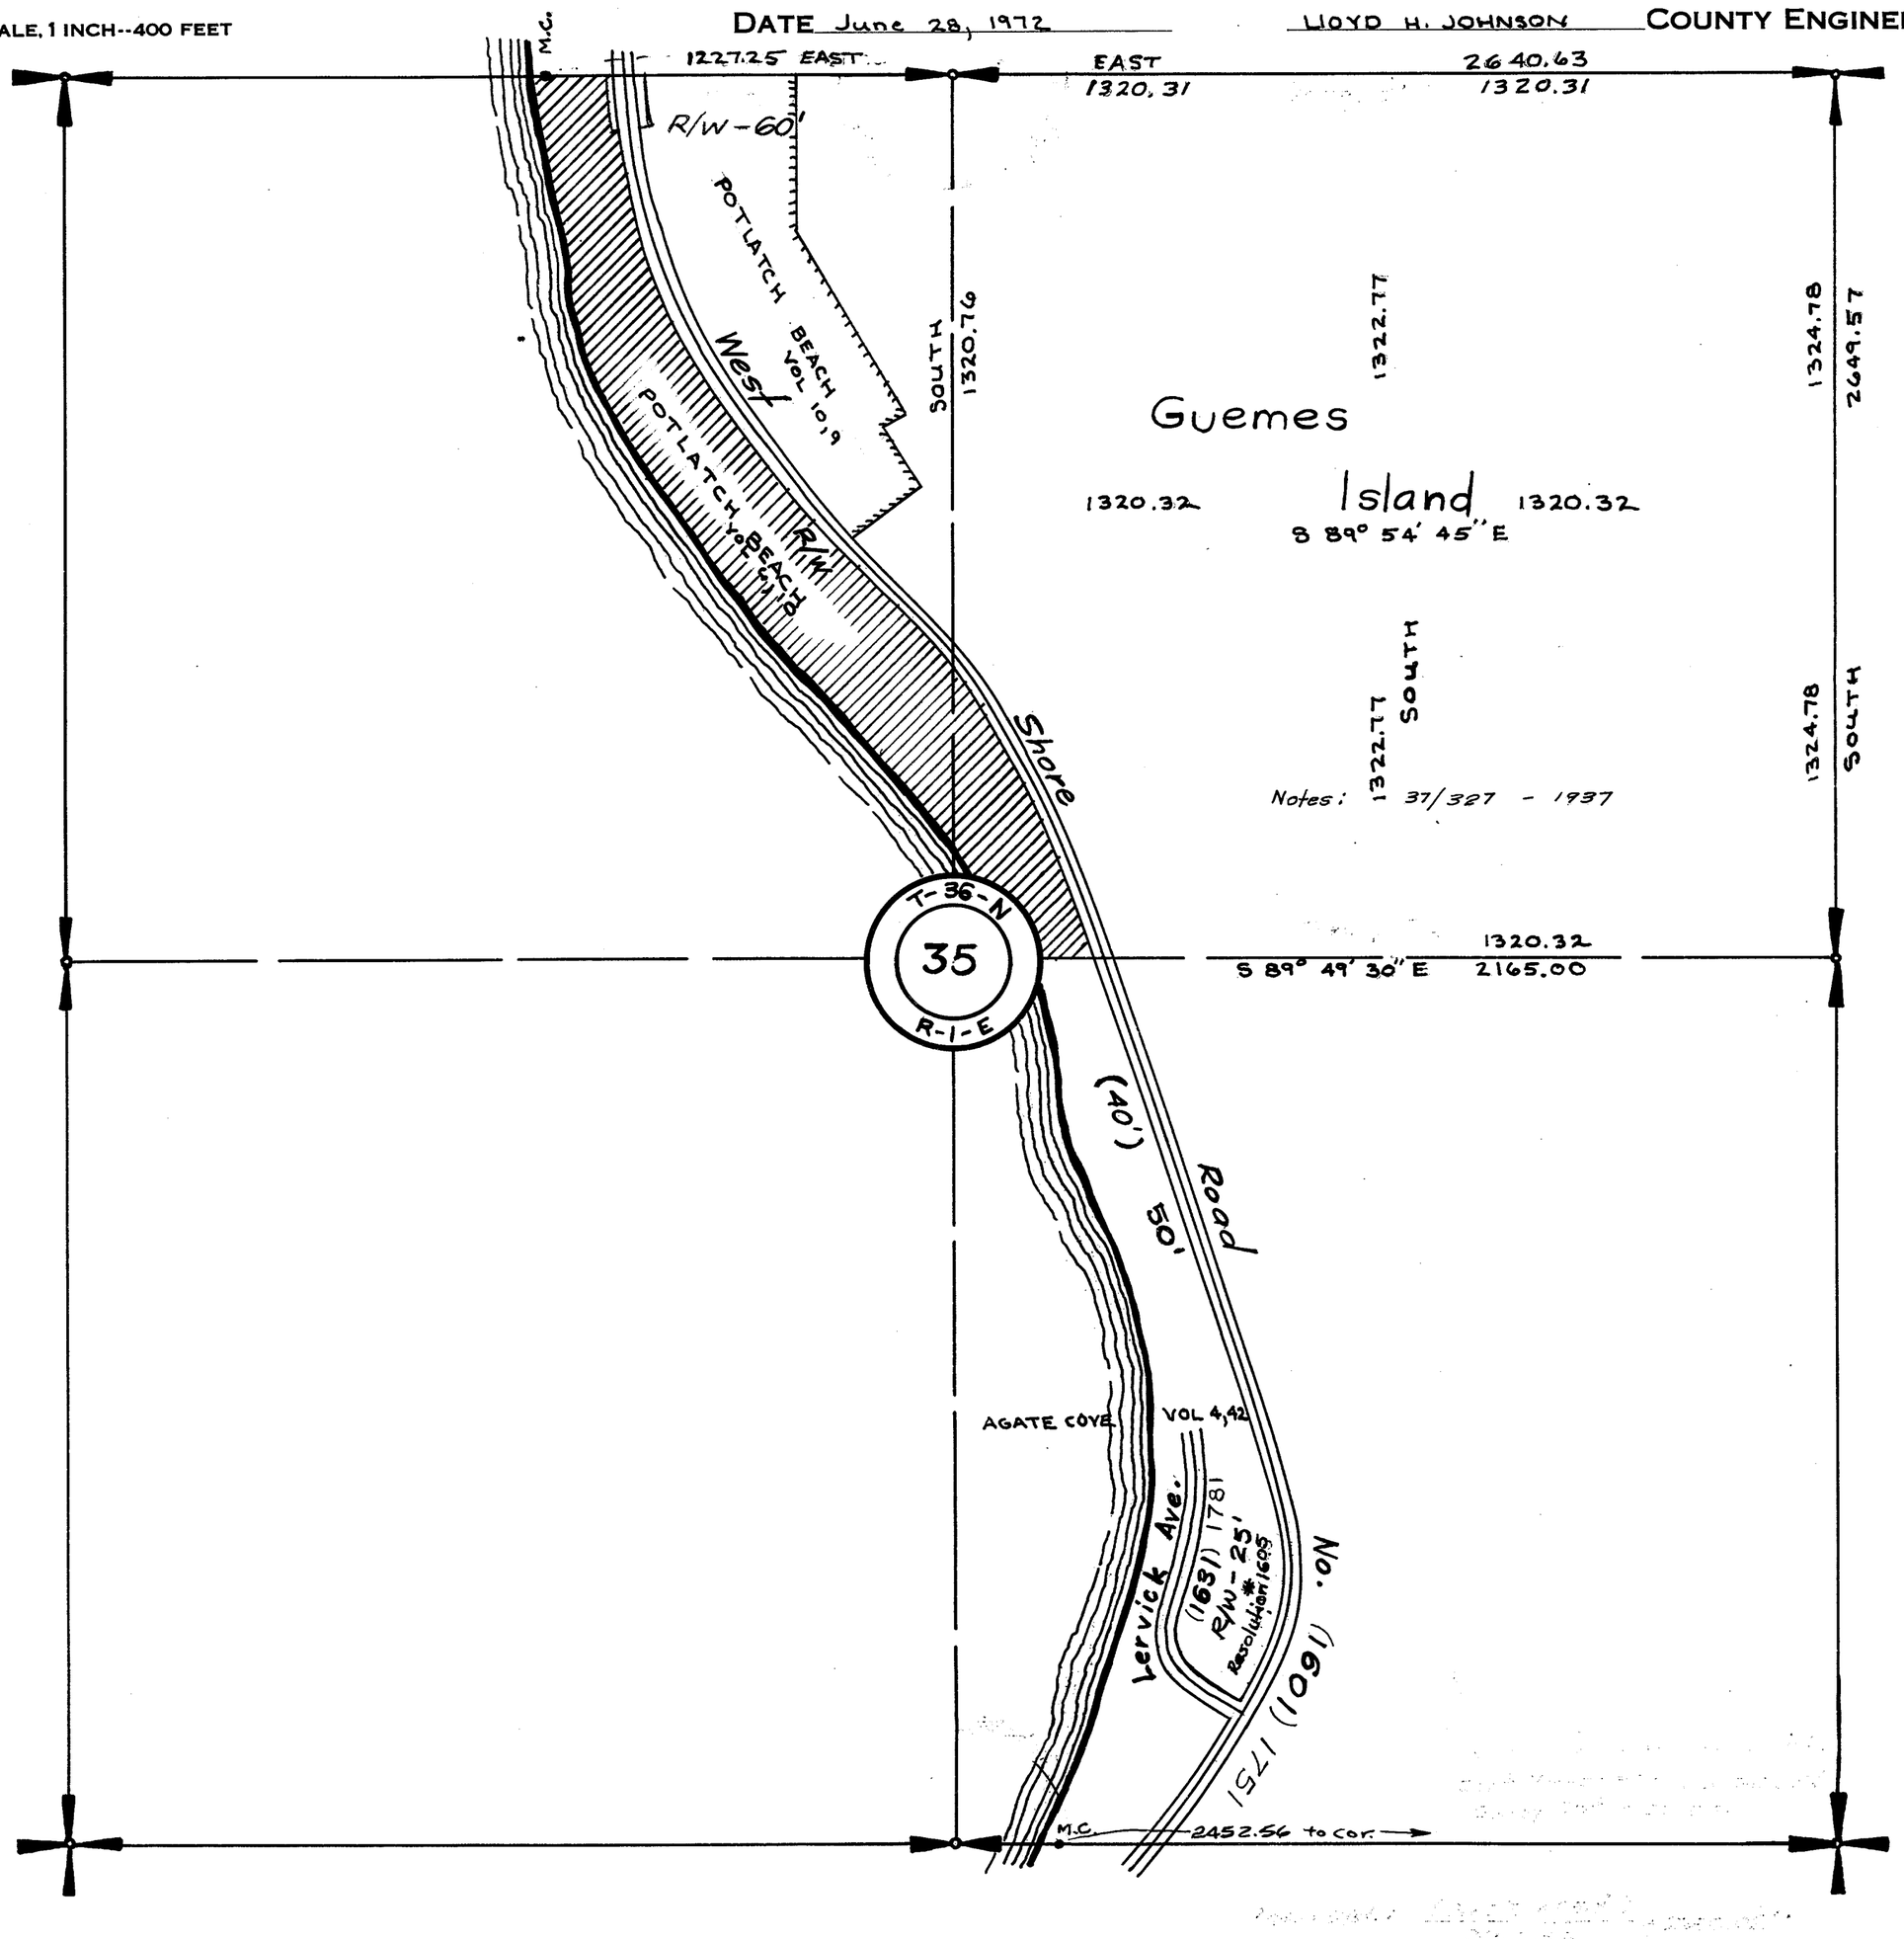


SECTION 36

TOWNSHIP 36 NORTH, RANGE 1 EAST, W. M.

SKAGIT COUNTY, WASH.

SCALE, 1 INCH--400 FEET

G. D. LeGro
July 1958
COUNTY ENGINEER

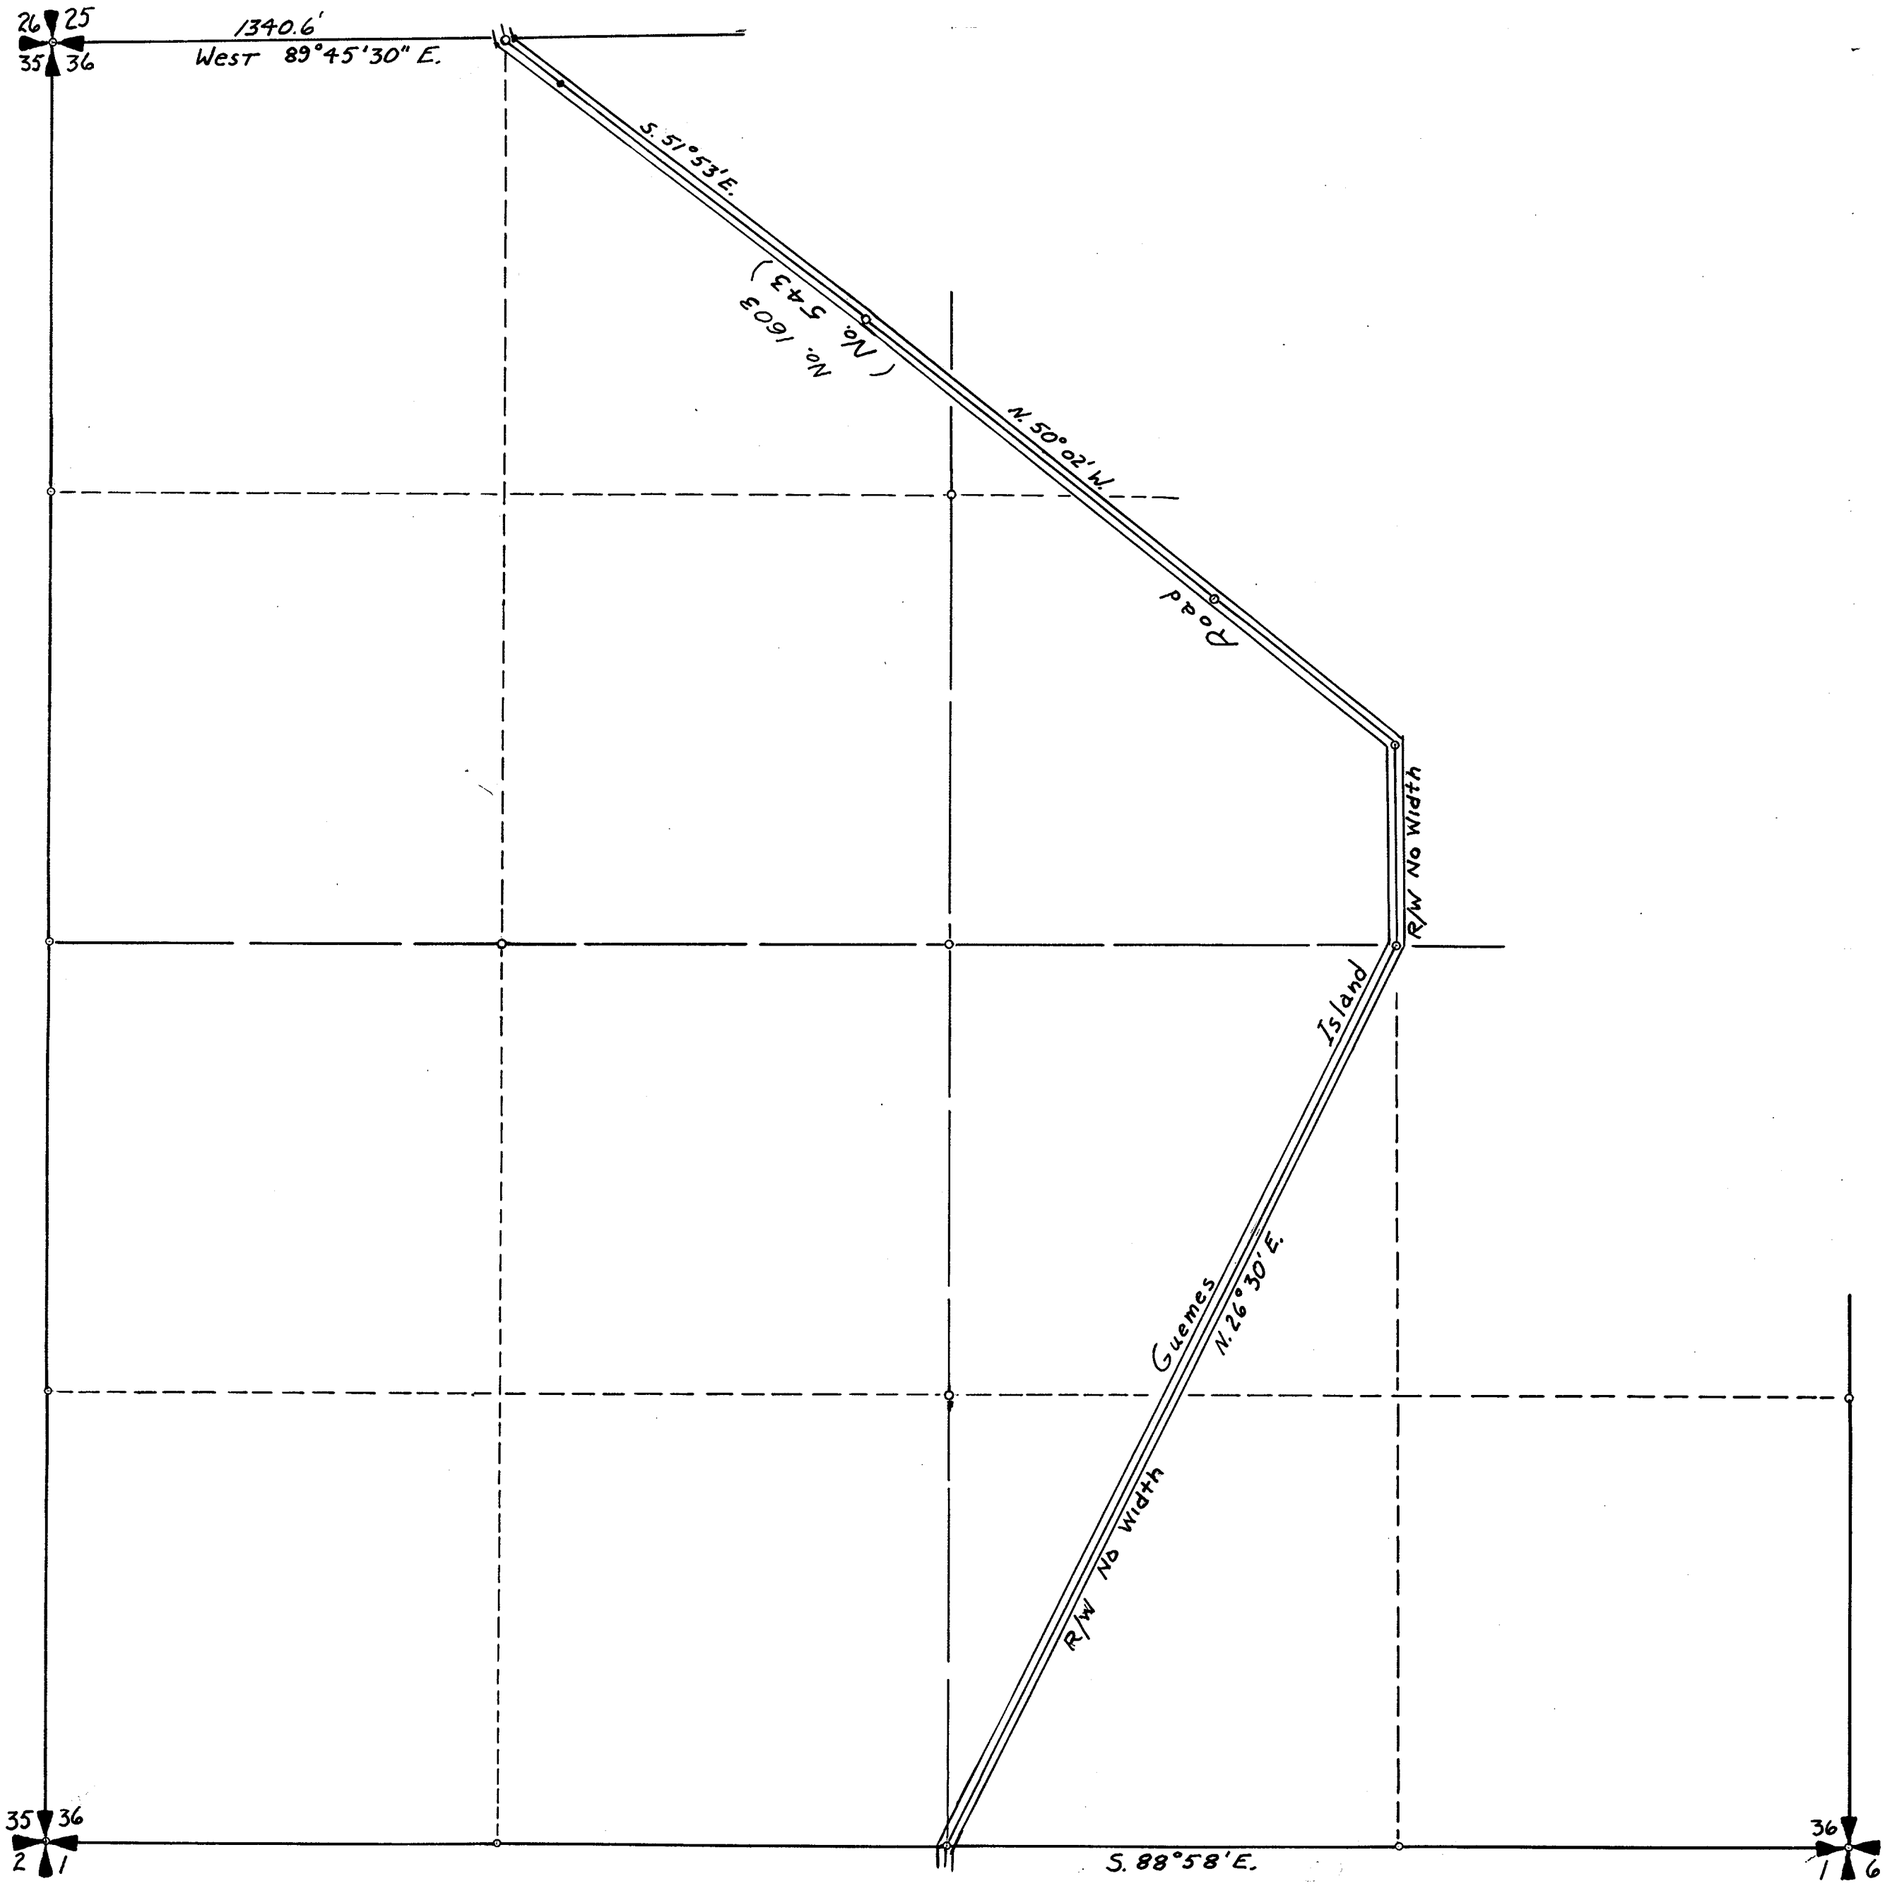


SECTION 36

TOWNSHIP 36 NORTH, RANGE 1 EAST, W. M.

SKAGIT COUNTY, WASH.

SCALE, 1 INCH--400 FEET

DATE August, 1965 Lloyd Johnson COUNTY ENGINEER

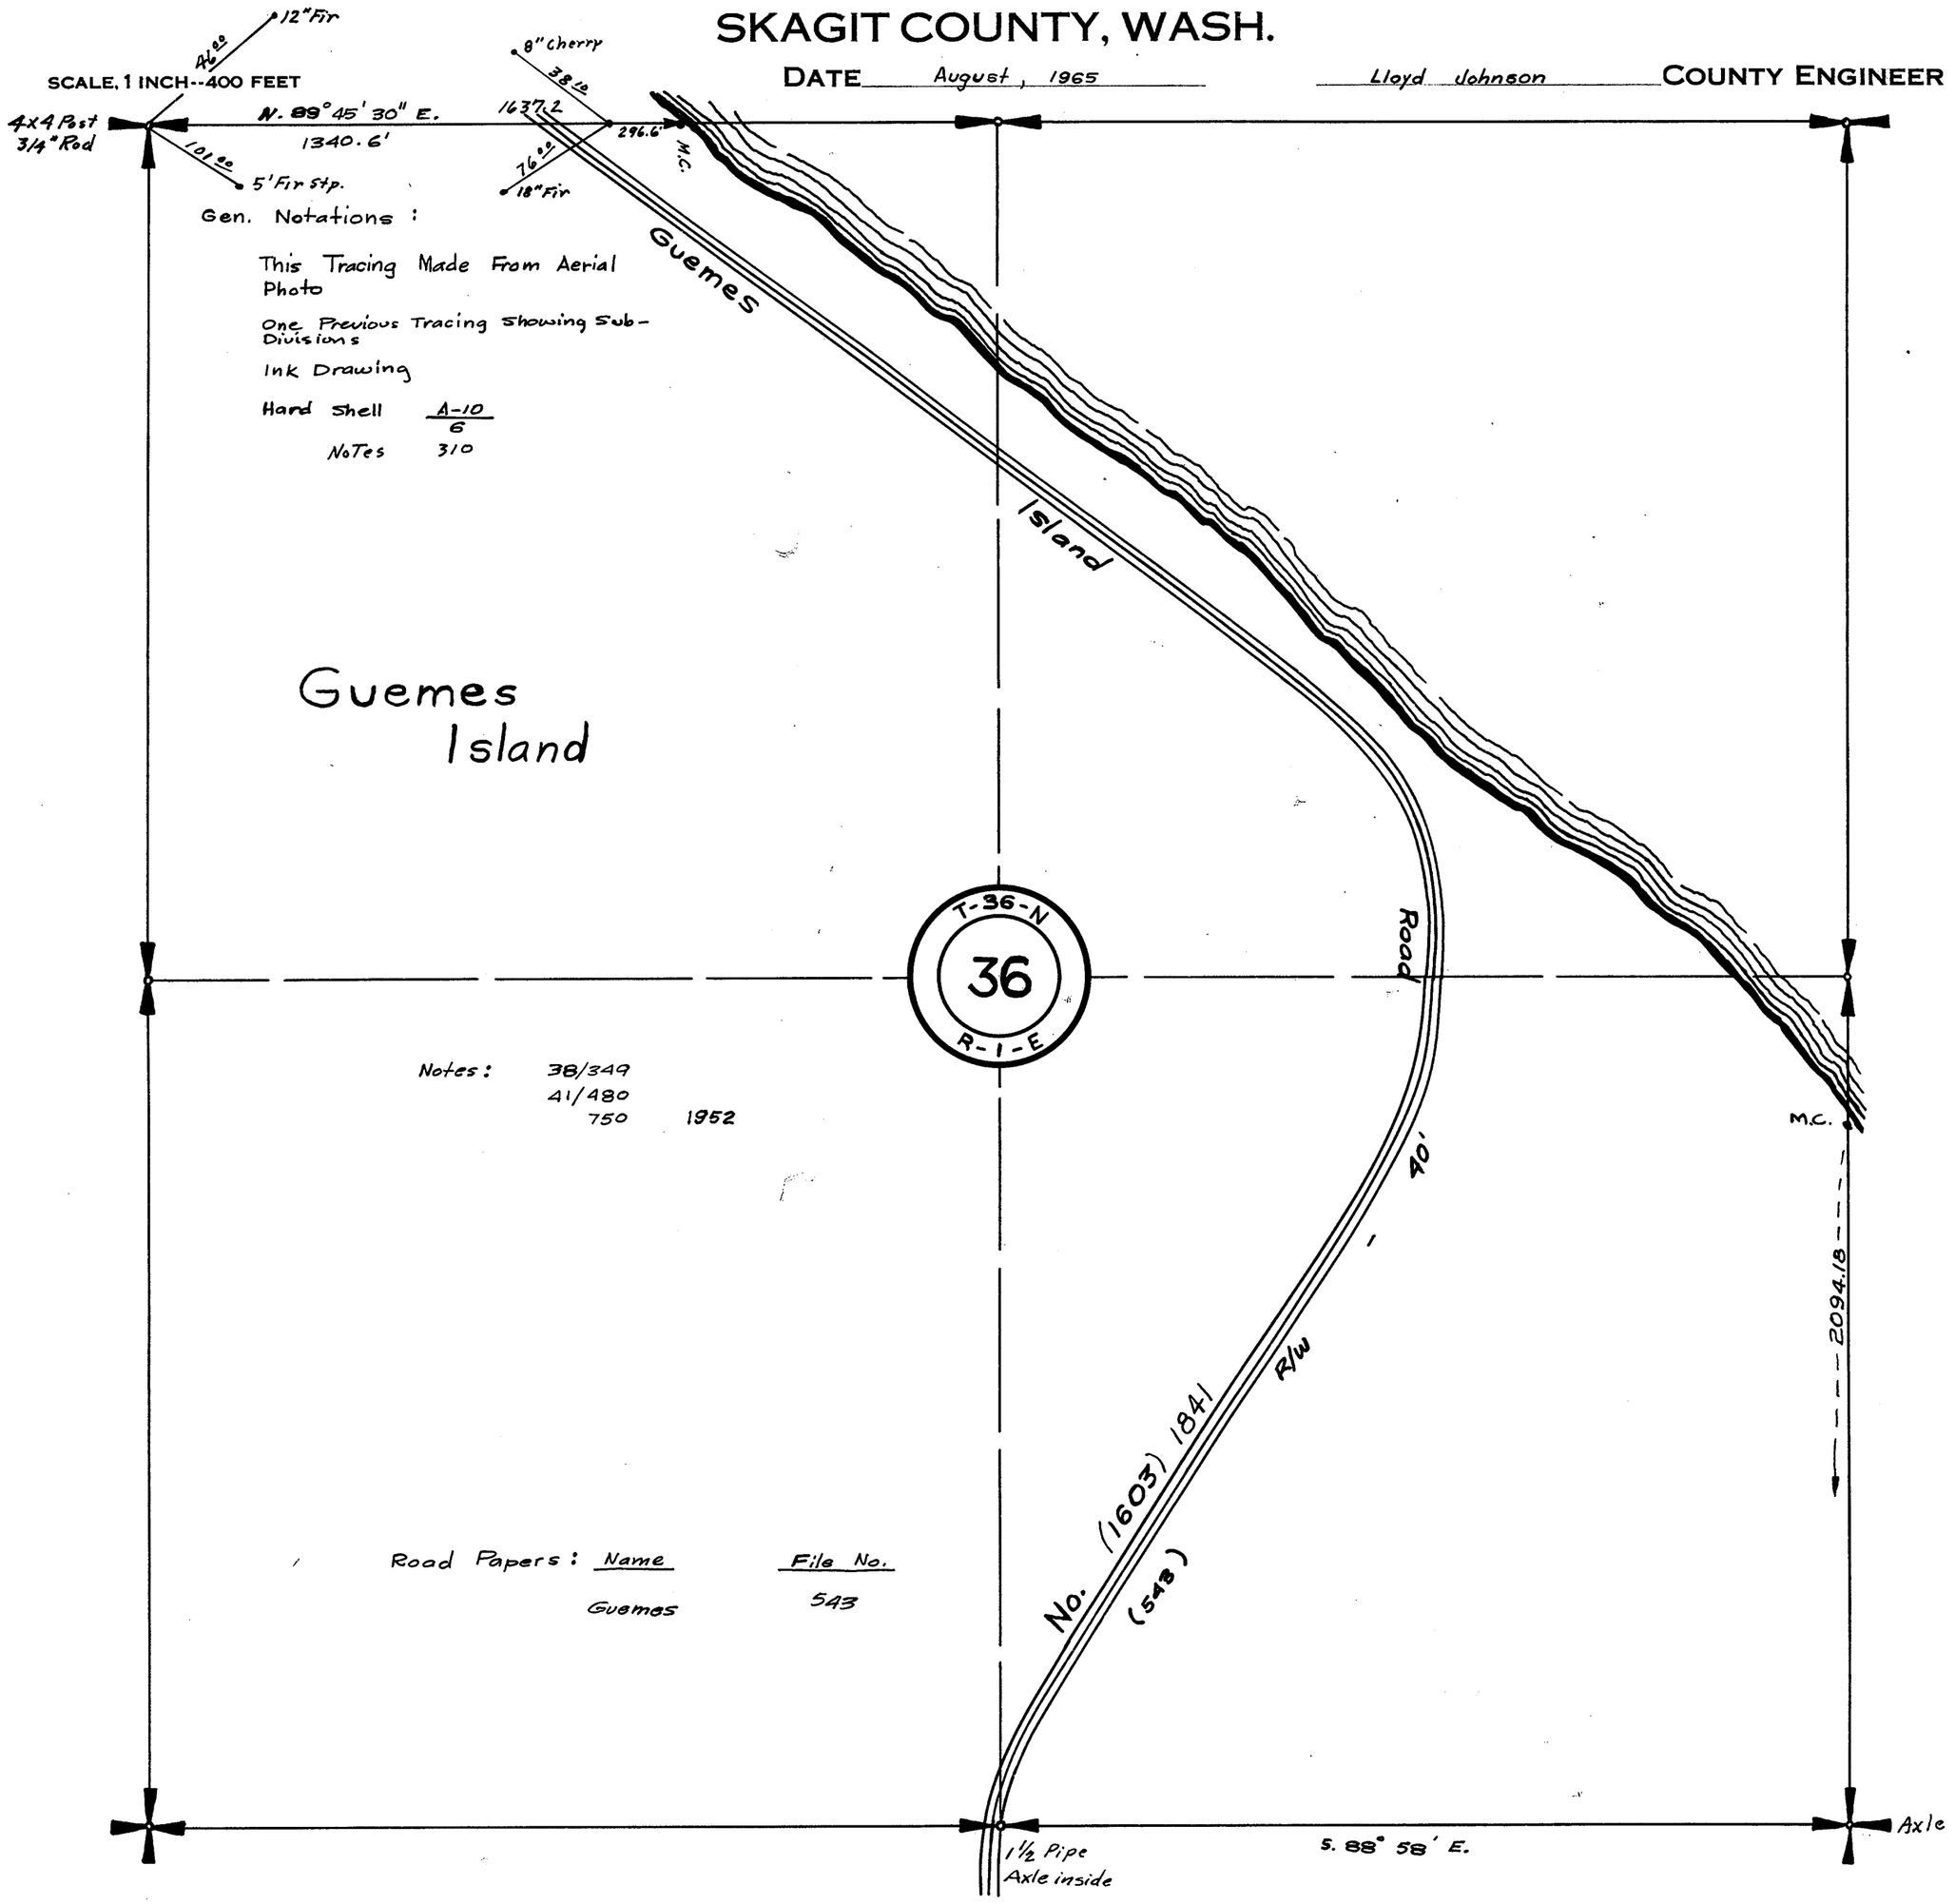

Gen. Notations :

This Tracing Made From Aerial Photo

One Previous Tracing Showing Sub-Divisions

Ink Drawing

Hard Shell A-10/6

Notes 310

Guemes Island

Notes: 38/349
41/480
750 1952

Road Papers:

Name	File No.
Guemes	543


SECTION 36

TOWNSHIP 36 NORTH. RANGE 1 EAST. W. M.
SKAGIT COUNTY. WASH.

SCALE. 1 INCH—400 FEET

LLOYD H. JOHNSON COUNTY ENGINEER

DATE July 31, 1972

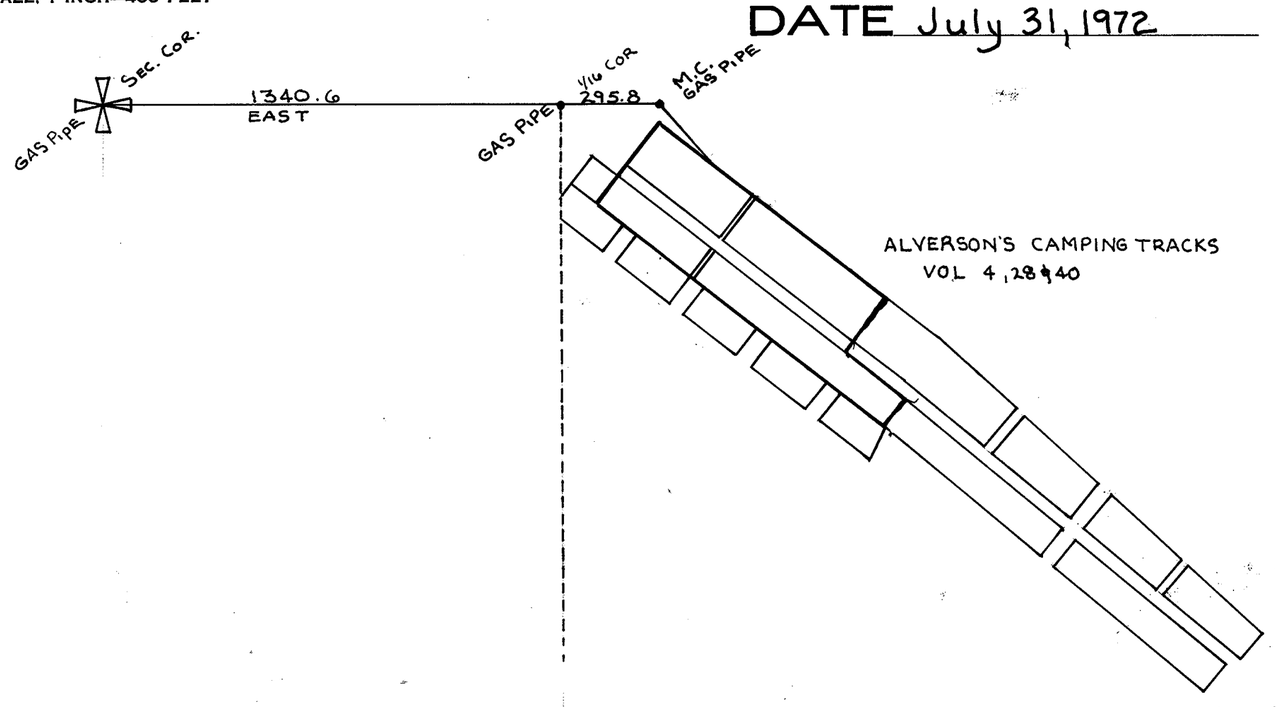

SECTION 25

TOWNSHIP 36 NORTH, RANGE 2 EAST, W. M.

SKAGIT COUNTY, WASH.

SCALE, 1 INCH--400 FEET

DATE August, 1965

Lloyd Johnson COUNTY ENGINEER

T-36-N
25
R-2-E

GEN. NOTATION:

THIS TRACING TAKEN FROM AERIAL PHOTO

* INK DRAWING
* PHOTO-COPY OF TRACT

Road Papers:

Name	File No.
Roney	295
Pike	324
Hayton	347

Notes: G-197 2/9/31

38/341

41/492

R/W - Checked with deeds 6/16/69

MC

Lot(2)

Lot(1)

R/W 47.06'

2½" Pipe on beach

31.90

P. Pole (1940)

118.0'

Tel. P. (90)

R/W 47' & 50'

(347)

R/W 50'

(Hayton Blue Heron Rd. No. 3841 Road)

No. (1610) 40' 100'

N 01°18'35" E 1163.05 (1940)

1156.4'

1163.05

401

R/W-(30')

Harold R. Roney

(1613) 3061 -(295

(63) T. Pole

(63) P. Pole

52.65

46.35

(1615) Road

(Pike Road.) (324) R/W-30'

28.92

3/4" Pipe

59.15

P. Pole

Samish Island

N 88°57'E 2639.6'

Blue Heron Rd. No. 3841

673.10'


MC

SECTION 26

TOWNSHIP 36 NORTH, RANGE 2 EAST, W. M.
SKAGIT COUNTY, WASH.

SCALE, 1 INCH-400 FEET
Notes: H 210

Robt. E. L. Knapp COUNTY ENGINEER
Jan. 1932.

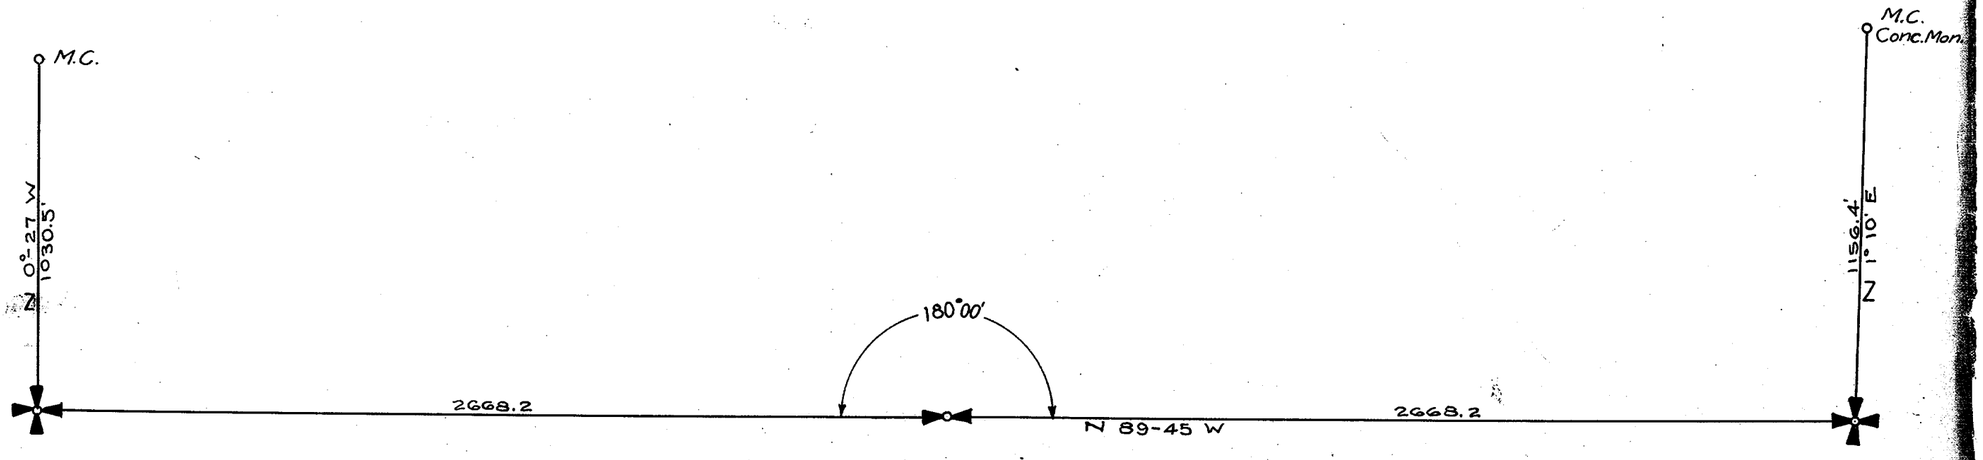

SECTION 26

TOWNSHIP 36 NORTH, RANGE 2 EAST, W. M.

SKAGIT COUNTY, WASH.

SCALE, 1 INCH--400 FEET

DATE August, 1965

Lloyd Johnson COUNTY ENGINEER

GEN. NOTATION. THIS TRACING MADE FROM AERIAL PHOTO
SUB-DIVISION INFORMATION TAKEN FROM PREVIOUS TRACING
* OLD INK DRAWING SHOWING VACATIONS OF R/W
* OLD TRACING SHOWING SUB-DIV. ONLY

Road Papers:

Name.	File No.
Halloran	331
Roney	295
Samish Terrace	571
Wallen	
Mercer	470

T-36-N
26
R-2-E

Notes:
H-210 - 4/15/31, 2/12/63
E-118 - 6/19/28
41/492 -

Samish Island

M.C
Conc. Mon.
2½" pipe (1940)
118.0'
T. Pole 1940
31.90
P. Pole (90)
N 1°18'35" E 1163.05 (1940)
N. 1° 10' E.
1156.4'

Plat- Vol. 7 Page 20
Harold R. Roney Road
No. (1613) 3061 (295) R/W-(30') 40'
Samish Terrace R/W-40'
Rd.
Plat- Vol. 7 Page 20
(1611) (571) 3906
(63) T. Pole
52.68
28.22
T. Pole (63)
3/4" Pipe (63)
4435
P. Pole (63)
59.15
P. Pole

M.C
(1612) 3810
N. 0°27' W. 1030.5' (1940)
18" Fir (47)
T. Pole (1963)
53.60
100.20
Conc. Mon. (47)
50.48
T. Pole (63)
53.60
T. Pole (47)
63.38
T. Pole (63)
63.38
50.30
T. Pole (47)
61.30
T Pole (47)
Cor. Post (63)

Wallen Road - 3032
No. (1634)(3930)
R/W - 50'
Samish Shores Plat
8" Alder (1940)
A1.20
4" x 25" Cedar Post MKT 1/4 (1940)
Mercer Road No. (1609) 303
R/W 30' (470)

2668.2 S89°51'W 2668.2

Halloran Road

N. 89 45 W.
589°51'W
5337.20 (1940)
(1963)
5338.7
A16.0°
30" Fir Stp (1940)
180°00'

No. (1612) (331) R/w - 40'
3810

SECTION 27

TOWNSHIP 36 NORTH, RANGE 2 EAST, W. M.

SKAGIT COUNTY, WASH.

SCALE, 1 INCH--400 FEET

DATE August, 1965 Lloyd Johnson COUNTY ENGINEER

GEN. NOTATION: THIS TRACING DRAWN FROM AERIAL PHOTO

* INK DRAWING SHOWING ESTABLISHMENTS & VACATIONS

FIELD NOTES: H-210 4/15/31 2/12/63


E-118 6/19/28

46/583

46/591

Road Papers:

Name	File No.
Samish Point	302
Marshall	469
Halloran	331

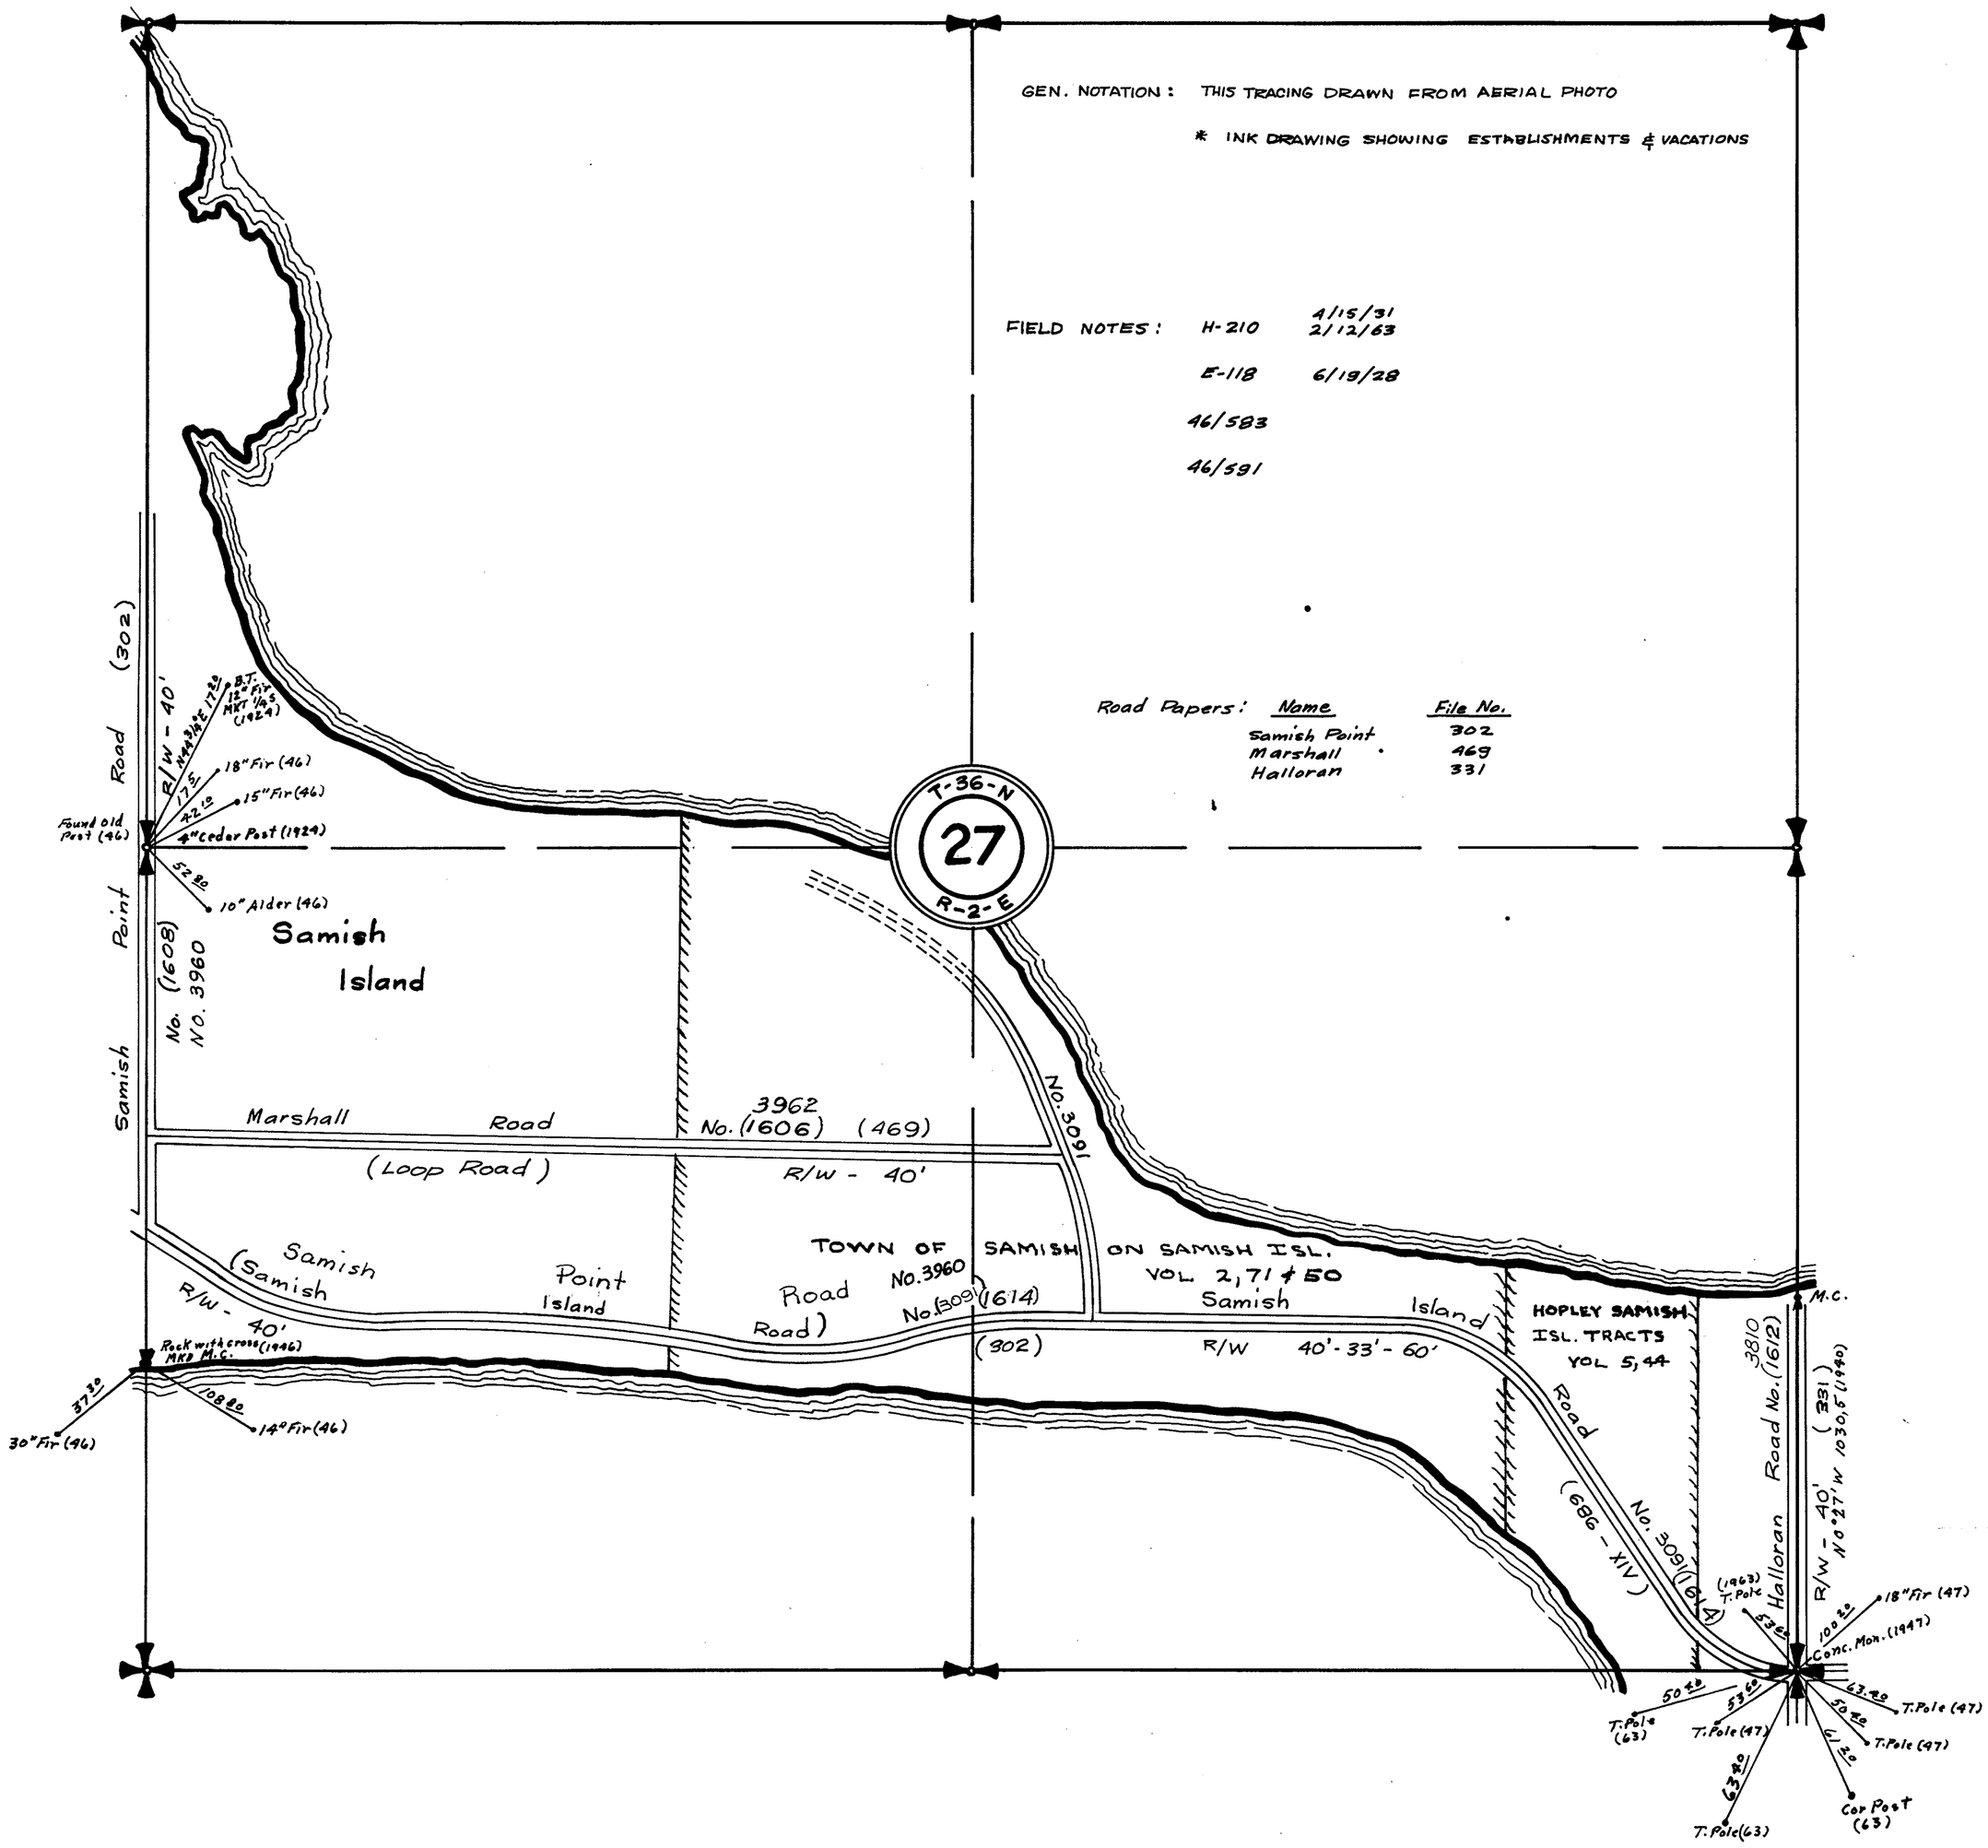

SECTION 31


TOWNSHIP 36 NORTH. RANGE 2 EAST. W. M.

SKAGIT COUNTY. WASH.

SCALE. 1 INCH—400 FEET

DATE Aug. 9, 1972

LLOYD H. JOHNSON COUNTY ENGINEER

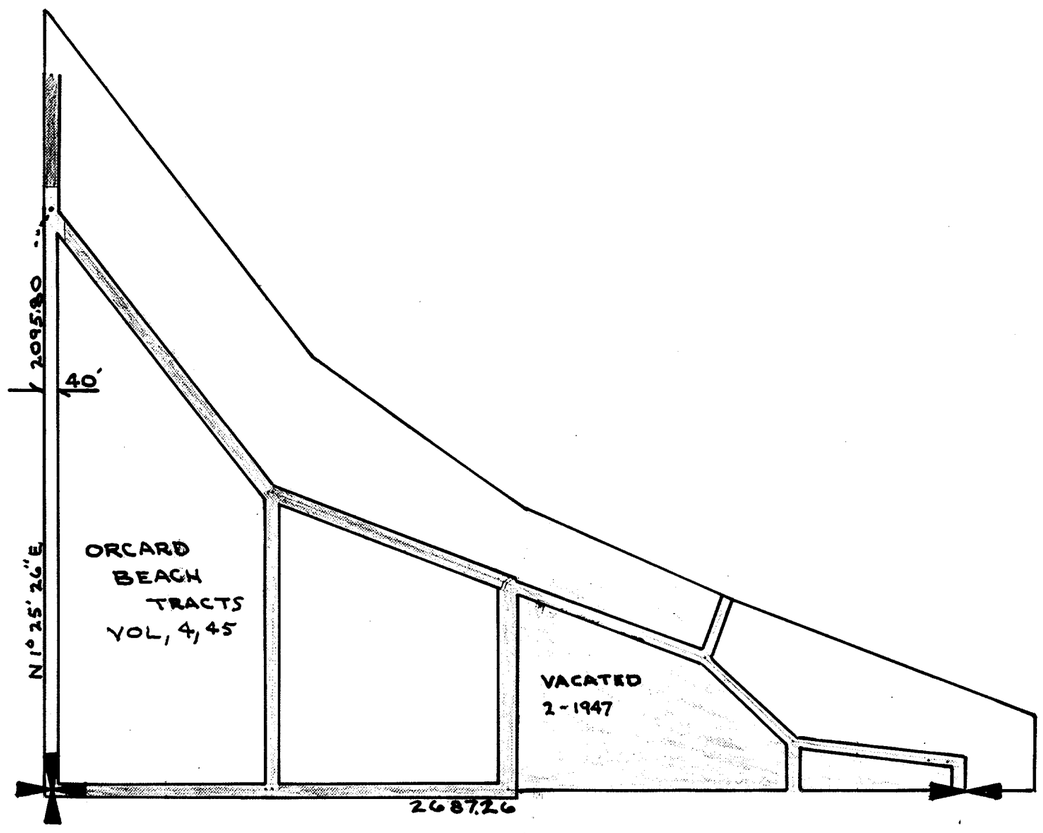

SECTION 35


TOWNSHIP 36 NORTH, RANGE 2 EAST, W. M.

SKAGIT COUNTY, WASH.

SCALE, 1 INCH--400 FEET

DATE August, 1965

Lloyd Johnson COUNTY ENGINEER

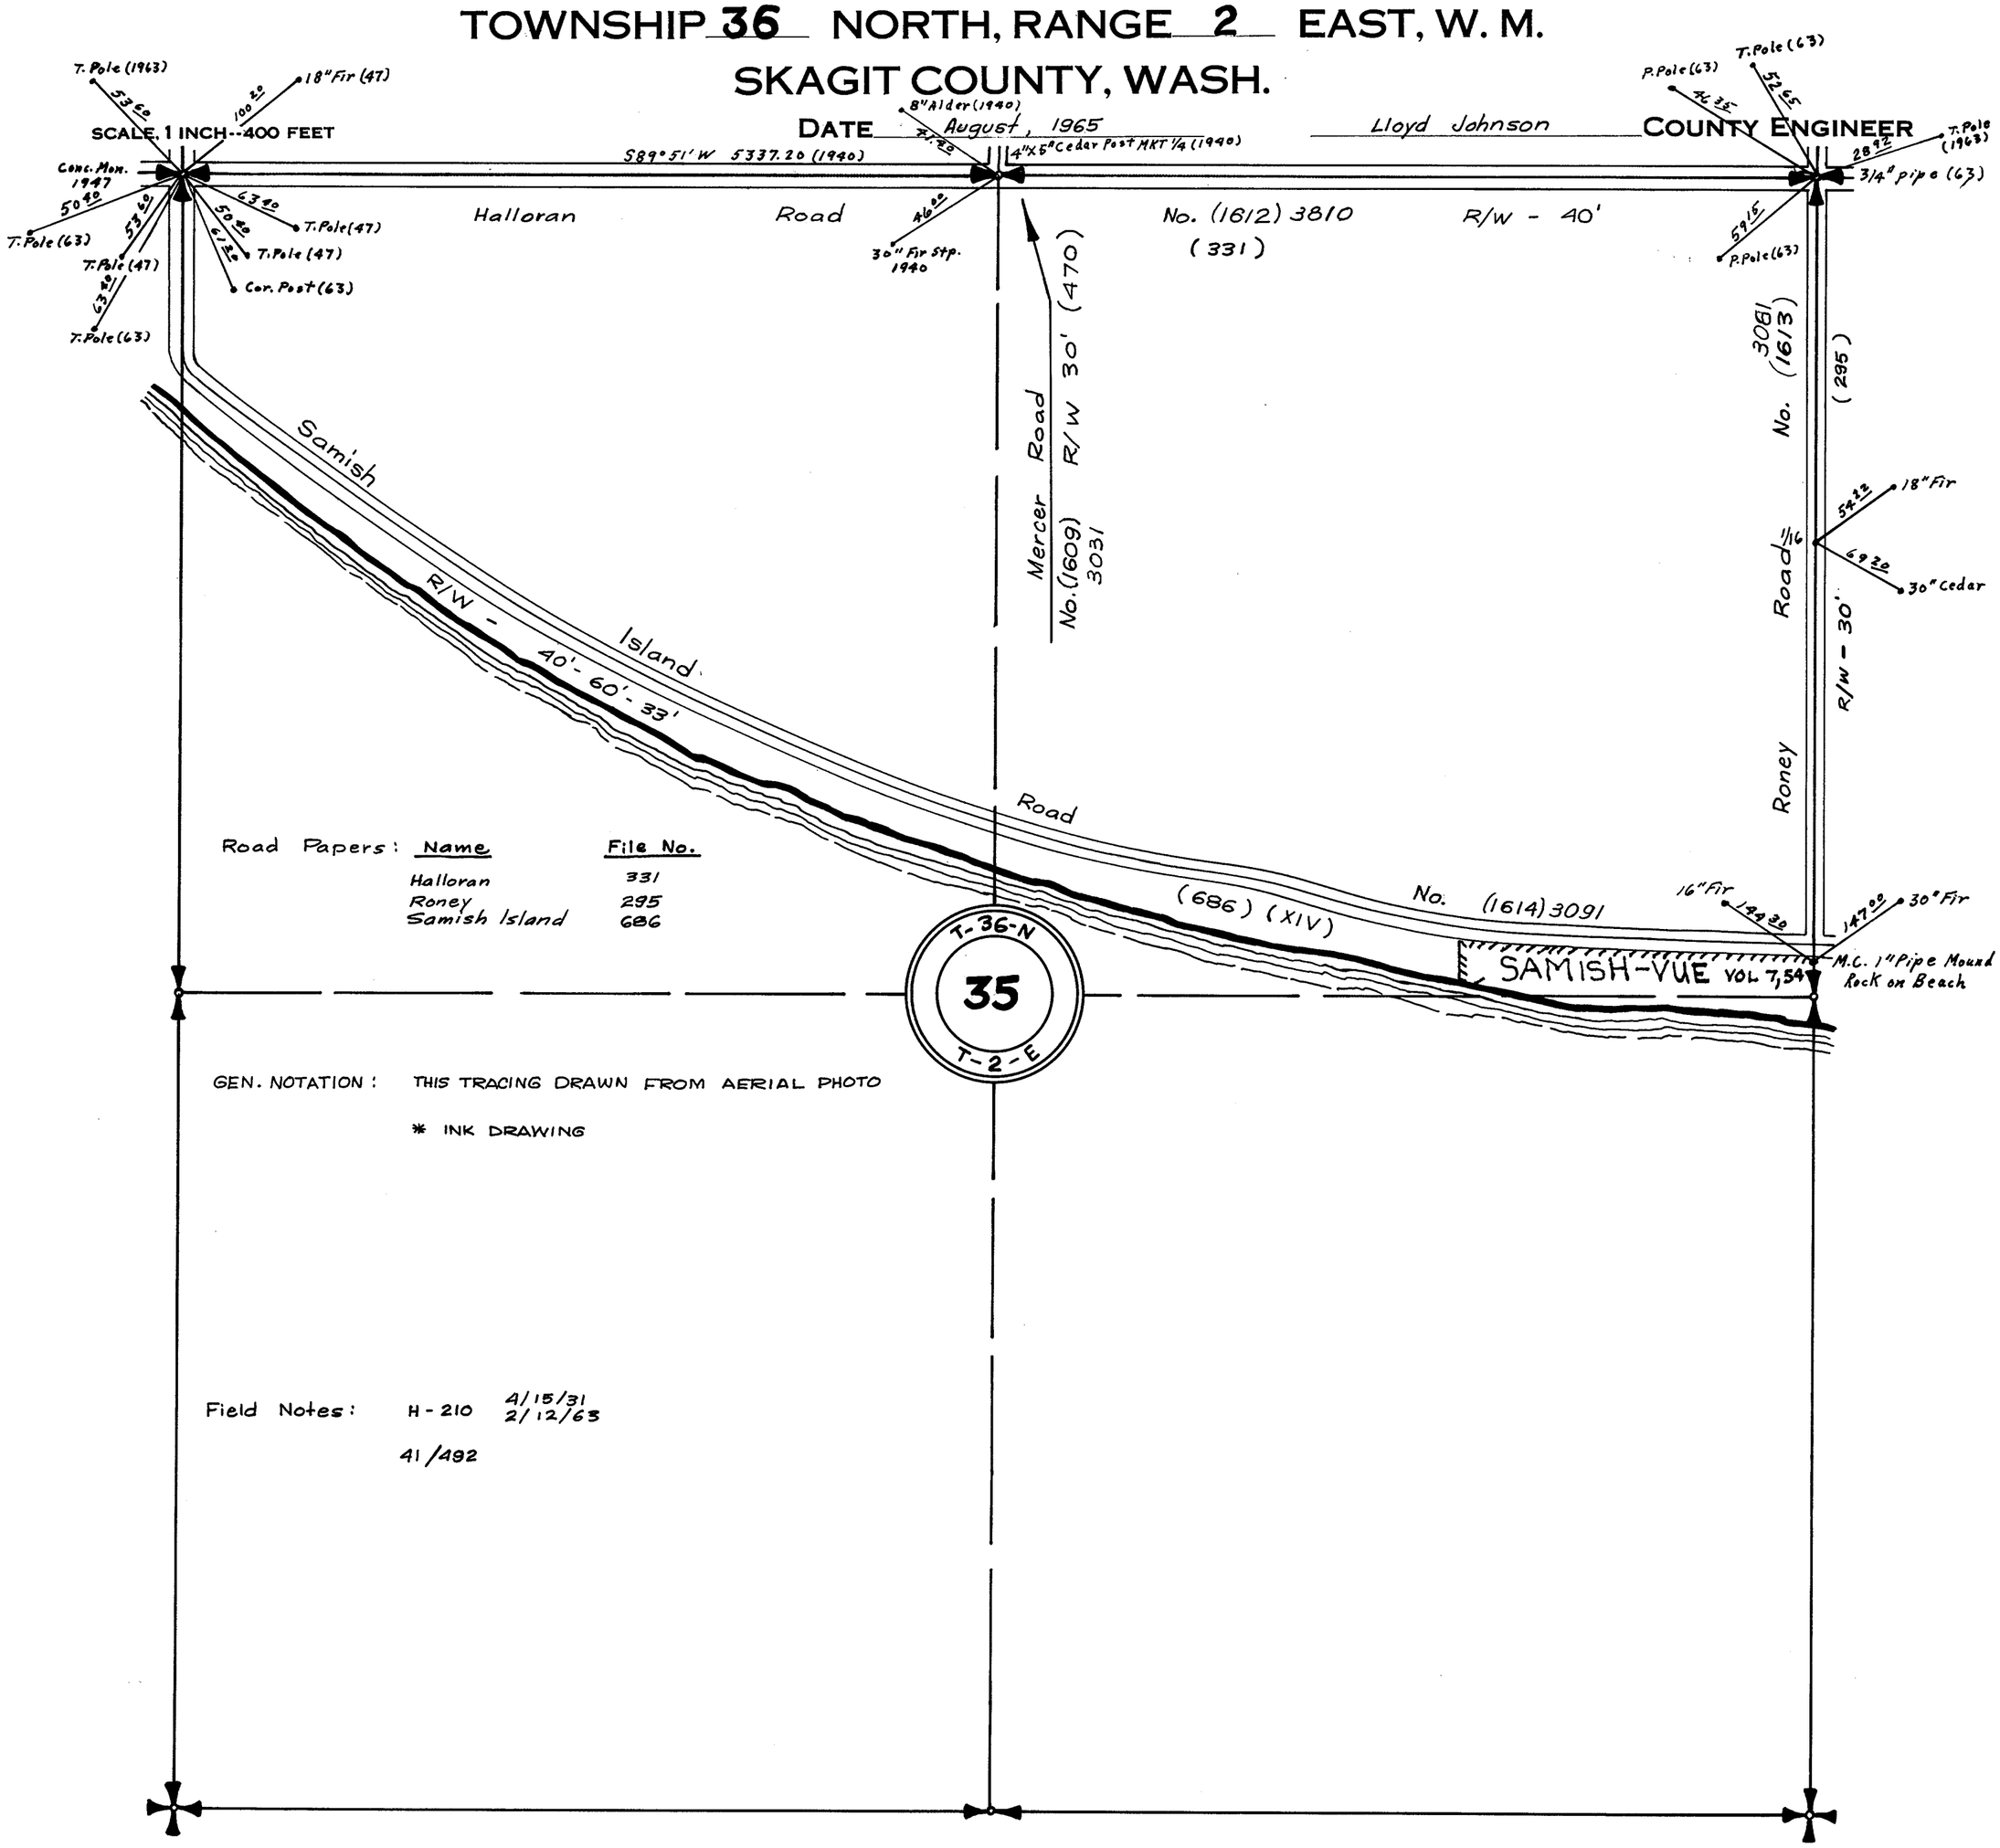

Road Papers:

Name	File No.
Halloran	331
Roney	295
Samish Island	686

GEN. NOTATION: THIS TRACING DRAWN FROM AERIAL PHOTO

* INK DRAWING

Field Notes: H-210 4/15/31
2/12/63

41/492

N89° 03' 30" E

1/16 Cor. { N 6834.02 / E 6457.27

Government Lot 3
Section 36, T36N, R2E.

N1° 35' W

488.82

N

Recd. Easement No. 2744
Apr. 20, 1956

Filed under date Jan 27, 1932 #1406 Wash State file No

N 72° 22' 50" E

121.34

33.69

159.03

7460

{ N 6270.82 / E 6472.85

40.91

40.91

{ N 6089.10 / E 6204.03

P.I. 6430.9
44.6

307.03

348.18

10°

Δ 62° 31' 30"

N 45° 35' E

218.24

S 80° 30' W

152.50

138.04

212.74

35' 30"

37.26

40.40

26.19

130.84

Δ 74° 38'

T 76.69

100

137.86

Meander Line

696.58

{ N 6011.73 / E 6210.47

4+29.9

286.48

N 9° 30' W

N 18° 06' 30" E

N 33° 02' 30" E

6+42.64

7+80.5

{ N 5913.96 / E 6307.65

20 20

Δ 70° 07'
D 20°
R 286.48
T 201.0
L 350.60

{ N 5772.40 / E 6053.02

S 5° 38' E

S 23° 29' E

S 29° 88 E

{ N 5574.51 / E 6492.05

S 89° 09' 40" W 2649.55

Center Sec. { N 5510.33 / E 6493.86

Office of County Road Engineer
of Kagit County, Washington
Feb. 23, 1956
1" = 100'


SECTION 36

TOWNSHIP 36 NORTH. RANGE 2 EAST. W. M.
SKAGIT COUNTY. WASH.

SCALE, 1 INCH—400 FEET

LLOYD H. JOHNSON COUNTY ENGINEER

DATE Aug 4, 1972

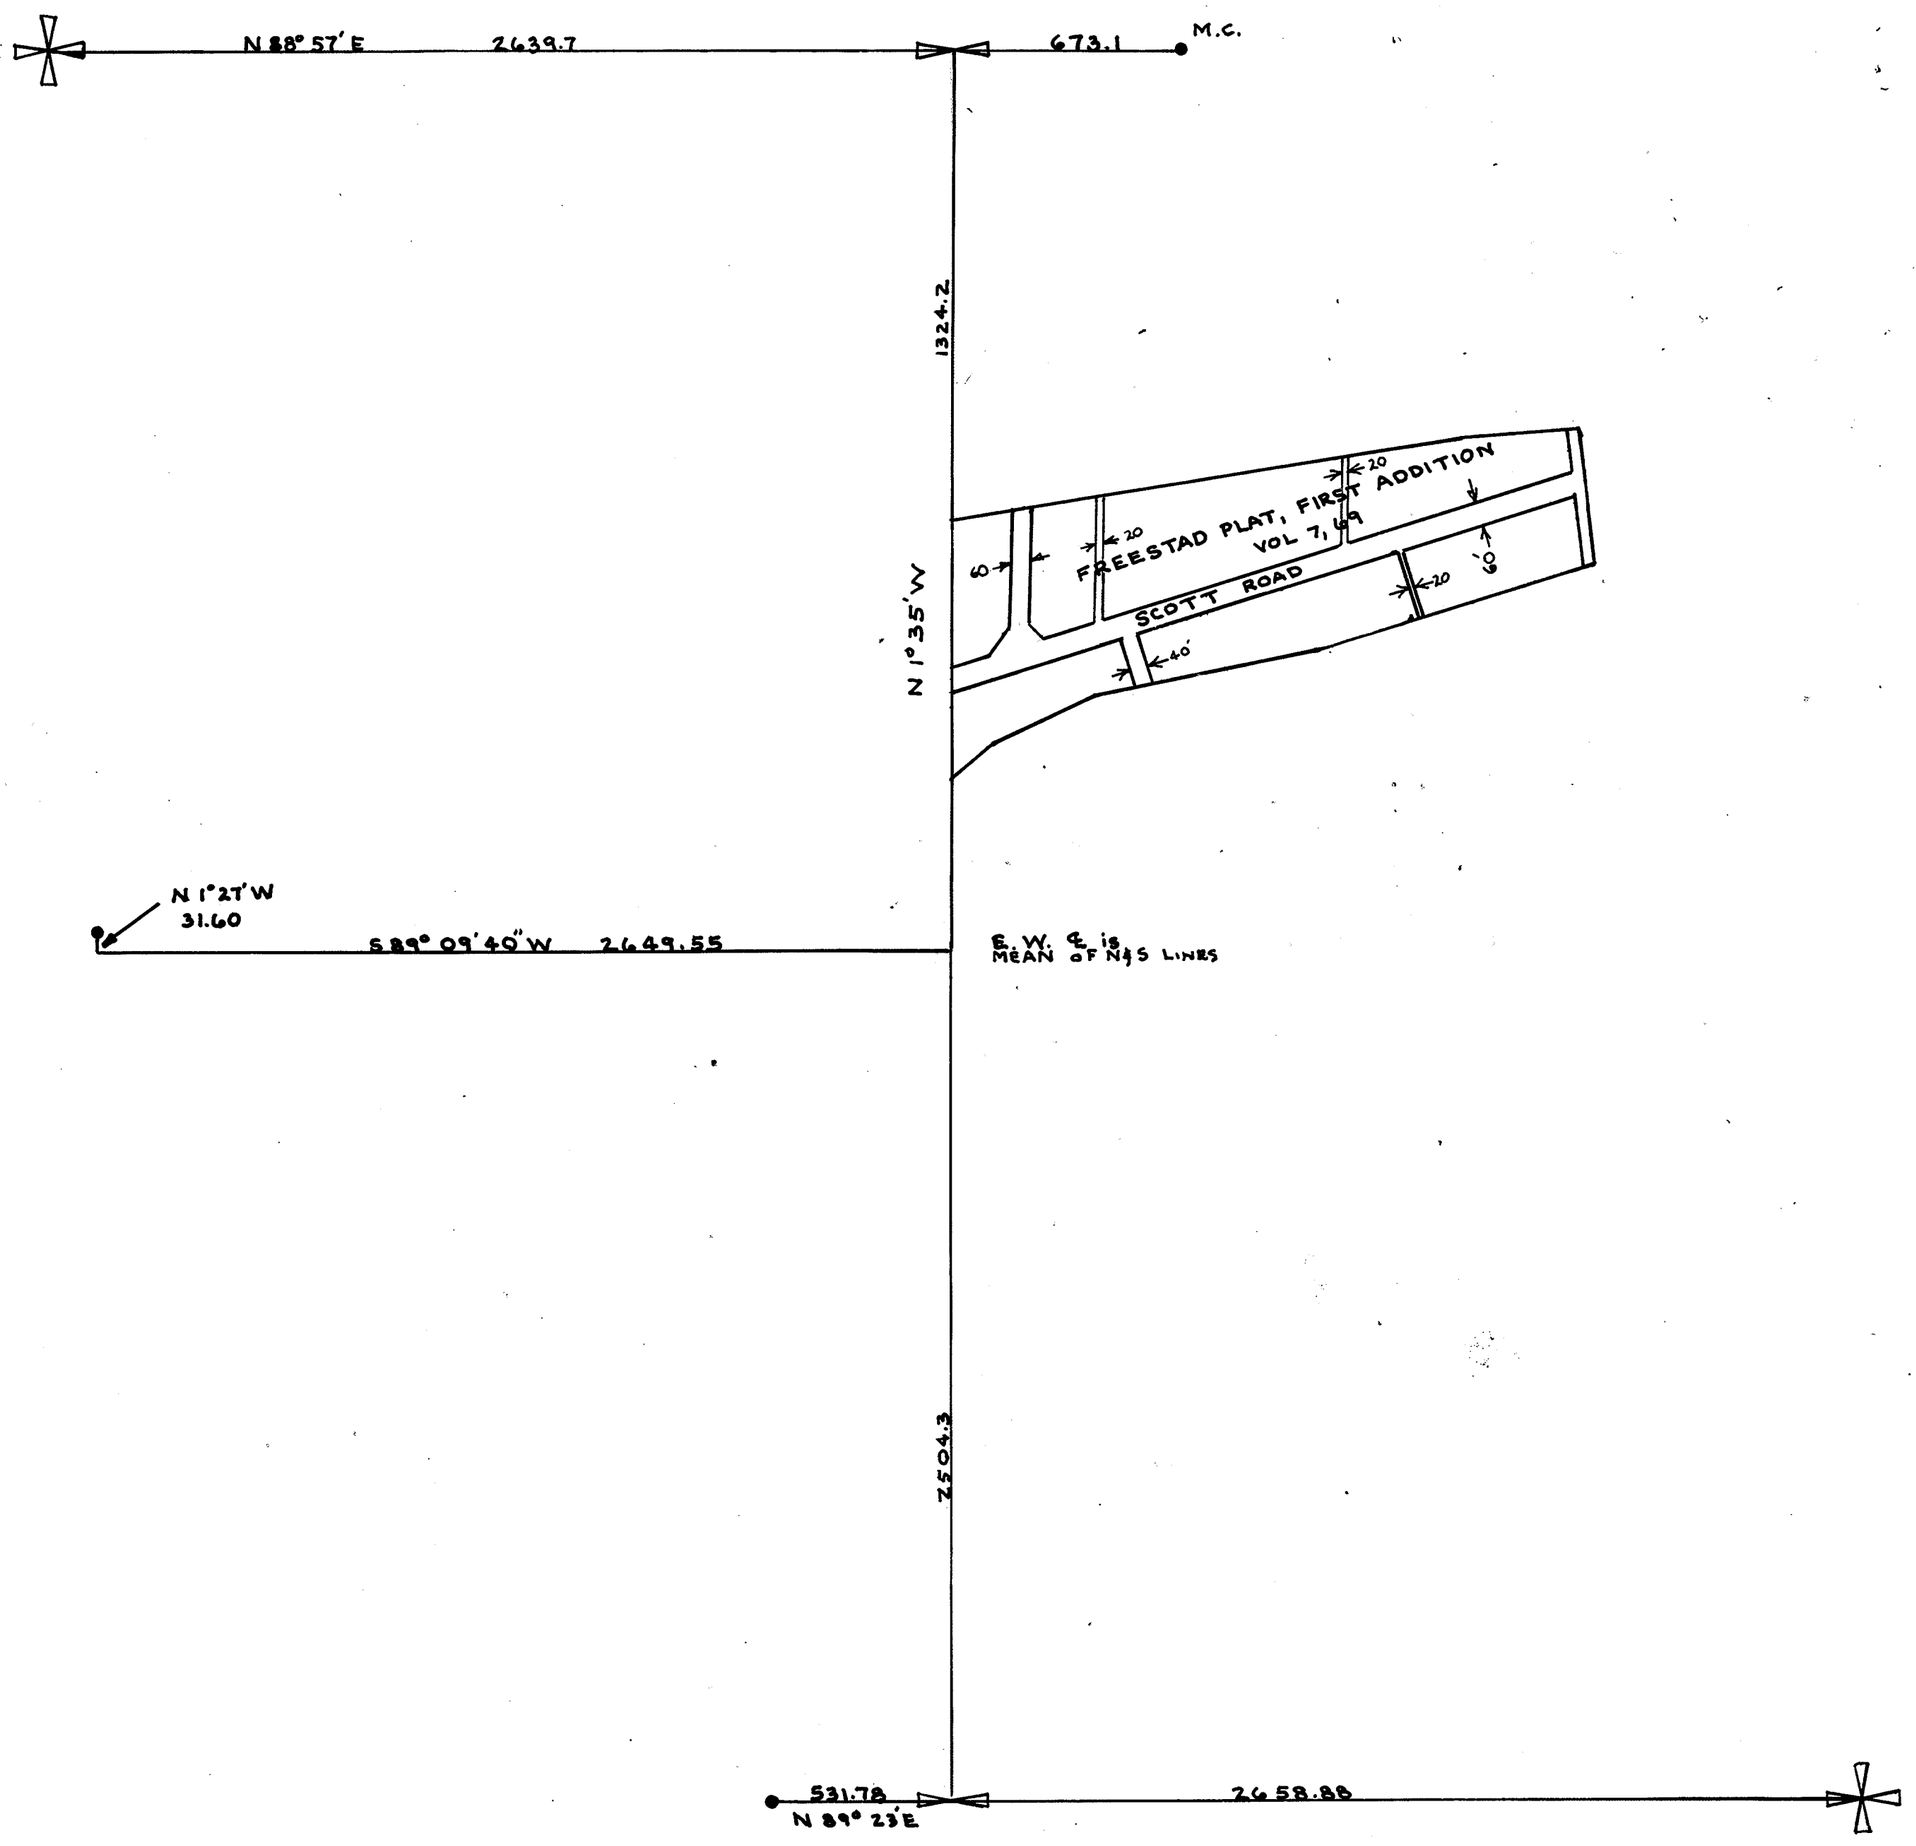

SECTION 36

TOWNSHIP 36 NORTH, RANGE 2 EAST, W. M.

SKAGIT COUNTY, WASH.


Subdivision Assembled from County Engineer's Records

9-M-55
Notes 146 & F.G. Subdiv.

Maps A 21
H 5

SCALE, 1 INCH--400 FEET

H. O. Walberg COUNTY ENGINEER

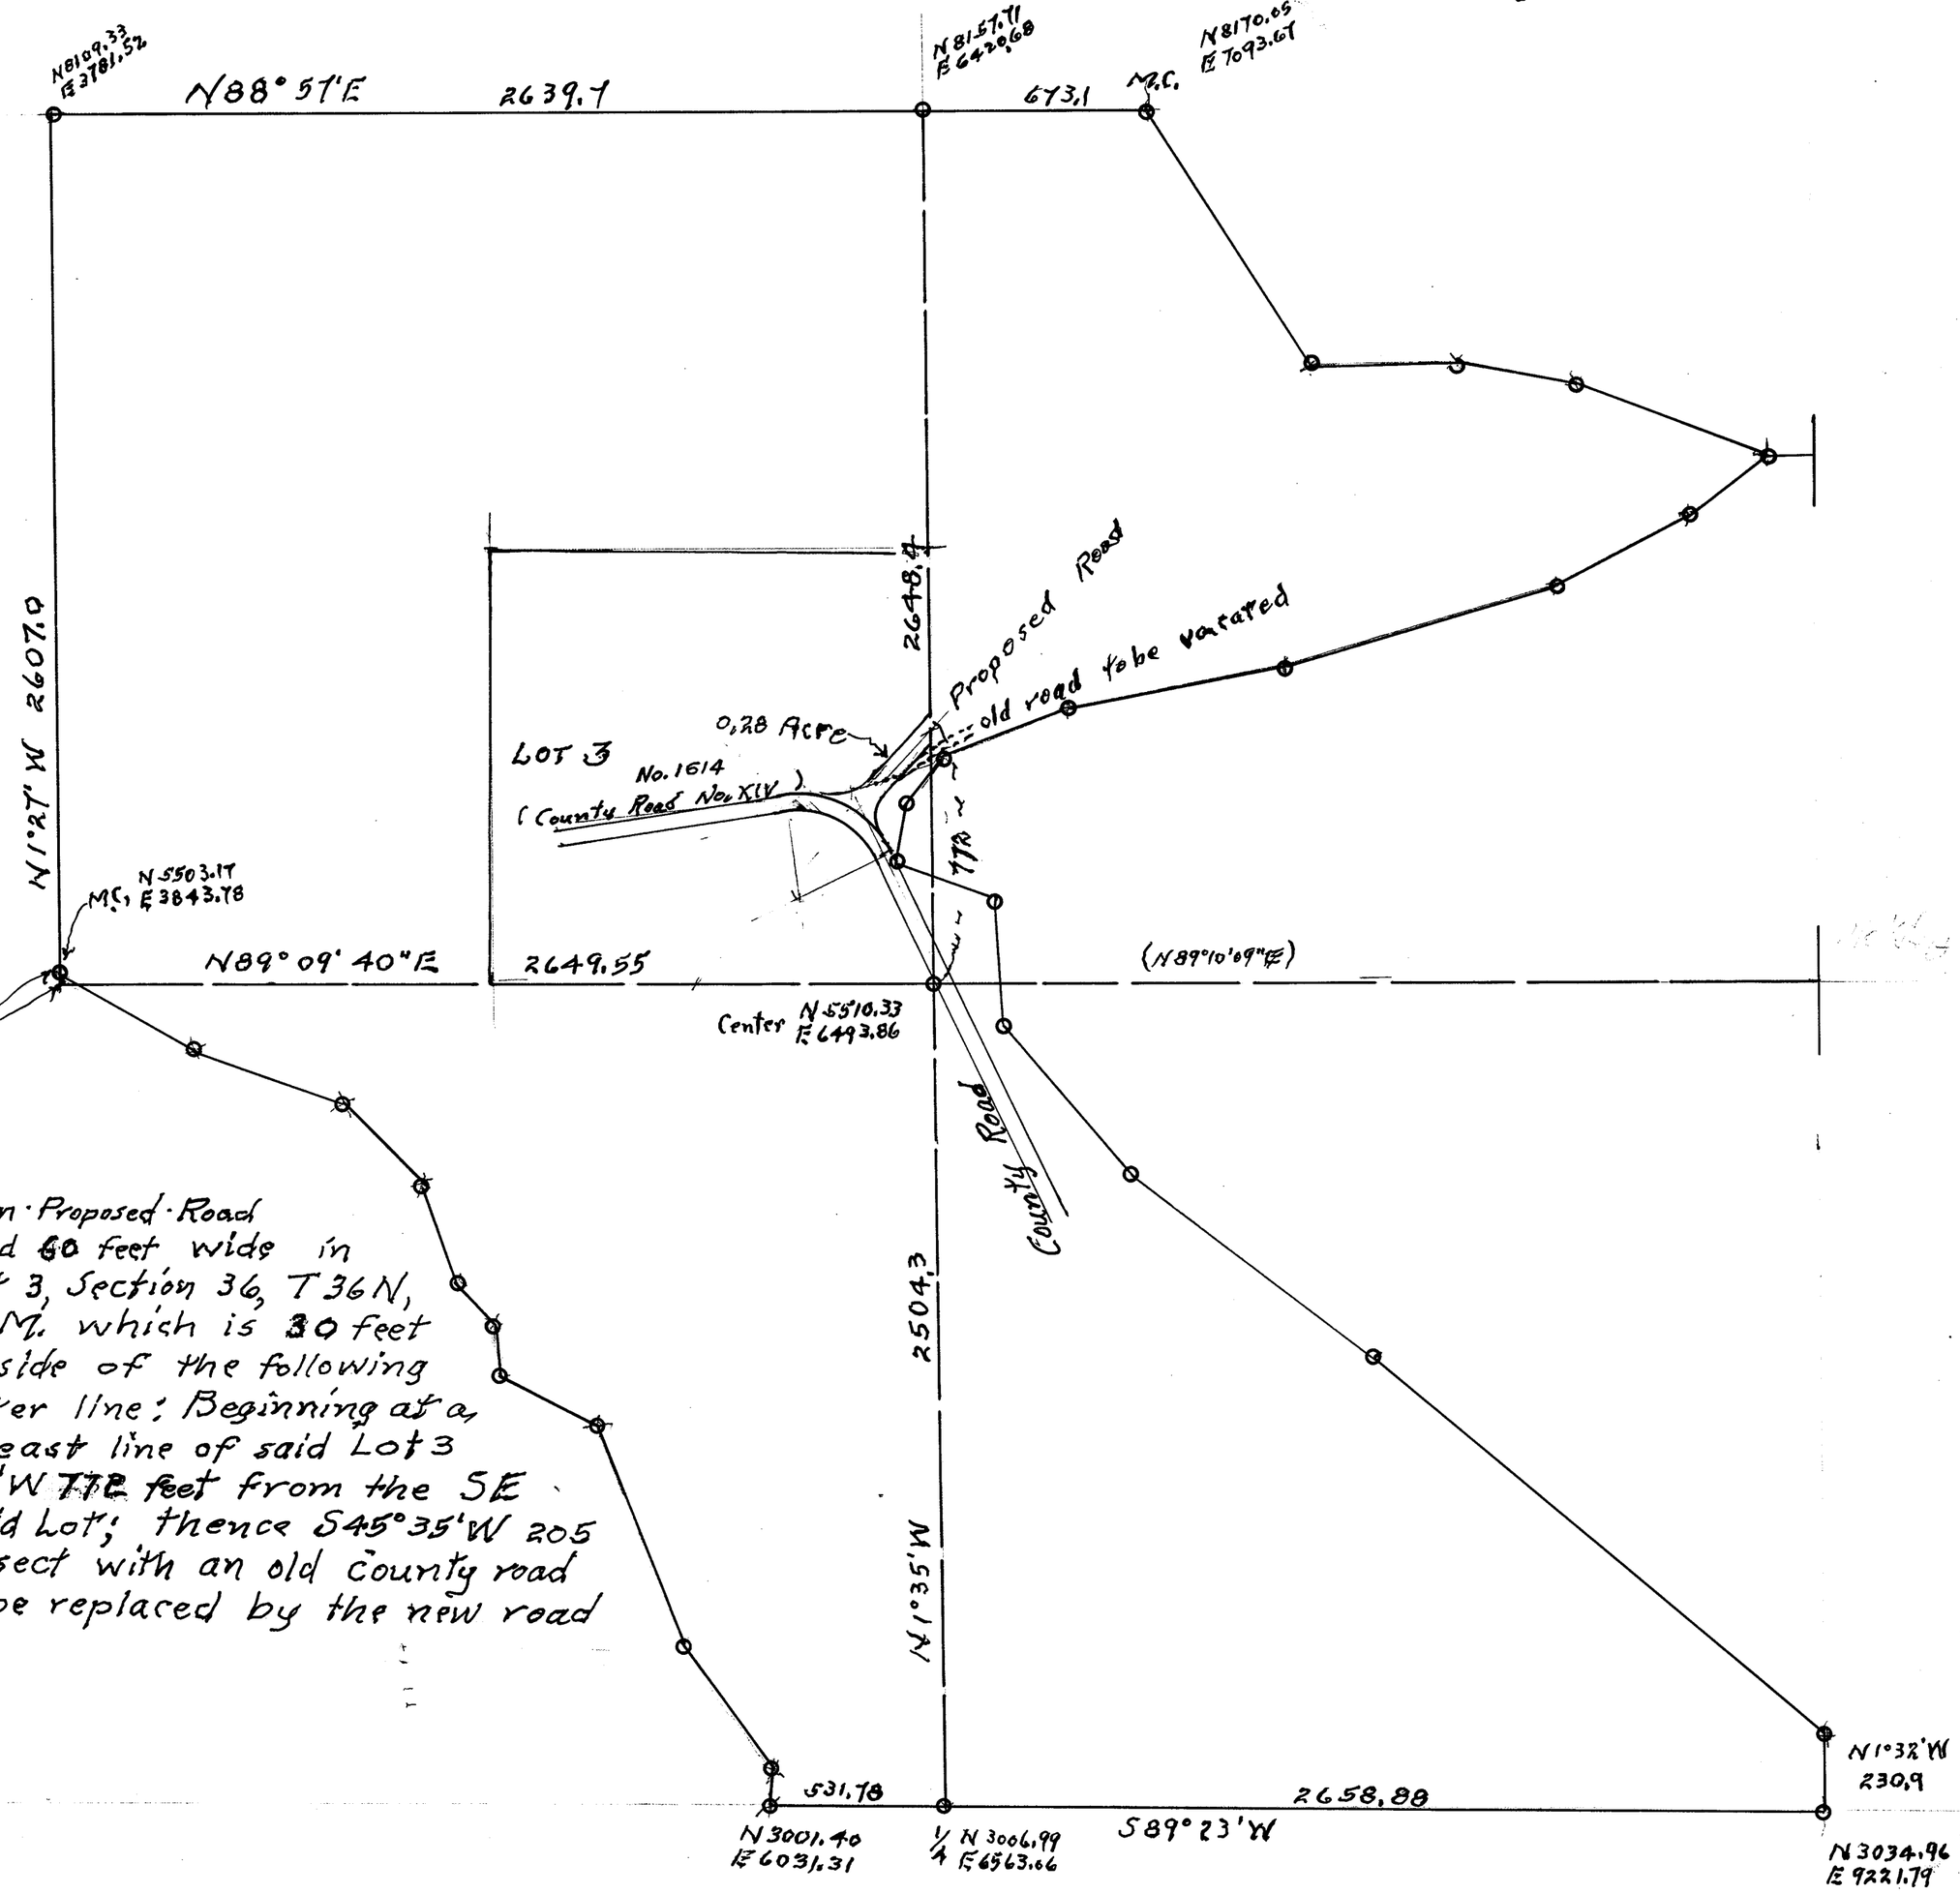

Description · Proposed · Road


A strip of land 60 feet wide in Government Lot 3, Section 36, T 36 N, R. 2 E. of W. M. which is 30 feet wide on each side of the following described center line: Beginning at a point on the east line of said Lot 3 which is N1°35'W 772 feet from the SE corner of said Lot; thence S45°35'W 205 feet to intersect with an old County road which is to be replaced by the new road

SECTION 36

TOWNSHIP 36 NORTH. RANGE 2 EAST. W. M.
SKAGIT COUNTY. WASH.

SCALE. 1 INCH–400 FEET

Robt. E. L. Knapp COUNTY ENGINEER
May 1932
Notes – F 146

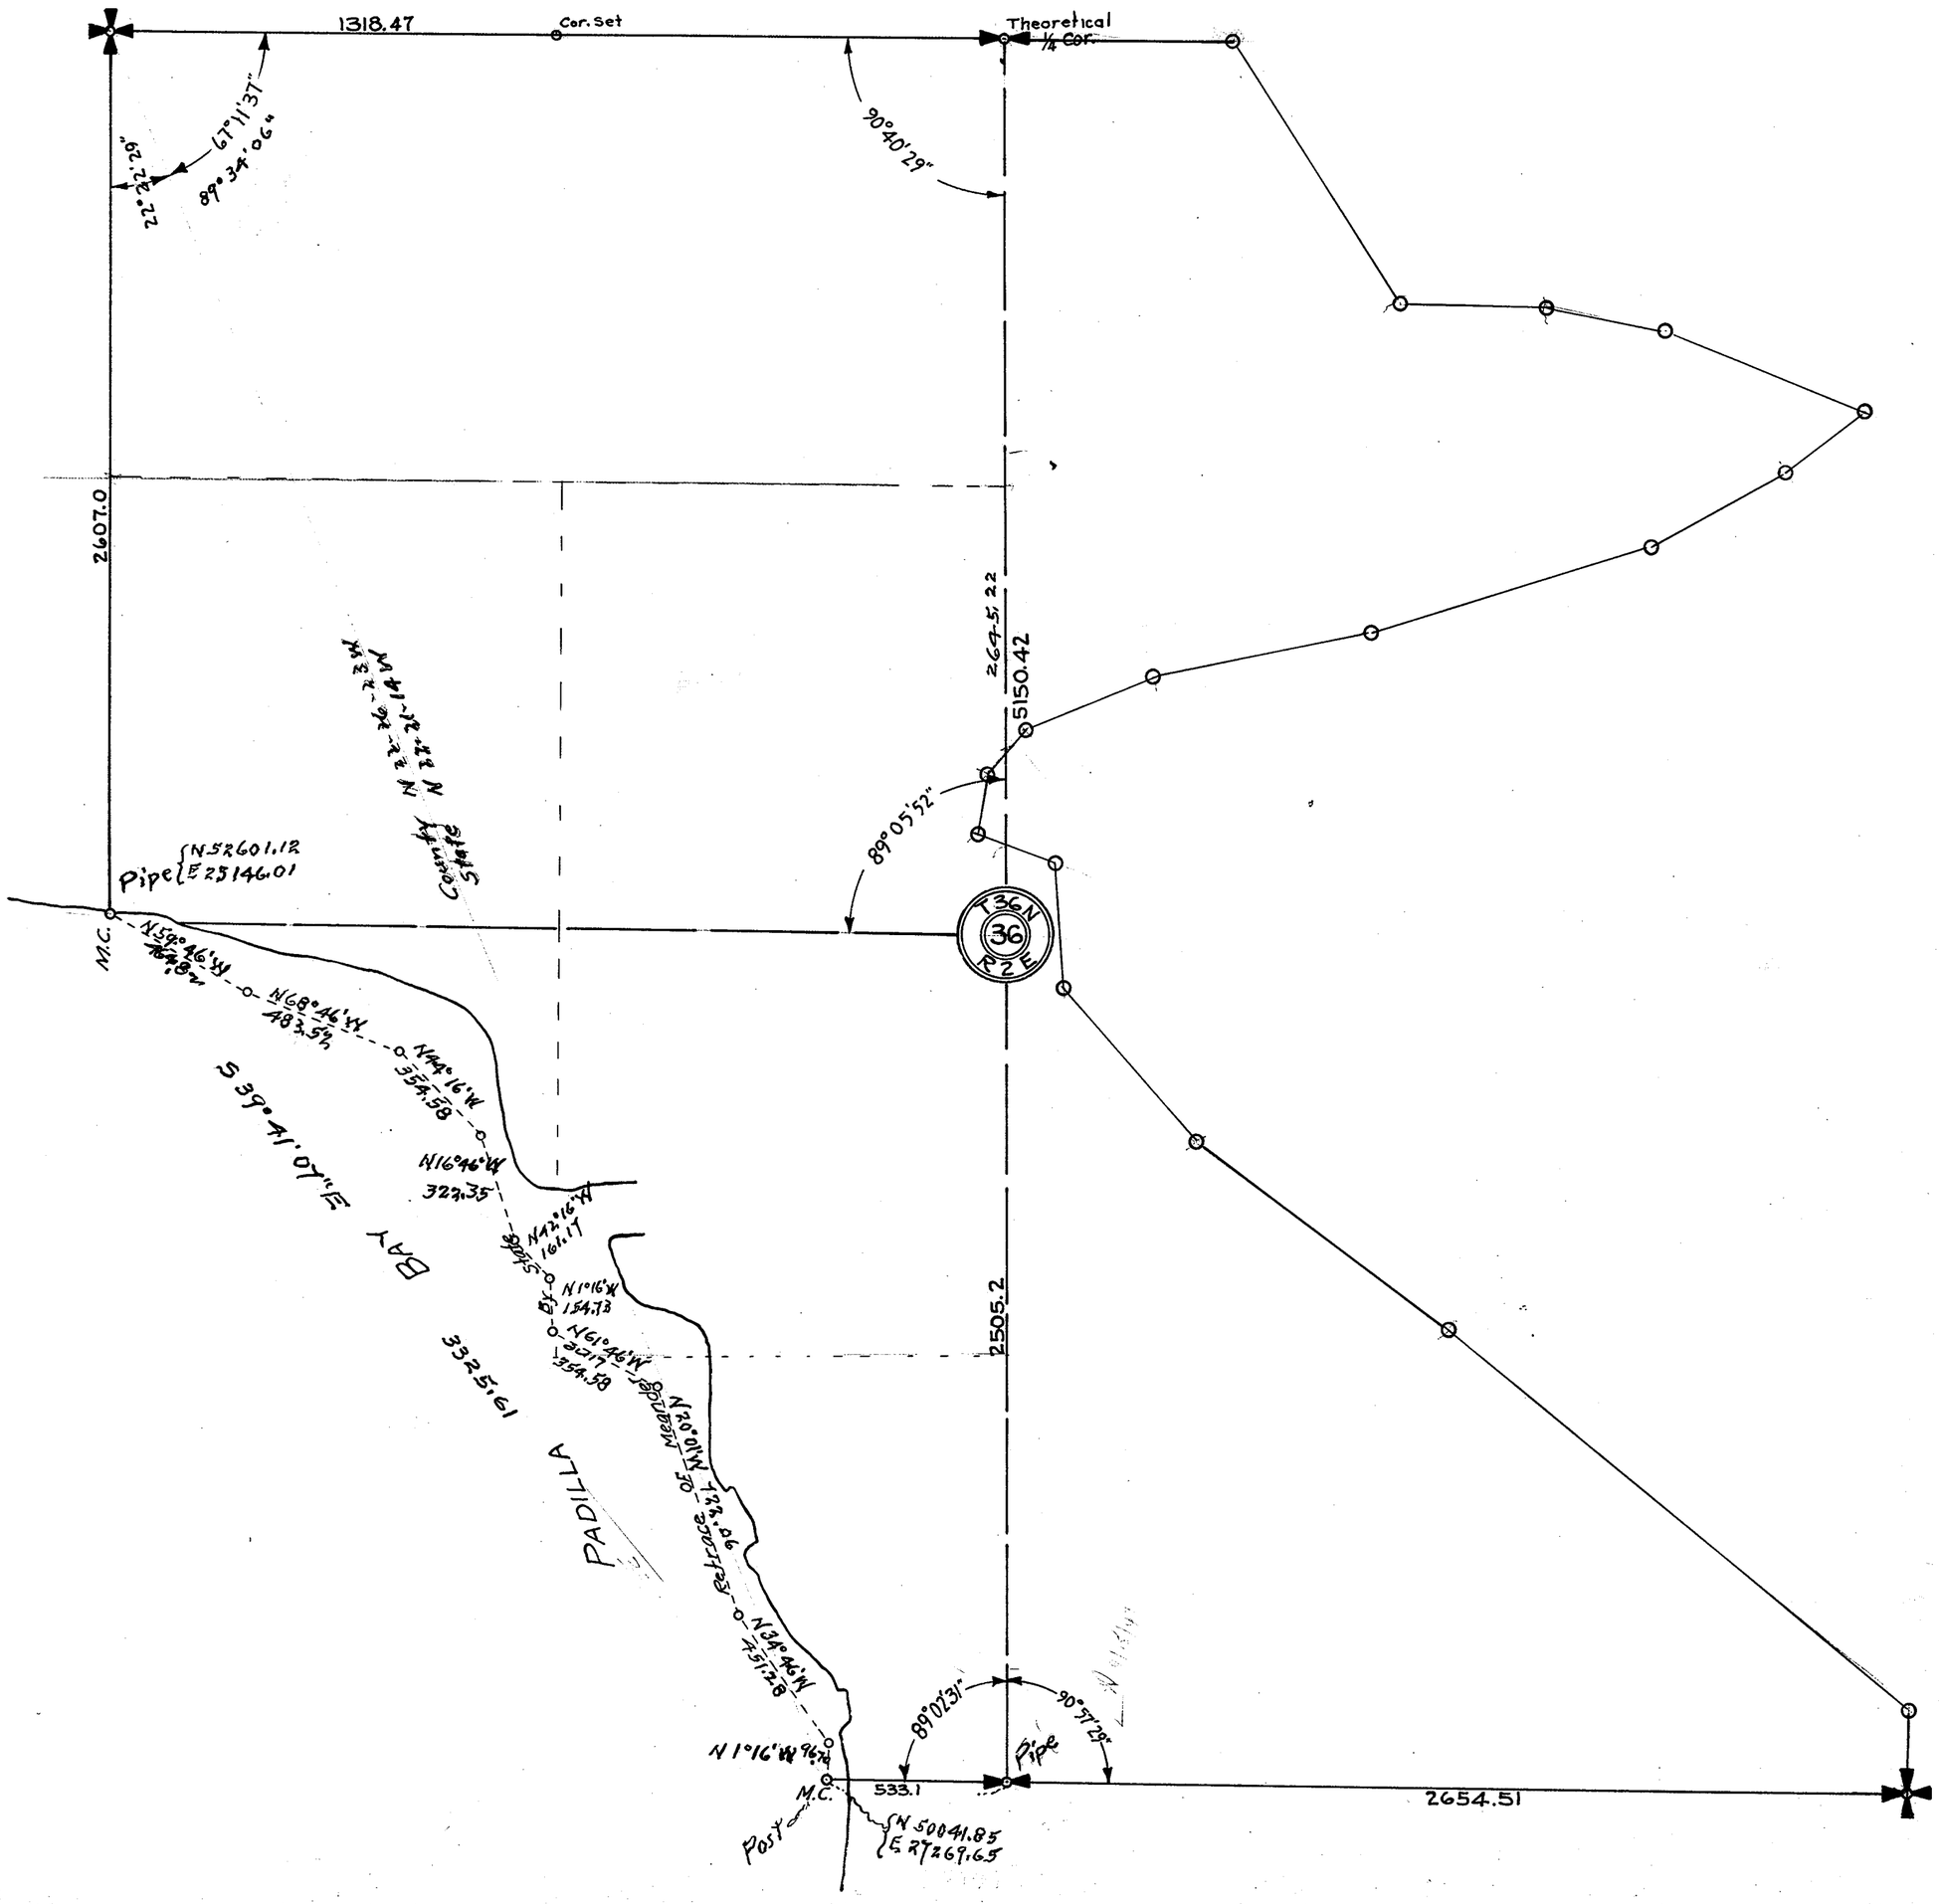

SECTION 36

TOWNSHIP 36 NORTH, RANGE 2 EAST, W. M.

SKAGIT COUNTY, WASH.

DATE August, 1965 — Lloyd Johnson — COUNTY ENGINEER

SCALE 1 INCH = 400 FEET

T. Pole (63) — 52.6E — T. Pole (1963) — 28.9E — (63) P. Pole — 46.35' — 3/4" Pipe — 59.1E — P. Pole

N 88°57'E — 1319.8 — 2639.6' — 1319.8' — 673.10' — M.C.

89°36'

Harold R. Roney Road No. (1613) 3061 — (295) — 1319.3' — N11°27'W 2603.0' — R/W - 30'

1321.75 — 1324.2

1/16 — 1/2" Pipe — N89°03'30"E — 1321.4 — 1321.4 — 18" Fir — 54.2E — 69.2E — 30" Cedar

Samish Island

1324.2'

Scott Road — 3780 No. (1617) (590) — R/W 60'

16" Fir — 144.2E — 30" Fir — 147.0E — R/W - 40' 33' 60' — Samish Island

89°15'

M.C. 1" Pipe Mound Rock on Beach

N89°09'40"E — 2649.55'

T-36-N — 36 — R-2-E

Road — 2504.3' — N1°35'W — No. (1614) (686)(XIV) — 3091

N 1°27' W

Notes:

F-146	10/18/29
38/342	6/13/36
41/492	
9/88	1956-7

GEN. NOTATION: THIS TRACING DRAWN FROM AERIAL PHOTO

* INK DRAWING

* 3-TRACINGS — SHOWING INTERSECTION TO SCALE

Road Papers:

NAME	FILE NO.
RONEY	295
SAMISH IS.	686
SCOTT	590


M.C. — 531.78' — 90°58' — 2658.88' — S89°23'W 3190.66'

SECTION 1

TOWNSHIP 36 NORTH, RANGE 3 EAST, W. M.
SKAGIT COUNTY, WASH.

SCALE, 1 INCH—400 FEET

W.E. COSTELLO COUNTY ENGINEER

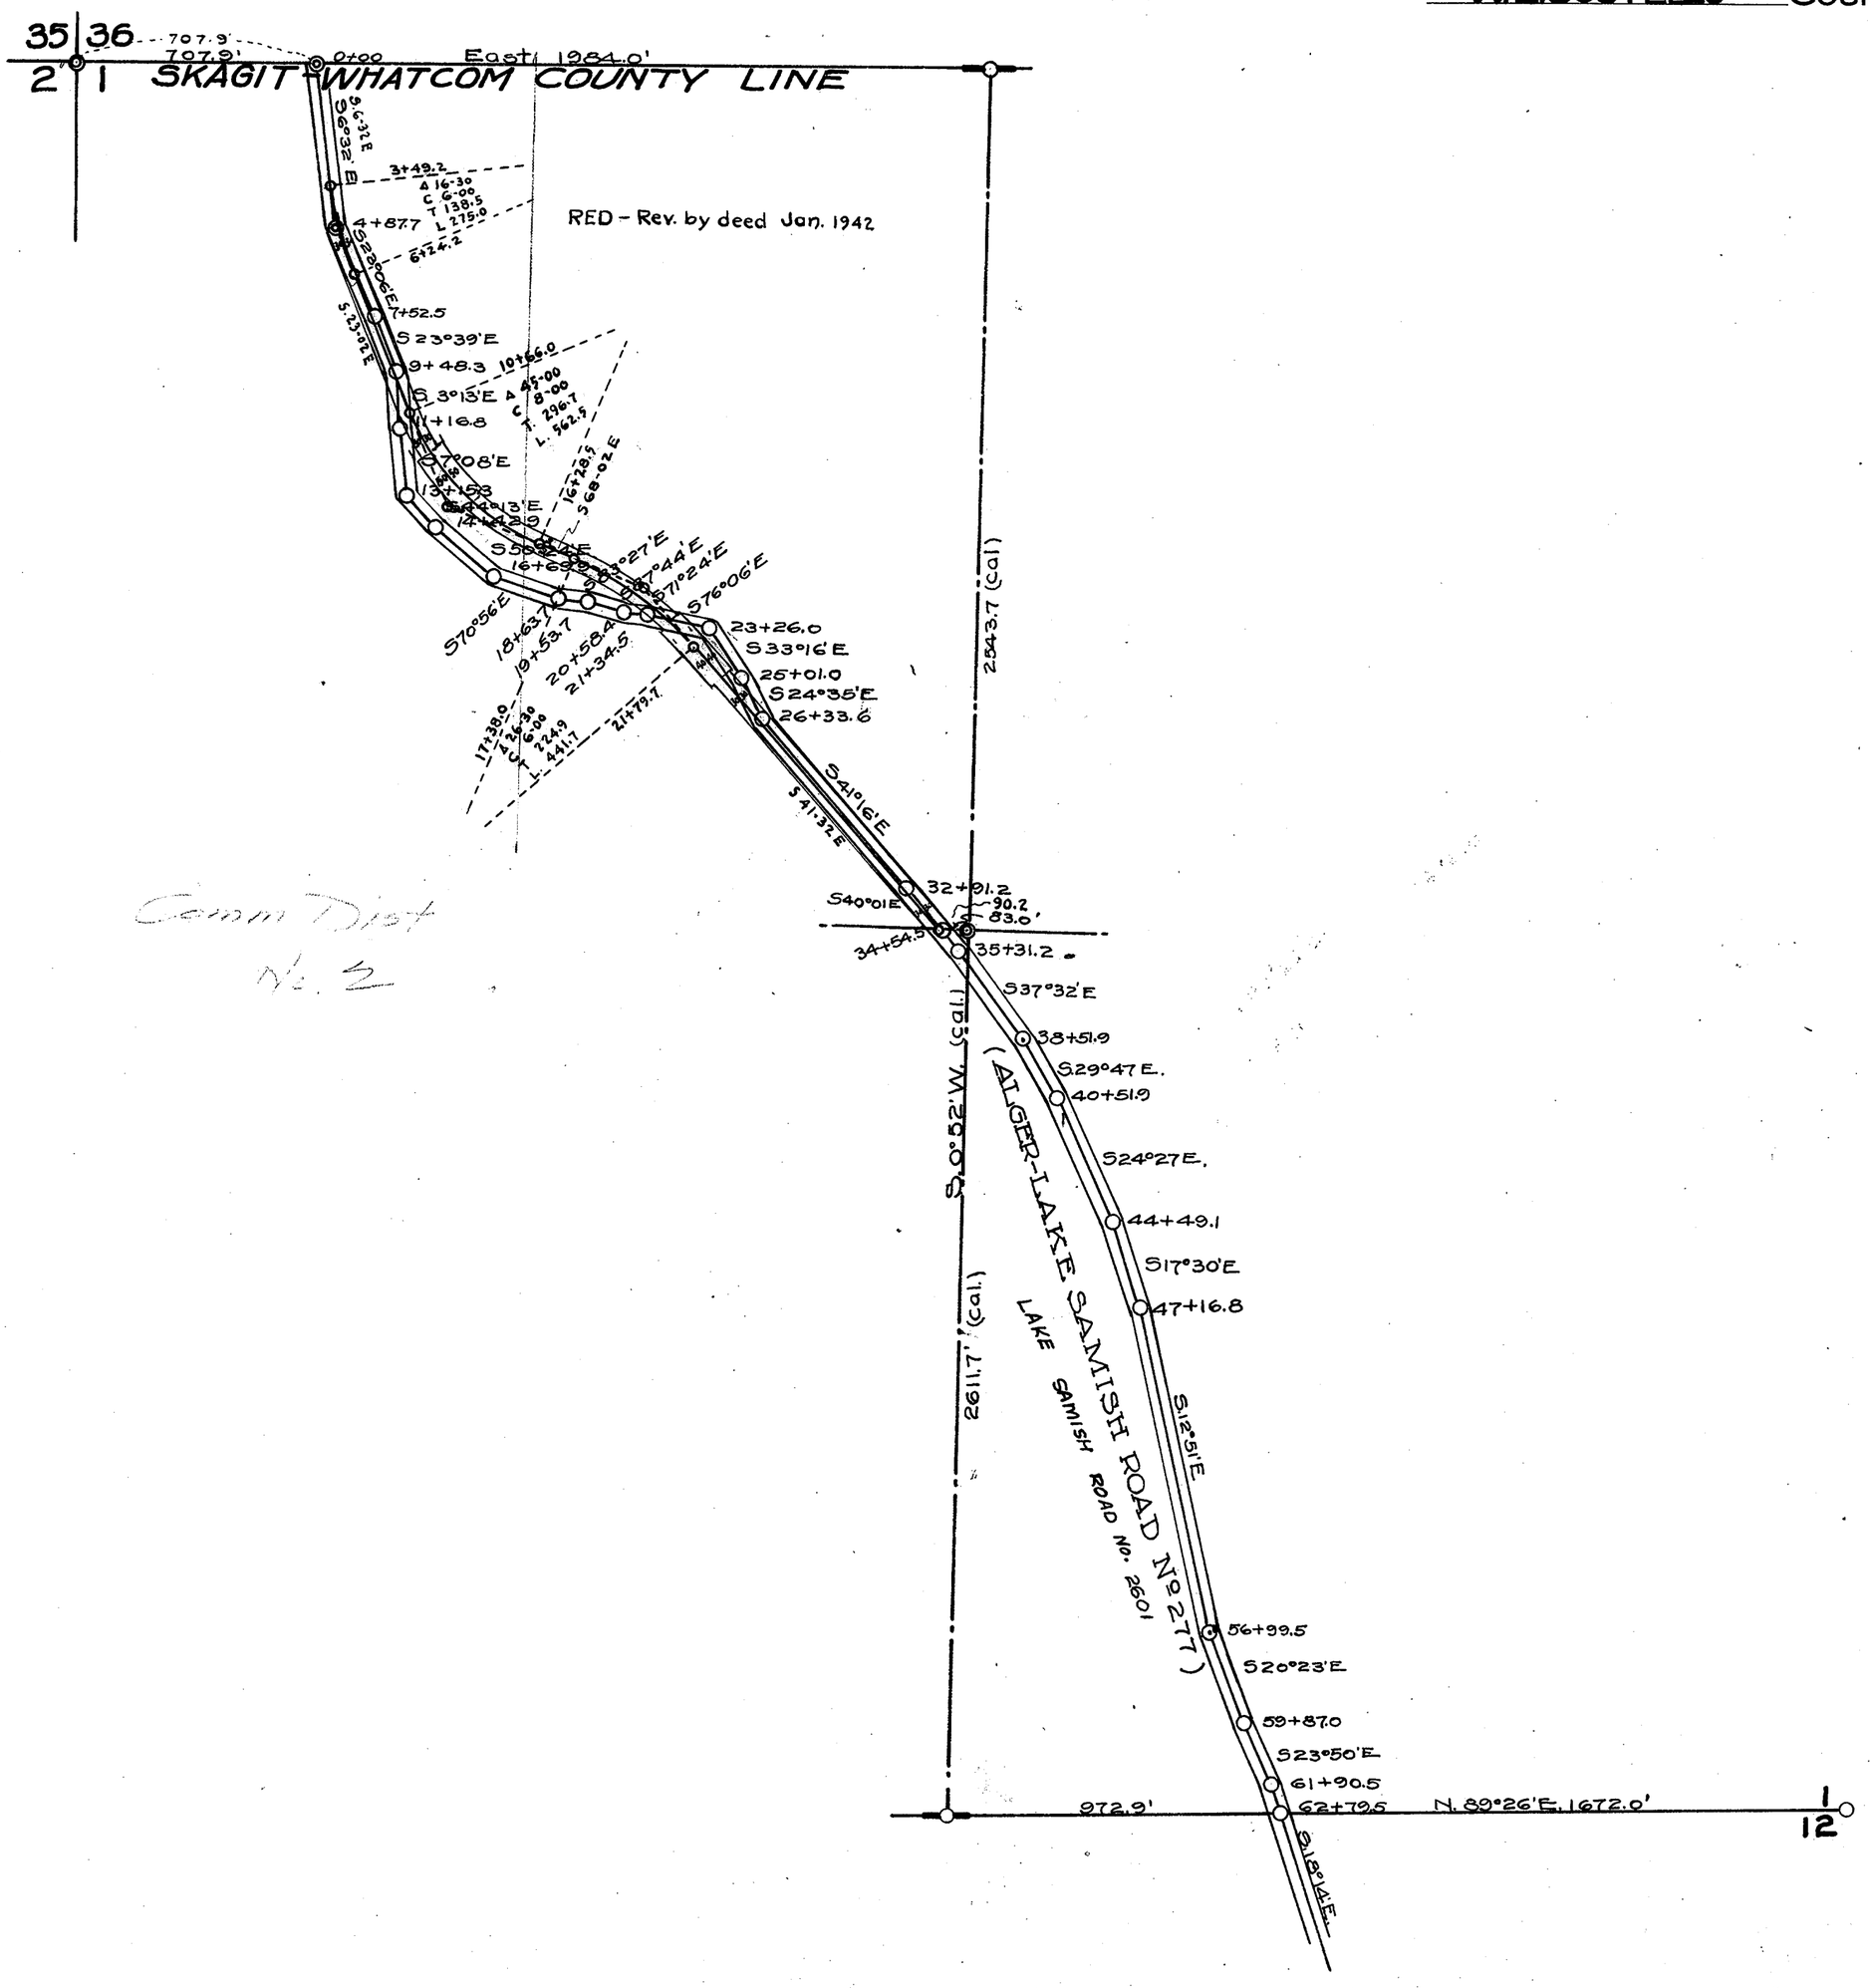

RED – Rev. by deed Jan. 1942

Comm Dist
No. 2

SECTION 1


TOWNSHIP 36 NORTH, RANGE 3 EAST, W. M.

SKAGIT COUNTY, WASH.

SCALE, 1 INCH--400 FEET

DATE August, 1965

Lloyd Johnson COUNTY ENGINEER

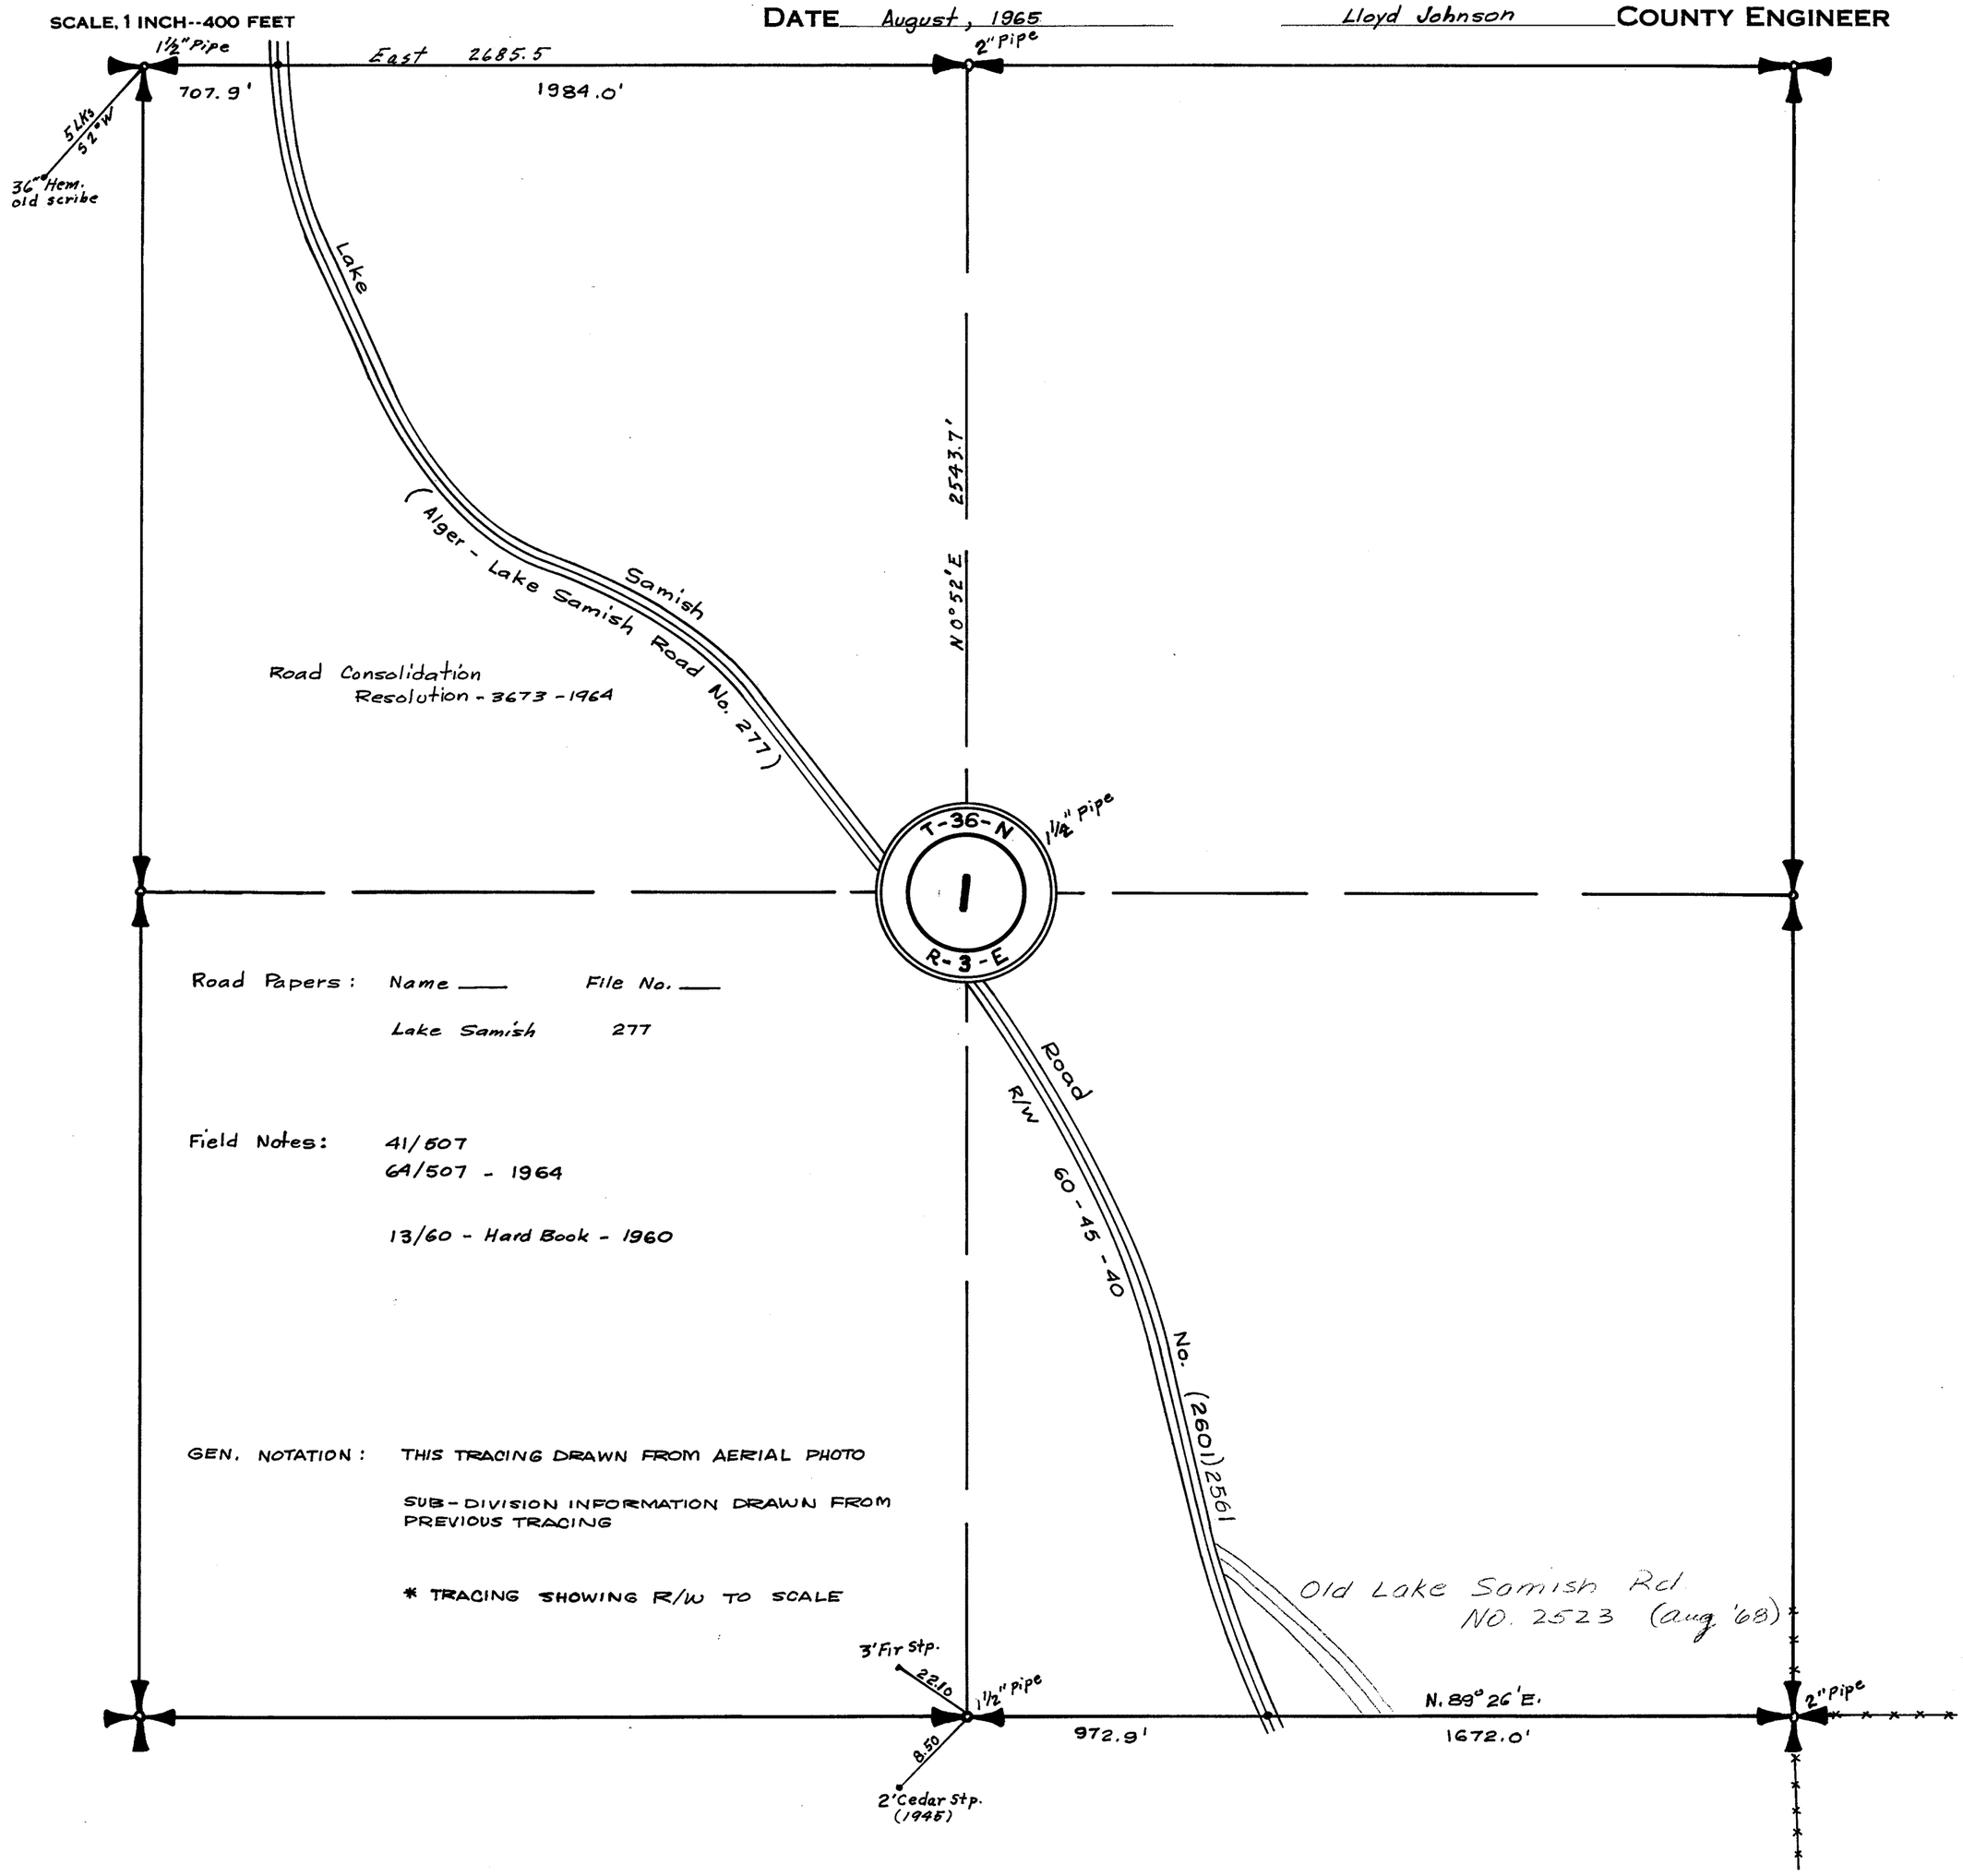

Road Papers: Name ____ File No. ____

Lake Samish 277

Field Notes: 41/507
64/507 - 1964

13/60 - Hard Book - 1960

GEN. NOTATION: THIS TRACING DRAWN FROM AERIAL PHOTO


SUB-DIVISION INFORMATION DRAWN FROM PREVIOUS TRACING

* TRACING SHOWING R/W TO SCALE

PLAT OF SECTION 3

Tp. 36N, R3E, WM. for E½, NW¼

March, 1915. Scale: 1 inch = 400 ft. H.M. Wellman, Engr.

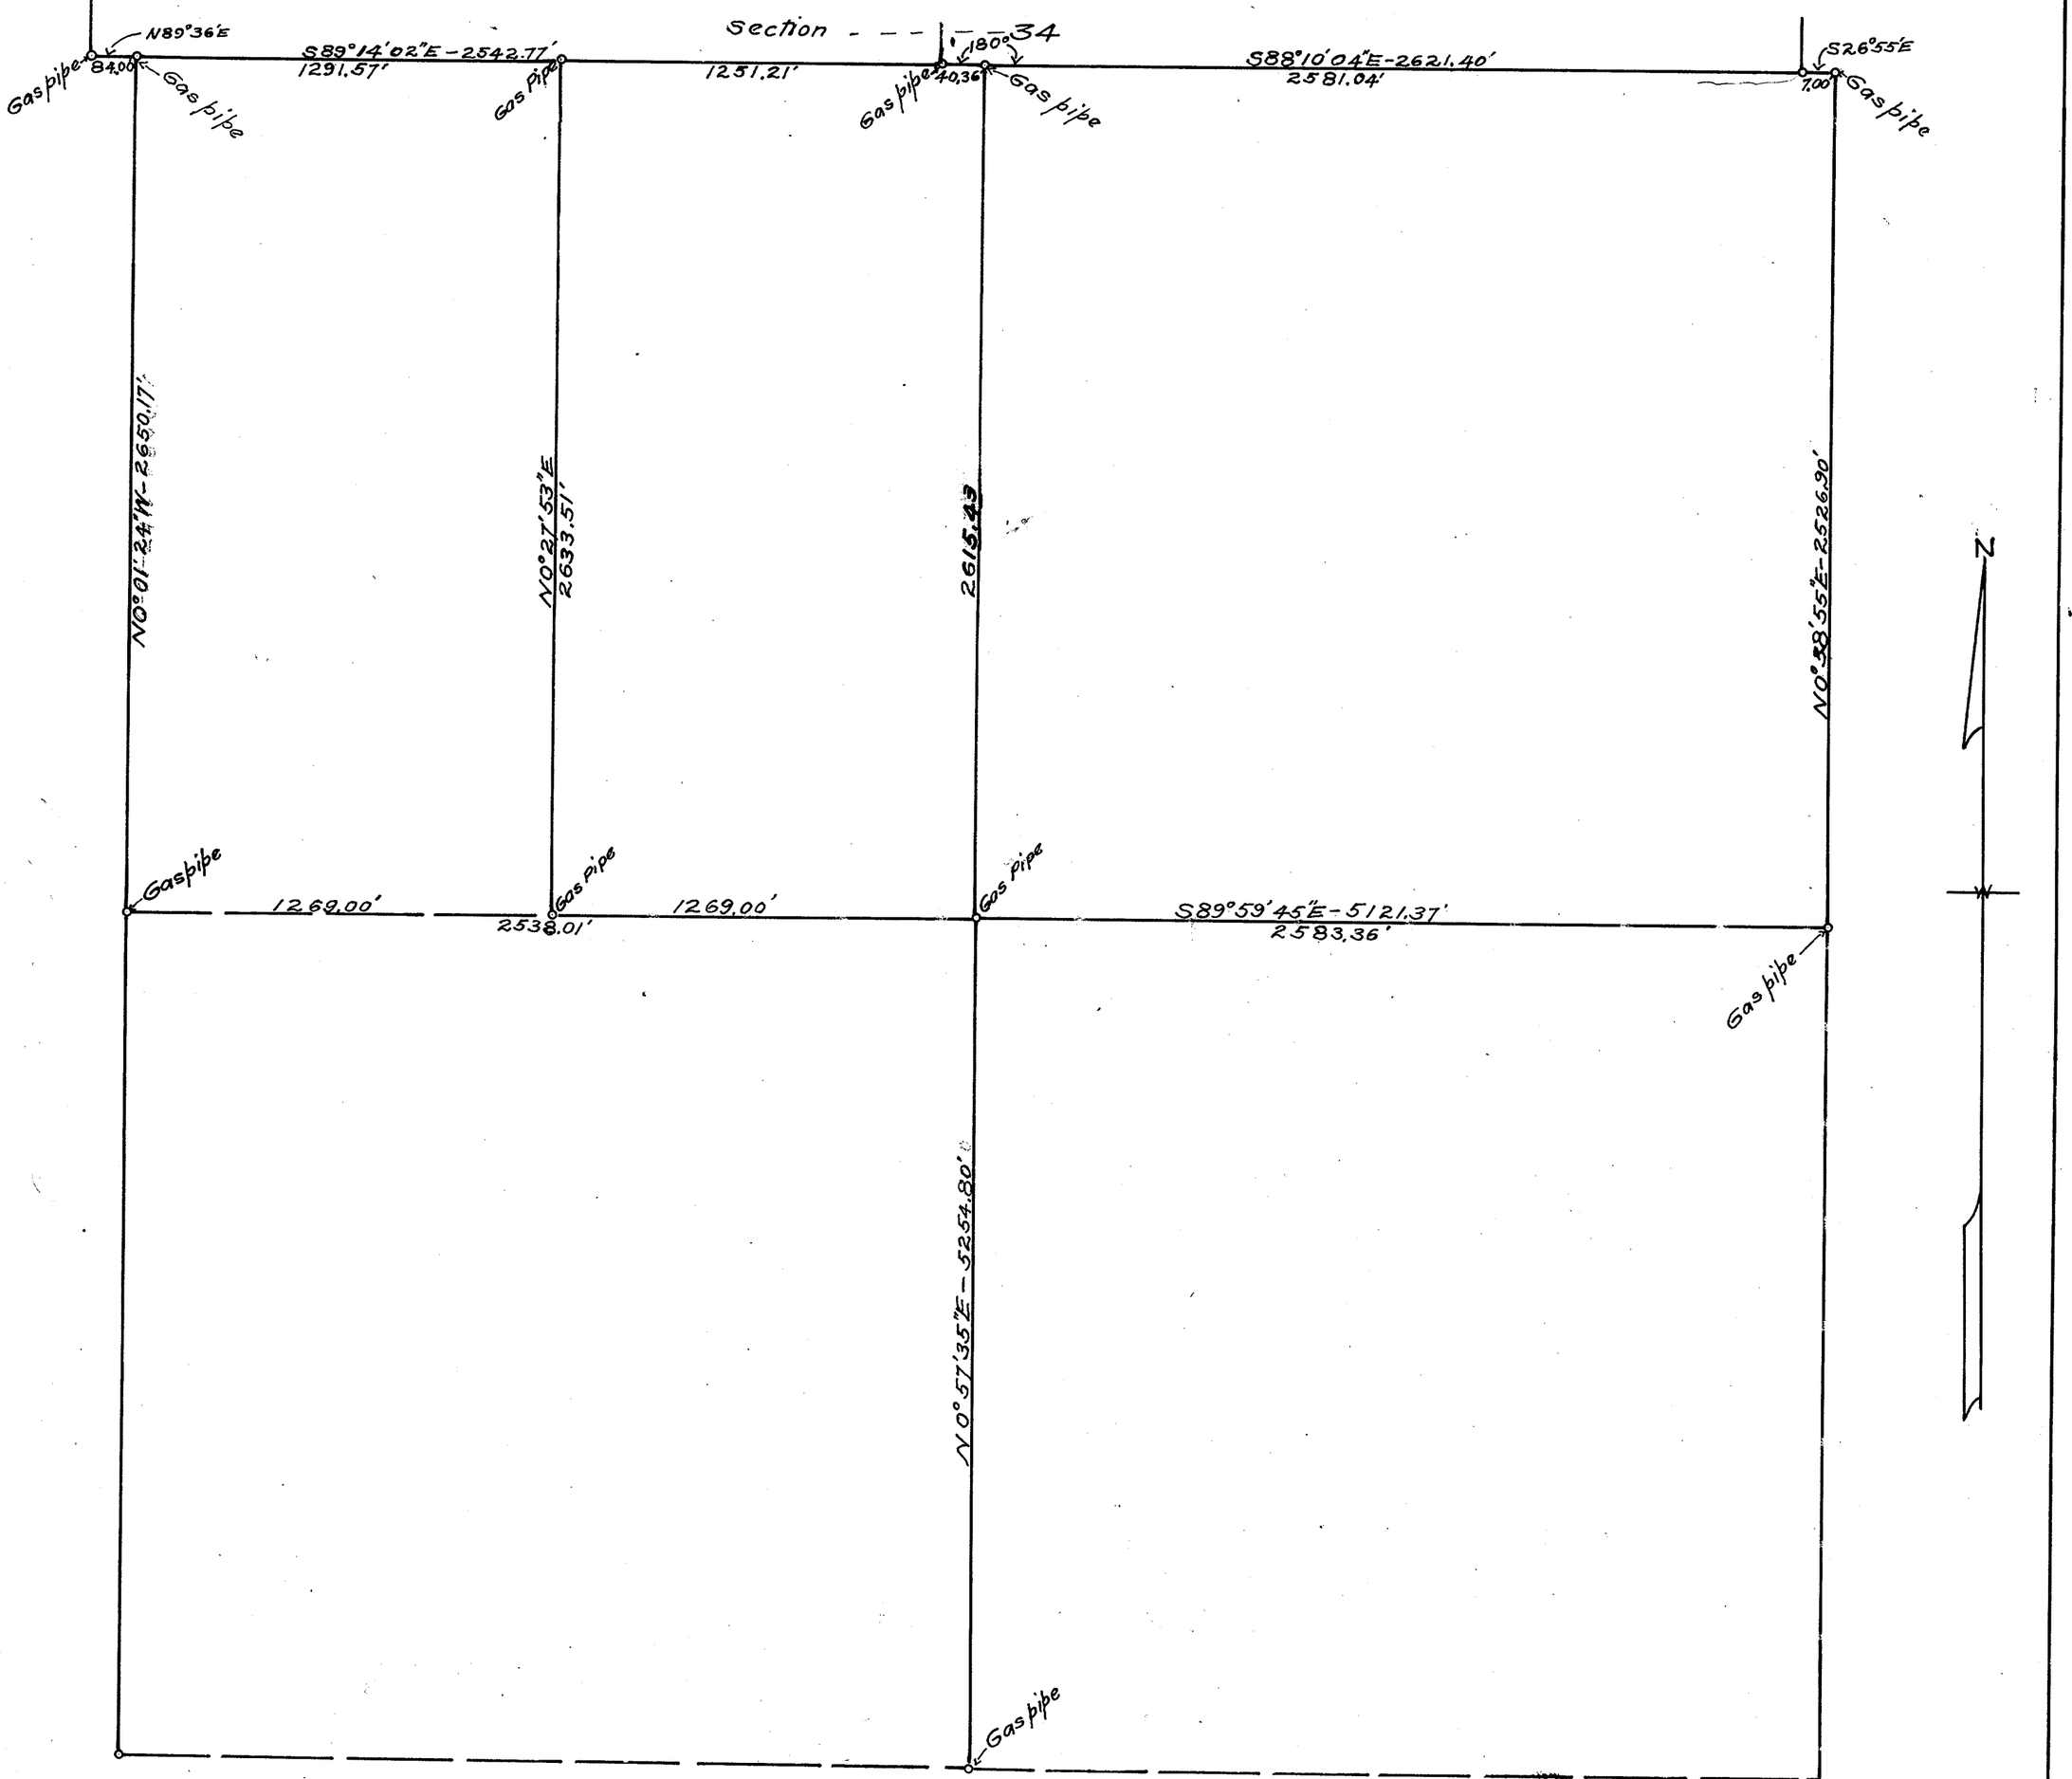

I hereby certify that this plat of section 3, Tp. 36 N. R3E, W.M. is made from notes of an actual survey upon the ground and that the courses and distances are as marked upon the face of the plat

H.M. Wellman,
surveyor.

Approved and filed for record by the County Engineer this 20 day of March A.D. 1915.

A. L. Strong
Engineer for Skagit Co. Wn.

SECTION 4


TOWNSHIP 36 NORTH, RANGE 3 EAST, W. M.

SKAGIT COUNTY, WASH.

SCALE, 1 INCH -- 400 FEET

DATE DECEMBER 1970

_____ COUNTY ENGINEER

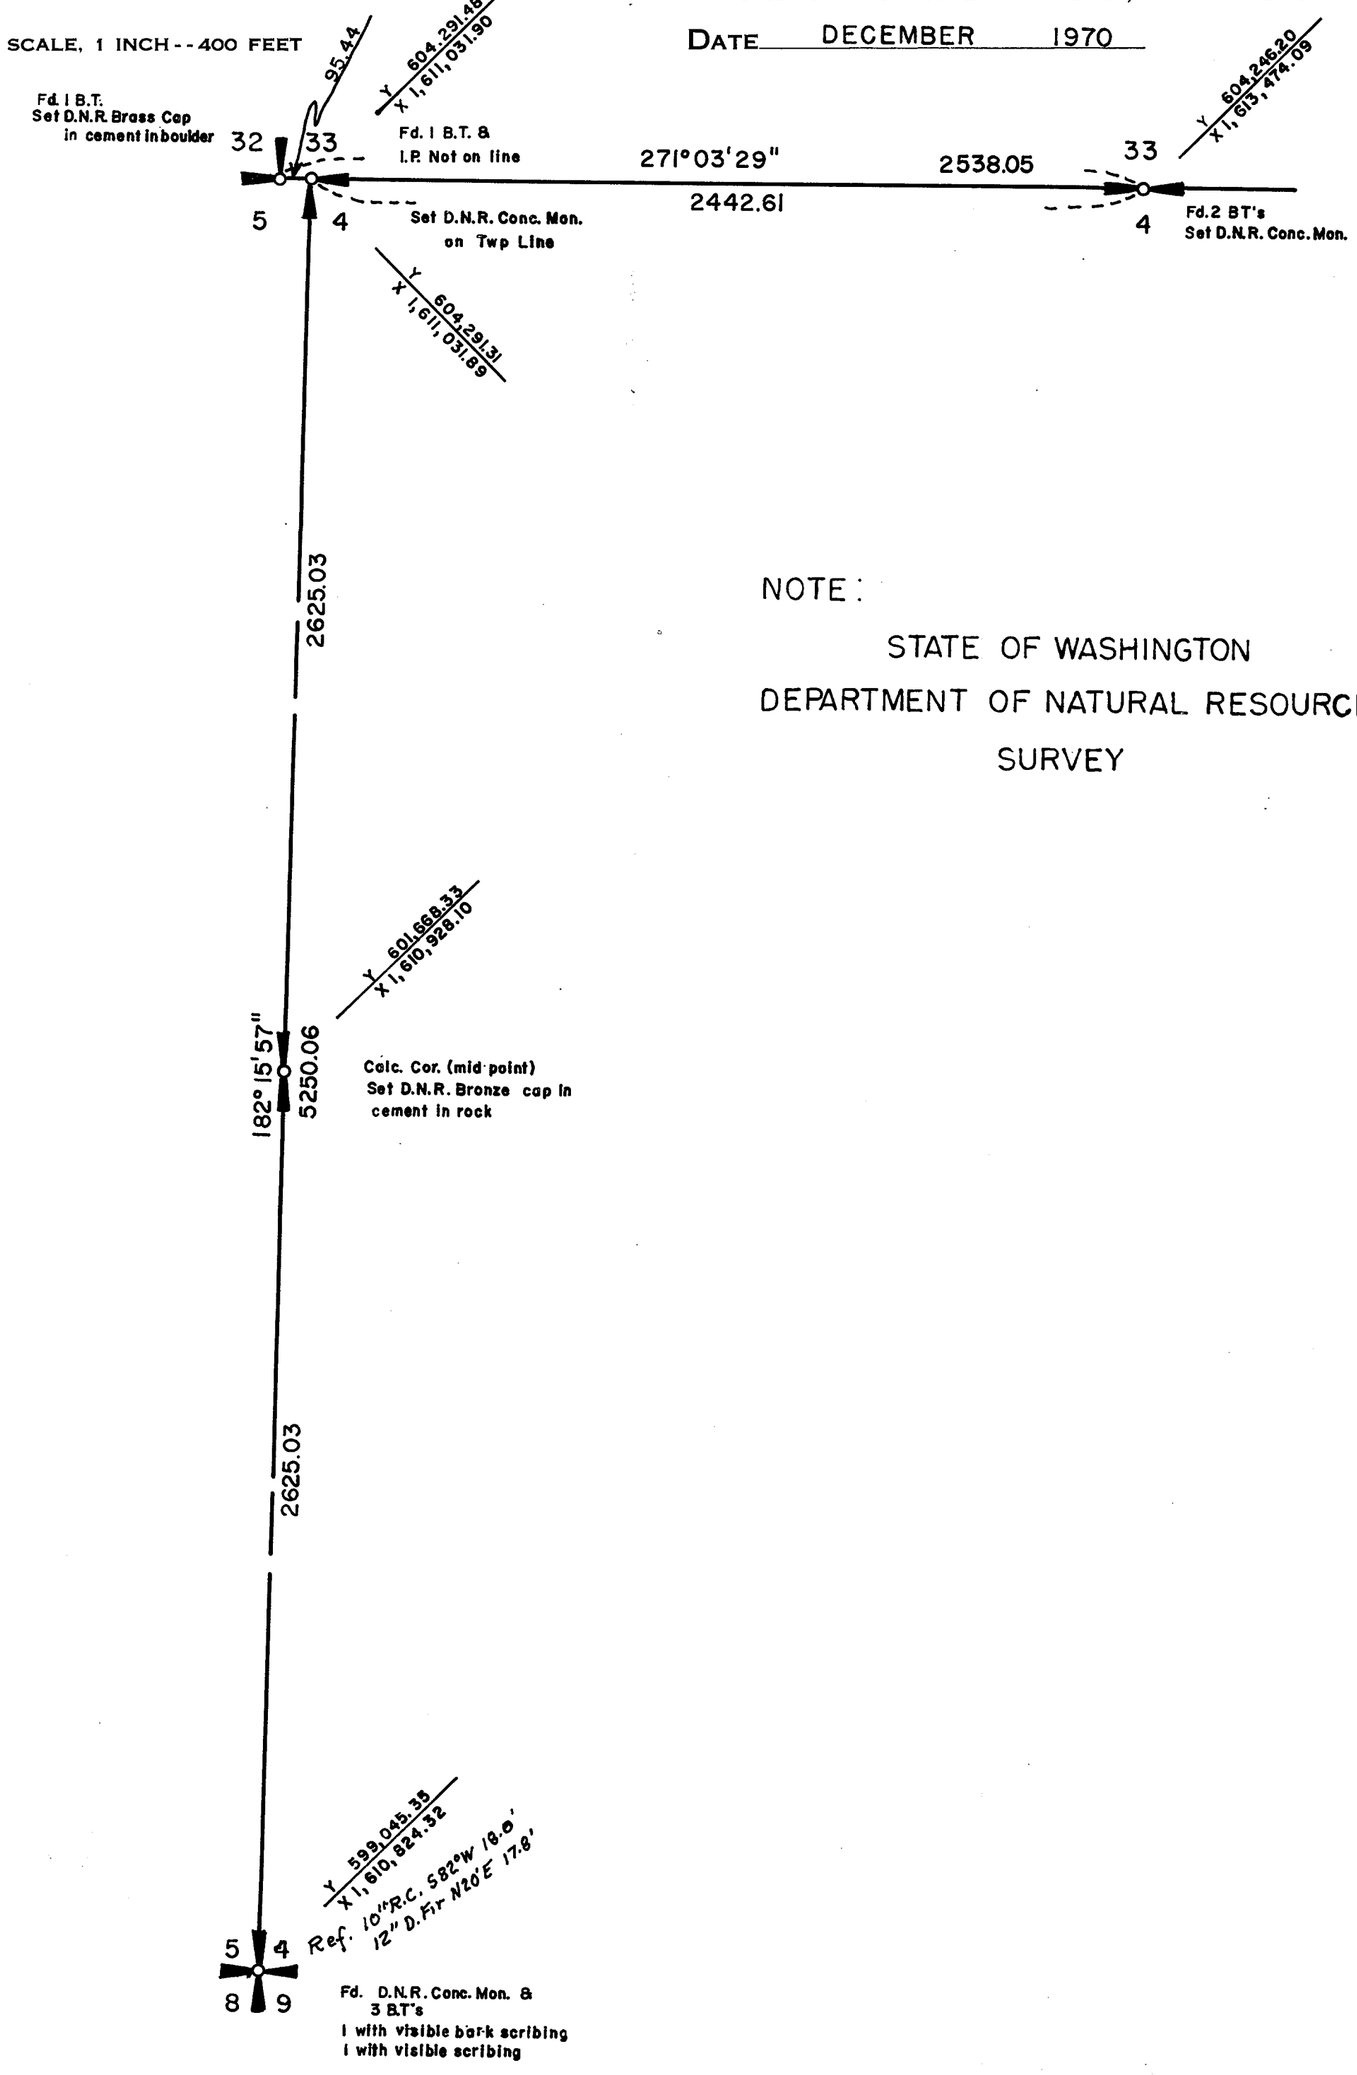

NOTE:

STATE OF WASHINGTON

DEPARTMENT OF NATURAL RESOURCES

SURVEY

SECTION 5

TOWNSHIP 36 NORTH, RANGE 3 EAST, W. M.

SKAGIT COUNTY, WASH.

SCALE, 1 INCH--400 FEET

DATE OCTOBER 1970

COUNTY ENGINEER

Fd. 2 BT's. Set 2 D.N.R. Conc. Reference Mons

Y 604,425.80 X 1,605,803.50

31 32 6 5

96.35

2567.34

Set D.N.R. Conc. Mon. Calc. Cor.

Y 604,423.31 X 1,605,899.82

2566.89

Calc. Cor. NOT SET

Y 604,359.44 X 1,608,365.98

95.90

271° 28' 52"

2566.89

Set D.N.R. Conc. Mon. Calc. Cor.

Y 604,356.96 X 1,608,465.85

2567.35

Fd. 1 B.T. Set D.N.R. Brass Cap in cement in boulder

32 33 5 4

95.44

Y 604,291.48 X 1,611,031.90

Fd. 1 B.T. & I.P. Not on line

Set D.N.R. Conc. Mon. on Twp. Line.

Y 604,293.07 X 1,610,936.47

Y 604,291.31 X 1,611,031.89

1352.90

1332.38

2625.03

271° 02' 26"

2585.84

2648.32

Set D.N.R. Conc. Mon Calc. Cor.

Set D.N.R. Conc. Mon. Calc. Cor.

1319.90

Y 601,736.47 X 1,605,721.44

1315.94

Y 601,712.40 X 1,608,324.90

Y 601,668.33 X 1,610,928.10

Set D.N.R. Conc. Mon. Calc Cor.

183° 49' 36"

270° 58' 11"

2603.83

Set D.N.R. Conc. Mon.

2603.58

182° 15' 57"

5250.06

Calc. Cor. (mid point) Set D.N.R. Bronze cap in cement in rock

NOTE: SURVEY BY
STATE OF WASHINGTON
DEPARTMENT OF NATURAL RESOURCES

Corners indicated as "Calculated Cor." were considered lost and were restored, as noted, in accord with the U.S. Bureau of Land Management Manual of Surveying Instructions 1947

2639.81

183° 03' 03"

2632.18

2625.03

Y 599,122.85 X 1,605,545.27

Y 599,083.95 X 1,608,184.80

Y 599,045.38 X 1,610,824.32

Ref. 10" R.C. S82°W 18.0' 12" D. Fir N20°E 17.8'

6 5 7 8

271° 50' 16"

2639.81

5 8

5279.61

2639.80

5 4 8 9

Calc. Cor. Govt. Distance from Estoblished corner to the North and from found corner to the East Set D.N.R. Conc. Mon.

Set D.N.R. Conc. Mon. Calc. Cor.

Fd. D.N.R. Conc. Mon. & 3 B.T.s
1 with visible bark scribing
1 with visible scribing

SECTION 6

TOWNSHIP 36 NORTH, RANGE 3 EAST, W. M.

SKAGIT COUNTY, WASH.

SCALE, 1 INCH -- 400 FEET

DATE DECEMBER 1970

_____ COUNTY ENGINEER

Ref. NW Cor.
10" hem S58½°W 19.5'
18" D.Fir S21°W 18.0'

Y 604,423.31
X 1,605,899.82

Fd. 2 BT's.
Set
2 D.N.R. Conc.
Reference Mons

31 32 96.35 (271° 28'52")

6 5 Set D.N.R. Conc. Mon.
Calc. Cor

N 49 E 28.90

Y 604,425.80
X 1,605,803.50

R.M. No 2

N 44 W 33.90

R.M. No. 1

1352.90

0 Set D.N.R. Conc. Mon.
Calc. Cor.

1319.90

Y 601,756.47
X 1,605,721.44

Set D.N.R. Conc Mon
Calc. Cor.

6 49' 36
183°

6 5

2639.81

SAMISH BAY

Y 599,152.78
X 1,604,113.50

6 M.C.
Calc Cor. 7

271° 12' 35"
1432.09

6 5
7 8

Y 599,122.55
X 1,605,545.27

Calc. Cor. Govt. Distance from
Established corner to the North
and from found corner to the East.
Set D.N.R. Conc. Mon.

SECTION 7


TOWNSHIP 36 NORTH, RANGE 3 EAST, W. M.

SKAGIT COUNTY, WASH.

SCALE, 1 INCH -- 400 FEET

DATE DECEMBER 1970

_____ COUNTY ENGINEER

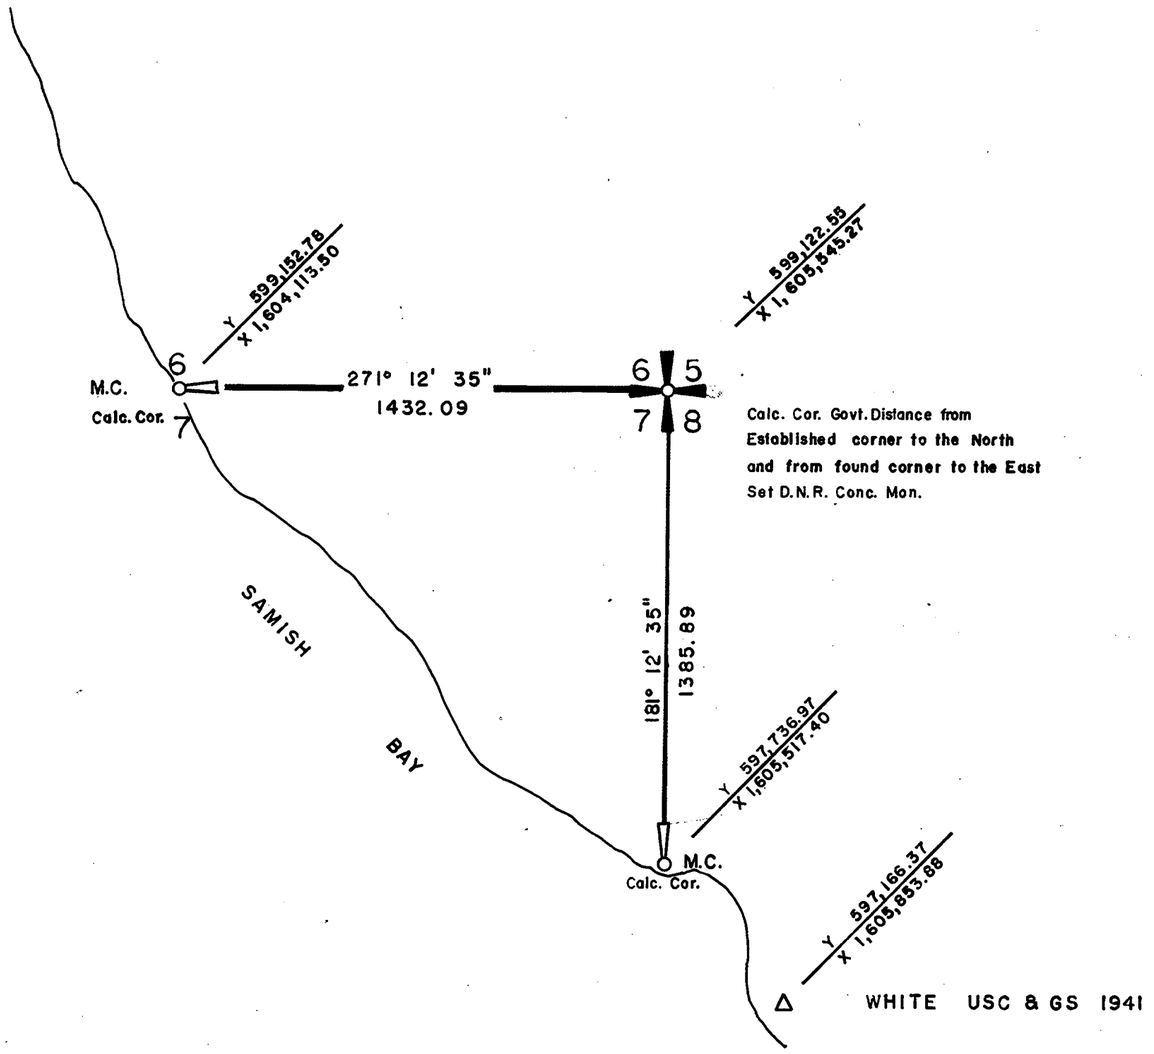

SECTION 12


TOWNSHIP 36 NORTH, RANGE 3 EAST, W. M.

SKAGIT COUNTY, WASH.

SCALE, 1 INCH–400 FEET

COUNTY ENGINEER

Comm Dist No 2

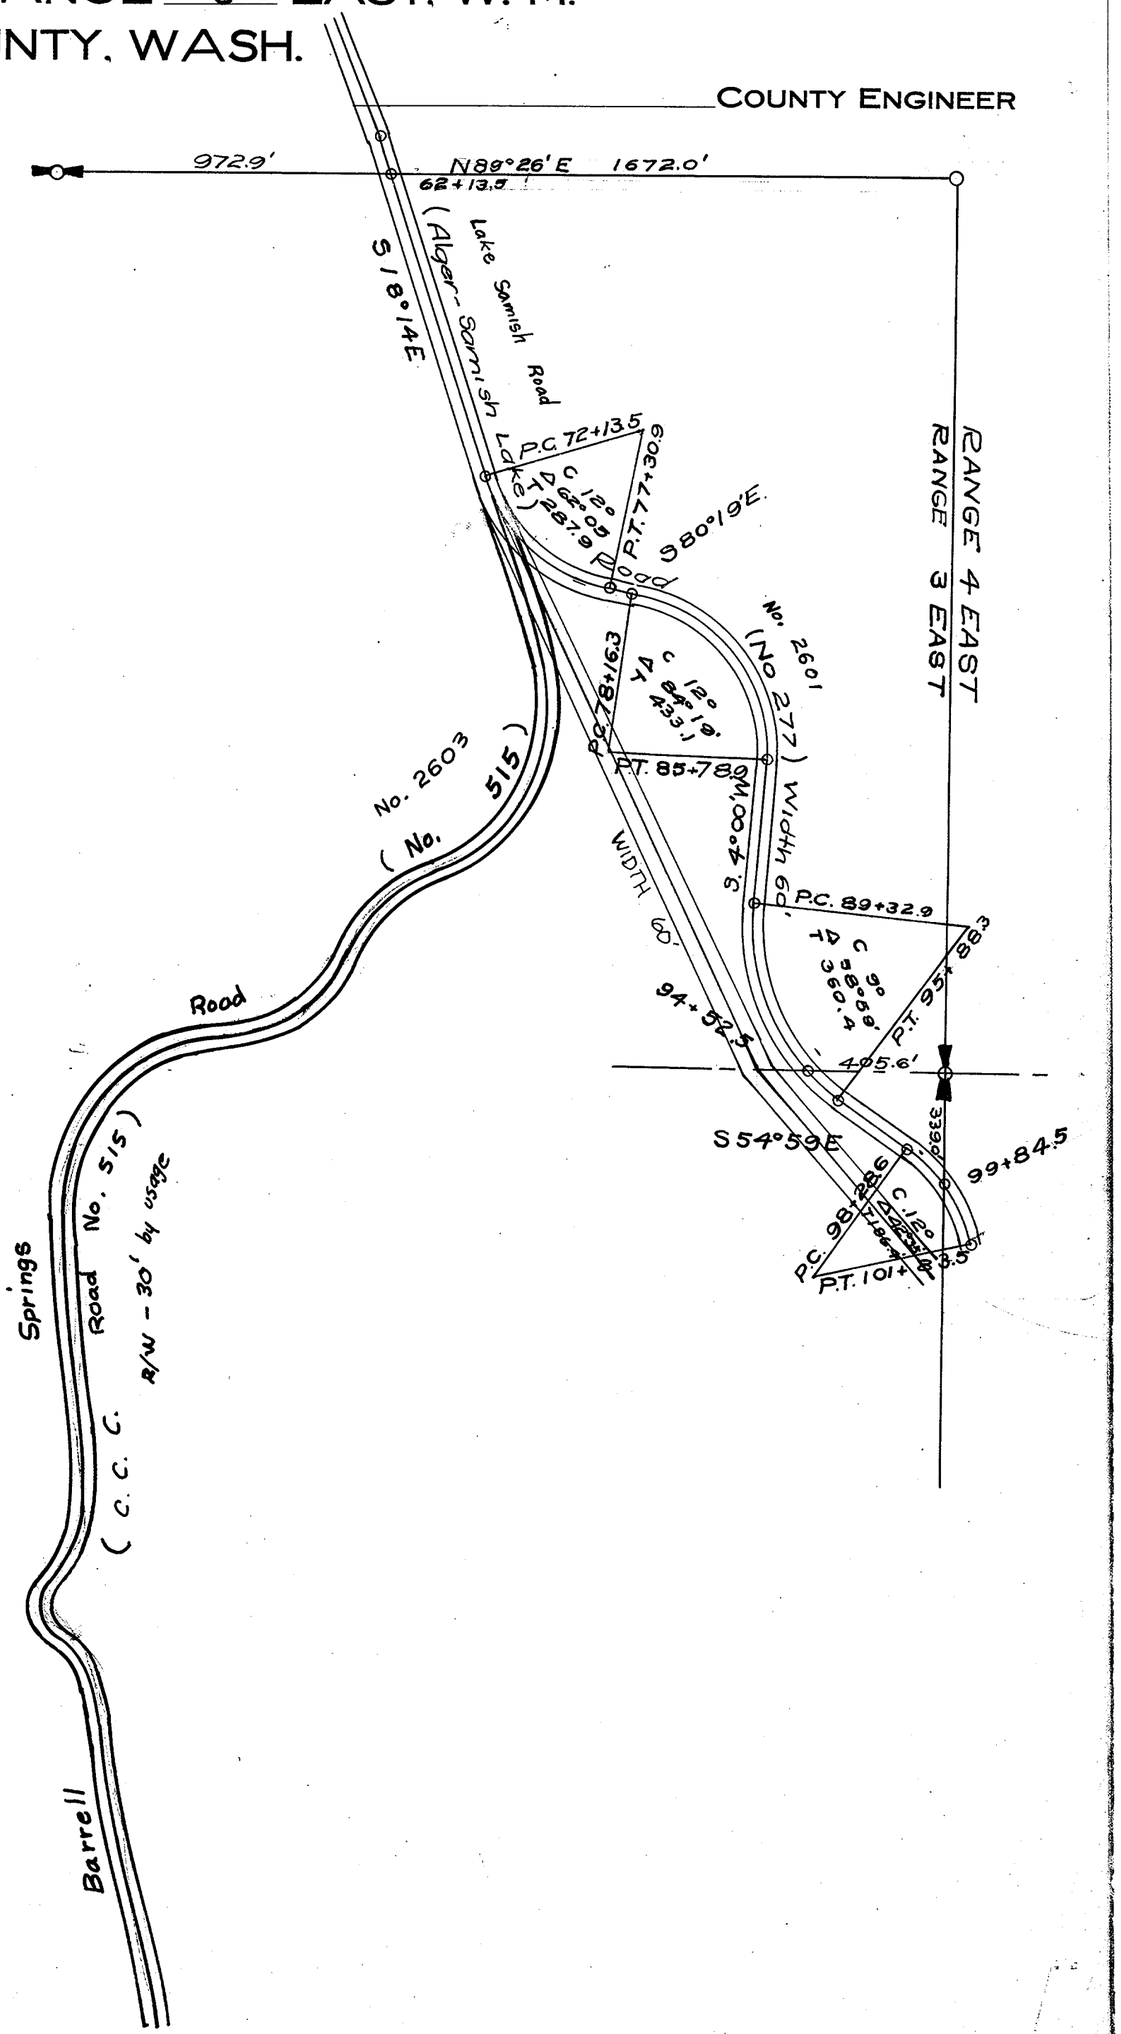

SECTION 12

TOWNSHIP 36 NORTH, RANGE 3 EAST, W. M.

SKAGIT COUNTY, WASH.

SCALE, 1 INCH--400 FEET


DATE August, 1965

Lloyd Johnson COUNTY ENGINEER

GEN. NOTATION : THIS TRACING DRAWING FROM AERIAL PHOTO

* PREVIOUS TRACING SHOWING LAKE SAMISH ROAD IN DETAIL TO SCALE

SUB-DIVISION INFORMATION TAKEN FROM PREVIOUS TRACING

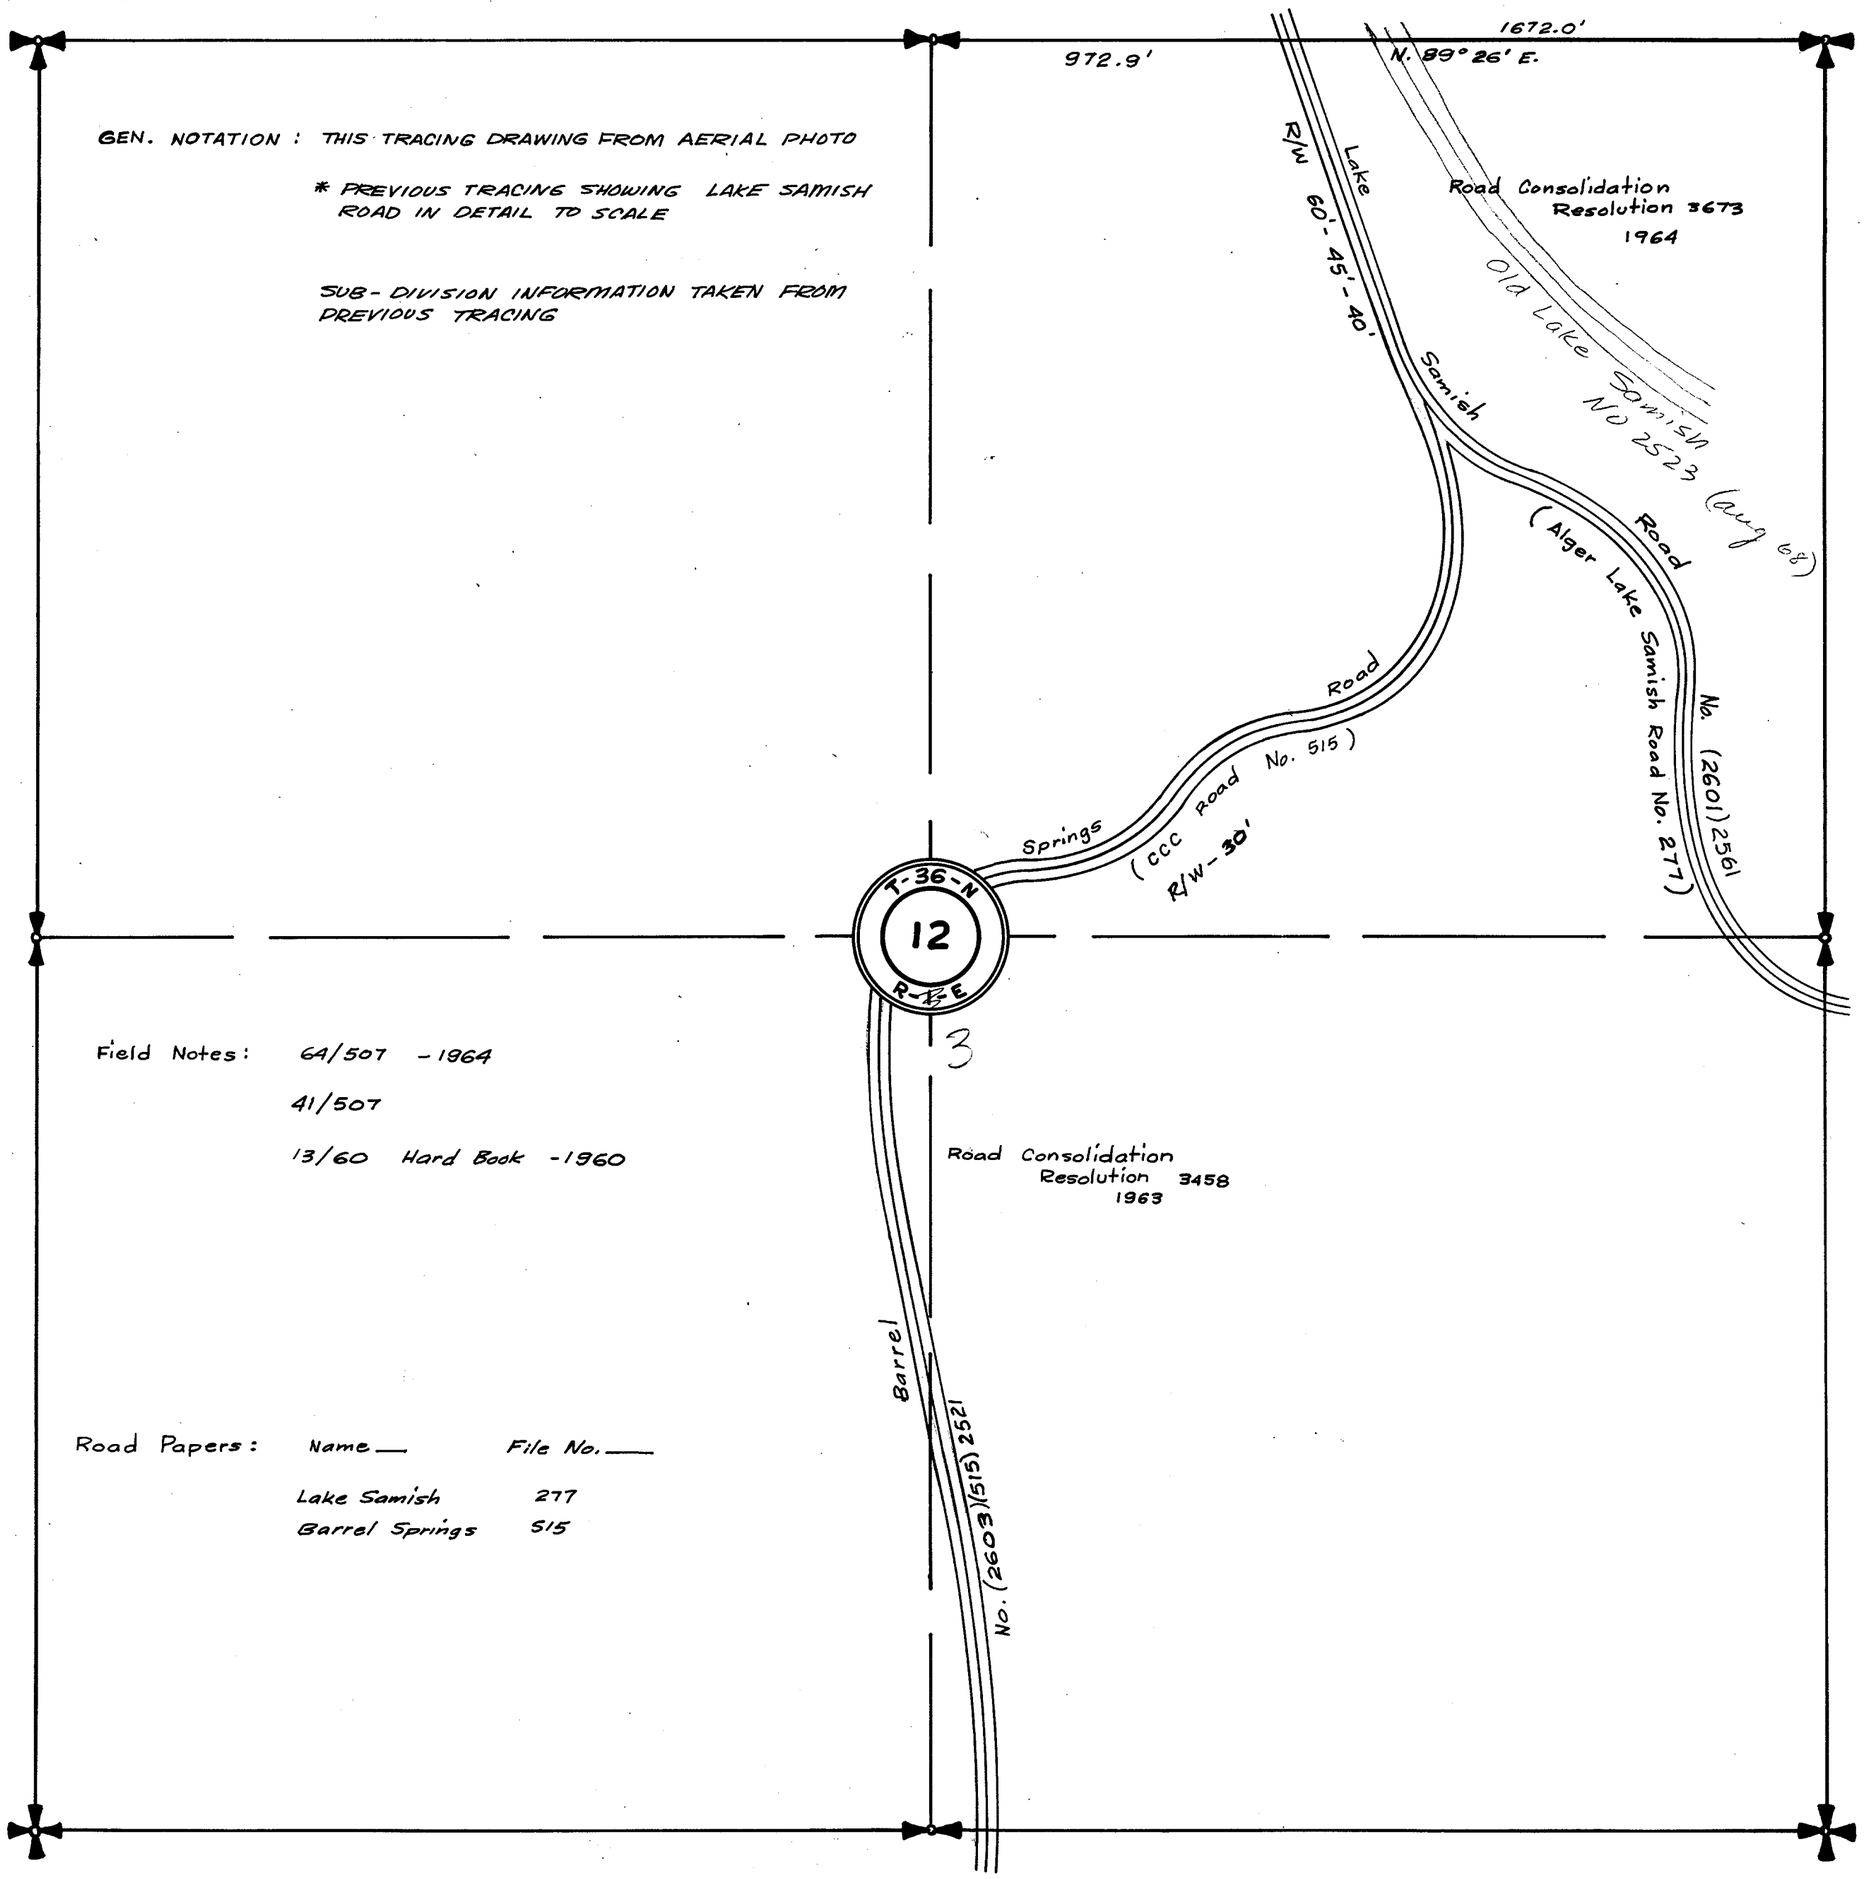

Field Notes: 64/507 -1964

41/507

13/60 Hard Book -1960

Road Papers: Name — File No. —

Lake Samish 277

Barrel Springs 515

SECTION 12

TOWNSHIP 36 NORTH, RANGE 3 EAST, W. M.


SKAGIT COUNTY, WASH.

SCALE, 1 INCH--400 FEET

D. H.

DATE Dec. 2, 1965

LLOYD JOHNSON COUNTY ENGINEER

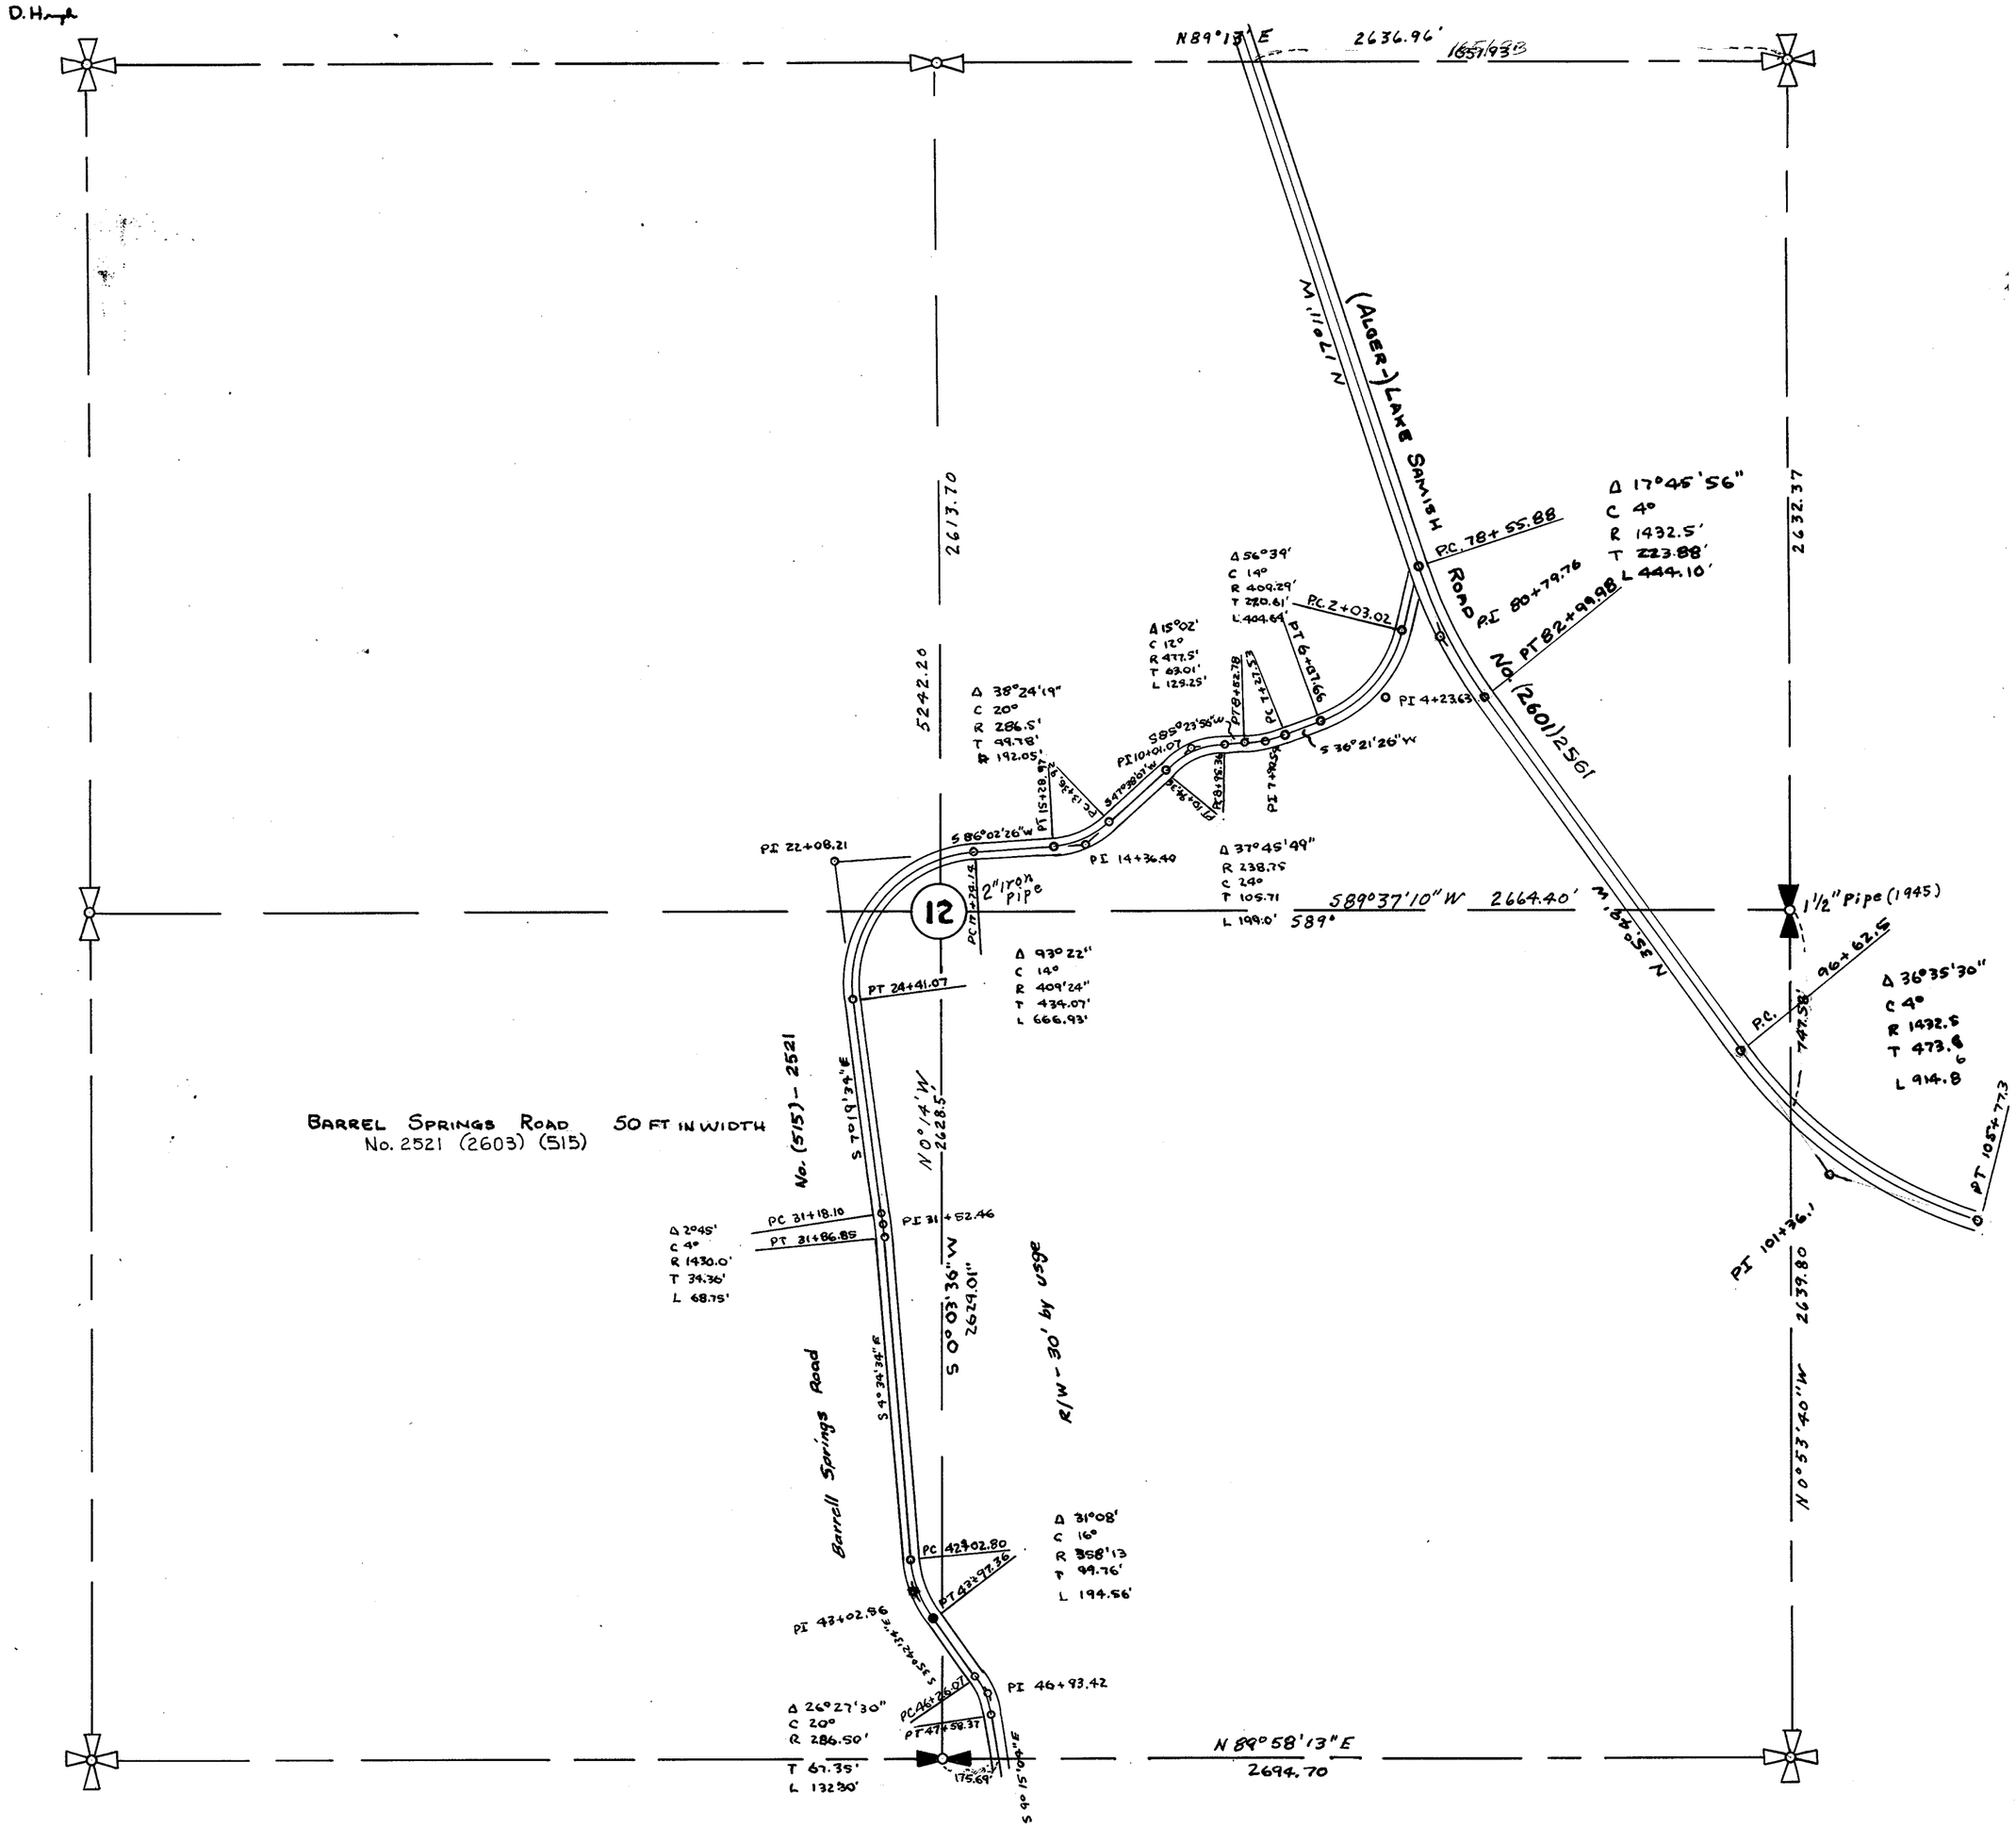

SECTION 13


TOWNSHIP 36 NORTH, RANGE 3 EAST, W. M.

SKAGIT COUNTY, WASH.

SCALE, 1 INCH--400 FEET
D. H.

DATE DECEMBER 2, 1965

LLOYD JOHNSON COUNTY ENGINEER

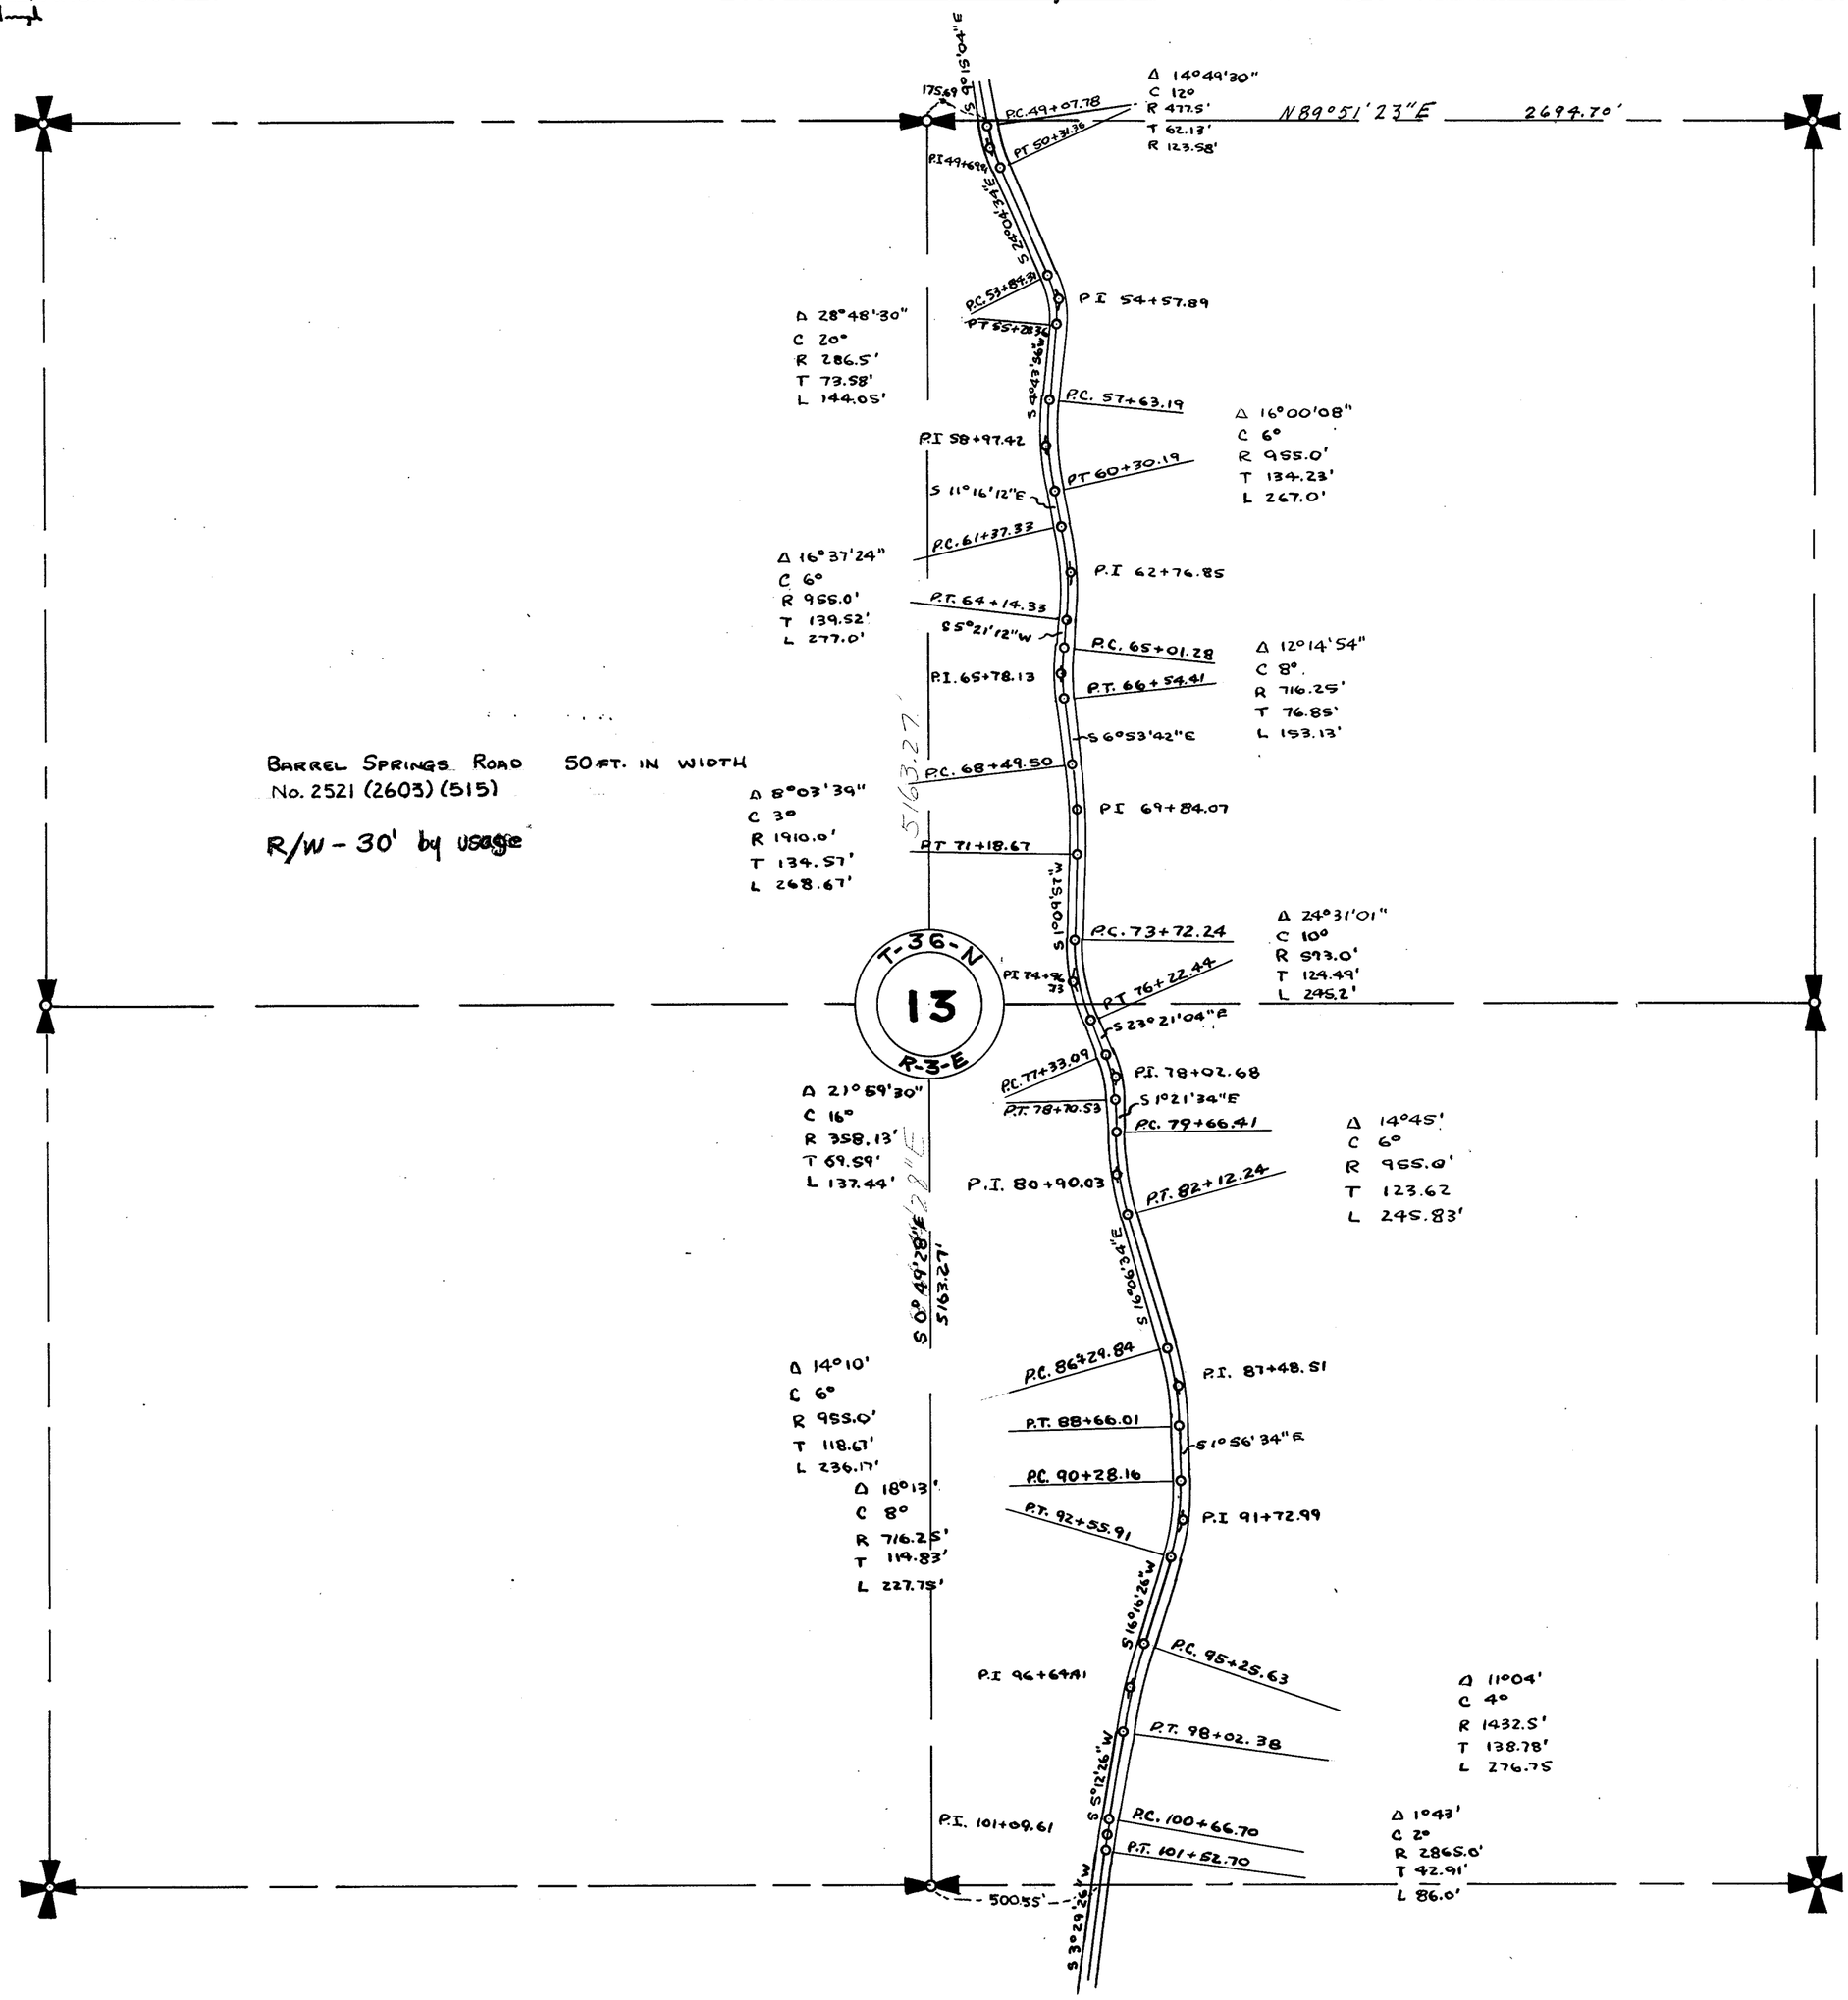

BARREL SPRINGS ROAD 50 FT. IN WIDTH
No. 2521 (2603) (515)

R/W - 30' by usage



TOWNSHIP 36 NORTH, RANGE 3 EAST, W. M.

SKAGIT COUNTY, WASH.

SCALE, 1 INCH--400 FEET

DATE July, 1959

Frank Gilkey COUNTY ENGINEER

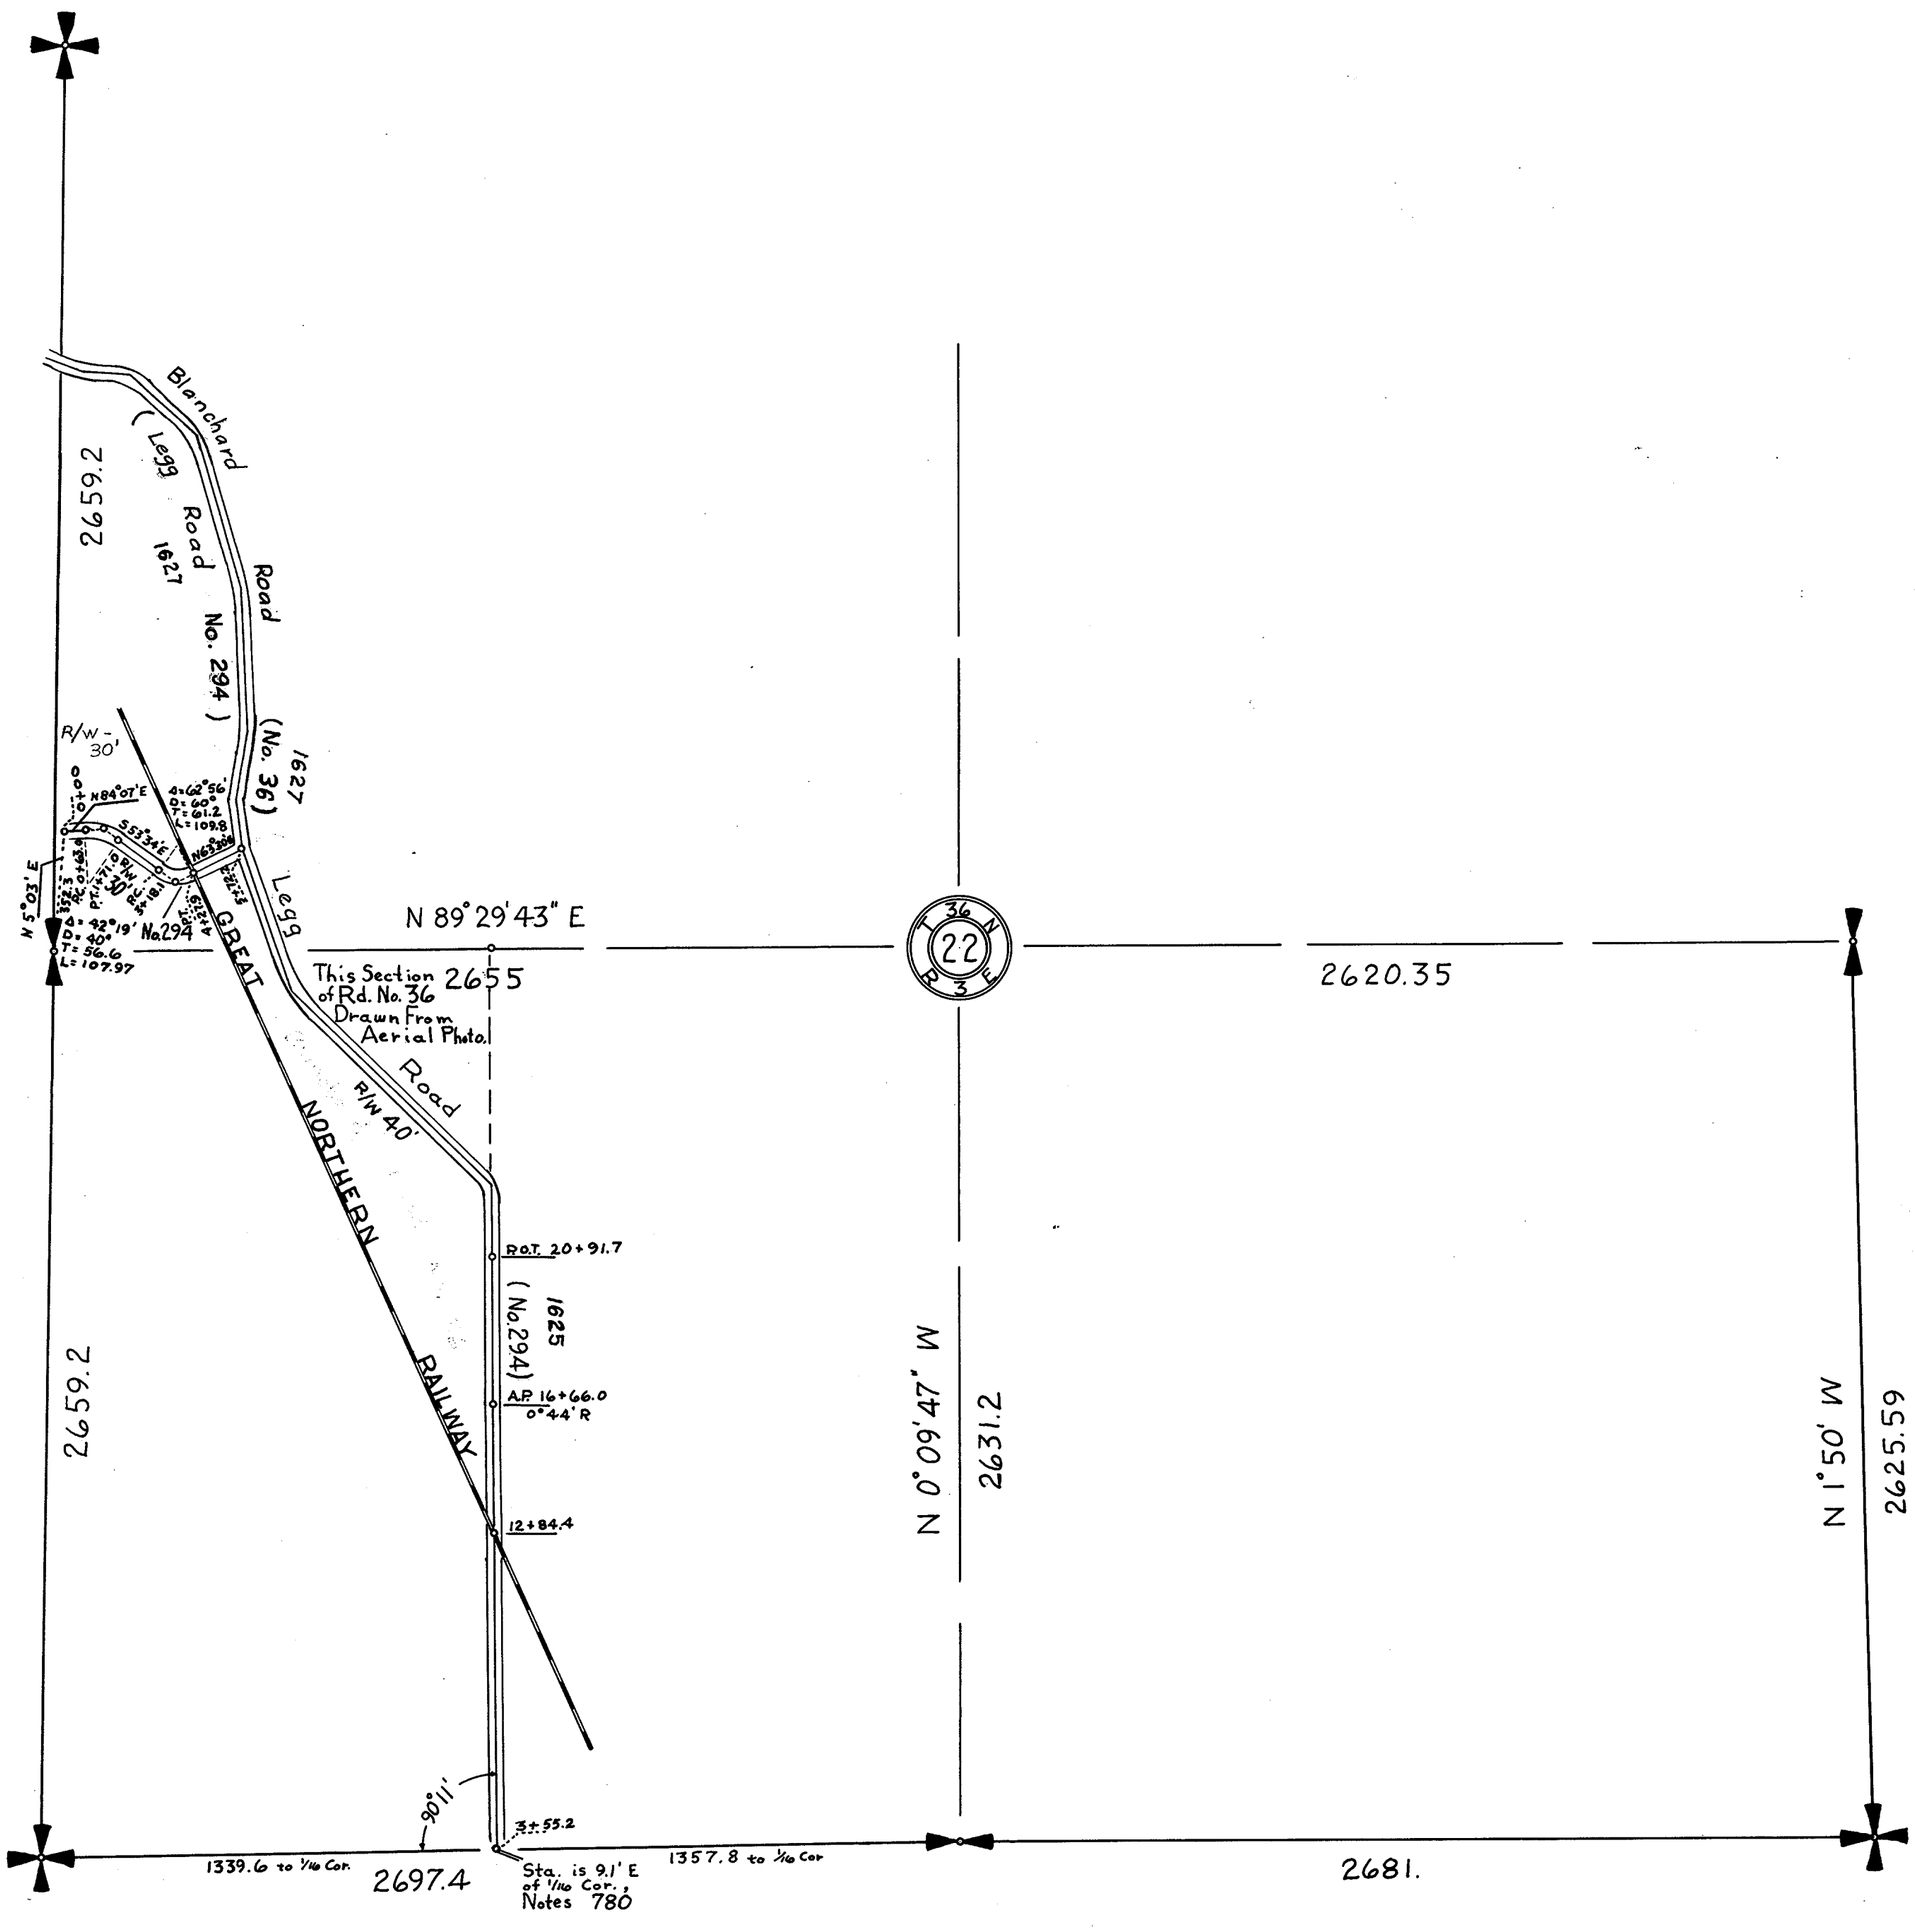


SECTION 22

TOWNSHIP 36 NORTH, RANGE 3 EAST, W. M.
SKAGIT COUNTY, WASH.

SCALE, 1 INCH=400 FEET

_____ COUNTY ENGINEER

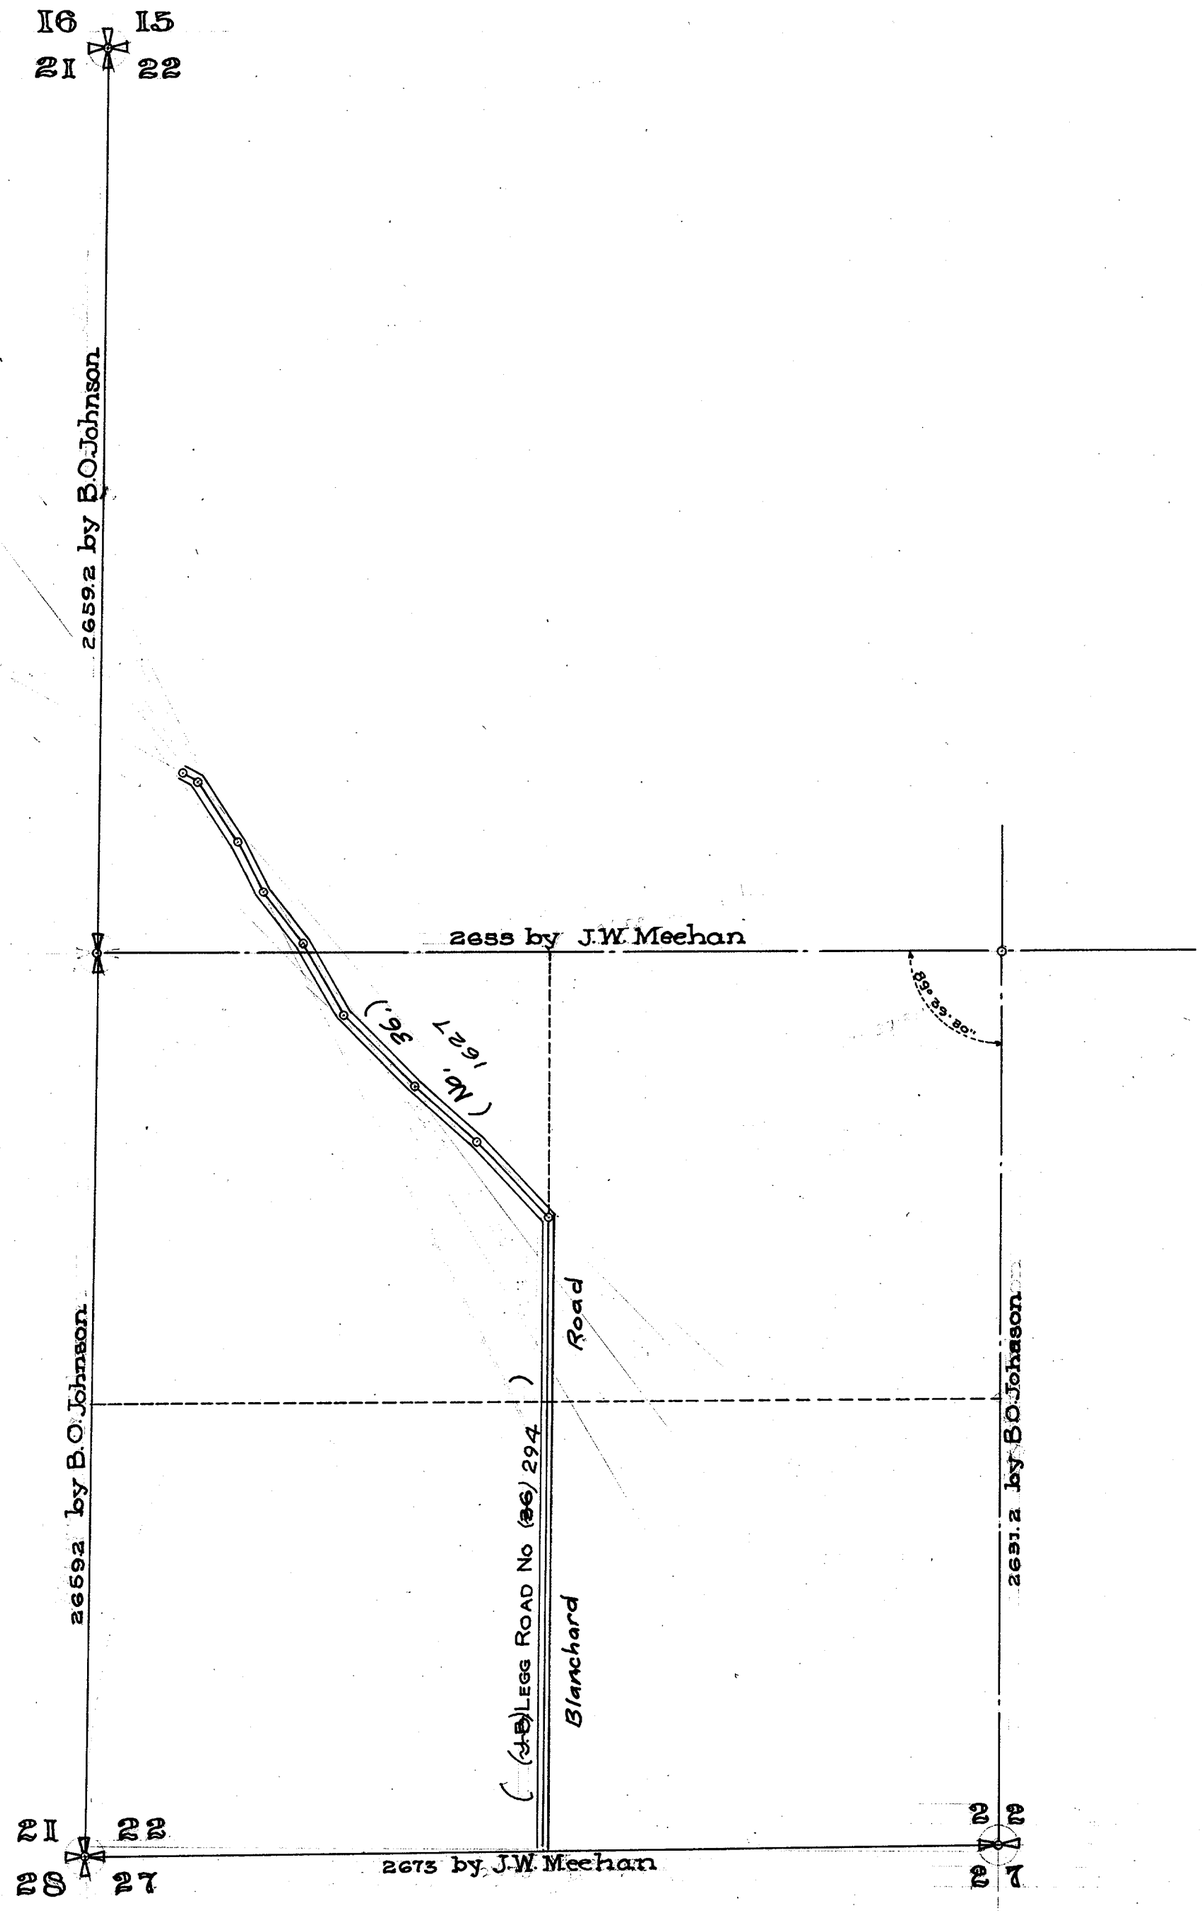

SECTION 22

TOWNSHIP 36 NORTH, RANGE 3 EAST, W. M.


SKAGIT COUNTY, WASH.

SCALE, 1 INCH--400 FEET

DATE August, 1965 — Lloyd Johnson COUNTY ENGINEER

GEN. NOTATION: THIS TRACING DRAWN FROM AERIAL PHOTO

SUB-DIVISION INFORMATION DRAWN FROM PREVIOUS TRACING (July, 1959)

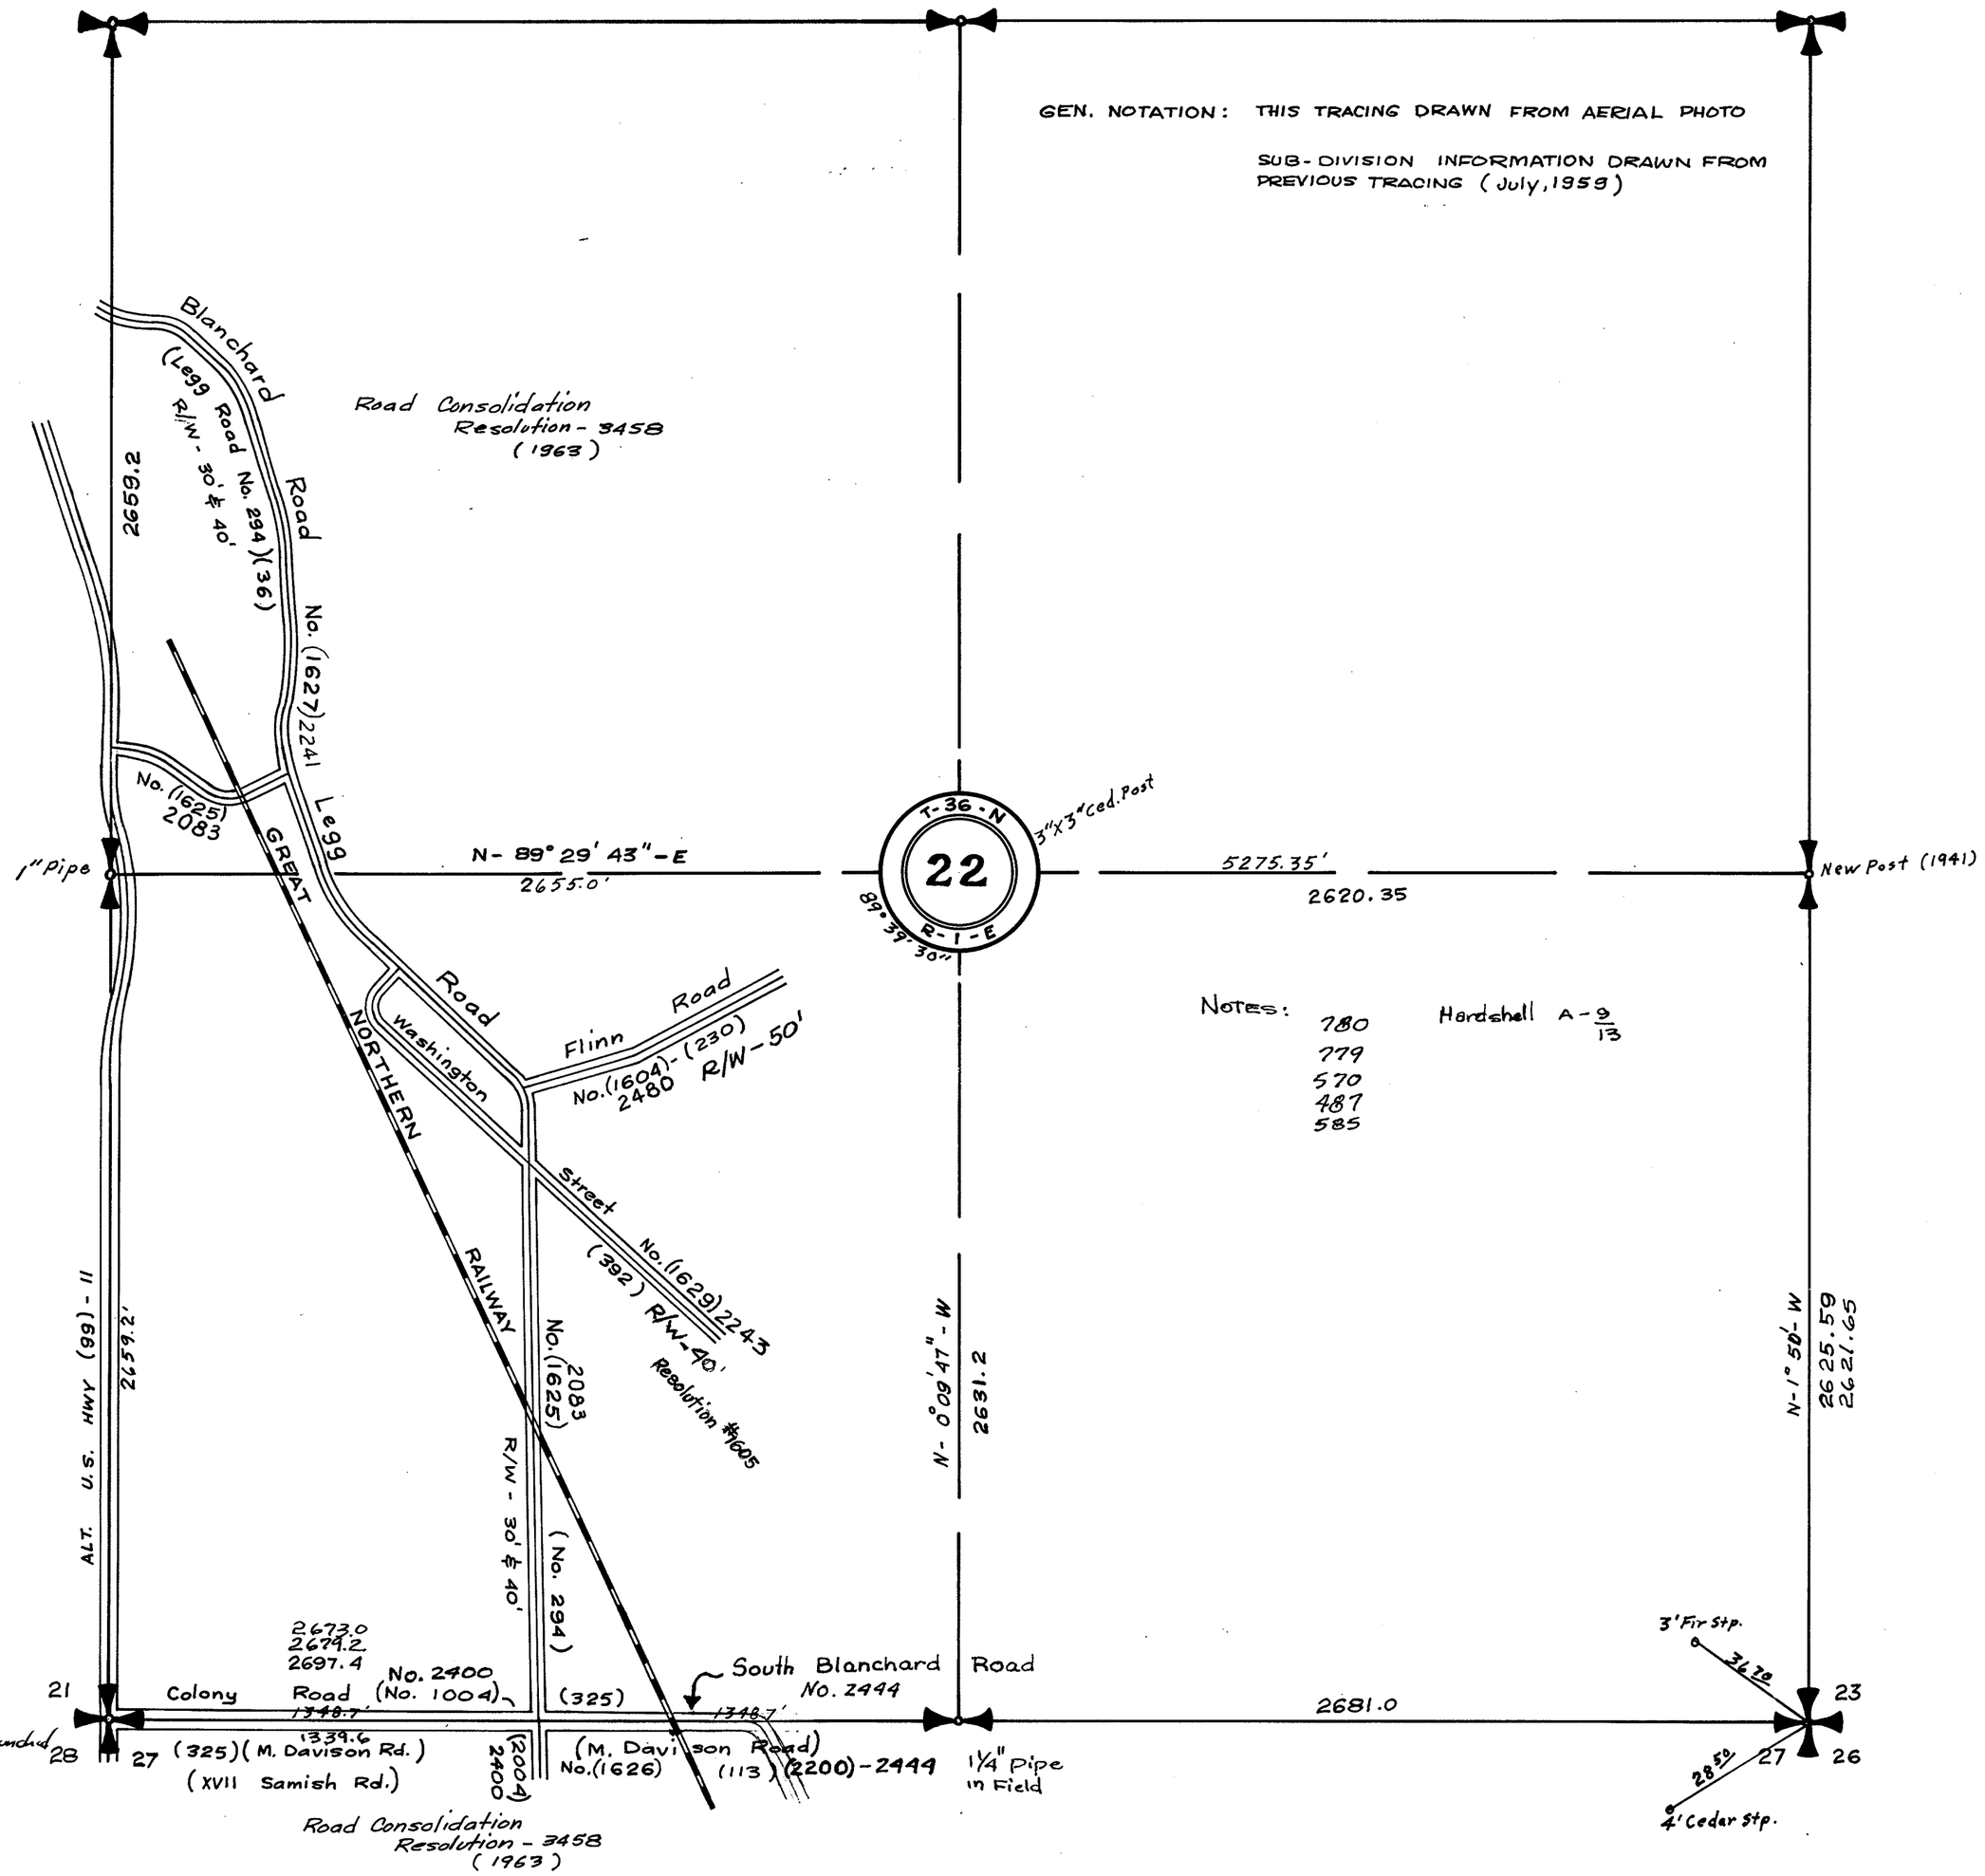




SKAGIT COUNTY, WASH.

SCALE, 1 INCH--400 FEET
D.H.

DATE DEC. 3, 1965

LLOYD JOHNSON COUNTY ENGINEER

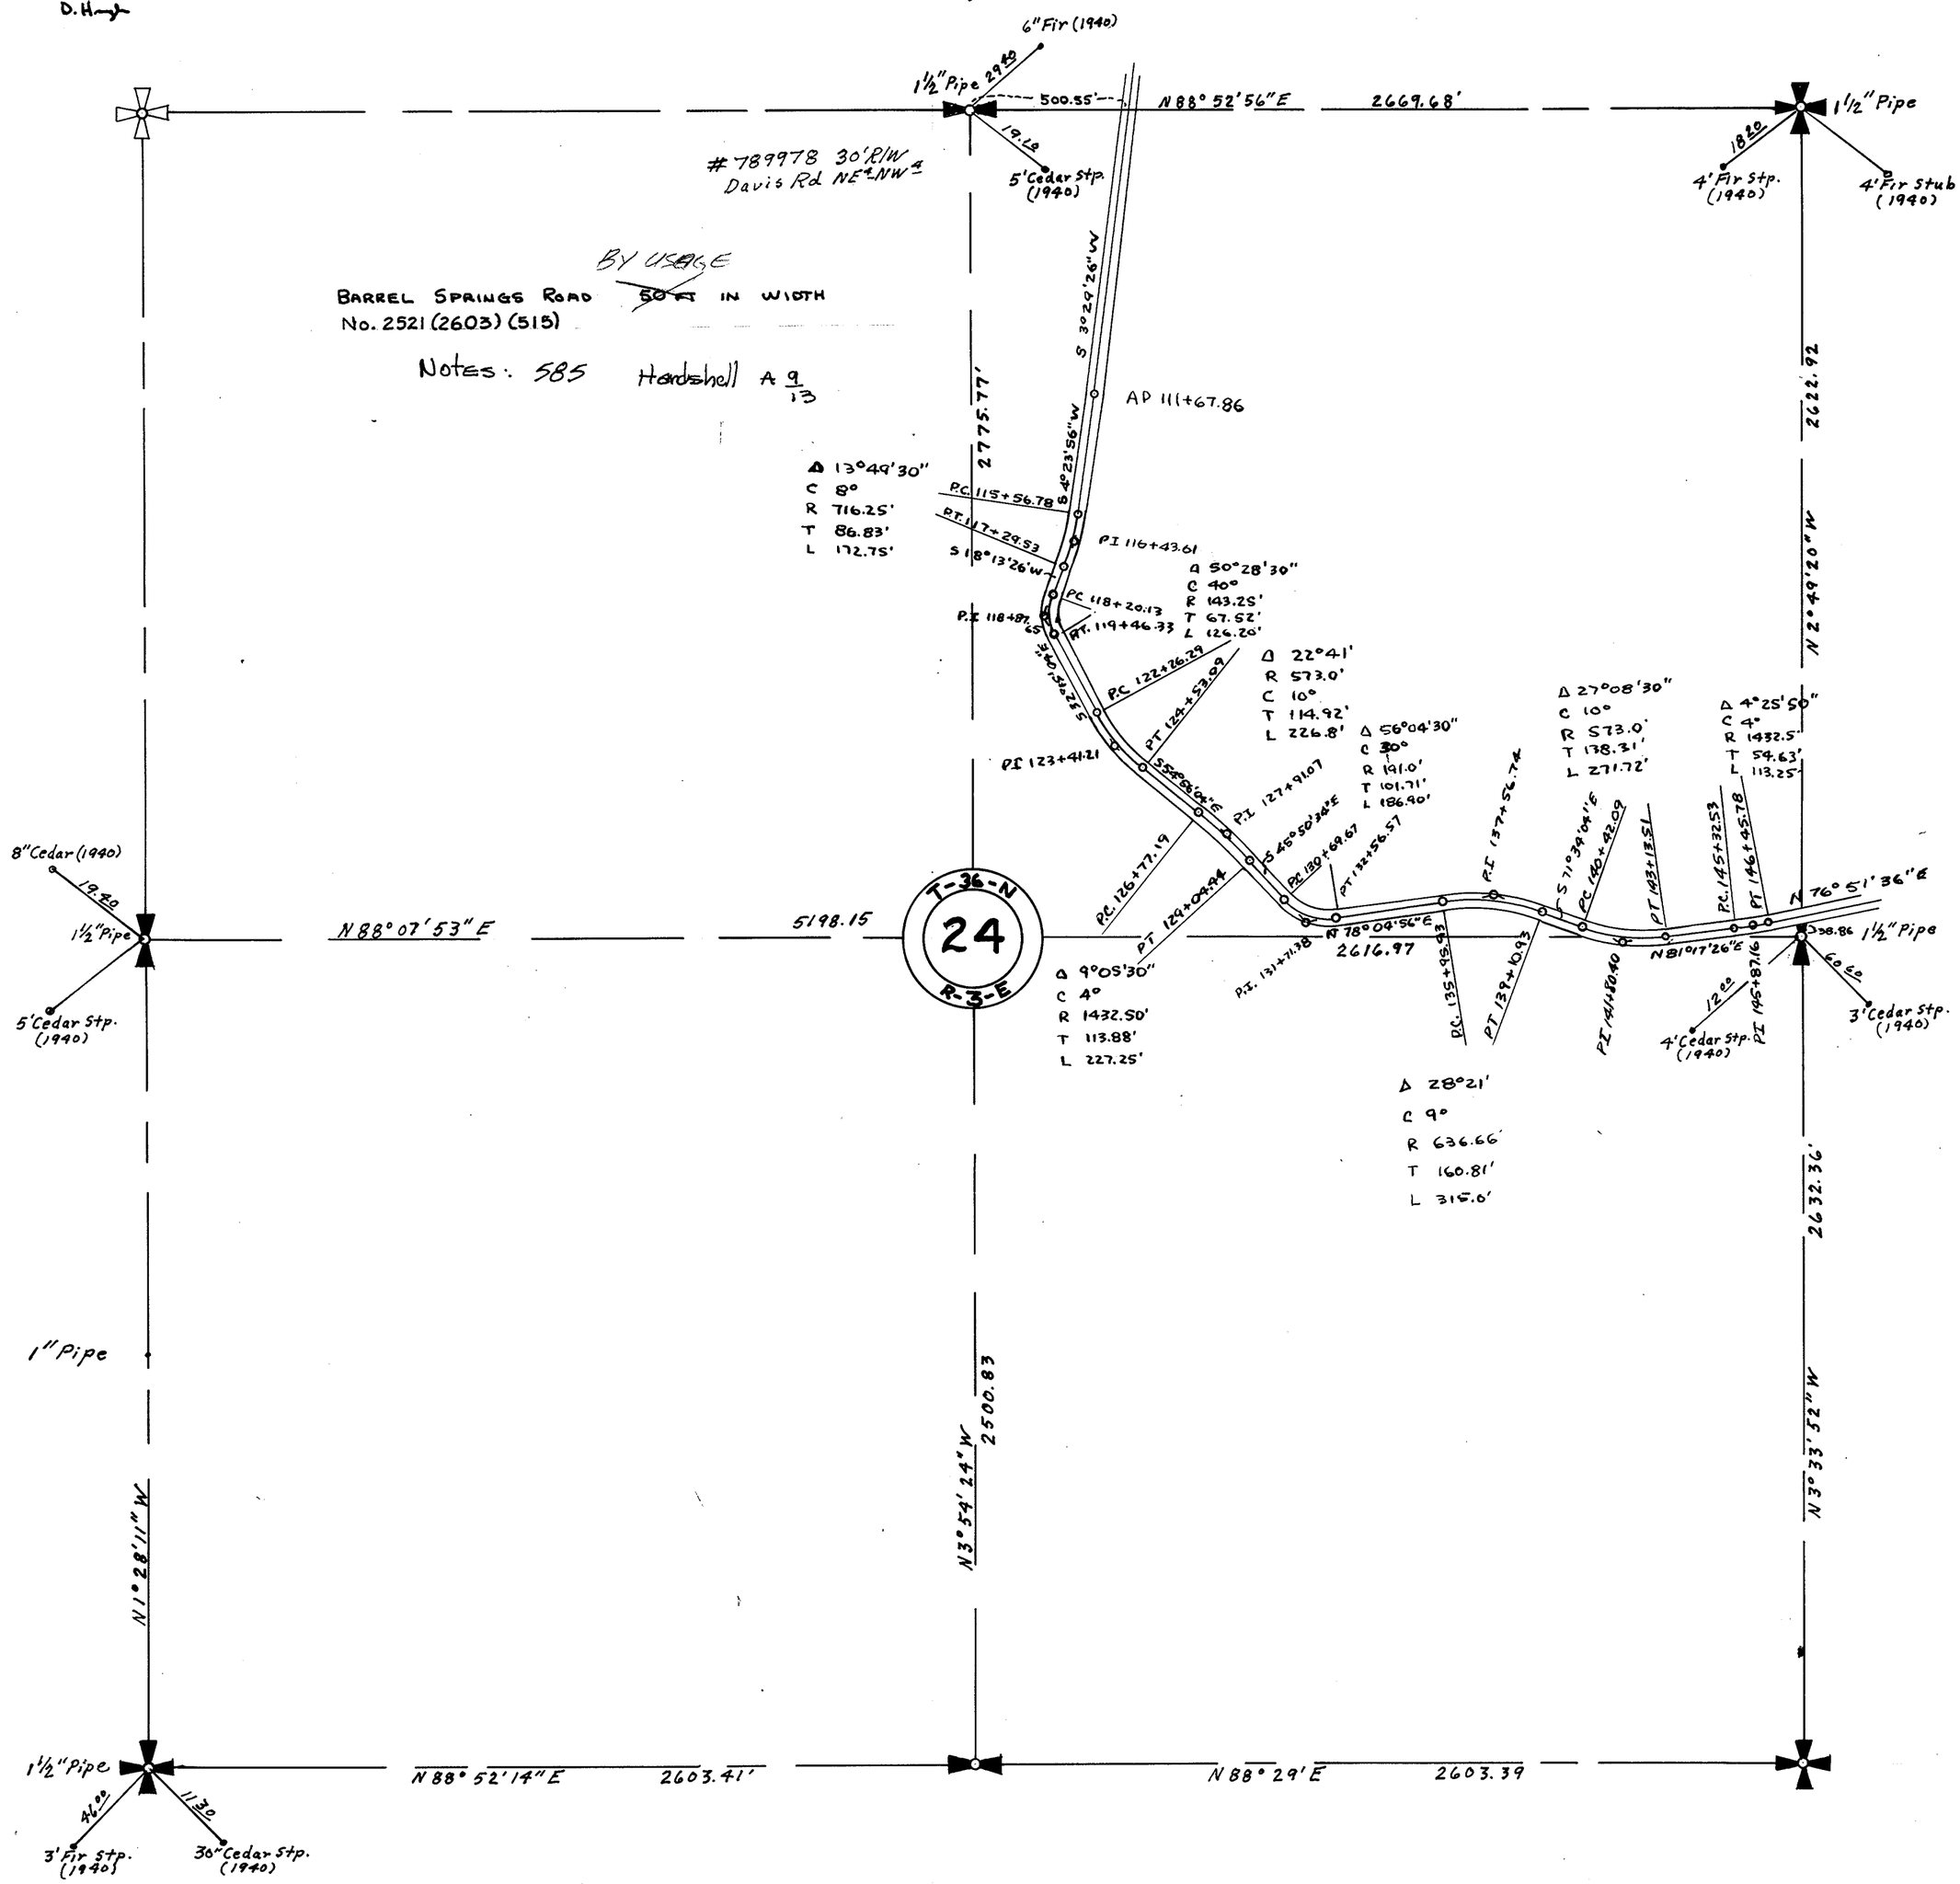


SECTION 24

TOWNSHIP 36 NORTH, RANGE 3 EAST, W. M.
SKAGIT COUNTY, WASH.

SCALE, 1 INCH=400 FEET
1932- Notes G-192

See B18
13

KNAPP COUNTY ENGINEER

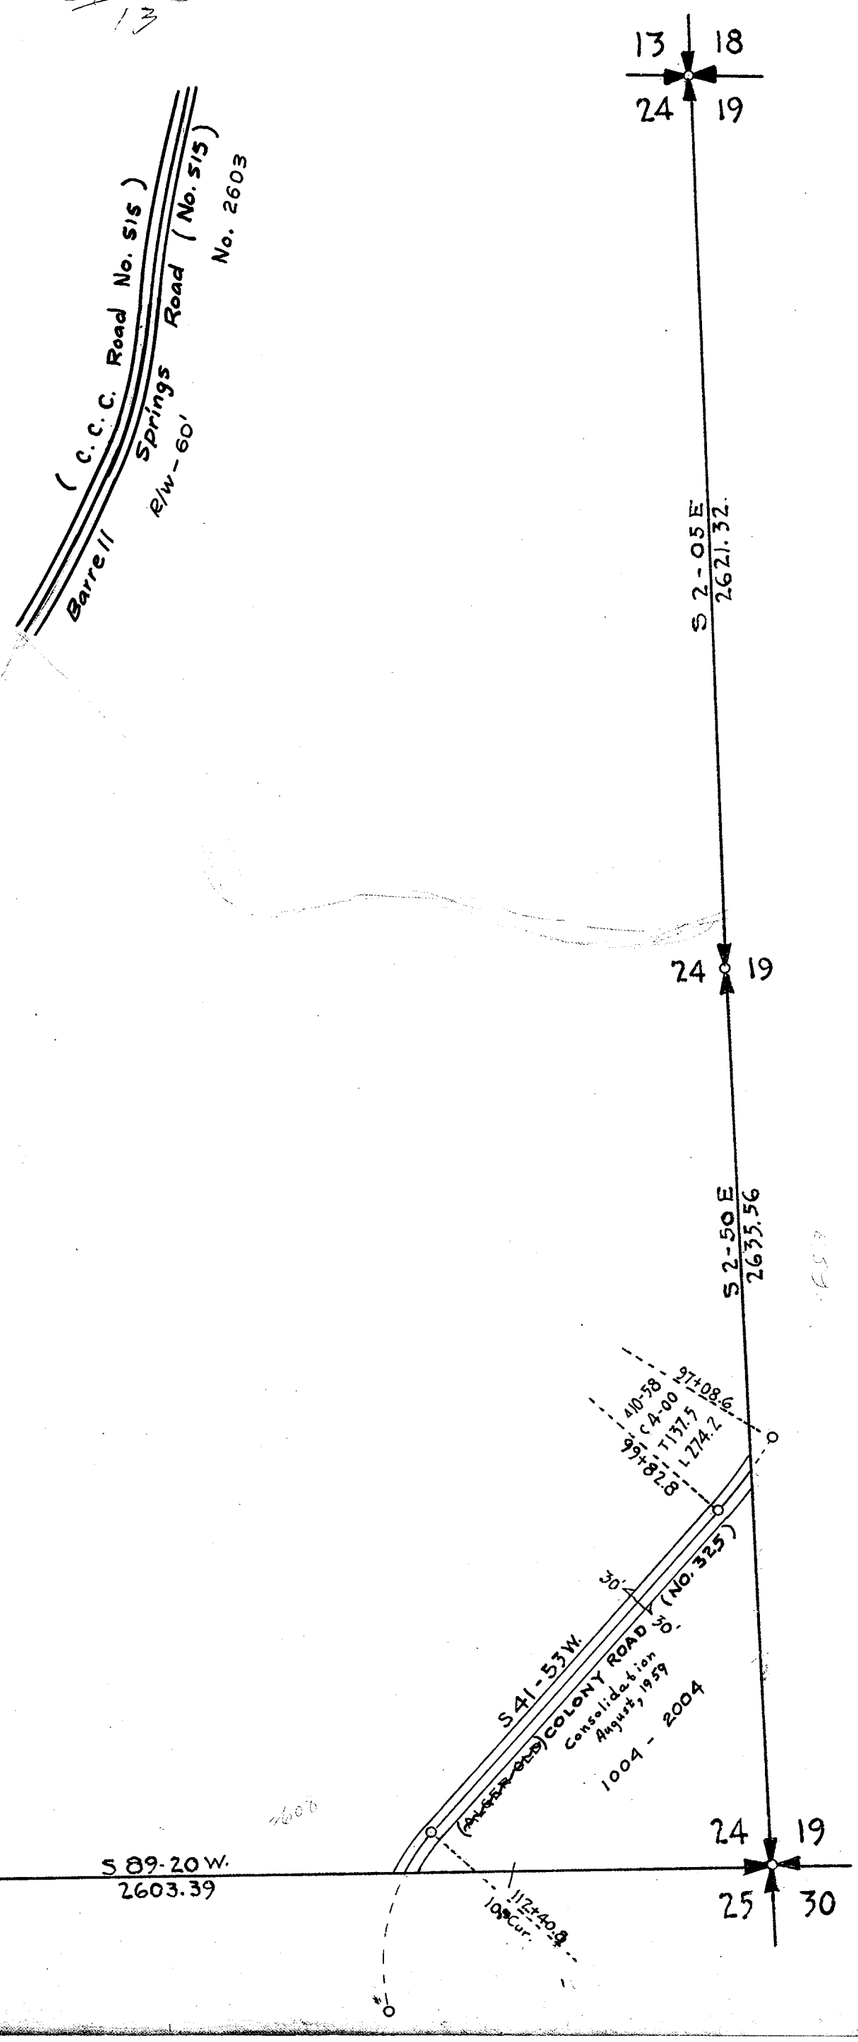

SECTION 24

TOWNSHIP 36 NORTH, RANGE 3 EAST, W. M.

SKAGIT COUNTY, WASH.

SCALE, 1 INCH--400 FEET

DATE August, 1965

Lloyd Johnson COUNTY ENGINEER

GEN. NOTATIONS: THIS TRACING DRAWN FROM AERIAL PHOTO

SUB-DIVISION INFORMATION FOUND ON PREVIOUS TRACING

* PREVIOUS TRACING SHOWING R/W TO SCALE

* INK DRAWING SHOWING FILING INFORMATION

N 88°52'56" E 2669.68

Barrel Springs Road (515 ccc Road)

No. (2603) 2521

R/W - 30' by usage

Road Consolidation Resolution 3458 1963

2775.77

S. 2-05 E 2621.32

N 2°49'20" W 2622.92'

T-36-N 24 R-3-E

1½ Pipe N 88°07'53" E 5198.15 1½ Pipe

No. 2440 (No. 1002 - 2002) (472)

Field Notes: 41-487 585

Hardshell A9/13

1" Pipe

Wood Road (Tobacco Road) No. 2490

R/W - 60'

2500.83'

N 1°28'11" W

N 3°54'24" W

Road Papers: Name File No.

Wood 472

Barrel Springs 515

Road Consolidation Resolution 3458 1963

R/W - 60' Resolution #1612

S. 2-50 E. 2635.56 2632.36

N 3°33'52" W

Colony Road No. 2400 (1004-2004) (Alger Old Colony Rd. No. 325) R/W - 60'

1½ Pipe N 88°52'14" E 2603.41' S. 89 29 W. 2603.39

24 19 25 30


SECTION 25

TOWNSHIP 36 NORTH, RANGE 3 EAST, W. M.

SKAGIT COUNTY, WASH.

SCALE, 1 INCH–400 FEET

Robt. E. L. Knapp COUNTY ENGINEER
Nov. 1931.

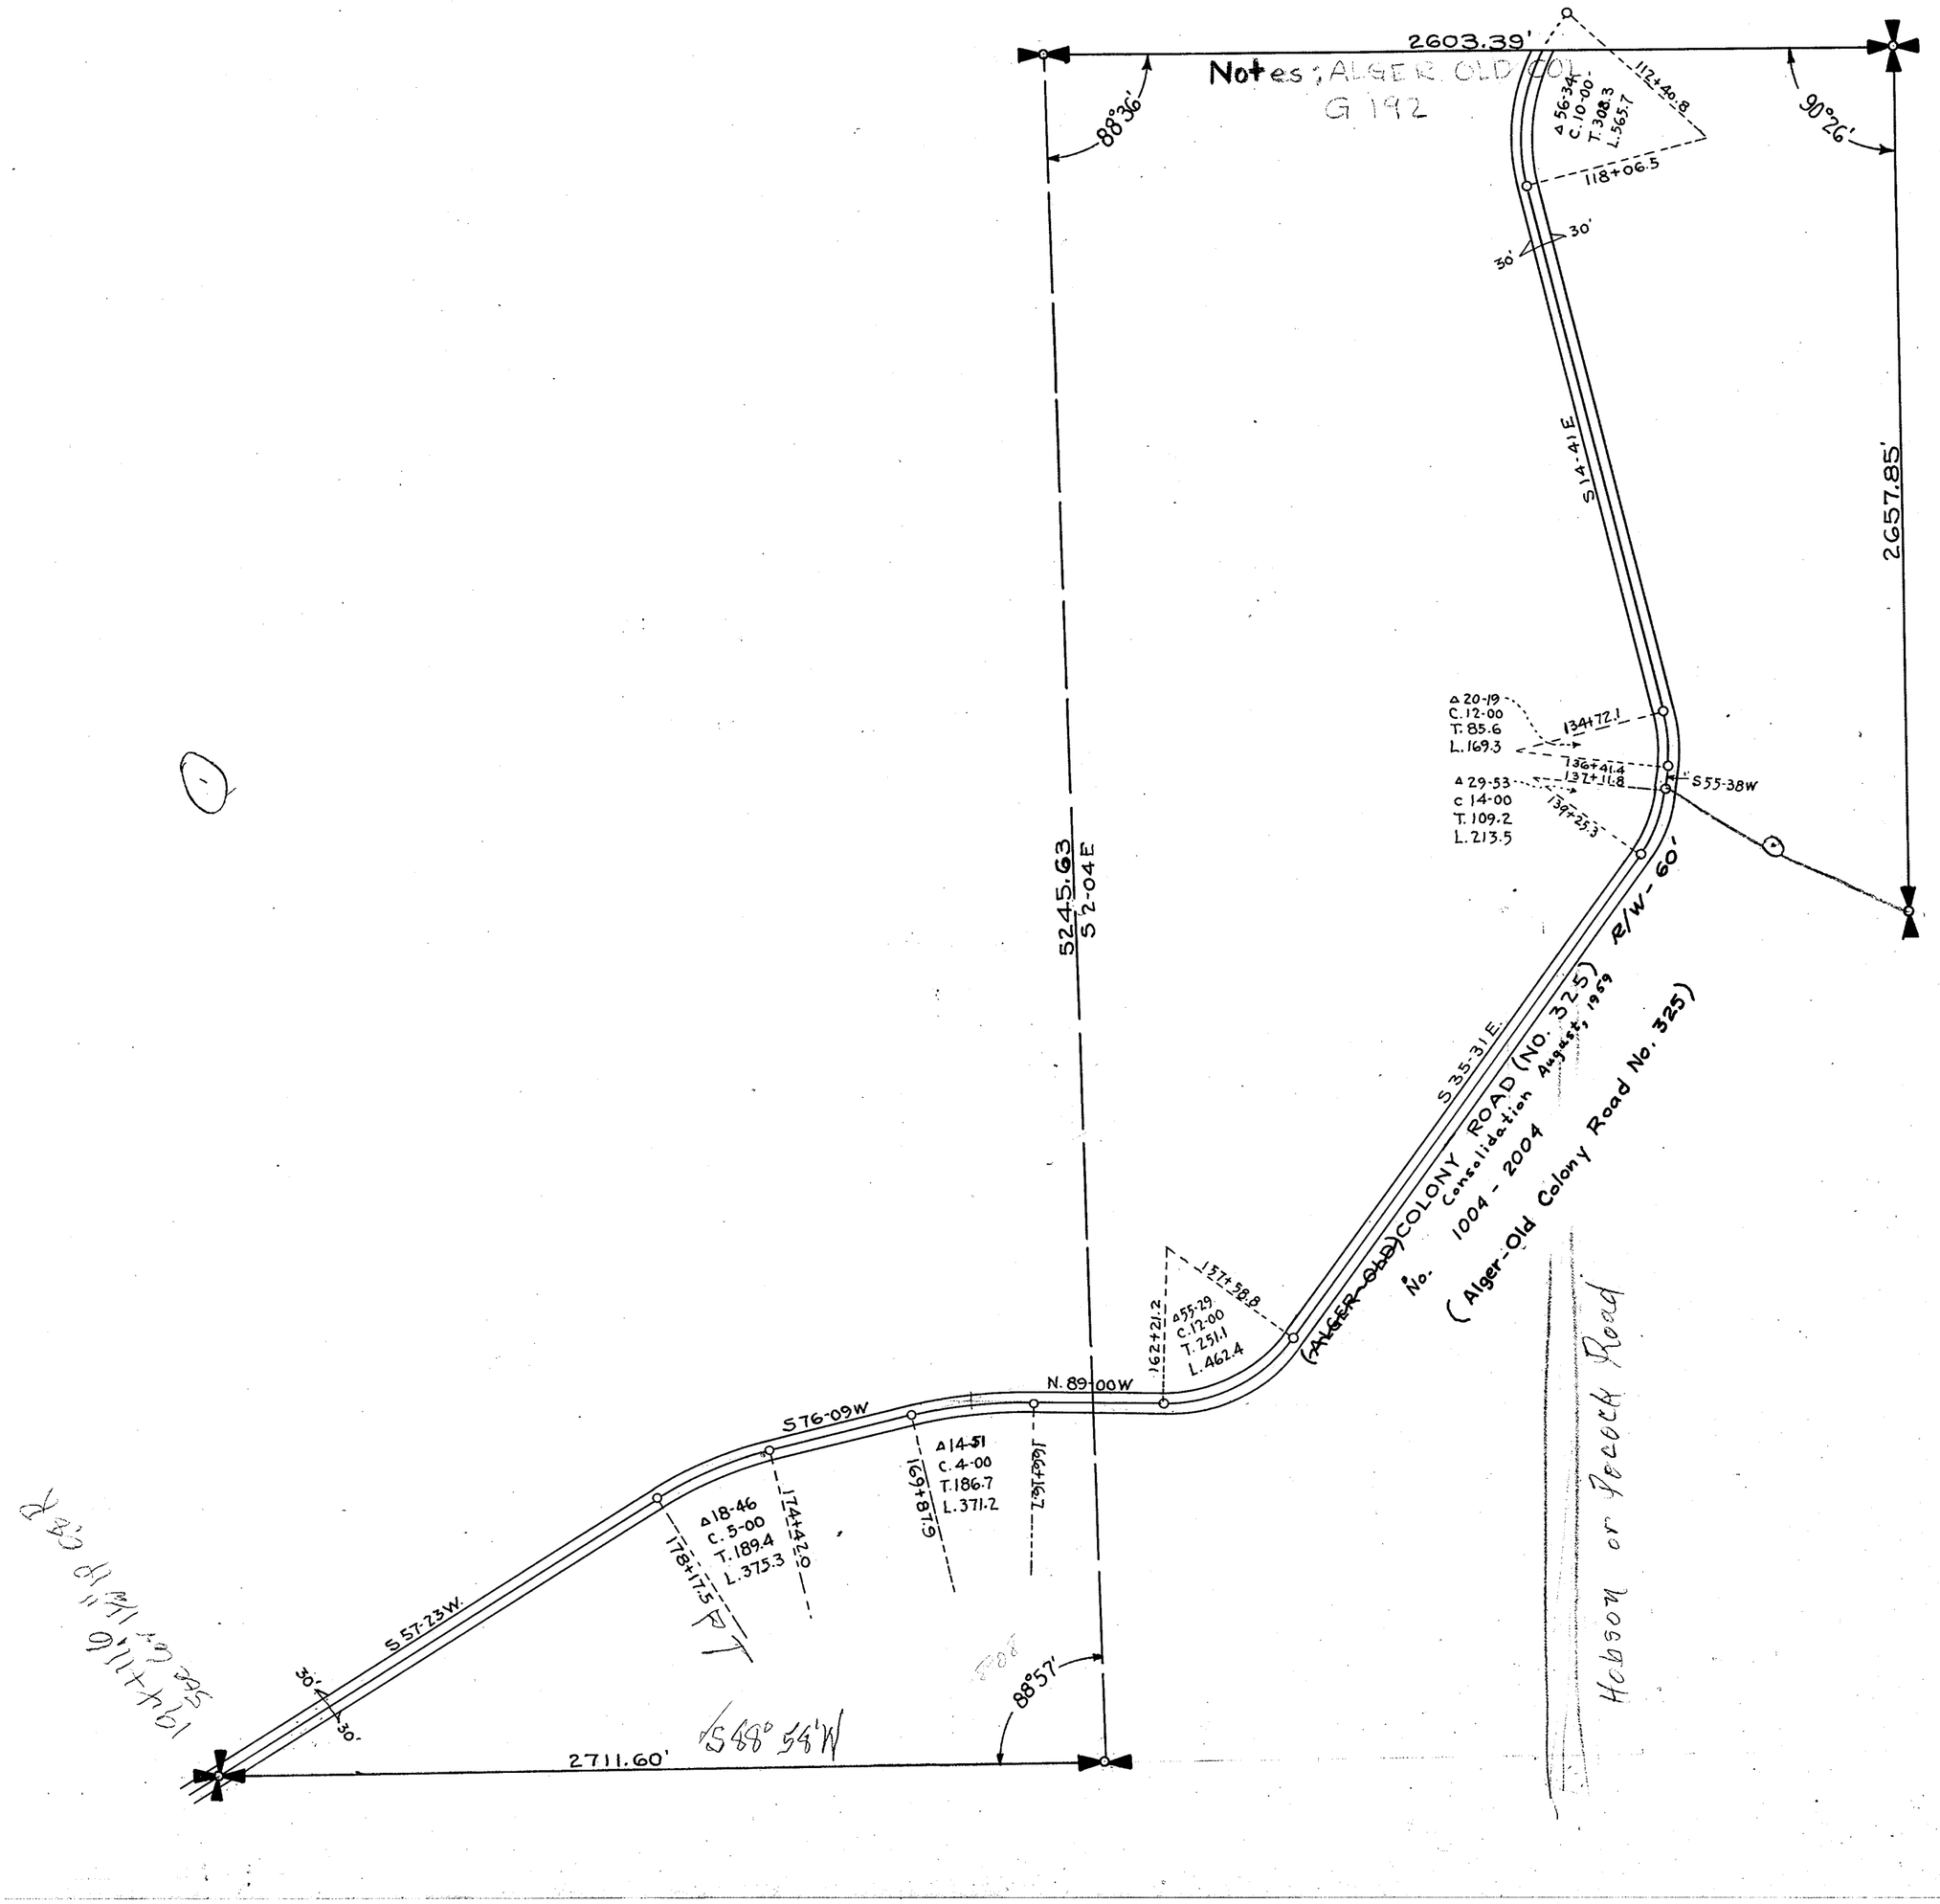


SECTION 25

TOWNSHIP 36 NORTH, RANGE 3 EAST, W. M.

SKAGIT COUNTY, WASH.

SCALE, 1 INCH--400 FEET

DATE August, 1965 — Lloyd Johnson — COUNTY ENGINEER

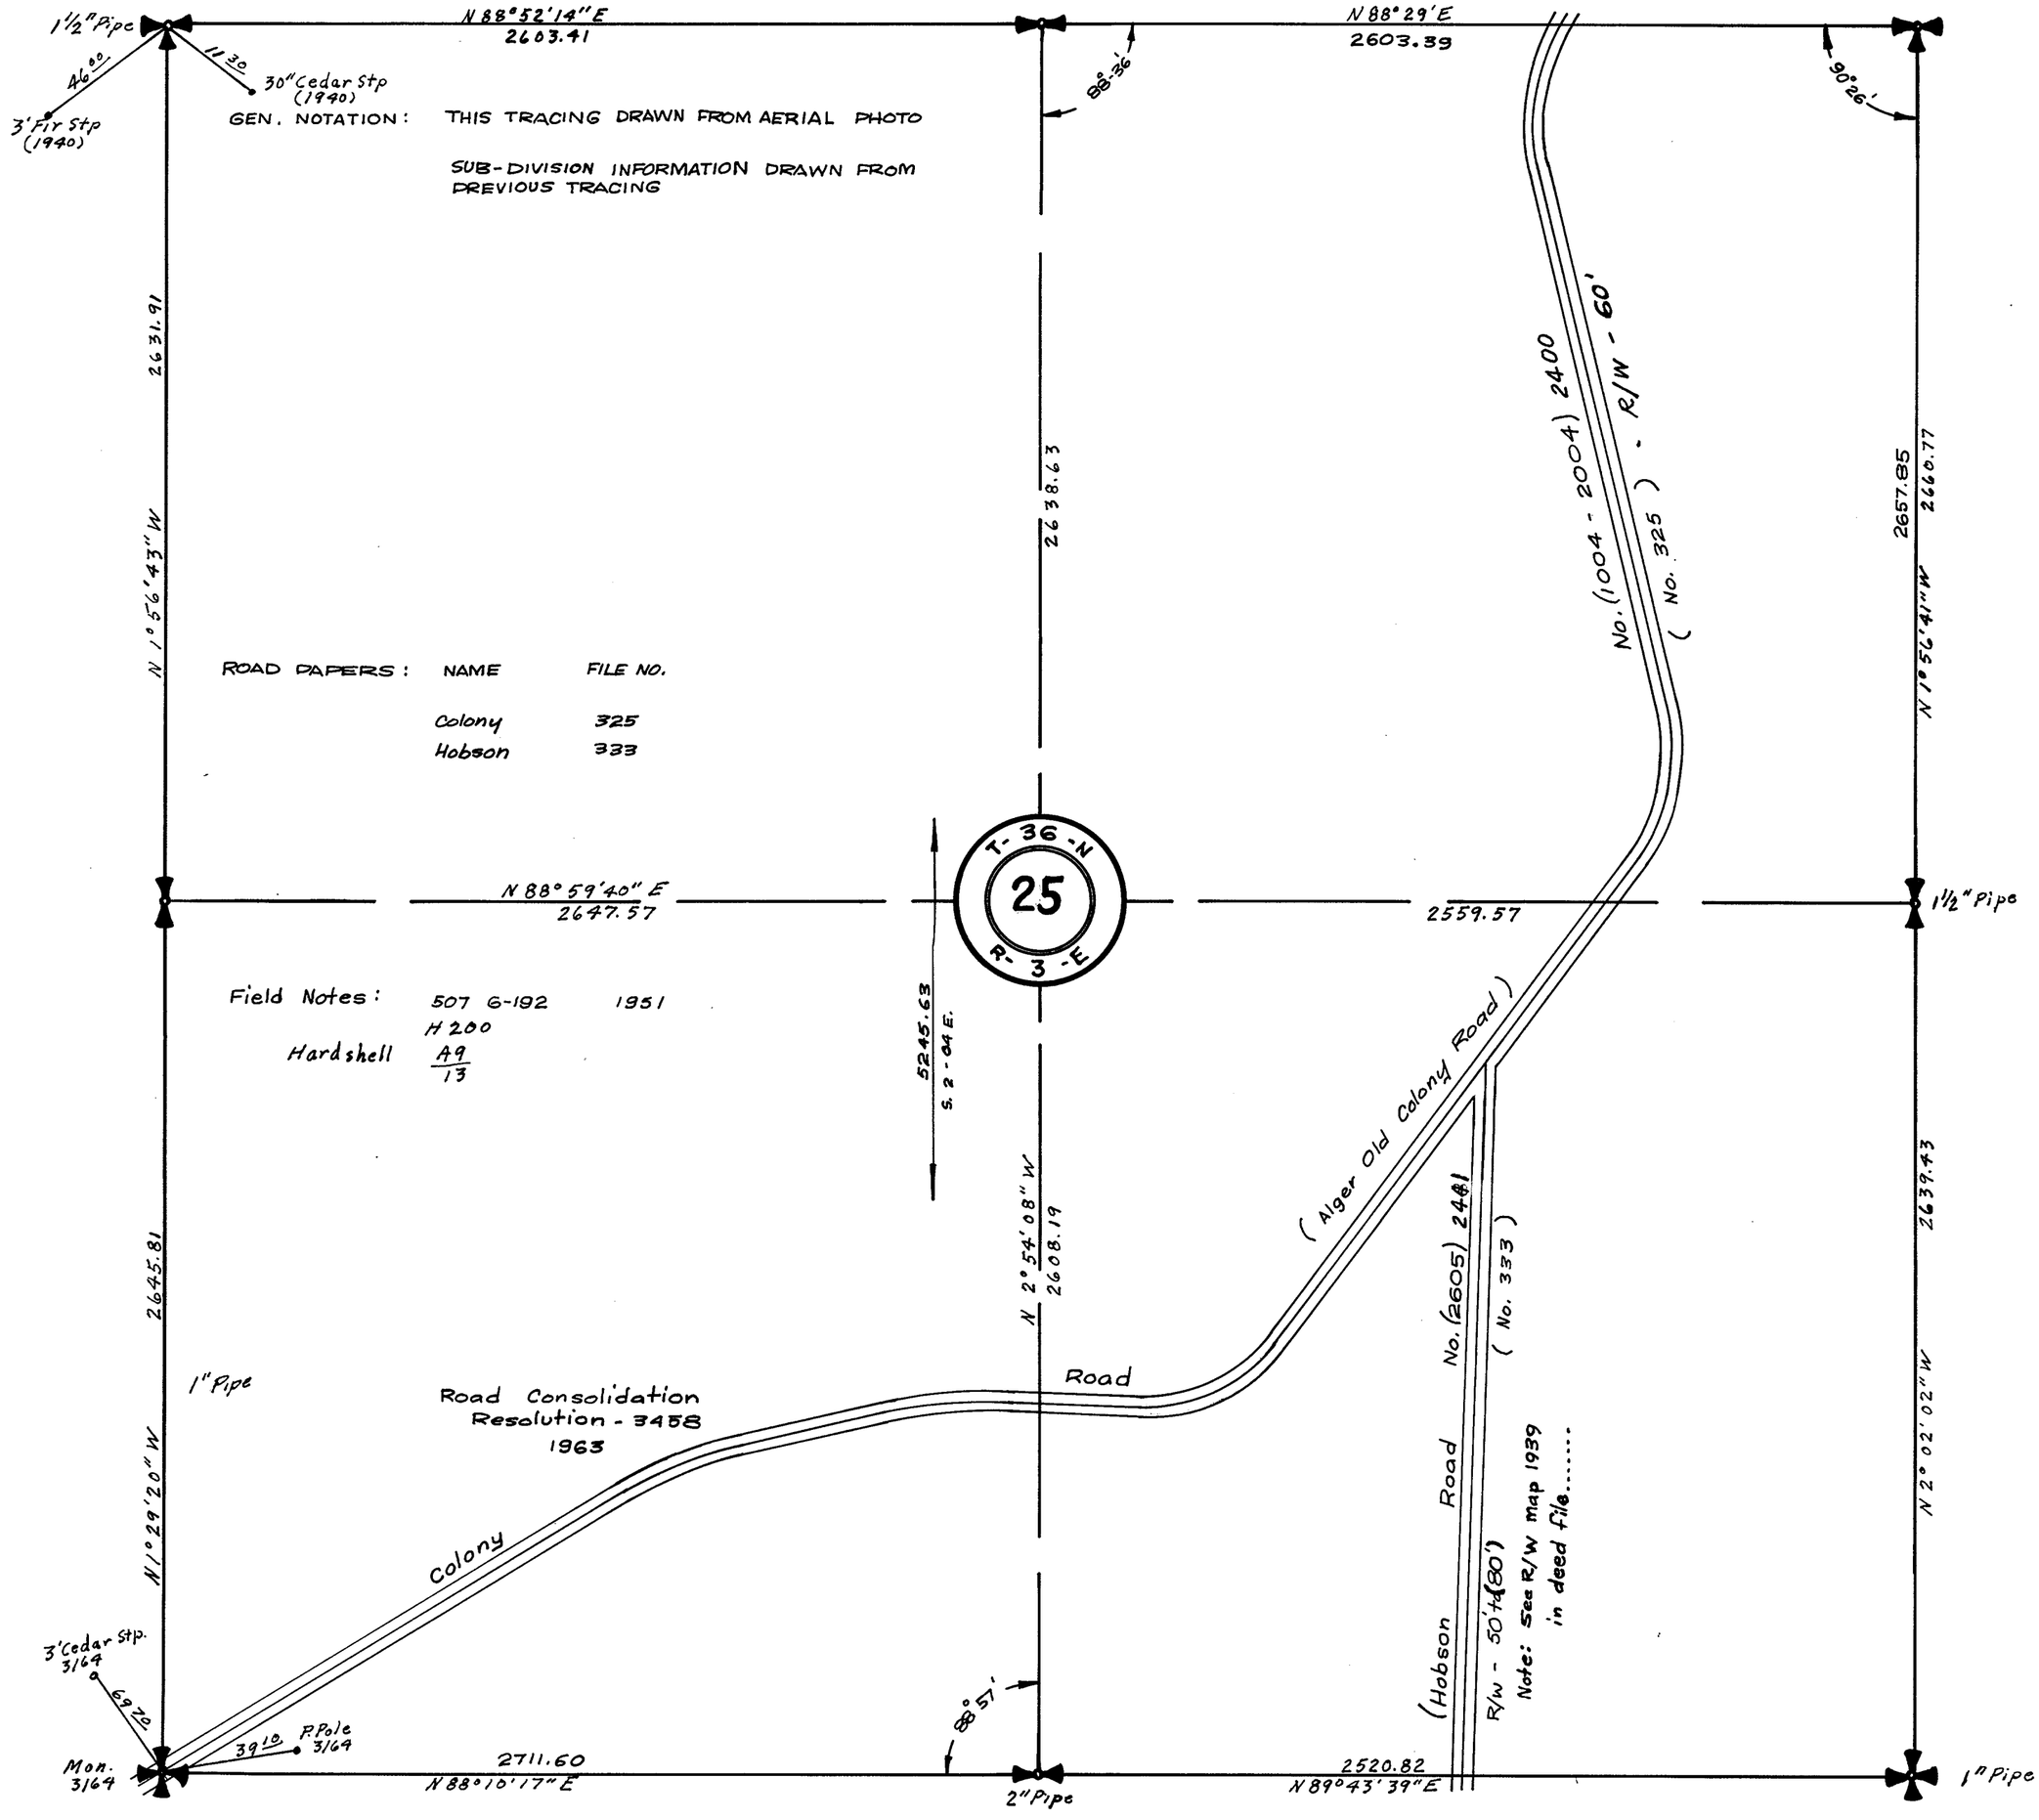


SECTION 26

TOWNSHIP 36 NORTH, RANGE 3 EAST, W. M.
SKAGIT COUNTY, WASH.

SCALE, 1 INCH–400 FEET

See B18/13

Robt. E. L. Knapp
Nov. 1931.
COUNTY ENGINEER

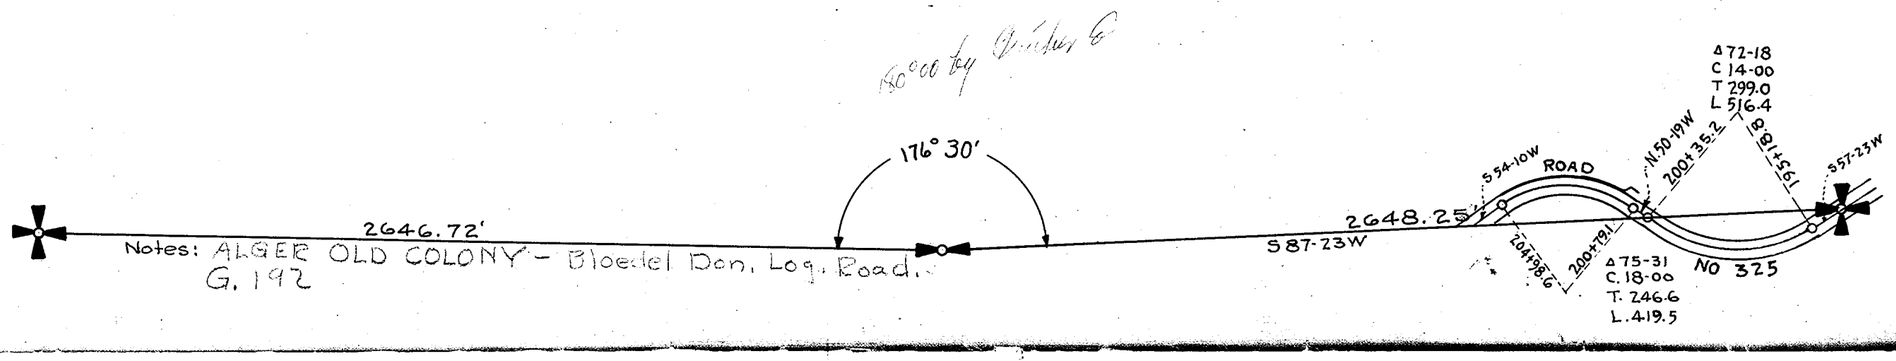

Notes: ALGER OLD COLONY – Bloedel Don. Log. Road.
G. 192

60°00 by Bridges

SECTION 27


TOWNSHIP 36 NORTH, RANGE 3 EAST, W. M.

SKAGIT COUNTY, WASH.

SCALE, 1 INCH--400 FEET

DATE August, 1959


Frank Gilkey COUNTY ENGINEER

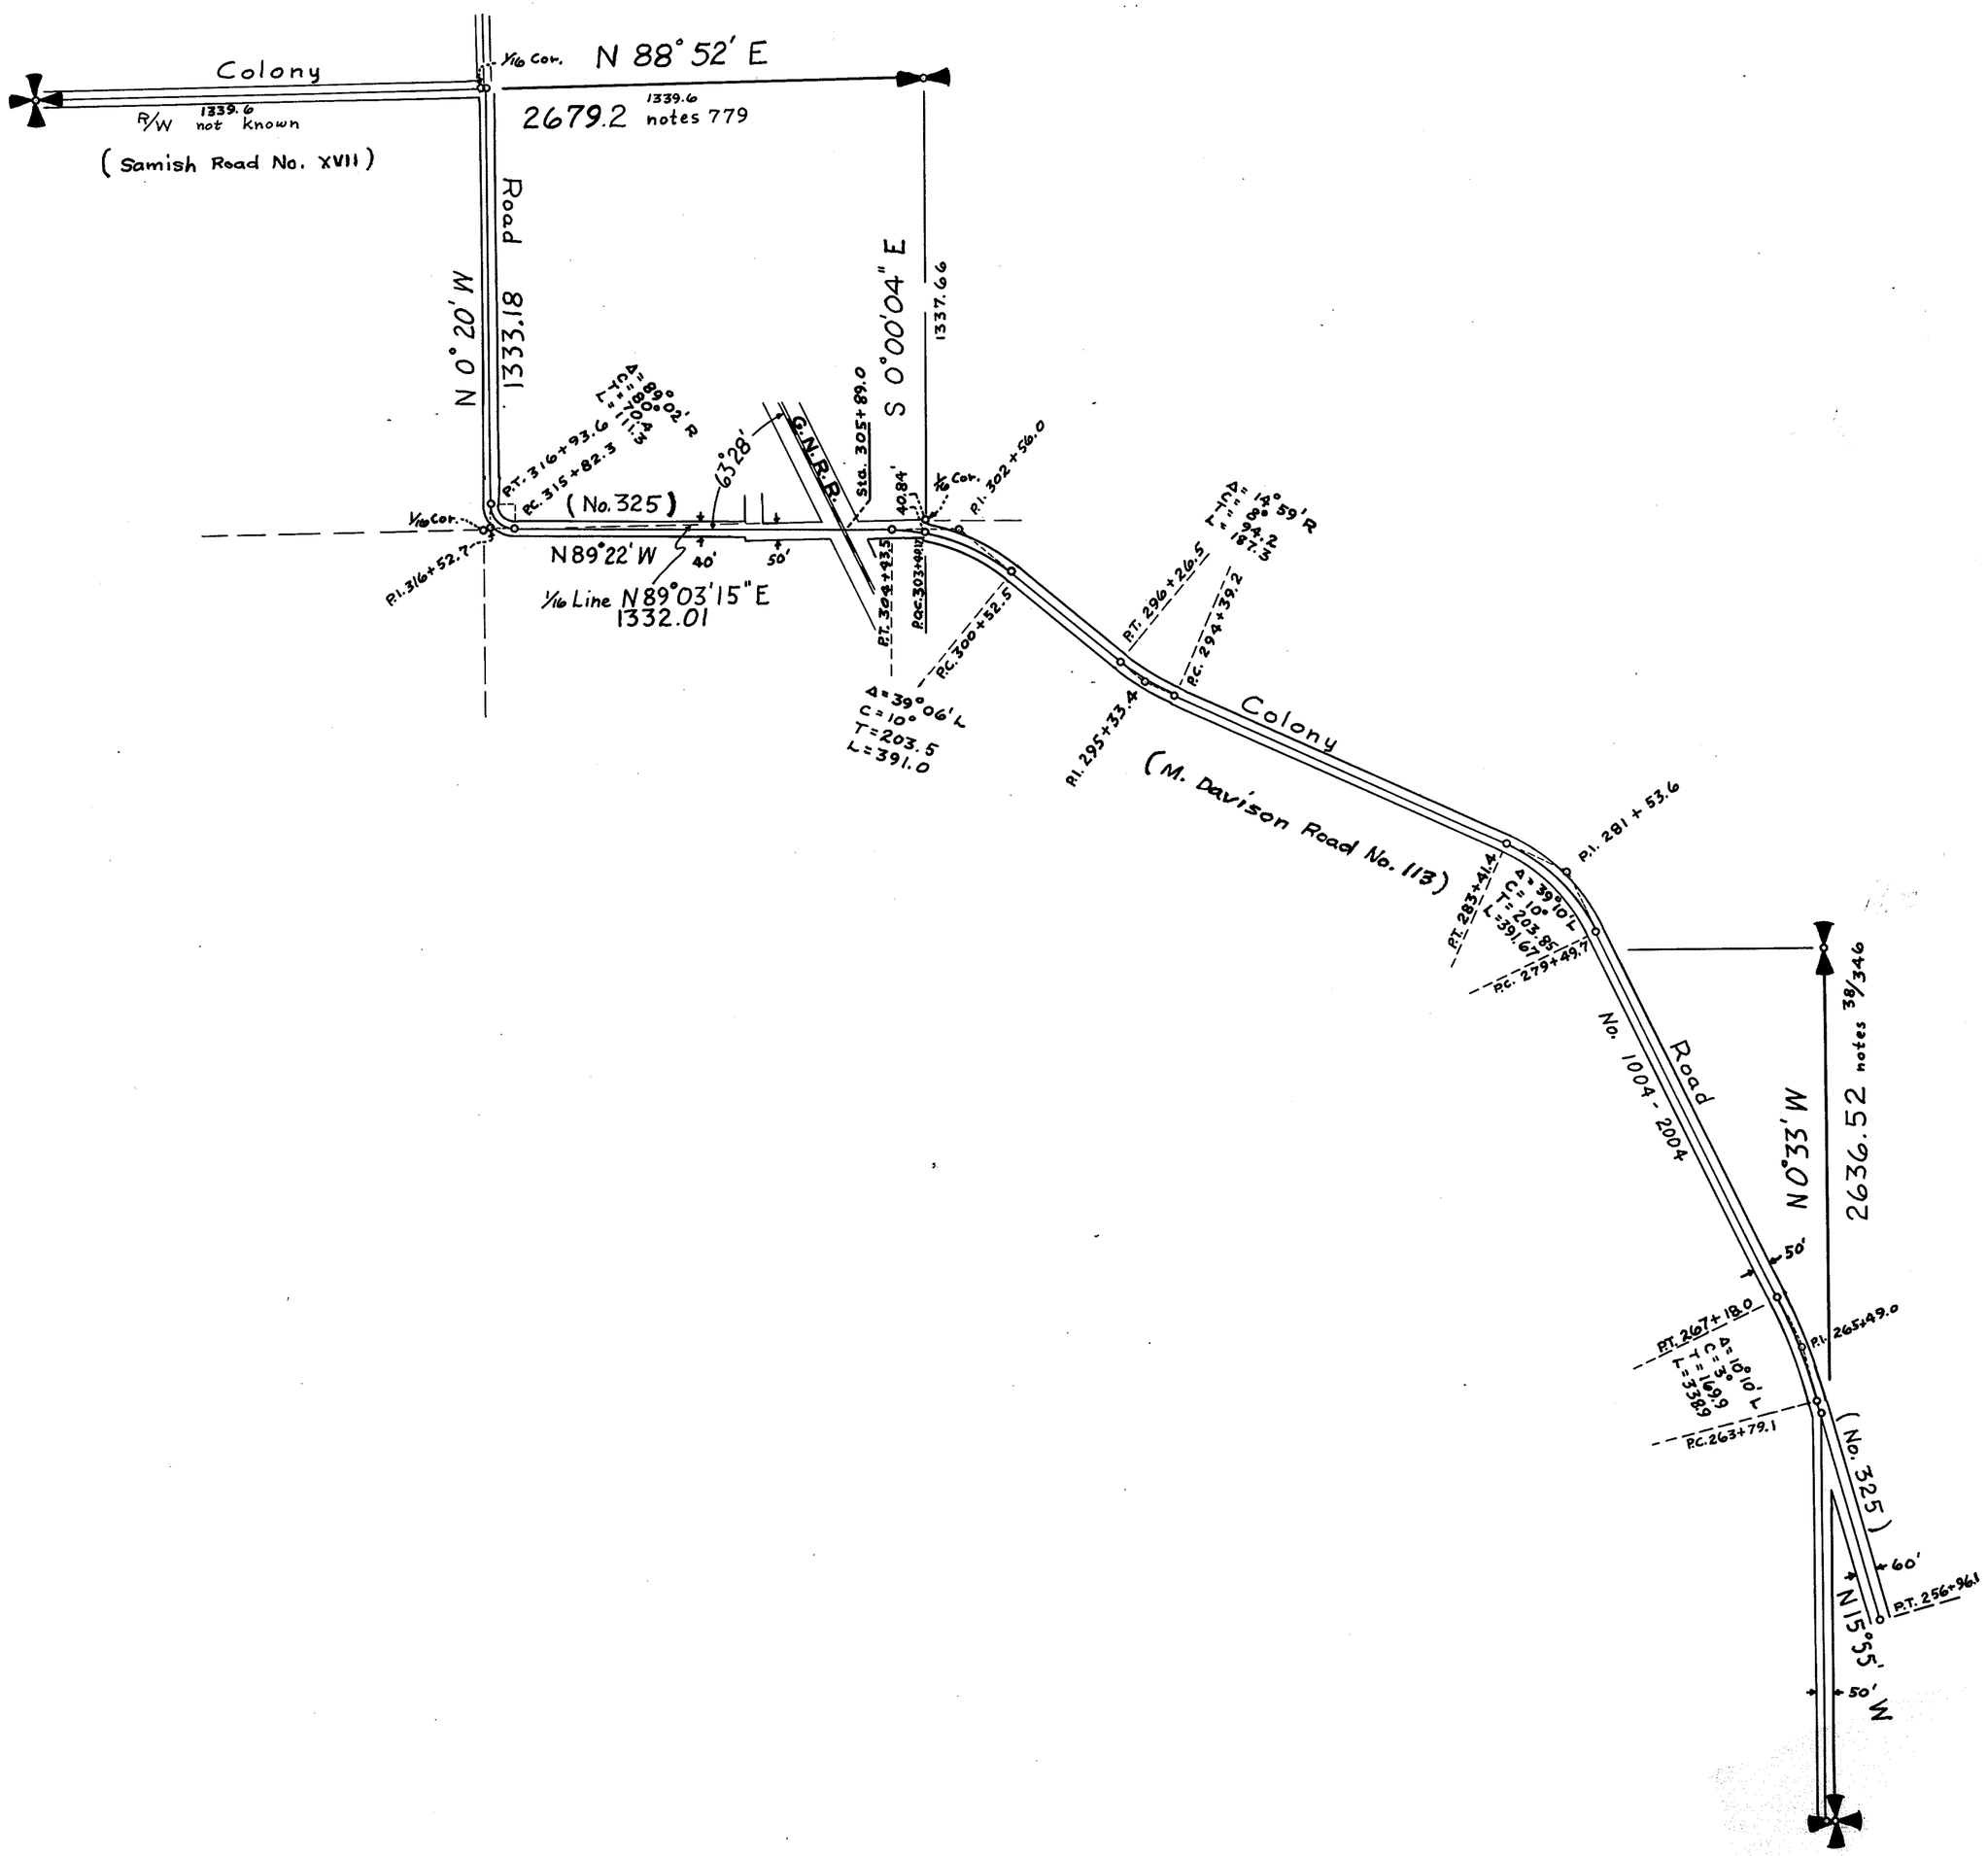

SECTION 27
TOWNSHIP 36 NORTH, RANGE 3 EAST, W. M.
SKAGIT COUNTY, WASH.

SCALE, 1 INCH--400 FEET

DATE August, 1965 — Lloyd Johnson — COUNTY ENGINEER

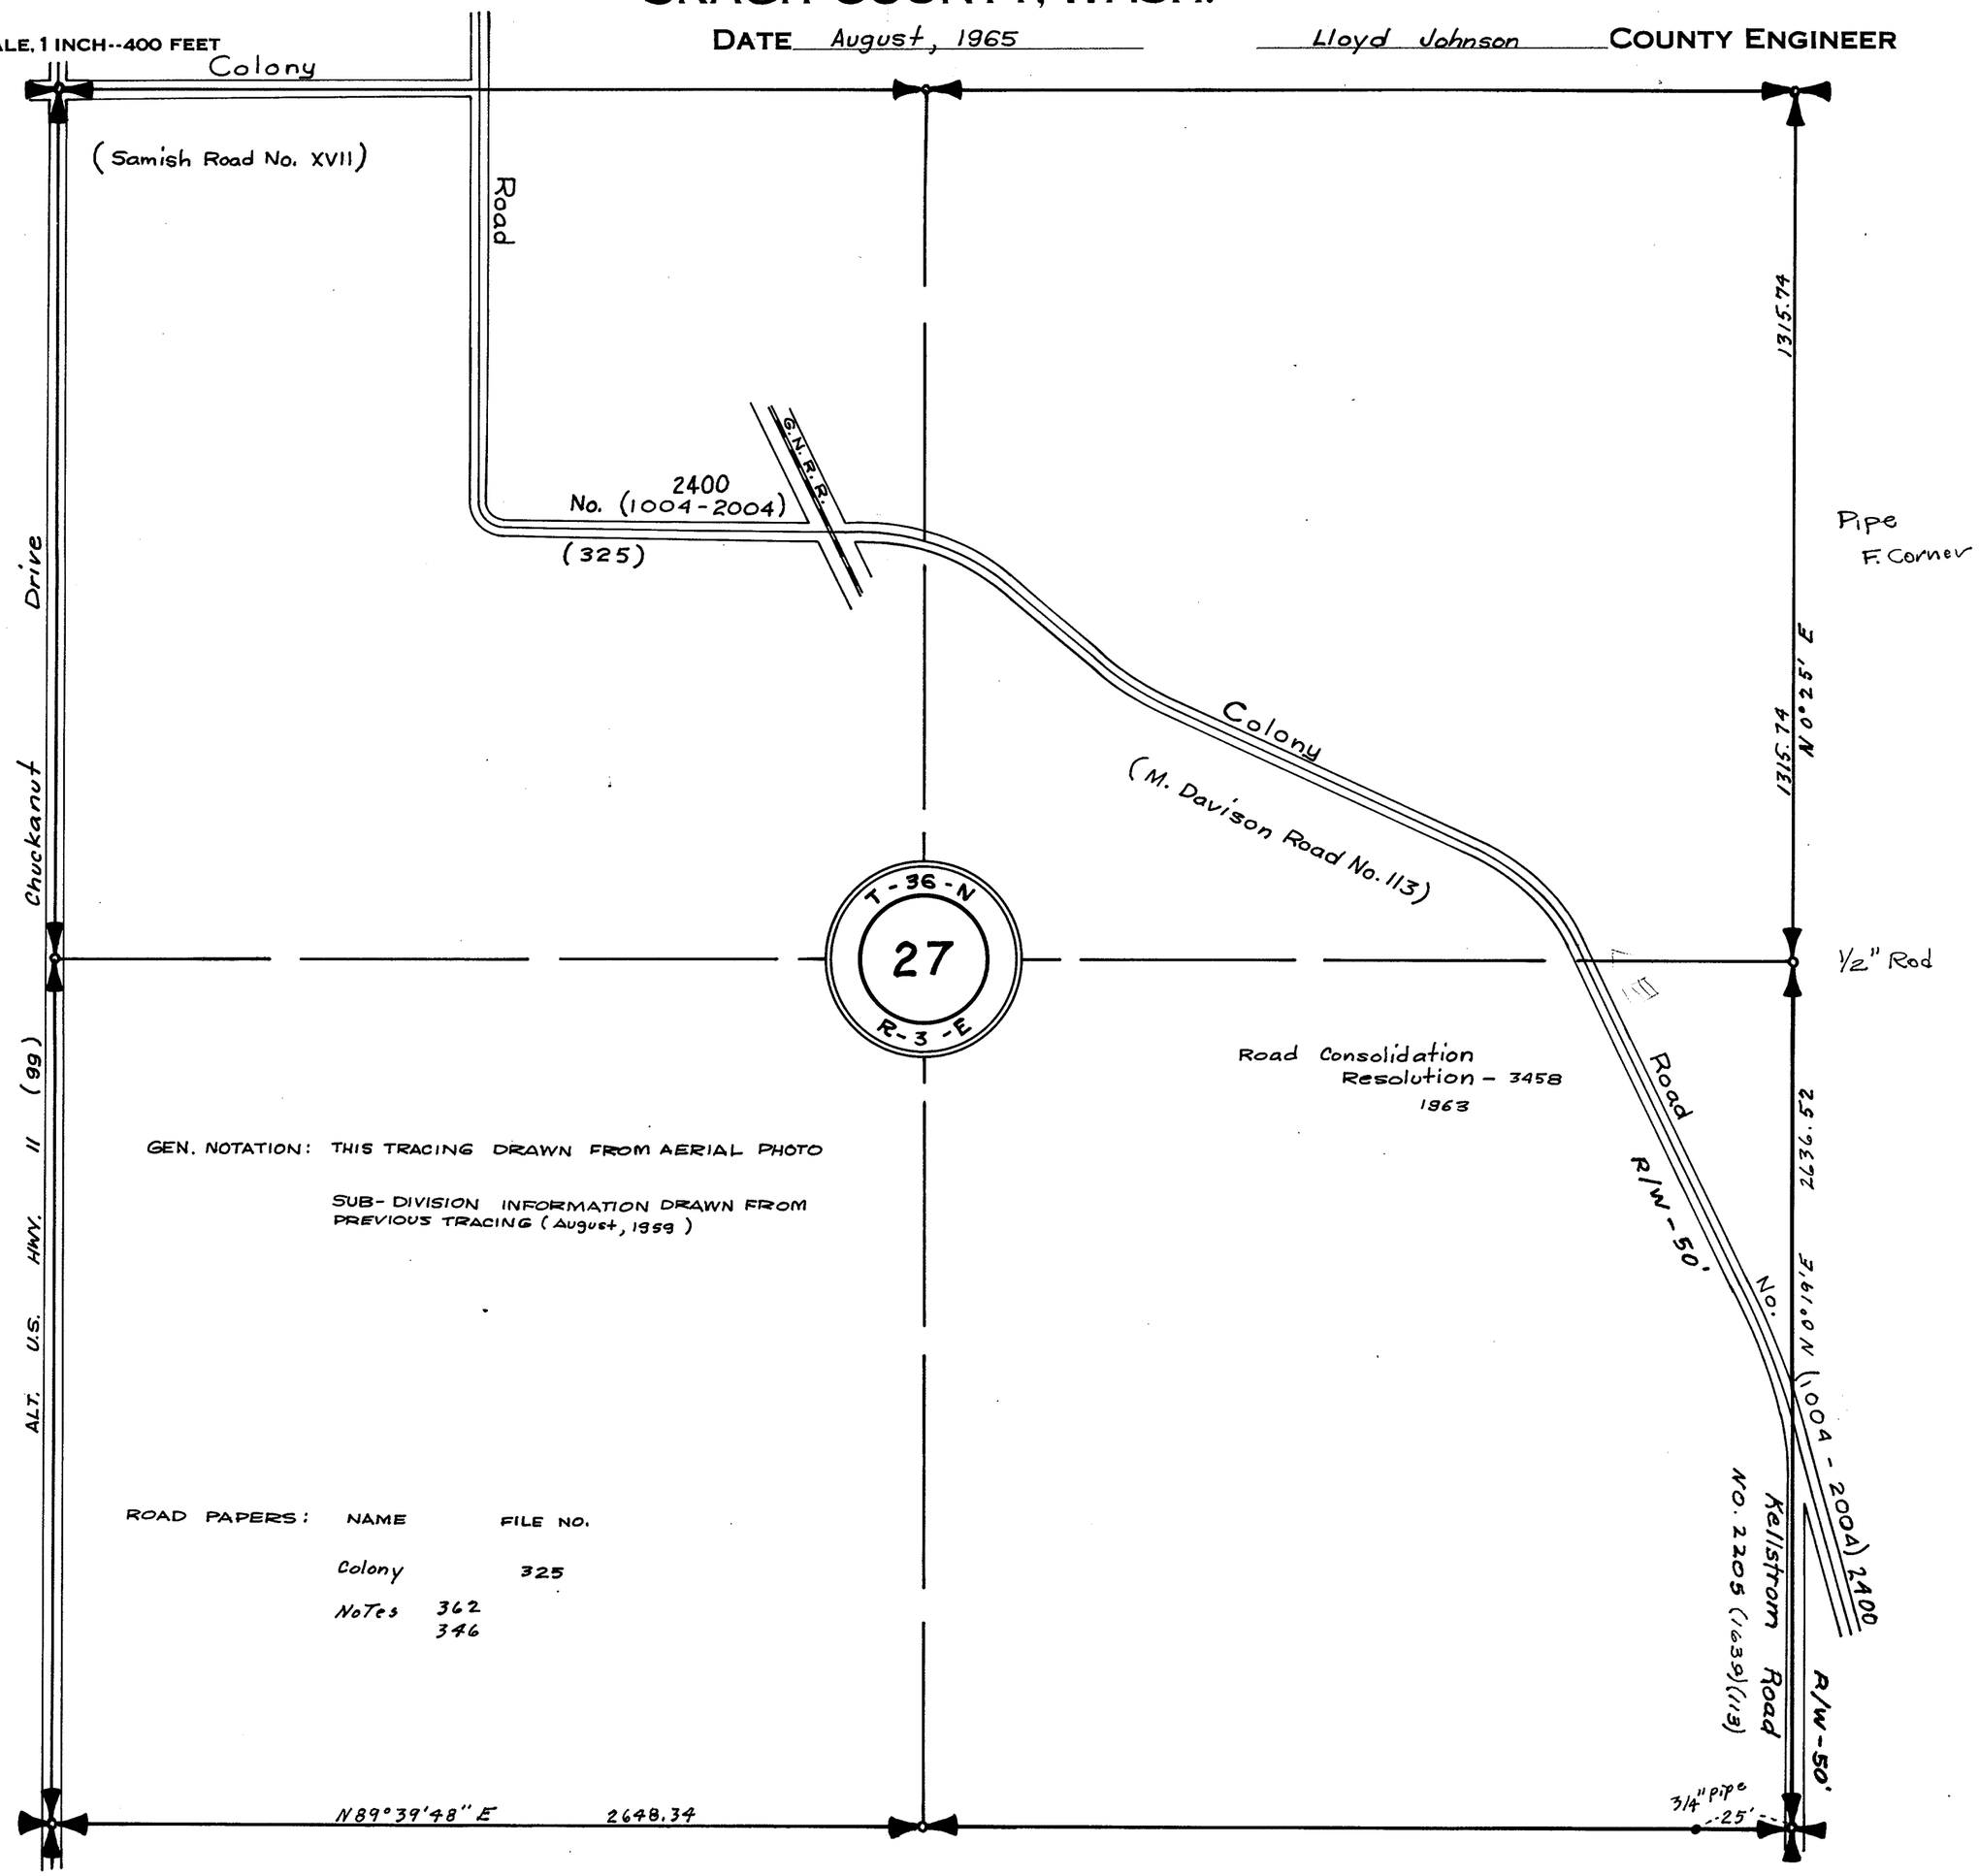

Road Consolidation
Resolution - 3458
1963

GEN. NOTATION: THIS TRACING DRAWN FROM AERIAL PHOTO

SUB-DIVISION INFORMATION DRAWN FROM PREVIOUS TRACING (August, 1959)

ROAD PAPERS:

NAME	FILE NO.
Colony	325
NoTes	362
	346

SECTION 33

TOWNSHIP 36 NORTH, RANGE 3 EAST, W. M.

SKAGIT COUNTY, WASH.

SCALE, 1 INCH--400 FEET Dw. W.G.W DATE Aug. 25, 1963 Lloyd Johnson COUNTY ENGINEER

Notes : 671 1947

Road Papers :

Name	File No.
East Edison	679

T-36-N
33
R-3E

Road Consolidation
Resolution - 3458
(1963)

East Edison Road (No. 679)
(Warner Road No. XCVI)
Road No. (1624) 2520

S. S. H 1-C

EDISON

S.S.H. 1-C

U.S. HWY 99 Alt. S0°46'W 2652.8'

1/16
1¼ Pipe

1½" Pipe
1" W. Pavement

SECTION 34

TOWNSHIP 36 NORTH, RANGE 3 EAST, W. M.

SKAGIT COUNTY, WASH.

SCALE, 1 INCH--400 FEET

Notes 158

DATE July 19, 1963

COUNTY ENGINEER

GEN. NOTATION: THIS TRACING DRAWN FROM AERIAL PHOTO

SUB-DIVISION INFORMATION TAKEN FROM PREVIOUS TRACINGS & FIELD NOTES

* TRACING SHOWING SUB-DIVISION INFOR. ONLY

* INK DRAWING SHOWING R/W NOT TO SCALE

Notes: 38/346 3/12/37

F-158 11/26/29

49/643

ROAD PAPERS:

NAME	FILE NO.
Bow Hill	680

N 89°39'48" E 2648.34

(3/4" Pipe 25' in ditch

1/16 1¼" Pipe

N 89°53'15" E 2660.80

2652.8

2673.28

GREAT NORTHERN RAILWAY

Kellstrom Road No. 2205 (1639)(113) 2661.0 N 1°11'E R/W - 60'

U.S. Highway 99 (ALT.) S 0°46'W

1½" Pipe 1' W. Pavement

2673.28

T-36-N 34 R-3-E

N 89°53'20" W 5345.07

30" Alder (1947) 21°

1" Pipe with union 15½°

12" Birch (1947)

Bow (Warner Hill Road No. XCVI) Road (1006 - 2006) 2120

R/W - 60'

Road Consolidation Resolution - 3458 1963

5333.84 N 0°13'10" E

N 89°41'35" E

1/16 Buggy Axle

2621.57 N 0°23'E

GUY POLE N. W. 20.71

X IN PIPE SIGN POST GOLDEN GLOW FARMS RP 48.14

24" Elm 17½°

(680)

P. Pole (1947) 72°

2664.6 N. 89°16'31" E

1" Pipe Notes 643

26.30 Cor Fence Post (1947)

67.80 T. Pole (1947)

SECTION 34


TOWNSHIP 36 NORTH, RANGE 3 EAST, W. M.

SKAGIT COUNTY, WASH.

Notes- F-158

SCALE, 1 INCH–400 FEET

Robt. E.L. Knapp COUNTY ENGINEER

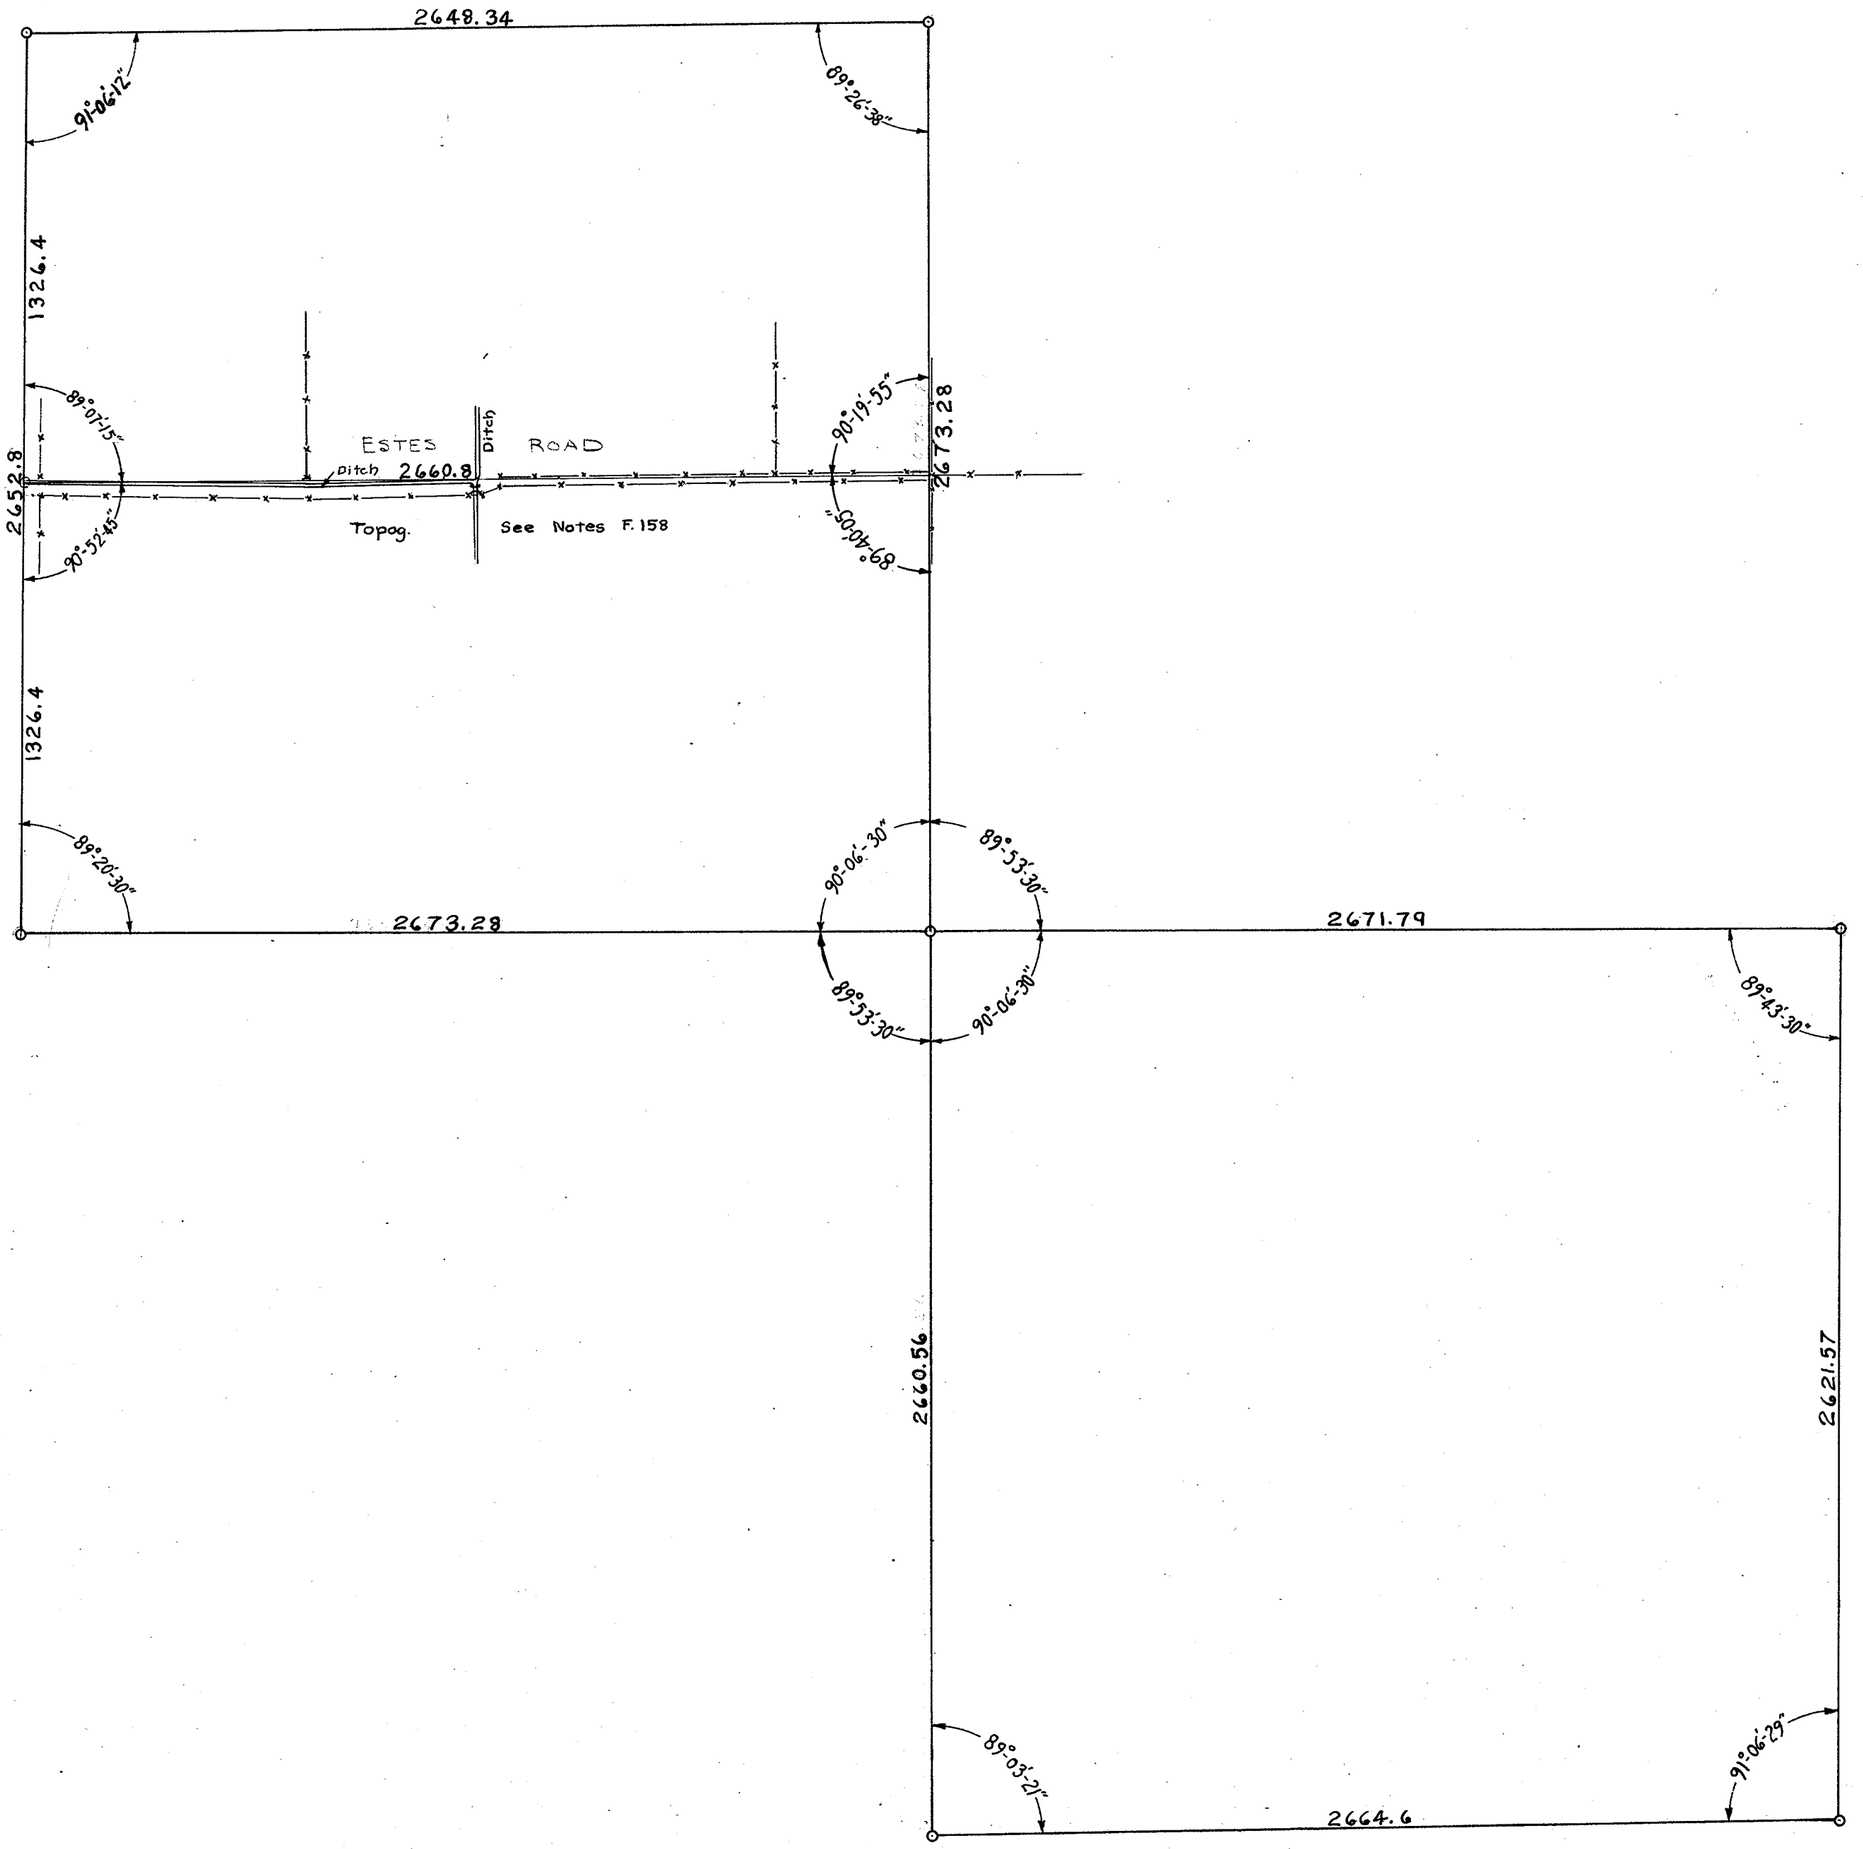


SECTION 35

TOWNSHIP 36 NORTH, RANGE 3 EAST, W. M.

SKAGIT COUNTY, WASH.

SCALE, 1 INCH--400 FEET

DATE August, 1959 Frank Gilkey COUNTY ENGINEER

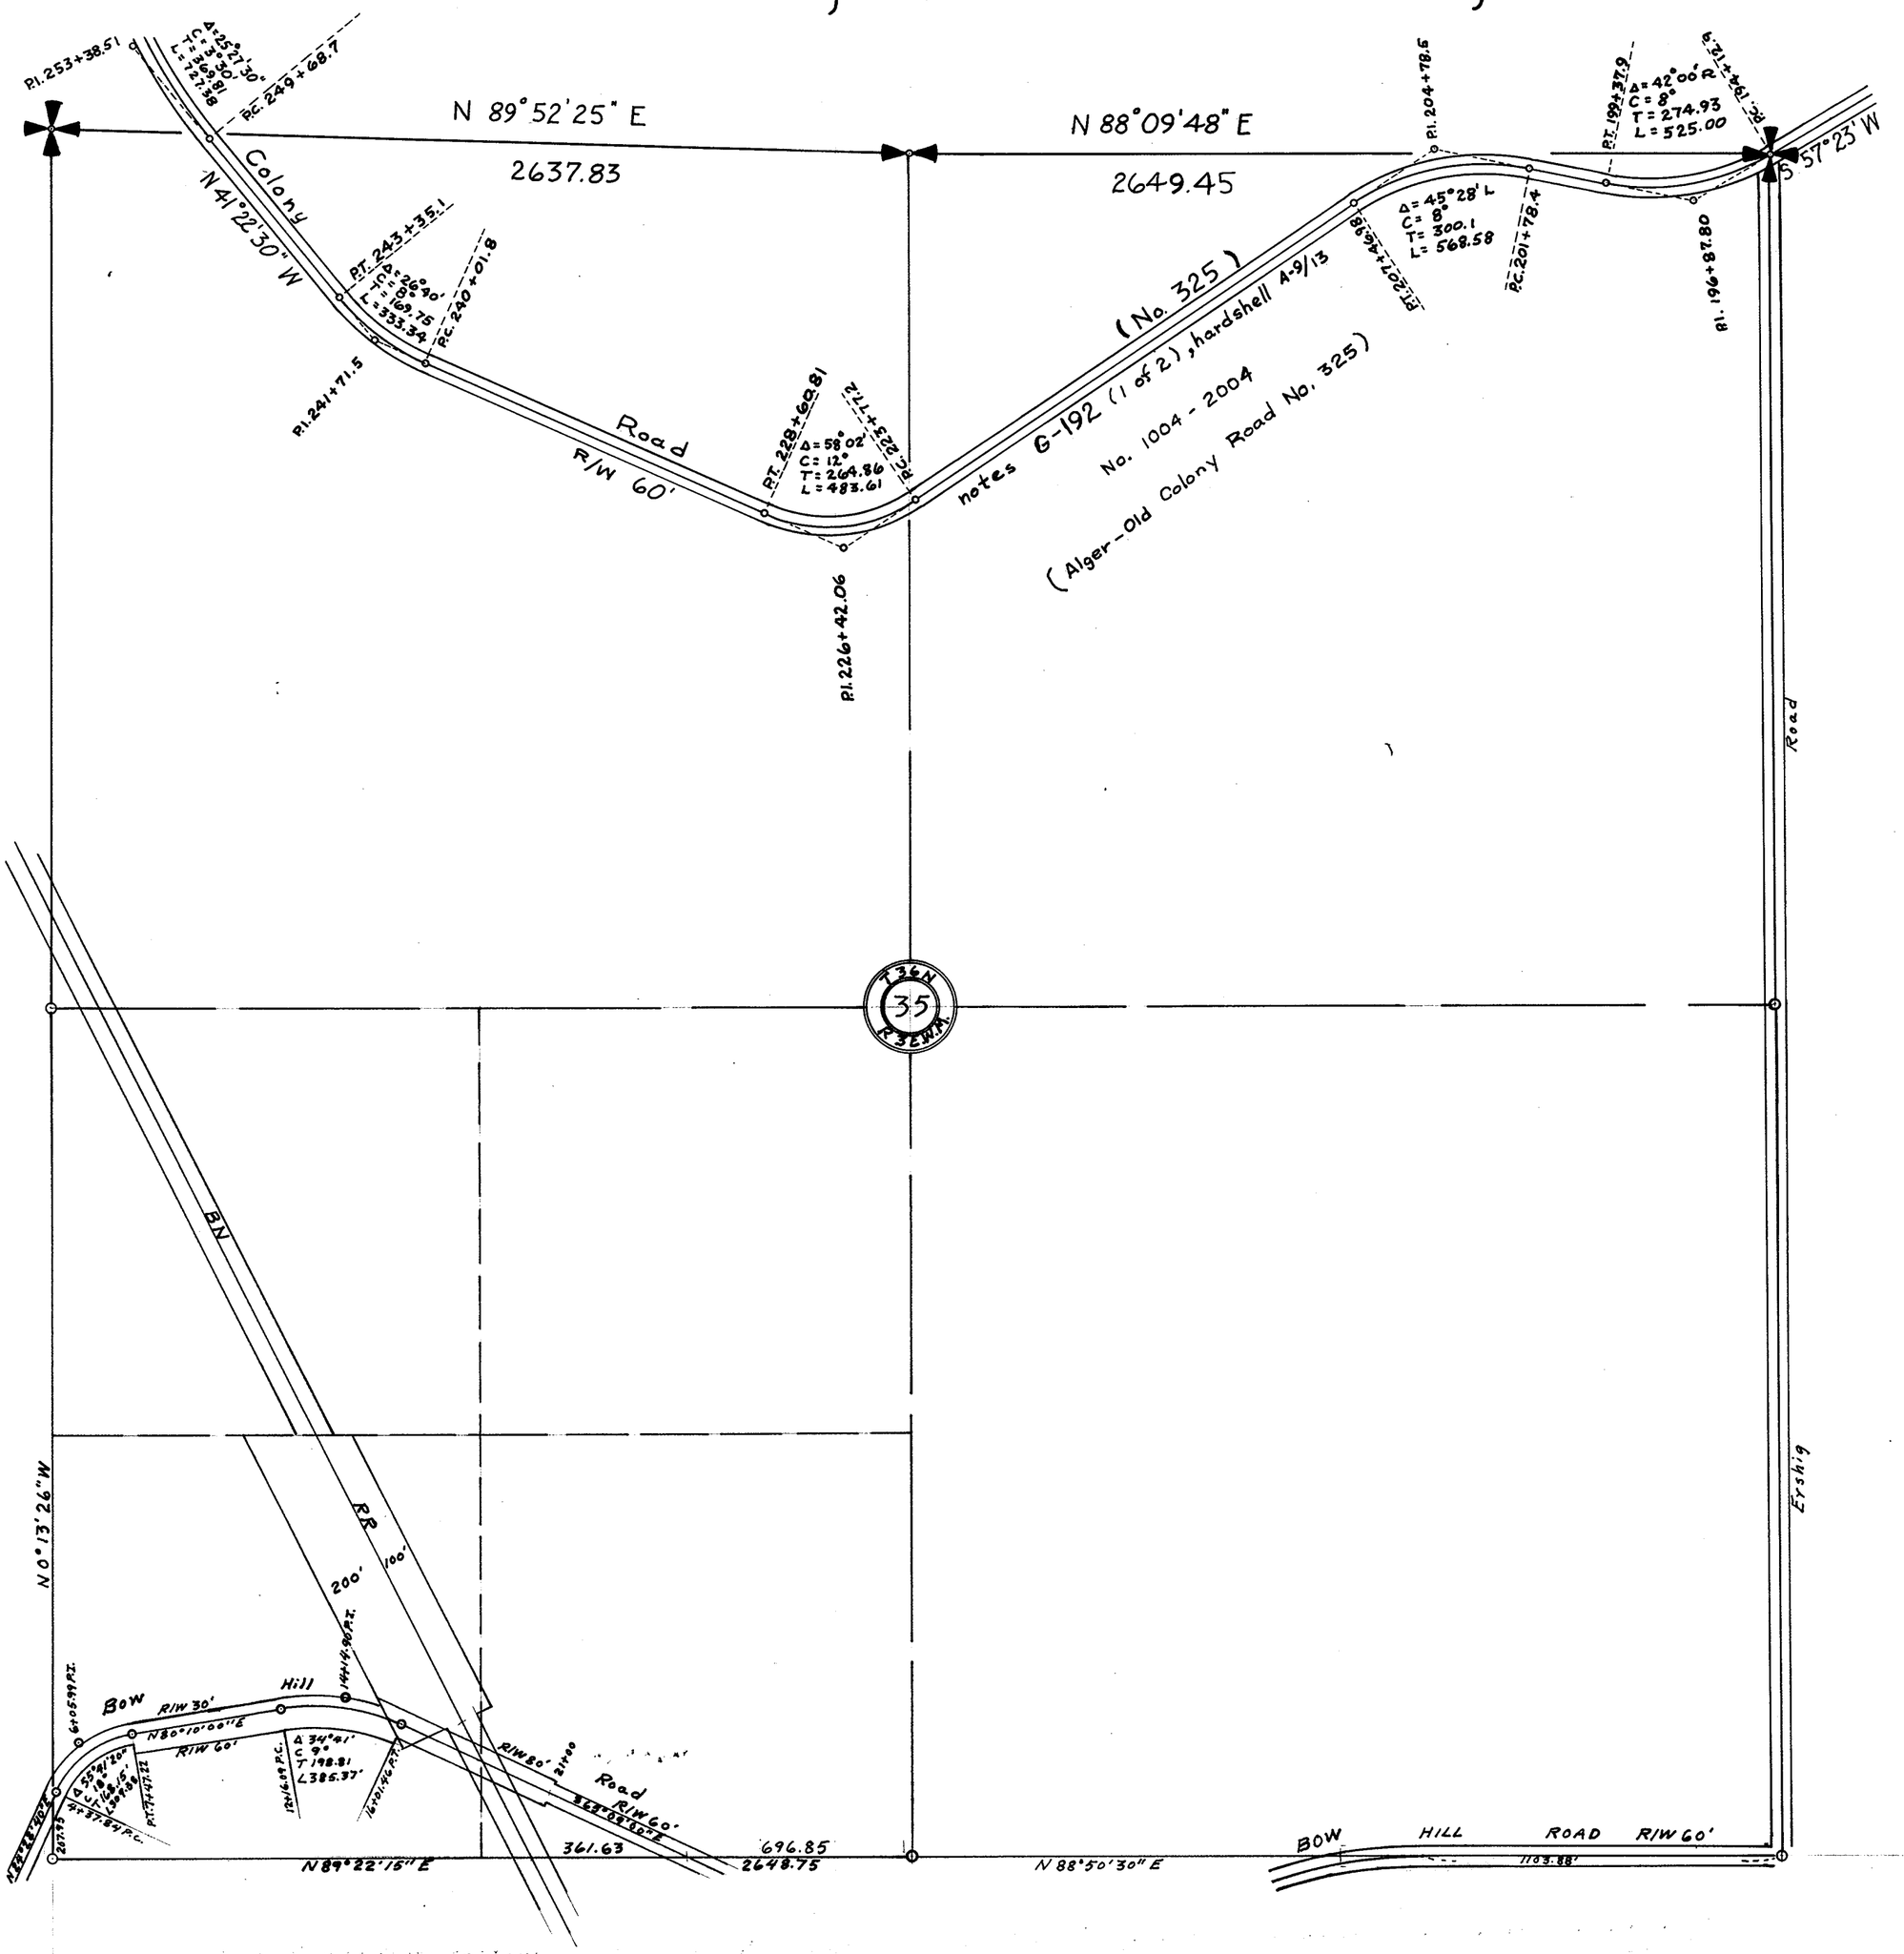

SECTION 35

TOWNSHIP 36 NORTH, RANGE 3 EAST, W. M.

SKAGIT COUNTY, WASH.

SCALE, 1 INCH--400 FEET DATE July 17, 1963 Lloyd Johnson COUNTY ENGINEER

(N89°52'25"E 2637.83 Hardshell A9/13)

S 89° 07'E 2646.72

S 87° 23'W 2648.25

(N 88° 09' 48" E 2649.45 Hardshell A9/13)

3/4" Pipe -25'
Notes 346

Corner in ditch
Notes 158

1" Pipe

1 1/2" Pipe
Notes G 192
Mon. 3/64

3' Cedar Stp. 3/64

P. Pole 3/64

39.19

69.76

2613.7

Kellstrom Road No. 2205

No. (1639) (113) R/W - 60' (Davison Road)

Colony Road Consolidation Resolution - 3458 - 1963

(Alger - Old Colony Road)

Road

No. 2400 (325)

(1004 - 2004)

R/W 60'

No. (1003 - 2003) (533) R/W - 60'

2321

GEN. NOTATIONS: THIS TRACING DRAWN FROM AERIAL PHOTO

SUB-DIVISION INFORMATION TAKEN FROM

TRACINGS & FIELD NOTES

TWO TRACINGS SHOWING R/W TO SCALE (COLONY ROAD ONLY)

* INK DRAWING

T-36-N
35
R-3-E

30" Alder (1947)

21.00

Great Northern Railway

15.42

12" Birch (1947)

1" Pipe with Union

2621.57

N 0° 23' E

R/W - 40'

2201 (1641)

Ines Street

2203 (1645) Cedar St. R/W - 40'

Wm. J. Brown Road No. 2160

(No. 1628) R/W - 60'

(152)

R/W - 50'

No. (1626) 2200 Davison Road (118)

R/W - 40'

(1006 - 2006) 2120

McCaskill Street (1643) No. 2283

Bow Hill

P/Pole R.P. Samish River

S 89° 30' E

HSE #601

R.P. COR F POST. WEST

26.30

Notes 643

30.89

TELE/POLE S.W.

R.P. 56.67 SCRIBE IN CONC. CONC.

R.P. 48.58 TACK

DUG 2½' FOUND 1" PIPE BENT OVER SET CONC. MON W/BRASS CAP IN CASE

R/W - 60'

60" STUMP

29.64

32.51

60" STUMP

1" Pipe

24" ALDER

15.42

Road

(1006 - 2006)

No. 2120 (680)

(Warner Road)(No. XCVI)

R.P. Pole 1418

28.22

49.60

40.07

30" Cedar Stp.

Cor F. Post

1 1/2" Pipe

39.50

T. Pole

2628.5

Ershig Road (L.D. Shadle Road #318)

Road Consolidation - Resolution 3458 - 1963

P. Pole

29.60

28.80

Cor. F. Post

1 1/2" Pipe

6" deep

4.10

Notes 856

T. Pole

Road Consolidation - Resolution 3458 - 1963

Notes:

507 - G-192	1951	Hardshell	A-9/13
38/346	3/12/37		
36/304			
856	4/15/54		

Road Papers:


Name	File No.
Bow Hill	680
Colony	325

SECTION 35

TOWNSHIP 36 NORTH, RANGE 3 EAST, W. M.
SKAGIT COUNTY, WASH.

SCALE, 1 INCH–400 FEET

COUNTY ENGINEER

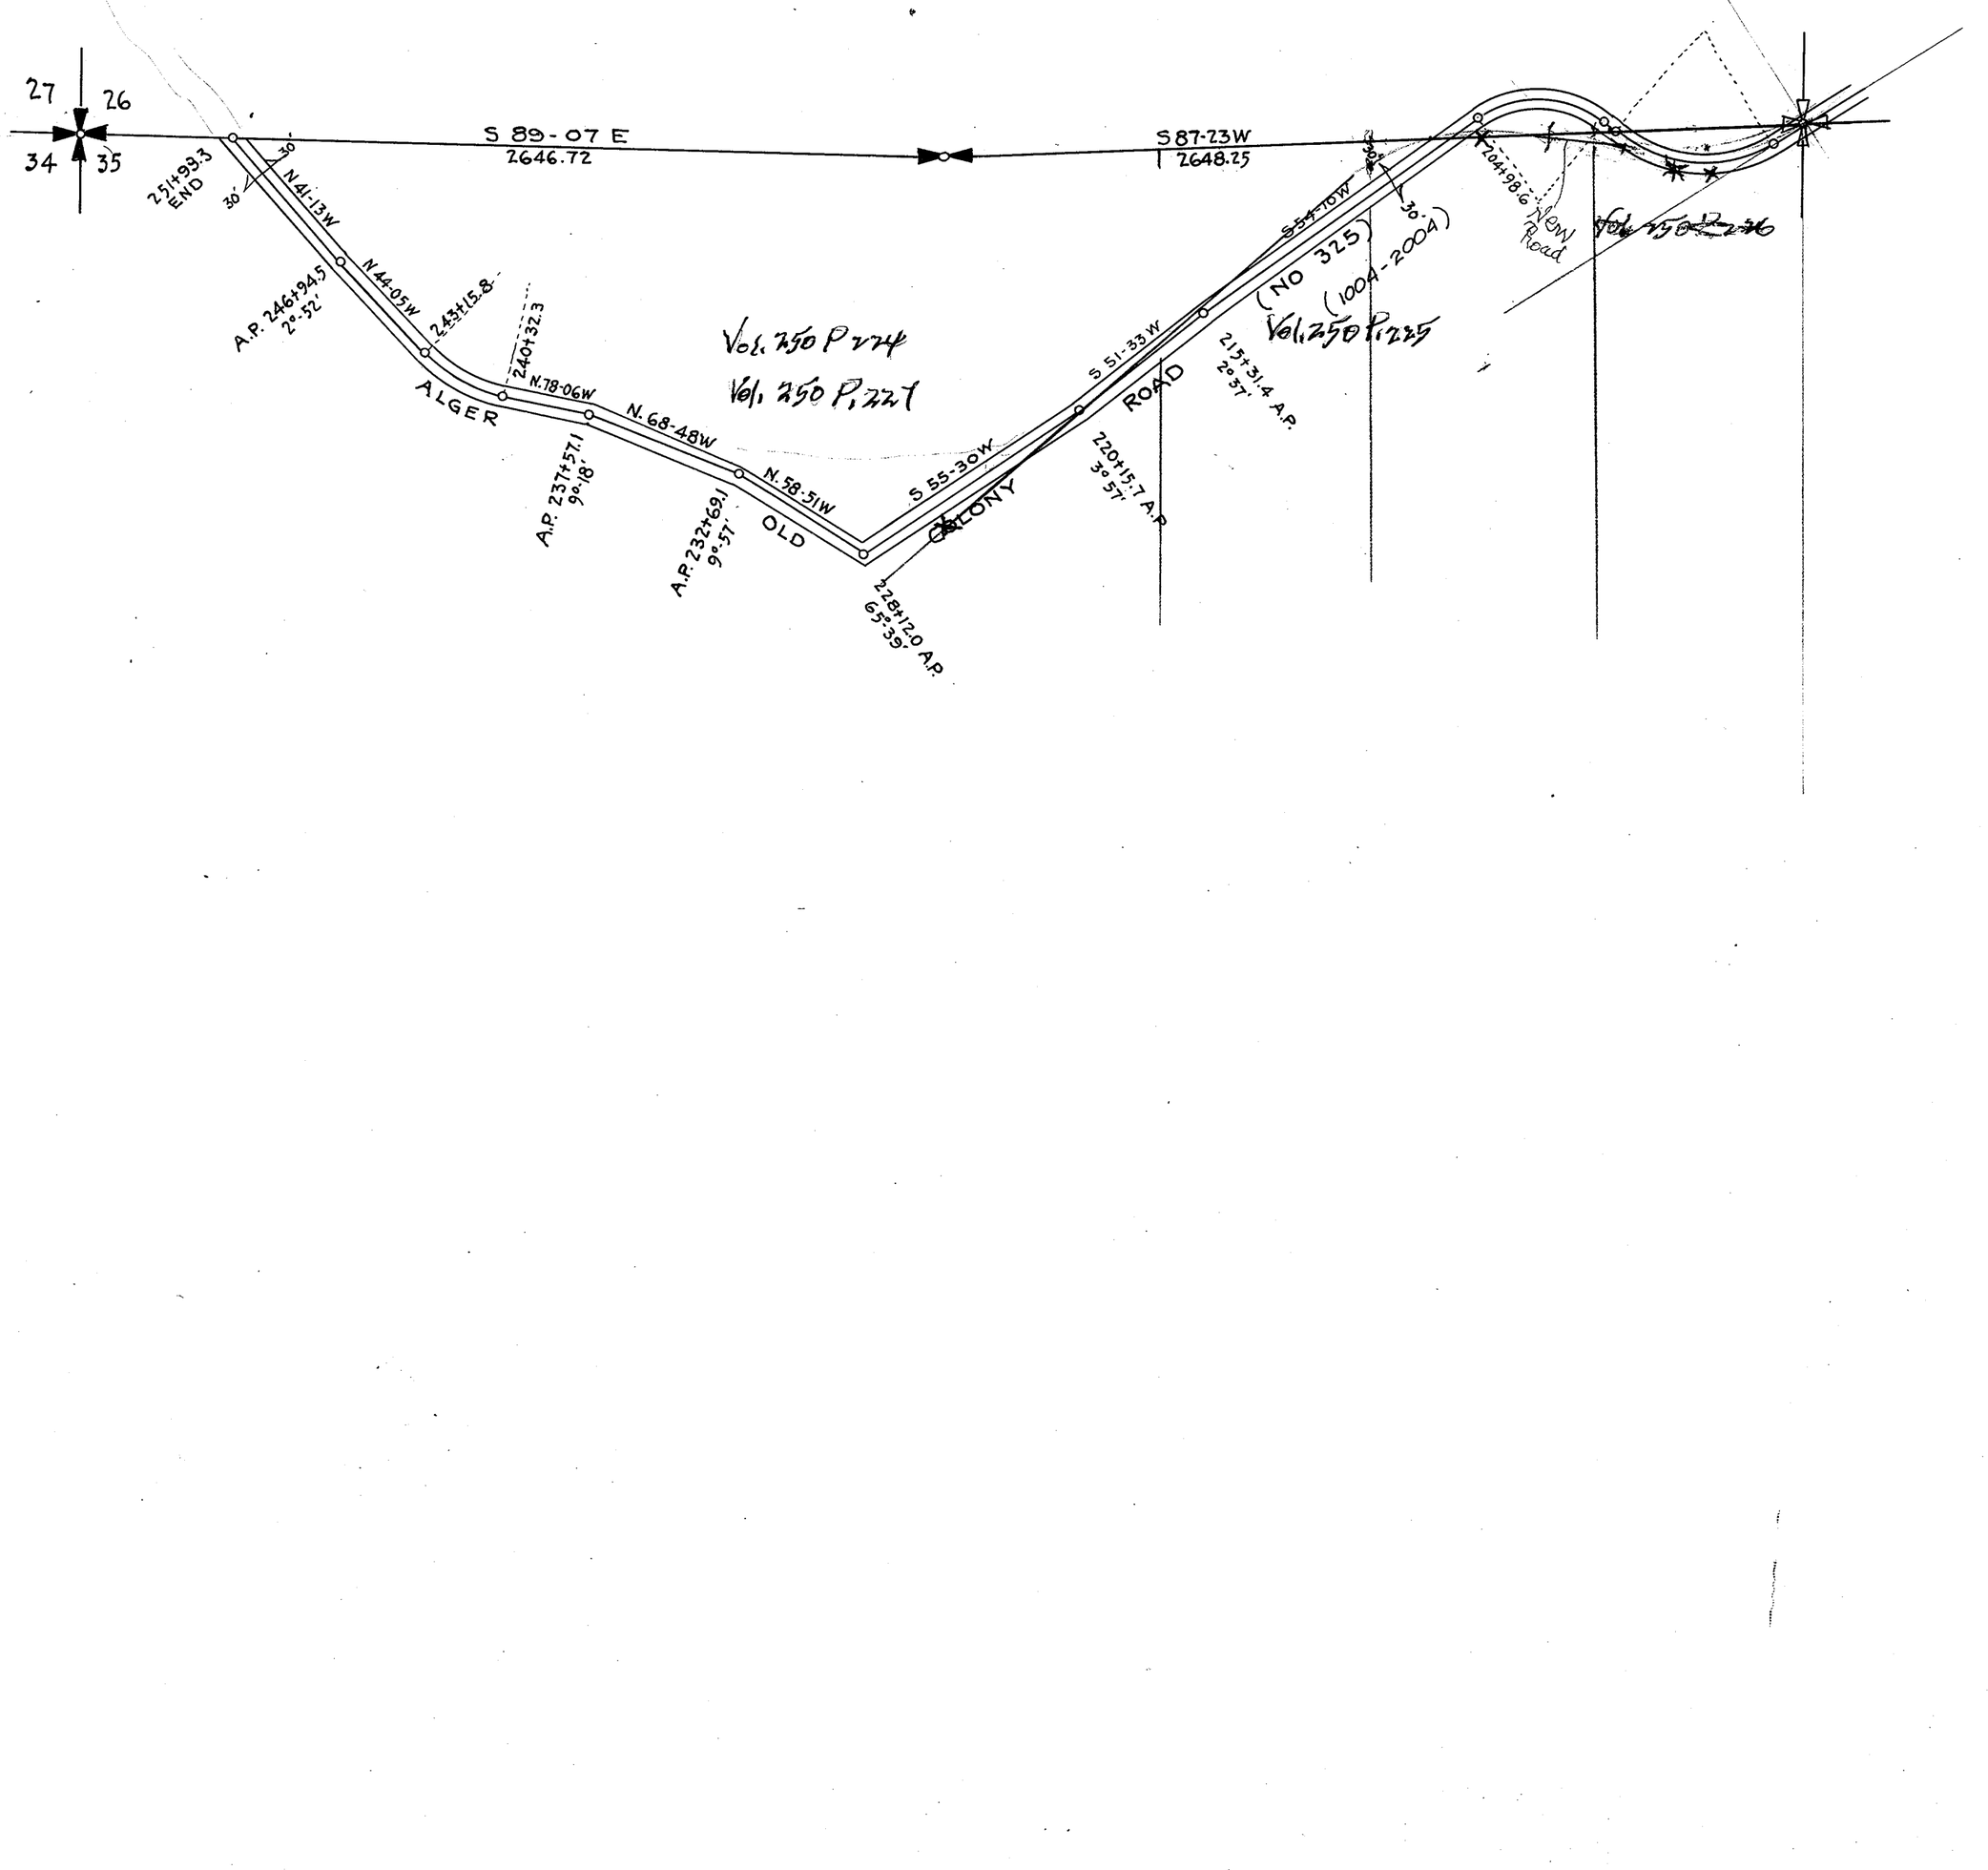


SECTION 36

TOWNSHIP 36 NORTH, RANGE 3 EAST, W. M.
SKAGIT COUNTY, WASH.

SCALE, 1 INCH—400 FEET

A. L. STRONG COUNTY ENGINEER

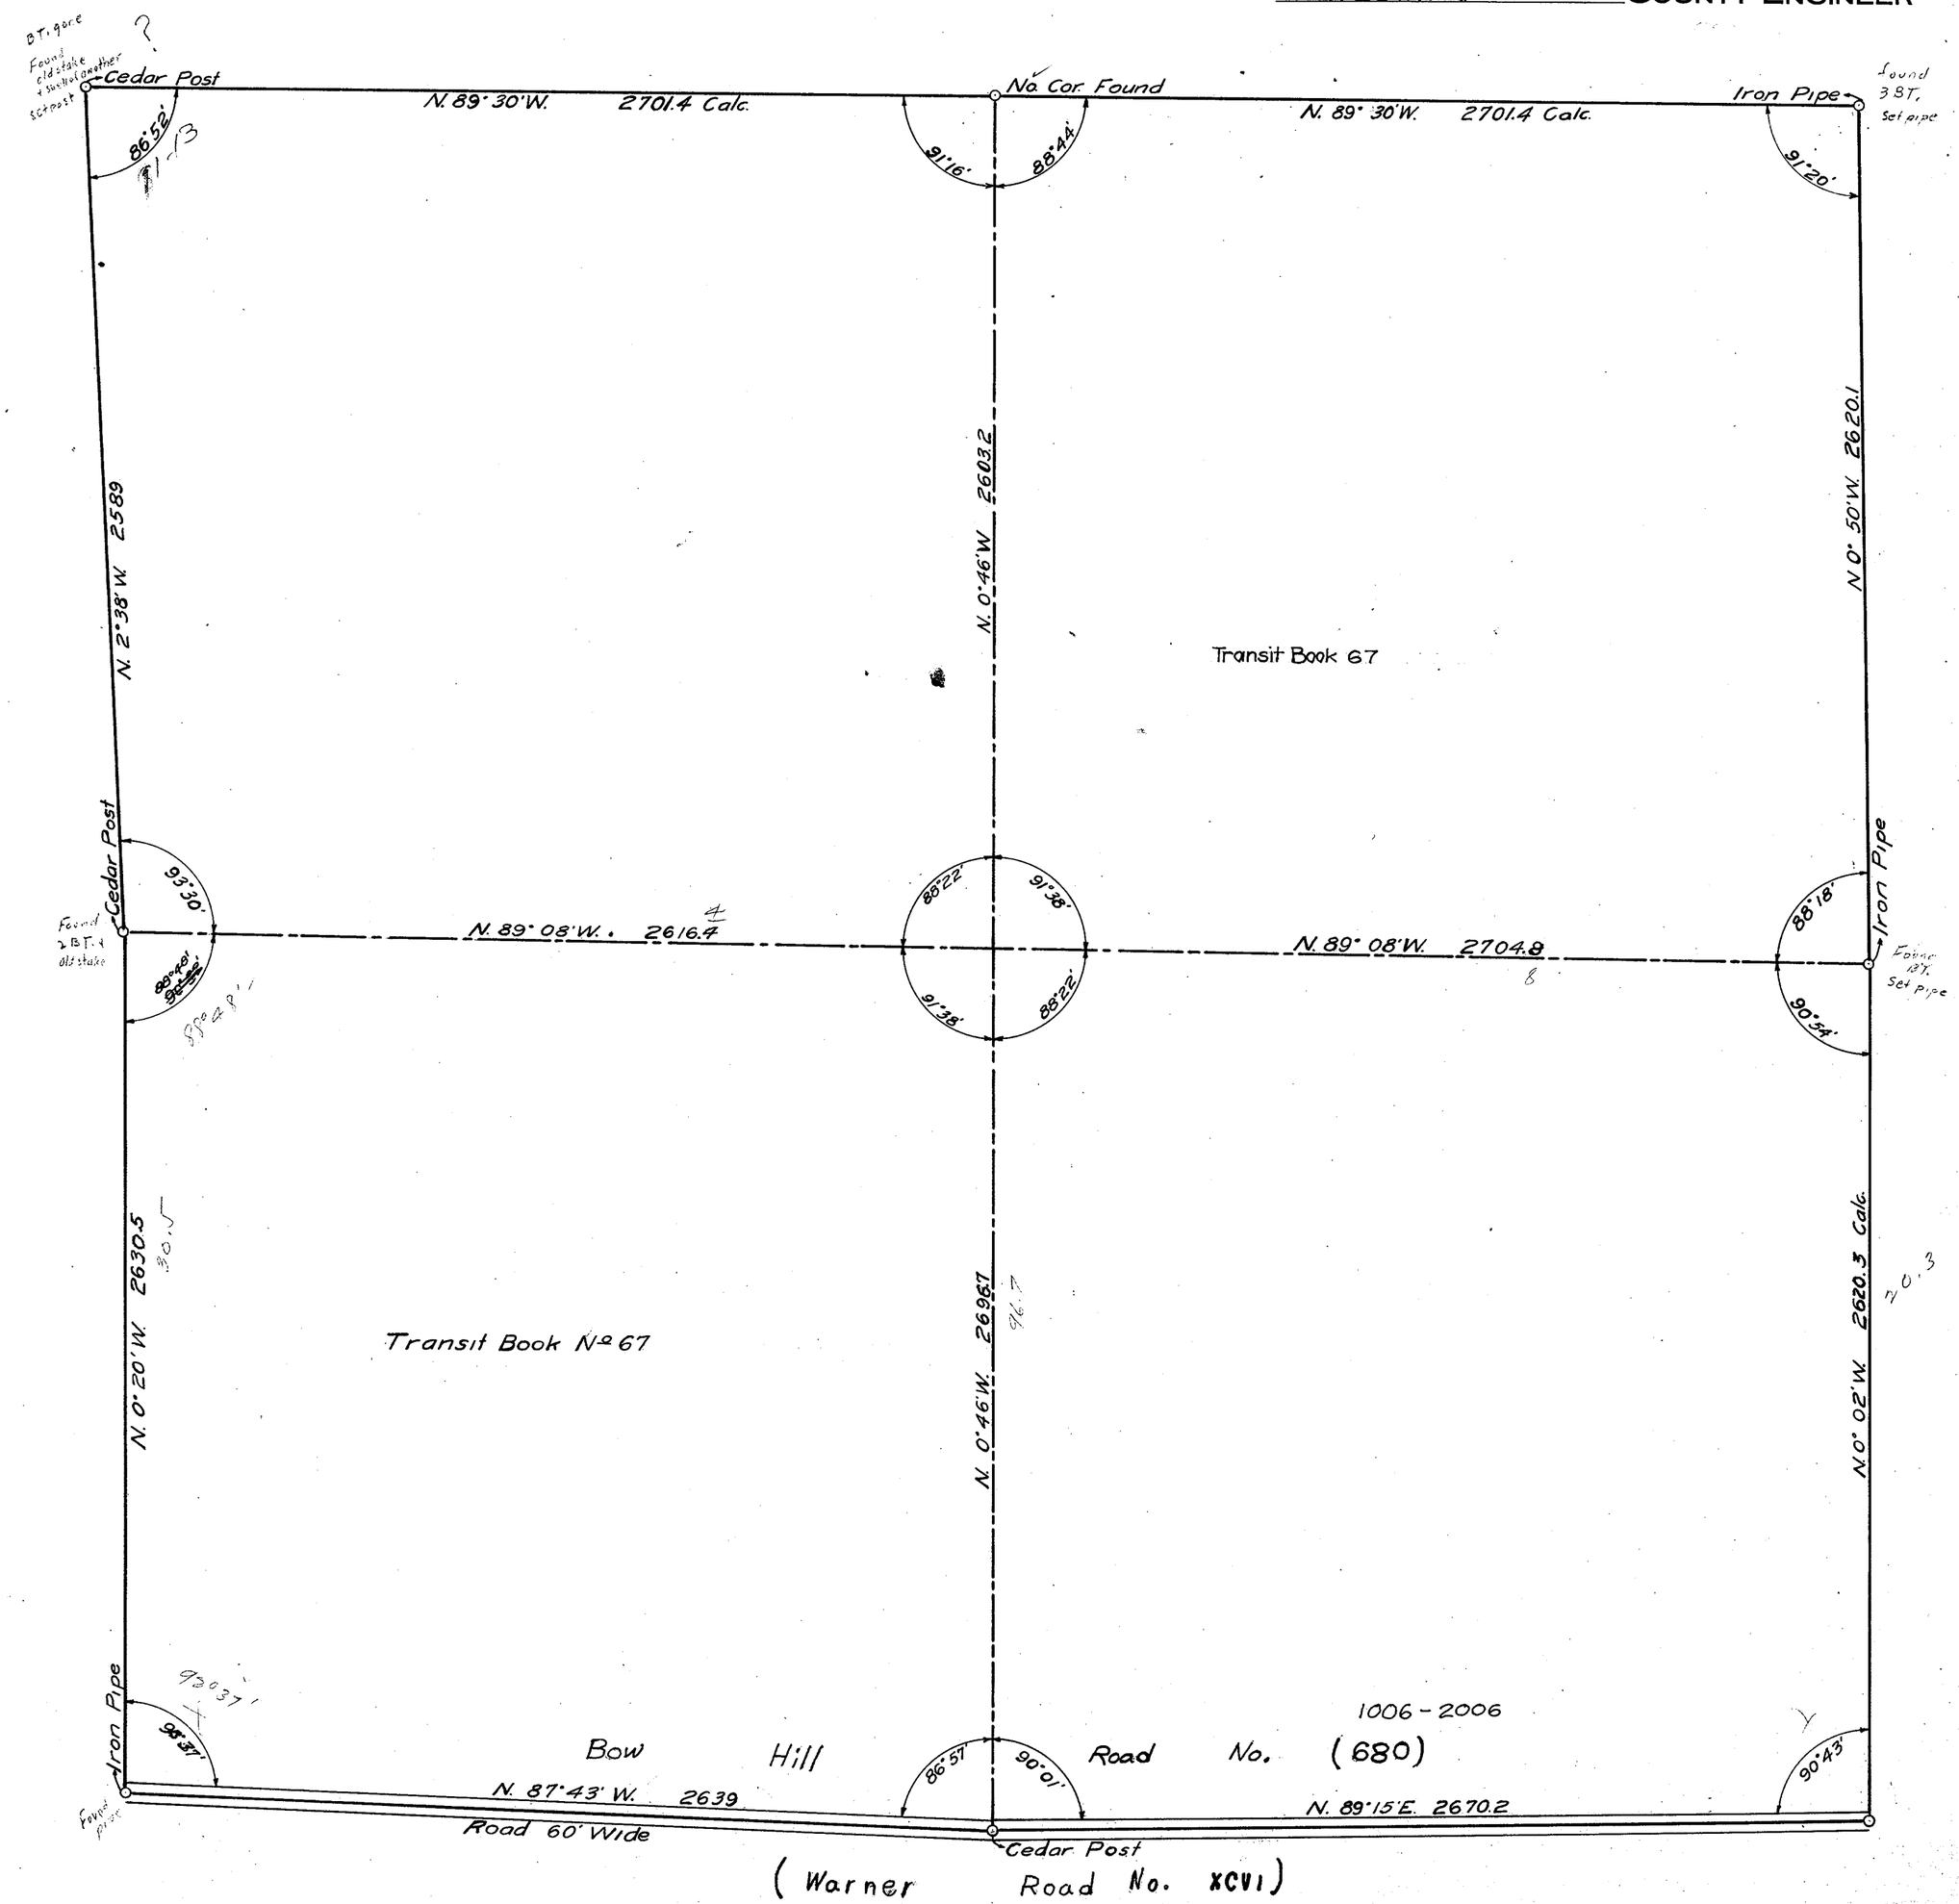

SECTION 36

TOWNSHIP 36 NORTH, RANGE 3 EAST, W. M.

SKAGIT COUNTY, WASH.

DATE August, 1965 — Lloyd — COUNTY ENGINEER

SCALE, 1 INCH--400 FEET

3' Cedar Stp. 3/64 — 69.7° — 42" Fir Stp. — 70.9° — P. Pole 3/64 — 39.1° — 4' Fir Stp. — 93.6° — Mon. 3/64 — 88.7° — 5" Alder — 100.9° — S.W. Cor House

N 88°10'17"E 2711.86 — N 89°43'39"E 2520.82 — 1" Pipe 4x4 Post MKD 25|30 / 36|31

Notes:

507 - G-192	1951
F-148	8/27/29
H-200	10/28/31
38/353	
856	4/15/54
294-2	1957

No. (1003 - 2003) 2321 — R/W - 40' — (533) — N 0° 39' W 2613.7

Road Consolidation Resolution - July 1959

No. (2605) 2442 — (333) — 35' — 25' — 40' — 40'

P. Pole 1418 — 28.0° — 30" Cedar Stp. — 49.6° — 40.7° — Cor. F. Post 3164

Shadle Road No. (2604) 2402 — (318) R/W - 40' — 1½" Pipe — 39.5° — T. Pole

T-36-N / 36 / R-3-E

Road — 1½" Pipe — 10.3° N 77 W — 48" Hemlock B.T. Scribed 1/4S

GEN. NOTATION: THIS TRACING DRAWN FROM AERIAL PHOTO

SUB-DIVISION INFORMATION SHOWN ON PREVIOUS TRACING

VACATIONS SHOWN ON INK DRAWING

Ershig — (L.D. Shadle Road No. 318) N 2°07'40"W 2628.5

Hobson — R/W - 50' to 80'

Road Papers:

Name	File No.
Ershig	533
Bow Hill	680
Hobson	333

Road Consolidation Resolution - 3458 1963

P. Pole — 29.6° — Con F. Post — 28.8° — 1½ Pipe — 44.5° — T. Pole

Bow Hill Road — R/W - N 89°34'W 2642.25 — S 87°21'E 2643.35 — (680 - XCVI)

1" Pipe Road Consolidation Resolution - 3458 1963

No. (1006 - 2006) 2120 — N 89°39'E 2663.04 — R/W - (?) @ 60'

SHADLE ROAD NO. 318

SECTION 36

TOWNSHIP 36 NORTH, RANGE 3 EAST, W. M.

SKAGIT COUNTY, WASH.

SCALE, 1 INCH = 400 FEET

FILE - Notes F-148

Robt. E. L. Knapp COUNTY ENGINEER

Survey Sept. 1929

Pipe

N. 88-08 E. 2710.09

Pipe

N. 89°50'-47" E 2522.02

Pipe

Alger-Old Colony Rd. 325

20' 20'

Bloedel - Donovan Lumber Mill

(No. 533)

No. 1003 2003

N 0-39 W. 2615.59

Road

SCHOOL LAND

STATE

Tot. 40.79 Net. 39.58

Consolidation Resolution 3673 (1964)

2604

L. D. Shadle (#318)

Leassee

Clarence Pocock

2653.92

176-496

176-490

Hobson Rd #333; 50 to 80' wide Comm. File 7842

2617.01 N. 2°34'34" W.

Stake

1354.65 0.61 Ac

20' 20'

0.61 Ac

2709.31

T. 36 N. R. 3 E. 36

N. 88-59-20 E. 2610.18

Pipe

Ershig Consolidation July, 1959

L. D. Shadle #318

Leassee W½

Tot. Ac 40.90 Net 39.69

2695.89

176-497

1329.89

20' 20'

Hobson Rd #333; 50 to 80' wide

E. T. Nobles

N 2-07-40 W 2629.51

N 0-39 W.

N 88-12 E 1318.07

1318.41

N 1-13 W 2659.76

N 1-47 W 2623.63

Tot. 40.89 Net 38.85

Warner Road

Bow Hill Road No. 1005

20' 20'

1329.87

Survey of Nov. 1931

176-494

176-498

J. Coates

Vacated 8-25-58 No. XCVI Com. file No 9988

Pipe

2642.25 S. 89-34 E.

WARNER ROAD

No. XCVI

Sch.

Pipe

N 87-26 E 2663.38

(No. XCVI)

Pipe


SECTION 4

TOWNSHIP 36 NORTH. RANGE 4 EAST. W. M.
SKAGIT COUNTY. WASH.

SCALE, 1 INCH—400 FEET

LLOYD H. JOHNSON COUNTY ENGINEER

DATE SEPT. 5, 1972

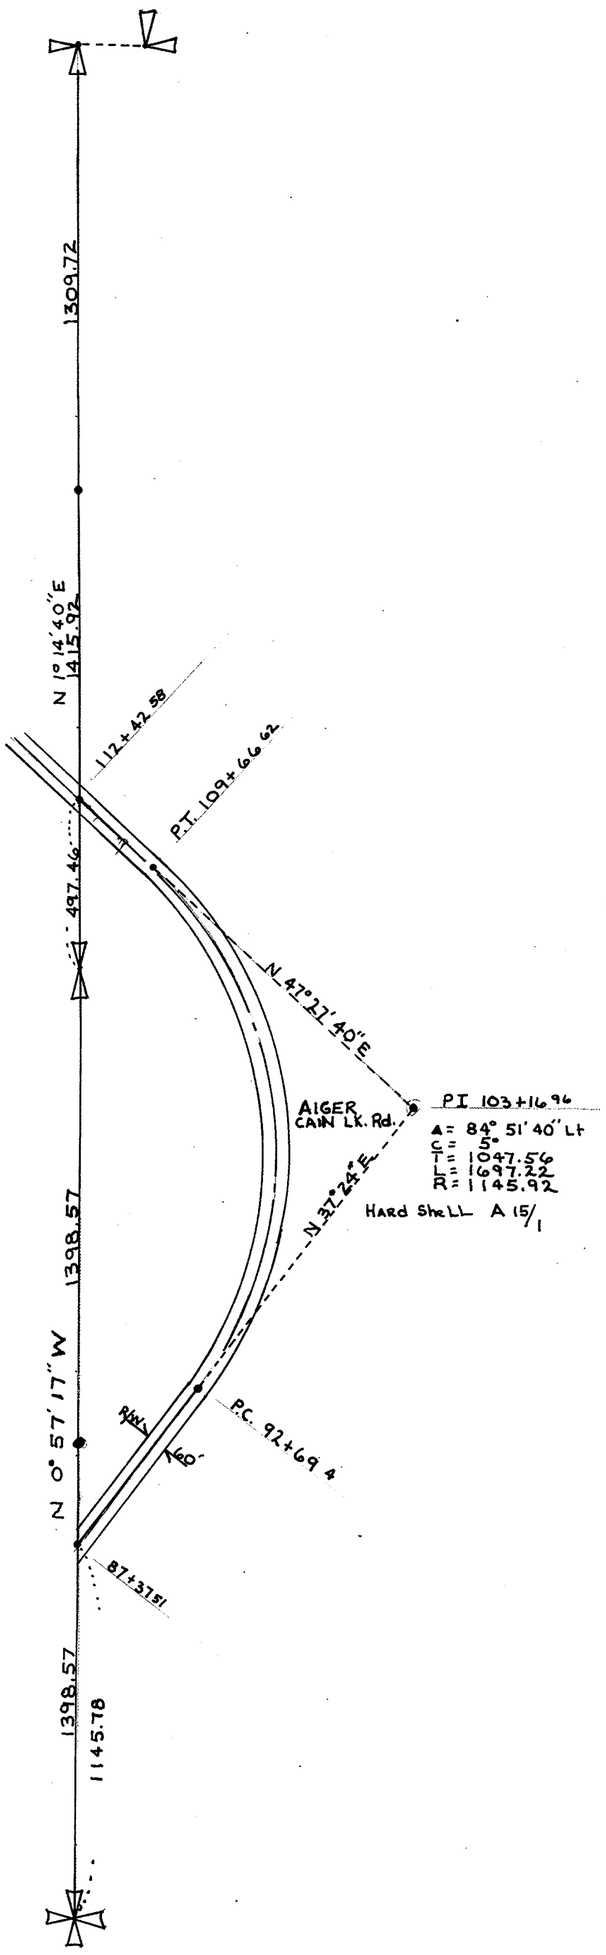


SECTION 5

TOWNSHIP 36 NORTH. RANGE 4 EAST. W. M.
SKAGIT COUNTY. WASH.

SCALE, 1 INCH—400 FEET

LLOYD H. JOHNSON COUNTY ENGINEER

DATE SEPT 6, 1972

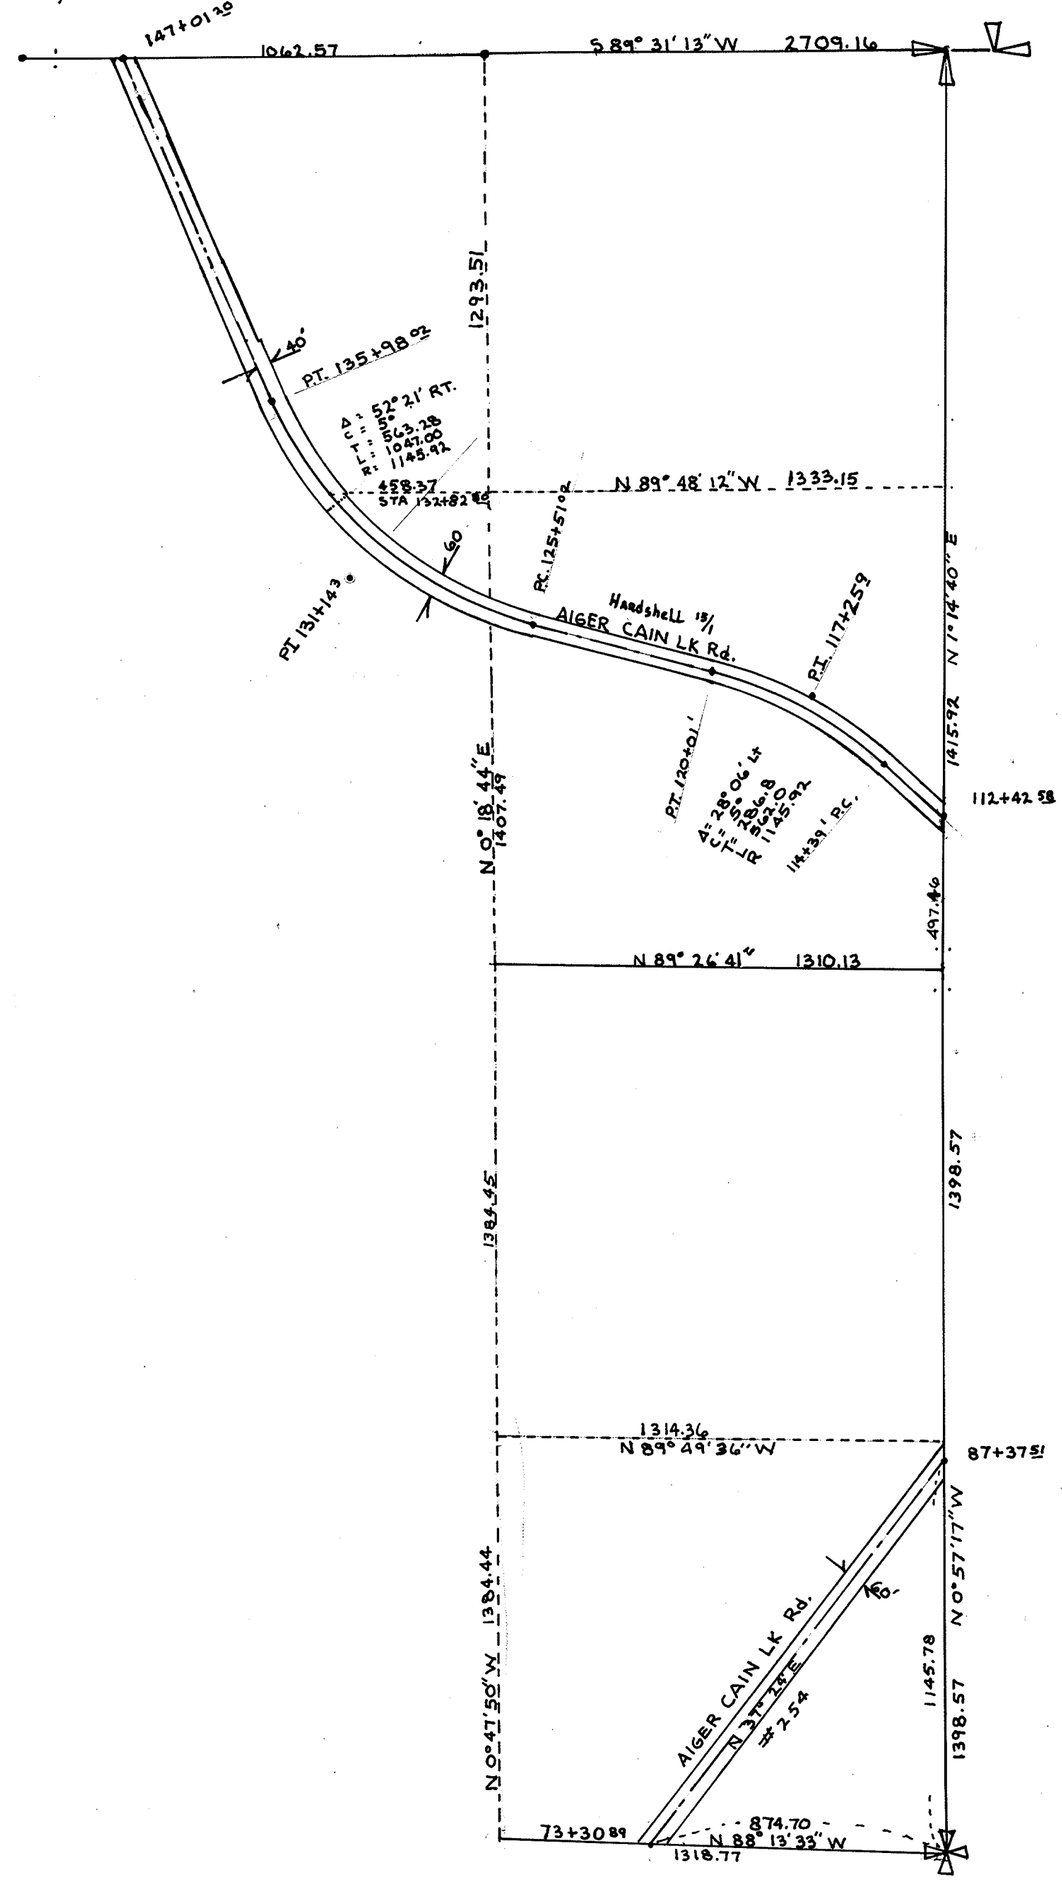

SECTION 5

TOWNSHIP 36 NORTH, RANGE 4 EAST, W. M.

SKAGIT COUNTY, WASH.


SCALE, 1 INCH--400 FEET

DATE August, 1965

Lloyd Johnson COUNTY ENGINEER

GEN. NOTATION: THIS TRACING DRAWN FROM AERIAL PHOTO

SUB-DIVISION INFORMATION TAKEN FROM PREVIOUS TRACING

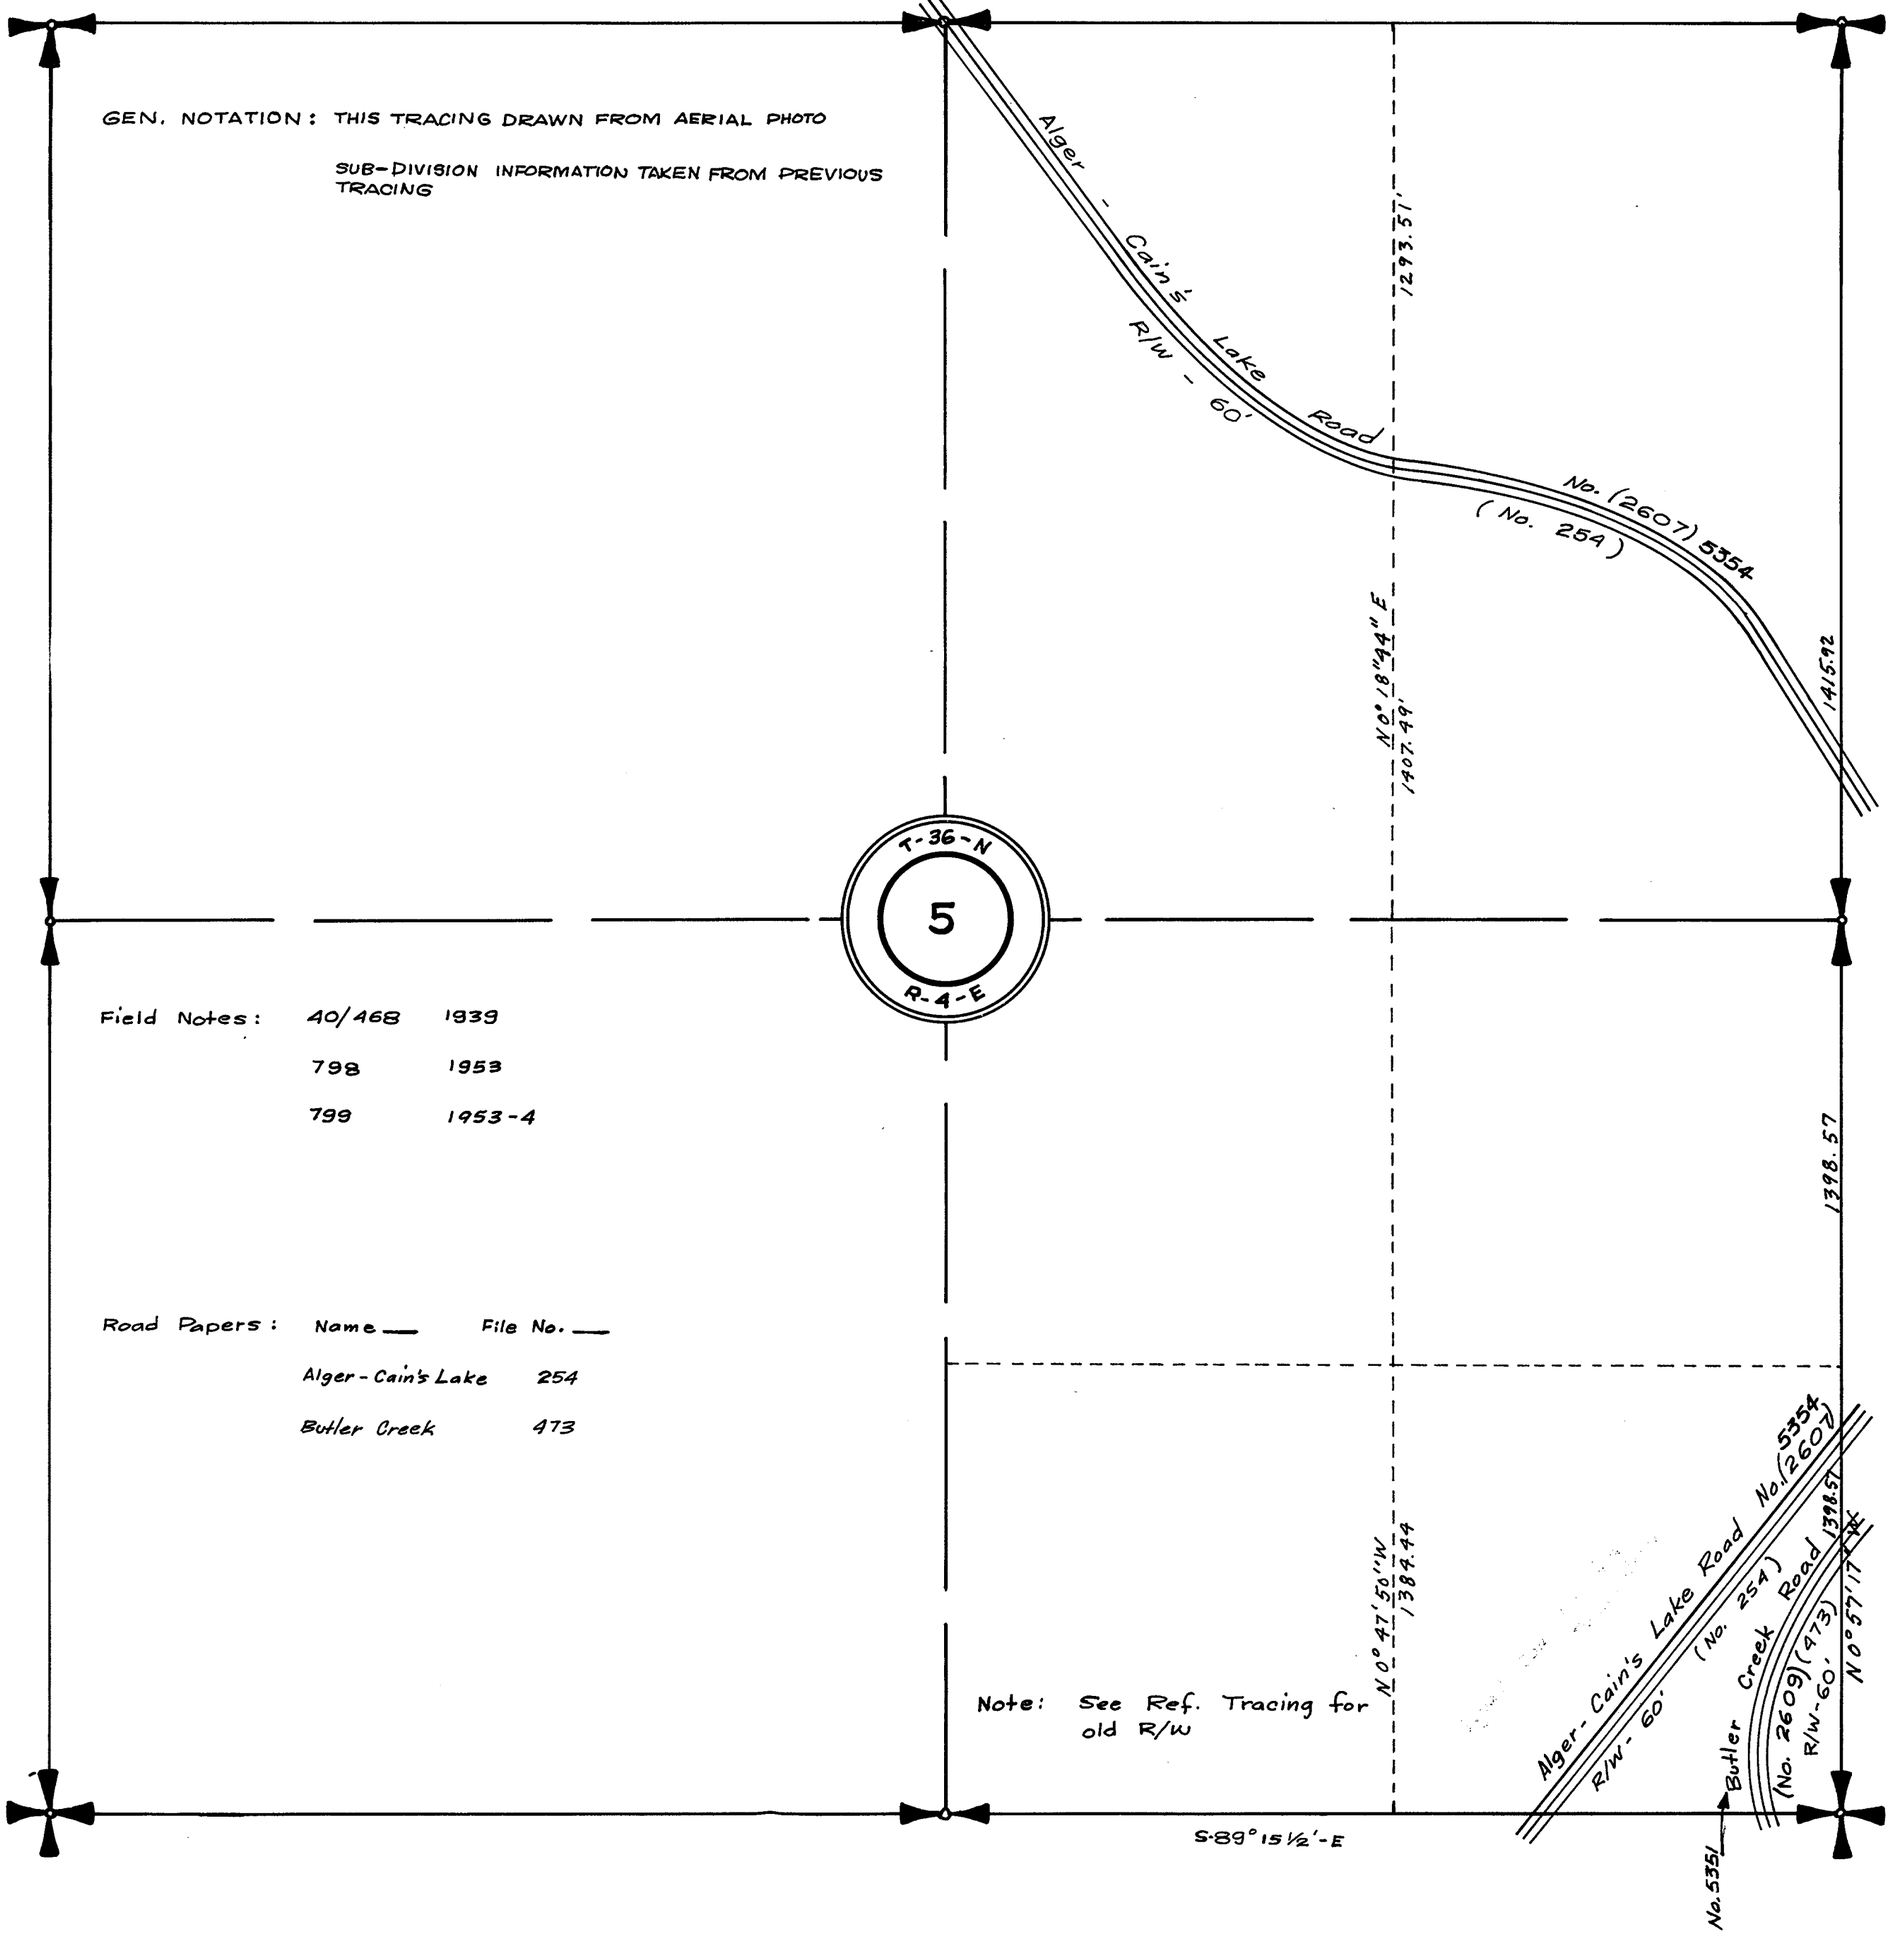

Field Notes:

	40/468	1939
	798	1953
	799	1953-4

Road Papers:

Name	File No.
Alger - Cain's Lake	254
Butler Creek	473


Note: See Ref. Tracing for old R/W

SECTION 5

TOWNSHIP 36 NORTH, RANGE 4 EAST, W. M.
SKAGIT COUNTY, WASH.

SCALE, 1 INCH–400 FEET

Arthur L Strong COUNTY ENGINEER

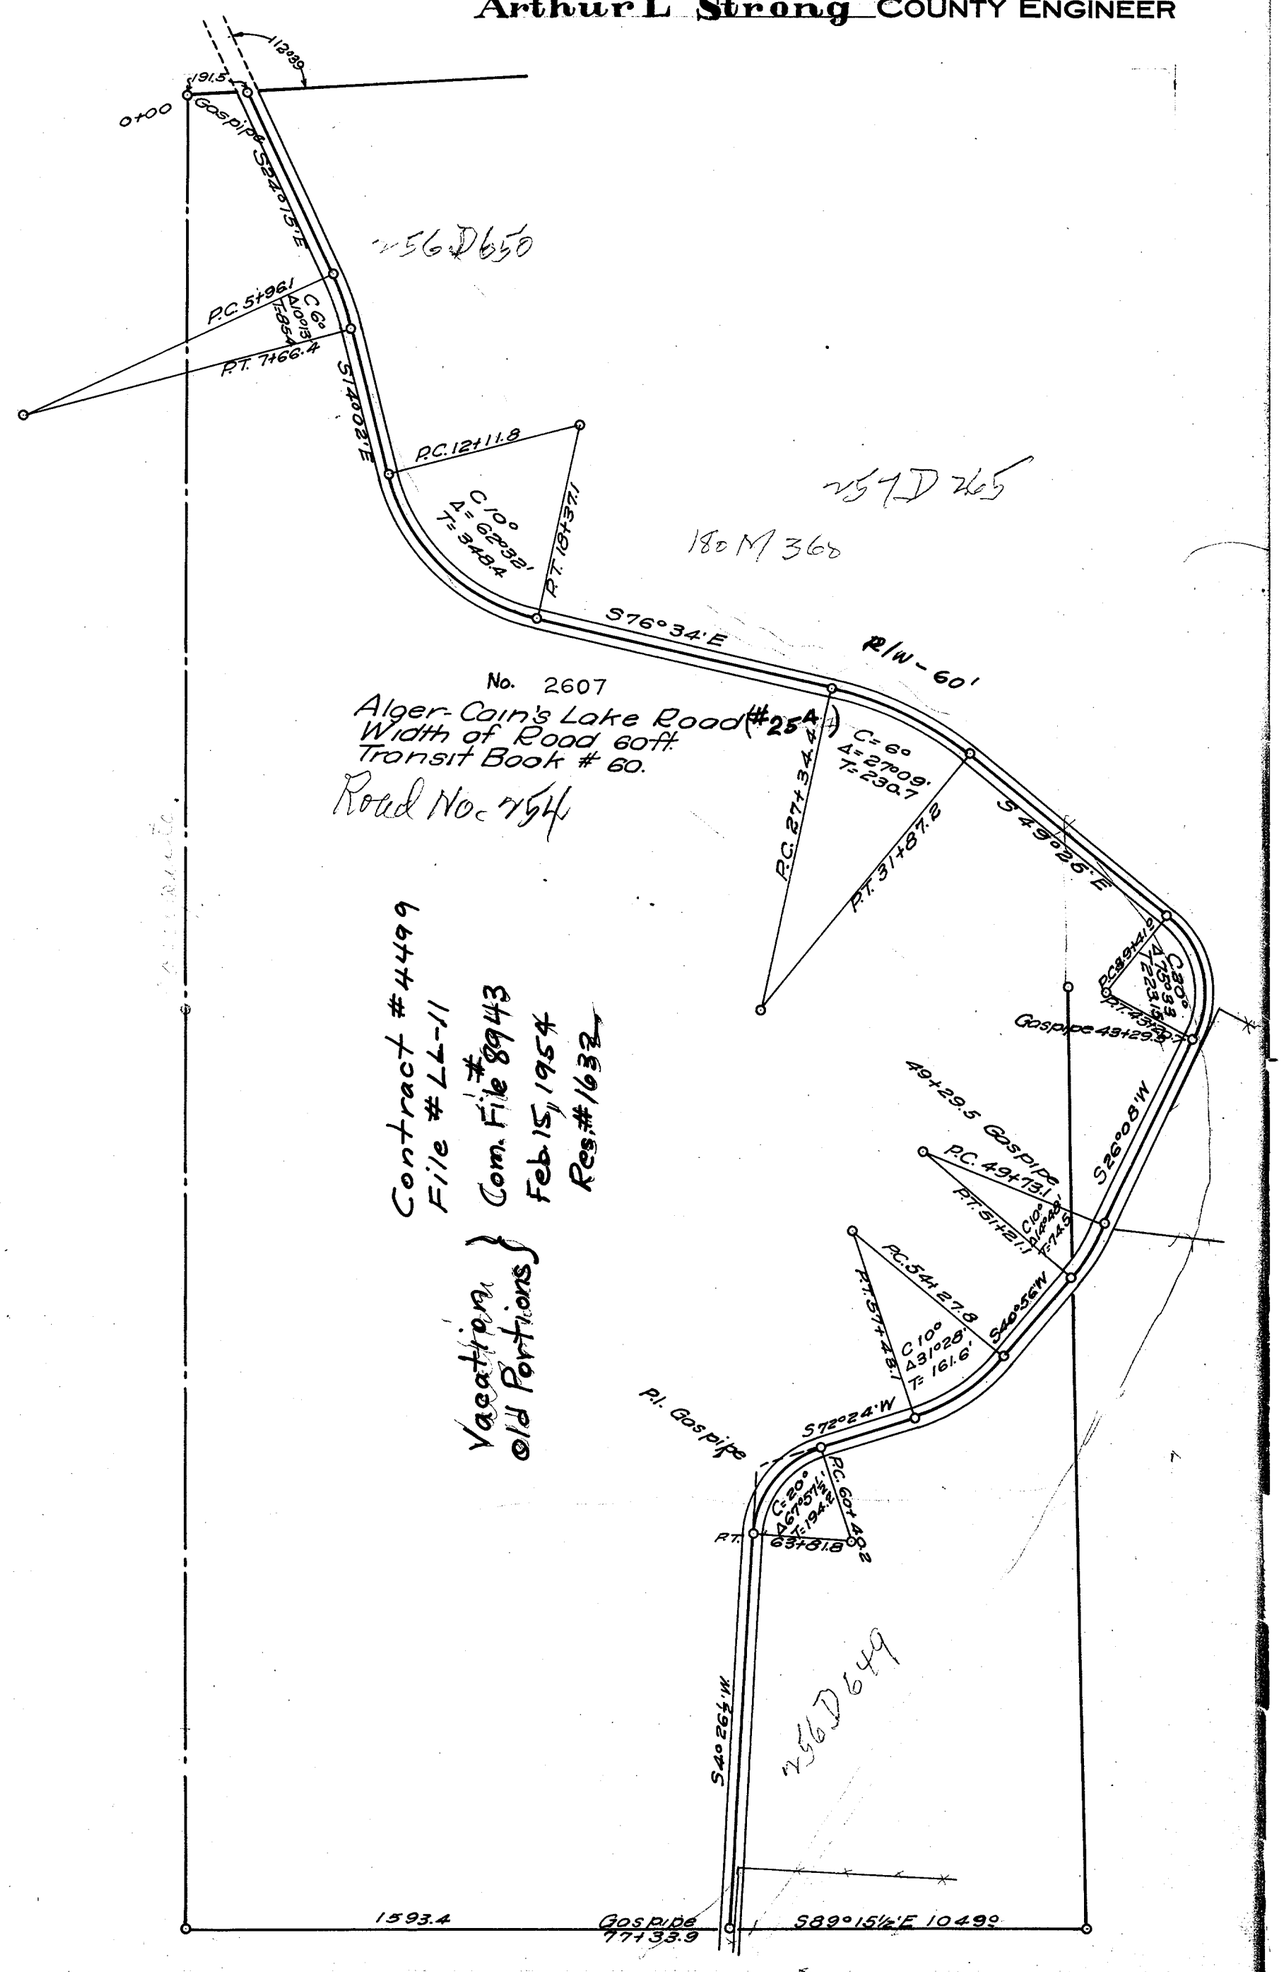

SECTION 7

TOWNSHIP 36 NORTH, RANGE 4 EAST, W. M.

SKAGIT COUNTY, WASH.

SCALE, 1 INCH--400 FEET

DATE August, 1965

Lloyd Johnson COUNTY ENGINEER

Field Notes: 33/231 - 1933

41/547

875 1955

15 - Hard Book 4/14/60

Road Papers:

Name	Deed File #
Lake Samish	277
Colony	325
Alger Cain Lake	254

GEN. NOTATION:

THIS TRACING DRAWN FROM AERIAL PHOTO

PREVIOUS TRACING SHOWS R/W FOR ROAD NO. 2601

U.S. HWY. (99) - 5

T-36-N
7
R-4-E

Road Consolidation
Resolution - 3673
1964

Lake Samish Road
R/W - 60'-45'-40'
(No. 277)

No. 2561
(2601)

(1004 2400 - 2004)

No. 5354
Alger Cain's Lake Road
(No. 2607) (254)
R/W - 60'

Colony Road
(Alger-Old Colony Road)
No. 325
R/W-60'


Road Consolidation
Resolution - 3458
1963

SECTION 7

TOWNSHIP 36 NORTH, RANGE 4 EAST, W. M.
SKAGIT COUNTY, WASH.

SCALE, 1 INCH–400 FEET

_____ COUNTY ENGINEER

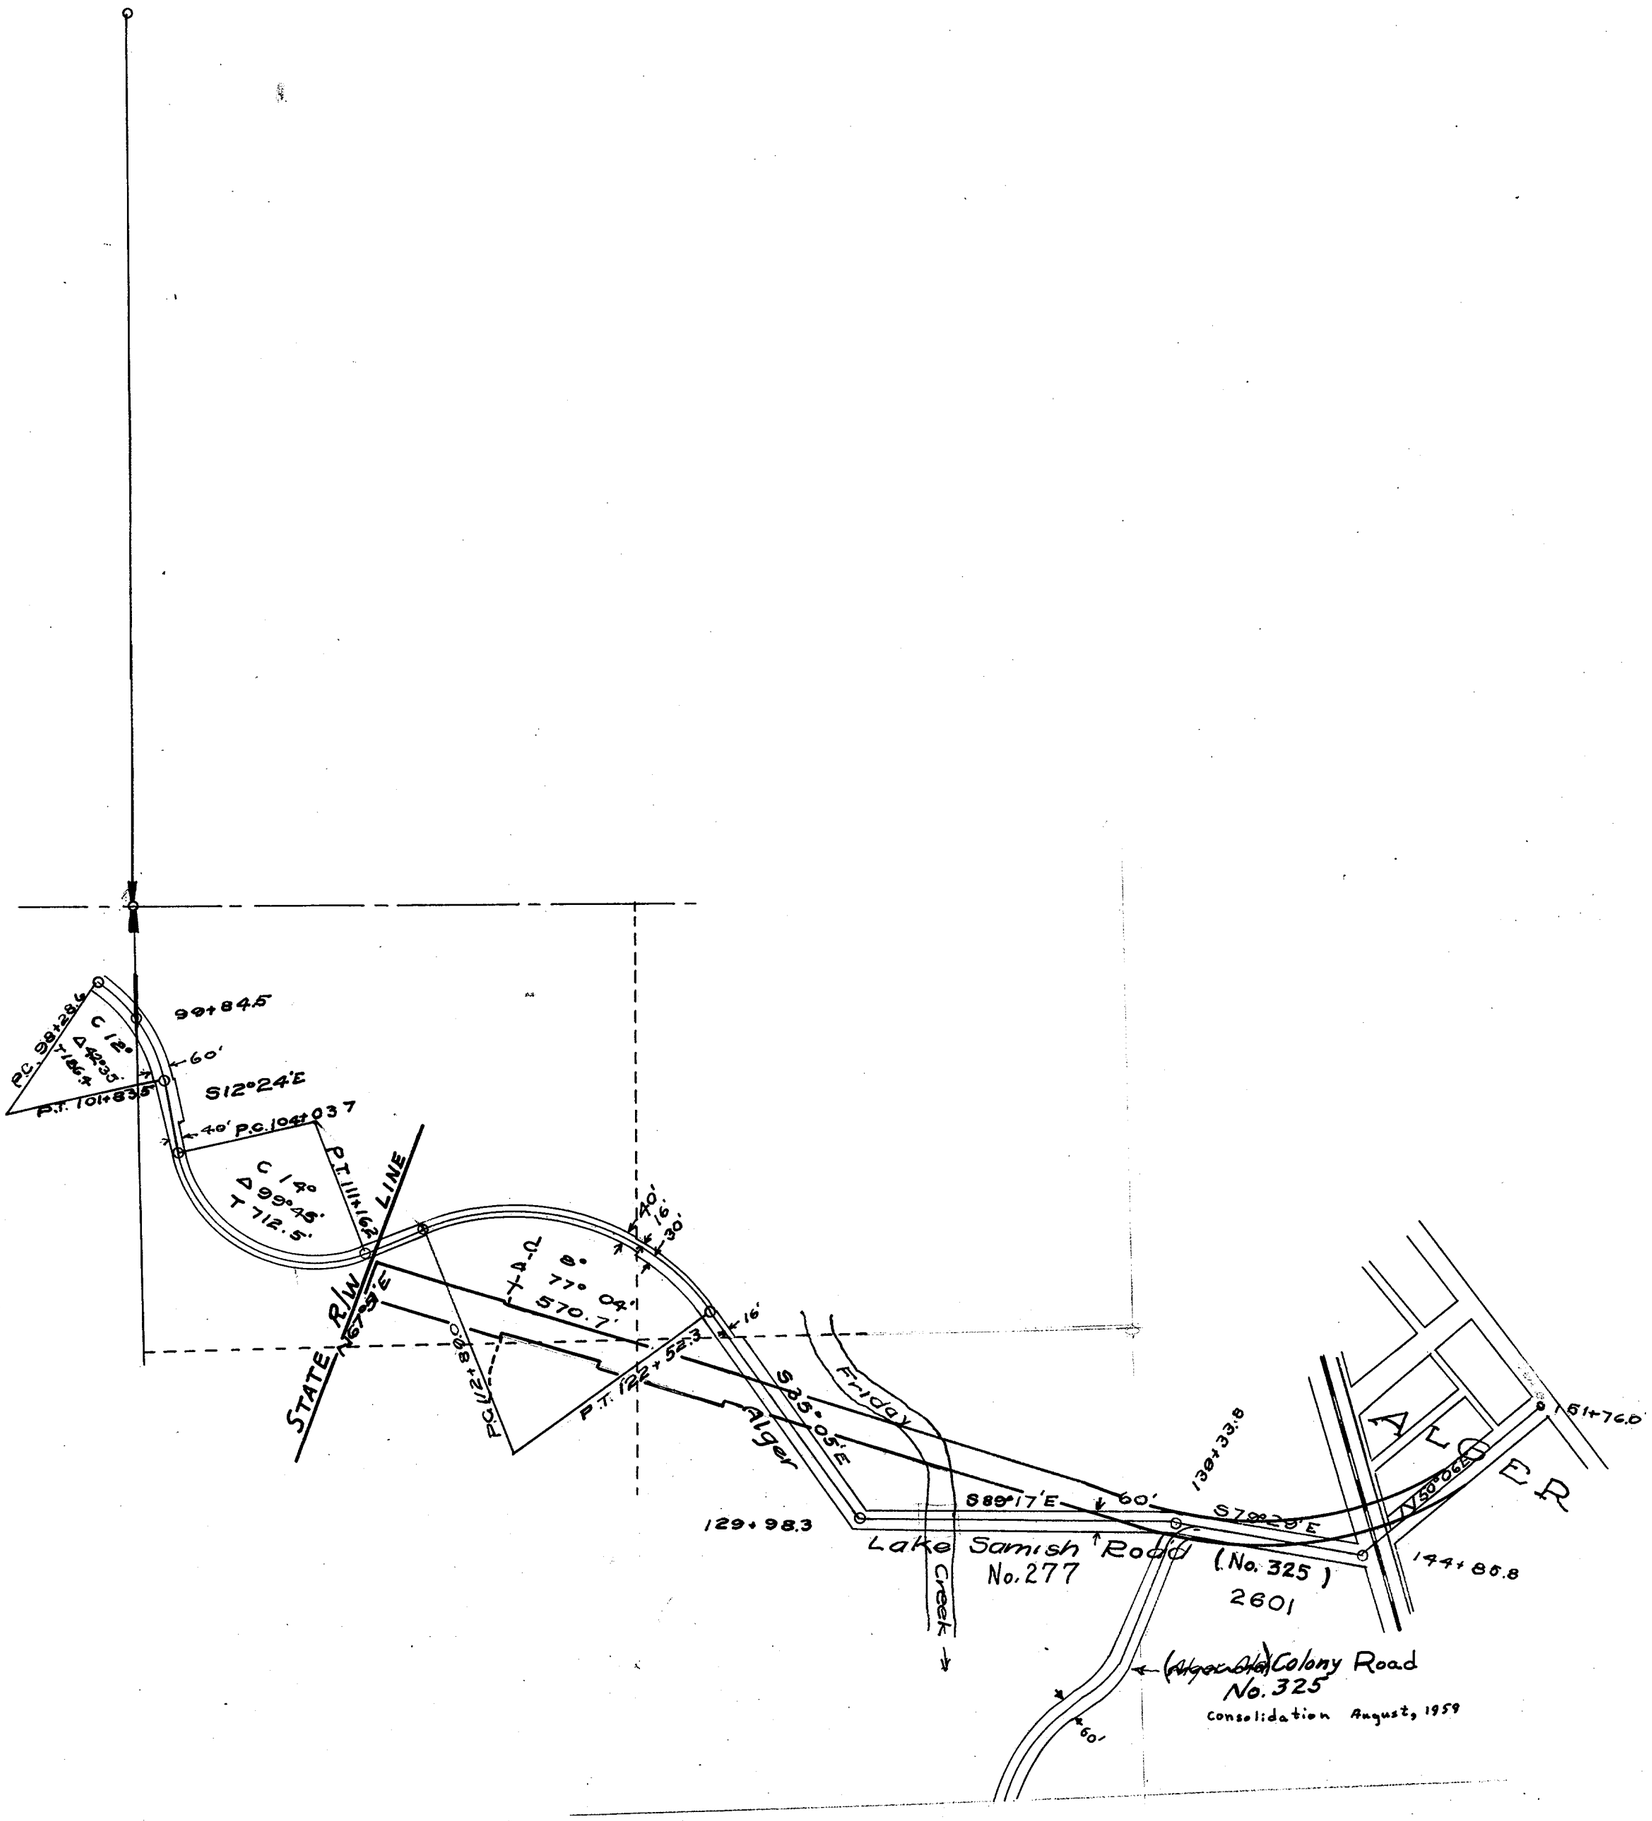

SECTION 8

TOWNSHIP 36 NORTH, RANGE 4 EAST, W. M.

SKAGIT COUNTY, WASH.

SCALE, 1 INCH--400 FEET


DATE August, 1965 Lloyd Johnson COUNTY ENGINEER

Field Notes:

40/468	1939
40/468	
48/622	5/18/46
51/707	6/25/51
707	1951
798	1953
799	1953-4

GEN. NOTATION: THIS TRACING DRAWN FROM AERIAL PHOTO

PREVIOUS TRACING SHOW R/W FOR ROAD NO. 2607 - (Note Relocation)

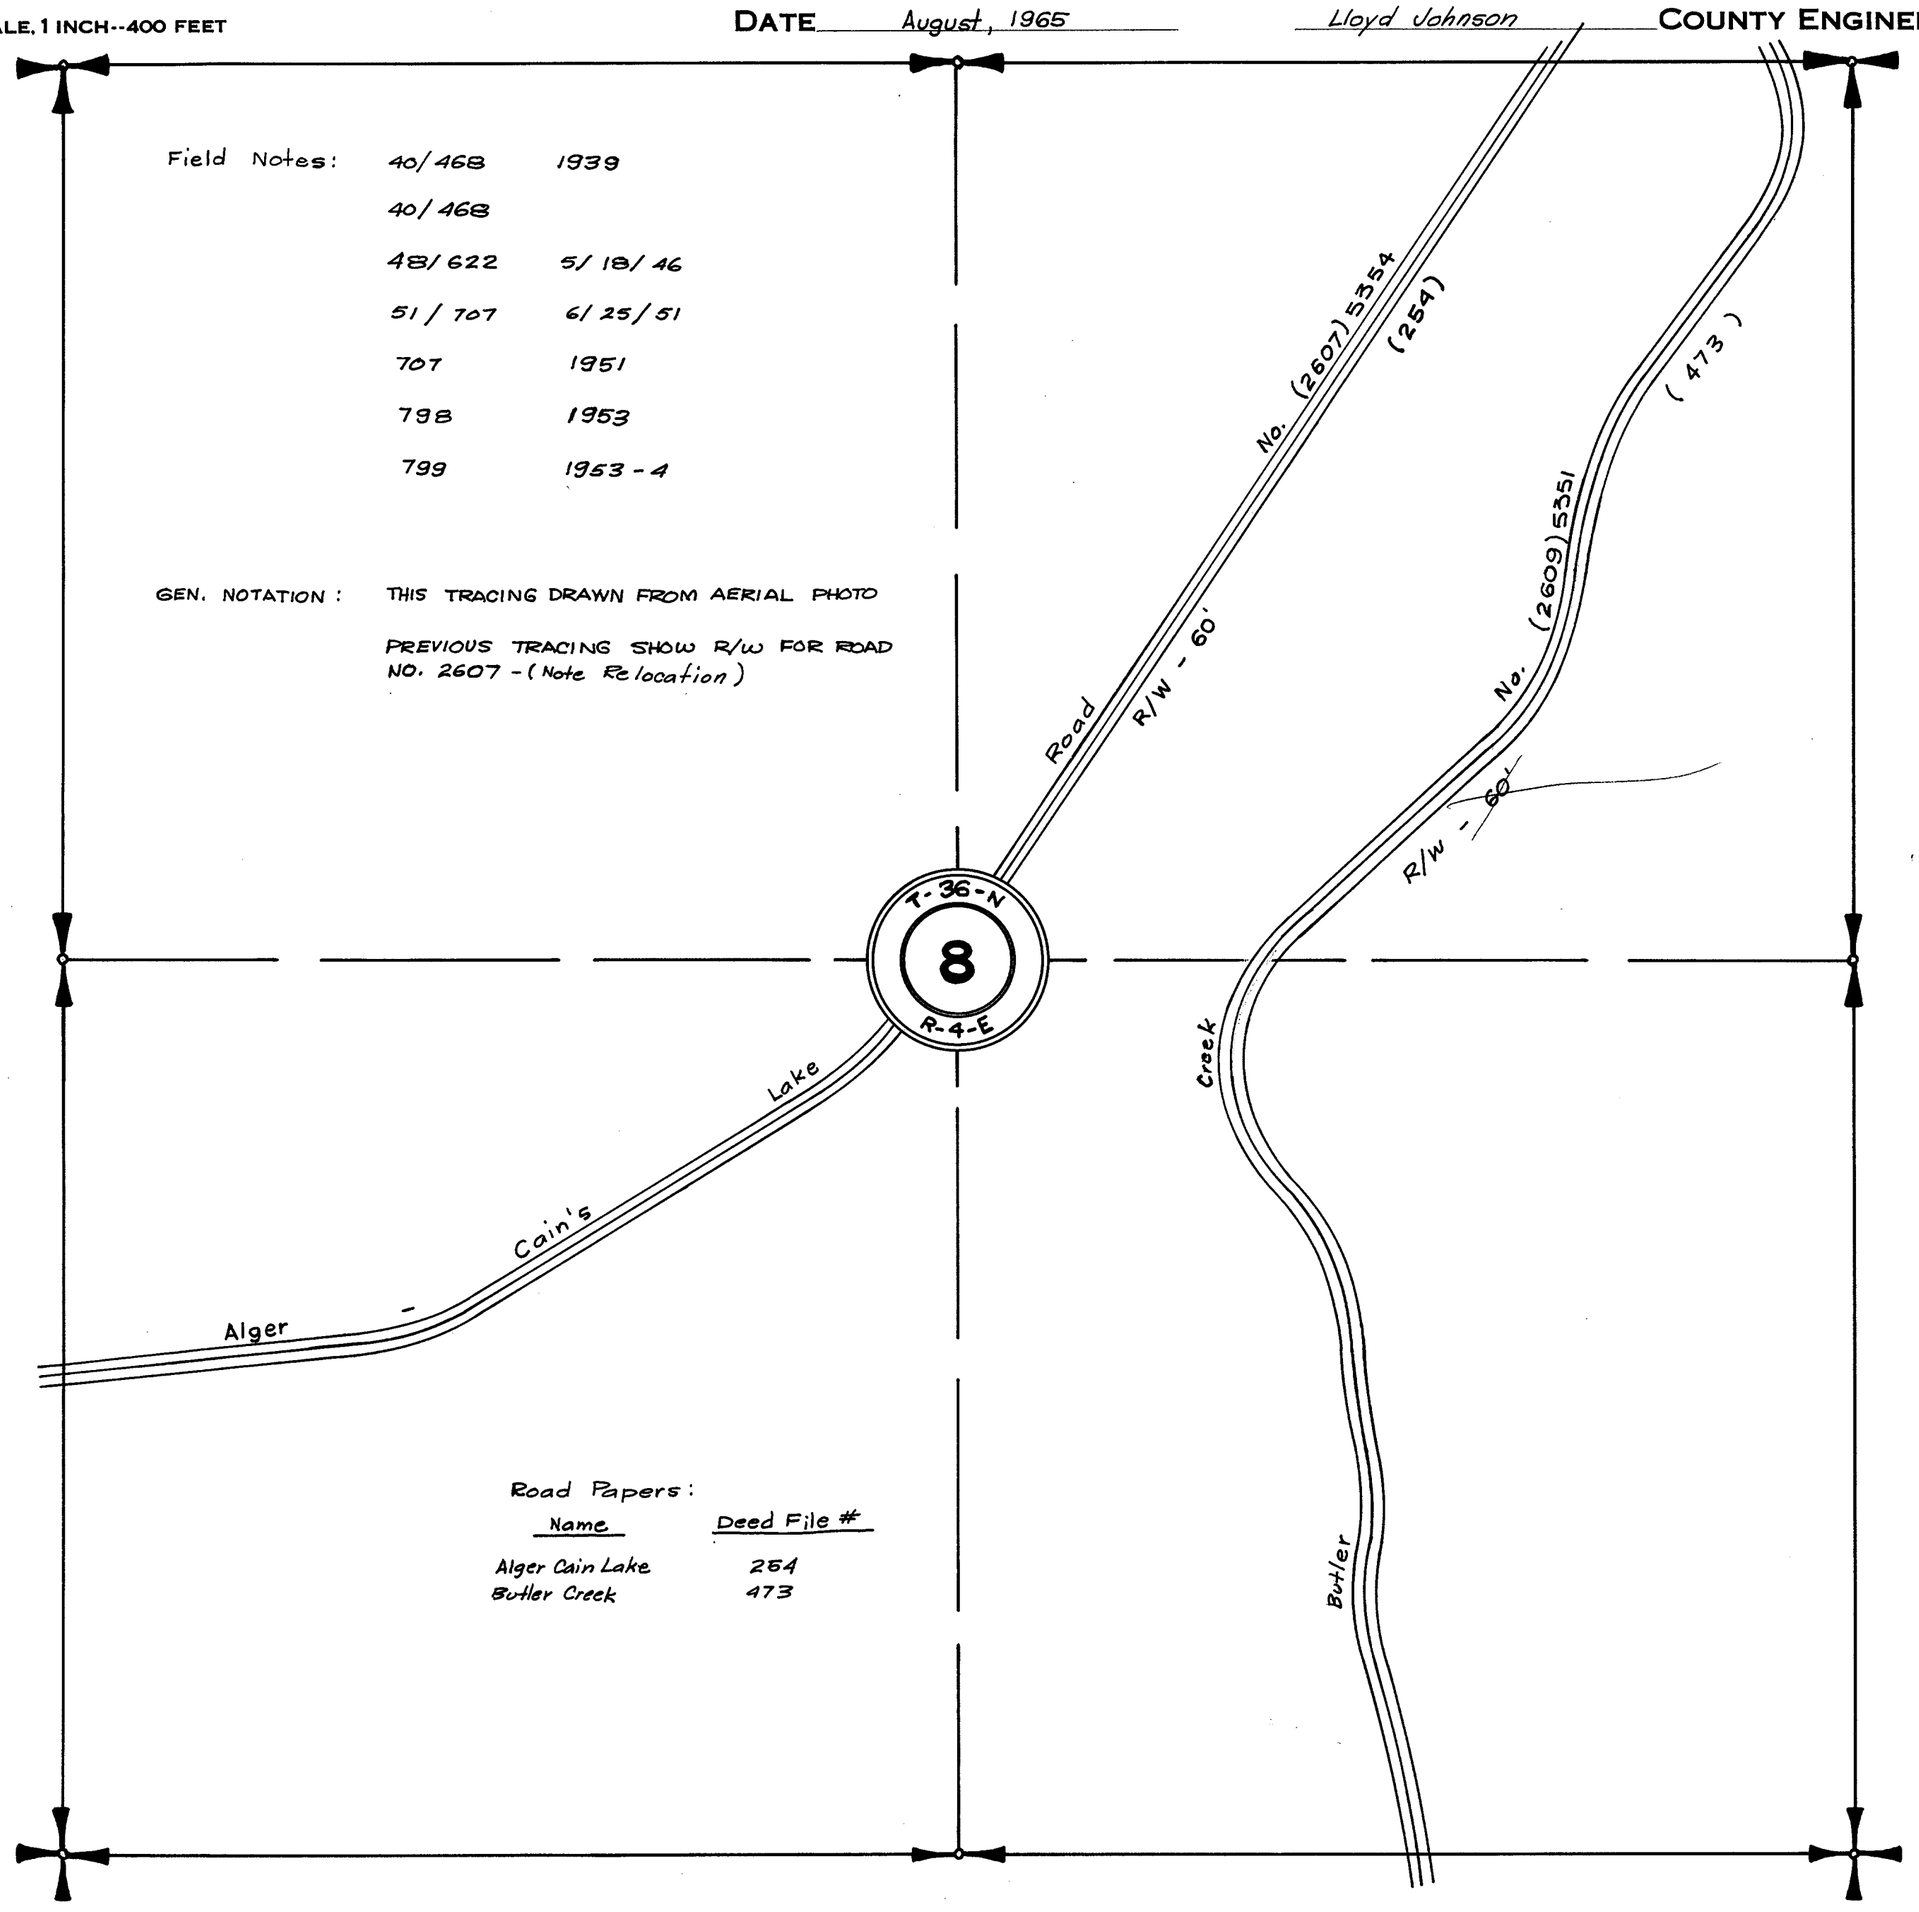

Road Papers:

Name	Deed File #
Alger Cain Lake	254
Butler Creek	473


SECTION 8

TOWNSHIP 36 NORTH. RANGE 4 EAST. W. M.
SKAGIT COUNTY. WASH.

SCALE. 1 INCH—400 FEET

LLOYD H. JOHNSON COUNTY ENGINEER

DATE SEPT. 8, 1972

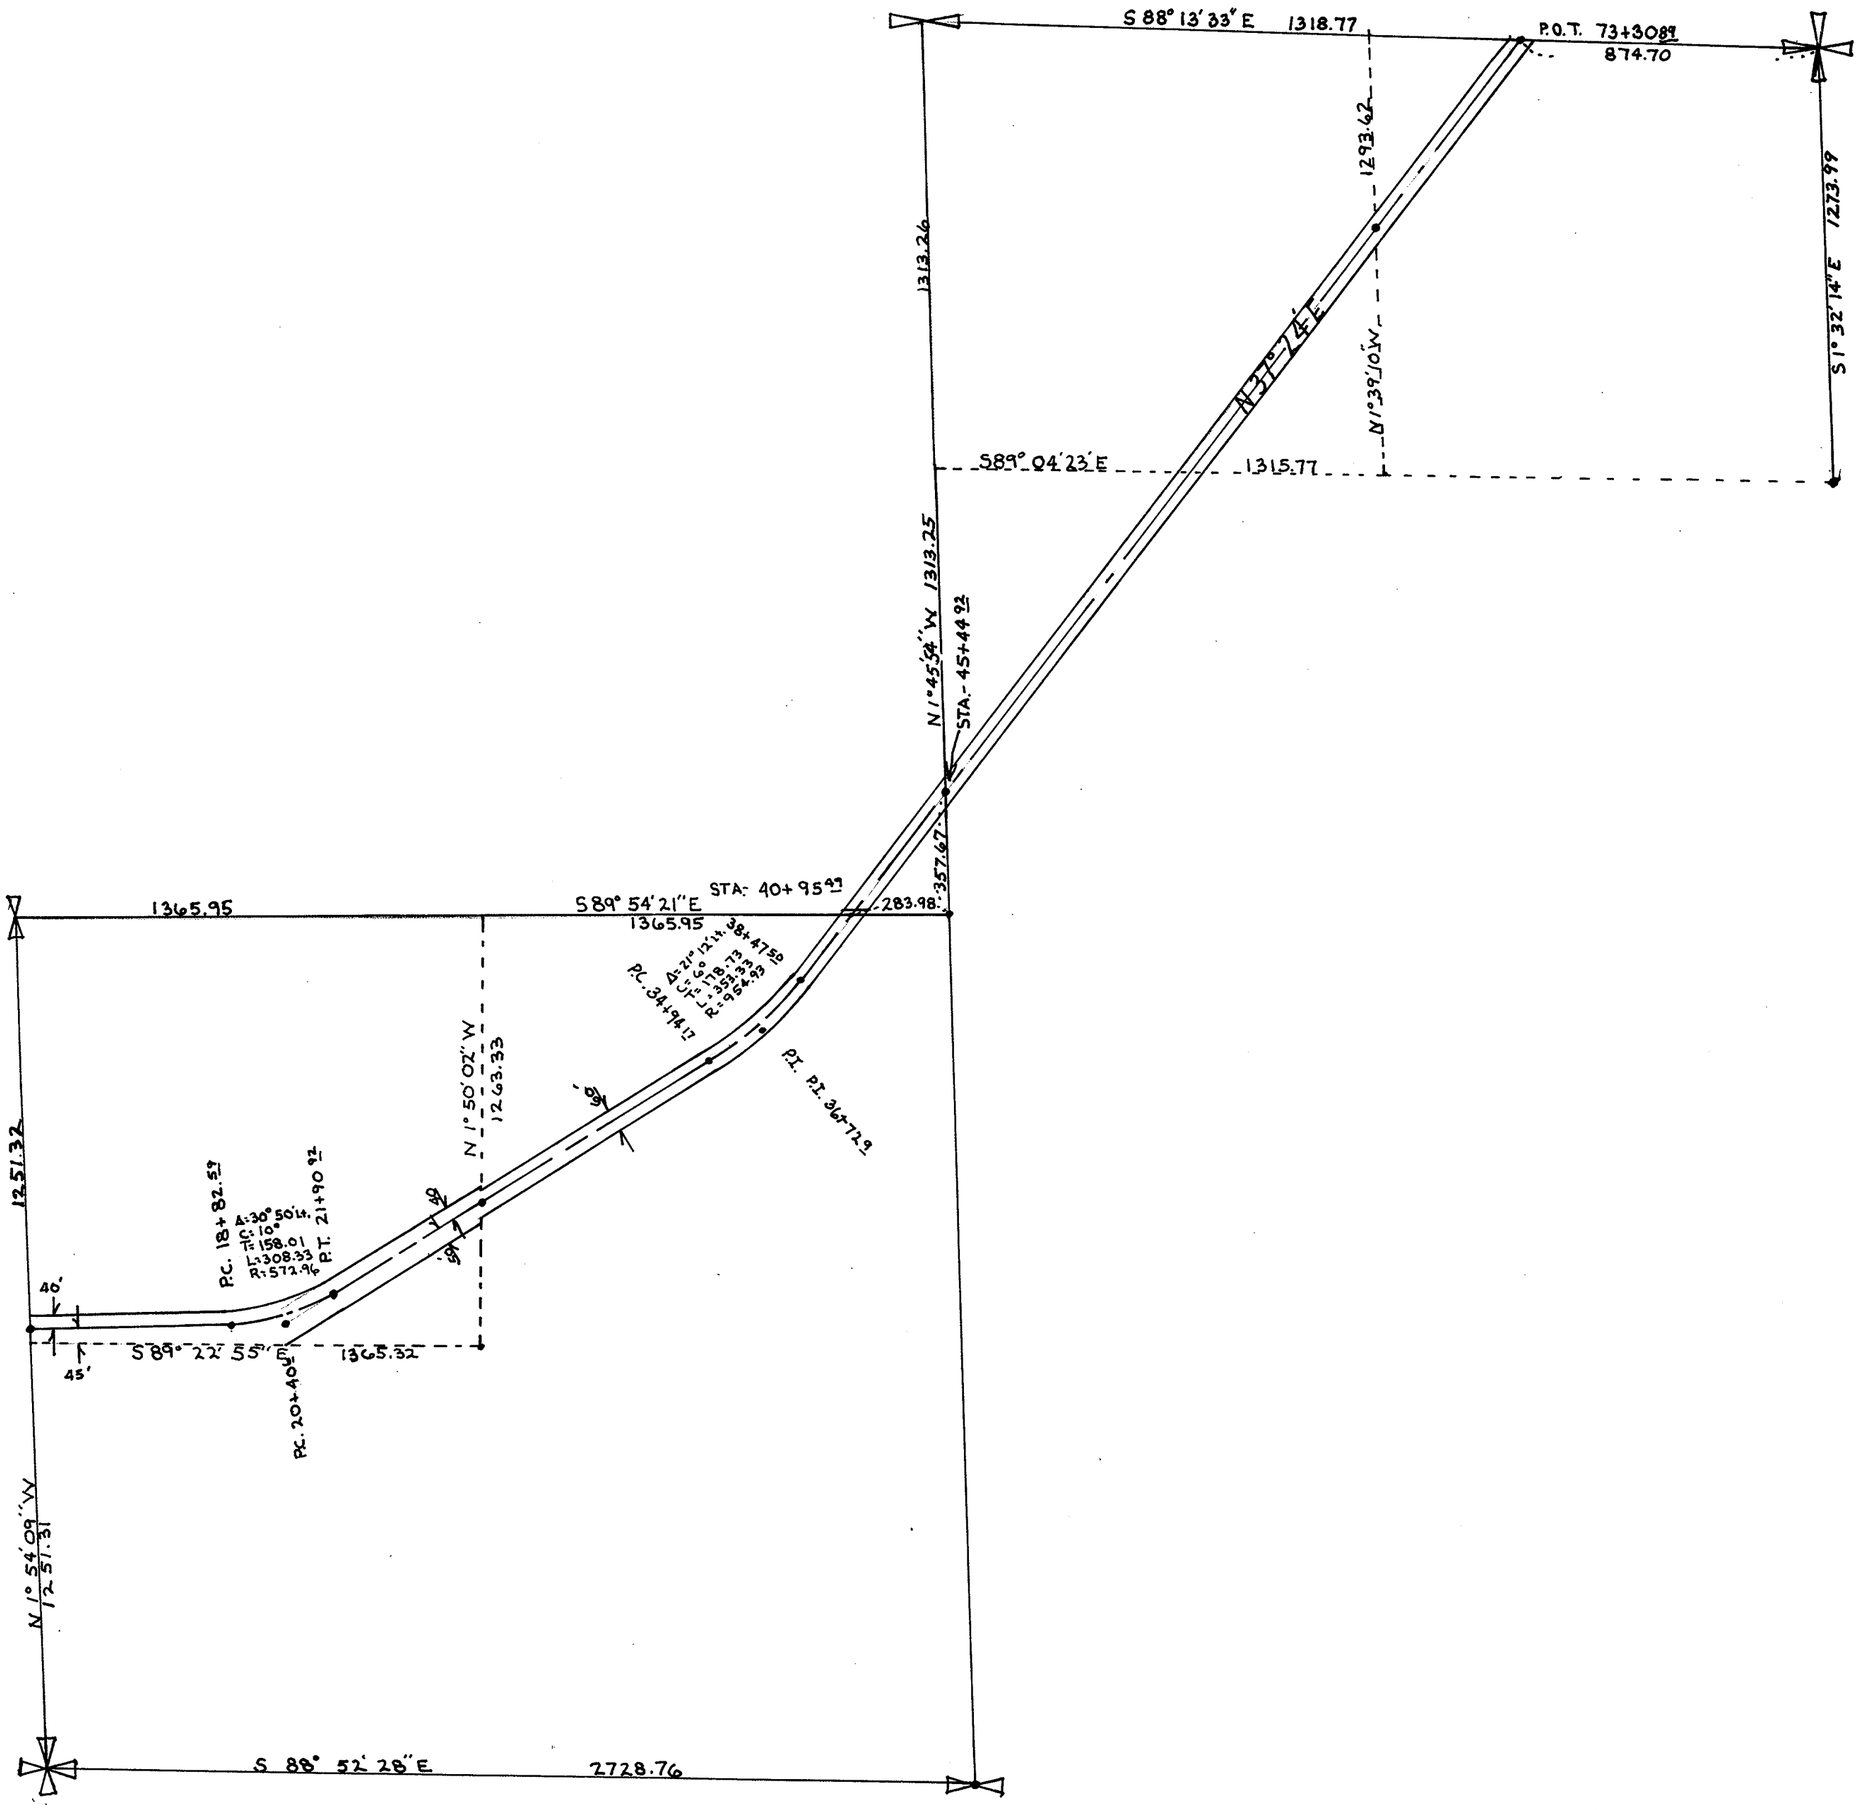


SECTION 8

TOWNSHIP 36 NORTH, RANGE 4 EAST, W. M.
SKAGIT COUNTY, WASH.

SCALE, 1 INCH–400 FEET

Arthur L. Strong COUNTY ENGINEER

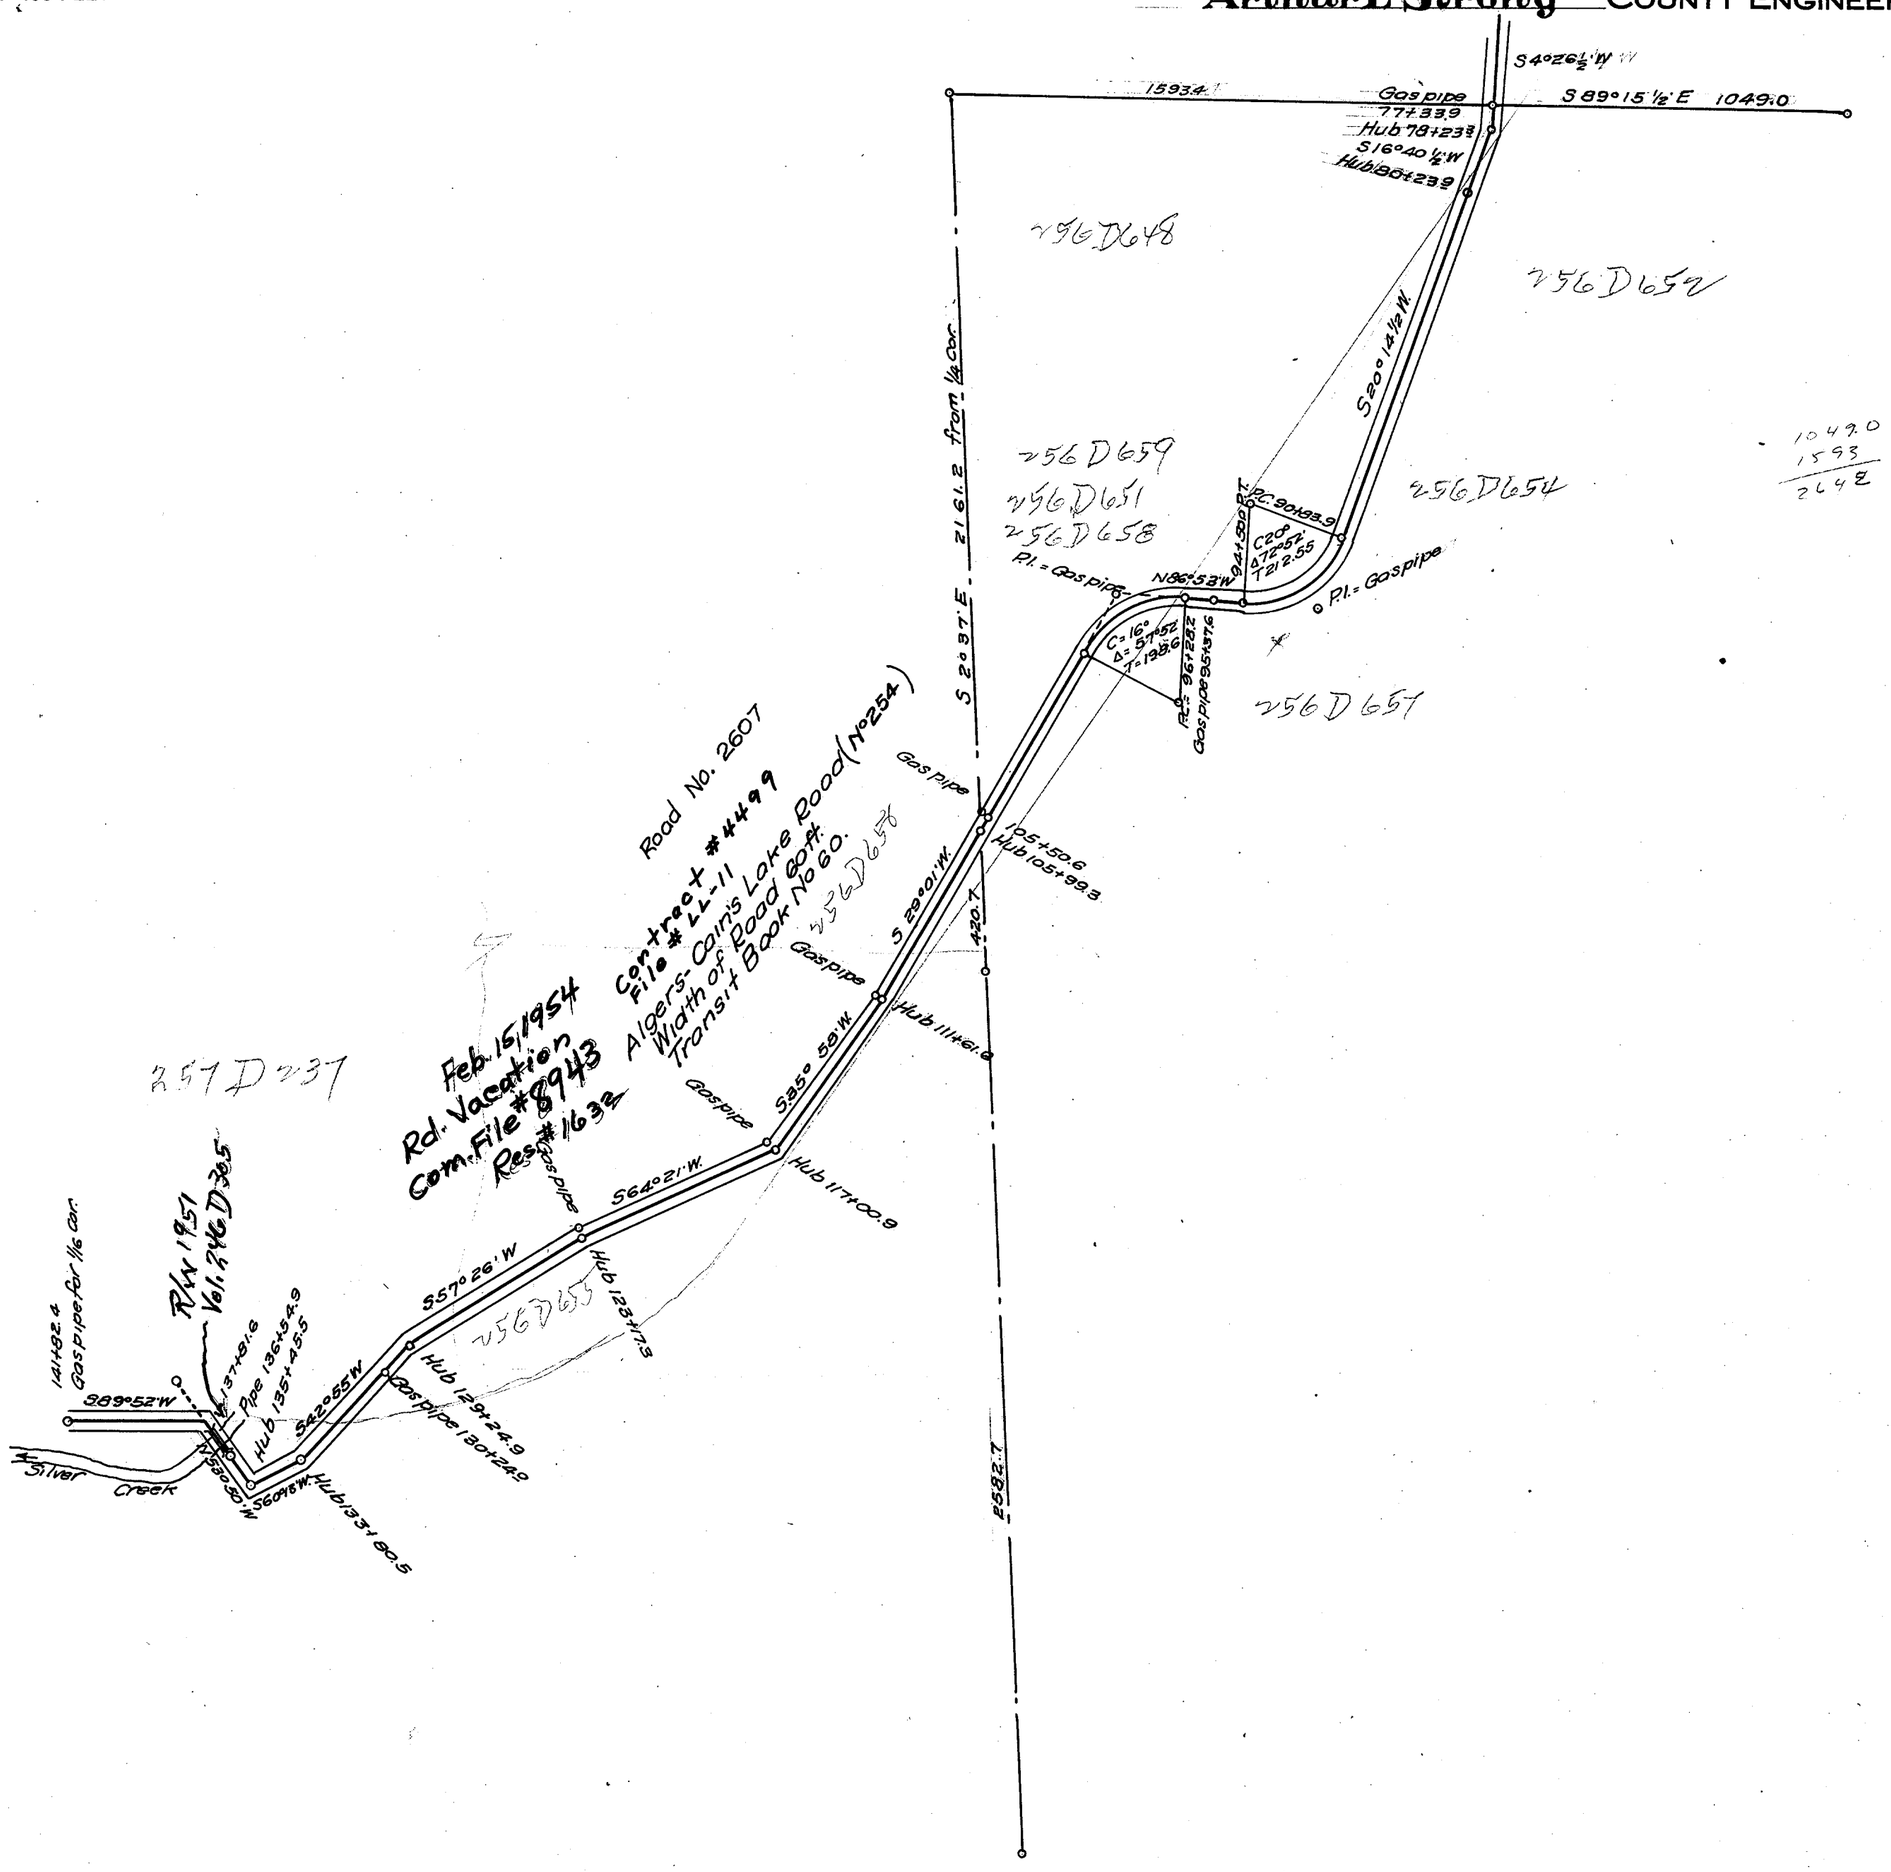

SECTION 13

TOWNSHIP 36 NORTH, RANGE 4 EAST, W. M.

SKAGIT COUNTY, WASH.

SCALE, 1 INCH--400 FEET


DATE August, 1965

Lloyd Johnson COUNTY ENGINEER

Field Notes: 37/332
38/371
41/481
41/485

Road Papers:

Name	Deed File #
Upper Samish	XCIX

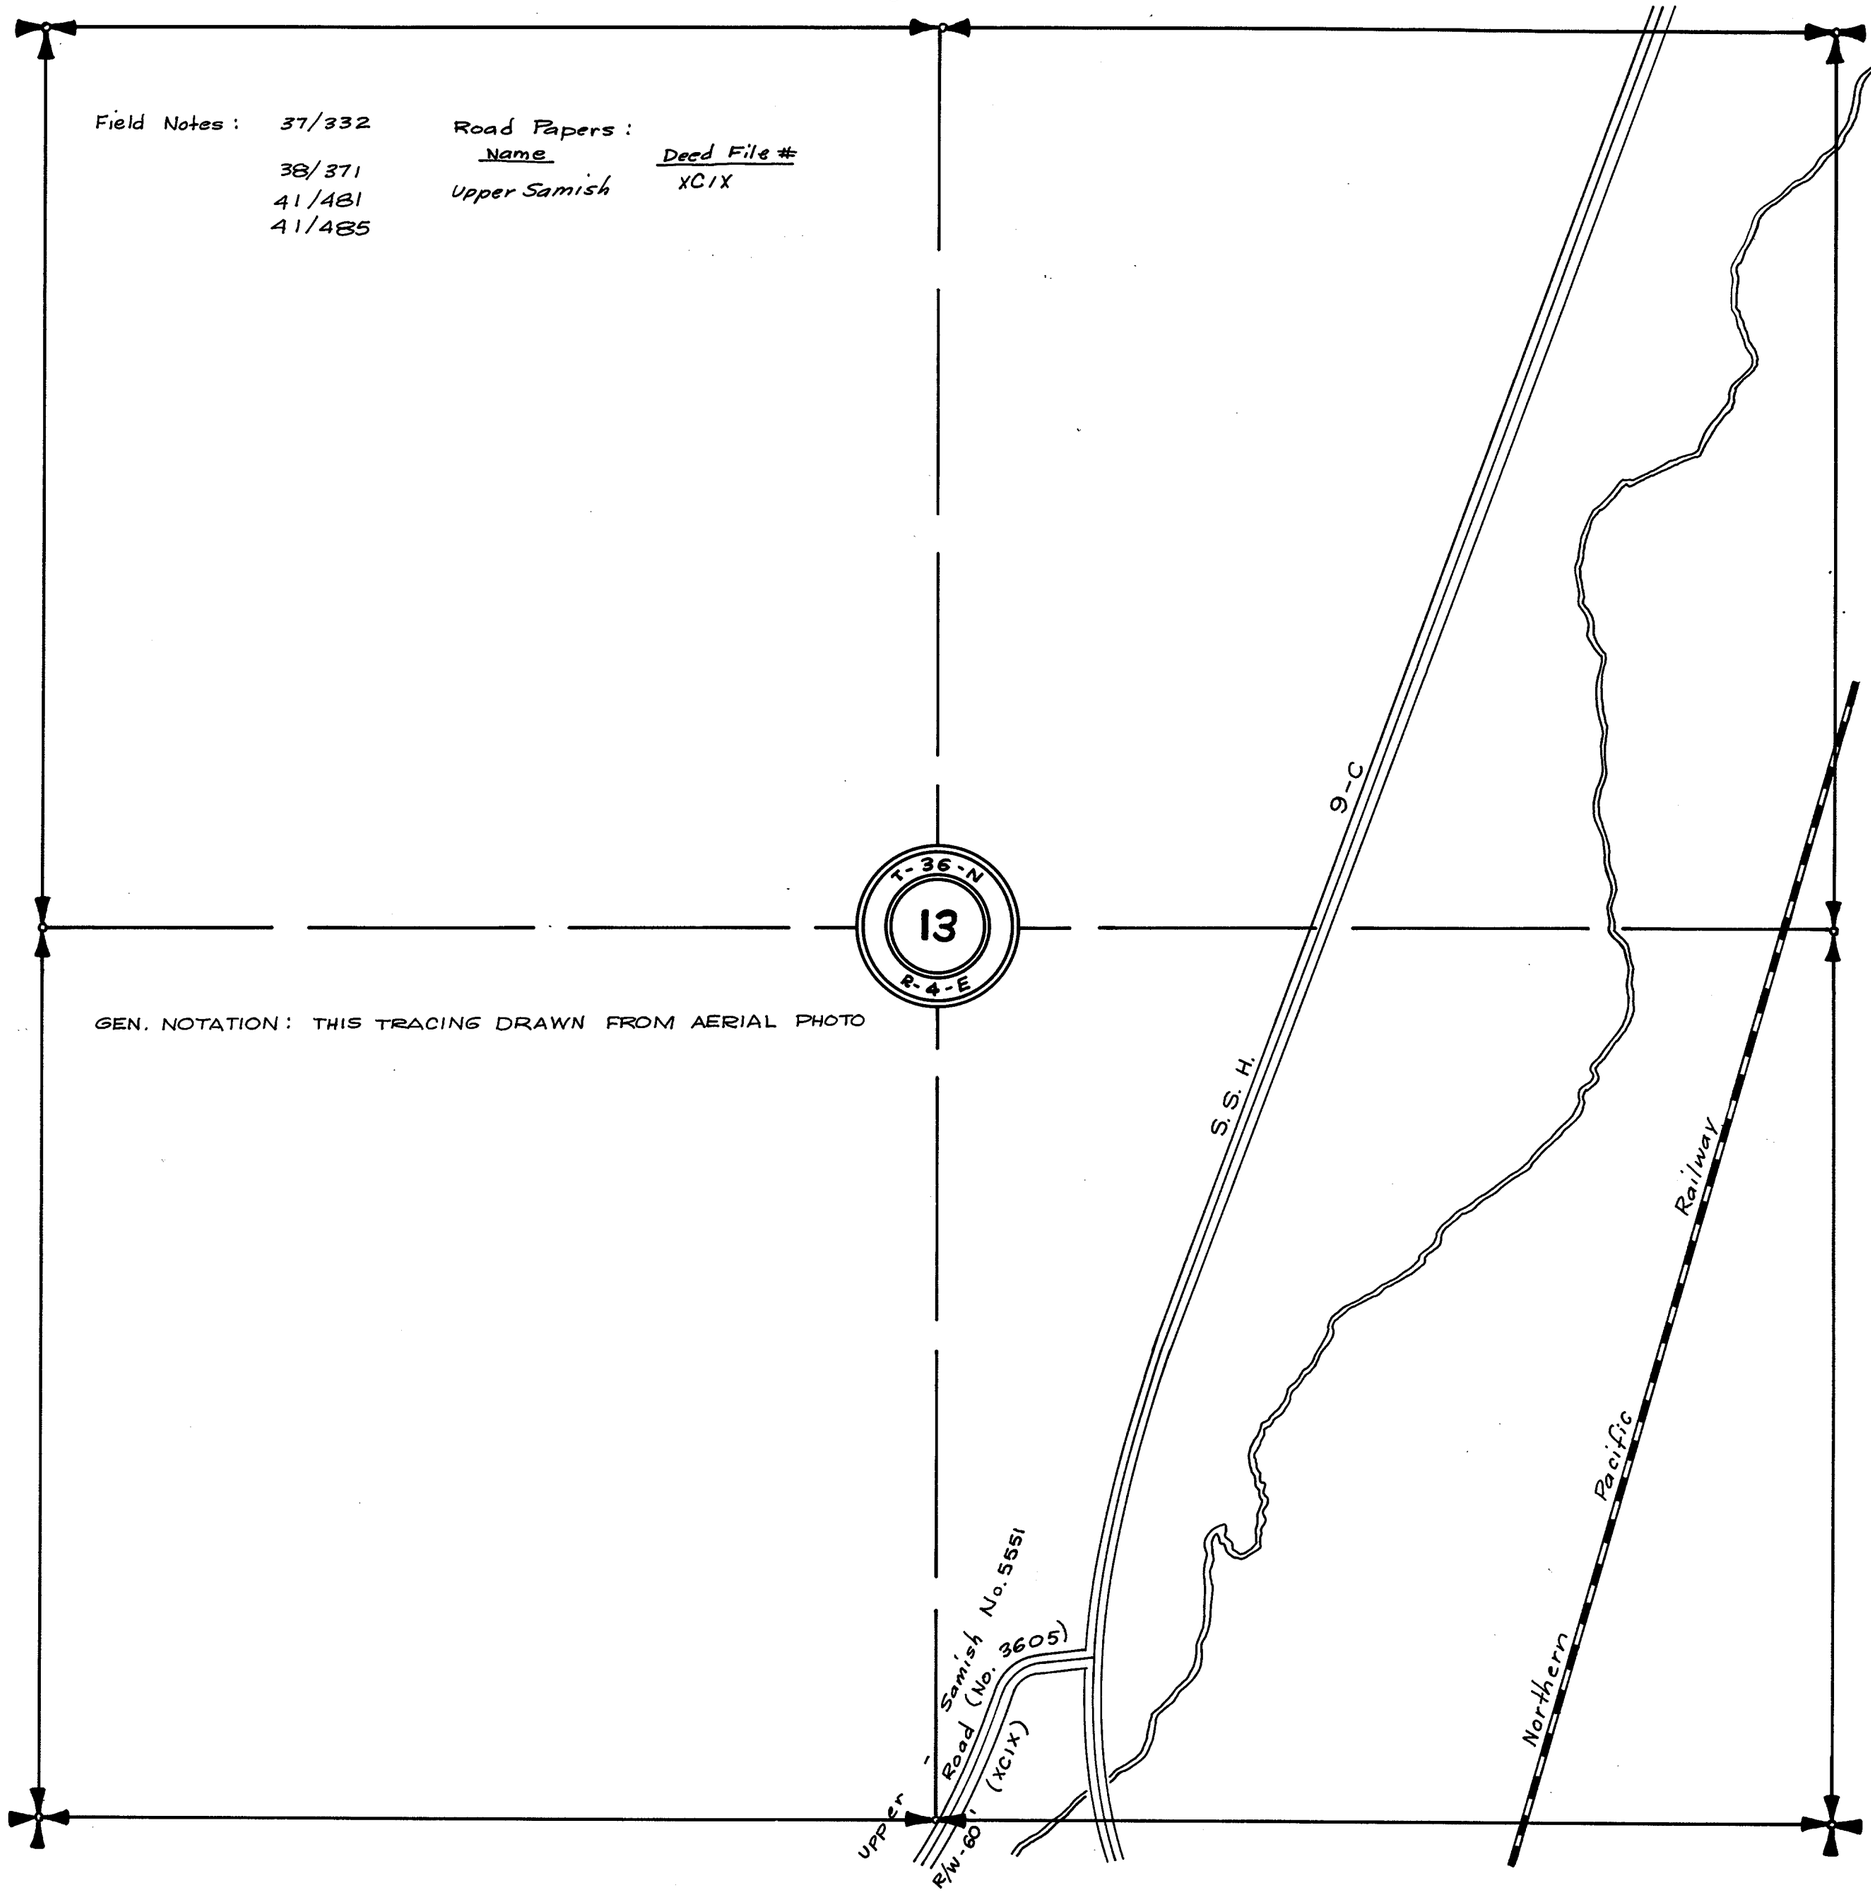

GEN. NOTATION: THIS TRACING DRAWN FROM AERIAL PHOTO

SECTION 17

TOWNSHIP 36 NORTH, RANGE 4 EAST, W. M.

SKAGIT COUNTY, WASH.

SCALE, 1 INCH--400 FEET

DATE August, 1965


Lloyd Johnson COUNTY ENGINEER

Road Papers:

Name	Deed File #
Frankie Bob	511
Friday Creek	64

Field Notes: 647-2 1964

GEN. NOTATION: THIS TRACING DRAWN FROM AERIAL PHOTO

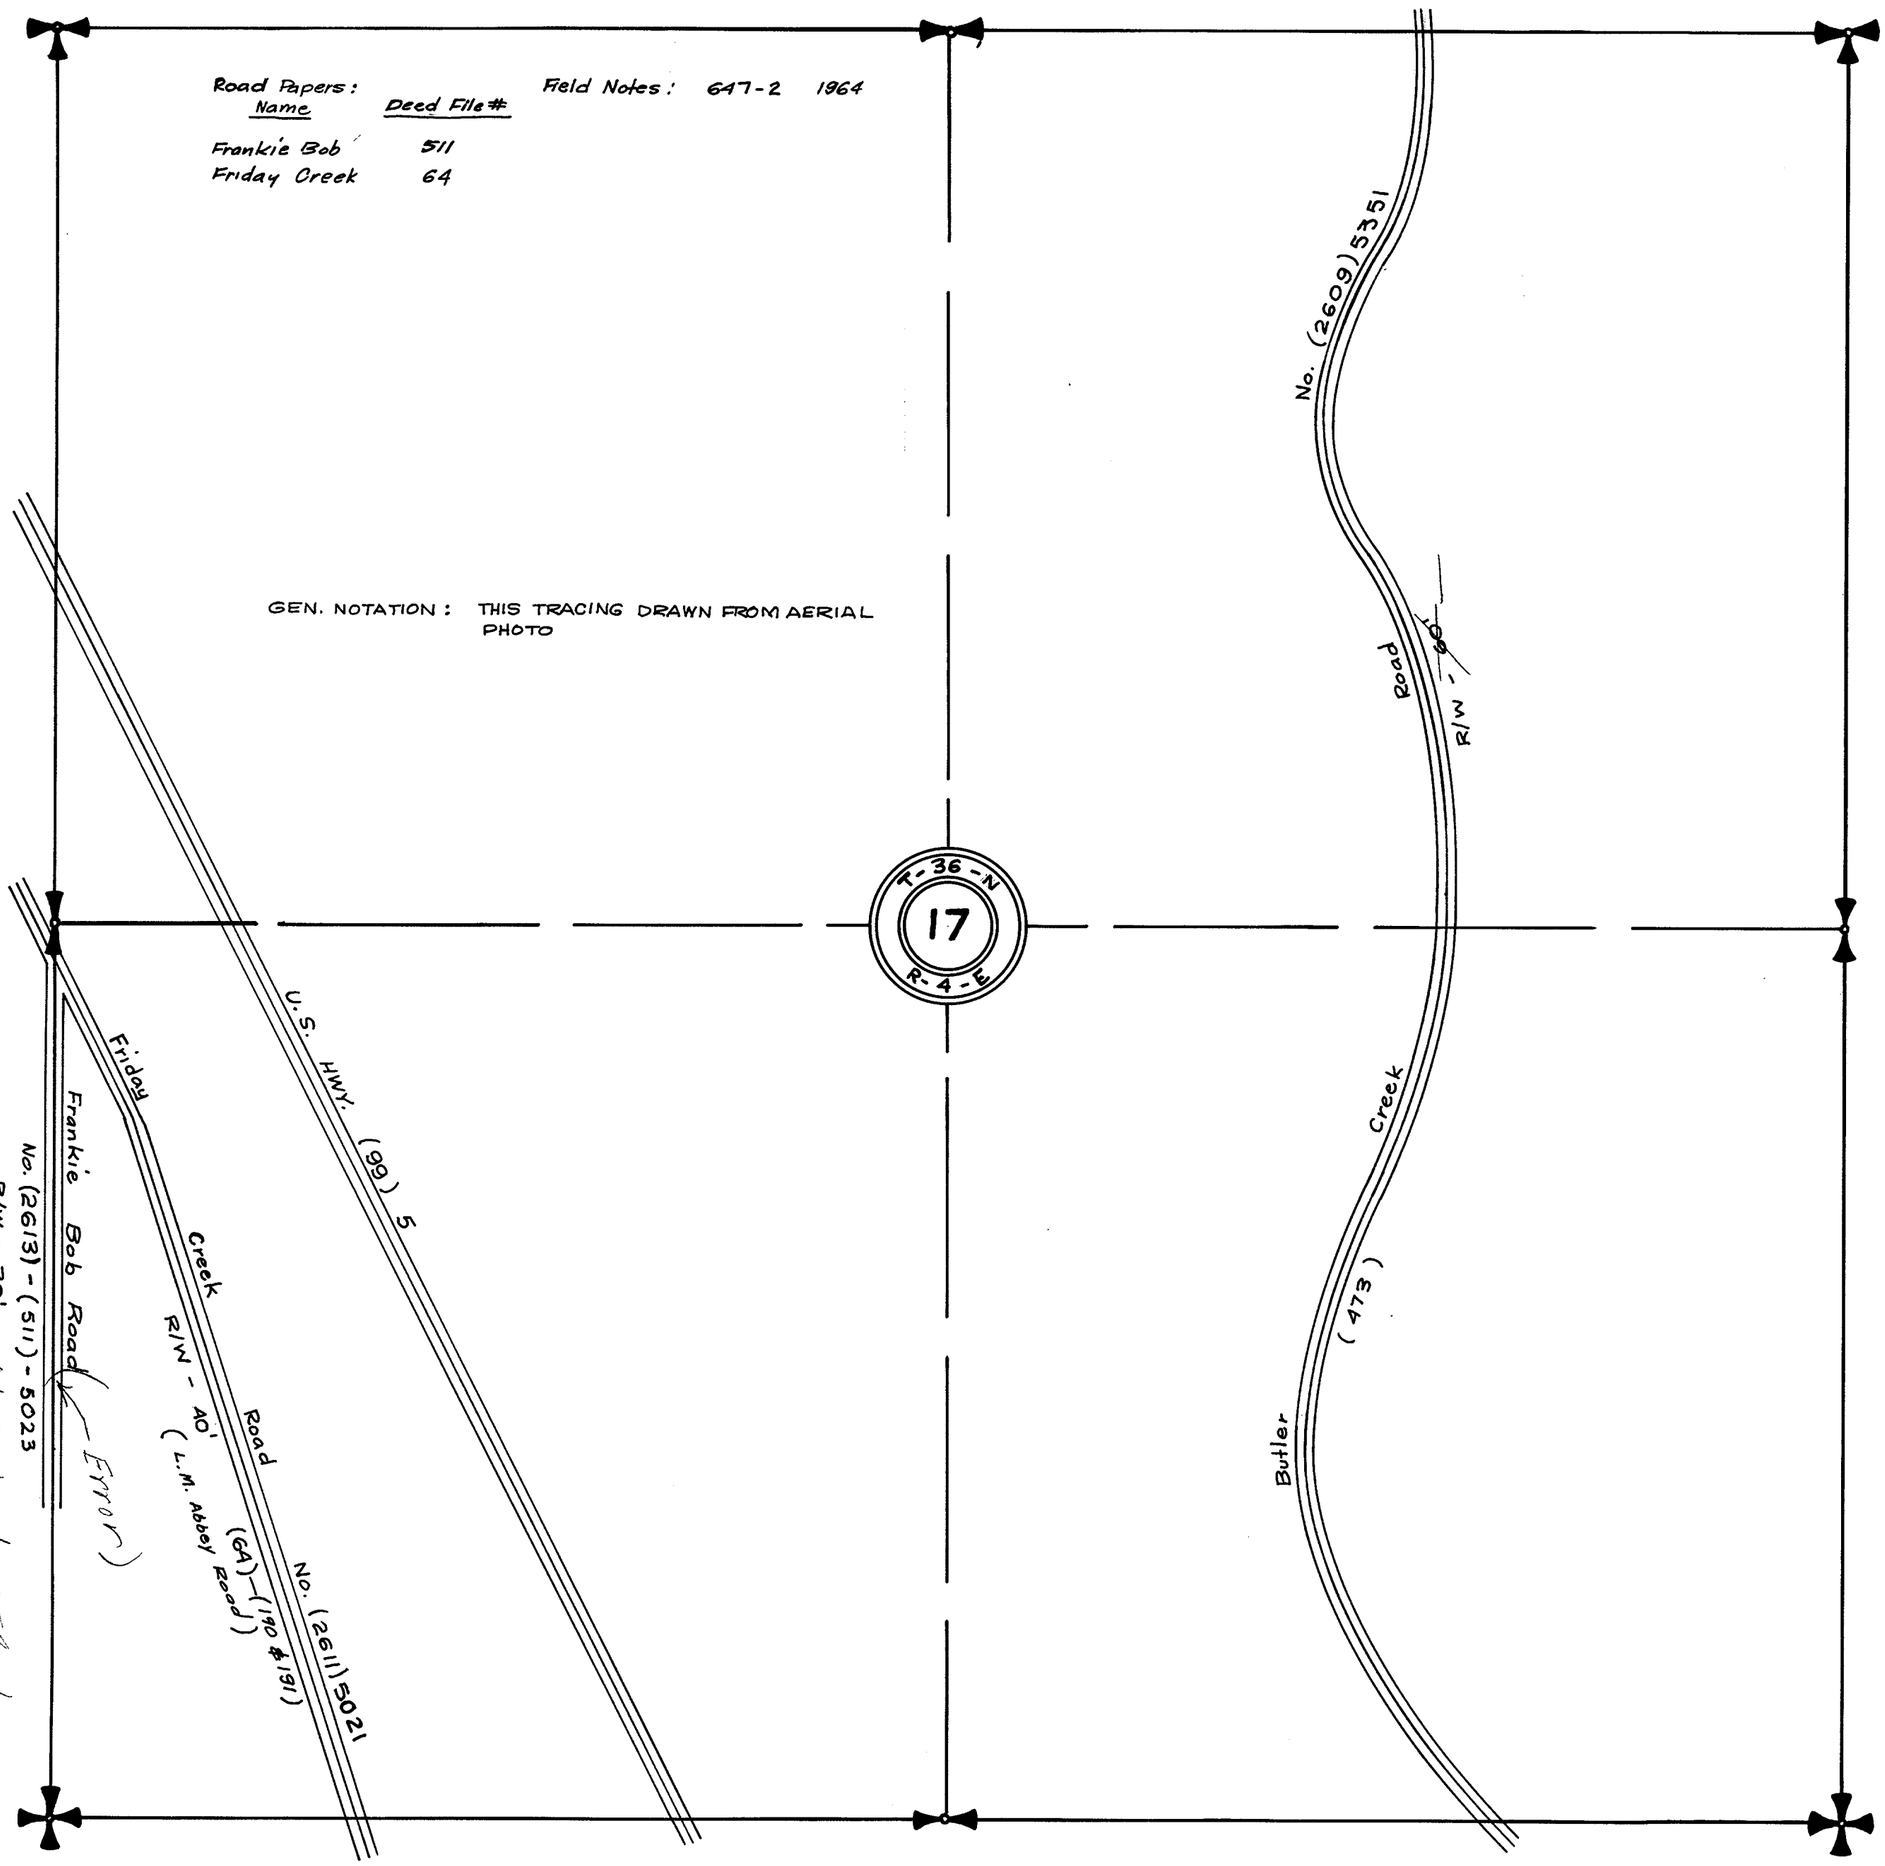

R/W of 30 feet is off East side of Section 18 Error

SECTION 18


TOWNSHIP 36 NORTH, RANGE 4 EAST, W. M.

SKAGIT COUNTY, WASH.

SCALE, 1 INCH--400 FEET

DATE August, 1965

Lloyd Johnson COUNTY ENGINEER

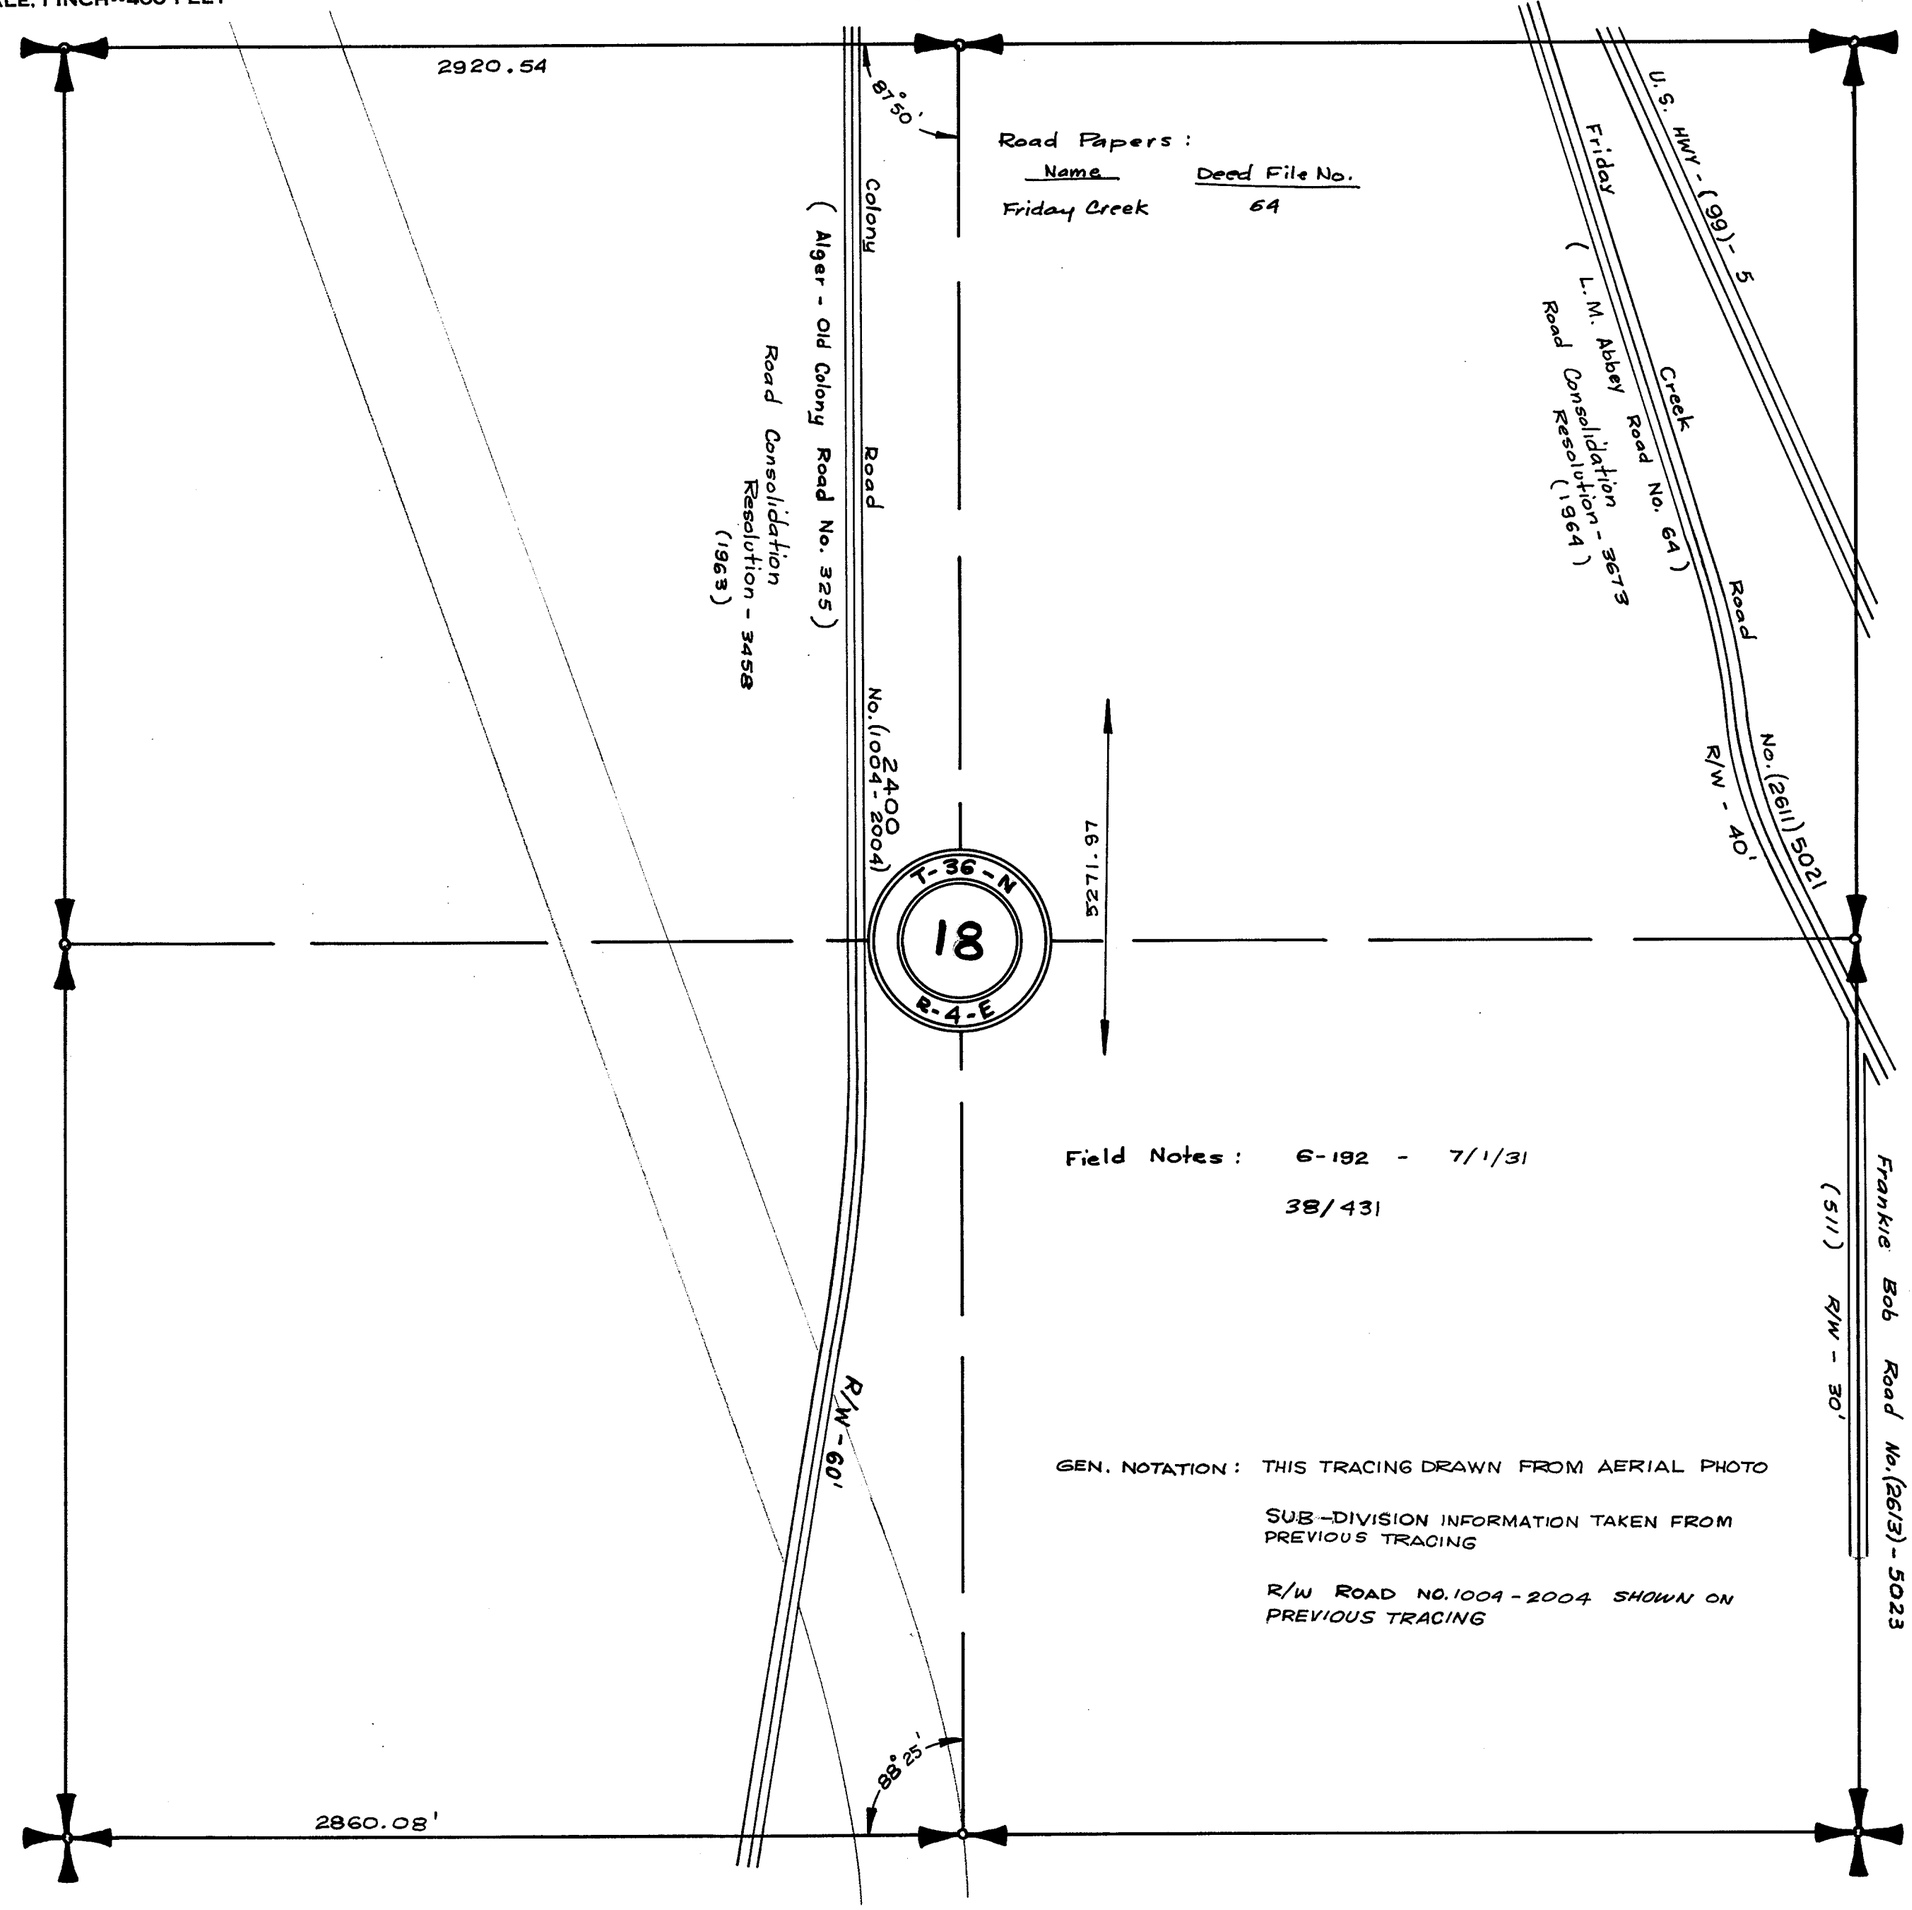

Field Notes : 6-192 - 7/1/31

38/431

GEN. NOTATION : THIS TRACING DRAWN FROM AERIAL PHOTO

SUB-DIVISION INFORMATION TAKEN FROM PREVIOUS TRACING

R/W ROAD NO. 1004 - 2004 SHOWN ON PREVIOUS TRACING


SECTION 18

TOWNSHIP 36 NORTH, RANGE 4 EAST, W. M.
SKAGIT COUNTY, WASH.

SCALE, 1 INCH–400 FEET

Notes; G 192

Robt. E. L. Knapp
Nov. 1931.
COUNTY ENGINEER

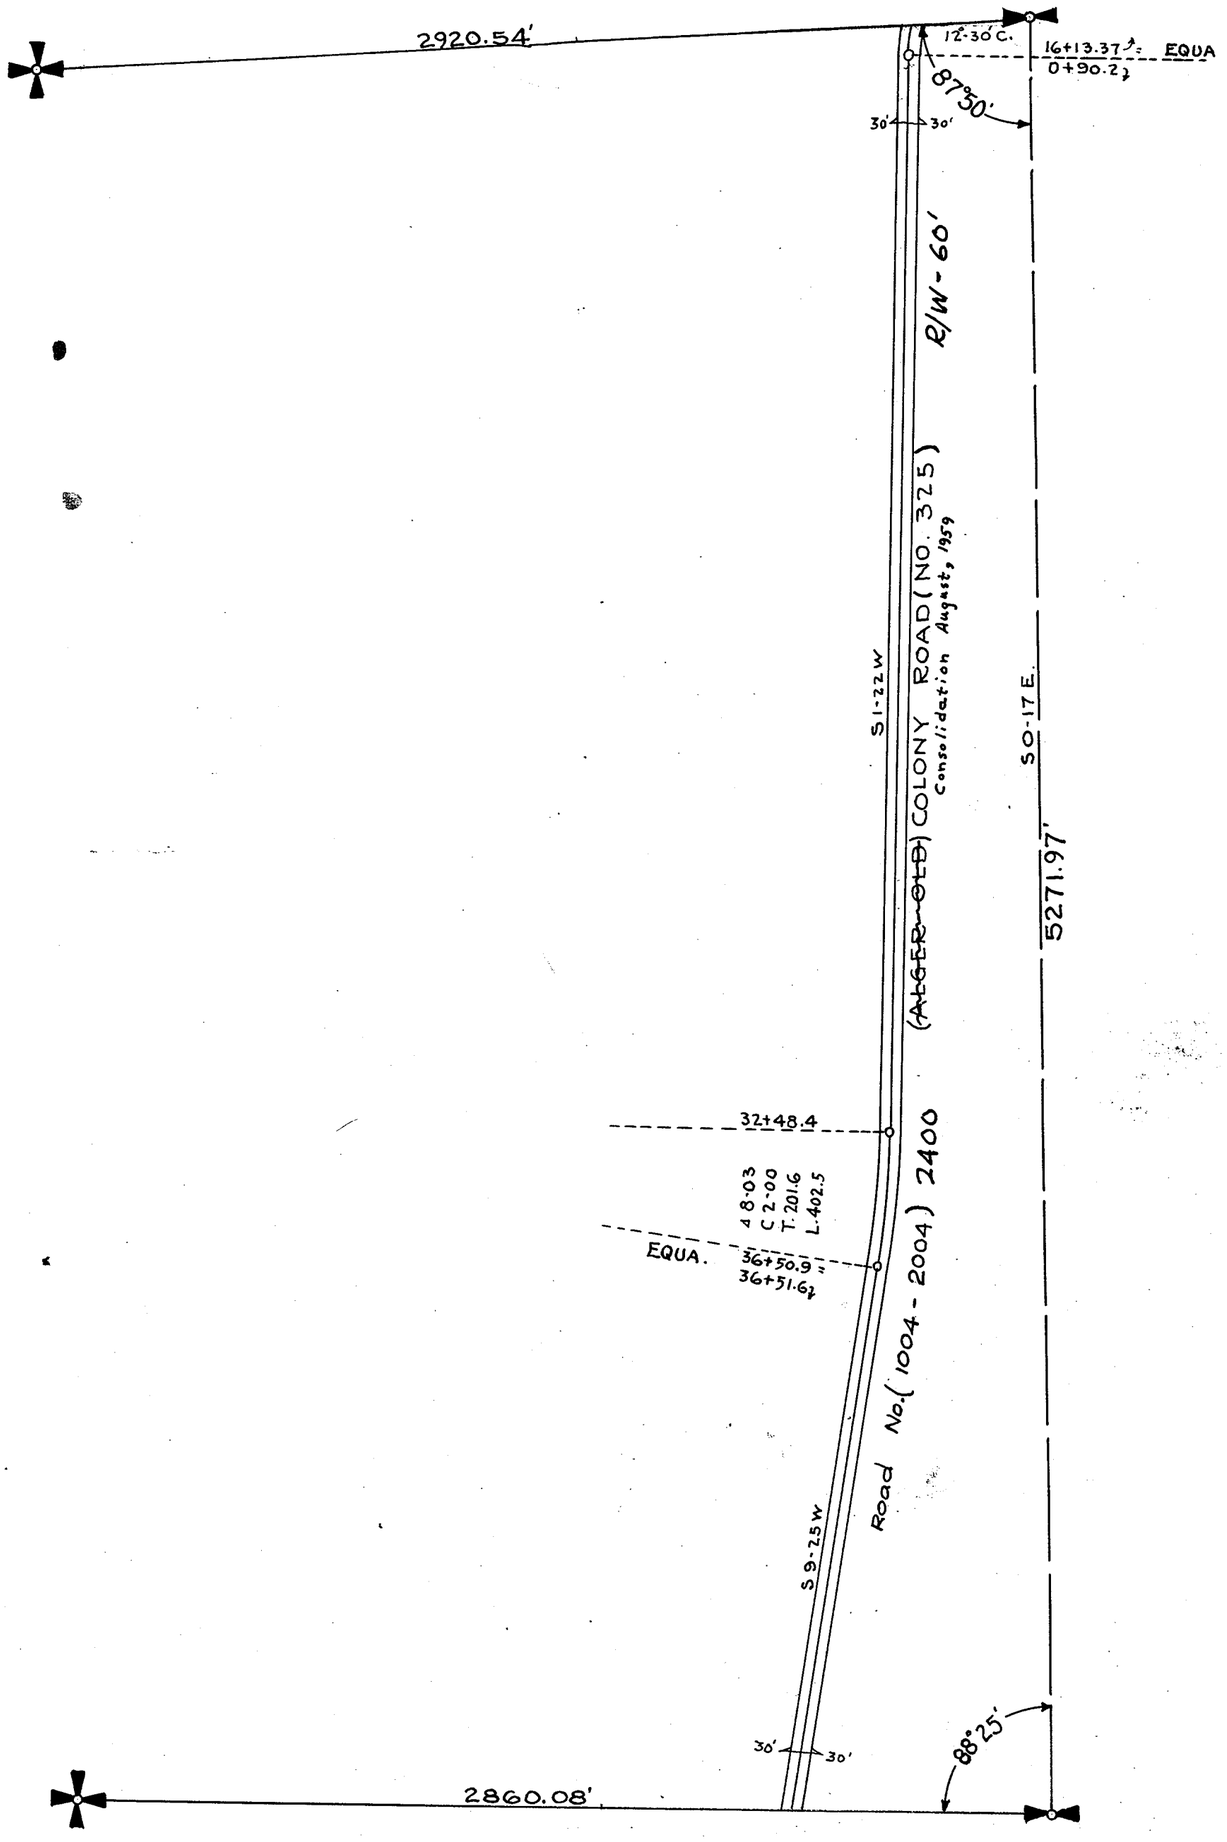



TOWNSHIP 36 NORTH, RANGE 4 EAST, W. M.

SKAGIT COUNTY, WASH.

SCALE, 1 INCH--400 FEET

DATE August, 1865

Lloyd Johnson COUNTY ENGINEER

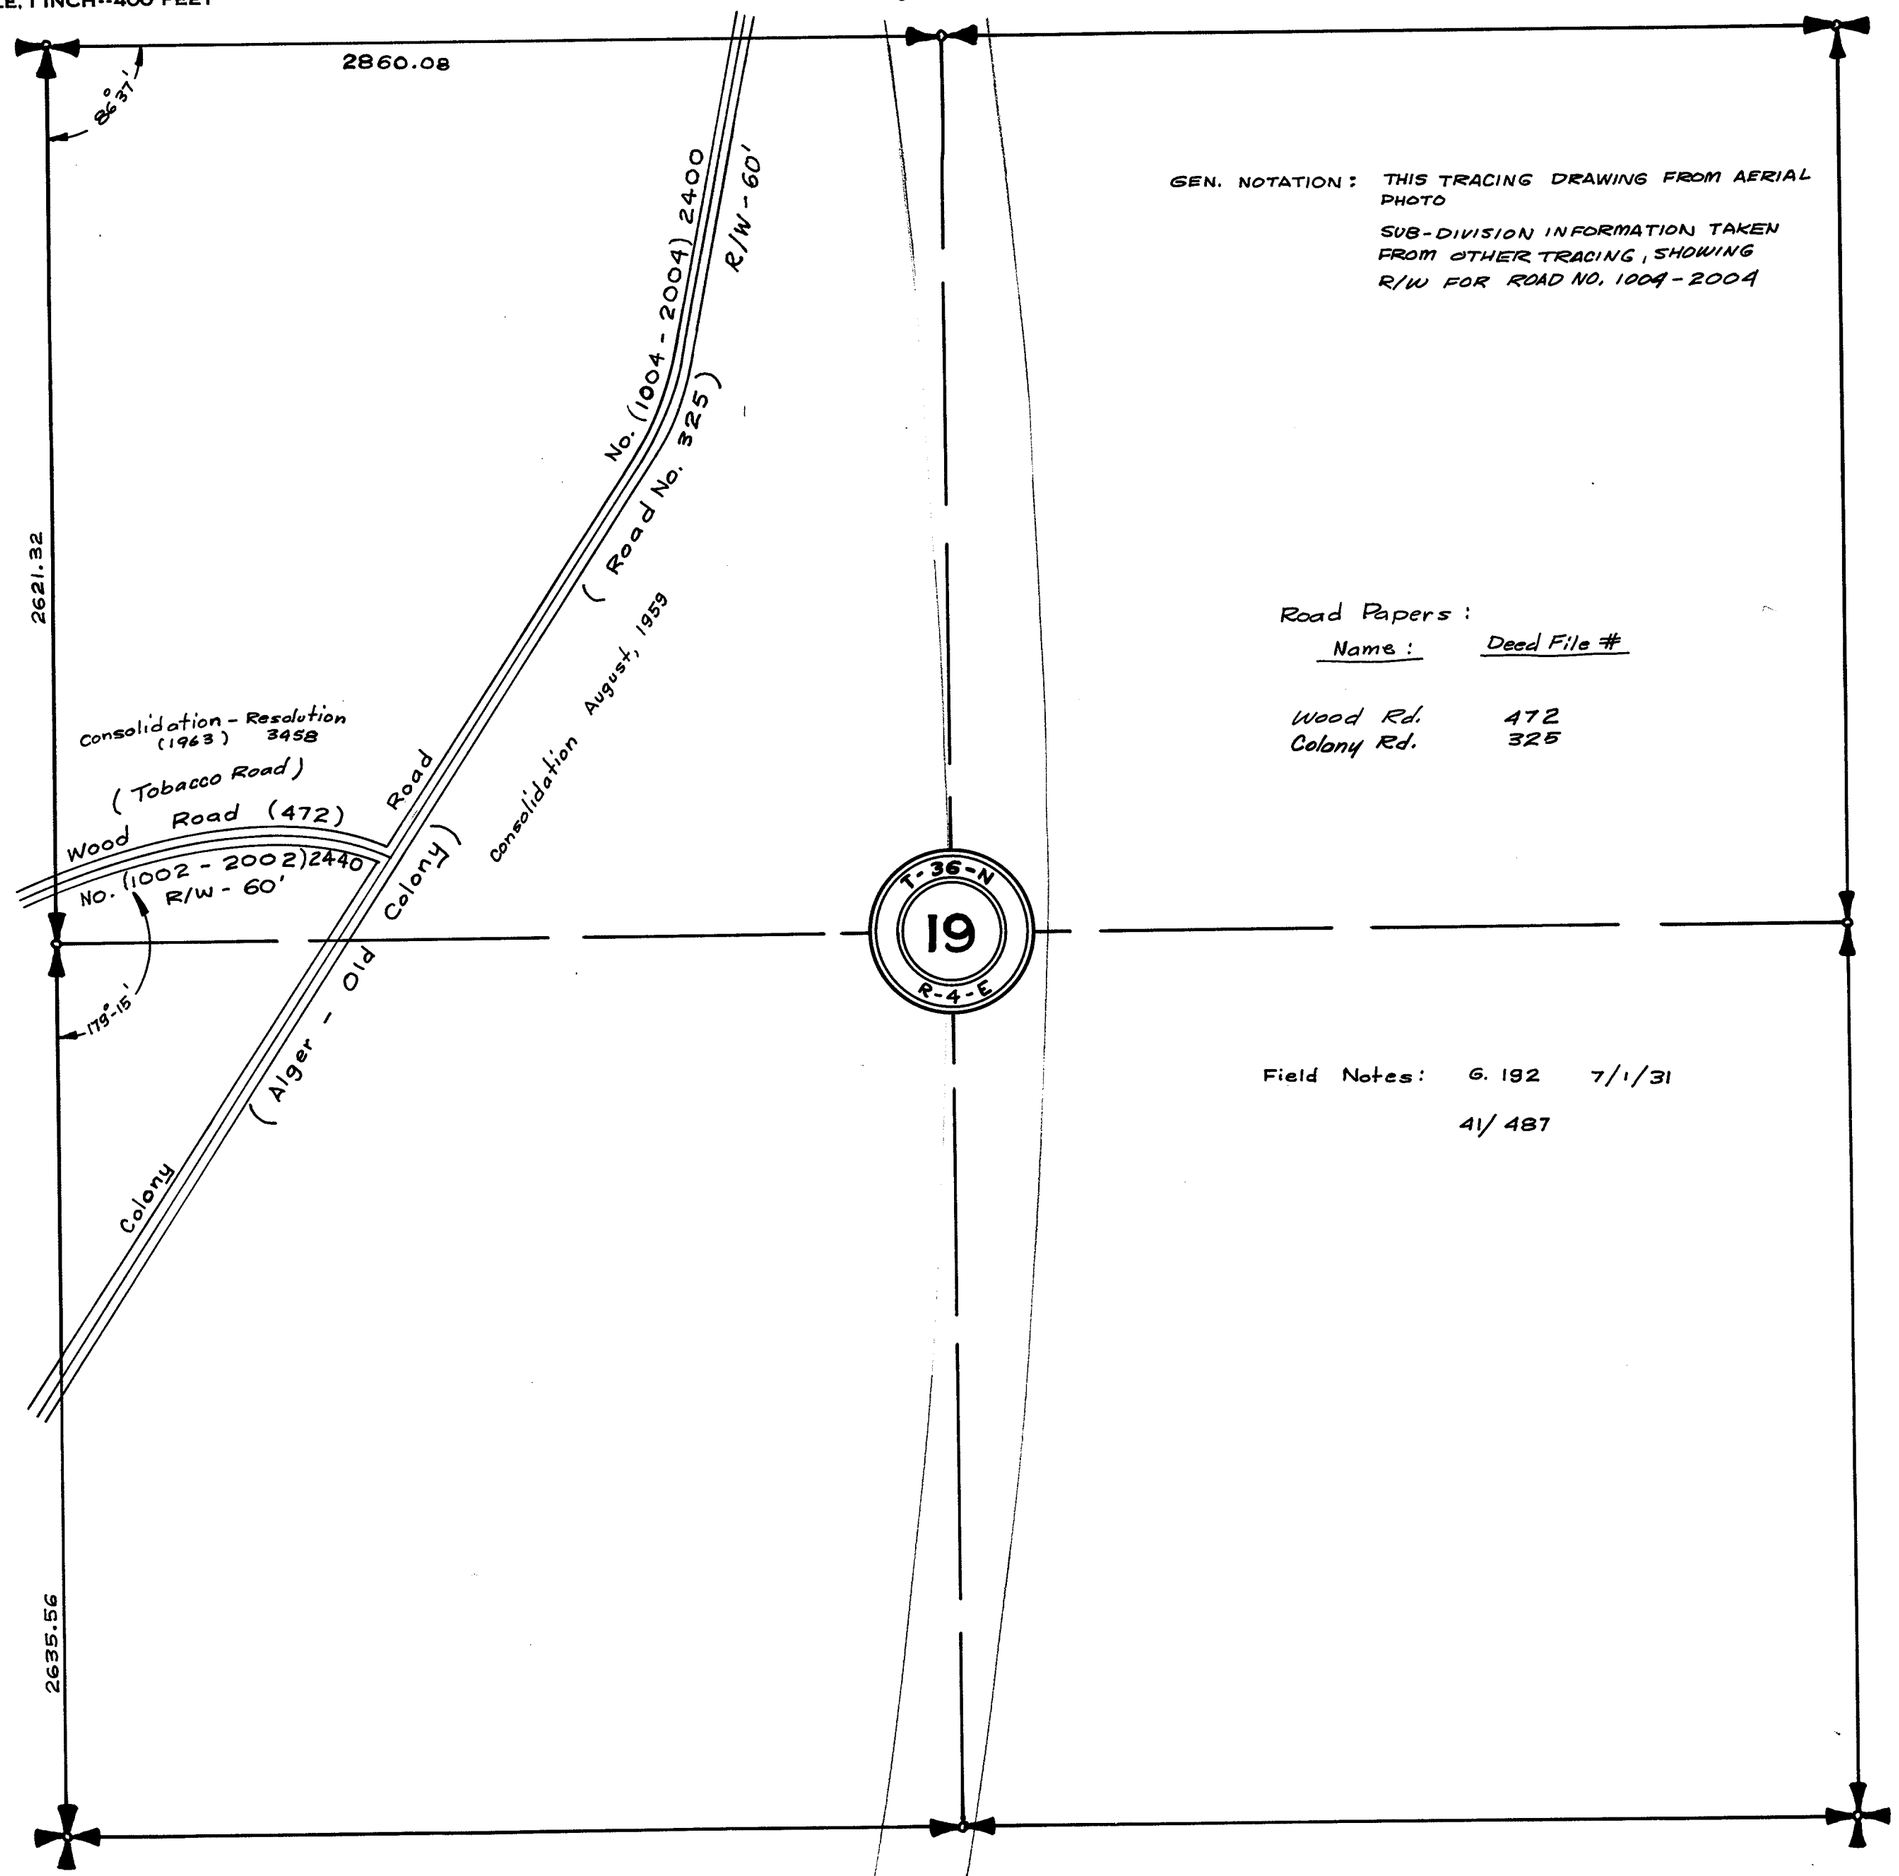

GEN. NOTATION: THIS TRACING DRAWING FROM AERIAL PHOTO

SUB-DIVISION INFORMATION TAKEN FROM OTHER TRACING, SHOWING R/W FOR ROAD NO. 1004 - 2004

Road Papers:

Name:	Deed File #
Wood Rd.	472
Colony Rd.	325

Field Notes: G. 192 7/1/31

41/ 487

SECTION 19


TOWNSHIP 36 NORTH, RANGE 4 EAST, W. M.

SKAGIT COUNTY, WASH.

SCALE, 1 INCH--400 FEET
D. Hoyt

DATE Dec. 3, 1965

LLOYD JOHNSON COUNTY ENGINEER

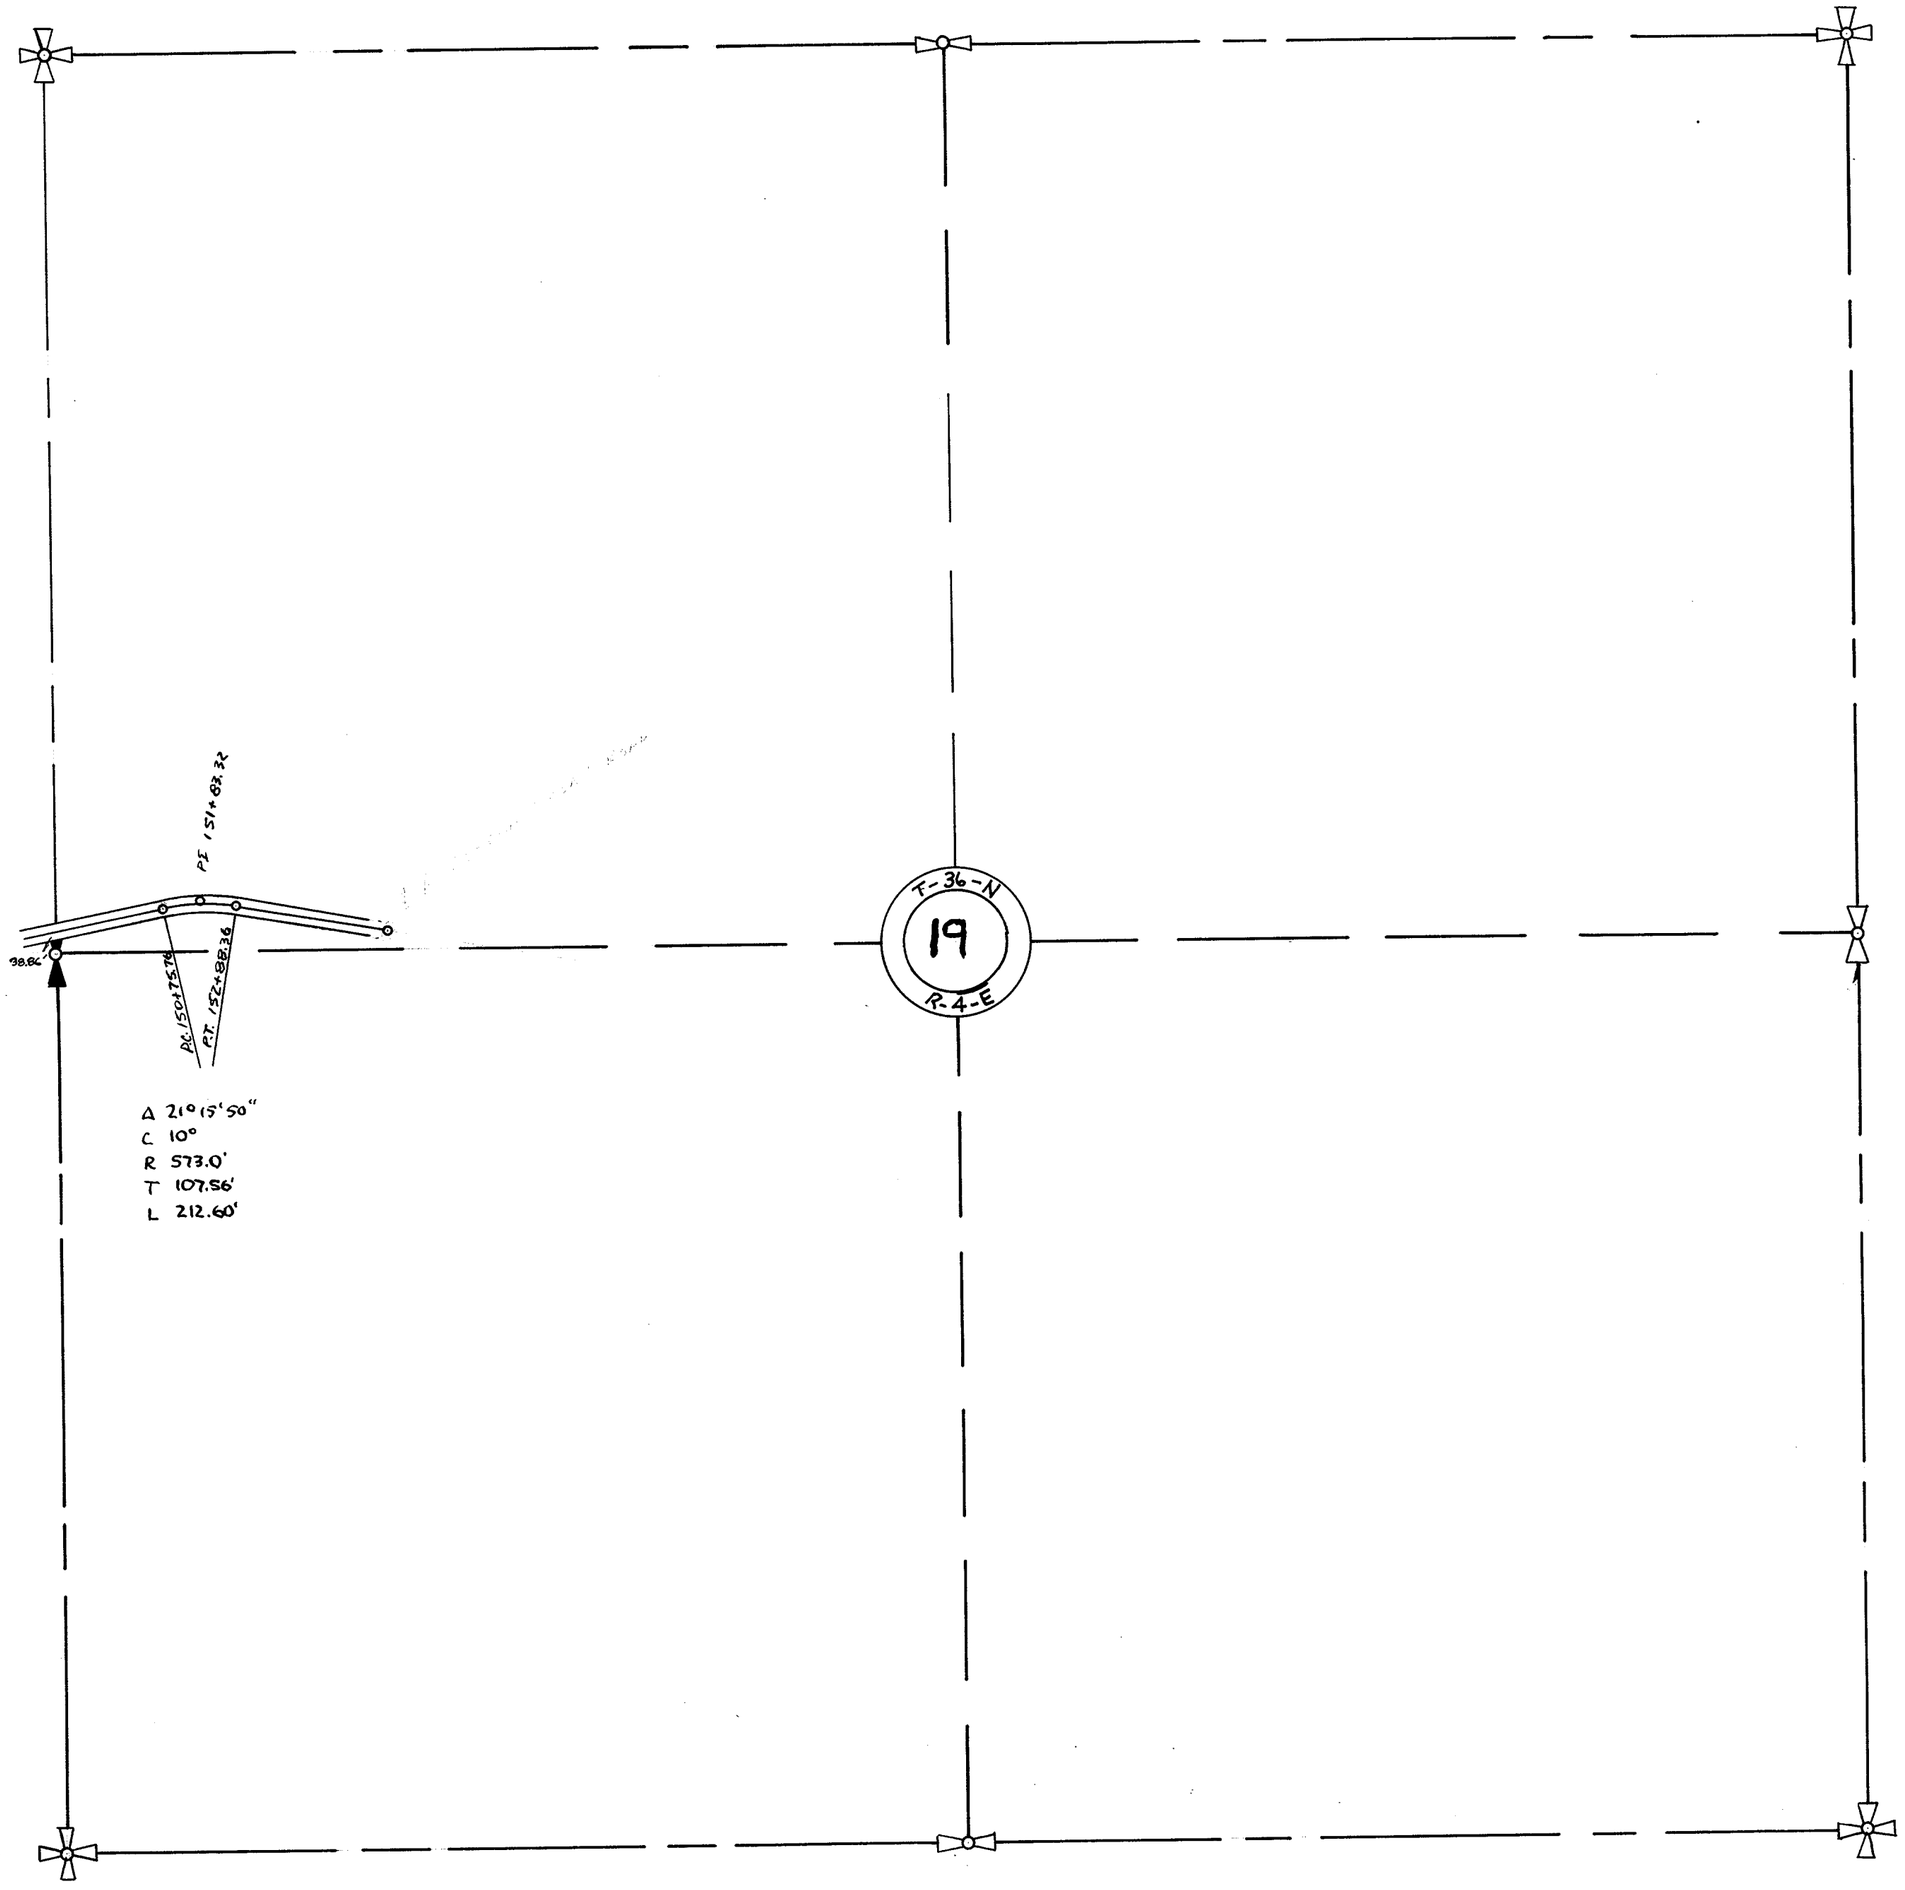

SECTION 19


TOWNSHIP 36 NORTH. RANGE 4 EAST. W. M.
SKAGIT COUNTY. WASH.

SCALE. 1 INCH–400 FEET

Notes: ALGER OLD COL. G. 192
Bloedel Don. Log. Road.

Robt. E. L. Knapp COUNTY ENGINEER
Nov. 1931.

See B18
13

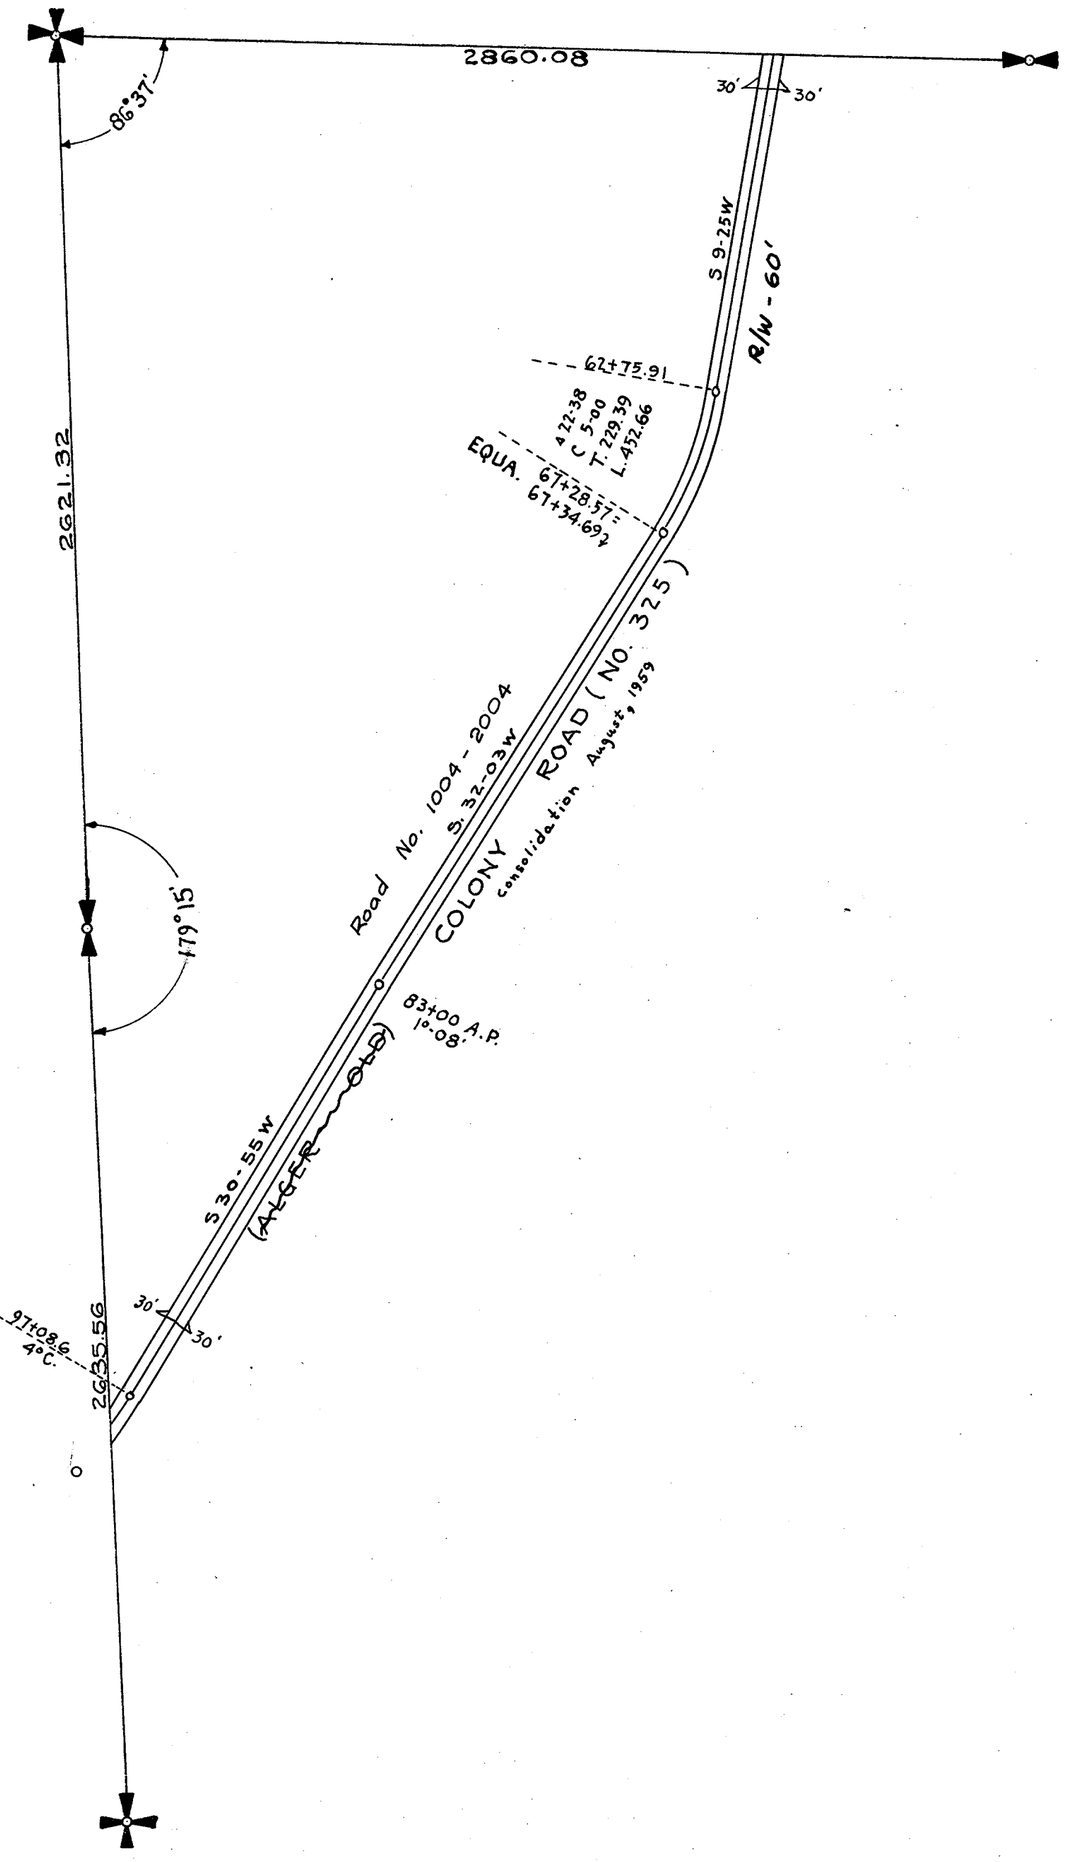

SECTION 20


TOWNSHIP 36 NORTH, RANGE 4 EAST, W. M.

SKAGIT COUNTY, WASH.

SCALE, 1 INCH--400 FEET

DATE August, 1965

Lloyd Johnson COUNTY ENGINEER

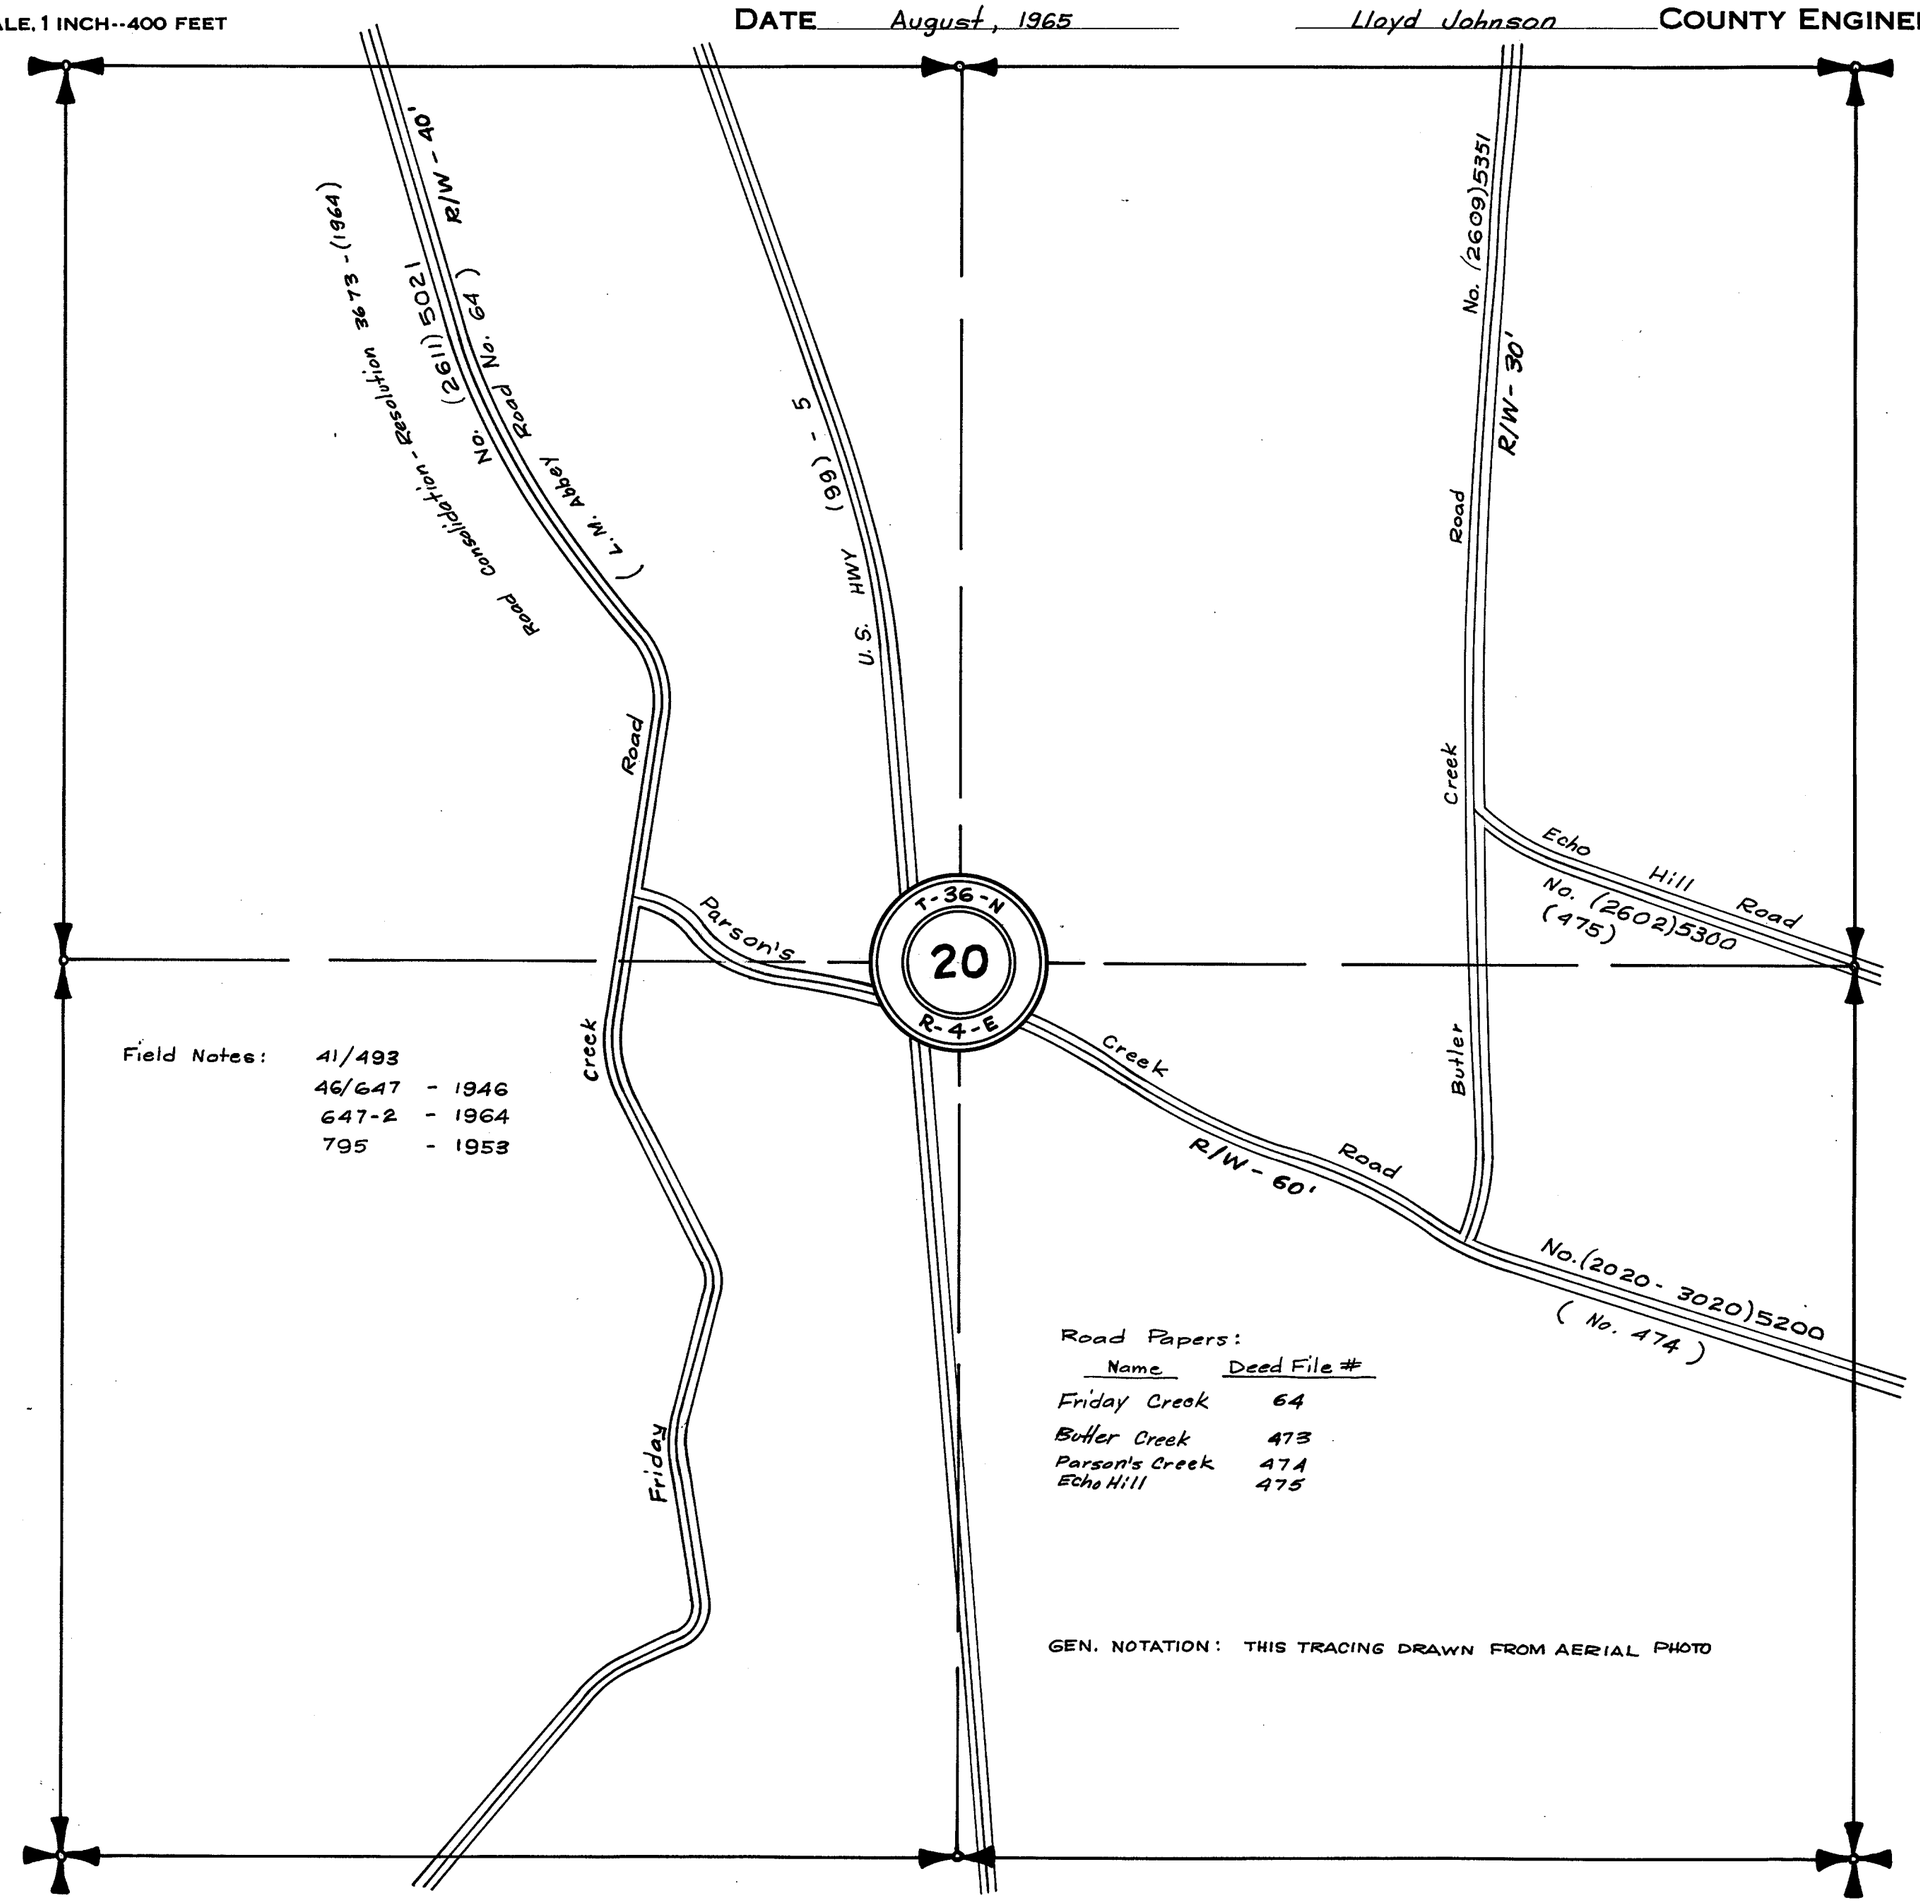

Field Notes:

41/493		
46/647	-	1946
647-2	-	1964
795	-	1953

Road Papers:

Name	Deed File #
Friday Creek	64
Butler Creek	473
Parson's Creek	474
Echo Hill	475

GEN. NOTATION: THIS TRACING DRAWN FROM AERIAL PHOTO

SECTION 21

TOWNSHIP 36 NORTH, RANGE 4 EAST, W. M.

SKAGIT COUNTY, WASH.

SCALE, 1 INCH--400 FEET

DATE August, 1965


Lloyd Johnson COUNTY ENGINEER

GEN. NOTATION: THIS TRACING DRAWN FROM AERIAL PHOTO

SUB-DIVISION INFORMATION FOUND ON A PREVIOUS TRACING

Road Papers:

Name	Deed File #
Echo Hill	475
Scaarup	569
Parson's Creek	474
Humphrey Hill	476

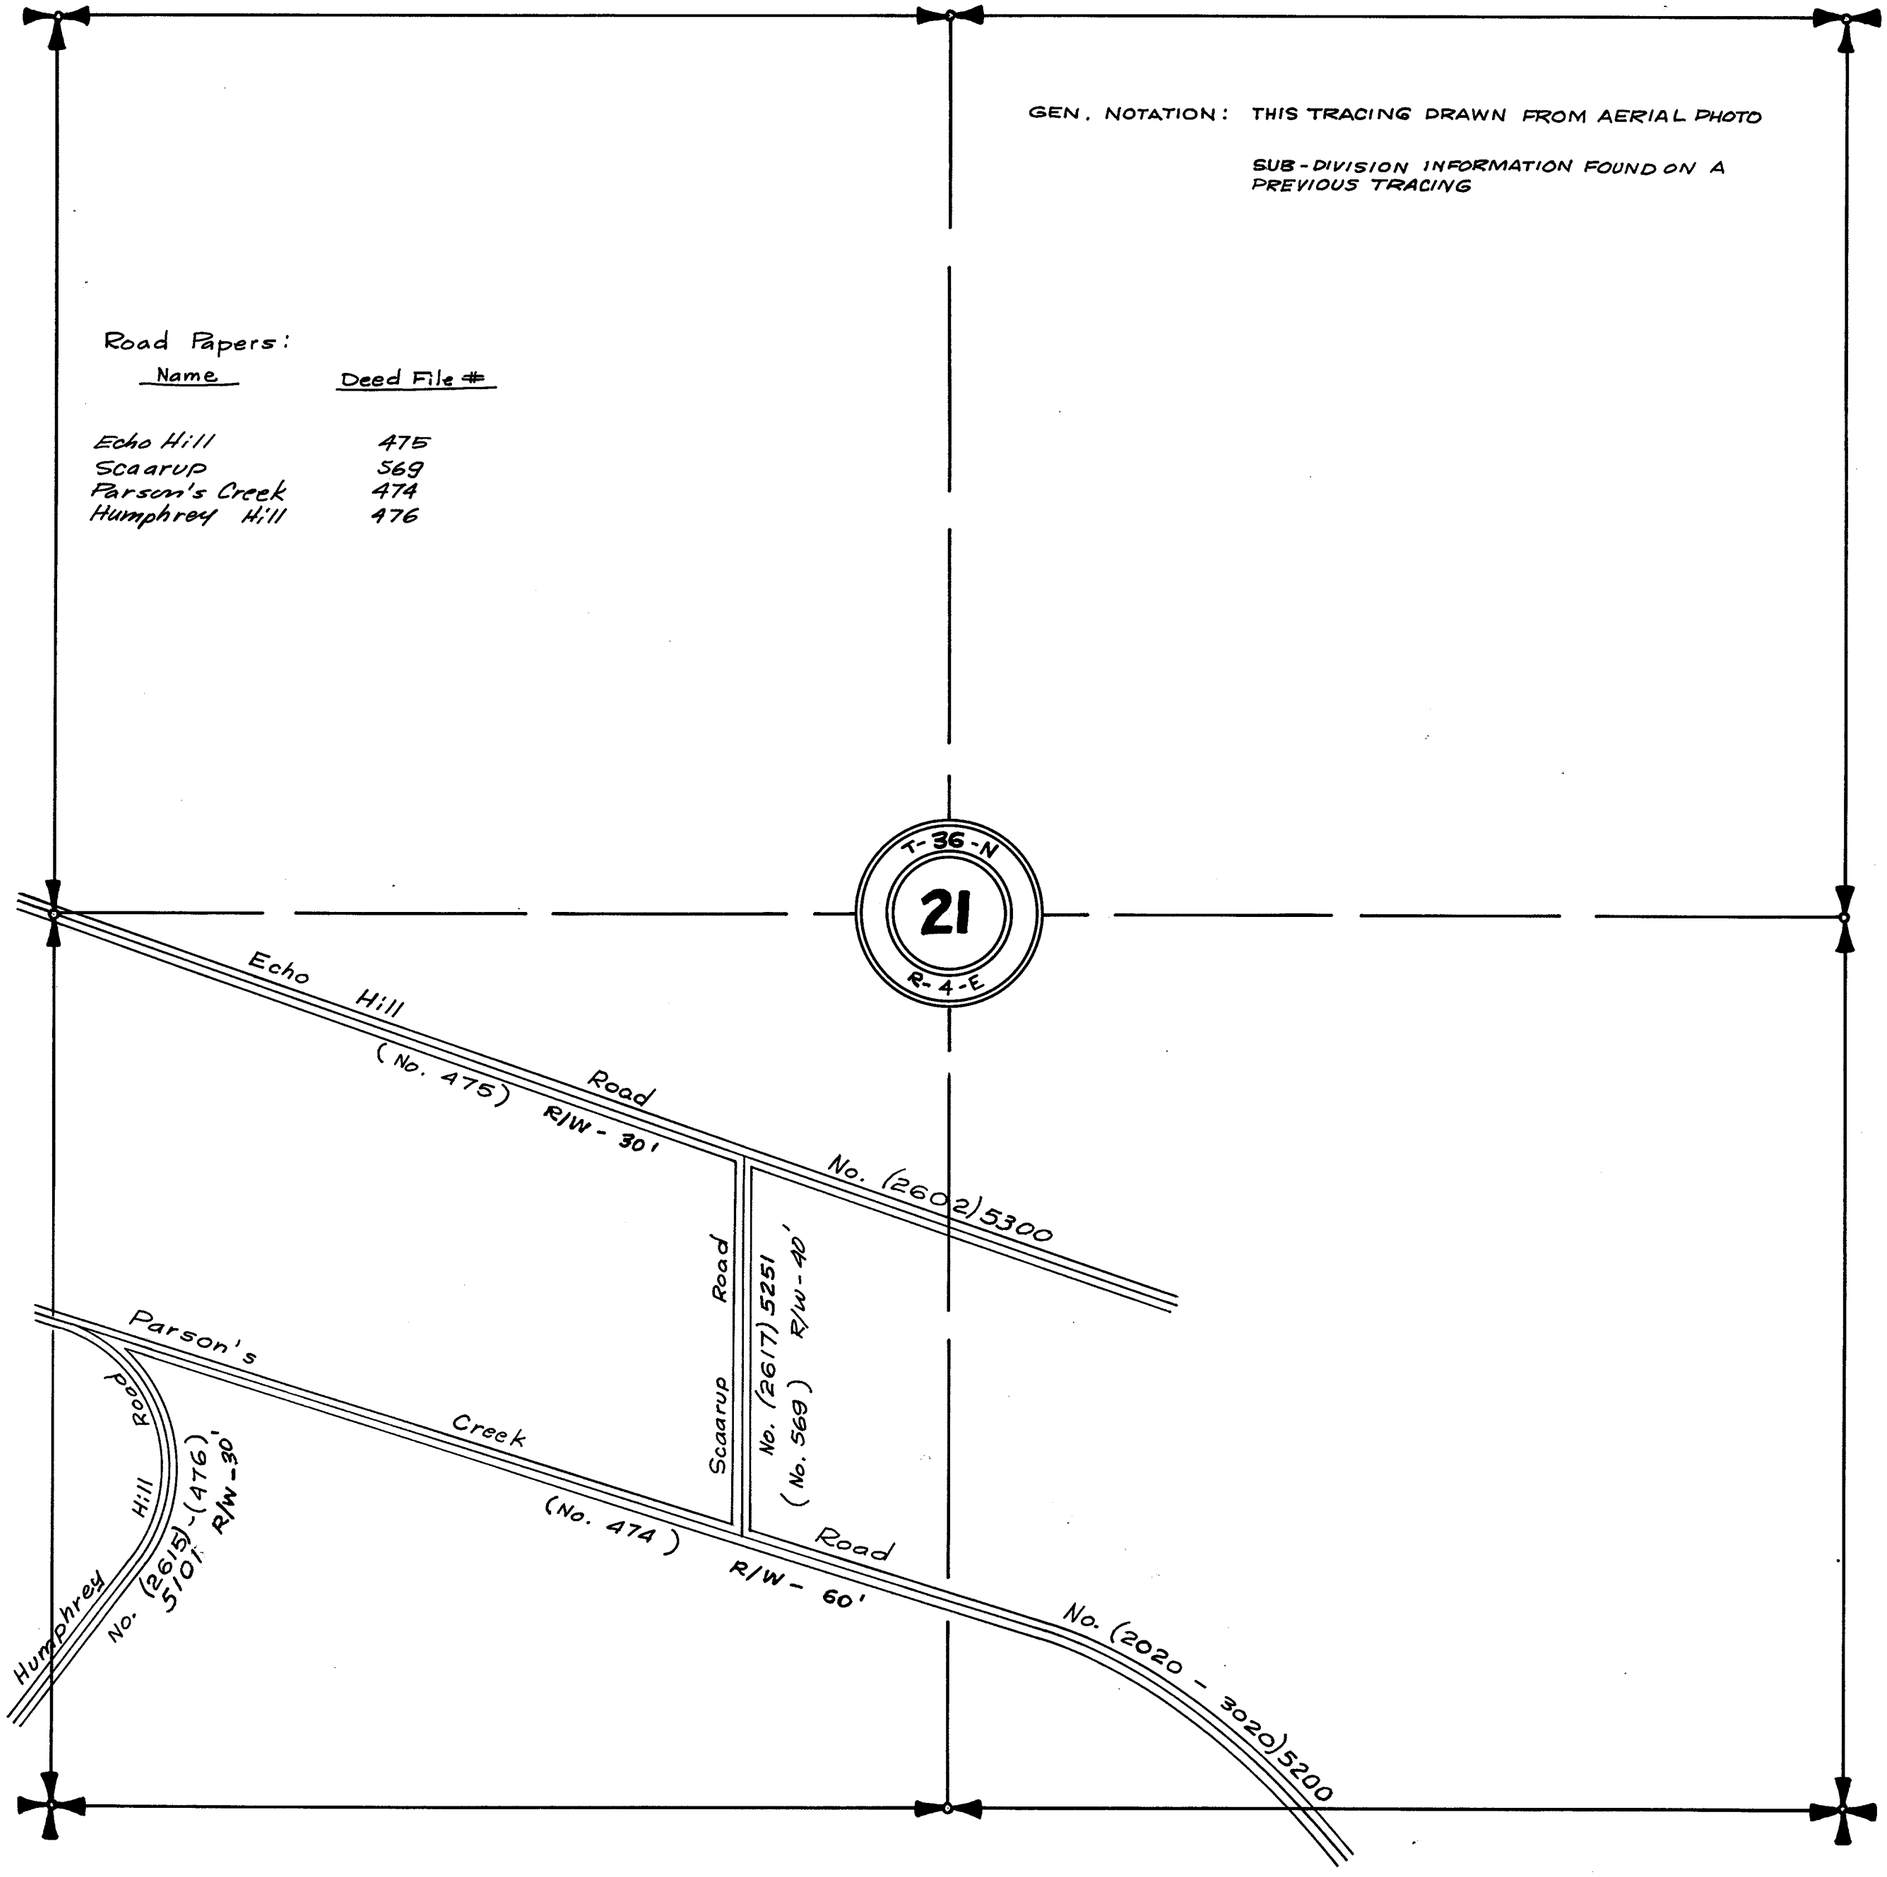

SECTION 24

TOWNSHIP 36 NORTH, RANGE 4 EAST, W. M.

SKAGIT COUNTY, WASH.

SCALE, 1 INCH--400 FEET

DATE August, 1965

Lloyd Johnson COUNTY ENGINEER

Field Notes: 35/283 8/23/35
38/363
41/481
715 12/14/51
757 1949

Road Papers:

Name	Deed File #
Upper Samish	XCIX
Prairie	30
(Kalloch)	30
Blank	321
Martin	512

No. 5551 Road

R/W - 60'

Samish

Upper

(No. 3605)-(XCIX)

T-36-N
24
R-4-E

6'-C

Railway

S. S. H.

Pacific

Northern

Martin Road No. 9150
(No. 3604)-(512)
R/W - 30'

Road Consolidation
Resolution - 3673
(1964)

Prairie Road

5000
No. (2022 - 3022)
R/W - 60'

-(30)

(Kalloch Road No. XCVIII)
Consolidation 1964

6491
No. (3607)-(321)

Blank Road
R/W - 40'

GEN. NOTATION: THIS TRACING DRAWN FROM AERIAL PHOTO

SECTION 24


TOWNSHIP 36 NORTH, RANGE 4 EAST, W.M.

SKAGIT COUNTY

Scale: 1" = 500'

R.W. McKINSTRY, CO. ENGR.

F.B. Vol. 92, Pg. 28-30.

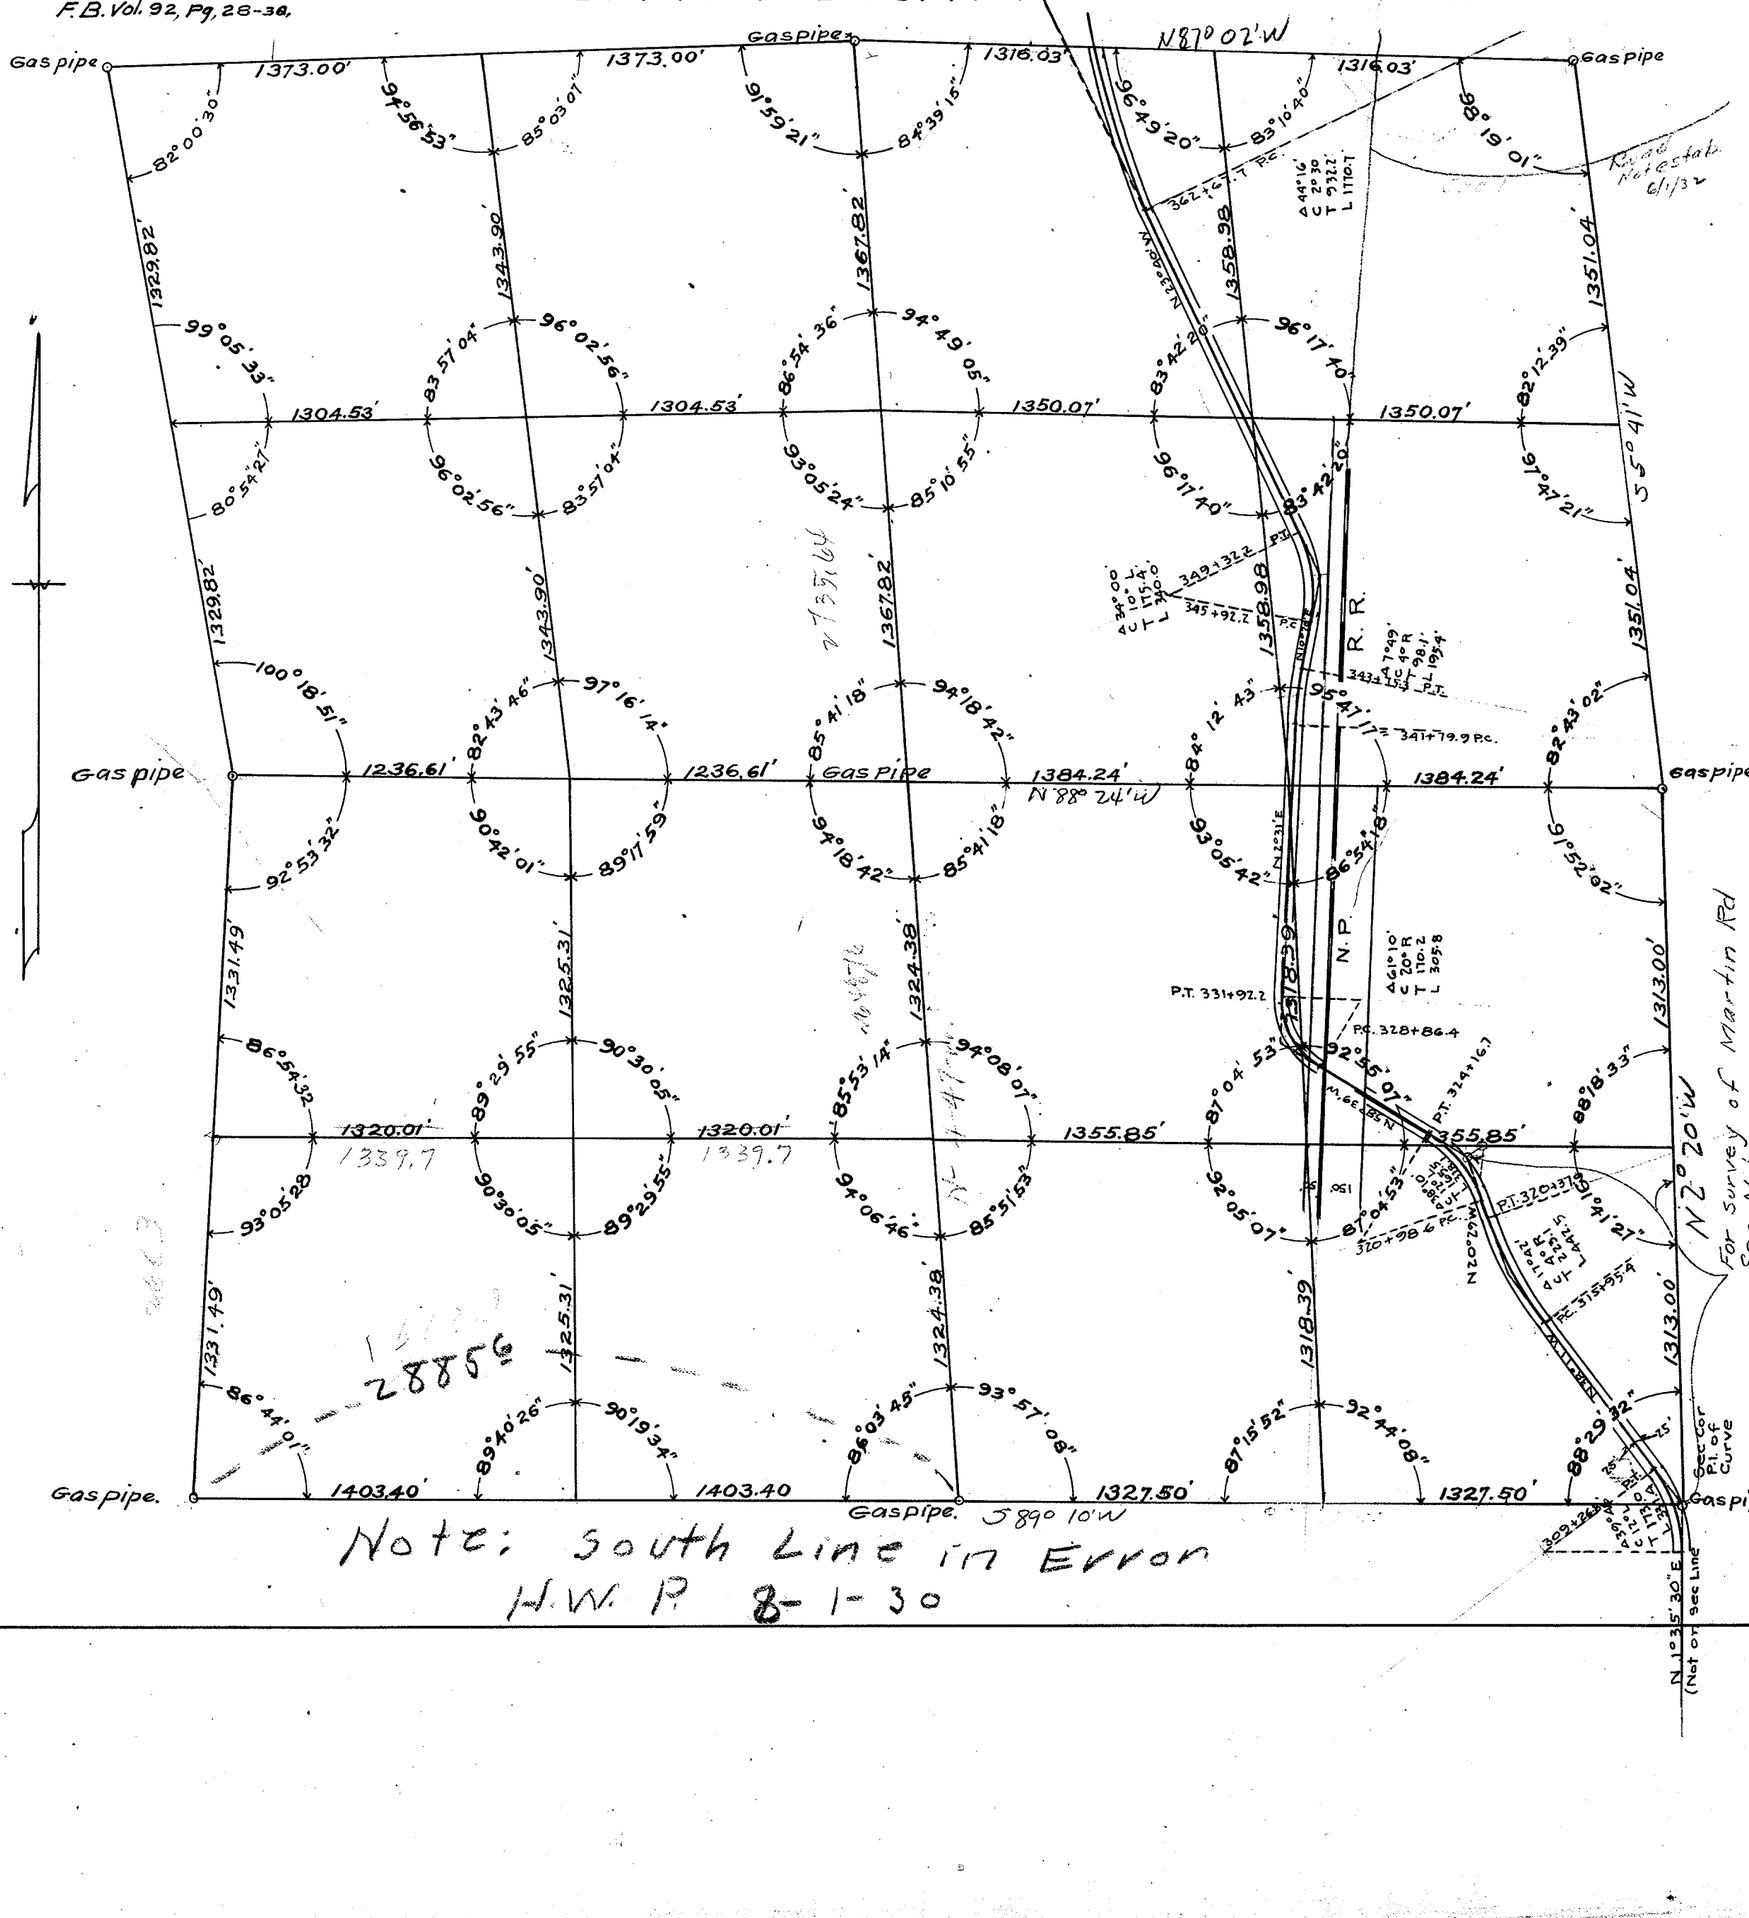

Note: South Line in Error

N.W. P. 8-1-30


SECTION 25

TOWNSHIP 36 NORTH, RANGE 4 EAST, W. M.
SKAGIT COUNTY, WASH.

SCALE, 1 INCH = 400 FEET

Robt. E. L. Knapp
November 1931
Warner Road Added: July 1939 AI

COUNTY ENGINEER

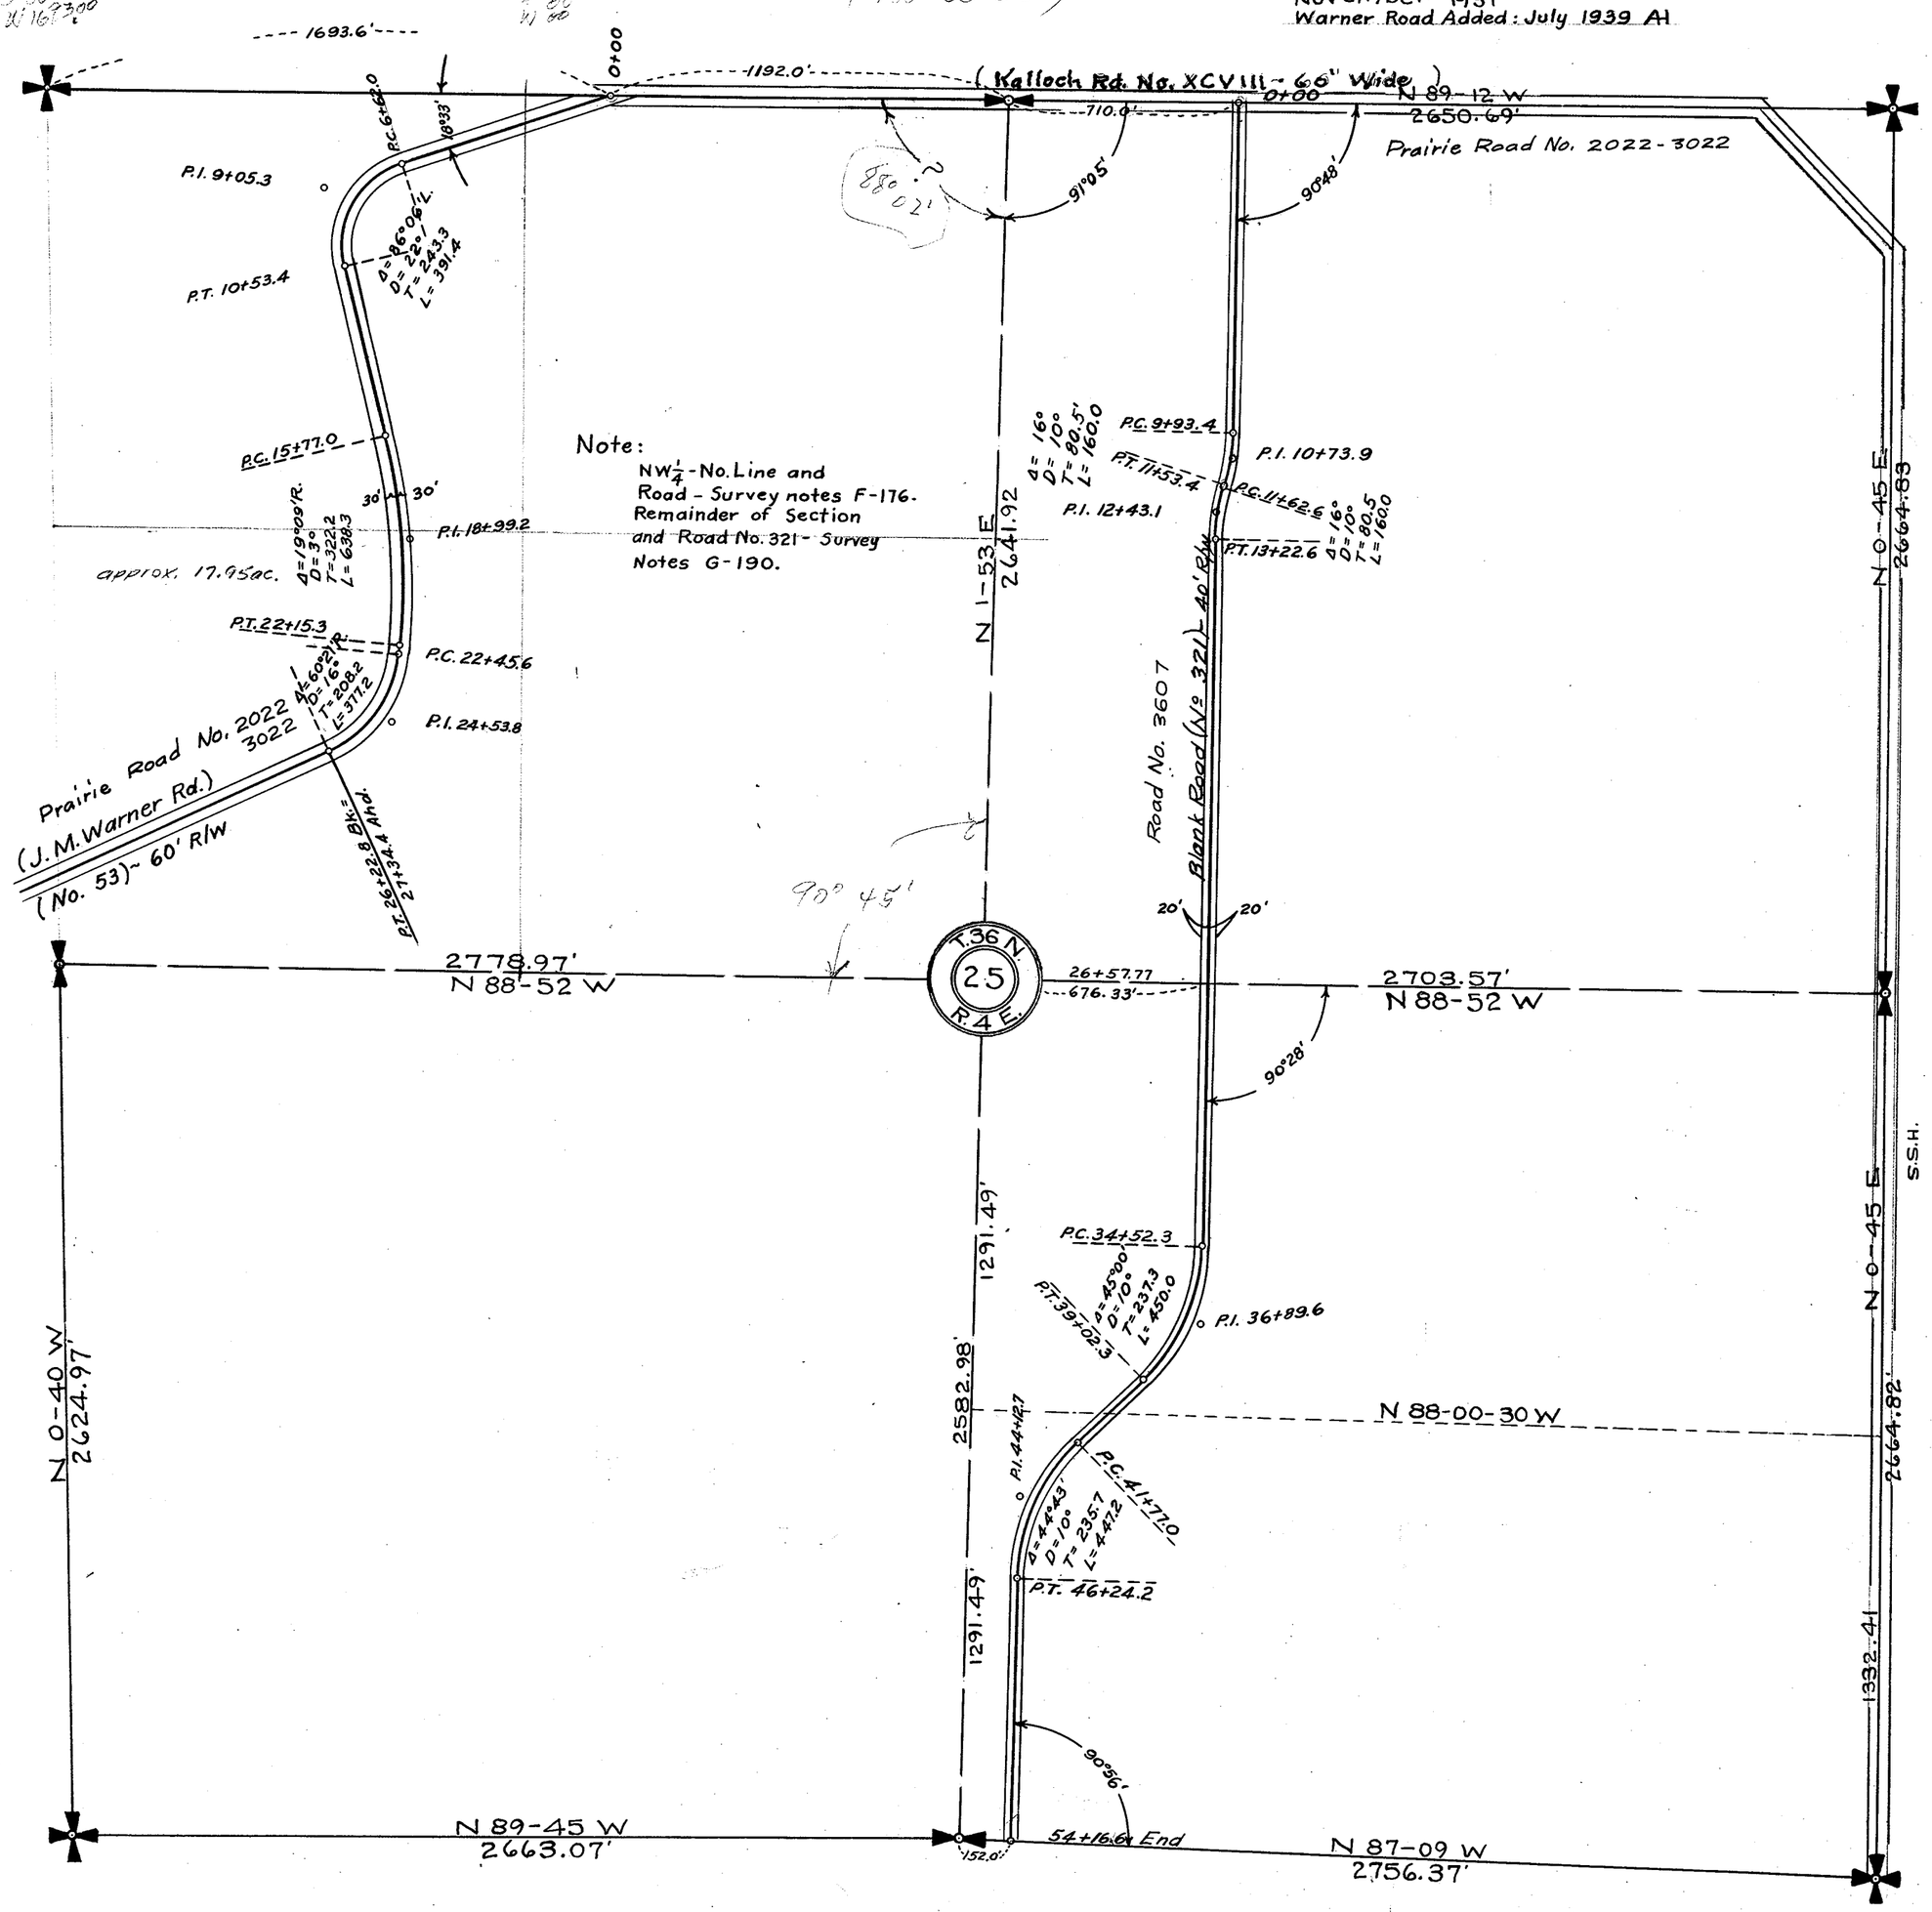

SECTION 25


TOWNSHIP 36 NORTH, RANGE 4 EAST, W. M.

SKAGIT COUNTY, WASH.

SCALE, 1 INCH--400 FEET

DATE August, 1965

Lloyd Johnson COUNTY ENGINEER

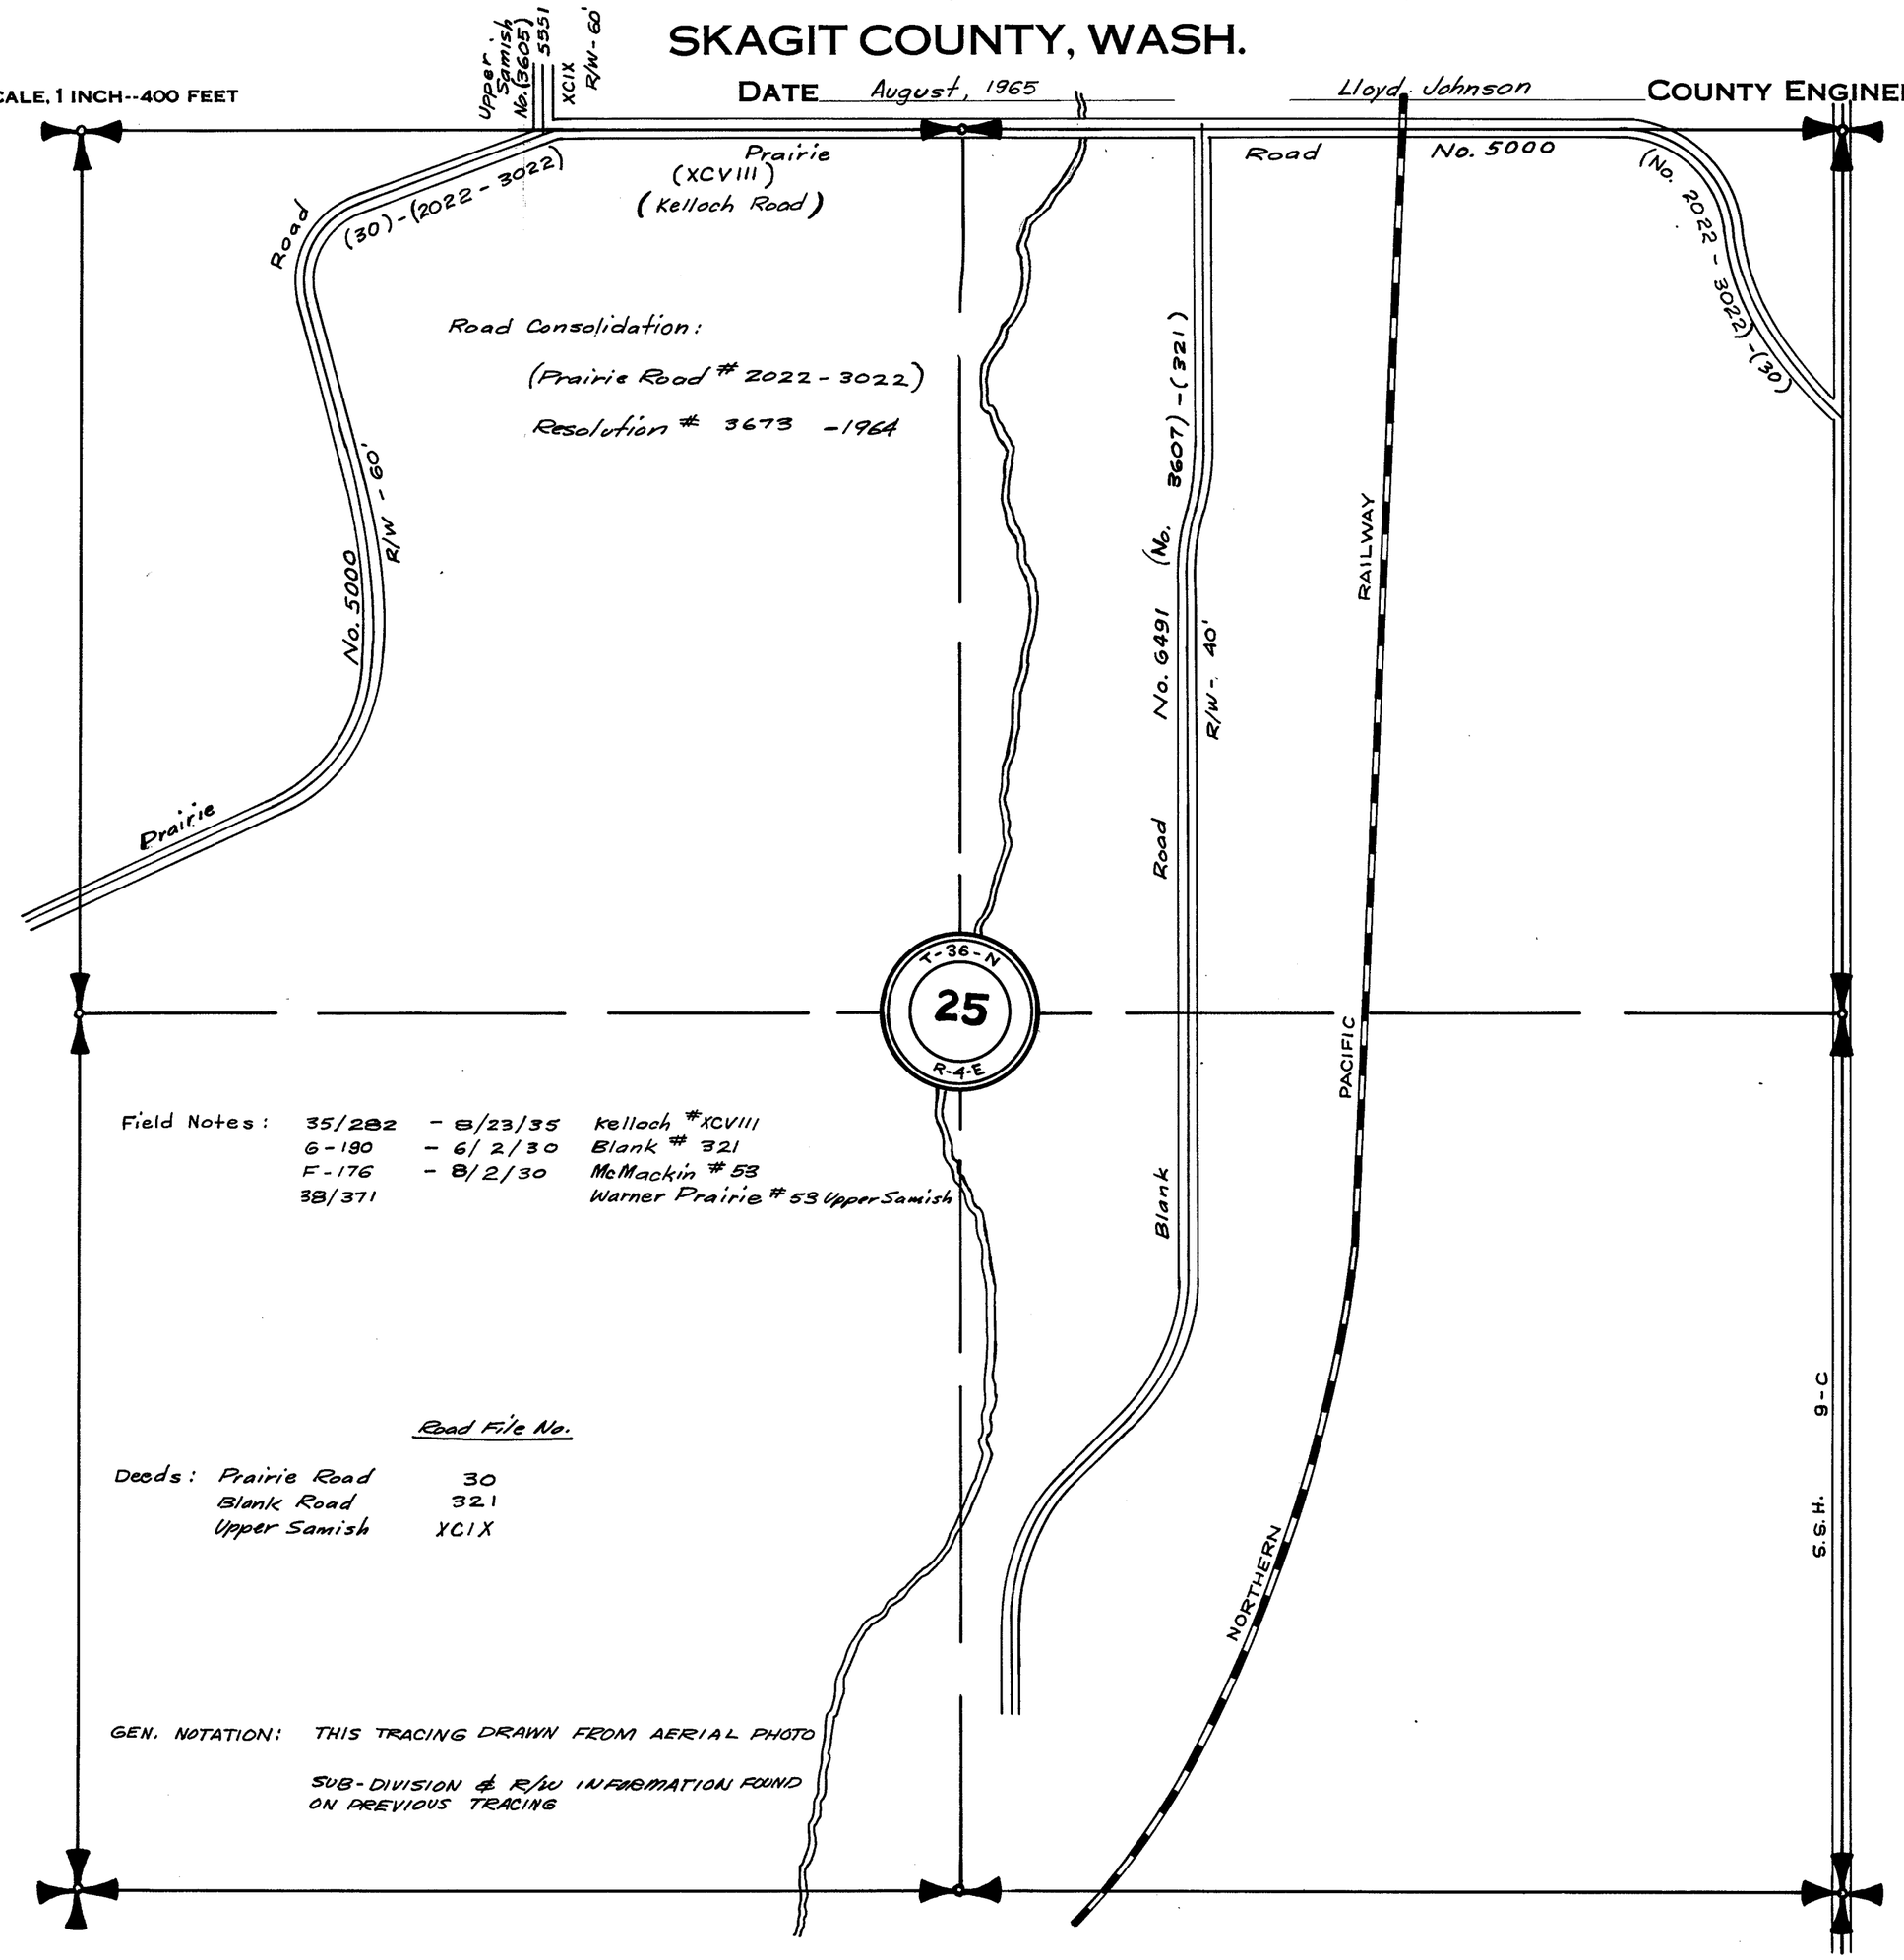

Field Notes:

35/282	- 8/23/35	Kelloch #XCVIII
G-190	- 6/2/30	Blank # 321
F-176	- 8/2/30	McMackin # 53
38/371		Warner Prairie # 53 Upper Samish

Deeds:	Road File No.
Prairie Road	30
Blank Road	321
Upper Samish	XCIX

GEN. NOTATION: THIS TRACING DRAWN FROM AERIAL PHOTO


SUB-DIVISION & R/W INFORMATION FOUND ON PREVIOUS TRACING


TOWNSHIP 36 NORTH, RANGE 4 EAST, W. M.
SKAGIT COUNTY, WASH.

SCALE, 1 INCH--400 FEET


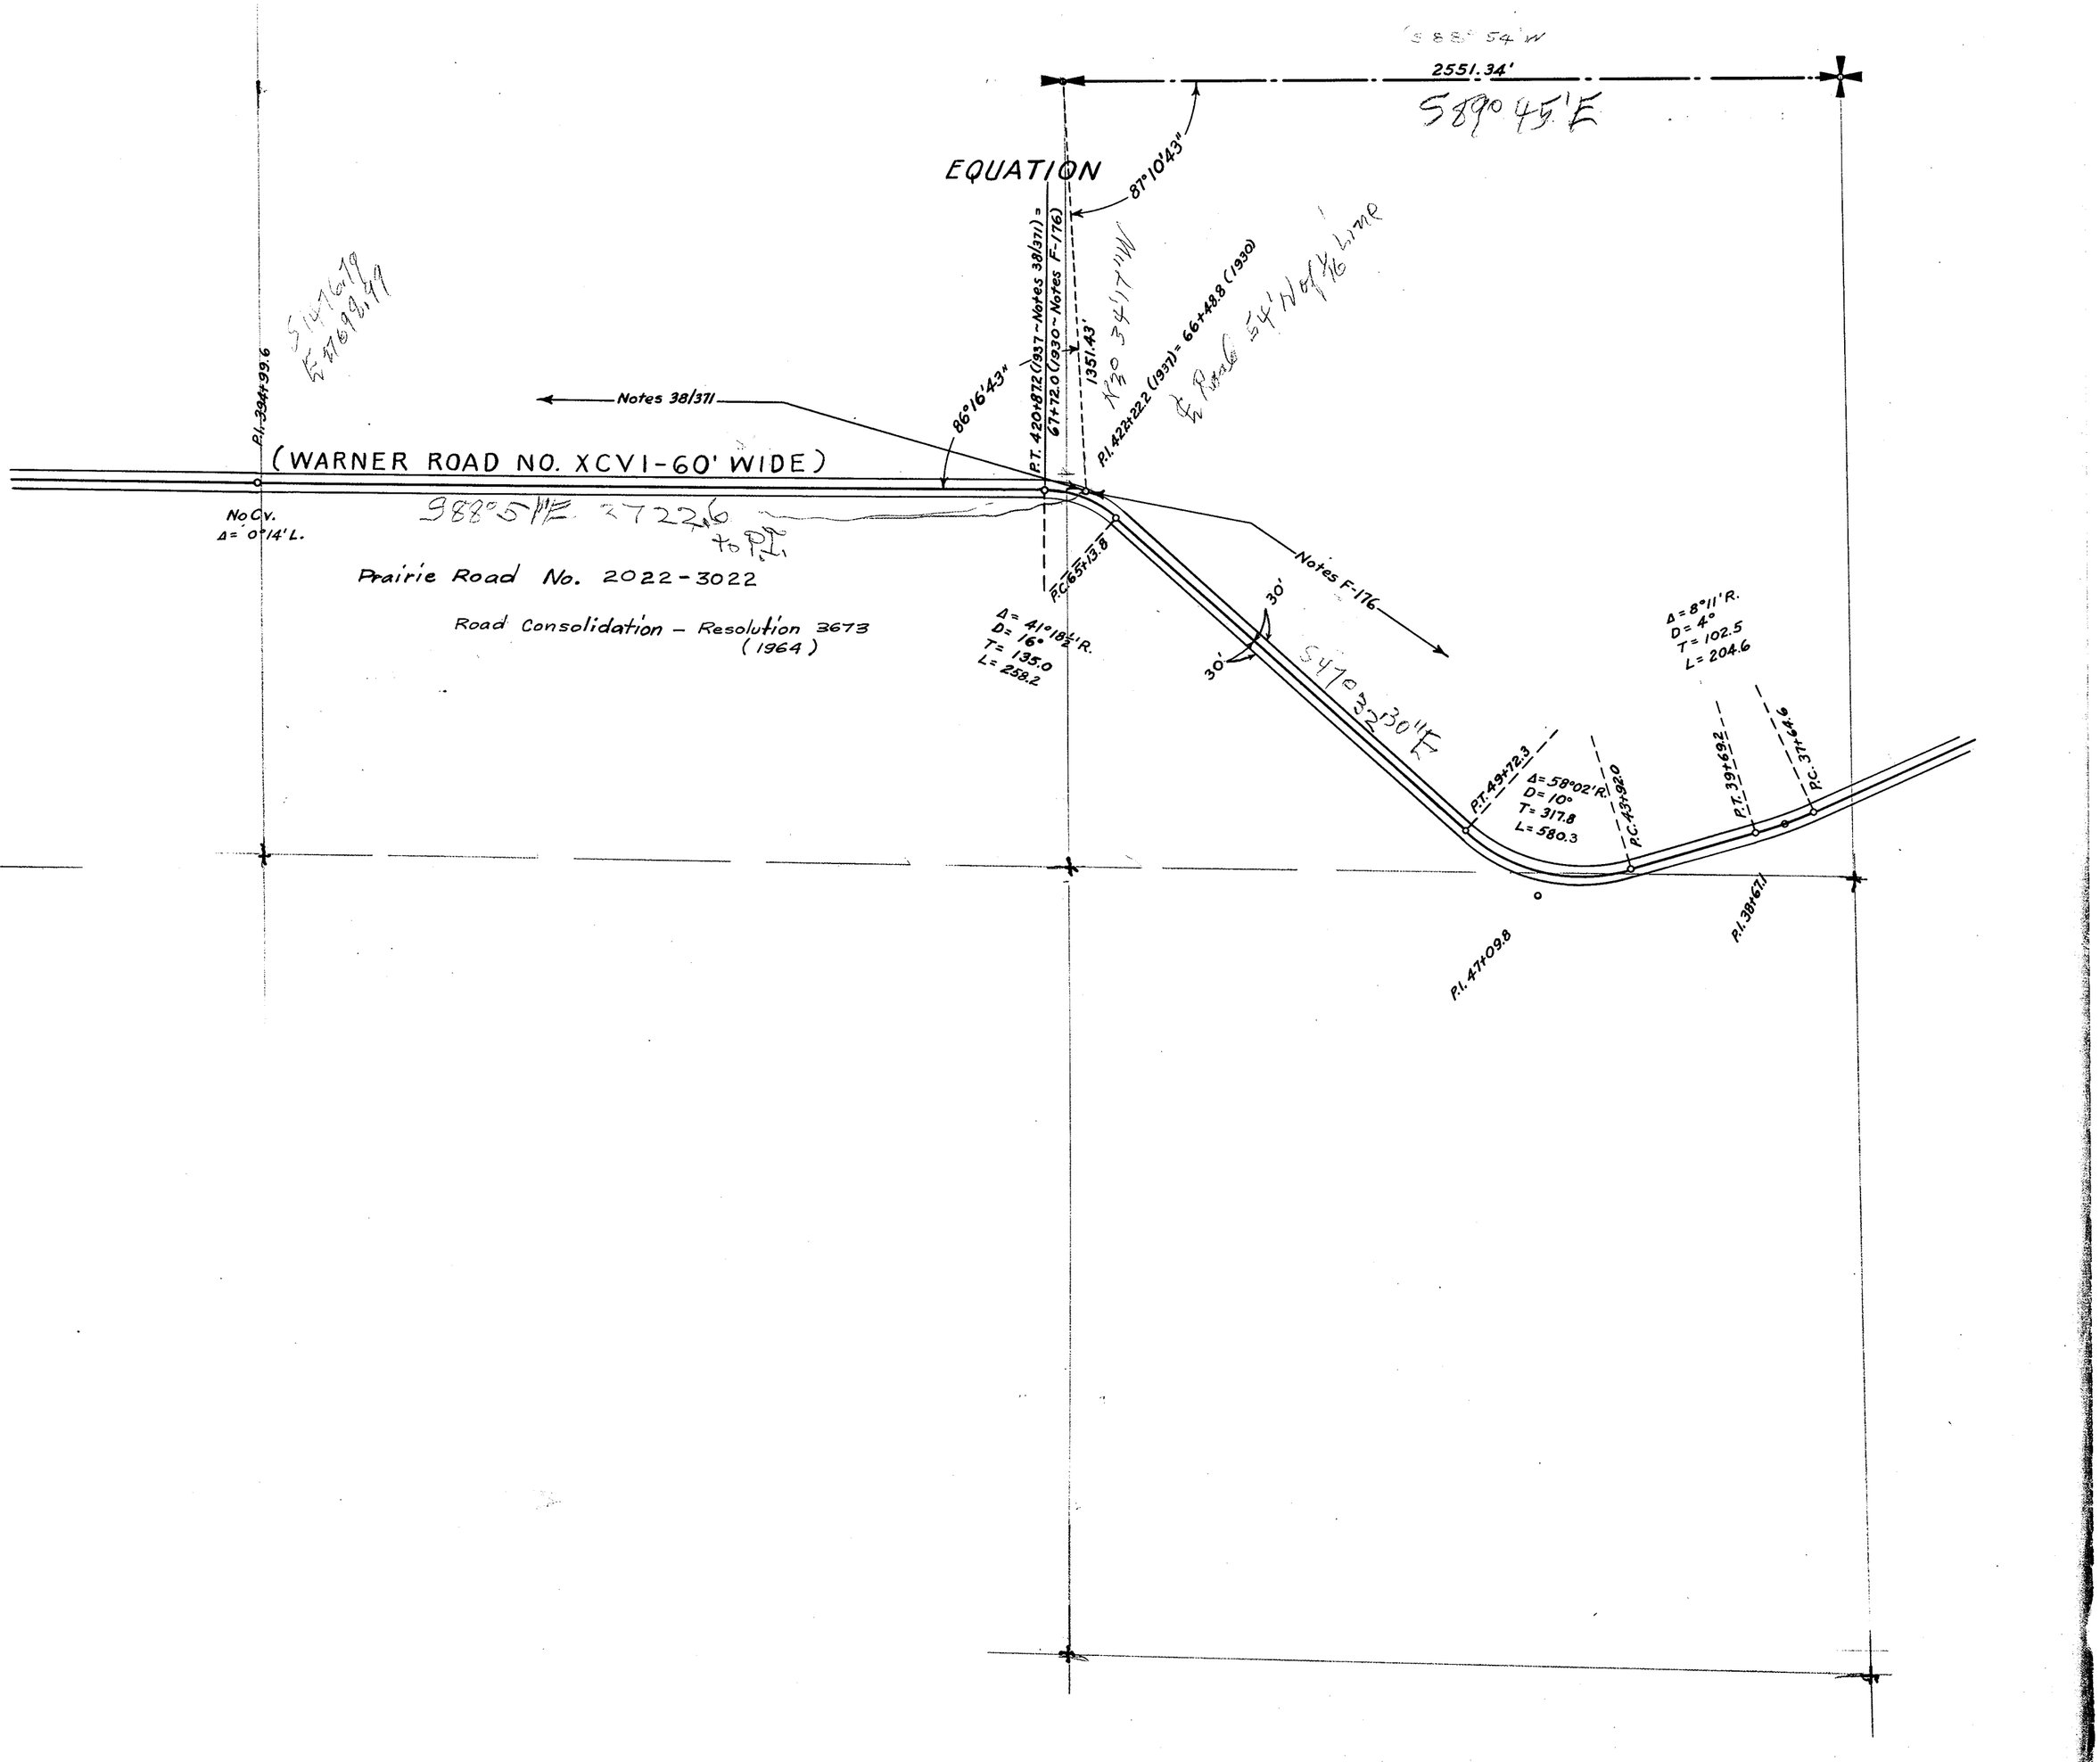


SECTION 26

TOWNSHIP 36 NORTH, RANGE 4 EAST, W. M.

SKAGIT COUNTY, WASH.

SCALE, 1 INCH--400 FEET

DATE August, 1965 Lloyd Johns COUNTY ENGINEER

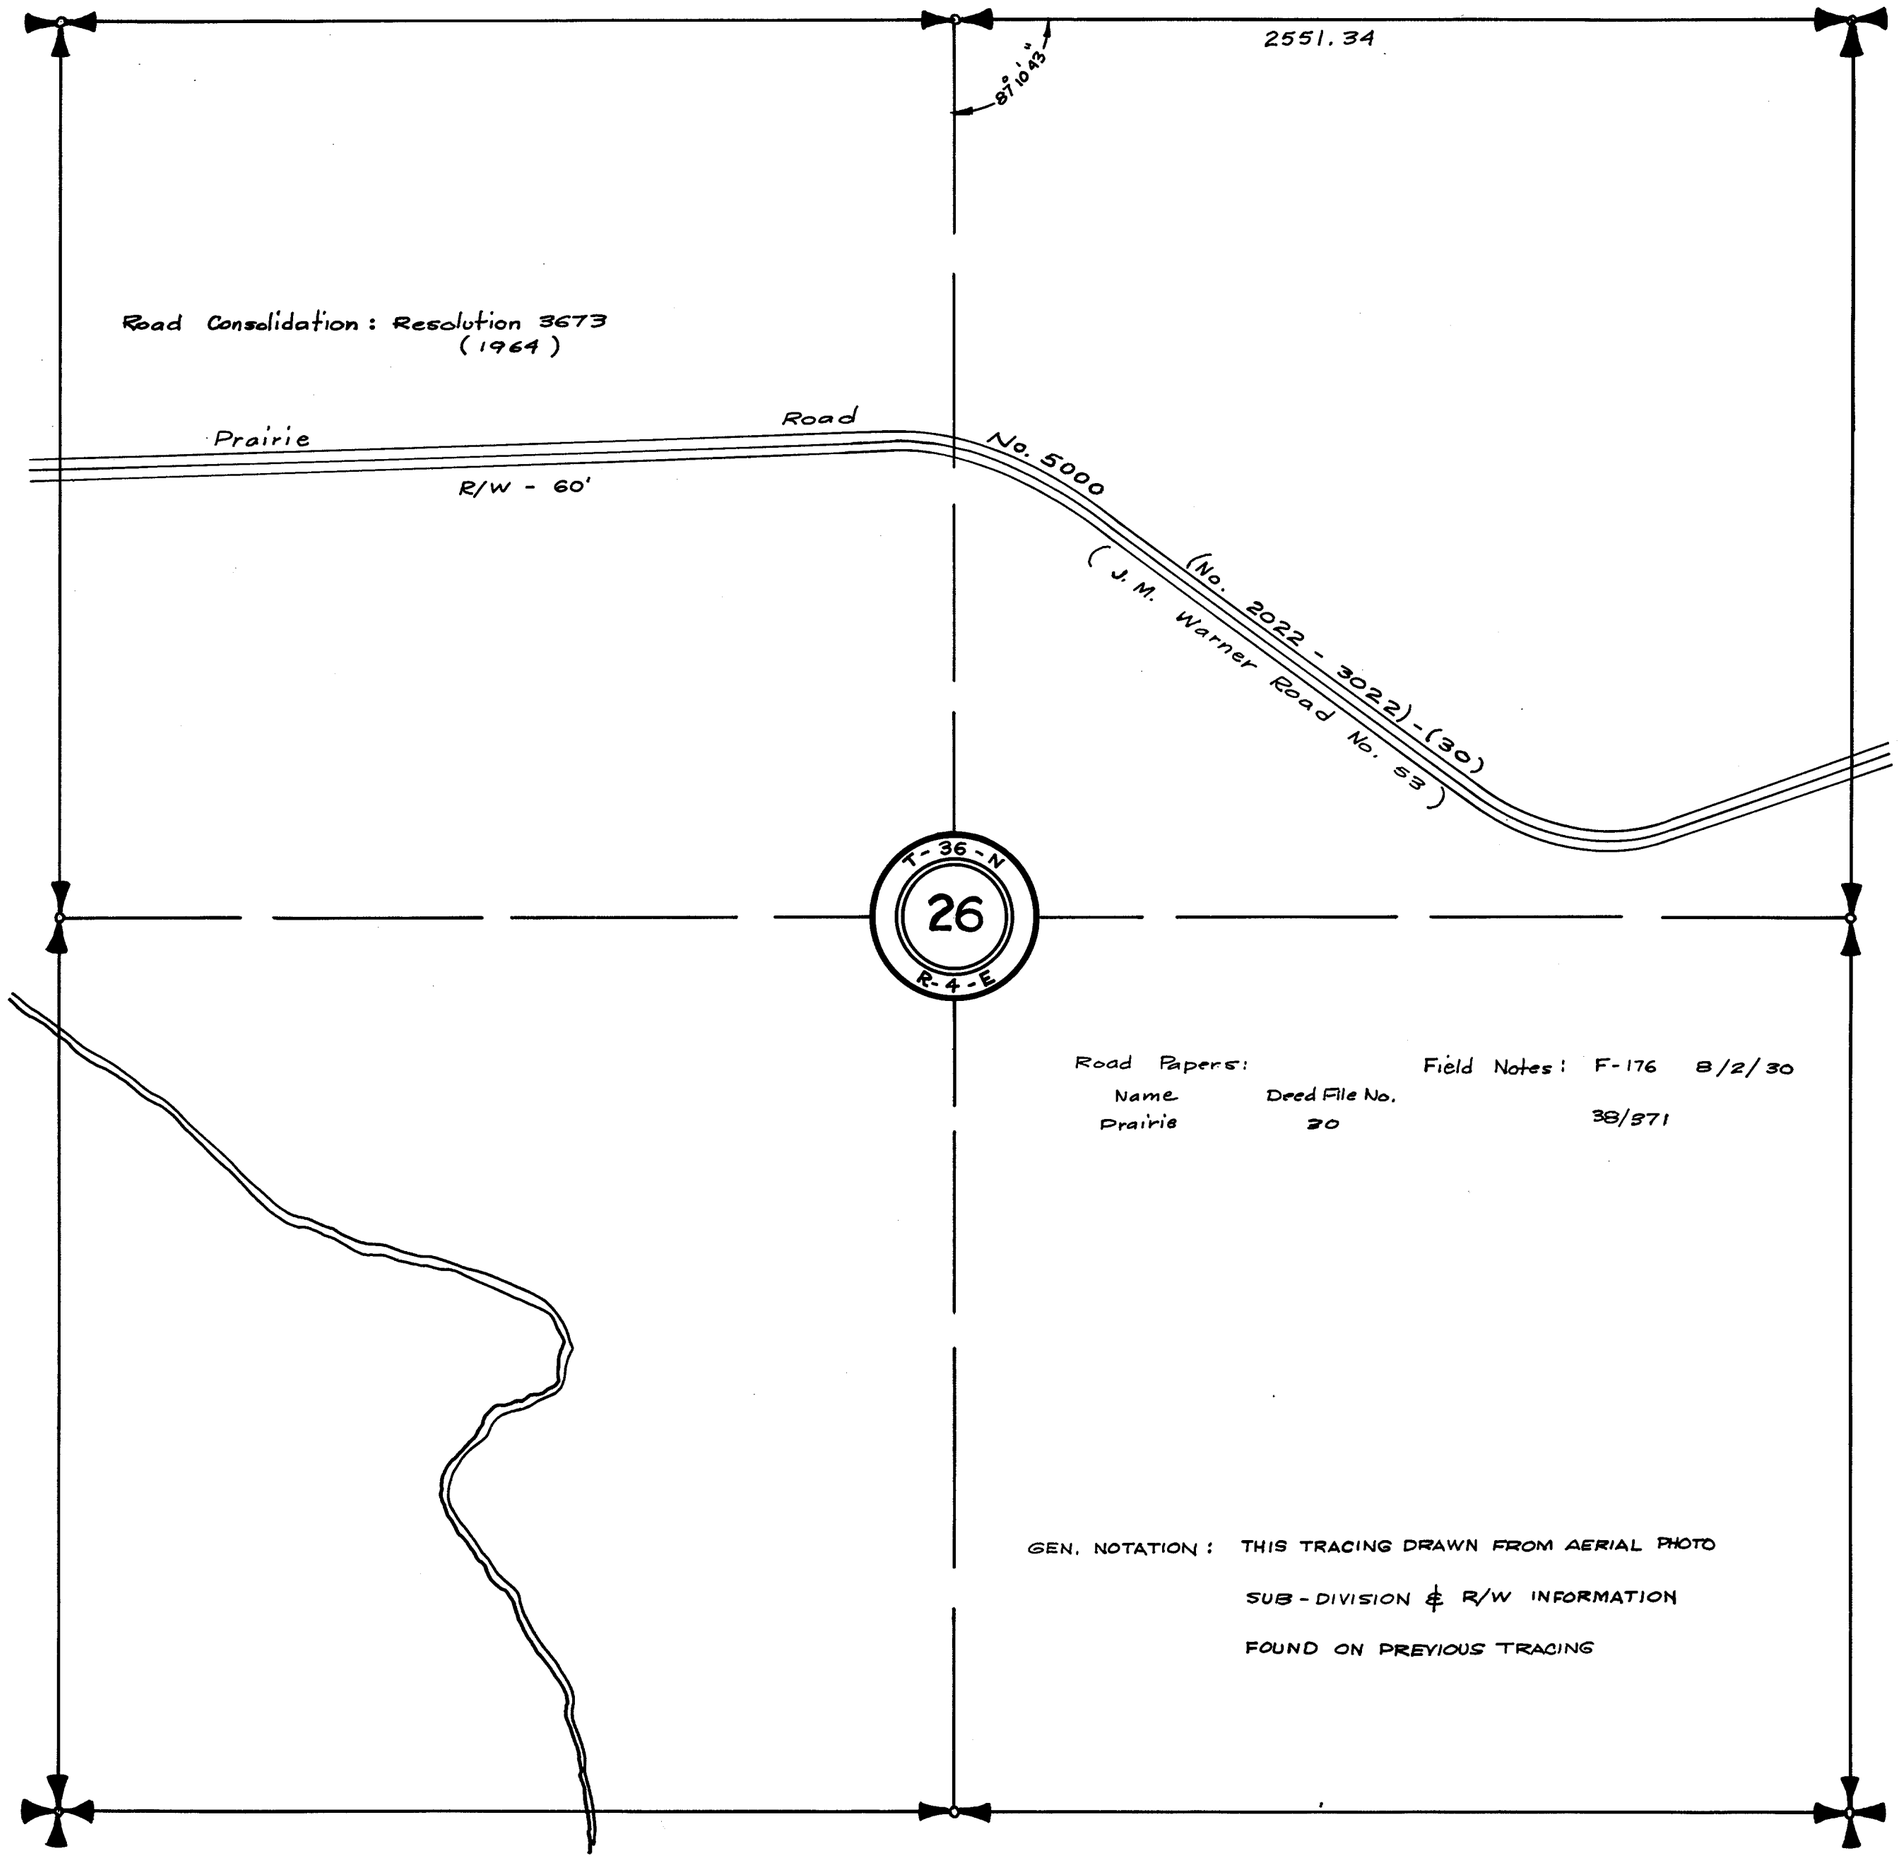

Road Papers:

Name	Deed File No.
Prairie	20

Field Notes : F-176 8/2/30
38/371

GEN. NOTATION : THIS TRACING DRAWN FROM AERIAL PHOTO
SUB-DIVISION & R/W INFORMATION
FOUND ON PREVIOUS TRACING



TOWNSHIP 36 NORTH, RANGE 4 EAST, W. M.

SKAGIT COUNTY, WASH.

SCALE, 1 INCH--400 FEET

DATE August, 1965

Lloyd Johnson COUNTY ENGINEER

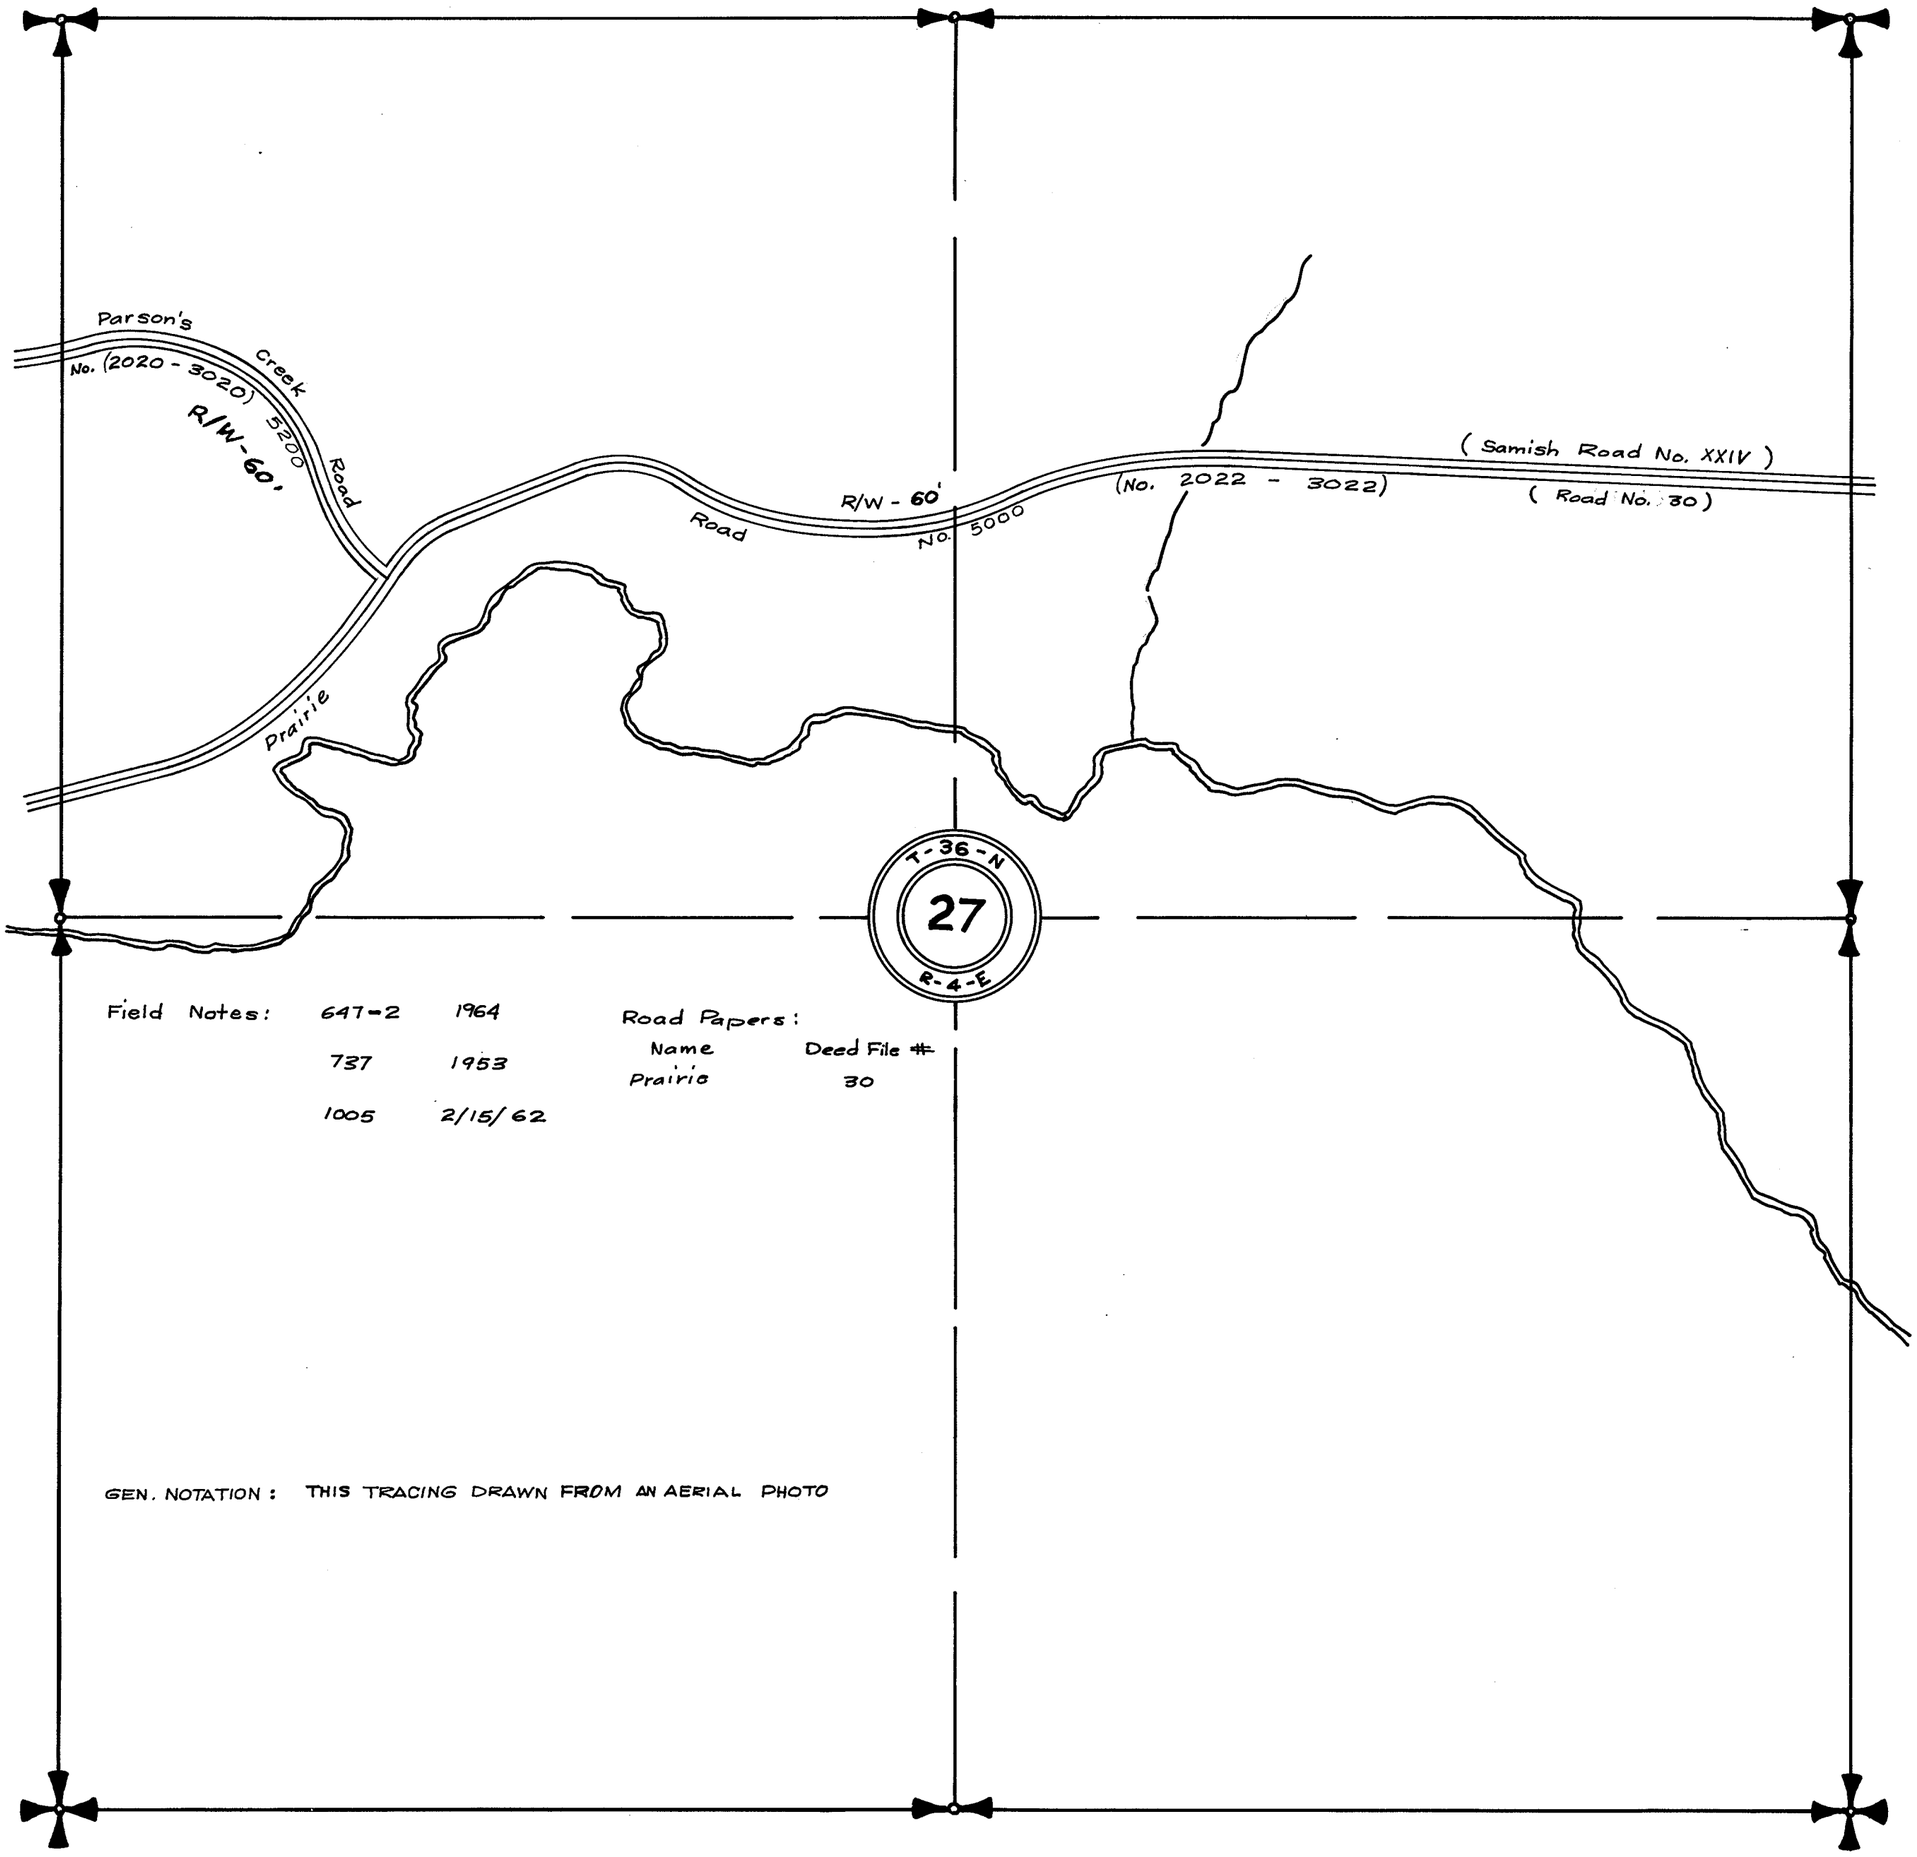

Field Notes:

647-2	1964	
737	1953	
1005	2/15/62	

Road Papers:

Name	Deed File #
Prairie	30


GEN. NOTATION: THIS TRACING DRAWN FROM AN AERIAL PHOTO

SECTION 27

TOWNSHIP 36 NORTH, RANGE 4 EAST, W. M.
SKAGIT COUNTY, WASH.

SCALE, 1 INCH--400 FEET

W.A. COSTELLO
Notes 38/371
COUNTY ENGINEER

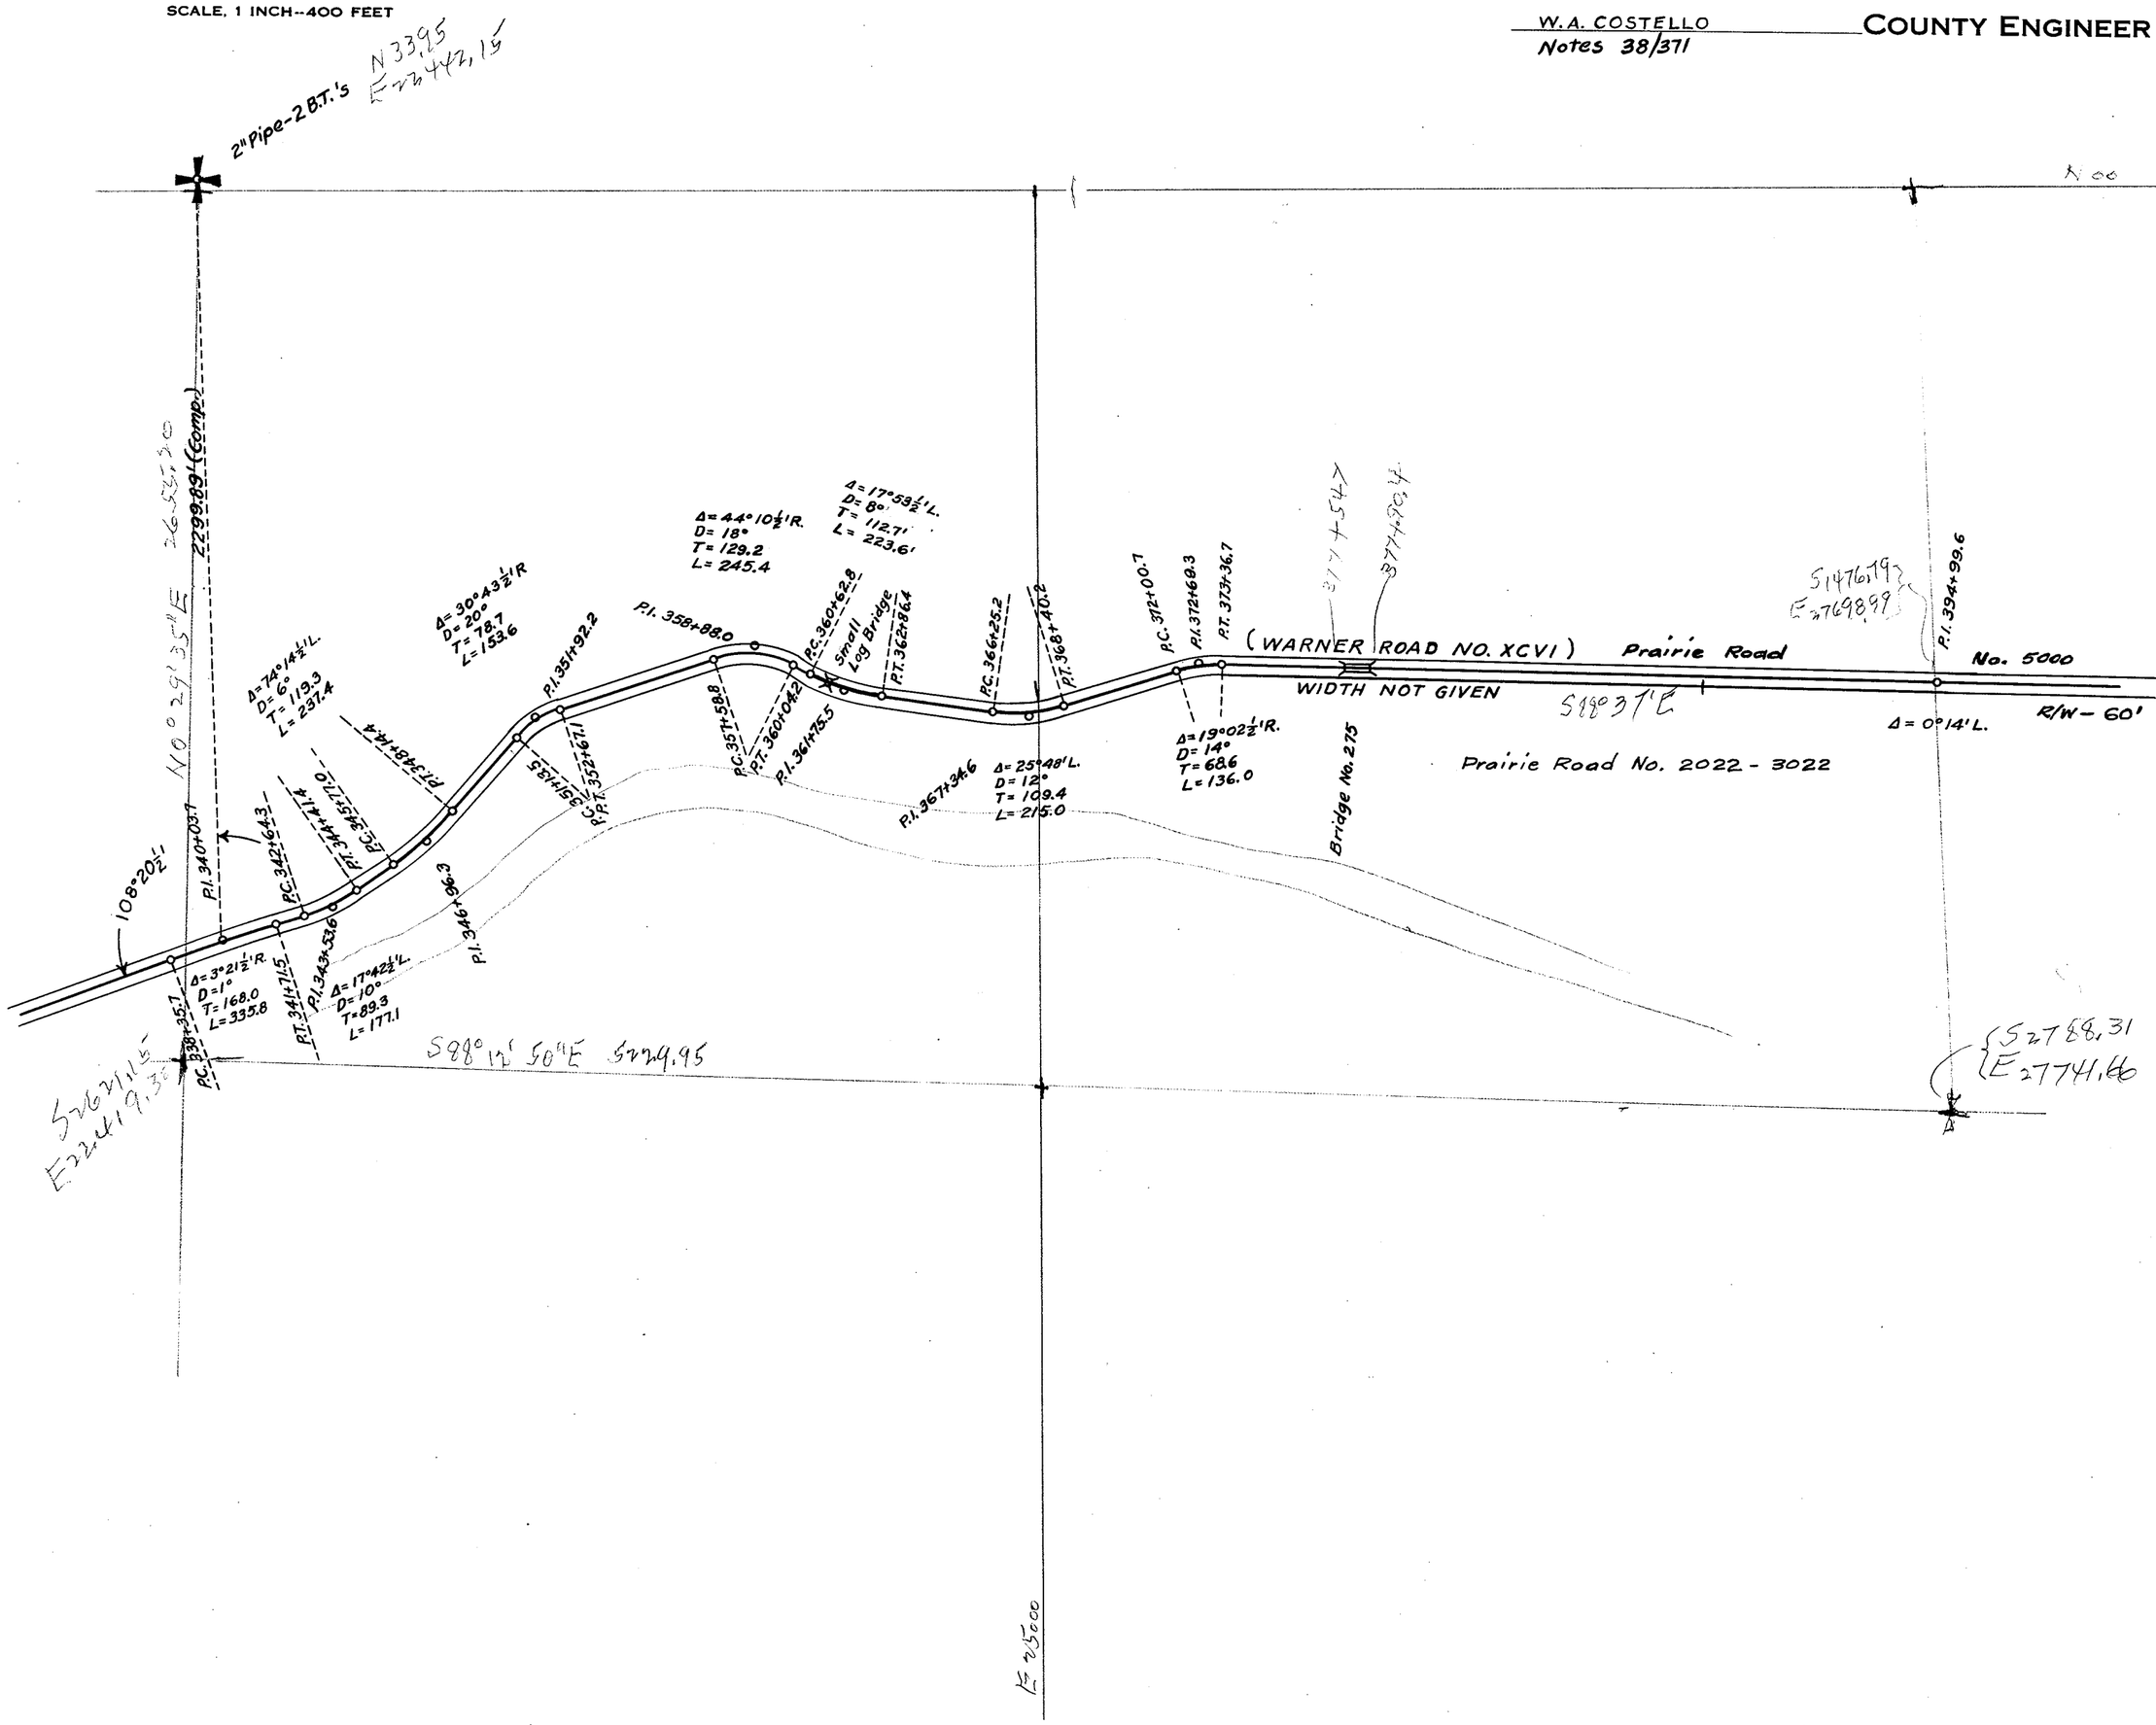


SECTION 28

TOWNSHIP 36 NORTH, RANGE 4 EAST, W. M.
SKAGIT COUNTY, WASH.

SCALE, 1 INCH--400 FEET

W.A. COSTELLO COUNTY ENGINEER
Notes 38/371

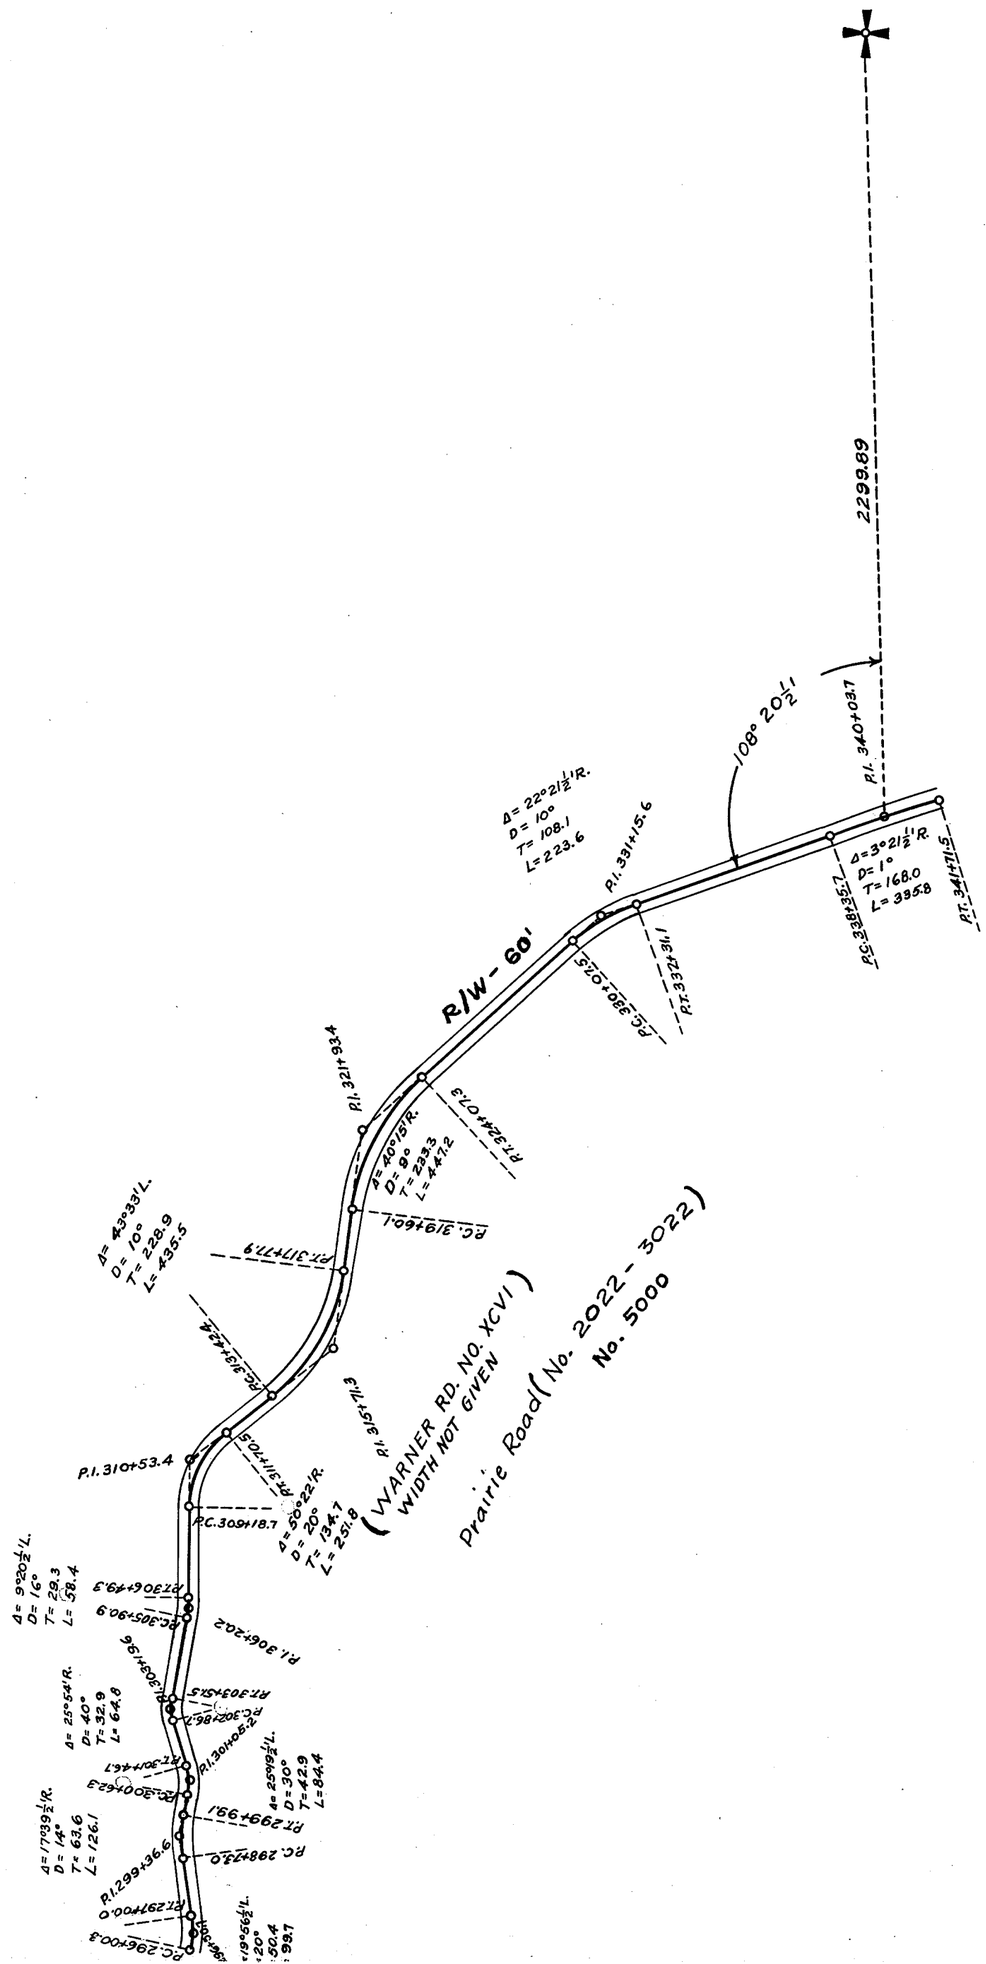

SECTION 28

TOWNSHIP 36 NORTH, RANGE 4 EAST, W. M.

SKAGIT COUNTY, WASH.

SCALE, 1 INCH--400 FEET

DATE August, 1965

Lloyd Johnson COUNTY ENGINEER

Field Notes: 38/380


46/647 1946

647-2 1964

641 #789 1949

Road Papers:

Name	Deed File #
Parson's Creek	474
Prairie	30

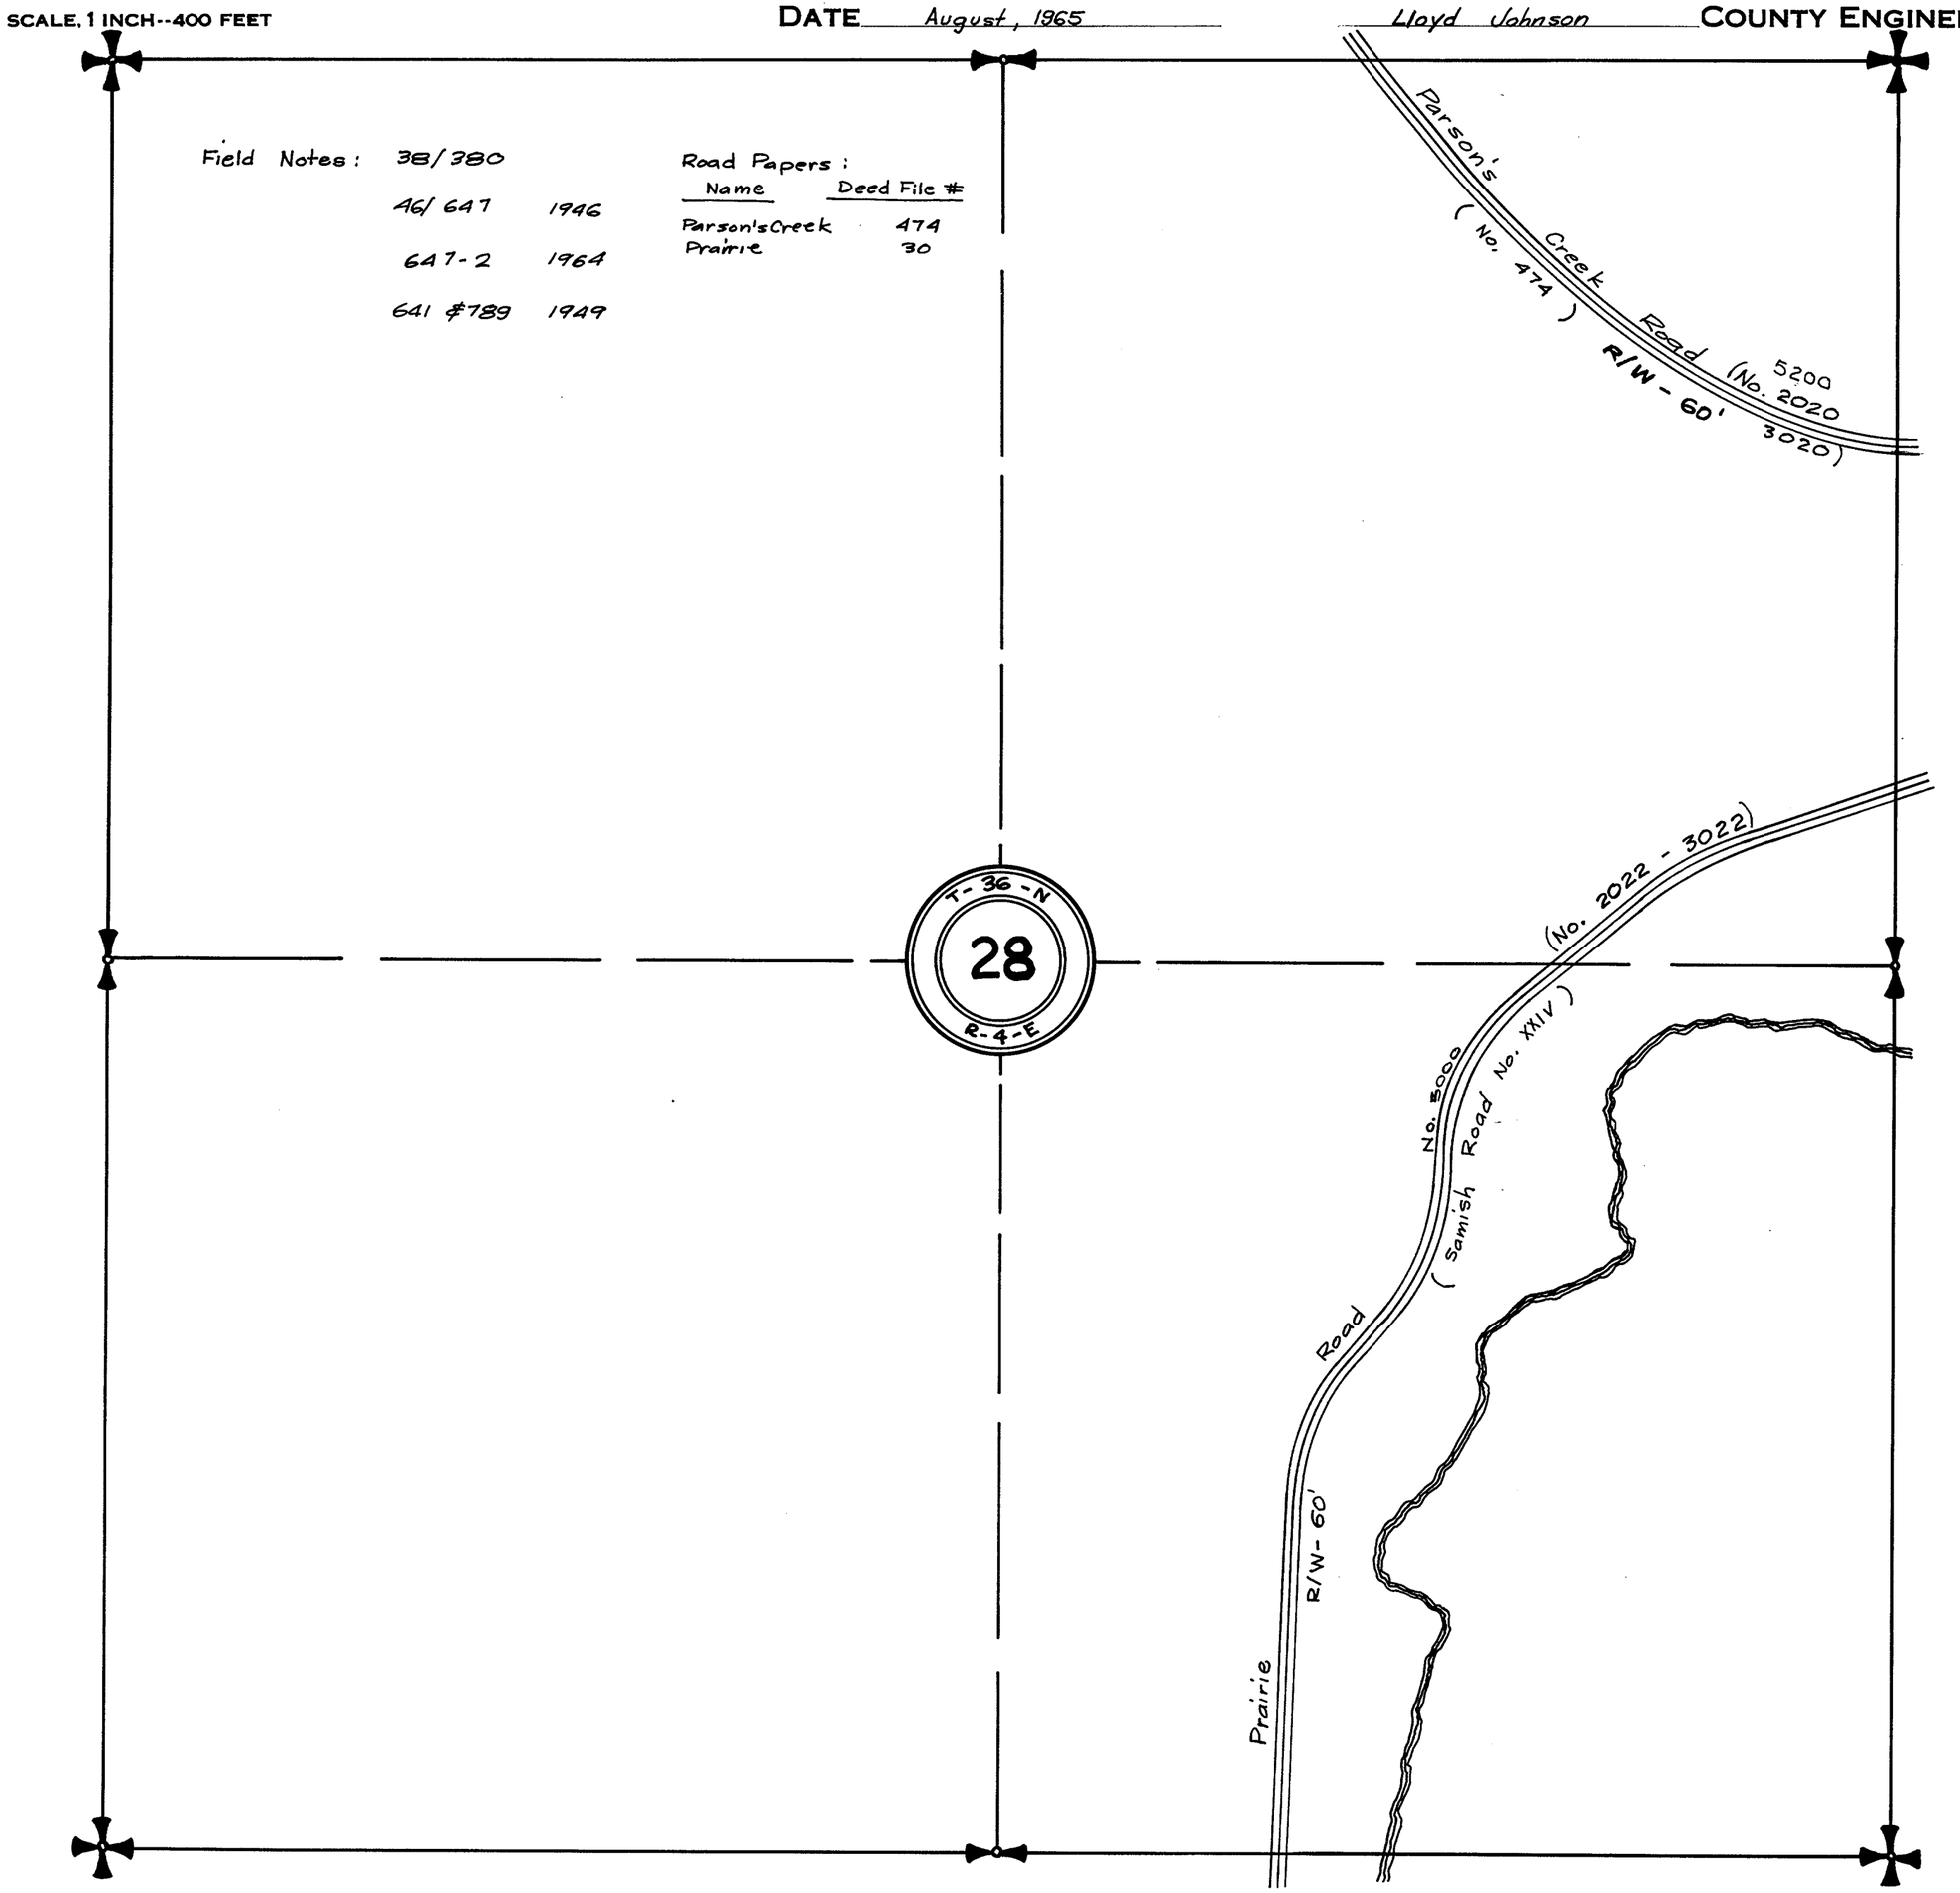

GEN. NOTATION: THIS TRACING DRAWN FROM AN AERIAL PHOTO

ROAD NO. 2022-3022 R/W SHOWN TO SCALE ON PREVIOUS TRACING.

SECTION 29

TOWNSHIP 36 NORTH, RANGE 4 EAST, W. M.

SKAGIT COUNTY, WASH.

SCALE, 1 INCH--400 FEET


DATE August, 1965

Lloyd Johnson COUNTY ENGINEER

Field Notes: 41/493 -(Bridges)

Road File No.

Deeds : Humphrey Hill #476 - 476

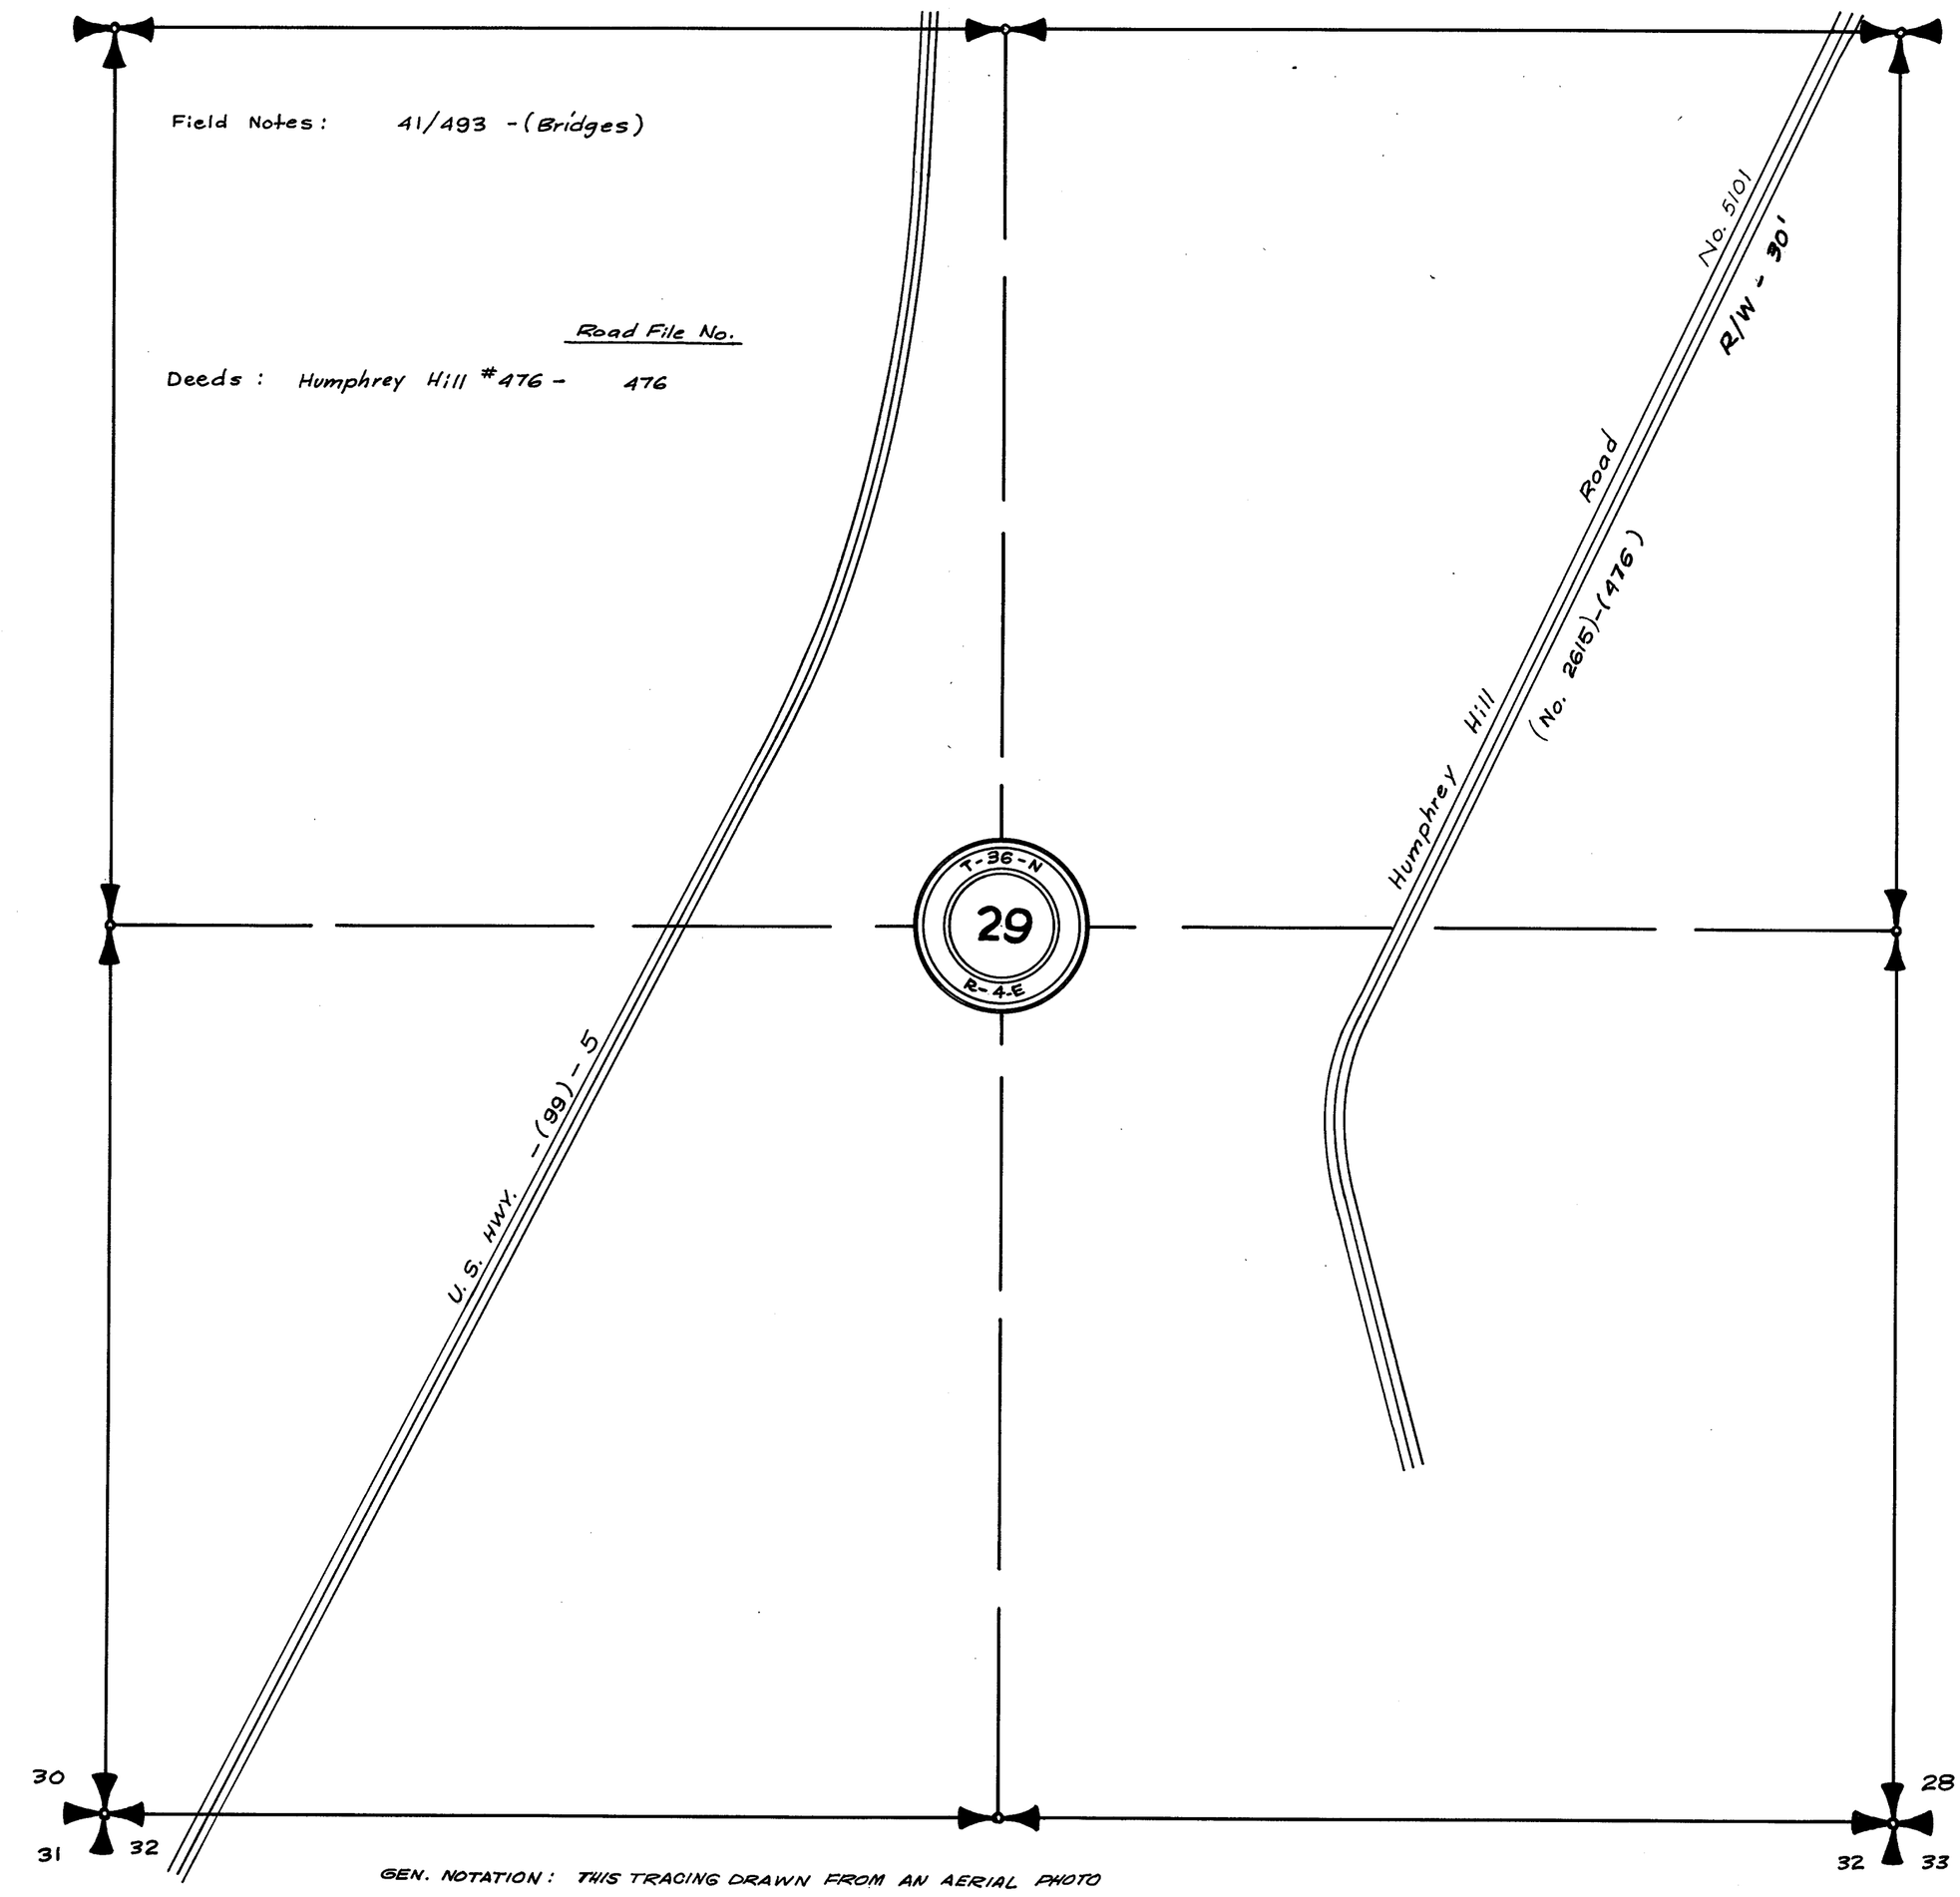

GEN. NOTATION: THIS TRACING DRAWN FROM AN AERIAL PHOTO

SECTION 30

TOWNSHIP 36 NORTH, RANGE 4 EAST, W. M.

SKAGIT COUNTY, WASH.

SCALE, 1 INCH--400 FEET

DATE August, 1965


Lloyd Johnson COUNTY ENGINEER

Field Notes : 6.182 7/1/31 Alger-Old Colony Road

41/493 Abbey Road

1028 1964 Buchanan Addition to Mt. Vernon

Deeds : Friday Creek Road File No. 64

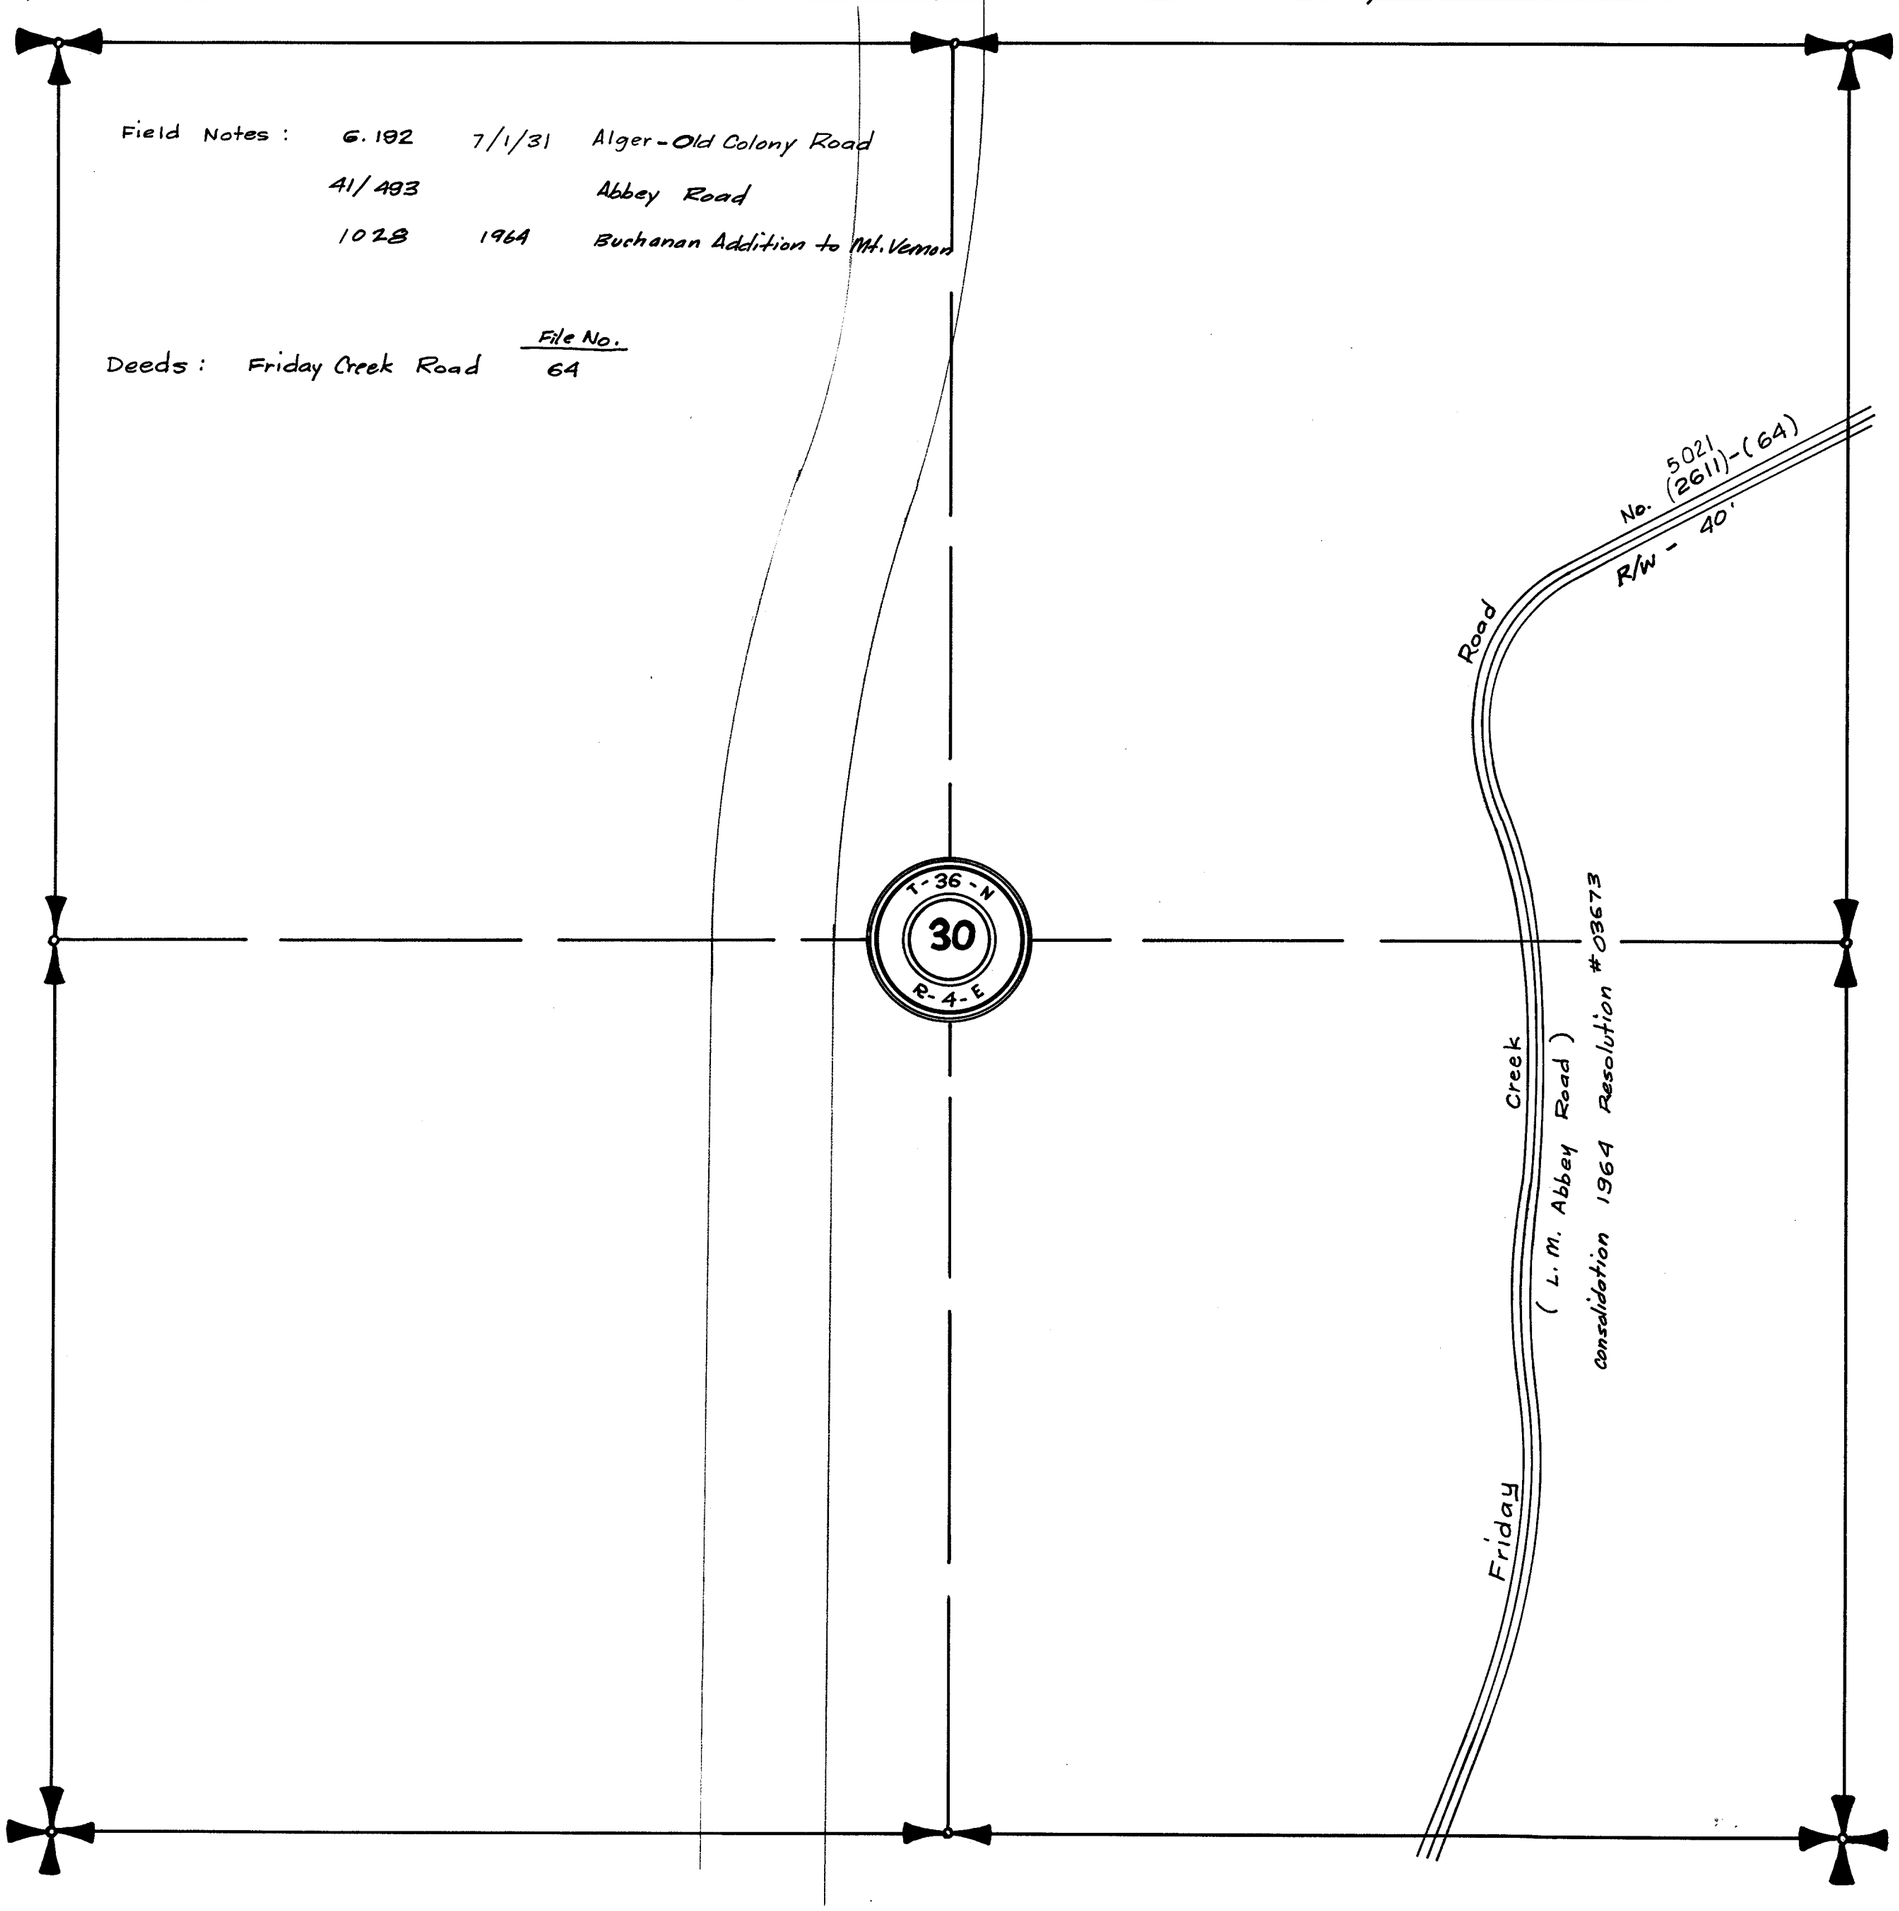


GEN. NOTATION : THIS TRACING DRAWN FROM AN AERIAL PHOTO.

SECTION 31

TOWNSHIP 36 NORTH, RANGE 4 EAST, W. M.
SKAGIT COUNTY, WASH.

SCALE. 1 INCH--400 FEET

W.A. COSTELLO
Notes: 38/371
COUNTY ENGINEER

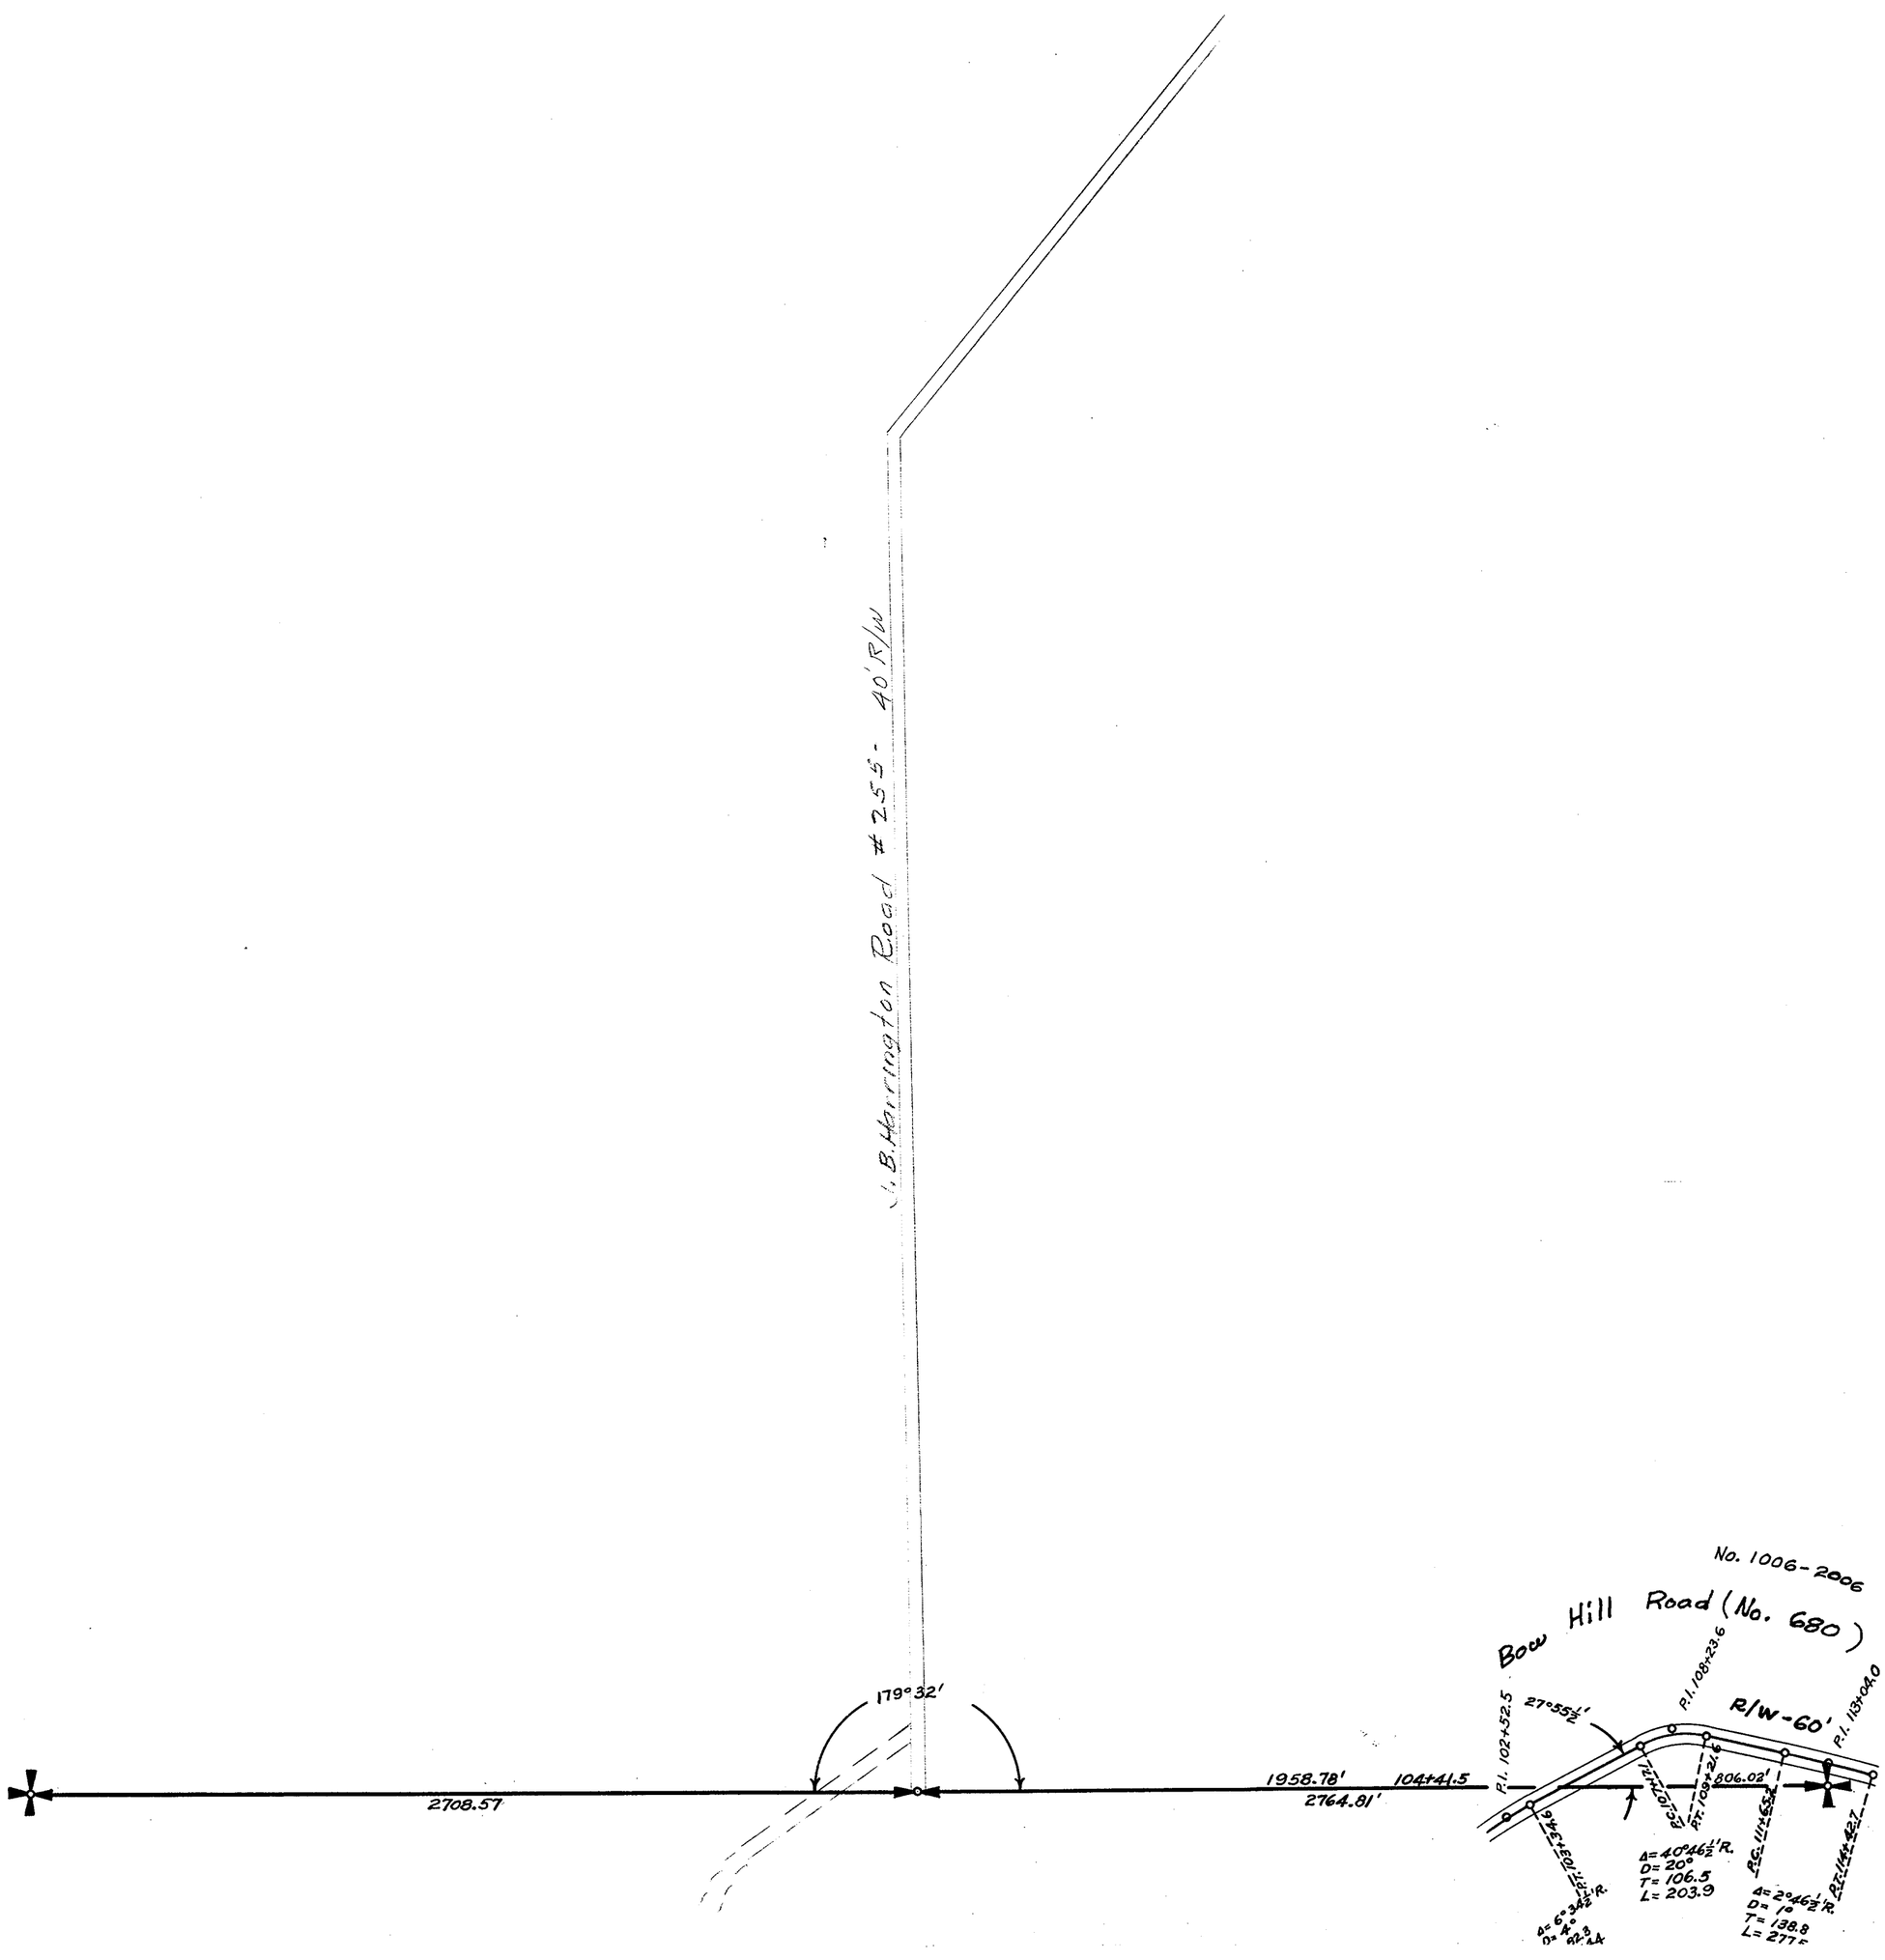


SECTION 31

TOWNSHIP 36 NORTH, RANGE 4 EAST, W. M.
SKAGIT COUNTY, WASH.

SCALE, 1 INCH–400 FEET

Arthur L. Strong COUNTY ENGINEER

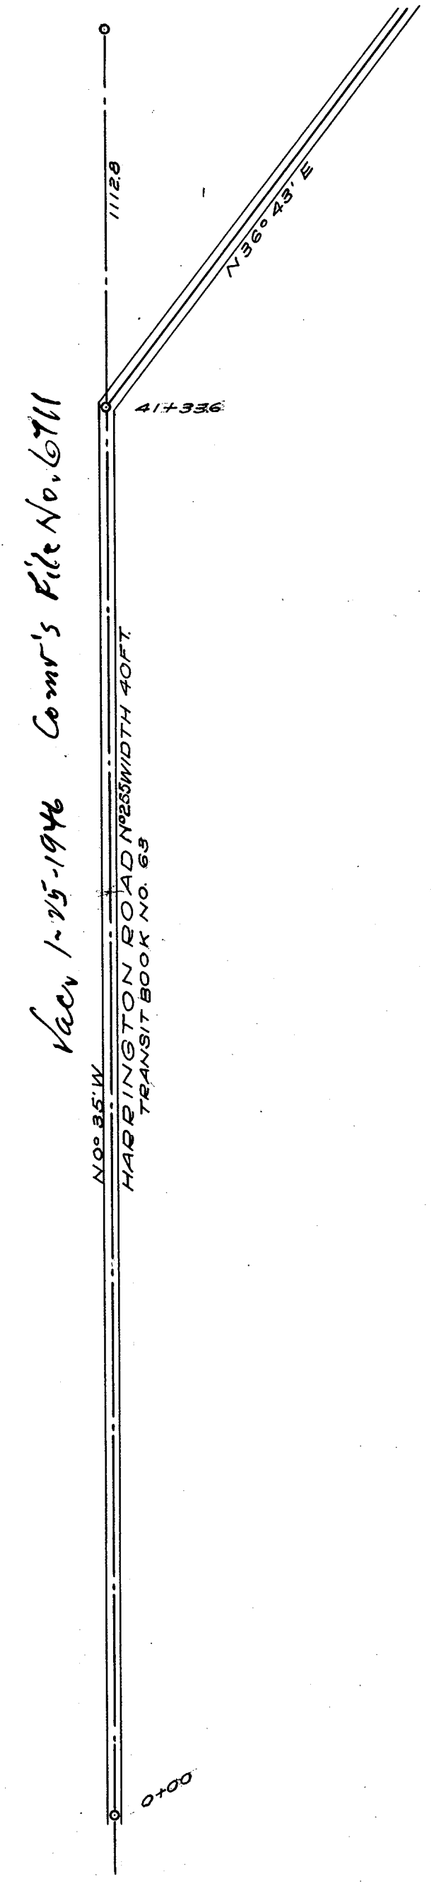


Drawn Aug. 1939 by AI
Notes: 38/371

SECTION 32

TOWNSHIP 36 NORTH, RANGE 4 EAST, W. M.
SKAGIT COUNTY, WASH.

SCALE, 1 INCH--400 FEET

W.A. COSTELLO COUNTY ENGINEER

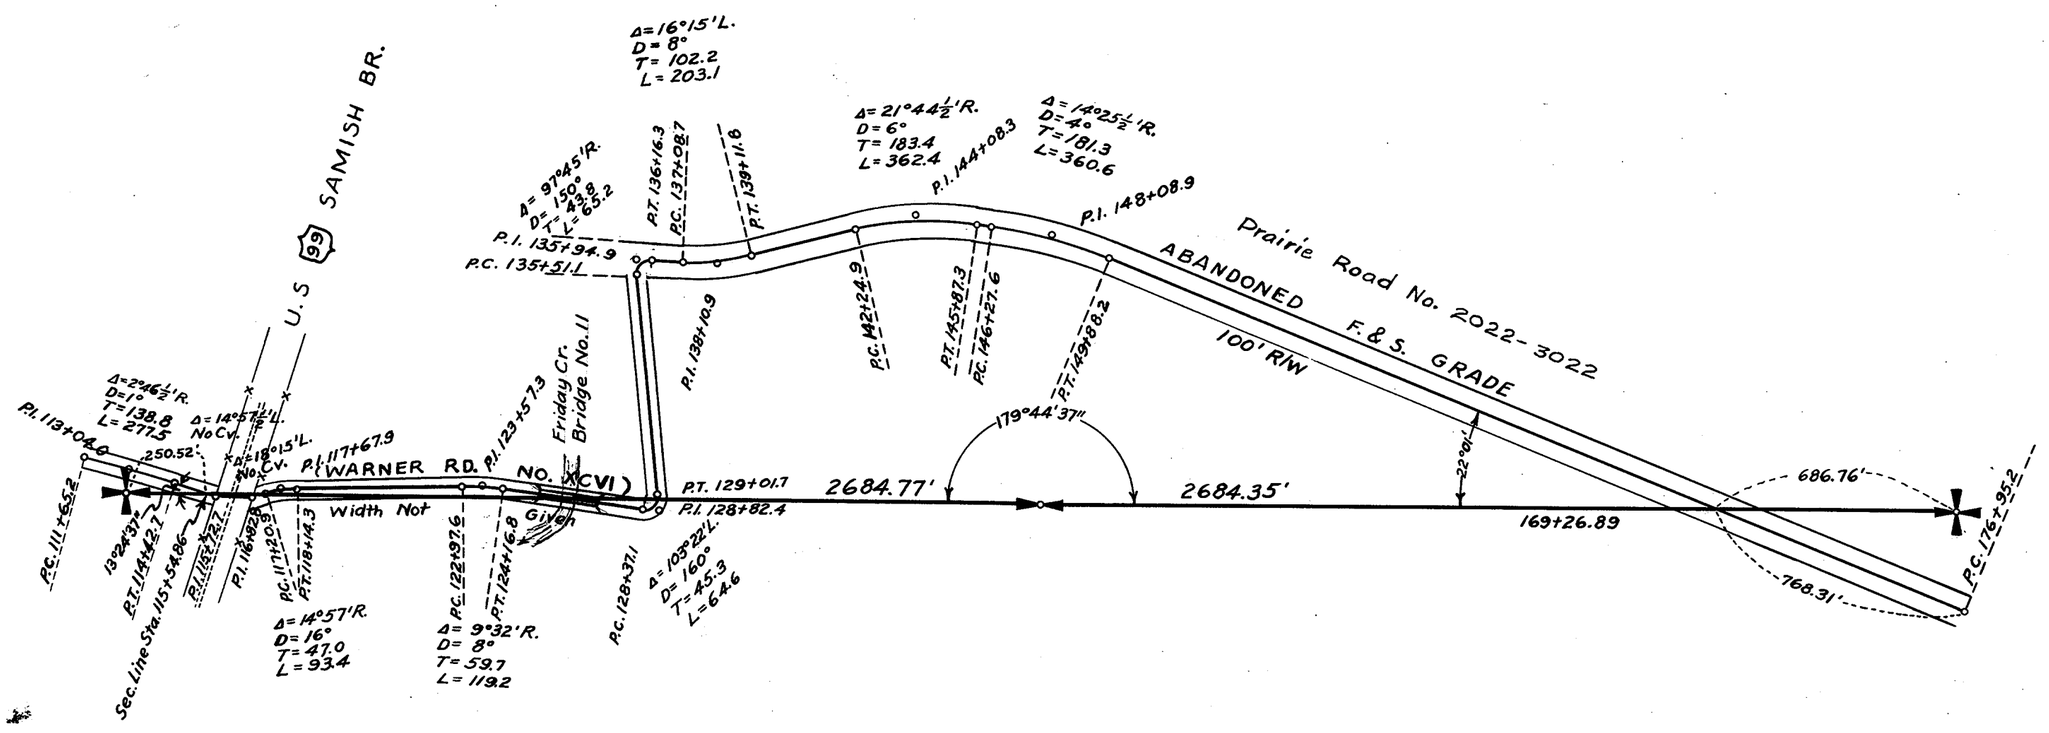

SECTION 32


TOWNSHIP 36 NORTH. RANGE 4 EAST. W. M.

SKAGIT COUNTY. WASH.

SCALE. 1 INCH—400 FEET

DATE 1951 & 1975 Revision

Lloyd Johnson COUNTY ENGINEER

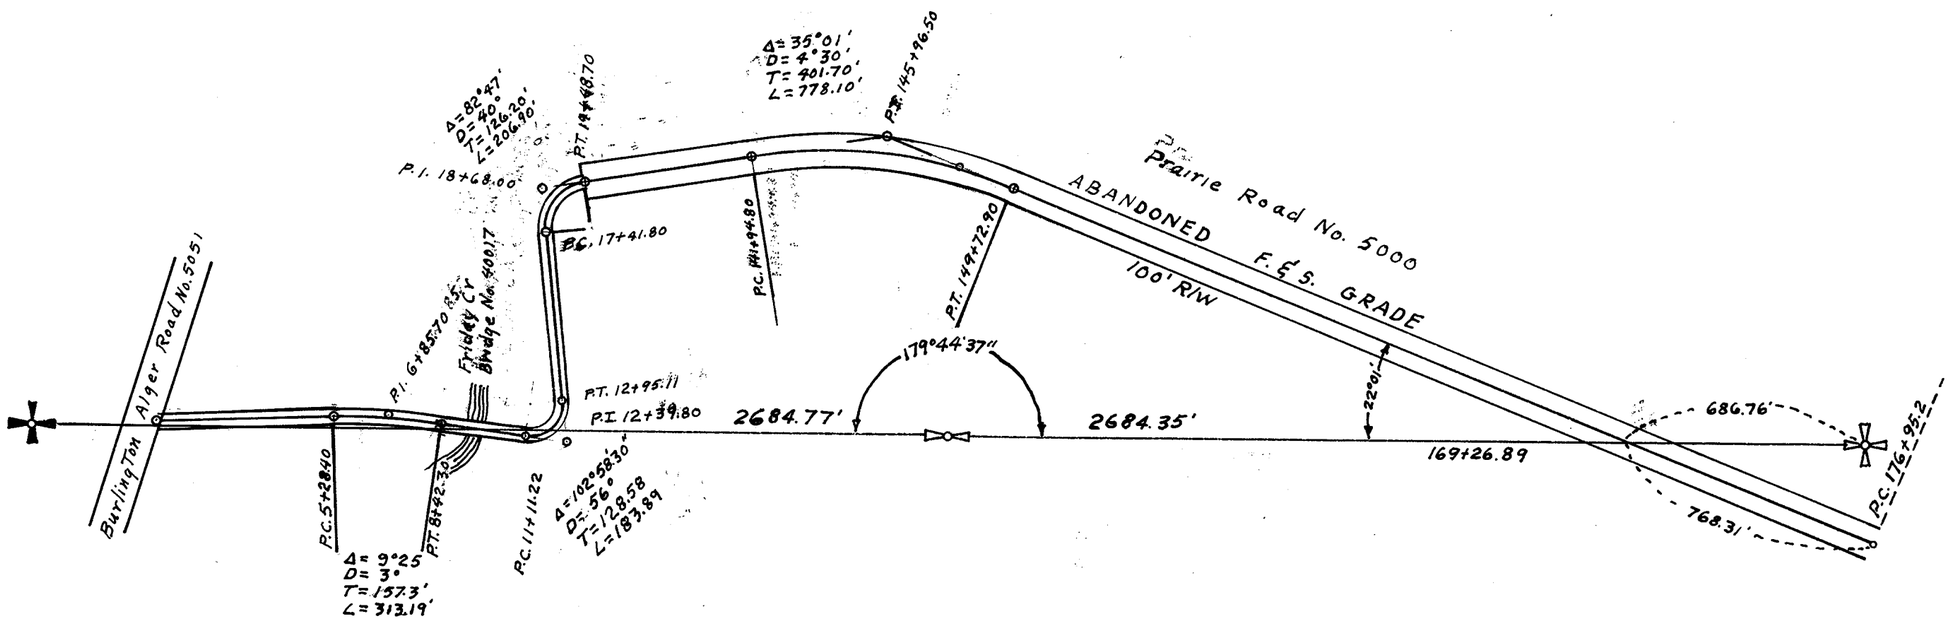

SECTION 32

TOWNSHIP 36 NORTH, RANGE 4 EAST, W. M.

SKAGIT COUNTY, WASH.

SCALE, 1 INCH--400 FEET


DATE August, 1865

Lloyd Johnson COUNTY ENGINEER

Field Notes :

Road Papers :

Name	Deed File #
Prairie	30
Bow Hill	30

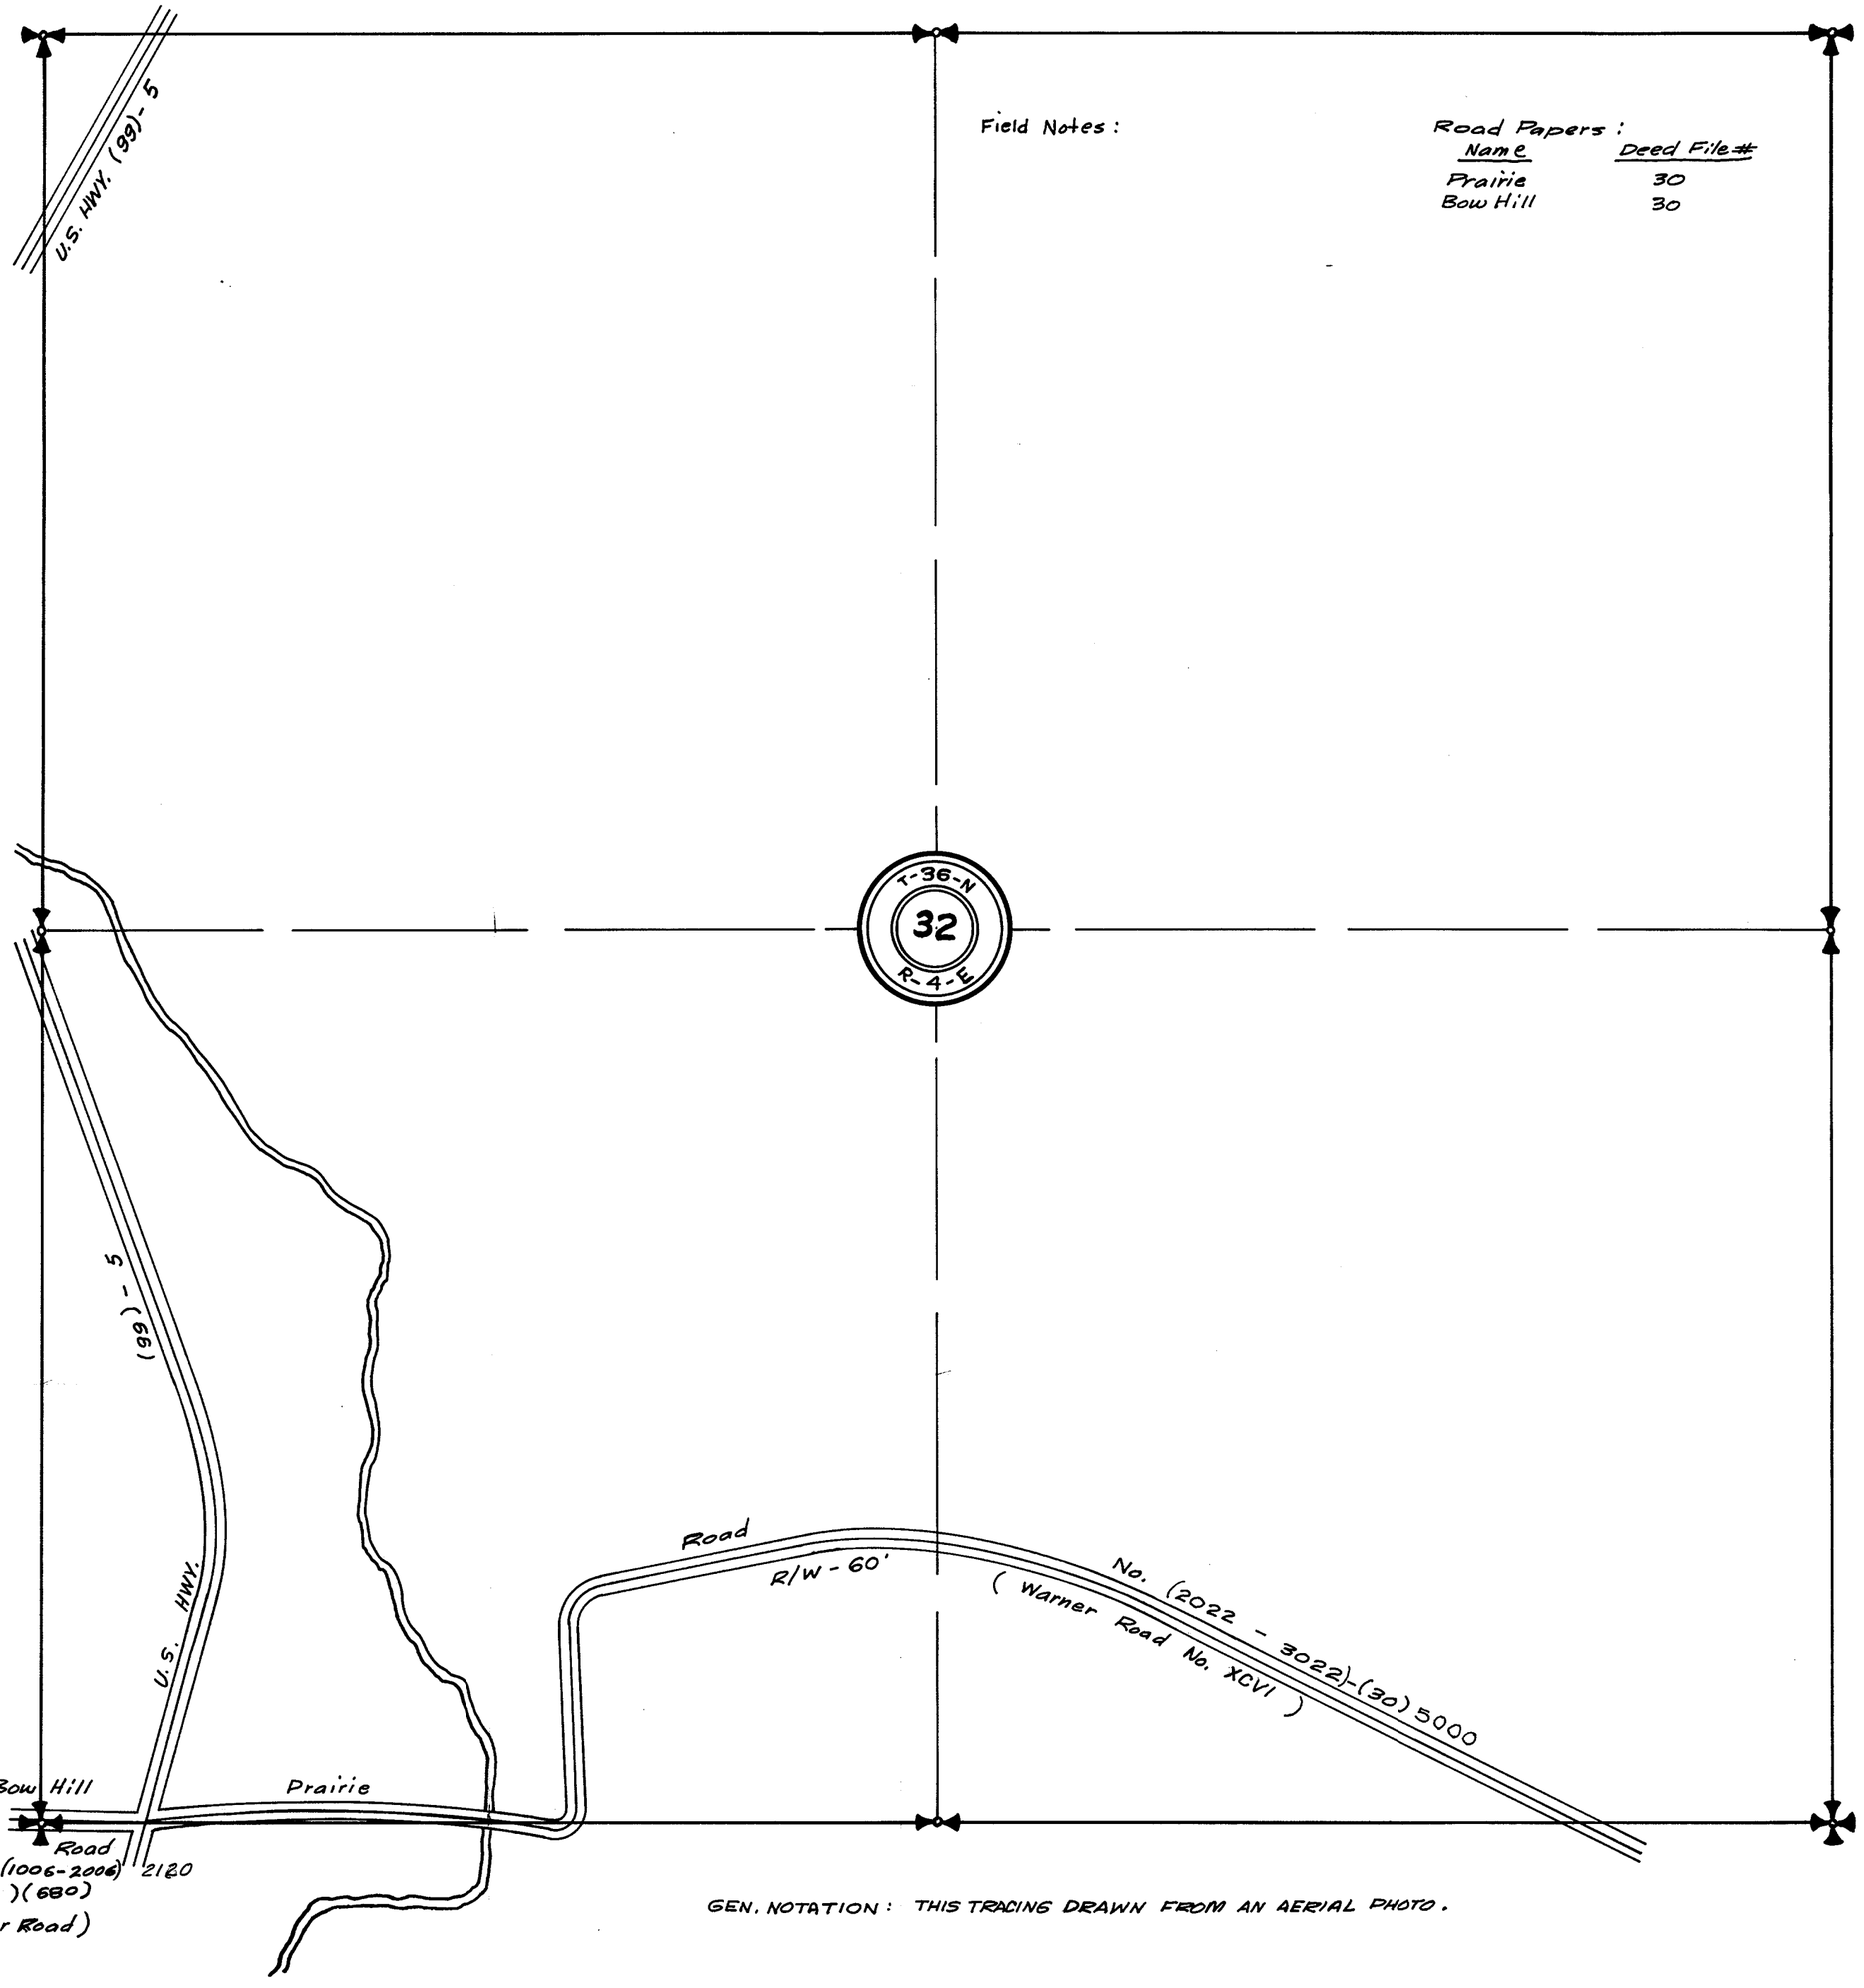

GEN. NOTATION : THIS TRACING DRAWN FROM AN AERIAL PHOTO.


SECTION 32

TOWNSHIP 36 NORTH, RANGE 4 EAST, W. M.

SKAGIT COUNTY, WASH.

SCALE, 1 INCH--500 FEET

DATE _____ _____ COUNTY ENGINEER

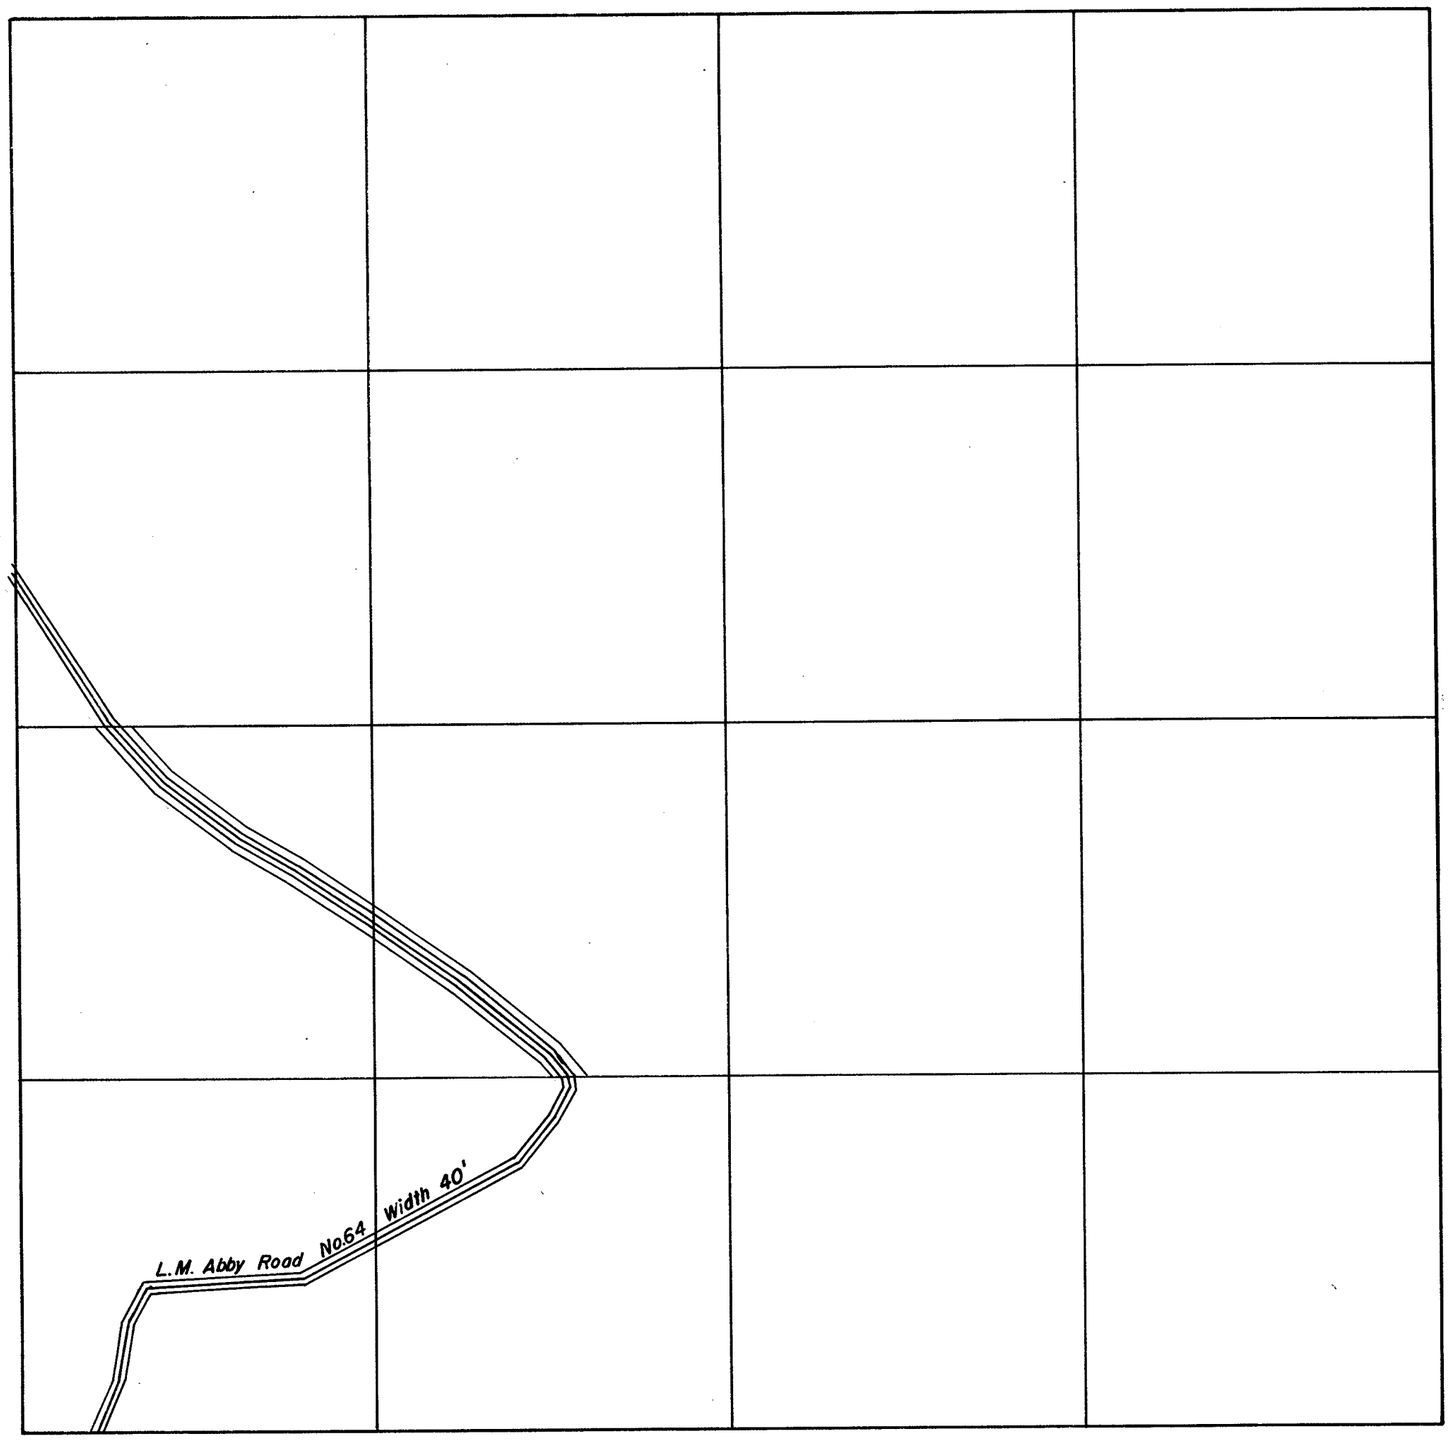

SECTION 33

TOWNSHIP 36 NORTH, RANGE 4 EAST, W. M.

SKAGIT COUNTY, WASH.

SCALE, 1 INCH--400 FEET


DATE August 1965

Lloyd Johnson COUNTY ENGINEER

Field Notes :

Road File No.

Deeds: W. Mathews Rd #30 30 - (Prairie Rd)
2022-3022

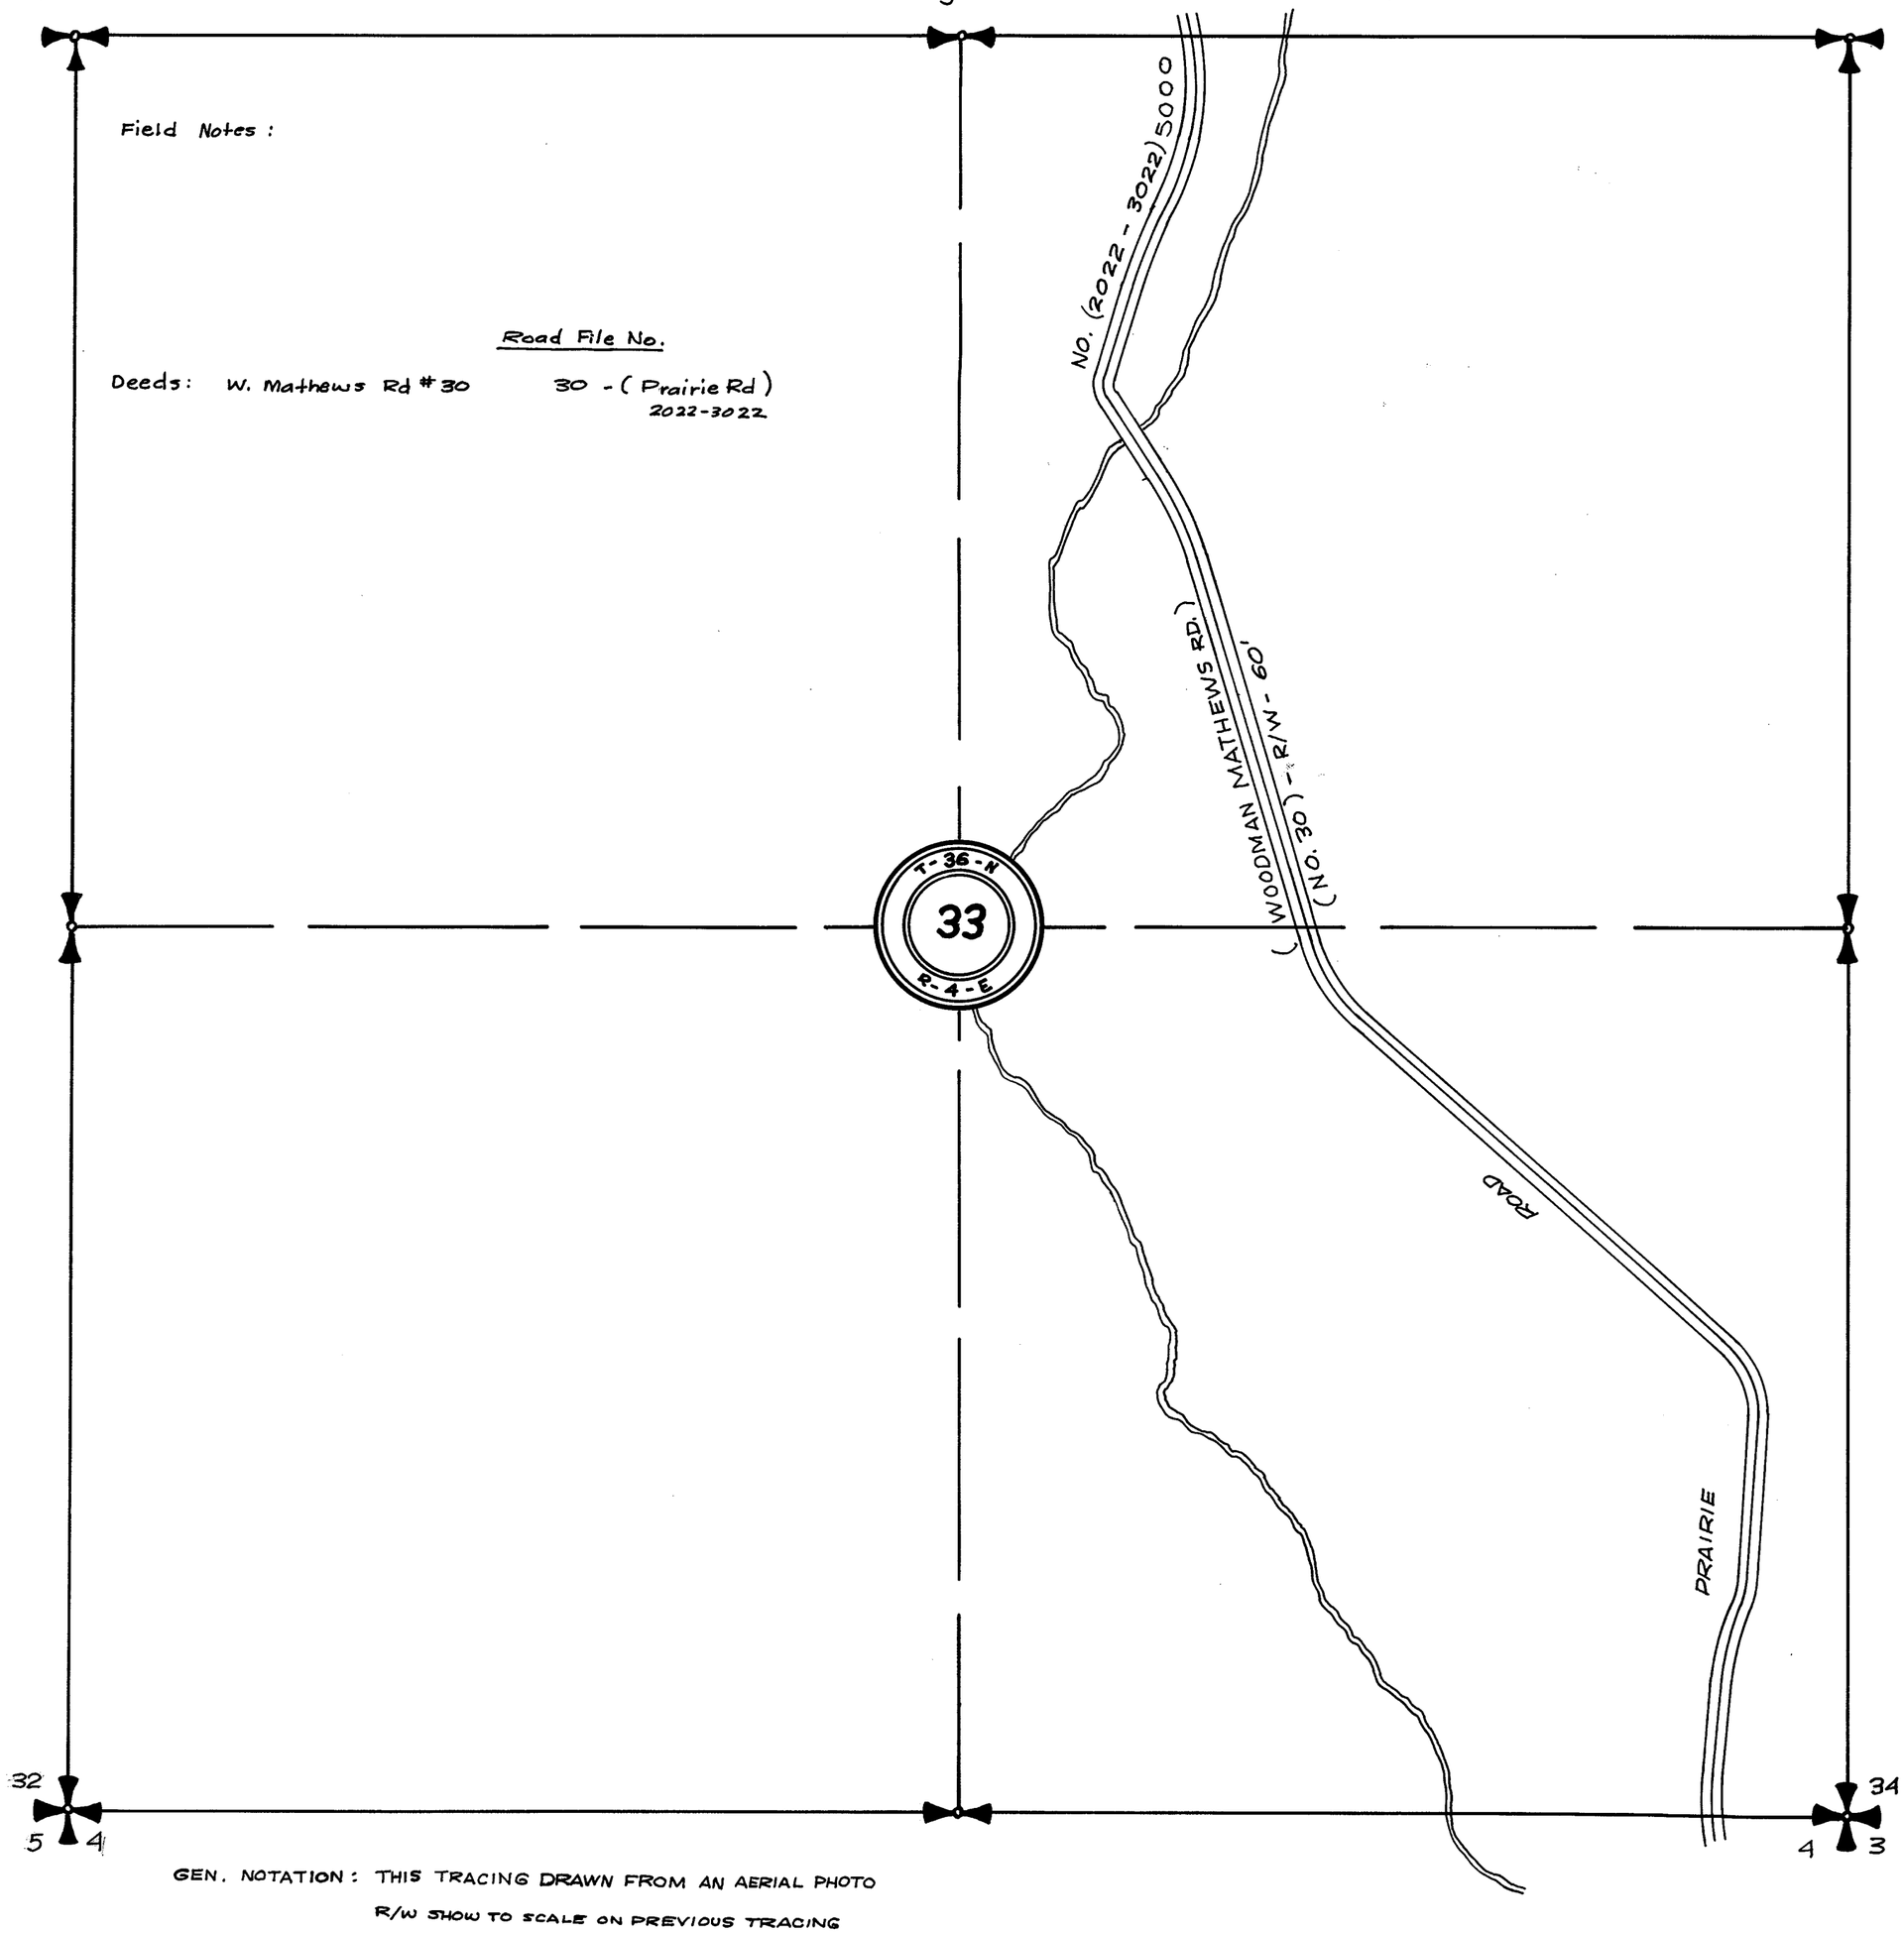

GEN. NOTATION: THIS TRACING DRAWN FROM AN AERIAL PHOTO

R/W SHOW TO SCALE ON PREVIOUS TRACING

SUB-DIVISION INFORMATION TAKEN FROM PREVIOUS TRACING

SECTION 33


TOWNSHIP 36 NORTH, RANGE 4 EAST, W. M.

SKAGIT COUNTY, WASH.

SCALE, 1 INCH--400 FEET

W. A. COSTELLO COUNTY ENGINEER

Platted Aug. 1939 by AH
Notes: 38/371

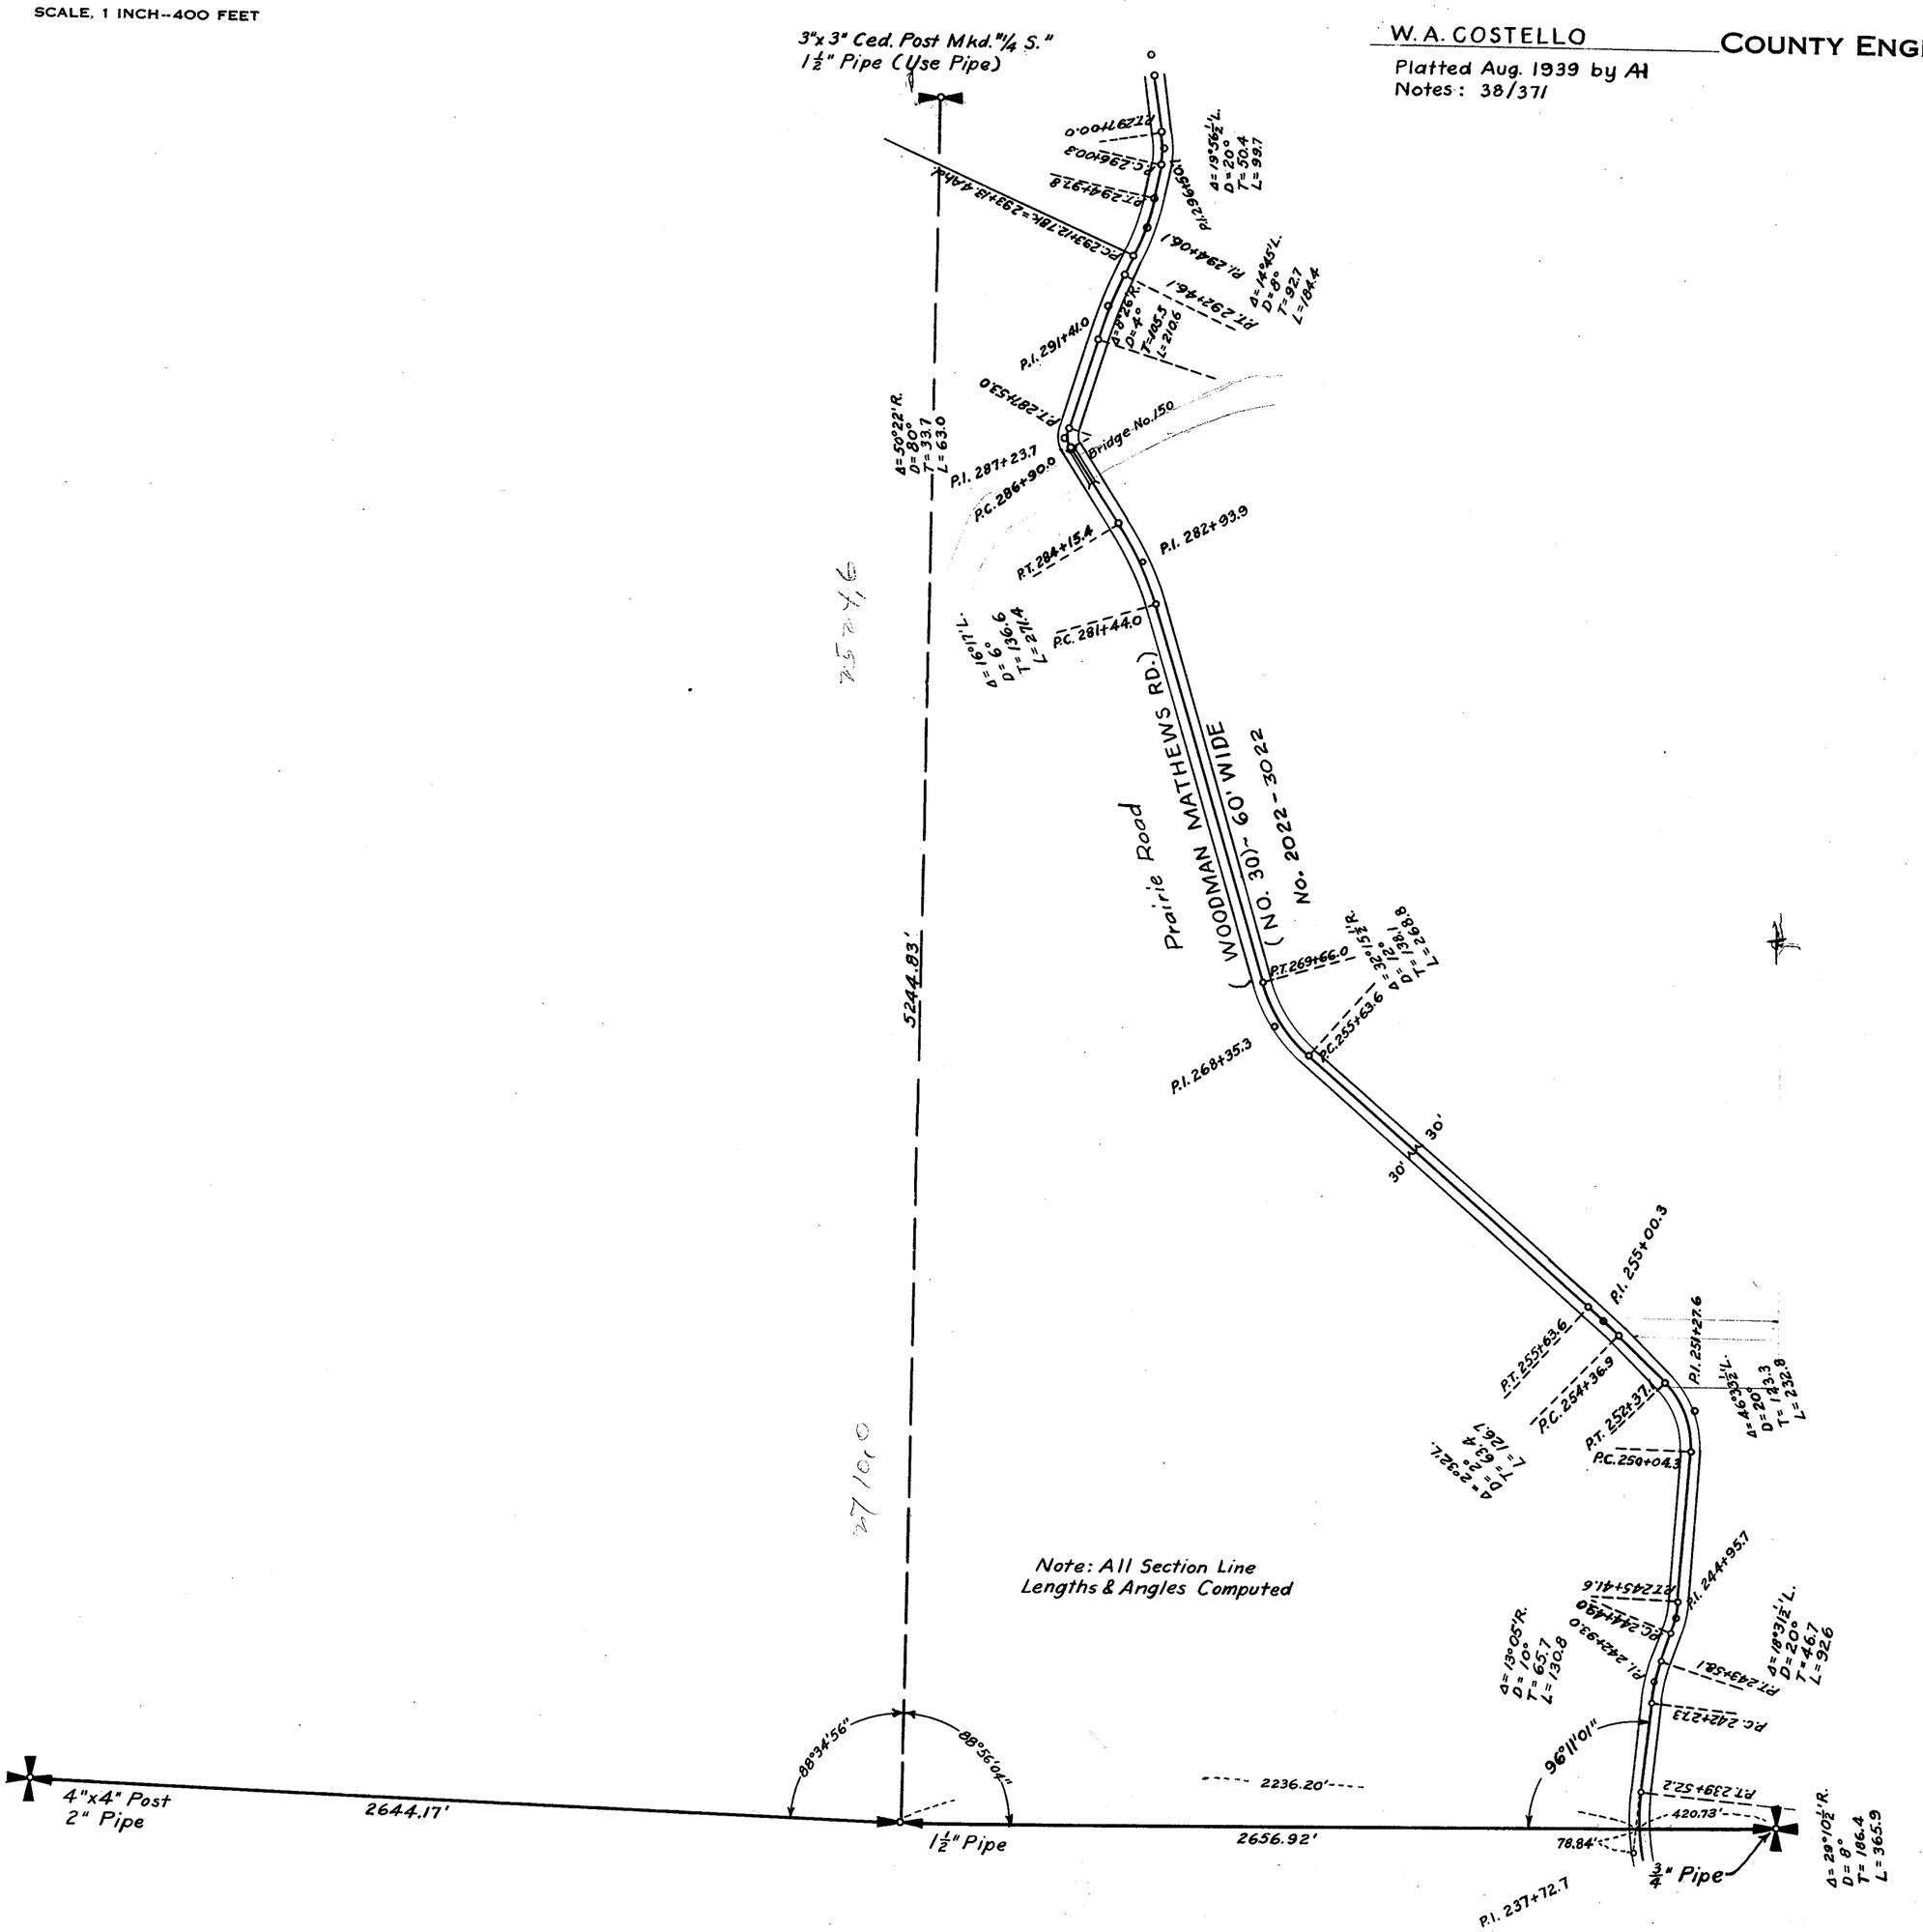


SECTION 33

TOWNSHIP 36 NORTH, RANGE 4 EAST, W. M.
SKAGIT COUNTY, WASH.

SCALE, 1 INCH–400 FEET

W.E. COSTELLO, COUNTY ENGINEER

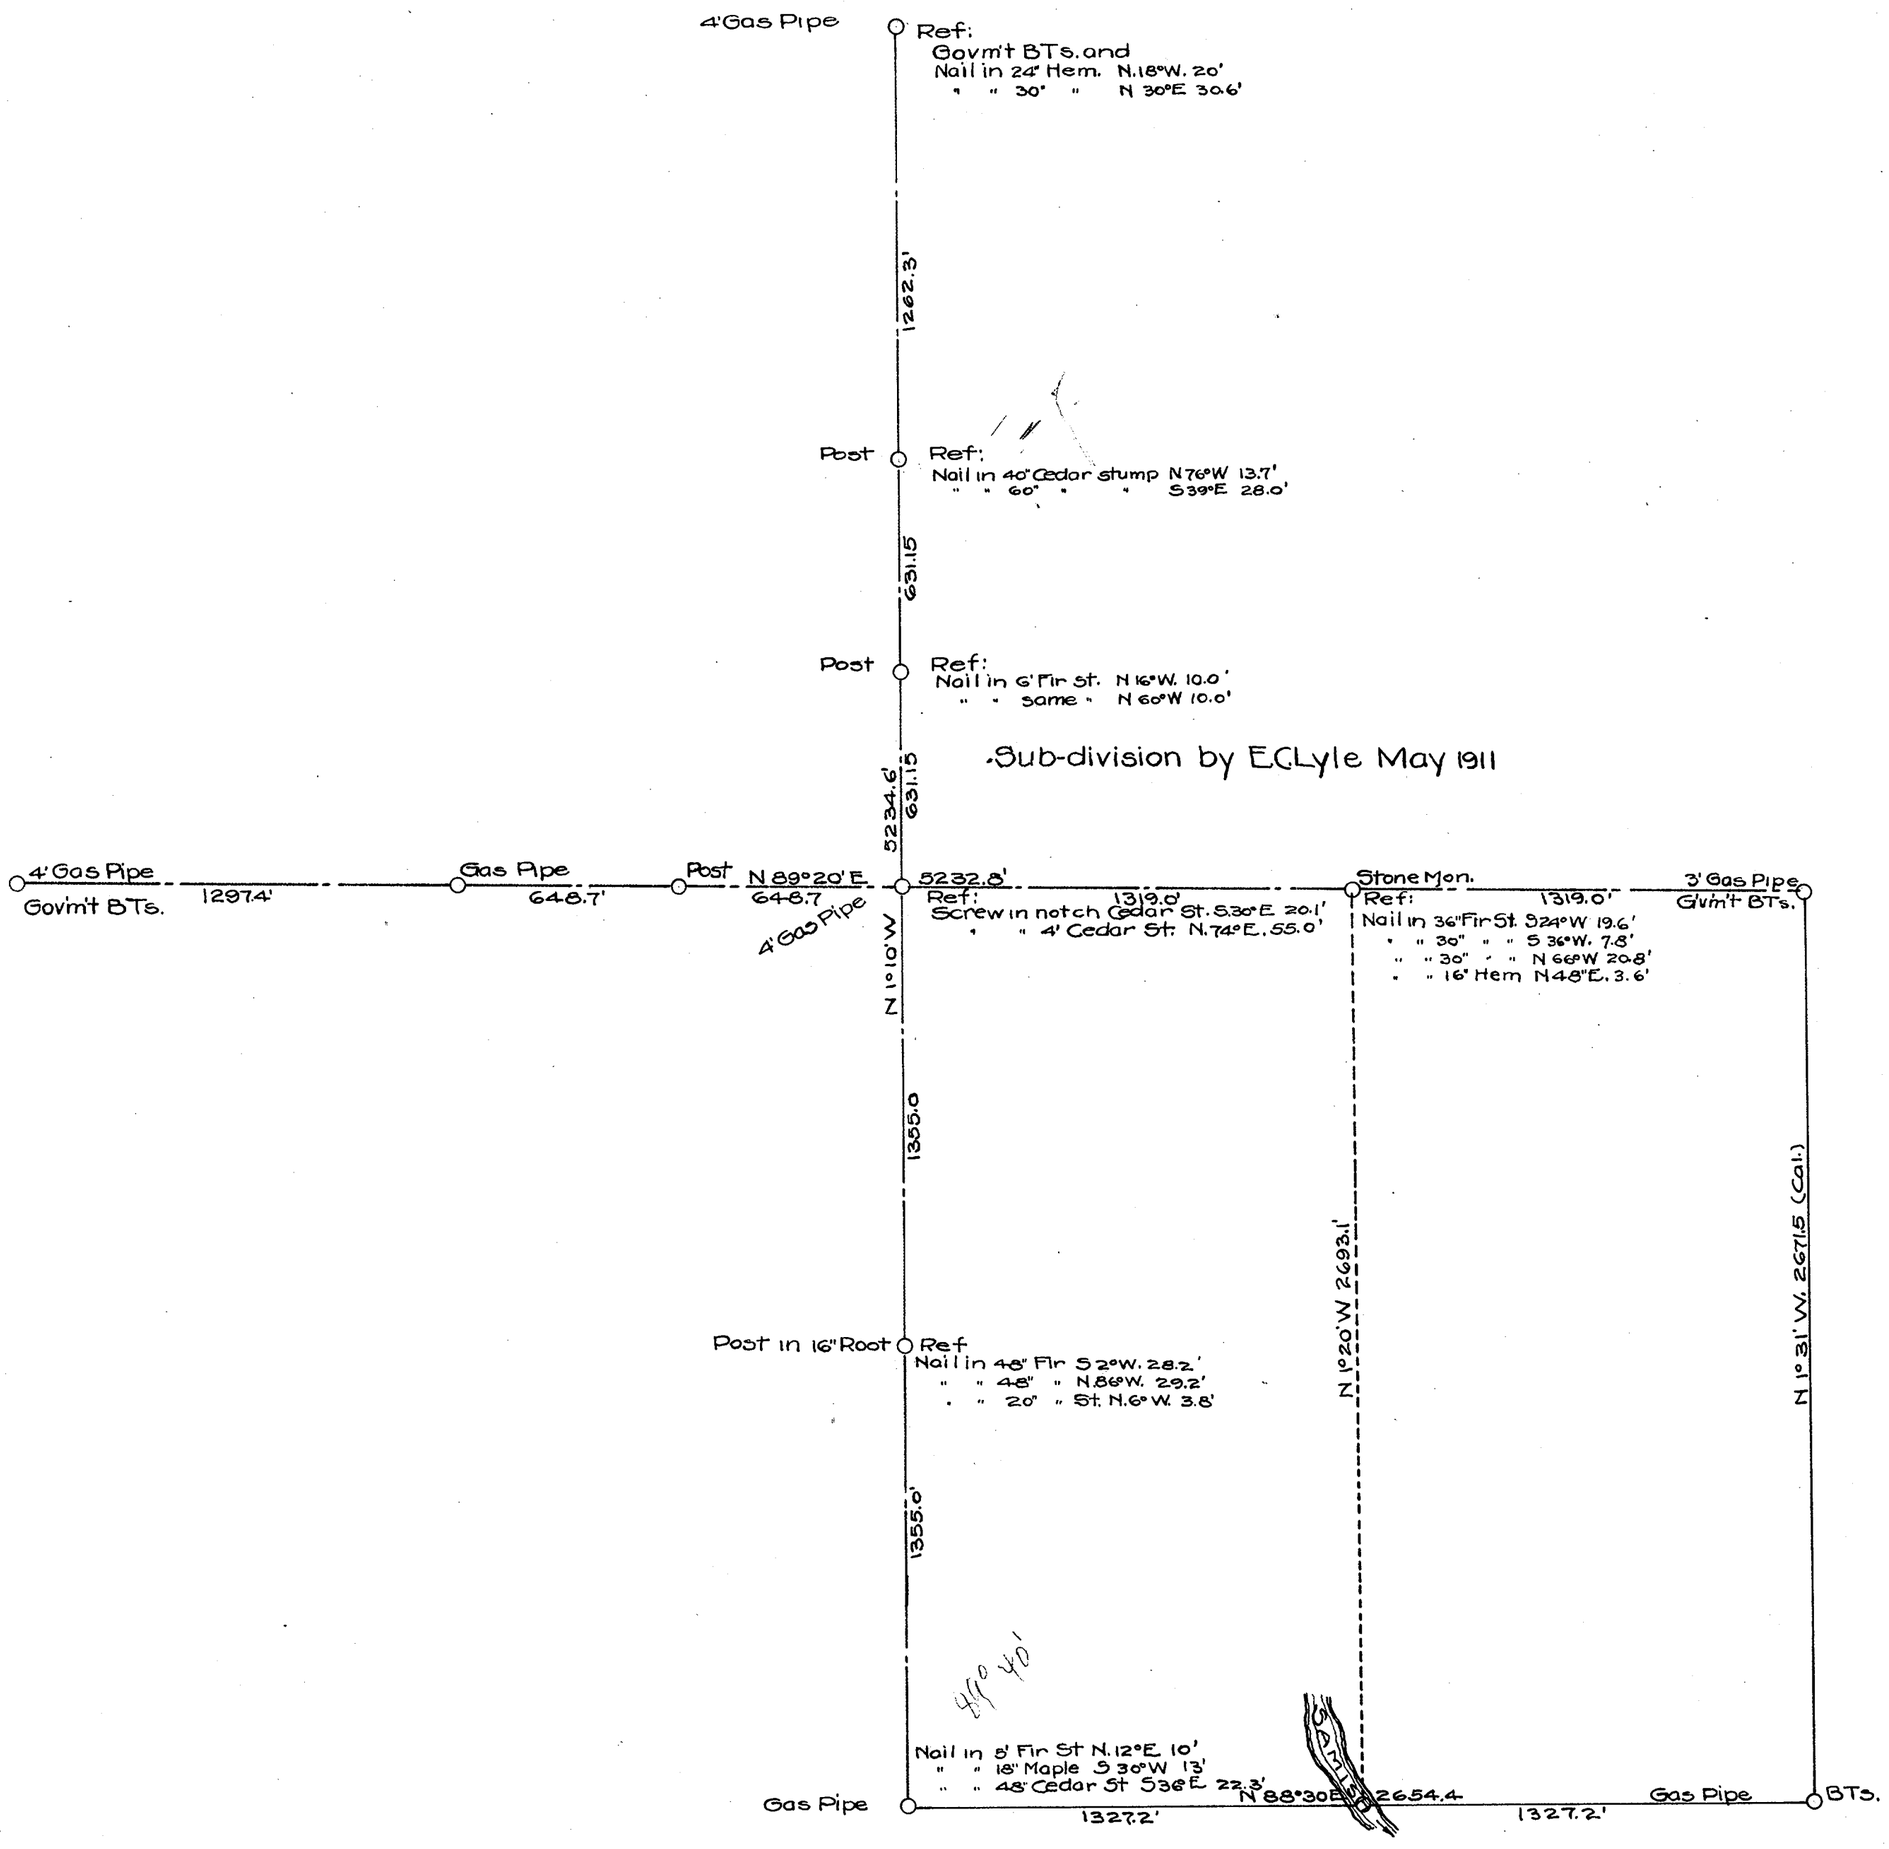


SECTION 34

TOWNSHIP 36 NORTH, RANGE 4 EAST, W. M.

SKAGIT COUNTY, WASH.

SCALE, 1 INCH–400 FEET

A. L. STRONG COUNTY ENGINEER

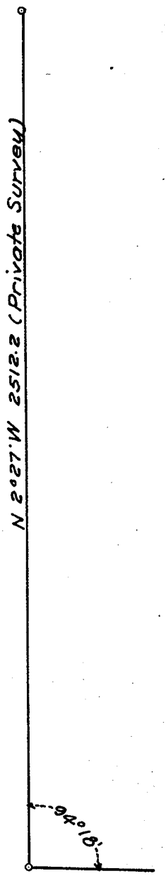


SECTION 35

TOWNSHIP 36 NORTH, RANGE 4 EAST, W. M.
SKAGIT COUNTY, WASH.

SCALE, 1 INCH–400 FEET

A. L. STRONG COUNTY ENGINEER

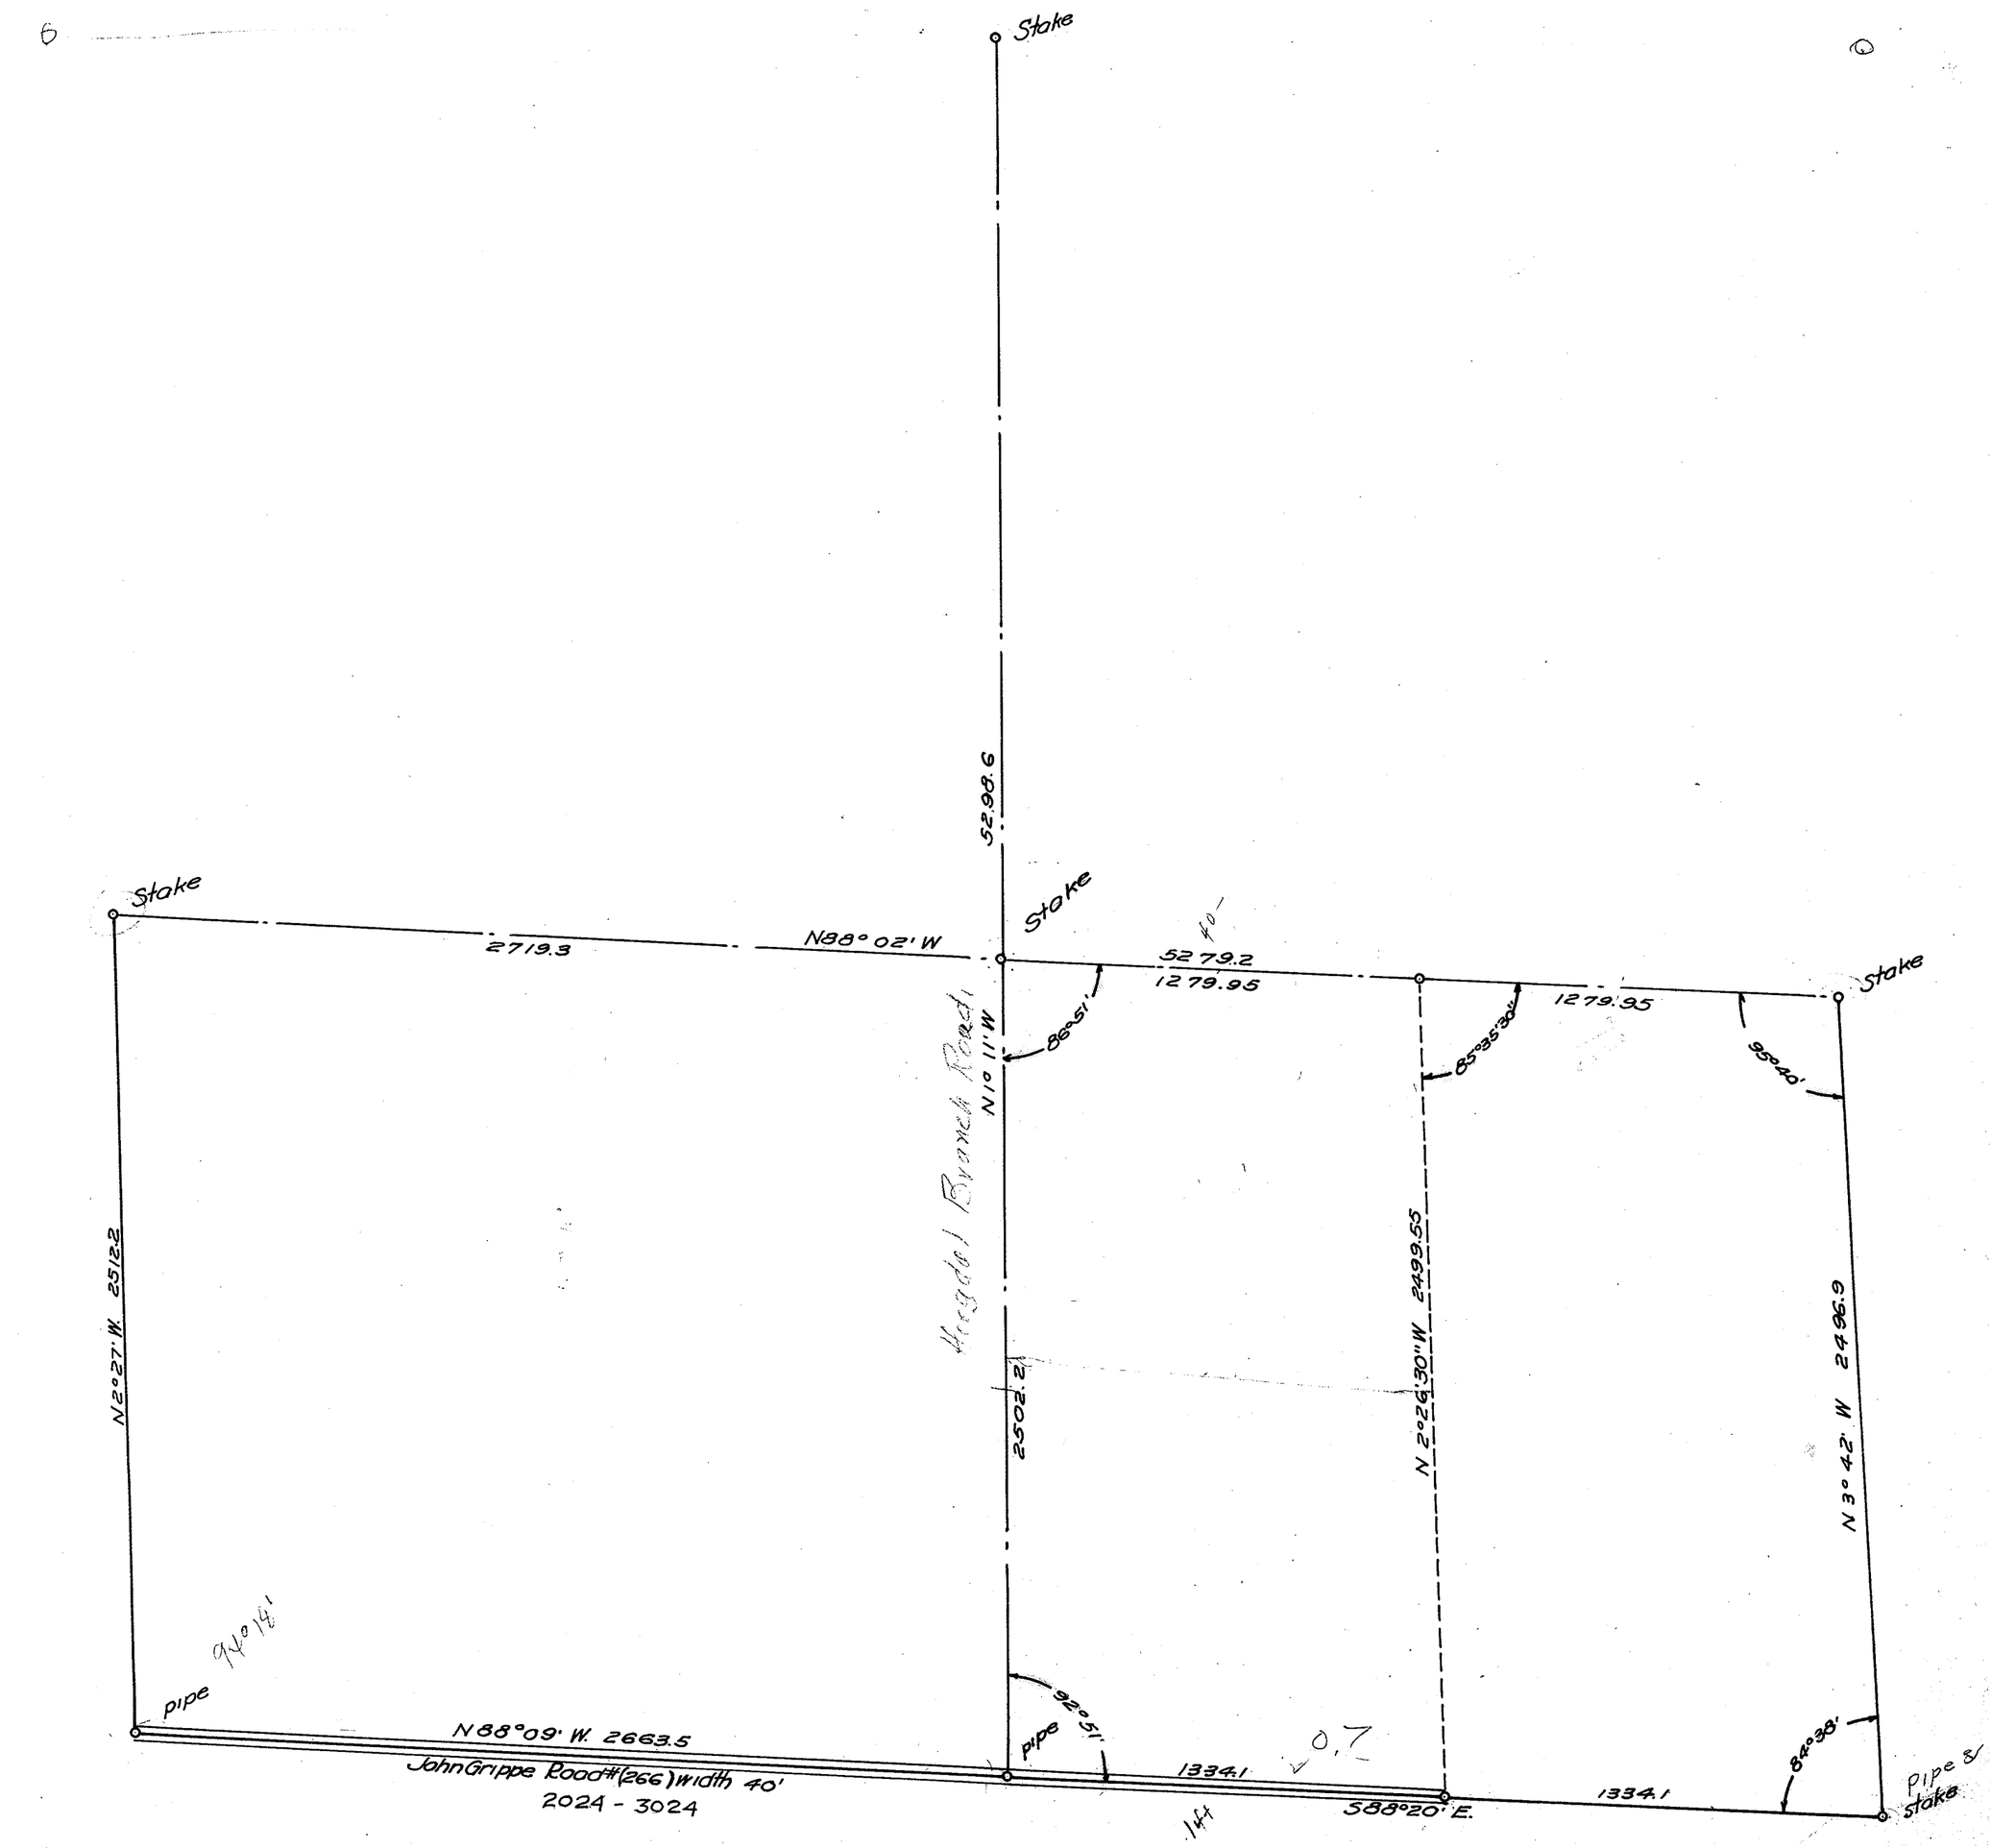


SECTION 35

TOWNSHIP 36 NORTH, RANGE 4 EAST, W. M.

SKAGIT COUNTY, WASH.

SCALE, 1 INCH--400 FEET

DATE _____ _____ COUNTY ENGINEER

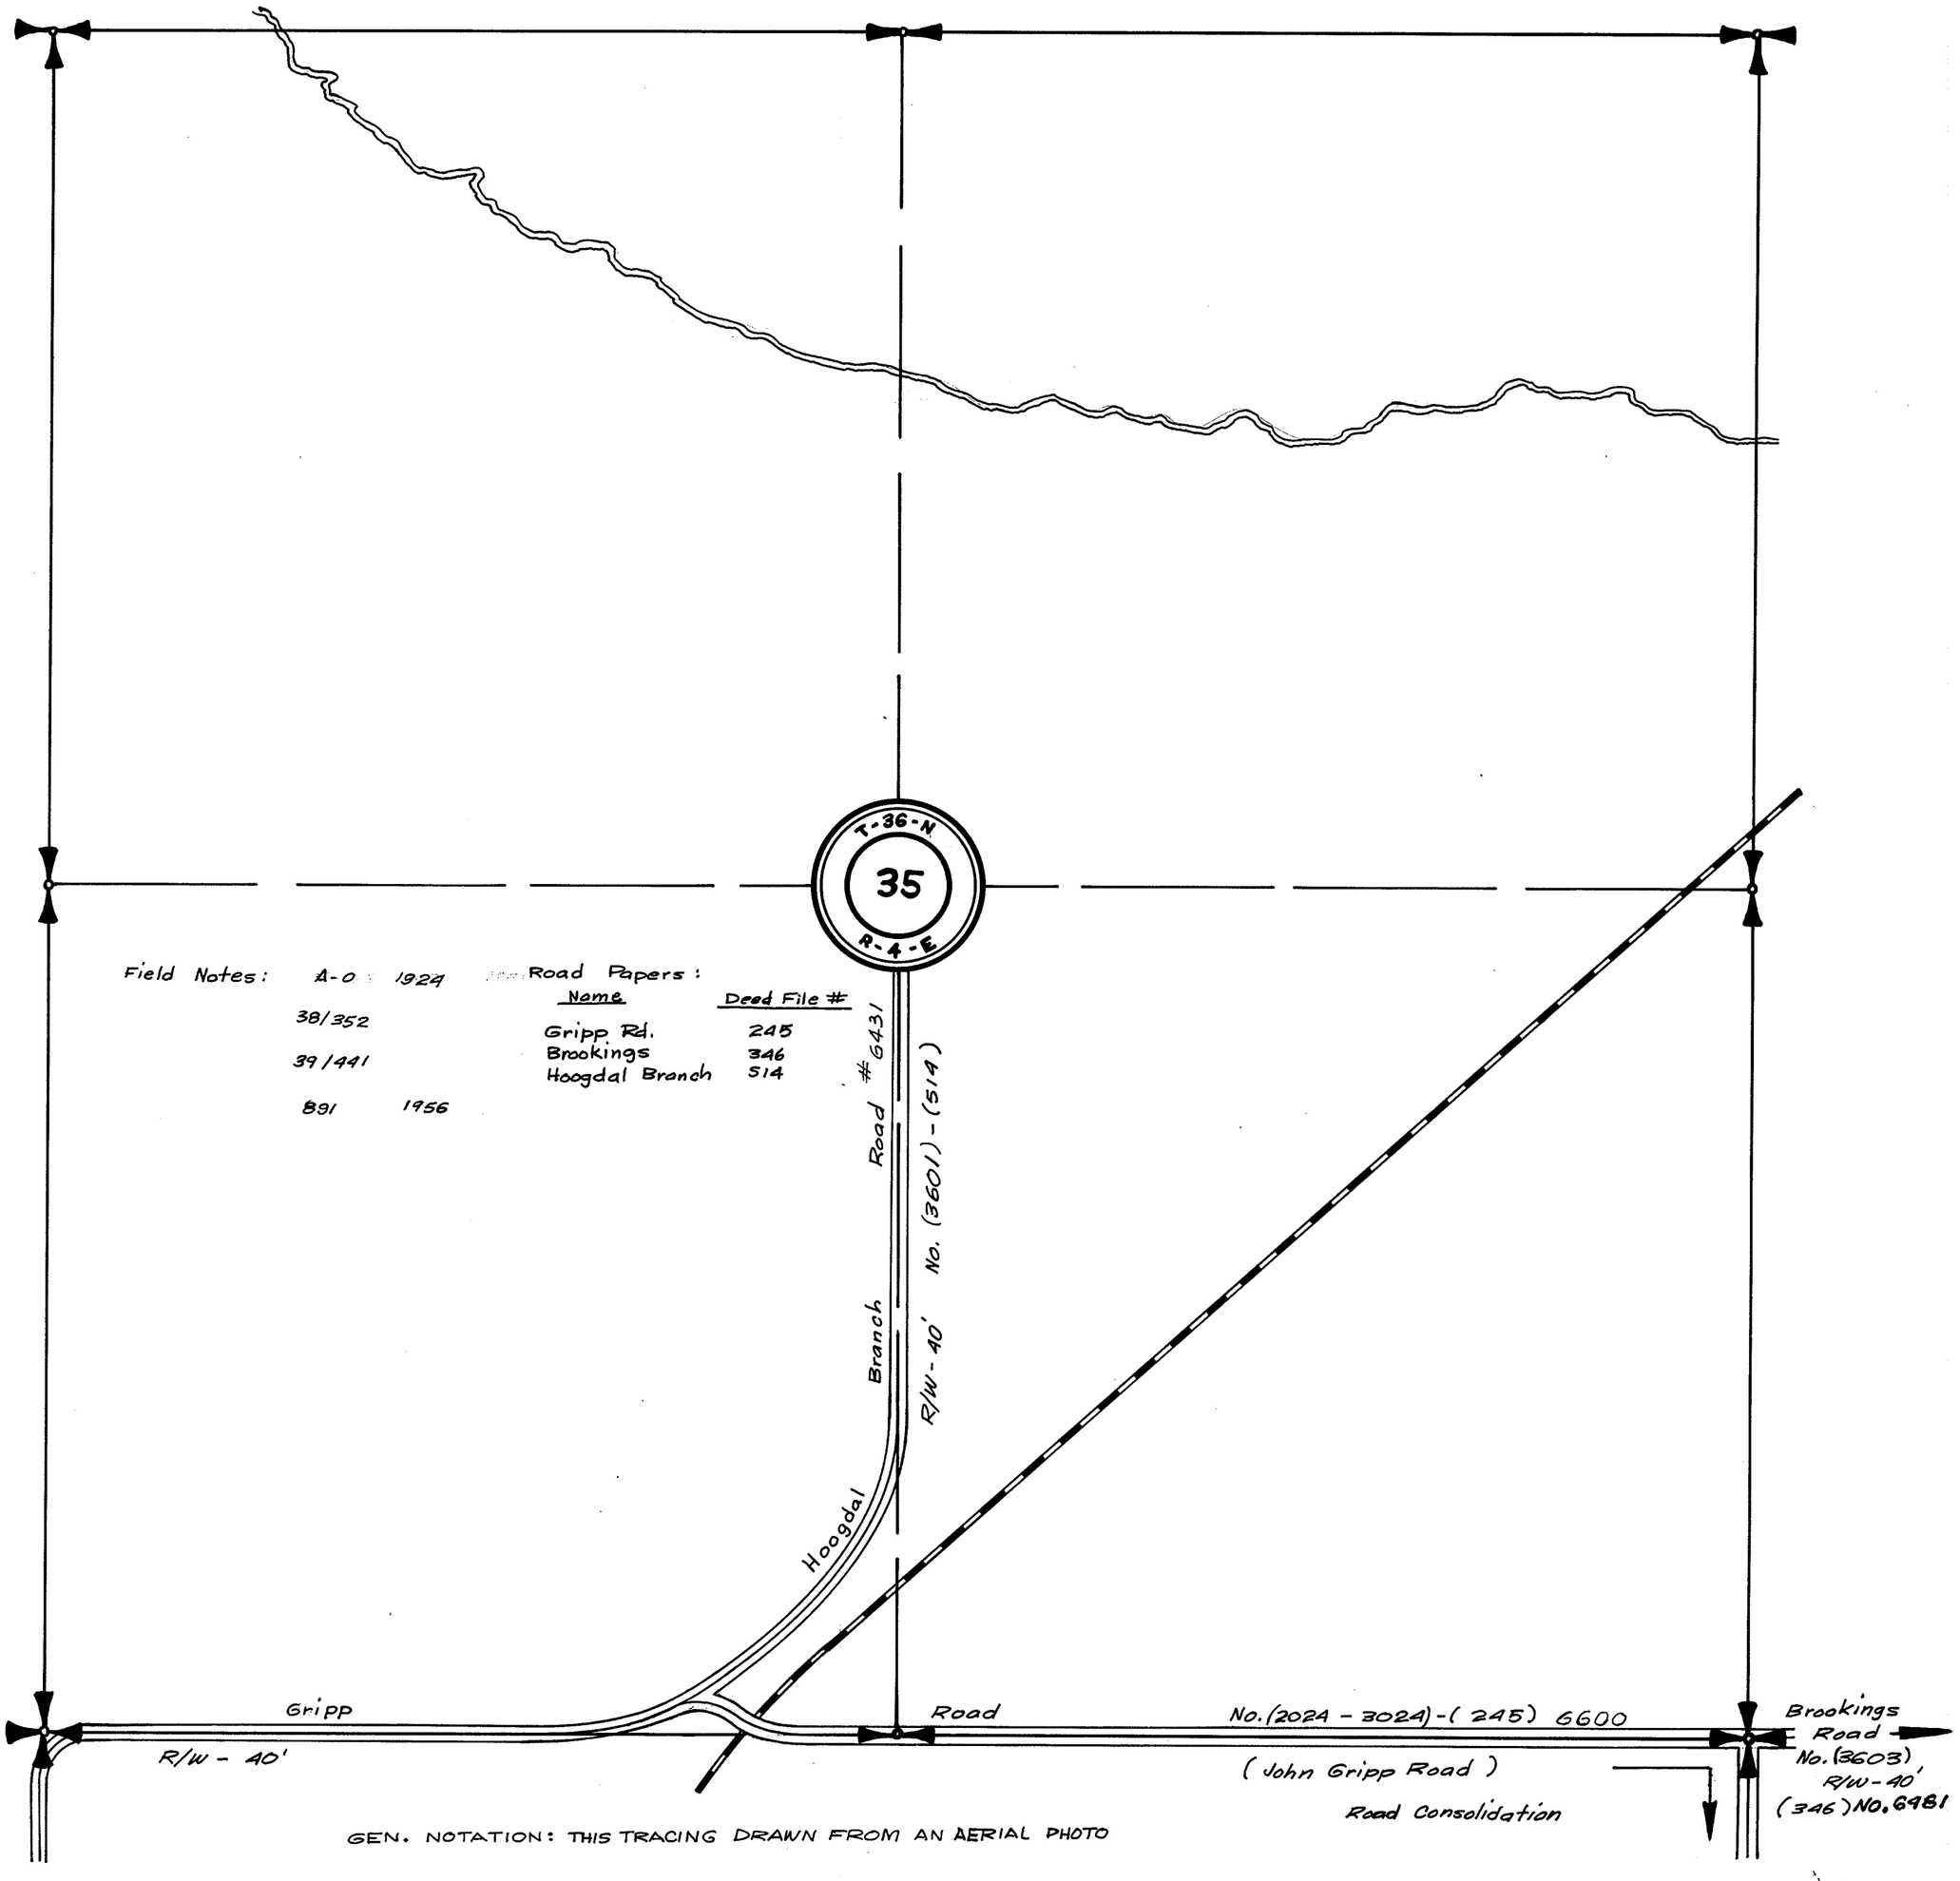

Field Notes: A-0 1924 38/352 39/441 891 1956

Road Papers:

Name	Deed File #
Gripp Rd.	245
Brookings	346
Hoogdal Branch	514


GEN. NOTATION: THIS TRACING DRAWN FROM AN AERIAL PHOTO

SECTION 36

TOWNSHIP 36 NORTH, RANGE 4 EAST, W. M.
SKAGIT COUNTY, WASH.

SCALE, 1 INCH–400 FEET

A. L. STRONG COUNTY ENGINEER

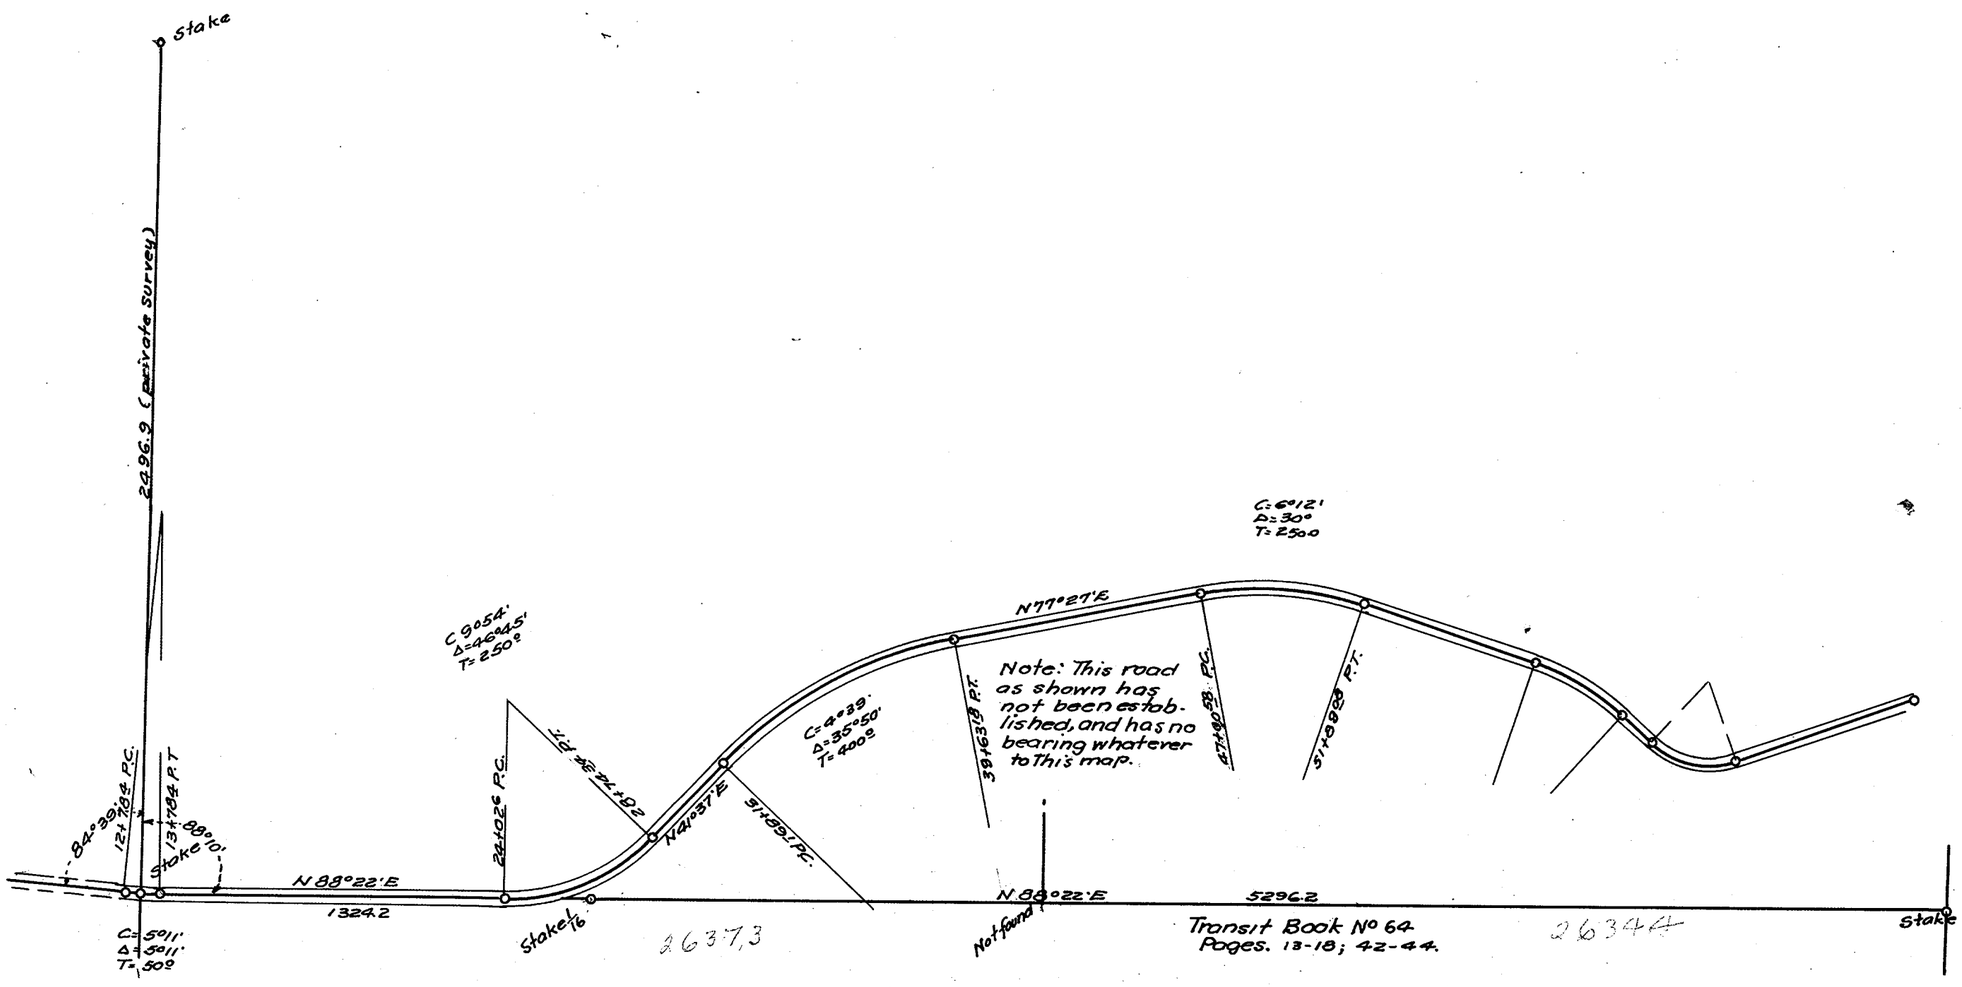


SECTION 36

TOWNSHIP 36 NORTH, RANGE 4 EAST, W. M.

SKAGIT COUNTY, WASH.

SCALE, 1 INCH--400 FEET

H.O. Walberg COUNTY ENGINEER

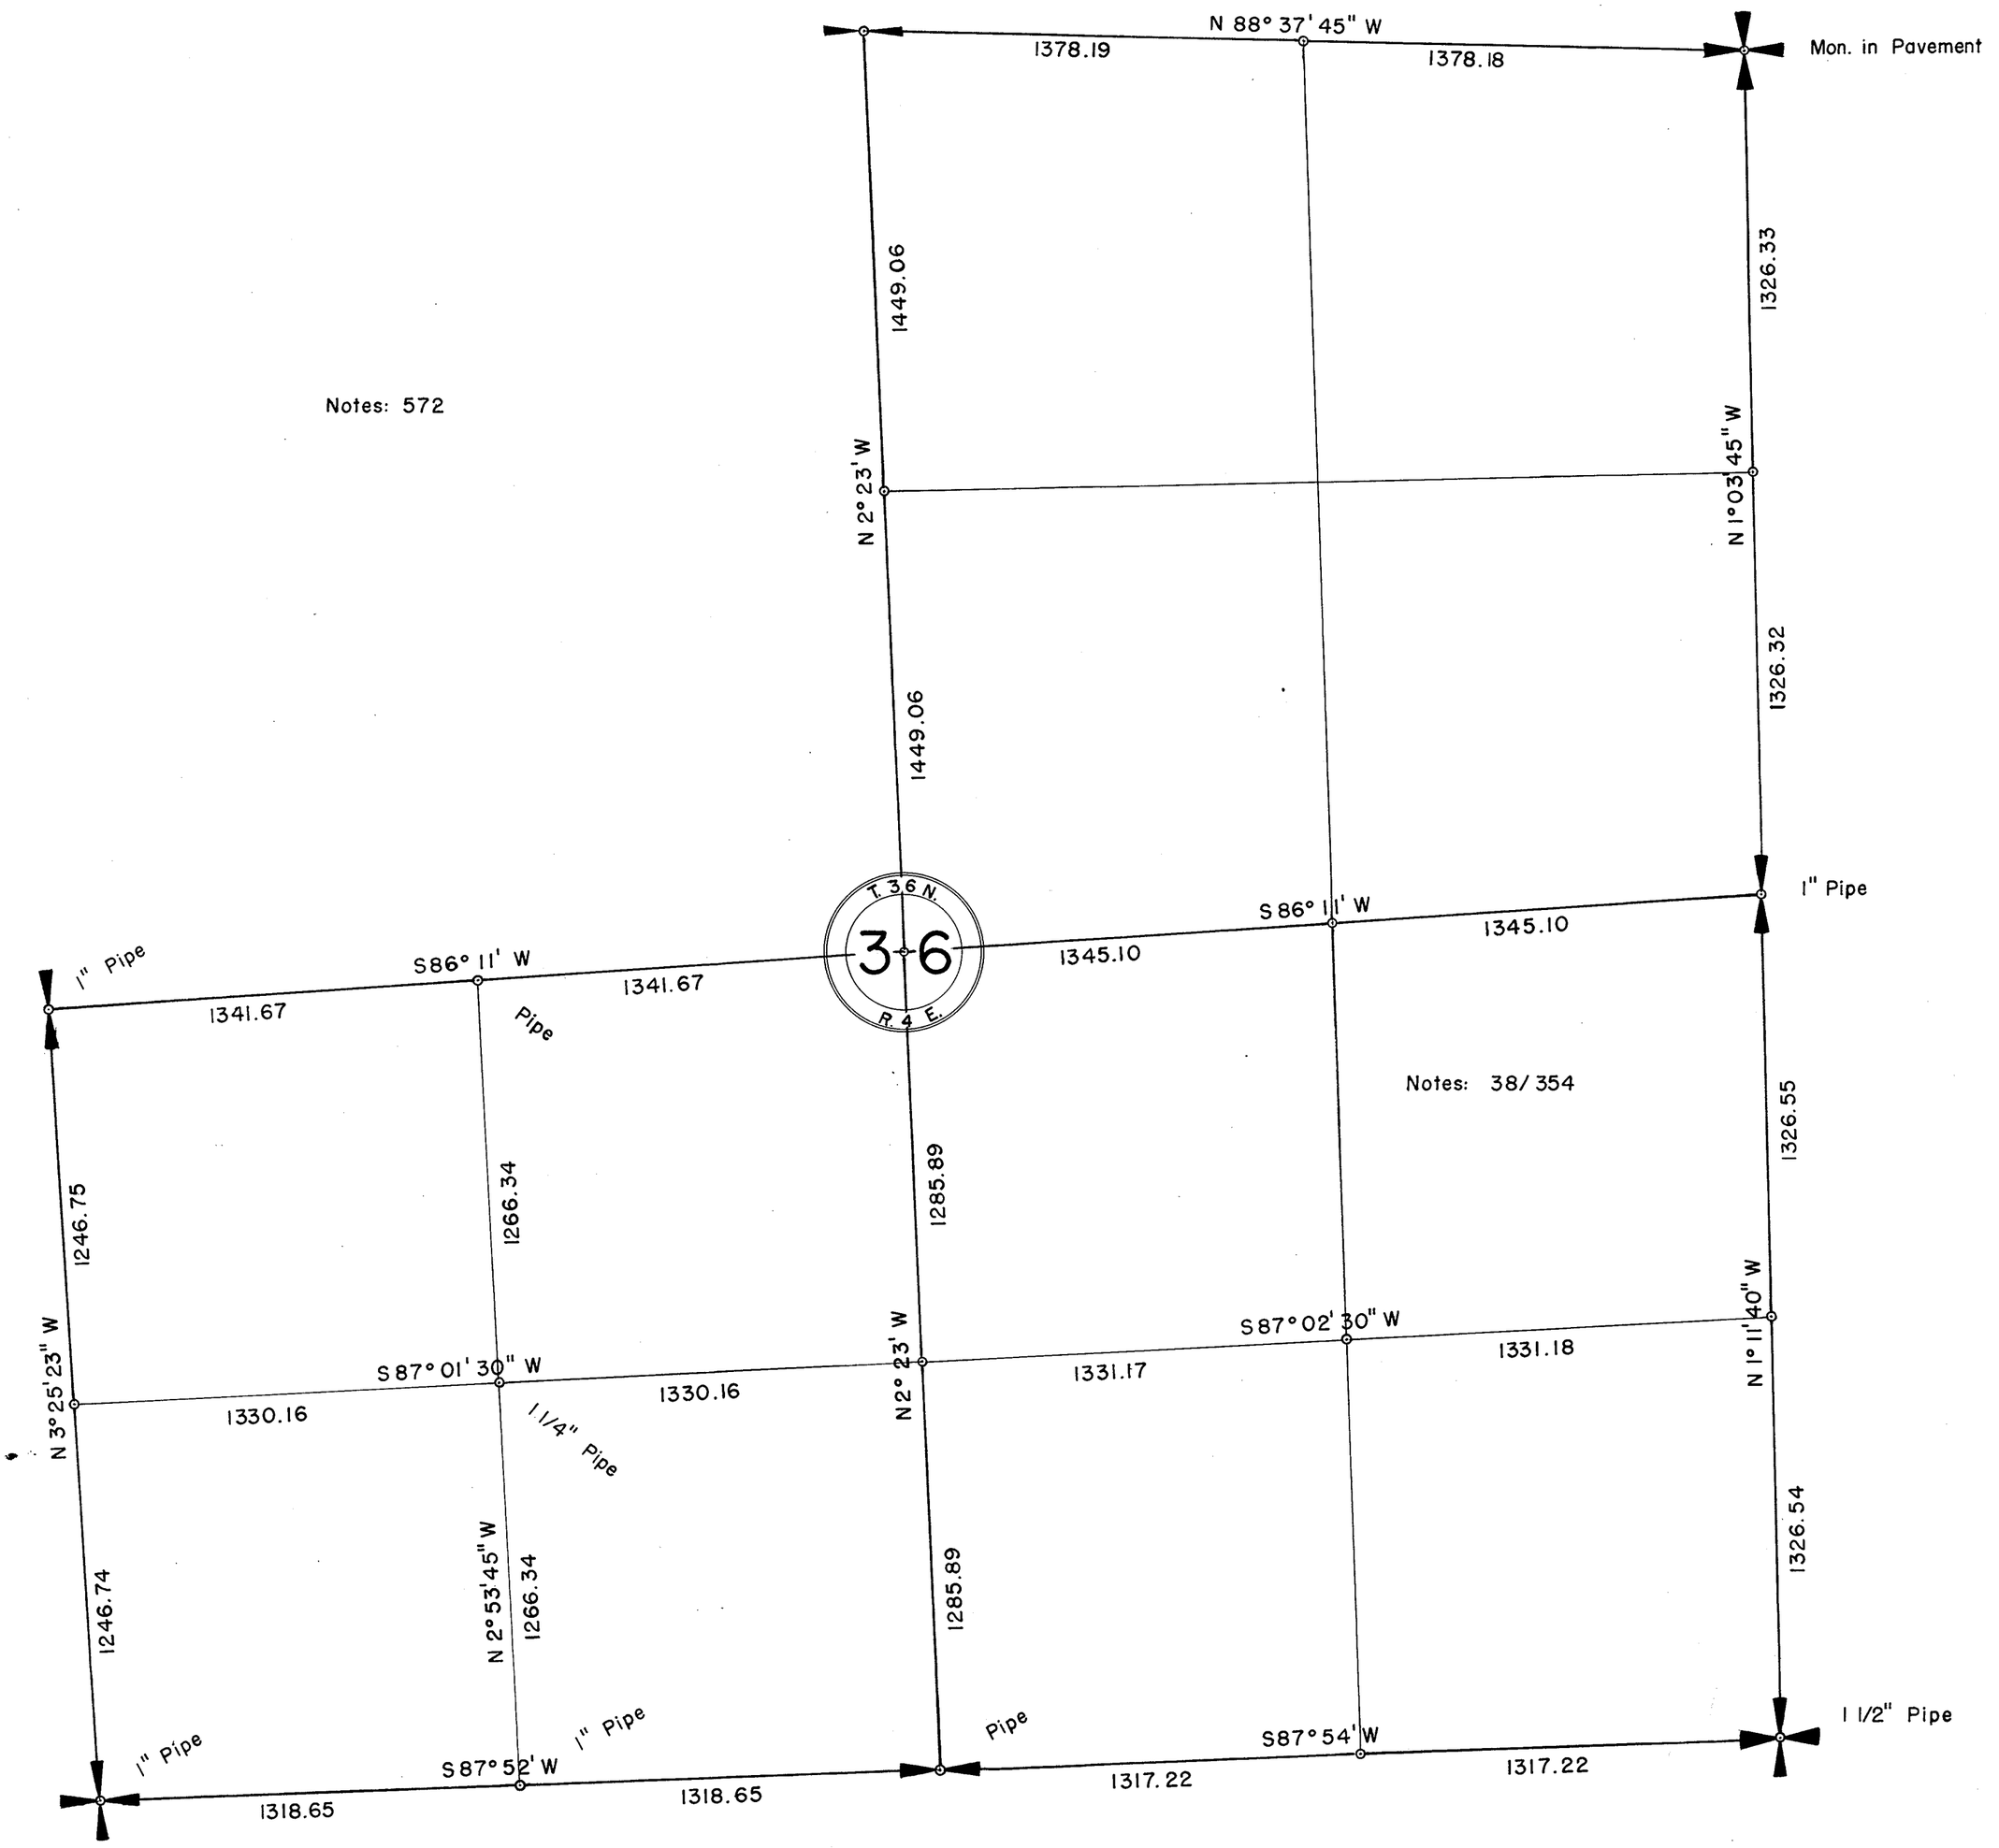

Notes: 572

J.F


SECTION 36

TOWNSHIP 36 NORTH, RANGE 4 EAST, W. M.

SKAGIT COUNTY, WASH.

SCALE, 1 INCH--400 FEET

DATE _____ _____ COUNTY ENGINEER

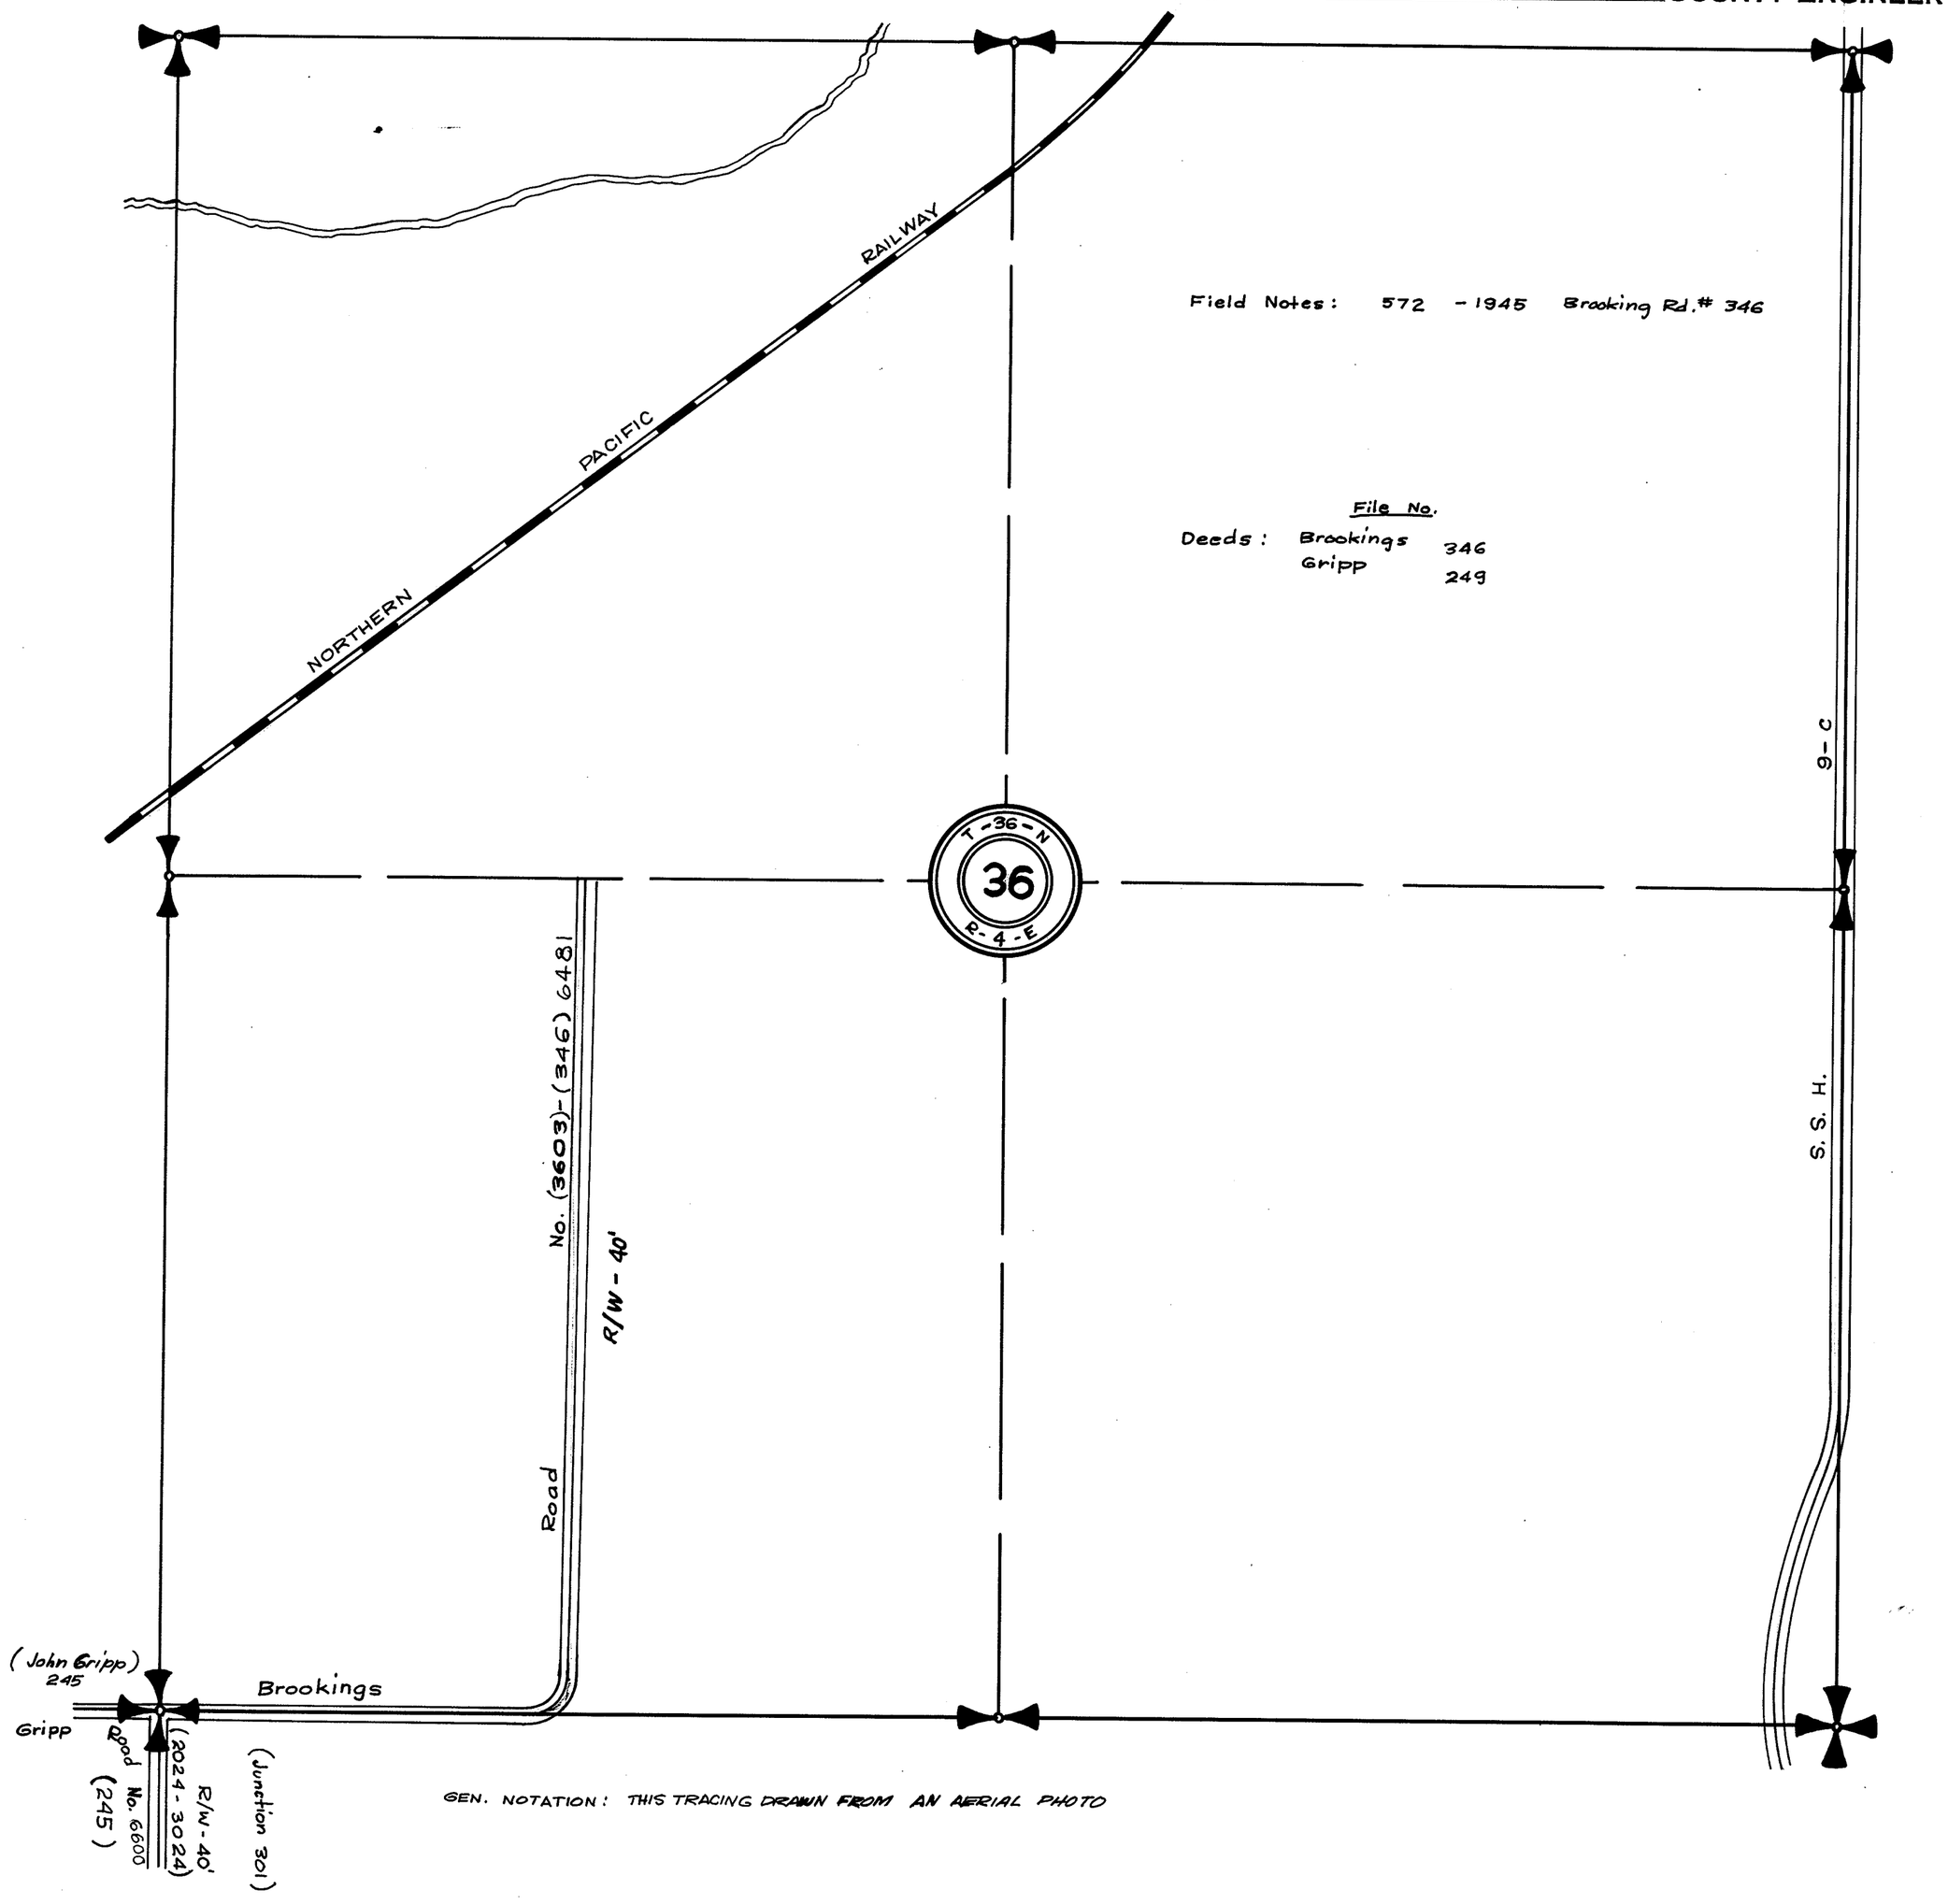

Field Notes: 572 - 1945 Brooking Rd.# 346

		File No.
Deeds:	Brookings	346
	Gripp	249

GEN. NOTATION: THIS TRACING DRAWN FROM AN AERIAL PHOTO

SECTION 17

TOWNSHIP 36 NORTH, RANGE 5 EAST, W. M.

SKAGIT COUNTY, WASH.

SCALE, 1 INCH -- 400 FEET

DATE November 1971

Lloyd Johnson COUNTY ENGINEER

D.N.R. Conc. Mon. Set 1968

25.03'

7 8 18 17

Calc. Cor. Not Set

270° 53' 41" 2664.34

Found 2 B.T's & D.N.R. Conc. Mon. set by District.

274° 26' 13" 1329.68

SET.

1329.69

8 9 17 16

Found 2 B.T's with visible scribe 1" Iron Pipe. Replaced 1" Iron Pipe with D.N.R. Conc. Mon.

1304.85 181° 15' 48" 1304.85

SET.

1352.88 1335.83 1318.78

181° 30' 02"

SET. 1329.28 SET. 273° 42' 07" 1329.28 SET.

181° 29' 05"

1352.88 1335.83 1318.78

181° 30' 57"

1326.77 Found Post & possible B.T. Replaced post with D.N.R. Conc. Mon.

SET. 1326.77 SET. 272° 58' 01" 1329.10 SET. 1329.10

Found 1 B.T. with visible scribe Set D.N.R. Conc. Mon.

1009.84 1016.36 1322.89

300.00'

273° 14' 48" 1328.69 SET. SET 300.00'

273° 14' 45" 1329.21 1329.21

181° 42' 47" 181° 36' 50"

1309.84 1316.36 1322.89 2641.09 181° 35' 14"

Legend

D.N.R. CONC. MON UNLESS OTHERWISE STATED

18 17 19 20

1331.67 273° 31' 24" 1331.67

Found 1 B.T. with overgrown axe marks Set D.N.R. Conc. Mon.

Found 1 B.T. with visible scribe Uprooted & down Set D.N.R. Conc. Mon.

2654.80 272° 52' 04"

17 16 20 21

Set 1" IRON PIPE with D.N.R. brass Cap

SECTION 18


TOWNSHIP 36 NORTH, RANGE 5 EAST, W. M.

SKAGIT COUNTY, WASH.

SCALE, 1 INCH -- 400 FEET

DATE November 1971

Lloyd Johnson COUNTY ENGINEER

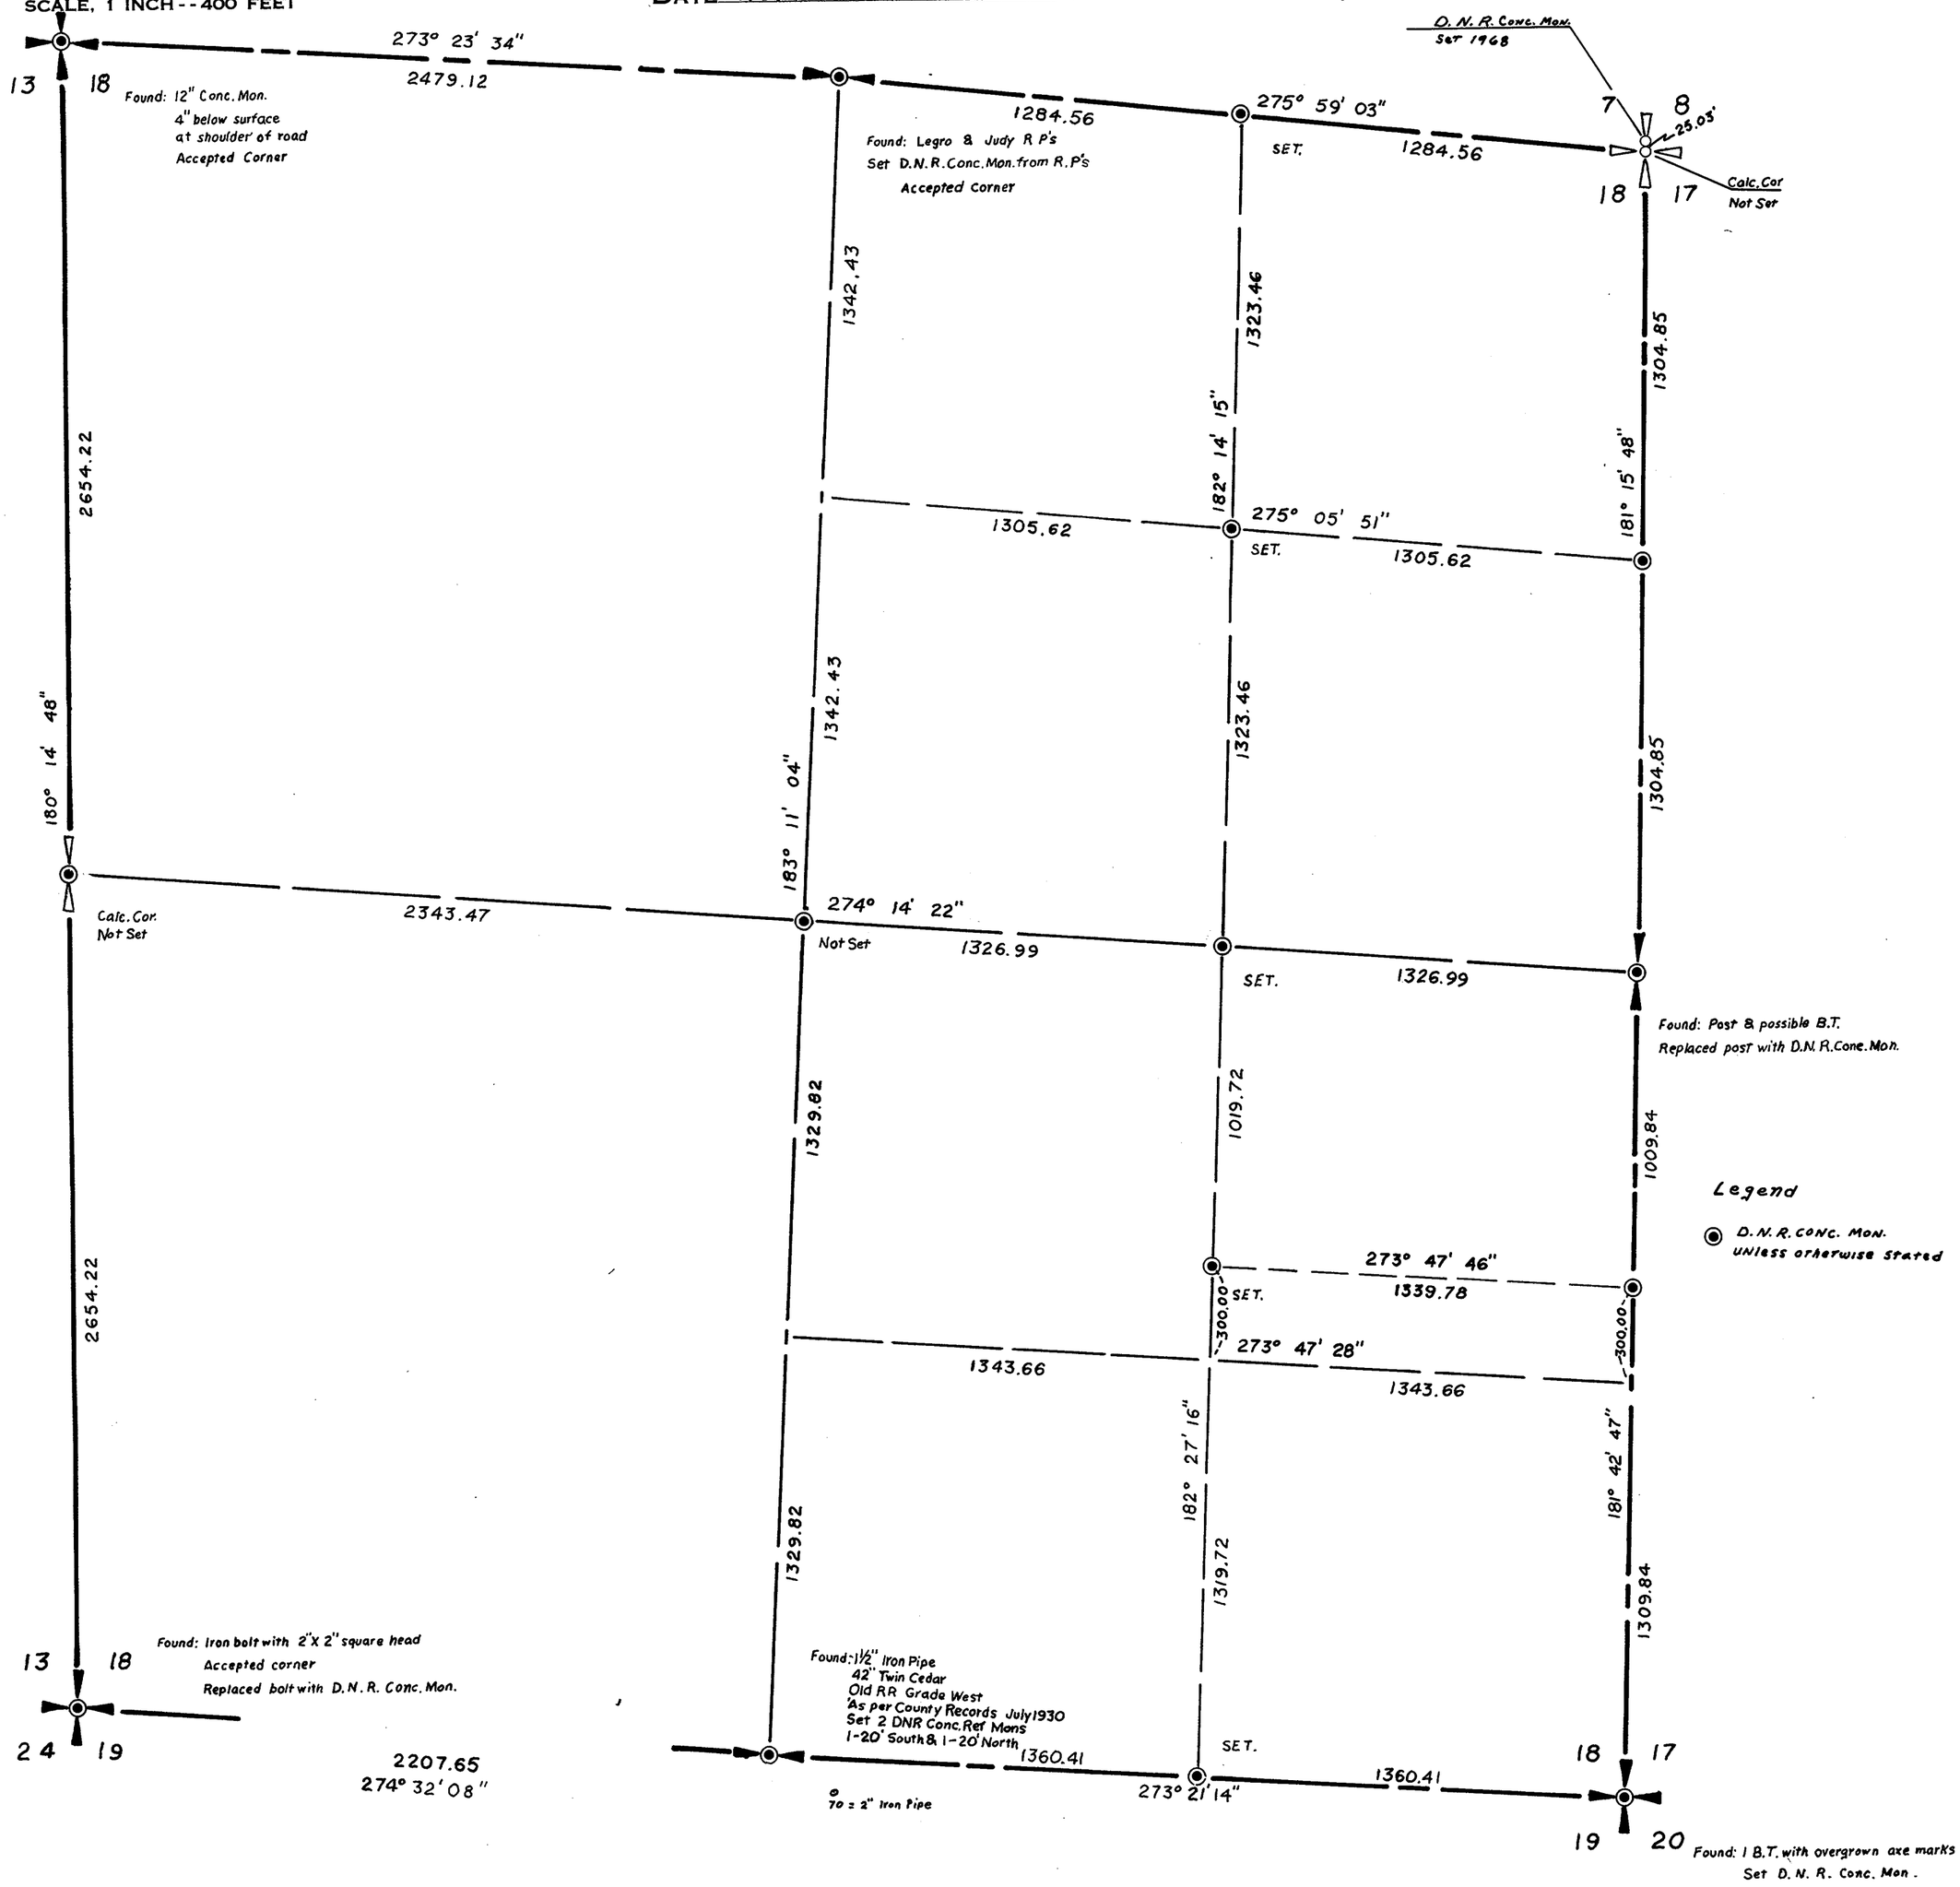


SECTION 18

TOWNSHIP 36 NORTH, RANGE 5 EAST, W. M.

SKAGIT COUNTY, WASH.

SCALE, 1 INCH--400 FEET

DATE _____ _____ COUNTY ENGINEER

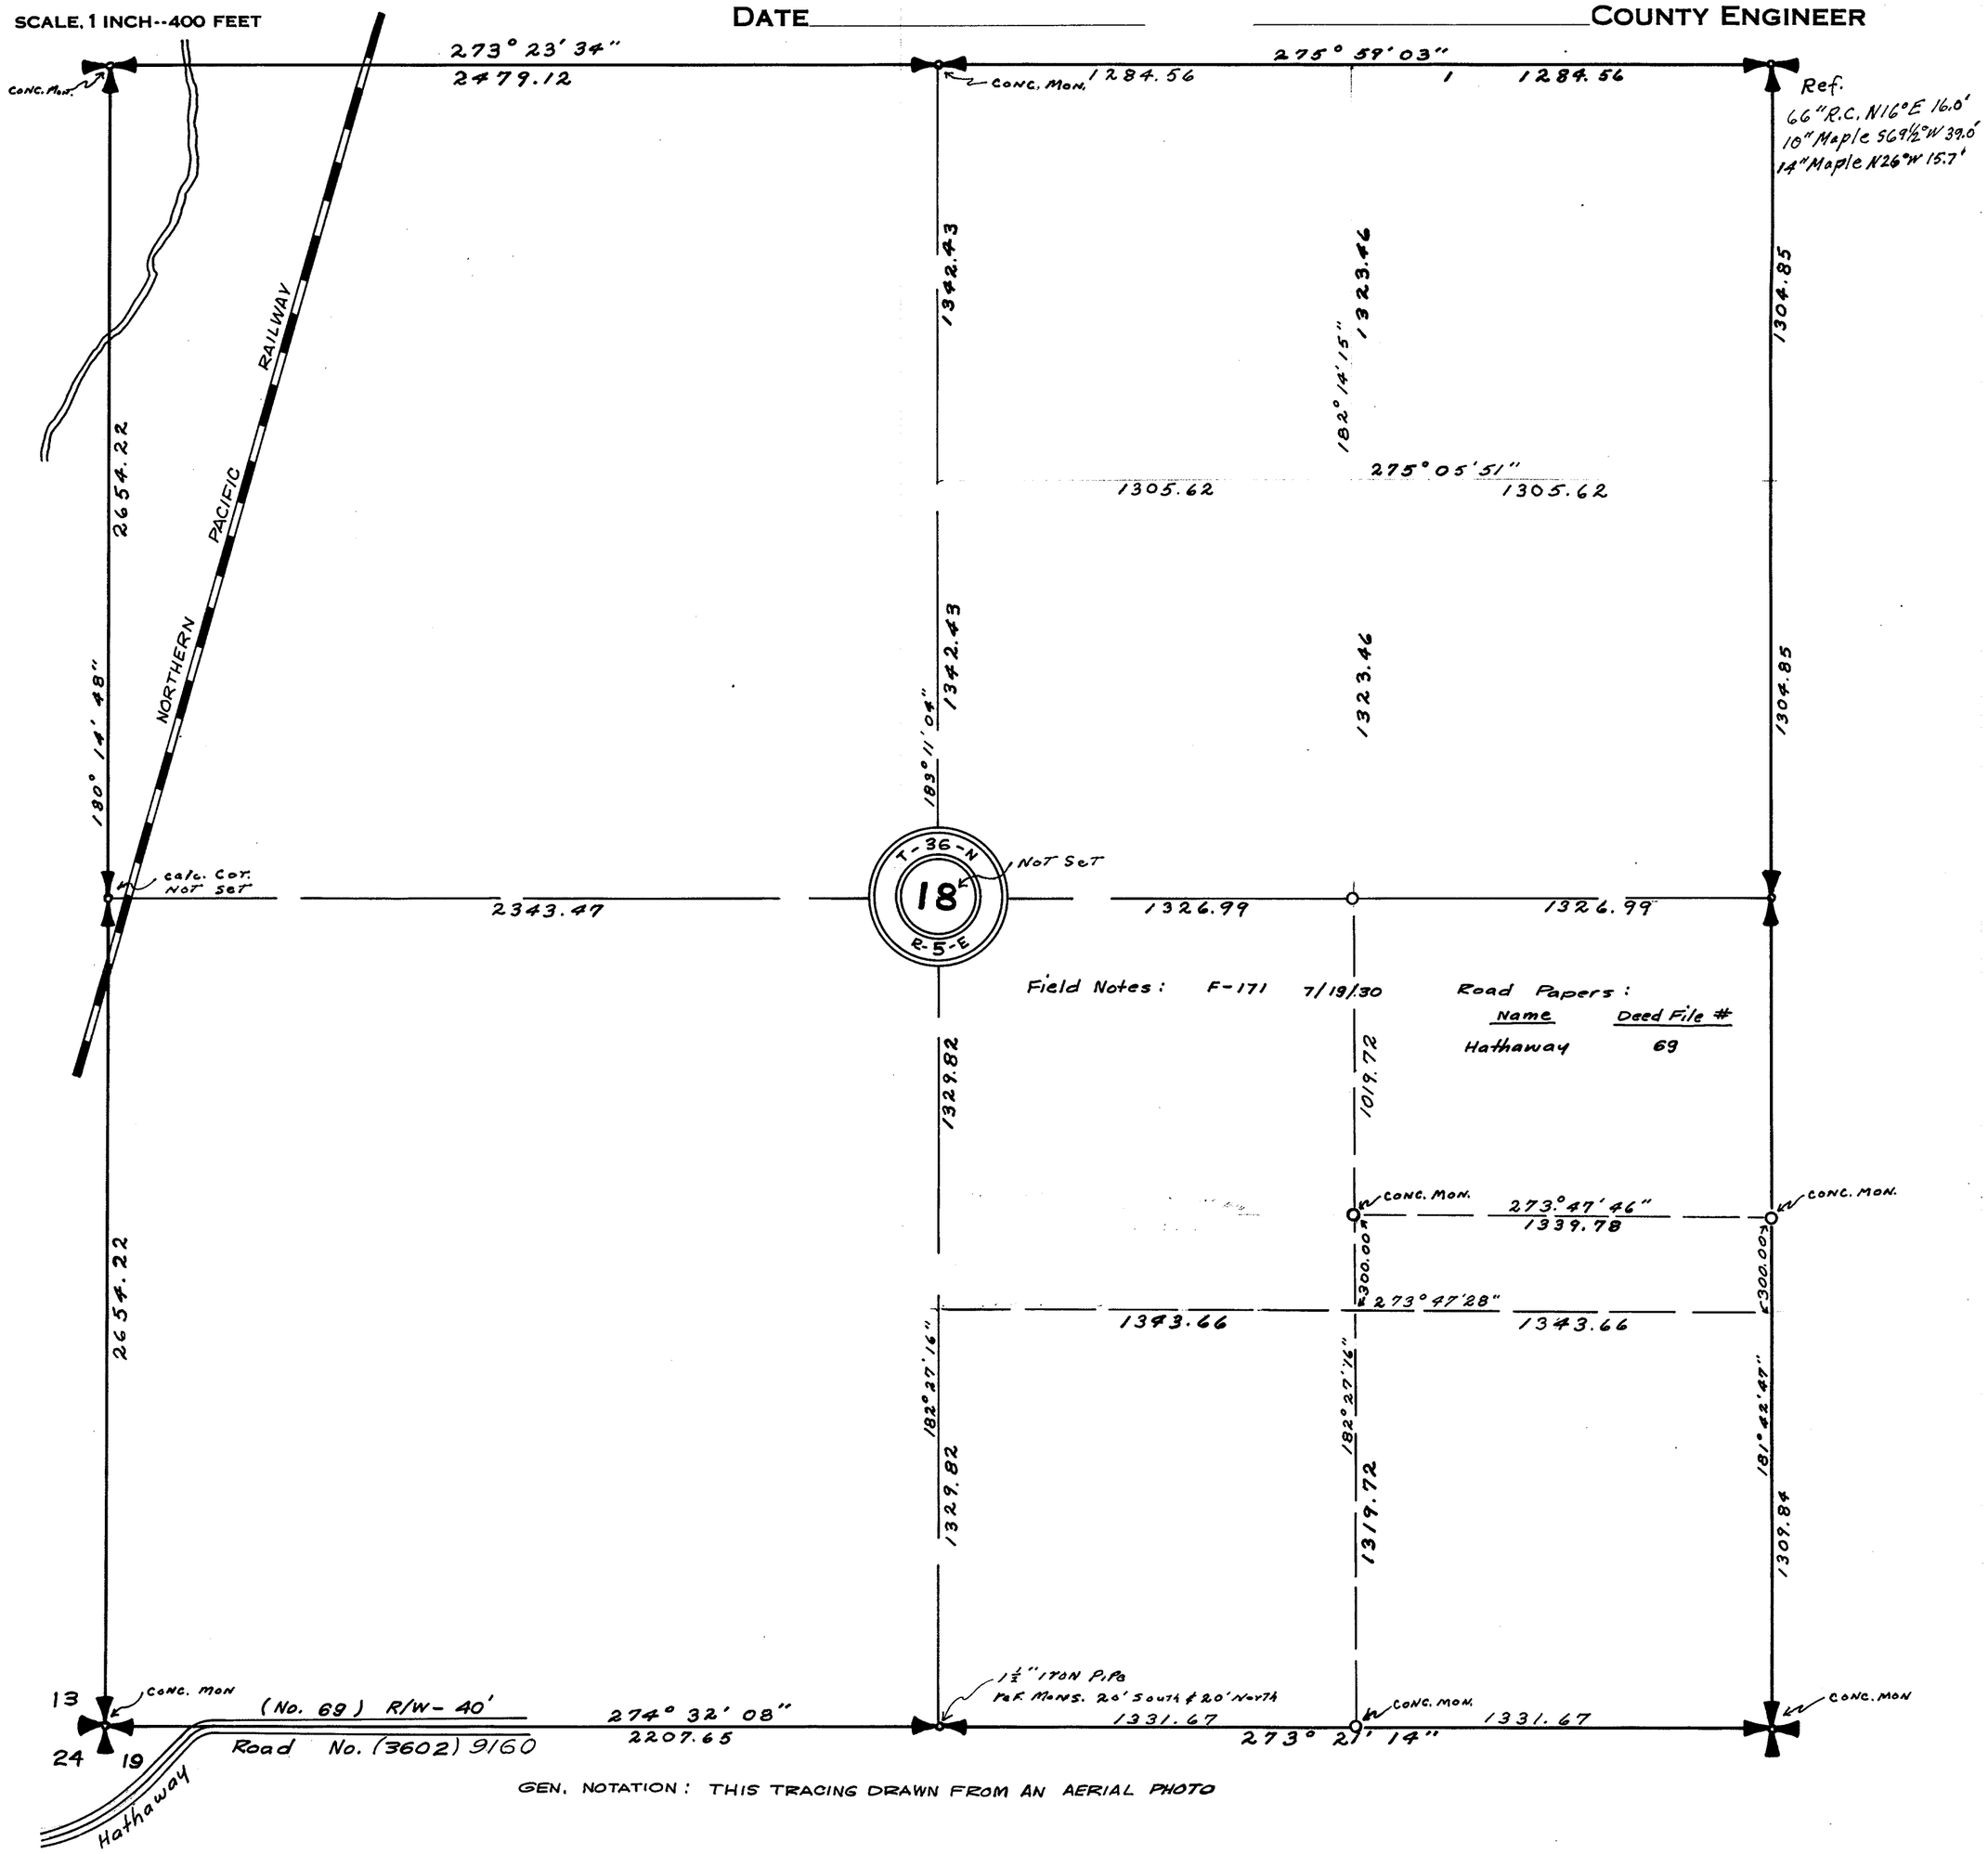


GEN. NOTATION: THIS TRACING DRAWN FROM AN AERIAL PHOTO

SECTION 18

TOWNSHIP 36 NORTH, RANGE 5 EAST, W. M.
SKAGIT COUNTY, WASH.

SCALE, 1 INCH–400 FEET

Robt. E. L. Knapp 1930 COUNTY ENGINEER

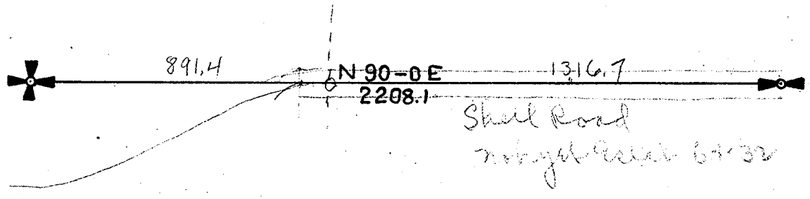


SECTION 31

TOWNSHIP 36 NORTH, RANGE 5 EAST, W. M.

SKAGIT COUNTY, WASH.

SCALE, 1 INCH–400 FEET

Arthur L Strong COUNTY ENGINEER

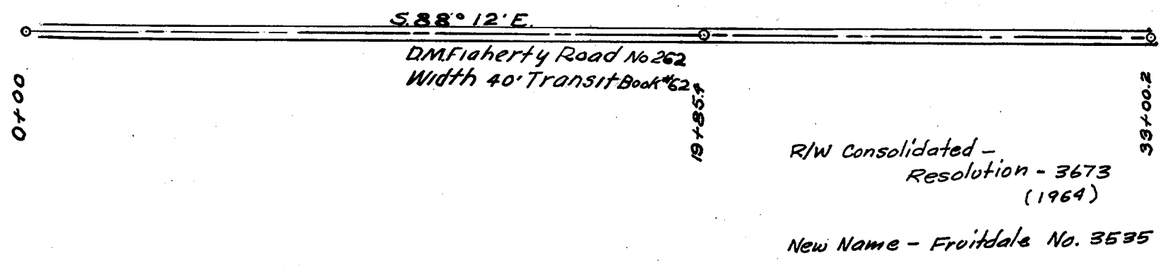

SECTION 31

TOWNSHIP 36 NORTH, RANGE 5 EAST, W. M.

SKAGIT COUNTY, WASH.

SCALE, 1 INCH--400 FEET

DATE _____ _____ COUNTY ENGINEER

Road Papers:

Name	Deed File #
Birss	72
Fruitdale	179

Field Notes: C-61 1/8/26
38-585
38-412
818 1964 — A 18/1 Fruitdale Road

A. Birss Road No. (3606)-(72) 9600

R/W - 60'

Fruitdale Road No. (3535) 9111

(Flaherty Road No. 262)

R/W - 40'

T-36-N
31
R-5-E

Consolidation - Resolution 3673
Aug. 1964

State Hwy - 9

No. (3535) 9111 Fruitdale Road

GEN. NOTATION: THIS TRACING DRAWN FROM AN AERIAL PHOTO


SECTION 36

TOWNSHIP 36 NORTH, RANGE 7 EAST, W. M.

SKAGIT COUNTY, WASH.

SCALE, 1 INCH--400 FEET

DATE _____ _____ COUNTY ENGINEER

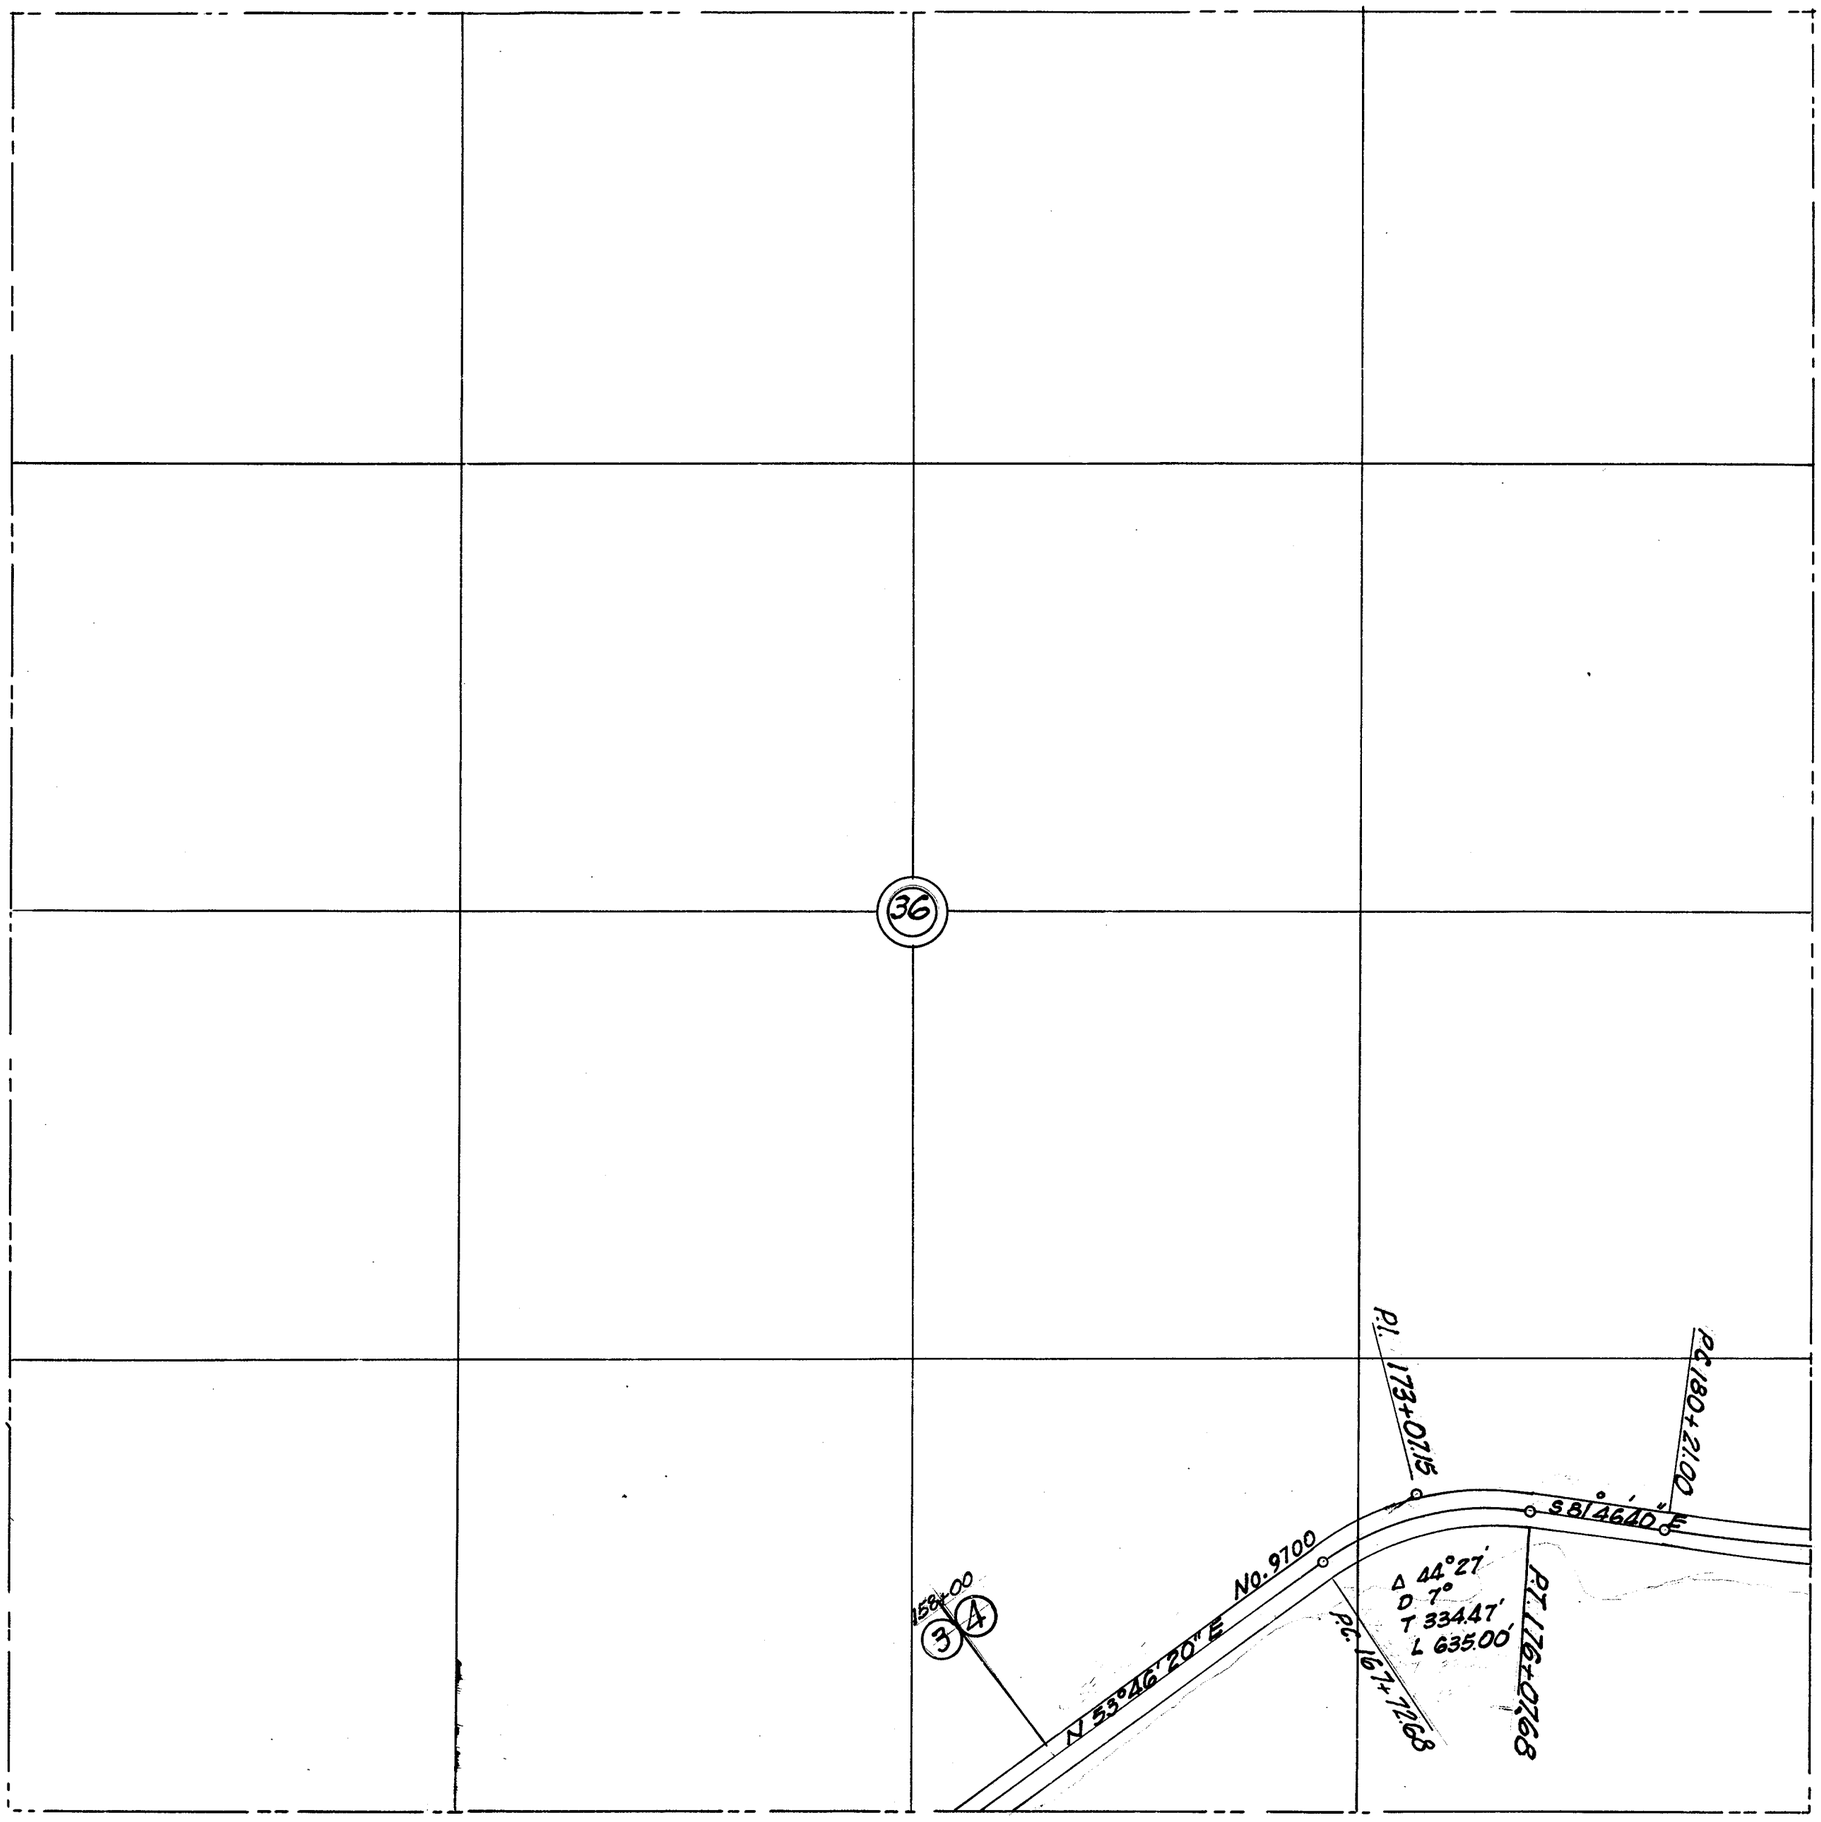

SECTION 2


TOWNSHIP 36 NORTH, RANGE 8 EAST, W. M.

SKAGIT COUNTY, WASH.

SCALE, 1 INCH--400 FEET
Road No. 310 & Sec. Corners from A-8 (Notes D-91)

DATE January, 1960

Frank Gilkey COUNTY ENGINEER

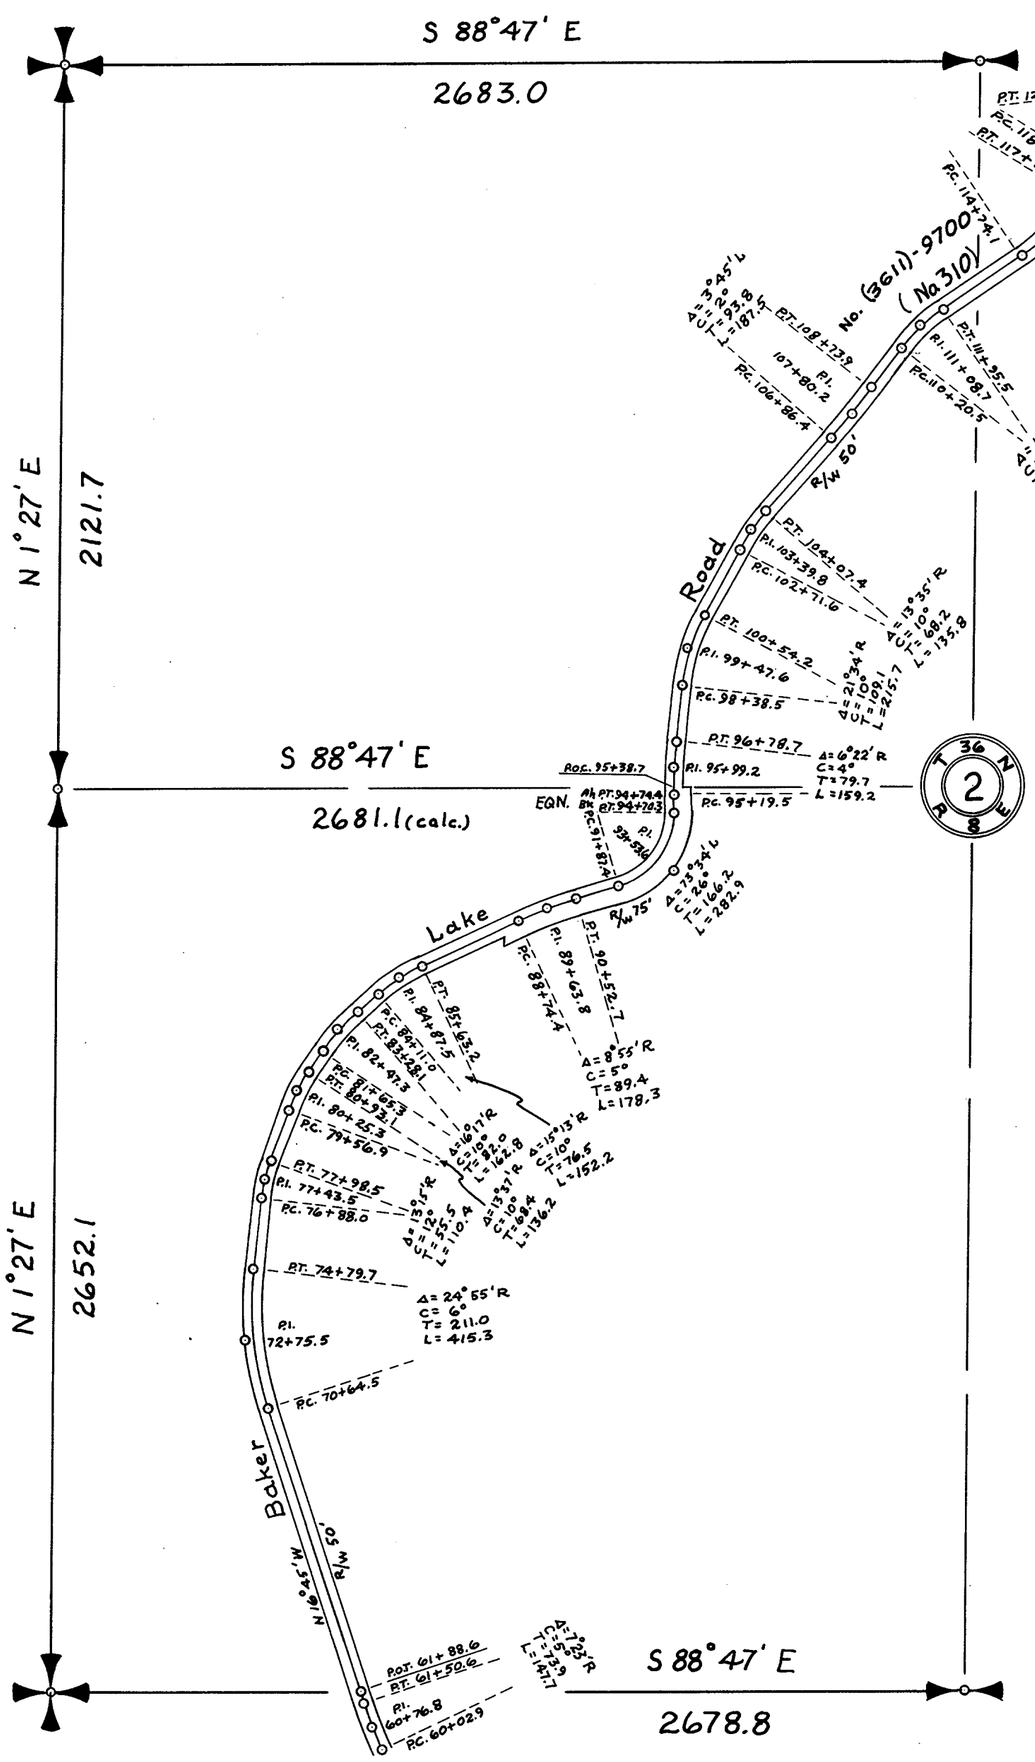

SECTION 10


TOWNSHIP 36 NORTH, RANGE 8 EAST, W. M.

SKAGIT COUNTY, WASH.

SCALE, 1 INCH -- 400 FEET

DATE 1968

Lloyd Johnson COUNTY ENGINEER

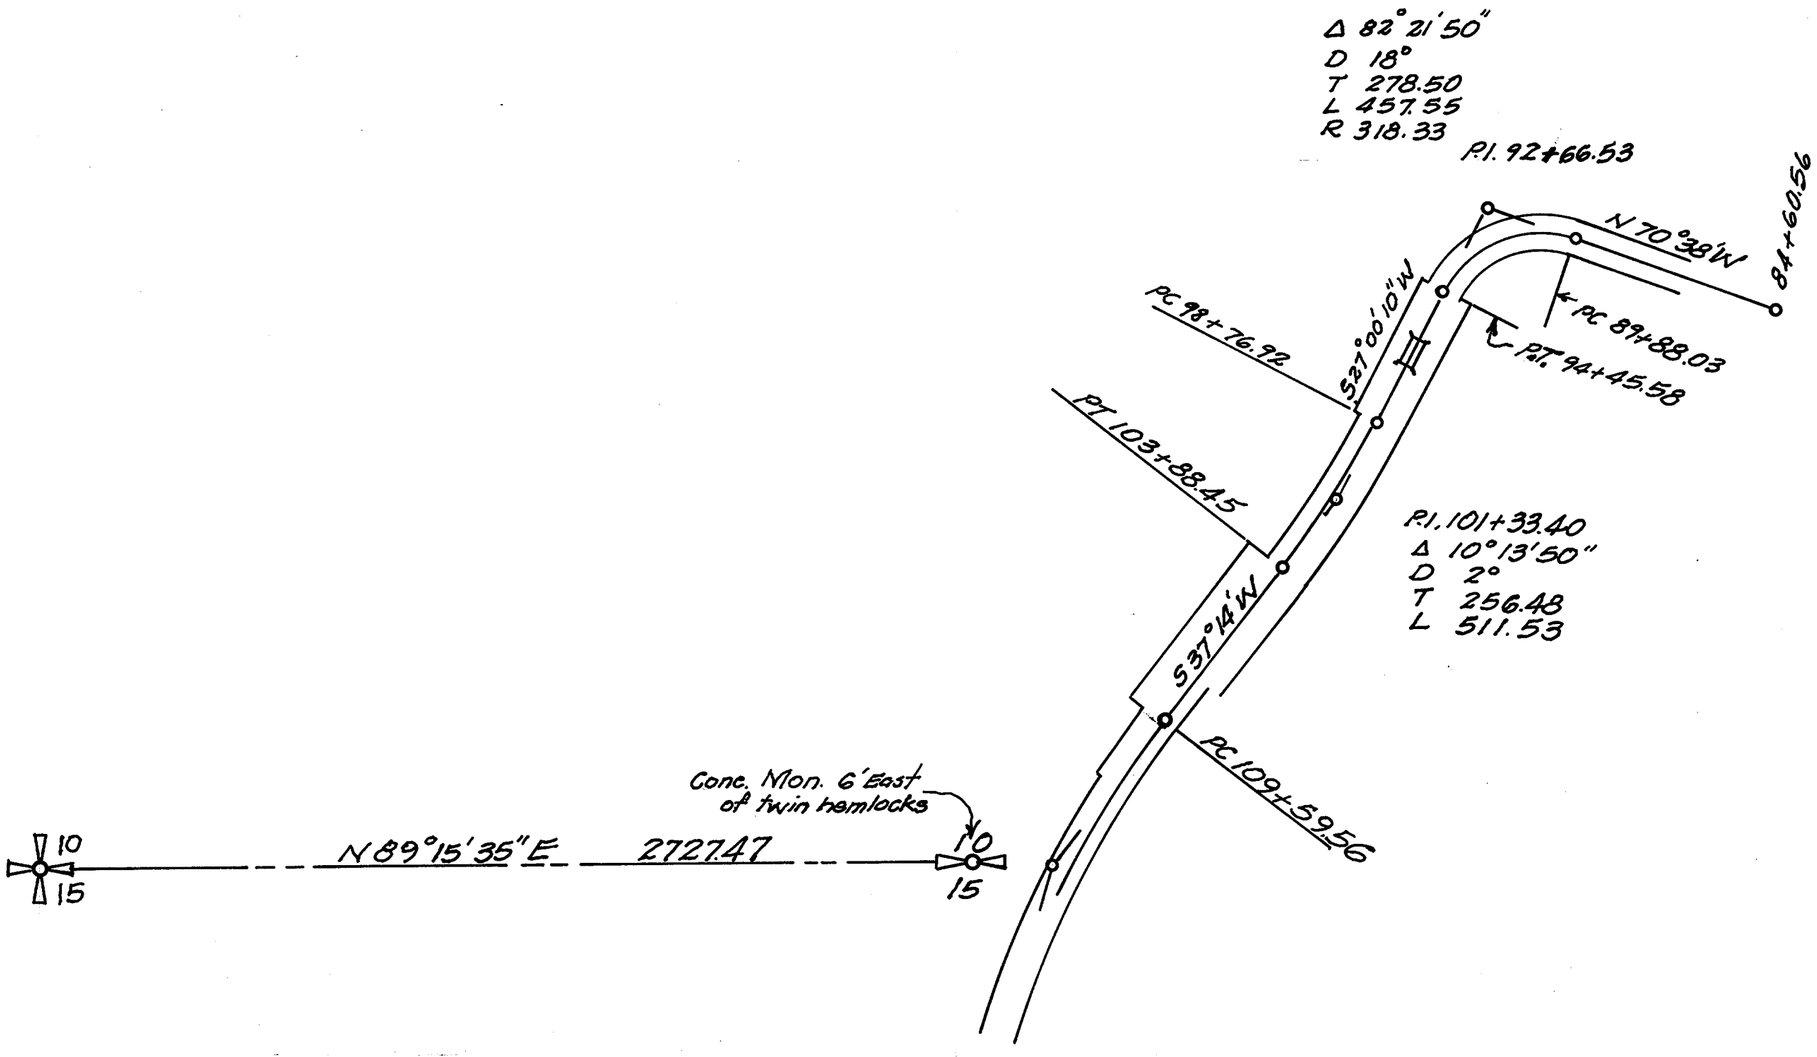


SECTION 11

TOWNSHIP 36 NORTH, RANGE 8 EAST, W. M.

SKAGIT COUNTY, WASH.

SCALE, 1 INCH--400 FEET
Road No. 310 & Sec. Corners from A-8, (Notes D-91)

DATE January, 1960 Frank Gilkey COUNTY ENGINEER

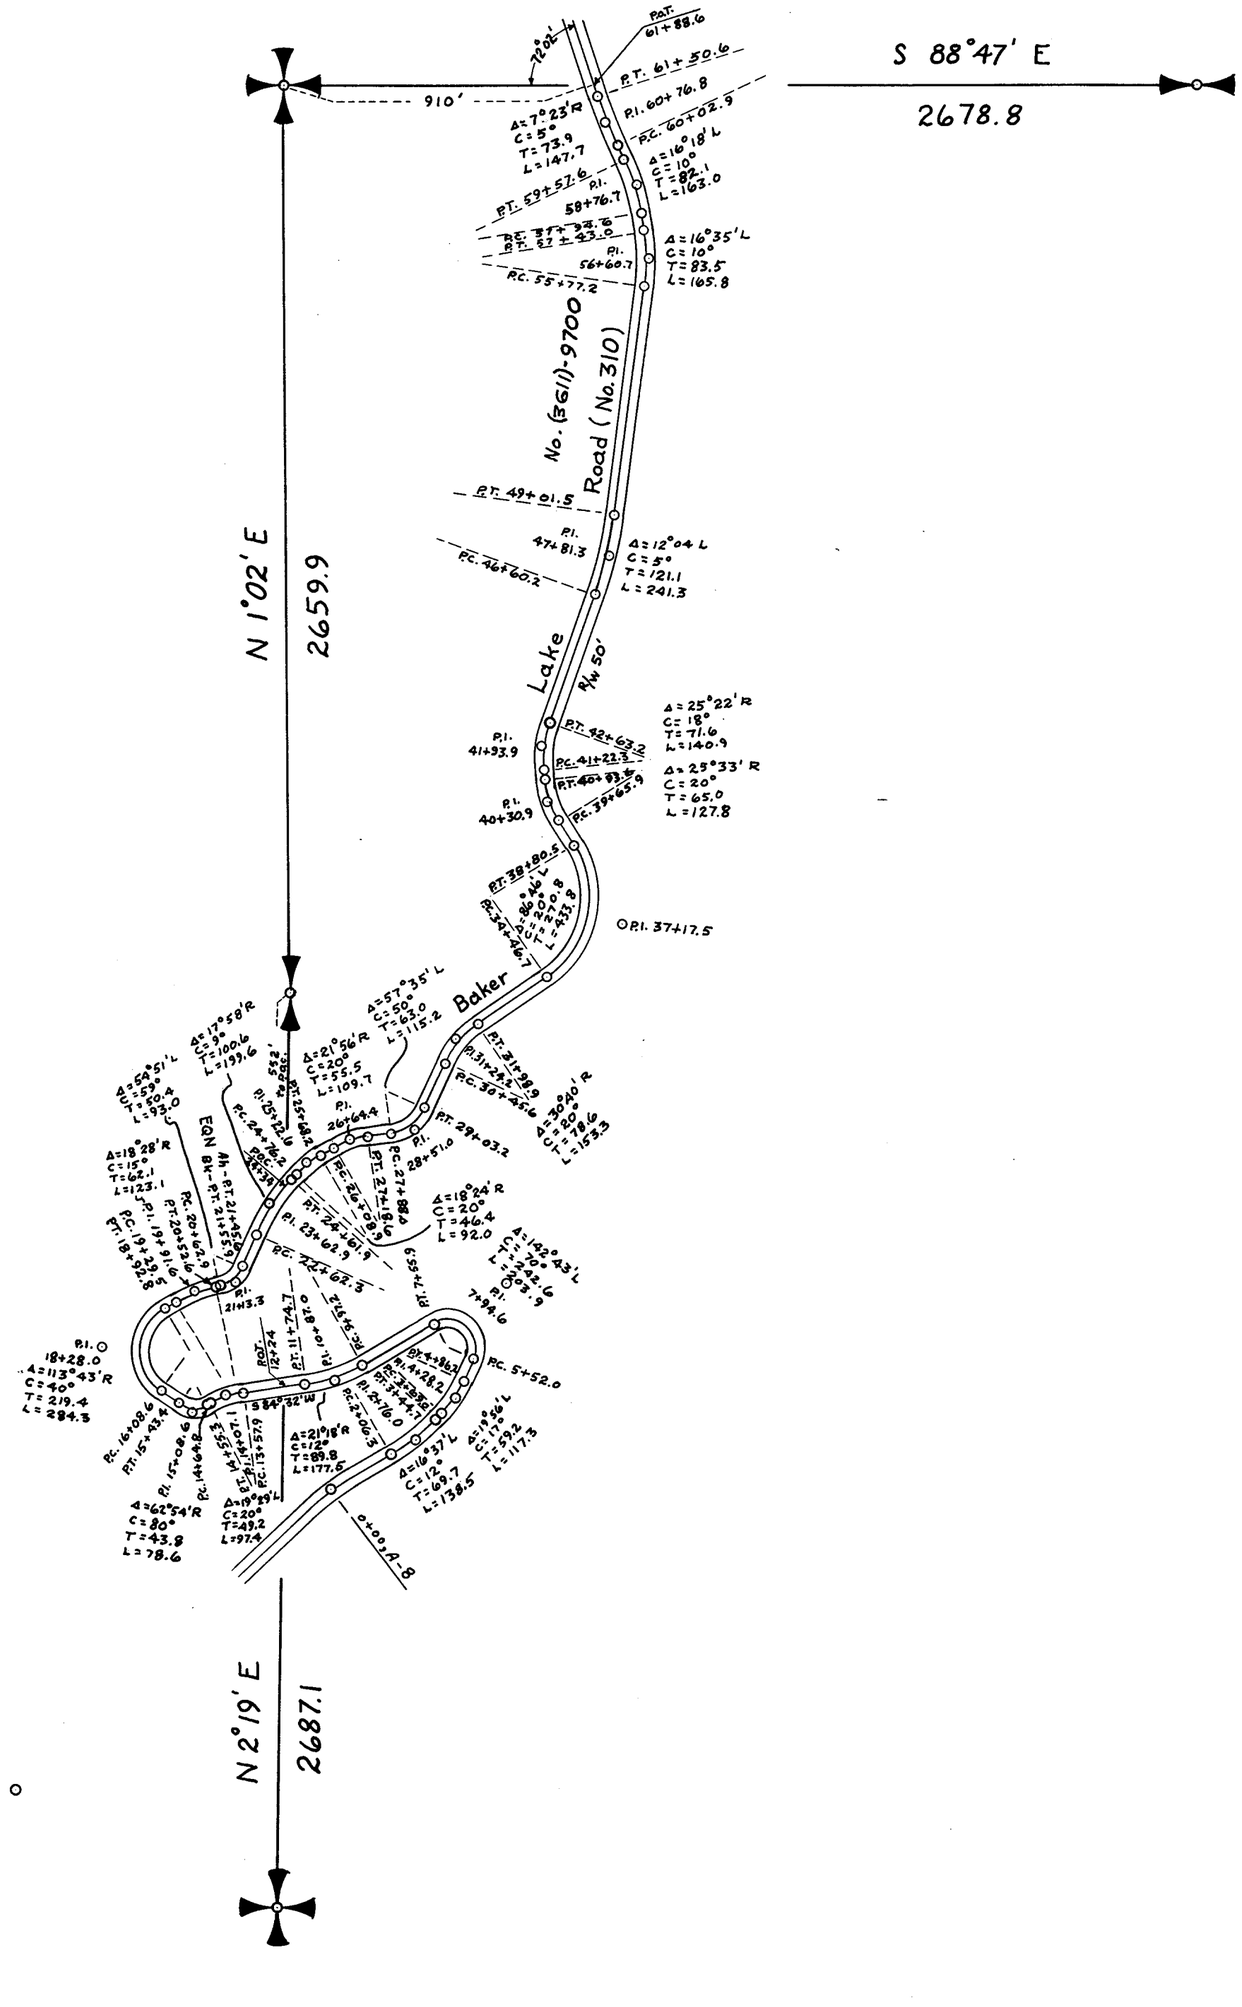

SECTION 15


TOWNSHIP 36 NORTH, RANGE 8 EAST, W. M.

SKAGIT COUNTY, WASH.

SCALE, 1 INCH -- 400 FEET

DATE 1968

Lloyd Johnson COUNTY ENGINEER

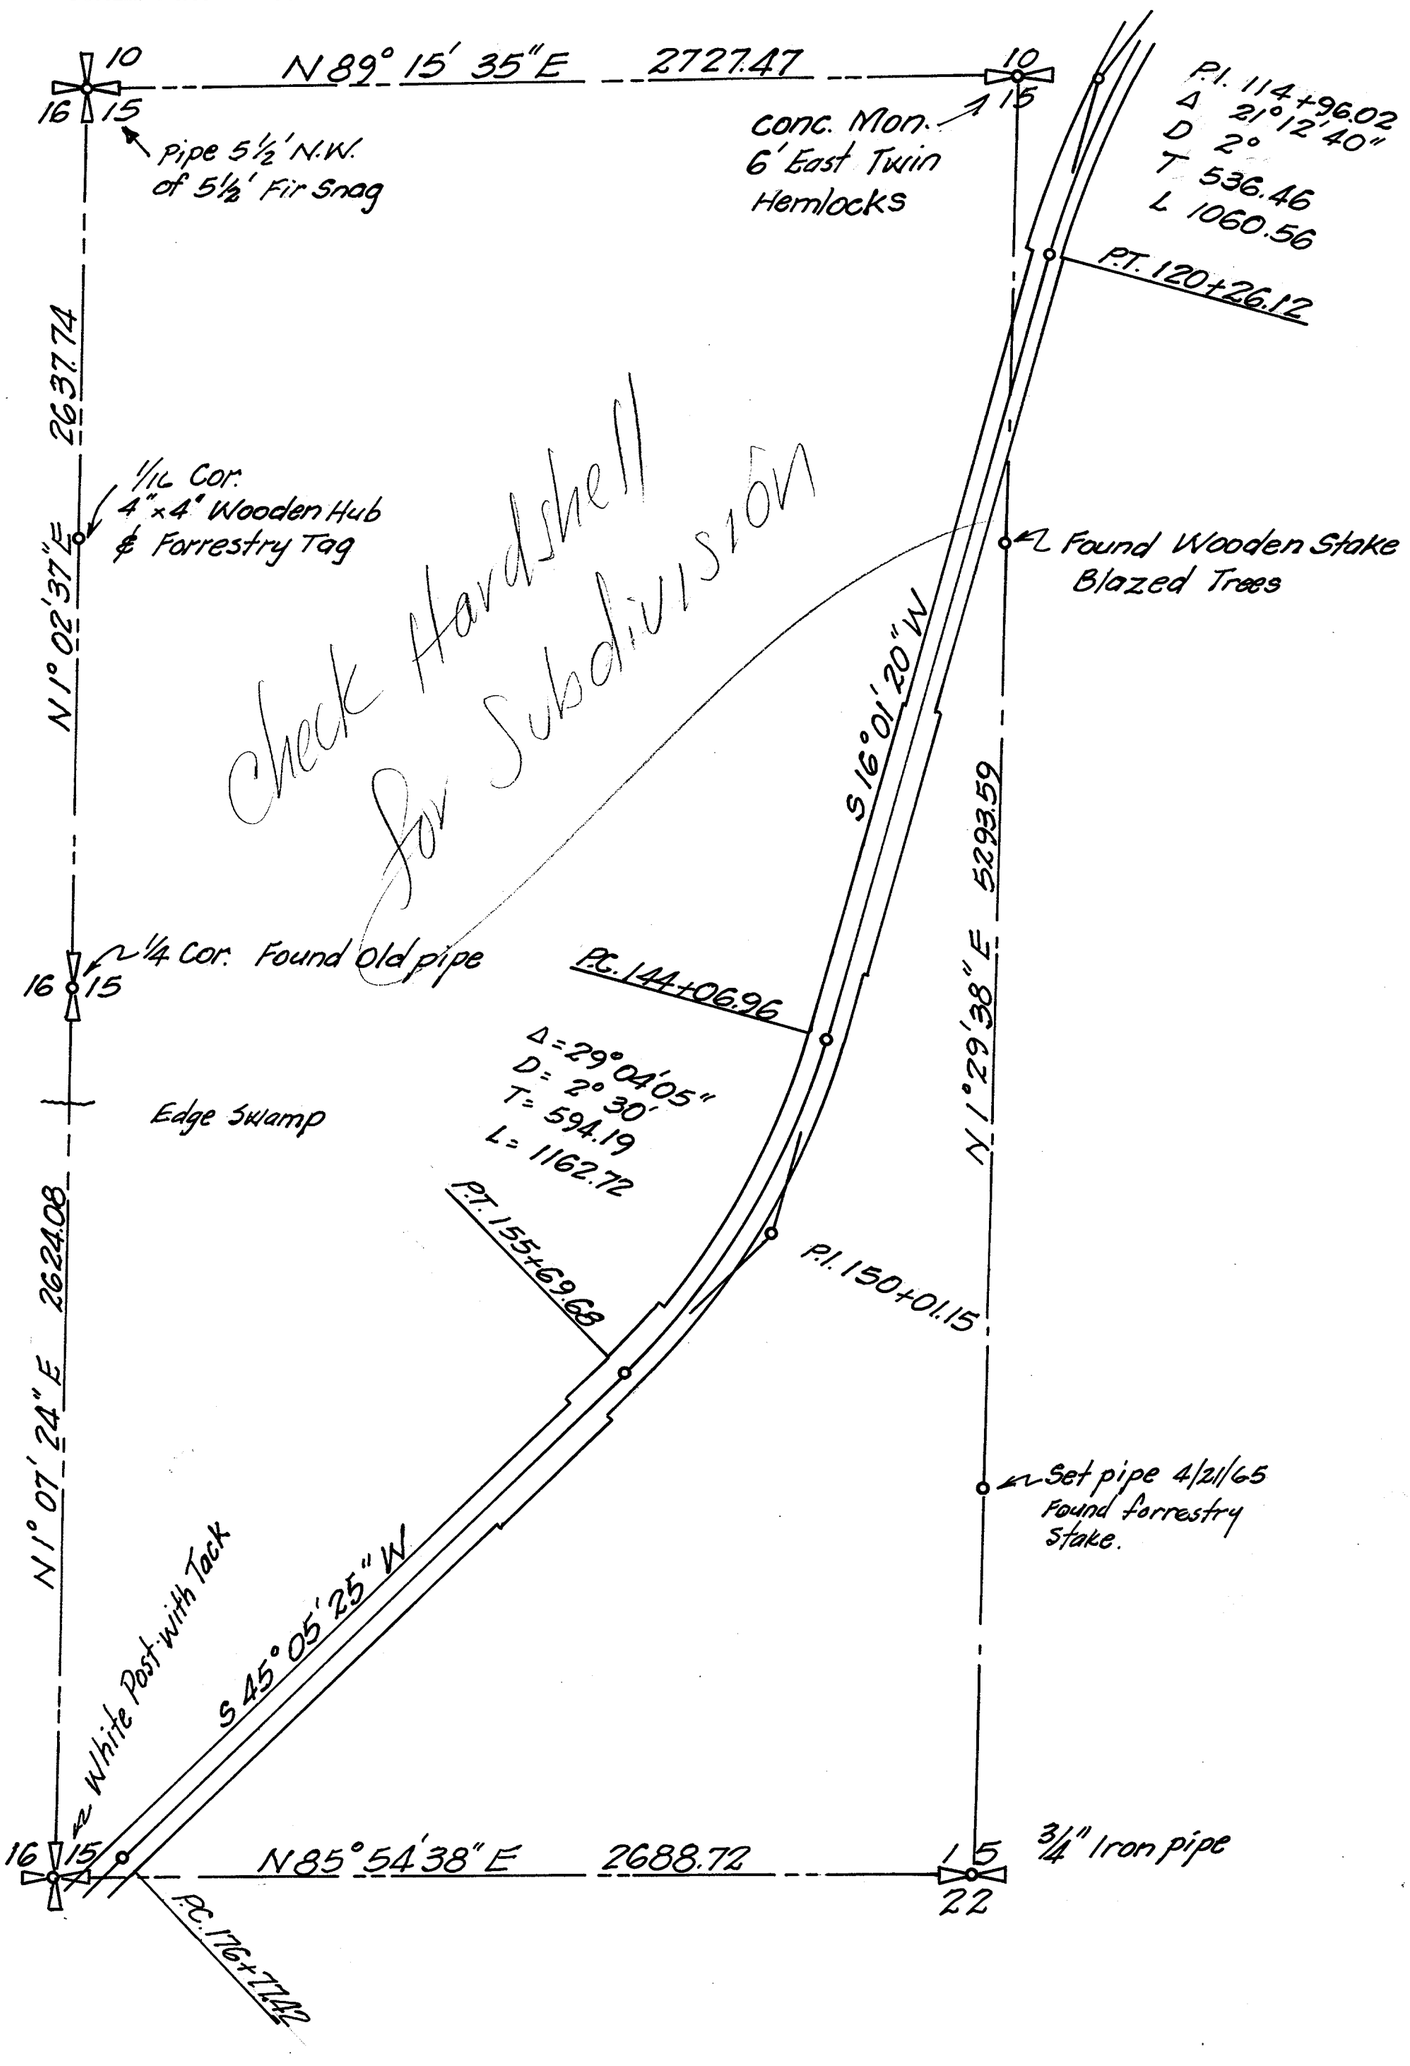

SECTION 15


TOWNSHIP 36 NORTH, RANGE 8 EAST, W. M.

SKAGIT COUNTY, WASH.

SCALE, 1 INCH--400 FEET
Road No. 310, Unmarked, from Aerial Photo CWD-1R-136 (Assessor's)
Unshaded Sec. Cor. from Aerial Photo.

DATE January, 1960

Frank Gilkey COUNTY ENGINEER

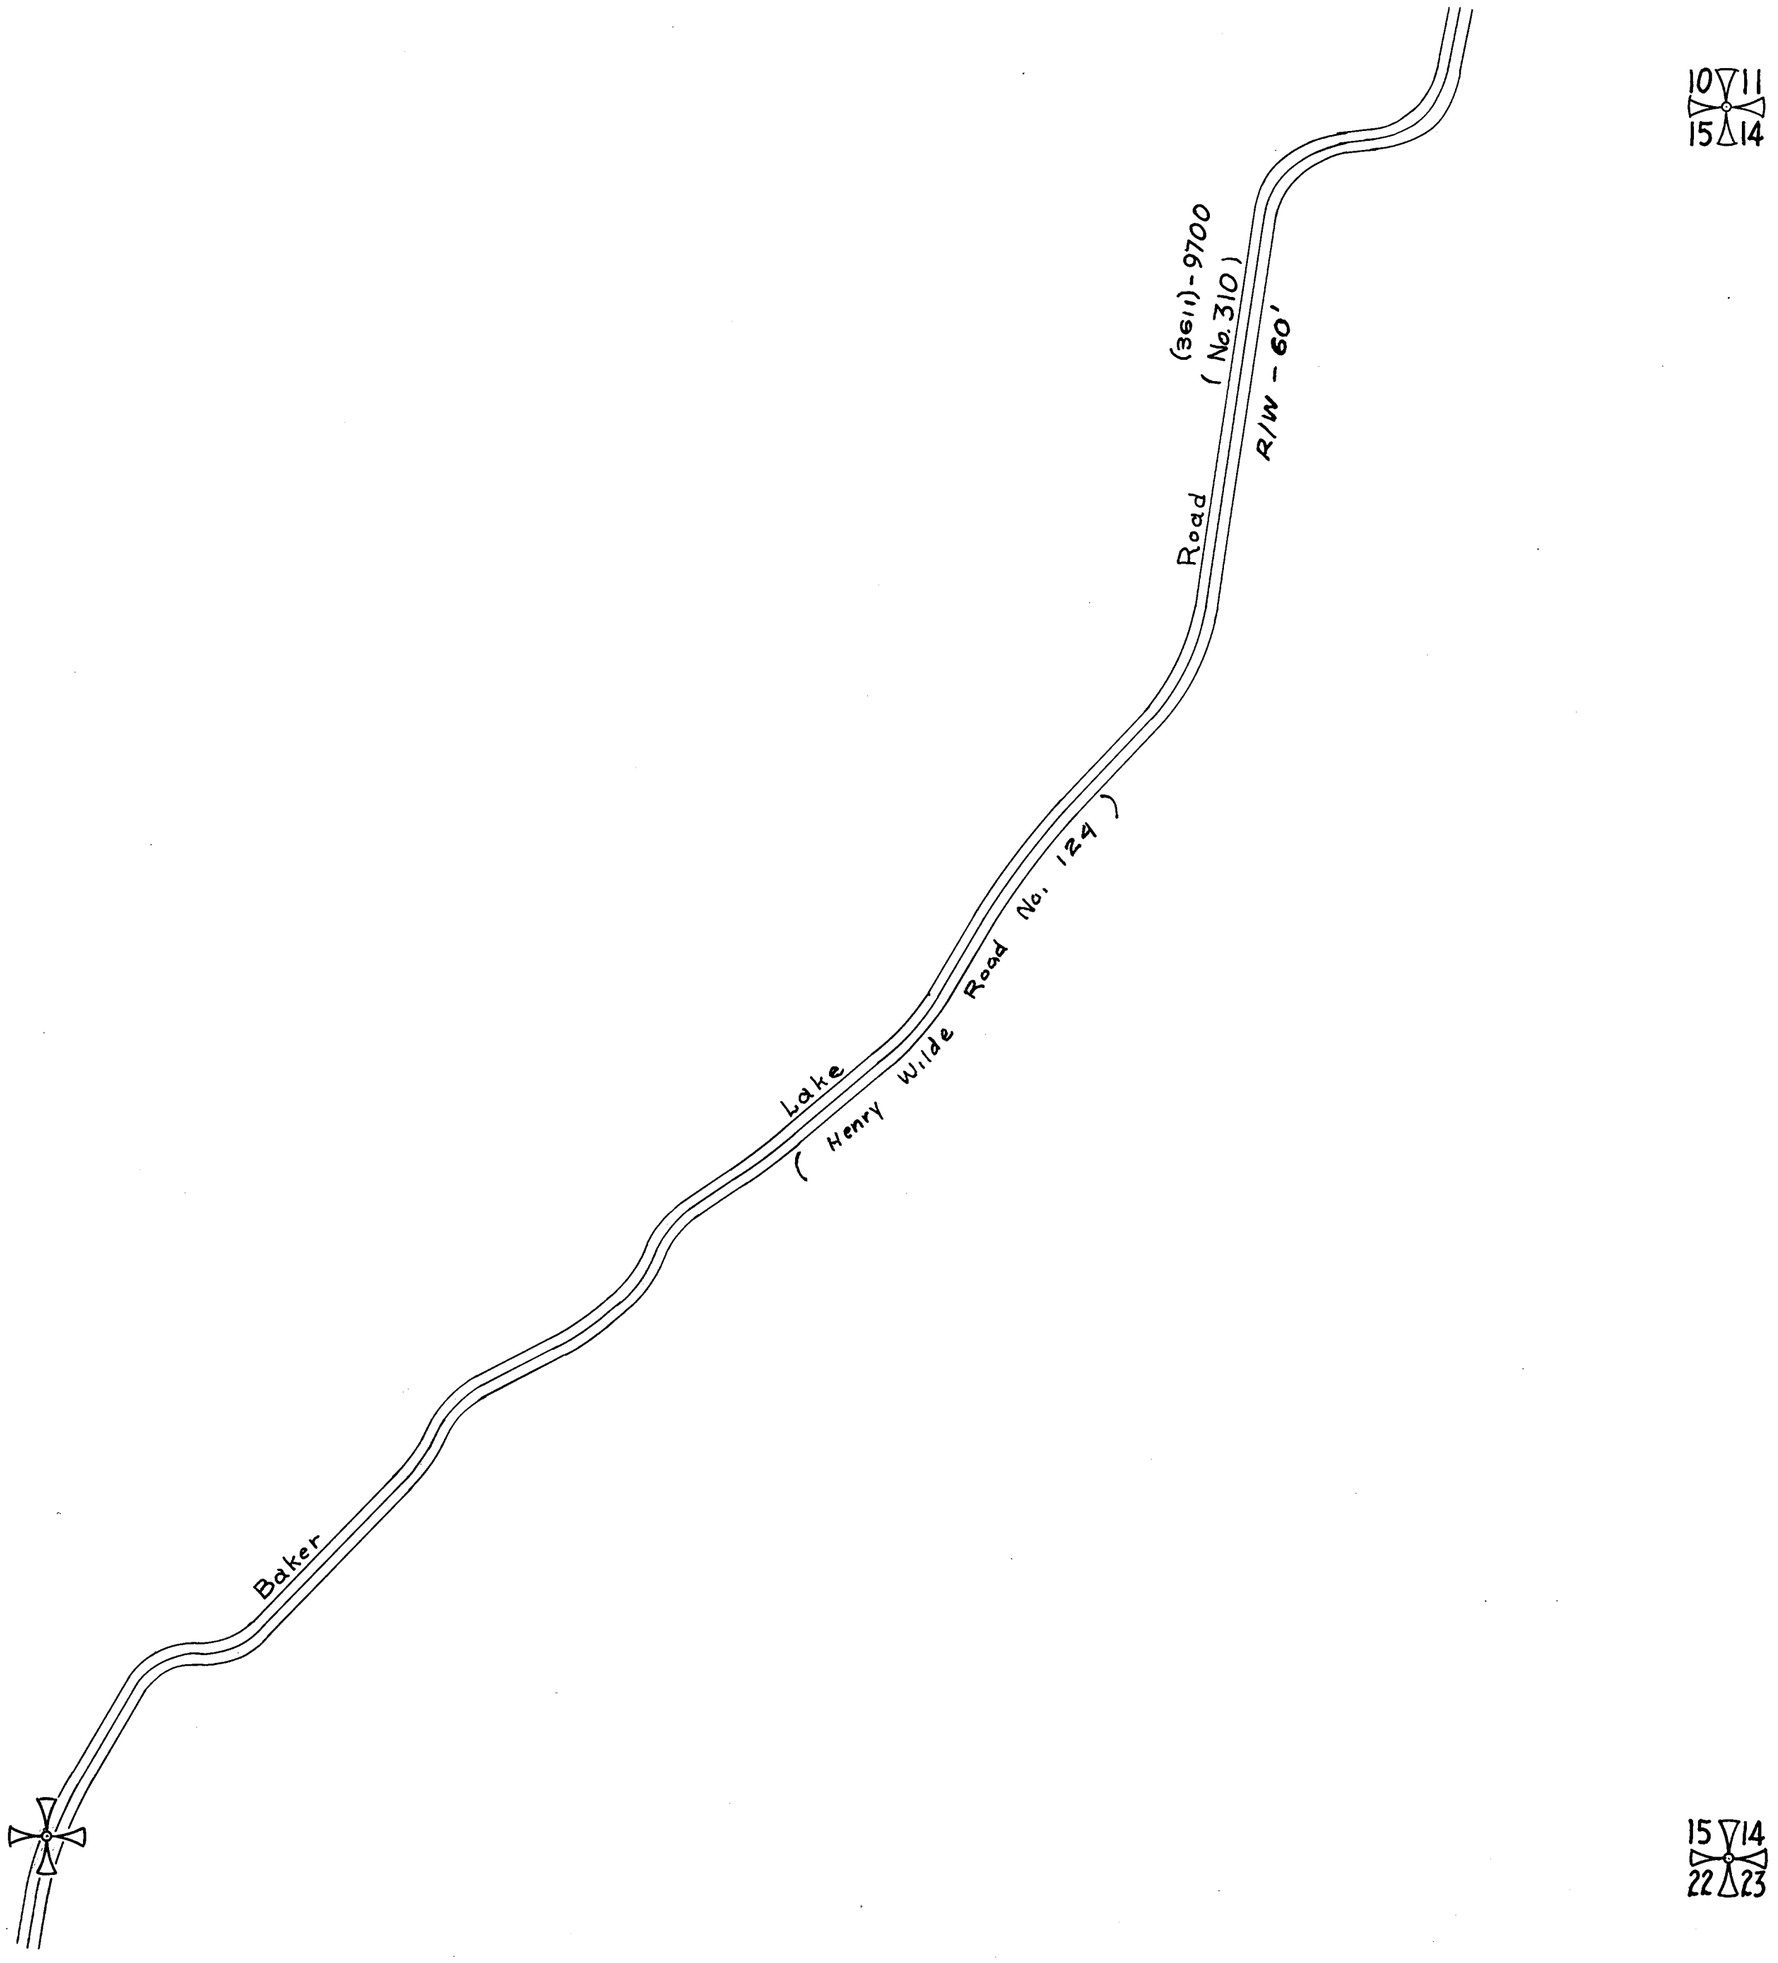

SECTION 21


TOWNSHIP 36 NORTH, RANGE 8 EAST, W. M.

SKAGIT COUNTY, WASH.

SCALE, 1 INCH--400 FEET
Road No. 310, Unmarked, from Aerial Photo CWD-1R-136 (Assessor's)
Unshaded Sec. Cor. from Aerial Photo

DATE January, 1960

Frank Gilkey COUNTY ENGINEER

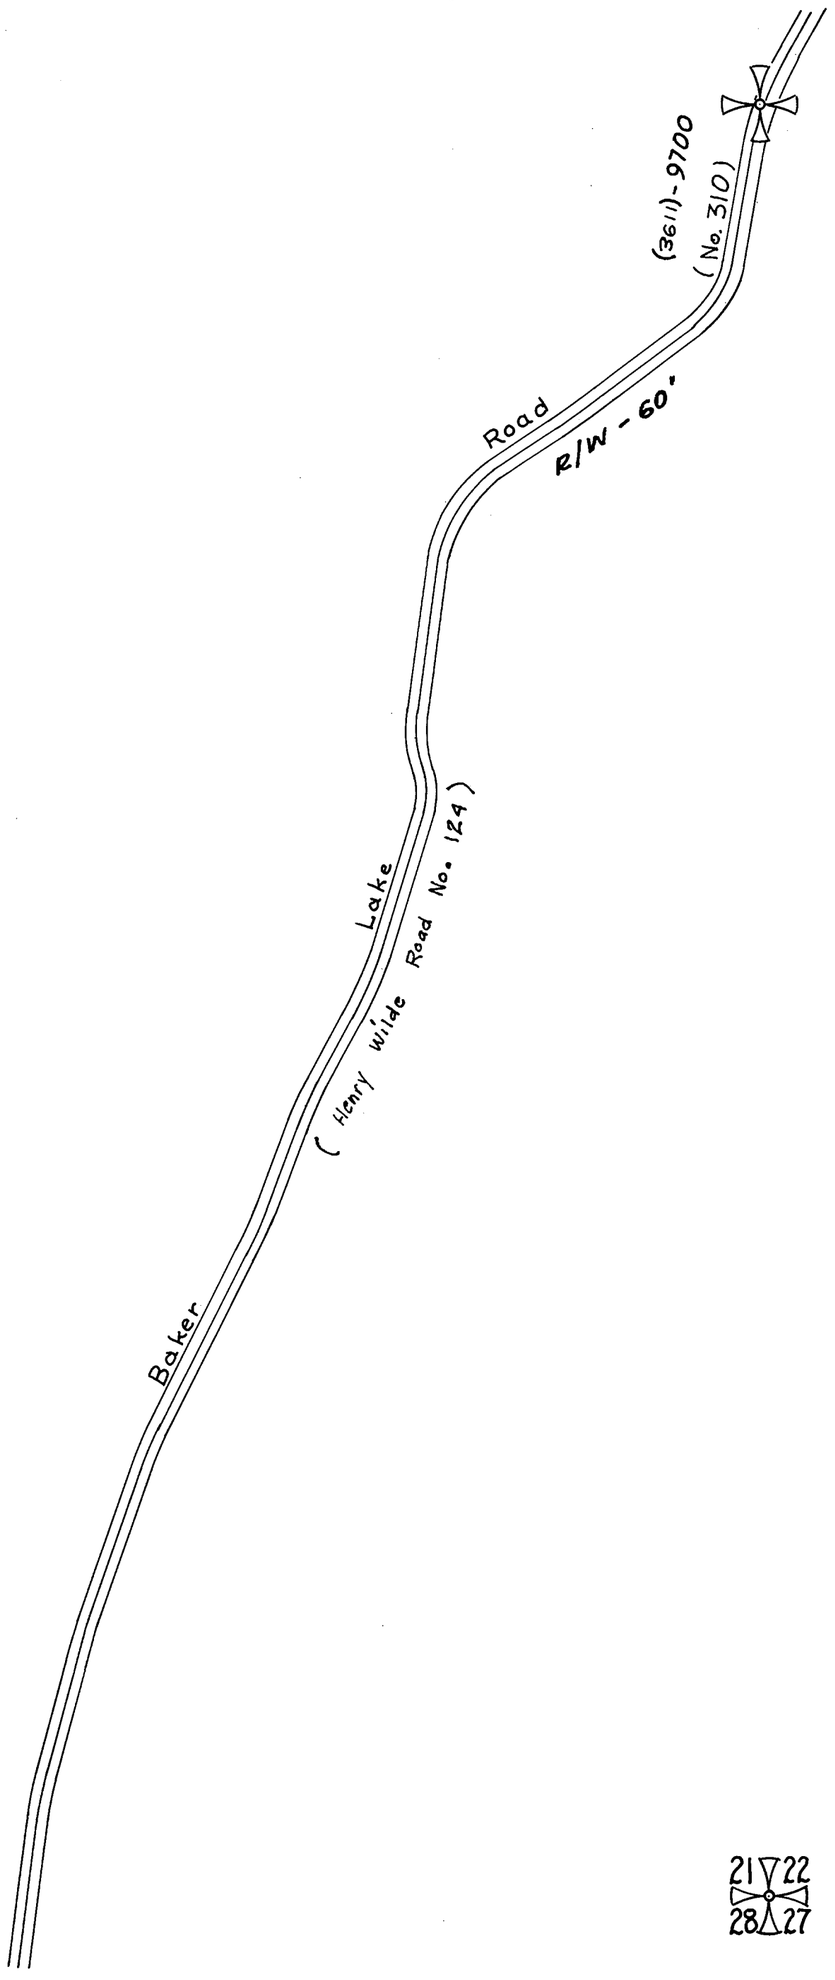

21 22
28 27

SECTION 21


TOWNSHIP 36 NORTH, RANGE 8 EAST, W. M.

SKAGIT COUNTY, WASH.

SCALE, 1 INCH -- 400 FEET

DATE 1968

Lloyd Johnson COUNTY ENGINEER

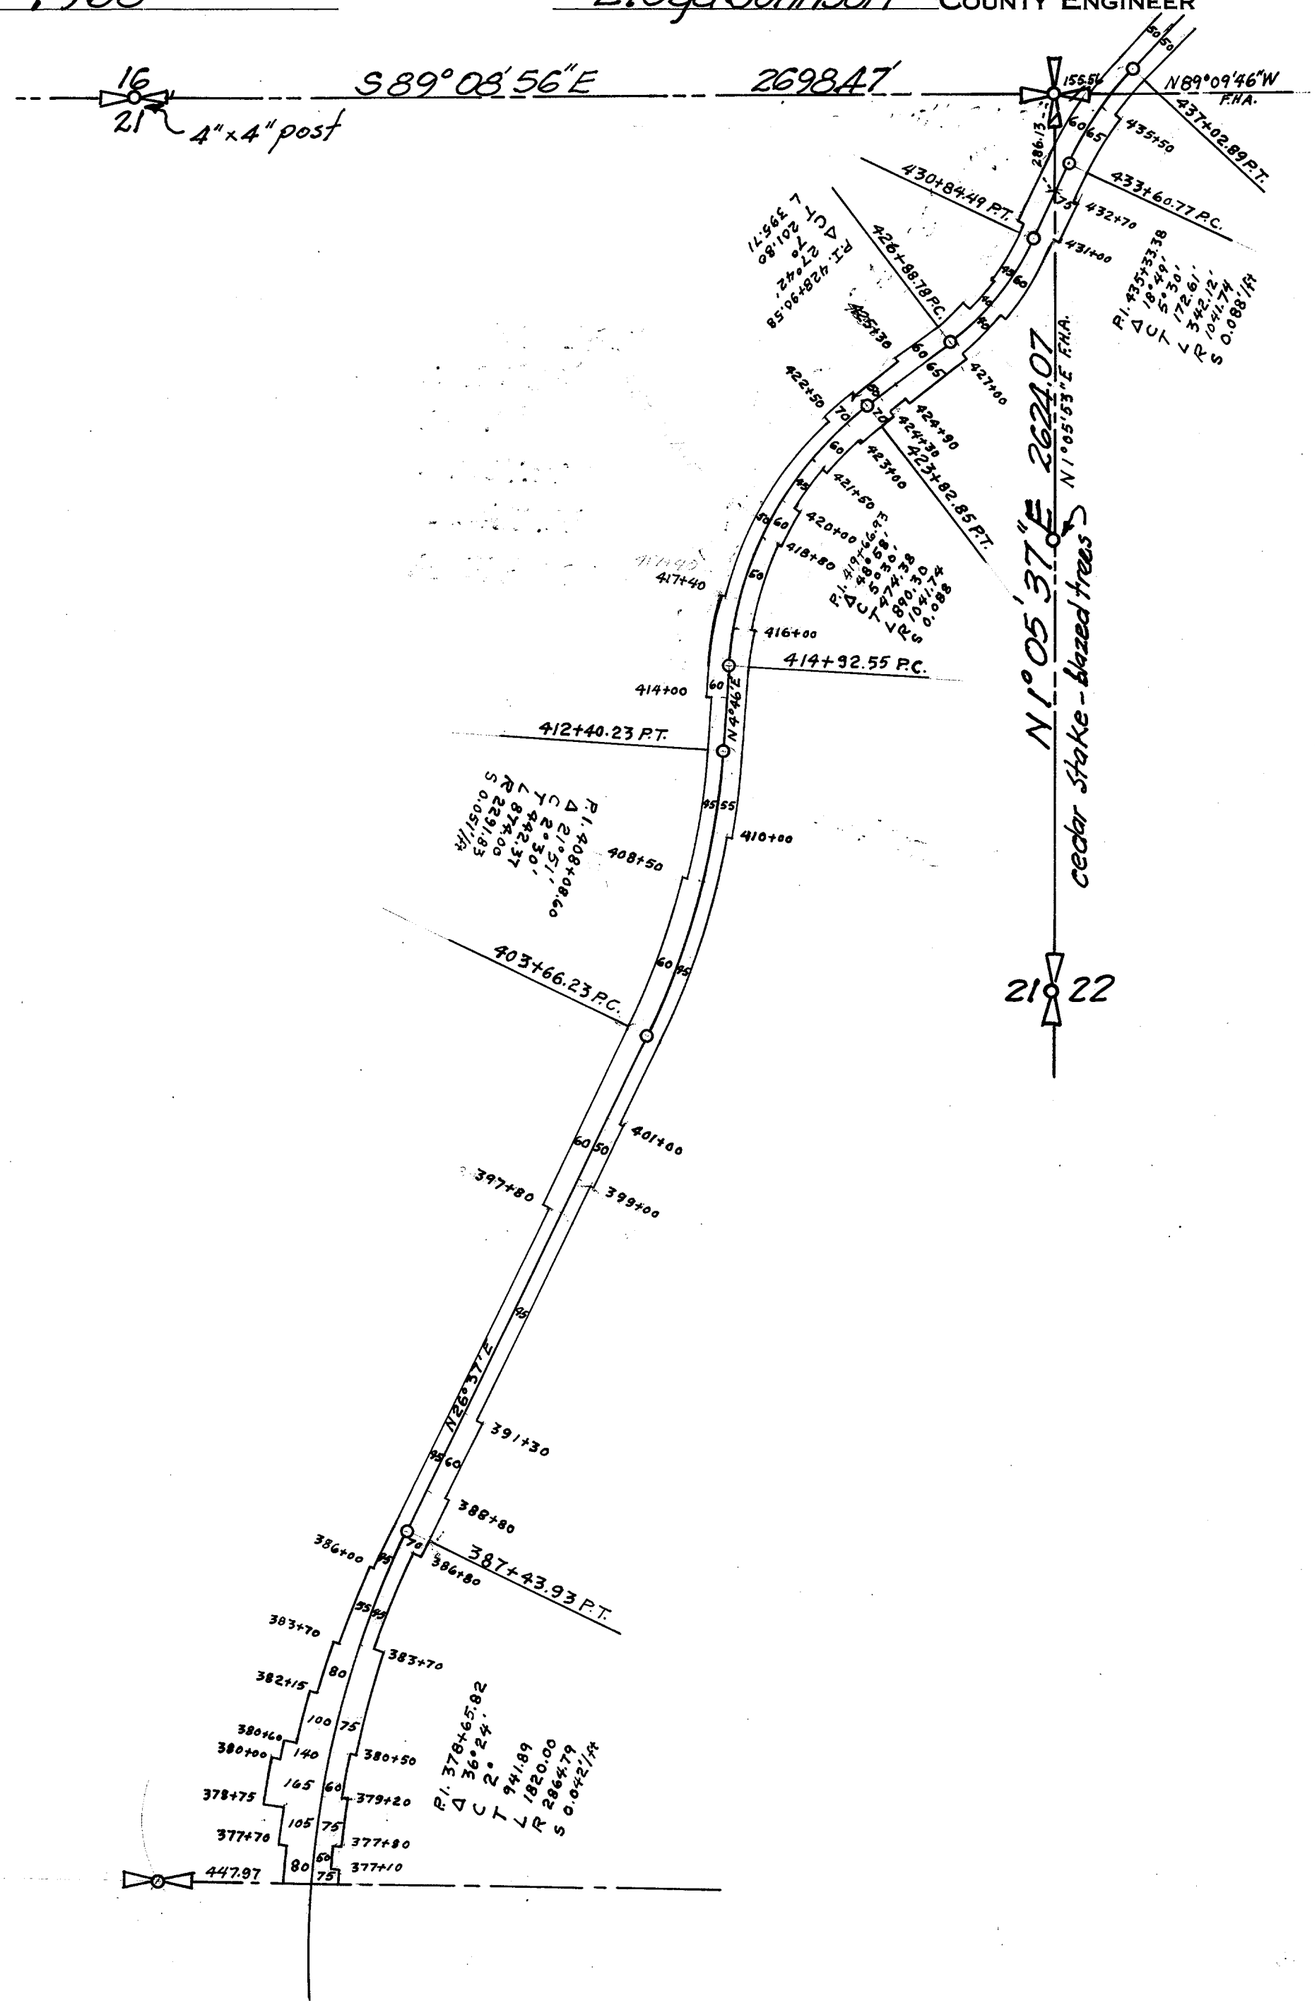

SECTION 22


TOWNSHIP 36 NORTH, RANGE 8 EAST, W. M.

SKAGIT COUNTY, WASH.

SCALE, 1 INCH -- 400 FEET

DATE 1968

Lloyd Johnson COUNTY ENGINEER

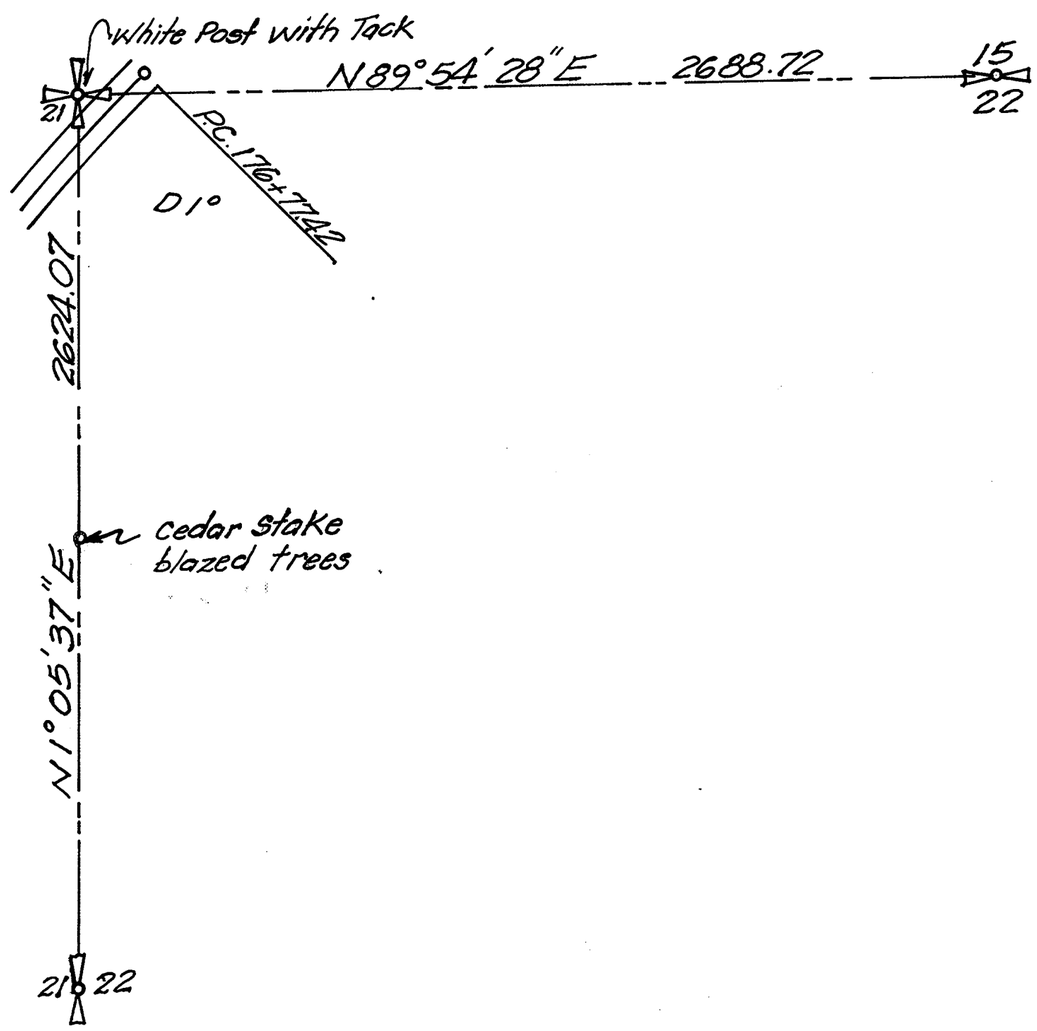

SECTION 24


TOWNSHIP 36 NORTH, RANGE 8 EAST, W. M.

SKAGIT COUNTY, WASH.

SCALE, 1 INCH -- 400 FEET

DATE September

Lloyd Johnson COUNTY ENGINEER

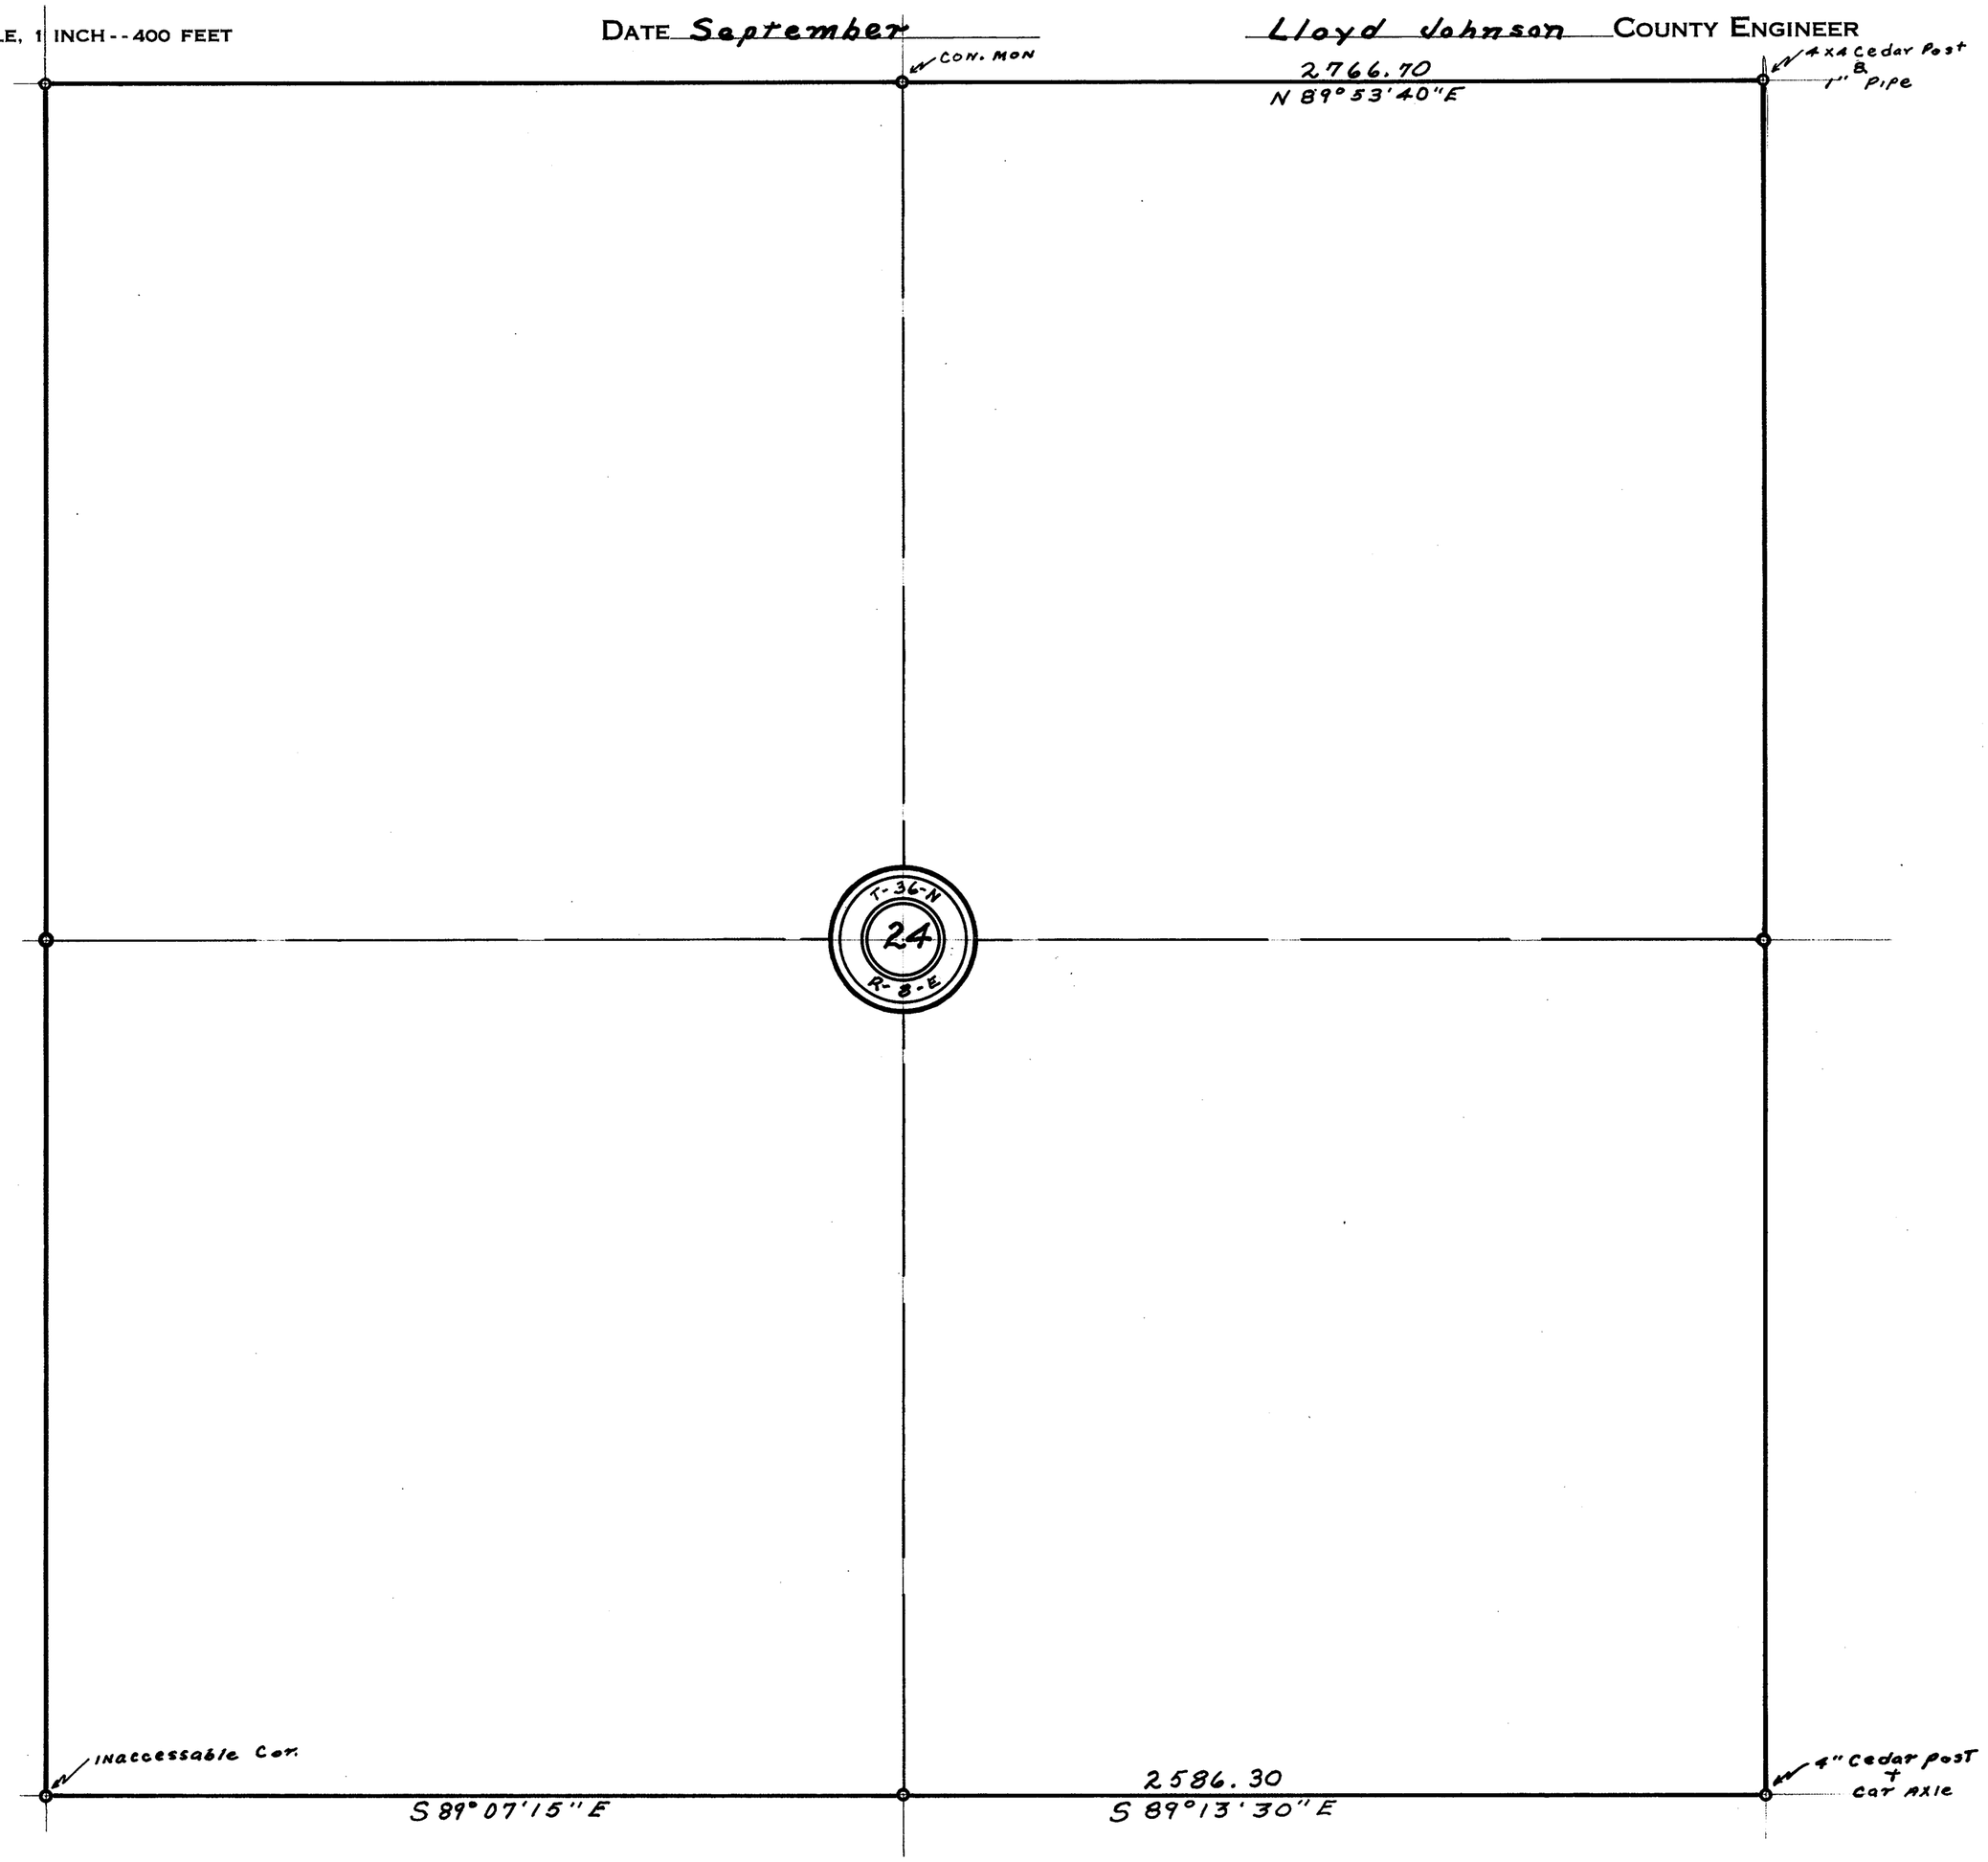

SECTION 25


TOWNSHIP 36 NORTH, RANGE 8 EAST, W. M.

SKAGIT COUNTY, WASH.

SCALE, 1 INCH -- 400 FEET

DATE September, 1971

Lloyd Johnson COUNTY ENGINEER

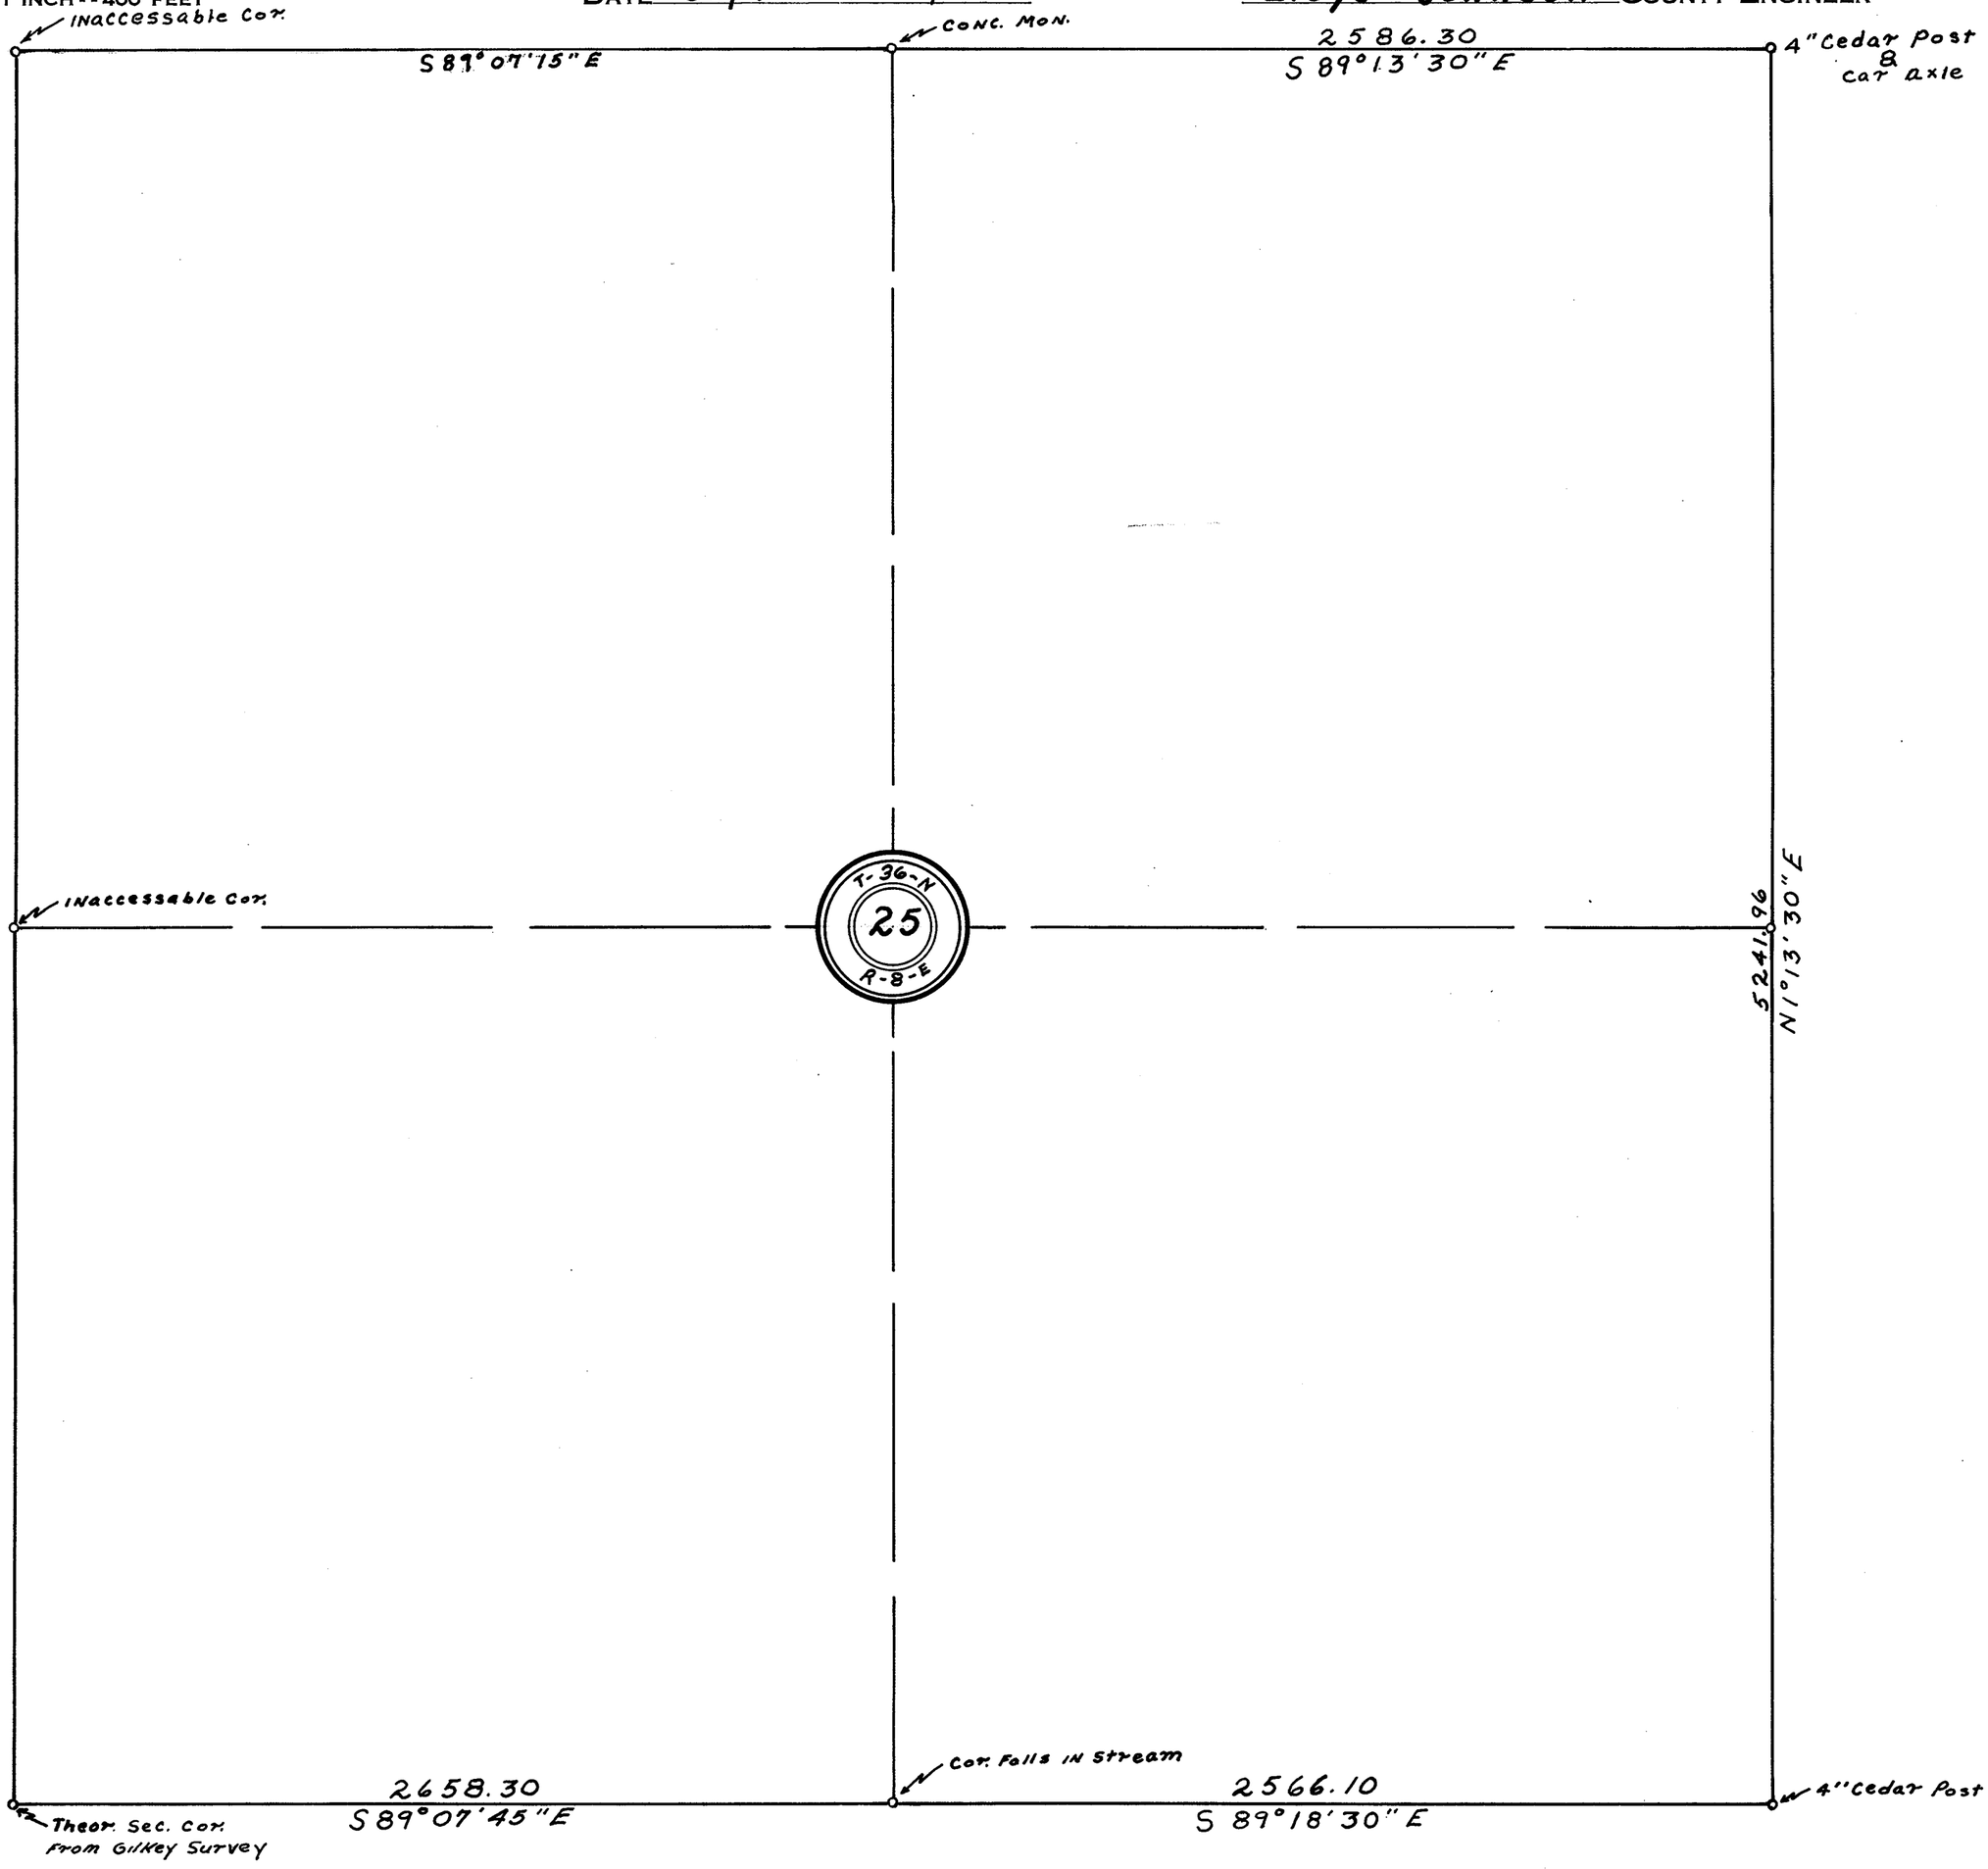

SECTION 28

TOWNSHIP 36 NORTH, RANGE 8 EAST, W. M.


SKAGIT COUNTY, WASH.

SCALE, 1 INCH -- 400 FEET

DATE 12-31-70 Rev. 6-27-75

Lloyd Johnson COUNTY ENGINEER

NOTE:
Token From Hard Copy A21/21

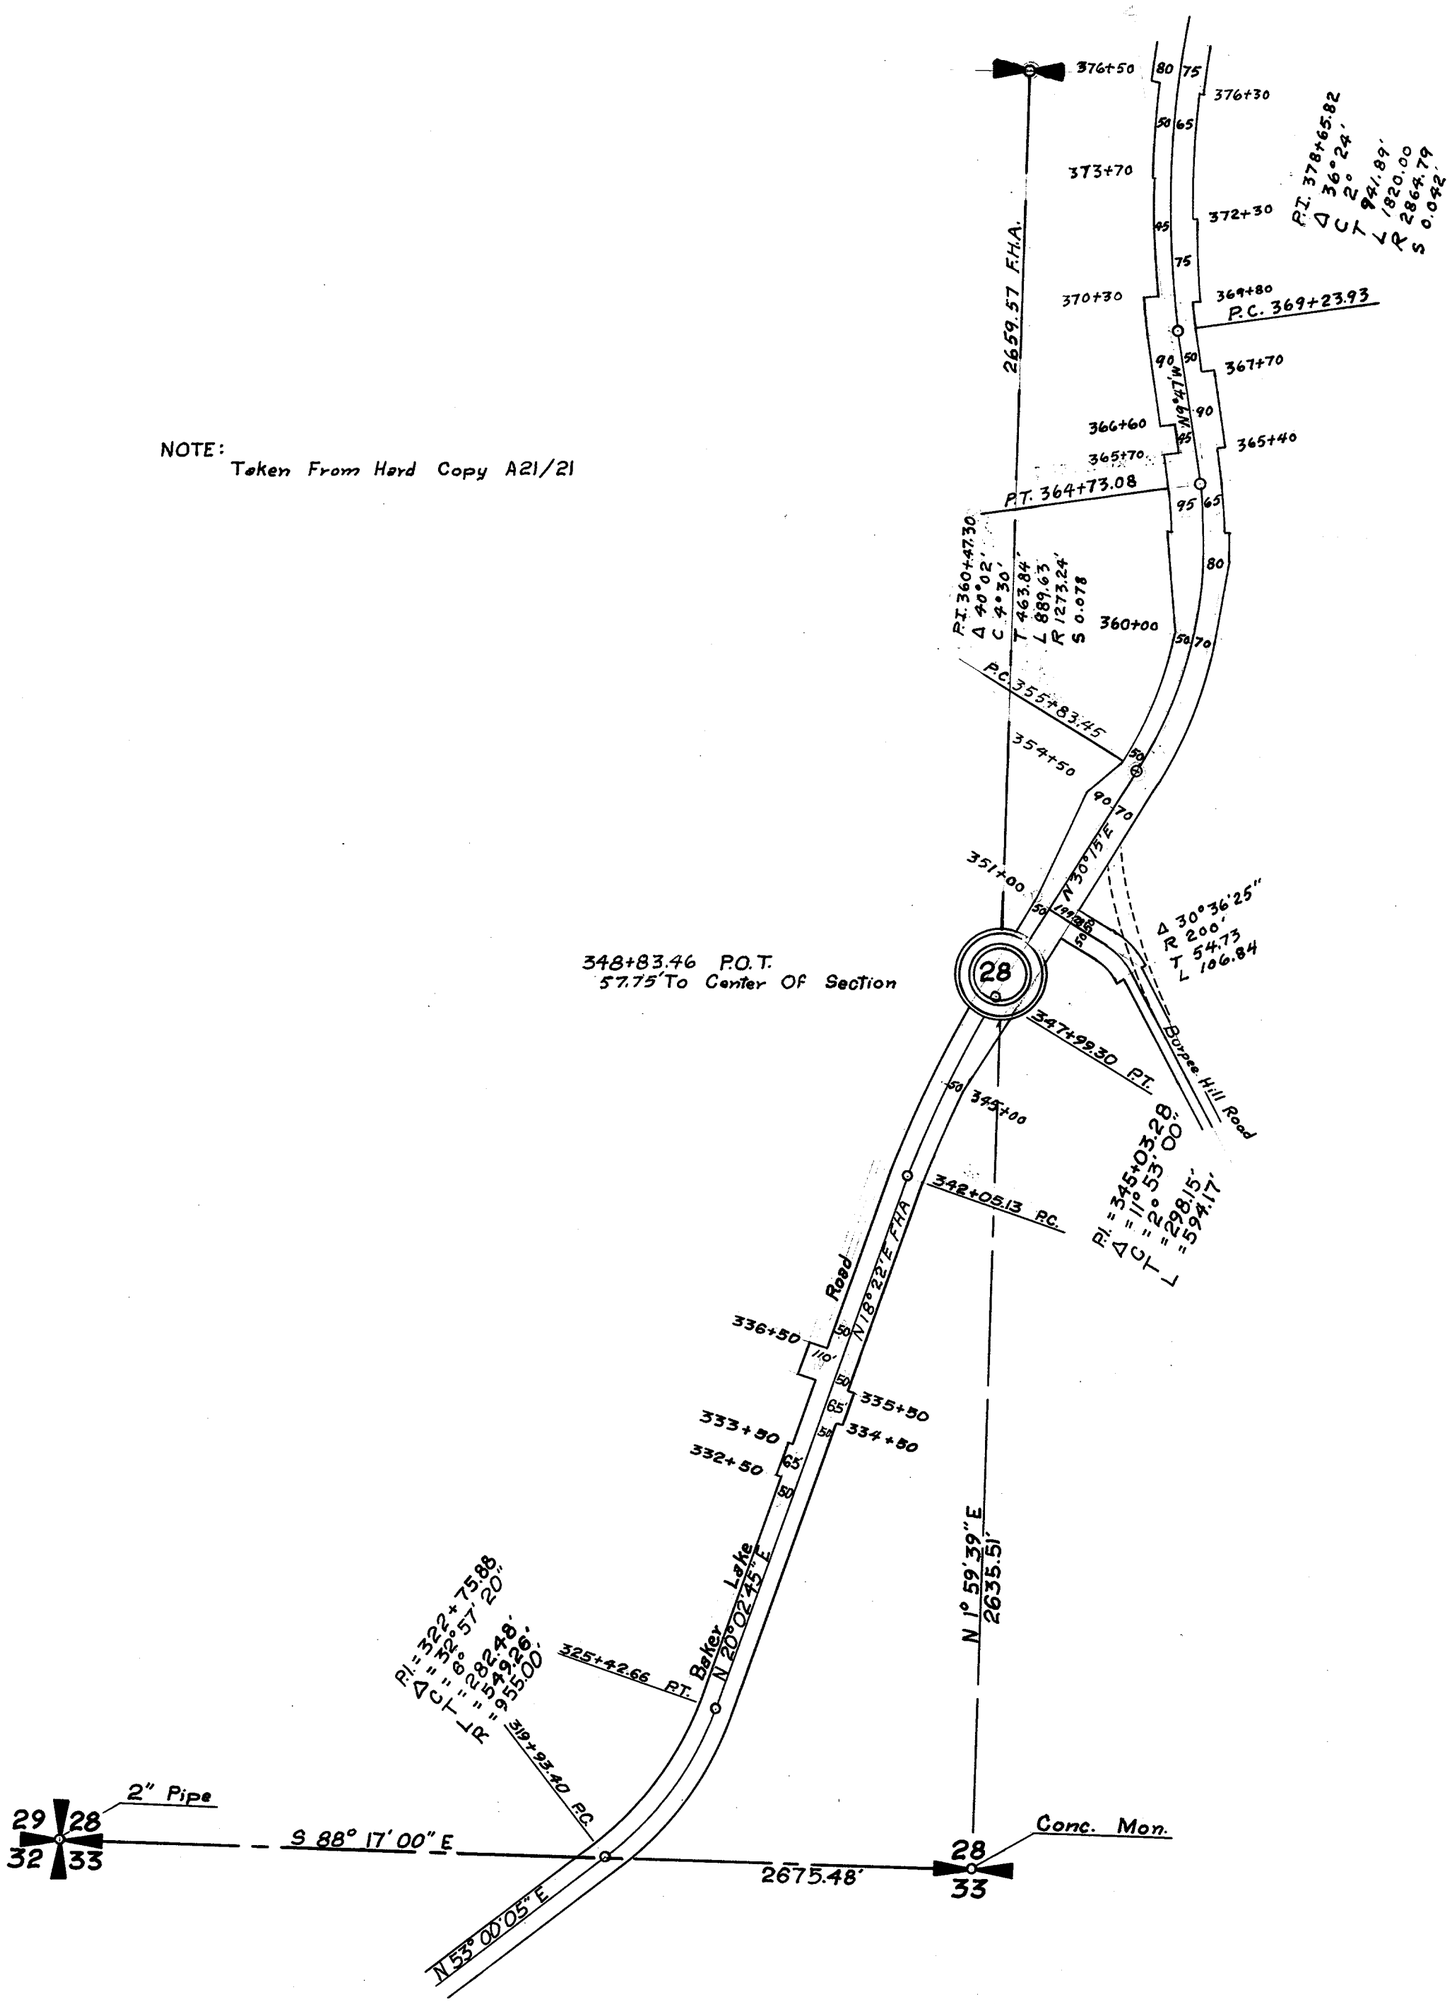

SECTION 28


TOWNSHIP 36 NORTH, RANGE 8 EAST, W. M.

SKAGIT COUNTY, WASH.

SCALE, 1 INCH--400 FEET

DATE January, 1960 Frank Gilkey COUNTY ENGINEER

Road No. 310, P.O.T. 78+82.7 to P.I. 116+11.3 from Notes 41/486
Road No. 310, Unmarked, from Aerial Photo CWD-1R-136 (Assessors)
Unshaded Sec. Cor. from Aerial Photo

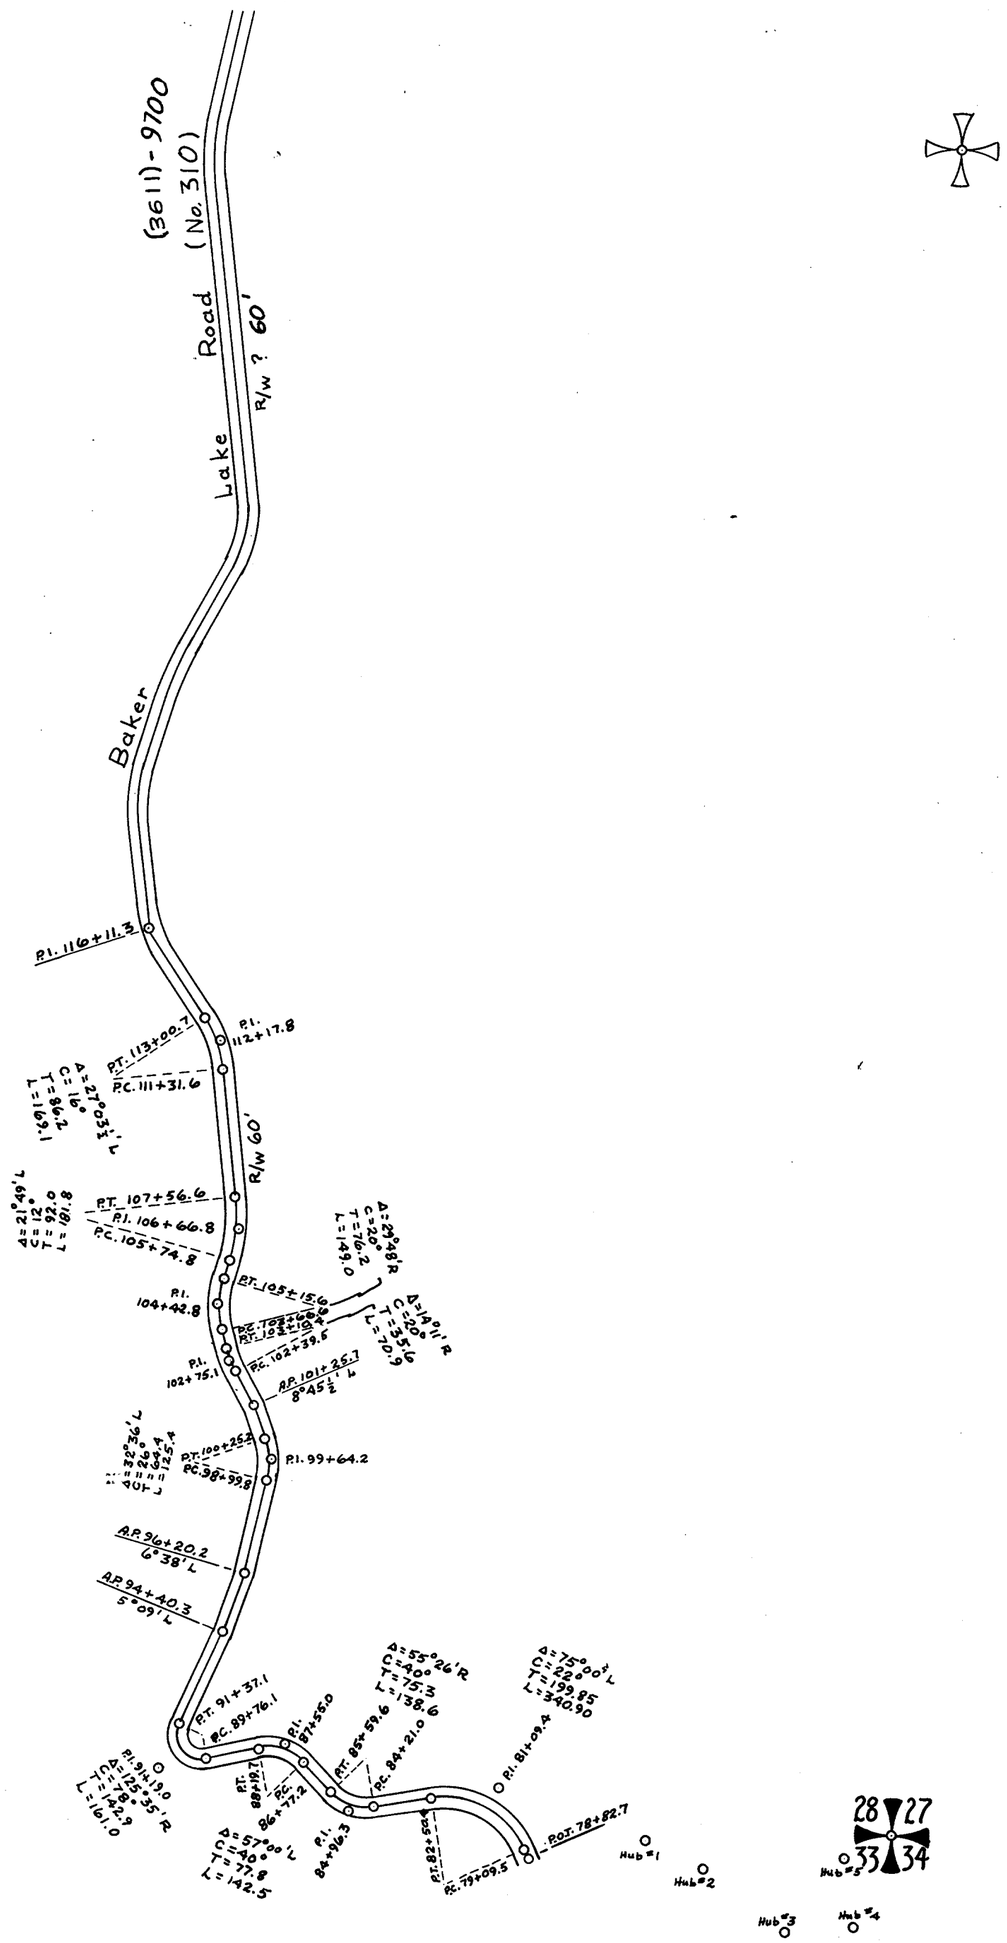


SECTION 31

TOWNSHIP 36 NORTH, RANGE 8 EAST, W. M.

SKAGIT COUNTY, WASH.

SCALE, 1 INCH--400 FEET

DATE _____ _____ COUNTY ENGINEER

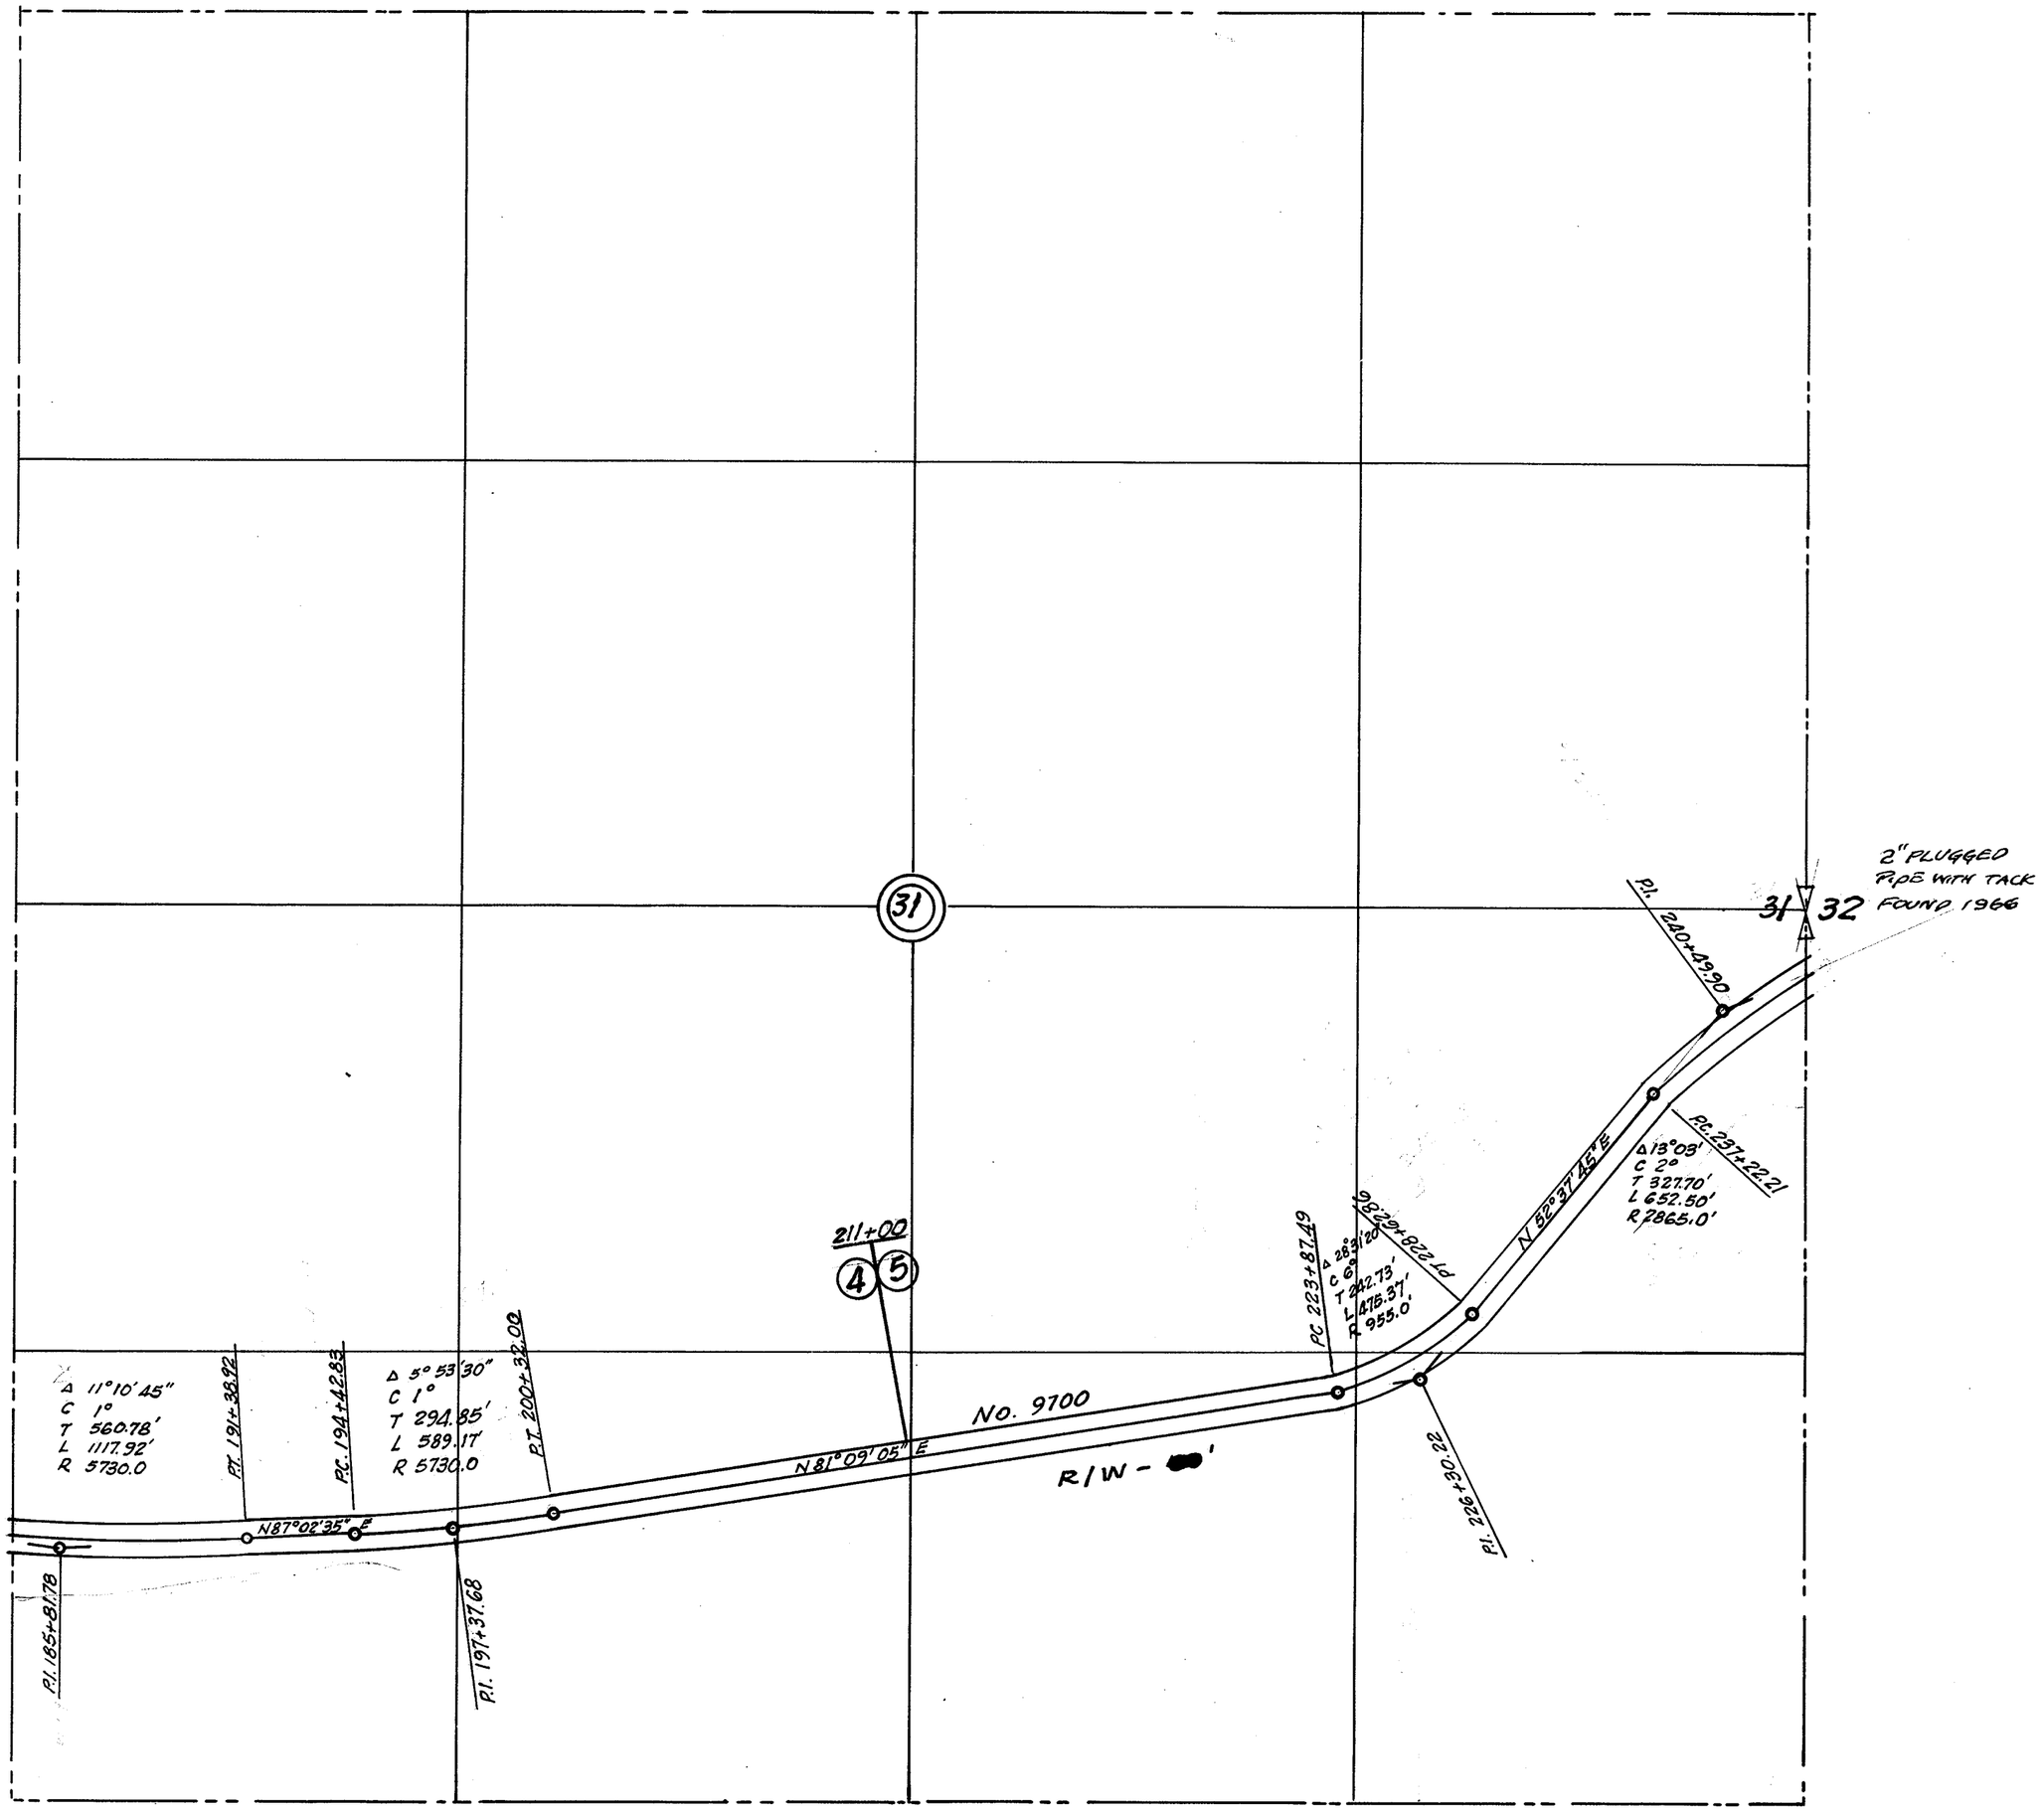

SECTION 32


TOWNSHIP 36 NORTH, RANGE 8 EAST, W. M.

SKAGIT COUNTY, WASH.

SCALE, 1 INCH -- 400 FEET

DATE Jan 1968

Lloyd Johnson COUNTY ENGINEER
CR Reid

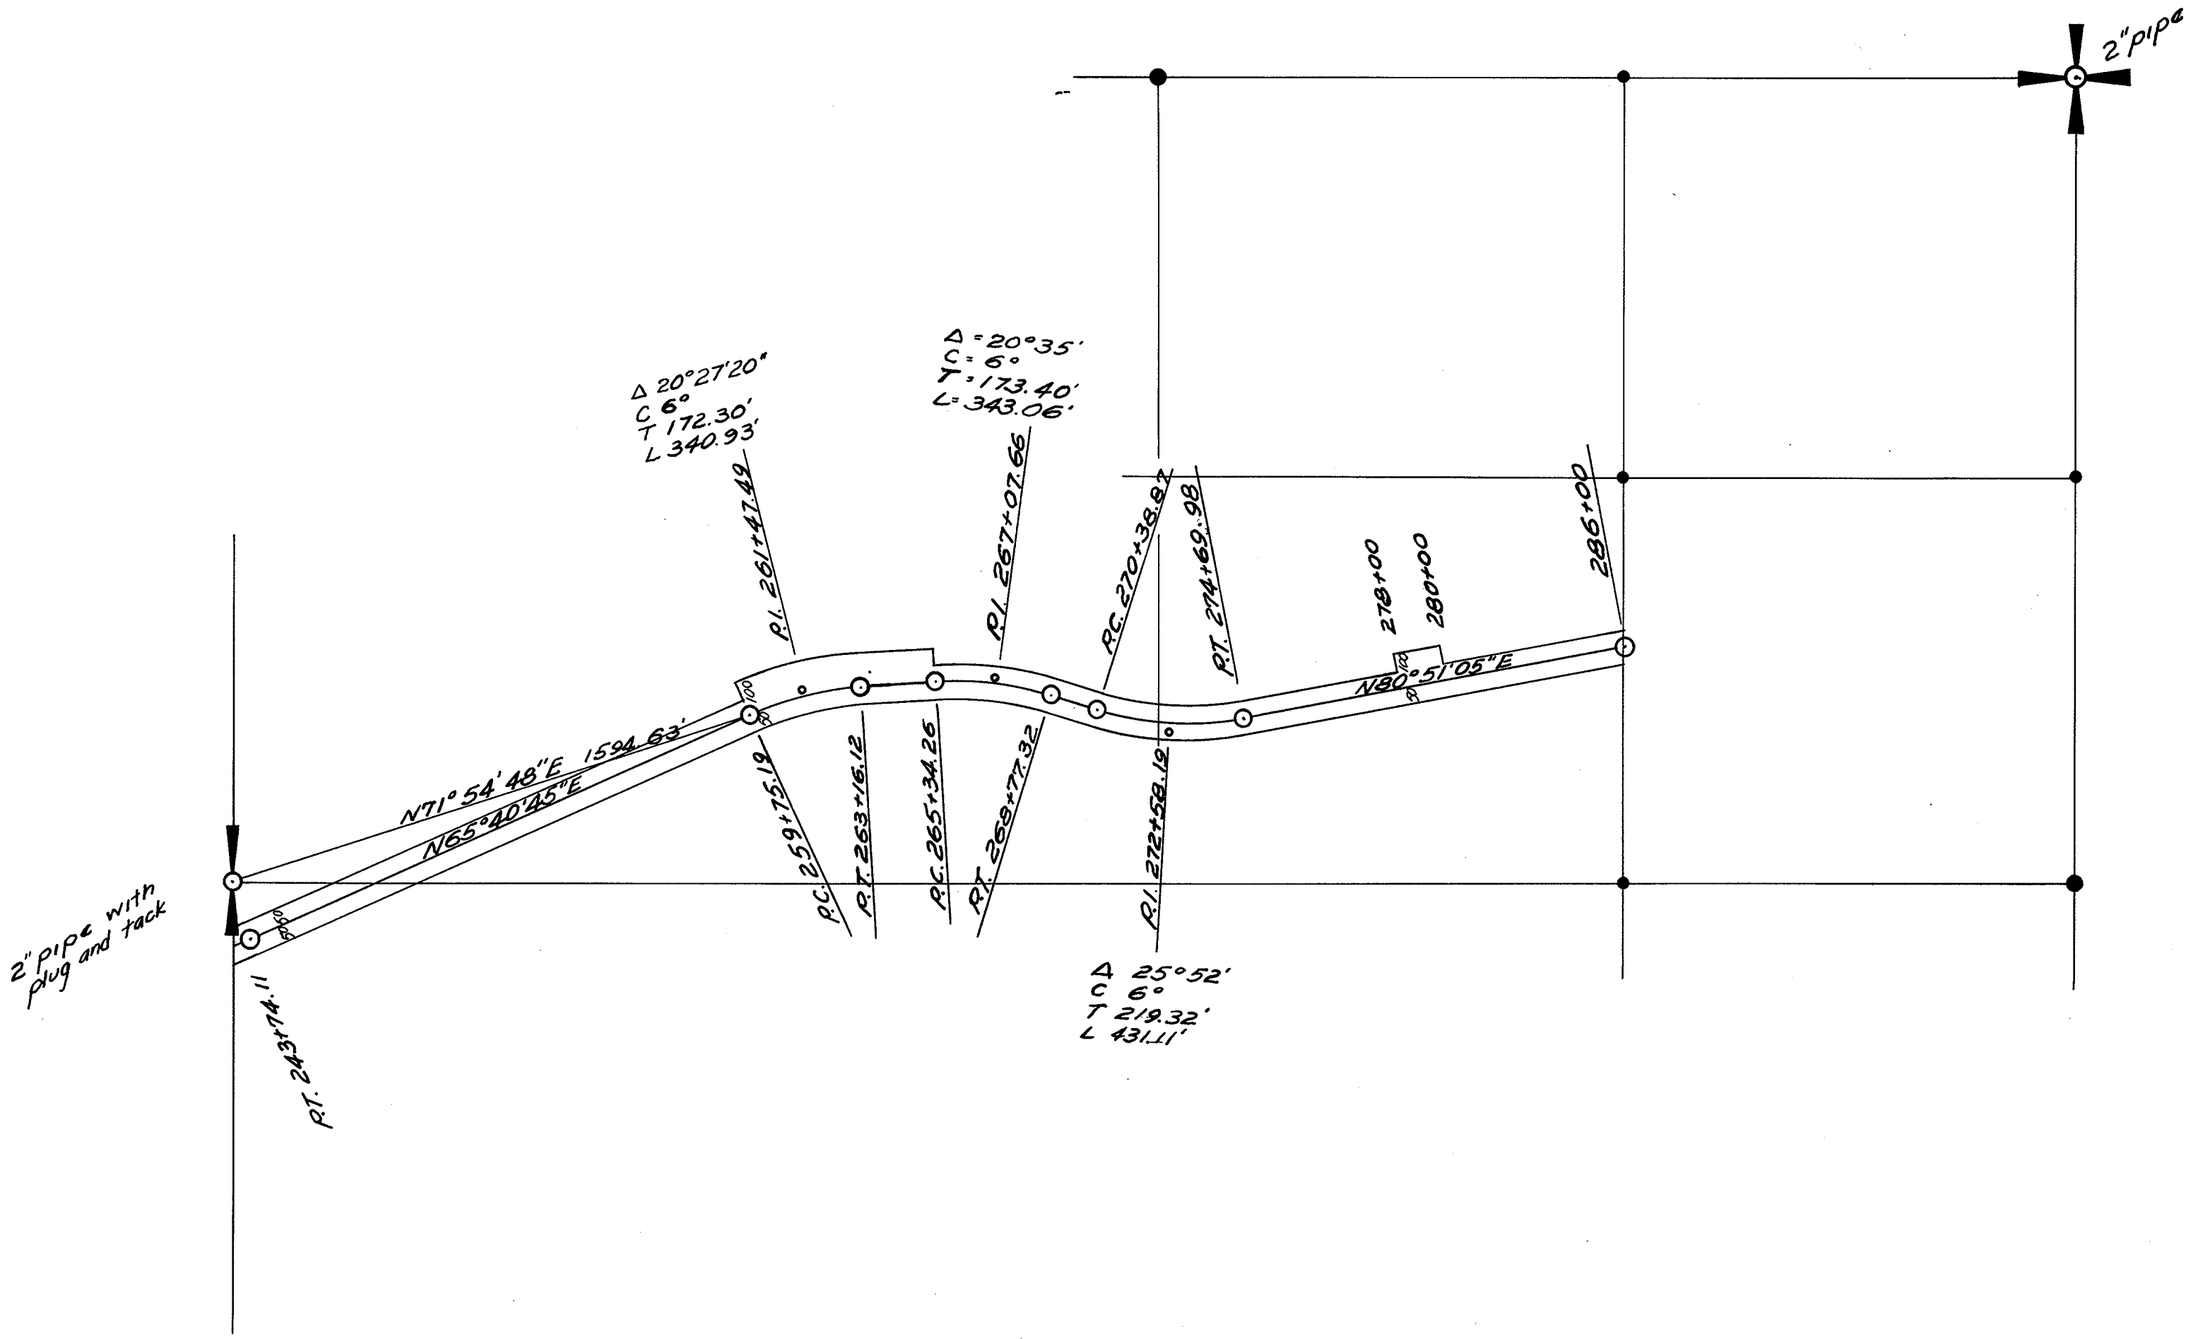


SECTION 32

TOWNSHIP 36 NORTH, RANGE 8 EAST, W. M.

SKAGIT COUNTY, WASH.

SCALE, 1 INCH--400 FEET

DATE _____ _____ COUNTY ENGINEER

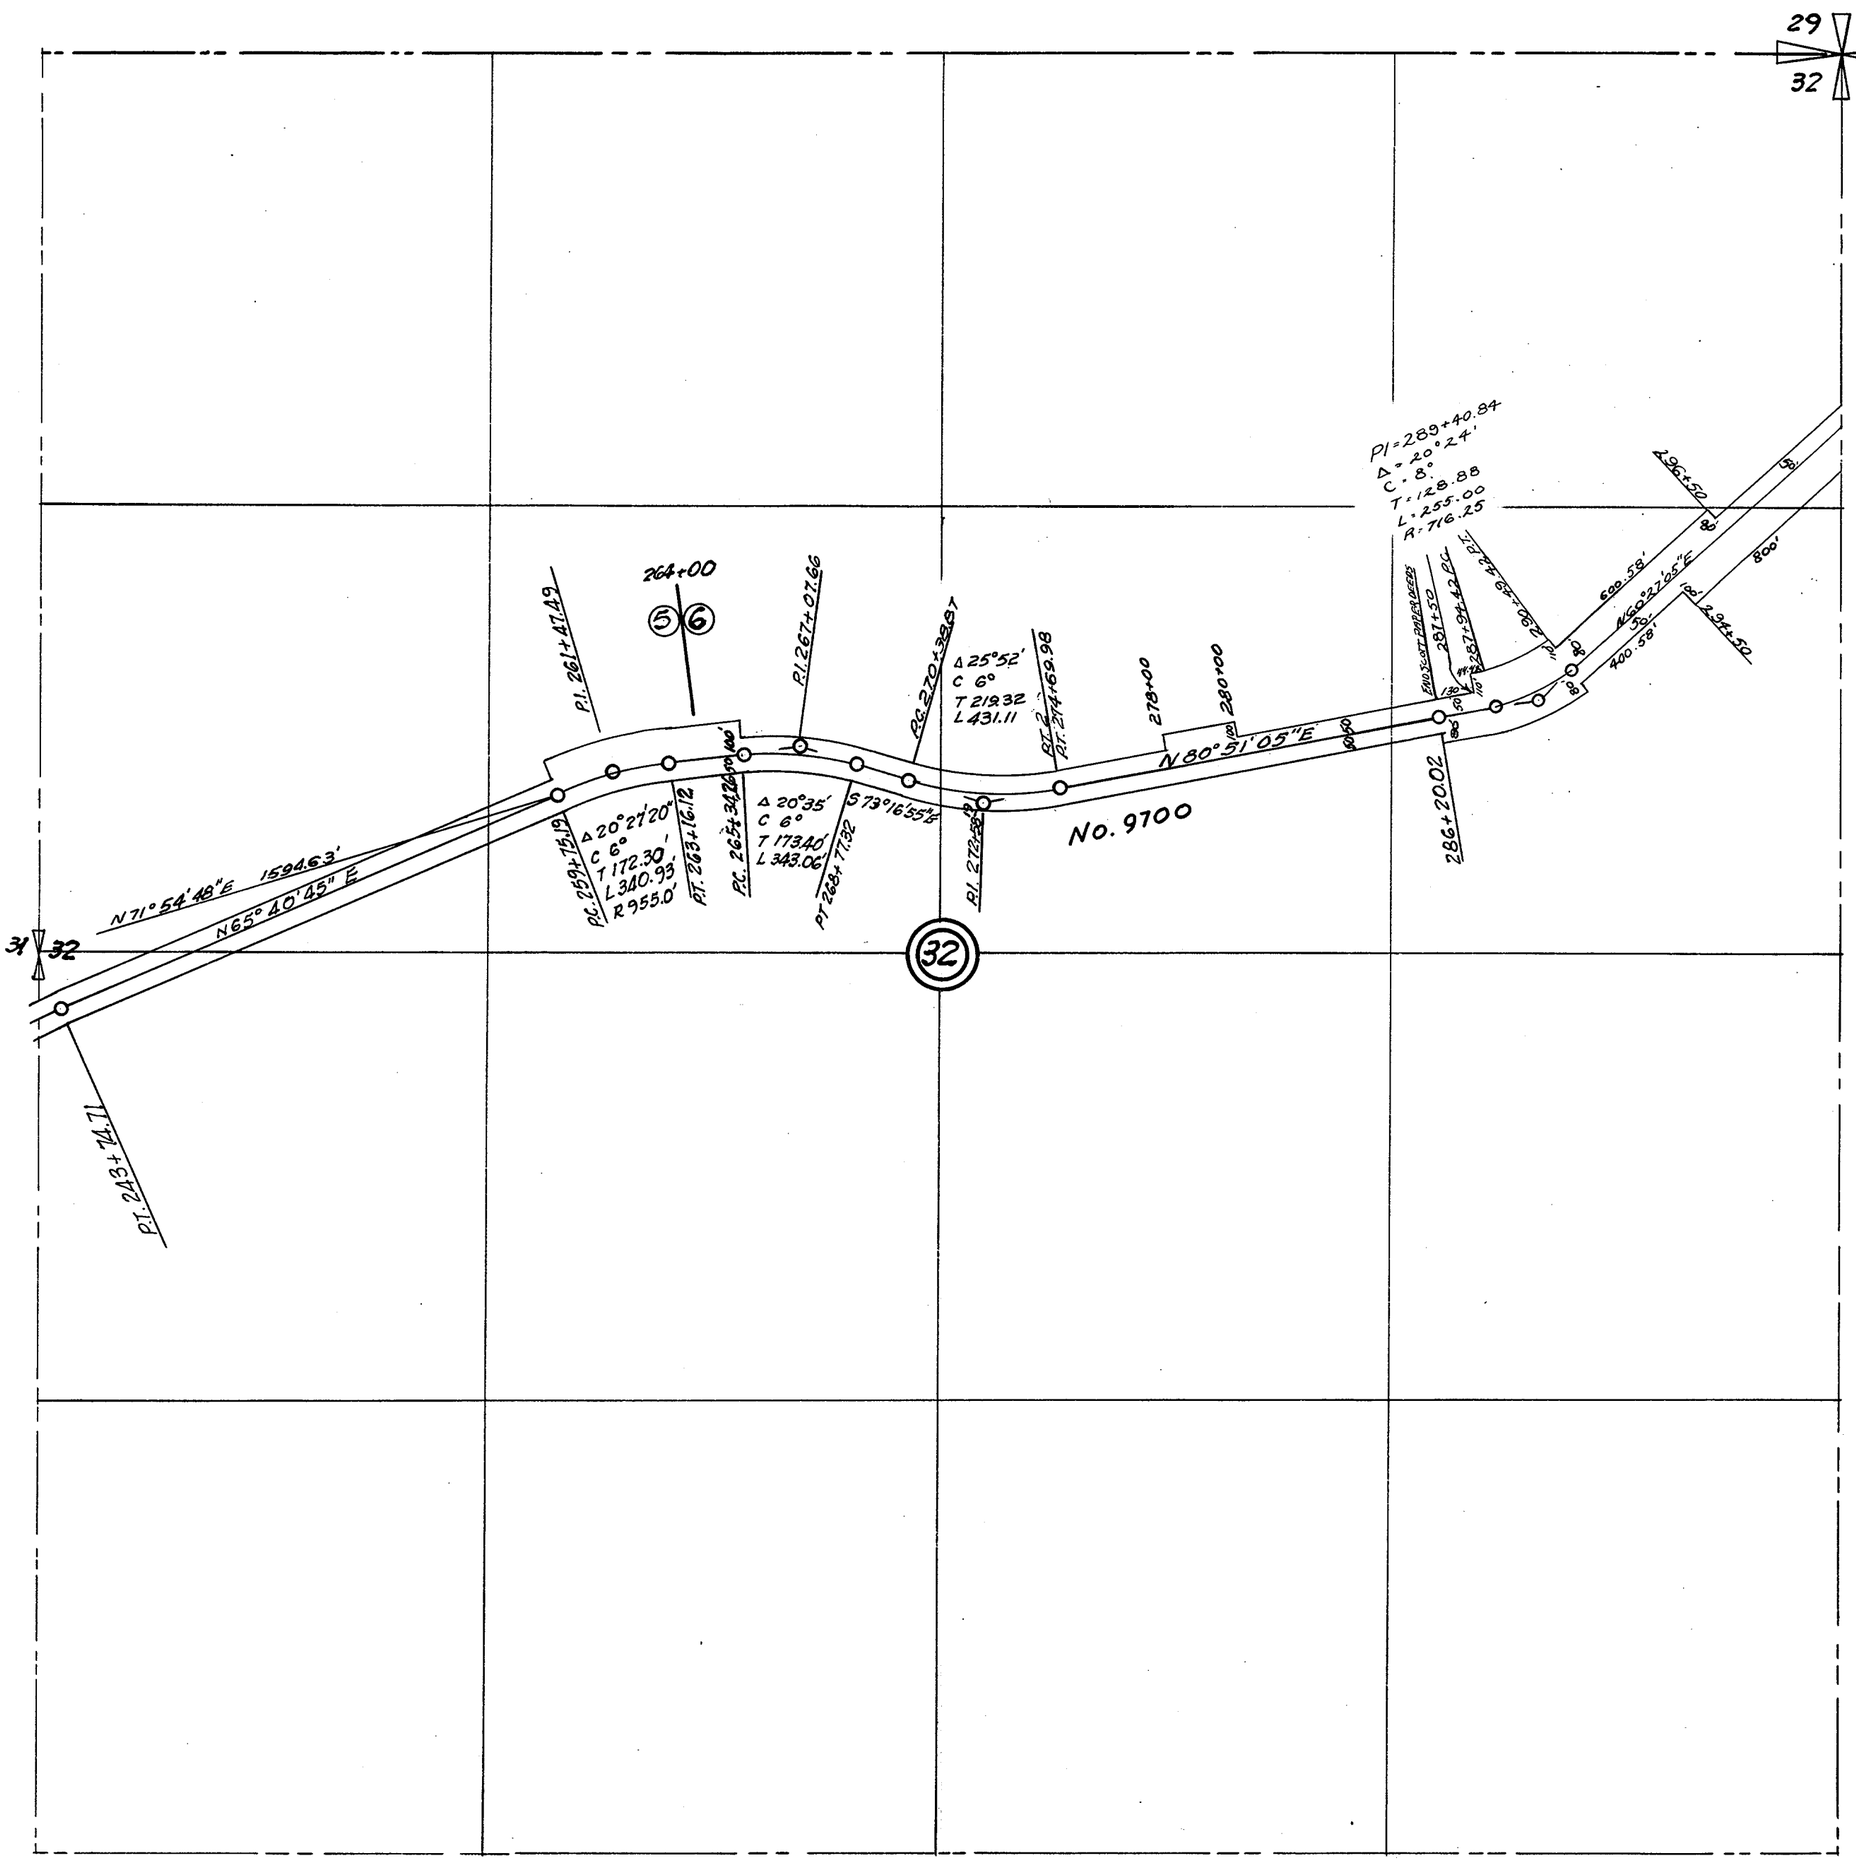

SECTION 33


TOWNSHIP 36 NORTH, RANGE 8 EAST, W. M.

SKAGIT COUNTY, WASH.

SCALE, 1 INCH--400 FEET
Road No. 310 from Notes 41/486

DATE January, 1960

Frank Gilkey COUNTY ENGINEER

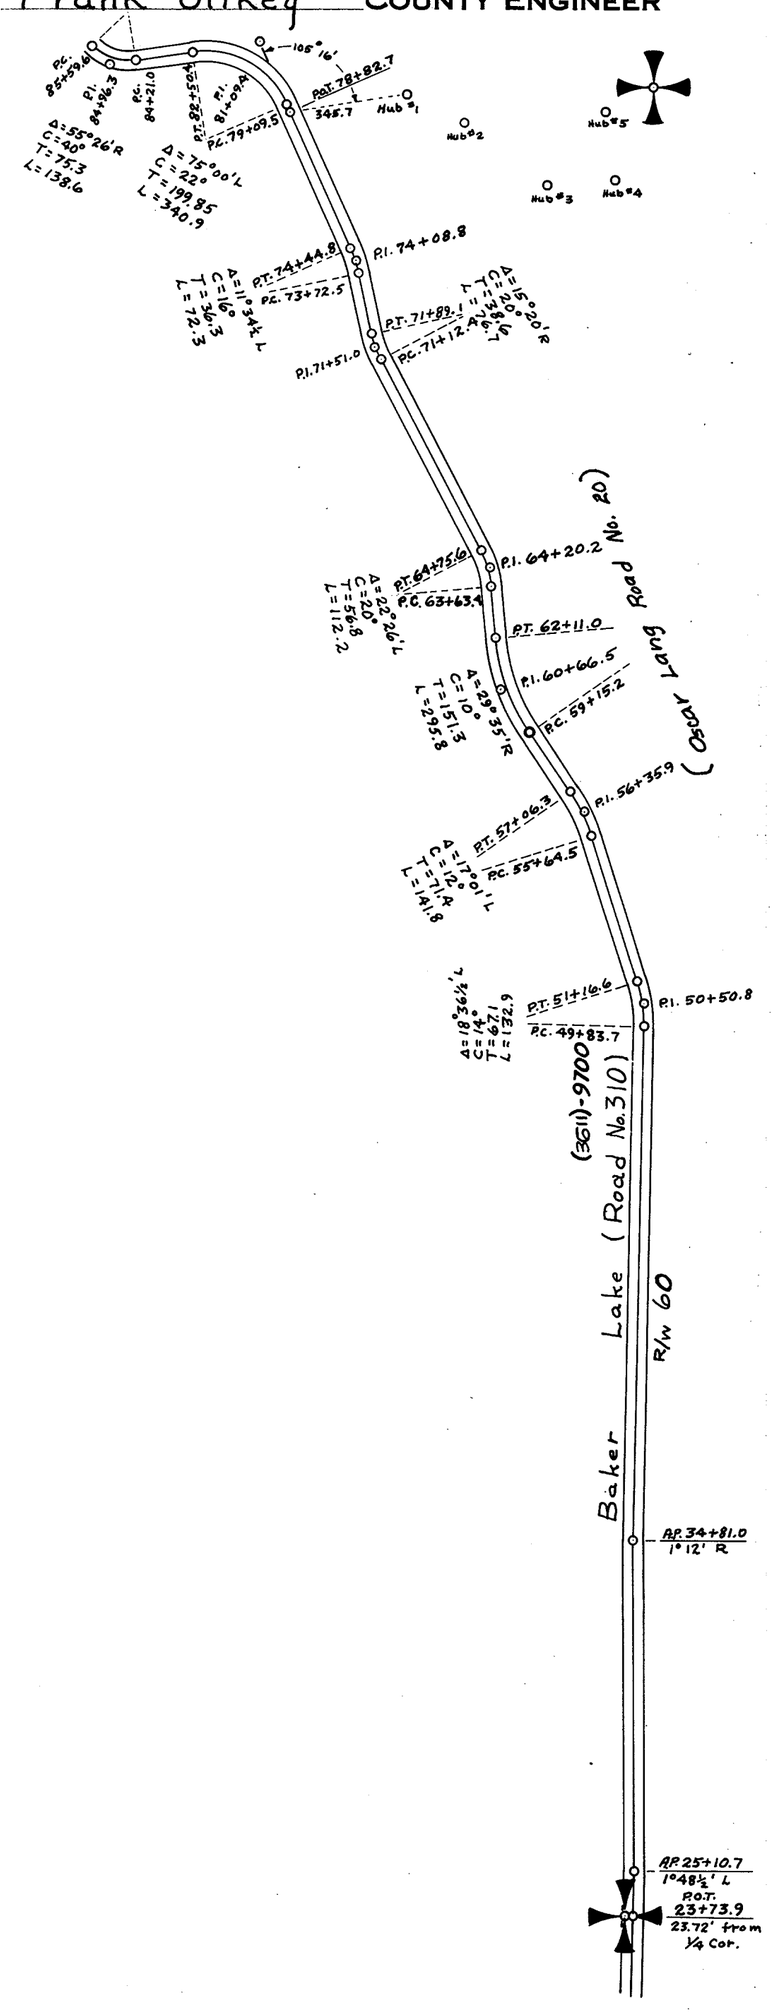

SECTION 33


TOWNSHIP 36 NORTH, RANGE 8 EAST, W. M.

SKAGIT COUNTY, WASH.

SCALE, 1 INCH -- 400 FEET

DATE 12-30-70

Lloyd Johnson COUNTY ENGINEER

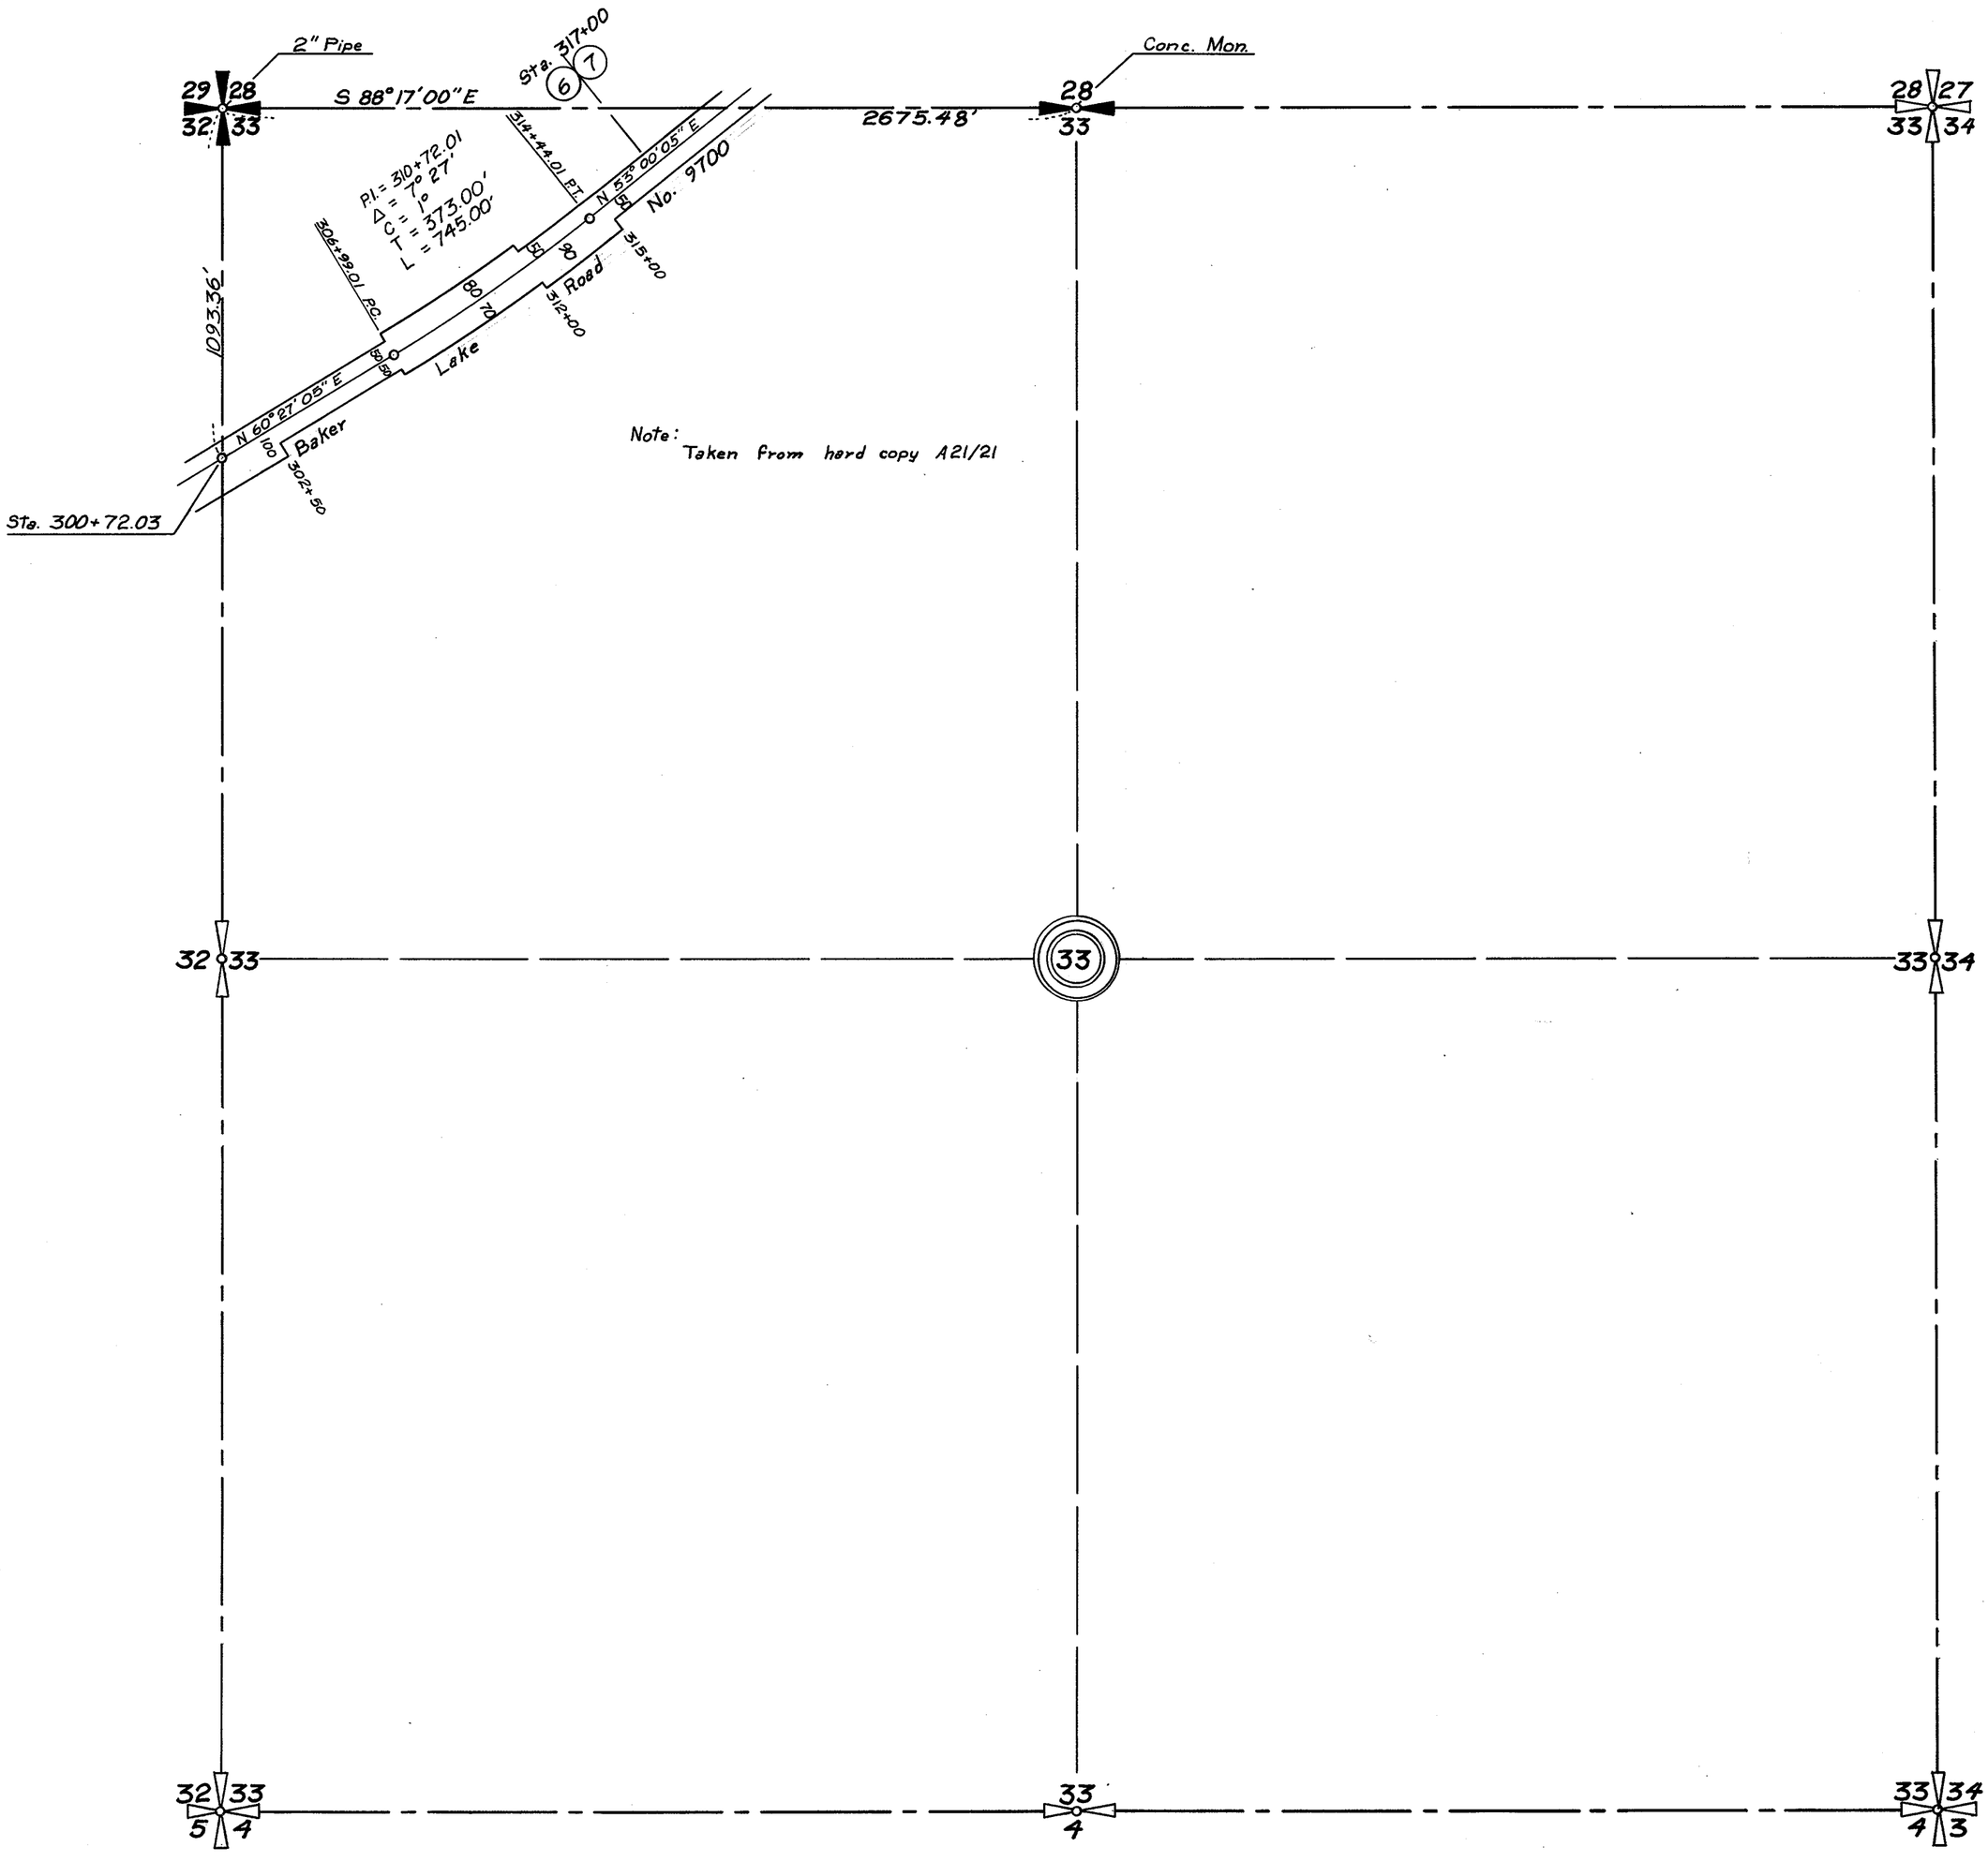


TOWNSHIP 36 NORTH, RANGE 8 EAST, W. M.

SKAGIT COUNTY, WASH.

SCALE, 1 INCH = 400 FEET

DATE September, 1971

Lloyd Johnson COUNTY ENGINEER

